


LEGEND

- ✕ 571.23 AS-BUILT DATA LOCATED 11/13/2025
- 0.12 ✕ ELEVATION DIFFERENCE BETWEEN DESIGN AND AS-BUILT DATA LOCATED 11/13/2025

Elevations Table			
Number	Minimum Elevation	Maximum Elevation	Color
1	-0.200	-0.100	Red
2	-0.100	0.000	Light Red
3	0.000	0.100	Light Blue
4	0.100	0.200	Dark Blue

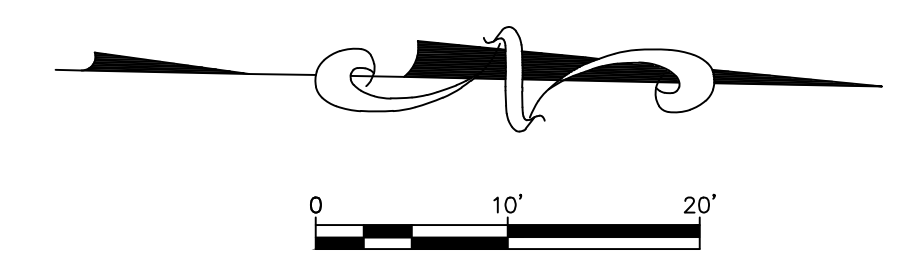

McCARTY ASSOCIATES LLC CONSTRUCTION SERVICES
 NEW POINTS IN
 ALAN STONE - GAL-7-19.94
 PAVEMENT ASBUILT
 DATE 11/13/25
 SCALE 1" = 10'

U:\2025\25-131 Alan Stone Co. GAL-7-19.94 Alan Stone Co. Survey\25131_2025-11-13 EP Asphalt.dwg, layout1, 11/14/2025 3:24:22 PM, .csh