


ROUTE	FROM	TO	PLAN SPLITS	DISTANCE		618		621			642		644	
						RUMBLE STRIPES, EDGE LINE	RUMBLE STRIPES, CENTER LINE	RPM		RAISED PAVEMENT MARKER REMOVED	CENTER LINE	EDGE LINE	STOP LINE	DOTTED LINE
	YEL/YEL	WHITE	EACH	EACH	EACH			MILE	MILE					
	SLM	SLM		MILES	FEET	MILE	MILE	EACH	EACH	EACH	MILE	MILE	FT	FT
ALL SR 66	2.38	2.40	01/STR/05	0.02	106	0.04	0.02	1		1	0.02	0.04		
ALL SR 66	2.40	3.58	01/STR/05	1.18	6230	2.36	1.18	78		78	1.18	2.36		
ALL SR 66	3.58	3.80	01/STR/05	0.22	1162	0.44	0.22	15		15	0.22	0.44		
ALL SR 66	3.80	4.11	01/STR/05	0.31	1637	0.62	0.31	41		41	0.31	0.62	39	262
ALL SR 66	4.11	4.17	01/STR/05	0.06	317	0.12	0.06	4	16 #	4	0.06	0.12	20	
ALL SR 66	4.17	5.62	01/STR/05	1.45	7656	2.90	1.45	96		96	1.45	2.90		
ALL SR 66	5.62	9.68	01/STR/05	4.06	21437	8.12	4.06	268		268	4.06	8.12		
ALL SR 66	9.68	10.13	01/STR/05	0.45	2376	0.90	0.45	30		30	0.45	0.90		
ALL SR 66	10.13	10.49	02/S5K/05	0.36	1901	0.72	0.36	24		24	0.36	0.72		
HAN SR 613	9.19	9.29	01/STR/05	0.10	528		0.10							
	Plan Split 01					15.50	7.85	533	16	533	7.75	15.50	59	262
	Plan Split 02					0.72	0.36	24		24	0.36	0.72		
	Totals					16.22	8.21	573		557	8.11	16.22	59	262

Note: Pavement Marking subtotals carried to General Summary.

Note: Unless otherwise noted, proposed pavement markings shall match the locations of existing pavement markings. Prior to starting the work, the contractor and project engineer shall confirm the locations of proposed pavement markings.

- 16 One Way White RPM's added to SR 66 edge line at SR 81 intersection as per SCD TC-65.11.

Note: Center line rumble stripes to be added at additional location shown on the map below. Located on SR 613 in Hancock County from SLM 9.19 to 9.29.

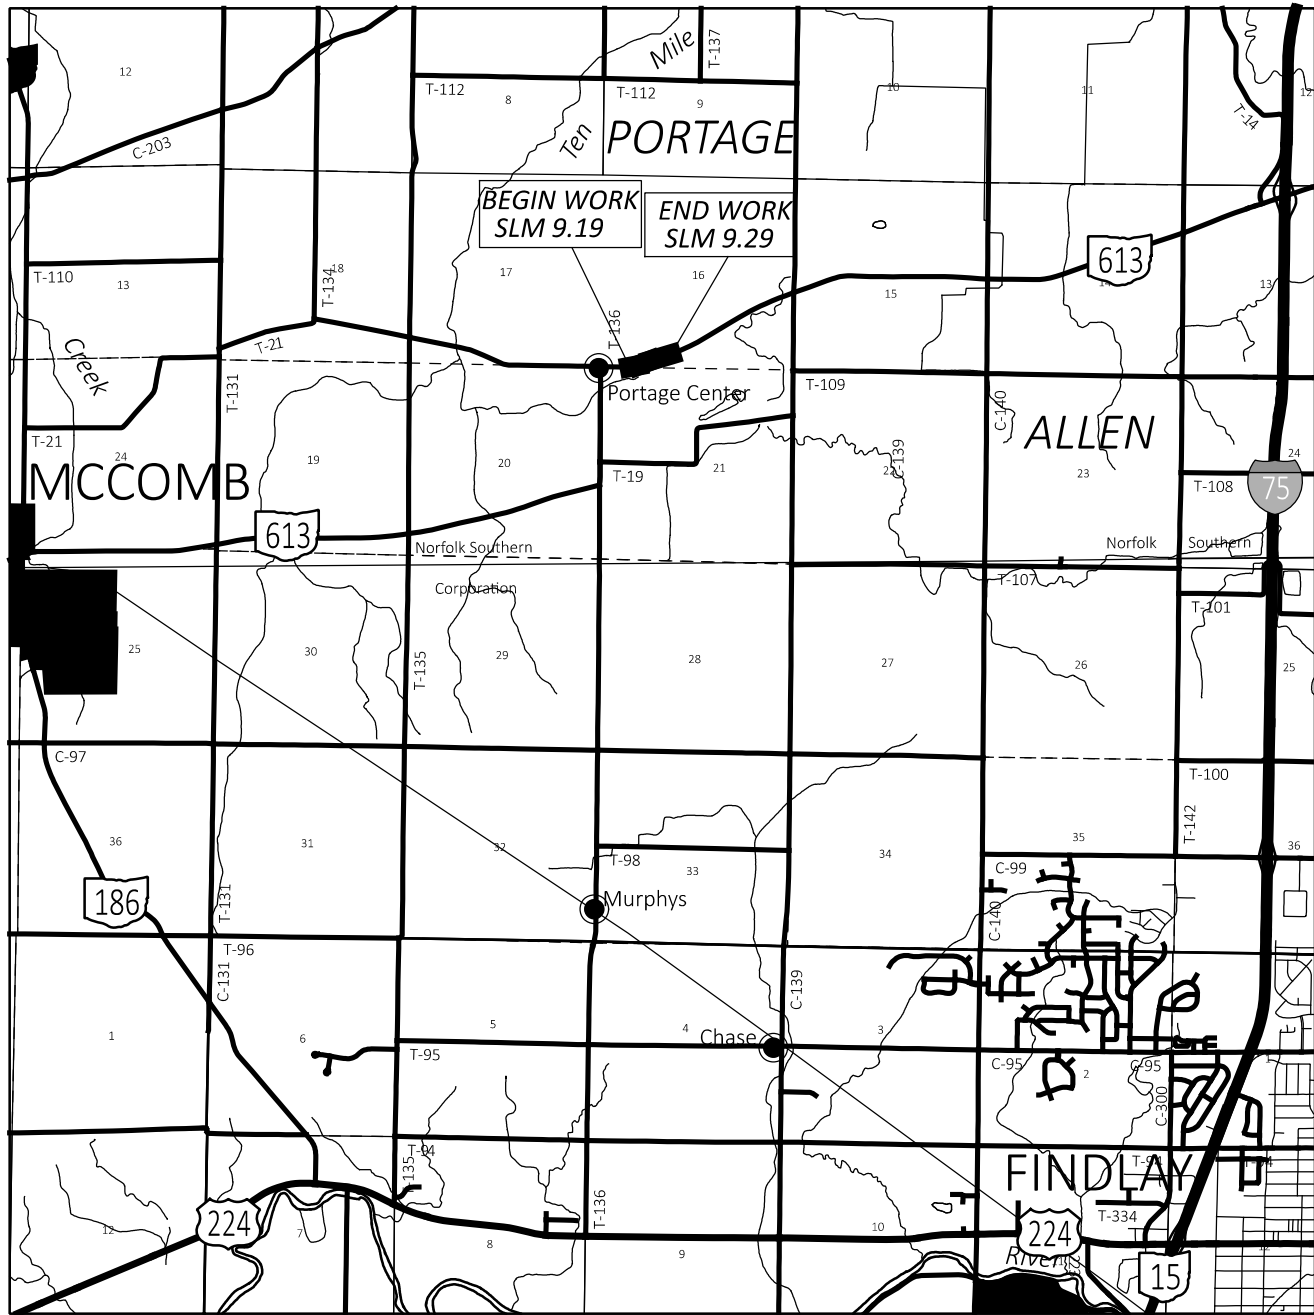

ALL-66-2.38

MODEL: Sheet PAPERSIZE: 34x22 (in.) DATE: 11/7/2025 TIME: 10:42:29 AM PLTDRY: OHDOT_PDF.pltgr USER: Tanner.Hkrott@dot.ohio.gov WORKSPACE: OHDOTCEV02 WORKSET: 107674 PRODUCT: OpenRoadsDesigner 24.00.00.2005
pw:\ohdotd-pw.bentley.com:ohdotd-pw-02\Documents\01 Active Projects\District 01\Allen\107674\400-Engineering\Roadway\Sheets\107674_GG001.dgn

[illegible]

GENERAL SUMMARY

DESIGN AGENCY



DESIGNER

GLI

REVIEWER

MPB 2-13-25

PROJECT ID

107674

SHEET	TOTAL
9	9