



**SIDEWALK DETAIL I**  
 STA. 100+19.97 TO STA. 408+10.19  
 STA. 400+20.07 TO STA. 404+54.27  
 STA. 600+21.25 TO STA. 605+92.09

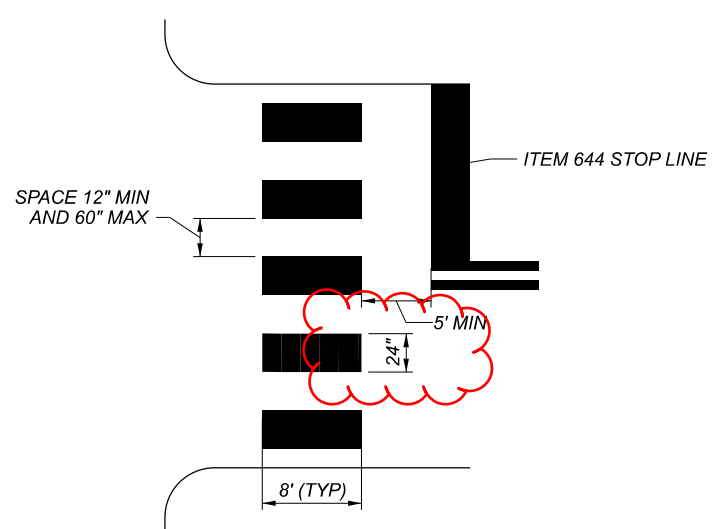


**ITEM 644 - CROSSWALKLINE, AS PER PLAN**

THE CONTRACTOR SHALL INSTALL THE CROSSWALK LINES PER THE DETAIL ABOVE WHERE SHOWN IN PLANS. CROSSWALK MARKINGS TO RUN PARALLEL TO EXISTING PAVEMENT MARKINGS ON ROADWAY EDGE.

- LEGEND**
- 1 ITEM 608 - 4" CONCRETE WALK
  - 2 ITEM 659 - SEEDING AND MULCHING
  - 3 ITEM 253 - PAVEMENT REPAIR
  - 4 ITEM 441 - ASPHALT CONCRETE SURFACE COURSE TYPE 1, (446), PG64-22, 2"
  - 5 ITEM 407 - TACK COAT
  - 6 ITEM 301 - ASPHALT CONCRETE BASE, PG64-22
  - 7 ITEM 608 - 6" CONCRETE WALK
  - 8 ITEM 452 - 8" UNREINFORCED CONCRETE PAVEMENT, TYPE QC1
  - 9 ITEM 304 - AGGREGATE BASE, 8"

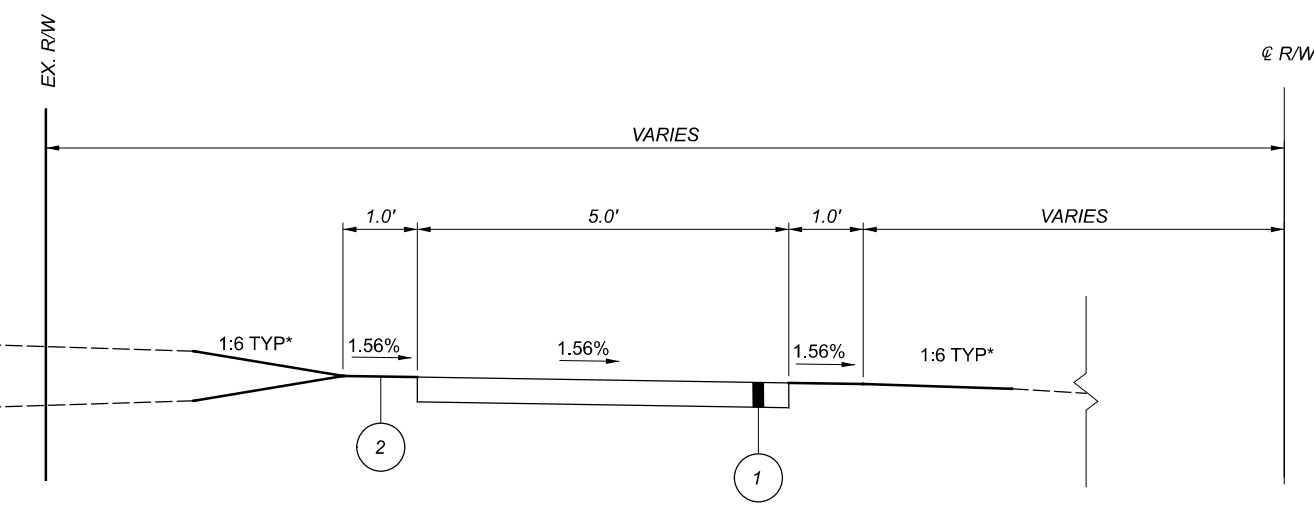


**SIDEWALK DETAIL II**  
 STA. 110+02.24 TO STA. 112+19.52      STA. 201+76.02 TO STA. 203+58.33\*\*  
 STA. 200+12.46 TO STA. 200+99.52\*\*      STA. 600+21.34 TO STA. 601+50.00  
 STA. 201+47.78 TO STA. 201+76.02

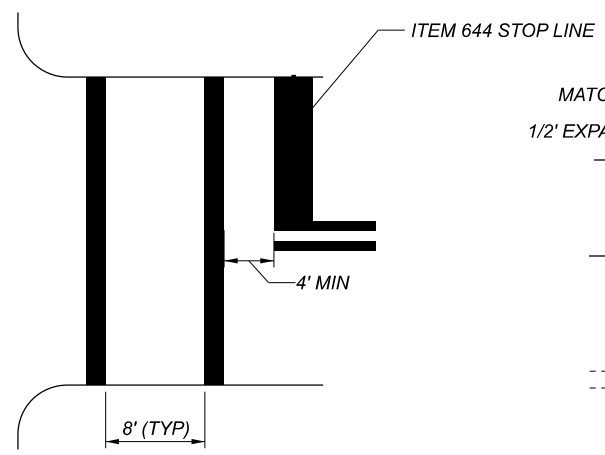


**ITEM 644 - CROSSWALKLINE**

THE CONTRACTOR SHALL INSTALL THE CROSSWALK LINES PER THE DETAIL ABOVE WHERE SHOWN IN PLANS. EXISTING OR PROPOSED CURB RAMPS MUST BE WITHIN CROSSWALK MARKINGS.

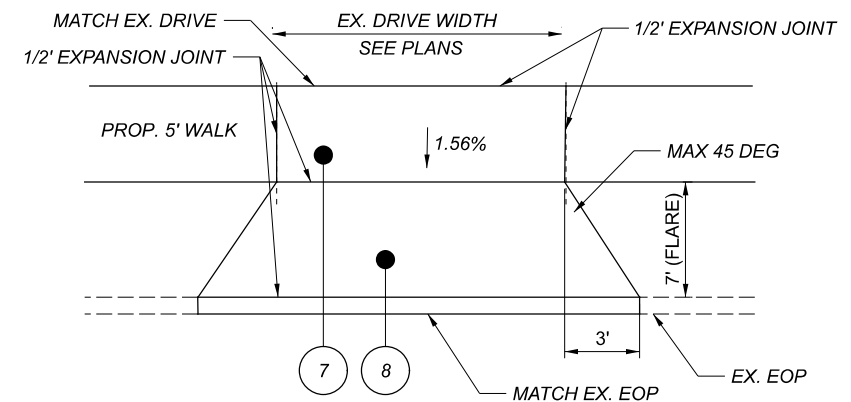


**CONCRETE RESIDENTIAL DRIVEWAY DETAIL**

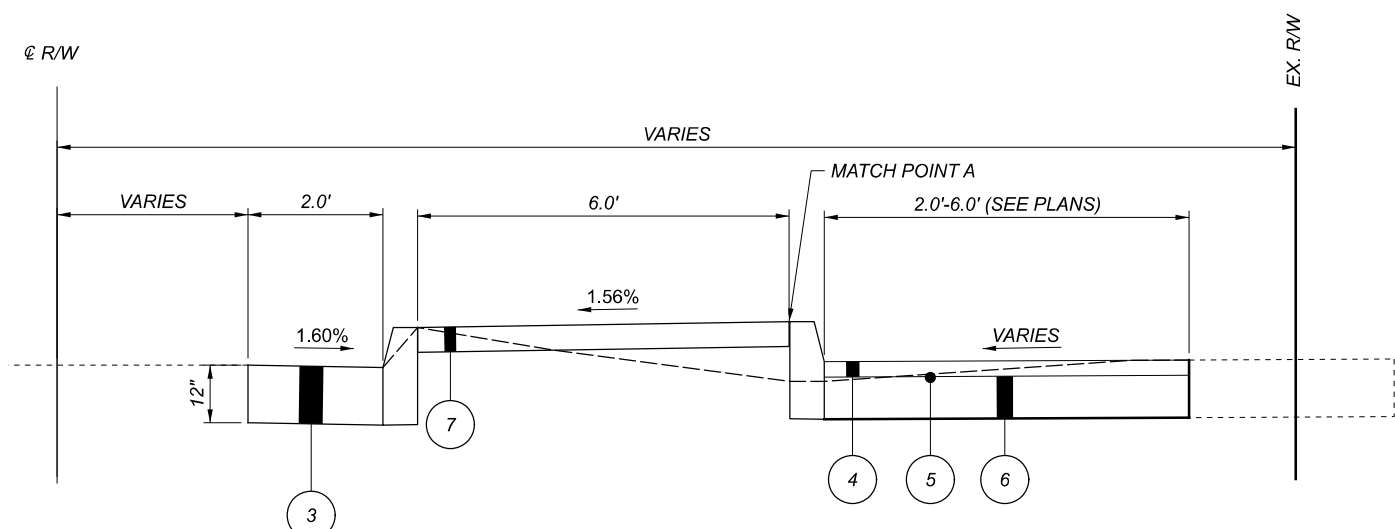

**SIDEWALK DETAIL III**  
 STA. 605+92.09 TO STA. 606+27.08\*\*\*  
 STA. 606+27.08 TO STA. 606+92.75

**SIDEWALK DETAIL NOTES:**  
 \* SEE CROSS SECTIONS, CONTRACTOR SHALL GRADE TO DRAIN (1:3 MAX, 1:64 MIN)  
 \*\* REVERSE WALK SLOPE TO MATCH EXISTING DRAINAGE PATTERNS  
 \*\*\* FOLLOW SIDEWALK DETAIL I AT MATCH POINT A INSTEAD

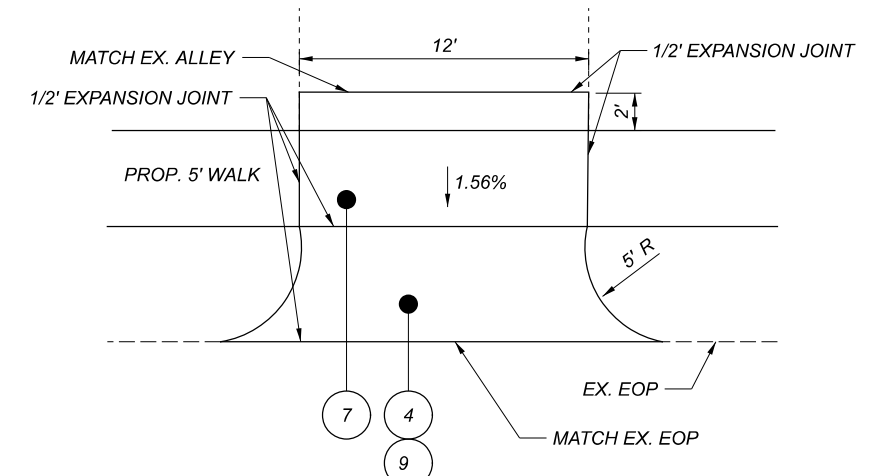

**ALLEY DETAIL**

**DRIVEWAY AND ALLEY DETAIL NOTES:**  
 1. SIDEWALK PROFILE SHALL BE MAINTAINED THROUGH DRIVEWAYS AND ALLEYS.  
 2. DRIVEWAY AND ALLEY APRON GRADES SHALL BE ADJUSTED TO MEET SIDEWALK PROFILE.