




- 12" EXCAVATE & REPLACE WITH GRANULAR MATERIAL, TYPE B, WITH GEOGRID
- 15" EXCAVATE & REPLACE WITH GRANULAR MATERIAL, TYPE B, WITH GEOGRID
- 12" EXCAVATE & REPLACE WITH GRANULAR MATERIAL, TYPE B, WITH GEOTEXTILE FABRIC
- * - MEASURED IN CADD

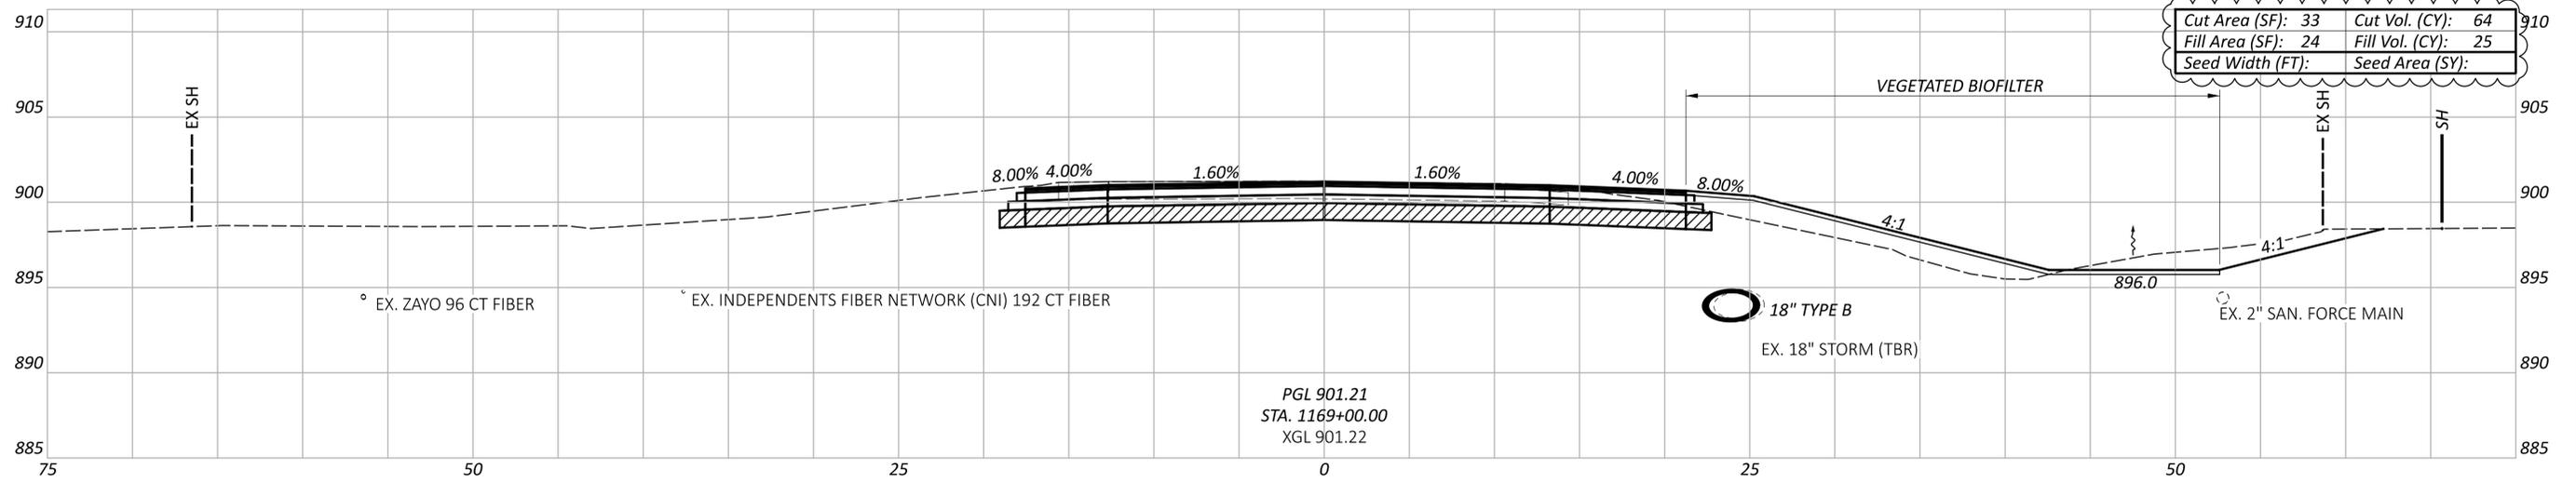

Cut Area (SF): 33	Cut Vol. (CY): 64
Fill Area (SF): 24	Fill Vol. (CY): 25
Seed Width (FT):	Seed Area (SY):

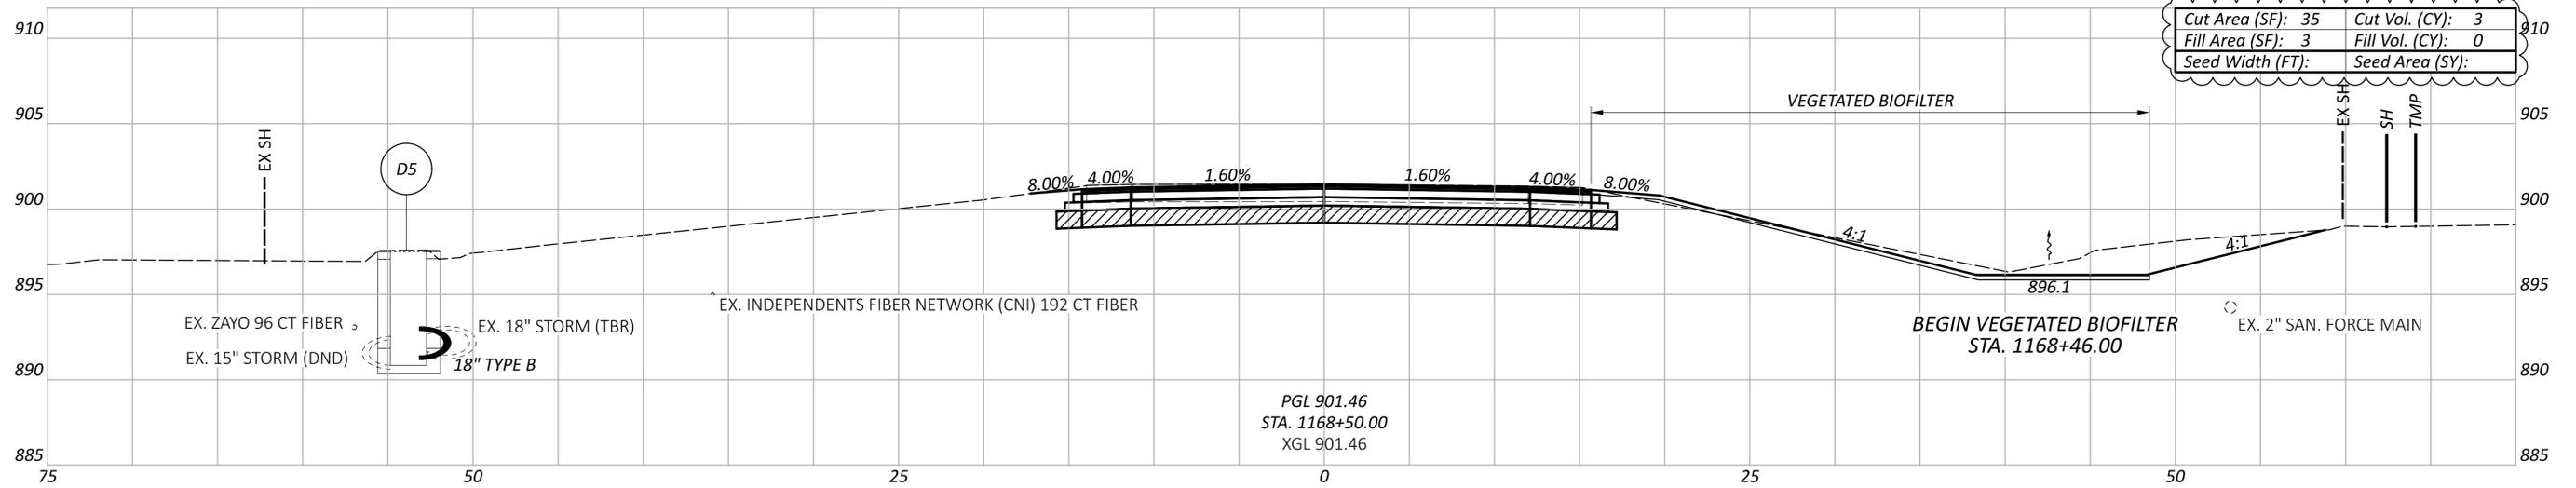

Cut Area (SF): 35	Cut Vol. (CY): 3
Fill Area (SF): 3	Fill Vol. (CY): 0
Seed Width (FT):	Seed Area (SY):

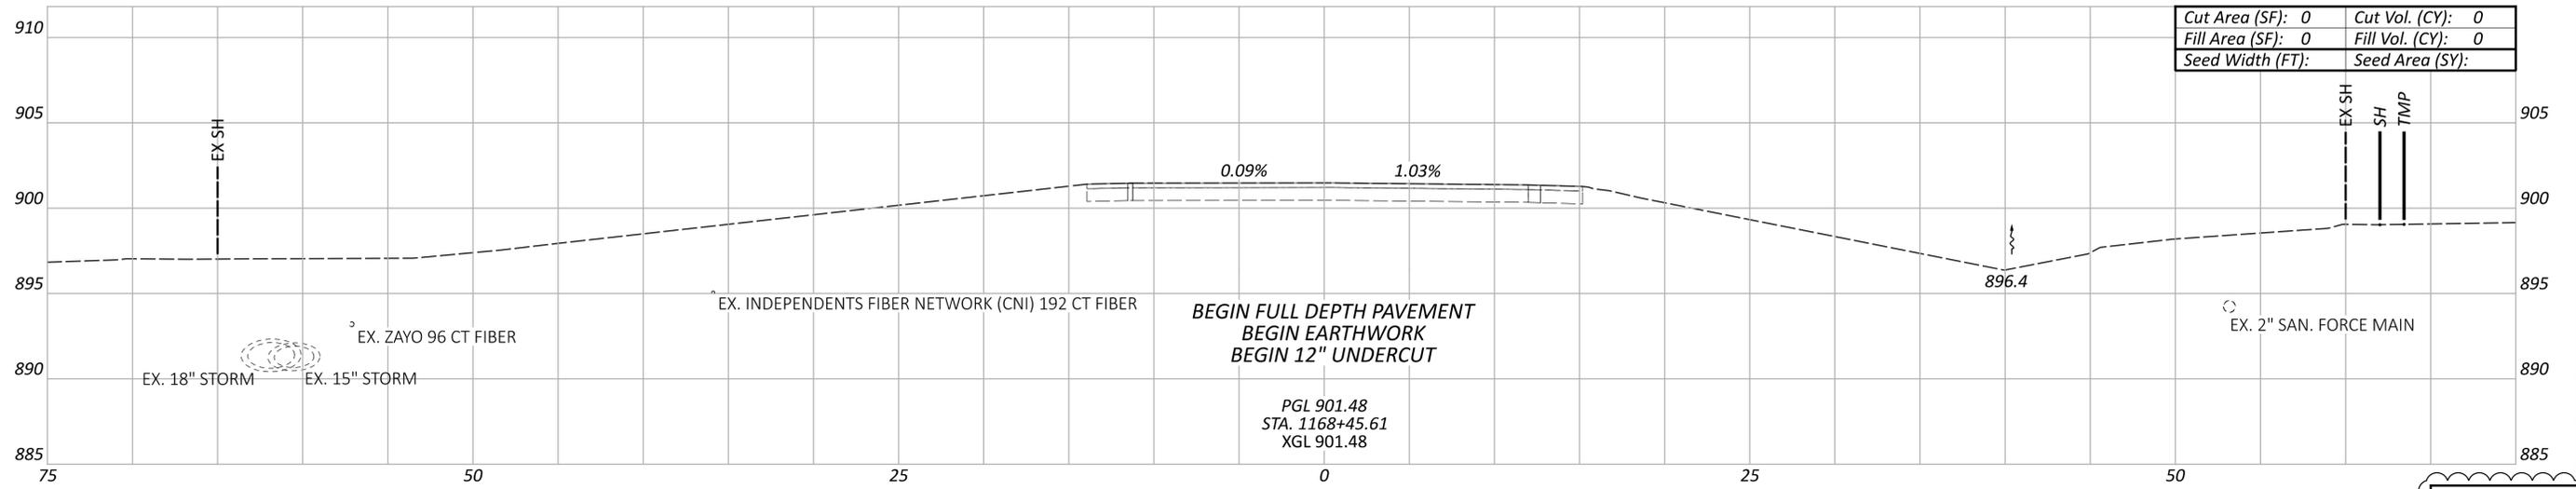

Cut Area (SF): 0	Cut Vol. (CY): 0
Fill Area (SF): 0	Fill Vol. (CY): 0
Seed Width (FT):	Seed Area (SY):

CROSS SECTIONS - S.R. 81 (WEST LEG)
STA. 1168+45.61 TO STA. 1169+00.00

ALL-81-22.23

MODEL: CLP_5081W - 1168+45.61 [Sheet] PAPER SIZE: 34x22 (in.) DATE: 5/21/2025 TIME: 5:17:07 PM USER: Coffield
 pw:\ohiodoc-pw-bentley.com\ohiodoc-pw-02\Documents\01 Active Projects\District 01\Allen\117742\401-Engineering_WSP\Roadway\Sheets\117742_X5001.dgn

DESIGN AGENCY

WSP USA, Inc.
2 Miranova Pl,
Suite 450
Columbus, OH 43215

DESIGNER
KAB

REVIEWER
ABS 07/30/24

PROJECT ID
117742

Sheet Totals	
Seeding	Cut Fill
*	67 25




SHEET TOTAL
P.51 | 107

ALL-81-22.23

MODEL: CLP_5081W - 1169+50.00 [Sheet] PAPER SIZE: 34x22 (in.) DATE: 5/21/2025 TIME: 5:17:25 PM USER: Coffield
 pw:\ohiodoc-pw.bentley.com\ohiodoc-pw-02\Documents\01.Active Projects\District 01\Allen\117742\401-Engineering_WSP\Roadway\Sheets\117742_X5001.dgn

-  12" EXCAVATE & REPLACE WITH GRANULAR MATERIAL, TYPE B, WITH GEOGRID
-  15" EXCAVATE & REPLACE WITH GRANULAR MATERIAL, TYPE B, WITH GEOGRID
-  12" EXCAVATE & REPLACE WITH GRANULAR MATERIAL, TYPE B, WITH GEOTEXTILE FABRIC

* - MEASURED IN CADD

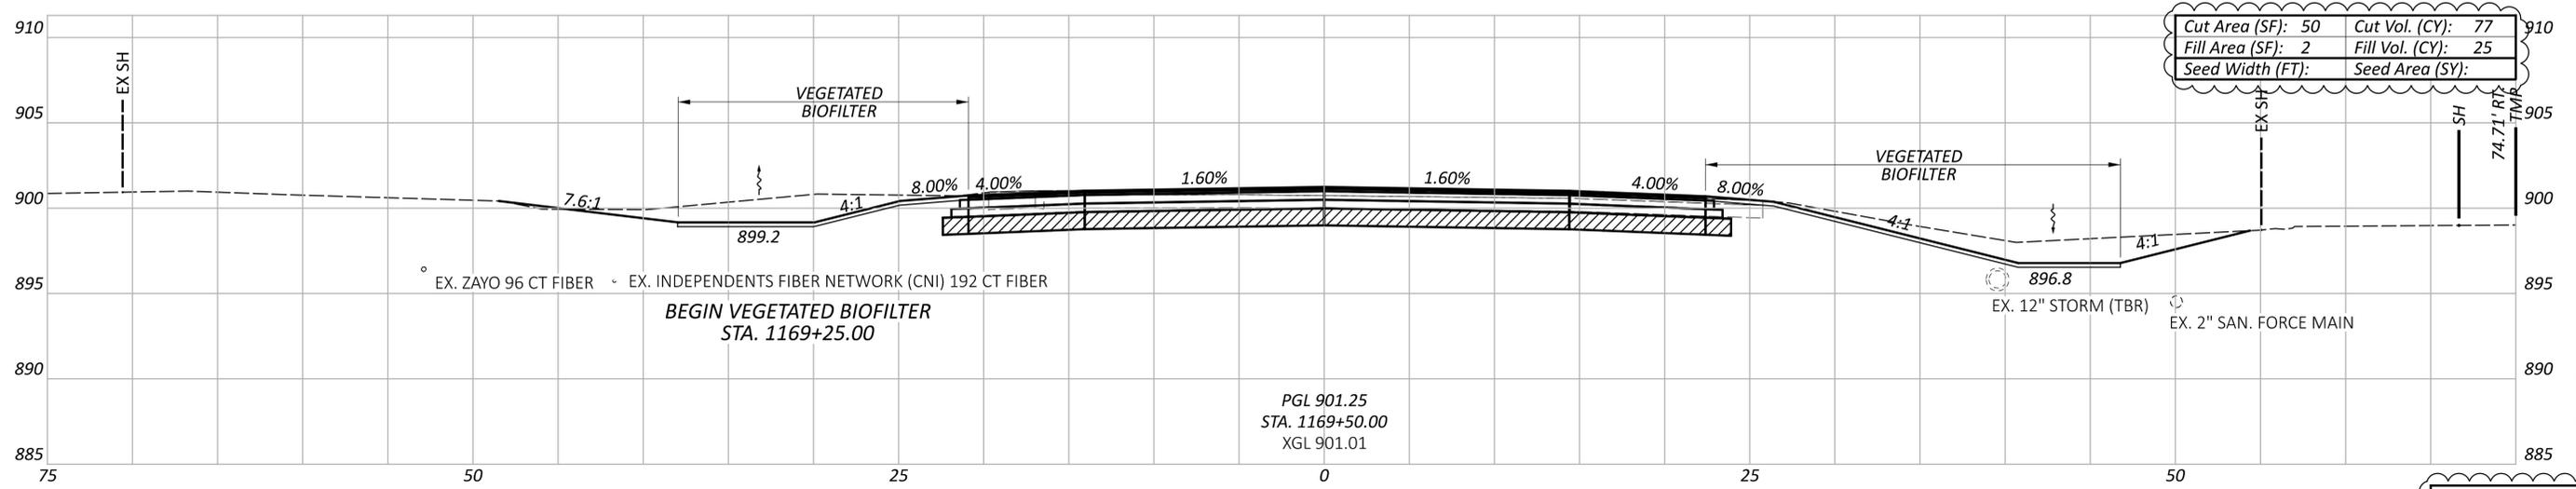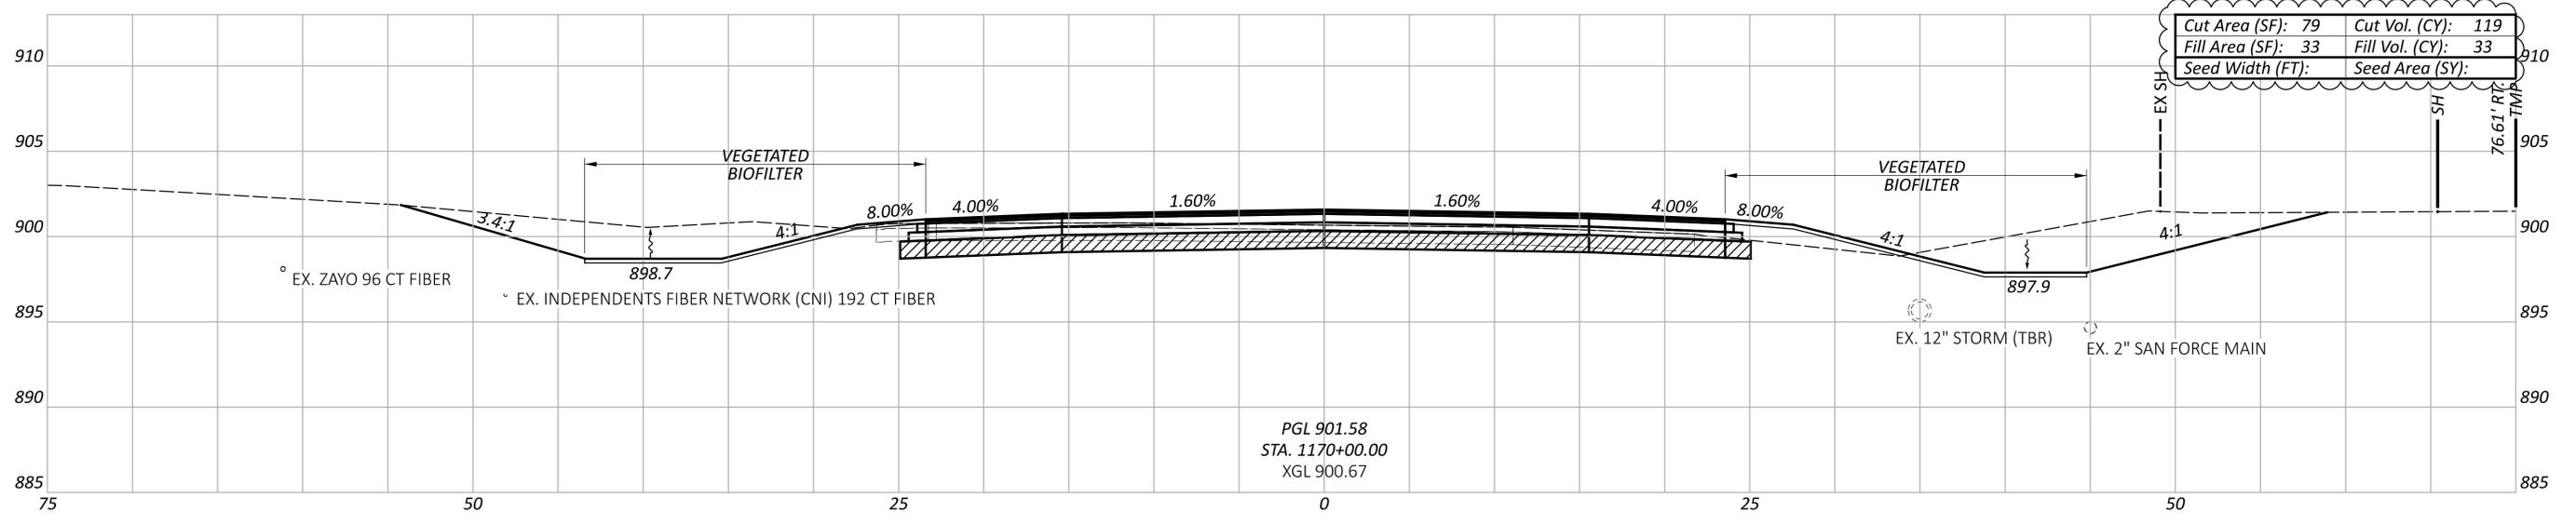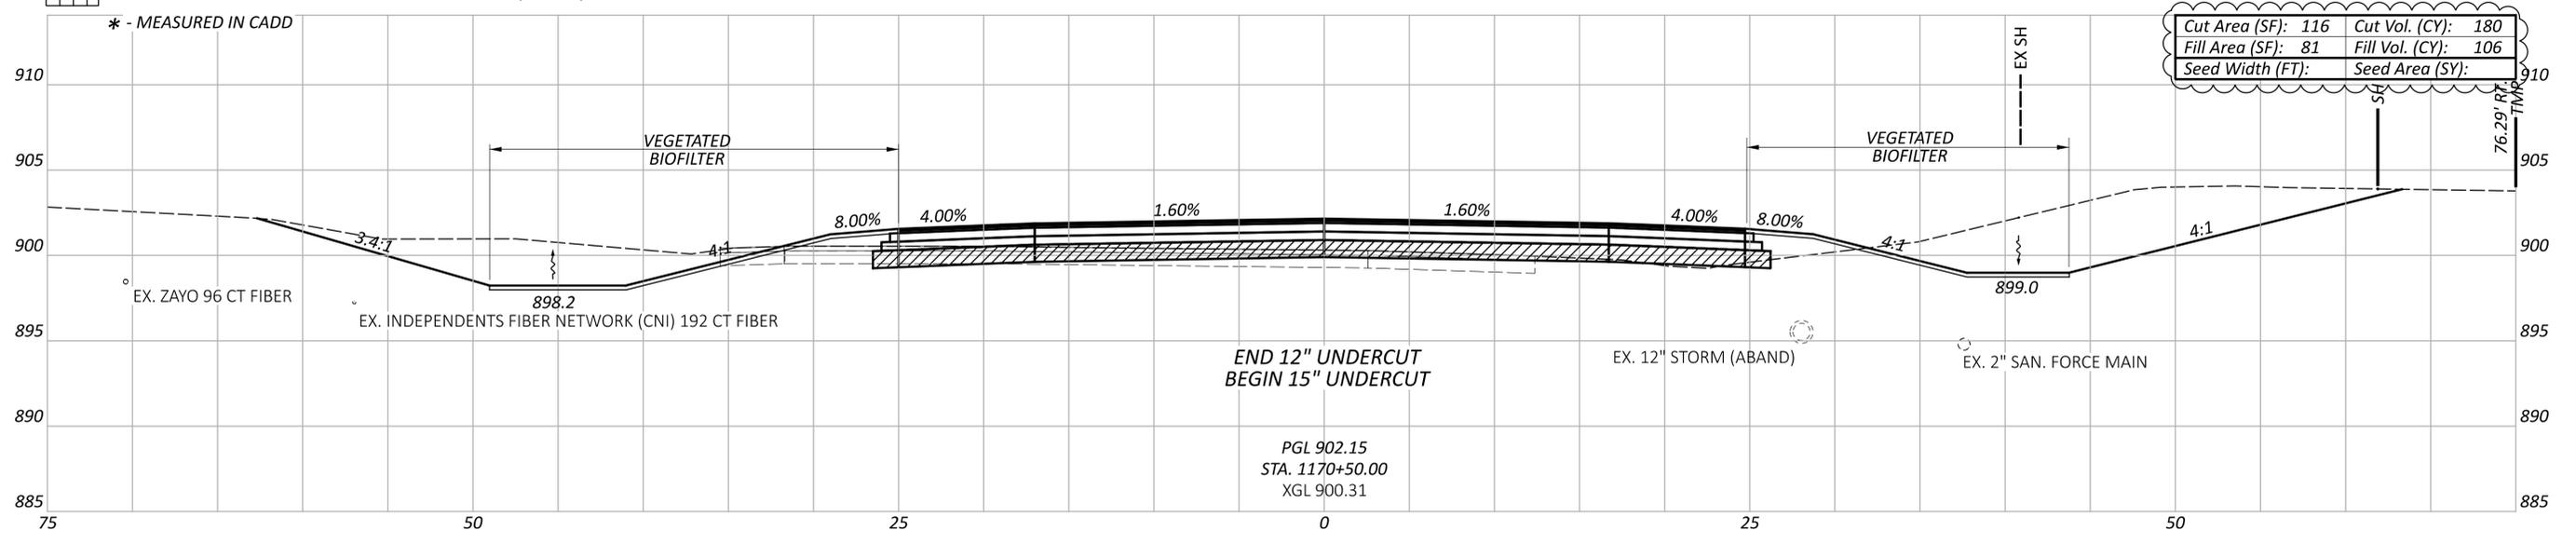

CROSS SECTIONS - S.R. 81 (WEST LEG)
 STA. 1169+50.00 TO STA. 1170+50.00

DESIGN AGENCY

 WSP USA, Inc.
 2 Miranova Pl,
 Suite 450
 Columbus, OH 43215

DESIGNER
 KAB
 REVIEWER
 ABS 07/30/24

PROJECT ID
 117742


Sheet Totals		
Seeding	Cut	Fill
*	376	164

SHEET TOTAL
 P.52 | 107


ALL-81-22.23

MODEL: CLP_5081W - 1171+00.00 [Sheet] PAPER SIZE: 34x22 (in.) DATE: 5/21/2025 TIME: 5:17:32 PM USER: Coffield
 pw:\ohiodot-pw-bentley.com\ohiodot-pw-02\Documents\01.Active Projects\District 01\Allen\117742\401-Engineering_WSP\Roadway\Sheets\117742_X5001.dgn

-  12" EXCAVATE & REPLACE WITH GRANULAR MATERIAL, TYPE B, WITH GEOGRID
 -  15" EXCAVATE & REPLACE WITH GRANULAR MATERIAL, TYPE B, WITH GEOGRID
 -  12" EXCAVATE & REPLACE WITH GRANULAR MATERIAL, TYPE B, WITH GEOTEXTILE FABRIC
- * - MEASURED IN CADD

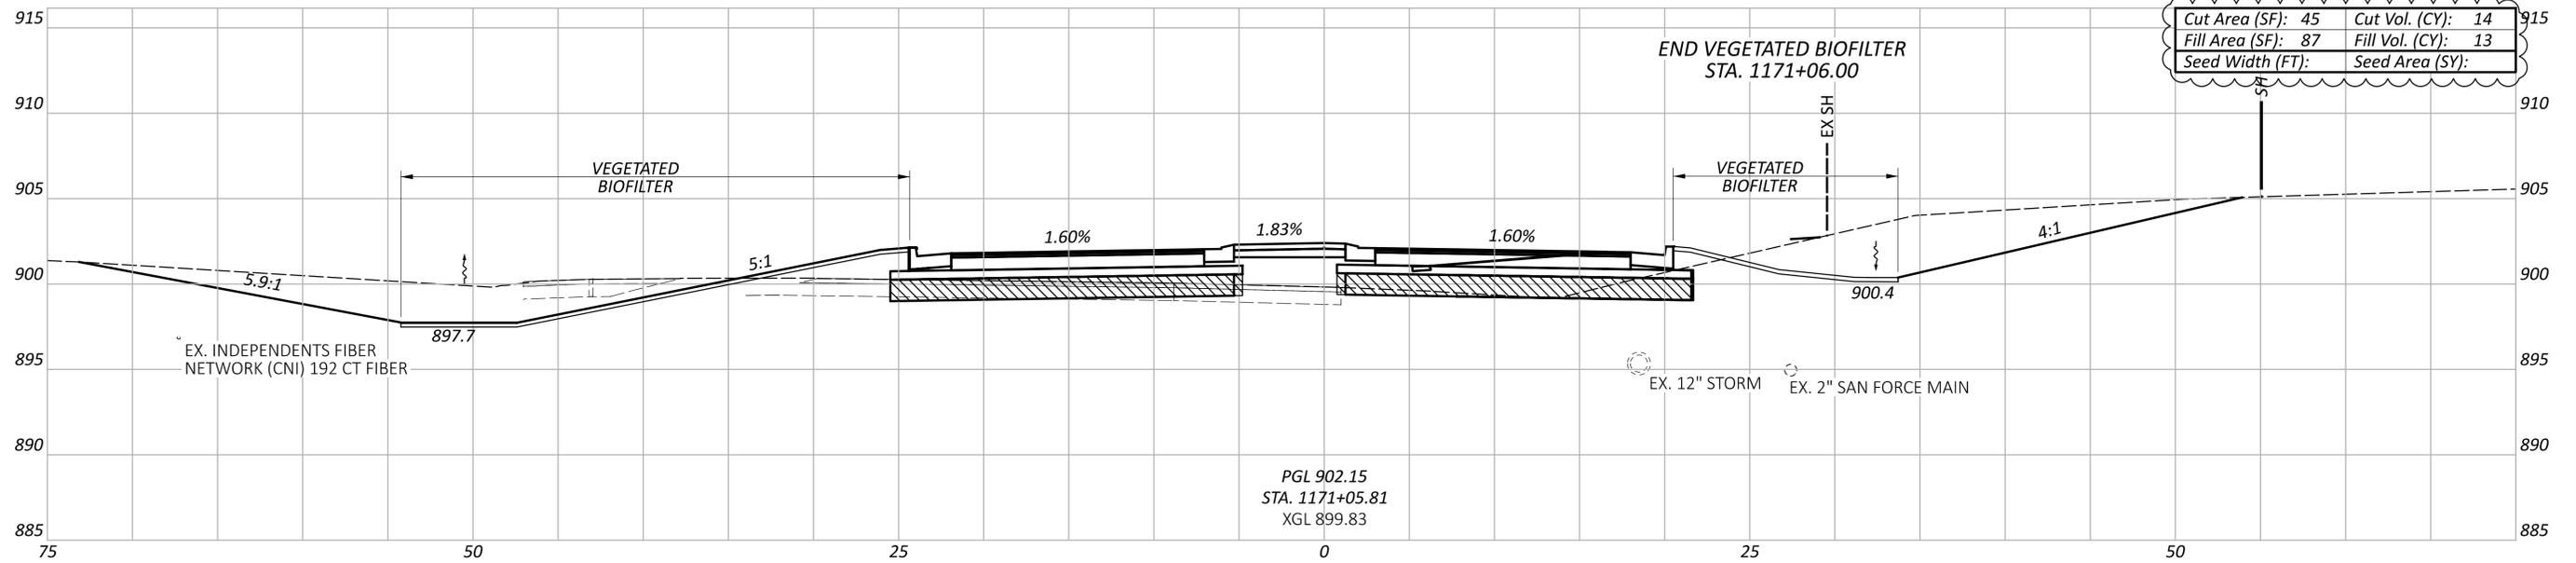

PGL 902.15
 STA. 1171+05.81
 XGL 899.83

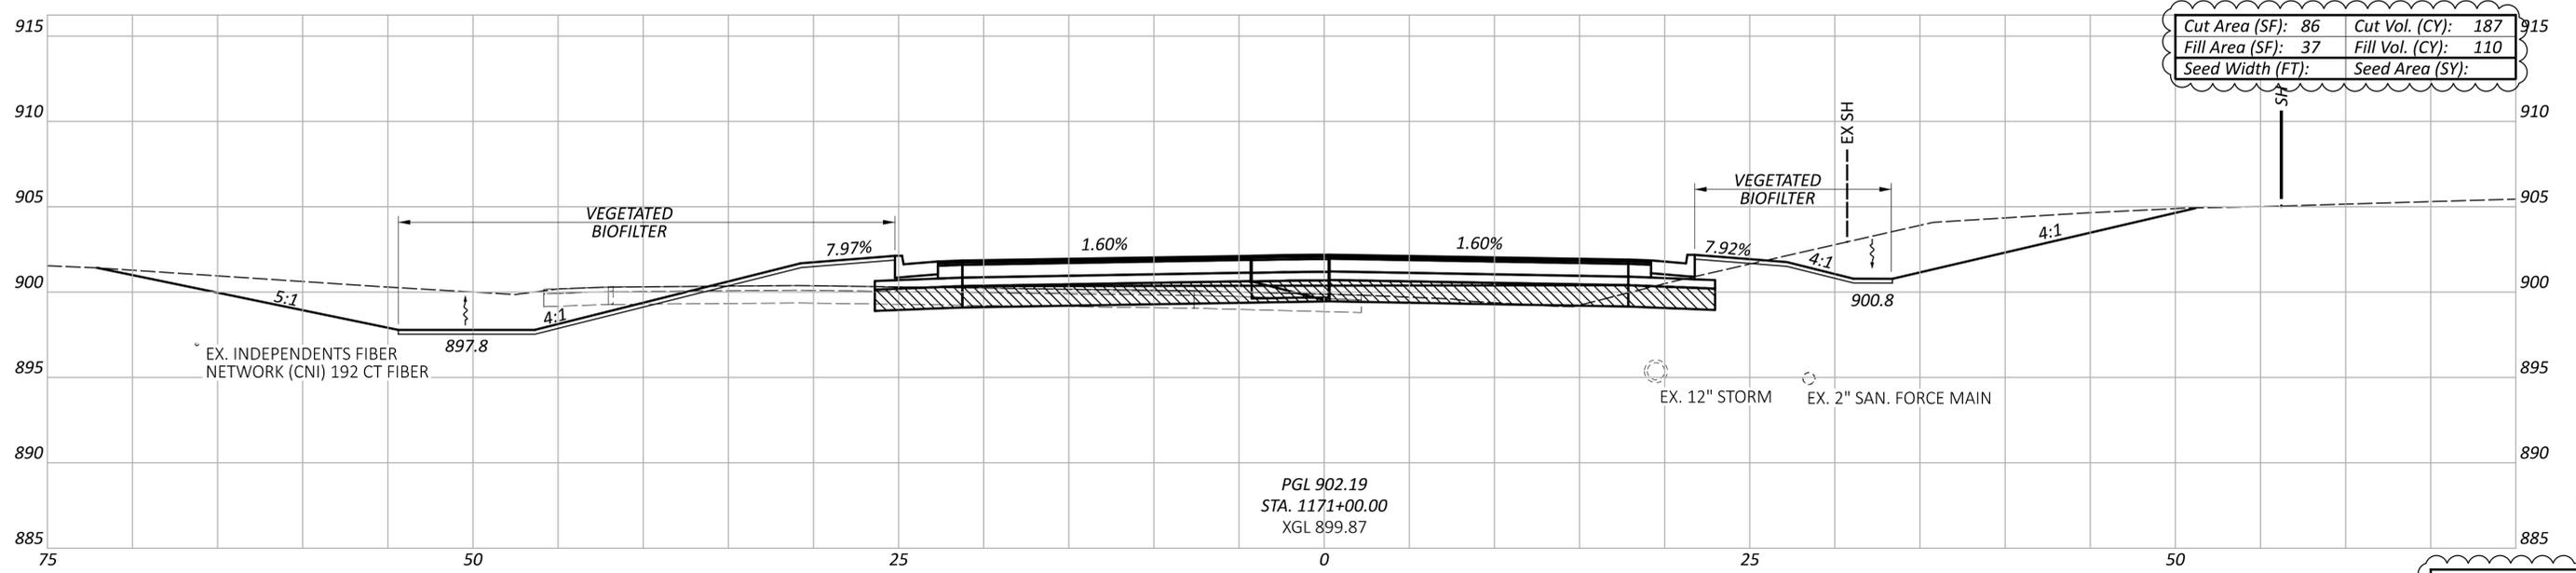

PGL 902.19
 STA. 1171+00.00
 XGL 899.87

CROSS SECTIONS - S.R. 81 (WEST LEG)
 STA. 1171+00.00 TO STA. 1171+05.81

DESIGN AGENCY

 WSP USA, Inc.
 2 Miranova Pl,
 Suite 450
 Columbus, OH 43215

DESIGNER
 KAB
 REVIEWER
 ABS 07/30/24


PROJECT ID
 117742

Sheet Totals			
SEEDING	CUT	FILL	TOTAL
*	201	123	P.53 107


ALL-81-22.23

MODEL: CLP_5081W - 1171+50.00 [Sheet] PAPER SIZE: 34x22 (in.) DATE: 5/21/2025 TIME: 5:17:37 PM USER: Coffield
 pw:\ohiodot-pw-bentley.com\ohiodot-pw-02\Documents\01.Active Projects\District 01\Allen\117742\401-Engineering_WSP\Roadway\Sheets\117742_X5001.dgn

-  12" EXCAVATE & REPLACE WITH GRANULAR MATERIAL, TYPE B, WITH GEOGRID
 -  15" EXCAVATE & REPLACE WITH GRANULAR MATERIAL, TYPE B, WITH GEOGRID
 -  12" EXCAVATE & REPLACE WITH GRANULAR MATERIAL, TYPE B, WITH GEOTEXTILE FABRIC
- * - MEASURED IN CADD

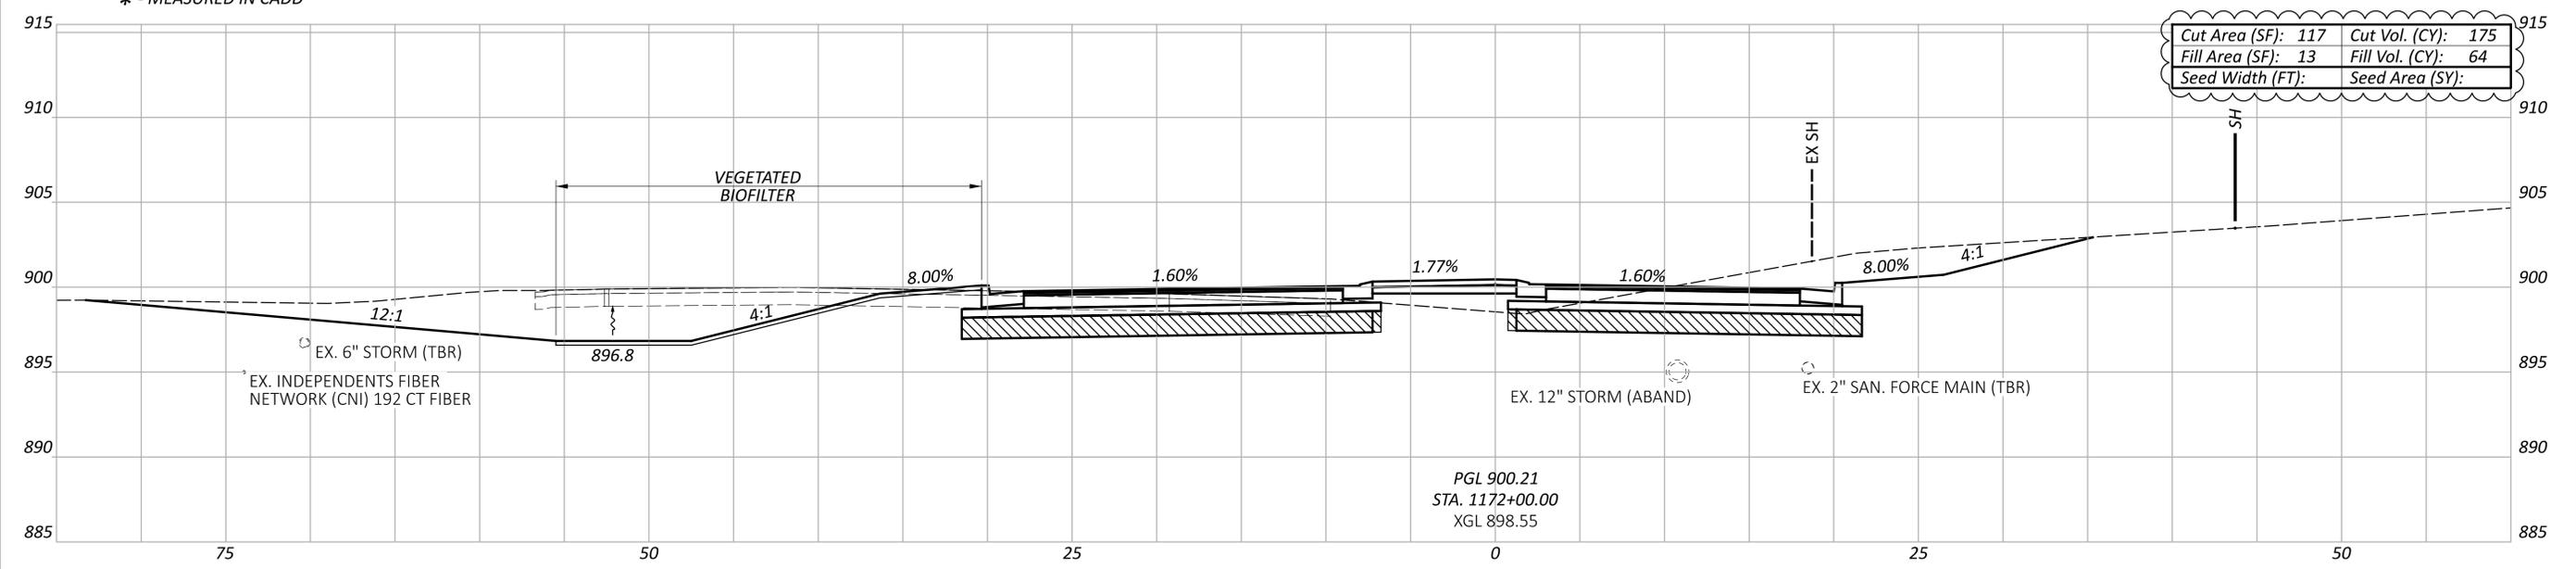

Cut Area (SF):	117	Cut Vol. (CY):	175
Fill Area (SF):	13	Fill Vol. (CY):	64
Seed Width (FT):		Seed Area (SY):	

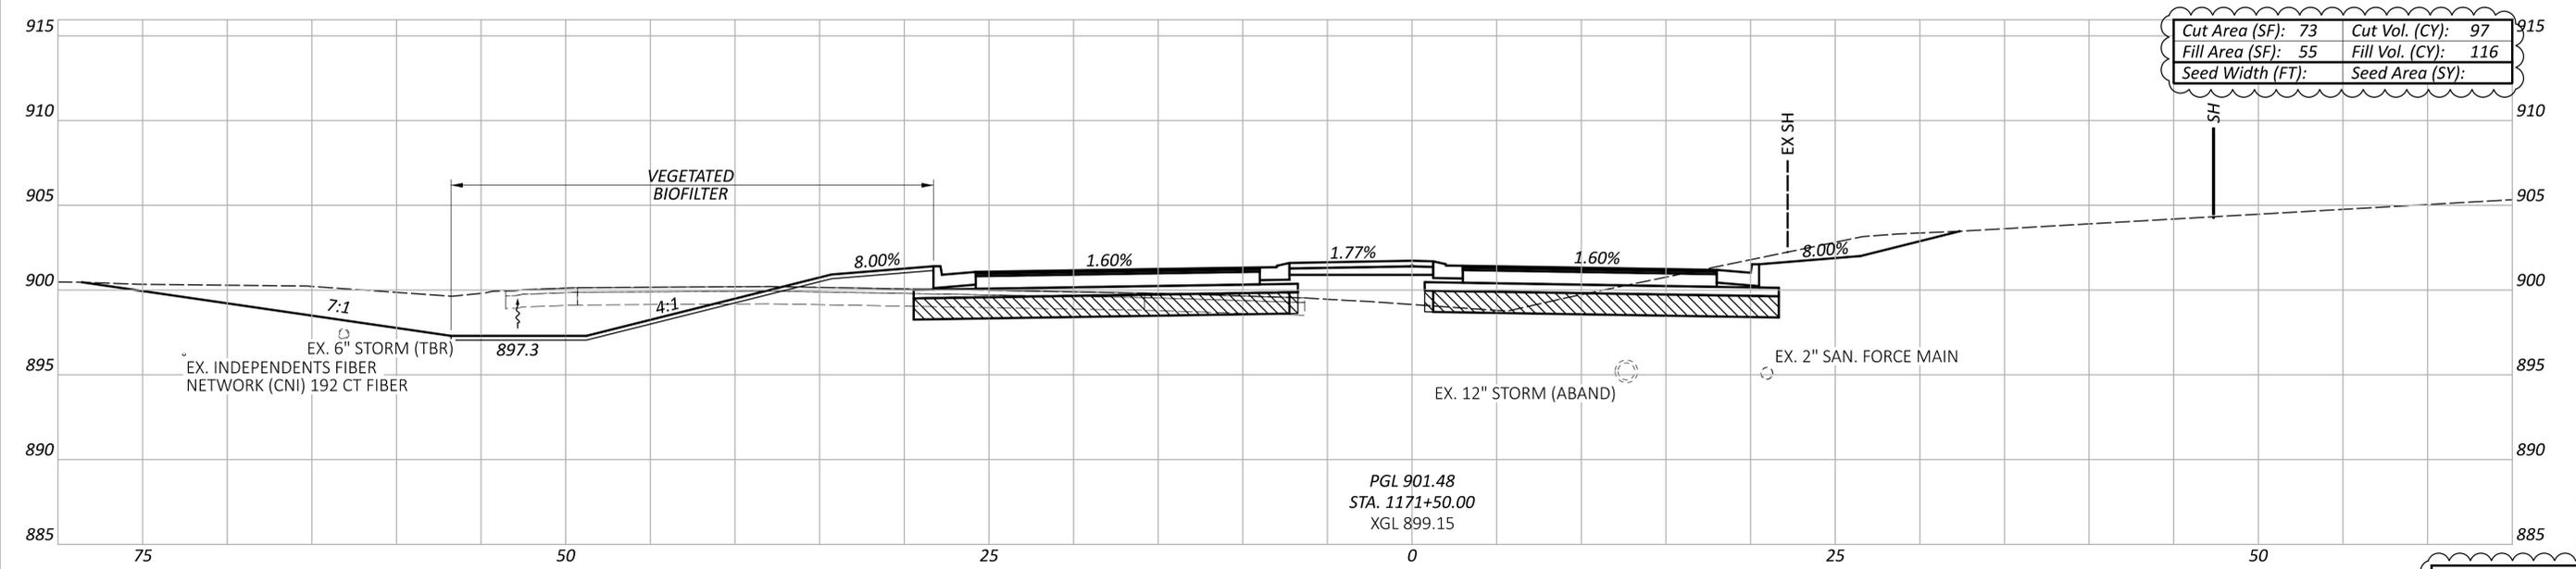

Cut Area (SF):	73	Cut Vol. (CY):	97
Fill Area (SF):	55	Fill Vol. (CY):	116
Seed Width (FT):		Seed Area (SY):	

CROSS SECTIONS - S.R. 81 (WEST LEG)
 STA. 1171+50.00 TO STA. 1172+00.00

DESIGN AGENCY

 WSP USA, Inc.
 2 Miranova Pl,
 Suite 450
 Columbus, OH 43215

DESIGNER
 KAB
 REVIEWER
 ABS 07/30/24

PROJECT ID
 117742



Sheet Totals		
Seeding	Cut	Fill
*	272	180

SHEET	TOTAL
P.54	107

ALL-81-22.23

MODEL: CLP_5081W - 1172+50.00 [Sheet] PAPER SIZE: 34x22 (in.) DATE: 5/21/2025 TIME: 5:17:43 PM USER: Coffield
 pw:\ohiodot-pw.bentley.com\ohiodot-pw-02\Documents\01.Active Projects\District 01\Allen\117742\401-Engineering_WSP\Roadway\Sheets\117742_X5001.dgn

-  12" EXCAVATE & REPLACE WITH GRANULAR MATERIAL, TYPE B, WITH GEOGRID
 -  15" EXCAVATE & REPLACE WITH GRANULAR MATERIAL, TYPE B, WITH GEOGRID
 -  12" EXCAVATE & REPLACE WITH GRANULAR MATERIAL, TYPE B, WITH GEOTEXTILE FABRIC
- * - MEASURED IN CADD

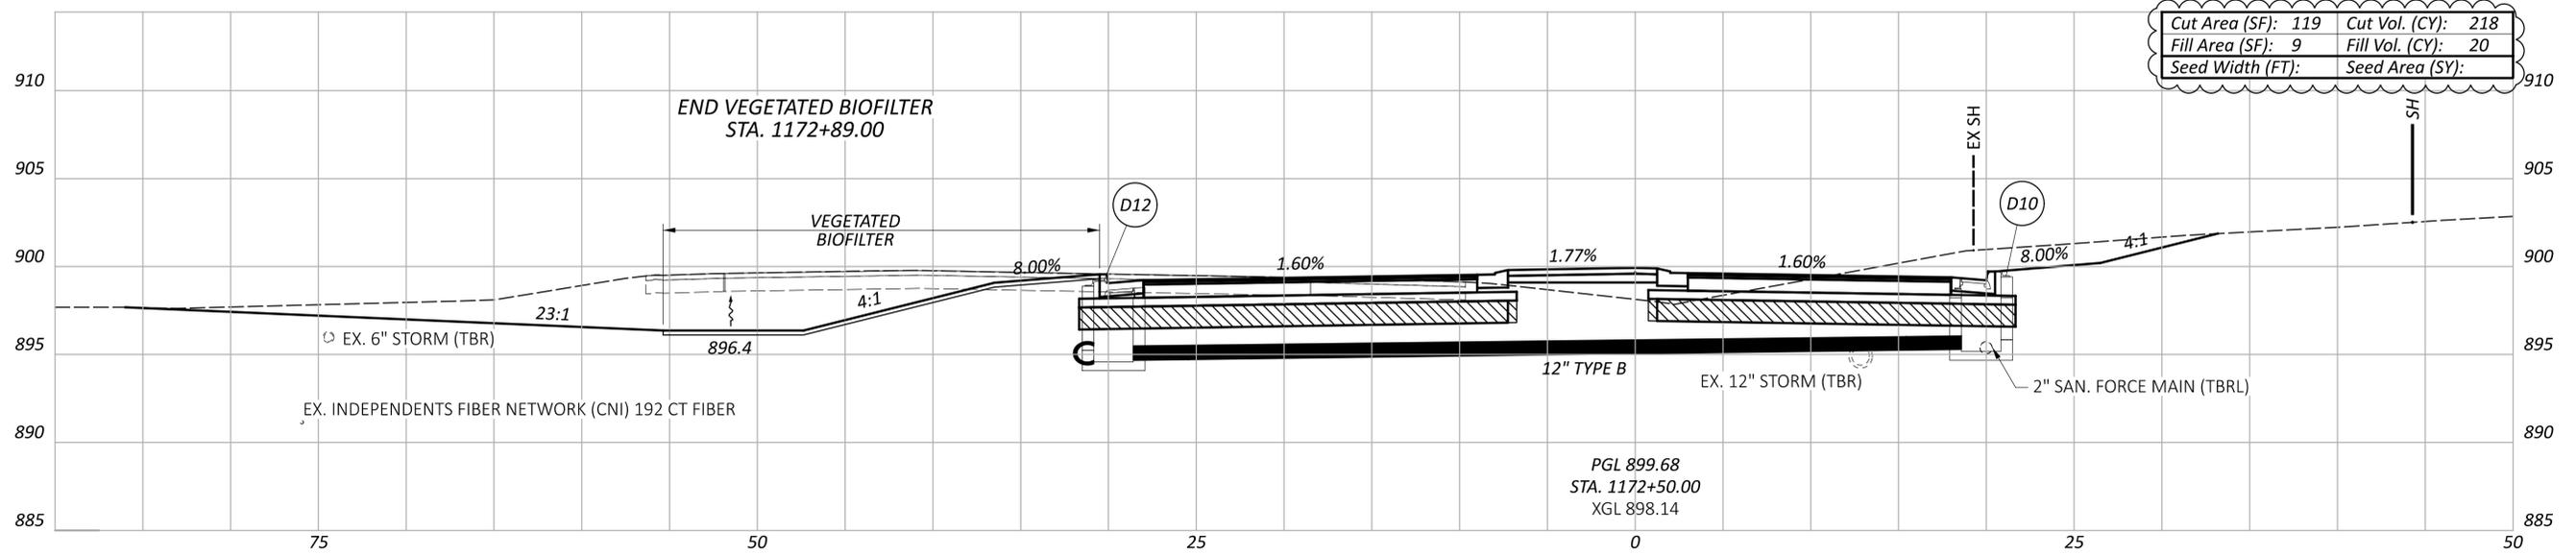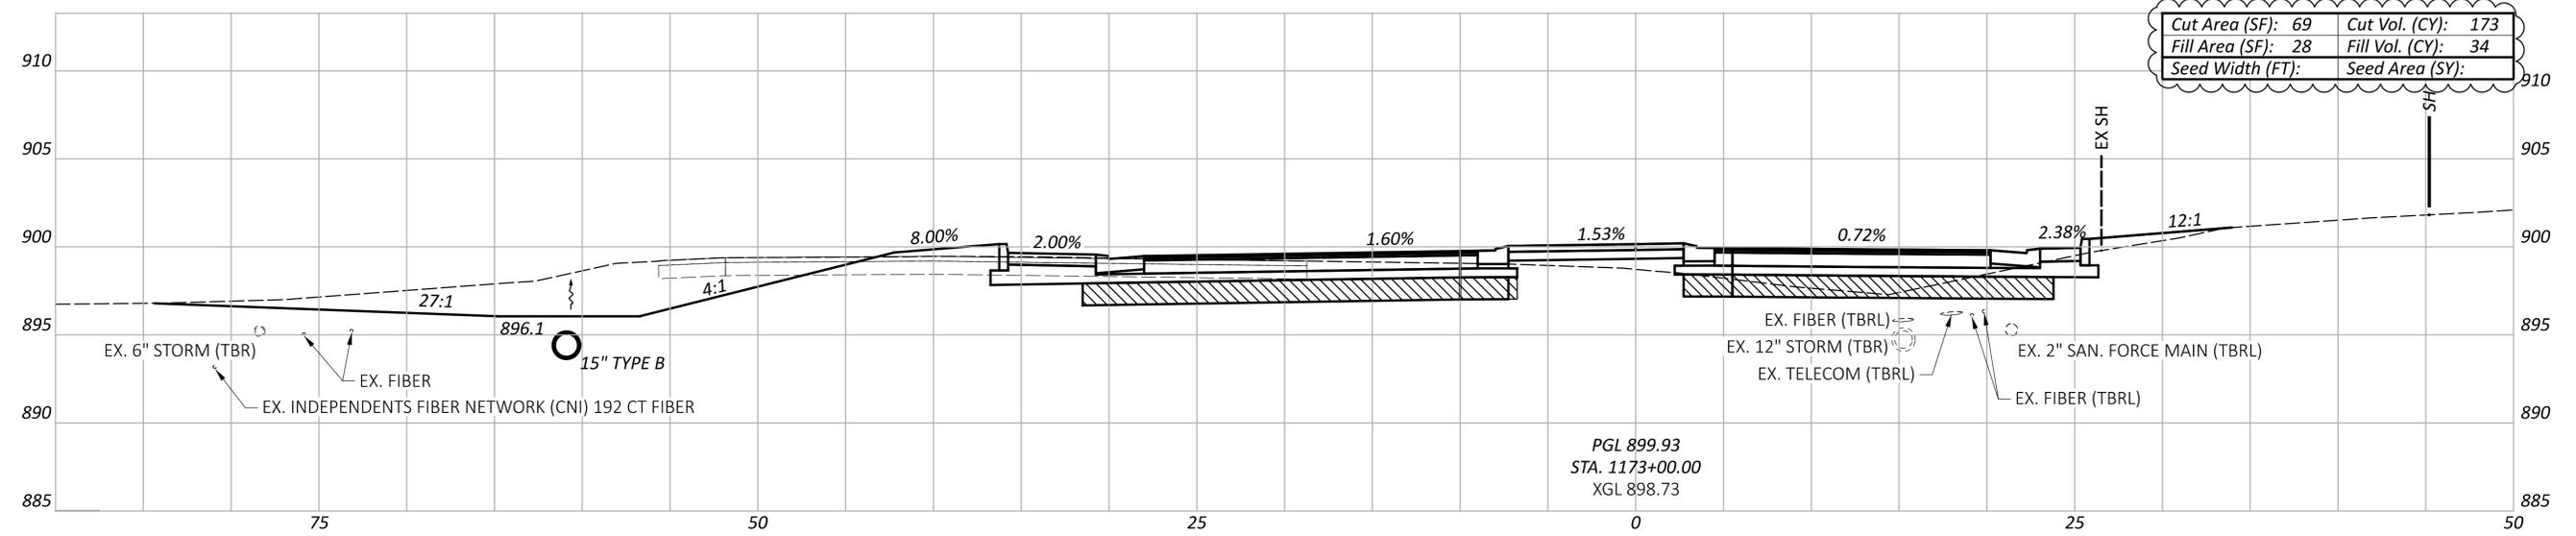

CROSS SECTIONS - S.R. 81 (WEST LEG)
 STA. 1172+50.00 TO STA. 1173+00.00

DESIGN AGENCY



DESIGNER
 KAB

REVIEWER
 ABS 07/30/24


PROJECT ID
 117742

Sheet Totals			SHEET TOTAL	
Seeding	Cut	Fill	P.55	107
*	391	54		

ALL-81-22.23

MODEL: CLP_S081W - 1173+50.00 [Sheet] PAPER SIZE: 34x22 (in.) DATE: 5/21/2025 TIME: 5:17:49 PM USER: Coffield
 pw:\ohiodot-pw-bentley.com\ohiodot-pw-02\Documents\01\Active Projects\District 01\Allen\117742\401-Engineering_WSP\Roadway\Sheets\117742_XS001.dgn

-  12" EXCAVATE & REPLACE WITH GRANULAR MATERIAL, TYPE B, WITH GEOGRID
 -  15" EXCAVATE & REPLACE WITH GRANULAR MATERIAL, TYPE B, WITH GEOGRID
 -  12" EXCAVATE & REPLACE WITH GRANULAR MATERIAL, TYPE B, WITH GEOTEXTILE FABRIC
- * - MEASURED IN CADD

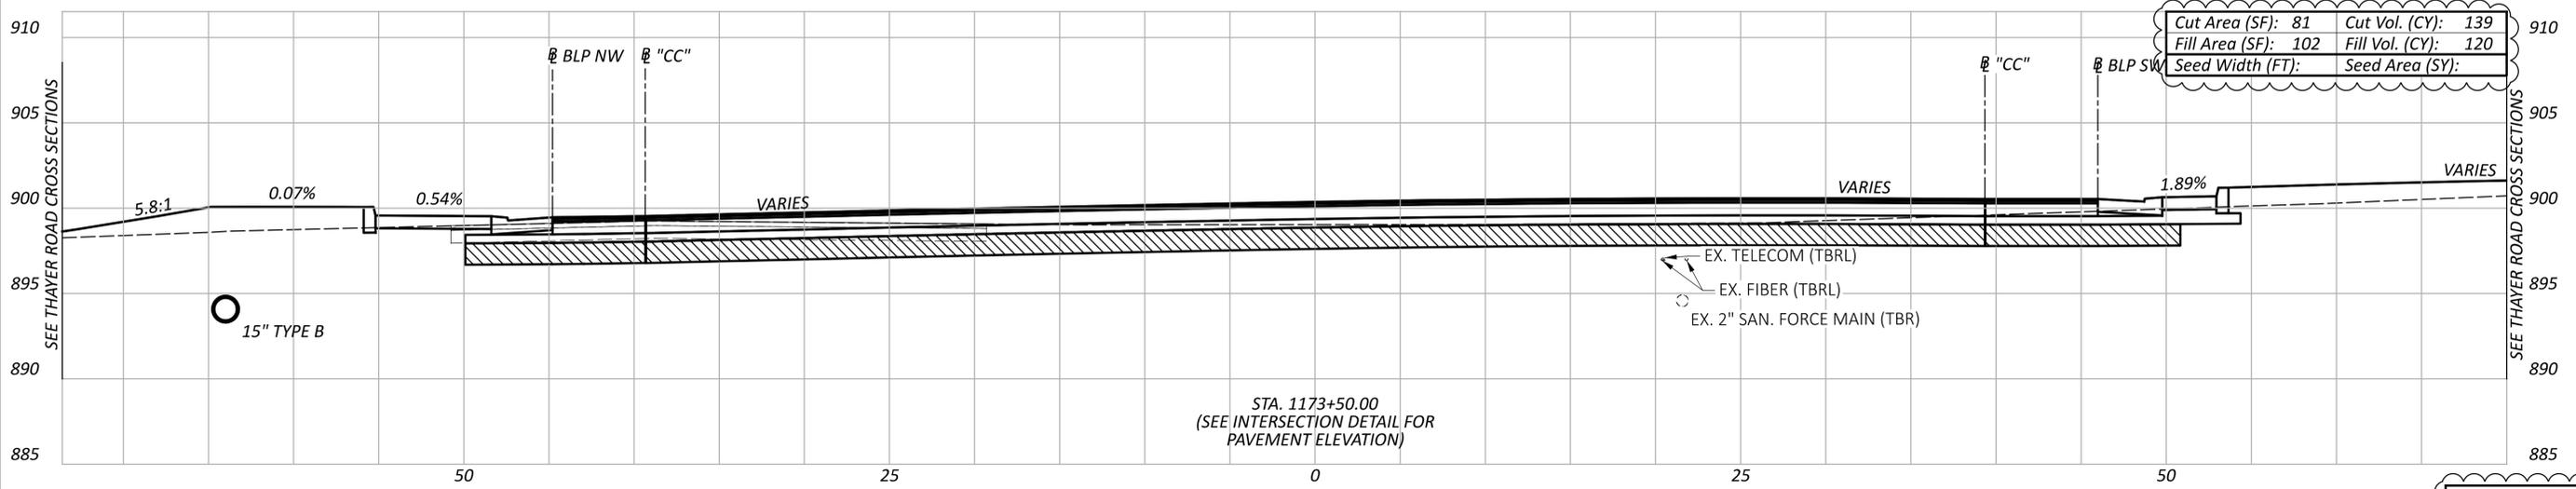

STA. 1173+50.00
 (SEE INTERSECTION DETAIL FOR PAVEMENT ELEVATION)

CROSS SECTIONS - S.R. 81 (WEST LEG)
 STA. 1173+00.00

DESIGN AGENCY




 WSP USA, Inc.
 2 Miranova Pl.
 Suite 450
 Columbus, OH 43215

DESIGNER
 KAB
 REVIEWER
 ABS 07/30/24

Sheet Totals			PROJECT ID	
Seeding	Cut	Fill	SHEET	TOTAL
*	139	120	P.56	107

ALL-81-22.23

MODEL: CLP_5081E - 1174+50.00 (Sheet) PAPER SIZE: 34x22 (in.) DATE: 5/21/2025 TIME: 5:18:19 PM USER: Coffield
 pw:\ohiodoc-pw-bentley.com\ohiodoc-pw-02\Documents\01 Active Projects\District 01\Allen\117742\401-Engineering_WSP\Roadway\Sheets\117742_X5002.dgn

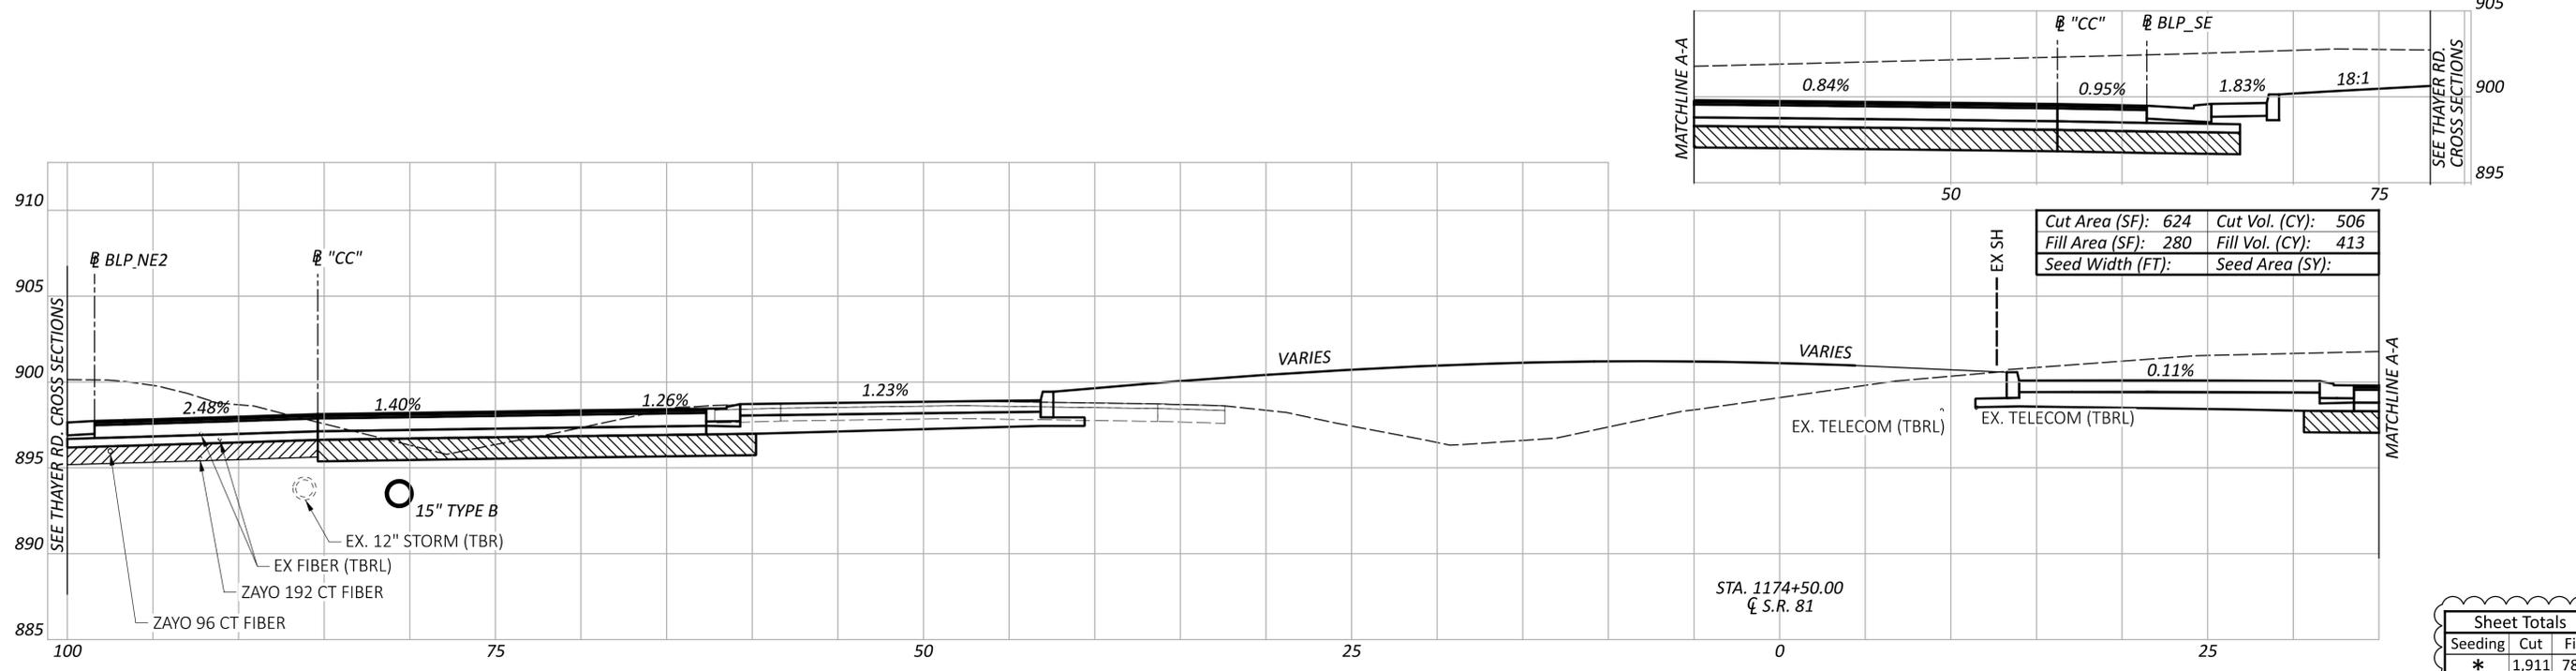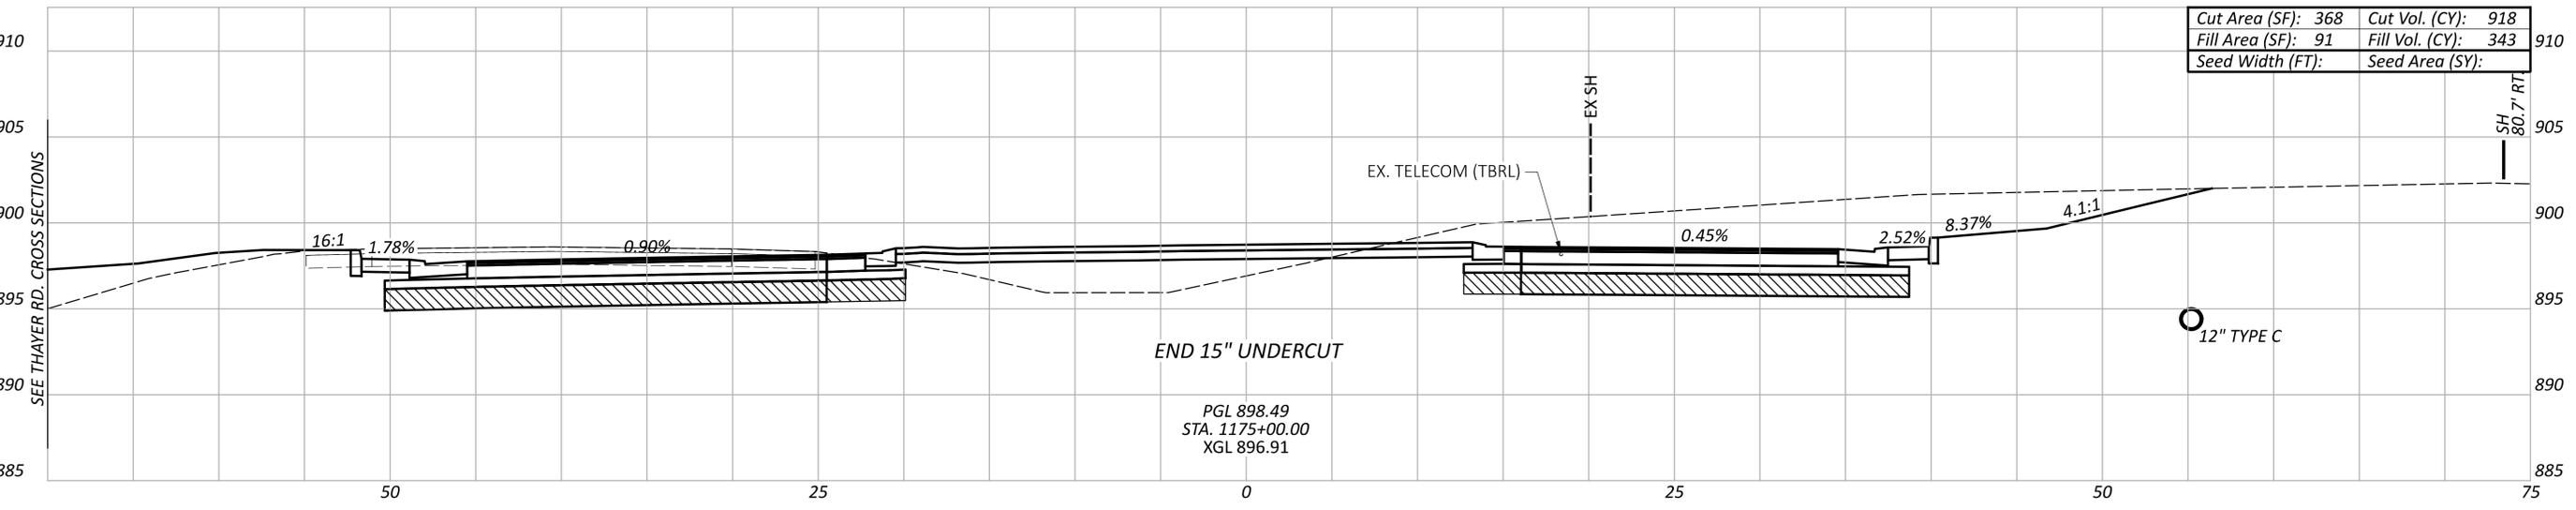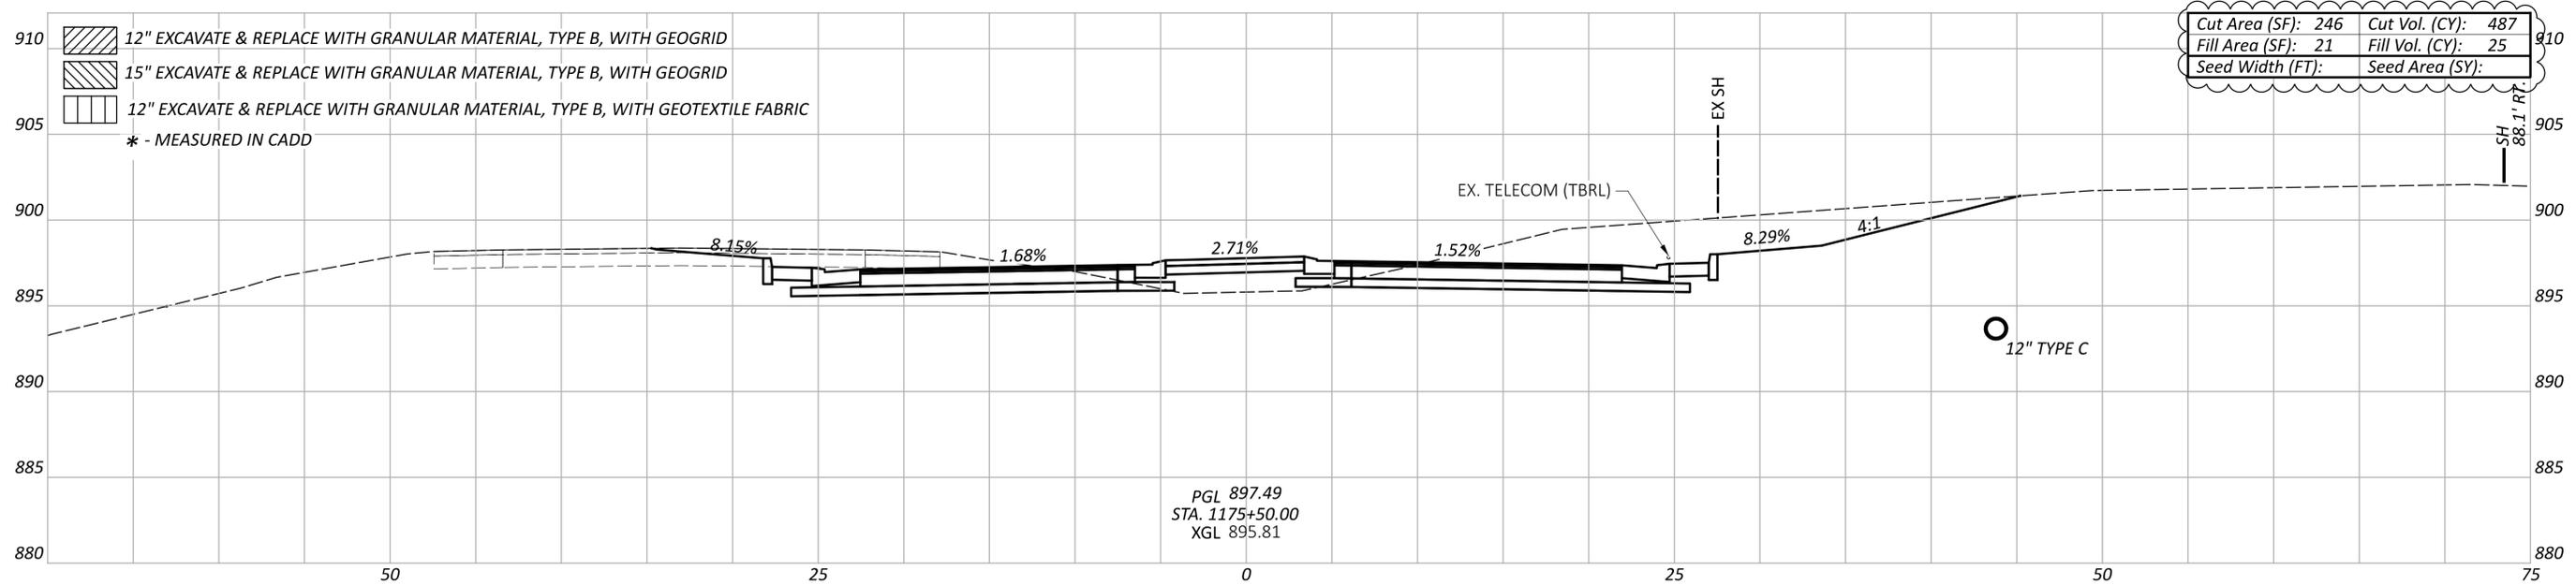

CROSS SECTIONS - S.R. 81 (EAST LEG)
 STA. 1174+50.00 TO STA. 1175+50.00

DESIGN AGENCY

 WSP USA, Inc.
 2 Miranova Pl.
 Suite 450
 Columbus, OH 43215

DESIGNER
 KAB

REVIEWER
 ABS 07/30/24


PROJECT ID
 117742

SHEET TOTAL
 P.59 | 107


ALL-81-22.23

MODEL: CLP_5081E - 1176+00.00 [Sheet] PAPER SIZE: 34x22 (in.) DATE: 5/21/2025 TIME: 5:18:27 PM USER: Coffield
 pw:\chiodo-pw.bentley.com\chiodo-pw-02\Documents\01.Active Projects\District 01\Allen\117742\401-Engineering_WSP\Roadway\Sheets\117742_X5002.dgn

-  12" EXCAVATE & REPLACE WITH GRANULAR MATERIAL, TYPE B, WITH GEOGRID
 -  15" EXCAVATE & REPLACE WITH GRANULAR MATERIAL, TYPE B, WITH GEOGRID
 -  12" EXCAVATE & REPLACE WITH GRANULAR MATERIAL, TYPE B, WITH GEOTEXTILE FABRIC
- * - MEASURED IN CADD

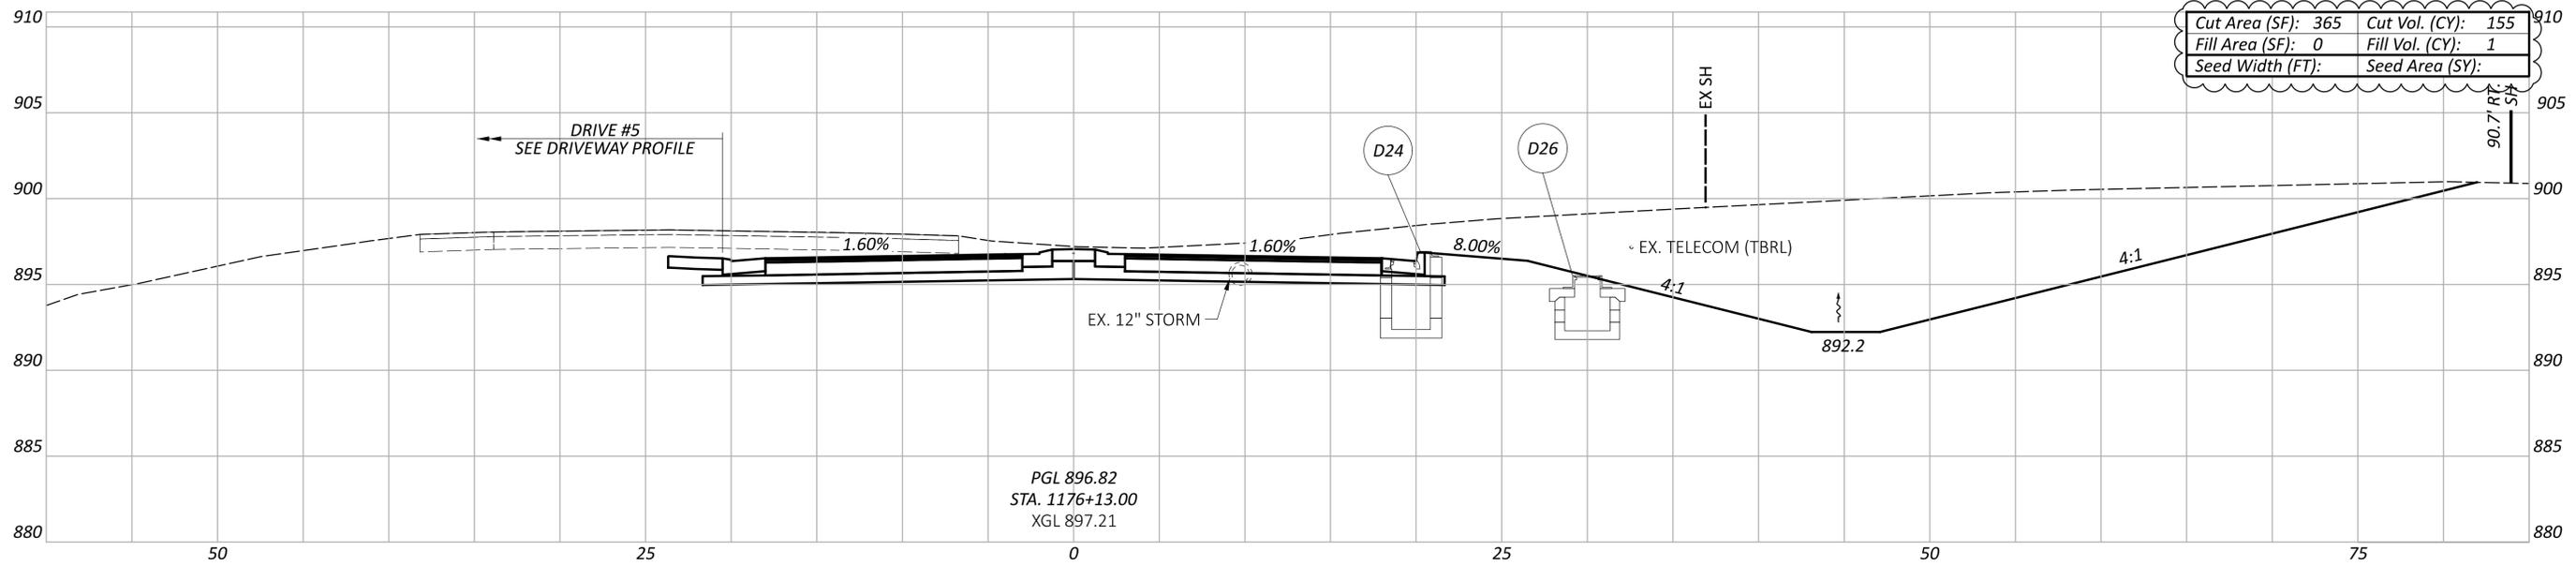

Cut Area (SF):	365	Cut Vol. (CY):	155
Fill Area (SF):	0	Fill Vol. (CY):	1
Seed Width (FT):		Seed Area (SY):	

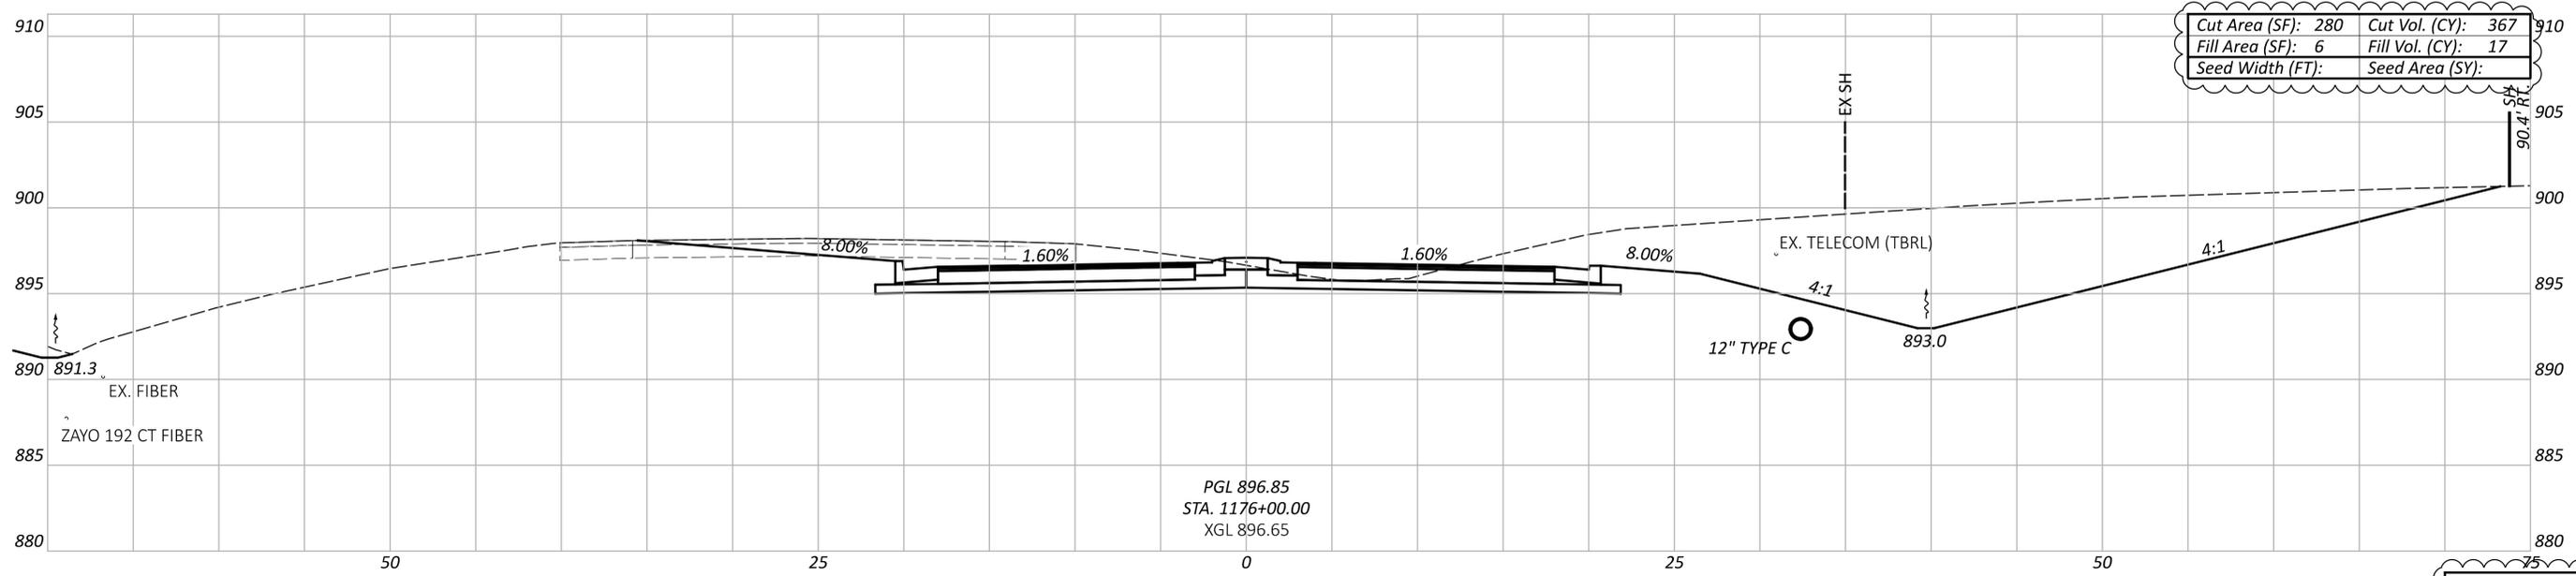

Cut Area (SF):	280	Cut Vol. (CY):	367
Fill Area (SF):	6	Fill Vol. (CY):	17
Seed Width (FT):		Seed Area (SY):	

Sheet Totals		
Seeding	Cut	Fill
*	522	18

CROSS SECTIONS - S.R. 81 (EAST LEG)
 STA. 1176+00.00 TO STA. 1176+13.00

DESIGN AGENCY

 WSP USA, Inc.
 2 Miranova Pl.
 Suite 450
 Columbus, OH 43215



DESIGNER
 KAB
 REVIEWER
 ABS 07/30/24

PROJECT ID
 117742
 SHEET TOTAL
 P.60 107

ALL-81-22.23

MODEL: CLP_5081E - 1176+47.00 [Sheet] PAPER SIZE: 34x22 (in.) DATE: 5/21/2025 TIME: 5:18:32 PM USER: Coffield
 pw:\ohiodoc-pw.bentley.com\ohiodoc-pw-02\Documents\01.Active Projects\District 01\Allen\117742\401-Engineering_WSP\Roadway\Sheets\117742_X5002.dgn

-  12" EXCAVATE & REPLACE WITH GRANULAR MATERIAL, TYPE B, WITH GEOGRID
 -  15" EXCAVATE & REPLACE WITH GRANULAR MATERIAL, TYPE B, WITH GEOGRID
 -  12" EXCAVATE & REPLACE WITH GRANULAR MATERIAL, TYPE B, WITH GEOTEXTILE FABRIC
- * - MEASURED IN CADD

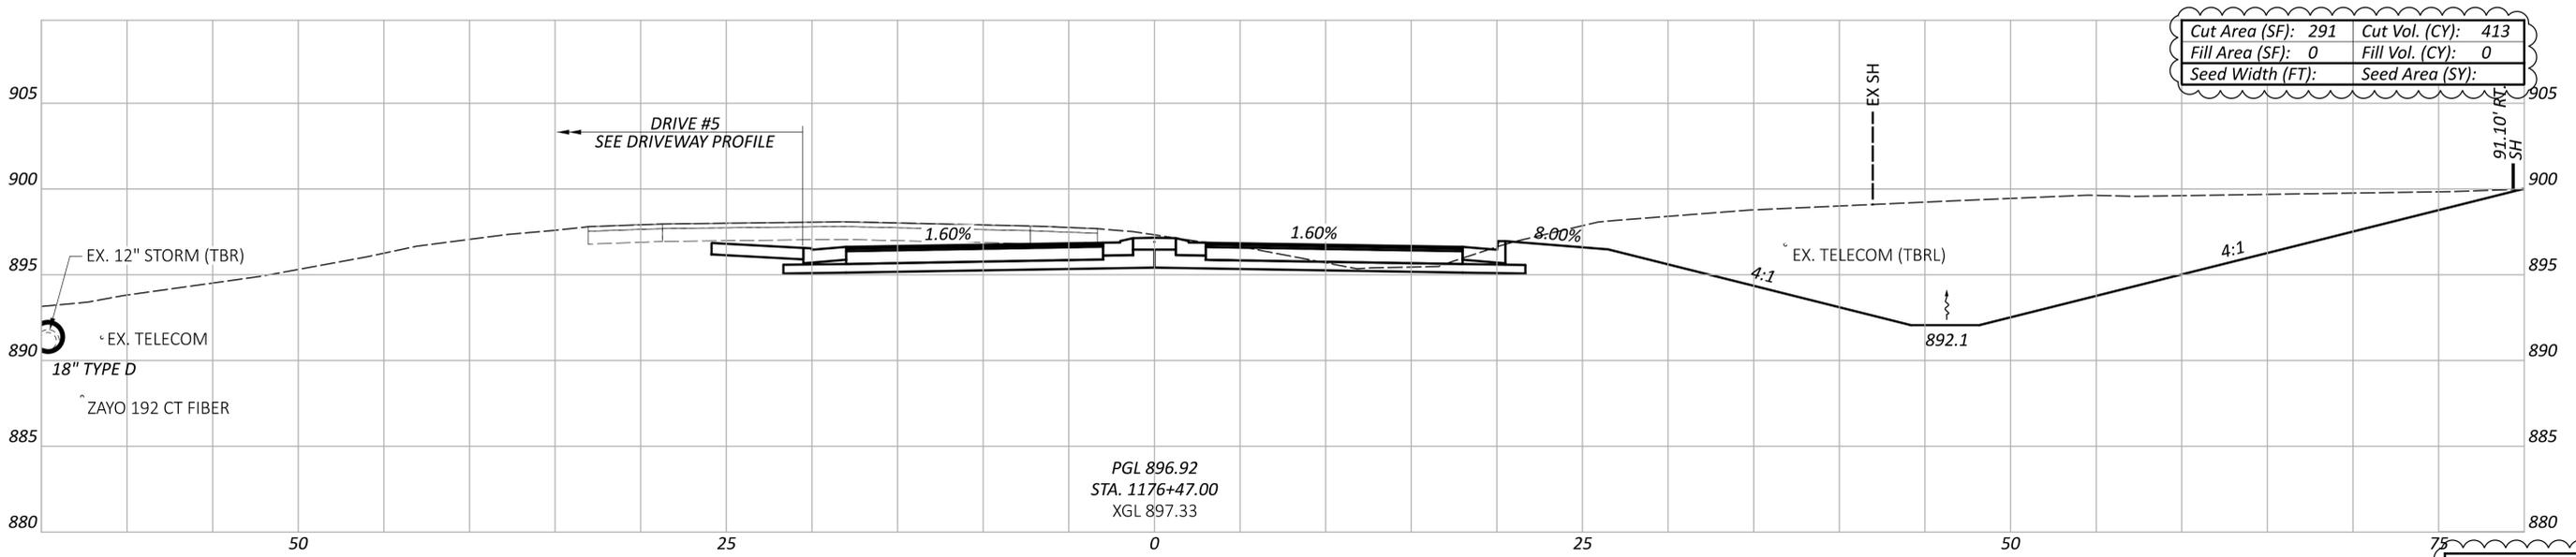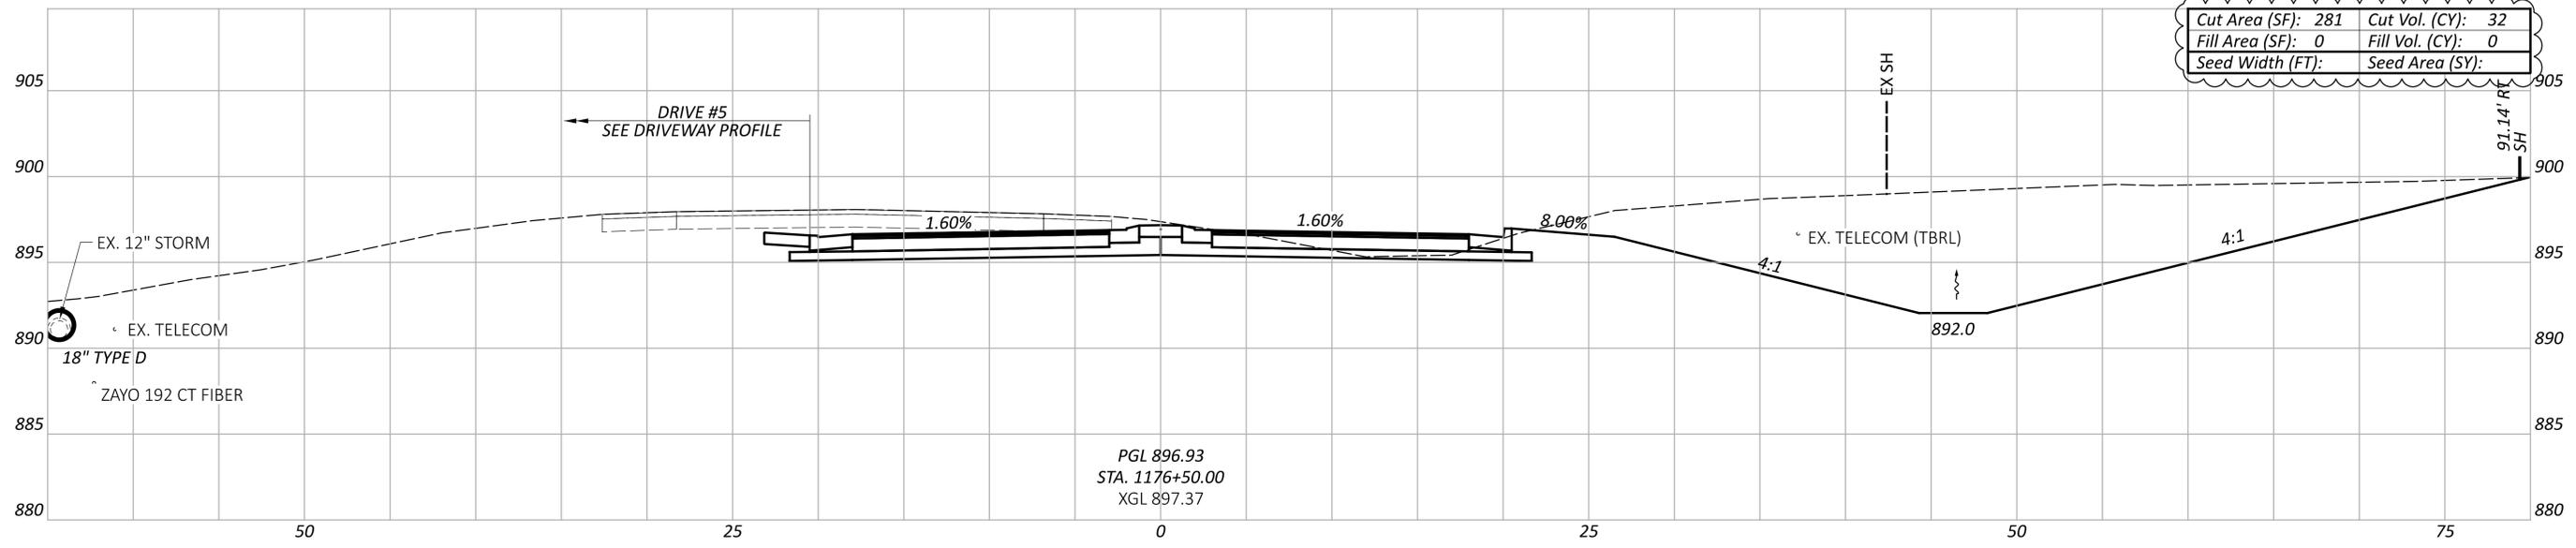

Sheet Totals		
SEEDING	CUT	FILL
*	445	0

CROSS SECTIONS - S.R. 81 (EAST LEG)
 STA. 1176+47 TO STA. 1176+50.00

DESIGN AGENCY

 WSP USA, Inc.
 2 Miranova Pl,
 Suite 450
 Columbus, OH 43215



DESIGNER
 KAB
 REVIEWER
 ABS 07/30/24

PROJECT ID
 117742
 SHEET TOTAL
 P.61 | 107

ALL-81-22.23

MODEL: CLP_5081E - 1177+00.00 [Sheet] PAPER SIZE: 34x22 (in.) DATE: 5/21/2025 TIME: 5:18:37 PM USER: Coffield
 pw:\ohiodot-pw-bentley.com\ohiodot-pw-02\Documents\01 Active Projects\District 01\Allen\117742\401-Engineering_WSP\Roadway\Sheets\117742_X5002.dgn

-  12" EXCAVATE & REPLACE WITH GRANULAR MATERIAL, TYPE B, WITH GEOGRID
 -  15" EXCAVATE & REPLACE WITH GRANULAR MATERIAL, TYPE B, WITH GEOGRID
 -  12" EXCAVATE & REPLACE WITH GRANULAR MATERIAL, TYPE B, WITH GEOTEXTILE FABRIC
- * - MEASURED IN CADD

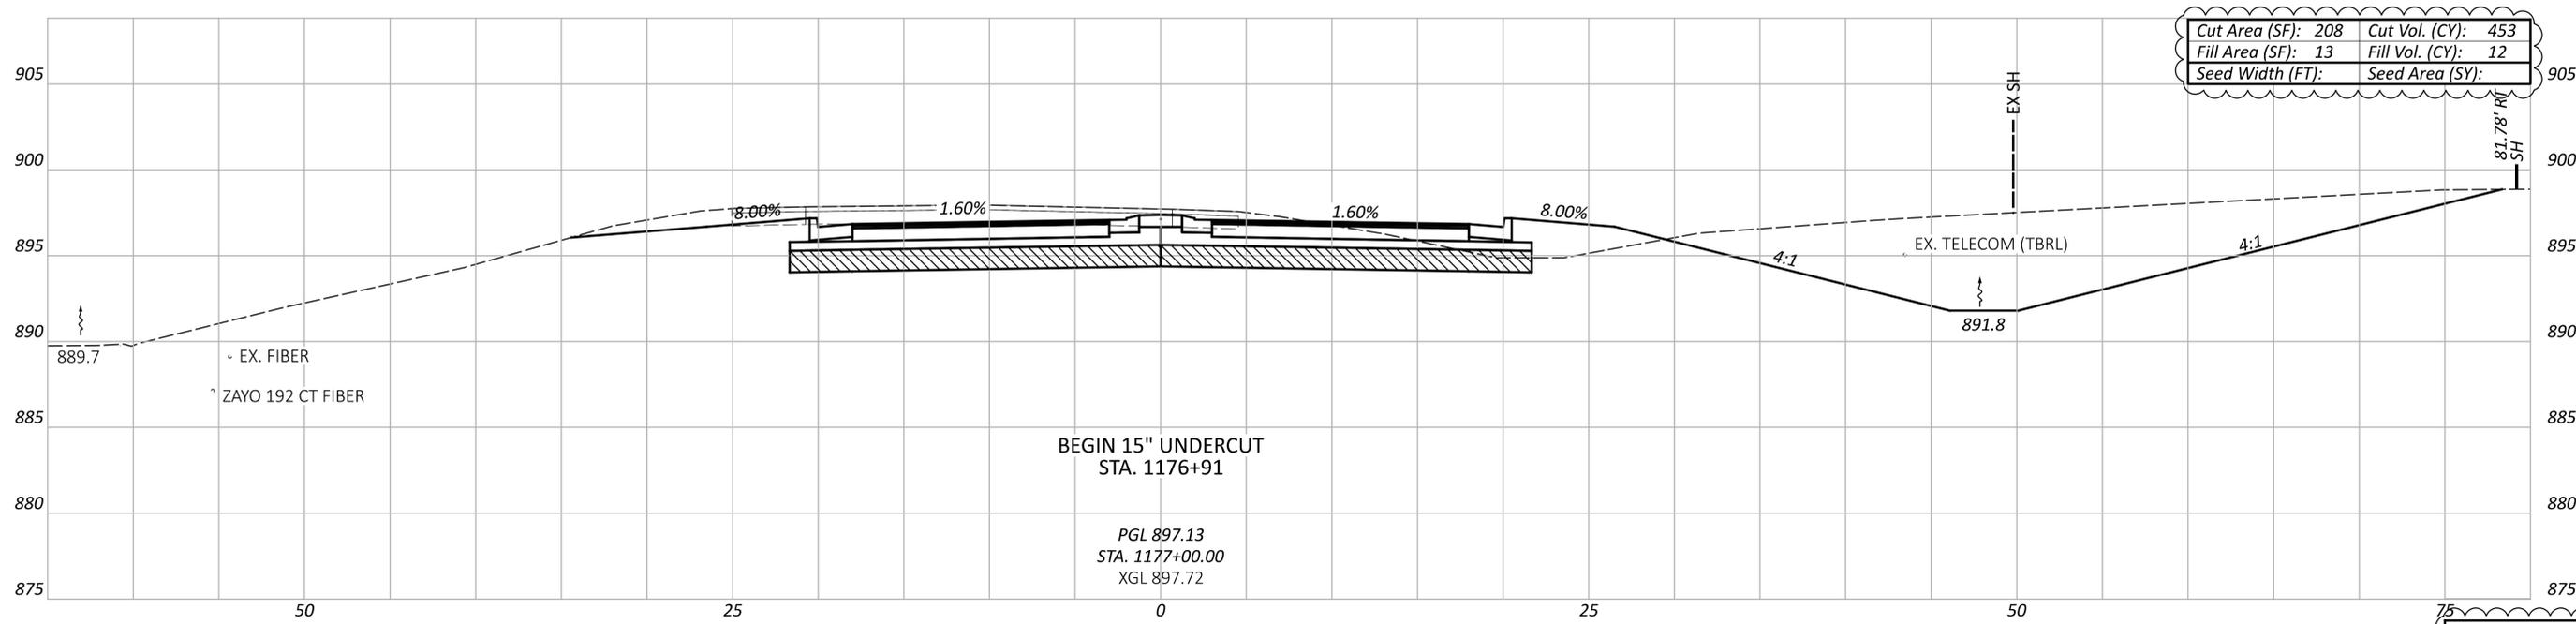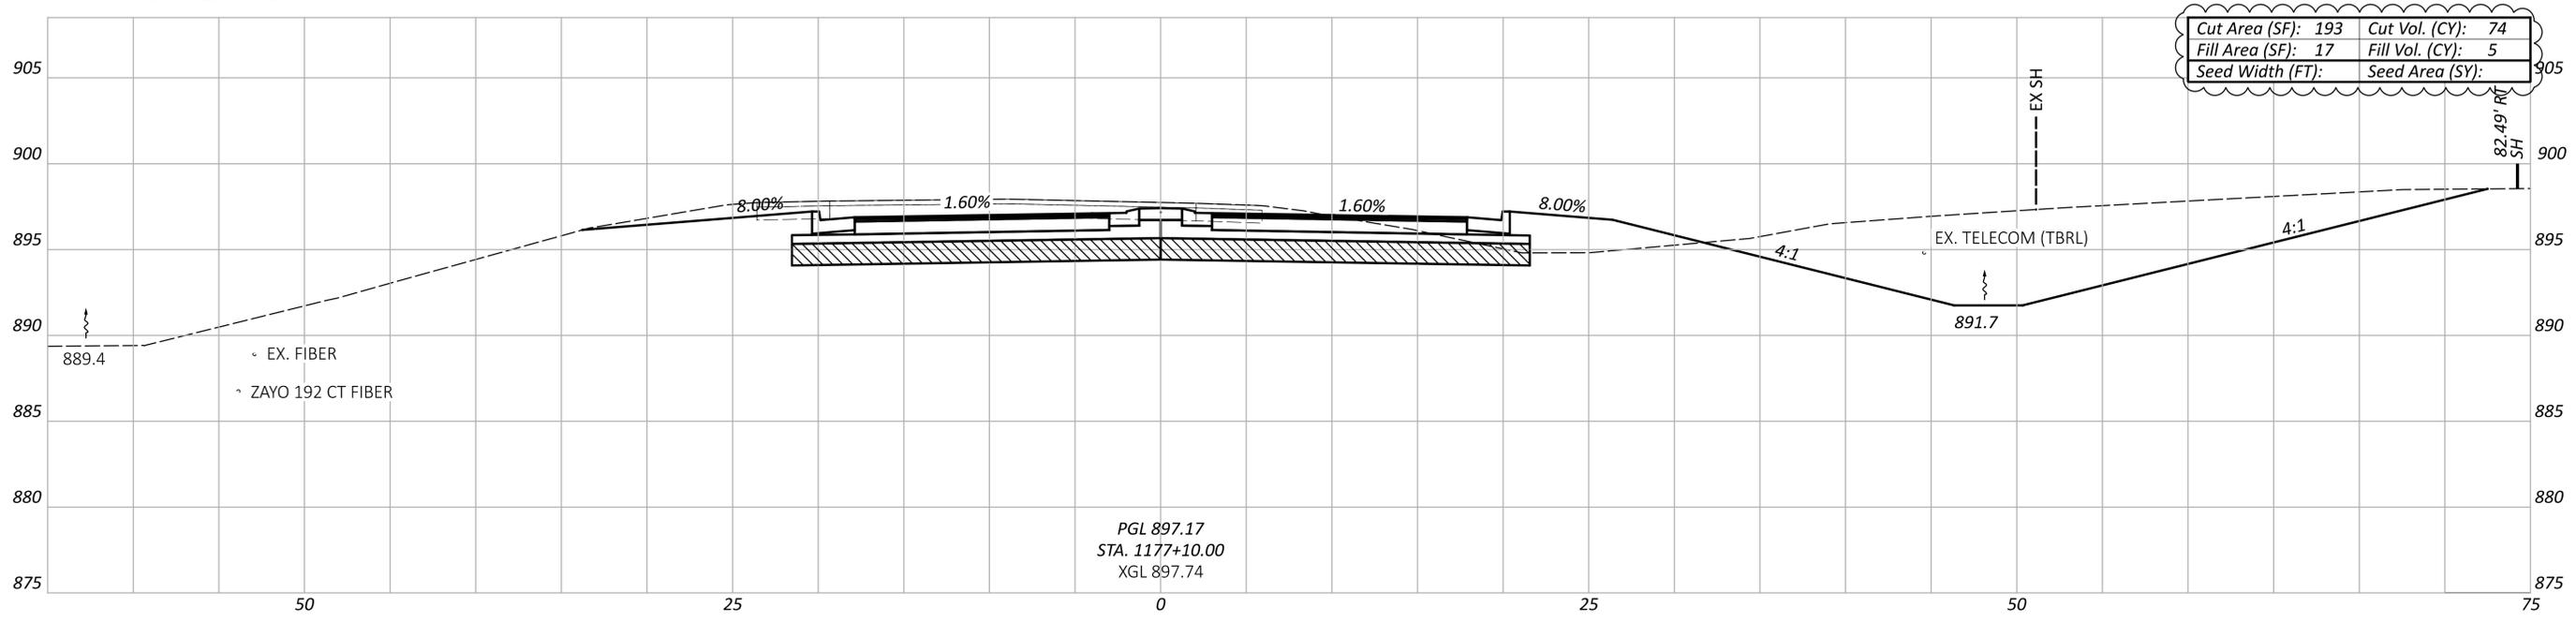

Sheet Totals	
Seeding	Cut Fill
*	527 17

CROSS SECTIONS - S.R. 81 (EAST LEG)
STA. 1177+00.00 TO STA. 1177+10.00

DESIGN AGENCY

 WSP USA, Inc.
 2 Miranova Pl,
 Suite 450
 Columbus, OH 43215

DESIGNER
 KAB

REVIEWER
 ABS 07/30/24



PROJECT ID
 117742

SHEET TOTAL	P.62 107
-------------	------------

ALL-81-22.23

MODEL: CLP_5081E - 1177+50.00 [Sheet] PAPER SIZE: 34x22 (in.) DATE: 5/21/2025 TIME: 5:18:42 PM USER: Coffield
 pw:\ohiodot-pw-bentley.com\ohiodot-pw-02\Documents\01 Active Projects\District 01\Allen\117742\401-Engineering_WSP\Roadway\Sheets\117742_X5002.dgn

-  12" EXCAVATE & REPLACE WITH GRANULAR MATERIAL, TYPE B, WITH GEOGRID
 -  15" EXCAVATE & REPLACE WITH GRANULAR MATERIAL, TYPE B, WITH GEOGRID
 -  12" EXCAVATE & REPLACE WITH GRANULAR MATERIAL, TYPE B, WITH GEOTEXTILE FABRIC
- * - MEASURED IN CADD

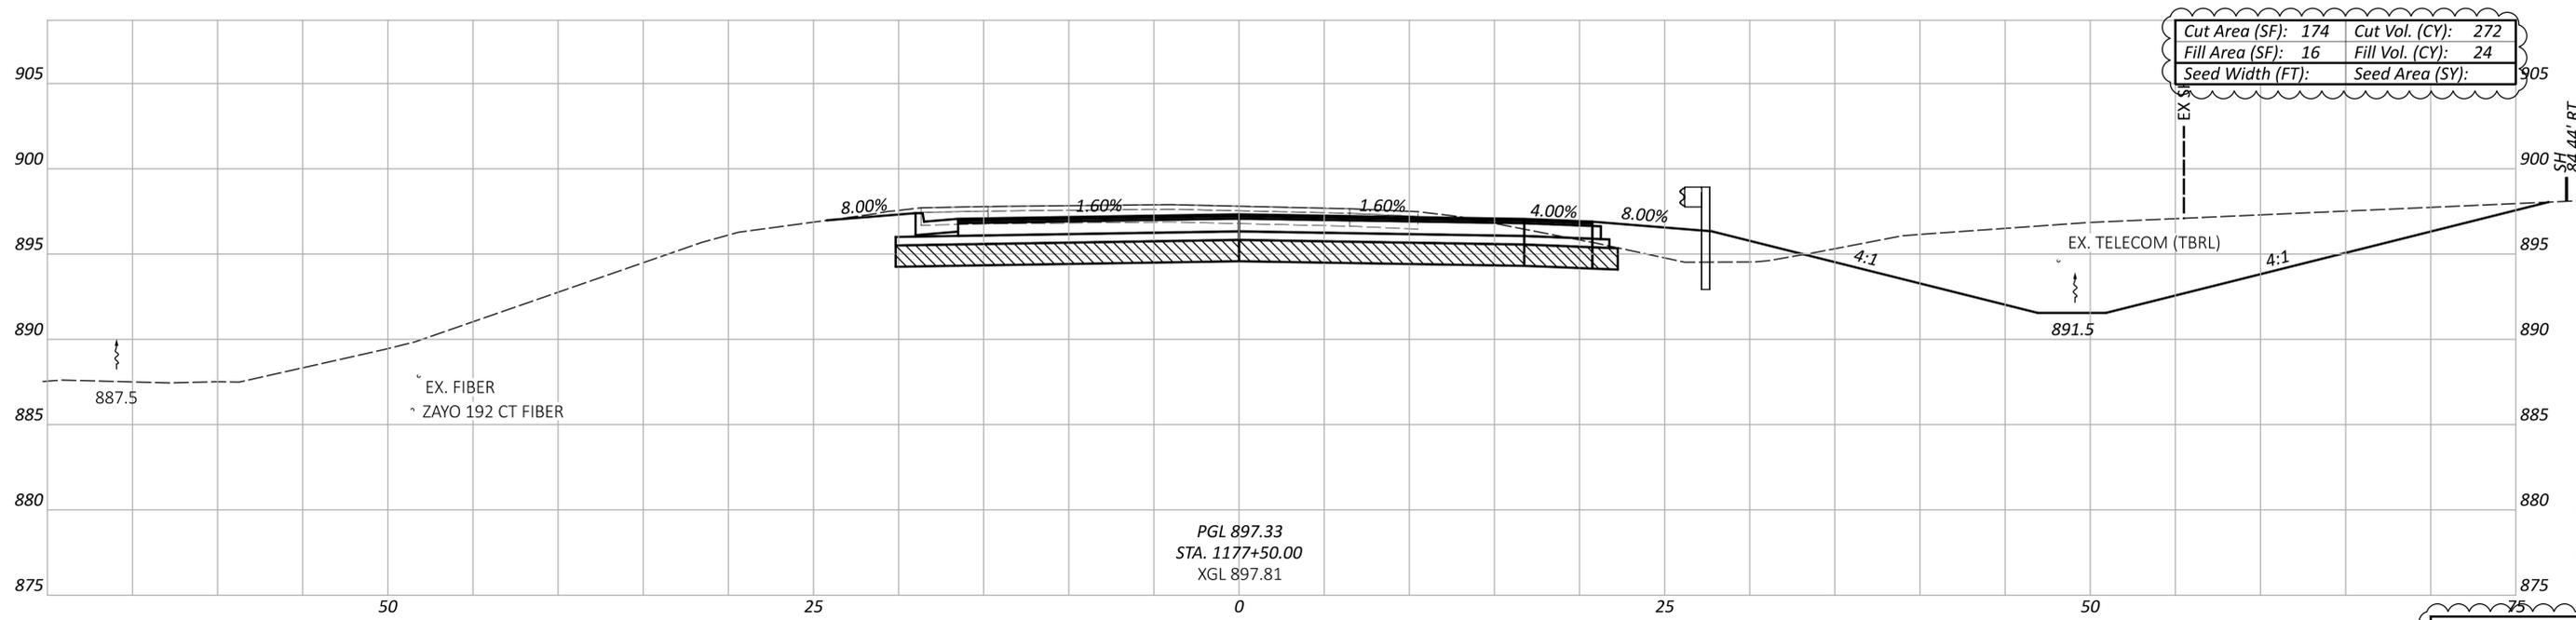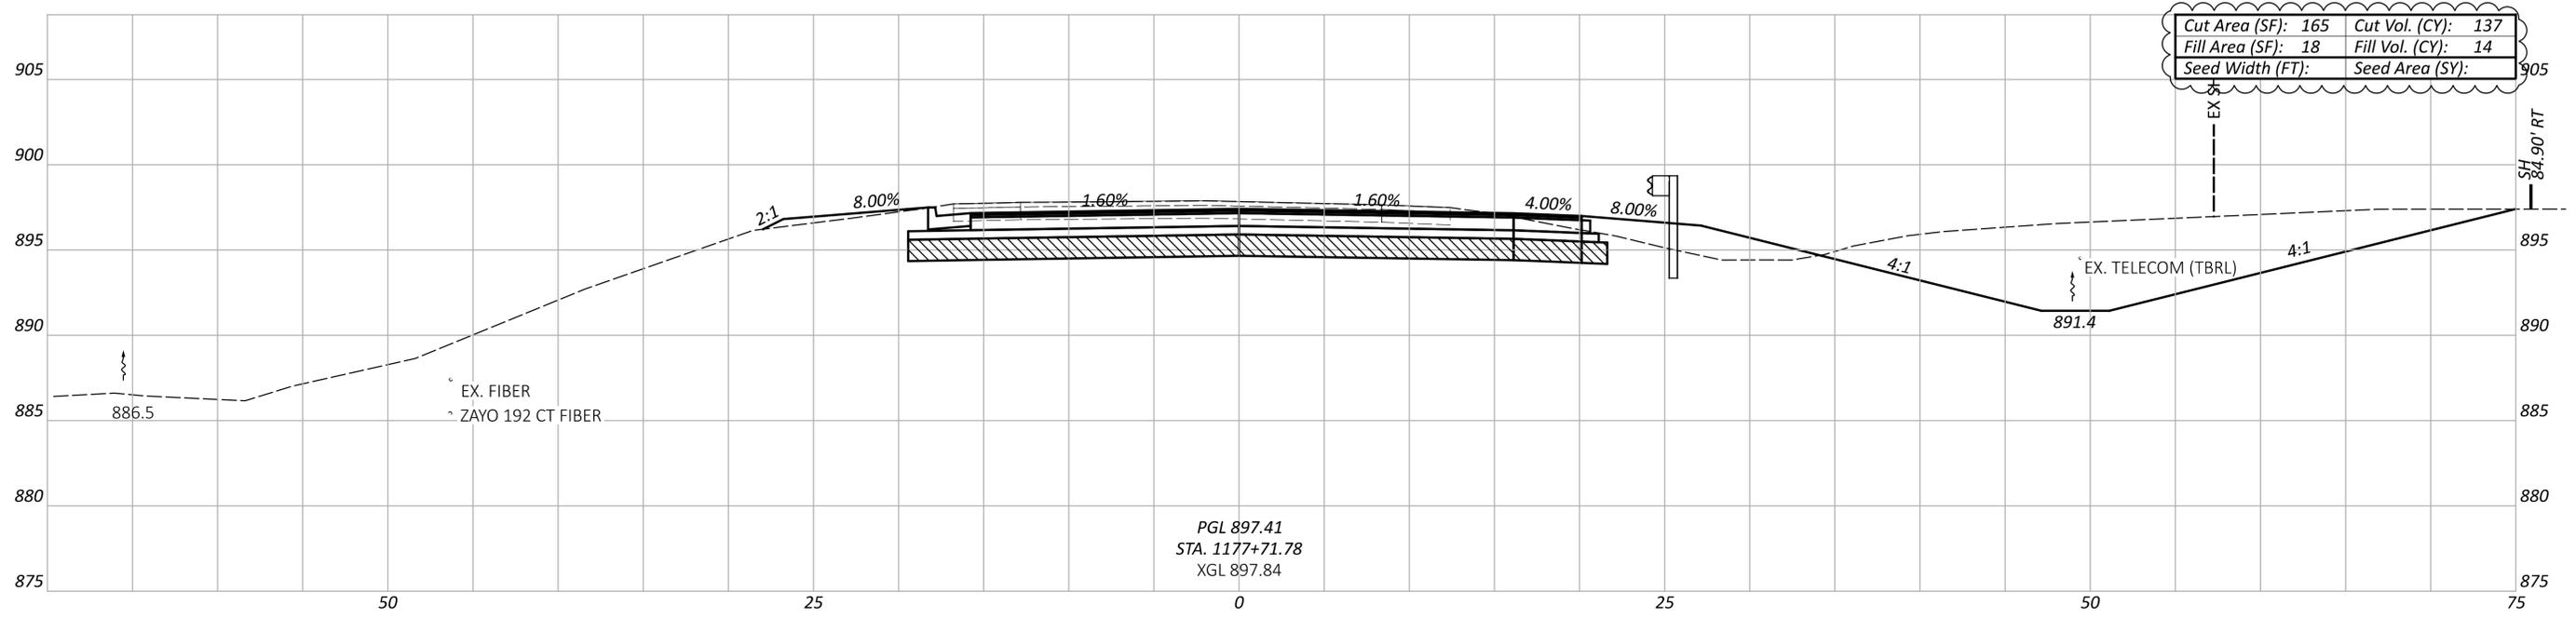

Sheet Totals		
Seeding	Cut	Fill
*	409	38

DESIGN AGENCY

 WSP USA, Inc.
 2 Miranova Pl,
 Suite 450
 Columbus, OH 43215

DESIGNER
 KAB
 REVIEWER
 ABS 07/30/24



PROJECT ID
 117742
 SHEET TOTAL
 P.63 | 107

CROSS SECTIONS - S.R. 81 (EAST LEG)
 STA. 1177+50.00 TO STA. 1177+71.78

ALL-81-22.23

MODEL: CLP_5081E - 1178+00.00 [Sheet] PAPER SIZE: 34x22 (in.) DATE: 5/21/2025 TIME: 5:18:45 PM USER: Coffield
 pw:\ohiodot-pw-bentley.com\ohiodot-pw-02\Documents\01 Active Projects\District 01\Allen\117742\401-Engineering_WSP\Roadway\Sheets\117742_X5002.dgn

-  12" EXCAVATE & REPLACE WITH GRANULAR MATERIAL, TYPE B, WITH GEOGRID
-  15" EXCAVATE & REPLACE WITH GRANULAR MATERIAL, TYPE B, WITH GEOGRID
-  12" EXCAVATE & REPLACE WITH GRANULAR MATERIAL, TYPE B, WITH GEOTEXTILE FABRIC
- * - MEASURED IN CADD

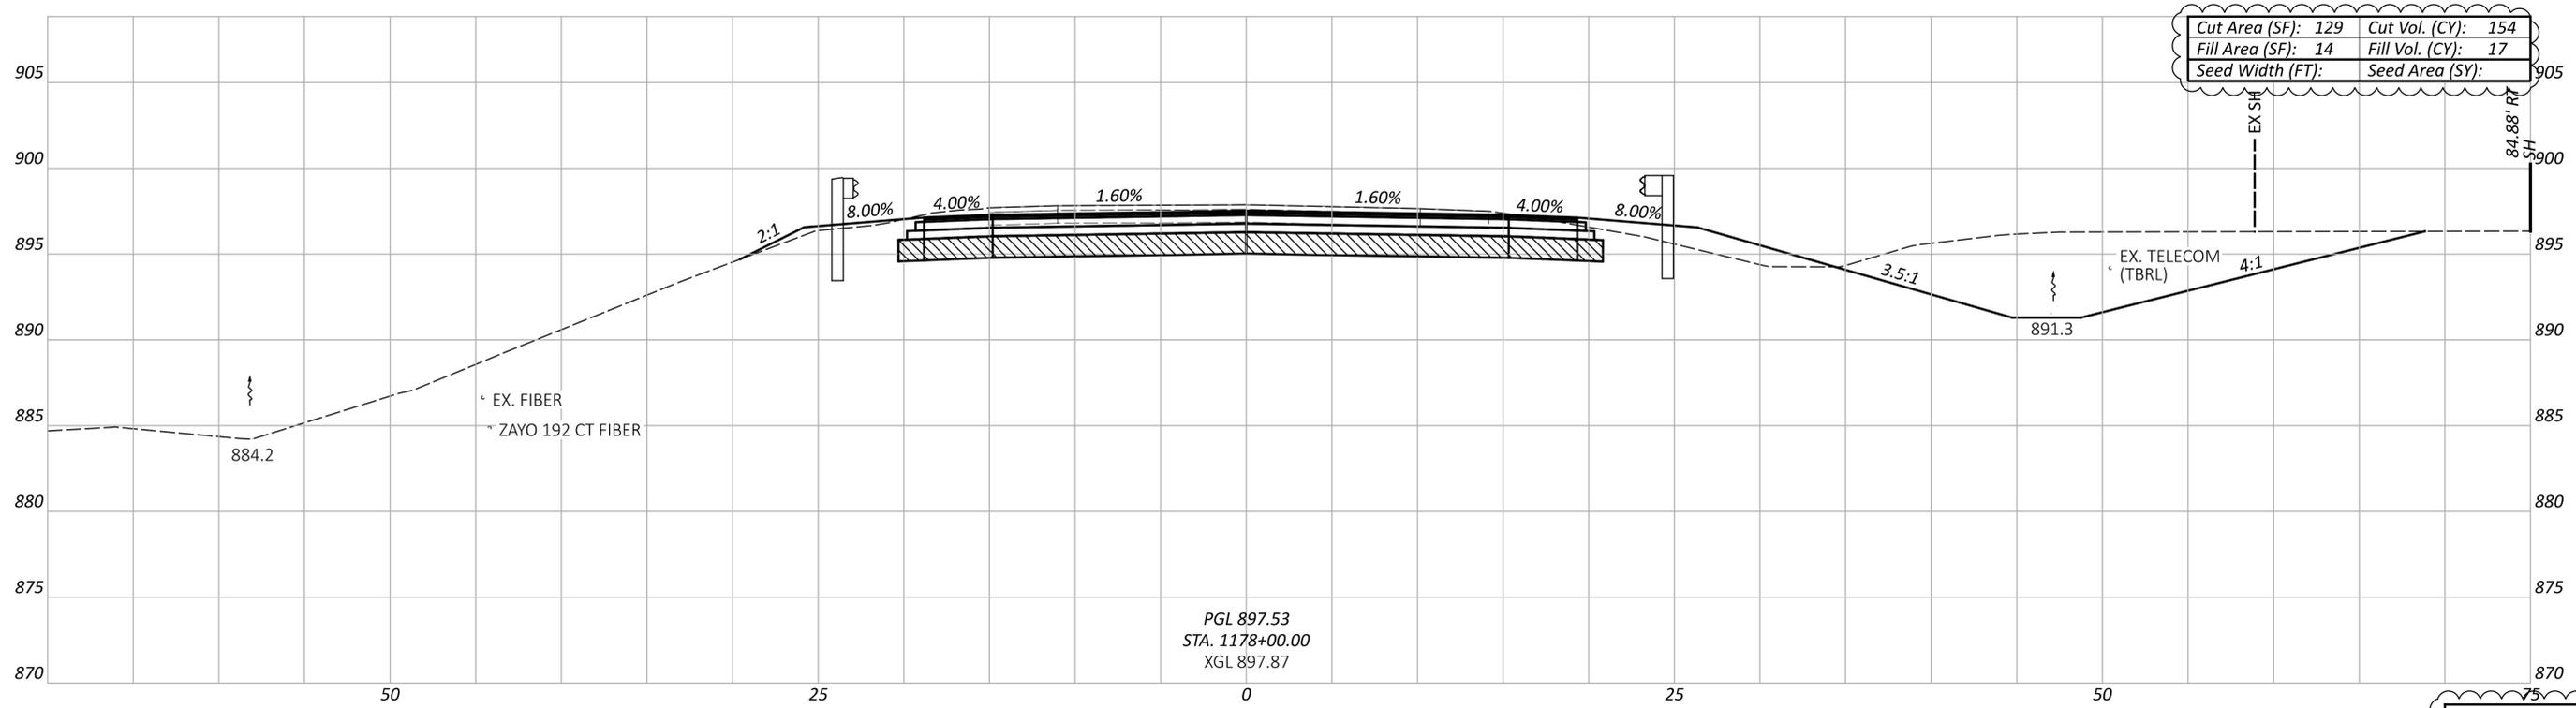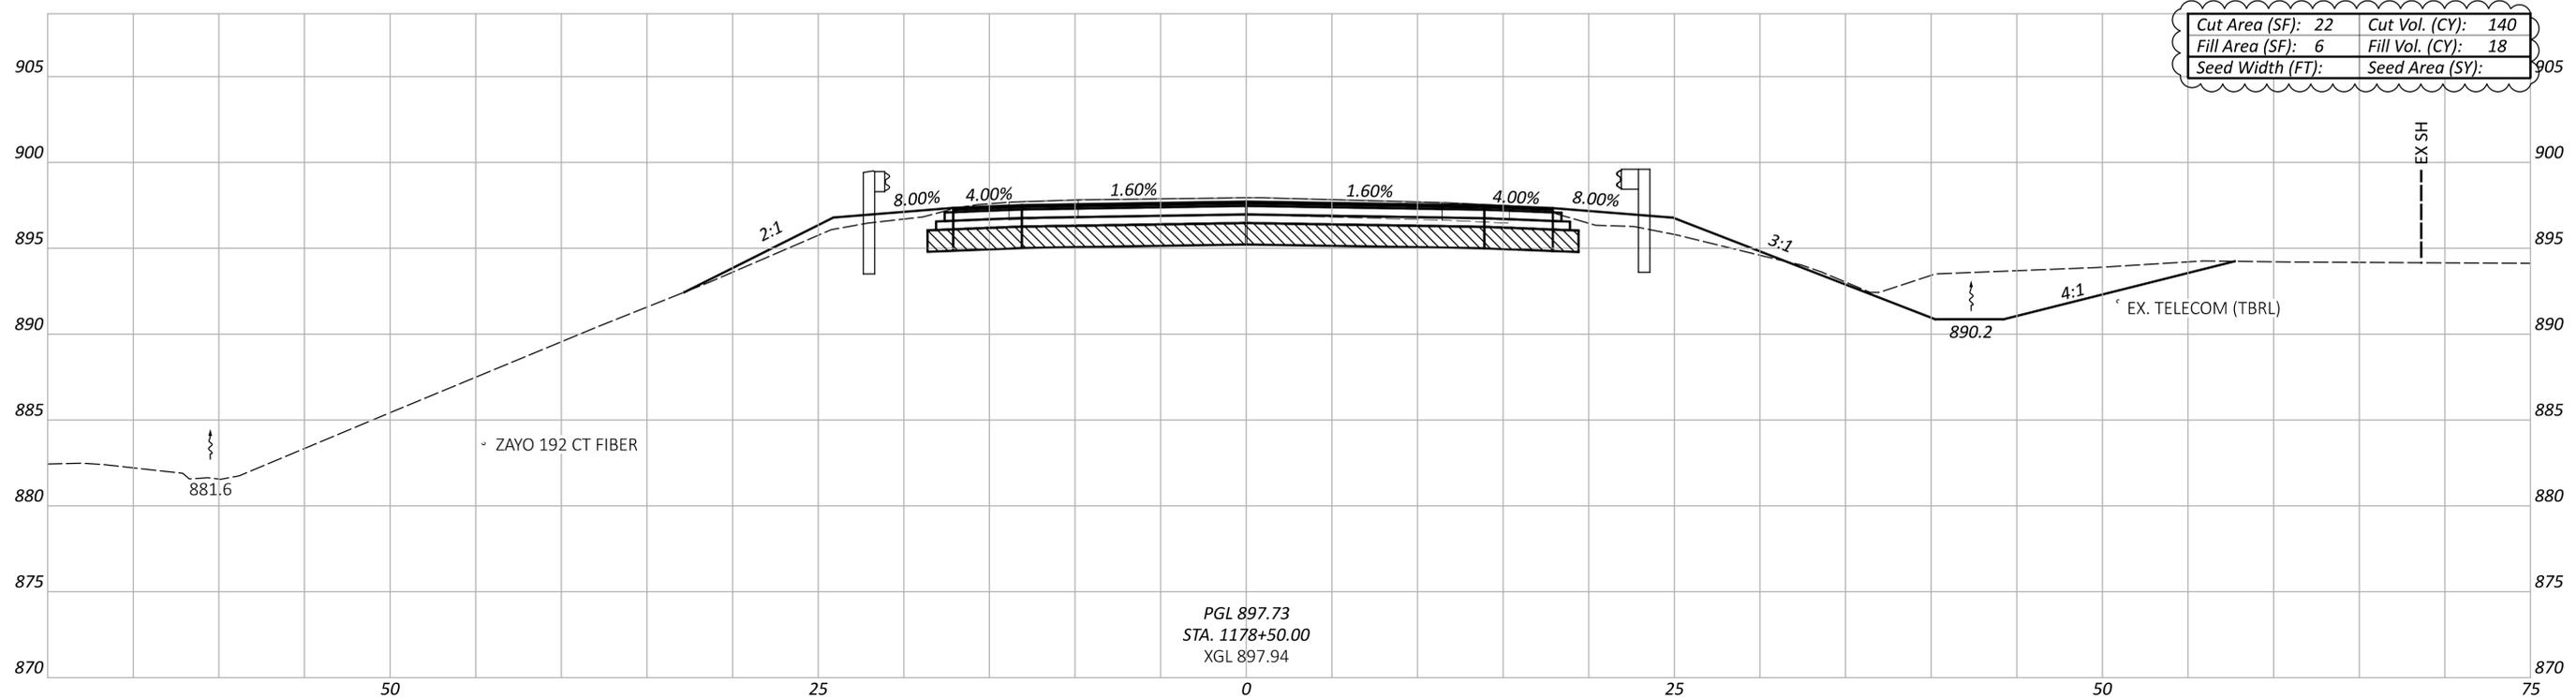

CROSS SECTIONS - S.R. 81 (EAST LEG)
 STA. 1178+00.00 TO STA. 1178+50.00

DESIGN AGENCY

 WSP USA, Inc.
 2 Miranova Pl.
 Suite 450
 Columbus, OH 43215

DESIGNER
 KAB

REVIEWER
 ABS 07/30/24



PROJECT ID
 117742

Sheet Totals		
Seeding	Cut	Fill
*	294	35

SHEET TOTAL
 P.64 107

-  12" EXCAVATE & REPLACE WITH GRANULAR MATERIAL, TYPE B, WITH GEOGRID
-  15" EXCAVATE & REPLACE WITH GRANULAR MATERIAL, TYPE B, WITH GEOGRID
-  12" EXCAVATE & REPLACE WITH GRANULAR MATERIAL, TYPE B, WITH GEOTEXTILE FABRIC

* - MEASURED IN CADD

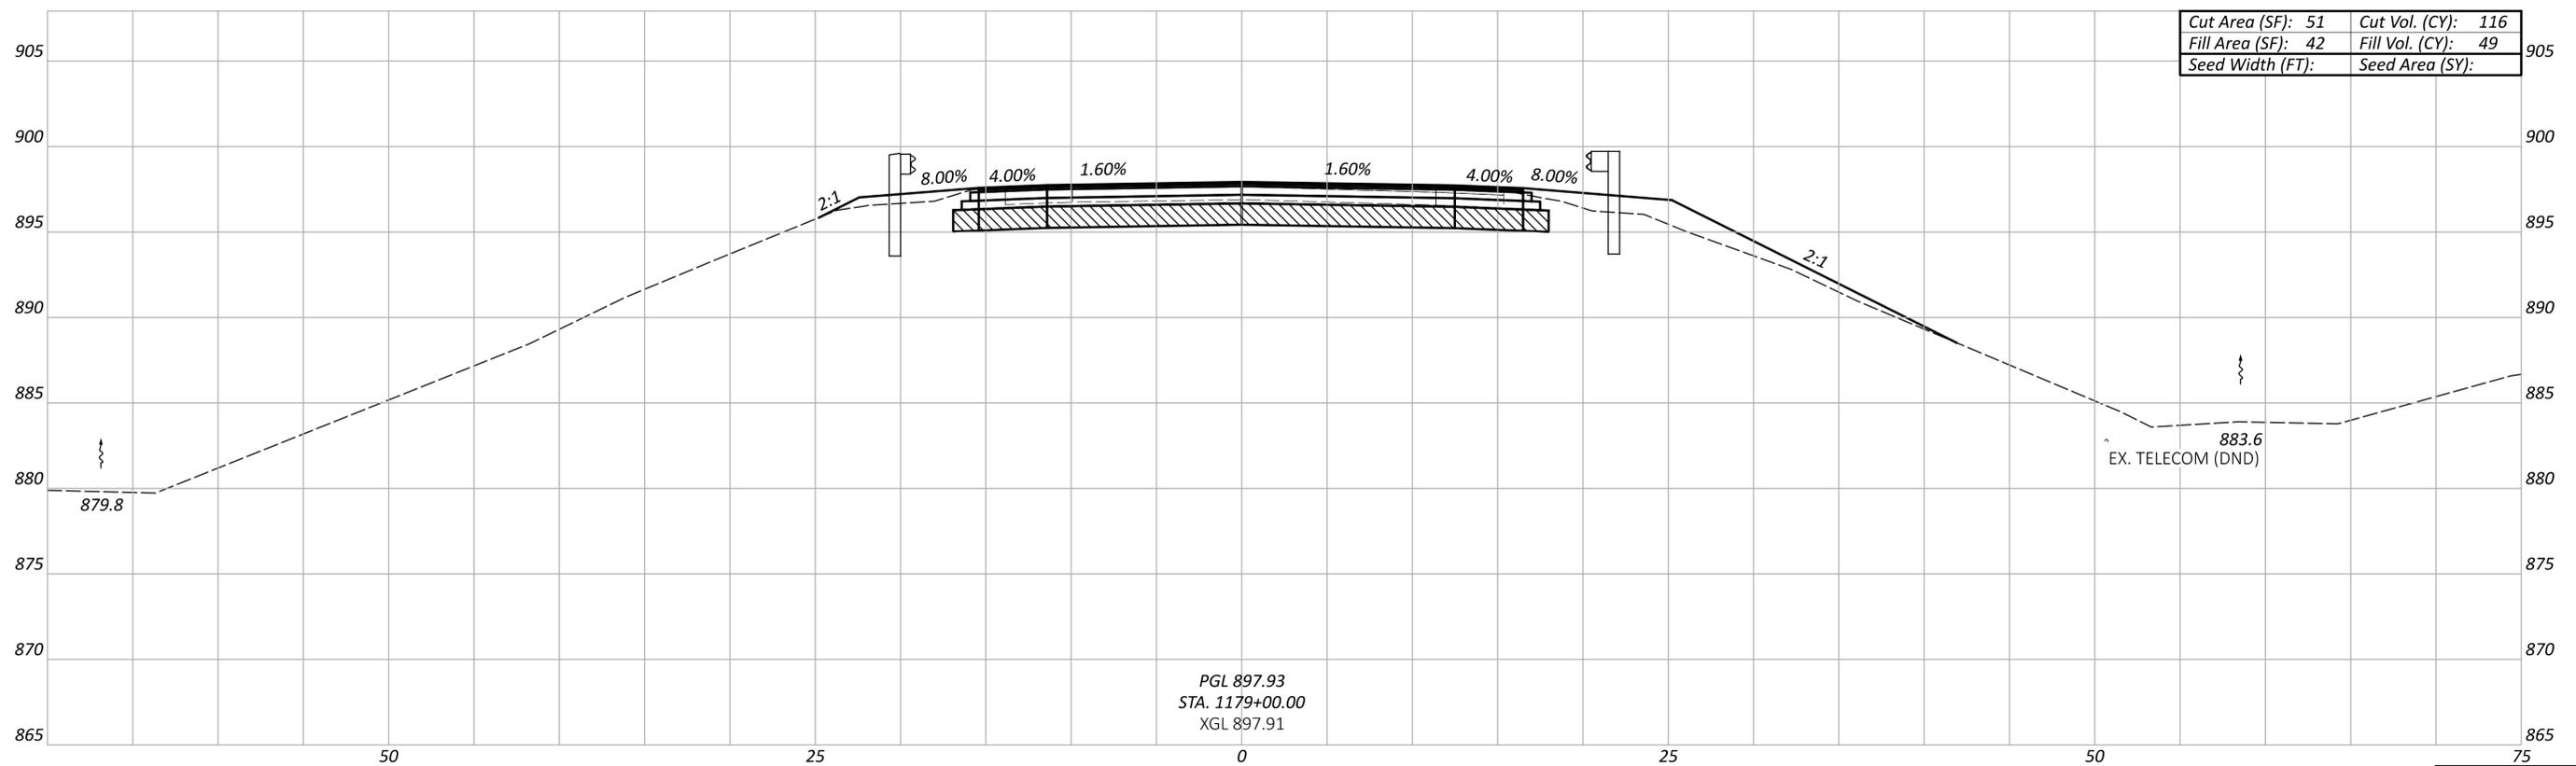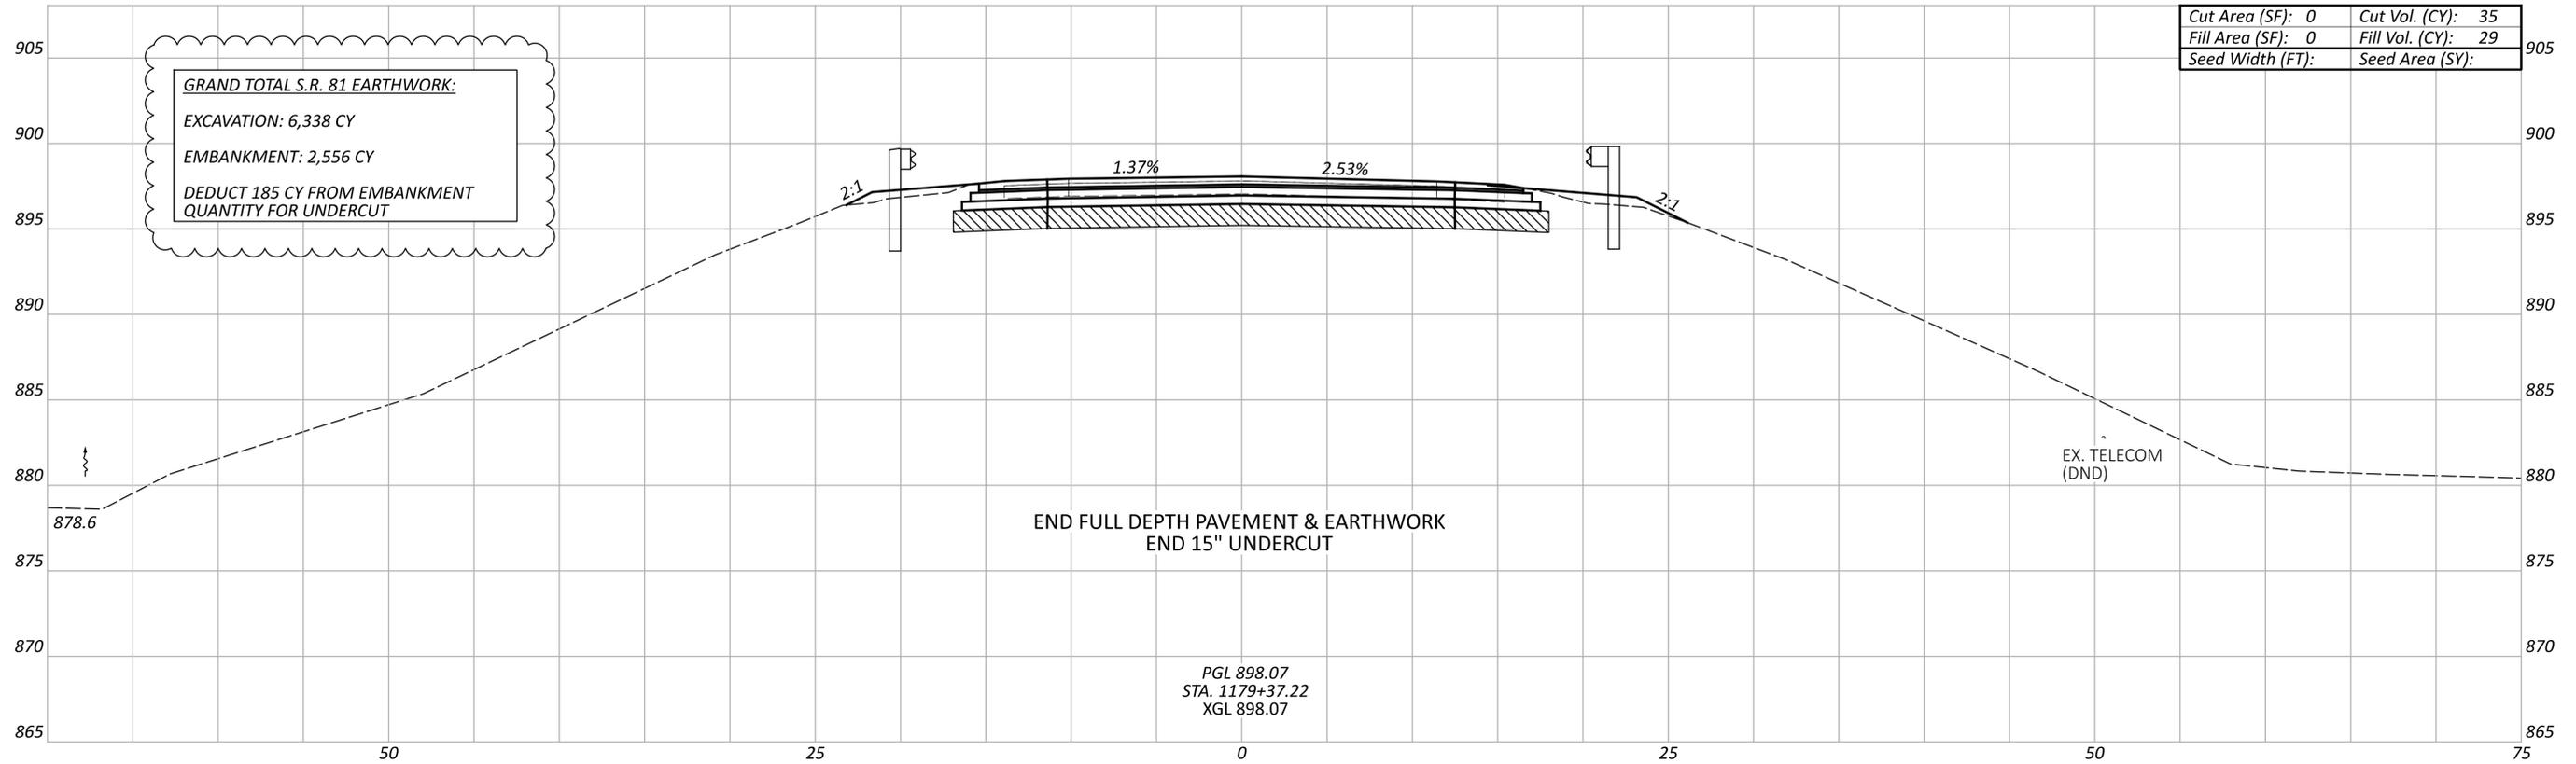

CROSS SECTIONS - S.R. 81 (EAST LEG)
STA. 1179+00.00 TO STA. 1179+37.22

ALL-81-22.23

MODEL: CLP_5081E - 1179+00.00 [Sheet] PAPER SIZE: 34x22 (in.) DATE: 5/22/2025 TIME: 8:59:20 AM USER: Coffield
pw:\ohiodot-pw-bentley.com\ohiodot-pw-02\Documents\01 Active Projects\District 01\Allen\117742\401-Engineering_WSP\Roadway\Sheets\117742_X5002.dgn

DESIGN AGENCY



WSP USA, Inc.
2 Miranova Pl,
Suite 450
Columbus, OH 43215

DESIGNER

KAB

REVIEWER

ABS 07/30/24

PROJECT ID


117742

Sheet Totals			SHEET TOTAL	
Seeding	Cut	Fill	P.65	107
*	151	78		

ALL-81-22.23


MODEL: CLP_THAYERS - 93+67.84 [Sheet] PAPER SIZE: 34x22 (in.) DATE: 5/22/2025 TIME: 7:05:21 AM USER: Coffield
 pw:\ohiodot-pw-bentley.com\ohiodot-pw-02\Documents\01-Active Projects\District 01\Allen\117742\401-Engineering_WSP\Roadway\Sheets\117742_X5003.dgn

-  12" EXCAVATE & REPLACE WITH GRANULAR MATERIAL, TYPE B, WITH GEOGRID
-  15" EXCAVATE & REPLACE WITH GRANULAR MATERIAL, TYPE B, WITH GEOGRID
-  12" EXCAVATE & REPLACE WITH GRANULAR MATERIAL, TYPE B, WITH GEOTEXTILE FABRIC
- * - MEASURED IN CADD

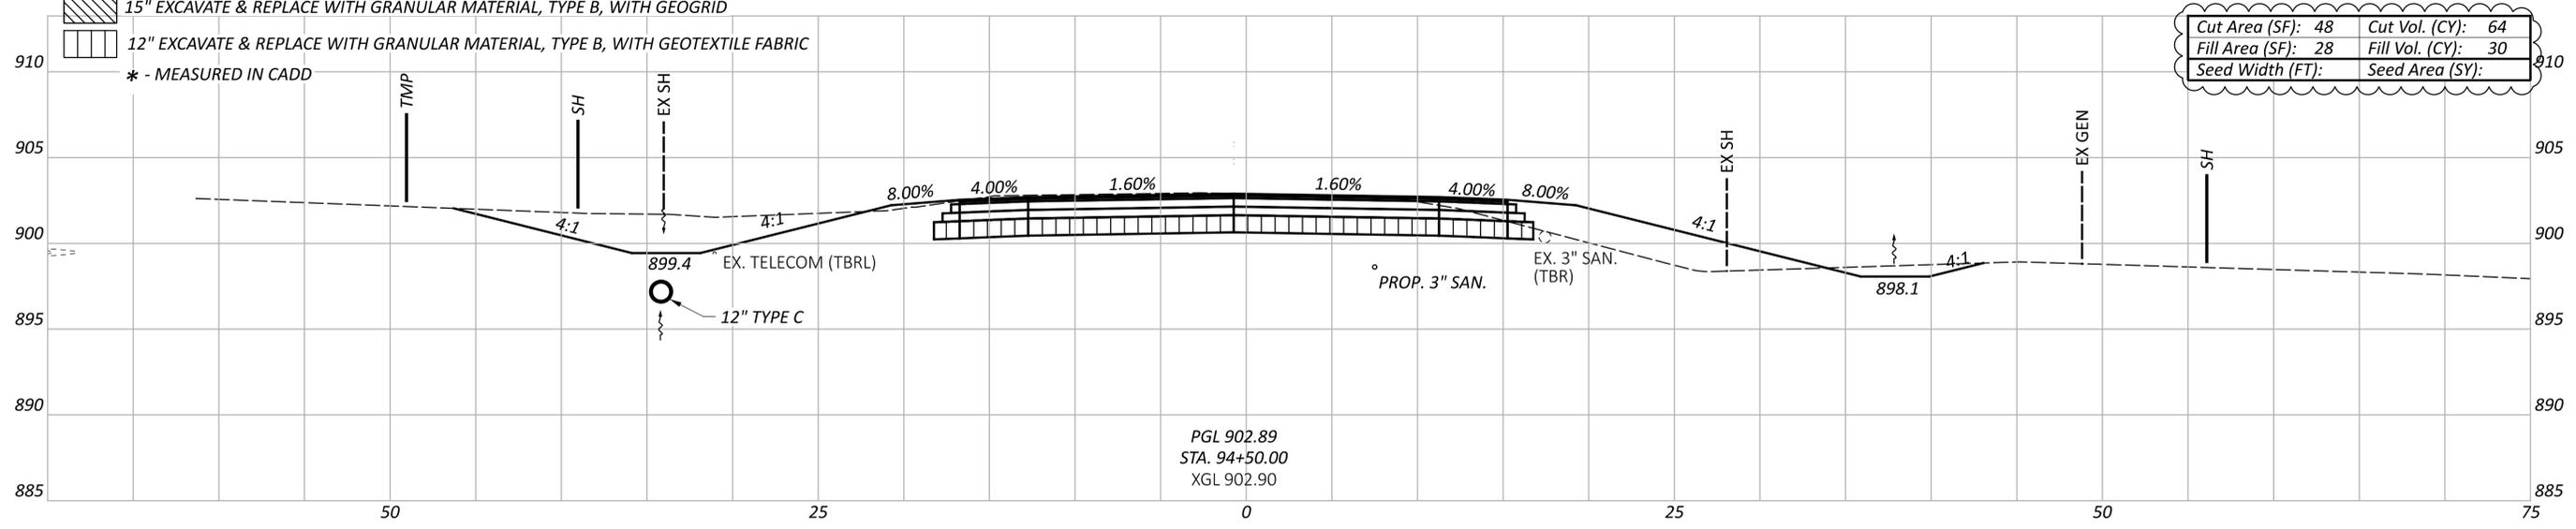


Cut Area (SF): 48	Cut Vol. (CY): 64
Fill Area (SF): 28	Fill Vol. (CY): 30
Seed Width (FT):	Seed Area (SY):

PGL 902.89
 STA. 94+50.00
 XGL 902.90

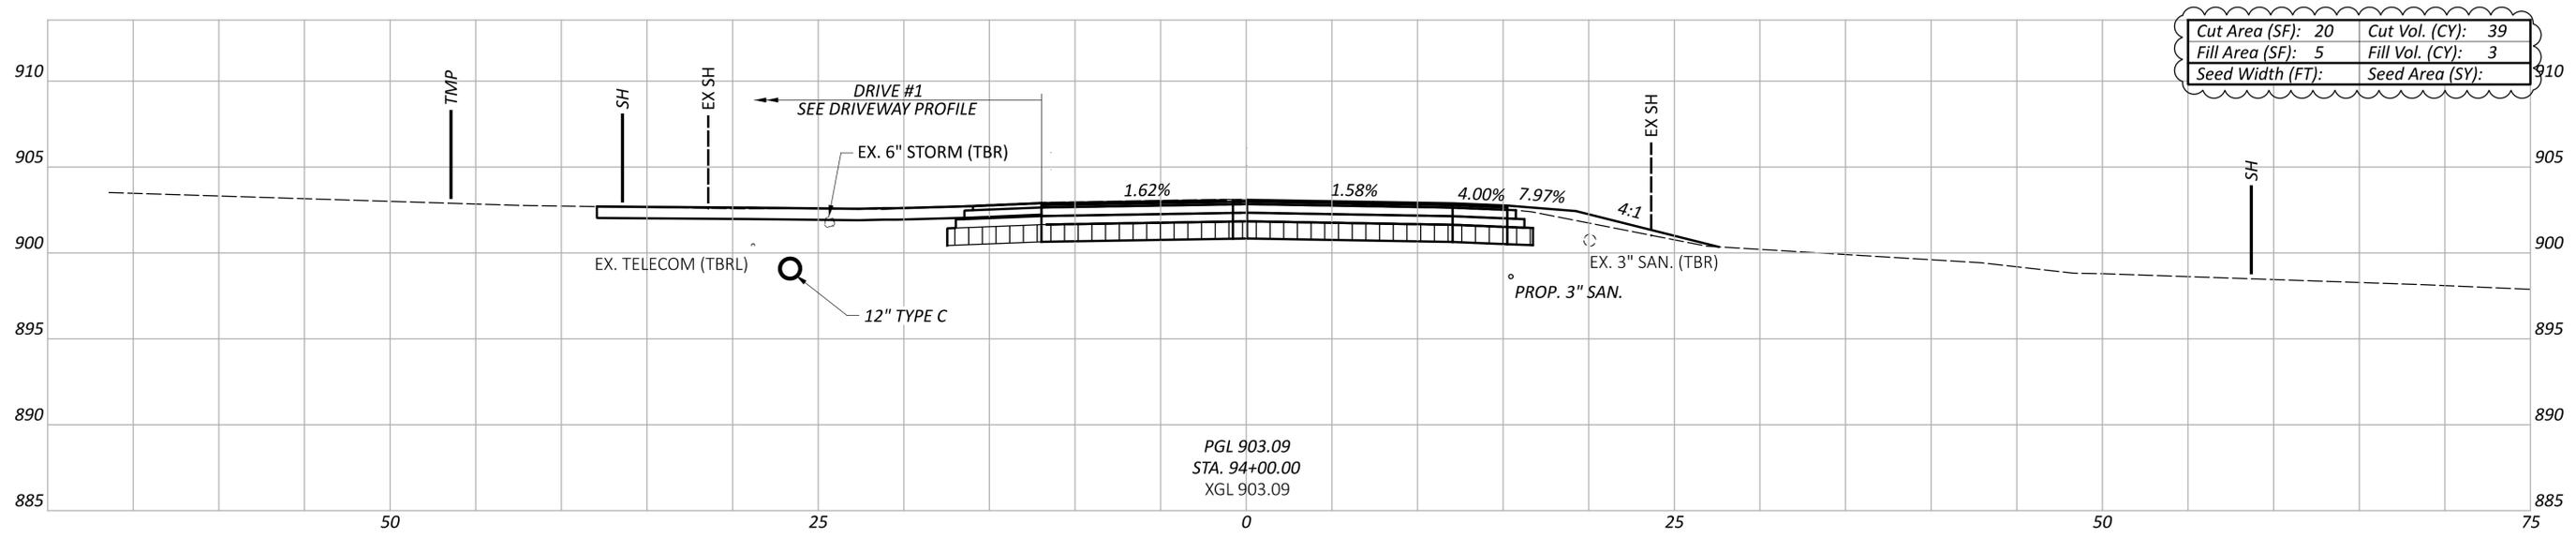

Cut Area (SF): 20	Cut Vol. (CY): 39
Fill Area (SF): 5	Fill Vol. (CY): 3
Seed Width (FT):	Seed Area (SY):

PGL 903.09
 STA. 94+00.00
 XGL 903.09

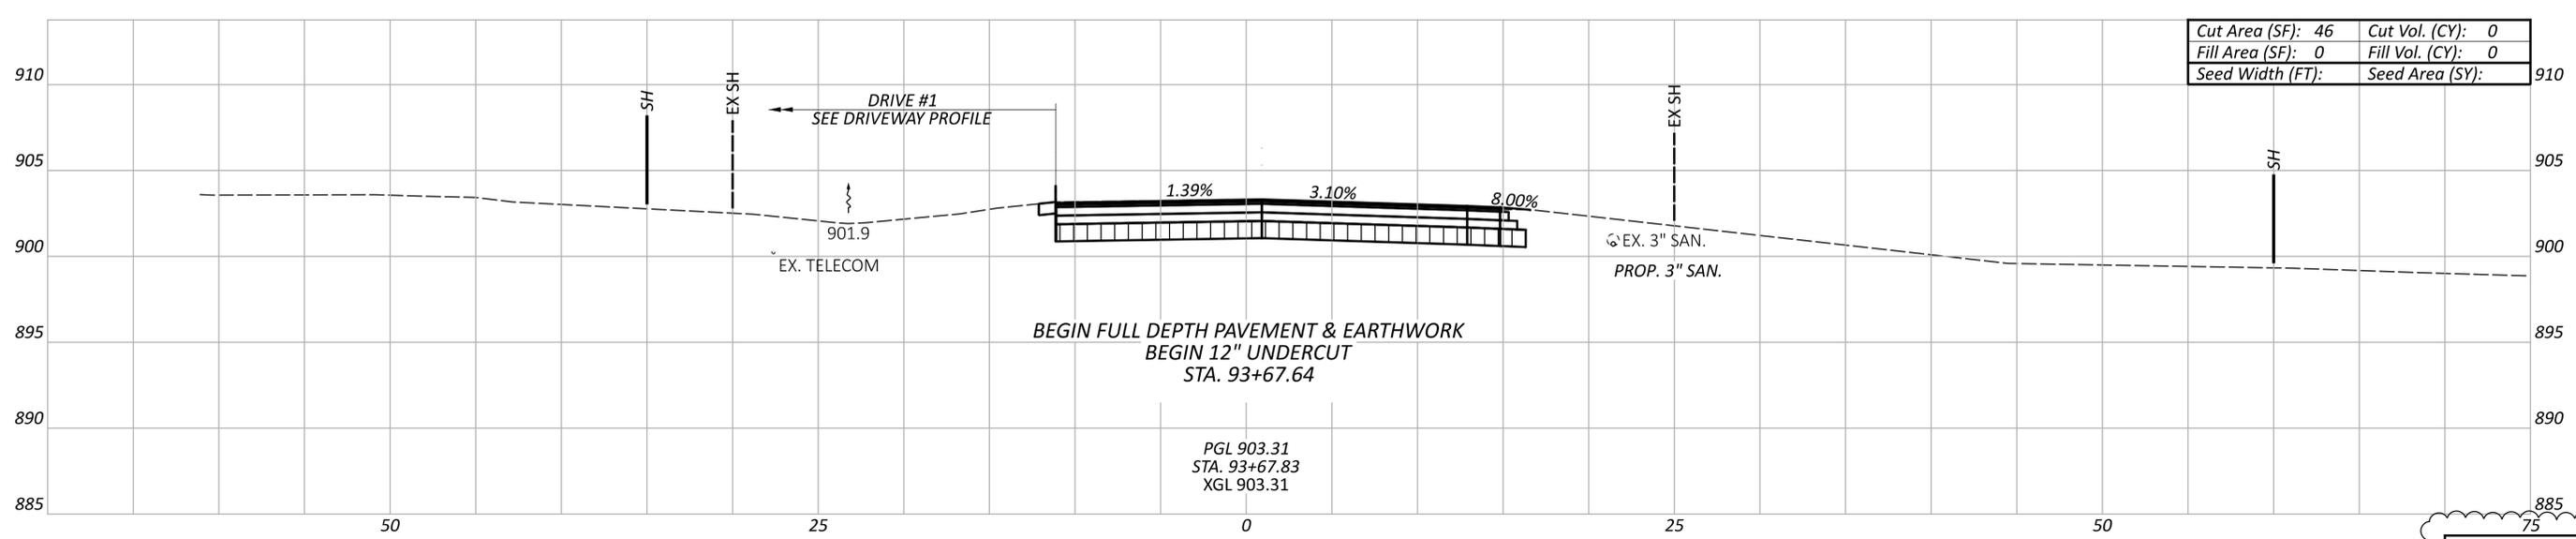

Cut Area (SF): 46	Cut Vol. (CY): 0
Fill Area (SF): 0	Fill Vol. (CY): 0
Seed Width (FT):	Seed Area (SY):

BEGIN FULL DEPTH PAVEMENT & EARTHWORK
 BEGIN 12" UNDERCUT
 STA. 93+67.64

PGL 903.31
 STA. 93+67.83
 XGL 903.31

CROSS SECTIONS - THAYER ROAD (SOUTH LEG)
 STA. 93+67.83 TO STA. 94+50.00

DESIGN AGENCY

 WSP USA, Inc.
 2 Miranova Pl,
 Suite 450
 Columbus, OH 43215

DESIGNER
 KAB


REVIEWER
 ABS 07/30/24

PROJECT ID
 117742

Sheet Totals			SHEET TOTAL
Seeding	Cut	Fill	
*	103	33	107

ALL-81-22.23


MODEL: CLP_THAYERS - 95+00.00 [Sheet] PAPER SIZE: 34x22 (in.) DATE: 5/21/2025 TIME: 5:19:14 PM USER: Coffield
 pw:\ohiodot-pw-bentley.com\ohiodot-pw-02\Documents\01 Active Projects\District 01\Allen\117742\401-Engineering_WSP\Roadway\Sheets\117742_X5003.dgn

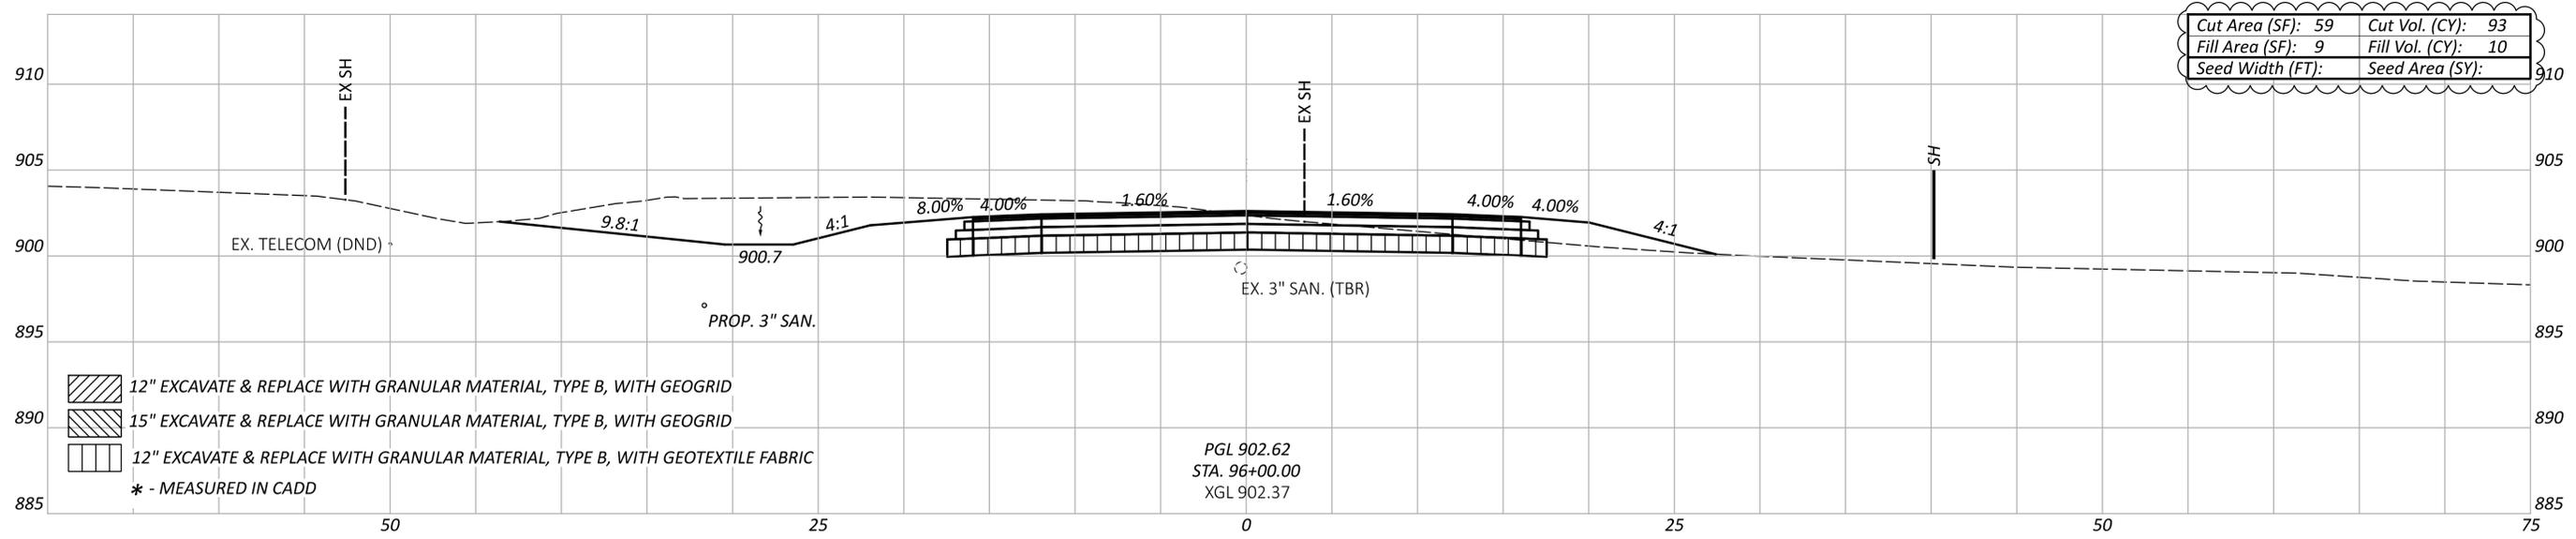

Cut Area (SF): 59	Cut Vol. (CY): 93
Fill Area (SF): 9	Fill Vol. (CY): 10
Seed Width (FT):	Seed Area (SY):


- 12" EXCAVATE & REPLACE WITH GRANULAR MATERIAL, TYPE B, WITH GEOGRID
- 15" EXCAVATE & REPLACE WITH GRANULAR MATERIAL, TYPE B, WITH GEOGRID
- 12" EXCAVATE & REPLACE WITH GRANULAR MATERIAL, TYPE B, WITH GEOTEXTILE FABRIC
- * - MEASURED IN CADD

PGL 902.62
 STA. 96+00.00
 XGL 902.37

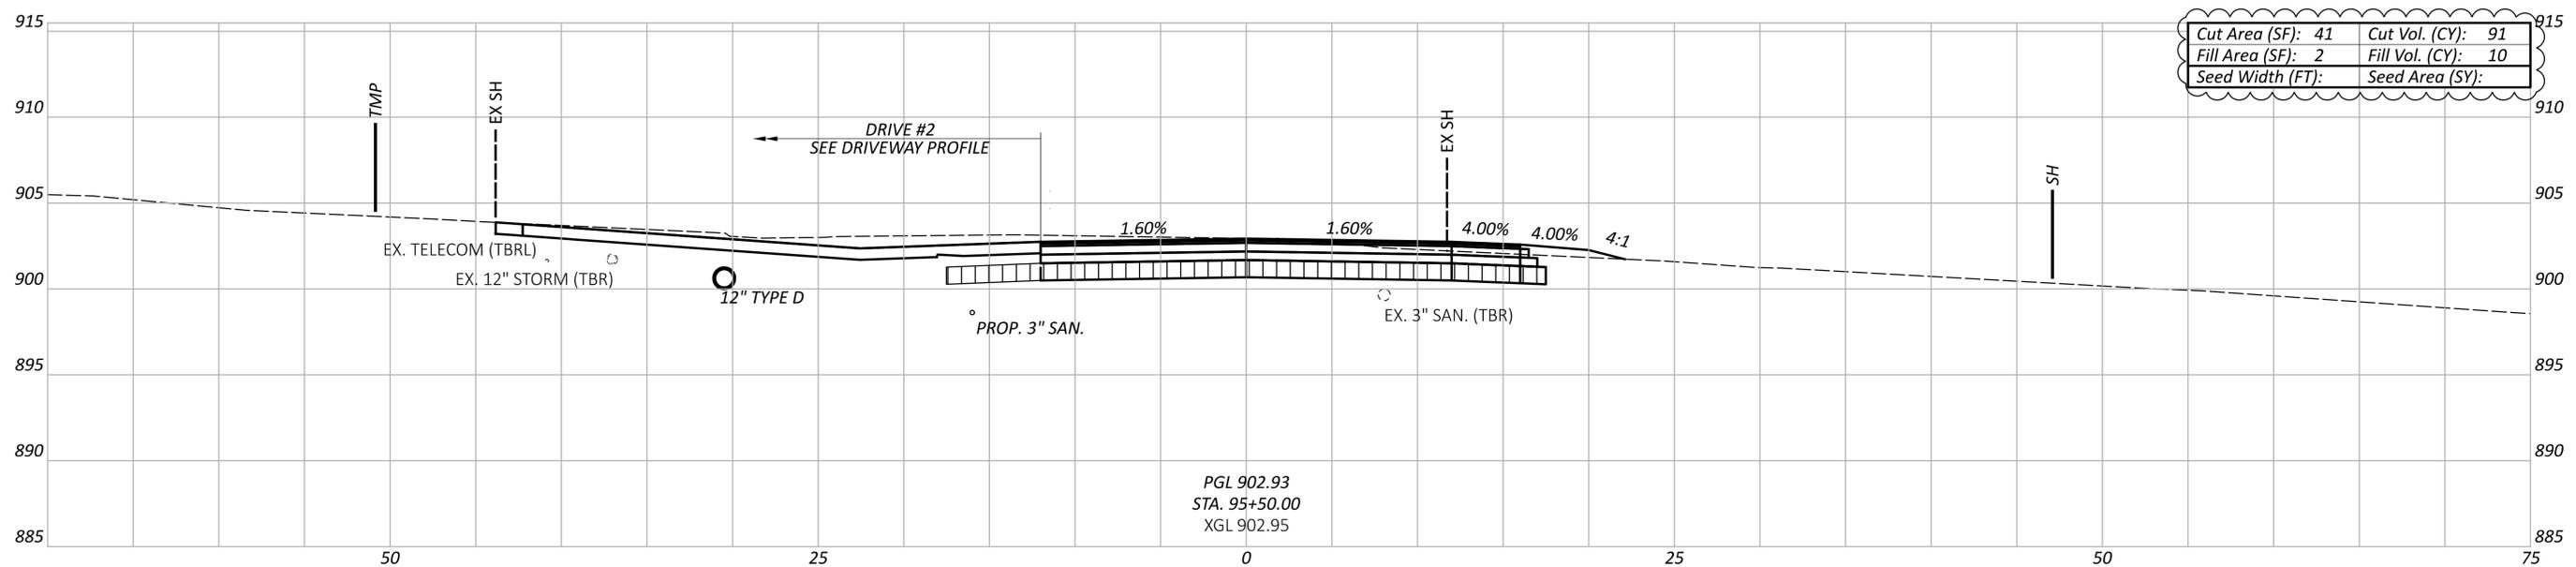

Cut Area (SF): 41	Cut Vol. (CY): 91
Fill Area (SF): 2	Fill Vol. (CY): 10
Seed Width (FT):	Seed Area (SY):

PGL 902.93
 STA. 95+50.00
 XGL 902.95

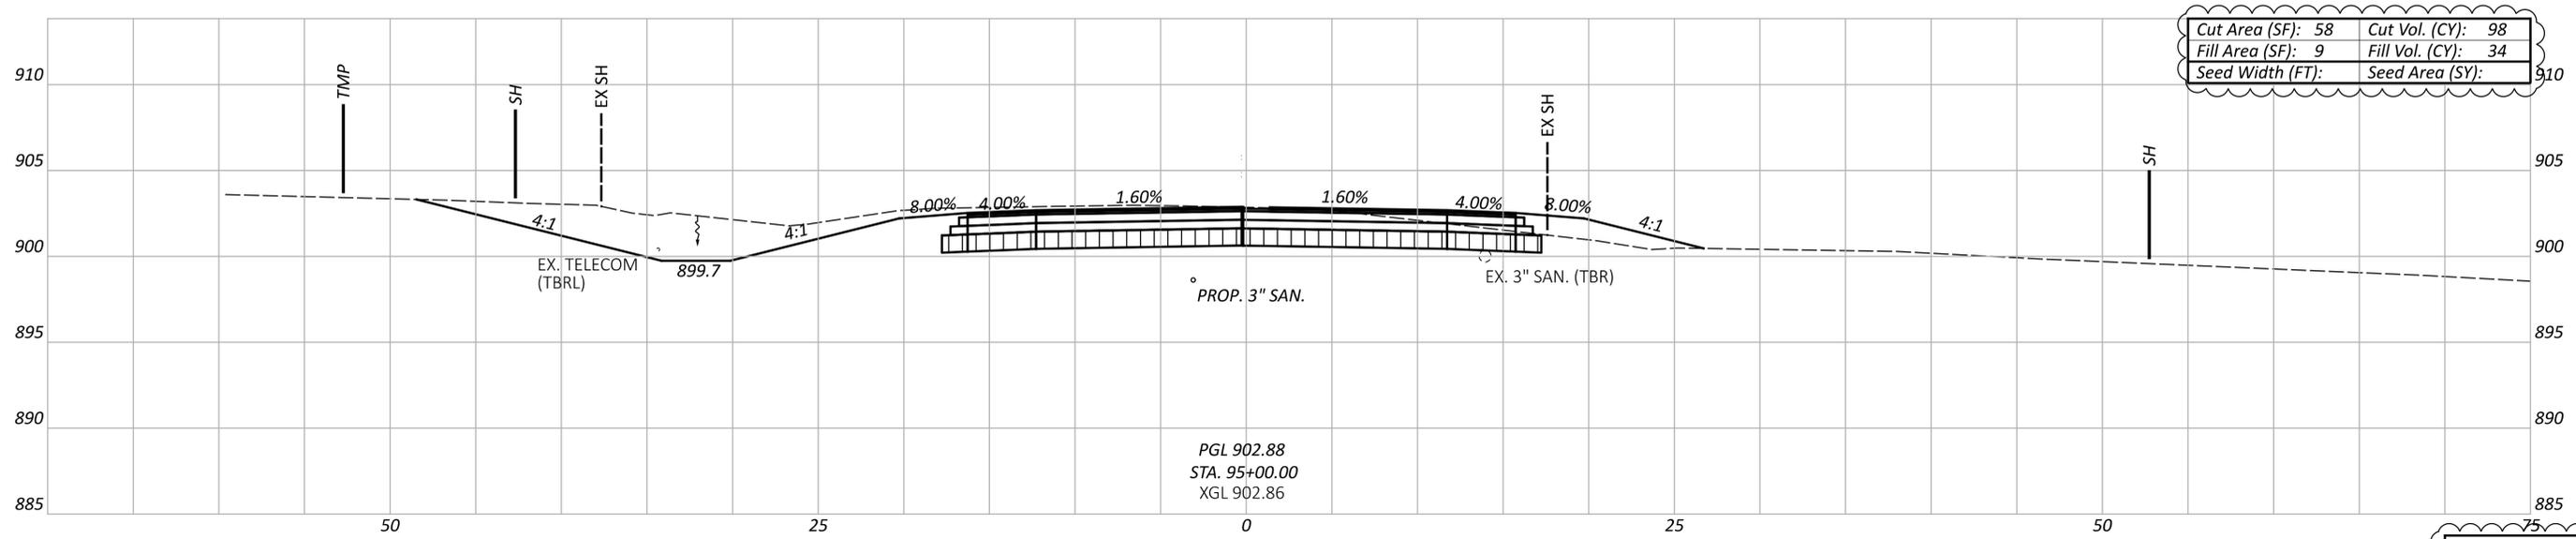

Cut Area (SF): 58	Cut Vol. (CY): 98
Fill Area (SF): 9	Fill Vol. (CY): 34
Seed Width (FT):	Seed Area (SY):

PGL 902.88
 STA. 95+00.00
 XGL 902.86

CROSS SECTIONS - THAYER ROAD (SOUTH LEG)
 STA. 95+00.00 TO STA. 96+00.00

DESIGN AGENCY

 WSP USA, Inc.
 2 Miranova Pl,
 Suite 450
 Columbus, OH 43215

DESIGNER
 KAB
 REVIEWER
 ABS 07/30/24

PROJECT ID
 117742




Sheet Totals			117742	
Seeding	Cut	Fill	SHEET	TOTAL
*	282	54	P.67	107

ALL-81-22.23

MODEL: CLP_THAYERS - 96+50.00 [Sheet] PAPER SIZE: 34x22 (in.) DATE: 5/21/2025 TIME: 5:19:19 PM USER: Coffield
 pw:\ohiodot-pw-bentley.com\ohiodot-pw-02\Documents\01-Active Projects\District 01\Allen\117742\401-Engineering_WSP\Roadway\Sheets\117742_XS003.dgn

-  12" EXCAVATE & REPLACE WITH GRANULAR MATERIAL, TYPE B, WITH GEOGRID
-  15" EXCAVATE & REPLACE WITH GRANULAR MATERIAL, TYPE B, WITH GEOGRID
-  12" EXCAVATE & REPLACE WITH GRANULAR MATERIAL, TYPE B, WITH GEOTEXTILE FABRIC

* - MEASURED IN CADD

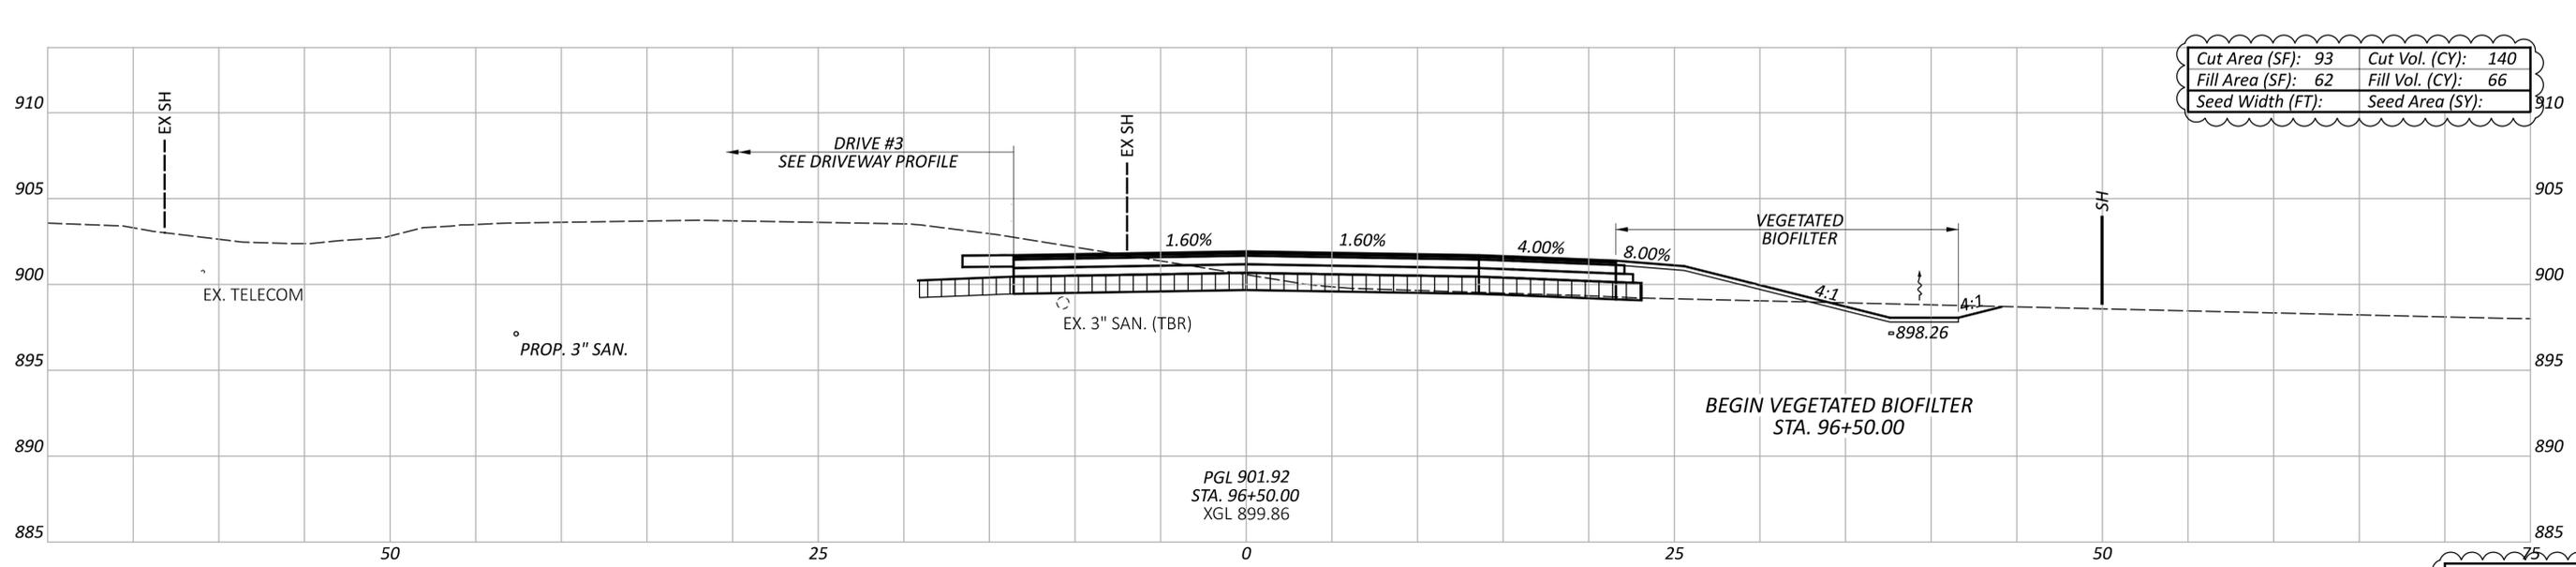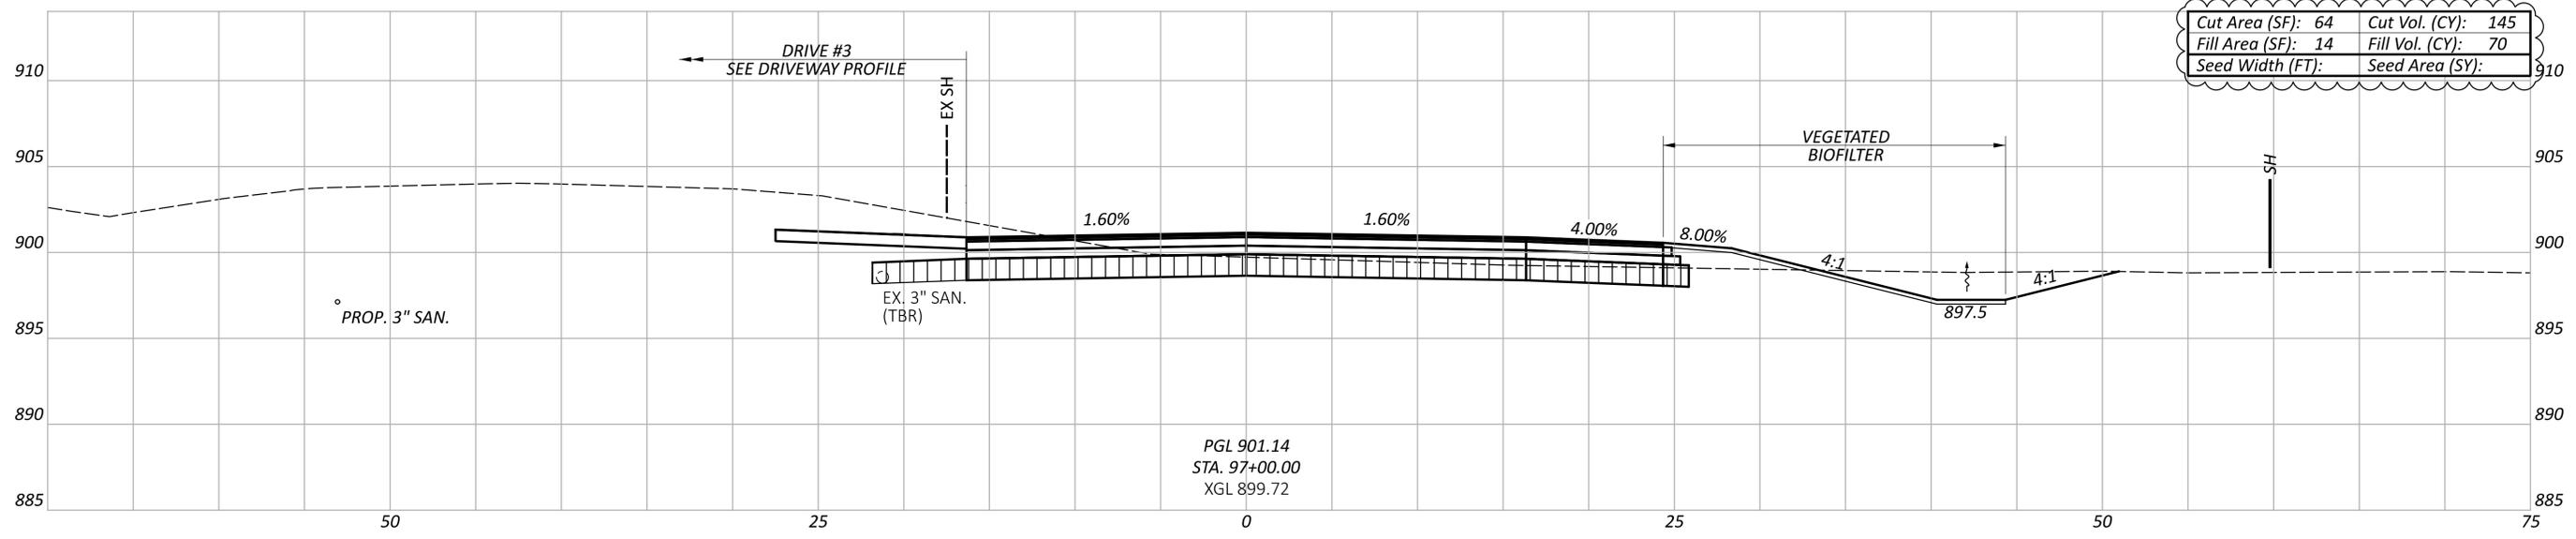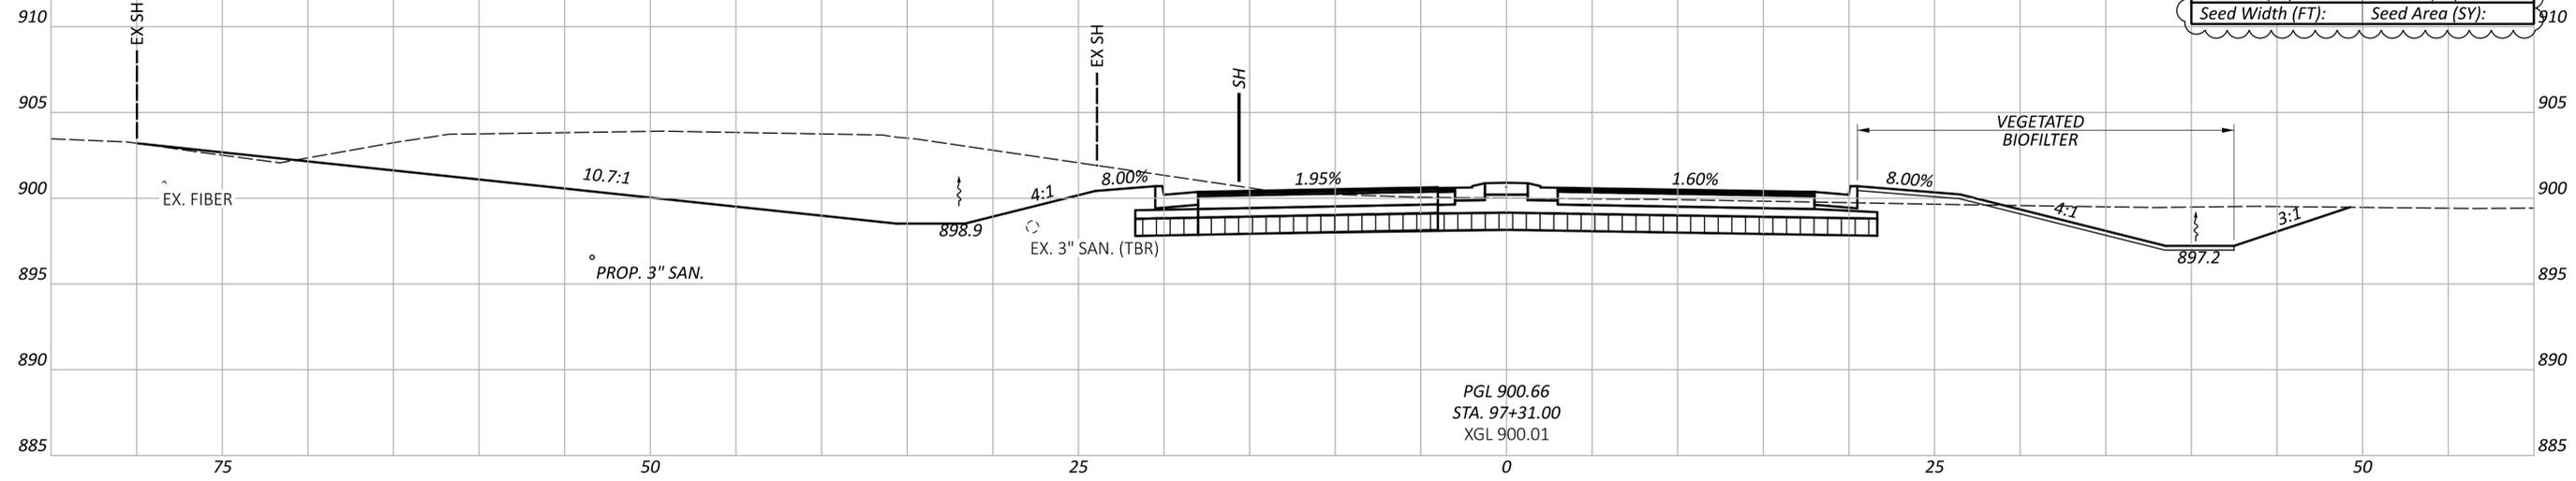

Sheet Totals			117742
Seeding	Cut	Fill	TOTAL
*	623	145	P.68 107

CROSS SECTIONS - THAYER ROAD (SOUTH LEG)
 STA. 96+50.00 TO STA. 97+30.07

DESIGN AGENCY




 WSP USA, Inc.
 2 Miranova Pl,
 Suite 450
 Columbus, OH 43215

DESIGNER
 KAB

REVIEWER
 ABS 07/30/24

PROJECT ID
 117742

- 12" EXCAVATE & REPLACE WITH GRANULAR MATERIAL, TYPE B, WITH GEOGRID
 - 15" EXCAVATE & REPLACE WITH GRANULAR MATERIAL, TYPE B, WITH GEOGRID
 - 12" EXCAVATE & REPLACE WITH GRANULAR MATERIAL, TYPE B, WITH GEOTEXTILE FABRIC
- * - MEASURED IN CADD

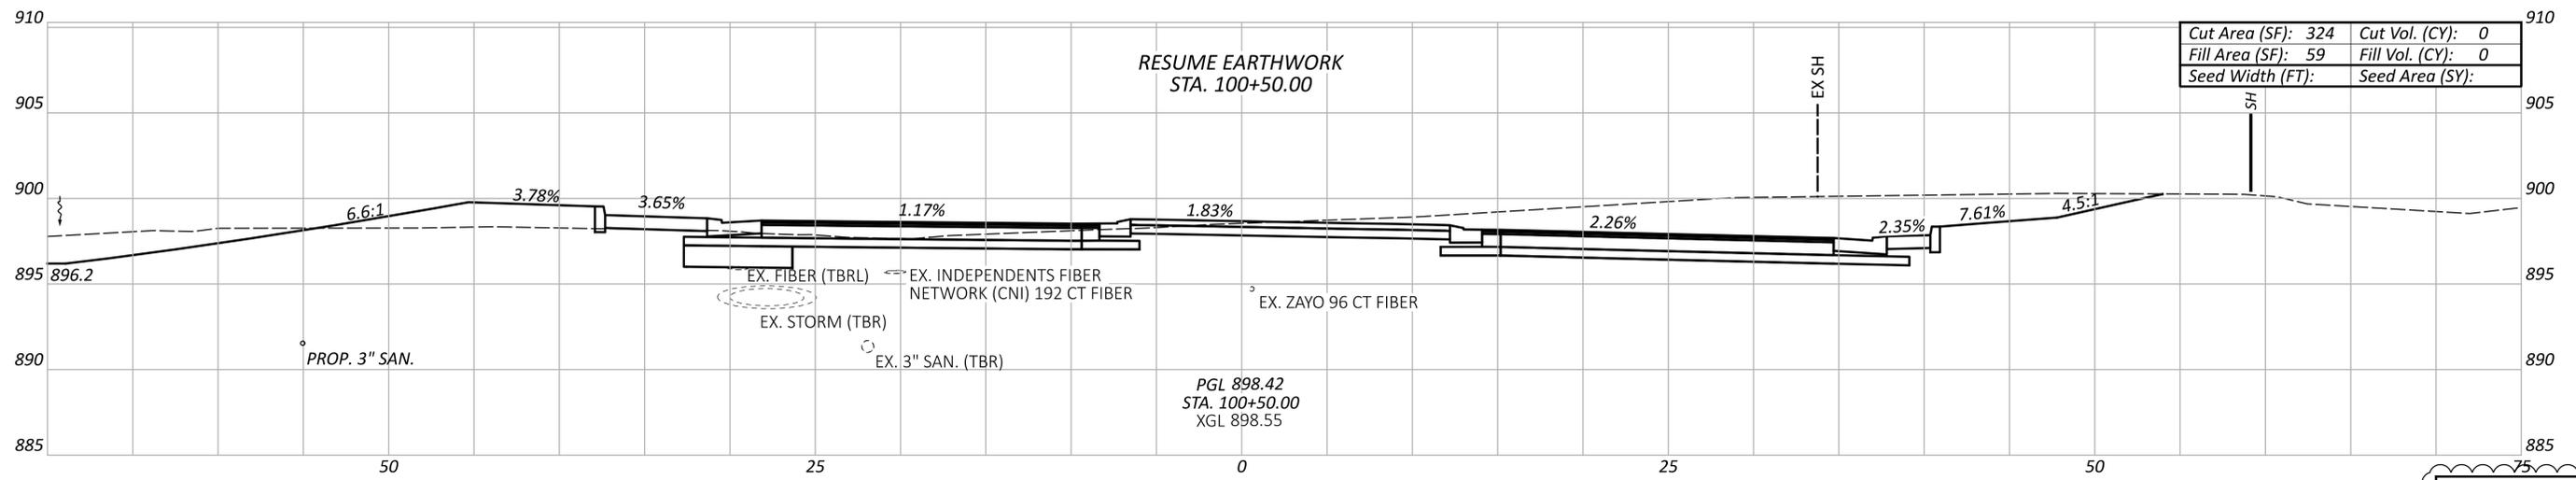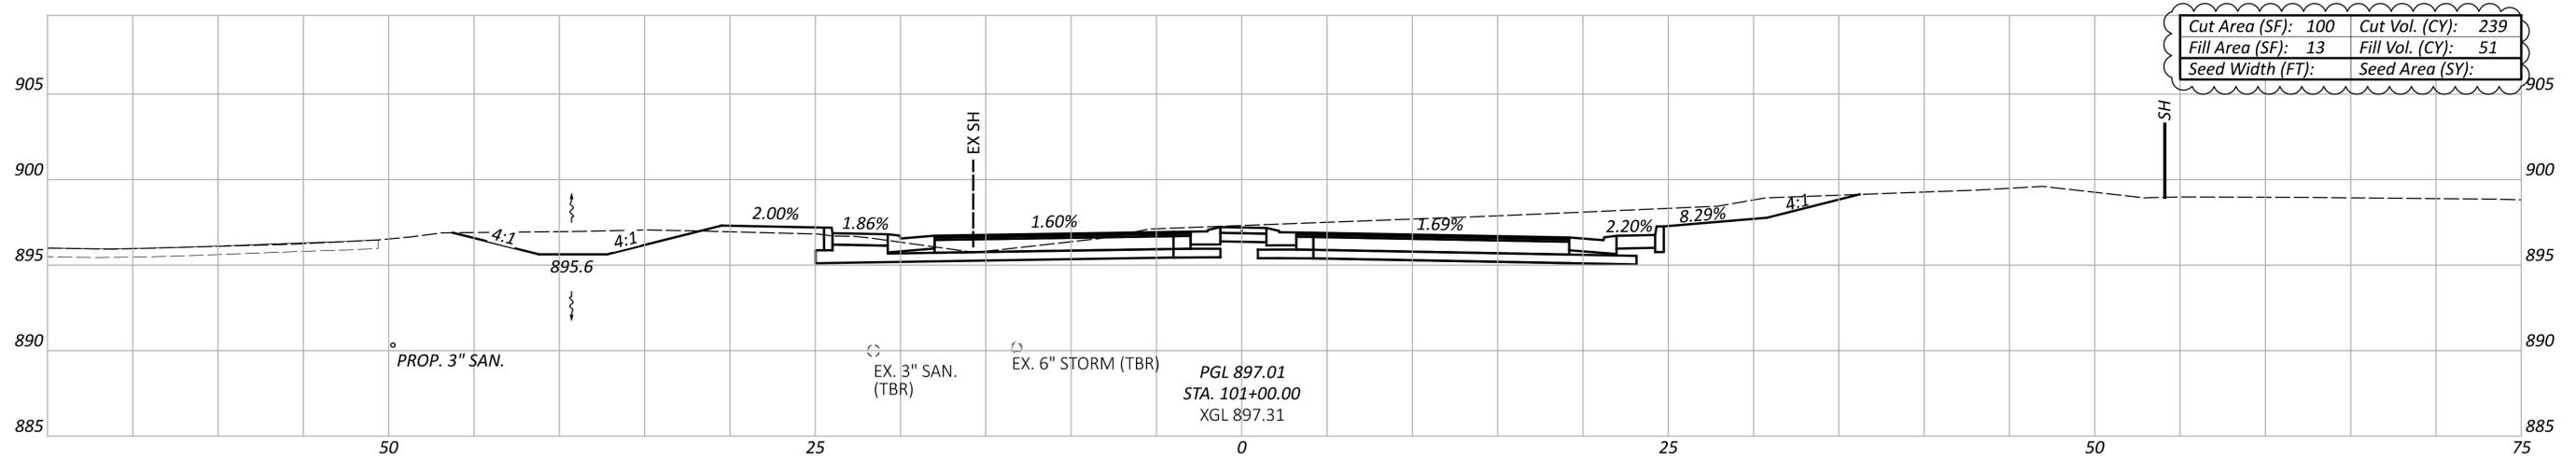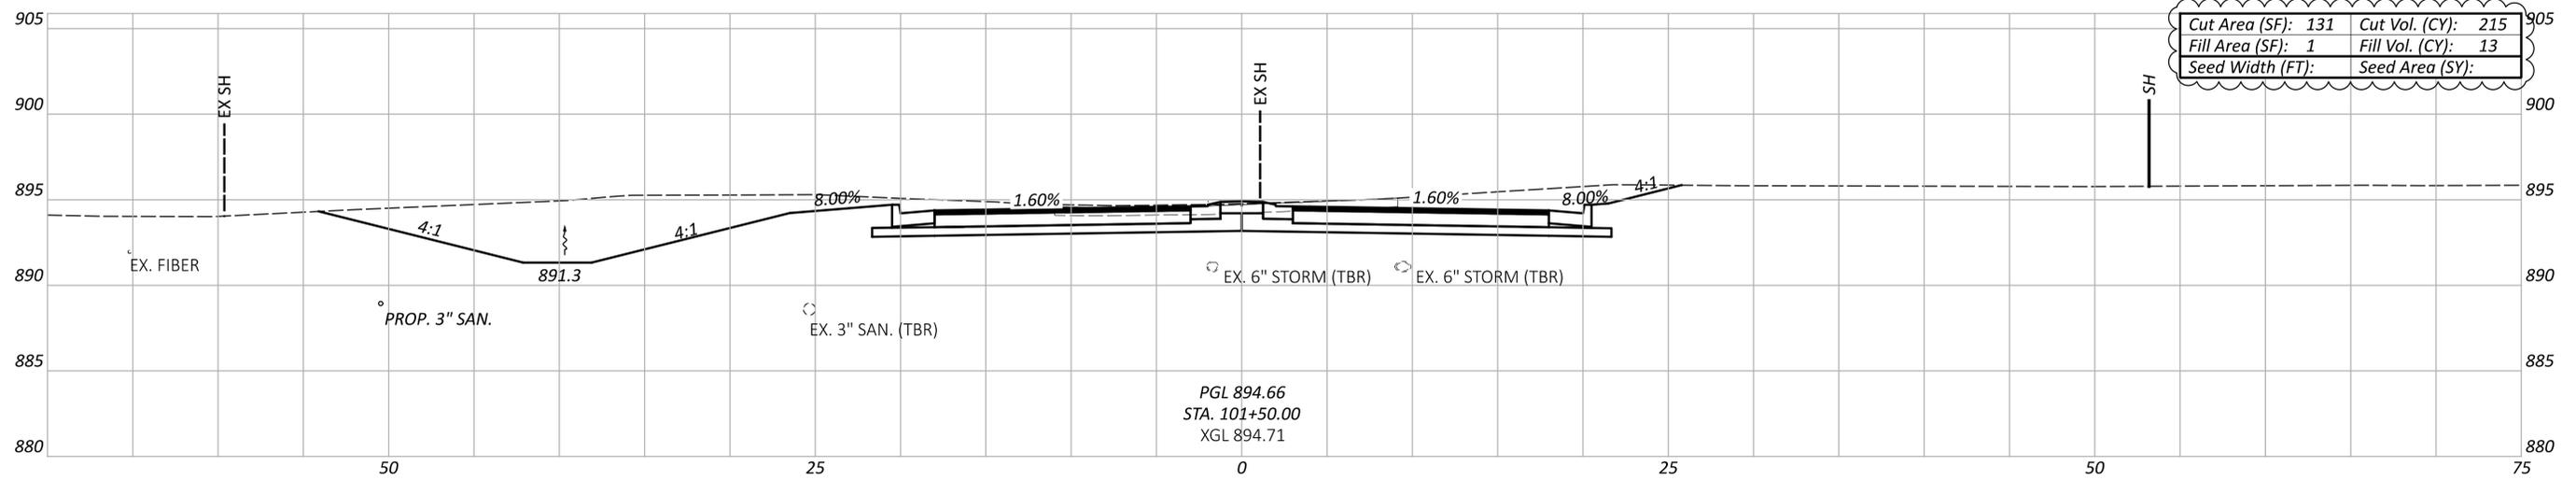

**CROSS SECTIONS - THAYER ROAD (NORTH LEG)
STA. 100+50.00 TO STA. 101+50.00**

ALL-81-22.23

MODEL: CLP_THAYERN - 100+50.00 [Sheet] PAPER SIZE: 34x42 (in.) DATE: 5/21/2025 TIME: 5:21:01 PM USER: Coffield
pw:\ohiodoc-pw.bentley.com\ohiodoc-pw-02\Documents\01 Active Projects\District 01\Allen\117742\401-Engineering_WSP\Roadway\Sheets\117742_X5004.dgn

DESIGN AGENCY
WSP
WSP USA, Inc.
2 Miranova Pl,
Suite 450
Columbus, OH 43215

DESIGNER
KAB
REVIEWER
ABS 07/30/24




PROJECT ID
117742
SHEET TOTAL
P.71 107

Sheet Totals		
Seeding	Cut	Fill
*	454	64

ALL-81-22.23

MODEL: CLP_THAYERN - 102+00.00 (Sheet) PAPER SIZE: 34x42 (in.) DATE: 5/21/2025 TIME: 5:21:08 PM USER: Coffield
 pw:\ohiodoc-pw.bentley.com\ohiodoc-pw-02\Documents\01 Active Projects\District 01\Allen\117742\401-Engineering_WSP\Roadway\Sheets\117742_X5004.dgn

-  12" EXCAVATE & REPLACE WITH GRANULAR MATERIAL, TYPE B, WITH GEOGRID
-  15" EXCAVATE & REPLACE WITH GRANULAR MATERIAL, TYPE B, WITH GEOGRID
-  12" EXCAVATE & REPLACE WITH GRANULAR MATERIAL, TYPE B, WITH GEOTEXTILE FABRIC
- * - MEASURED IN CADD

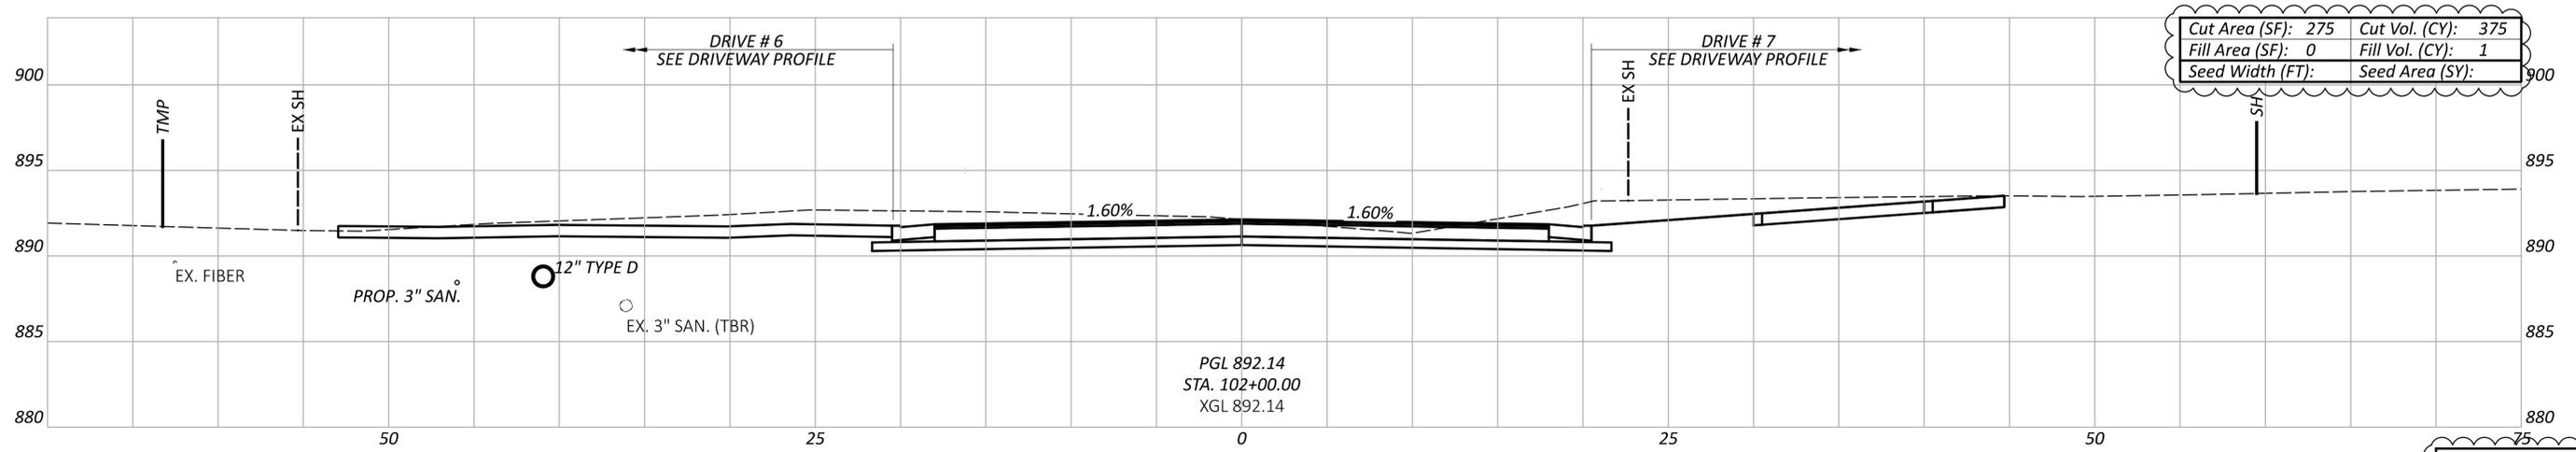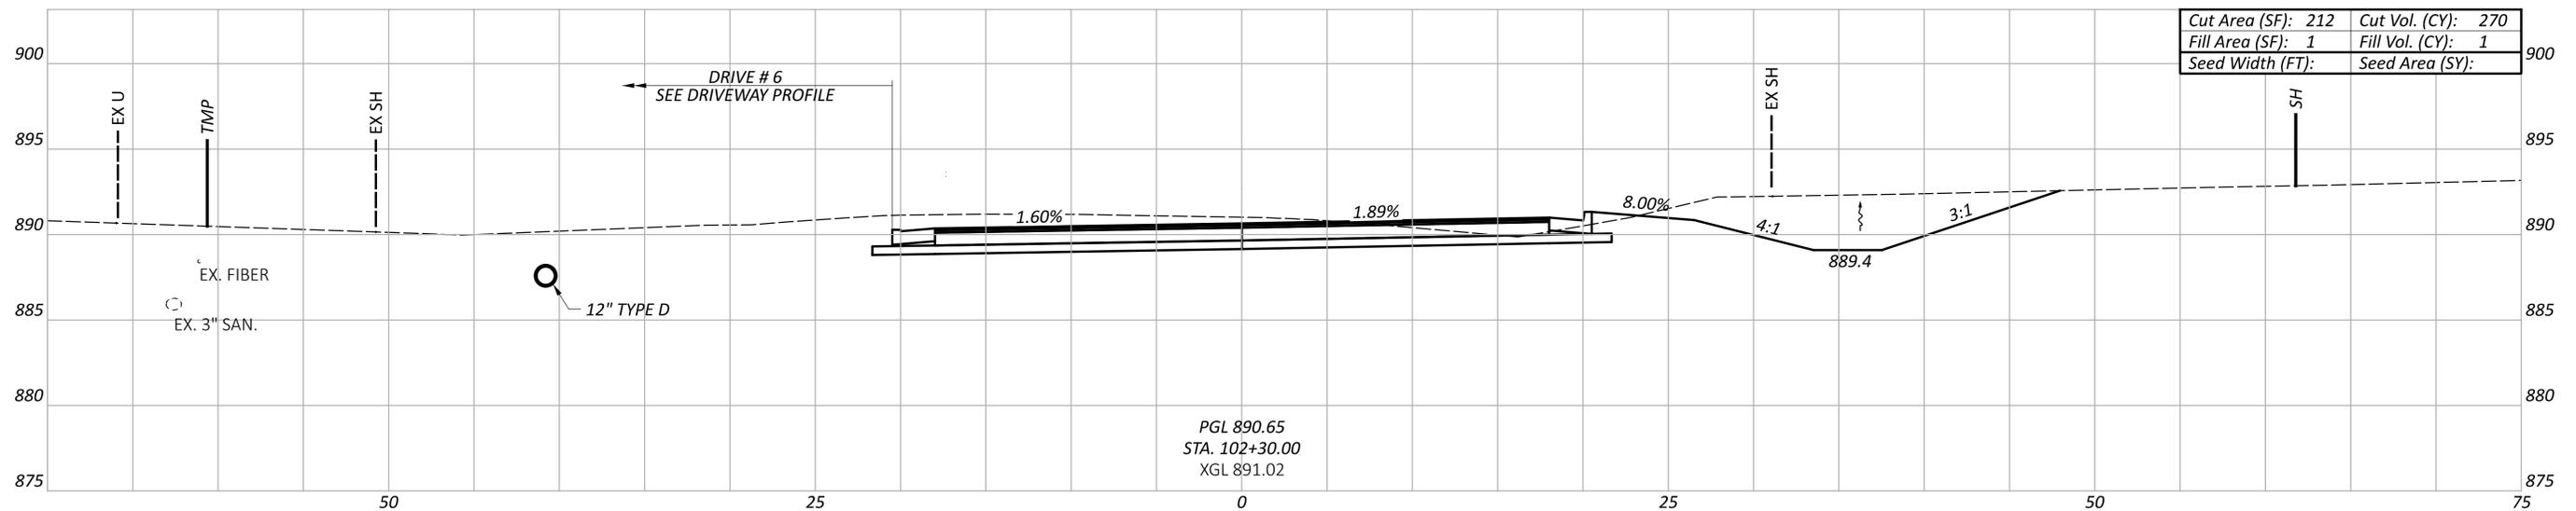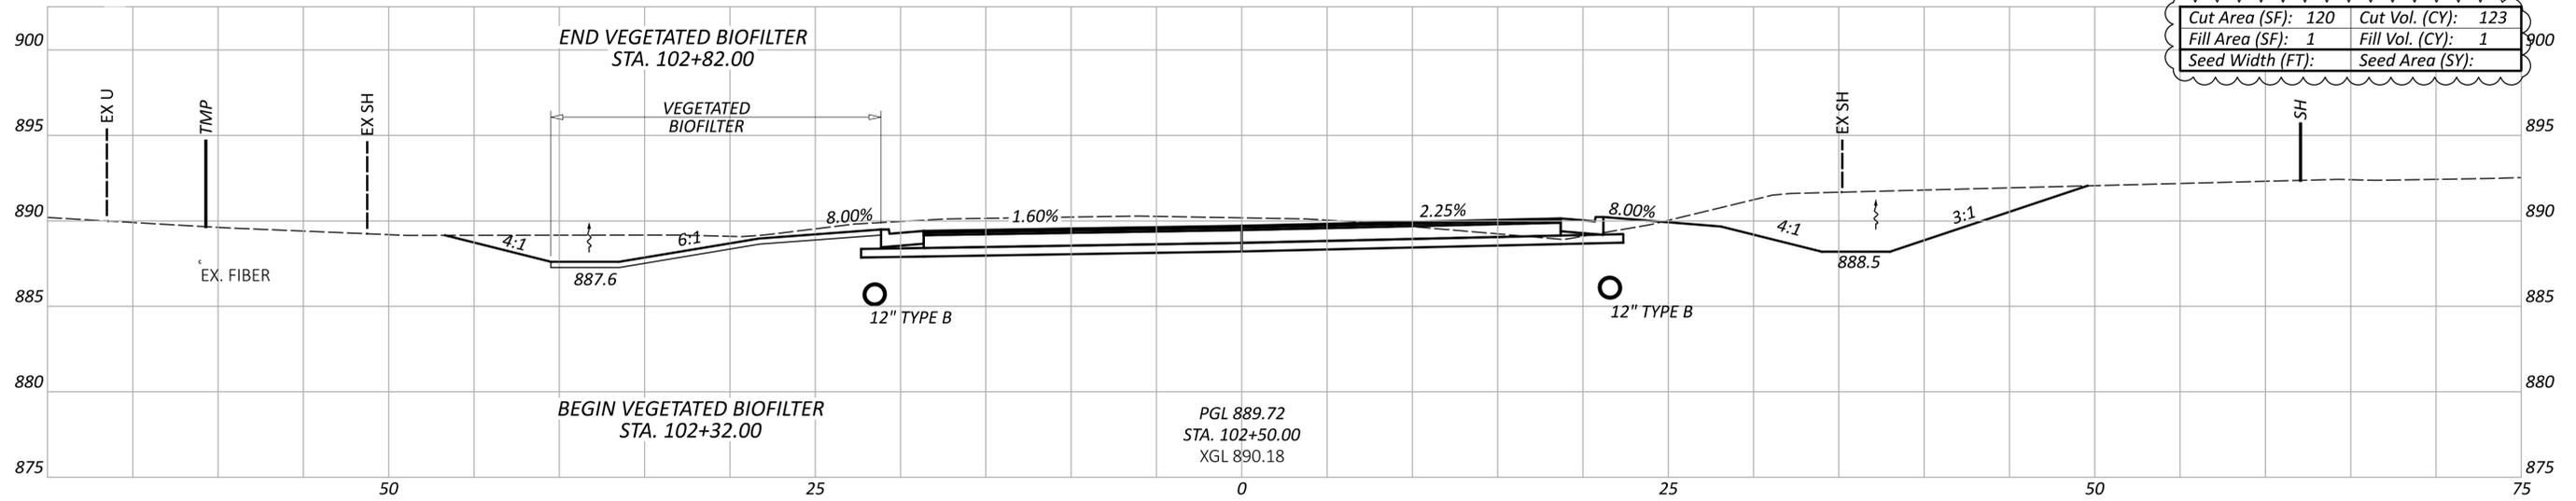

Sheet Totals			117742
Seeding	Cut	Fill	TOTAL
*	768	3	P.72 107

CROSS SECTIONS - THAYER ROAD (NORTH LEG)
 STA. 102+00.00 TO STA. 102+50.00

DESIGN AGENCY




 WSP USA, Inc.
 2 Miranova Pl,
 Suite 450
 Columbus, OH 43215

DESIGNER
 KAB
 REVIEWER
 ABS 07/30/24

PROJECT ID
 117742
 SHEET TOTAL
 P.72 | 107

ALL-81-22.23

MODEL: CLP_THAYERN - 103+00.00 [Sheet] PAPER SIZE: 34x42 (in.) DATE: 5/22/2025 TIME: 8:59:35 AM USER: coffield
 pw:\ohiodoc-pw.bentley.com\ohiodoc-pw-02\Documents\01 Active Projects\District 01\Allen\117742\401-Engineering_WSP\Roadway\Sheets\117742_X5004.dgn

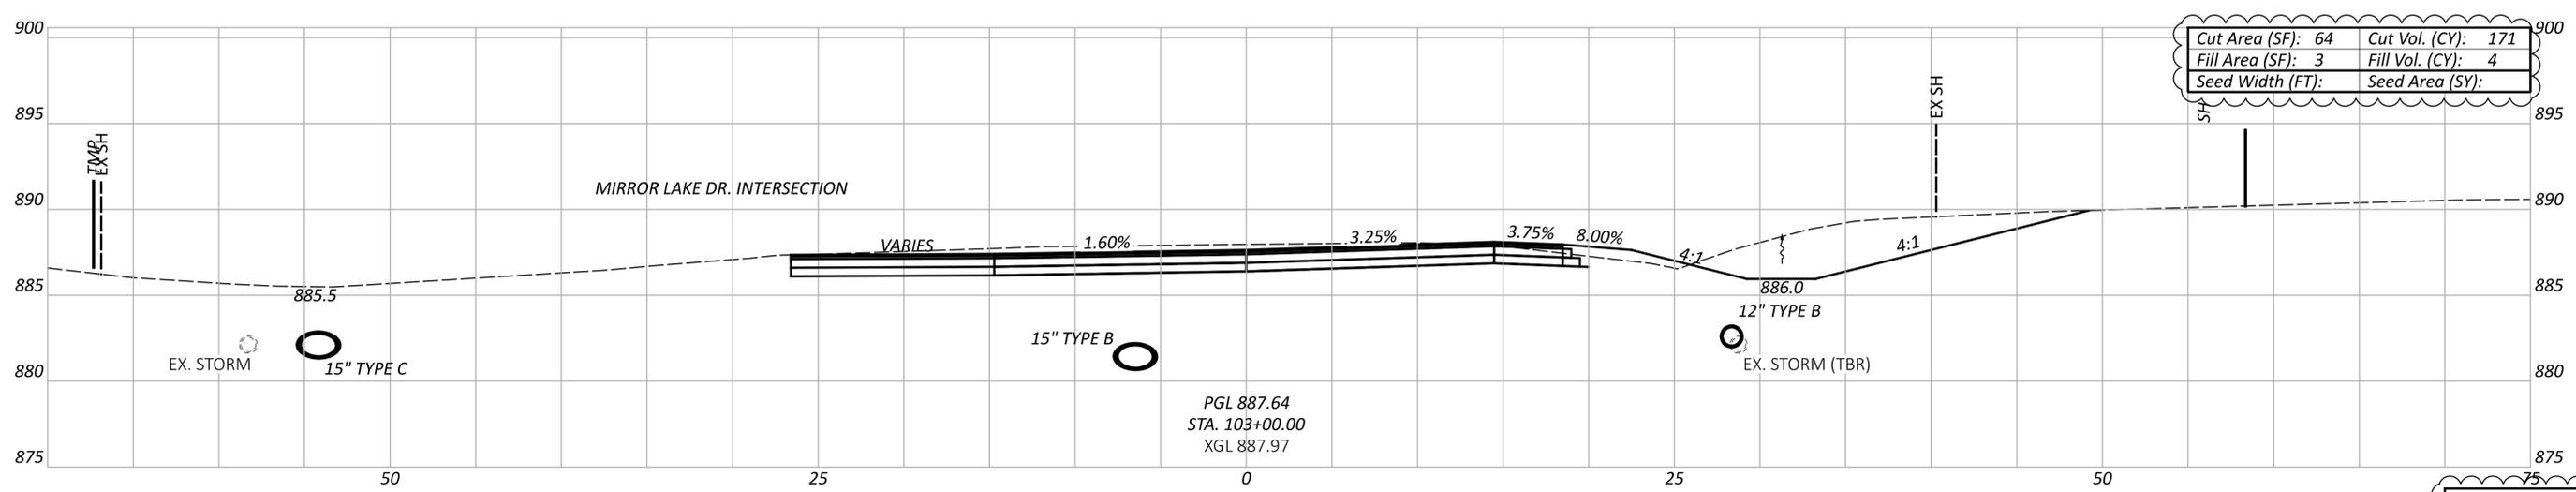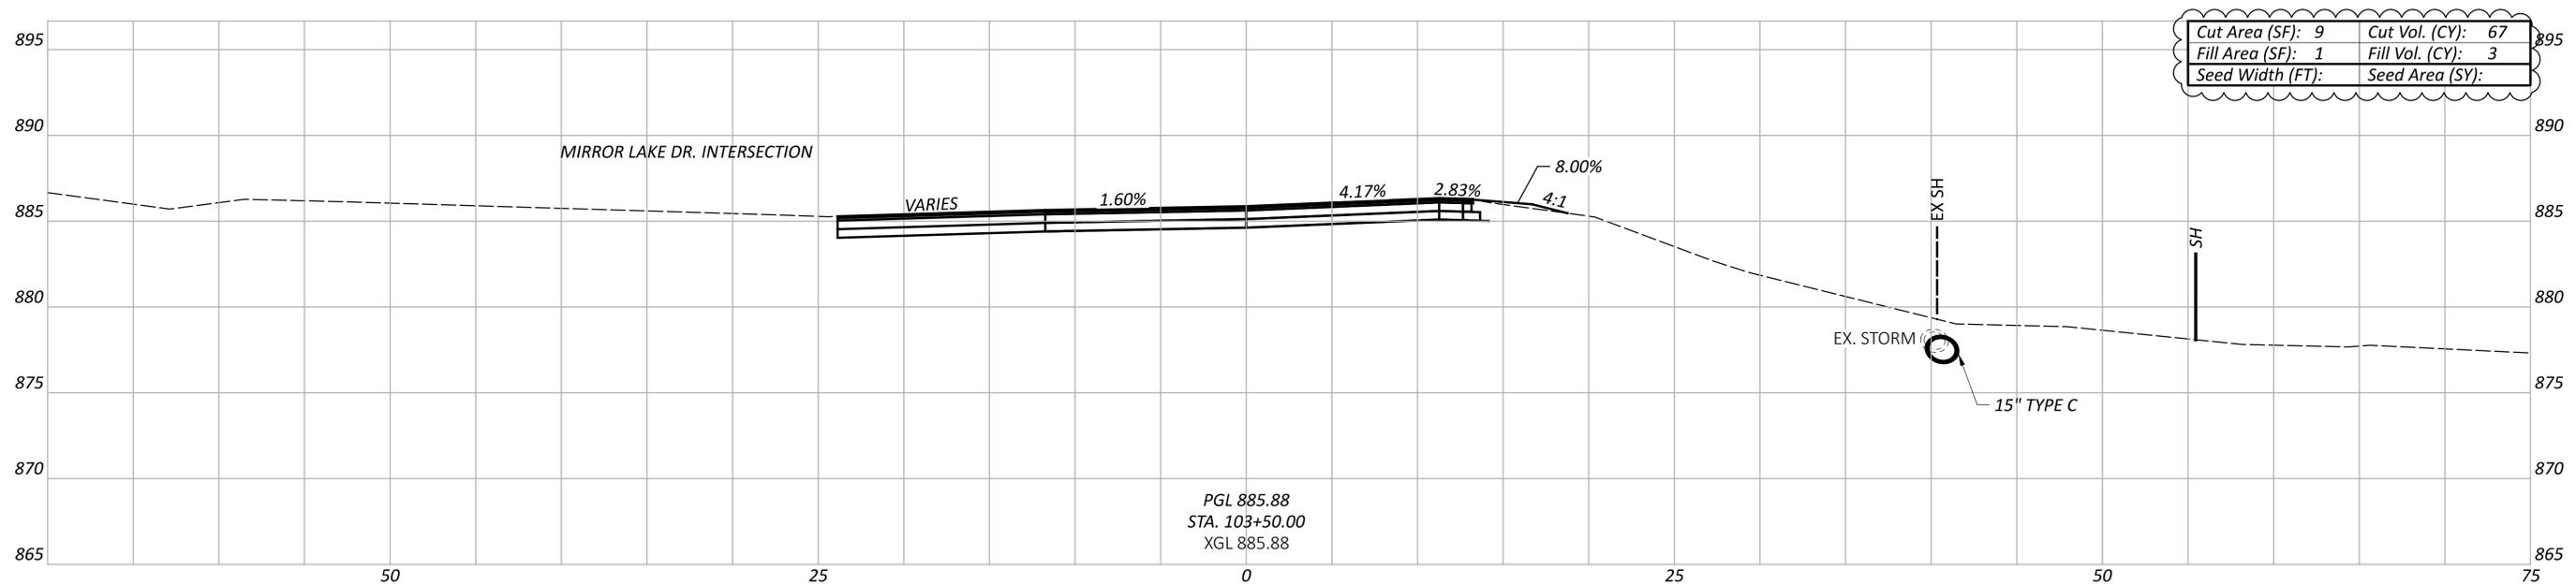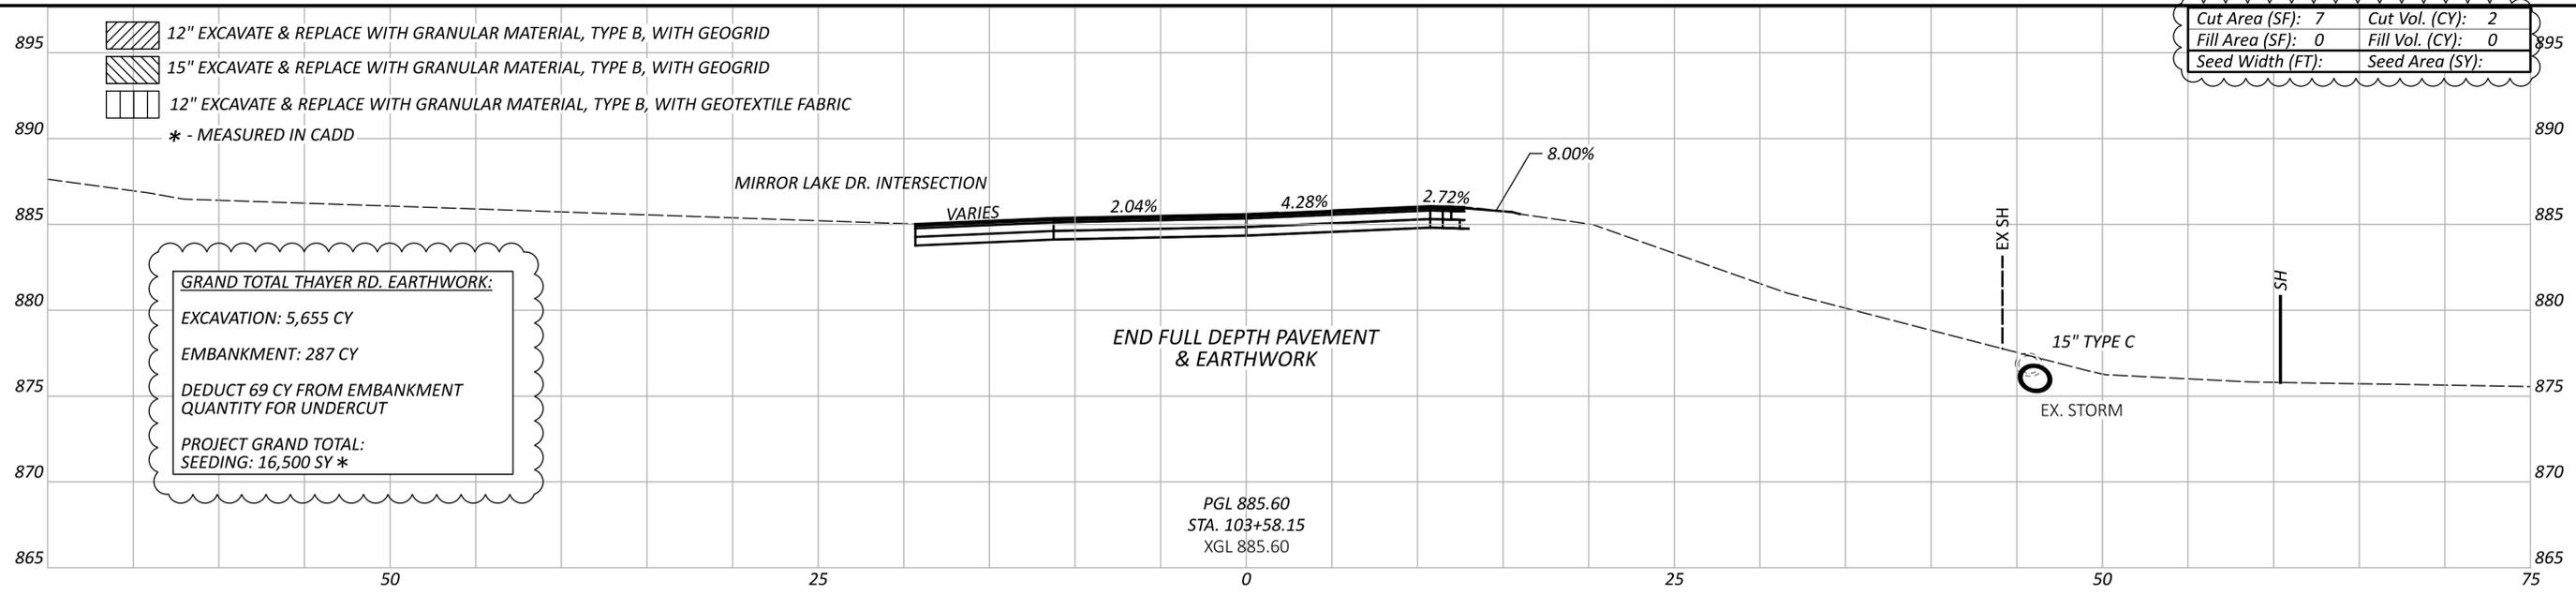

Sheet Totals			117742	
Seeding	Cut	Fill	SHEET	TOTAL
*	240	7	P.73	107

CROSS SECTIONS - THAYER ROAD (NORTH LEG)
 STA. 103+00.00 TO STA. 103+58.15

DESIGN AGENCY

 WSP USA, Inc.
 2 Miranova Pl,
 Suite 450
 Columbus, OH 43215

DESIGNER
 KAB

REVIEWER
 ABS 07/30/24

PROJECT ID
 117742