

STATE OF OHIO DEPARTMENT OF TRANSPORTATION

ATB-90-19.56

CITY OF CONNEUAT
KINGSVILLE TOWNSHIP

ASHTABULA COUNTY

FEDERAL PROJECT NUMBER

E220289

RAILROAD INVOLVEMENT


NONE

PROJECT DESCRIPTION

RESURFACING OF ATB IR 90 IN ASHTABULA FROM 19.56 TO 22.71

EARTH DISTURBED AREAS

PROJECT EDA:	N/A
ESTIMATED CONTRACTOR EDA:	0.25 ACRES
NOTICE OF INTENT EDA:	N/A

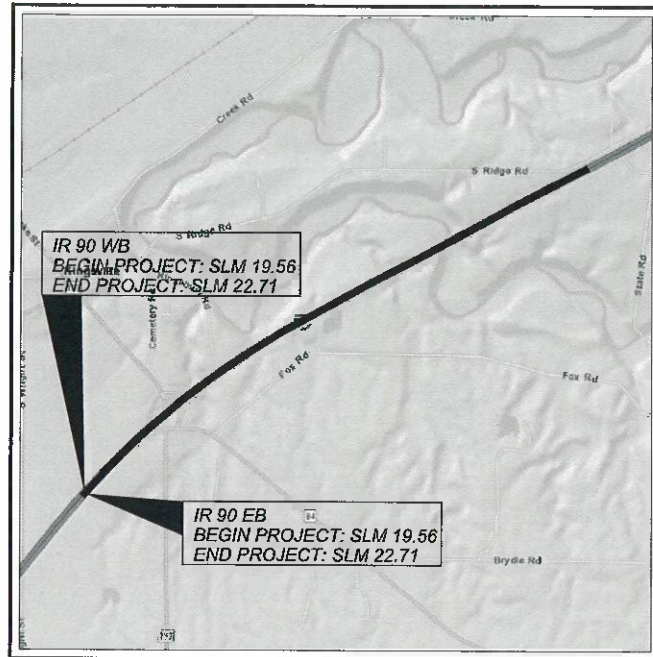

LOCATION MAP

LATITUDE: 41°53'17" N LONGITUDE: 80°39'09" W



PORTION TO BE IMPROVED	_____	=====
INTERSTATE HIGHWAY	_____	=====
FEDERAL ROUTES	_____	=====
STATE ROUTES	_____	=====
COUNTY & TOWNSHIP ROADS	_____	=====
OTHER ROADS	_____	=====

DESIGN DESIGNATION

DESIGN FUNCTIONAL CLASSIFICATION:
RURAL FREEWAYS AND EXPRESSWAYS
NHS PROJECT _____ YES

DESIGN EXCEPTIONS

NONE

ADA DESIGN WAIVERS

N/A

UNDERGROUND UTILITIES
Contact Two Working Days
Before You Dig

OHIO811.org
Before You Dig

OHIO811, 8-1-1, or 1-800-362-2764
(Non members must be called directly)

PLAN PREPARED BY:
ODOT DISTRICT 4- CAPITAL PLANNING
2088 SOUTH ARLINGTON ROAD
AKRON, OHIO 44306

INDEX OF SHEETS:

TITLE SHEET	P.1	
TYPICAL SECTIONS	P.2	
GENERAL NOTES	P.3A	
MAINTENANCE OF TRAFFIC	P.4-P.5	sheet 3A added
GENERAL SUMMARY	P.6	
RPM SUBSUMMARY	P.7	
PAVEMENT MARKINGS SUBSUMMARY	P.8	
PAVEMENT CALCULATIONS	P.9	

2019 SPECIFICATIONS

THE STANDARD SPECIFICATIONS OF THE STATE OF OHIO, DEPARTMENT OF TRANSPORTATION, INCLUDING SUPPLEMENTAL SPECIFICATIONS LISTED IN THE PLANS AND CHANGES LISTED IN THE PROPOSAL SHALL GOVERN THIS IMPROVEMENT.

I HEREBY APPROVE THESE PLANS AND DECLARE THAT THE MAKING OF THIS IMPROVEMENT WILL NOT REQUIRE THE CLOSING TO TRAFFIC OF THE HIGHWAY AND THAT PROVISIONS FOR THE MAINTENANCE AND SAFETY OF TRAFFIC WILL BE AS SET FORTH ON THE PLANS AND ESTIMATES.

STANDARD CONSTRUCTION DRAWINGS				SUPPLEMENTAL SPECIFICATIONS	SPECIAL PROVISIONS
BP-3.1	1/17/20	MT-101.90	7/17/20	800-2019	1/21/22
BP-3.2	1/18/19	MT-104.10	10/16/15	821	4/20/12
BP-9.1	1/18/19	MT-105.10	1/17/20	832	10/19/18
				921	4/20/12
DM-4.3	1/15/16	TC-41.20	10/18/13		
DM-4.4	1/15/16	TC-42.20	10/18/13		
		TC-52.10	10/18/13		
MT-95.30	7/19/19	TC-52.20	1/15/21		
MT-95.45	1/17/20	TC-64.10	1/17/20		
MT-95.50	7/21/17	TC-65.10	1/17/14		
MT-98.10	1/17/20	TC-65.11	7/21/17		
MT-98.11	1/17/20	TC-71.10	1/19/18		
MT-98.20	4/19/19	TC-73.20	1/17/20		
MT-98.22	1/17/20				
MT-98.29	1/17/20				
MT-99.50	1/17/20				

ENGINEER'S SEAL:

STATE OF OHIO
REGISTERED PROFESSIONAL ENGINEER
MATTHEW A. CHANEY
E-78423

SIGNED: Matthew Chaney
DATE: 1/10/22

APPROVED: [Signature]
DATE: 1/10/22 DISTRICT DEPUTY DIRECTOR

APPROVED: _____
DATE: _____ DIRECTOR, DEPARTMENT OF TRANSPORTATION

DESIGN AGENCY	
DESIGNER	CMW
REVIEWER	MAC 10-22-21
PROJECT ID	114324
SHEET	TOTAL
P.1	9

ATB-90-19.56

MODEL: Sheet PAPER SIZE: TX:11 (in.) DATE: 12/21/2021 TIME: 2:28:47 PM USER: cwellsh p:\v\h\dot-pw_baniley.com\h\dot-pw-02\Documents\01 Active Projects\District 04\Ashtabula\114324\00-Engineering\Roadway\Sheets\114324_GTO01.dgn

TITLE SHEET

ELECTRONIC TICKETING

PURPOSE:

PROVIDE ELECTRONIC MATERIAL TICKETS IN AN ELECTRONIC FORMAT DIRECTLY RECORDED FROM THE MATERIAL LOADING SOURCE.

PROVIDE ELECTRONIC MATERIAL TICKETS FOR THE FOLLOWING

MATERIALS:

ASPHALT CONCRETE

THIS NOTE IN NO WAY SUPERSEDES ANY OTHER COMMERCIAL REGULATIONS OR ANY OTHER LEGAL REQUIREMENTS REGULATING THE TRANSPORTATION OF COMMERCIAL MATERIALS.

REQUIREMENTS:

AT THE PRE-CONSTRUCTION MEETING, SUBMIT AN ELECTRONIC TICKETING PLAN TO THE ENGINEER DESCRIBING THE PROPOSED ELECTRONIC TICKET DELIVERY METHOD. THE ELECTRONIC MATERIAL TICKET SHALL CONTAIN INFORMATION AS REQUIRED PER THE APPLICABLE MATERIAL SPECIFICATION FOR WEIGHT MEASUREMENT AND OTHER MATERIAL CHARACTERISTICS; PROVIDE AN EXAMPLE(S) OR A "MOCK-UP" OF THE PROPOSED ELECTRONIC TICKET TO SHOW THE DETAILS ON WHAT IS TO BE TRANSMITTED TO THE DEPARTMENT. NAMING OF THE ELECTRONIC MATERIAL TICKET FILES SHALL BE DISTINCT SUCH THAT THE TICKET'S REPRESENTED MATERIAL IS EASILY DETERMINED; INCLUDE THE PROPOSED NAMING CONVENTION. DELIVERY MAY BE THROUGH A PRODUCER WEBSITE UPLOAD ACCESSIBLE TO THE ENGINEER, ODOT PROJECT SPECIFIC SHAREPOINT DOCUMENTATION SITE UPLOAD, OR ANOTHER SECURE ELECTRONIC TRANSMITTAL MEANS. EMAILING OF A TICKET TO AN ODOT CONTACT IS ACCEPTABLE BUT IS NOT PREFERRED. THE ELECTRONIC TICKETING PLAN SHALL IDENTIFY A CONTINGENCY METHOD FOR MANUALLY CAPTURING AND DELIVERING TICKET INFORMATION IF ELECTRONIC TRANSMISSION IS TEMPORARILY UNAVAILABLE. AN ELECTRONIC TICKETING PLAN WHICH INCLUDES SOLELY THE USE OF DIGITAL PHOTOS OF PAPER TICKETS IS NOT ACCEPTABLE.

sheet added

THE DEPARTMENT RECOGNIZES THAT VARIOUS DIGITAL TICKETING SYSTEMS MAY BE COMMERCIALY AVAILABLE AND USED TO ACCOMODATE INDIVIDUAL CONTRACTORS AND MATERIAL SUPPLIER CAPABILITIES. THE CONTRACTOR MAY PROVIDE A DIGITAL TICKETING SYSTEM GIVING SECURE ACCESS TO ORGANIZED DIGITAL DATA. IF UTILIZED, THE DIGITAL TICKETING SYSTEM MAY ALSO BE ACCESSIBLE BY REAL-TIME MONITORING WITH A MOBILE COMMUNICATION DEVICE SUCH AS A TABLET, SMARTPHONE, ETC. THROUGH MOBILE DEVICE APPLICATIONS ("MOBILE APP") IF ACCEPTABLE TO THE DEPARTMENT. IF A DIGITAL TICKETING SYSTEM REQUIRES A MOBILE APP, THE MOBILE APP SHALL BE AT NO COST TO THE DEPARTMENT. THE DIGITAL DATA MUST BE ABLE TO BE EXPORTED IN A FORMAT USABLE BY THE ENGINEER UPON REQUEST (I.E. MICROSOFT WORD, MICROSOFT EXCEL, PDF FORMATS.)

DELIVER EACH ELECTRONIC MATERIAL TICKET TO THE ENGINEER PRIOR TO THE PLACEMENT OF MATERIAL, BUT NOT PRIOR TO THE LOADING OF MATERIAL AT THE SOURCE.

PROVIDE THE ENGINEER A DAILY MATERIAL SUMMARY REPORT BY THE END OF THE DAY'S HAULING ACTIVITIES, OR AT A TIME APPROVED BY THE ENGINEER. THE DAILY MATERIAL SUMMARY REPORT INCLUDES SUMMARY INFORMATION LISTED FOR EACH MATERIAL AS OUTLINED IN THE RESPECTIVE MATERIAL SPECIFICATION.

PAYMENT:

COSTS FOR THE ELECTRONIC TICKETING SHALL BE INCIDENTAL TO THE PROJECT.

GENERAL NOTES

DESIGN AGENCY



DESIGNER
CMW

REVIEWER
MAC 10-22-21

PROJECT ID
114324

SHEET TOTAL
P.3A | 9