

ATB-20/307-3.94/7.81

[illegible]

CALC:	JF	DATE:	5/8/2025
CHECKED:	MJA	DATE:	7/1/2025

STRUCTURE ESTIMATED QUANTITIES
ATB-307-9.000 & ATB-307-10.992
OVER CENTER CREEK & OVER MILL CREEK

SFN
VARIOUS
DESIGN AGENCY



DESIGNER	CHECKER
JF	MJA

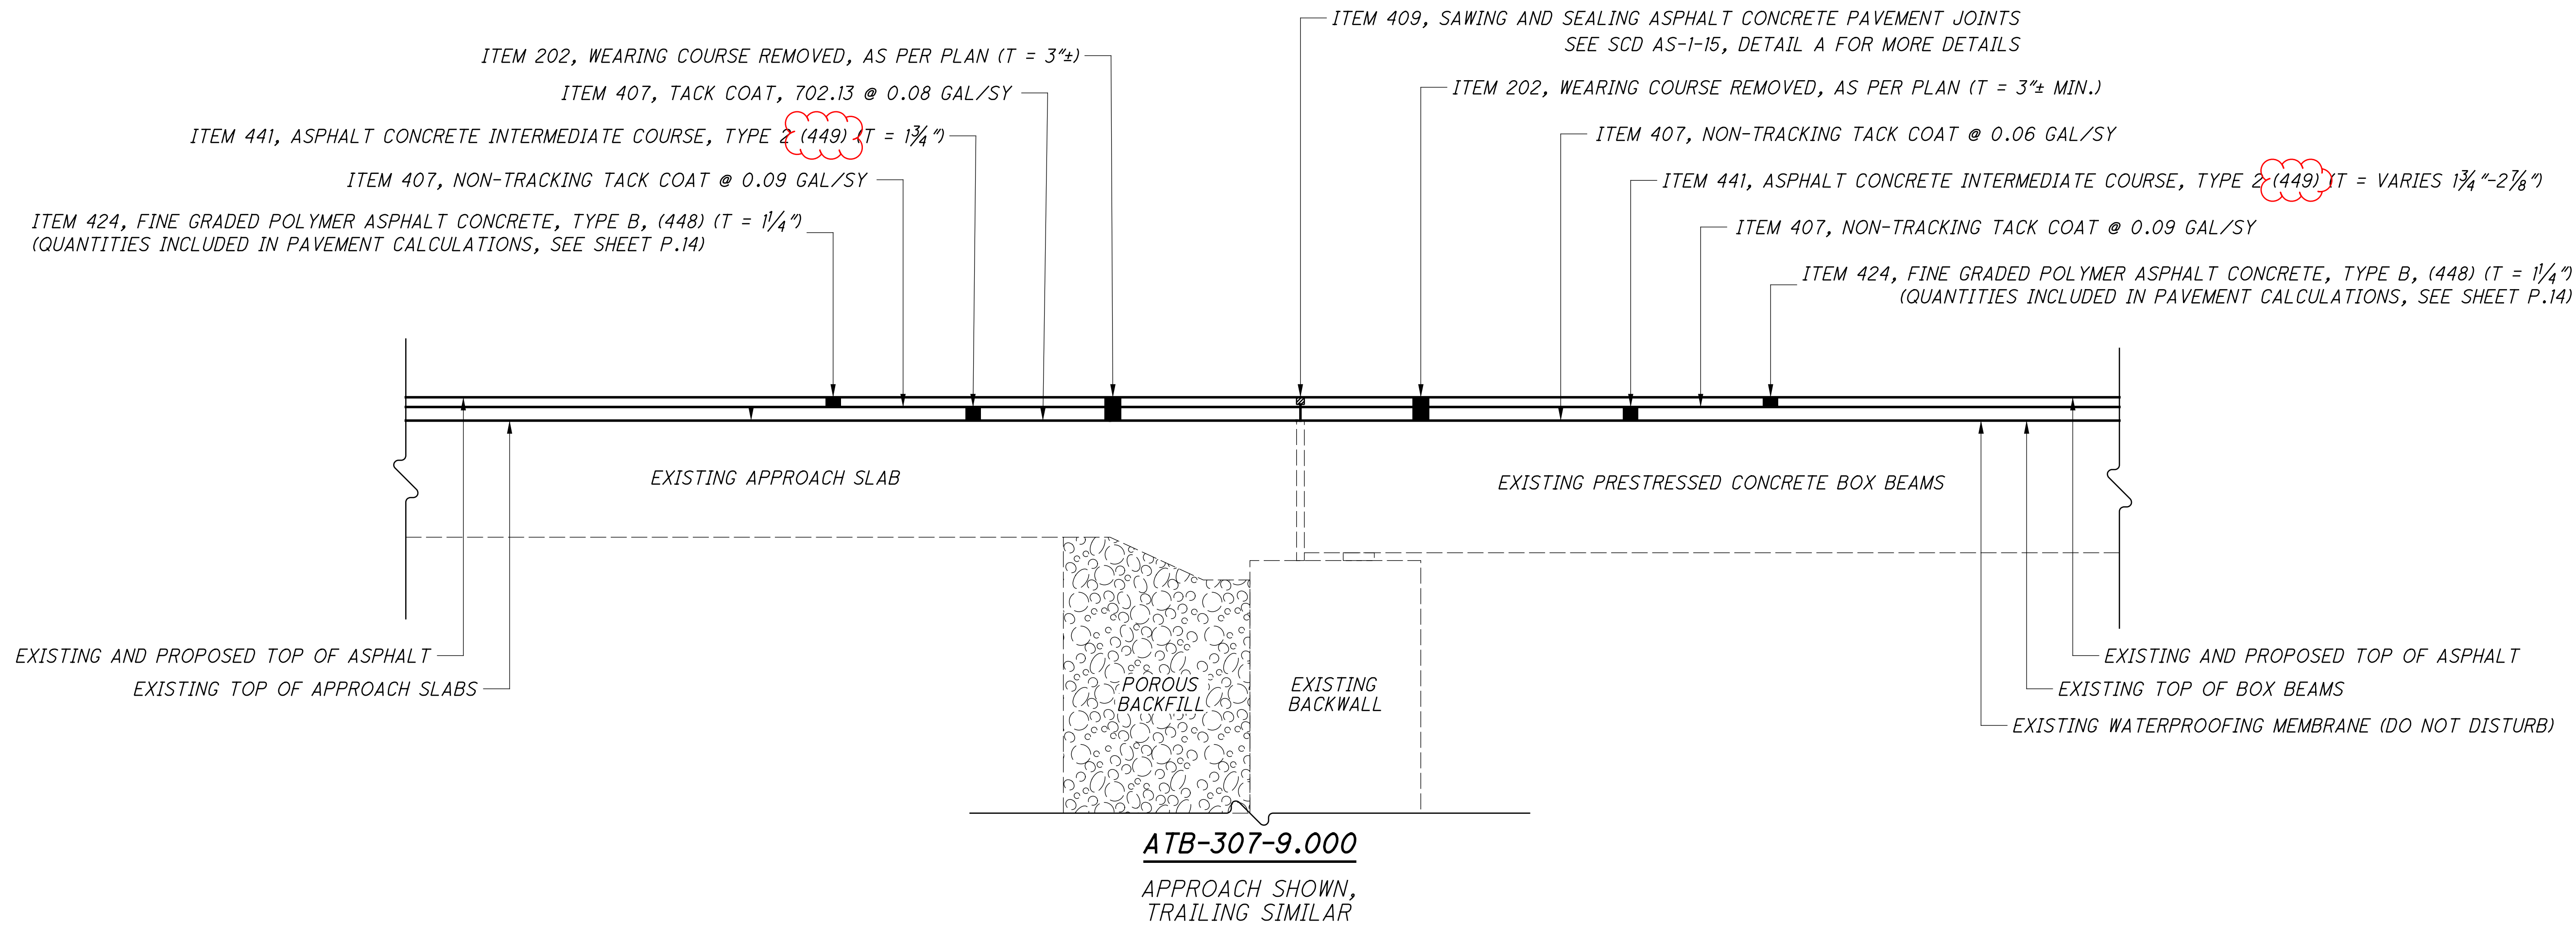
REVIEWER
MJA 05-20-25

PROJECT ID
120990

SUBSET	TOTAL
2	3

SHEET	TOTAL
P.19	20

ATB-20/307-3.94/7.81

[illegible]

SUPERSTRUCTURE DETAILS
ATB-307-9.000 & ATB-307-10.992
OVER CENTER CREEK & OVER MILL CREEK

SFN	
VARIOUS	
DESIGN AGENCY	
	
DESIGNER	CHECKER
JF	MJA
REVIEWER	
MJA 05-20-25	
PROJECT ID	
120990	
SUBSET	TOTAL
3	3
SHEET	TOTAL
P.20	20