### NONE

FEDERAL PROJECT NUMBER

### **PROJECT DESCRIPTION**

FOUR-LANE RESURFACING PROJECT
USING A MICROSURFACING TREATMENT.

### EARTH DISTURBED AREAS

PROJECT EARTH DISTURBED AREA: 0 ACRES
ESTIMATED CONTRACTOR EARTH DISTURBED AREA: 0 ACRES
NOTICE OF INTENT EARTH DISTURBED AREA: N/A ACRES\*
\*ROUTINE MAINTENANCE

### LIMITED ACCESS

THIS IMPROVEMENT IS ESPECIALLY DESIGNED FOR THROUGH TRAFFIC AND HAS BEEN DECLARED A LIMITED ACCESS HIGHWAY OR FREEWAY BY ACTION OF THE DIRECTOR IN ACCORDANCE WITH THE PROVISIONS OF SECTION 5511.02 OF THE OHIO REVISED CODE.

### **2019 SPECIFICATIONS**

THE STANDARD SPECIFICATIONS OF THE STATE OF OHIO, DEPARTMENT OF TRANSPORTATION, INCLUDING SUPPLEMENTAL SPECIFICATIONS LISTED IN THE PLANS AND CHANGES LISTED IN THE PROPOSAL SHALL GOVERN THIS IMPROVEMENT.

# ATH-33-4.38 AND VARIOUS

**STATE OF OHIO** 

**DEPARTMENT OF TRANSPORTATION** 

YORK, DOVER, ATHENS, COLUMBIA, DUNHAM, BARLOW TOWNSHIPS

### **INDEX OF SHEETS:**

TITLE SHEET	1
LOCATION MAPS	2
TYPICAL SECTIONS	3
GENERAL NOTES	4
GENERAL SUMMARY	5
PAVEMENT SUBSUMMARY	6
TRAFFIC CONTROL SUBSUMMARY	7
TRAFFIC CONTROL SUBSUMMARY	8
MAINTENANCE OF TRAFFIC SUBSUMMARY	9
PAVEMENT MARKING DETAILS	10-11

### **NHS PROJECT**

YES

### **DESIGN EXCEPTIONS**


NONE REQUIRED

### ADA DESIGN WAIVERS

NONE REQUIRED



PLAN PREPARED BY:

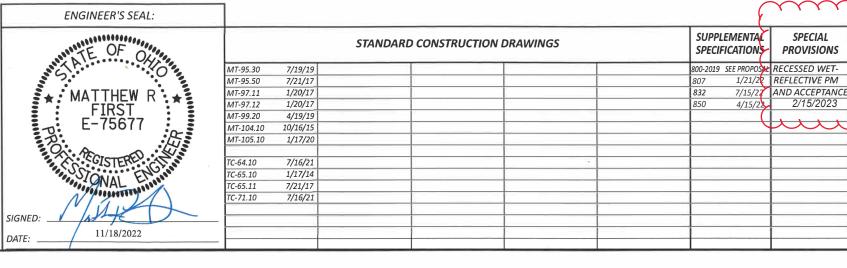

APPROVED TO THE STATE OF THE ST

ATE  $\frac{11/8/22}{}$  DISTRICT DEPUTY DIRECTOR

DATE \_\_\_\_\_\_ DIRECTOR, DEPARTMENT OF

DESIGN AGENC

SHEET

TITLE

DESIGNER
BAC
REVIEWER
MRF 10-15-22

102697
SHEET TOTAL
1 11

ATH-33-4.35 AND VARIOUS

# PEL: Sheet PAPERSIZE: 34x22 (in.) DATE: 2/16/2023 TIME: 8:51:46 AM USER: mfirst ohiodot-pw.bentley.com:ohiodot-pw-02\Documents\01 Active Projects\District 10\Athens\1026

### NOTIFICATION OF TRAFFIC RESTRICTIONS

THROUGHOUT THE DURATION OF THE PROJECT, THE CONTRACTOR SHALL NOTIFY THE PROJECT ENGINEER IN WRITING OF ALL TRAFFIC RESTRICTIONS AND UPCOMING MAINTENANCE OF TRAFFIC CHANGES. THE CONTRACTOR SHALL ENSURE THE WRITTEN NOTIFICATION IS SUBMITTED IN A TIMELY MANNER TO ALLOW THE PROJECT ENGINEER TO MEET THE REQUIRED TIME FRAMES SET FORTH IN THE TABLE BELOW TO INFORM THE SPECIAL HAULING PERMITS SECTION (HAULING.PERMITS@DOT.OHIO.GOV) AND THE DISTRICT PUBLIC INFORMATION OFFICE (PIO). THIS NOTIFICATION SHALL BE RECEIVED BY THE PROJECT ENGINEER PRIOR TO THE PHYSICAL SETUP OF ANY APPLICABLE SIGNS OR MESSAGE BOARDS.

INFORMATION SHOULD INCLUDE, BUT IS NOT LIMITED TO, ALL CONSTRUCTION ACTIVITIES THAT IMPACT OR INTERFERE WITH TRAFFIC AND SHALL LIST THE SPECIFIC LOCATION, TYPE OF WORK, ROAD STATUS, DATE AND TIME OF RESTRICTION, DURATION OF RESTRICTION, NUMBER OF LANES MAINTAINED, NUMBER OF LANES CLOSED, MINIMUM VERTICAL CLEARANCE, MINIMUM WIDTH OF DRIVABLE PAVEMENT, DETOUR ROUTES, IF APPLICABLE, AND ANY OTHER INFORMATION REQUESTED BY THE PROJECT ENGINEER.

NOTIFICATION TIME TABLE					
ITEM	DURATION OF CLOSURE	NOTICE DUE TO OFFICE OF COMMUNICATIONS			
RAMP & ROAD CLOSURES	>= 2 WEEKS	21 CALENDER DAYS PRIOR TO CLOSURE			
	> 12 HOURS & < 2 WEEKS	14 CALENDER DAYS PRIOR TO CLOSURE			
	< 12 HOURS	4 BUSINESS DAYS PRIOR TO CLOSURE			
LANE CLOSURES &	>= 2 WEEKS	14 CALENDER DAYS PRIOR TO CLOSURE			
RESTRICTIONS	< 2 WEEKS	5 BUSINESS DAYS PRIOR TO CLOSURE			
START OF CONSTRUCTION & TRAFFIC PATTERN CHANGES	N/A	14 CALENDER DAYS PRIOR TO IMPLEMENTATION			

ANY UNFORESEEN CONDITIONS NOT SPECIFIED IN THE PLANS REQUIRING TRAFFIC RESTRICTIONS SHALL ALSO BE REPORTED TO THE PROJECT ENGINEER USING THE NOTIFICATION TIME TABLE. THE PROJECT ENGINEER WILL FORWARD THIS INFORMATION TO THE FOLLOWING:

DISTRICT PUBLIC INFORMATION OFFICER (PIO):
ASHLEY RITTENHOUSE
FAX: (740) 373-3953
EMAIL: ASHLEY.RITTENHOUSE@DOT.OHIO.GOV

DISTRICT PERMIT SECTION: STEPHEN WELLS FAX: (740) 568-3973 EMAIL: STEPHEN.WELLS@DOT.OHIO.GOV

CENTRAL OFFICE SPECIAL HAUL PERMITS SECTION: FAX: (614) 728-4099

EMAIL: HAULING.PERMITS@DOT.OHIO.GOV

THE PIO WILL, IN TURN, NOTIFY THE PUBLIC, THE LOCAL EMERGENCY SERVICES, AFFECTED SCHOOLS AND BUSINESSES, AND ANY OTHER IMPACTED LOCAL PUBLIC AGENCY OF THE ABOVE MENTIONED ITEMS VIA MEDIA SOURCES.

### UTILITIES

THERE ARE NO UNDERGROUND UTILITIES SHOWN ON THIS PLAN. THE NATURE OF THE WORK REQUIRED BY THIS PROJECT WILL NOT AFFECT ANY KNOWN UNDERGROUND UTILITIES THAT EXIST UNDER, OR ADJACENT TO, THE WORK AREA.

## ITEM 623, CONSTRUCTION LAYOUT STAKES AND SURVEYING, AS PER PLAN

WHEN STATIONING A RESURFACING PROJECT FOR QUANTITY CONTROL, THE REFERENCE IN 623.02 TO A REGISTERED PROFESSIONAL ENGINEER OR REGISTERED PROFESSIONAL SURVEYOR SHALL BE WAIVED. THE STAKES MAY BE PLACED BY THE CONTRACTOR'S PERSONNEL USING A MEASURING WHEEL.

### ITEM 614, MAINTAINING TRAFFIC

TWO-WAY TRAFFIC SHALL BE MAINTAINED AT ALL TIMES EXCEPT THAT ONE-WAY TRAFFIC WILL BE PERMITTED FOR MINIMUM PERIODS OF TIME CONSISTENT WITH THE REQUIREMENTS OF THE SPECIFICATIONS FOR PROTECTION OF COMPLETED ASPHALT CONCRETE COURSES.

THE FOLLOWING ESTIMATED QUANTITIES HAVE BEEN INCLUDED IN THE GENERAL SUMMARY FOR USE AS DETERMINED BY THE ENGINEER FOR THE MAINTENANCE OF TRAFFIC:

ITEM 614, WORK ZONE MARKING SIGN (WAS-339)

 SIGN
 SPLIT 1

 W8-H12a
 22 EACH

 R4-1
 18 EACH

 R4-2
 17 EACH

SIGN TOTAL = 57 EACH CARRIED TO THE GENERAL SUMMARY

LENGTH AND DURATION OF LANE CLOSURES AND RESTRICTIONS SHALL BE AT THE APPROVAL OF THE ENGINEER. IT IS THE INTENT TO MINIMIZE THE IMPACT TO THE TRAVELING PUBLIC. LANE CLOSURES OR RESTRICTIONS OVER SEGMENTS OF THE PROJECT IN WHICH NO WORK IS ANTICIPATED WITHIN A REASONABLE TIME FRAME, AS DETERMINED BY THE ENGINEER, SHALL NOT BE PERMITTED. THE LEVEL OF UTILIZATION OF MAINTENANCE OF TRAFFIC DEVICES SHALL BE COMMENSURATE WITH THE WORK IN PROGRESS.

ALL WORK AND TRAFFIC CONTROL DEVICES SHALL BE IN ACCORDANCE WITH CMS 614 AND OTHER APPLICABLE PORTIONS OF THE SPECIFICATIONS, AS WELL AS THE OHIO MANUAL OF UNIFORM TRAFFIC CONTROL DEVICES. PAYMENT FOR ALL LABOR, EQUIPMENT AND MATERIALS SHALL BE INCLUDED IN THE LUMP SUM CONTRACT PRICE FOR ITEM 614, MAINTAINING TRAFFIC UNLESS SEPARATELY ITEMIZED IN THE PLAN.

### SIDE ROADS

DRIVES, MAILBOX TURNOUTS, AND SIDE ROADS ARE NOT INCLUDED IN THIS MICROSURFACING PROJECT.
MICROSURFACING SHALL BE PLACED FROM EDGE OF SHOULDER TO EDGE OF SHOULDER.
WHEN A SIDE ROAD IS APPROACHED BY A TURN LANE, THE CONTINUATION OF THE TURN LANE EDGE OF SHOULDER SHALL SERVE AS THE LIMIT FOR TREATING THE SIDE ROAD APRON.

### LONGITUDINAL CHANNELIZER

MICROSURFACING SHALL BE PLACED ALONG EXISTING
LONGITUDINAL CHANNELIZER. THE CONTRACTOR SHALL
CAREFULLY PLACE MICROSURFACING SURFACE COURSE
TO MEET THE CHANNELIZER CURB ELEMENTS.
THE CONTRACTOR SHALL BE RESPONSIBLE TO CLEAN ANY
ERRANTLY PLACED MICROSURFACING MATERIAL FROM THE
CHANNELIZER CURB OR UPRIGHTS.

# ITEM 421 MICROSURFACING, LEVELING COURSE, AS PER PLAN ITEM 421 MICROSURFACING, SURFACE COURSE, AS PER PLAN

THE INTENT OF THESE ITEMS IS TO CREATE A DOUBLE MICROSURFACING OVERLAY PER C&MS 421.11 ON ATH-33 AND MEG-32.

THE MICROSURFACING LEVELING COURSE SHALL BE APPLIED AT A 25 FT WIDTH TO OVERLAY THE DRIVING AND PASSING LANES ON ATH-33 AND MEG-32. THIS LEVELING COURSE SHALL BE APPLIED AT 14 LB/SY.

THE MICROSURFACING SURFACE COURSE SHALL BE APPLIED TO THE FULL WIDTH OF THE ROADWAY ON ATH-33 AND MEG-32. THIS SURFACE COURSE SHALL BE APPLIED AT 18 LB/SY ON THE TRAVEL LANES AND THE SHOULDERS.

# ITEM 690 - SPECIAL - WET REFLECTIVE THERMOPLASTIC PAVEMENT MARKINGS

ALL ITEMS BELOW SHALL COMPLY TO SUPPLEMENTAL SPECIFICATION 807 - WET REFLECTIVE LIQUID APPLIED PAVEMENT MARKINGS, EXCEPT AS FOLLOWS:

FINAL ACCEPTANCE FOR ALL RECESSED WET-REFLECTIVE
PAVEMENT MARKINGS BELOW SHALL FOLLOW ACCEPTANCE AS
DESCRIBED IN SPECIAL PROVISION, RECESSED WET-REFLECTIVE
PAVEMENT MARKINGS AND ACCEPTANCE. DATED 11/21/2022.

THE CONTRACTOR SHALL PROVIDE CR AWE 50/51 WET
REFLECTIVE OPTICS MANUFACTURED BY 3M FOR THE ITEM BELOW.

ITEM 690 - SPECIAL - WET REFLECTIVE THERMOPLASTIC PAVEMENT MARKING, EDGE LINE, 6 INCH, 3M OPTICS

THE CONTRACTOR SHALL PROVIDE DURALUX 334 WET
REFLECTIVE OPTICS MANUFACTURED BY SWARCO FOR THE ITEM
BELOW.

ITEM 690 - SPECIAL - WET REFLECTIVE THERMOPLASTIC PAVEMENT MARKING, EDGE LINE, 6 INCH, SWARCO

# ITEM 614, LAW ENFORCEMENT OFFICER (WITH PATROL CAR) FOR ASSISTANCE DURING CONSTRUCTION OPERATIONS

USE OF LAW ENFORCEMENT OFFICERS (LEOS) BY CONTRACTORS
OTHER THAN THE USES SPECIFIED BELOW WILL NOT BE
PERMITTED AT PROJECT COST. LEOS SHOULD NOT BE USED
WHERE THE OMUTCD INTENDS THAT FLAGGERS BE USED.

IN ADDITION TO THE REQUIREMENT OF C&MS 614 AND THE OMUTCD, A UNIFORMED LEO WITH AN OFFICIAL PATROL CAR (CAR WITH TOP-MOUNTED EMERGENCY FLASHING LIGHTS AND COMPLETE MARKINGS OF THE APPROPRIATE LAW ENFORCEMENT AGENCY) SHOULD BE PROVIDED FOR THE FOLLOWING TRAFFIC CONTROL TASKS AS APPROVED BY THE ENGINEER:

DURING THE ENTIRE ADVANCE PREPARATION AND CLOSURE SEQUENCE WHERE COMPLETE BLOCKAGE OF TRAFFIC IS REQUIRED.

FOR LANE CLOSURES: DURING INITIAL SET-UP PERIODS,
TEAR DOWN PERIODS, SUBSTANTIAL SHIFTS OF A CLOSURE
POINT OR WHEN NEW LANE CLOSURE ARRANGEMENTS ARE
INITIATED FOR LONG-TERM LANE CLOSURES/SHIFTS (FOR
THE FIRST AND LAST DAY OF MAJOR CHANGES IN TRAFFIC
CONTROL SETUP).

IN GENERAL, LEOS SHOULD BE POSITIONED IN ADVANCE OF AND ON THE SAME SIDE AS THE LANE RESTRICTION (OR AT THE POINT OF ROAD CLOSURE), AND TO MANUALLY CONTROL TRAFFIC MOVEMENTS THROUGH SIGNALIZED INTERSECTIONS IN WORK ZONES.

LEOS SHOULD NOT FORGO THEIR TRAFFIC CONTROL
RESPONSIBILITIES TO APPREHEND MOTORISTS FOR ROUTINE
TRAFFIC VIOLATIONS. HOWEVER, IF A MOTORIST'S ACTIONS
ARE CONSIDERED TO BE RECKLESS, THEN PURSUIT OF THE
MOTORIST IS APPROPRIATE.

THE LEOS WORK AT THE DIRECTION OF THE CONTRACTOR.

THE CONTRACTOR IS RESPONSIBLE FOR SECURING THE

SERVICES OF THE LEOS WITH THE APPROPRIATE AGENCIES

AND COMMUNICATING THE INTENTIONS OF THE PLANS WITH

RESPECT TO DUTIES OF THE LEOS. THE ENGINEER SHALL

HAVE FINAL CONTROL OVER THE LEOS' DUTIES AND PLACEMENT,

AND WILL RESOLVE ANY ISSUES THAT MAY ARISE BETWEEN THE

TWO PARTIES.

ENSURE PROVIDED LEOS HAVE BEEN TRAINED APPROPRIATE TO THE JOB DECISIONS THEY ARE REQUIRED TO MAKE WHILE ON THE PROJECT, IN ACCORDANCE WITH C&MS 614.03.

THE LEO SHALL REPORT IN TO THE CONTRACTOR PRIOR TO THE START OF THE SHIFT, IN ORDER TO RECEIVE INSTRUCTIONS REGARDING SPECIFIC WORK ASSIGNMENTS DURING HIS/HER SHIFT. THE LEO IS EXPECTED TO STAY AT THE PROJECT SITE FOR THE ENTIRE DURATION OF HIS/HER SHIFT. THE LEO SHALL REPORT TO THE CONTRACTOR AT THE END OF HIS/HER SHIFT. SHOULD IT BE NECESSARY TO LEAVE THE PROJECT SITE, THE LEO SHALL NOTIFY THE ENGINEER. THE CONTRACTOR SHALL PROVIDE THE LEO WITH A TWO-WAY COMMUNICATION DEVICE THAT SHALL BE RETURNED TO THE CONTRACTOR AT THE END OF HIS/HER SHIFT.

LEOS (WITH PATROL CAR) REQUIRED BY THE TRAFFIC MAINTENANCE TASKS ABOVE SHALL BE PAID FOR ON A UNIT PRICE (HOURLY) BASIS UNDER ITEM 614, LAW ENFORCEMENT OFFICER (WITH PATROL CAR) FOR ASSISTANCE. THE FOLLOWING ESTIMATED QUANTITIES HAVE BEEN CARRIED TO THE GENERAL SUMMARY.

ITEM 614, LAW ENFORCEMENT OFFICER WITH PATROL CAR
FOR ASSISTANCE 80 HOURS

THE HOURS PAID SHALL INCLUDE ANY MINIMUM SHOW-UP TIME REQUIRED BY THE LAW ENFORCEMENT AGENCY INVOLVED.

ANY ADDITIONAL COSTS (ADMINISTRATIVE OR OTHERWISE)
INCURRED BY THE CONTRACTOR TO OBTAIN THE SERVICES
OF A LEO ARE INCLUDED WITH THE BID UNIT PRICE FOR
ITEM 614, LAW ENFORCEMENT OFFICER WITH PATROL CAR
FOR ASSISTANCE.

### BRIDGE TREATMENTS

CNTY	RT	SEC	SFN	<b>EXISTING SURFACE</b>	PROPOSED TREATMENT
ATH	33	5.40L	0500577	Concrete	Stop at bridge joint
ATH	33	5.40R	0500607	Concrete	Stop at bridge joint
ATH	33	9.02L	0500631	Concrete	Stop at approach slabs
ATH	33	9.02R	0500666	Concrete	Stop at approach slabs
ATH	33	1107L	0500720	Concrete	Stop at approach slabs
ATH	33	1107R	0500755	Concrete	Stop at approach slabs
WAS	339	5.12	8404119	Concrete	Stop at the approach slabs

THE THE WARRING TO THE TOTAL THE TOT

SIGN AGENCY



REVIEWER
MRF 10-15-22
PROJECT ID
102697

EET TOTAL
4 11