

SHEET NUM.												PART.		ITEM	ITEM EXT	GRAND TOTAL	UNIT	DESCRIPTION	SEE SHEET NO.
						P.6	P.39	P.40	P.42	P.43	P.71	01/SAF/21							
																		ROADWAY	
						LS						LS		201	11000	LS		CLEARING AND GRUBBING	
							4,814	516				5,330		202	23000	5,330	SY	PAVEMENT REMOVED	
									63			63		202	32000	63	FT	CURB REMOVED	
										4		4		202	32700	4	SY	GUTTER REMOVED	
										295		295		202	35100	295	FT	PIPE REMOVED, 24" DIAMETER AND UNDER	
										12		12		202	35200	12	FT	PIPE REMOVED, OVER 24" DIAMETER	
									46			46		202	38000	46	FT	GUARDRAIL REMOVED	
									1			1		202	42010	1	EACH	ANCHOR ASSEMBLY REMOVED, TYPE E	
									1			1		202	42040	1	EACH	ANCHOR ASSEMBLY REMOVED, TYPE T	
										2		2		202	58100	2	EACH	CATCH BASIN REMOVED	
											20,617	20,617		203	10000	20,617	CY	EXCAVATION	
											1,612	1,612		203	20000	1,612	CY	EMBANKMENT	
							9,170	2,021				11,191		204	10000	11,191	SY	SUBGRADE COMPACTION	
									75			75		606	15050	75	FT	GUARDRAIL, TYPE MGS	
									1			1		606	26050	1	EACH	ANCHOR ASSEMBLY, MGS TYPE B	
									1			1		606	26550	1	EACH	ANCHOR ASSEMBLY, MGS TYPE T	
																		EROSION CONTROL	
						2						2		659	00100	2	EACH	SOIL ANALYSIS TEST	
						2,103				301		2,404		659	00300	2,404	CY	TOPSOIL	
											18,942	18,942		659	10000	18,942	SY	SEEDING AND MULCHING	
						948						948		659	14000	948	SY	REPAIR SEEDING AND MULCHING	
						948						948		659	15000	948	SY	INTER-SEEDING	
						2.71						2.71		659	20000	2.71	TON	COMMERCIAL FERTILIZER	
						3.92						3.92		659	31000	3.92	ACRE	LIME	
						105						105		659	35000	105	MGAL	WATER	
										2,430		2,430		670	00500	2,430	SY	SLOPE EROSION PROTECTION	
										279		279		670	00700	279	SY	DITCH EROSION PROTECTION	
										687		687		670	00750	687	SY	DITCH EROSION PROTECTION MAT, TYPE E	
												LS		832	15000	LS		STORM WATER POLLUTION PREVENTION PLAN	
												LS		832	15002	LS		STORM WATER POLLUTION PREVENTION INSPECTIONS	
												LS		832	15010	LS		STORM WATER POLLUTION PREVENTION INSPECTION SOFTWARE	
												75,000		832	30000	75,000	EACH	EROSION CONTROL	
										45		45		836	10020	45	SY	SEEDING AND EROSION CONTROL WITH TURF REINFORCING MAT, TYPE 2	
																		DRAINAGE	
						1				9		10		601	21050	10	SY	TIED CONCRETE BLOCK MAT WITH TYPE 1 UNDERLAYMENT	
										0.5		0.5		602	20000	0.5	CY	CONCRETE MASONRY	
										2,400		2,400		605	05100	2,400	FT	4" SHALLOW PIPE UNDERDRAINS	
										1,251		1,251		605	11100	1,251	FT	6" SHALLOW PIPE UNDERDRAINS	
						100						100		605	13300	100	FT	6" UNCLASSIFIED PIPE UNDERDRAINS	
						50						50		605	31100	50	FT	AGGREGATE DRAINS	
										106		106		611	00410	106	FT	4" CONDUIT, TYPE F FOR UNDERDRAIN OUTLET	
										8		8		611	00510	8	FT	6" CONDUIT, TYPE F FOR UNDERDRAIN OUTLETS	
						50						50		611	01500	50	FT	6" CONDUIT, TYPE F	
										504		504		611	05900	504	FT	15" CONDUIT, TYPE B	
										336		336		611	06100	336	FT	15" CONDUIT, TYPE C	
										6		6		611	10600	6	FT	24" CONDUIT, TYPE C	
										12		12		611	12100	12	FT	27" CONDUIT, TYPE C, 706.02	
										475		475		611	97000	475	FT	SLOTTED DRAIN, TYPE 1, 15"	
										1		1		611	98180	1	EACH	CATCH BASIN, NO. 3A	
										1		1		611	98370	1	EACH	CATCH BASIN, NO. 6	
										3		3		611	98410	3	EACH	CATCH BASIN, NO. 8	
										2		2		611	99574	2	EACH	MANHOLE, NO. 3	
									2			2		611	99654	2	EACH	MANHOLE ADJUSTED TO GRADE	
						1				6		7		611	99710	7	EACH	PRECAST REINFORCED CONCRETE OUTLET	

GENERAL SUMMARY

DESIGN AGENCY



DESIGNER

BAC

REVIEWER

TWG 11/07/24

PROJECT ID




118516

SHEET

P.36

TOTAL

109

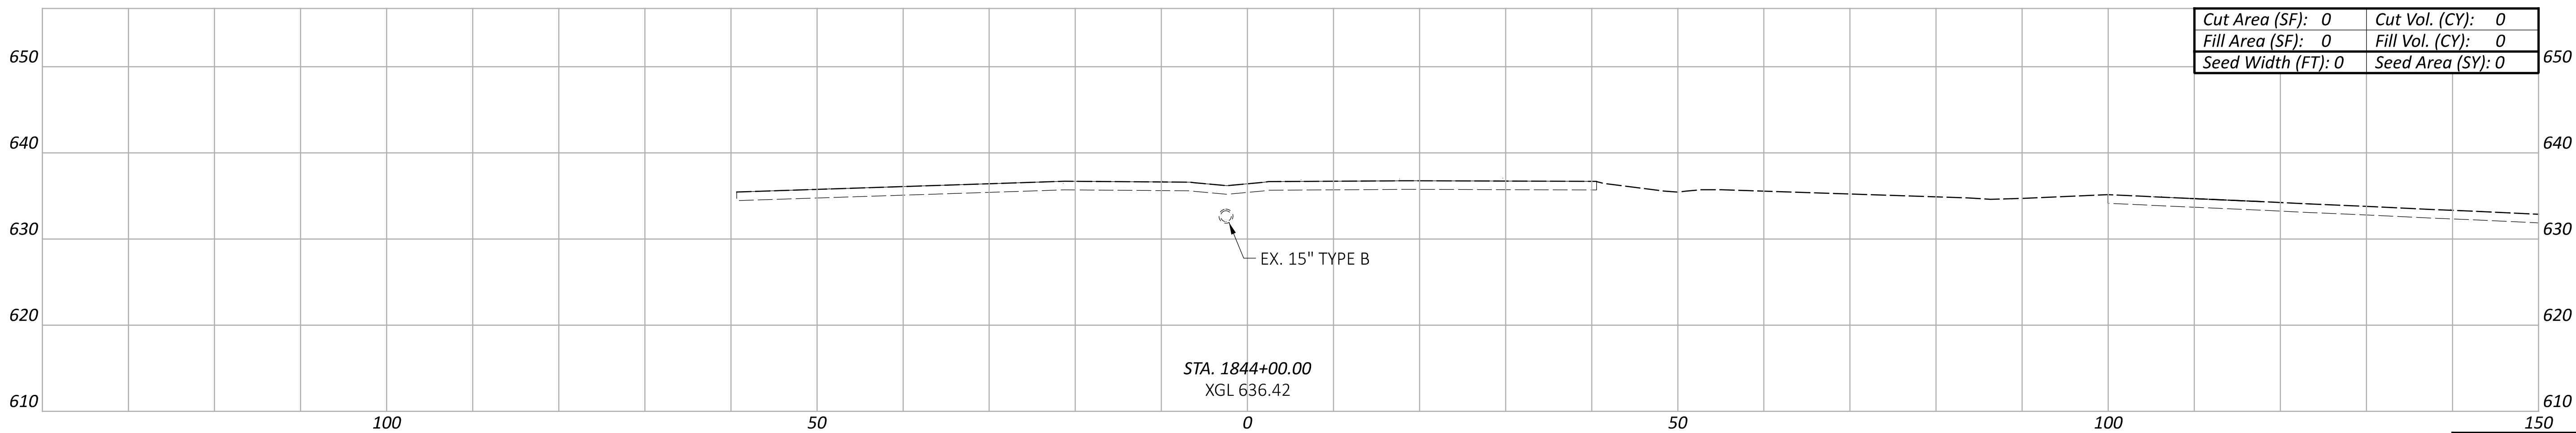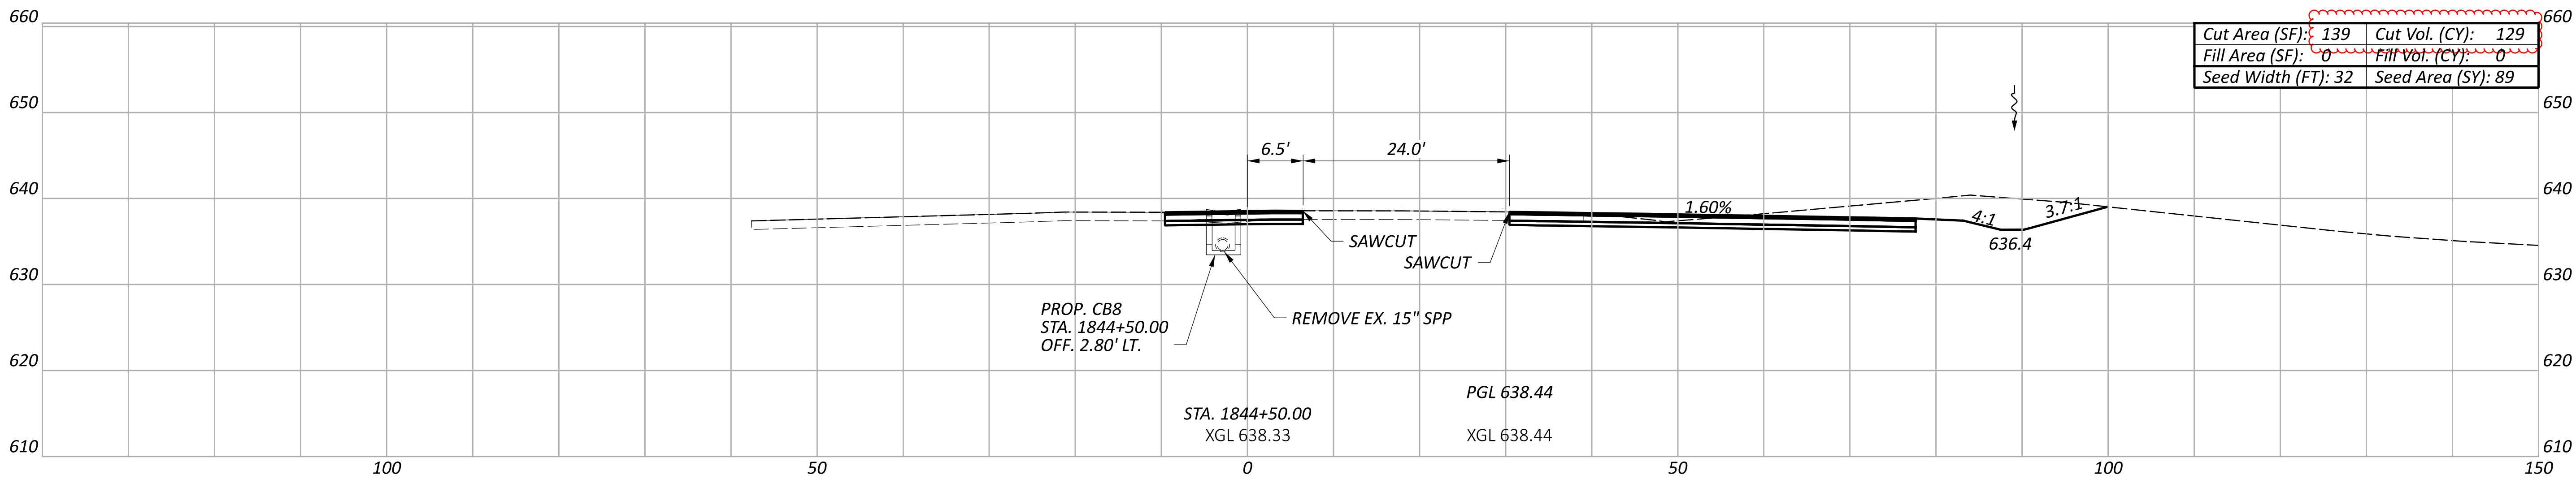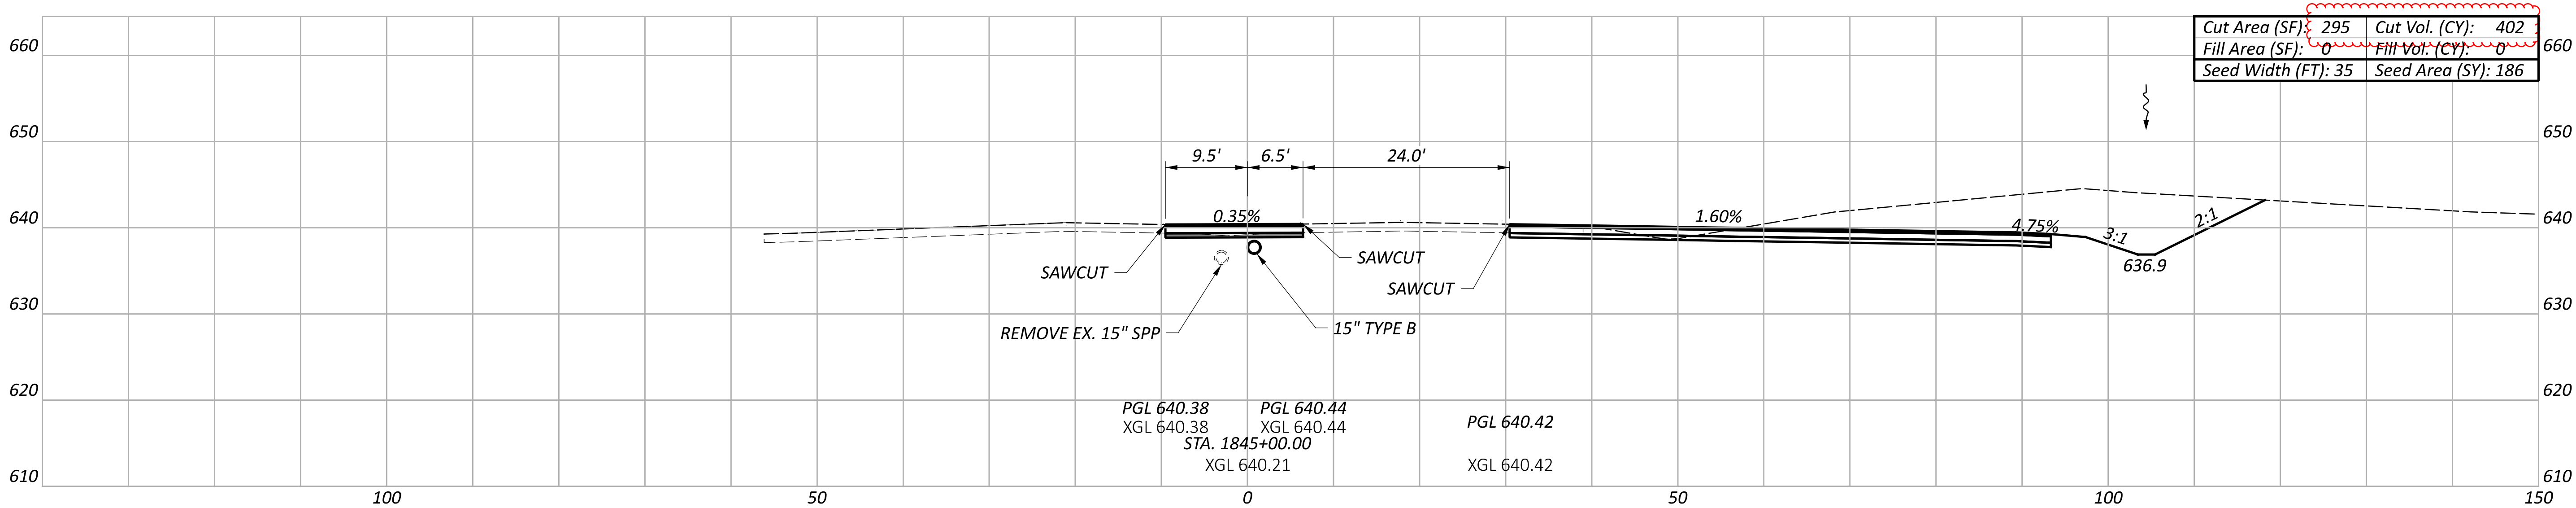

Sheet Totals			118516	
Seeding	Cut	Fill	SHEET	TOTAL
275	531	0	P.55	109

CROSS SECTIONS - U.S. 50
STA. 1844+00.00 TO STA. 1845+00.00

DESIGN AGENCY

CARPENTER
MARTY

DESIGNER

MGM

REVIEWER

TES 11/07/24

PROJECT ID




118516

SHEET

P.55

TOTAL

109

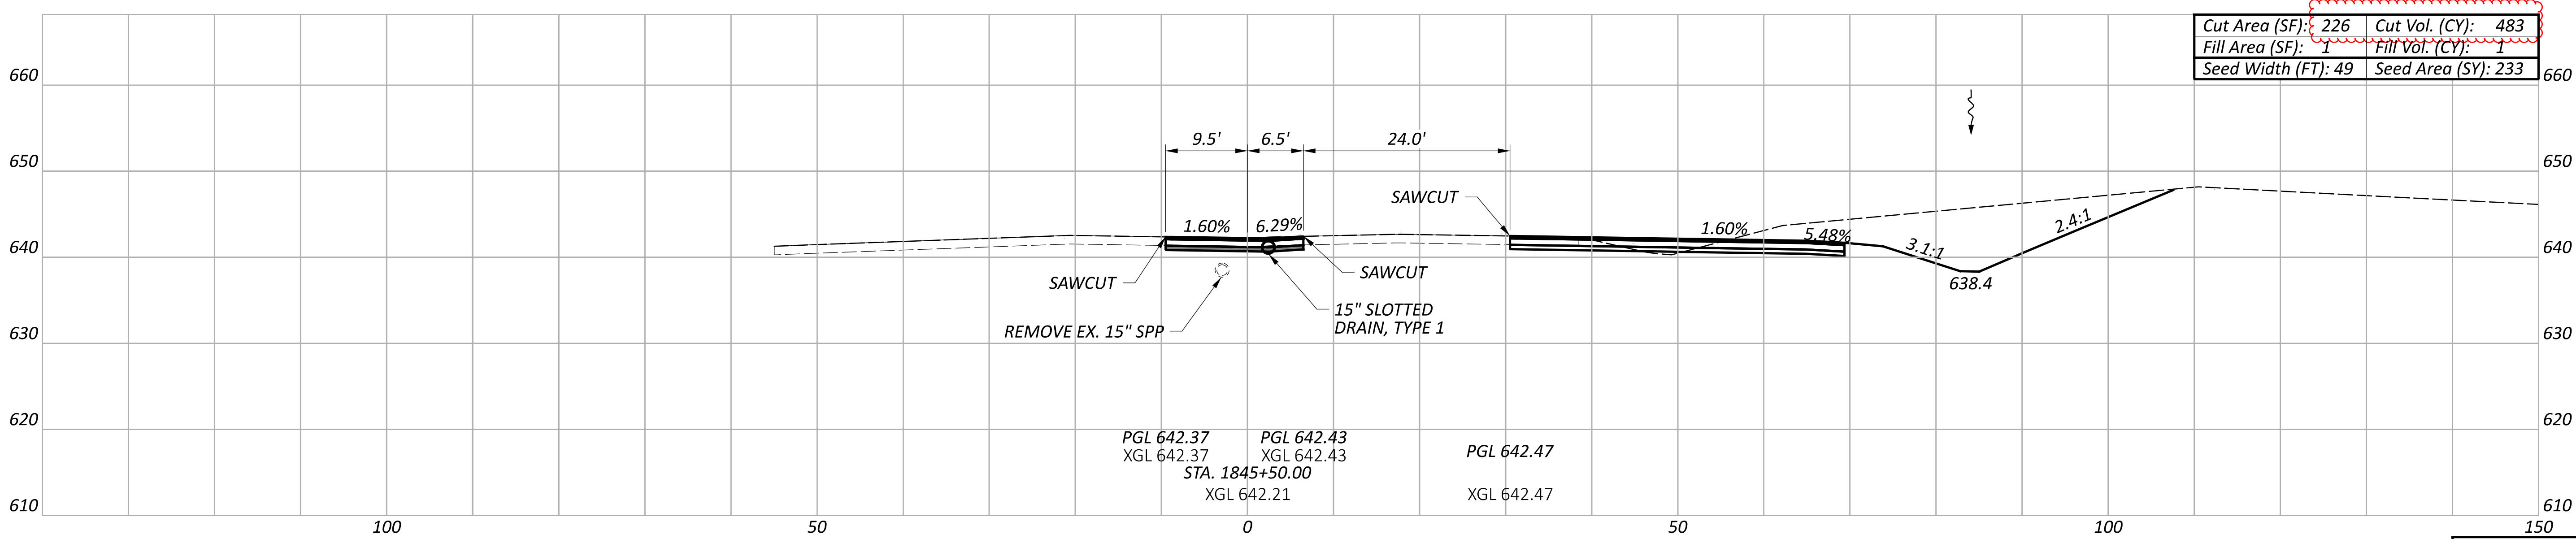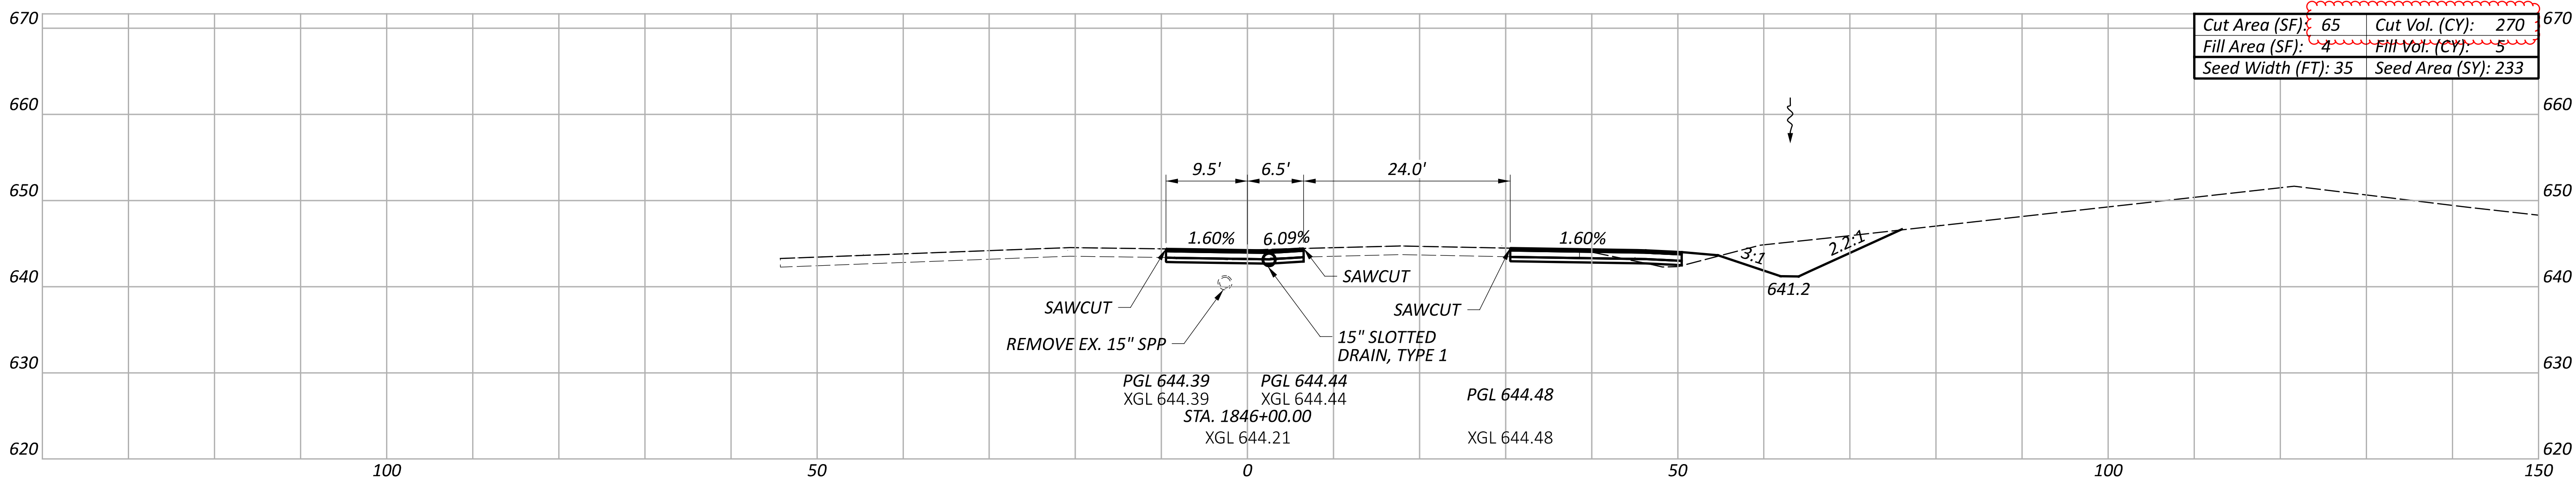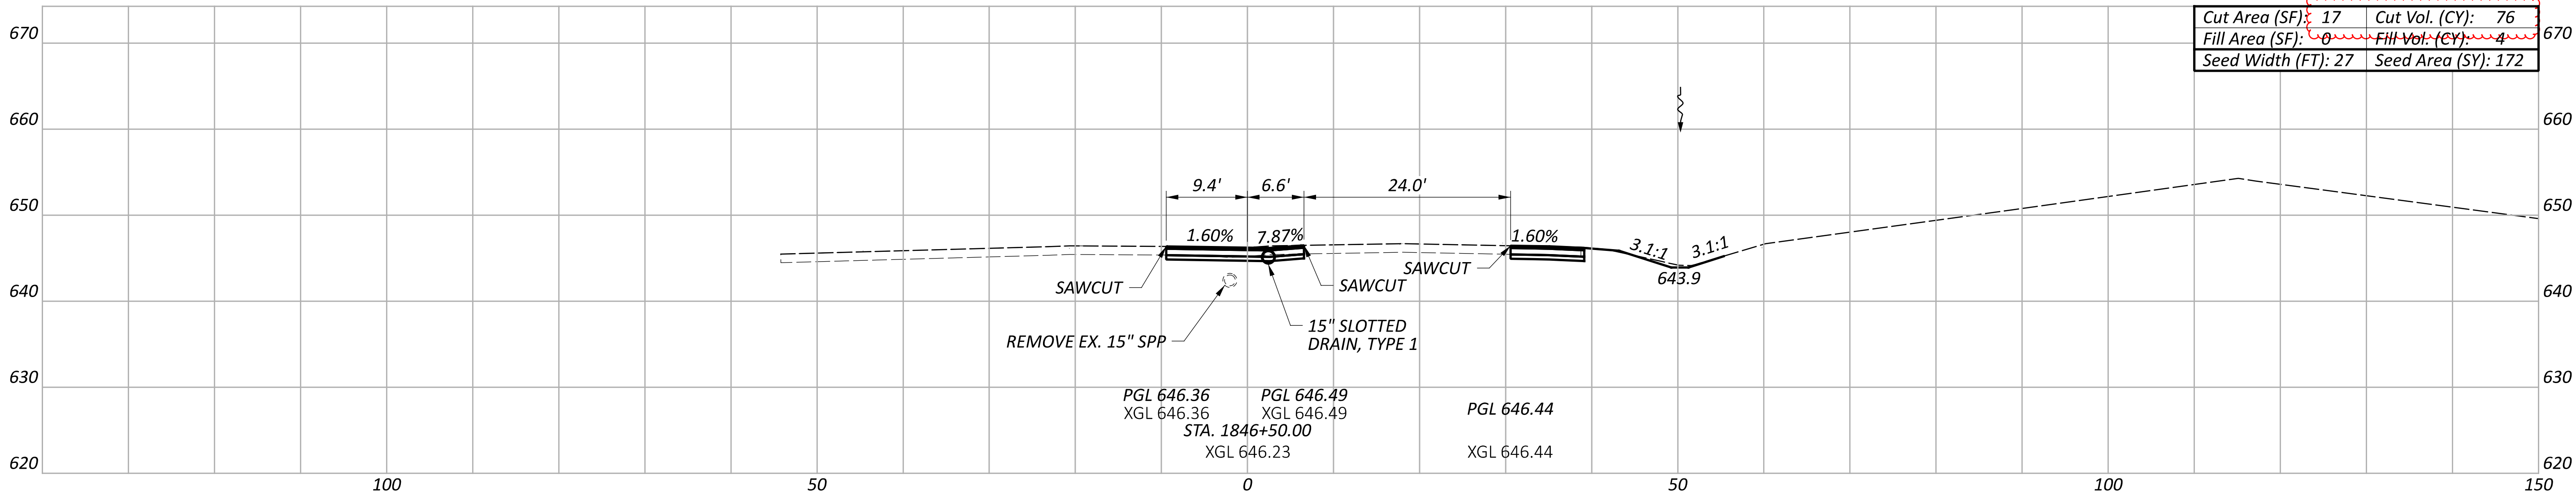

Sheet Totals			118516
Seeding	Cut	Fill	
638	829	10	

CROSS SECTIONS - U.S. 50
STA. 1845+50.00 TO STA. 1846+50.00

DESIGN AGENCY




CARPENTER MARTY

DESIGNER
MGM

REVIEWER
TES 11/07/24

PROJECT ID
118516

SHEET TOTAL
P.56 109

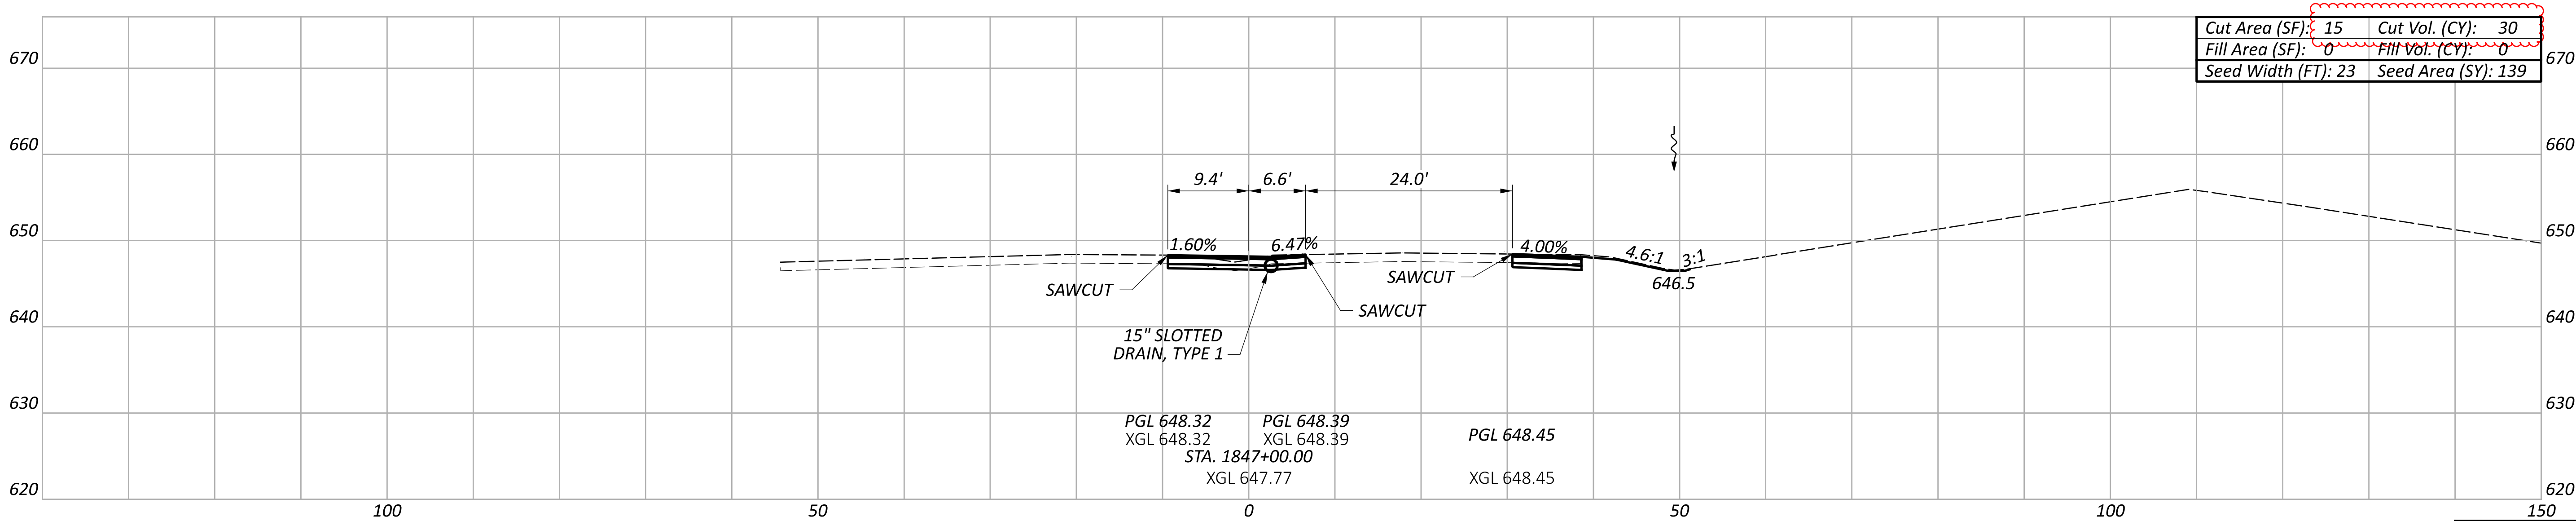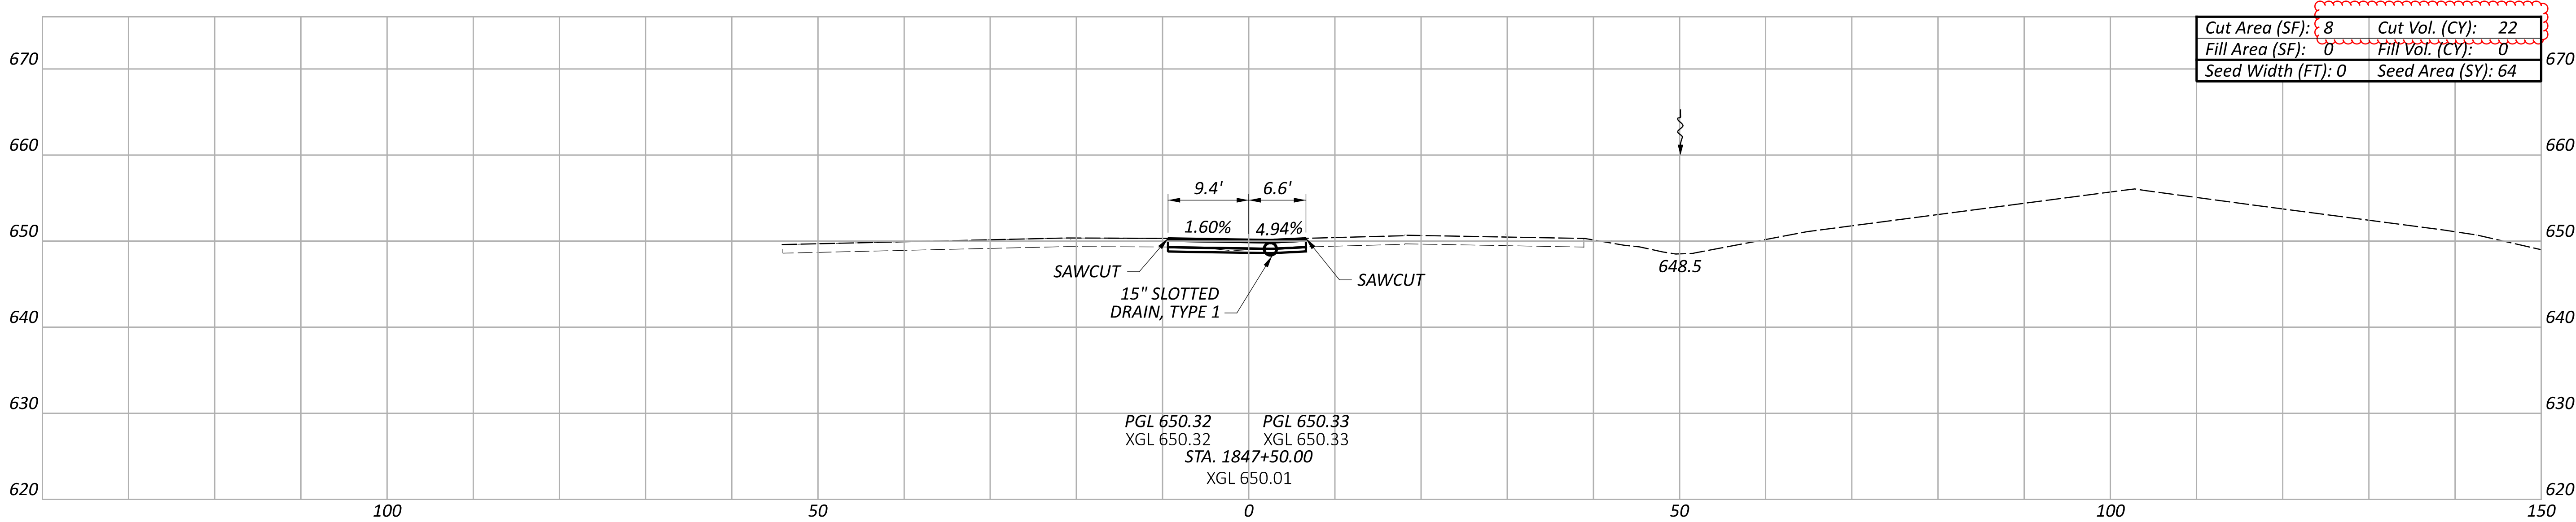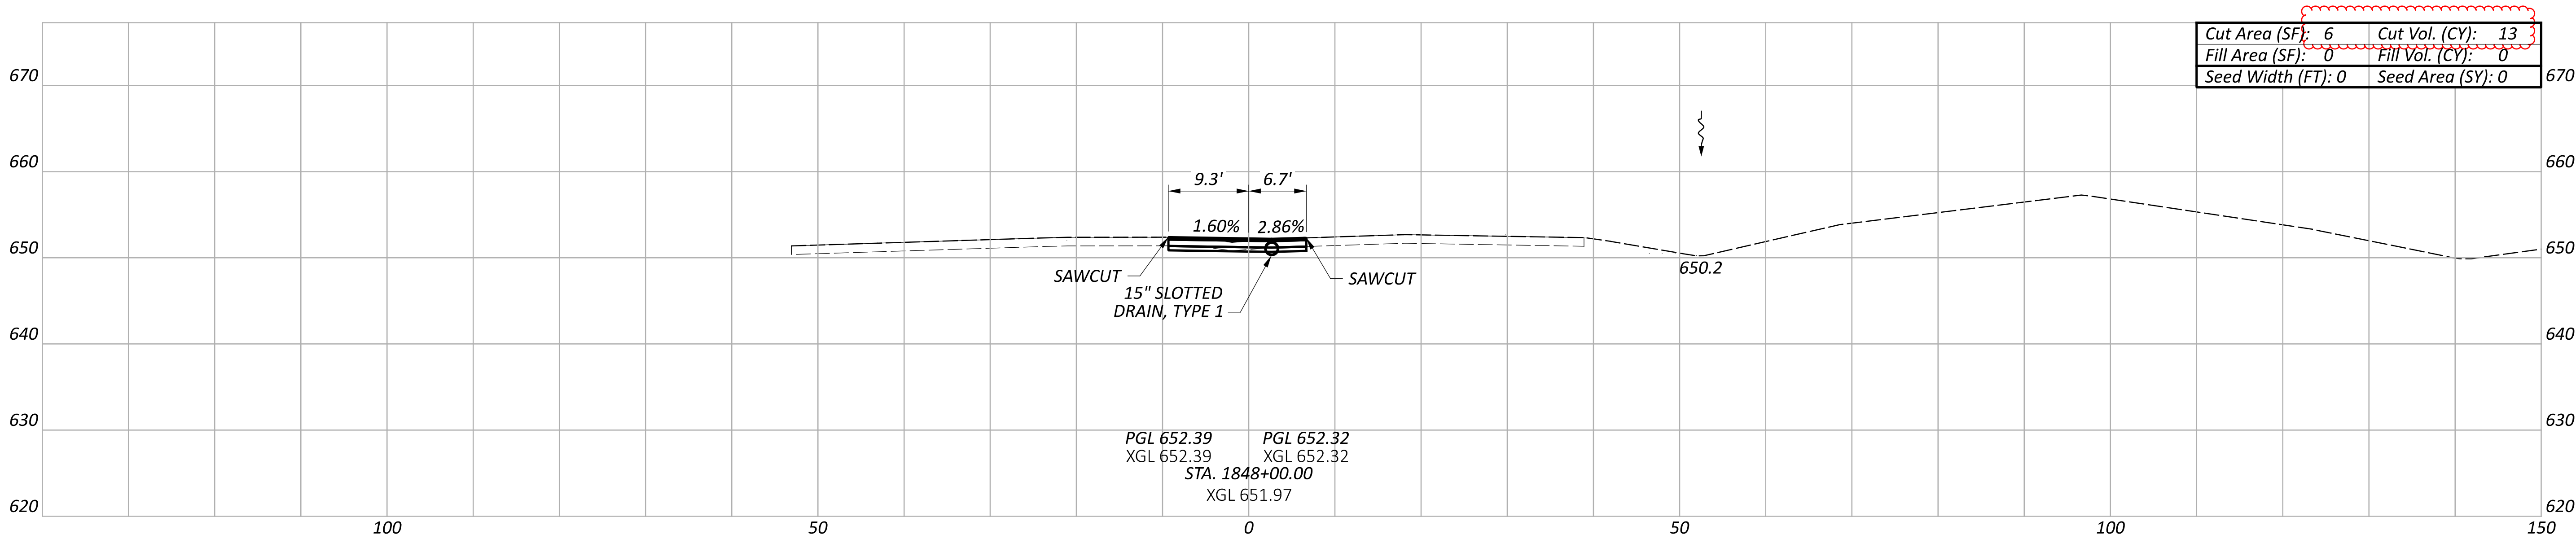

Sheet Totals			118516	
Seeding	Cut	Fill	SHEET	TOTAL
203	65	0	P.57	109

CROSS SECTIONS - U.S. 50
STA. 1847+00.00 TO STA. 1848+00.00

DESIGN AGENCY

CARPENTER
MARTY

DESIGNER




MGM

REVIEWER

TES 11/07/24

PROJECT ID

118516

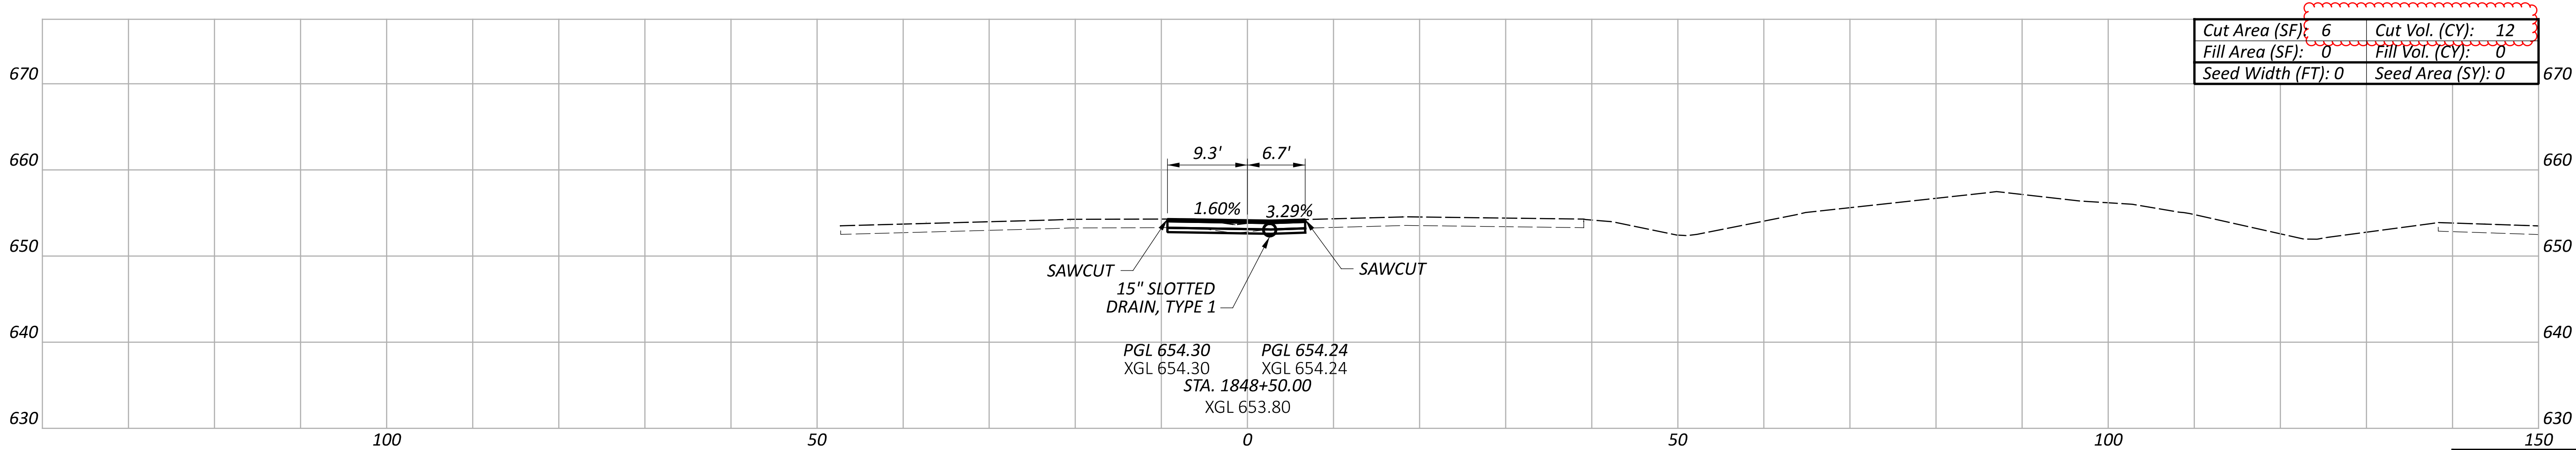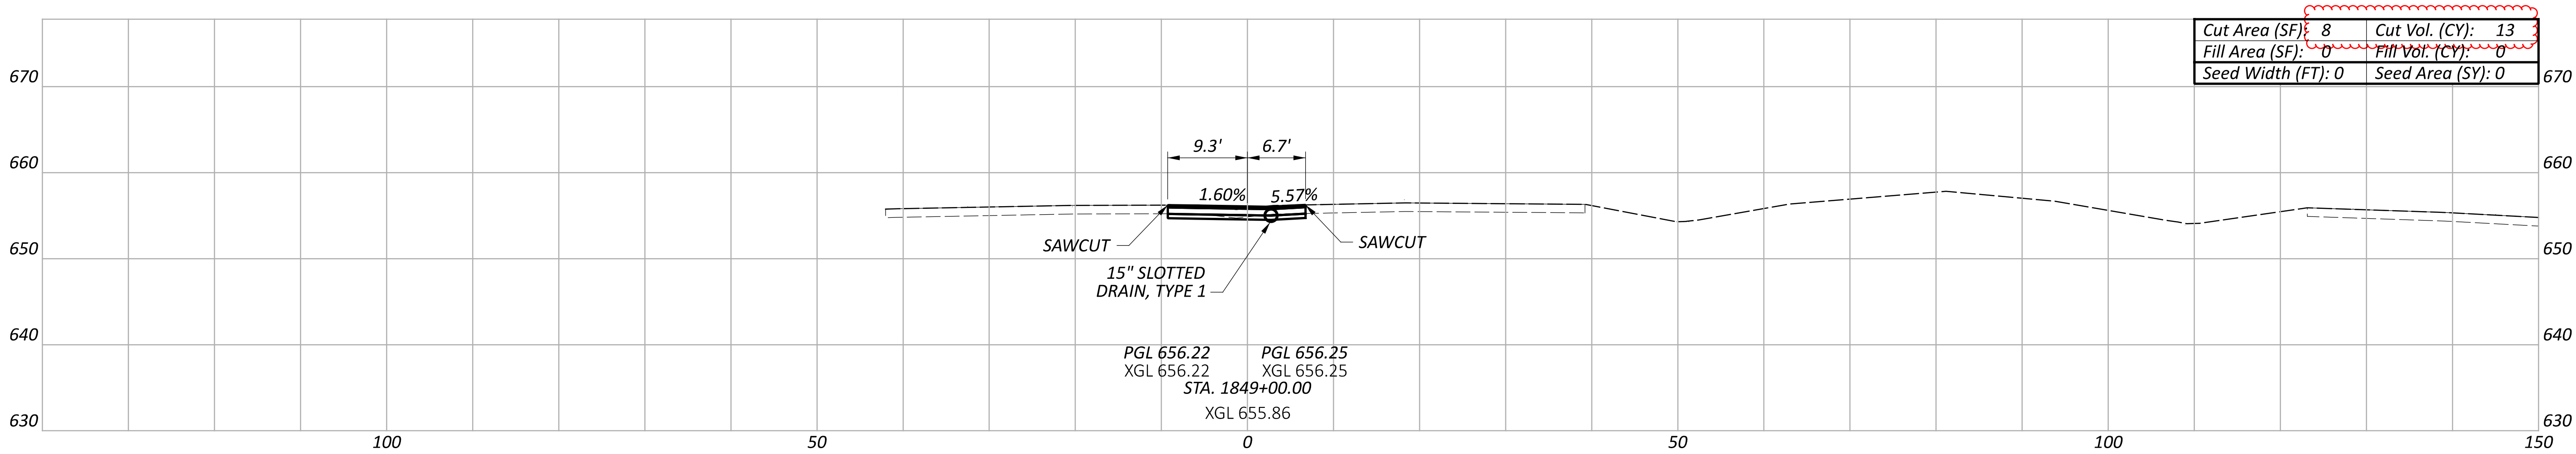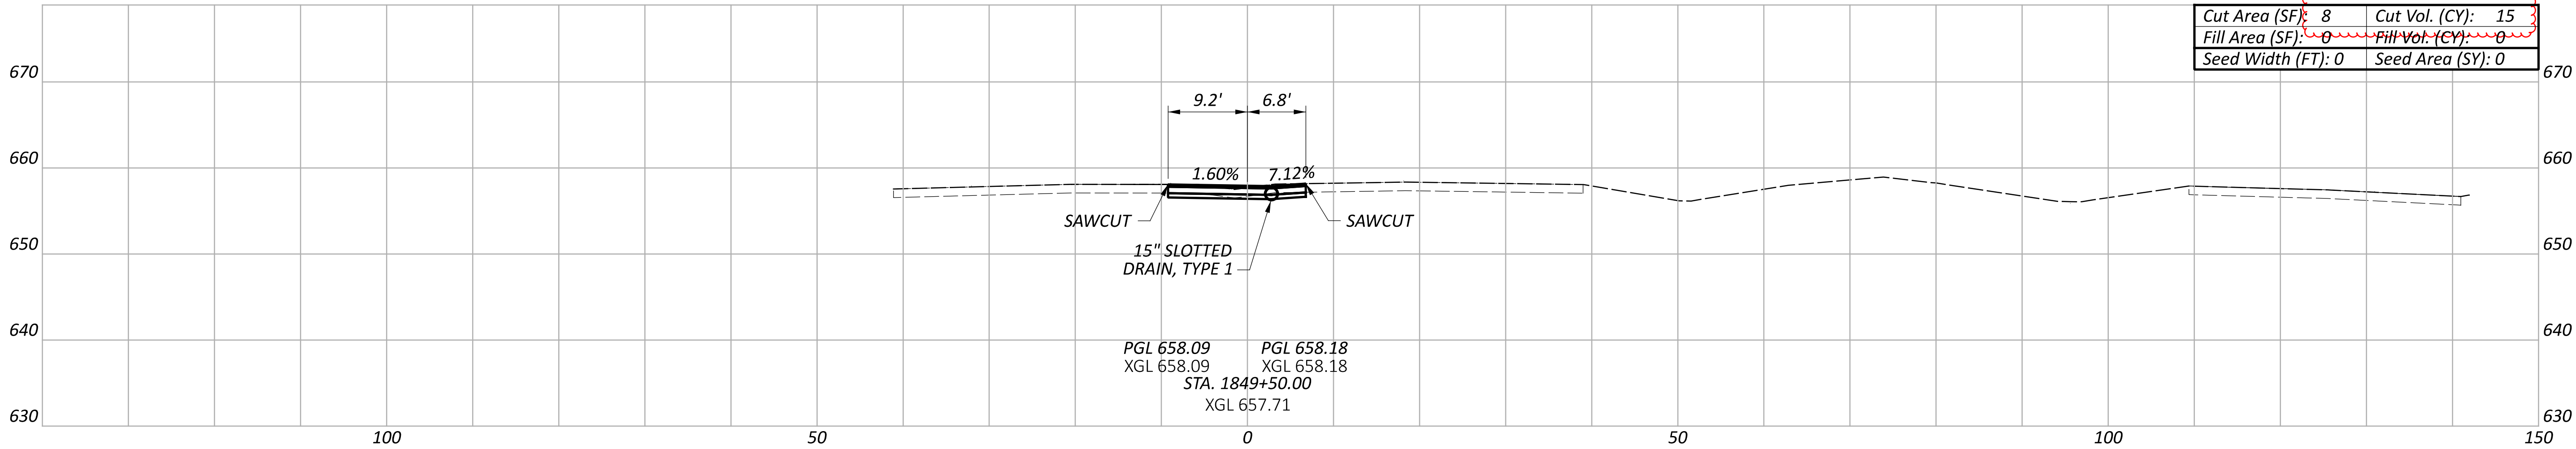

Sheet Totals			118516	
Seeding	Cut	Fill	SHEET	TOTAL
0	40	0	P.58	109

CROSS SECTIONS - U.S. 50
STA. 1848+50.00 TO STA. 1849+50.00

DESIGN AGENCY

CARPENTER MARTY

DESIGNER

MGM

REVIEWER

TES 11/07/24

PROJECT ID


118516

SHEET


P.58

TOTAL


109

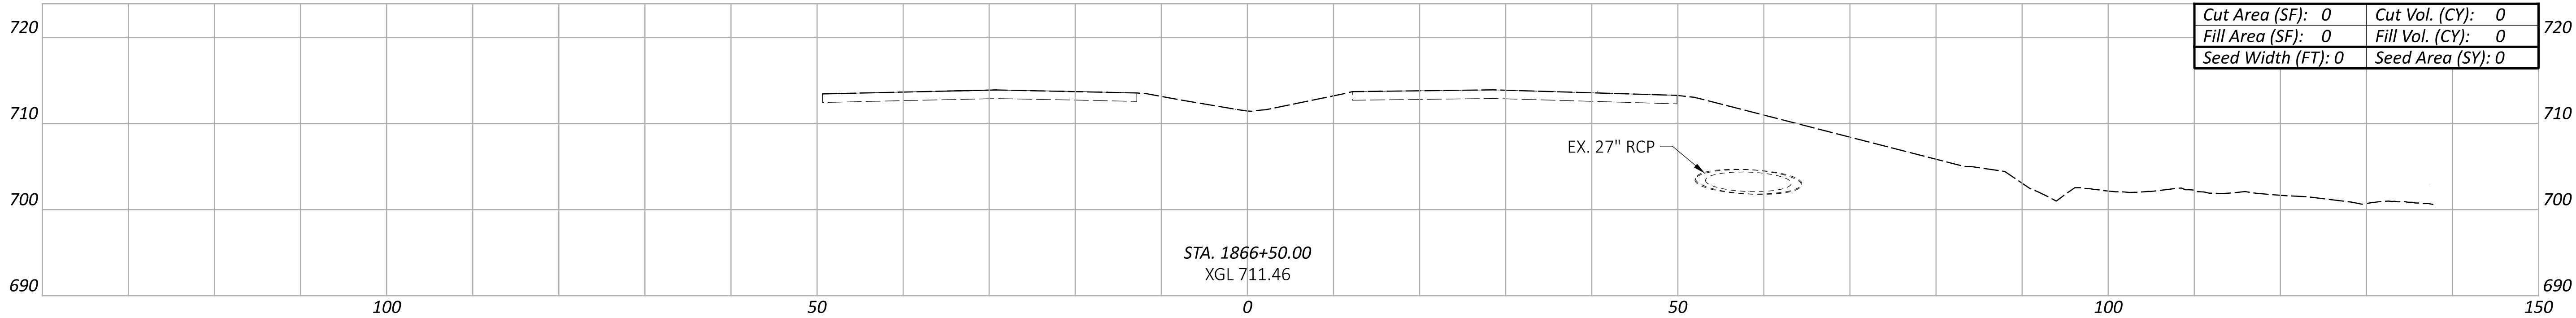

Cut Area (SF): 0	Cut Vol. (CY): 0
Fill Area (SF): 0	Fill Vol. (CY): 0
Seed Width (FT): 0	Seed Area (SY): 0

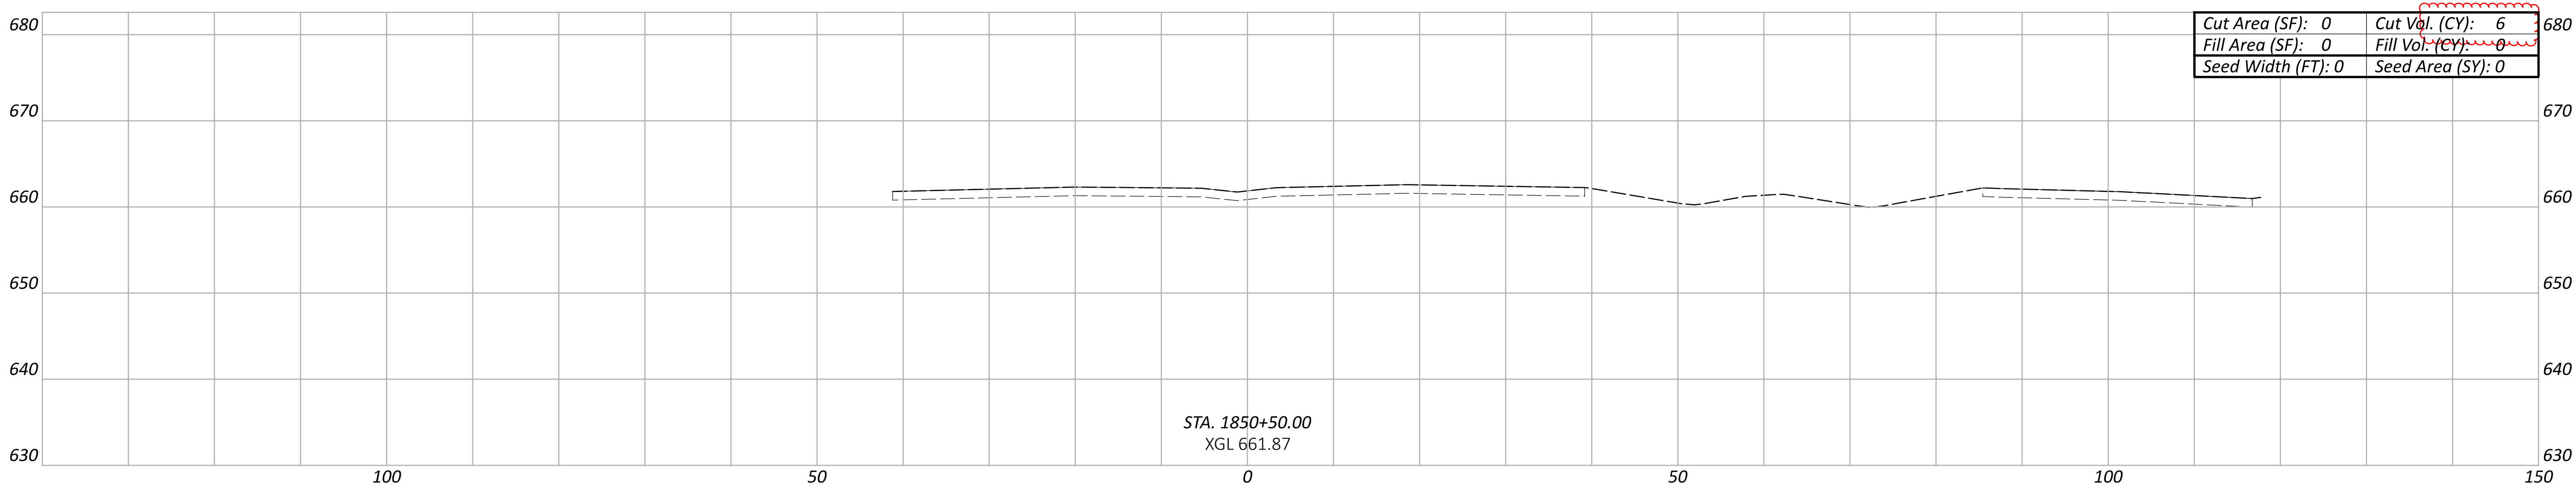

Cut Area (SF): 0	Cut Vol. (CY): 6
Fill Area (SF): 0	Fill Vol. (CY): 0
Seed Width (FT): 0	Seed Area (SY): 0

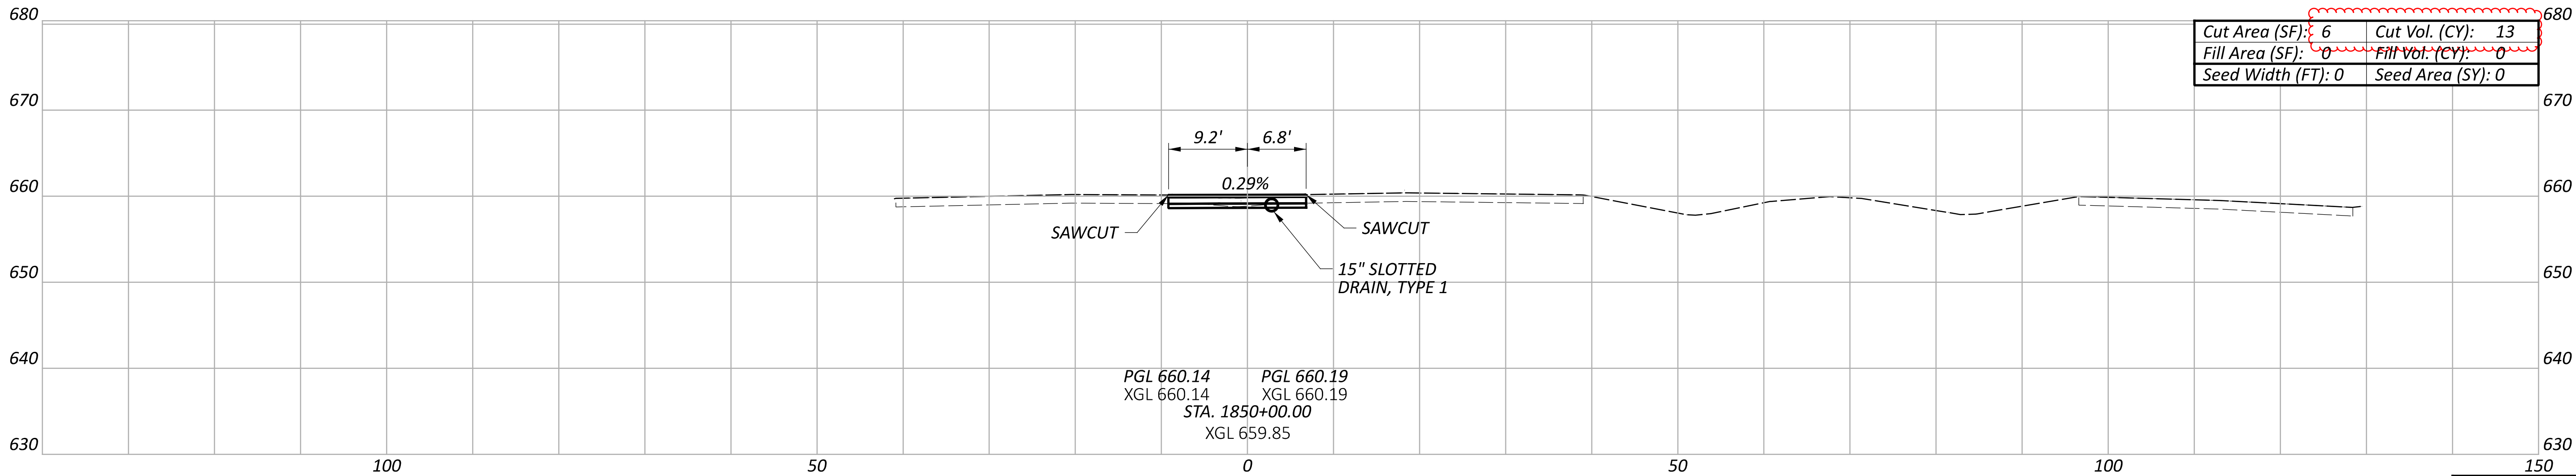

Cut Area (SF): 6	Cut Vol. (CY): 13
Fill Area (SF): 0	Fill Vol. (CY): 0
Seed Width (FT): 0	Seed Area (SY): 0

Sheet Totals		
Seeding	Cut	Fill
0	19	0

DESIGN AGENCY



CARPENTER
MARTY

DESIGNER

MGM

REVIEWER

TES 11/07/24

PROJECT ID





118516

SHEET

P.59

TOTAL

109

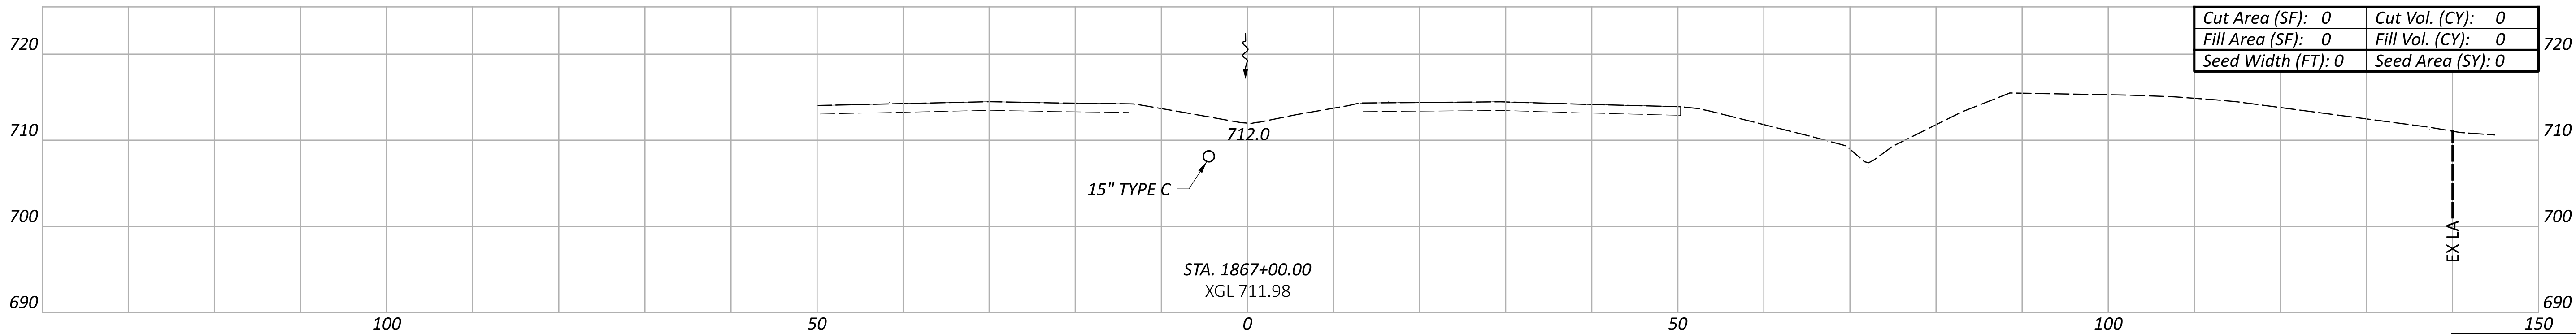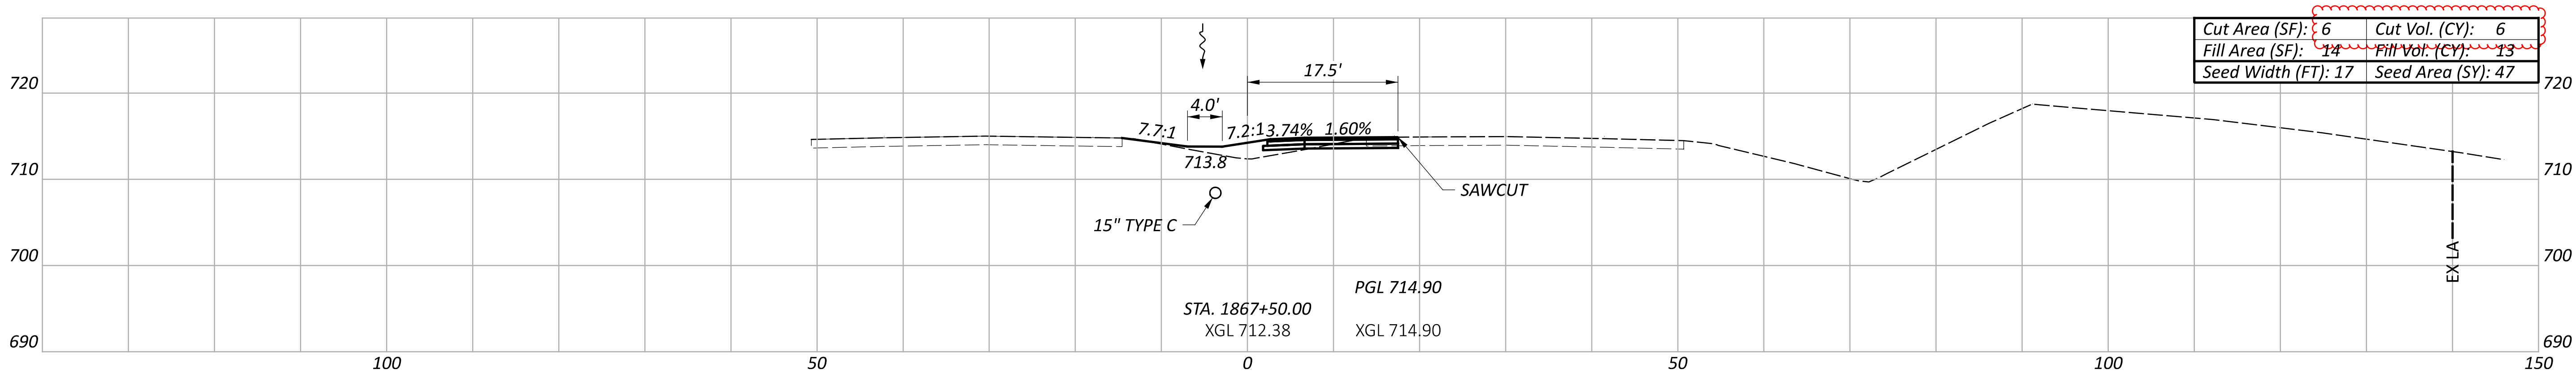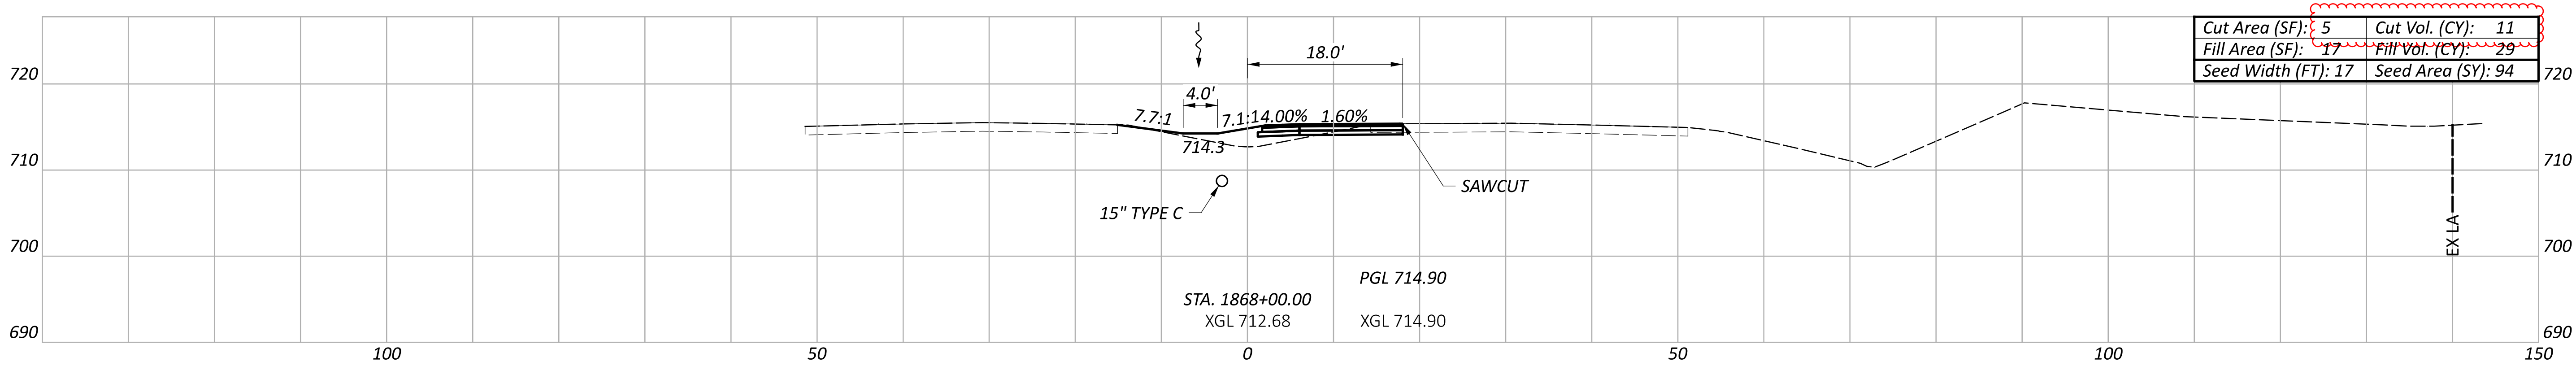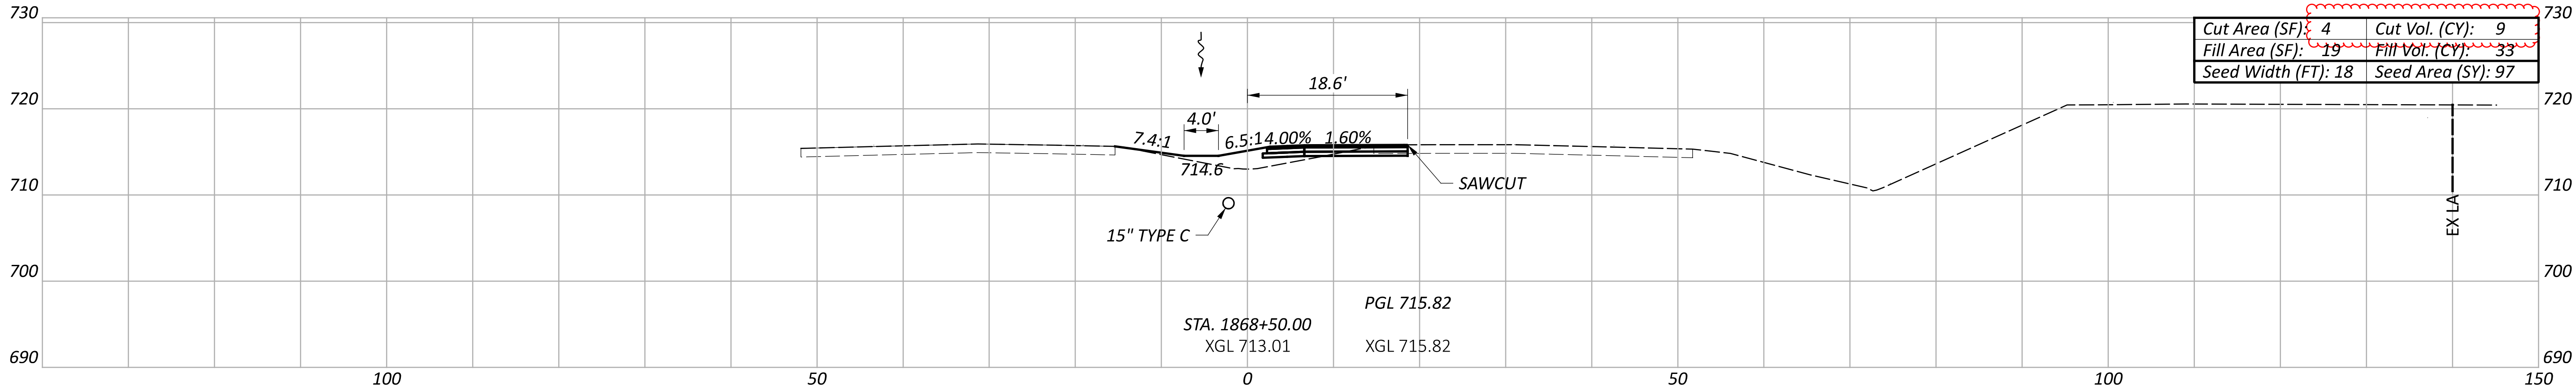

Sheet Totals		
Seeding	Cut	Fill
238	26	75

CROSS SECTIONS - U.S. 50
STA. 1867+00.00 TO STA. 1868+50.00

DESIGN AGENCY



DESIGNER

BAC

REVIEWER

TWG 11/07/24

PROJECT ID





118516

SHEET





P.60

TOTAL

109

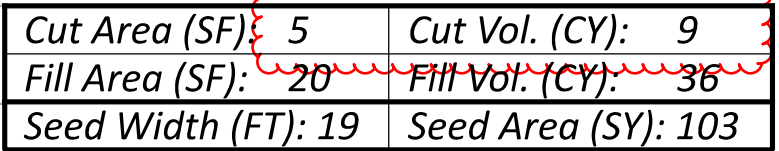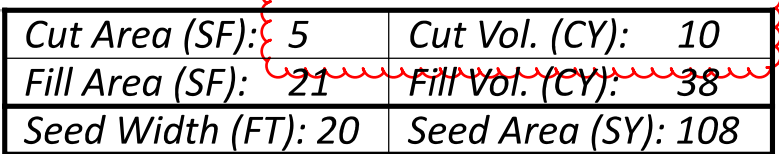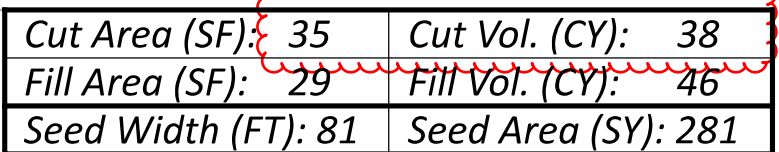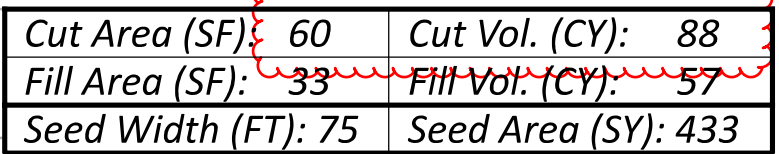

Sheet Totals			118516	
Seeding	Cut	Fill	SHEET	TOTAL
925	145	177	P.61	109

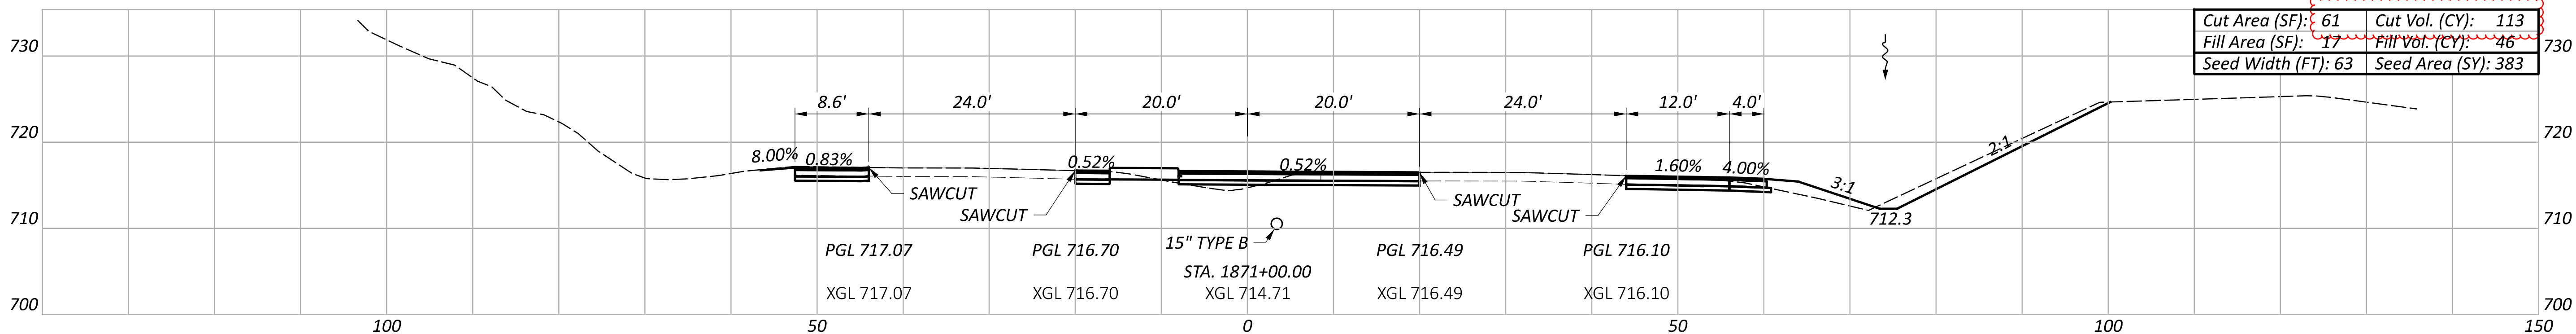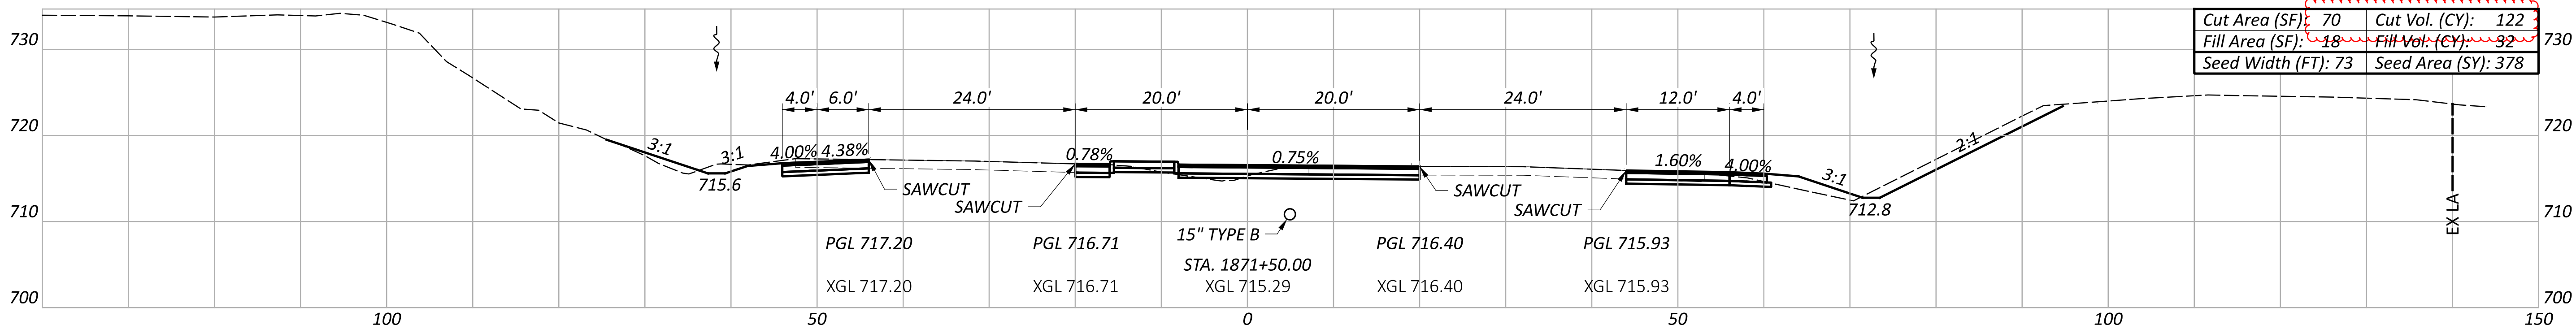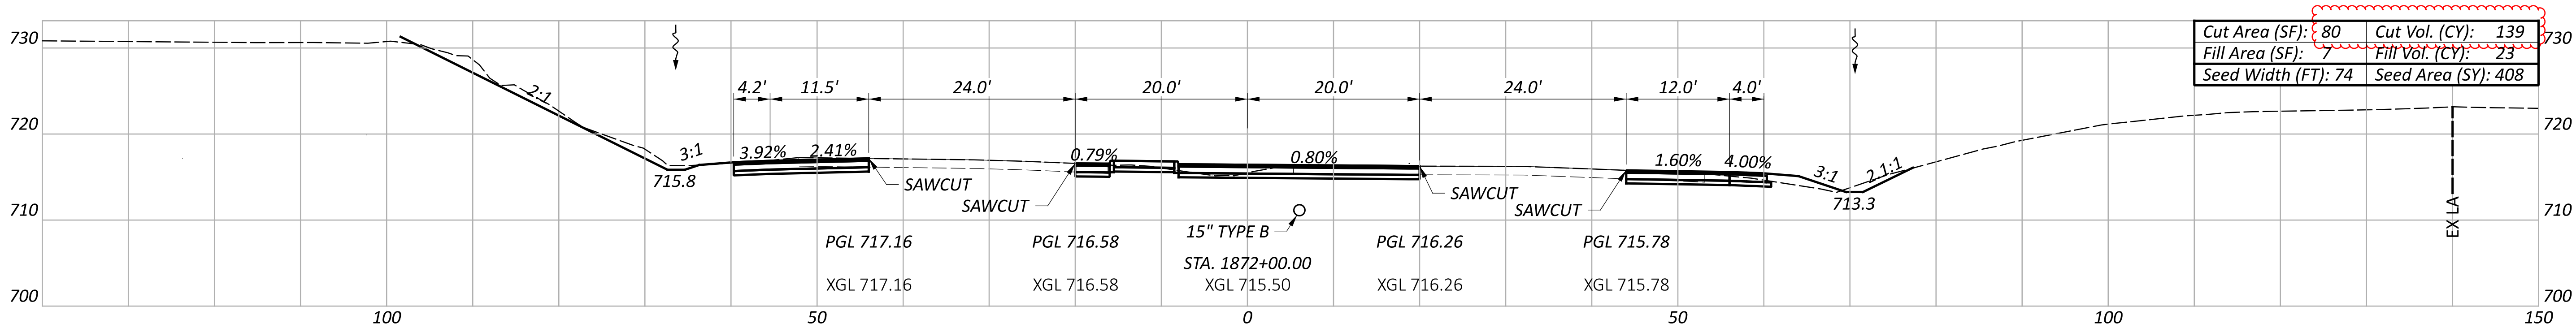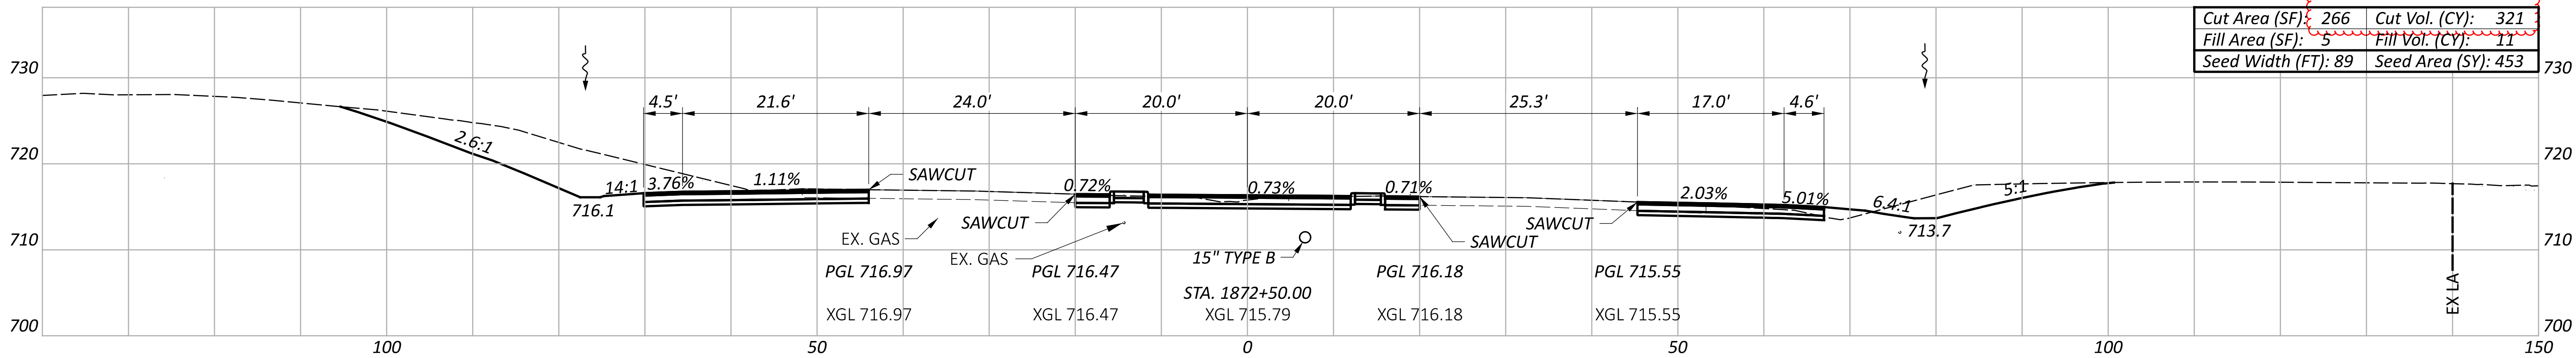

Sheet Totals			118516	
Seeding	Cut	Fill	SHEET	TOTAL
1622	695	112	P.62	109

CROSS SECTIONS - U.S. 50
STA. 1871+00.00 TO STA. 1872+50.00

DESIGN AGENCY

CARPENTER MARTY

DESIGNER





BAC

REVIEWER

TWG 11/07/24

PROJECT ID

118516

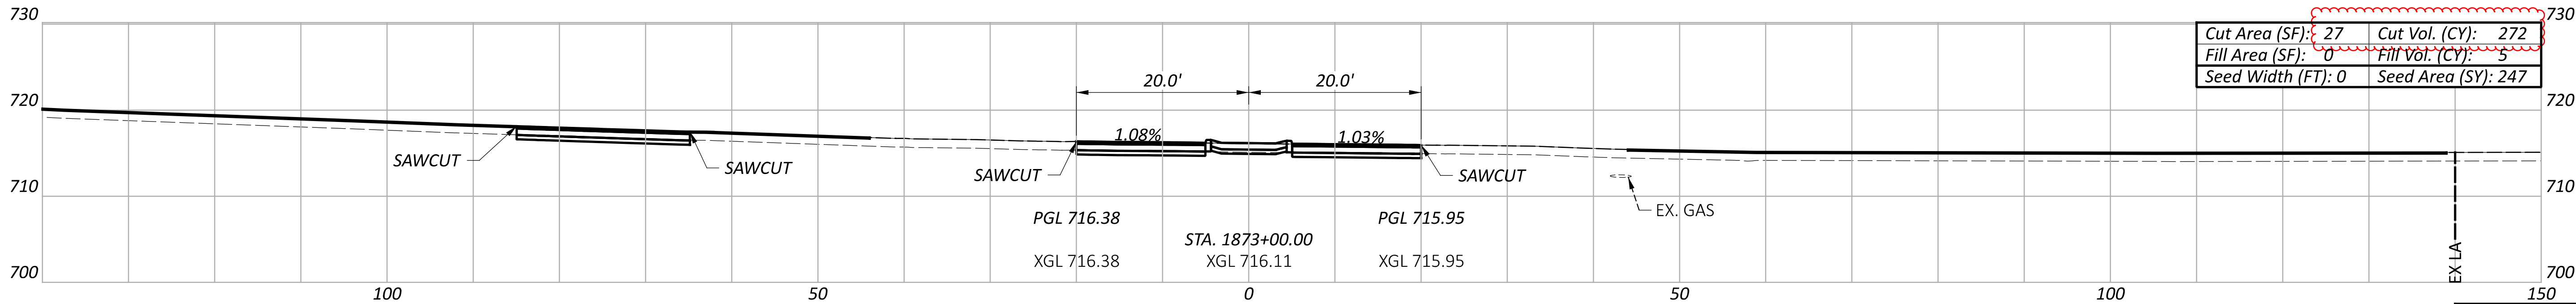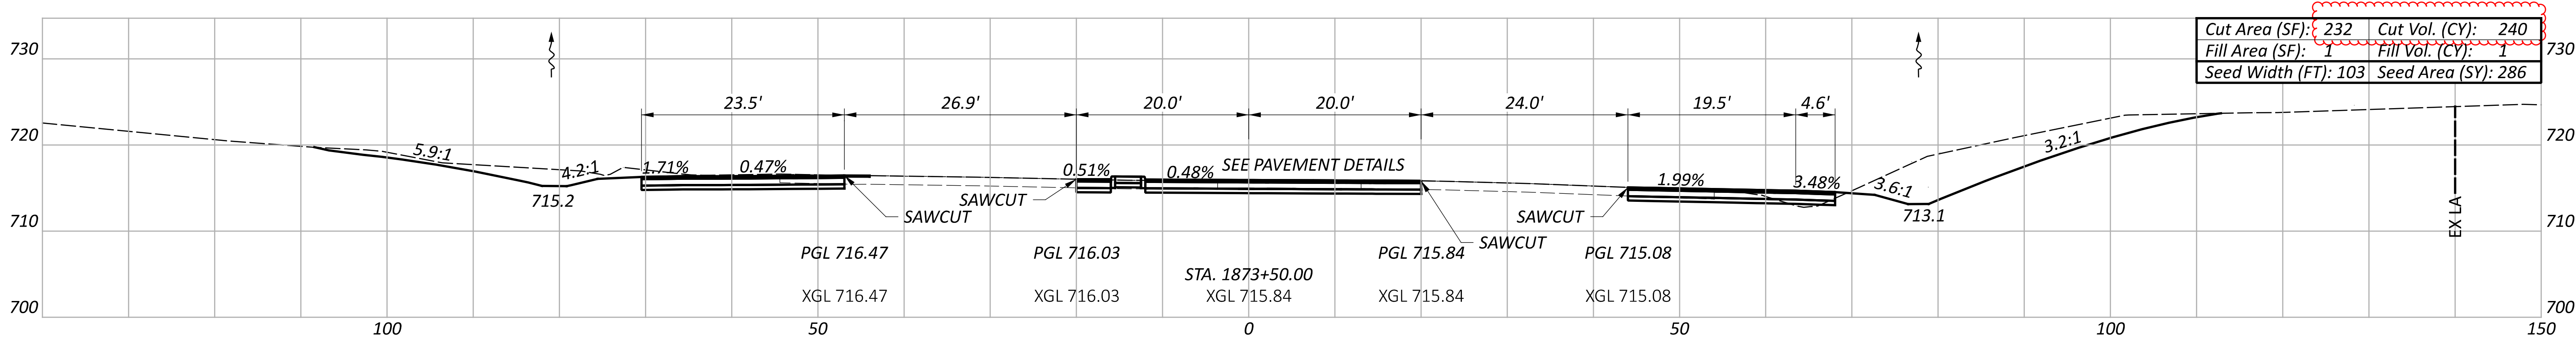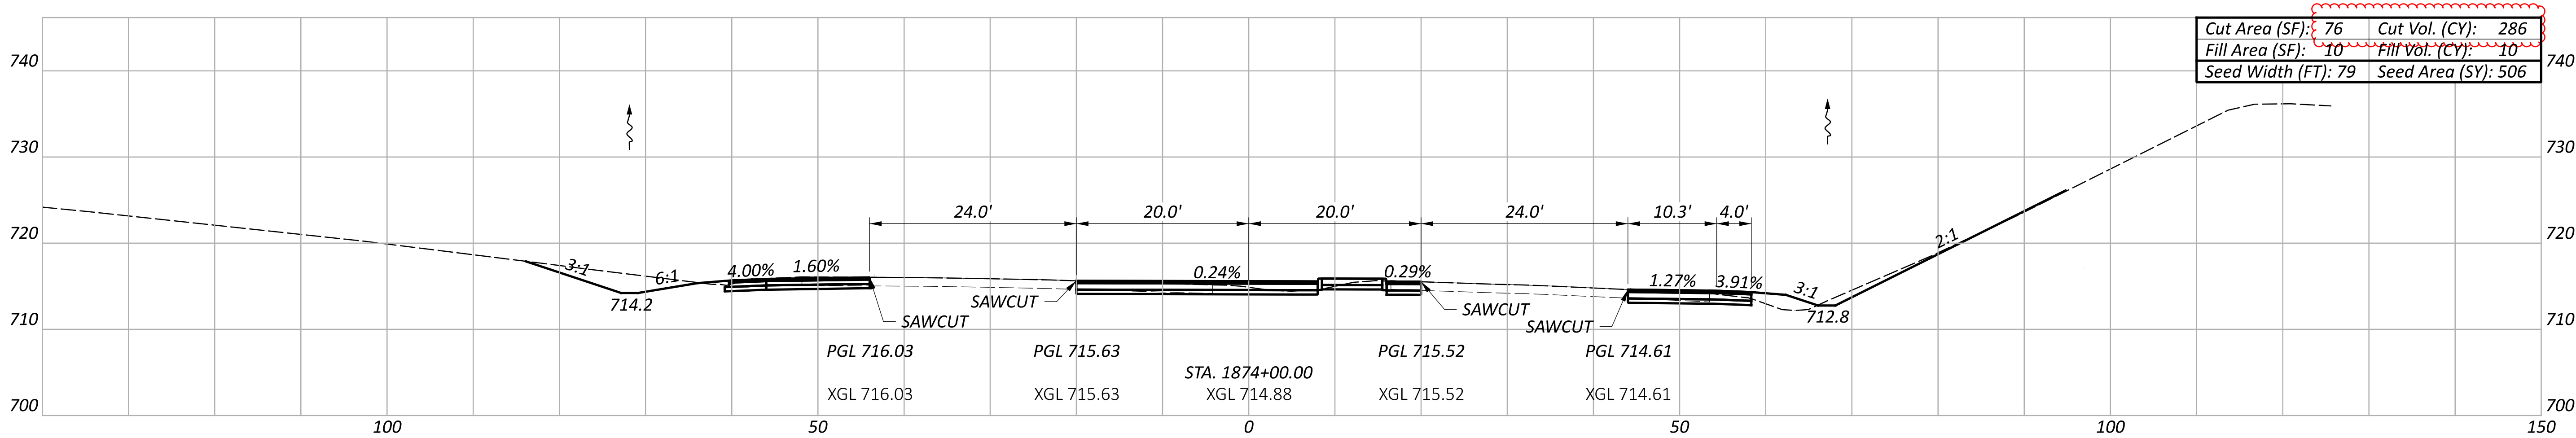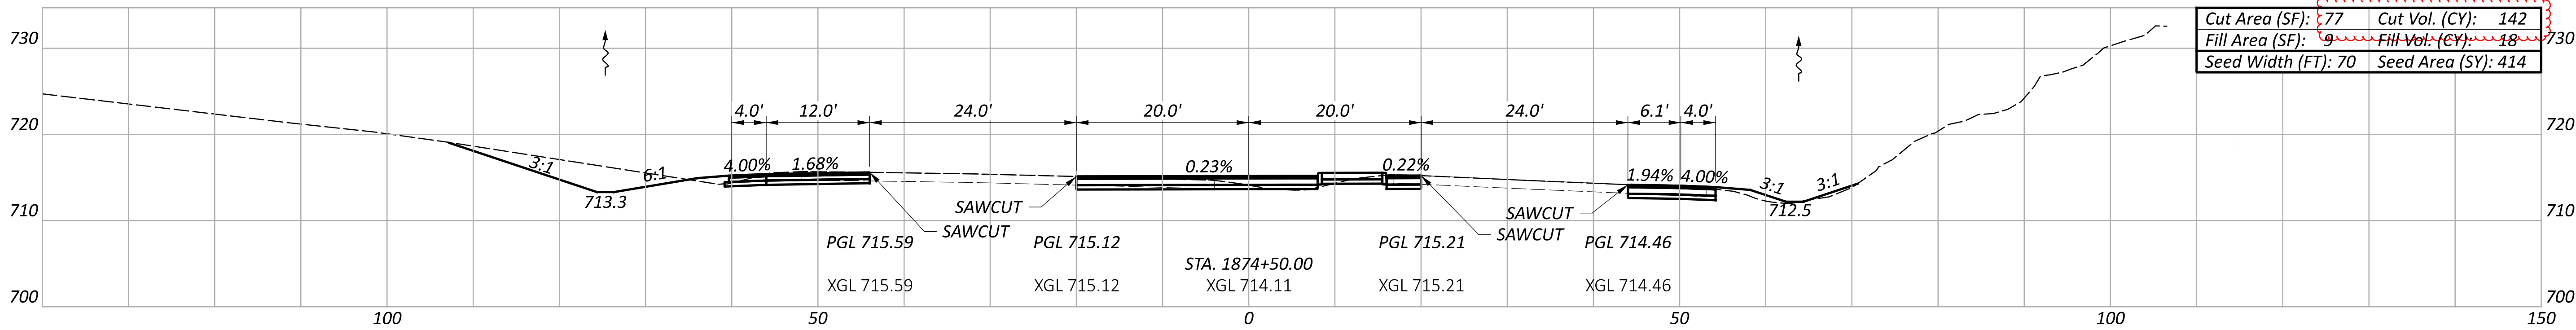

Sheet Totals			118516	
Seeding	Cut	Fill	SHEET	TOTAL
1453	940	34	P.63	109





CROSS SECTIONS - U.S. 50
STA. 1873+00.00 TO STA. 1874+50.00

DESIGN AGENCY
CARPENTER
MARTY

DESIGNER
BAC

REVIEWER
TWG 11/07/24




PROJECT ID
118516

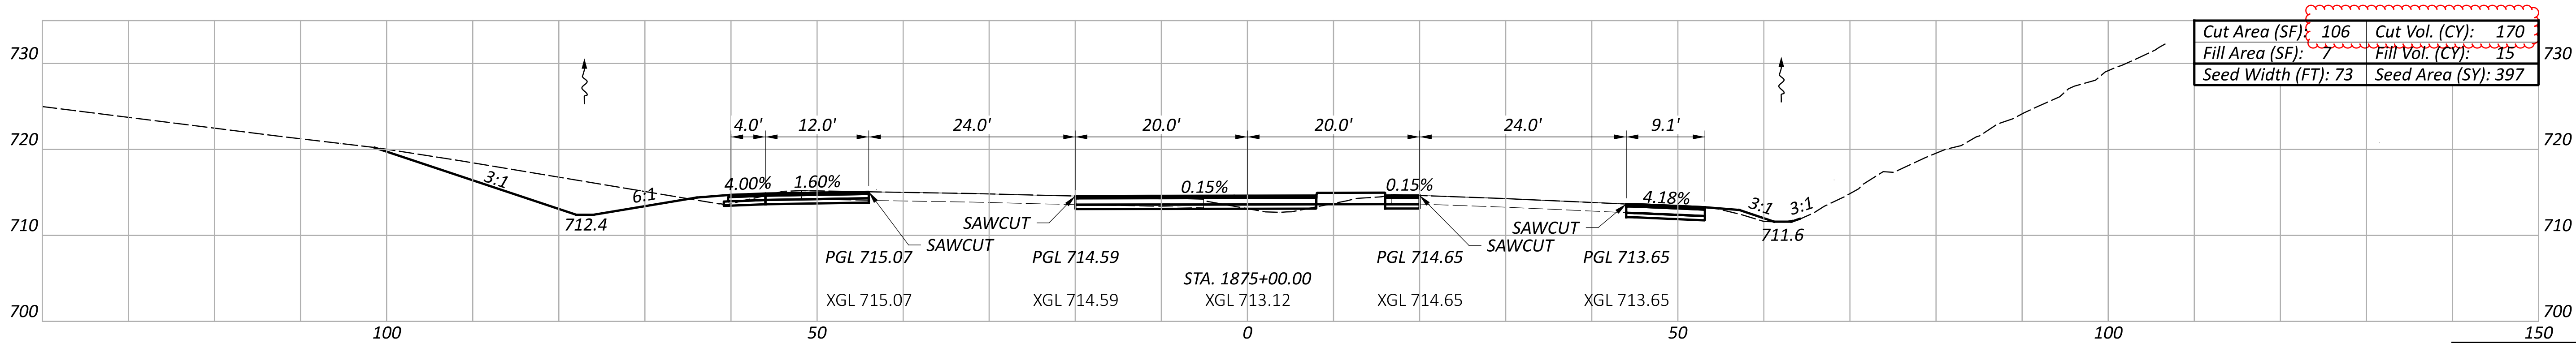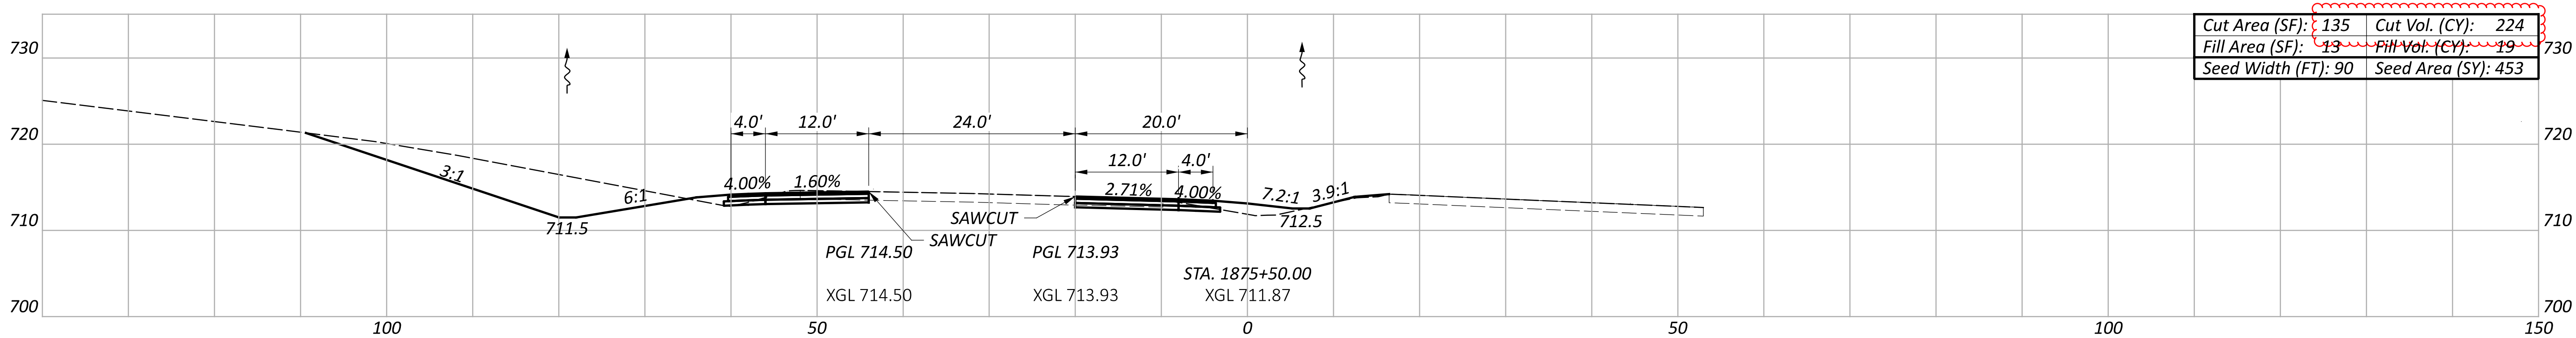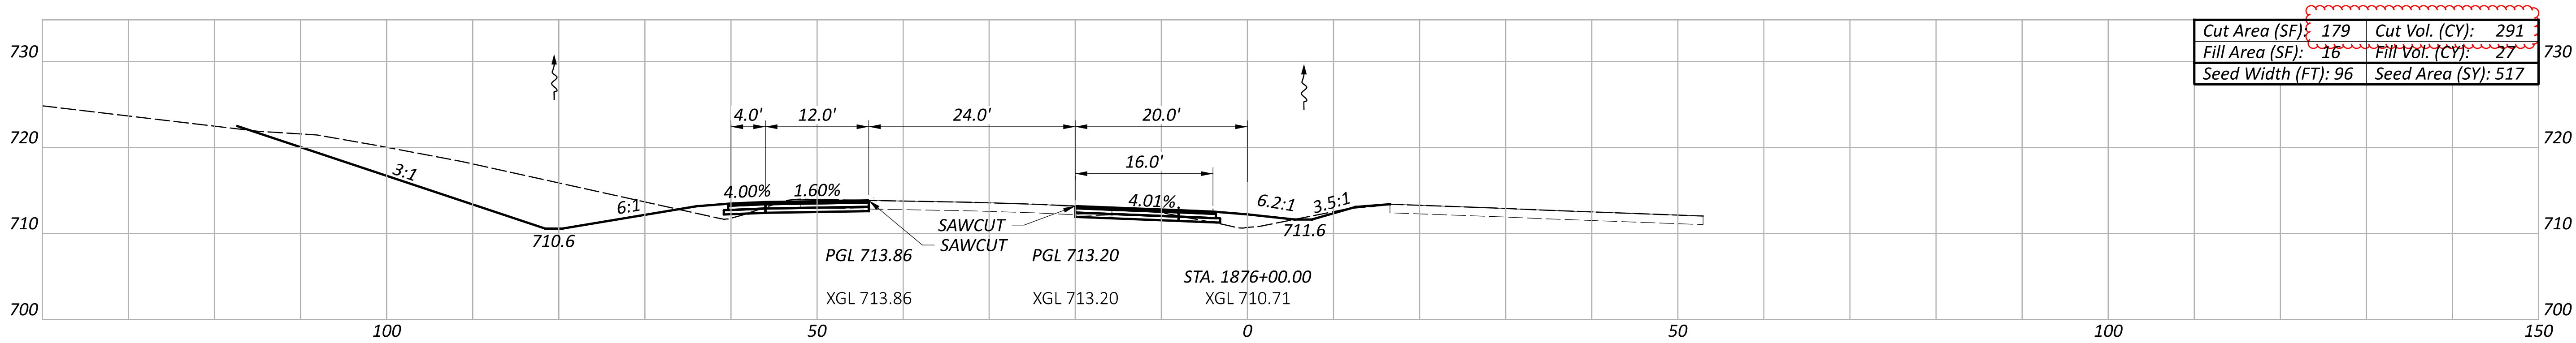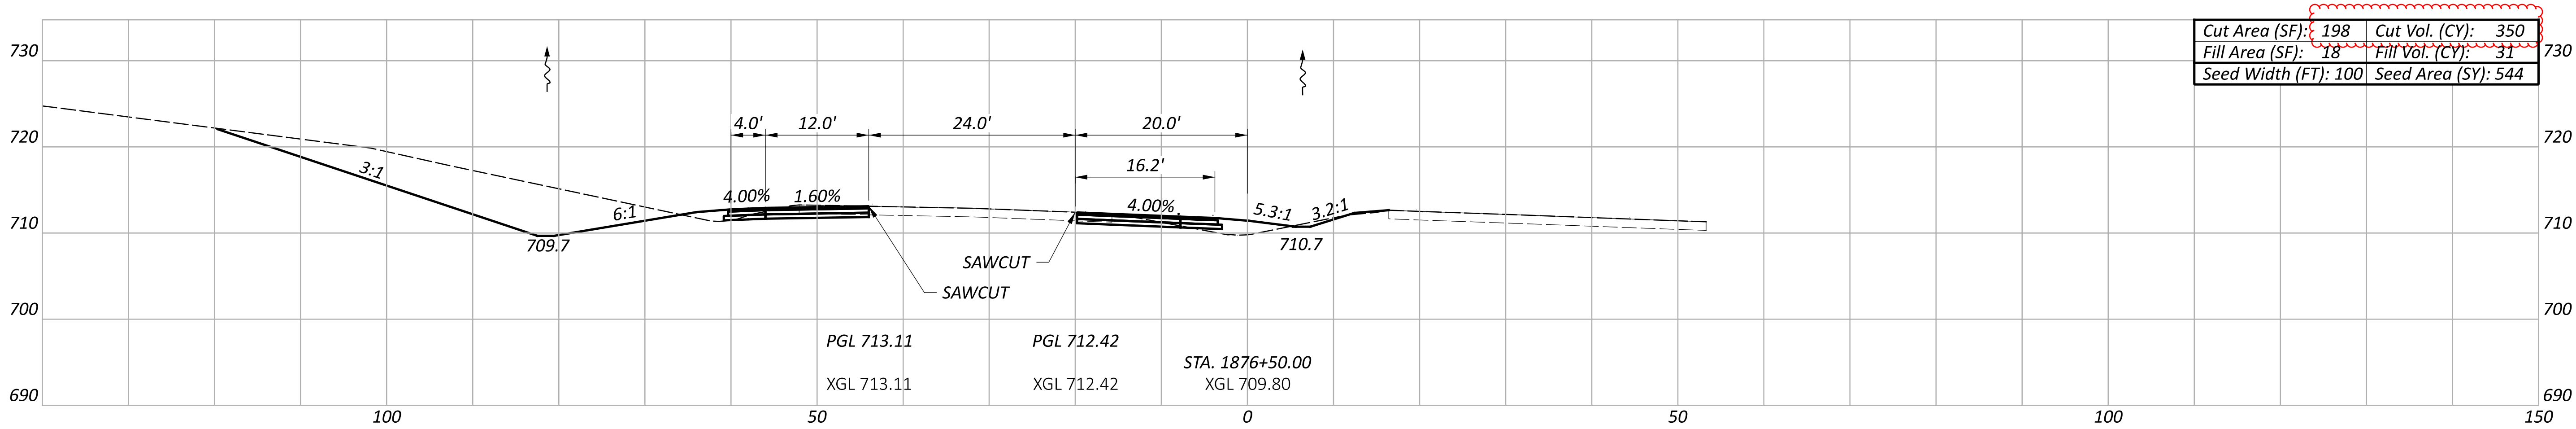

Sheet Totals			118516	
Seeding	Cut	Fill	SHEET	TOTAL
1911	1035	92	P.64	109





CROSS SECTIONS - U.S. 50
STA. 1875+00.00 TO STA. 1876+50.00

DESIGN AGENCY	
CARPENTER MARTY	
DESIGNER	
BAC	
REVIEWER	
TWG 11/07/24	
PROJECT ID	
118516	

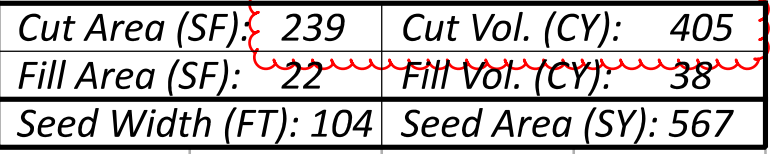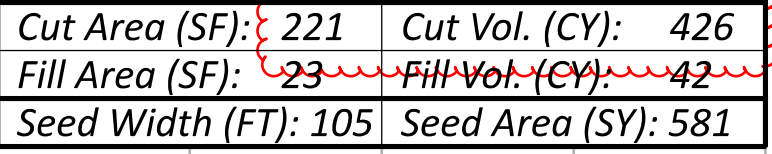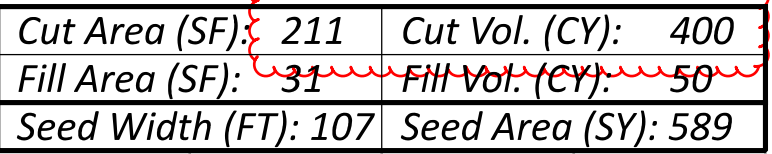

Sheet Totals			118516	
Seeding	Cut	Fill	SHEET	TOTAL
1737	1231	130	P.65	109

CROSS SECTIONS - U.S. 50
STA. 1877+00.00 TO STA. 1878+00.00

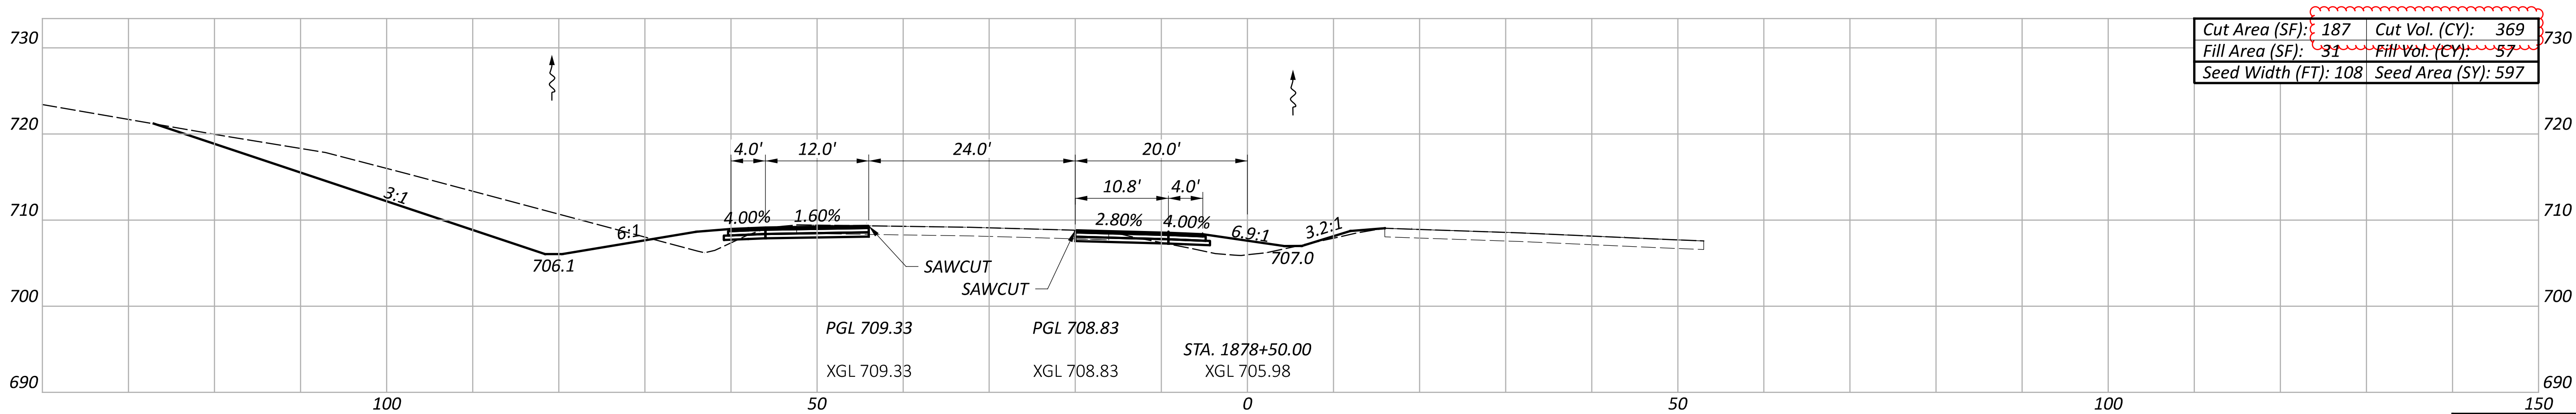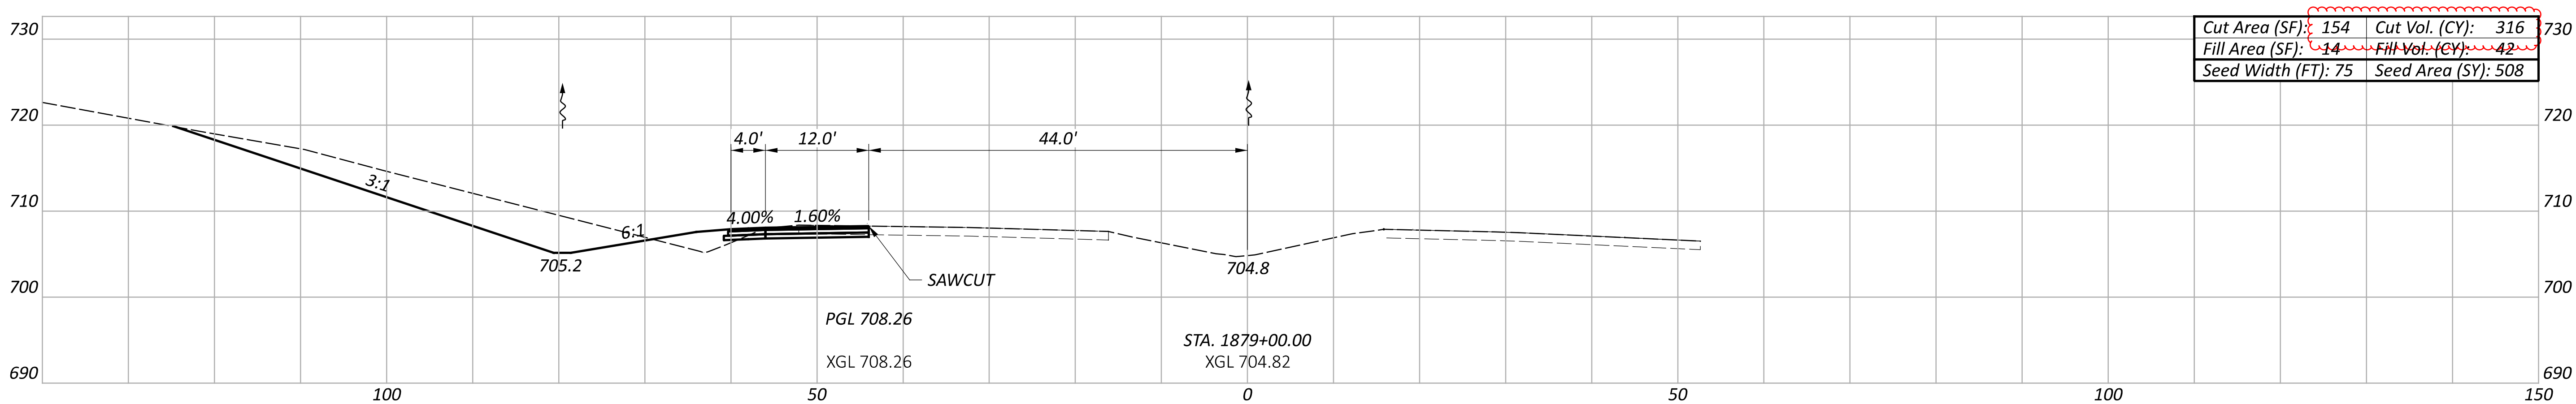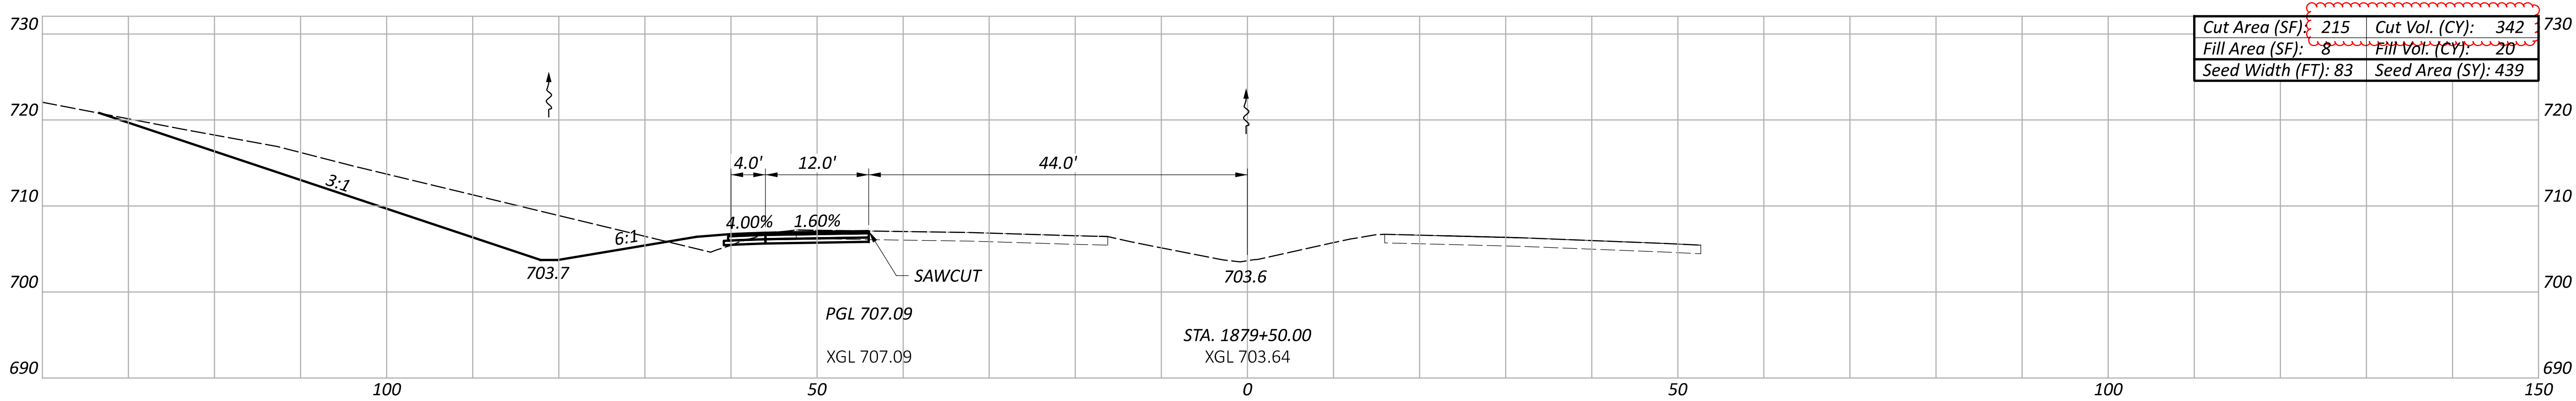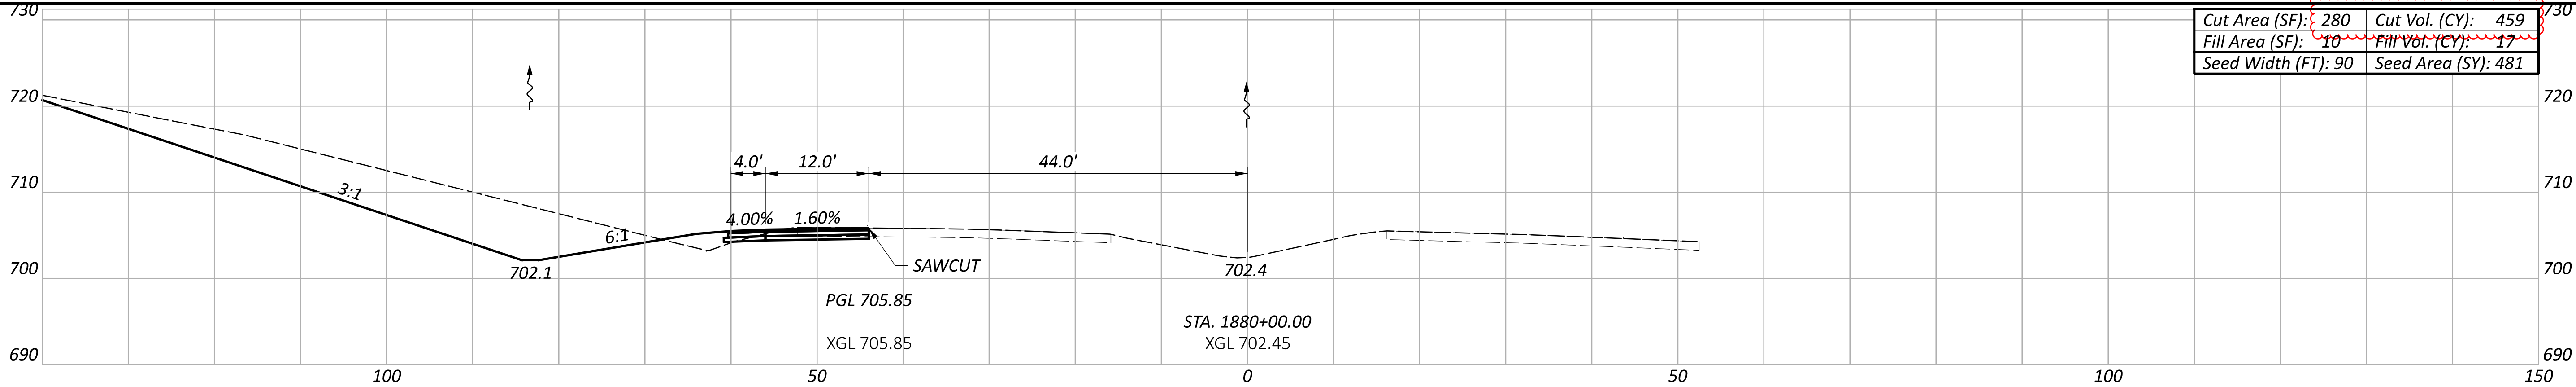

Sheet Totals			118516	
Seeding	Cut	Fill	SHEET	TOTAL
2025	1486	136	P.66	109

CROSS SECTIONS - U.S. 50
STA. 1878+50.00 TO STA. 1880+00.00

DESIGN AGENCY

CARPENTER
MARTY

DESIGNER




BAC

REVIEWER

TWG 11/07/24

PROJECT ID

118516

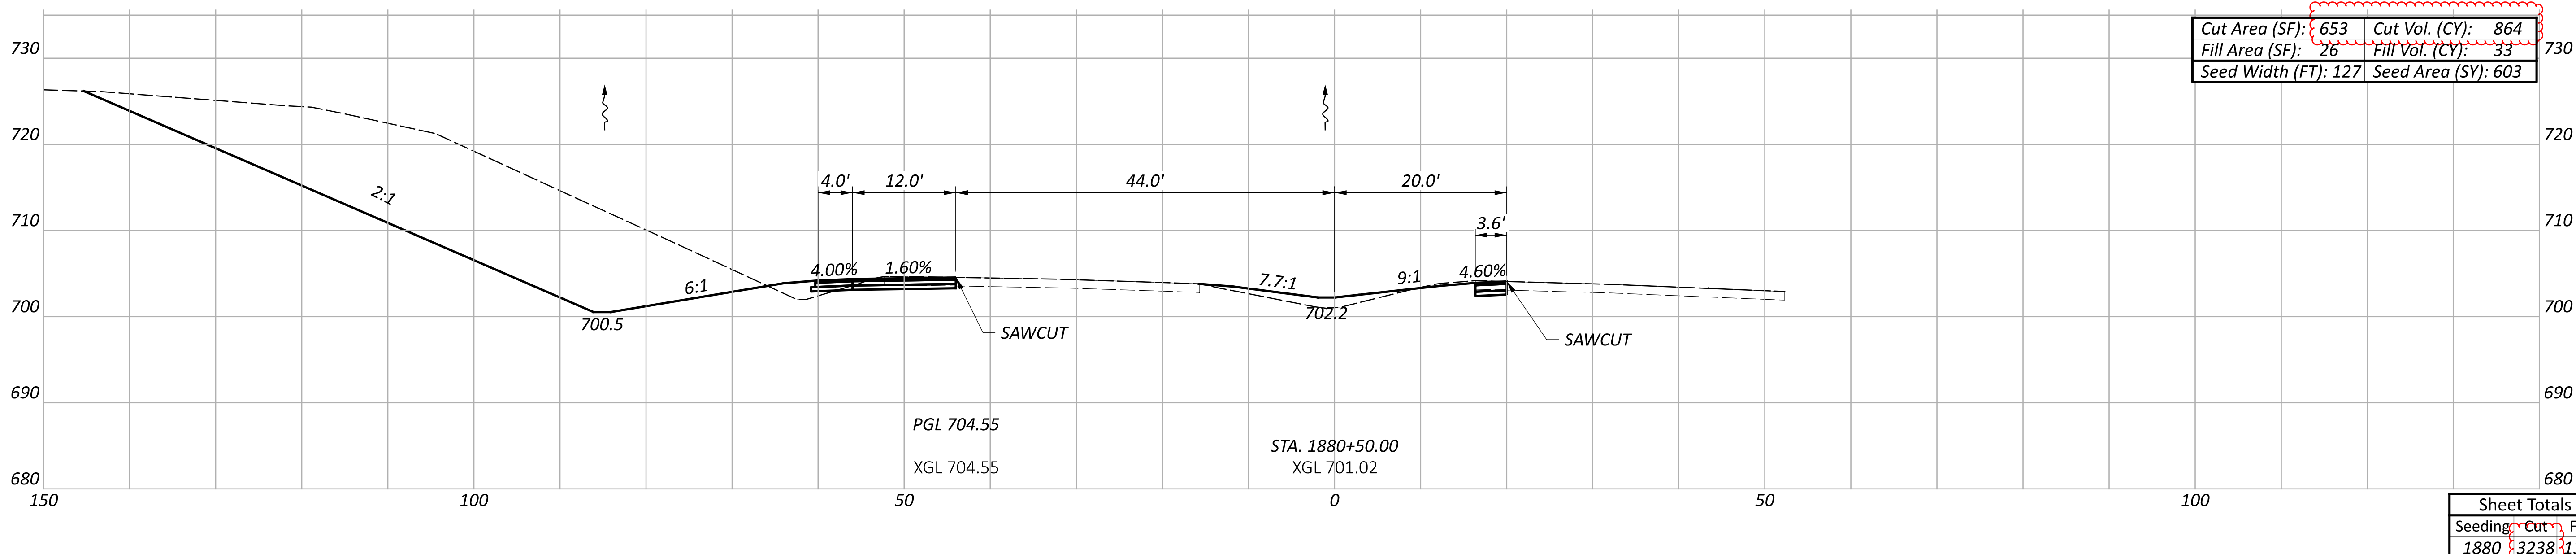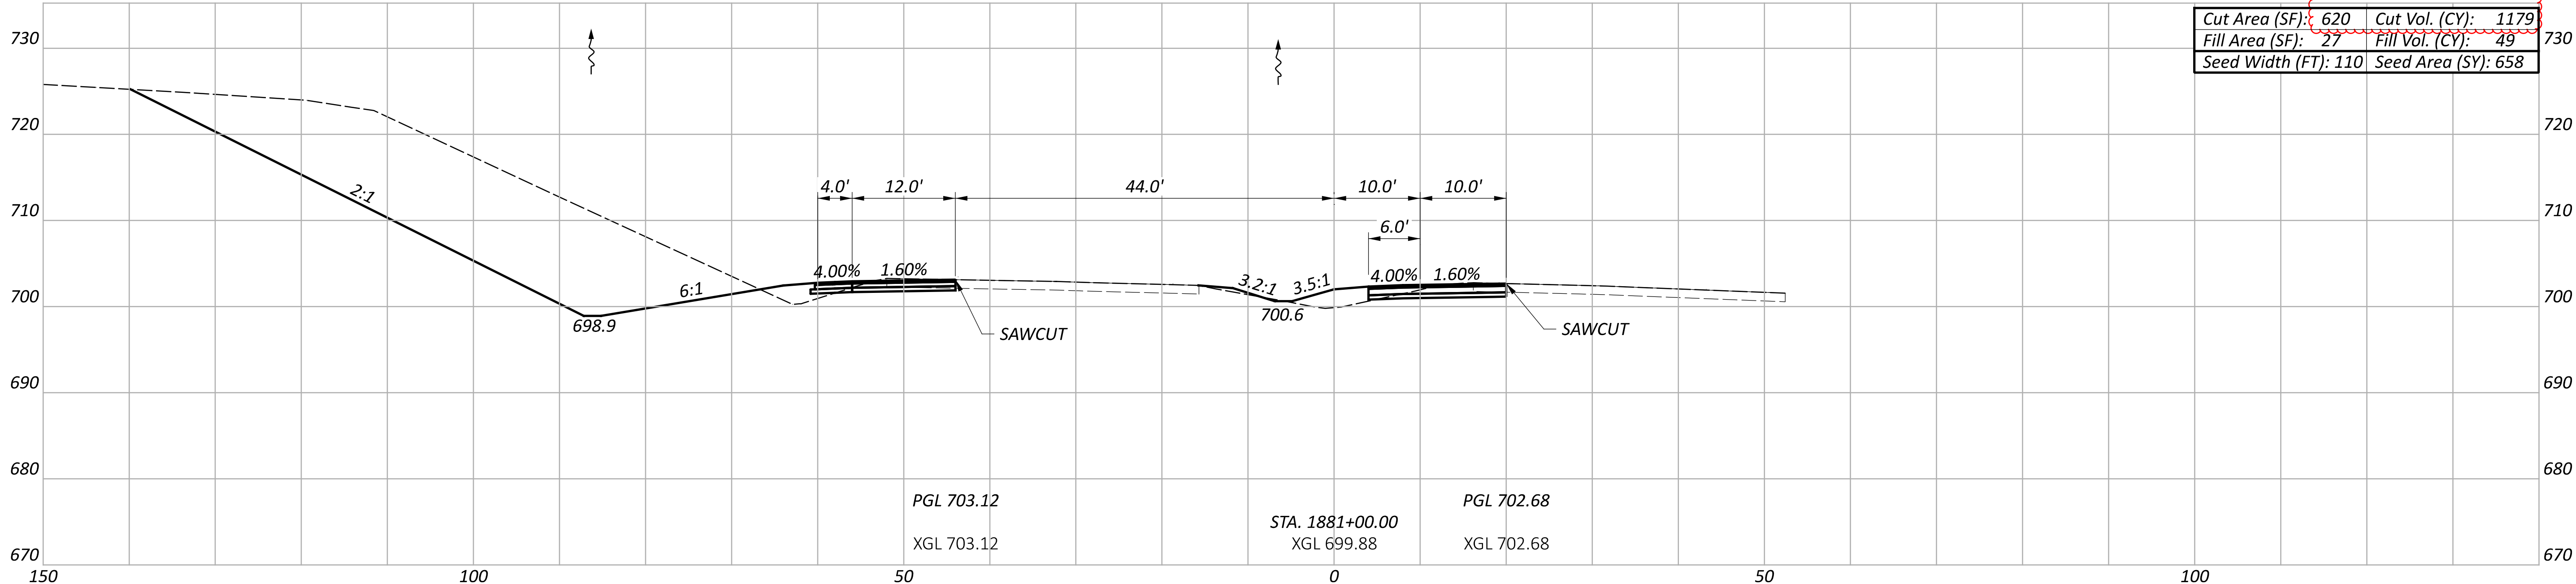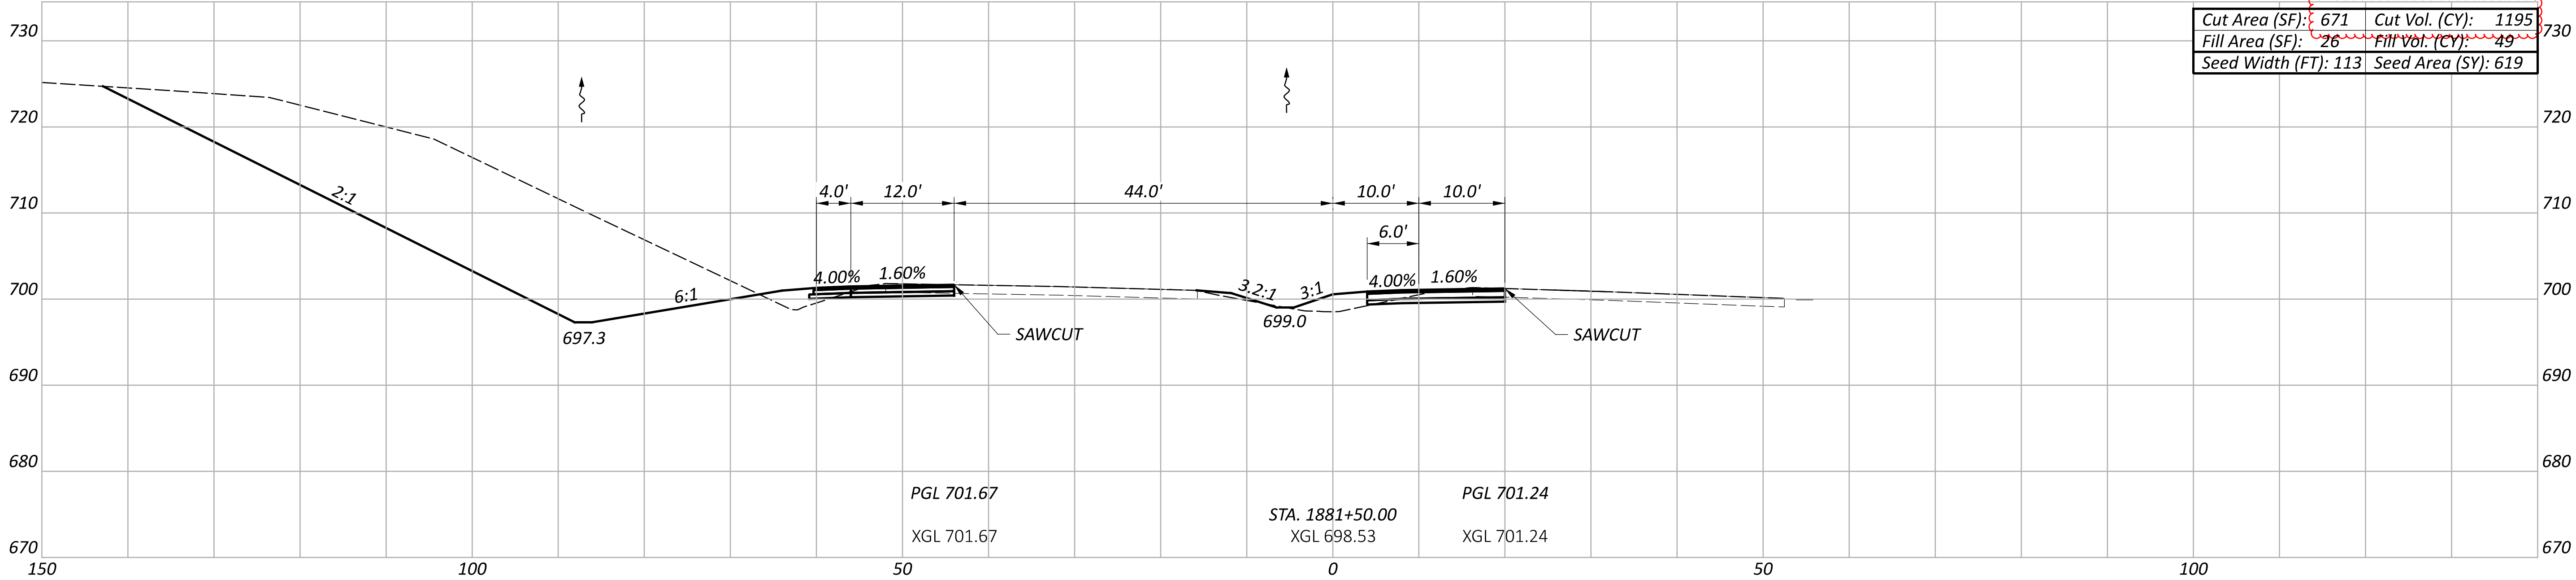

CROSS SECTIONS - U.S. 50
STA. 1880+50.00 TO STA. 1881+50.00



DESIGNER




BAC

REVIEWER

TWG 11/07/24

PROJECT ID

118516

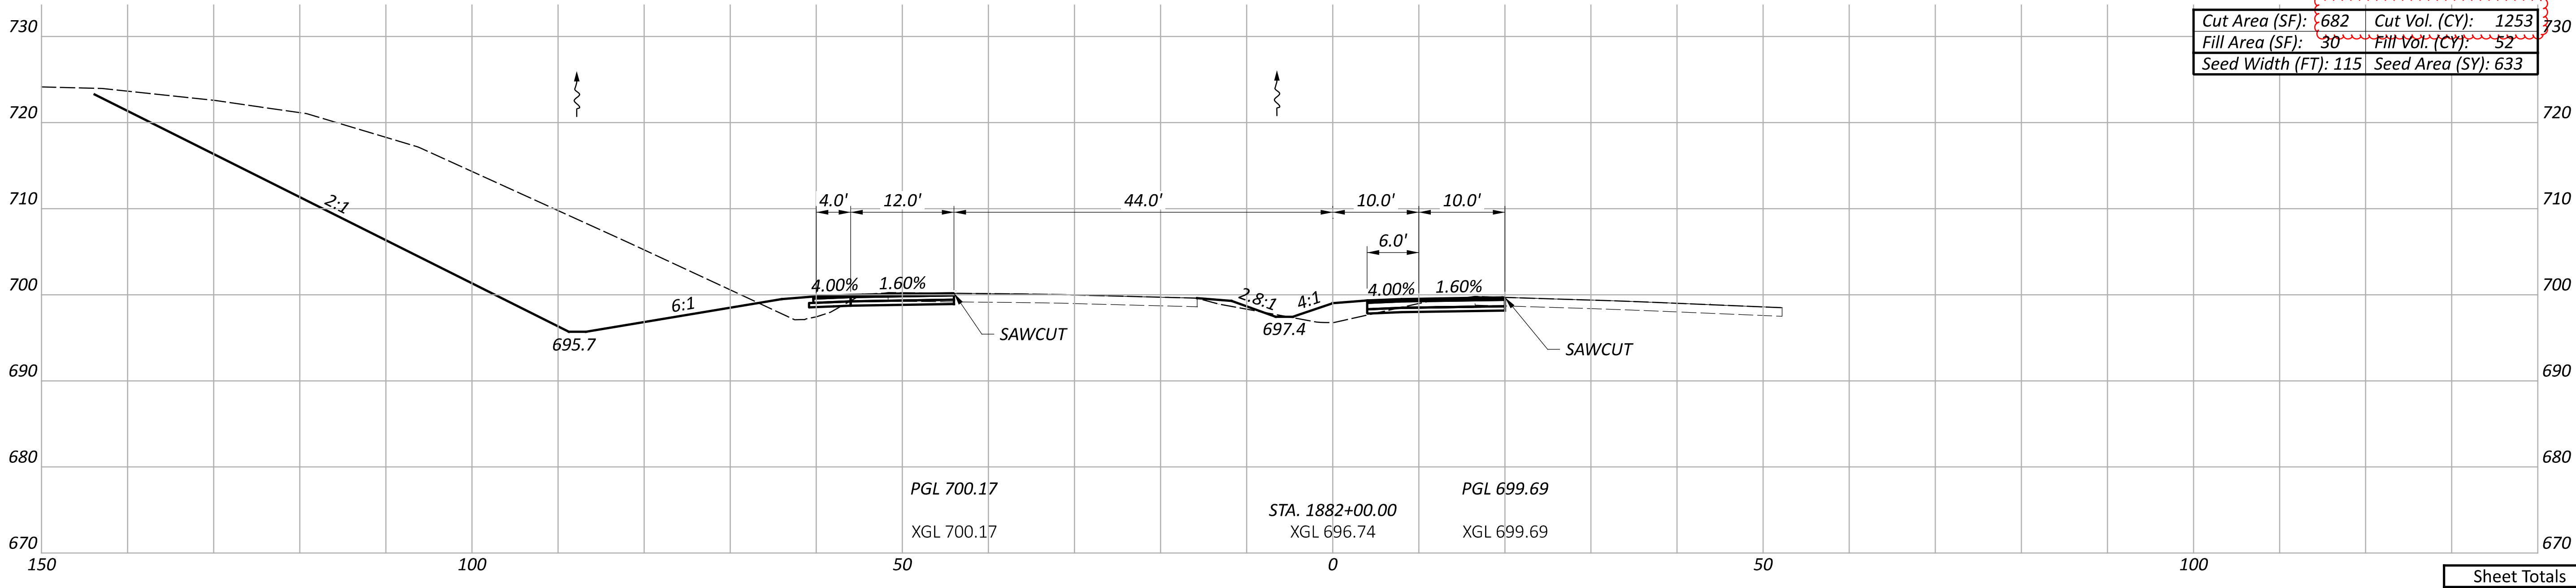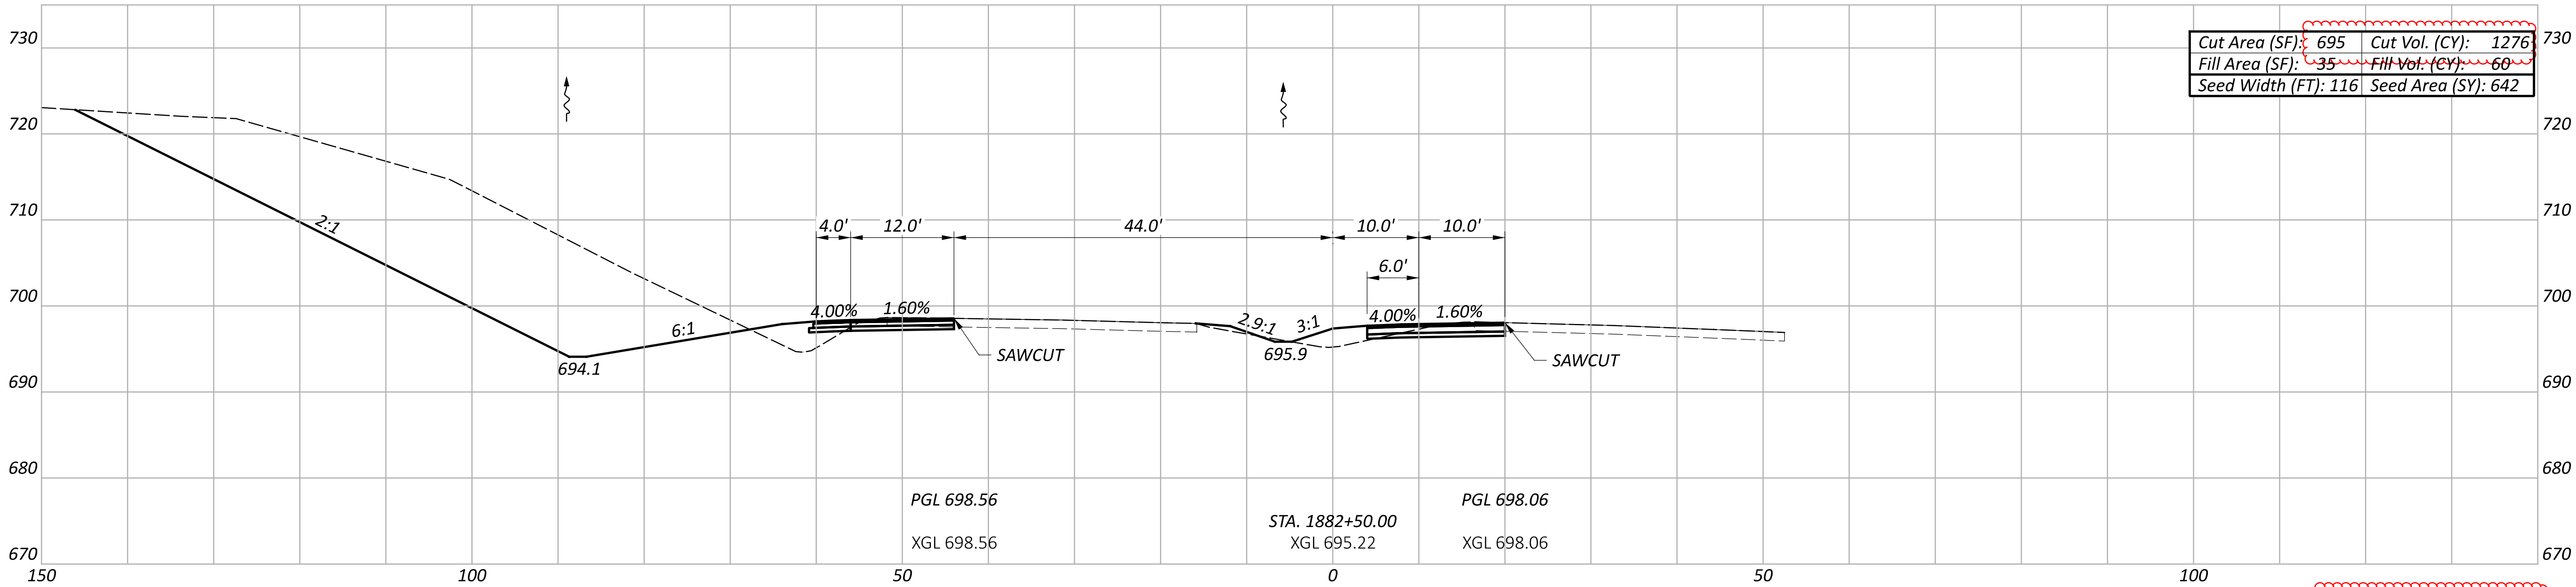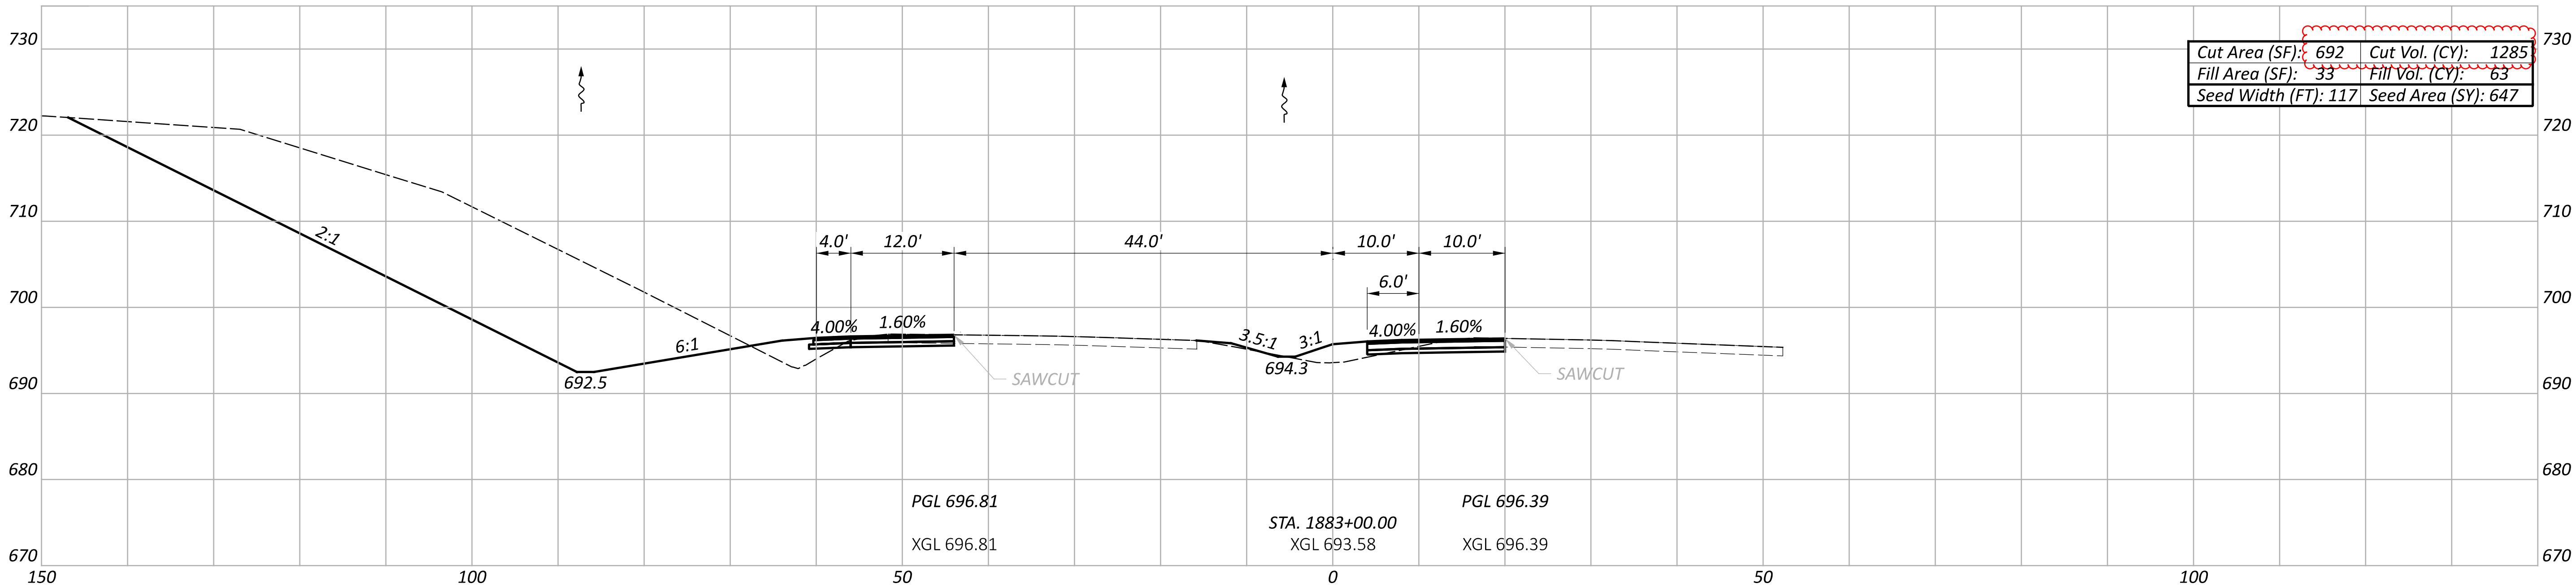

Sheet Totals			118516	
Seeding	Cut	Fill	SHEET	TOTAL
1922	3814	175	P.68	109

CROSS SECTIONS - U.S. 50
STA. 1882+00.00 TO STA. 1883+00.00

DESIGN AGENCY

CARPENTER
MARTY

DESIGNER




BAC

REVIEWER

TWG 11/07/24

PROJECT ID

118516

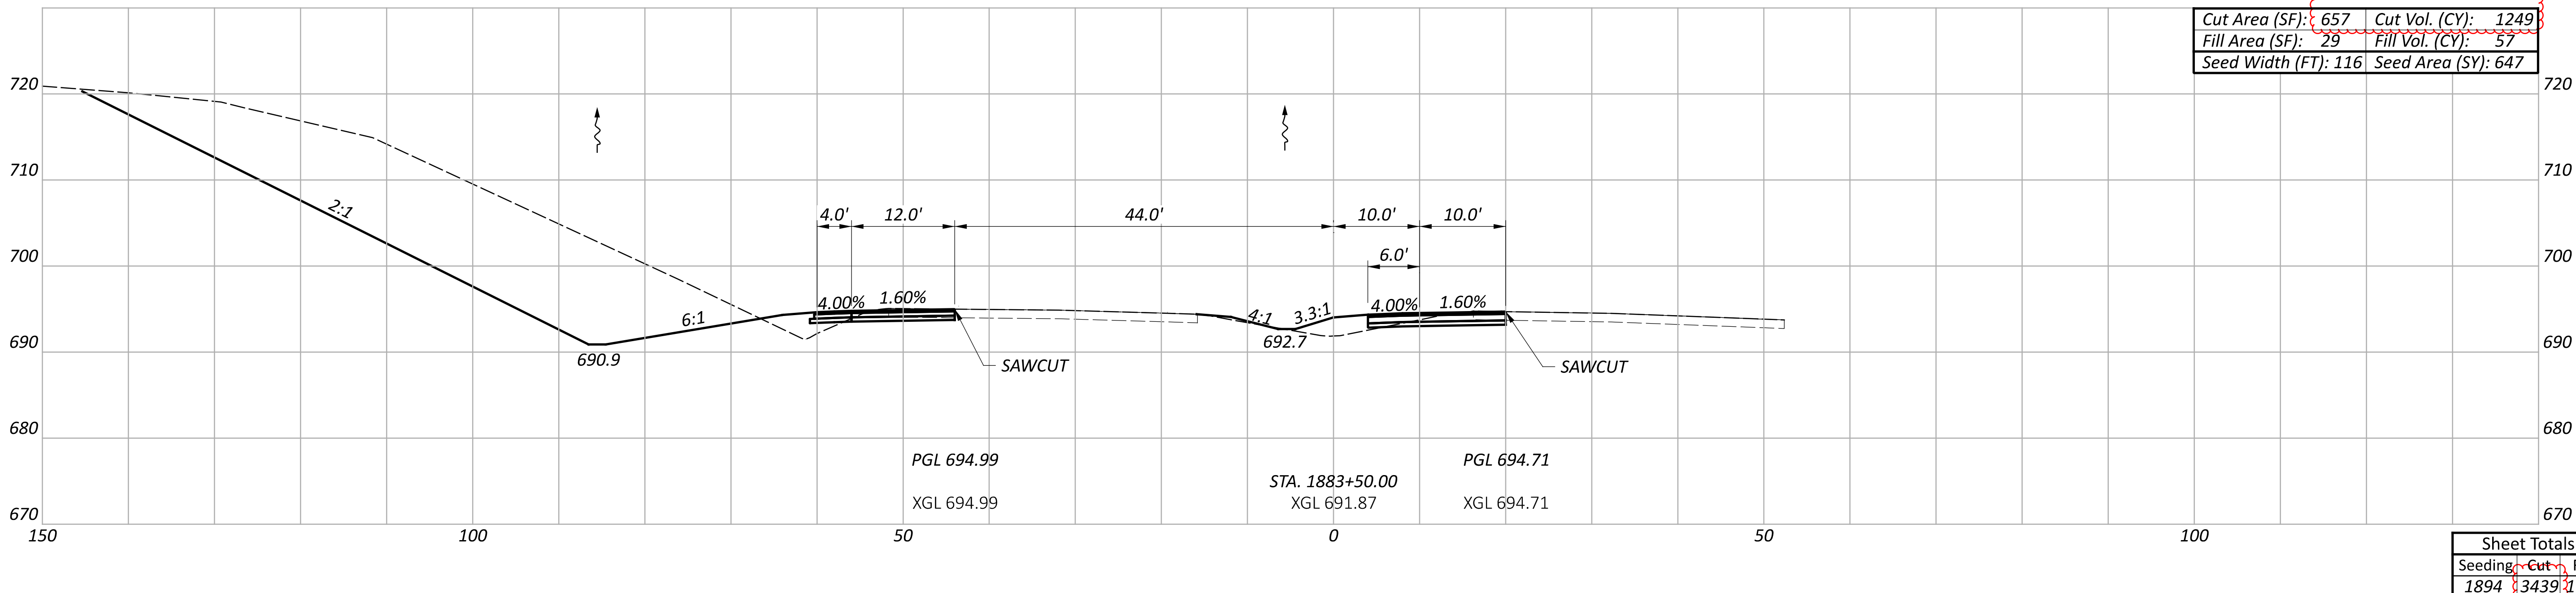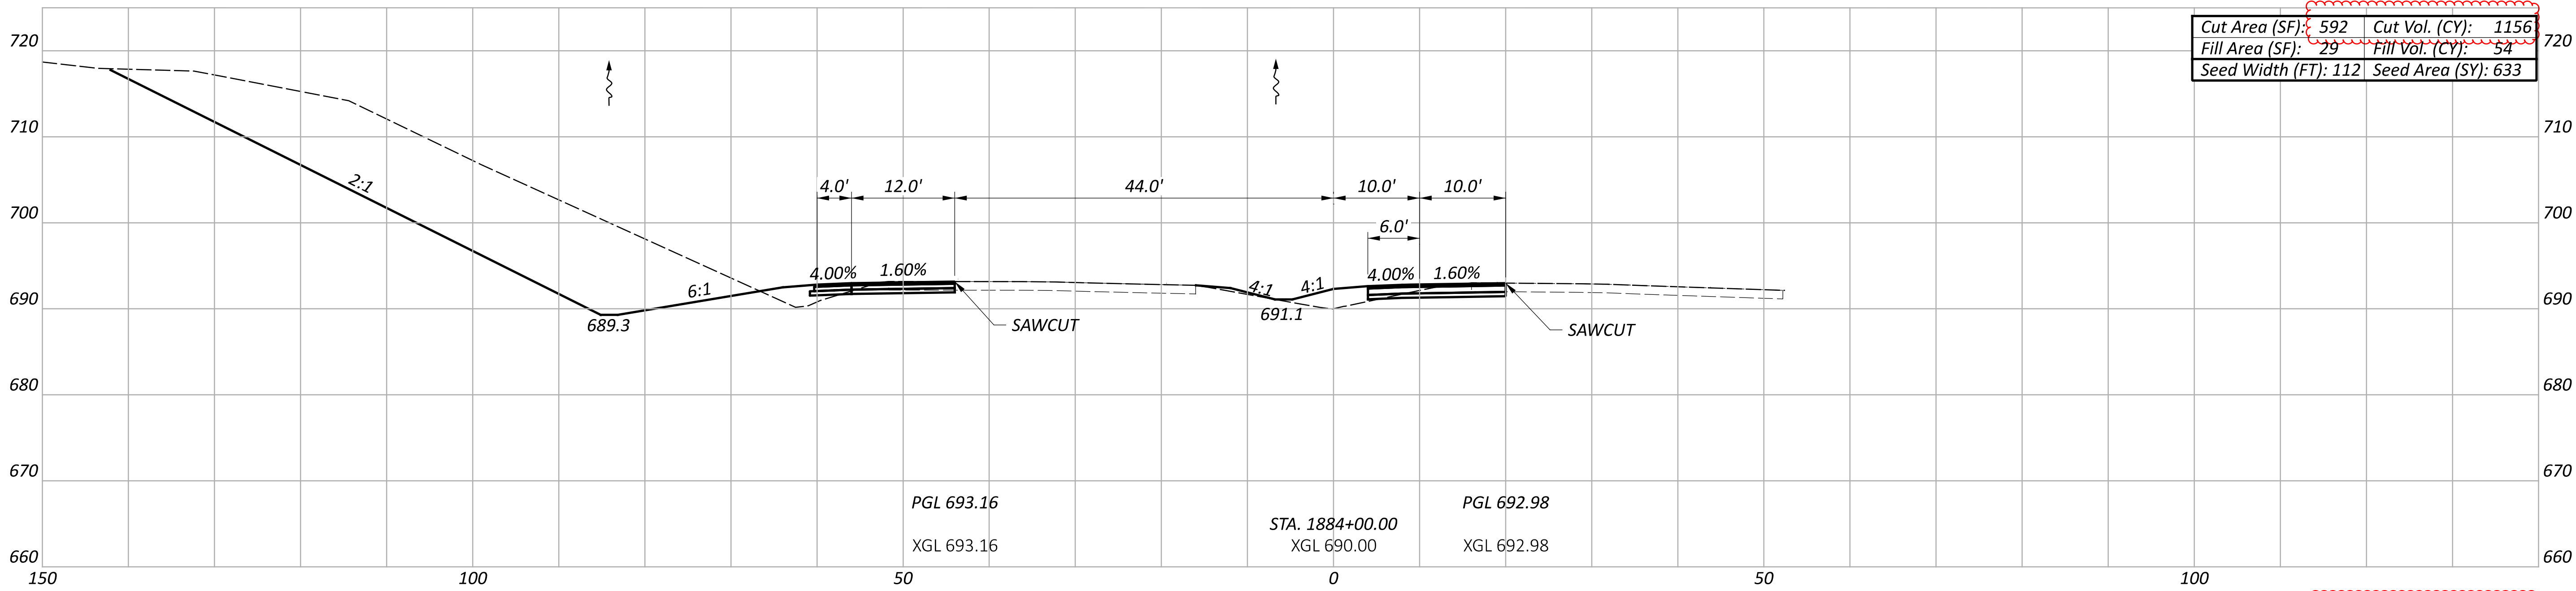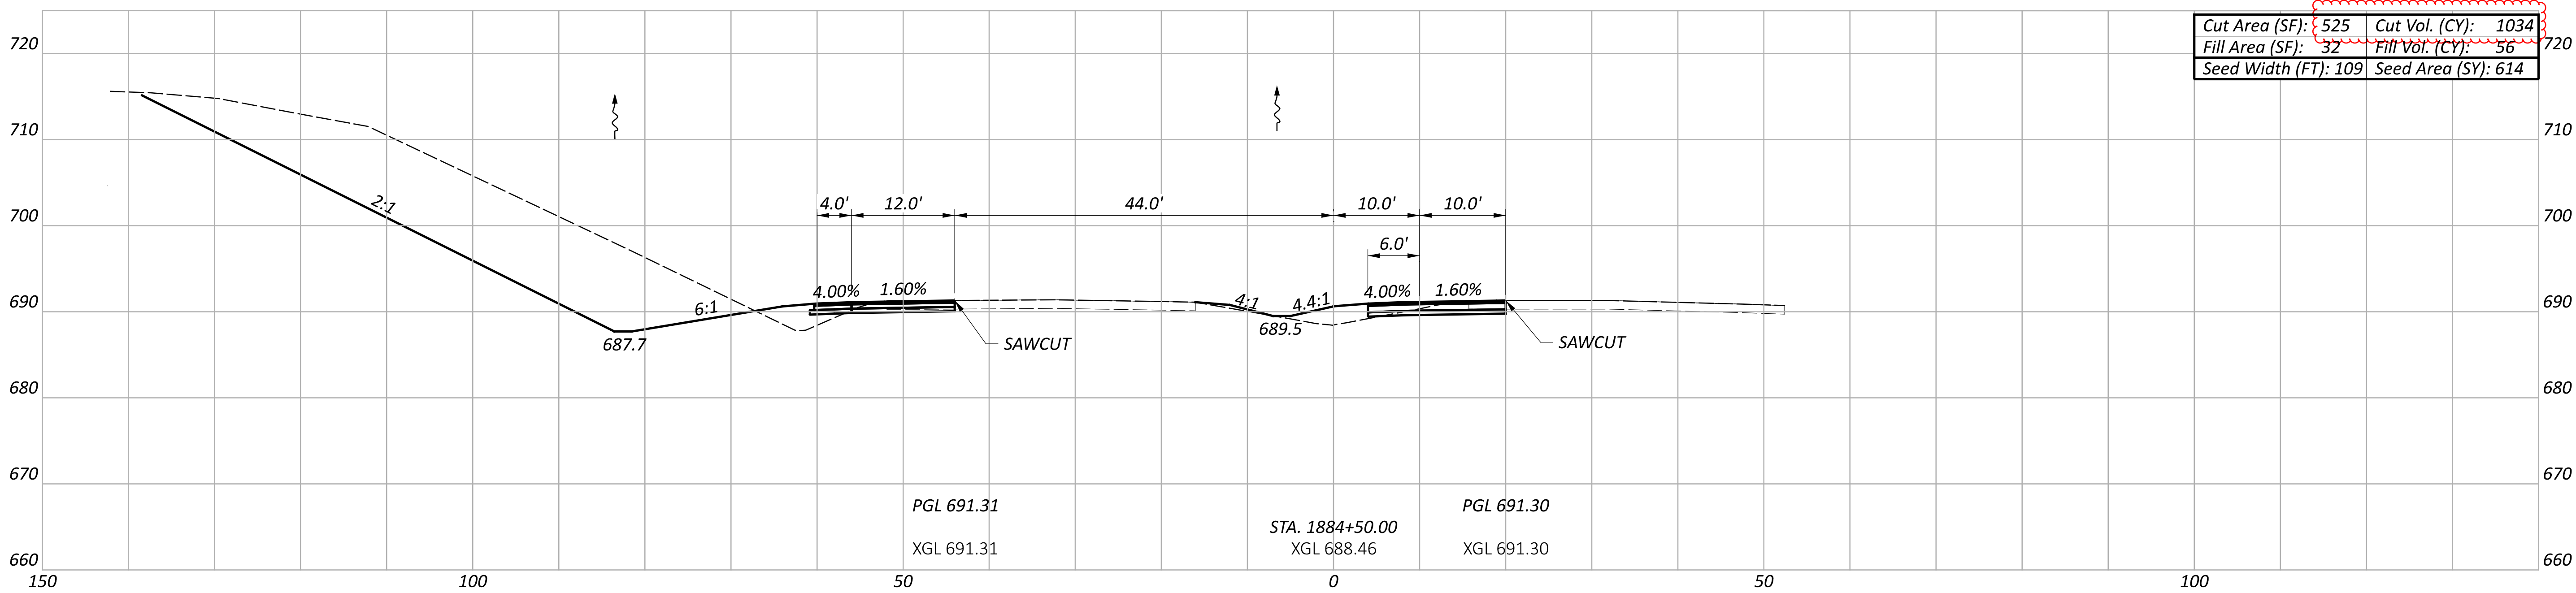

Sheet Totals			118516	
Seeding	Cut	Fill	SHEET	TOTAL
1894	3439	167	P.69	109

CROSS SECTIONS - U.S. 50
STA. 1883+50.00 TO STA. 1884+50.00

DESIGN AGENCY

CARPENTER
MARTY

DESIGNER




BAC

REVIEWER

TWG 11/07/24

PROJECT ID

118516

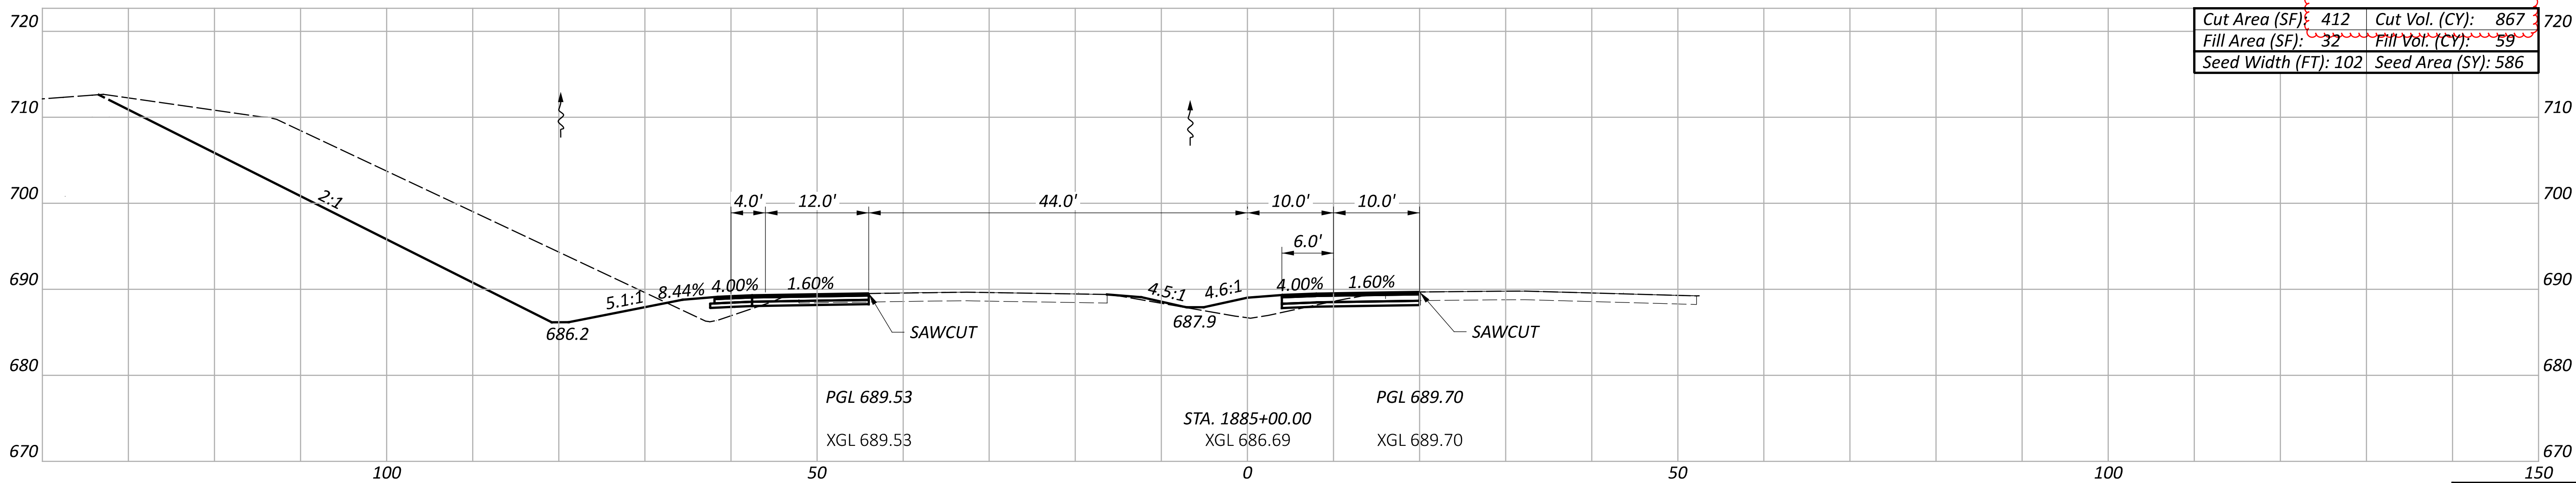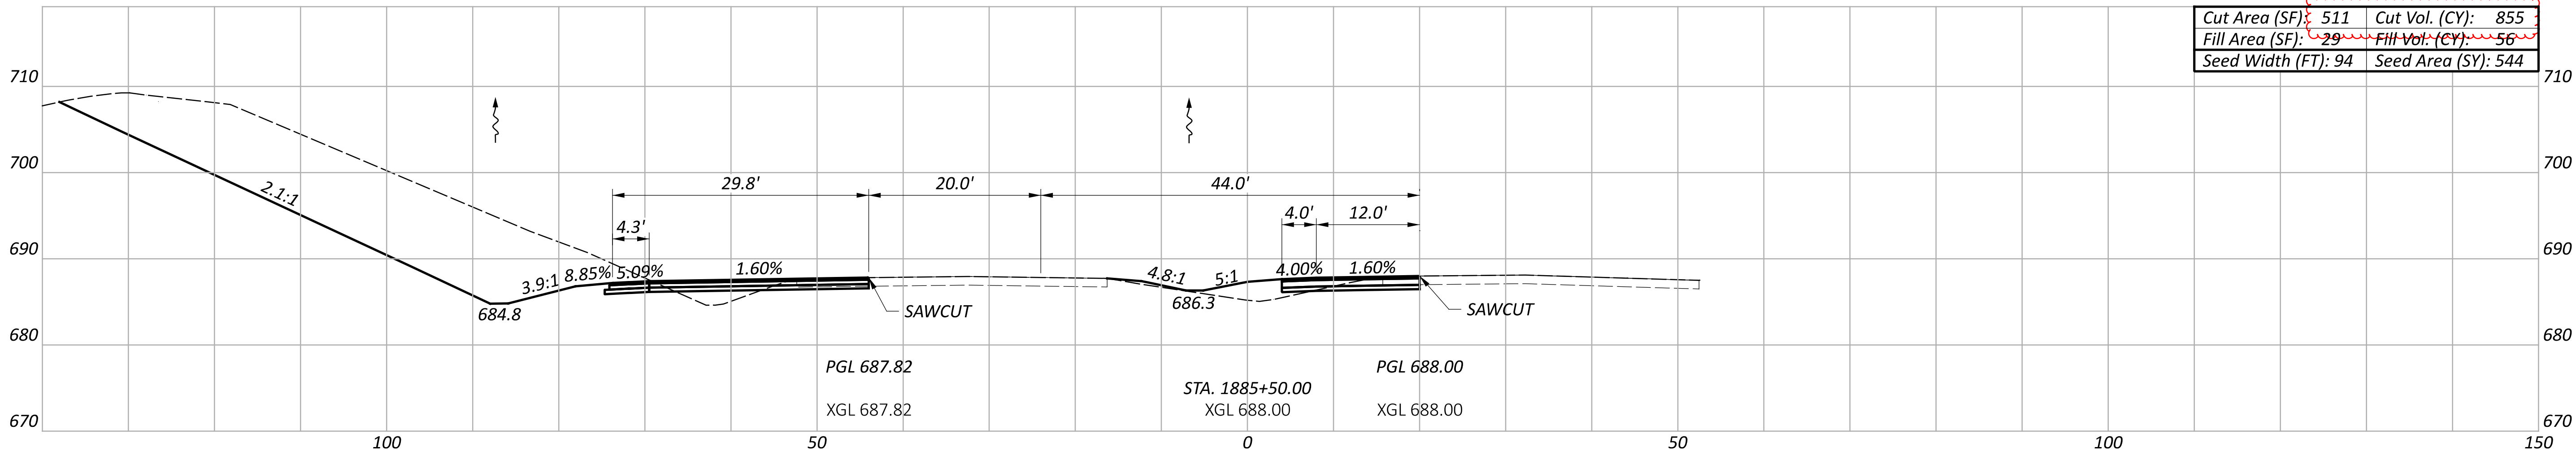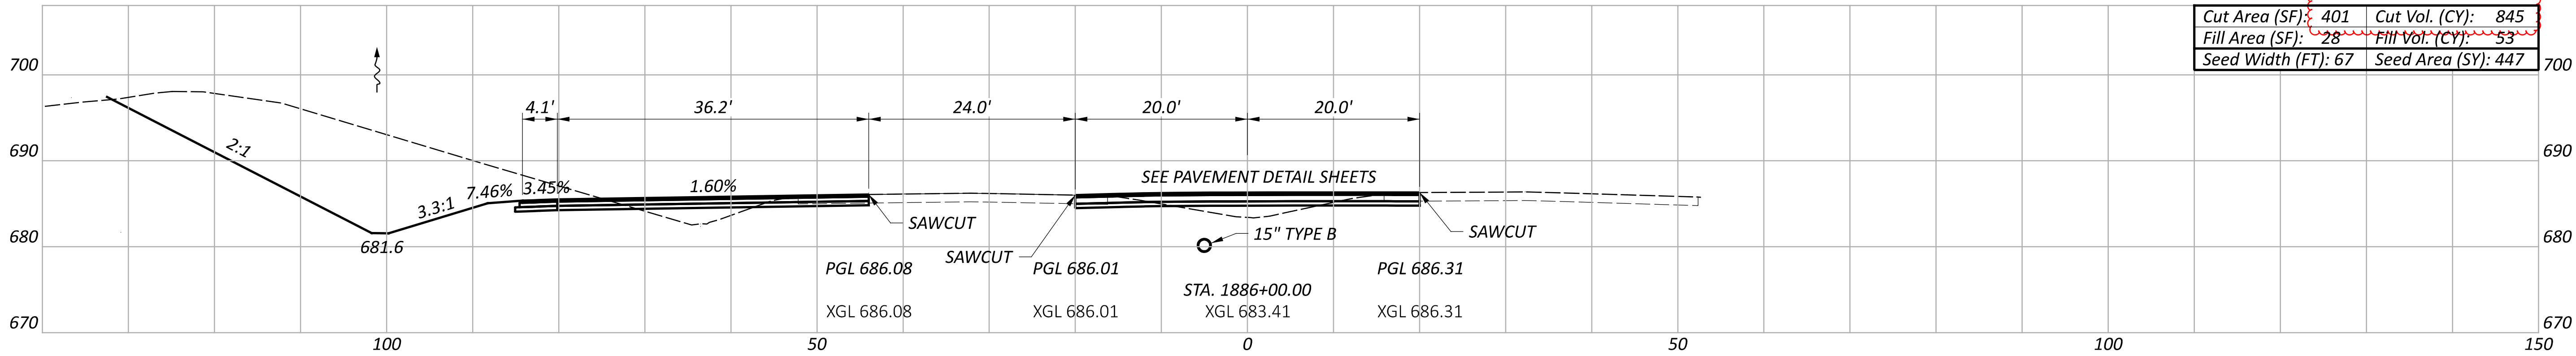

Sheet Totals			118516	
Seeding	Cut	Fill	SHEET	TOTAL
1577	2567	168	P.70	109

CROSS SECTIONS - U.S. 50
STA. 1885+00.00 TO STA. 1886+00.00

DESIGN AGENCY

CARPENTER
MARTY

DESIGNER

BAC

REVIEWER

TWG 11/07/24

PROJECT ID

118516

EARTHWORK QUANTITY SUBSUMMARY			
SHEET	203		659
	EXCAVATION	EMBANKMENT	SEEDING AND MULCHING
	CY	CY	SY
P.55	531	0	275
P.56	829	10	638
P.57	65	0	203
P.58	40	0	0
P.59	19	0	0
P.60	26	75	238
P.61	145	177	925
P.62	695	112	1622
P.63	940	34	1453
P.64	1035	92	1911
P.65	1231	130	1737
P.66	1486	136	2025
P.67	3238	131	1880
P.68	3814	175	1922
P.69	3439	167	1894
P.70	2567	168	1577
P.71	517	205	642
CARRIED TO GENERAL SUMMARY	20617	1612	18942

