

STATE OF OHIO
DEPARTMENT OF HIGHWAYS

S-135 (I)

FED. RD. DIVISION	STATE	PROJECT	FISCAL YEAR
2	OHIO	S-135 (I)	1947



BROWN COUNTY
S.H. 951 SEC. E (PT.)
BRO. 774 - 3.47

FELICITY-HAMERSVILLE-OAKLAND ROAD

S.H. 951 SEC. E (PT.)

PIKE TOWNSHIP

BROWN COUNTY

CONVENTIONAL SIGNS

County Line	-----
Township Line	-----
City or Village Line	-----
Property Line (not fenced)	-----
Fence Line	-x-x-x-
Center Line	-----
Pole Line	φ


φ Telephone

INDEX OF SHEETS

Title Sheet	Sheet No.	1
Schematic Plan	Sheet No.	2
Typical Section	" "	3-4
General Notes	" "	5-6
Summary of Quantities	" "	7
General Summary	" "	8
Plan and Profile	" "	9-14
Curve Tables	" "	15
Cross-sections	" "	16-29
Drives and Approaches	" "	30
Structures (20' Span and Under)	" "	31
Structures (Over 20' Span)	" "	32-39
Channel Alignment	" "	40
Channel Sections	" "	41-44

LINE DATA

Begin Project	S-135 (I)	Sta. 20+00
End Project	S-135 (I)	Sta. 62+68
Length of Project		4268 Lin. Ft.
Net Length of Project	S-135 (I)	4268 Lin. Ft. or 0.808 Miles
Begin Work	Sta. 19+00	
End Work	Sta. 63+02	
Length of Work		4402 Lin. Ft. or 0.833 Miles

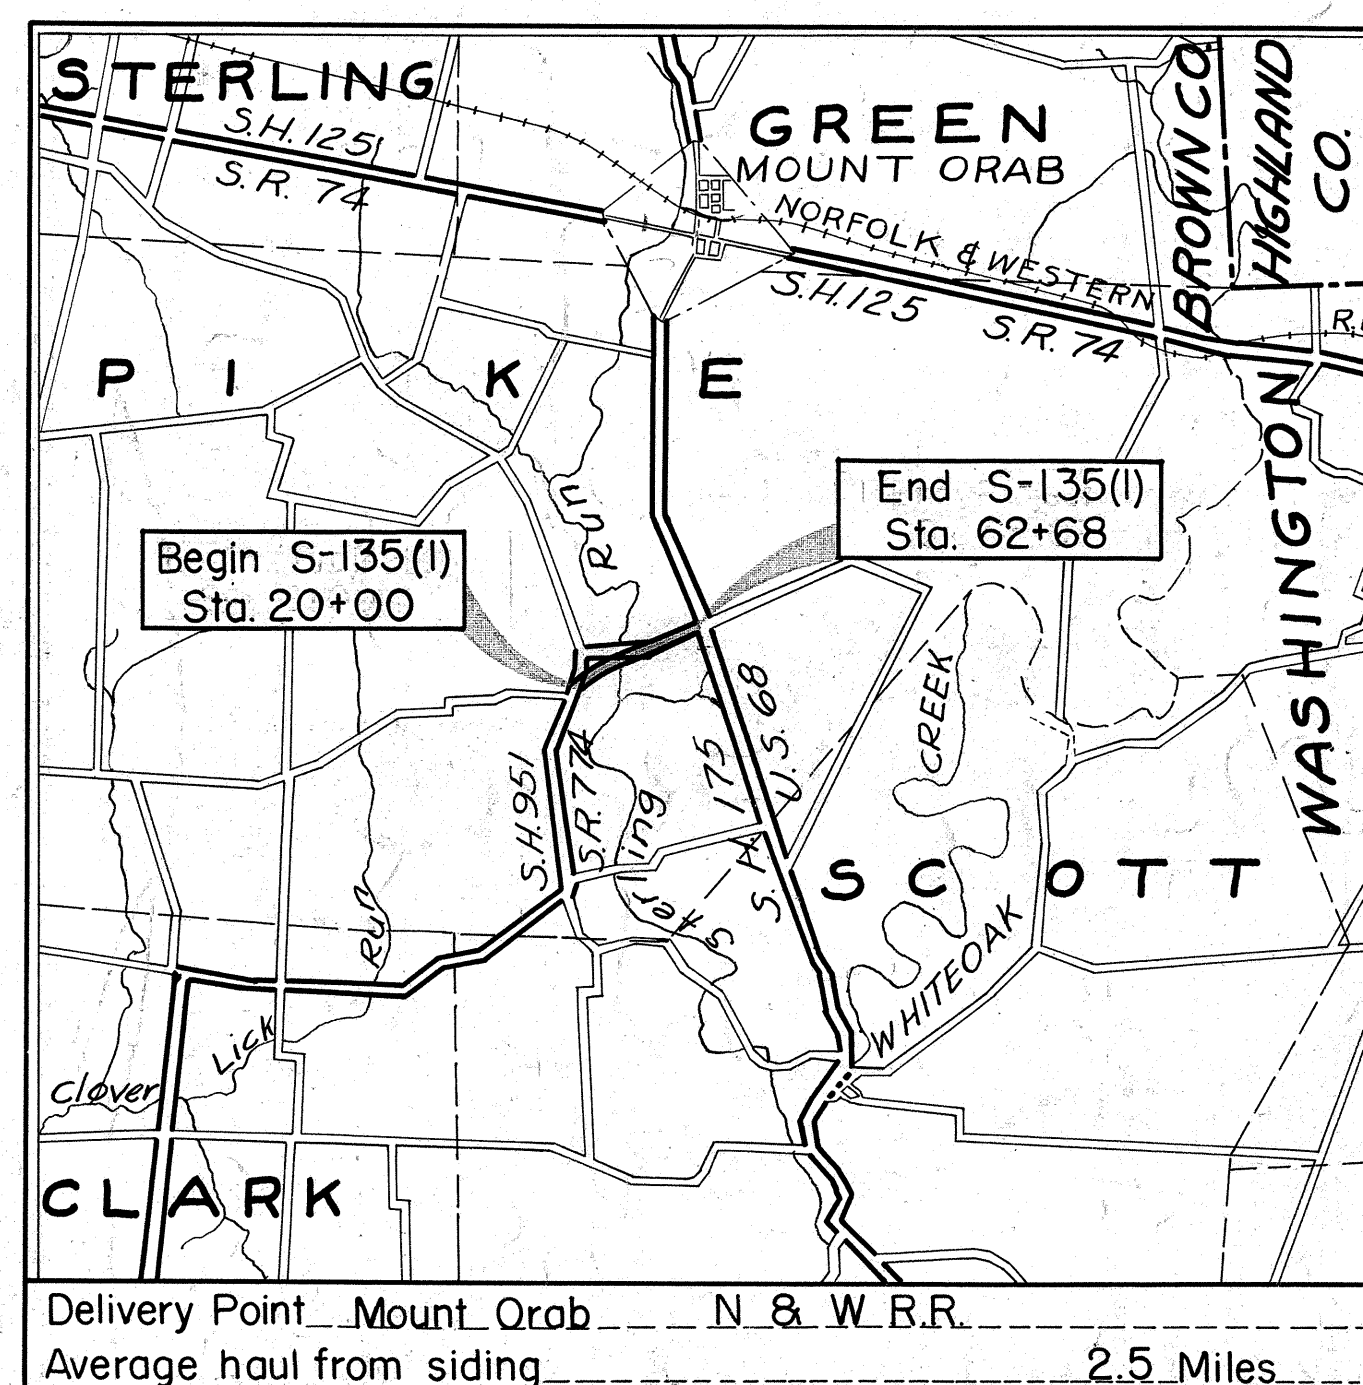

LOCATION PLAN

SCALE OF MILES



Portion to be improved	=====
State Roads	=====
Other Roads	=====

SCALE

Plan	1" = 50'
Profile Horizontal	1" = 50'
Profile Vertical	1" = 10'
Cross Sections	1" = 5'

The standard specifications of the State of Ohio, Department of Highways, including changes and supplemental specifications listed in the proposal shall govern this improvement.

The right of way for this improvement will be provided by the State of Ohio.

I hereby approve these plans and declare that the making of this improvement will not require the closing to traffic of the highway and that provisions for the maintenance and safety of traffic will be as set forth on the plans and estimates.

Approved Elmer S. Bantl
Date 2-19-47 Division Deputy Director

Approved _____
Date _____ Chief Engineer, Bureau of Maintenance

Approved Alboque
Date 4-12-47 Chief Engineer, Bureau of Bridges & R.R. Crossings

Approved George J. Thornycroft
Date 7/16/47 Chief Engineer, Bureau of Location & Design

Approved _____
Date _____ First Asst. Director & Chief Engineer

Approved Wasson
Date 7-14-47 Director of Highways

CONSTRUCTION BUREAU
AUG 14 1956
GROUND PHOTOLAB

Recommended for Approval Date

District Engineer
Public Roads Administration
Federal Works Agency

Approved Date

Division Engineer
Public Roads Administration
Federal Works Agency

Supplemental Prints of Standard Construction Drawings			
* 1-15 No. 8	2-1-47	* G-8.07	2-1-47
* 1-15 No. 1	3-1-47	AS-44-F	1-18-46
* 1-15 No. 2	2-1-47	* S-27 PC-1	3-1-39
* 1-15 No. 4	2-1-47	* S-27 PC-3	2-20-45
* 1-15 No. 5	2-1-47	* B-T-71 R	2-1-47
* 1-15 No. 6	2-1-47	* L-3	2-1-47
* 1-15 No. 7	2-1-47	* I-15 N 29	2-1-47
		* I-14 G	2-1-47

* Recommended for approval by P.R.A. 2-21-47

Supplemental Specifications	
CS-112	Rev. 11-6-46
E-109	12-21-39
F-305	5-1-41
T-110	Rev. 8-3-36
1A-102.12	10-2-43
1T-170.15	10-2-43
1-110	5-3-35

File No.	Brown County: S.H. 951 Sec. E (Pt.)
Date of Letting	194
Contract No.	

TYPICAL SECTION


TYPE T-32

Scale: 1/2" = 1'-0"


FED. RD. DIVISION	STATE	PROJECT	FISCAL YEAR
2	OHIO	S-135(1)	1947

3
14


BROWN COUNTY
S.H. 951 SEC. E (PT.)

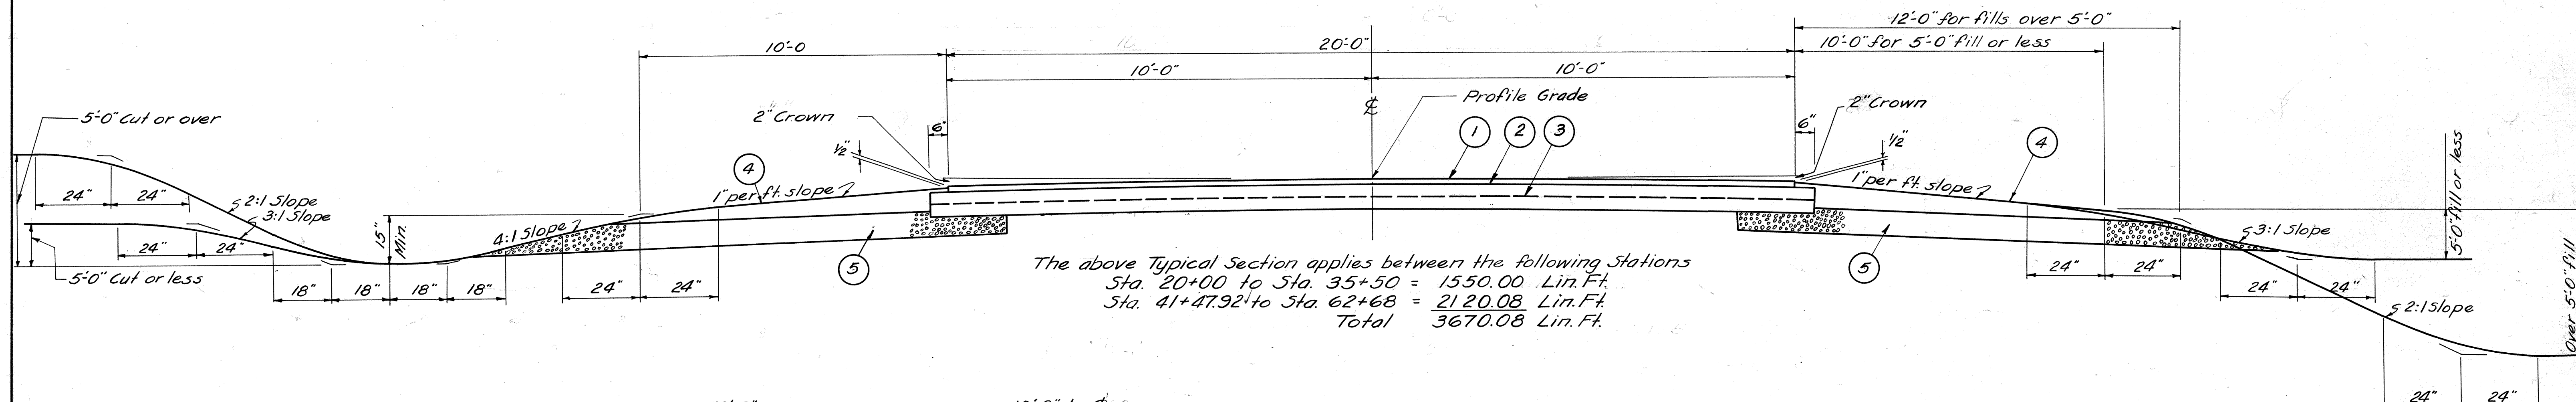


The above Typical Section applies between the following Stations
 Sta. 20+00 to Sta. 35+50 = 1550.00 Lin. Ft.
 Sta. 41+47.92 to Sta. 62+68 = 2120.08 Lin. Ft.
 Total 3670.08 Lin. Ft.

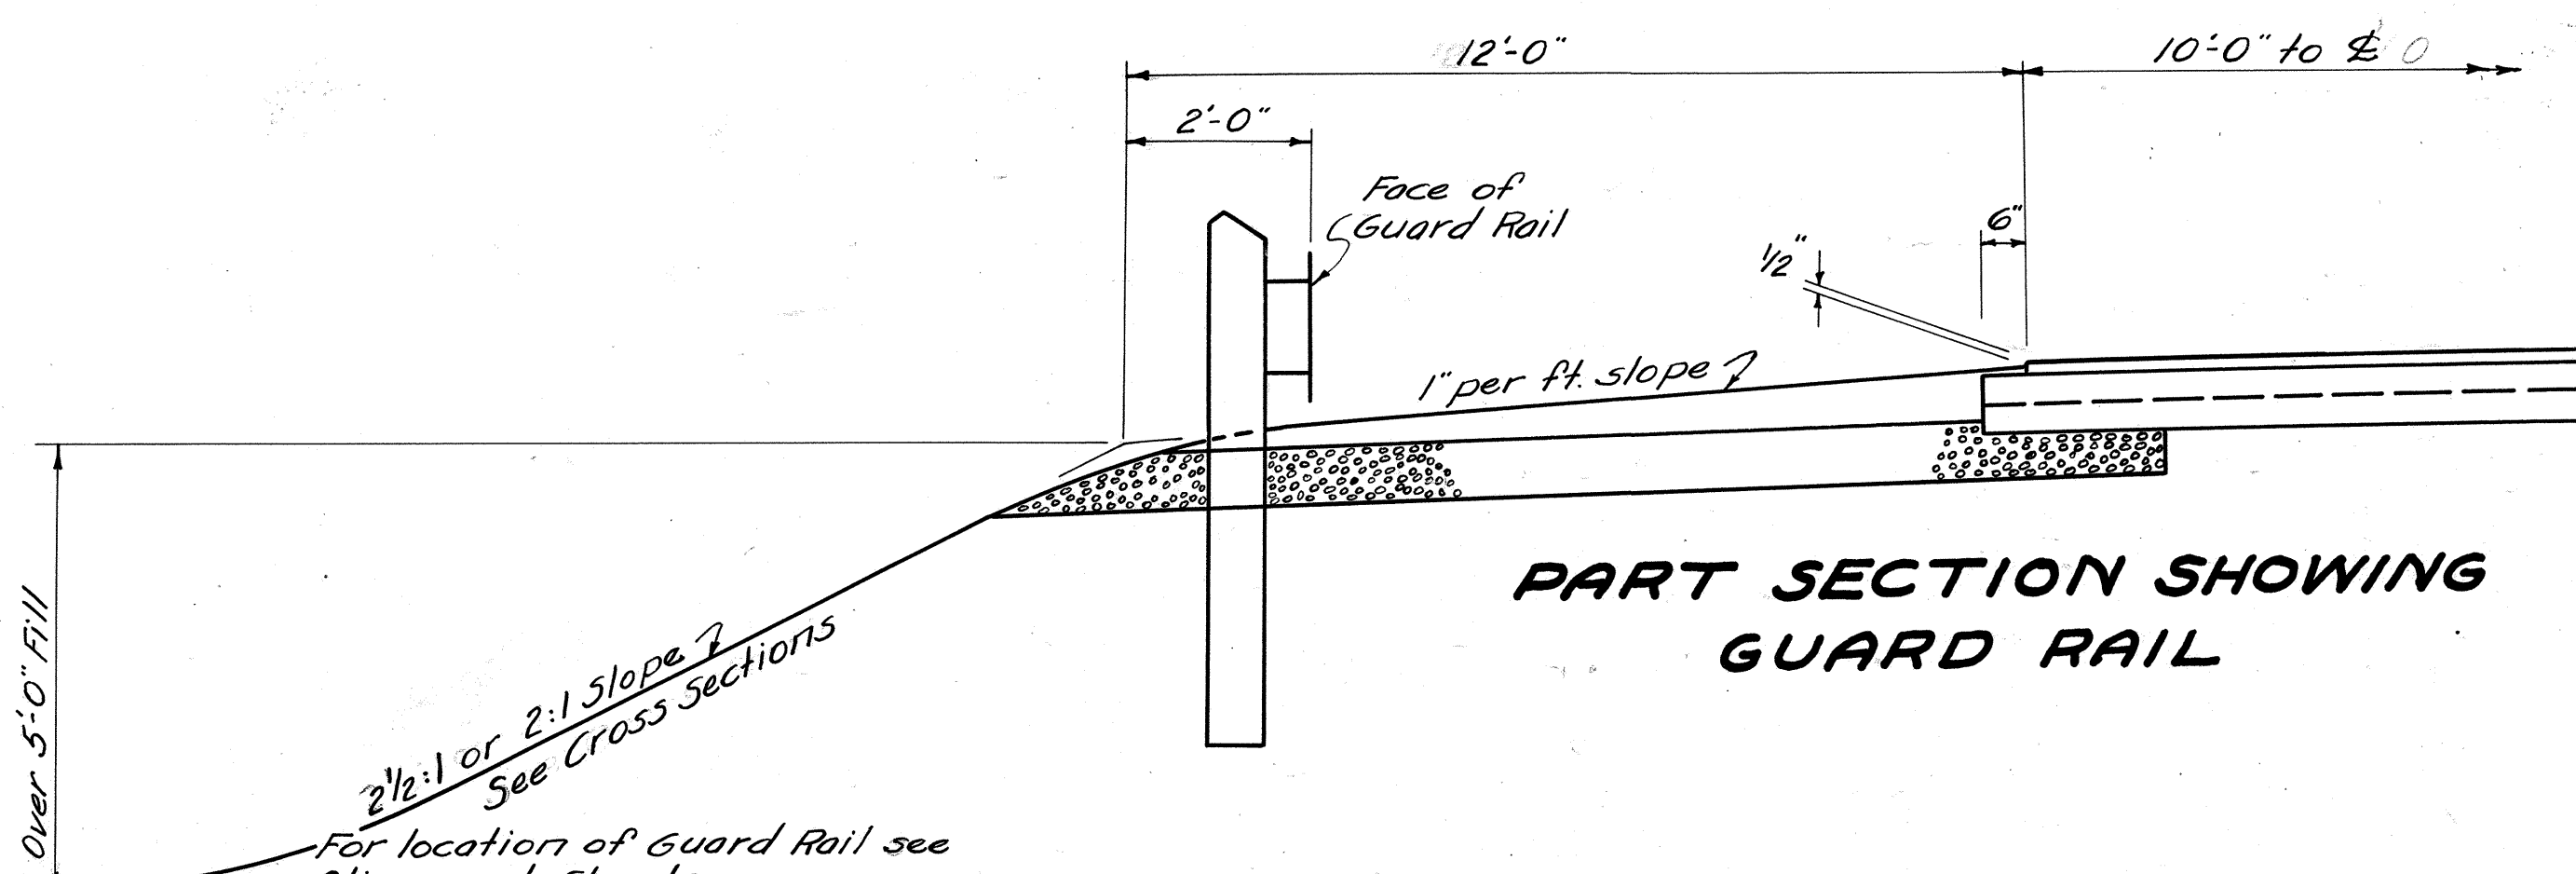


PART SECTION SHOWING
GUARD RAIL

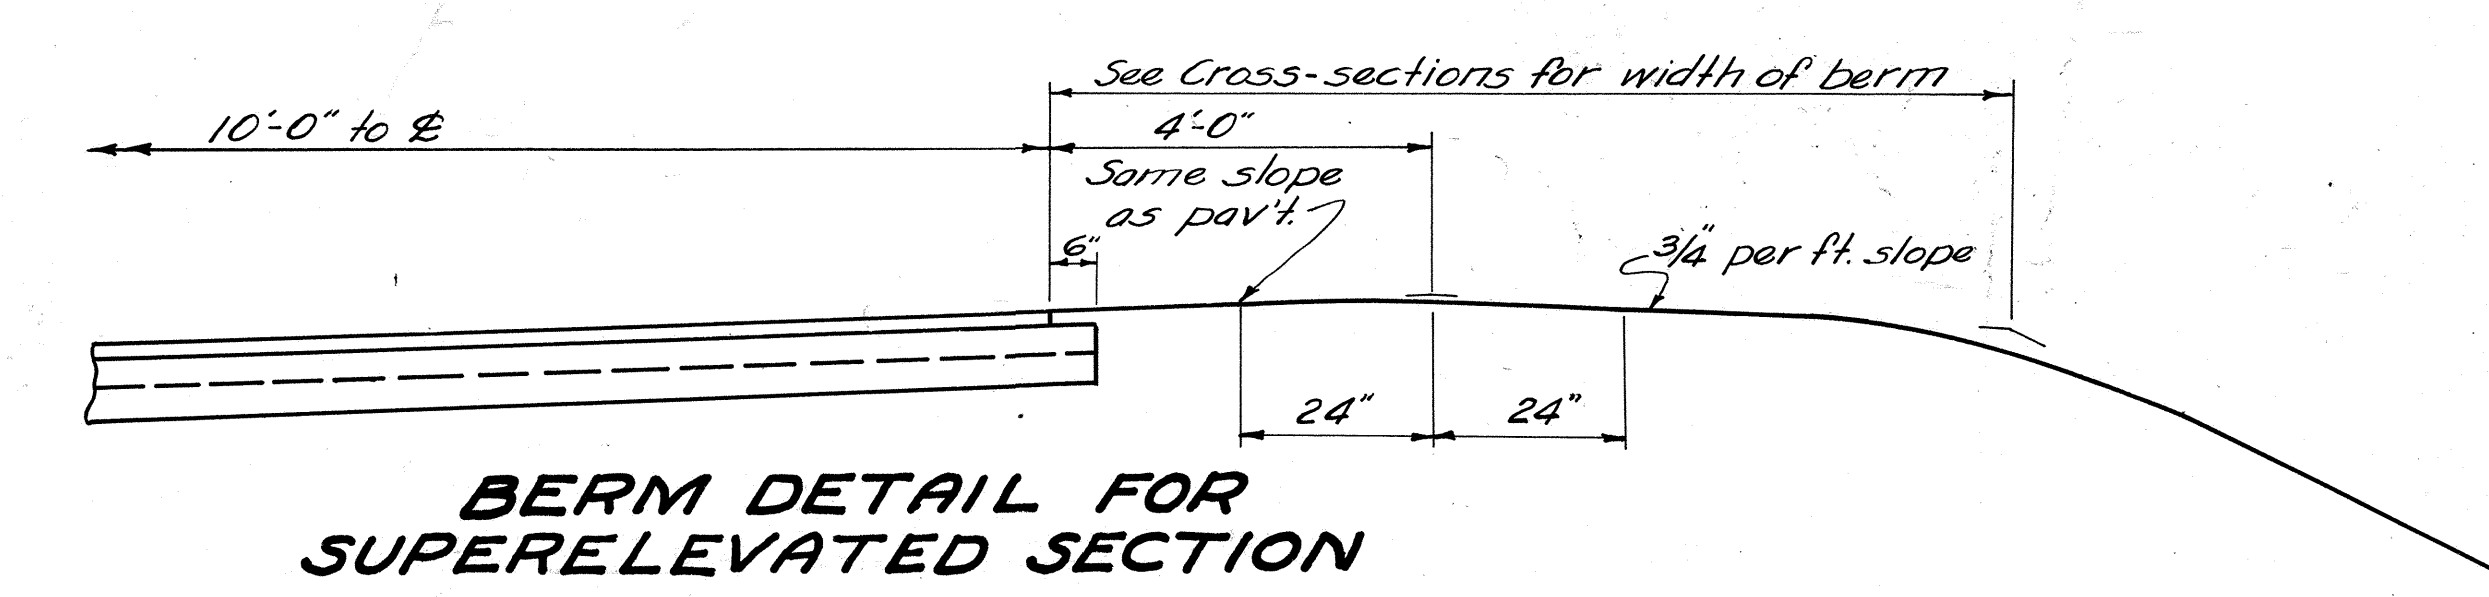


BERM DETAIL FOR
SUPERELEVATED SECTION

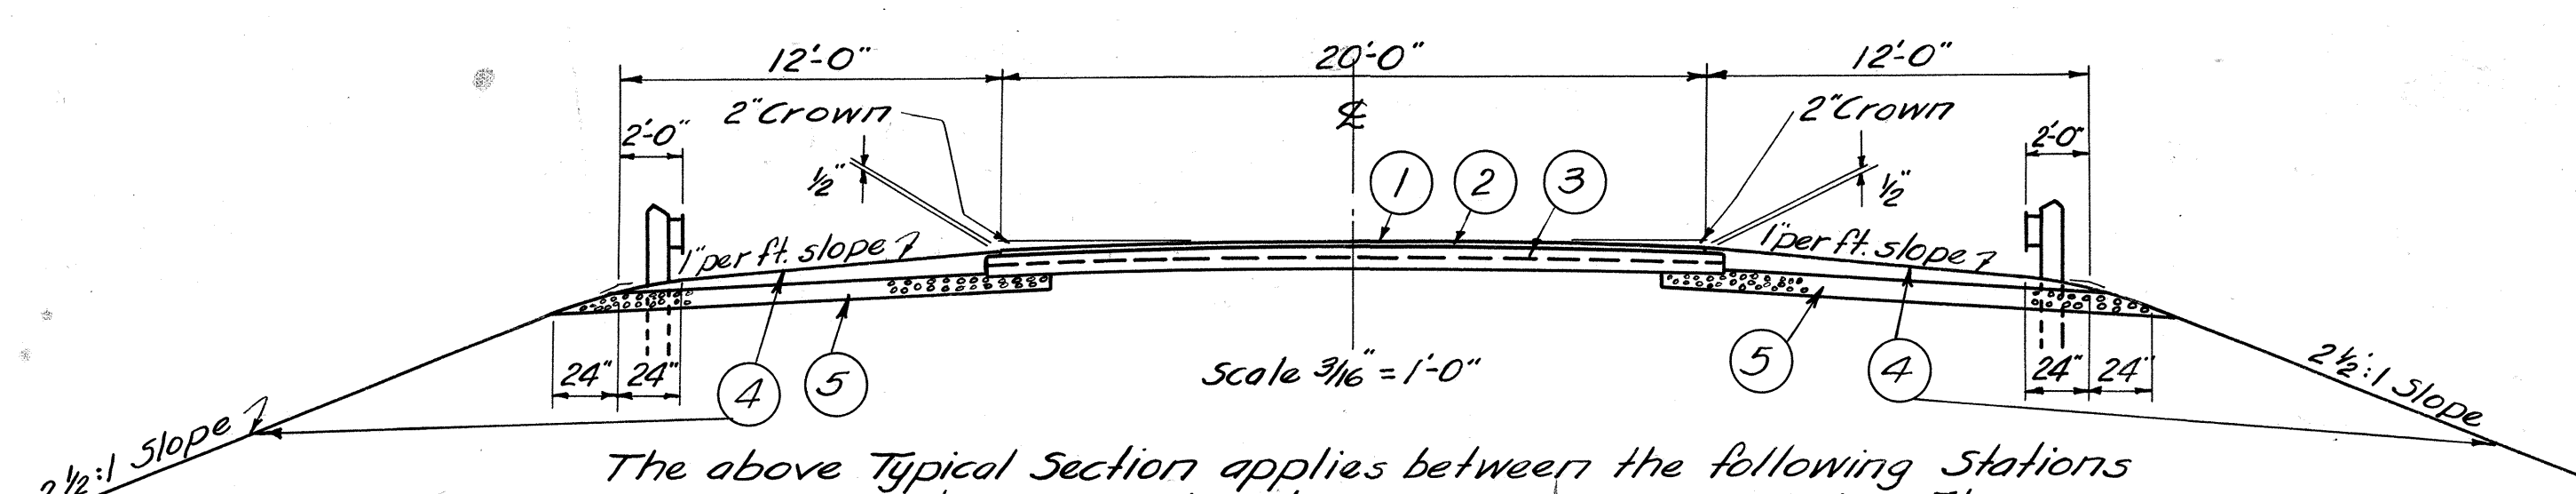

The above Typical Section applies between the following Stations
 Sta. 35+50 to Sta. 40+52.08 = 502.08 Lin. Ft.
 For Construction of Embankment between above
 stations see Note on Sheet No. 6

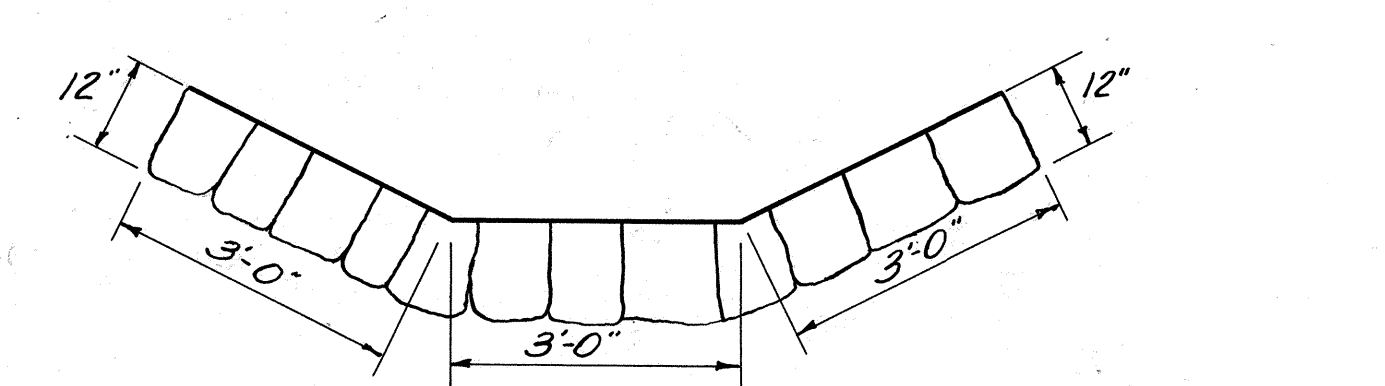

DETAIL OF STONE PAVED GUTTER

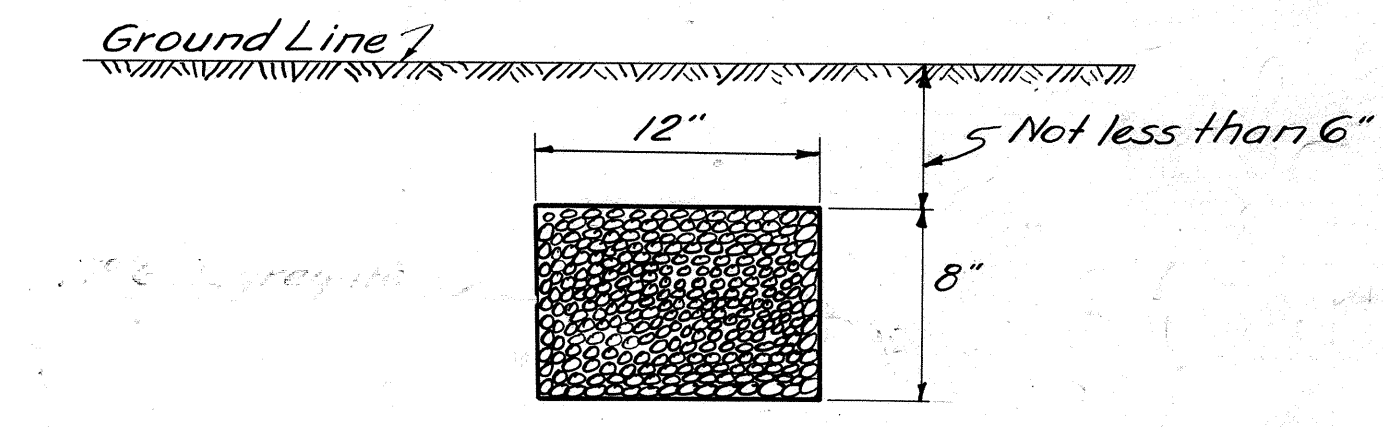

DETAIL OF STONE UNDERDRAIN

- ② Item T-30 Bituminous Prime Coat Sec. M-5.7 RT-2 or 3 applied at the rate of 0.35 gal. per sq. yd.
- ③ Item 55-112 8" Classified Embankment (Crusher run Limestone) 2-4" Courses
- ④ Item L-9 Seeding and Protecting (Type "A")
- ⑤ Item I-9 Stone Underdrain
- ① Item T-32 Bituminous Road Mix Surface Course, Method "A", "B" or "C"
 No. 46 aggregate applied at the rate of 0.0292 C.Y. per sq. yd.
 Bituminous material Sec. M-5.3 MC-5 applied at the rate of 0.65 to 0.75 gal. per sq. yd.
 Choke
 No. 9 aggregate applied at the rate of 0.00375 C.Y. per sq. yd.
 Seal
 Bituminous Material Sec. M-5.3 MC-5 applied at the rate of 0.25 gal. per sq. yd.
 Cover
 No. 6 aggregate applied at the rate of 0.0075 C.Y. per sq. yd.

TYPICAL SECTIONS


TYPE T-31

Scale: 1/2" = 1'-0"


FED. RD. DIVISION	STATE	PROJECT	FISCAL YEAR
2	OHIO	5-135 (1)	1947

4
44


BROWN COUNTY
S.H. 951 SEC. E (PT.)

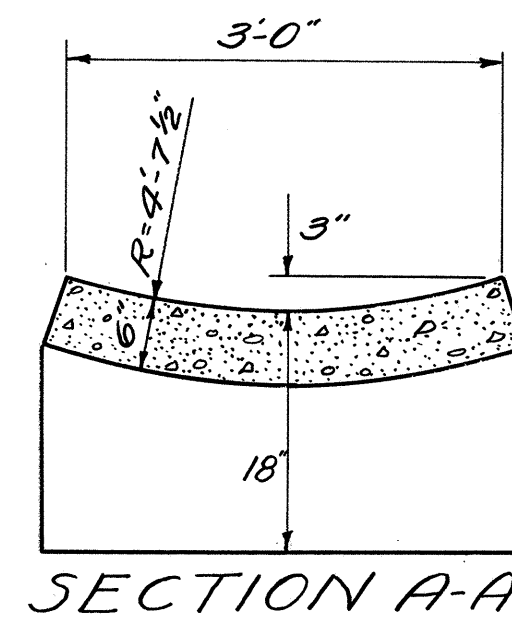

Note: Where proposed paved gutter abuts other gutter cutoff walls shall be eliminated

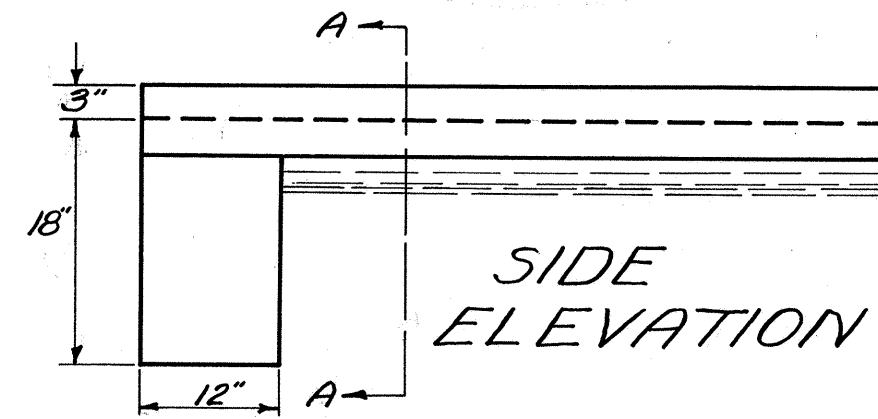

DETAIL OF CONCRETE PAVED GUTTER

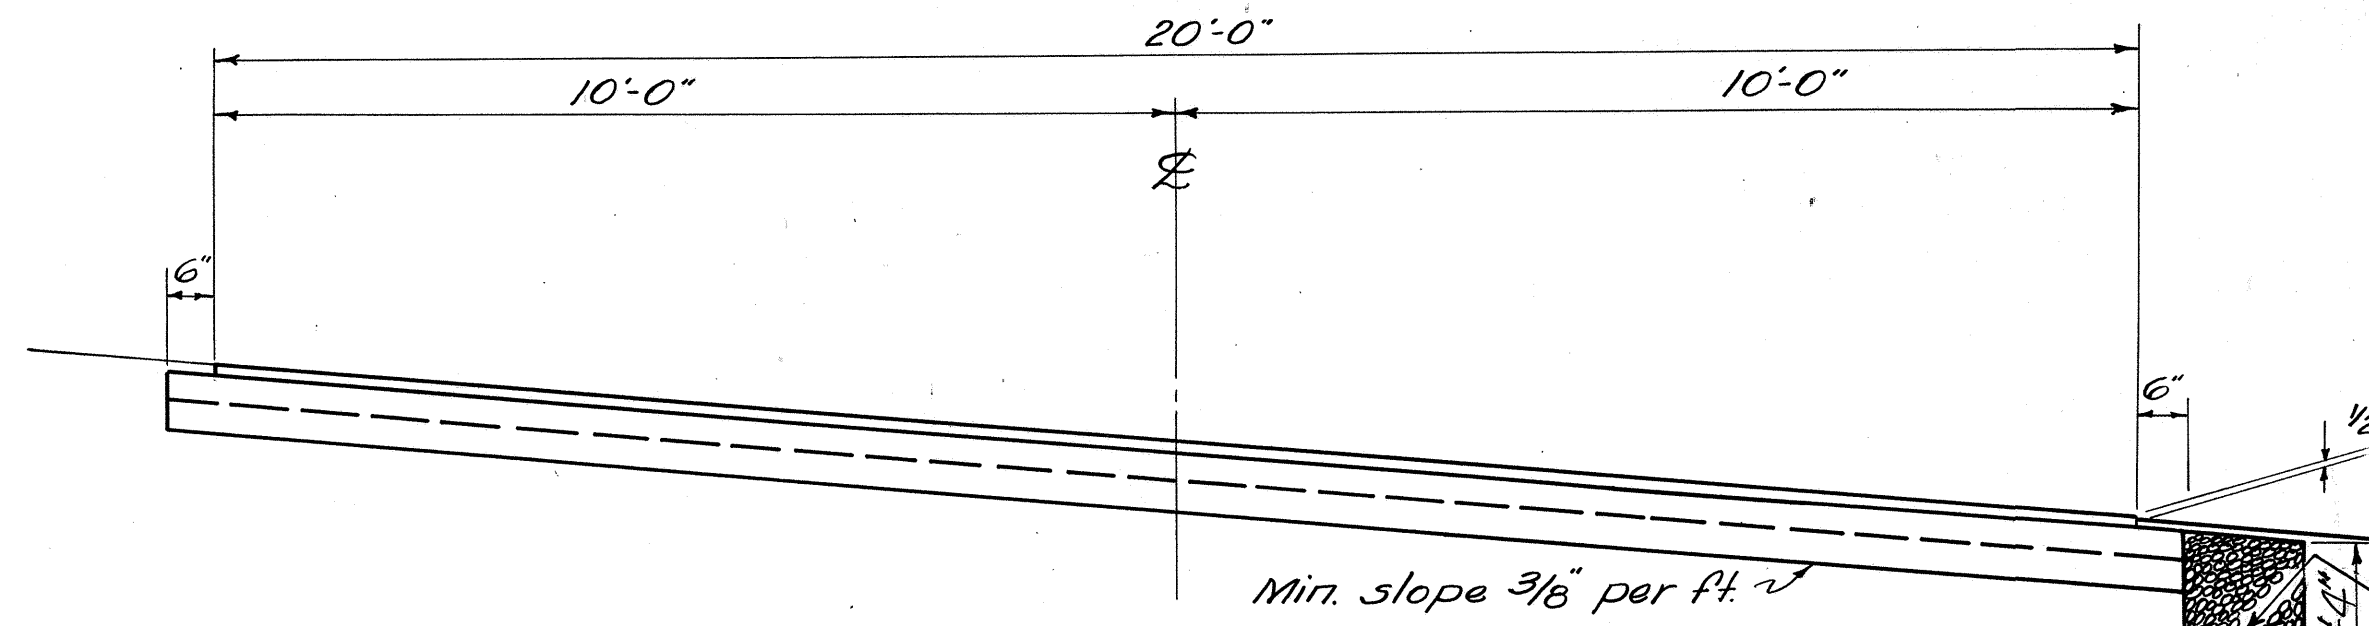


SECTION SHOWING LONGITUDINAL DRAINAGE

The above Section applies between the following Stations
Sta. 20+15 to Sta. 35+80


Porous Backfill for pipe Item I-4 shall be No. 20 size with a 1/2" sieve top of pipe, remainder of porous backfill shall conform to grading shown in table.

Pipe Underdrain Item I-4
For location, see Alignment and Cross Section Sheets.


PERCENT PASSING		
Sieve Openings		
3/4"	100	No. 200
30-100	0-35	0-5

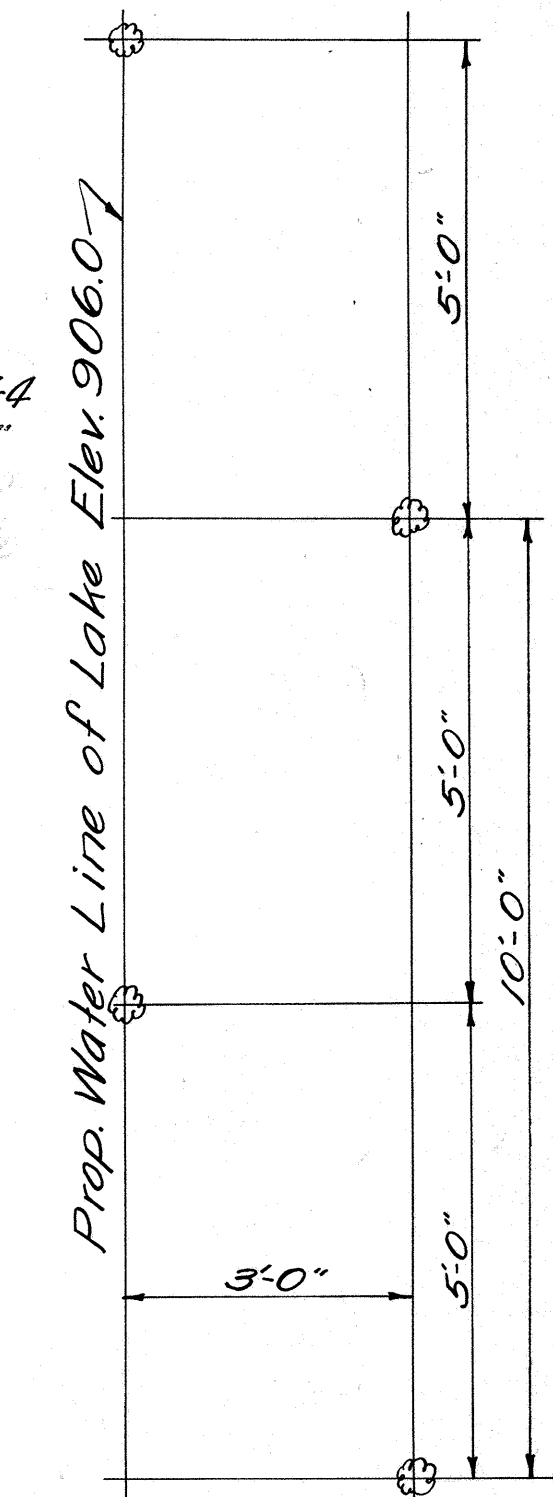

SPACING OF DWARF WILLOWS FOR SLOPE PROTECTION

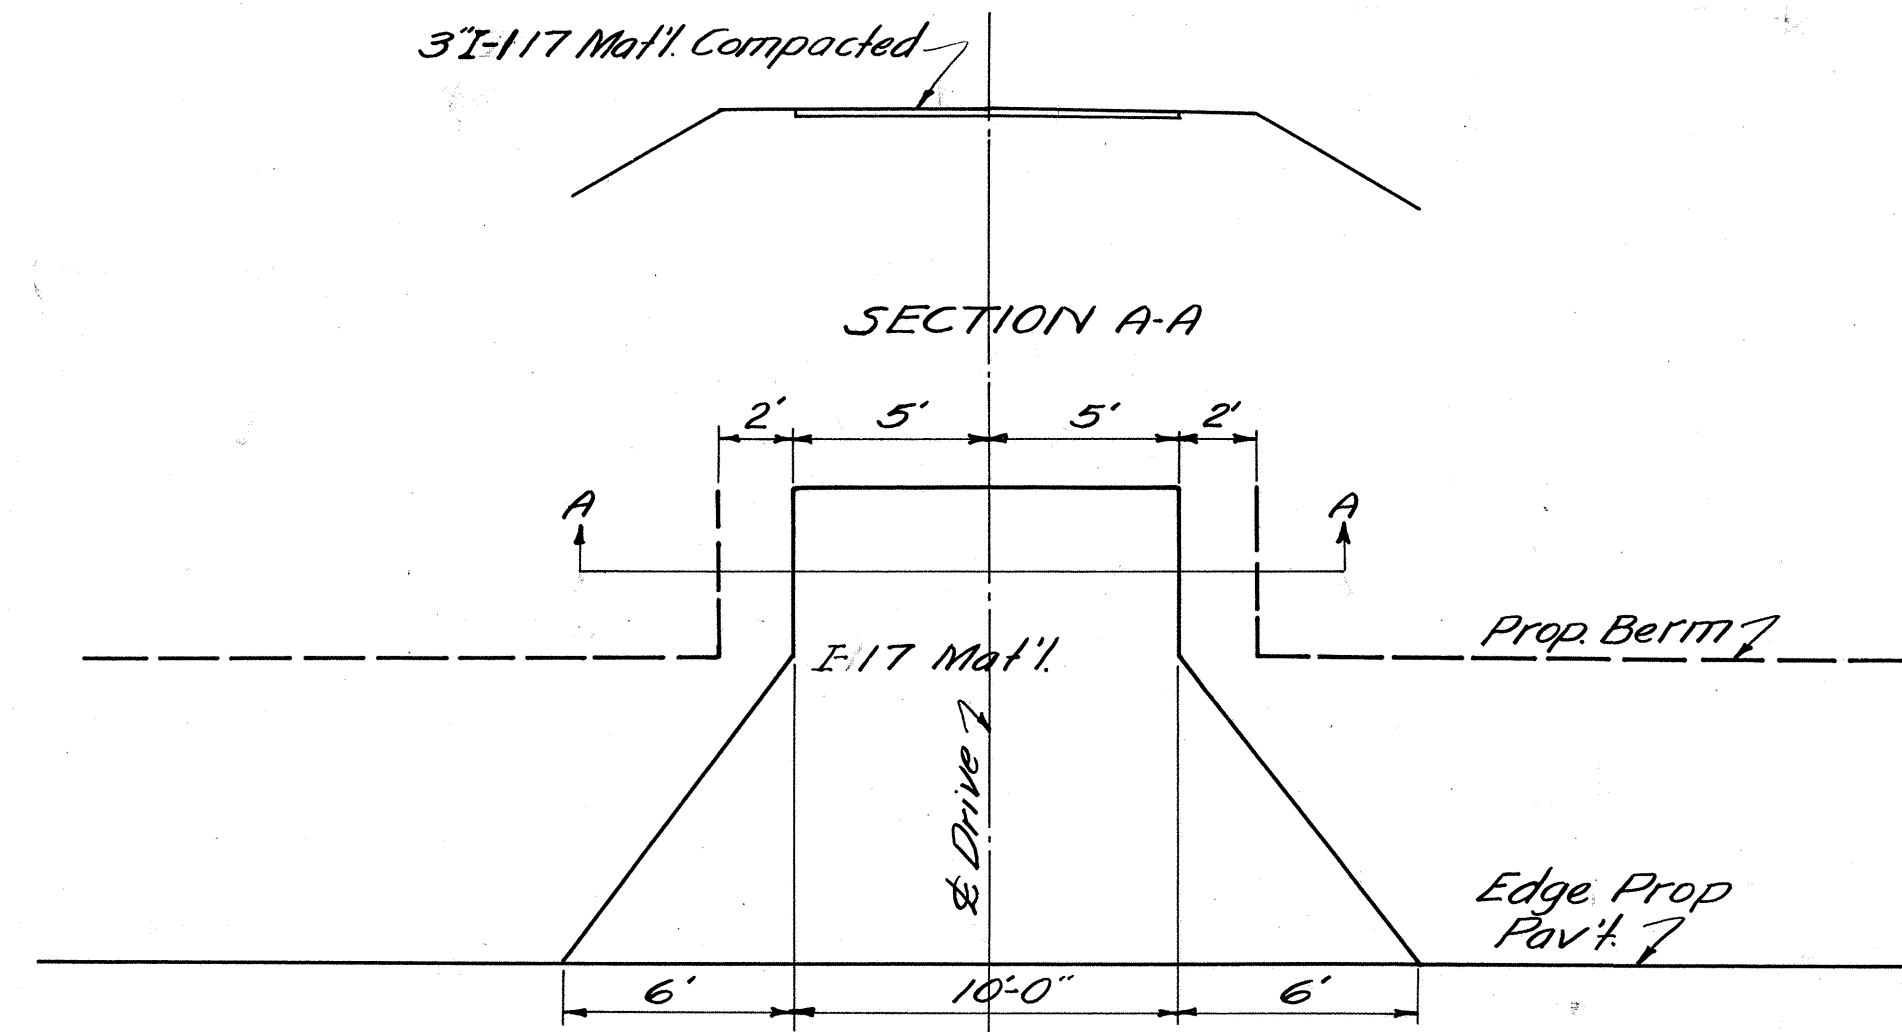


TYPICAL PLAN OF DRIVE

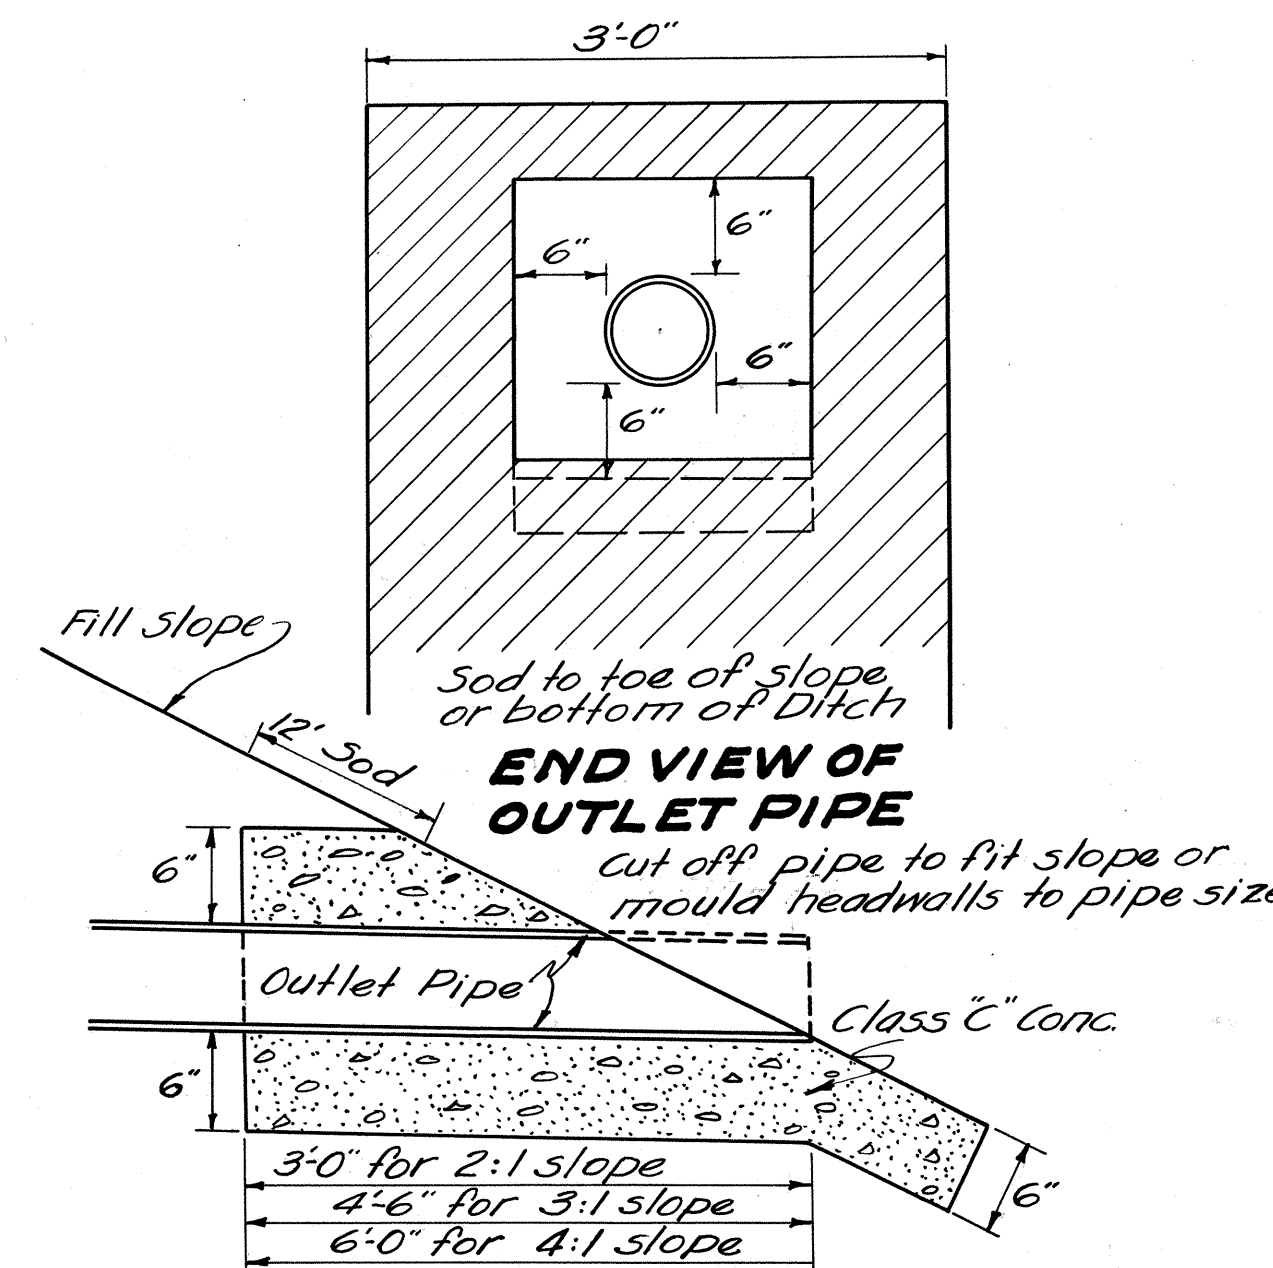


DETAIL OF PIPE UNDERDRAIN OUTLET HEADWALL

Note: No forms will be required for Pipe Underdrain Outlet Headwalls. Unit price bid per lineal feet for Pipe Outlets for Underdrains, shall include headwalls as shown above.

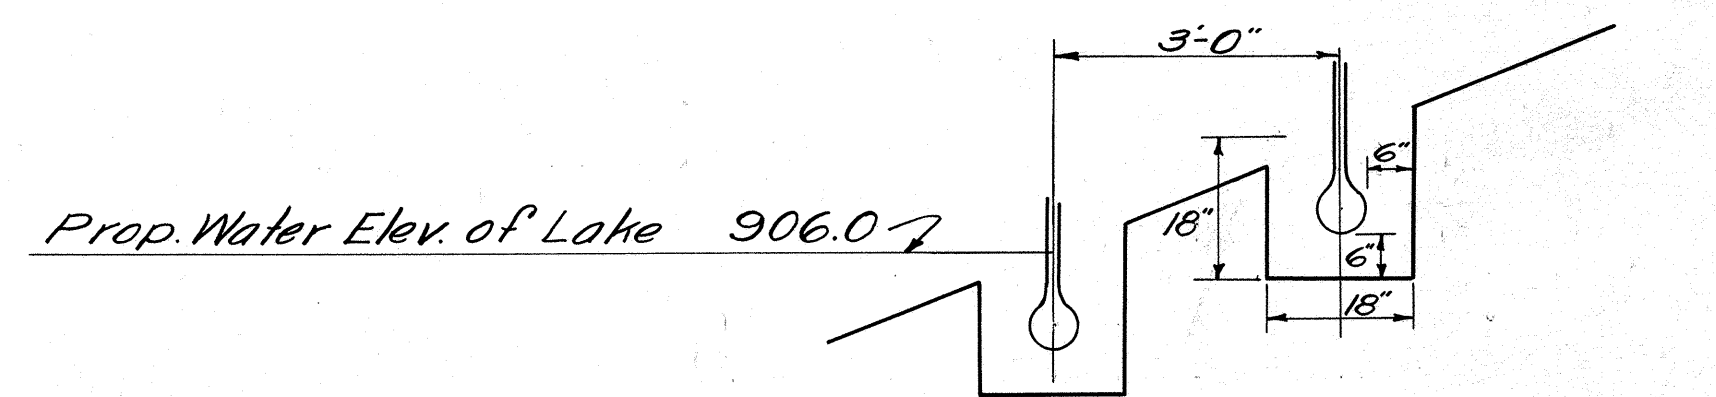

DETAIL OF POCKET HOLES FOR DWARF WILLOWS

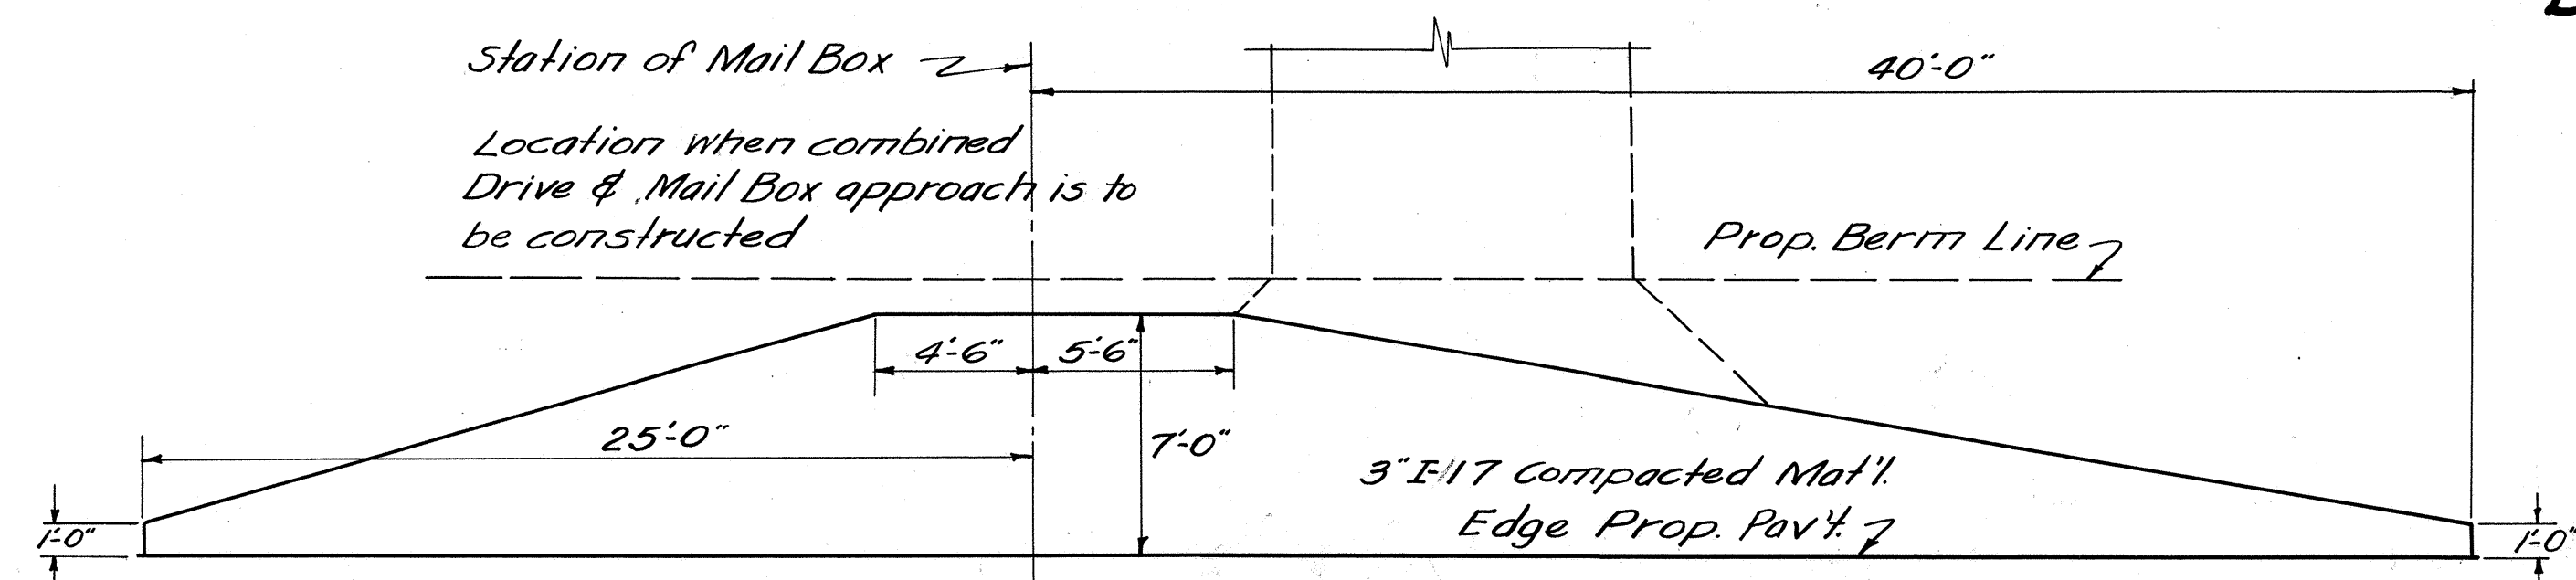

TYPICAL PLAN MAIL BOX APPROACH

Station of Mail Box
Location when combined Drive & Mail Box approach is to be constructed

NOTES

FED. RD. DIVISION	STATE	PROJECT	FISCAL YEAR
2	OHIO	S-135 (1)	1947

5
44

**BROWN COUNTY
S.H. 951 SEC. E (PT.)**

GENERAL

FIELD OFFICE

The contractor shall provide a suitable "Field Office" for the exclusive use of the engineer and inspectors assigned to this project. This office shall have a minimum of 140 sq. ft. of floor space and so arranged, equipped and lighted that the State employees will have a convenient place for making the necessary records, etc., and have a safe place for storage of equipment, plans and necessary supplies. The contractor shall have a telephone installed and maintained during construction of this project. When the work is in progress during cold weather, the office shall be heated to a temperature of at least seventy (70°) degrees Fahrenheit (See section 5-0.01 (b) of the Construction and Material Specifications.)

UTILITY ADJUSTMENT

Any and all work required for Public or Private Utilities will be done by and at the expense of their respective owners unless otherwise noted in these plans.

~~WINTER CONSTRUCTION~~

~~Construction operations shall not be suspended for inclement weather. Winter Concrete Construction will be required and structure operations will be made in accordance with Section 5-1.09 of the Construction and Material Specifications.~~

TRAFFIC

Two-way traffic shall be maintained at all times. Temporary roadways deemed necessary by the engineer, shall be constructed, maintained and removed by the contractor. During the paving operations one-way traffic will be permitted and the one-way traffic zones shall be consistent with the requirements of Sec. G-8.07.

In addition to the requirements of Sec. G-1.07, Barricades, Danger and Warning Signs, the contractor shall display one "PLEASE-MEN WORKING ON ROAD" sign furnished by the State at each end of each one-way zone and in such a position as to be visible to traffic approaching the one-way zone.

The contractor shall be responsible for the preservation of these signs, shall advance the signs as work progresses and shall return the signs to the State at the completion of the work.

The item of "Maintaining Traffic" shall include furnishing lights, signs, (other than those mentioned above) barricades and watchmen, plus the displaying and advancing of the "PLEASE-MEN WORKING ON ROAD" signs to secure the flow of traffic twenty four (24) hours daily.

Traffic Compacted Surface Course, Item T-110, and Calcium Chloride, Item M-10, estimated and paid for under Item T-110 and M-10, shall be applied as directed and in the amounts requested by the engineer.

All of the above, except Traffic Compacted Surface Course, Item T-110 and Calcium Chloride, Item M-10, is included in the lump sum bid for maintaining traffic. In addition to the above, Sec. G-4.05 (maintenance of local traffic) of the Construction and Materials Specifications, will be enforced during the life of the contract.

PAVEMENT

SUPERELEVATION

Superelevated curves shall be built without crown. The crown shall be worked out of the pavement in that portion between the beginning of the transition and the point where the superelevation equals twice the crown.

ROADWAY


REMOVAL OF TREES AND STUMPS

~~The removal of trees and stumps, the diameters of which are over eight (8) inches (measured one (1) foot above the ground) shall be in accordance with Supplemental Specifications No. E-109.~~

~~All stumps within the limits of the right-of-way shall be disposed of as specified in paragraph E-1.02 of the Construction and Material Specifications.~~

~~Trees shall not be removed, regardless of size, until specifically and conspicuously marked by the engineer.~~

~~Trees in areas where the proposed contour of the ground differs from the existing contour shall be removed or preserved as indicated on the plans by the following symbols:-~~

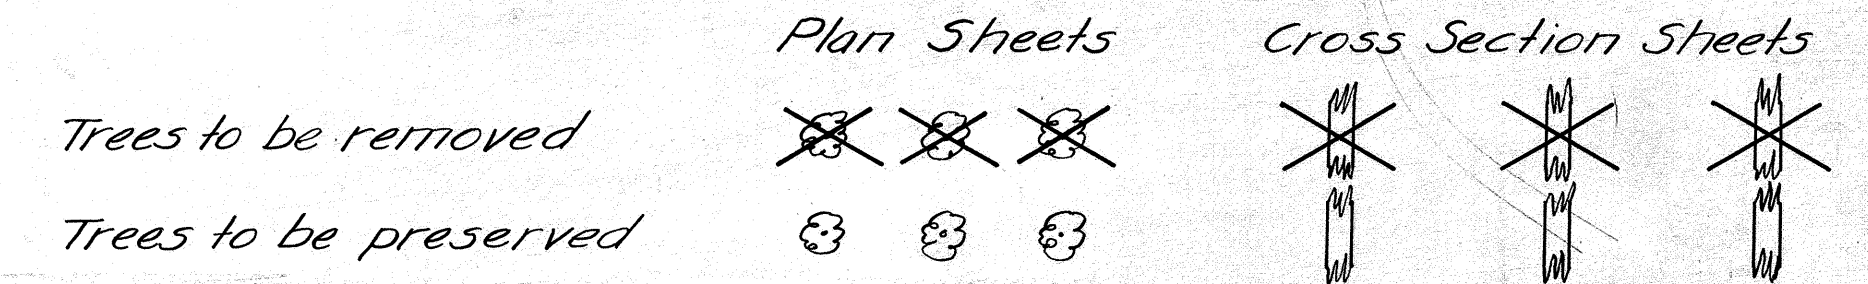

~~The number of trees to be removed as indicated by the above symbols is approximate and the State of Ohio reserves the right to order the removal of additional trees even though these trees are not indicated to be preserved.~~

~~Payment for the removal of these additional trees is included in the lump sum bid for removal of trees and stumps.~~

EMBANKMENT

In lieu of the requirements for full width construction under E-1.05 the embankment, where traffic is maintained, may be placed in part width construction.

~~DISPOSAL OF WASTE MATERIAL~~

~~Any excavation which is unfit for incorporation in the pavement and which would appear unsightly, shall be covered with earth to a minimum of eight (8) inches and made to conform to the contour of the adjacent land. If wasted within three hundred (300) feet of the right of way, without expense to the State, notwithstanding the written permission of the property owner to do otherwise.~~

SILT

Excavated material and borrow of which the grain size of 50% or more is between 0.074 mm and 0.005 mm (State Highway Testing Laboratory method of testing) shall be placed at least three (3) feet below the pavement when used in embankment, however such material shall not be used in any part of the embankment between Sta. 35+50 and Sta. 40+64.33.

REMOVAL AND STORING OF EXISTING PIPE

Pipe listed for removing and storing under Item E-12 shall be stored on the right of way at the disposal of the Highway Department.

LOCATION AND SIZE OF EXISTING PIPE

The location, type, depth and size of all existing pipes are shown as near exact as the available information will permit. The State of Ohio will not be responsible for any variations found during construction.

Payment for pipe removed will be made according to the listing shown on these plans.

STONE UNDERDRAINS

In the final finishing, care shall be exercised that the exposed ends of the underdrains shall be left free of earth cover that would impede free drainage.

NOTES

FED. RD. DIVISION	STATE	PROJECT	FISCAL YEAR
2	OHIO	S-135(1)	1947

6
44

BROWN COUNTY
S.H. 951 SEC. E (PT.)

ROADWAY

SEEDING AND PROTECTING ROADWAY AREAS

Quantities for Seeding Item L-9 are calculated for the soil areas between lines ten feet (10) outside the work limits as shown on the cross sections or to the R/W line if such line is less than ten feet from the work limits.

All areas outside these limits where the vegetative growth has been injuriously disturbed or destroyed by contractor shall be restored and seeded in accordance with the provisions of Item L-9 by the contractor at his own expense.

~~NO. 1 SEEDING ITEM E-305~~

~~Seeding on berms to be done according to specifications E-305 Rev. except that four (4) pounds per one thousand (1000) square feet shall be sown and the following mixture to be used.~~

- ~~30 % Meadow Fescue~~
- ~~20 % Kentucky Blue Grass~~
- ~~30 % Alsike Clover~~
- ~~15 % Perennial Rye Grass~~
- ~~5 % Hairy Vetch~~

~~NO. 2 SEEDING ITEM E-305~~

~~Seeding of all other berms shall be done according to specifications Item E-305 Rev. except that four (4) pounds per one thousand (1000) square feet shall be sown and the following mixture to be used.~~

- ~~15 % Meadow Fescue~~
- ~~10 % Kentucky Blue Grass~~
- ~~15 % Alsike Clover~~
- ~~15 % Perennial Rye Grass~~
- ~~15 % Hairy Vetch~~
- ~~30 % Yellow Blossom Clover~~

~~An additional 20% of Perennial Rye Grass shall be sown in all seeded ditches at the time of seeding operations.~~

~~All legumes shall be inoculated.~~

~~SODDING~~

~~The time limitations set up under Item L-10 may be waived at the discretion of the Director if straw which two (2) inches thick is estimated for all sod areas. Sod shall be mulched only if the time limitation is cancelled. Only sod areas placed because of cancellation of time limitation. Remainder of mulching (straw) Item L-10 shall be non-performed.~~

~~PLACING SOD~~

~~Special care shall be taken in placing all sod so that the top of the sod coincides with the finished surface as shown on the cross sections. All earthwork necessary to accomplish the above is included in the unit price bid per square yard of sod.~~

~~AGRICULTURAL GROUND LIMESTONE~~

~~Agricultural ground limestone shall be applied at the rate of 100 lbs. per 1000 sq. ft. for sodding and sodding areas. Agricultural ground limestone shall be of a fineness that 99% will pass a 10 mesh sieve, with 40% passing a 50 mesh sieve; and with a minimum total neutralizing power of 95%.~~

~~FERTILIZING AREAS TO BE SEEDED~~

~~All areas to be seeded and seeded in accordance with Item E-305 shall have commercial fertilizer (11-11-11), or any formula approved by the Director, applied at the rate of twenty (20) pounds per one thousand (1000) square feet.~~

ROADWAY

CLASSIFIED EMBANKMENT

Special care shall be taken to properly compact Classified Embankment Material placed adjacent to an existing pavement edge.

Compaction shall be carefully controlled and measured and the density shall not be less than 98% of the maximum density as determined by laboratory tests on material passing a 1" screen.

EXCESS EXCAVATION

Any excess material resulting from the various items of excavation on this project shall be disposed of in accordance with Item L-106 however a portion of the excess material shall be placed in the area right of Station 41+00 as shown on these plans.

MULCHING AREAS TO BE SEEDED

Within forty eight (48) hours after any areas have been seeded such areas shall be covered with mulch as specified under Item E-305 which shall be held in place through out the life of the contract.

Searman Pulver Mixer may be used to incorporate the mulch with the soil in place of the Peg and Twine method as outlined in Supplemental Specifications E-305.

REMOVING AND STORING OF EXISTING GUARD RAIL

Guard Rail listed for removing and storing under Item E-15 shall be stored on the right of way of the disposal of the Highway Department.

EMBANKMENT

The embankment in the area from Station 35+50 to Station 40+64.33 shall be constructed of soil as defined in Item E-105 which shall be of a nature so as to provide an impervious embankment to an elevation of 909.00 and shall meet the compaction requirement as outlined under "Condition II" of Item E-105. Special care shall be taken in the "Clearing and Grubbing" Item E-102 and "Scalping" Item E-103 and the "Bordling" of the embankment material to the existing earth in the area where the embankment is placed.

Where rock is encountered in the areas where embankment is to be placed a trench shall be cut along the centerline of the road, ten (10) feet wide and three (3) feet deep. This trench shall be cleaned of all loose rock, back-filled and compacted with soil as described above.

Payment for this excavation shall be made at the unit price bid per cu. yd. of "Roadway Excavation (Unclassified) Item E-1."

Note: Channel Excavation 13,504 Cu.Yds. (See Sheet No 20) shall be used to reduce borrow
 13,944 Borrow - 13,504 Channel Excavation = 440 Cu.Yds. Net Borrow.
 Additional Excavation for Pavement Removal not indicated on Cross-sections Sta. 41+87 to Sta. 48+00 = 613 Lin. Ft.; 200 Lin. Ft. See Sh. 2 (200+613) Lin. Ft. x 14" Width x 0.5 Thick = 207 Cu. Yds

SUMMARY OF QUANTITIES

FED. RD. DIVISION	STATE	PROJECT	FISCAL YEAR
2	OHIO	5-135 (1)	1947

7
44

**BROWN COUNTY
S.H. 951 SEC. E (PT.)**

①

Station to Station	Excavation Cu. Yds.	Embankment Cu. Yds.	Emb. + 20% Cu. Yds.	Borrow Cu. Yds.
19+00-20+00	346	4	5	Borrow
20+00-40+64.33	12496	33960	40752	
41+34.92-62+68	16074	1873	2250	
62+68-63+02	42	60	72	
63+02-63+66	207	24	28	
Total	29165	35899	43079	1394

②

Sheet No	Standard 9" Rein. Conc. Appr. Slabs Item I-7 Sq. Yds.	6" Asphaltic Concrete Tack Coat Concrete 0.1 gal. per Surface Course Sq. Yd. Item T-30 Item T-30 Sq. Yds.	Tack Coat Concrete 0.1 gal. per Surface Course Sq. Yd. Item T-30 Item T-30 Sq. Yds.
12	97	97	97
Total	97	97	97

* Carried to Box No. 8

⑦

Location	Bituminous Prime Coat Item T-30			Bituminous Surface Treatment Item T-32		
	Width	Calculations	Sq. Yds.	Width	Calculations	Sq. Yds.
Typical Sections 4172.16 Lin. Ft. Approaches	21	4172.16 x 21 x 1/8	9735	20	4172.16 x 20 x 1/8	9271
Total			9941			9466

* Carried from Box No 2

②

Sheet No	Bituminous Prime Coat Item T-30 Sq. Yds.	Bituminous Road Mix Surface Course Item T-32 Sq. Yds.	Side Approaches Mailbox Turnouts and Berm Mat'l Item I-17 Cu. Yds.	12" Pipe for Drive ways Item I-1 Lin. Ft.	18" Pipe for Drive ways Item I-1 Lin. Ft.	Sodding Item L-10 Sq. Yds.	8" Classified Embankment Item SS-112 Sq. Yds.	12" Boiler Pipe Removed and Disposed of Item E-12 Lin. Ft.	Removal of Exist. Structure 1' x 14" Stone Box Item S-24 Lump
10	54	53	30	48		20	54	16	Lump
12			7	22	22				
13			25	66		25			
14	133	127	3				133		
9	19	15					19		
Total	* 206	* 195	65	136	22	45	* 206	16	Lump

* Carried to Pavement Box No 7
 * Carried to Classified Embankment Box No 11

⑧

Item No	Material	Rate	Sq. Yds.	Calculations	Quantity
T-30 Prime Coat	M-5.7 RT-2 or 3	0.35 gal. per Sq. Yd.	9941	9941 x 0.35	3479 Gal.
T-32 Road Mix	M-5.3 MC-5	0.70 gal. per Sq. Yd.	9466	9466 x 0.70	6626 Gal.
T-32 Road Mix	No 46 Aggregate	0.0292 C.Y. per Sq. Yd.	9466	9466 x 0.0292	277 Cu. Yd.
T-32 Choke	No 9 Aggregate	0.00375 C.Y. per Sq. Yd.	9466	9466 x 0.00375	36 Cu. Yd.
T-32 Seal Coat	M-5.3 MC-5	0.25 gal. per Sq. Yd.	9466	9466 x 0.25	2367 Gal.
T-32 Cover	No 6 Aggregate	0.0075 C.Y. per Sq. Yd.	9466	9466 x 0.0075	71 Cu. Yd.
T-30 Tack Coat	M-5.7 RT-2 or 3	0.10 gal. per Sq. Yd.	97	97 x 0.10	10 Gal.

③

Sheet No	6" Pipe Underdrain Item I-4 Lin. Ft.	6" Pipe Outlet Item I-4 Lin. Ft.	Concrete Approach Gutter Item I-14 Lin. Ft.	Special Concrete Paved Gutter Item I-14 Lin. Ft.	Stone Paved Gutter Item I-14 Lin. Ft.	Sodding Item L-10 Sq. Yds.	Pipe Special (6" x 6" Wye's) Item I-5 Each
10	977.5	21			25	228	
11	575.5	32			363	501	
12	583.0	32	72	136	106	1568	5
13						127	
Total	2136.0	85	72	136	494	2424	5

⑨

Structure No	Station	Excavation for Structure Item E-2 Cu. Yds.	18" Pipe for Roadway Culverts Item S-27 Lin. Ft.	24" C.I.P. Removed and Stored Item E-12 Lin. Ft.	Sodding Item L-10 Sq. Yds.
1	62+75	27	120	30	32
Total		27	120	30	32

⑩

Location	Stone Underdrain Item I-9 Lin. Ft.
Project (Estimated)	1500
Total	1500

④

Sheet No	Seeding and Protecting Type "A" Sodding Item L-9 Sq. Yds.	Salix mutabilis (Dwarf Willows) Item L-13 Each	Commercial Fertilizer (10-6-4 Mix) Item L-9 Tons	Agricultural Ground Limestone Item L-9 Tons	Mulching Item L-16 Sq. Yds.
9	594				
10	9248				
11	10650	100			
12	11974	29			
13	7702				
14	2033				
Total	42201	* 2501	129	4.02	20.12

+ Carried from Box No 13

⑪

Location	Width	Calculations	Cu. Yds.
Typical Sections 4172.16 Lin. Ft. Approaches * 206 Sq. Yds.	21	4172.16 x 21 x 1/8	2163
Total			2168

* Carried from Box No 2

⑫

Sheet No	Guard Rail Steel Beam Type (Deep) Item I-15 Lin. Ft.	Guard Rail Removed and Stored (Plank) Item I-15 Lin. Ft.	Guard Rail (Posts only) Item I-15 Each
11	897		5
12	178	260	
Total	1075	260	5

⑤ **REMOVAL OF TREES & STUMPS ITEM E-9**
 See Note on Sheet No 5
 Lump

N 1 Seeding = 10.15 x 12 Beam + 7.35 x 10' beam x 1/8" = 9805 Sq. Yds.
 N 2 Seeding = 26.31 x 1/8" = 9805 Sq. Yds.

⑬

Box No	Sodding Item L-10 Sq. Yds.	Prime Coat M-5.7 RT-2 or RT-3 Item T-30 Gals.	Tack Coat M-5.7 RT-2 Item T-30 Gals.
2	45		
3	2424		
8		3479	10
9	32		
Total	* 2501	3479	10

* Carried to Box No 4

⑭

ITEM	QUANTITY	UNIT	DESCRIPTION
E-1	3	Cu. Yds.	Excavation
Special	89	Sq. Yds.	5" Concrete Channel Pavement
L-9	512	Sq. Yds.	Seeding & Protecting (Type "A")
L-9	0.05	Tons	Commercial Fertilizer (10-6-4 Mix)
L-9	0.23	Tons	Agricultural Ground Limestone
L-13	24	Each	Salix Mutabilis (Dwarf Willow)
I-7	97	Sq. Yds.	Reinf. Concrete Appr. Slabs 9" Thick
T-30	10	Gals.	Tack Coat
T-35	6.7	Cu. Yds.	Asphaltic Concrete Surface Course
I-15	4768	Lin. Ft.	Guard Rail Steel Beam Type (Deep)

The above items are included in Roadway items of the General Summary. They are shown here for inclusion with the reinforced concrete pavement type estimate to be submitted to Public Roads Administration.

GENERAL SUMMARY

ITEM No.	TOTAL QUANTITY CONSTR. CODE Nos. 4231 & 6708	UNIT	ROADWAY		CONSTRUCTION TYPE CODE Numbers
			NO.	DESCRIPTION	
E-1	29162	Cu. Yds.	Roadway Excavation	4231	6708
E-4	410	Cu. Yds.	Borrow	410	
E-11	197	M. Gal.	Water	197	
E-12	16	Lin. Ft.	Pipe Removed and Disposed of (12" Boiler Pipe)	16	
E-12	30	Lin. Ft.	Pipe Removed and Stored (24" C.I.P.)	30	
E-9	Lump	Lump	Removal of Trees and Stumps (See Supplemental Notes)	Lump	
E-305	19805	Sq. Yds.	Seeding and Protecting Roadway Areas (No. 1)		
E-305	18296	Sq. Yds.	Seeding and Protecting Roadway Areas (No. 2)		
I-1	136	Lin. Ft.	12" Pipe for Driveways	136	
I-1	22	Lin. Ft.	18" Pipe for Driveways	22	
I-4	2136	Lin. Ft.	6" Pipe Underdrain	2136	
I-4	85	Lin. Ft.	6" Pipe Outlets for Underdrains As Per Plan	85	
I-5	5	Each	6" Pipe Specials (6" x 6" Pipes)	5	
I-9	1500	Lin. Ft.	Stone Underdrain (as per plan)	1500	
I-14	72	Lin. Ft.	Concrete Approach Gutter, as per plan (sheet No. 31)	72	
I-14	494	Lin. Ft.	Stone Faced Gutter, as per plan (Sheet No. 3)	494	
I-14	136	Lin. Ft.	Special concrete Faced Gutter, as per plan (Sheet No. 4)	136	
I-15	1075	Lin. Ft.	Guard Rail, Steel Beam Type (Deep)	1027.32	47.68
I-15	260	Lin. Ft.	Guard Rail, as Removed and Stored (Plank)	260	
I-15	5	Each	Guard Rail Posts (only)	5	
I-17	65	Cu. Yds.	Side Approaches, Mailbox Turnouts and Berm Material	65	
L-9	42,201	Sq. Yd.	Seeding and Protecting Type "A"	41,689	512
L-9	402	Tons	Commercial Fertilizer (10-6-4 Mix)	3.97	0.05
L-9	2012	Tons	Agricultural Ground Limestone	19.89	0.23
L-10	2501	Sq. Yds.	Sodding	2501	
L-13	129	Each	Salix mutabilis - Dwarf Willows, 2" to 3"	105	24
L-16	1253	Sq. Yds.	Mulching		
S-24	Lump	Lump	Removal of Existing Structure	Lump	
Special	89	Sq. Yds.	5" Concrete Channel Pavement		89
M-10	11	Tons	Calcium Chloride for Temporary Roadway	11	
T-110	556	Cu. Yds.	Traffic Compacted Surface Course for Temporary Roadway	556	
J-7	97	Sq. Yds.	9" Reinforced Concrete Approach Slabs (See and Dwg. No. 44)		97
T-30	10	Gal.	Bituminous Tack Coat, Sec. M-5.7 RT-2 or RT-3	3479	10
T-30	3479	Gal.	Bituminous Prime Coat, Sec. M-5.7 RT-2 or RT-3	6626	
T-32	6626	Gal.	Road Mix Bituminous Material, Sec. M-5.3 MC-5	277	
T-32	277	Cu. Yds.	No. 46 Aggregate for Road Mix	36	
T-32	36	Cu. Yds.	No. 9 Aggregate for Choke	2367	
T-32	2367	Gal.	Seal Coat Bituminous Material, Sec. M-5.3 MC-5	71	
T-32	71	Cu. Yds.	No. 6 Aggregate for Seal Coat	2168	6.7
T-35	6.7	Cu. Yds.	Asphaltic Concrete Surface Course Type "C"		
S5-112	2168	Cu. Yds.	Classified Embankment Material As Per Plan		
E-2	27	Cu. Yds.	Excavation for Structure	27	
E-2	30	Lin. Ft.	24" C.I.P. Removed and Stored		
S-27	120	Lin. Ft.	18" Pipe for Roadway Culvert	120	
Special	Lump	Lump	Maintaining Traffic see Note on Sheet No. 5	Lump	

FED. RD. DIVISION	STATE	PROJECT	FISCAL YEAR
2	OHIO	S-135 (1)	1947

**BROWN COUNTY
S.H. 951 SEC. E (PT.)**

8
44

STRUCTURES 20 FT. SPAN AND UNDER


STRUCTURES OVER 20 FT. SPAN

For Summary of Quantities see Sheet No. 33 & 37

**BROWN COUNTY
S.H. 951 SEC. E (PT.)**



EROSION CONTROL		
Station To Station	Seeding Item L-9 Sq. Yds.	See Sheet No.
19+00~20+00	594	16
Total	594	

DRIVES AND APPROACHES			
Station To Station	Bituminous Road Mix Surface Course Item T-32 Sq. Yds.	Bituminous Prime Coat Item T-30 Sq. Yds.	8' Classified Embankment Item SS-112 Sq. Yds.
19+00-20+00	15	19	19
Total	15	19	19

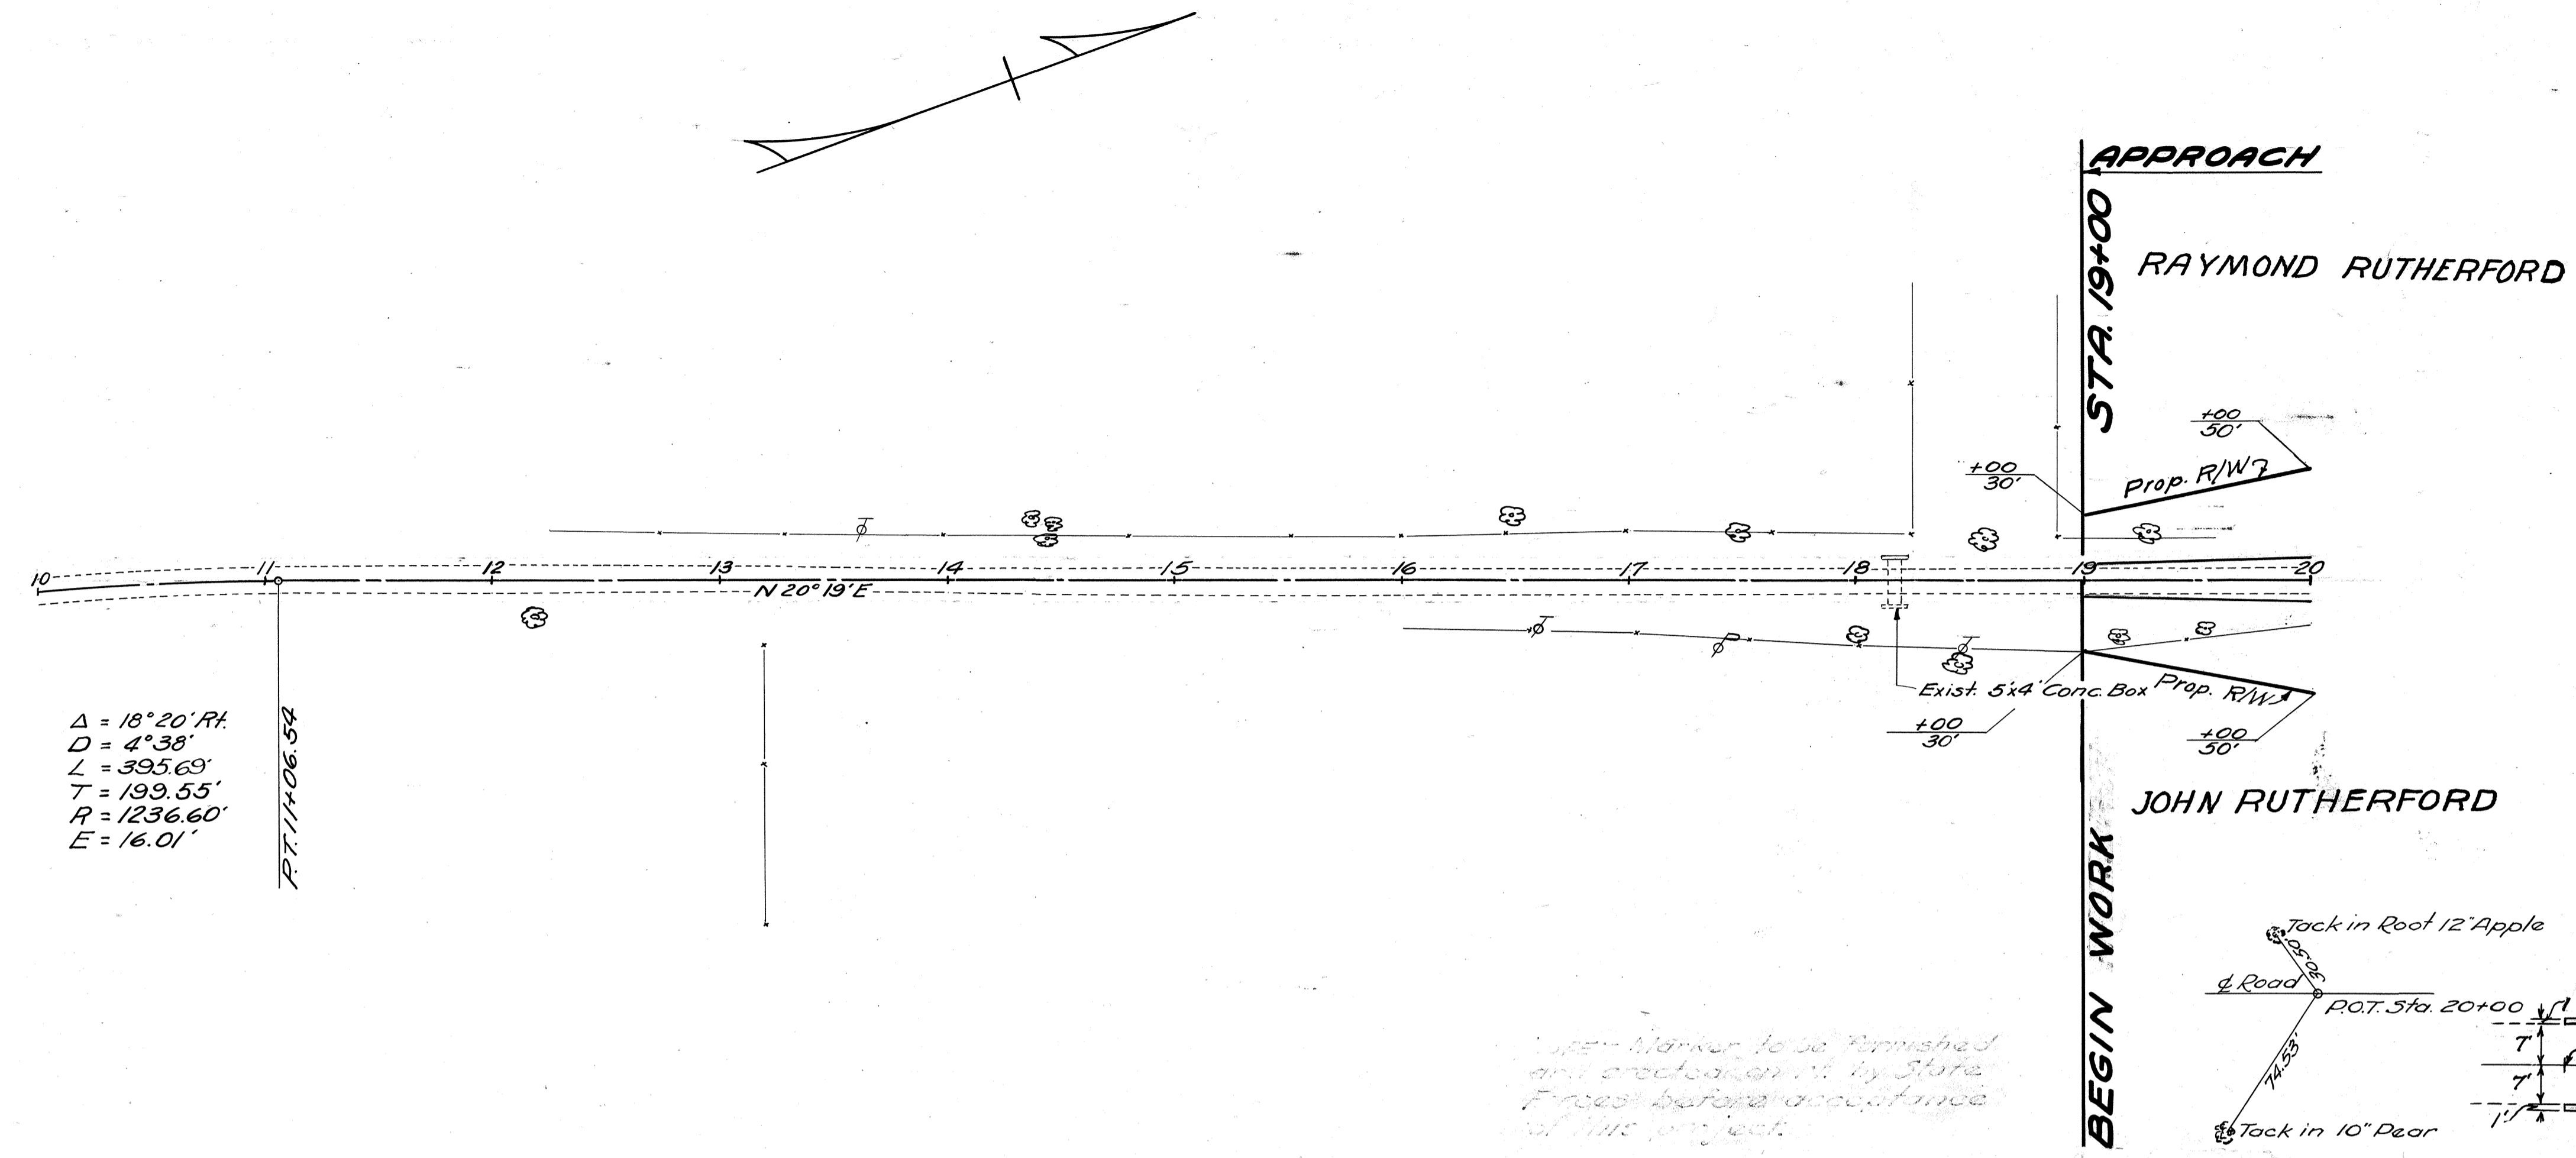

$\Delta = 18^\circ 20' \text{ Rt.}$
 $D = 4^\circ 38'$
 $L = 395.63'$
 $T = 199.55'$
 $R = 1236.60'$
 $E = 16.01'$


Survey Marker to be furnished and erected at by State Forces before acceptance of this project.

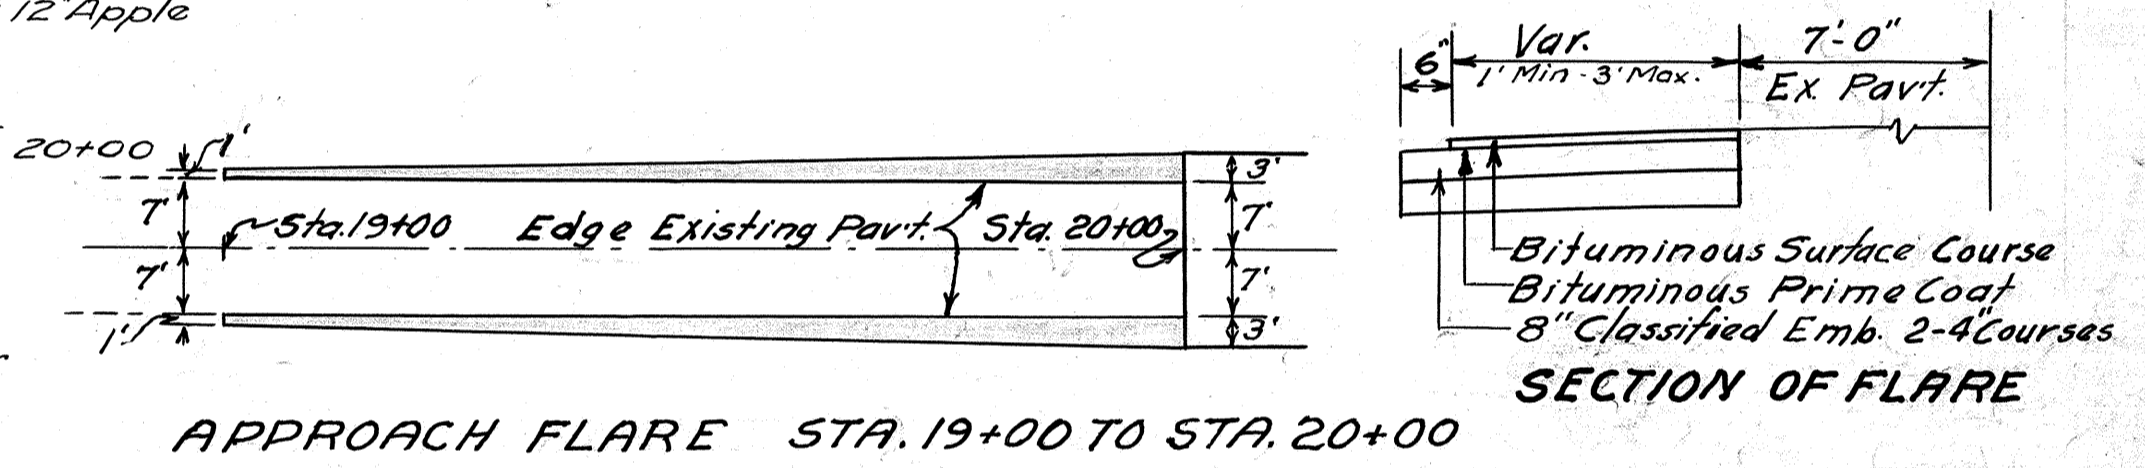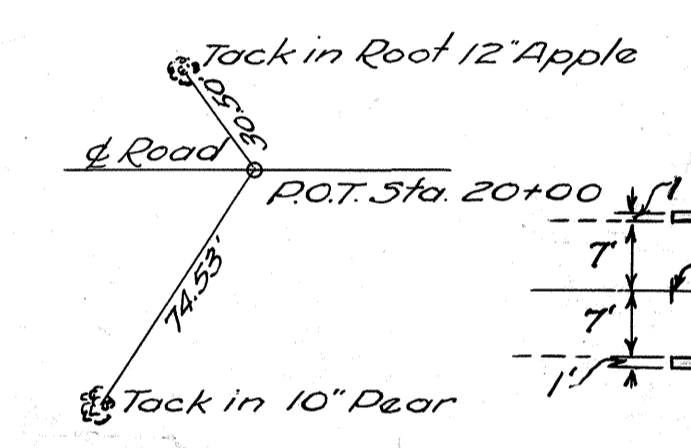

BENCH MARK
Boat Spike 3' up in 15" Walnut 20' Lt. Sta. 18+55
Elev. 929.34


Profile Shown is Crown of Existing Pavement

Note - All elevations shown are in reference to U.S.G.S. Datum.

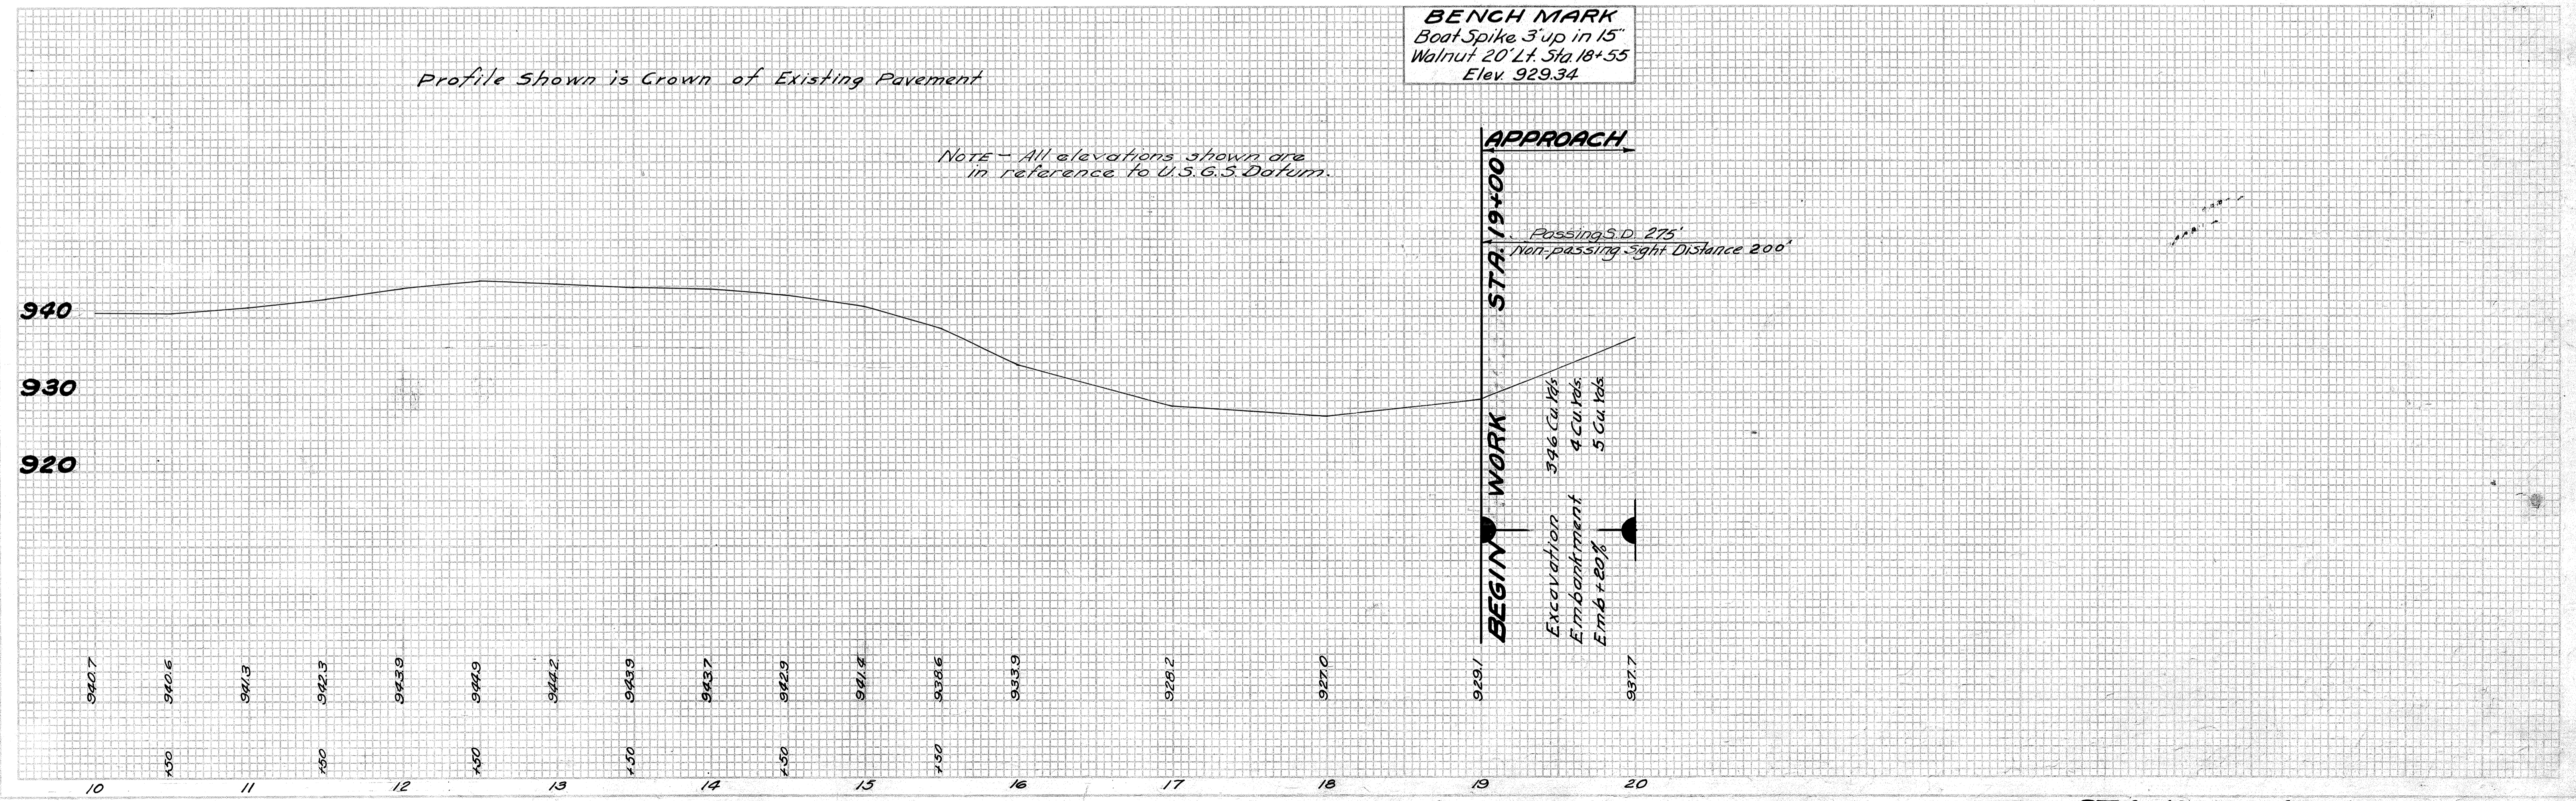

STA. 10+00 TO STA. 20+00


**BROWN COUNTY
S.H. 951 SEC. E (PT.)**

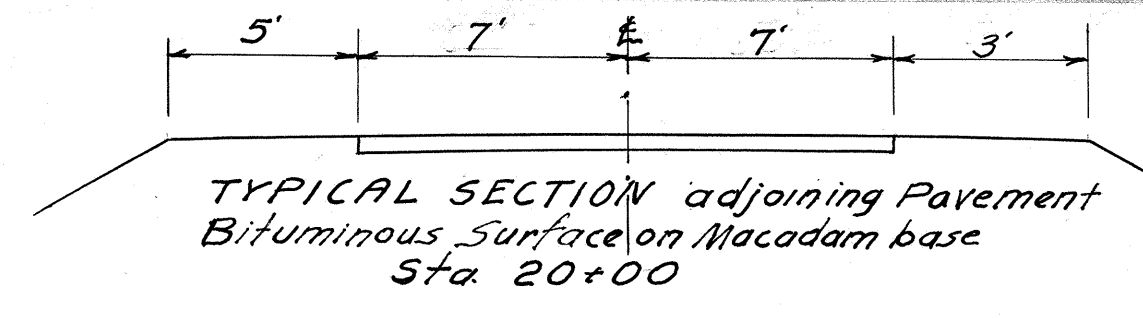

RAYMOND RUTHERFORD

UTILITY OWNERS
Telephone & Lynchburg & Mt. Orab Telephone Co., Mt. Orab, Ohio

JESSE GRIFFITH

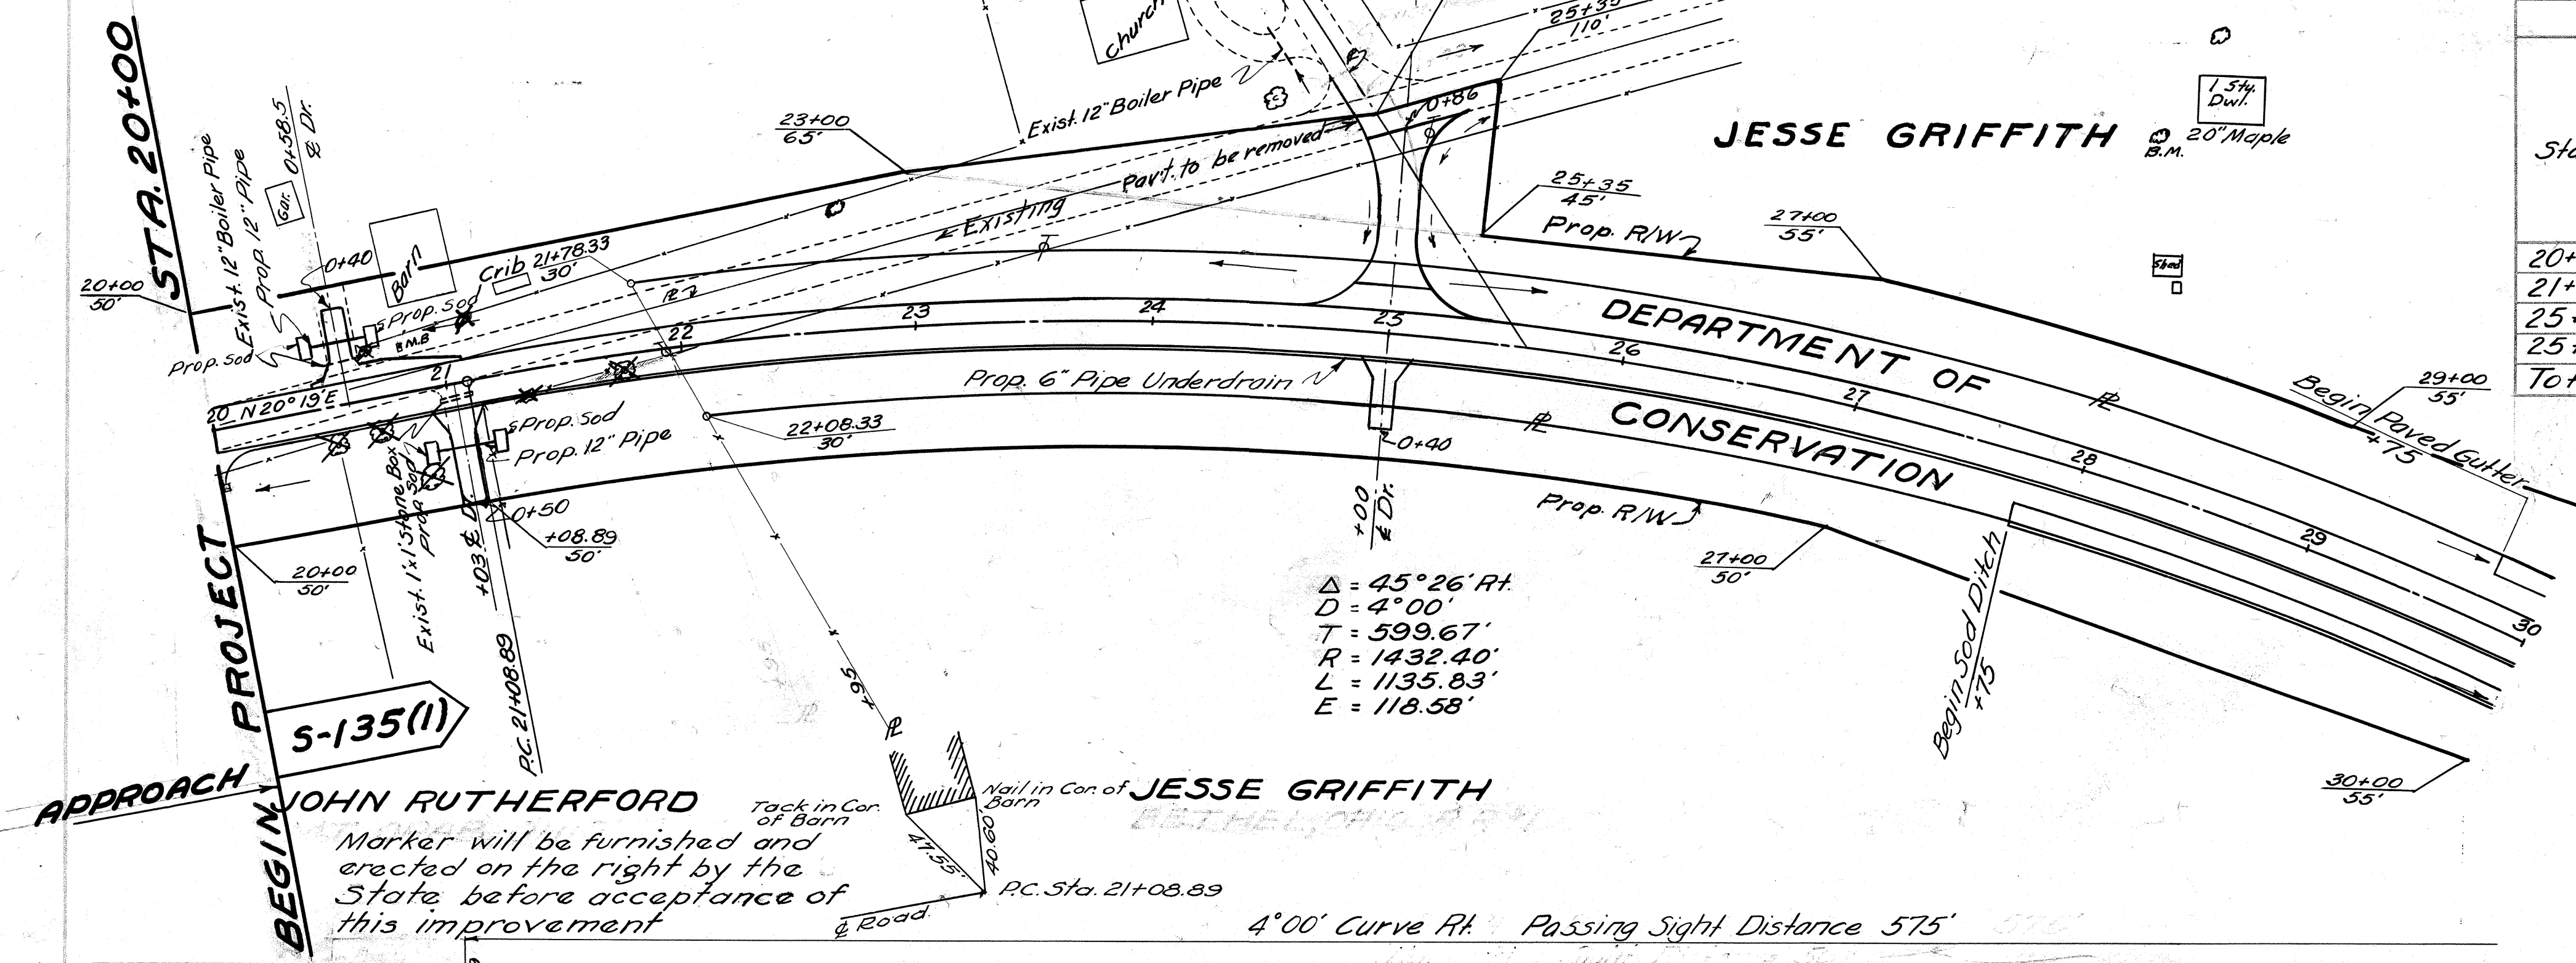


Station	Side	Approach Mailbox Turnout and Berm Material Item I-17 Cu. Yd.	Bituminous Road Mix Surface Course Item T-32 Sq. Yds.	Bituminous Prime Coat Item T-30 Sq. Yds.	8' Classified Embankment Driveways Item SS-112 Sq. Yds.	12\"/>				
20+58.5	Lt.	7				24	10	16		
21+03	Rt.	5				24	10		LUMP	
25+00	Lt.	14	53	54	54					30
25+00	Rt.	4								
Total		30	53	54	54	48	20	16	Lump	

Station To Station	Side	6\"/>			
20+00~20+15	Rt.		21	3	
20+15~30+00	Rt.	977.5			
29+75~30+00	Lt.				25
27+75~30+00	Rt.			225	
Total		977.5	21	228	25

Station To Station	Seeding Item L-9 Sq. Yds.	See Sheet No.
20+00~30+00	9248	16
Total	9248	

$\Delta = 45^\circ 26' \text{ Rt.}$
 $D = 4^\circ 00'$
 $T = 599.67'$
 $R = 1432.40'$
 $L = 1135.83'$
 $E = 118.58'$

BENCH MARK
Boat Spike in Root of 20 Maple in yard left of Sta. 27+00 Elev. 944.63

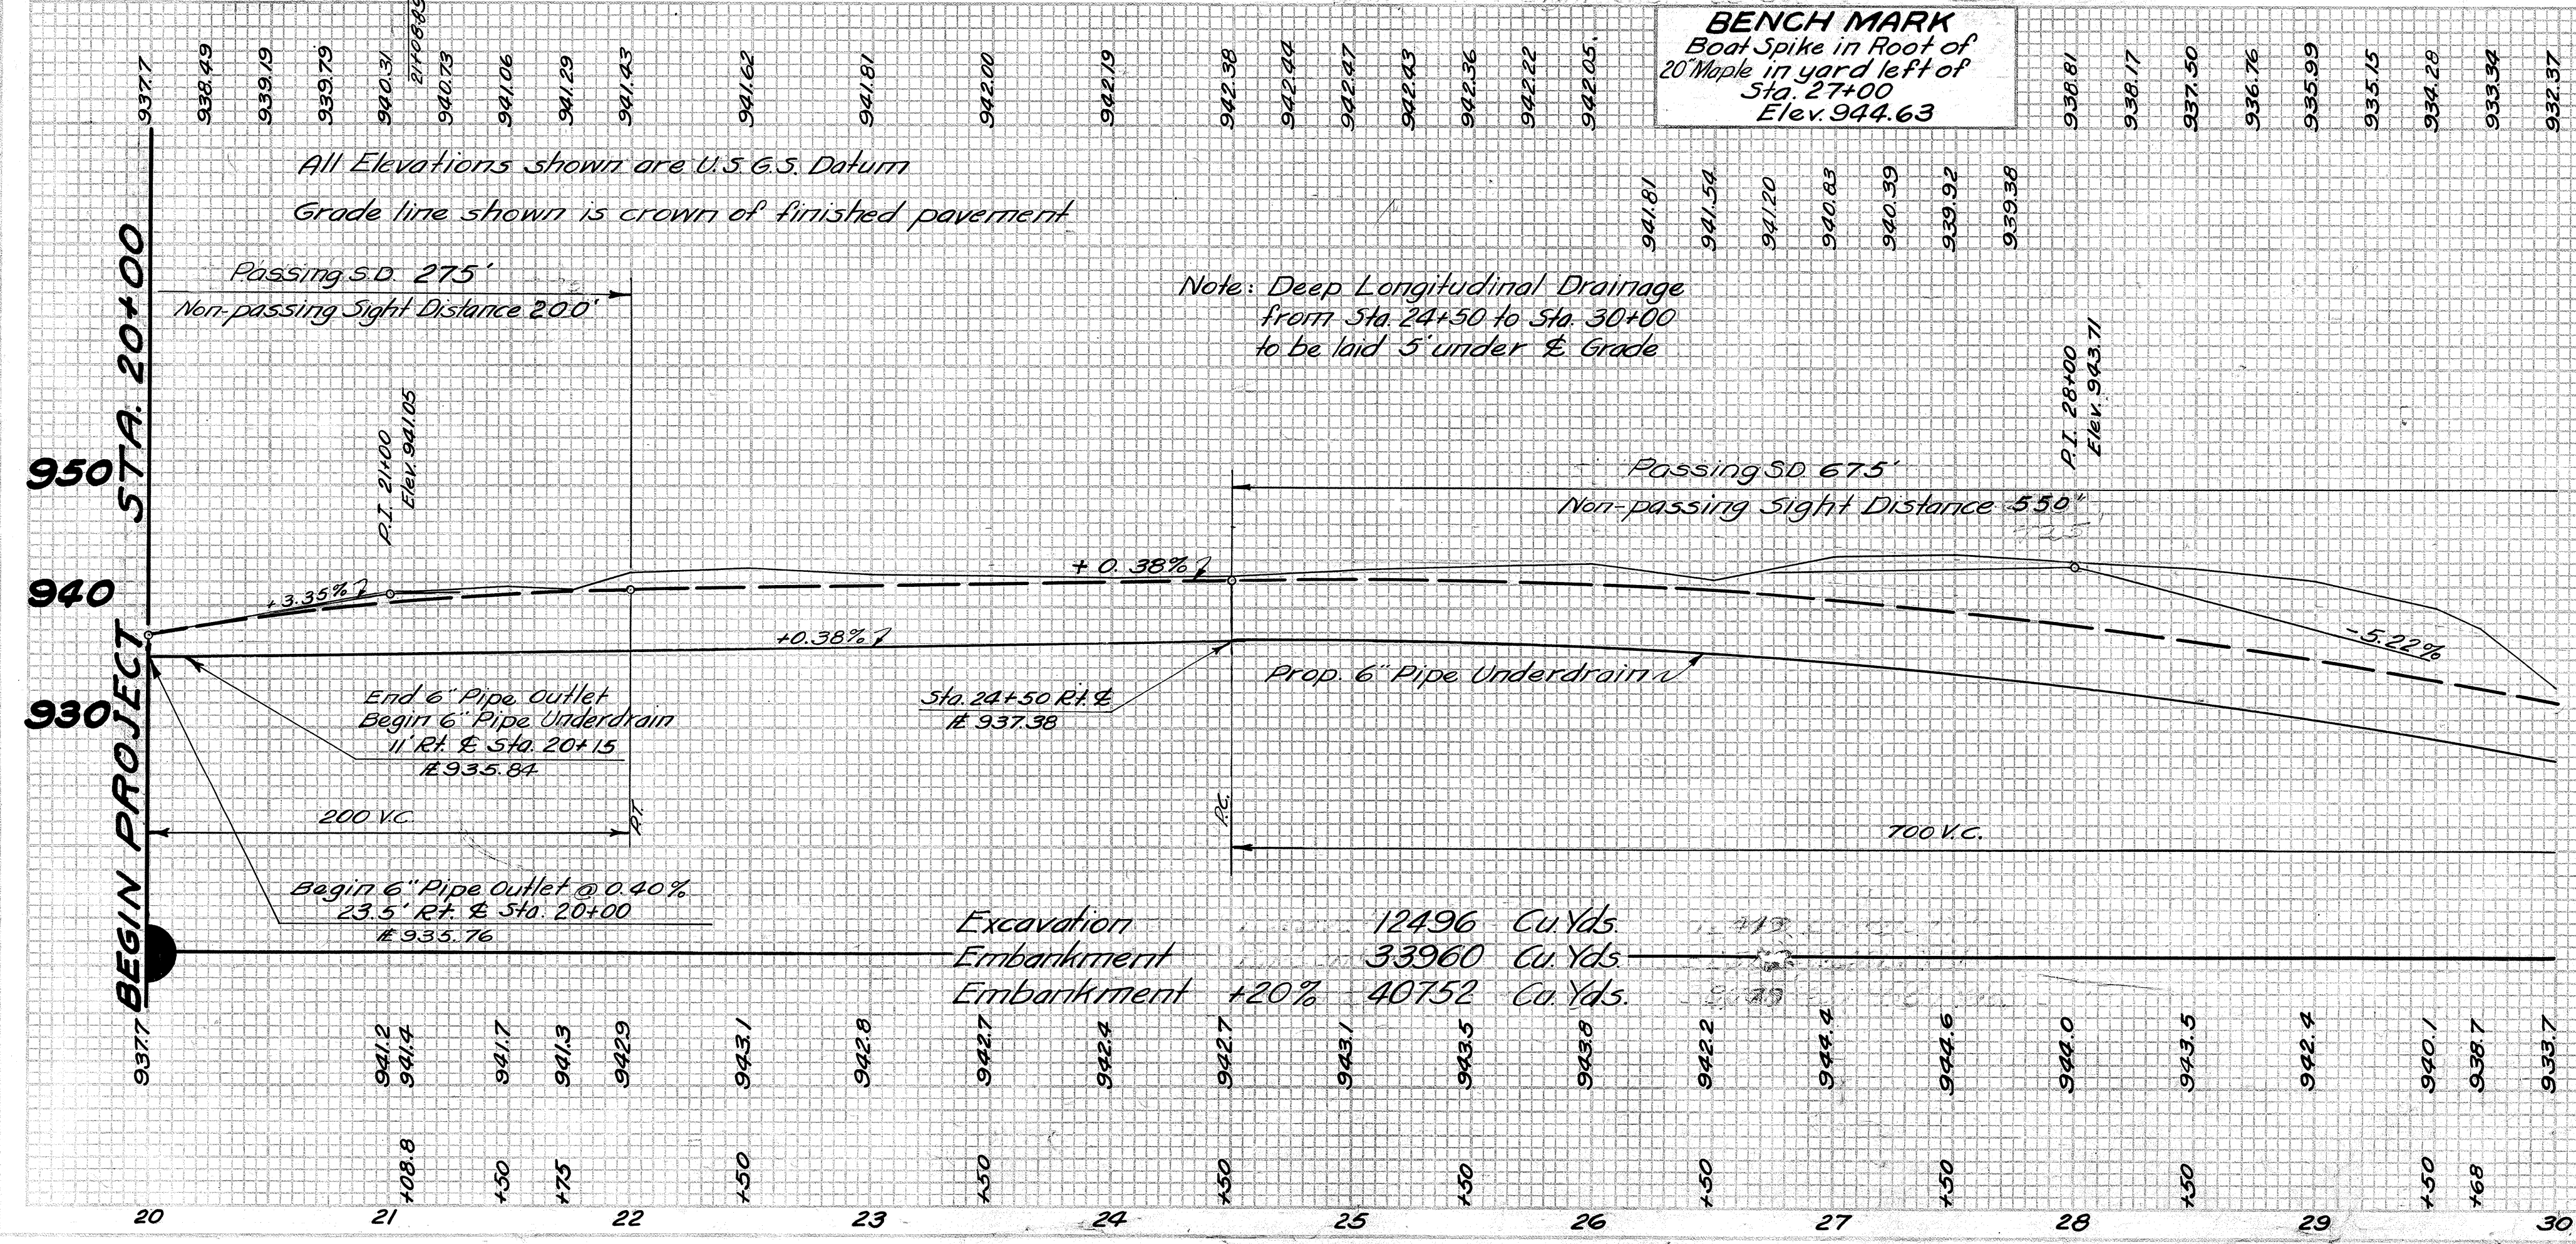

DEPARTMENT OF CONSERVATION


DEPARTMENT OF CONSERVATION

Prop. 24" Pipe Structure
5 (See Bridge Plans Sh. No. 32 & 37)

GUARD RAIL				
Station To Station	Side	Guard Rail Type (Deep) Item I-15 Lin. Ft.	Guard Rail Posts only Spaced 40c Each Item I-15 Lin. Ft.	See Sheet No.
35+26.5-40+00	Lt.	473.5		
35+76.5-40+00	Rt.	423.5		
34+80 Ex. Rd	Lt.		5	2
Total		897.0	5	


DRAINAGE					
Station To Station	Side	6" Pipe Underdrain Item I-4 Lin. Ft.	6" Pipe Outlet Item I-4 Lin. Ft.	Sodding Item L-10 Sq. Yds.	Stone Paved Gutter Item I-14 Lin. Ft.
30+00-35+80	Rt.	575.5			
35+80-36+00	Rt.		32	1	
30+00-31+00	Lt.				125
34+65	Lt.				30
35+00-36+90	Rt.			500	208
30+00-35+00	Rt.				
Total		575.5	32	501	363

EROSION CONTROL				
Station To Station	Side	Salix mutabilis (Dwarf Willows) Item L-13 Each	Seeding Item L-9 Sq. Yds.	See Sheet No.
30+00-40+00	Rt. Lt.		106.50	18
35+00-40+00	Lt.	100		
Total		100	106.50	

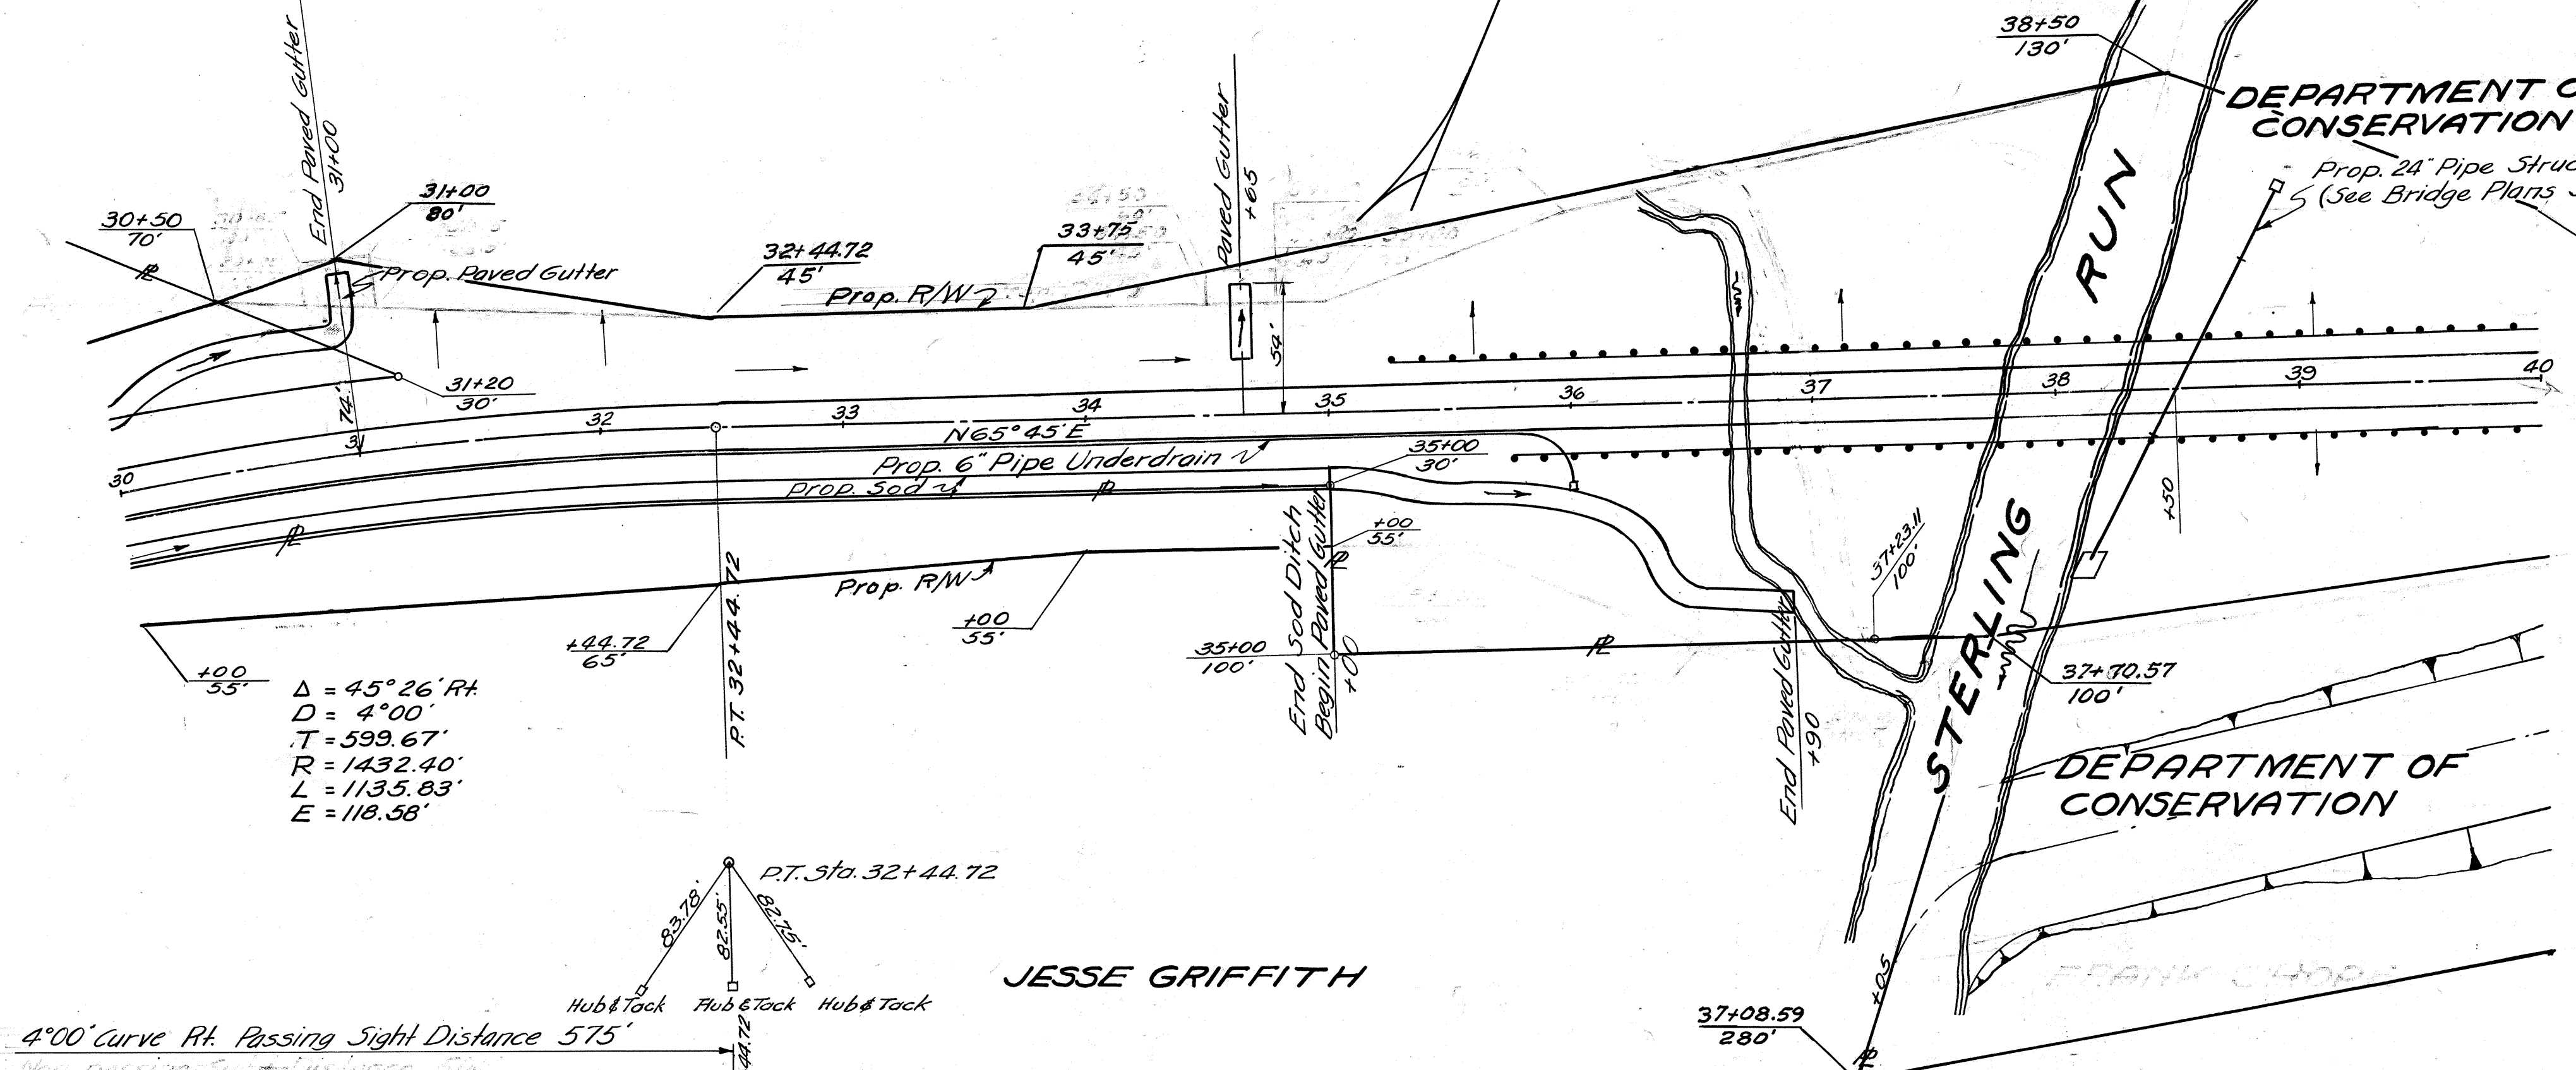


$\Delta = 45^\circ 26' \text{ Rt.}$
 $D = 4^\circ 00'$
 $T = 599.67'$
 $R = 1432.40'$
 $L = 1135.83'$
 $E = 118.58'$

BENCH MARK
Cross on N.E. Corner
N Wing W. Abutment
Bridge over Sterling Run
Elev. 899.42

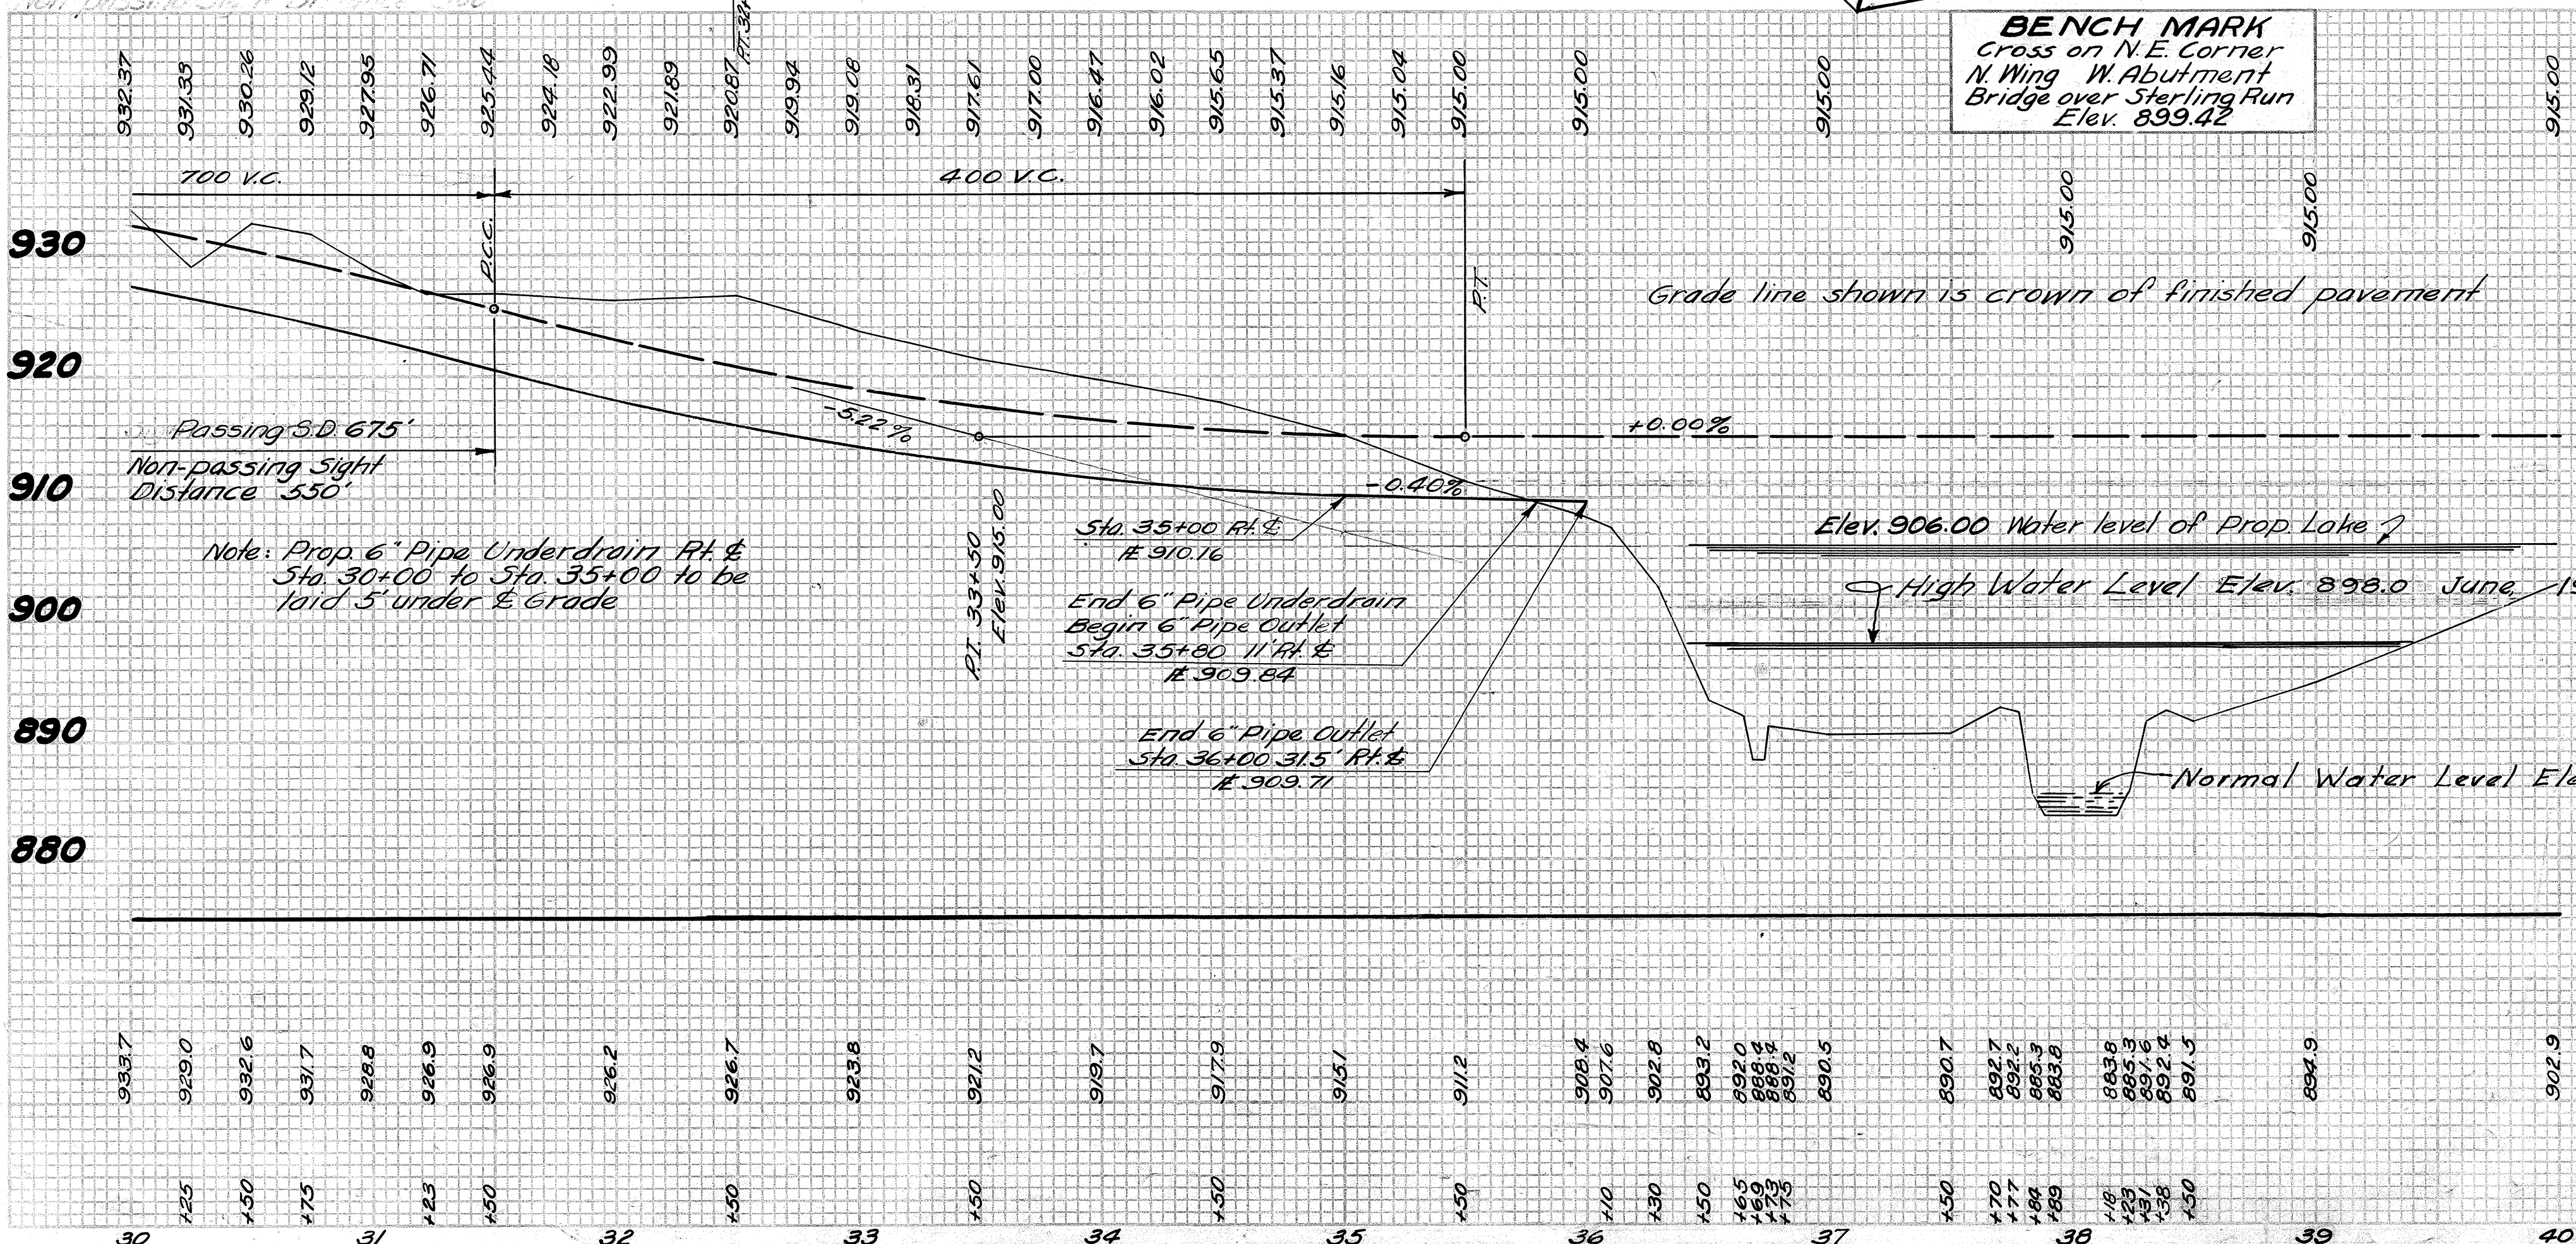

GUARD RAIL			
Station To Station	Side	Guard Rail Steel Beam Type (Deep) Lin. Ft.	Guard Rail Plank Remove & Store (Plank) Item I-15 Lin. Ft.
40+00~40+64	Lt.	64	
40+00~40+64	Rt.	64	
41+36~41+61	Rt.	25	
41+36~41+61	Lt.	25	
44+50~47+52	Lt.		260
Total		178	260

DRIVES AND APPROACHES				
Station	Side	Side Approaches Mailbox Turnouts & Berm Mat'l Item I-17 Cu. Yds.	Pipe for Driveway Item I-1 Lin. Ft.	
43+00	Rt.	4	22	
49+58	Rt.	3	22	
Total		7	22	22

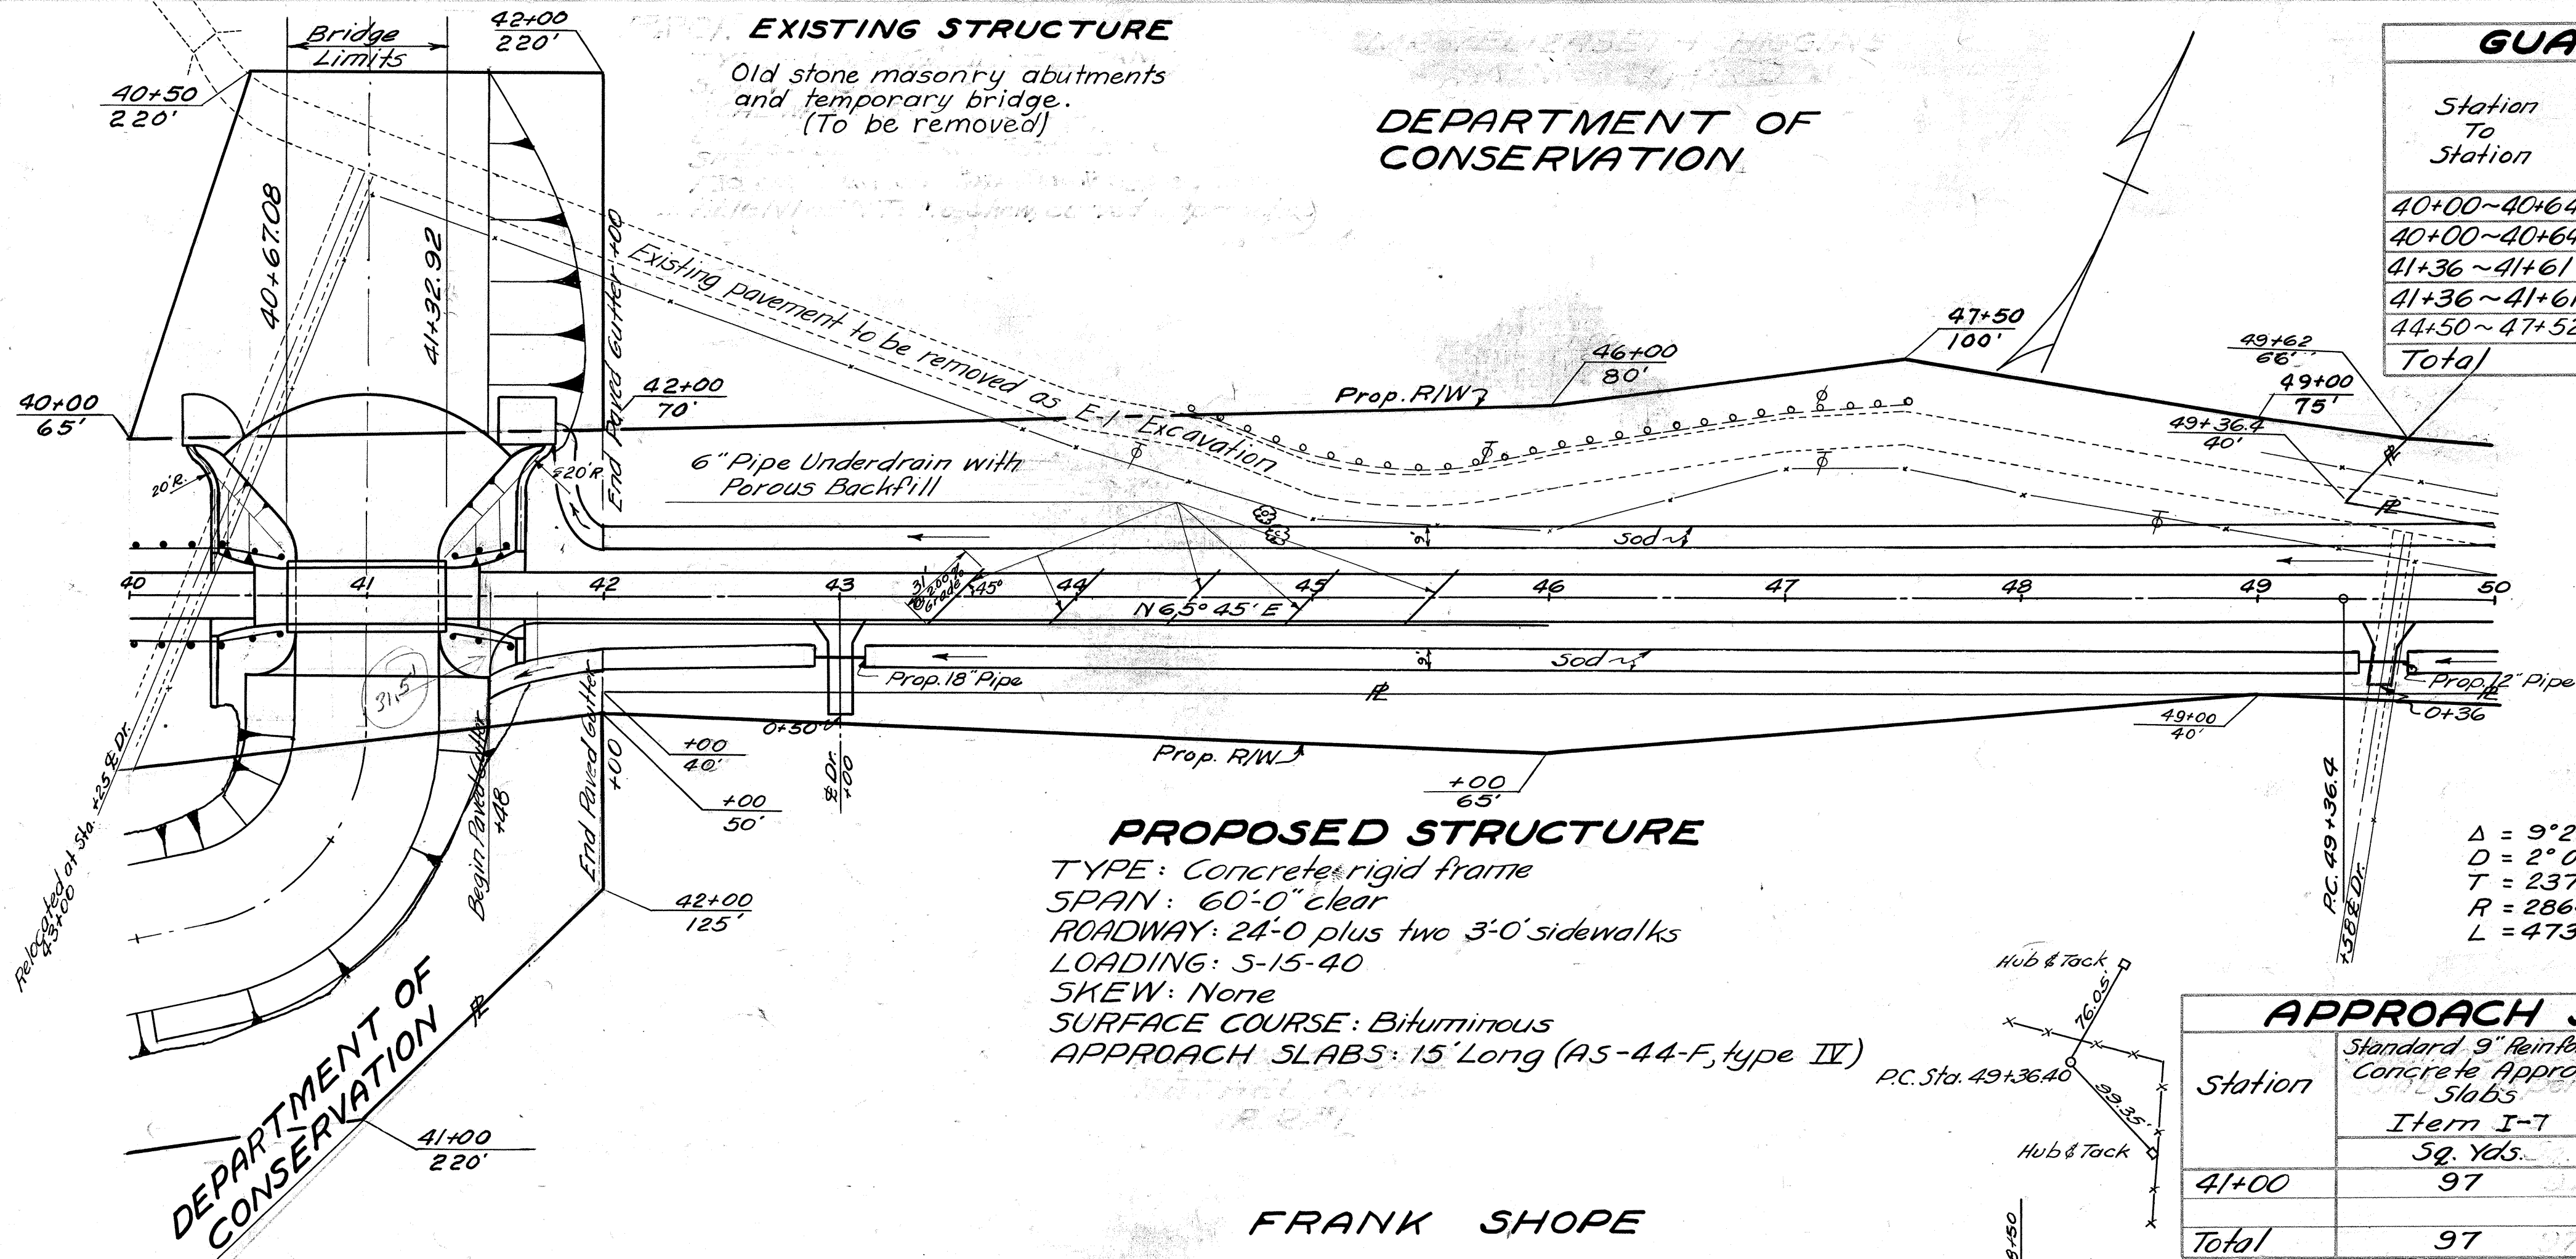


PROPOSED STRUCTURE
 TYPE: Concrete rigid frame
 SPAN: 60'-0" clear
 ROADWAY: 24'-0" plus two 3'-0" sidewalks
 LOADING: 5-15-40
 SKEW: None
 SURFACE COURSE: Bituminous
 APPROACH SLABS: 15' Long (A5-44-F, type II)

APPROACH SLABS			
Station	Standard 9" Reinforced Concrete Slabs Item I-7 Sq. Yds.	Asphaltic Tack Coat Concrete 0.1 gal per Surface Course Sq. Yd. Item T-35 Sq. Yds.	Asphaltic Tack Coat Concrete 0.1 gal per Surface Course Sq. Yd. Item T-30 Sq. Yds.
41+00	97	97	97
Total	97	97	97

$\Delta = 9^{\circ}28' \text{ Rt}$
 $D = 2^{\circ}00'$
 $T = 237.21'$
 $R = 2864.79'$
 $L = 473.33'$

FRANK SHOPE

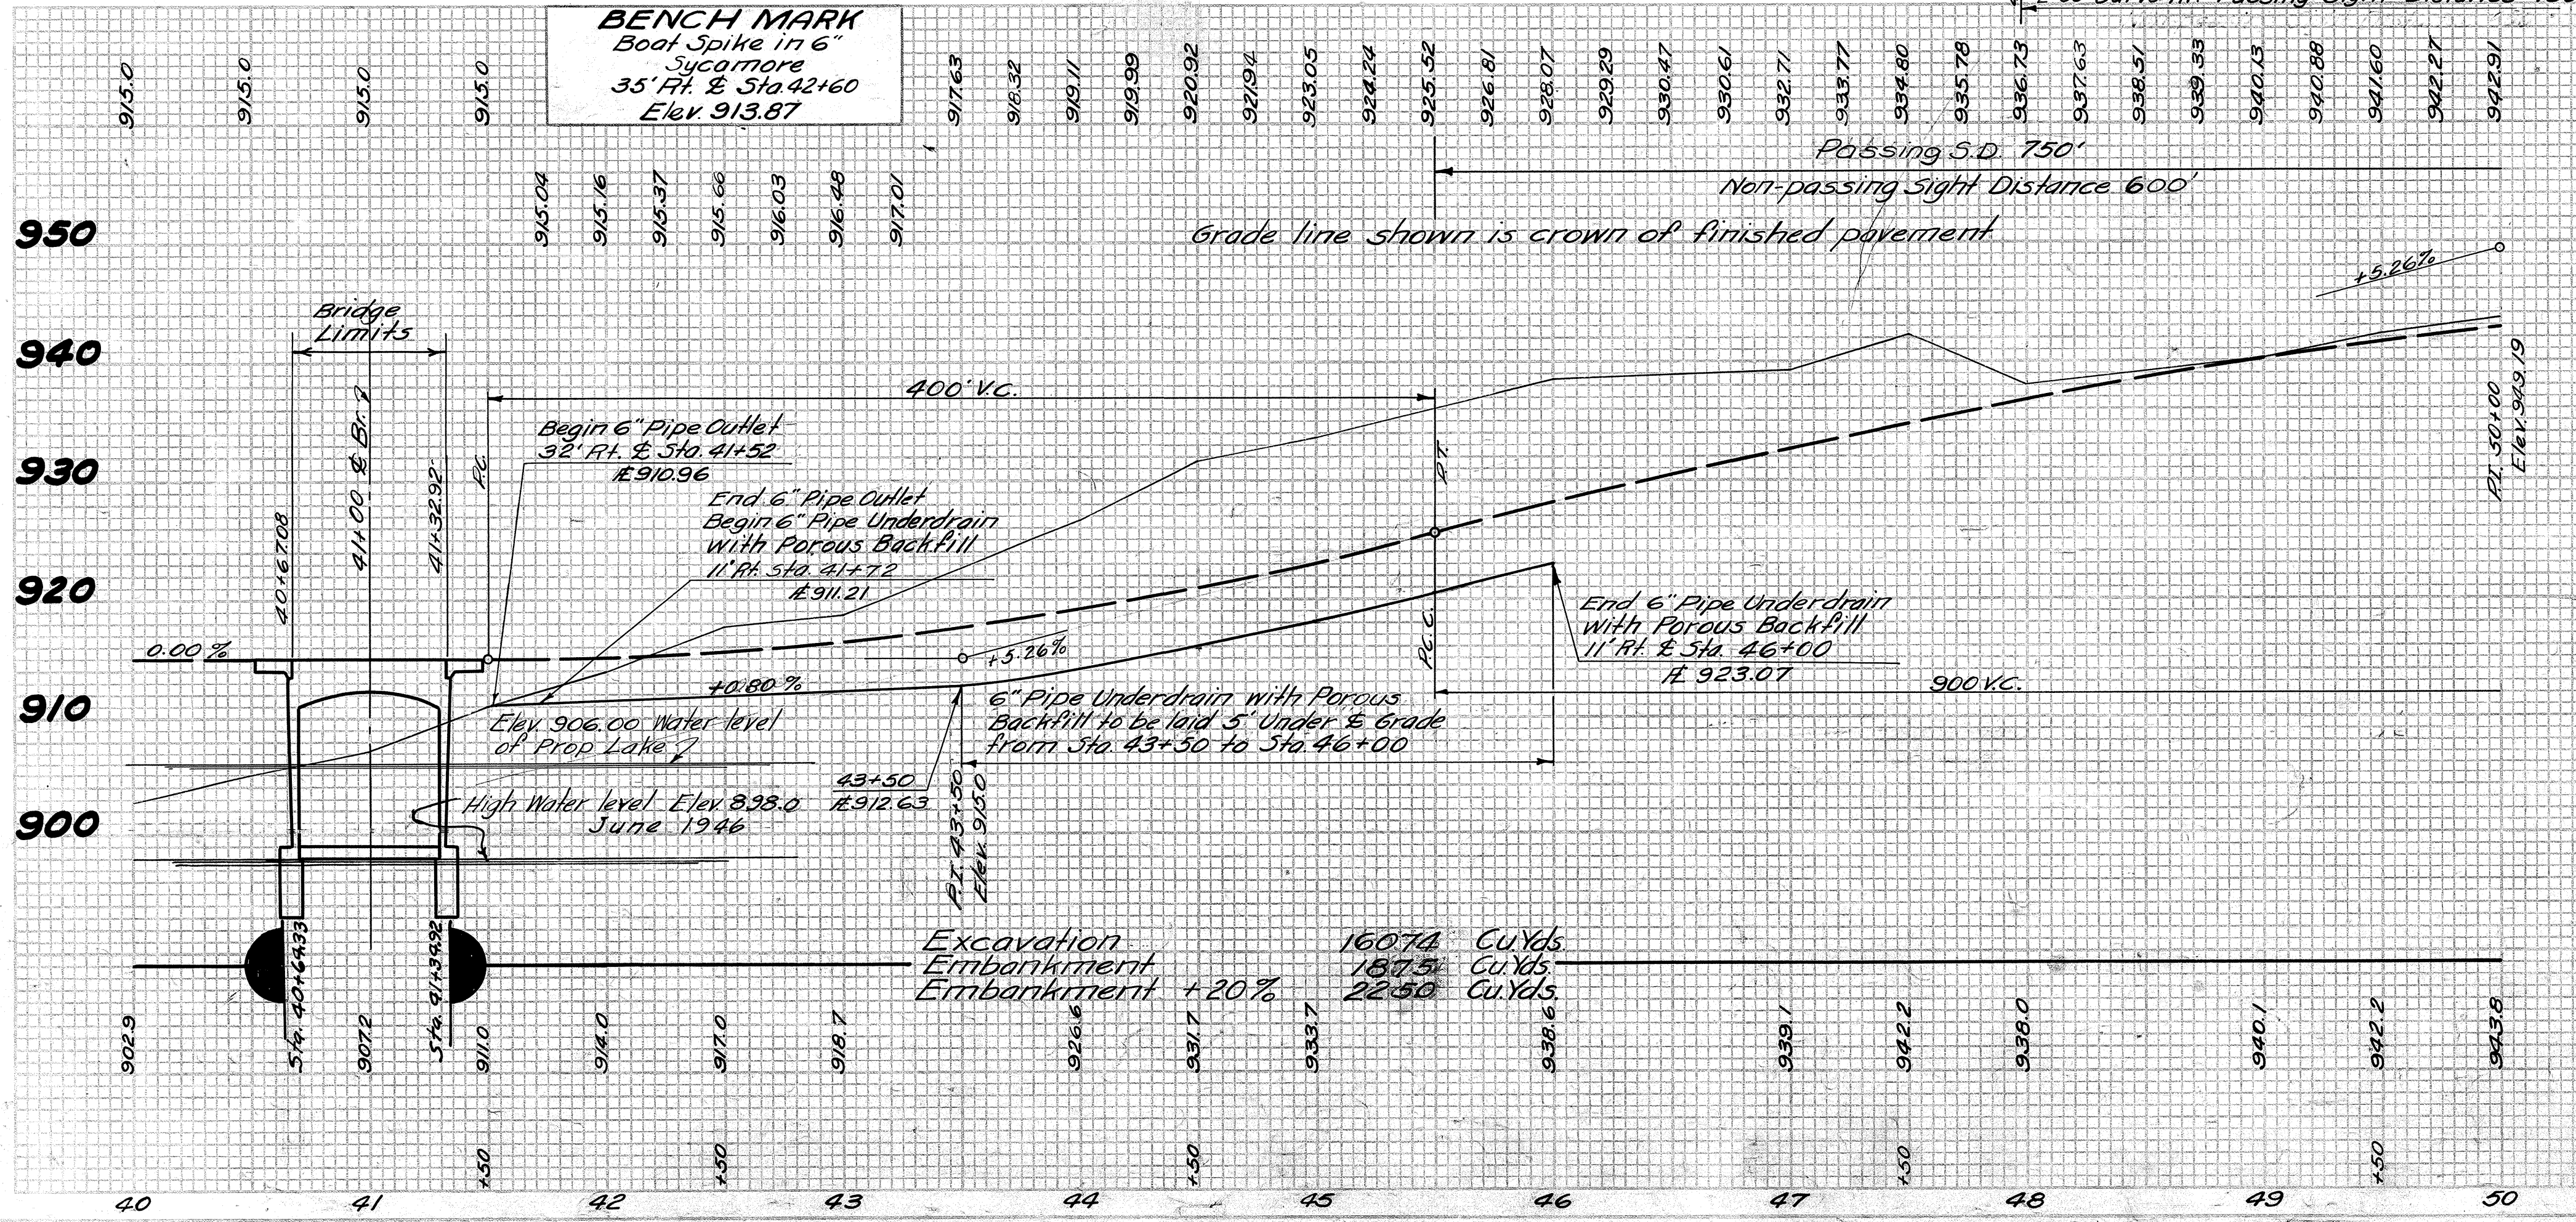

DRAINAGE									
Station To Station	Side	Concrete Approach Gutter Item I-14 Lin. Ft.	Special Concrete Paved Gutter Item I-14 Lin. Ft.	Stone Paved Gutter Item I-14 Lin. Ft.	Sodding Item I-10 Sq. Yds.	6" Pipe Outlet Item I-4 Lin. Ft.	6" Pipe Underdrain Item I-4 Lin. Ft.	Pipe Special (6x6) Wye's Item I-5 Each	See Sheet No
40+34.08~40+52.08	Rt.	18							31
40+34.08~40+52.08	Lt.	18							31
41+47.92~41+65.92	Rt.	18							31
41+47.92~41+65.92	Lt.	18							31
40+35.58	Rt.		30						4
40+35.58	Lt.		48						4
41+64.42	Rt.		10						4
41+64.42	Lt.		48						4
41+48~42+00	Rt.			52					3
41+75~42+00	Lt.			54					3
42+00~42+92	Rt.				92				
43+08~49+46	Rt.				638				
49+62~50+00	Rt.				38				
42+00~50+00	Lt.				800				
41+52~41+72	Rt.					32			
41+72~46+00	Rt.						428		
43+50~45+50	Lt.						155		
43+50~45+50	Rt.							5	
Total		72	136	106	1568	32	583	155	5

EROSION CONTROL				
Station To Station	Side	salix mutabilis (Dwarf Willows) Item L-13 Each	Seeding Item L-9 Sq. Yds.	See Street No
40+00~40+24	Lt.	5		
40+00~40+68.5	Rt.		396	26
41+31.5~50+00	Rt.		9527	27
41+68.5 Channel	Lt.	24		
41+00 Channel	Rt.		2051	40
Total		29	11974	

Excavation	160.74 Cu. Yds.
Embankment	180.5 Cu. Yds.
Embankment	22.50 Cu. Yds.

MRS. ELIZABETH HIGGINS

W.H. FOX


FED. RD. DIVISION	STATE	PROJECT	FISCAL YEAR	13 4.4
2	OHIO	S-135 (1)	1947	

BROWN COUNTY
S.H. 951 SEC. E (PT.)


DRIVES AND APPROACHES				
Station	Side	Side Approaches Mailbox Turnouts & Berms Item I-17 Cu. Yds.	12" Pipe for Driveways Item I-1 Linn. Ft.	Sodding Item L-10 Sq. Yds.
51+35	Rt.	6	22	5
52+57 Dr. MB.	Lt.	8		15
58+72	Rt.	4	22	10
59+43	Rt.	4	22	10
58+72 MB.	Lt.	3		
Total		25	66	25

EROSION CONTROL		
Station To Station	Seeding Item L-9 Sq. Yds.	See Sheet No
50+00 ~ 60+00	7702	28
Total	7702	

DRAINAGE		
Station To Station	Sodding Item L-10 Sq. Yds.	
50+00 ~ 51+27	127	
Total	127	

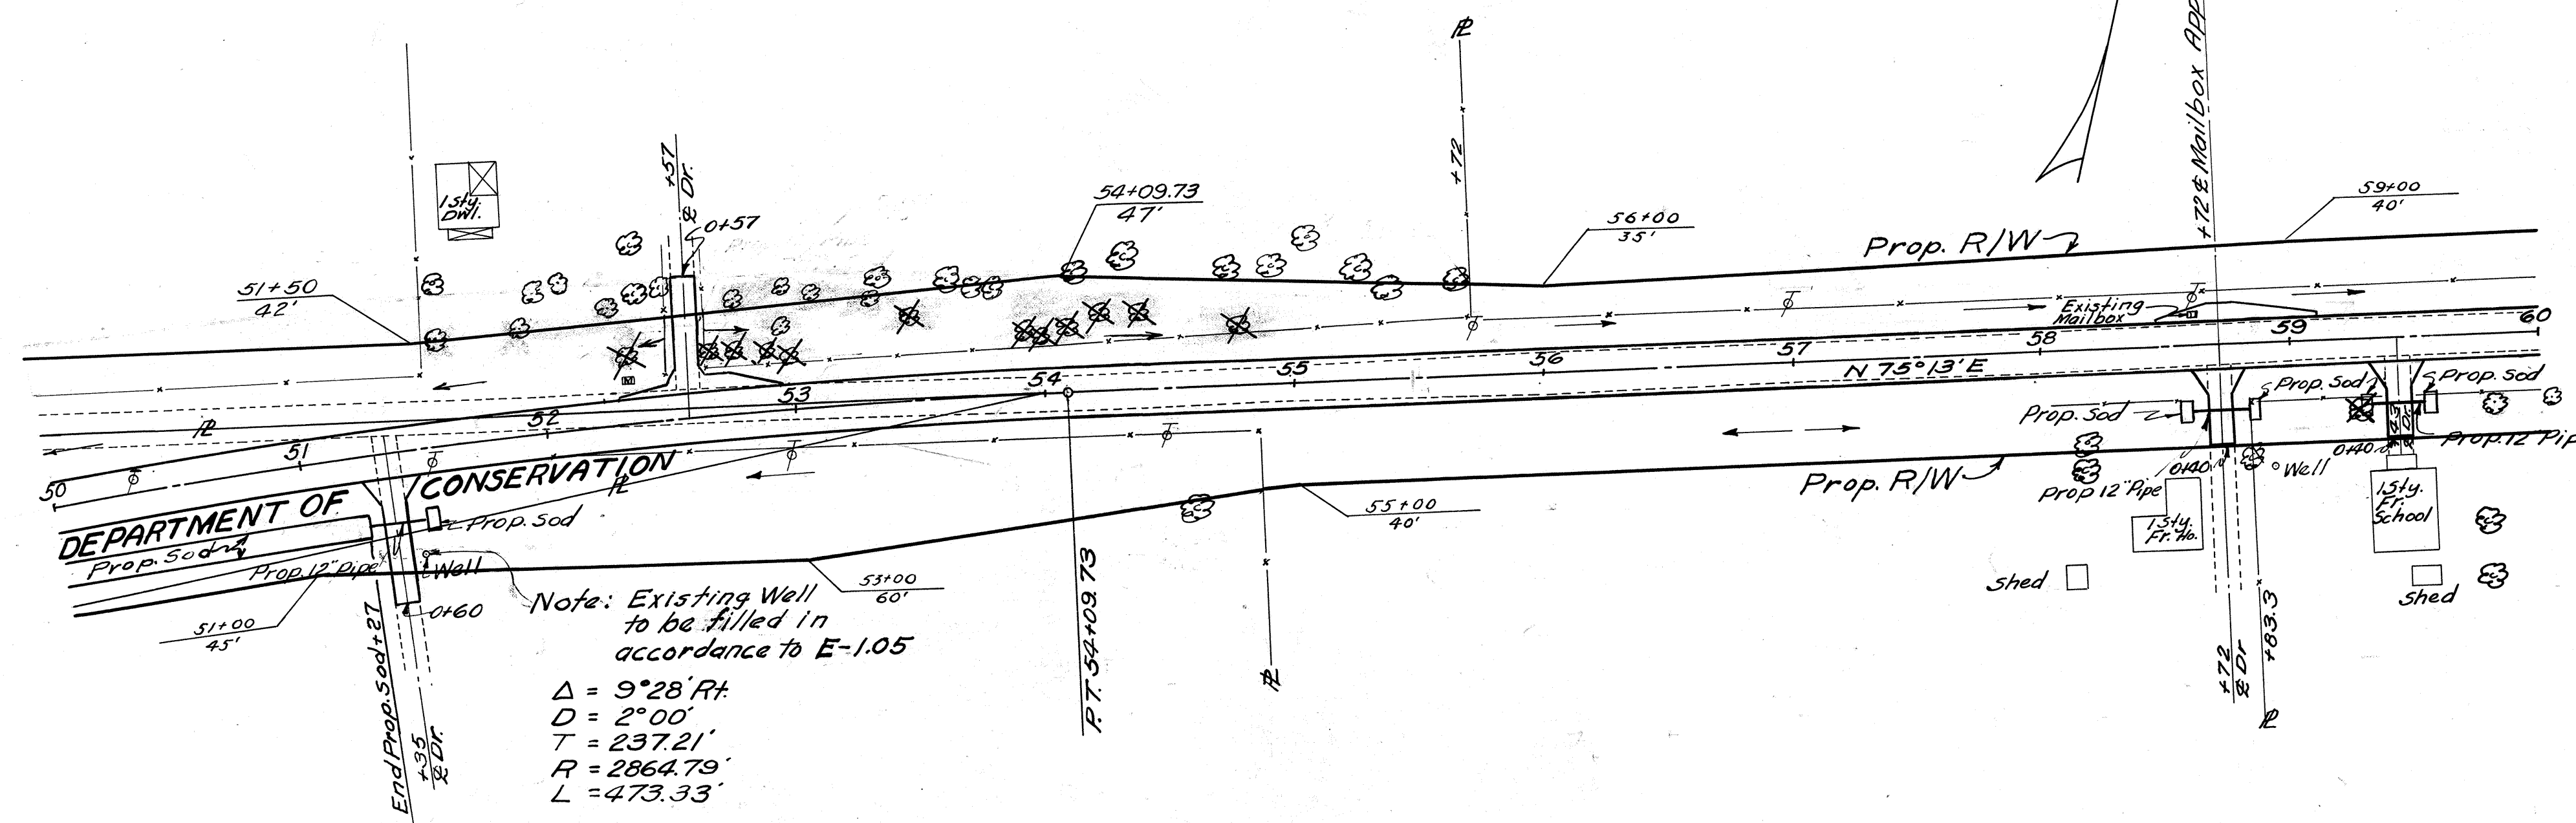

Note: Existing Well to be filled in accordance to E-1.05
 $\Delta = 9^{\circ}28' \text{ Rt.}$
 $D = 2^{\circ}00'$
 $T = 237.21'$
 $R = 2864.79'$
 $L = 473.33'$

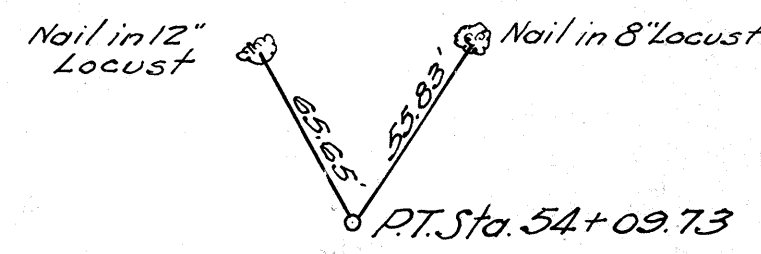


FRANK SHOPE


LAWRENCE WATERS

FRANK SHOPE

2°00' Curve Rt. Passing Sight Distance 750'

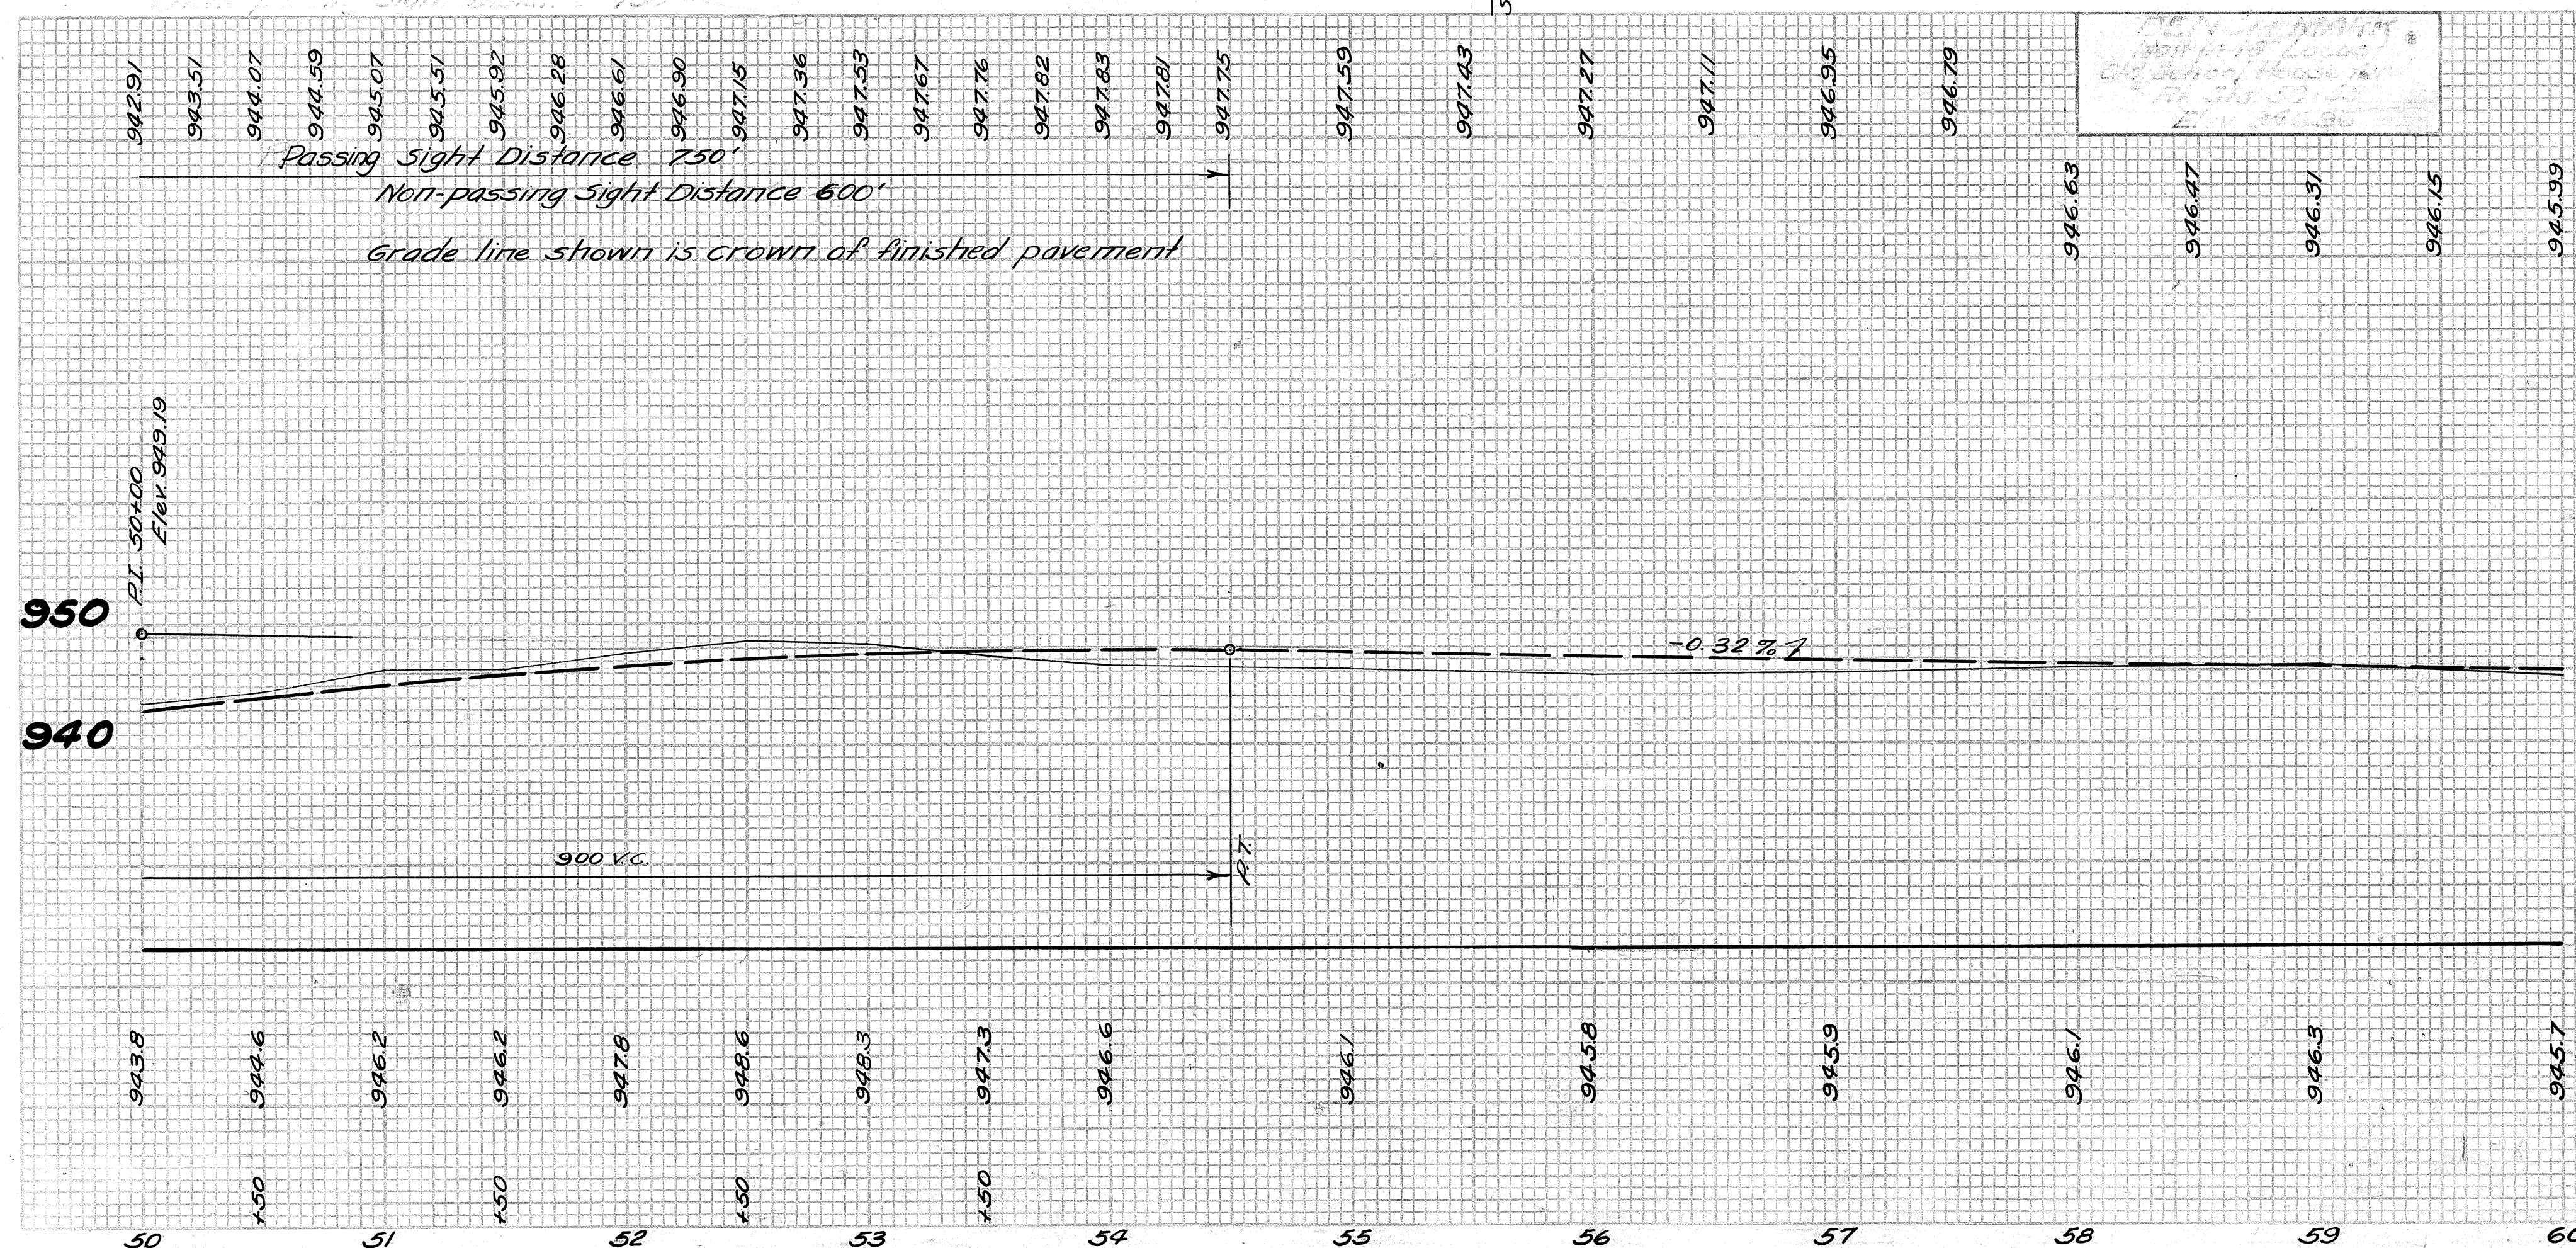


STA. 50+00 TO STA. 60+00

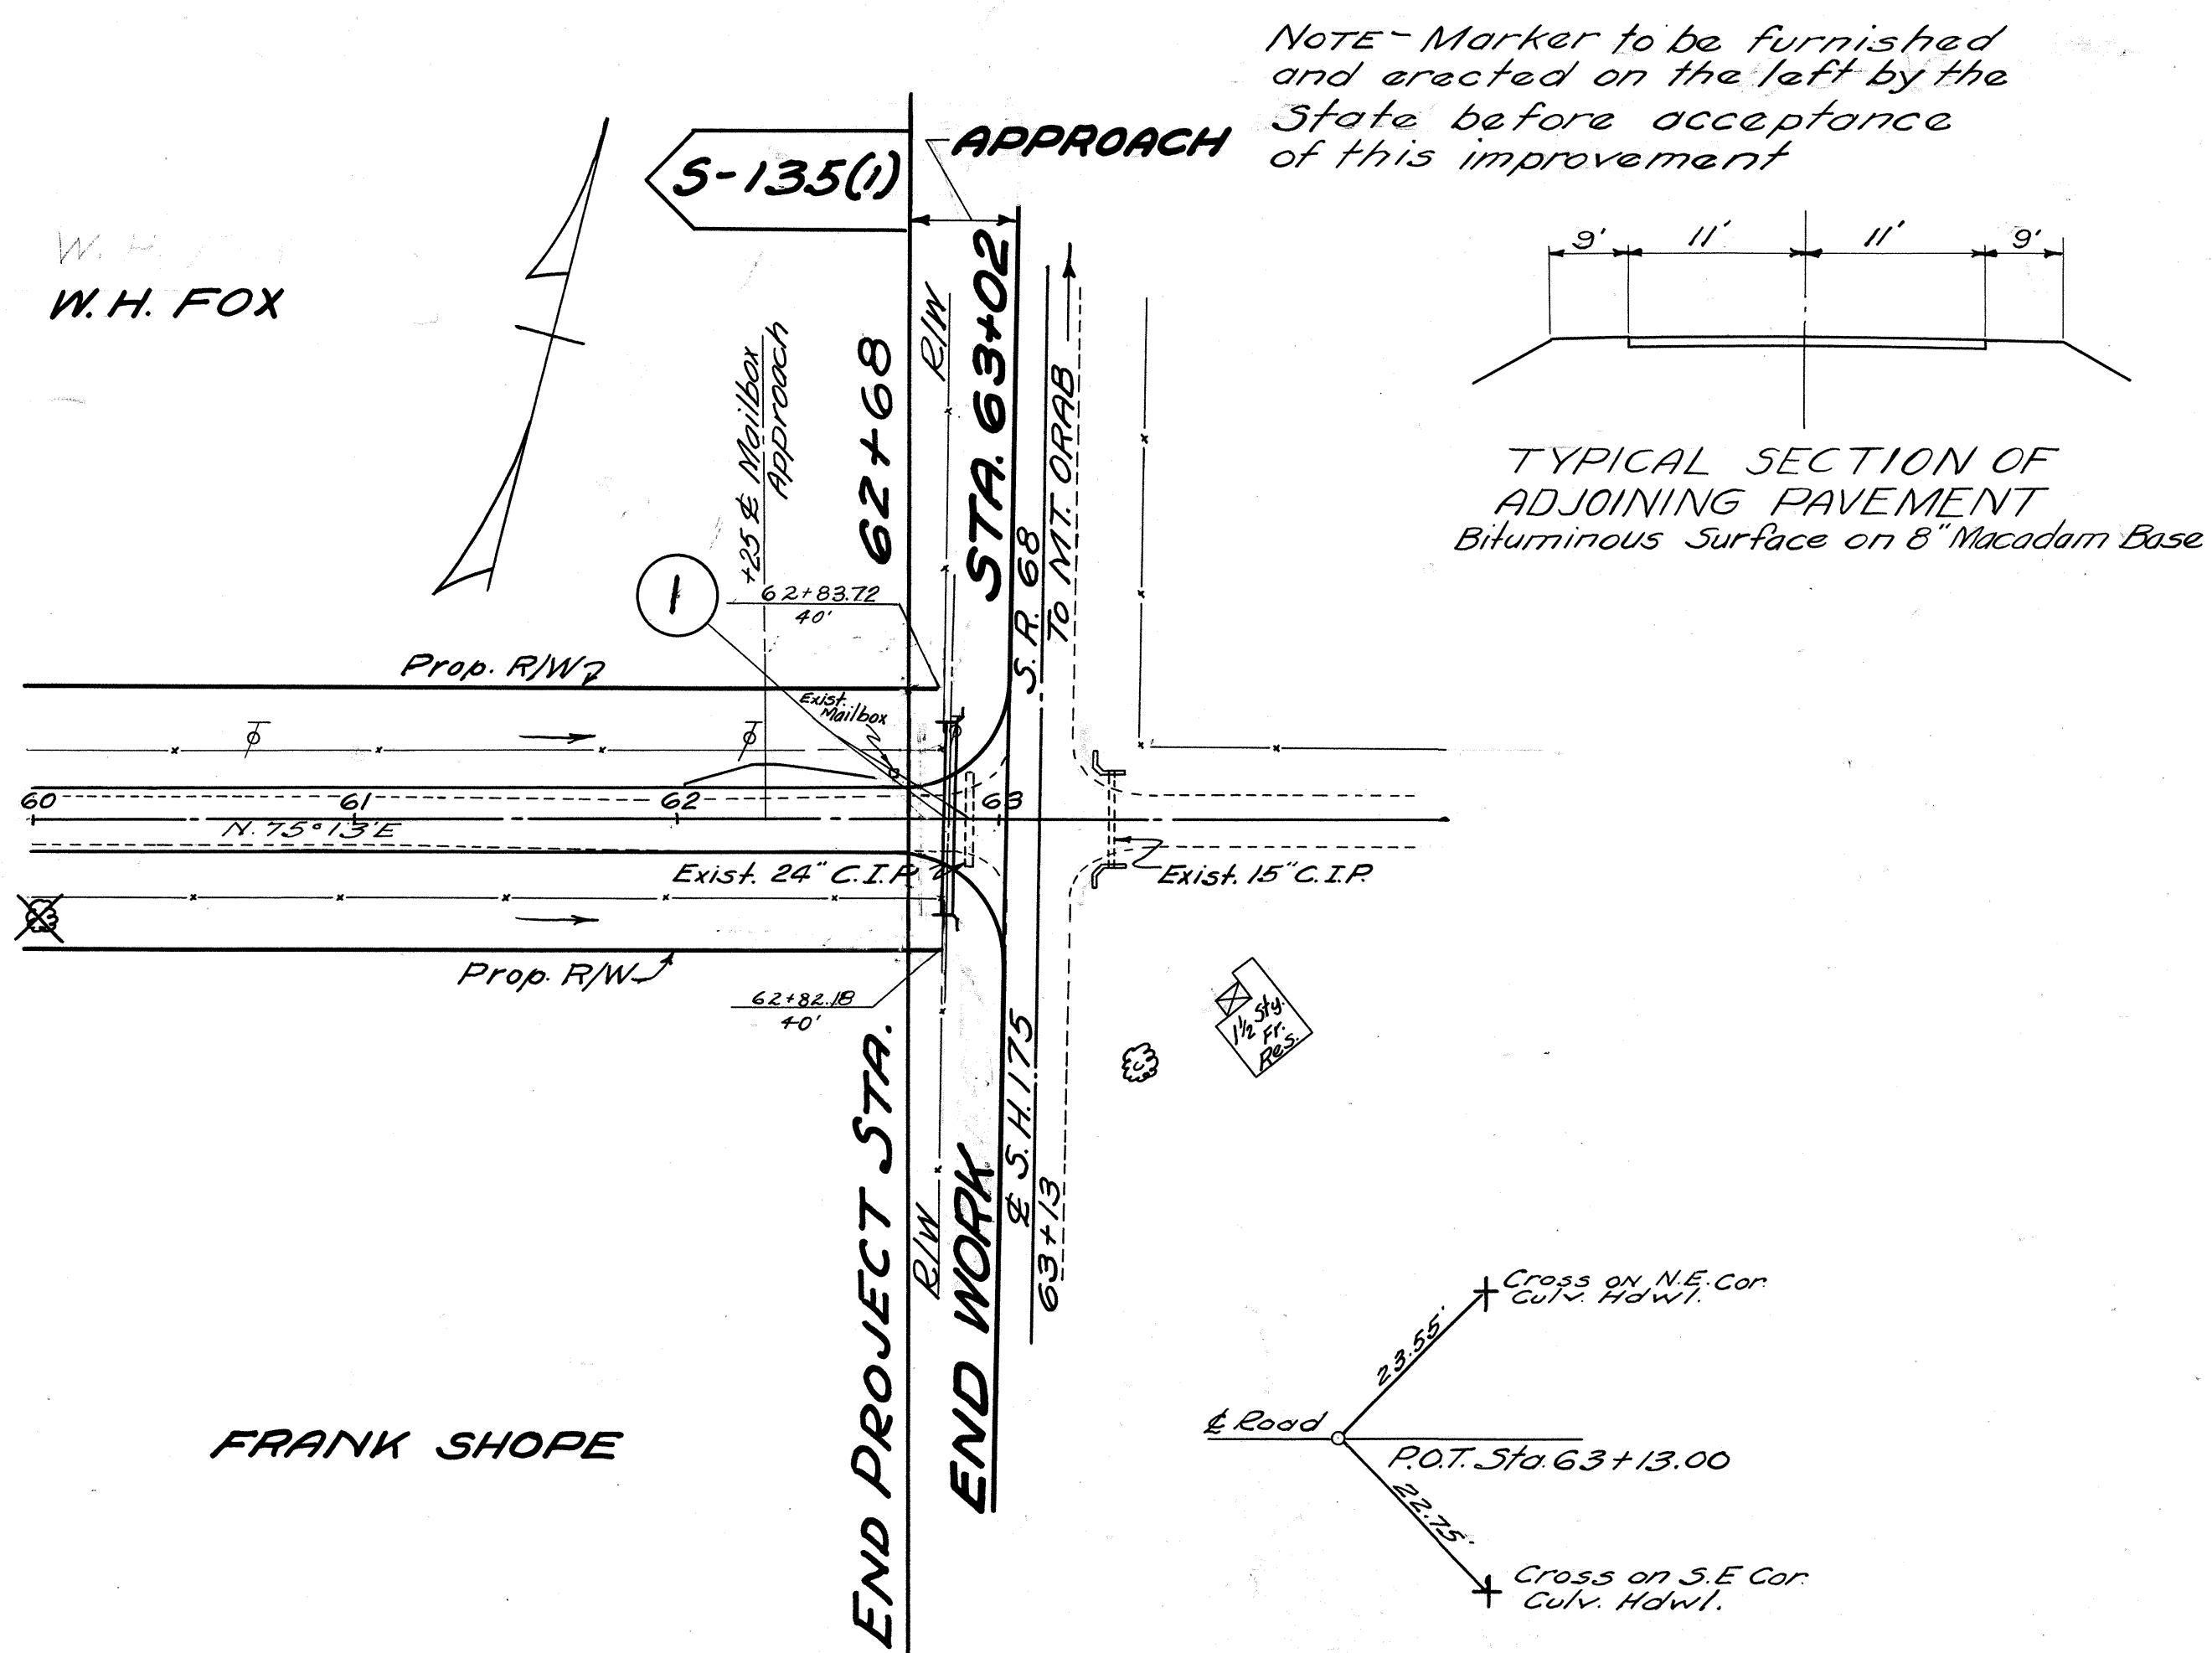

Station To Station	DRIVES AND APPROACHES				See Sheet No
	Bituminous Road Mix Surface Course Item T-32	Bituminous Prime Coat Item T-30	8' Classified Embankment Item SS-112	Side Approaches Mailbox Turnouts & Berm Material Item I-17	
	Sq. Yds.	Sq. Yds.	Sq. Yds.	Cu. Yds.	
62+68~63+02	127	133	133		30
62+25 M.B. Lt.				3	
Total	127	133	133	3	

No	STATION	EXISTING STRUCTURE			PROPOSED STRUCTURE			See Sheet No
		Type	Size	Length	Type	Size	Length	
1	62+84.5	Pipe	24"	30'-0"	Twin Pipe	18"	60'-0"	31

Station To Station	EROSION CONTROL	
	Seeding Item E-29	See Sheet No
	Sq. Yds.	
60+00~62+68	1783	29
62+68~63+02	250	29
Total	2033	

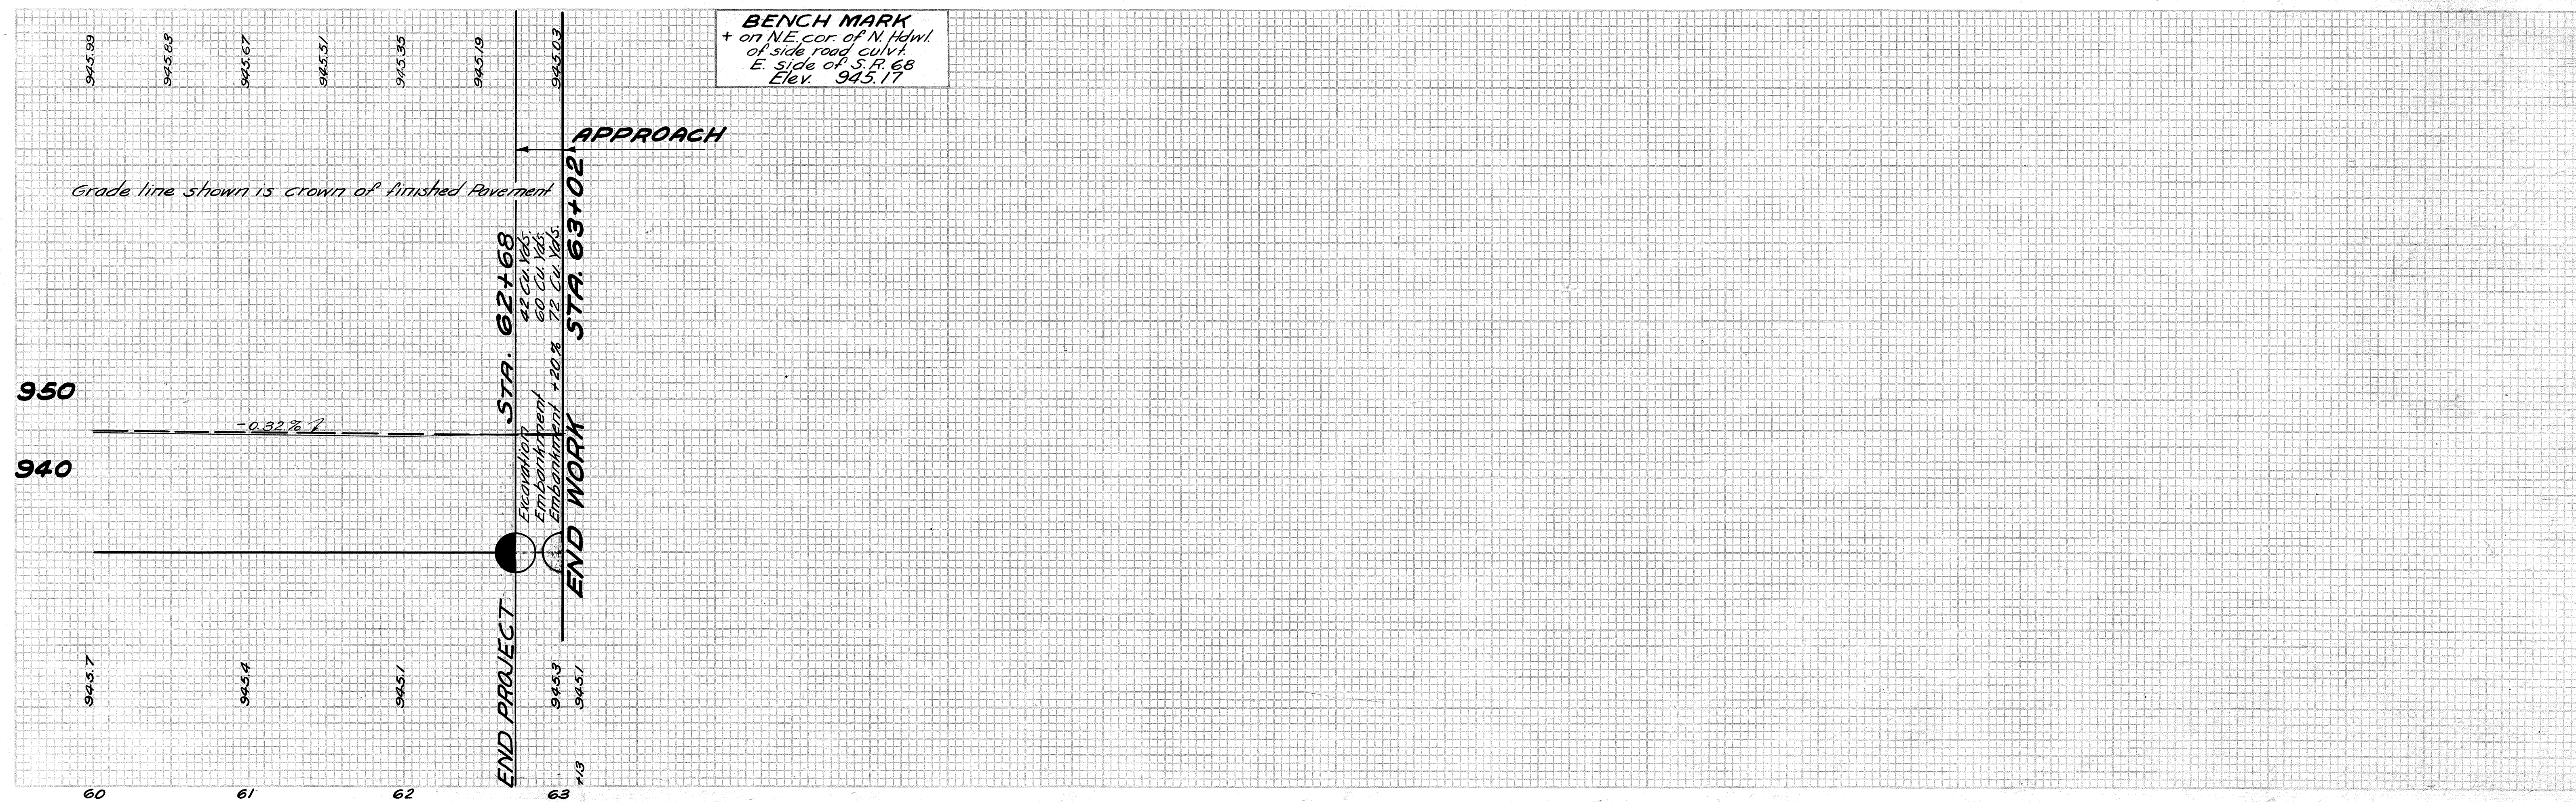

CURVE TABLE


FED. RD. DIVISION	STATE	PROJECT	FISCAL YEAR
2	OHIO	S-135 (1)	1947

15
44

BROWN COUNTY
S. H. 951 SEC. E (PT.)


CURVE DATA								
P.C. 21+08.89			P.T. 32+44.72					
Left			Dc = 4°00' Rl.			Right		
Profile	Elev.	Width	Elev.	Station	Width	Elev.	Station	Width
Grade	Lt. Edge		Rt. Edge			Rt. Edge		
937.67	937.51	10'	937.67	20+00	10'	937.50		
938.49	938.66		938.61	+25		938.44		
939.19	939.49		939.30	+50		939.10		
939.79	940.20		939.39	+75		939.64		
940.31	940.82		939.48	21+00		940.14		
940.73	941.39		940.97	+25		940.56		
941.06	941.93		941.40	+50		940.40		
941.29	942.37		941.74	+75		941.12		
941.43	942.71		941.98	22+00		941.26		
941.52	942.96		942.15	+25		941.35		
941.62	943.11		942.28	+50		941.45		
941.71	943.20		942.37	+75		941.54		
941.81	943.30		942.47	23+00		941.64		
941.90	943.39		942.56	+25		941.73		
942.00	943.49		942.66	+50		941.83		
942.09	943.58		942.75	+75		941.92		
942.19	943.68		942.85	24+00		942.02		
942.28	943.77		942.94	+25		942.11		
942.38	943.87		943.04	+50		942.21		
942.44	943.93		943.10	+75		942.27		
942.47	943.96		943.13	25+00		942.30		
942.43	943.92		943.09	+25		942.26		
942.36	943.85		943.02	+50		942.19		
942.22	943.71		942.88	+75		942.05		
942.05	943.54		942.71	26+00		941.88		
941.81	943.30		942.47	+25		941.64		
941.54	943.03		942.20	+50		941.37		
941.20	942.69		941.86	+75		941.03		
940.83	942.32		941.49	27+00		940.66		
940.39	941.88		941.05	+25		940.22		
939.92	941.41		940.58	+50		939.75		
939.38	940.87		940.04	+75		939.21		
938.81	940.30		939.47	28+00		938.64		
938.17	939.66		938.83	+25		938.00		
937.50	938.99		938.16	+50		937.33		
936.76	938.25		937.42	+75		936.59		
935.99	937.48		936.65	29+00		935.82		
935.15	936.64		935.81	+25		934.98		
934.28	935.77		934.94	+50		934.11		
933.34	934.83		934.00	+75		933.17		
932.37	933.86		933.03	30+00		932.20		
931.33	932.82		931.99	+25		931.16		
930.26	931.75		930.92	+50		930.09		
929.12	930.61		929.78	+75		928.95		
927.95	929.44		928.61	31+00		927.78		
926.71	928.20		927.37	+25		926.54		
925.44	926.93		926.10	+50		925.27		
924.18	925.65		924.83	+75		924.01		
922.99	924.41		923.61	32+00		922.82		
921.89	923.22		922.47	+25		921.72		
920.88	922.06		921.38	+50		920.71		
919.94	920.98		920.37	+75		919.77		
919.08	919.97		919.44	33+00		918.91		
918.31	919.08		918.61	+25		918.14		
917.62	918.22		917.83	+50		917.45		
917.01	917.44		917.14	+75		916.84		
916.47	916.78		916.54	34+00		916.30		
916.02	916.28		916.07	+25		915.85		
915.66	915.87		915.68	+50		915.49		
915.37	915.52		915.37	+75		915.20		
915.16	915.24		915.16	35+00		914.99		
915.04	915.04		915.04	+25		914.87		
915.00	914.91		915.00	+50		914.83		
915.00	914.83	10'	915.00	+75	10'	914.83		

CURVE DATA						
P.C. 49+36.4			P.T. 54+09.73			
Left			Right			
Profile	Elev.	Width	Elev.	Station	Width	
Grade	Lt. Edge		Rt. Edge			
935.71	935.54	10'	935.71	47+71.40	10'	935.54
935.78	935.61		935.78	+75		935.61
936.73	936.58		936.73	48+00		936.58
937.63	937.52		937.63	+25		937.46
938.51	938.47		938.51	+50		938.34
939.33	939.39		939.33	+75		939.16
940.13	940.32		940.13	49+00		939.96
940.88	941.19		940.95	+25		940.71
941.60	942.00		941.71	+50		941.43
942.27	942.73		942.41	+75		942.10
942.91	943.41		943.12	50+00		942.74
943.51	944.02		943.68	+25		943.34
944.07	944.58		944.24	+50		943.90
944.59	945.10		944.76	+75		944.42
945.07	945.58		945.24	51+00		944.90
945.50	946.02		945.68	+25		945.34
945.92	946.43		946.09	+50		945.75
946.28	946.79		946.45	+75		946.11
946.61	947.12		946.78	52+00		946.44
946.90	947.41		947.07	+25		946.73
947.15	947.66		947.32	+50		946.98
947.36	947.87		947.53	+75		947.19
947.53	948.04		947.70	53+00		947.36
947.67	948.18		947.84	+25		947.50
947.76	948.26		947.92	+50		947.59
947.82	948.27		947.96	+75		947.65
947.83	948.22		947.94	54+00		947.66
947.81	948.17		947.91	+25		947.64
947.75	948.02		947.80	+50		947.58
947.67	947.85		947.68	+75		947.50
947.59	947.68		947.59	55+00		947.42
947.51	947.52		947.51	+25		947.34
947.43	947.36		947.43	+50		947.26
947.35	947.24		947.35	+75		947.19
947.27	947.10	10'	947.27	56+00	10'	947.10

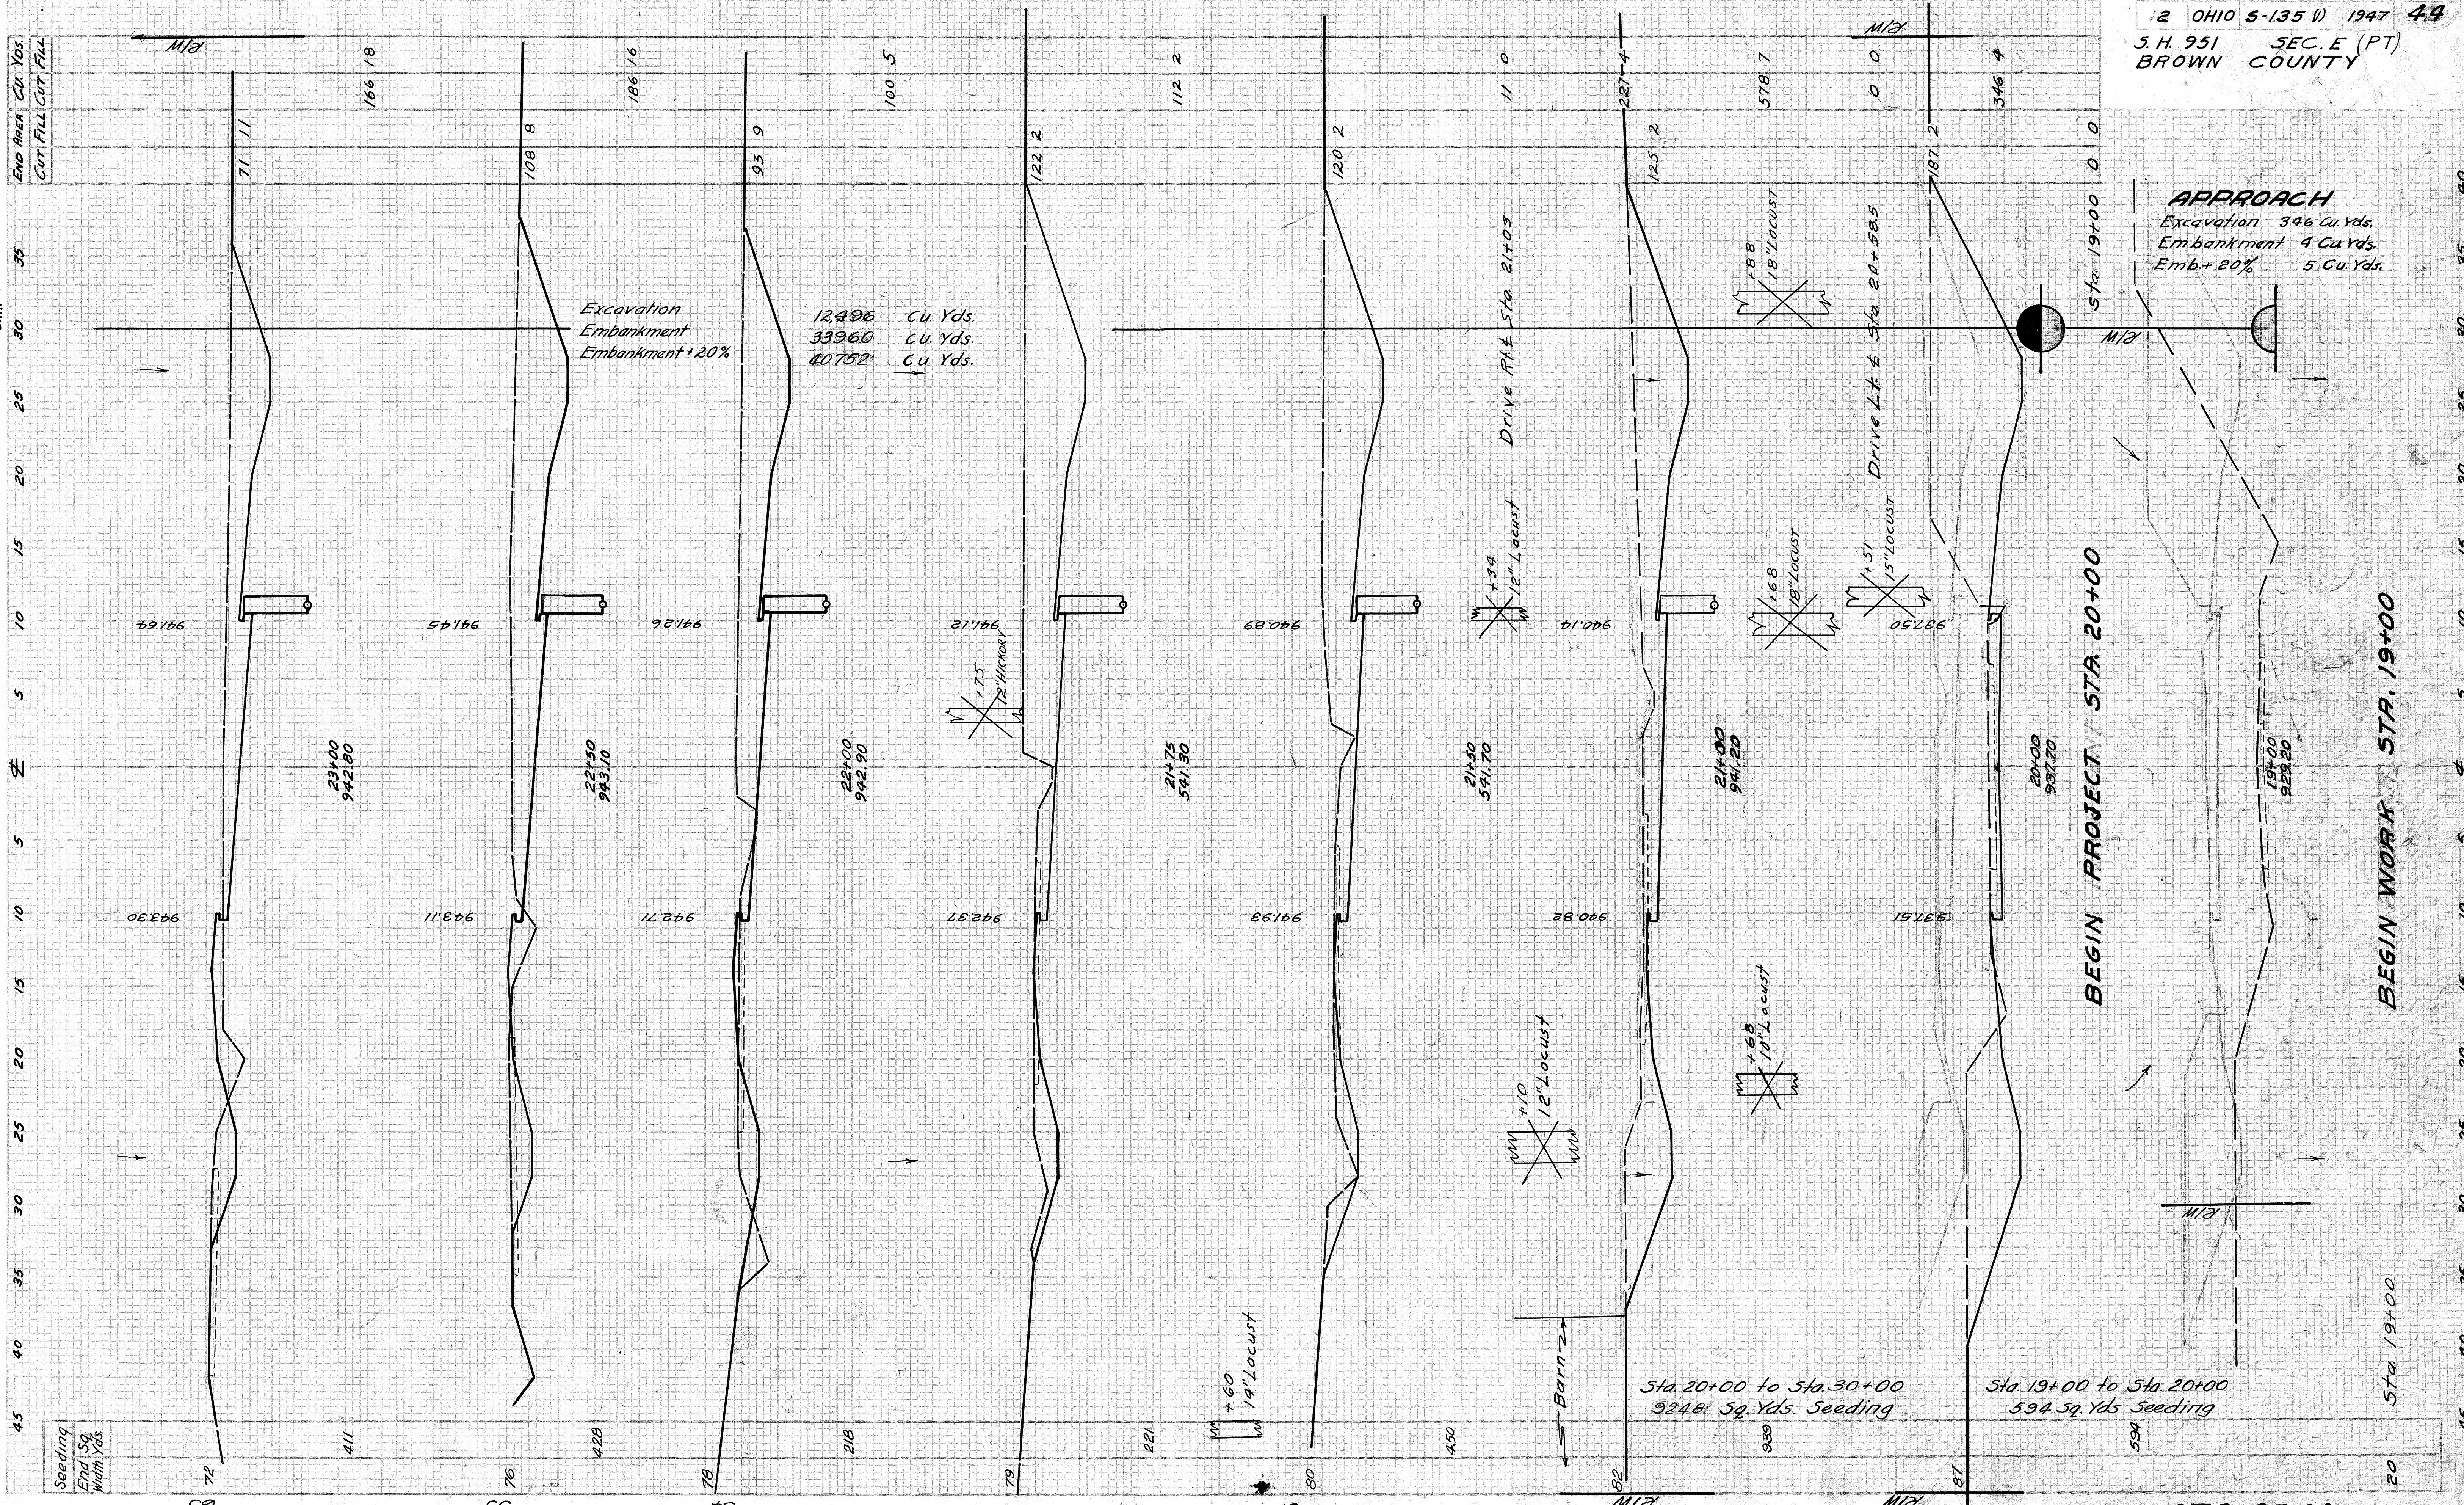

Plot. E.C.S.
 Chk. B.H.
 Temp. R.C.B.
 Chk. B.H.
 Areas B.H.
 Chk. B.H.
 Yds. B.H.
 Chk. B.H.

Seeding	End Sq. Width Yds.	End Area Cu. Yds.	CUT FILL CUT FILL
72	99330	71	11
411	23400 94280	166	18
76	94311	108	8
428	22450 94310	186	16
78	94271	93	9
218	22400 94290	100	5
79	94237	122	2
221	21475 54130	112	2
80	94193	120	2
450	21450 54170	11	0
82	94082	125	2
333	21400 94120	287	4
87	93751	187	2
590	20400 93770	0	0
20	18400 92220	346	4
		0	0

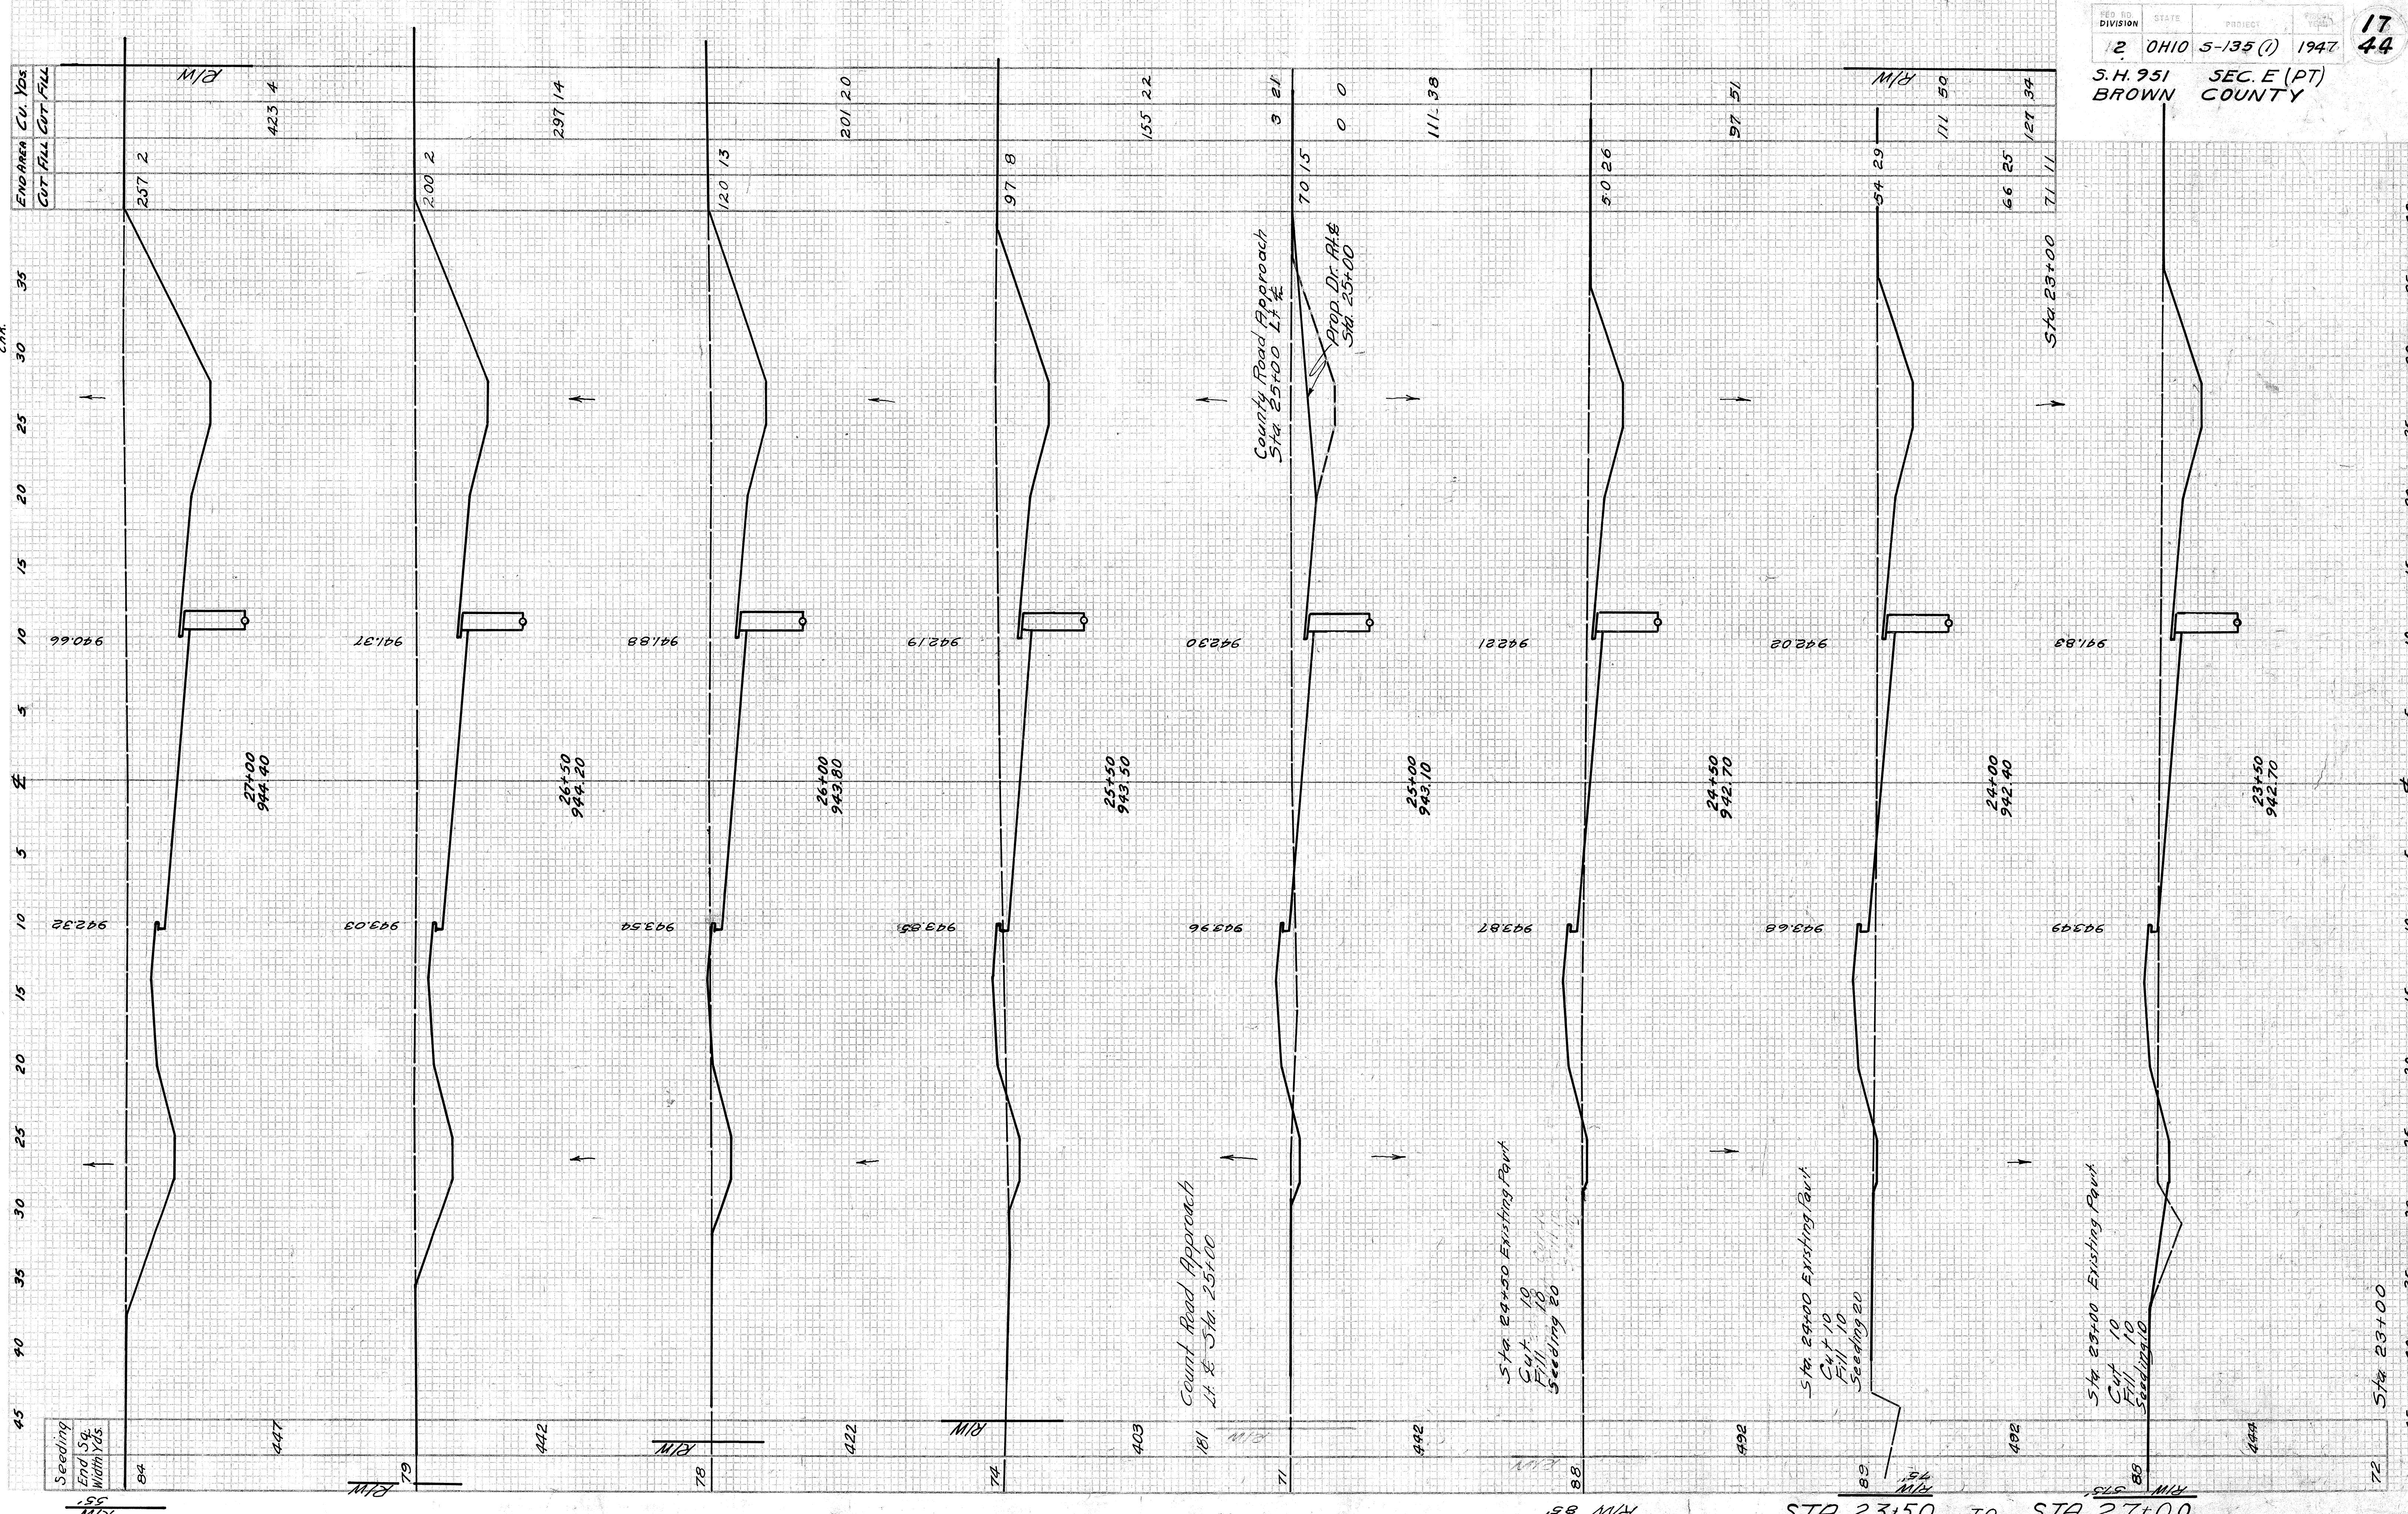


Plot
Chk
Temp
Chk
Areas
Chk
Ydg.
Chk.

B. K.
B. K.
B. K.
B. K.

Seeding	End Sq. Width Yds.	84	447	79	442	78	422	74	403	181	71	492	88	492	89	492	88	492	72
---------	--------------------	----	-----	----	-----	----	-----	----	-----	-----	----	-----	----	-----	----	-----	----	-----	----


STA 23+50 to STA 27+00

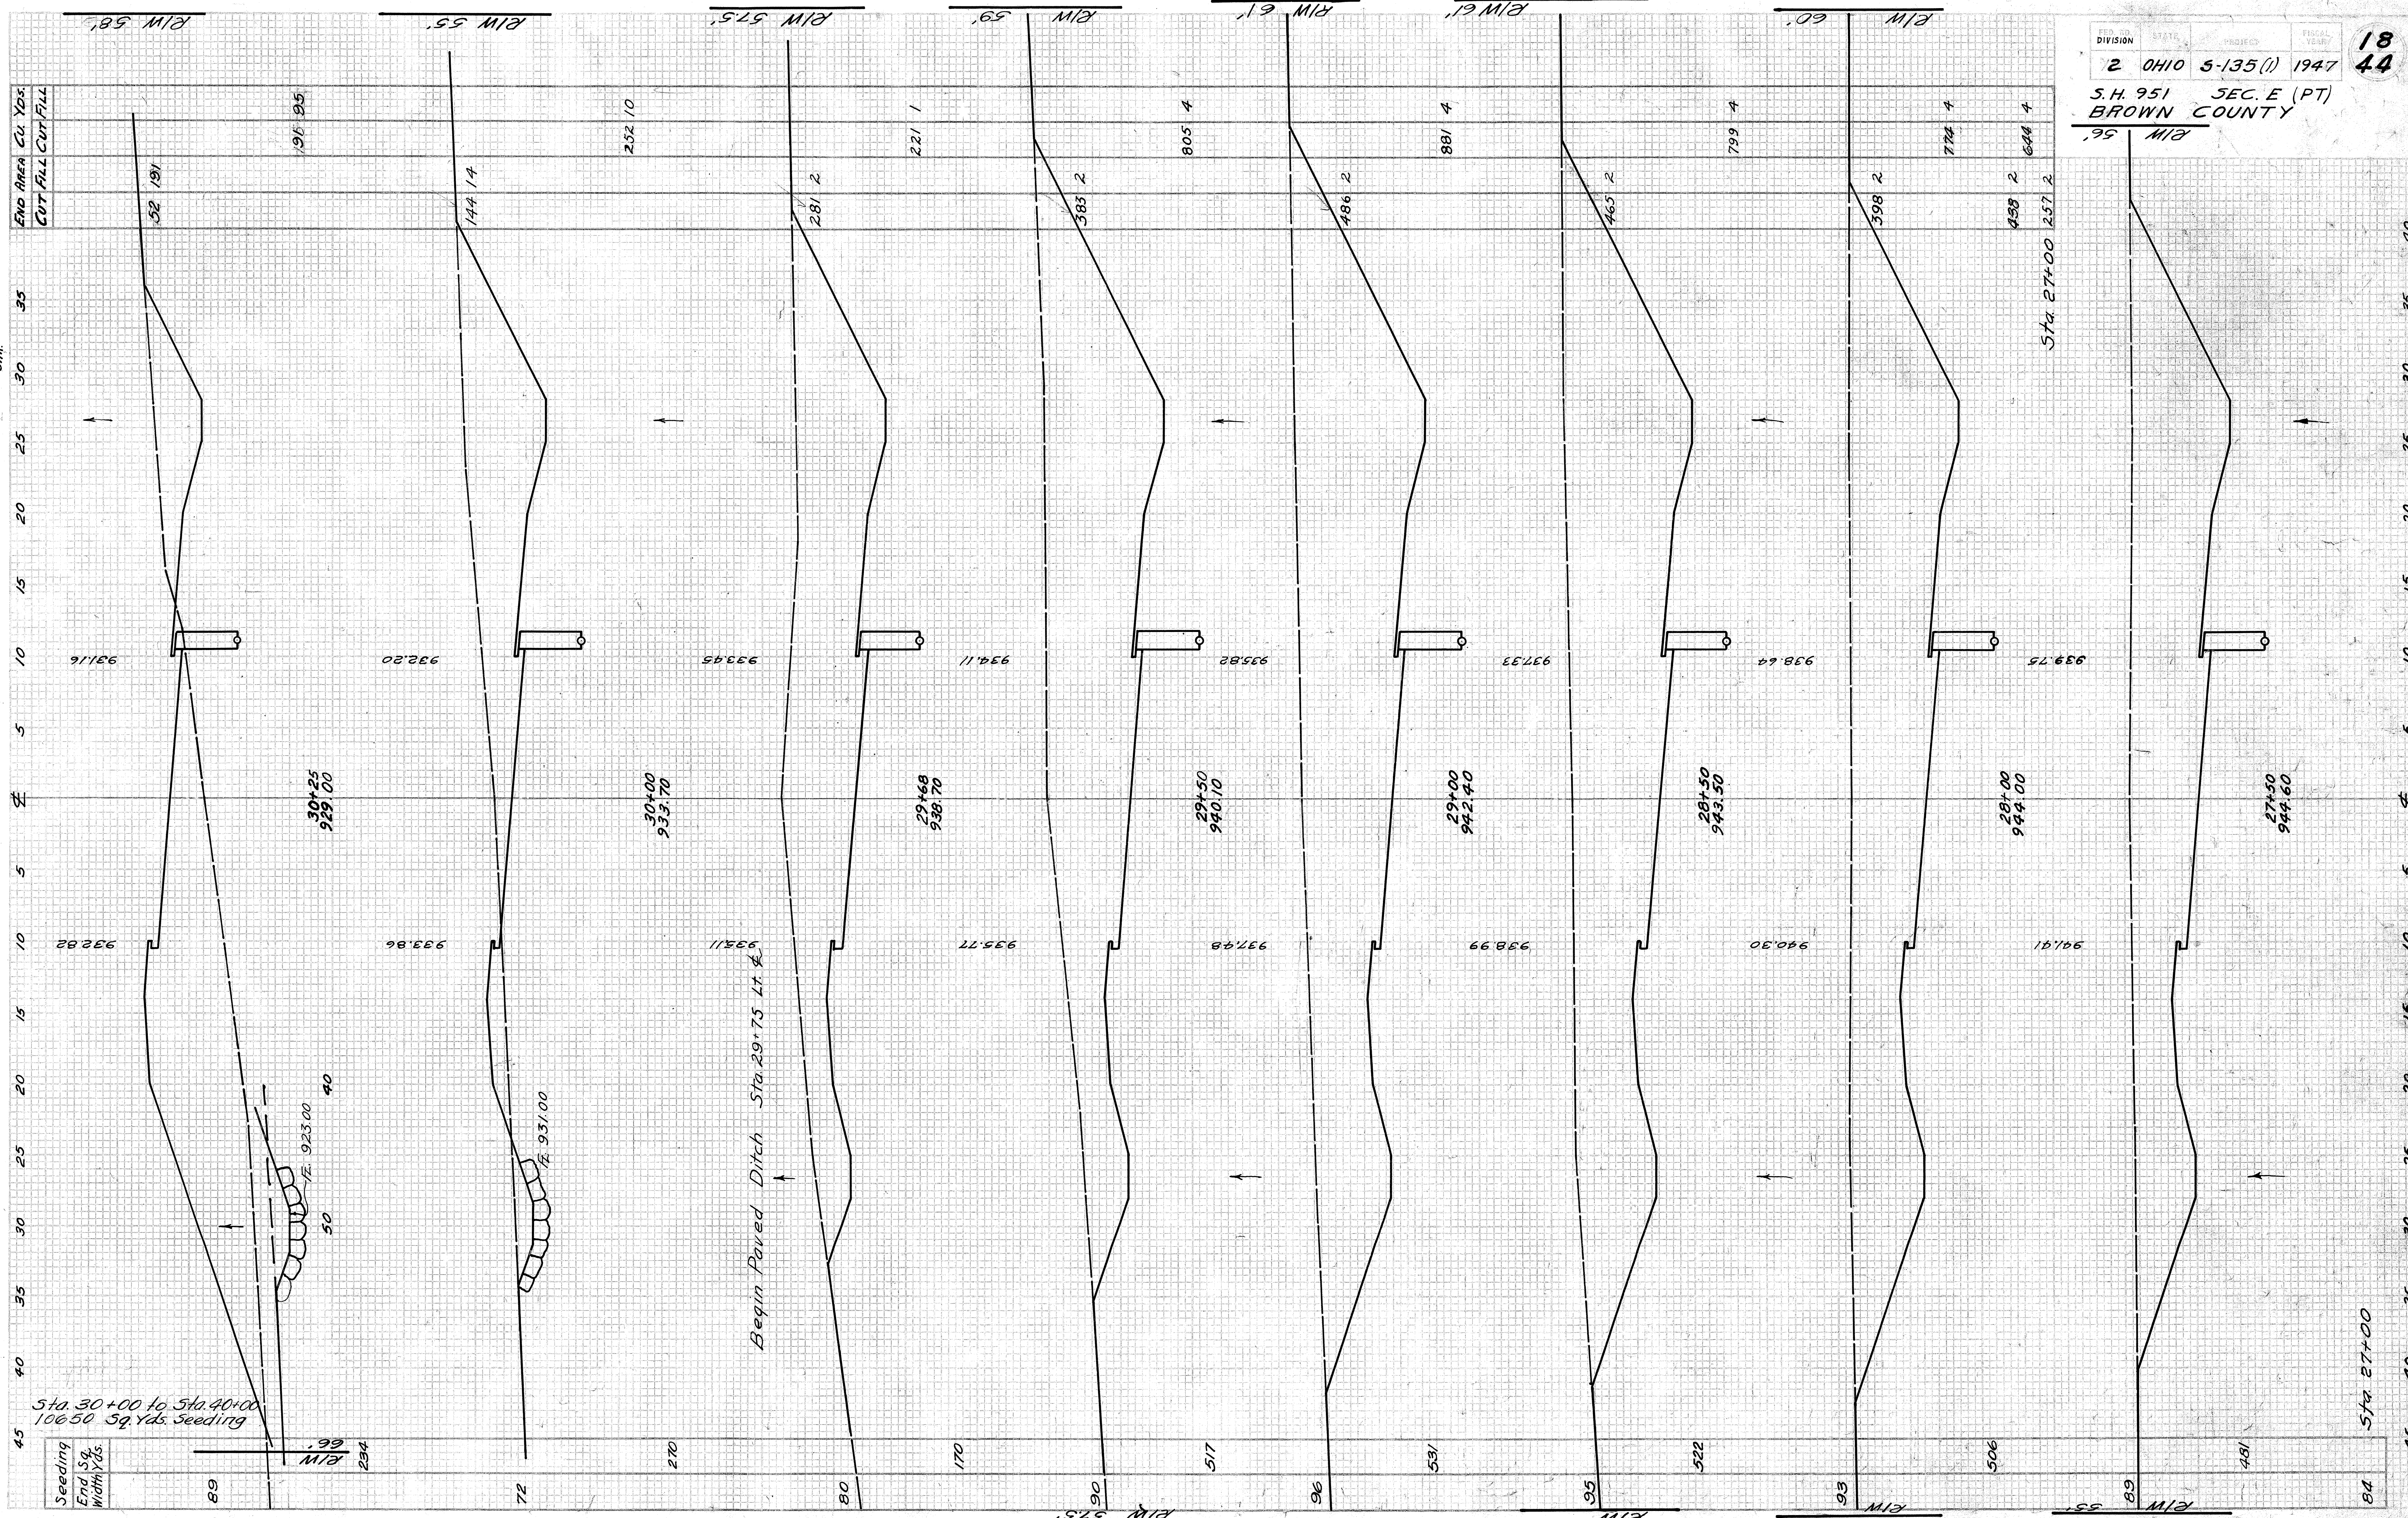


END AREA	CU YDS.	CUT	FILL	CUT/FILL
52	191			
144	14			
252	10			
281	2			
383	2			
486	2			
465	2			
398	2			
438	2			
438	2			
257	2			

Plot
CHK
Temp
CHK
Areas
CHK
Yds
CHK
B.M.
B.M.
B.M.
B.M.

Plot
 Chk. B.M.
 Temp
 Chk. B.M.
 Areas
 Chk. B.M.
 Yeg.
 Chk.

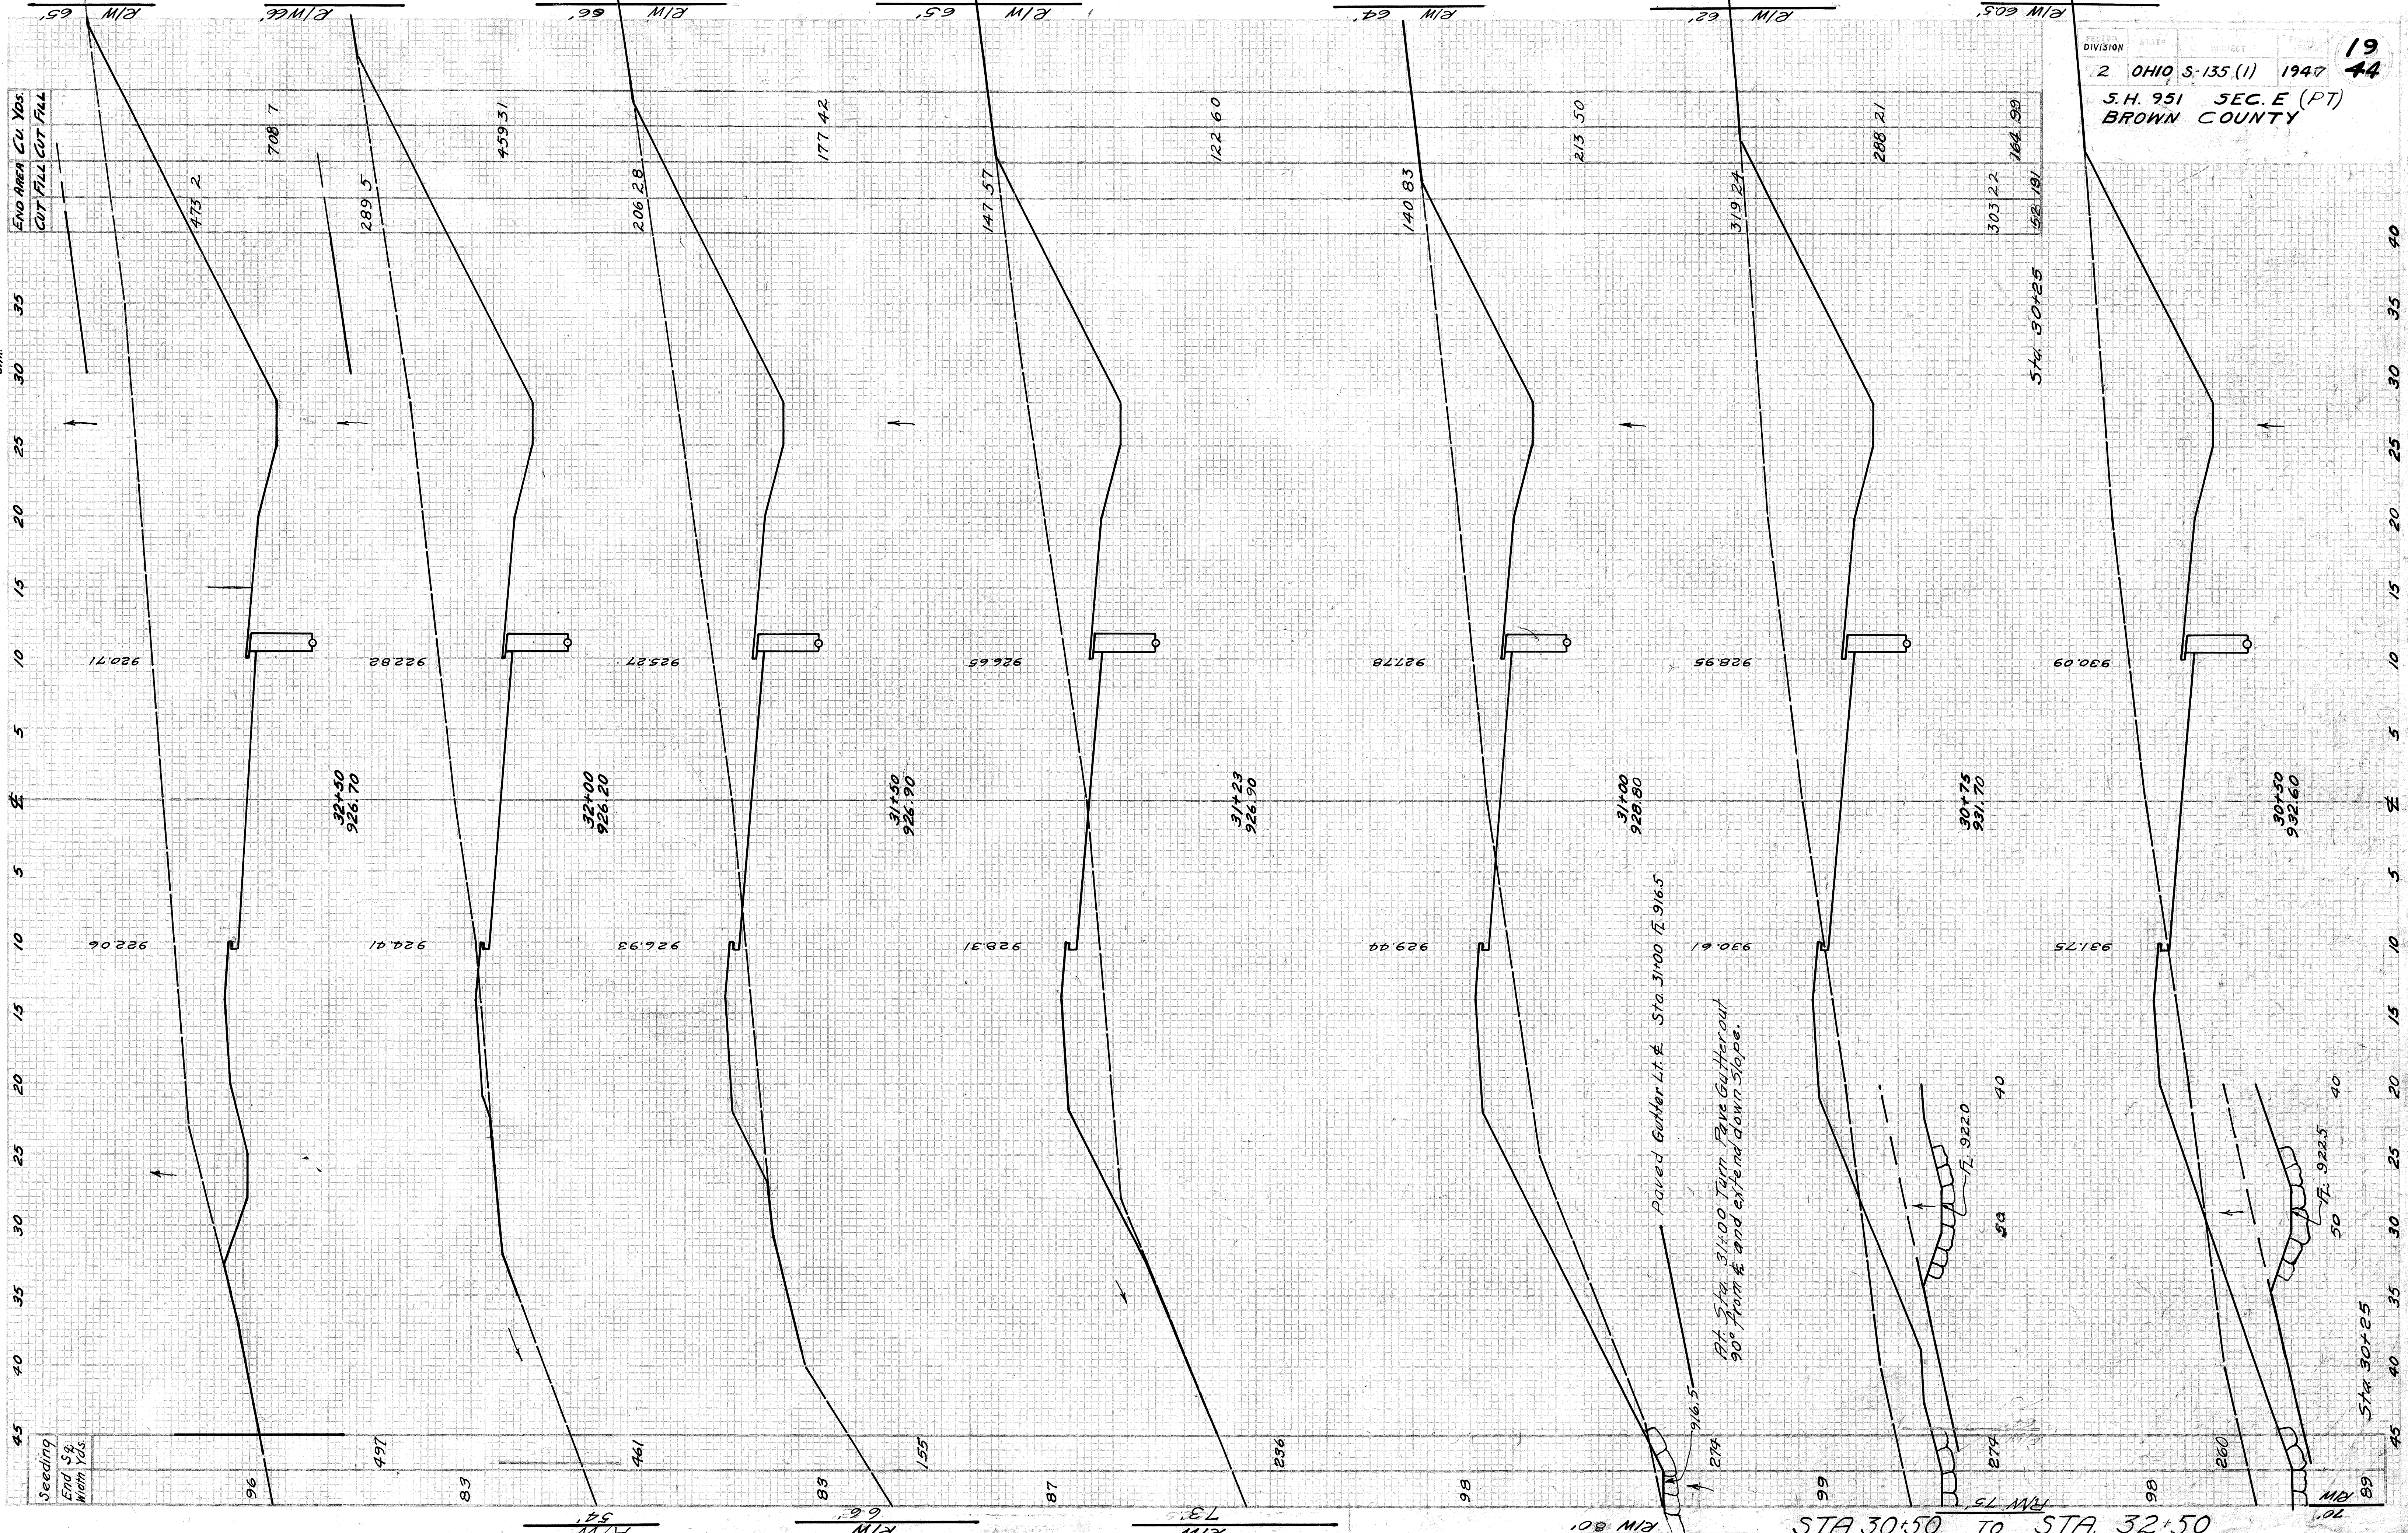

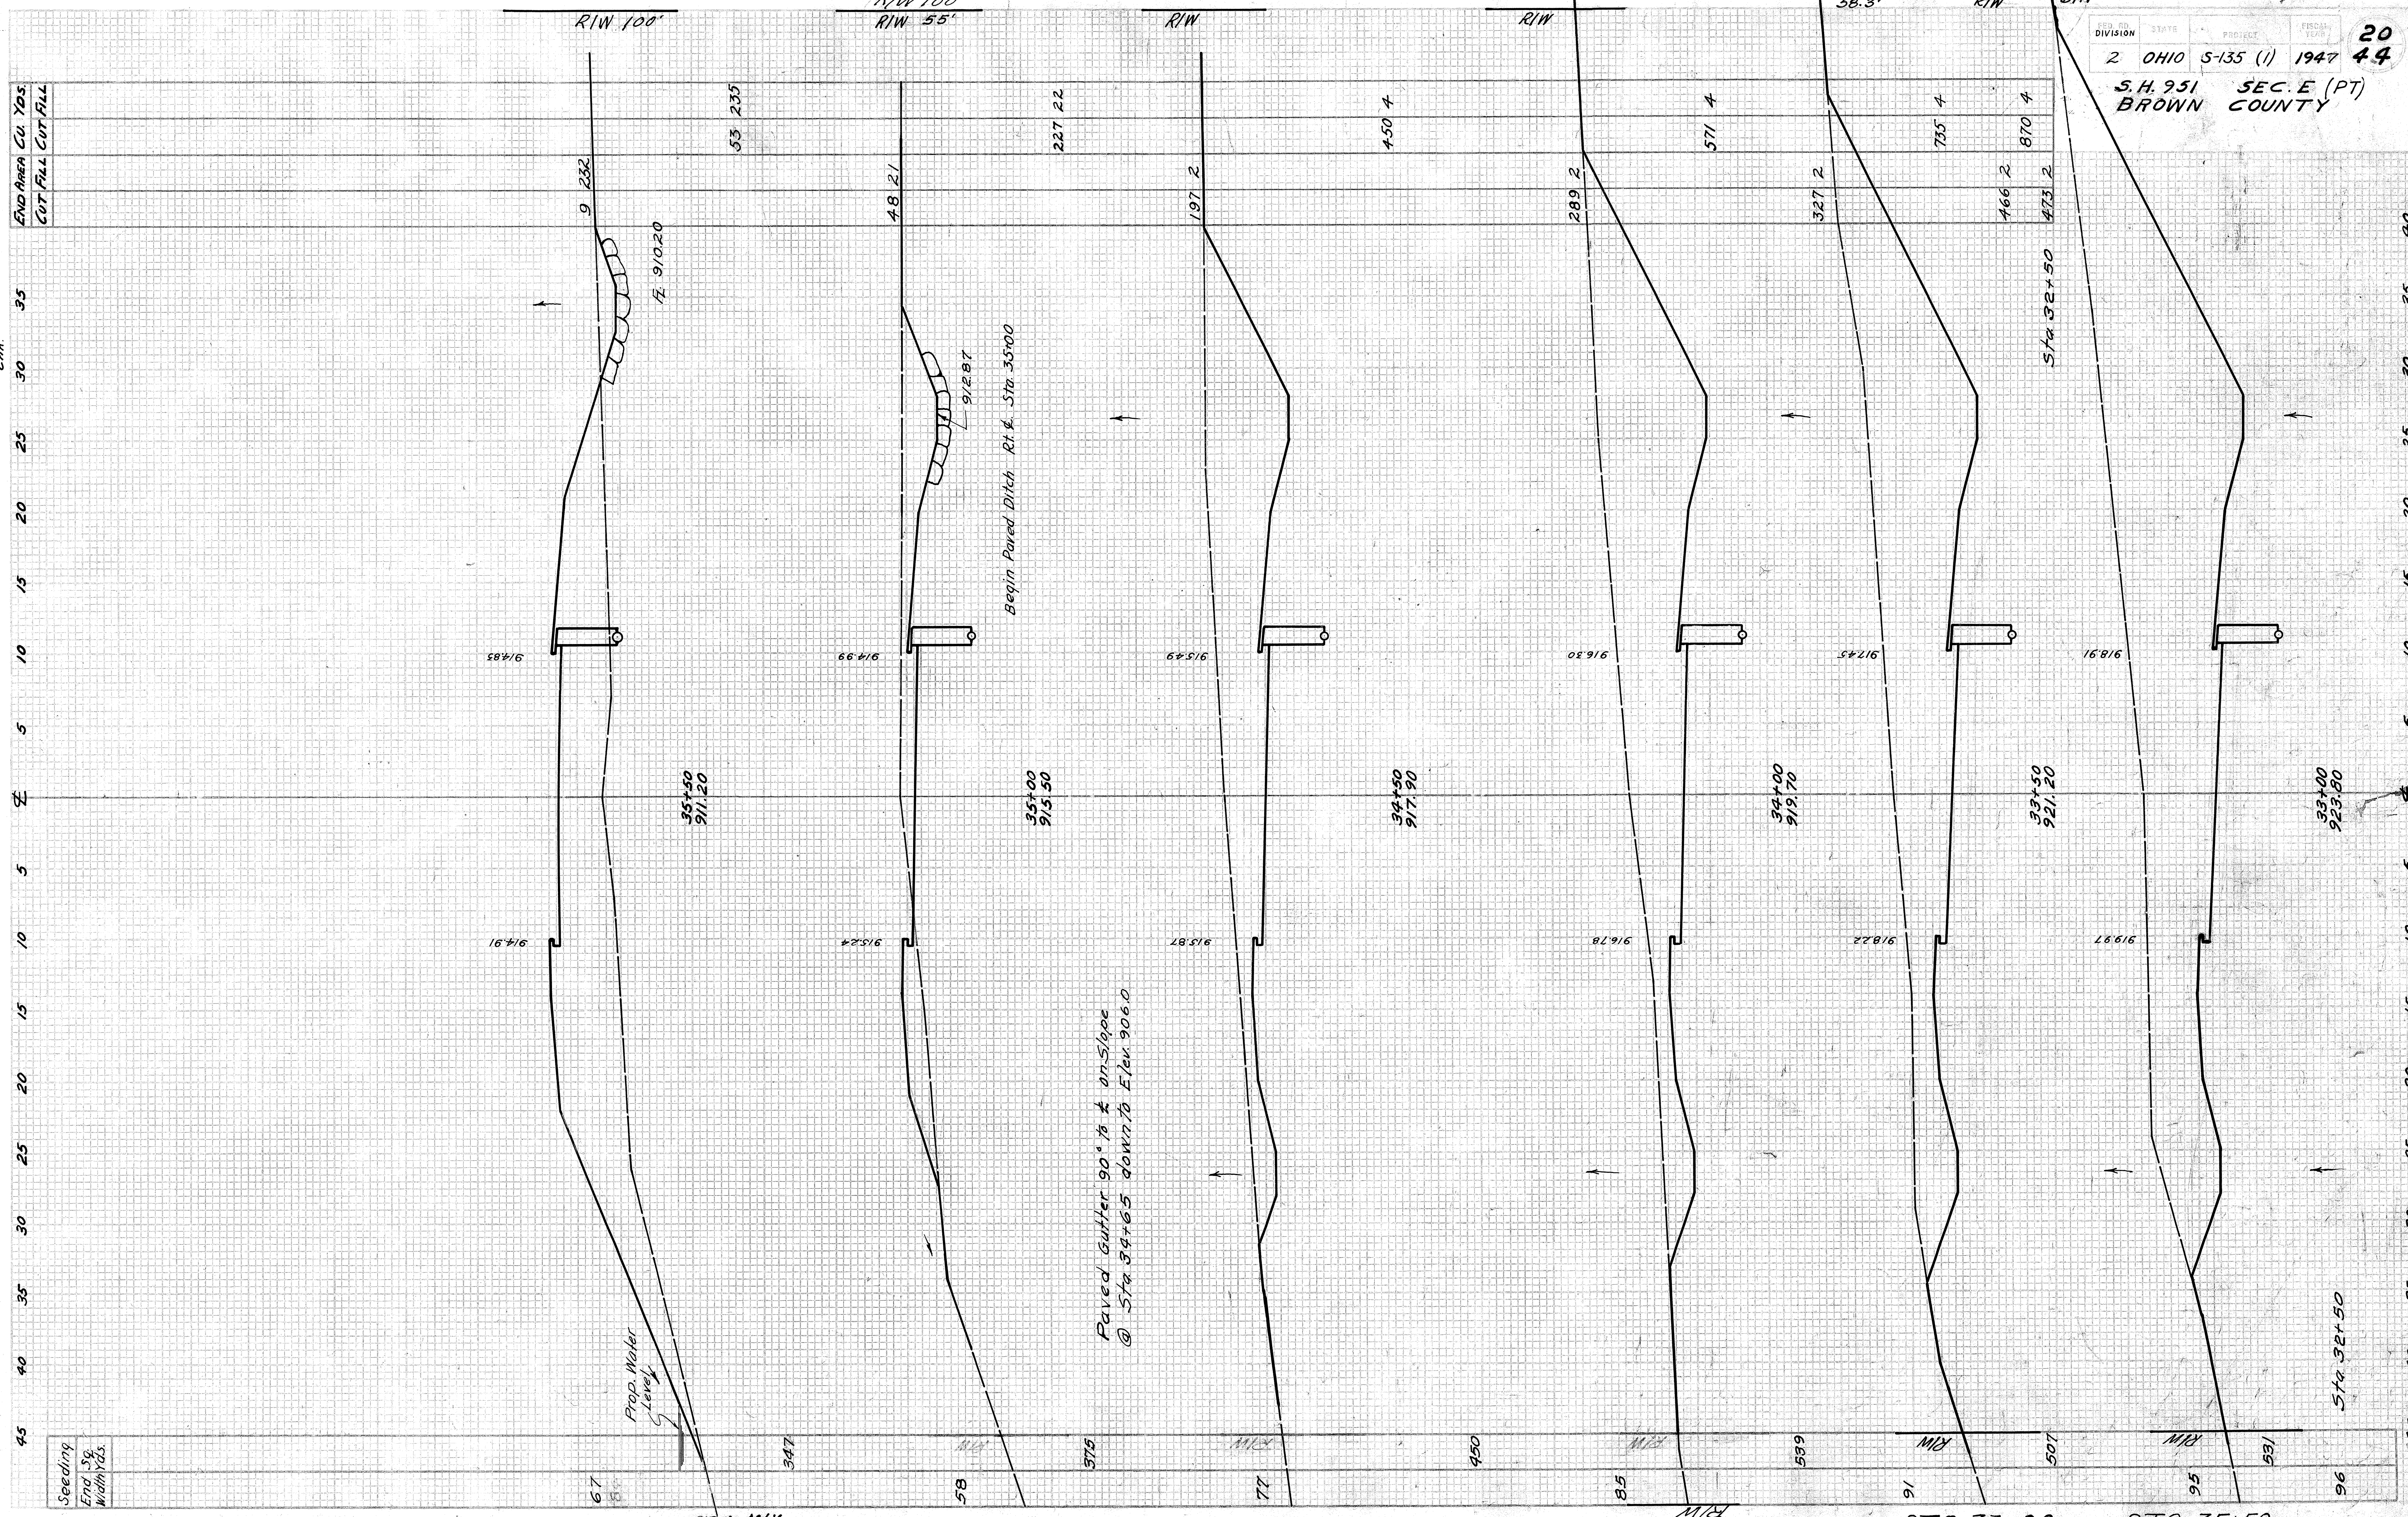


END AREA	CUT	FILL	CUT	FILL
9	232			
		53	235	
				227
				450
				571
				735
				870
				473

Plot
 Chk
 Temp
 Chk
 Areas
 Chk
 Yrs
 Chk
 B.M.
 B.M.
 F.B.T.
 B.M.

Seeding
 End 5g
 Width Yds.

05+50 STA. 01 00+53 STA.

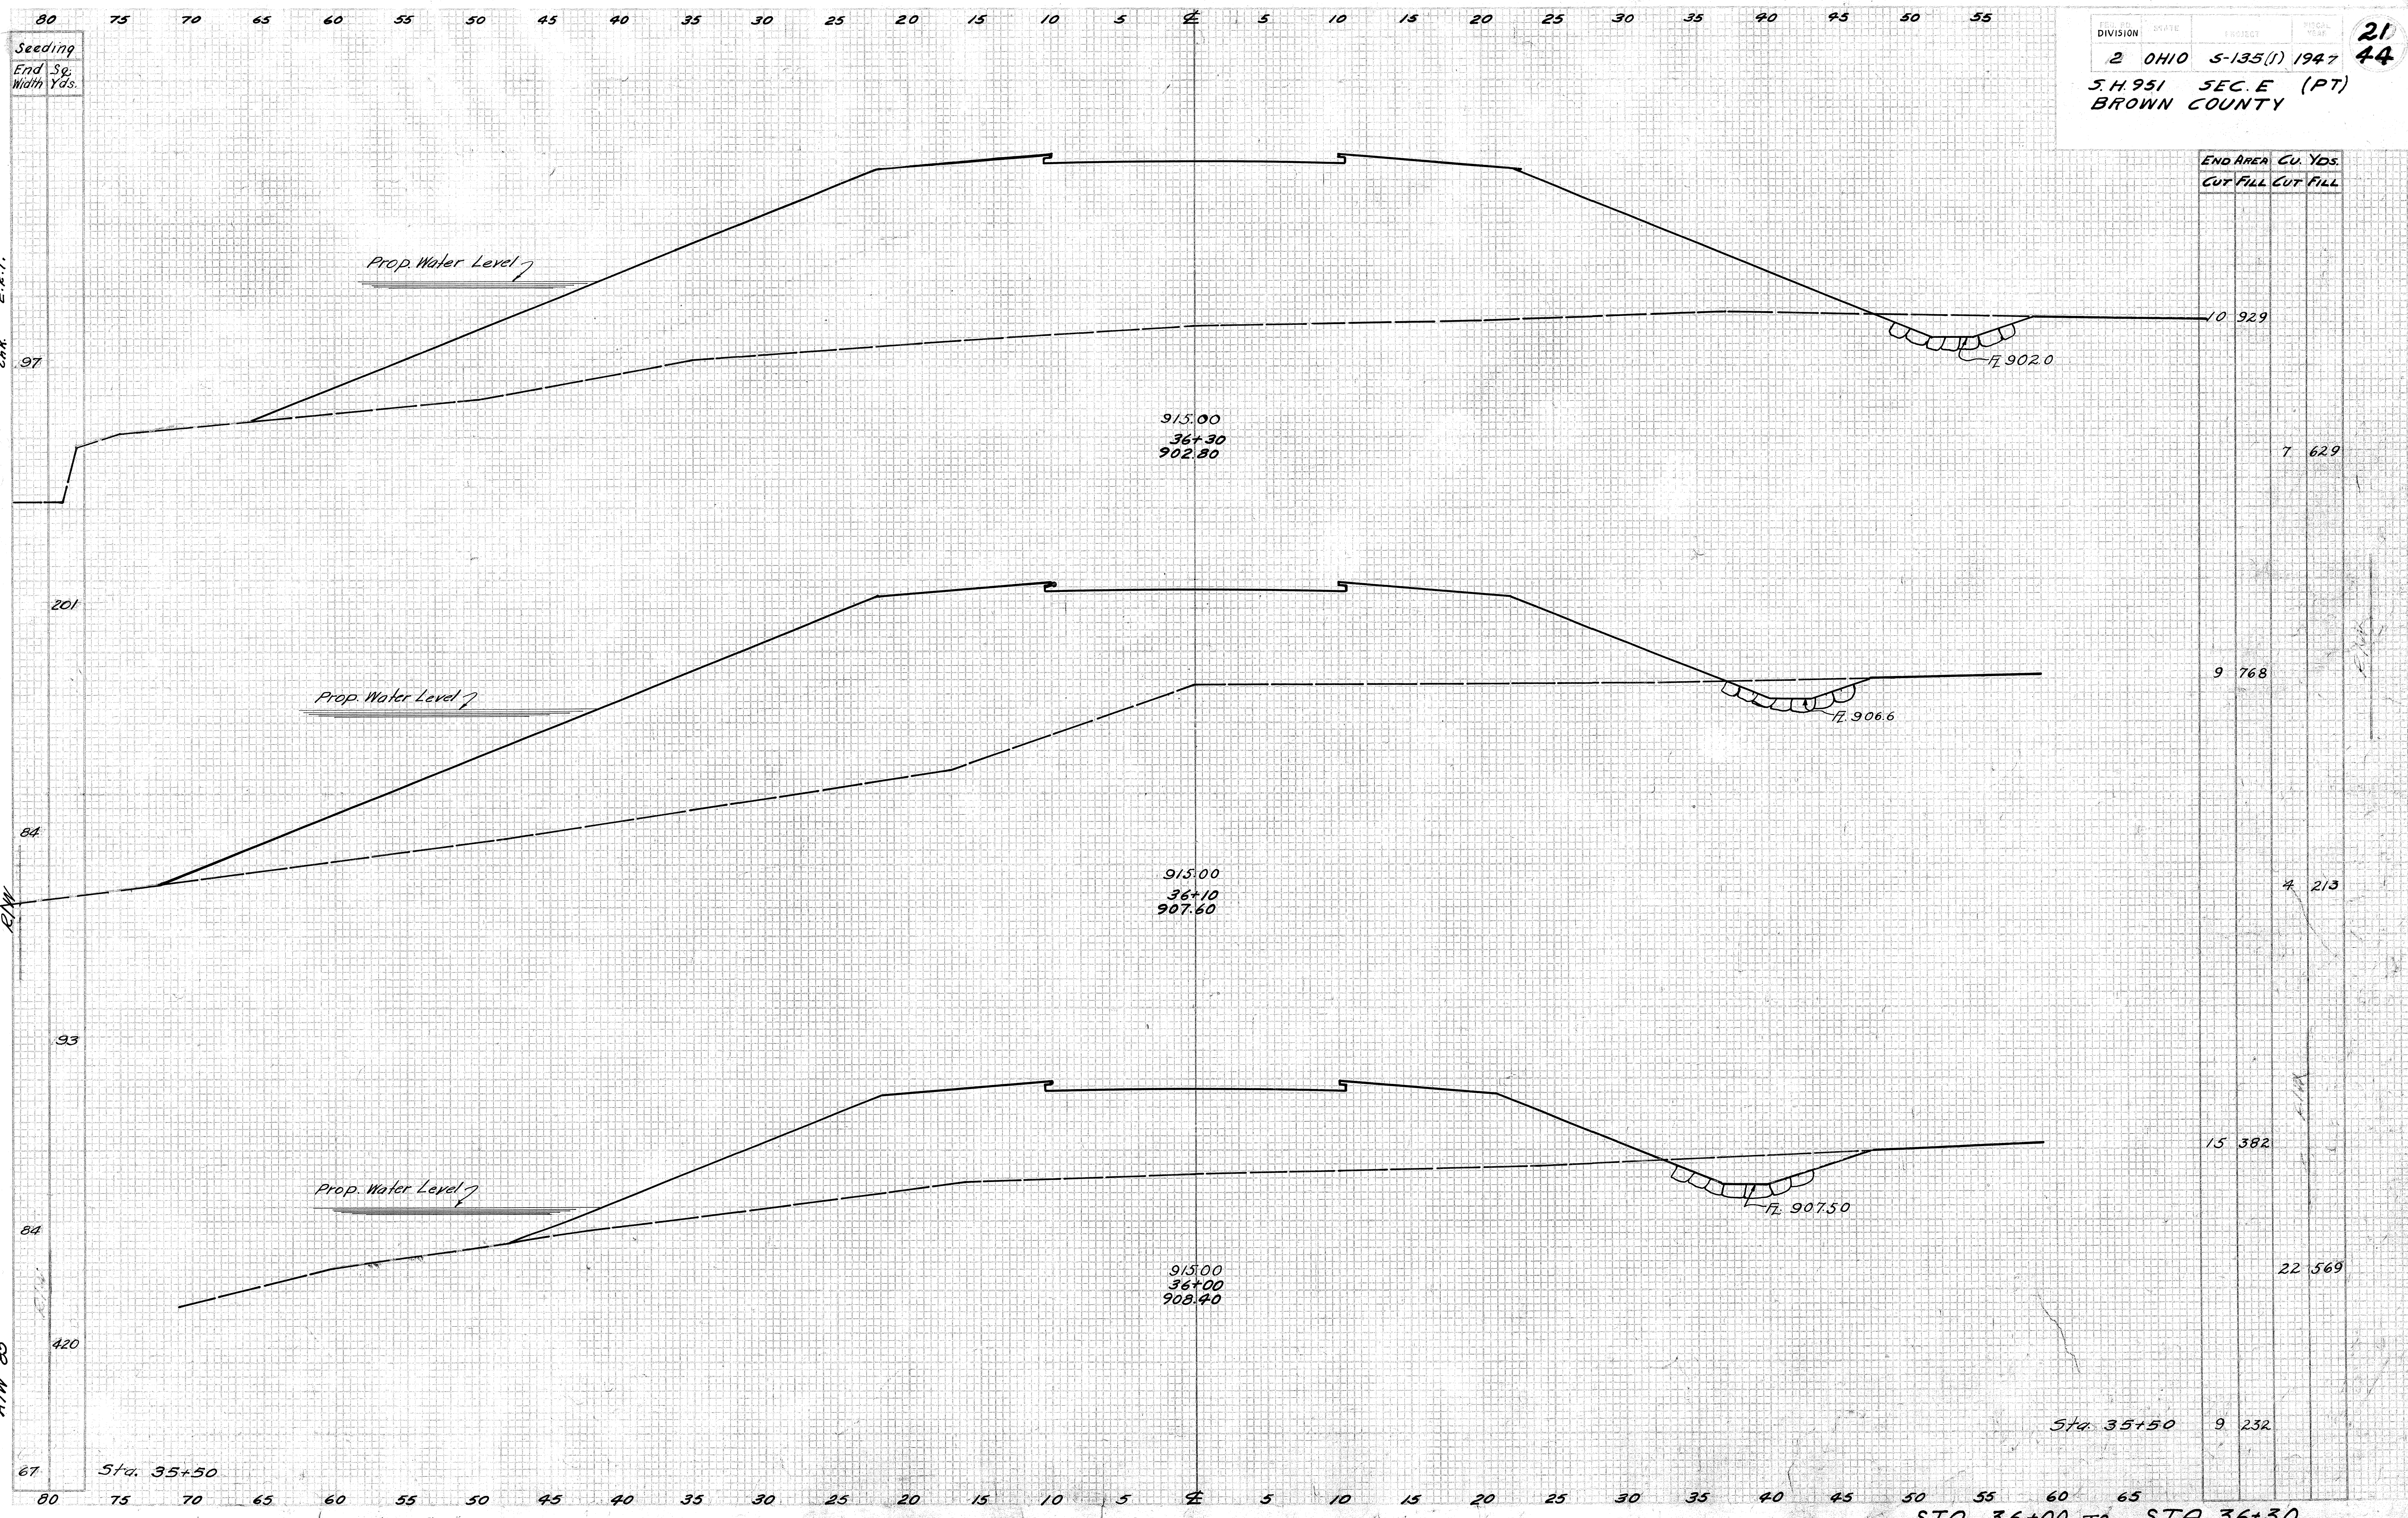

END AREA	CU. YDS.
CUT FILL	CUT FILL
10.929	7.629
9.768	4.213
15.382	22.569
9.232	

915.00
36+30
902.80

915.00
36+10
907.60

915.00
36+00
908.40

Sta. 35+50

Sta. 35+50

STA. 36+00 TO STA. 36+30

PLOT. G.C.B.
 CHK. B.K.
 Temp. B.K.
 CHK. B.K.
 Areas B.K.
 CHK. E.R.T.
 Ych. B.K.
 CHK. E.R.T.

R/W 90.5'


R/W 87'

R/W 85'

R/W 100'

R/W 100'

R/W 100'

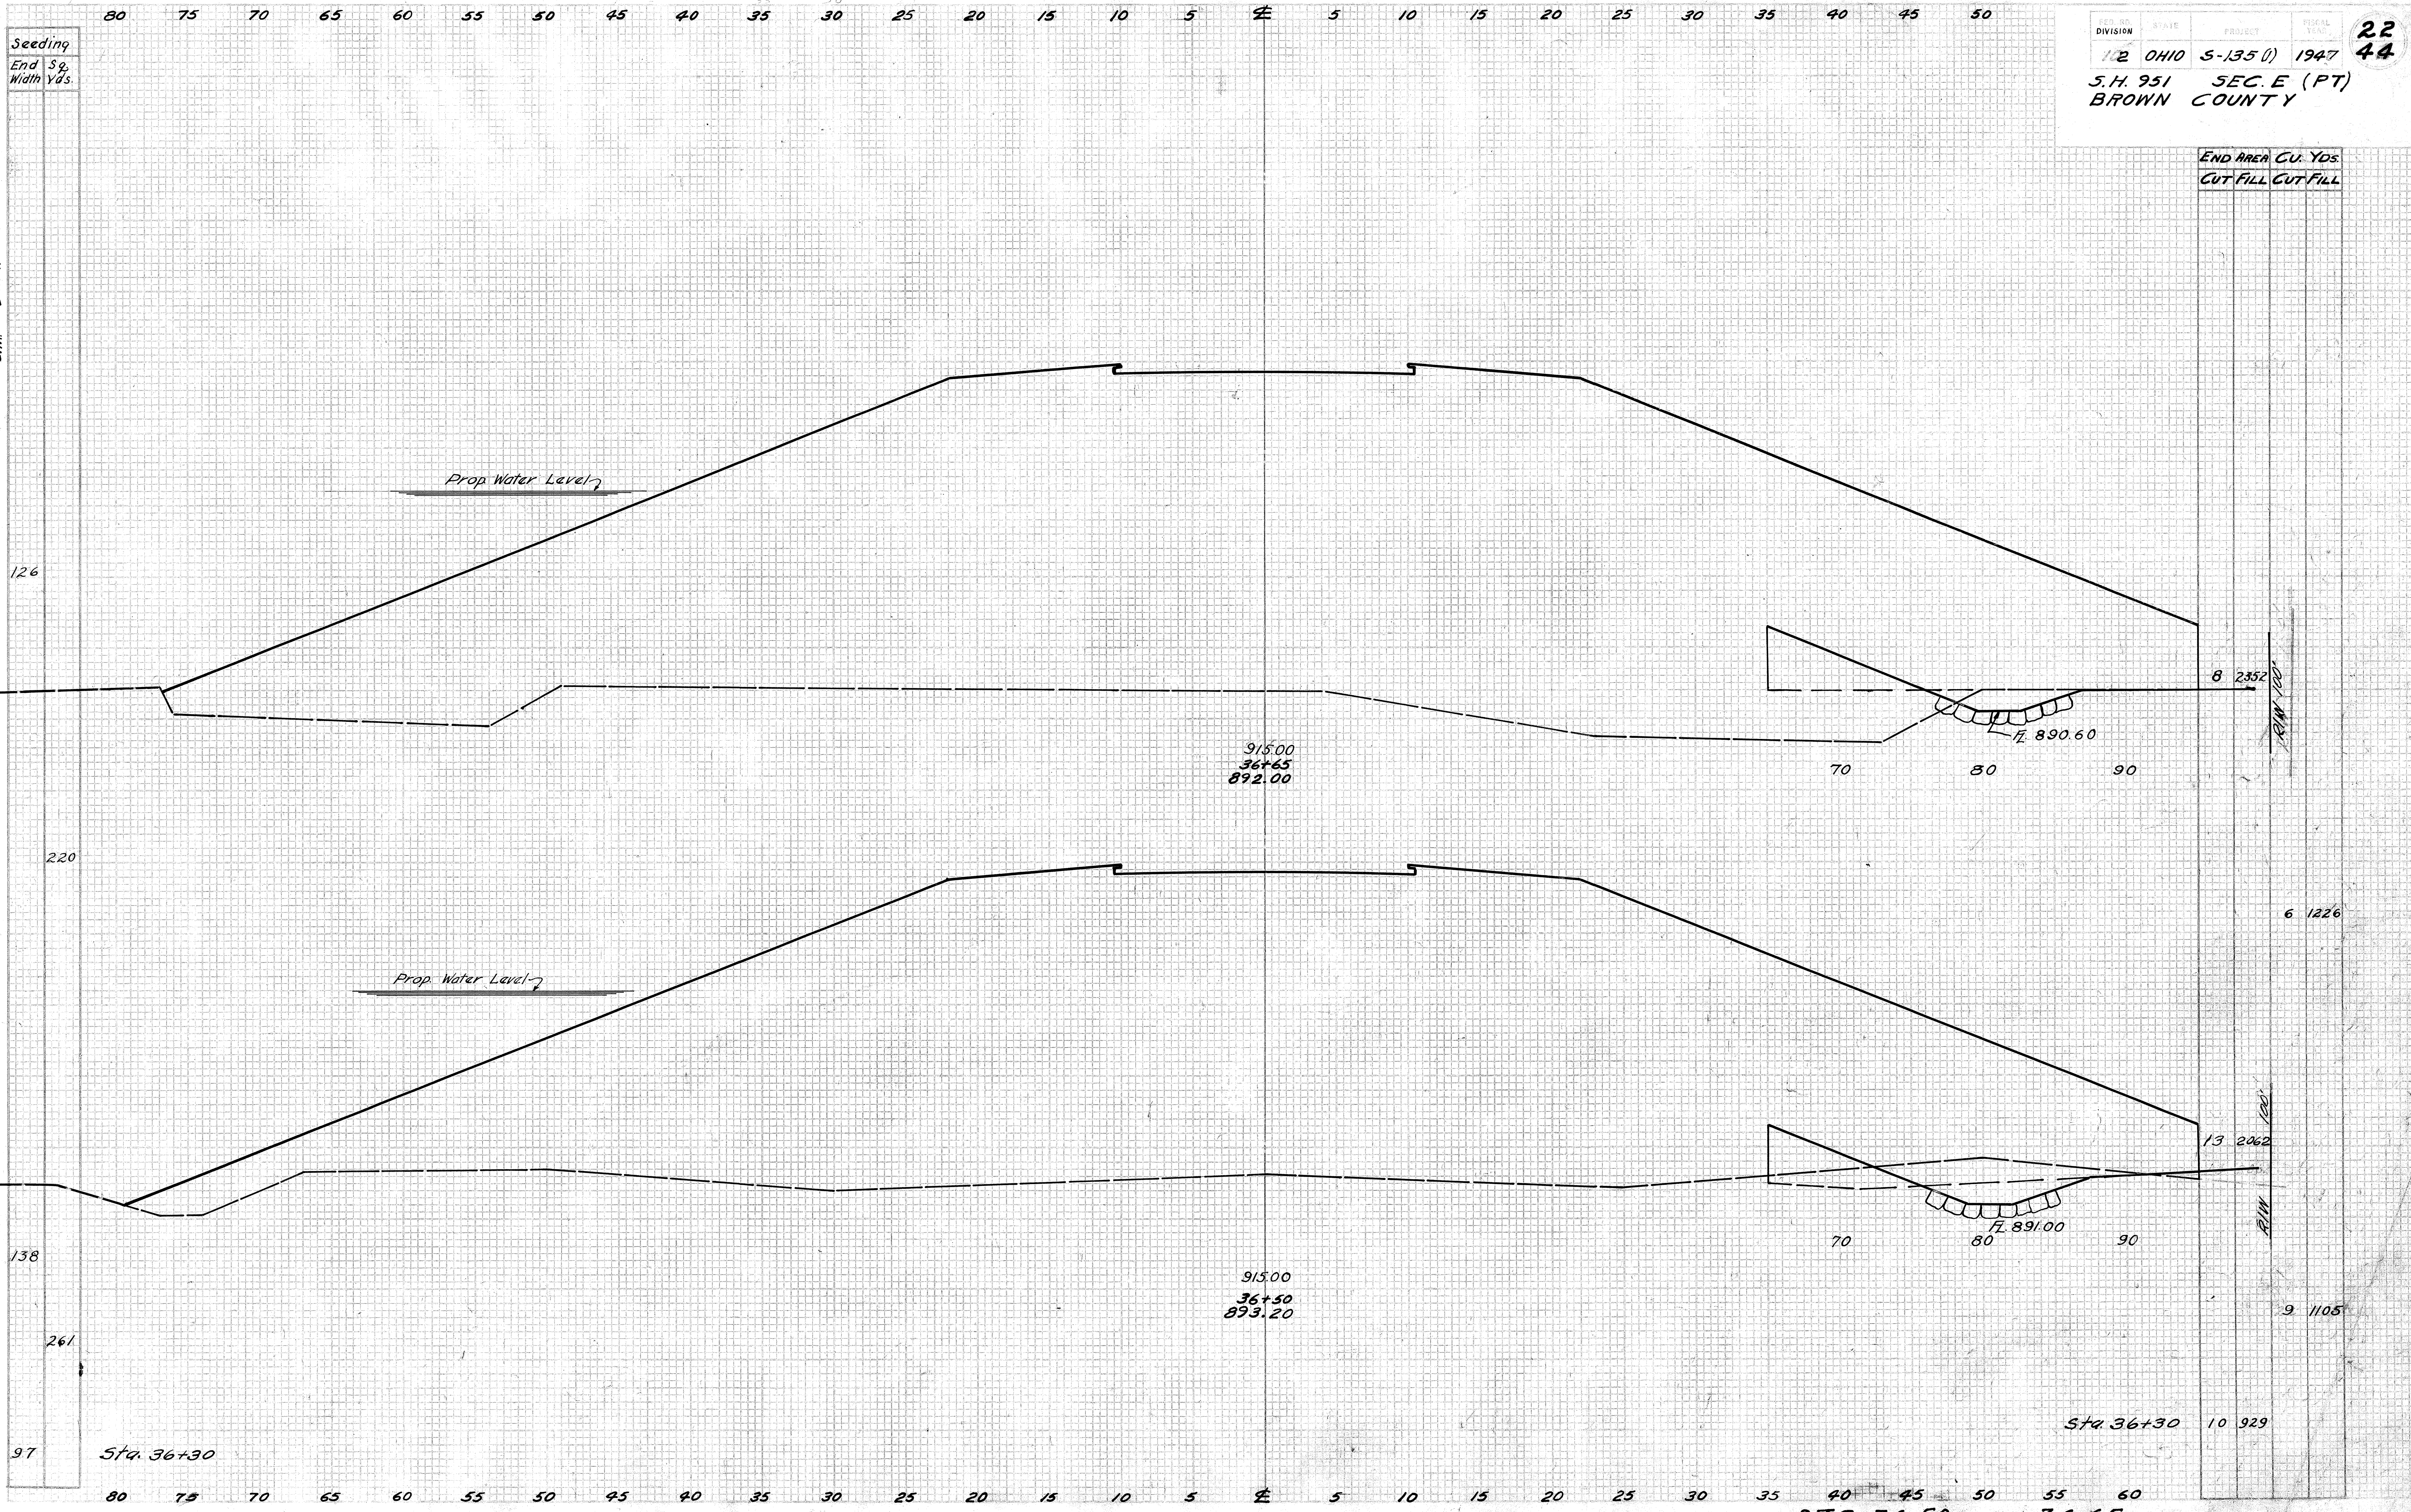

Seeding
End Sq.
Width Yds.

Pin P.C.B.
Chk. B.M.
Temp.
Chk. B.M.
Areas B.M.
Chk. F.I.T.
Xip. B.M.
Chk. F.I.T.

END AREA CU. YDS.	
CUT	FILL

915.00
36+65
892.00

915.00
36+50
893.20

8 2352

6 1226

13 2062

9 1105

10 929

Sta. 36+30

Sta. 36+30

STA. 36+50 TO 36+65

75 70 65 60 55 50 45 40 35 30 25 20 15 10 5 0 5 10 15 20 25 30 35 40 45 50 55 60


DIVISION STATE PROJECT YEAR
 12 OHIO S-135 (1) 1947
 S.H. 951 SEC. E (PT)
 BROWN COUNTY

23
44

Seeding
End Sq.
Width Yds.

Plat. E.R.T.
 Chk. B.K.
 Temp. B.K.
 Yk. B.K.
 Areas B.K.
 Chk. E.R.T.
 Yds. B.K.
 Chk. E.R.T.

END AREA CU. YDS.
 CUT FILL CUT FILL

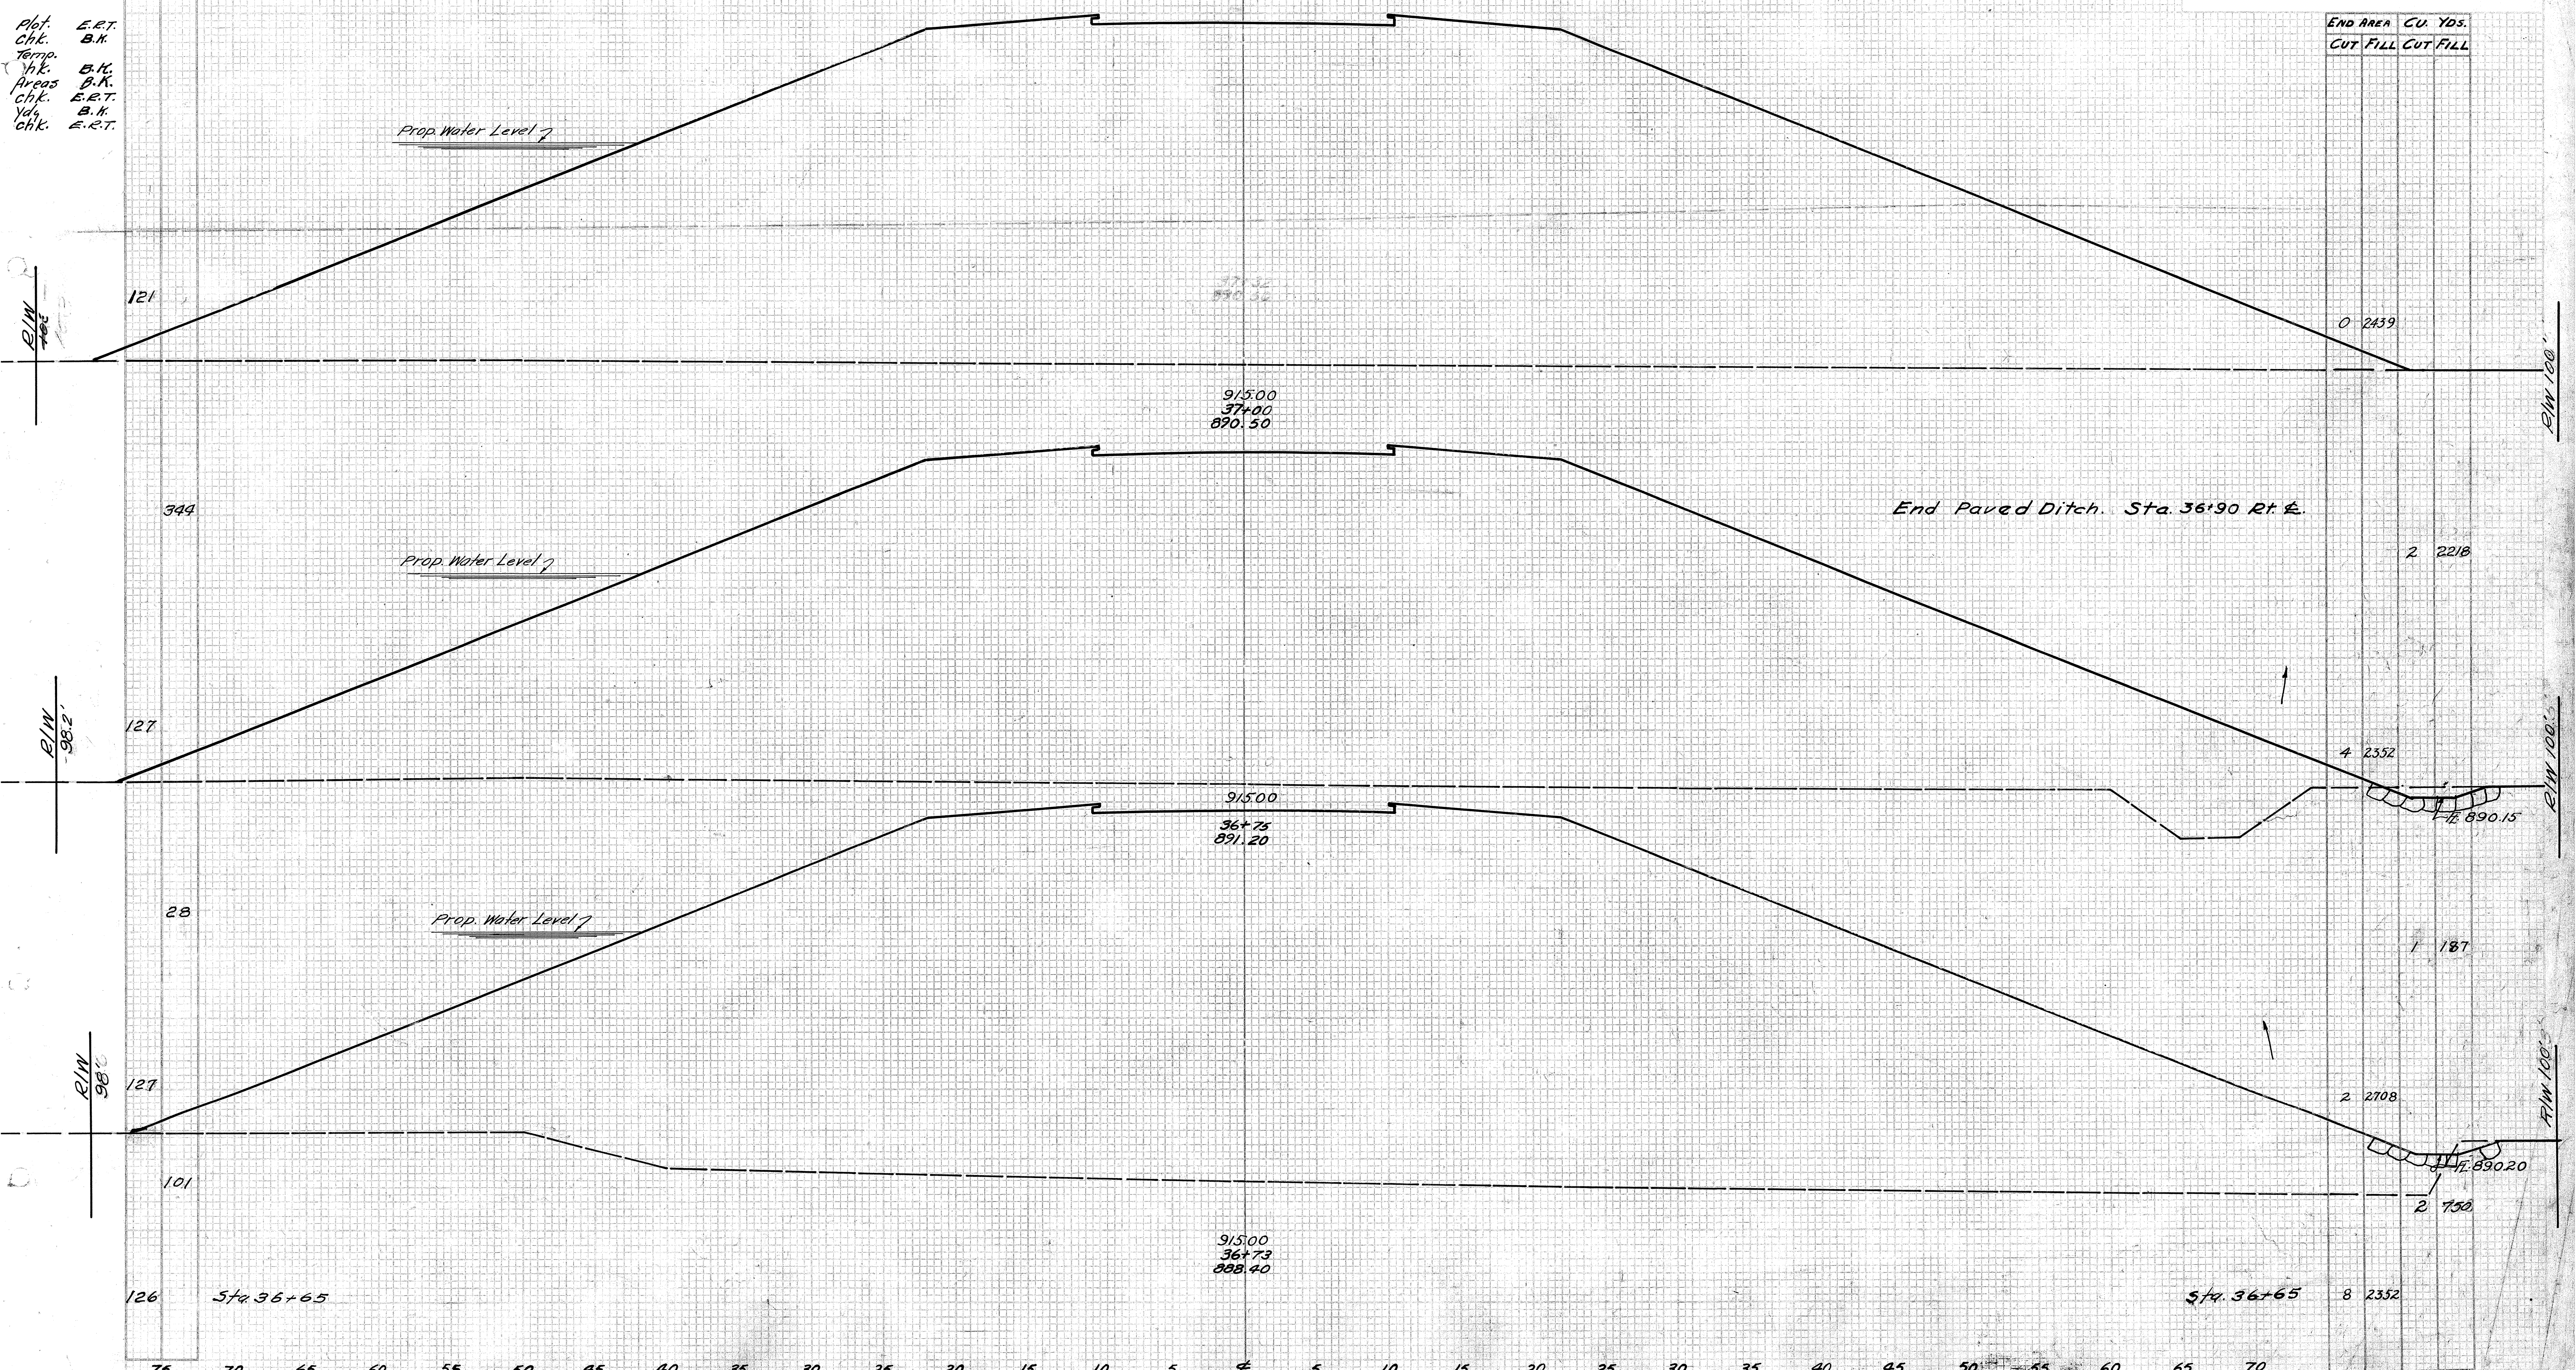

91500
37+00
890.50

91500
36+75
891.20

91500
36+73
888.40

End Paved Ditch. Sta. 36+90 Rt. E.

STA. 36+73 TO STA. 37+00

END AREA	CU. YDS.
CUT	FILL
0	2439
2	2218
4	2352
1	187
2	2708
2	750
8	2352

R/W 100'

R/W 100'

R/W 98.2'

R/W 100.5'

R/W 98'

R/W 100.5'

121

0 2439

344

2 2218

127

4 2352

28

1 187

127

2 2708

101

2 750

126

8 2352

Sta. 36+65

Sta. 36+65

75 70 65 60 55 50 45 40 35 30 25 20 15 10 5 0 5 10 15 20 25 30 35 40 45 50 55 60

Seeding
End Sq.
Width Yds.

DIVISION STATE PROJECT FISCAL YEAR
12 OHIO S-135 (I) 1947
S.H. 951 SEC. E (PT)
BROWN COUNTY


24
44

Plot
chk.
Temp.
chk.
End
chk.
Ydg.
chk.

E.R.T.
B.K.

Note: Limits of Key Trench to be determined by the Engineer.

END AREA CU YDS.
CUT FILL CUT FILL

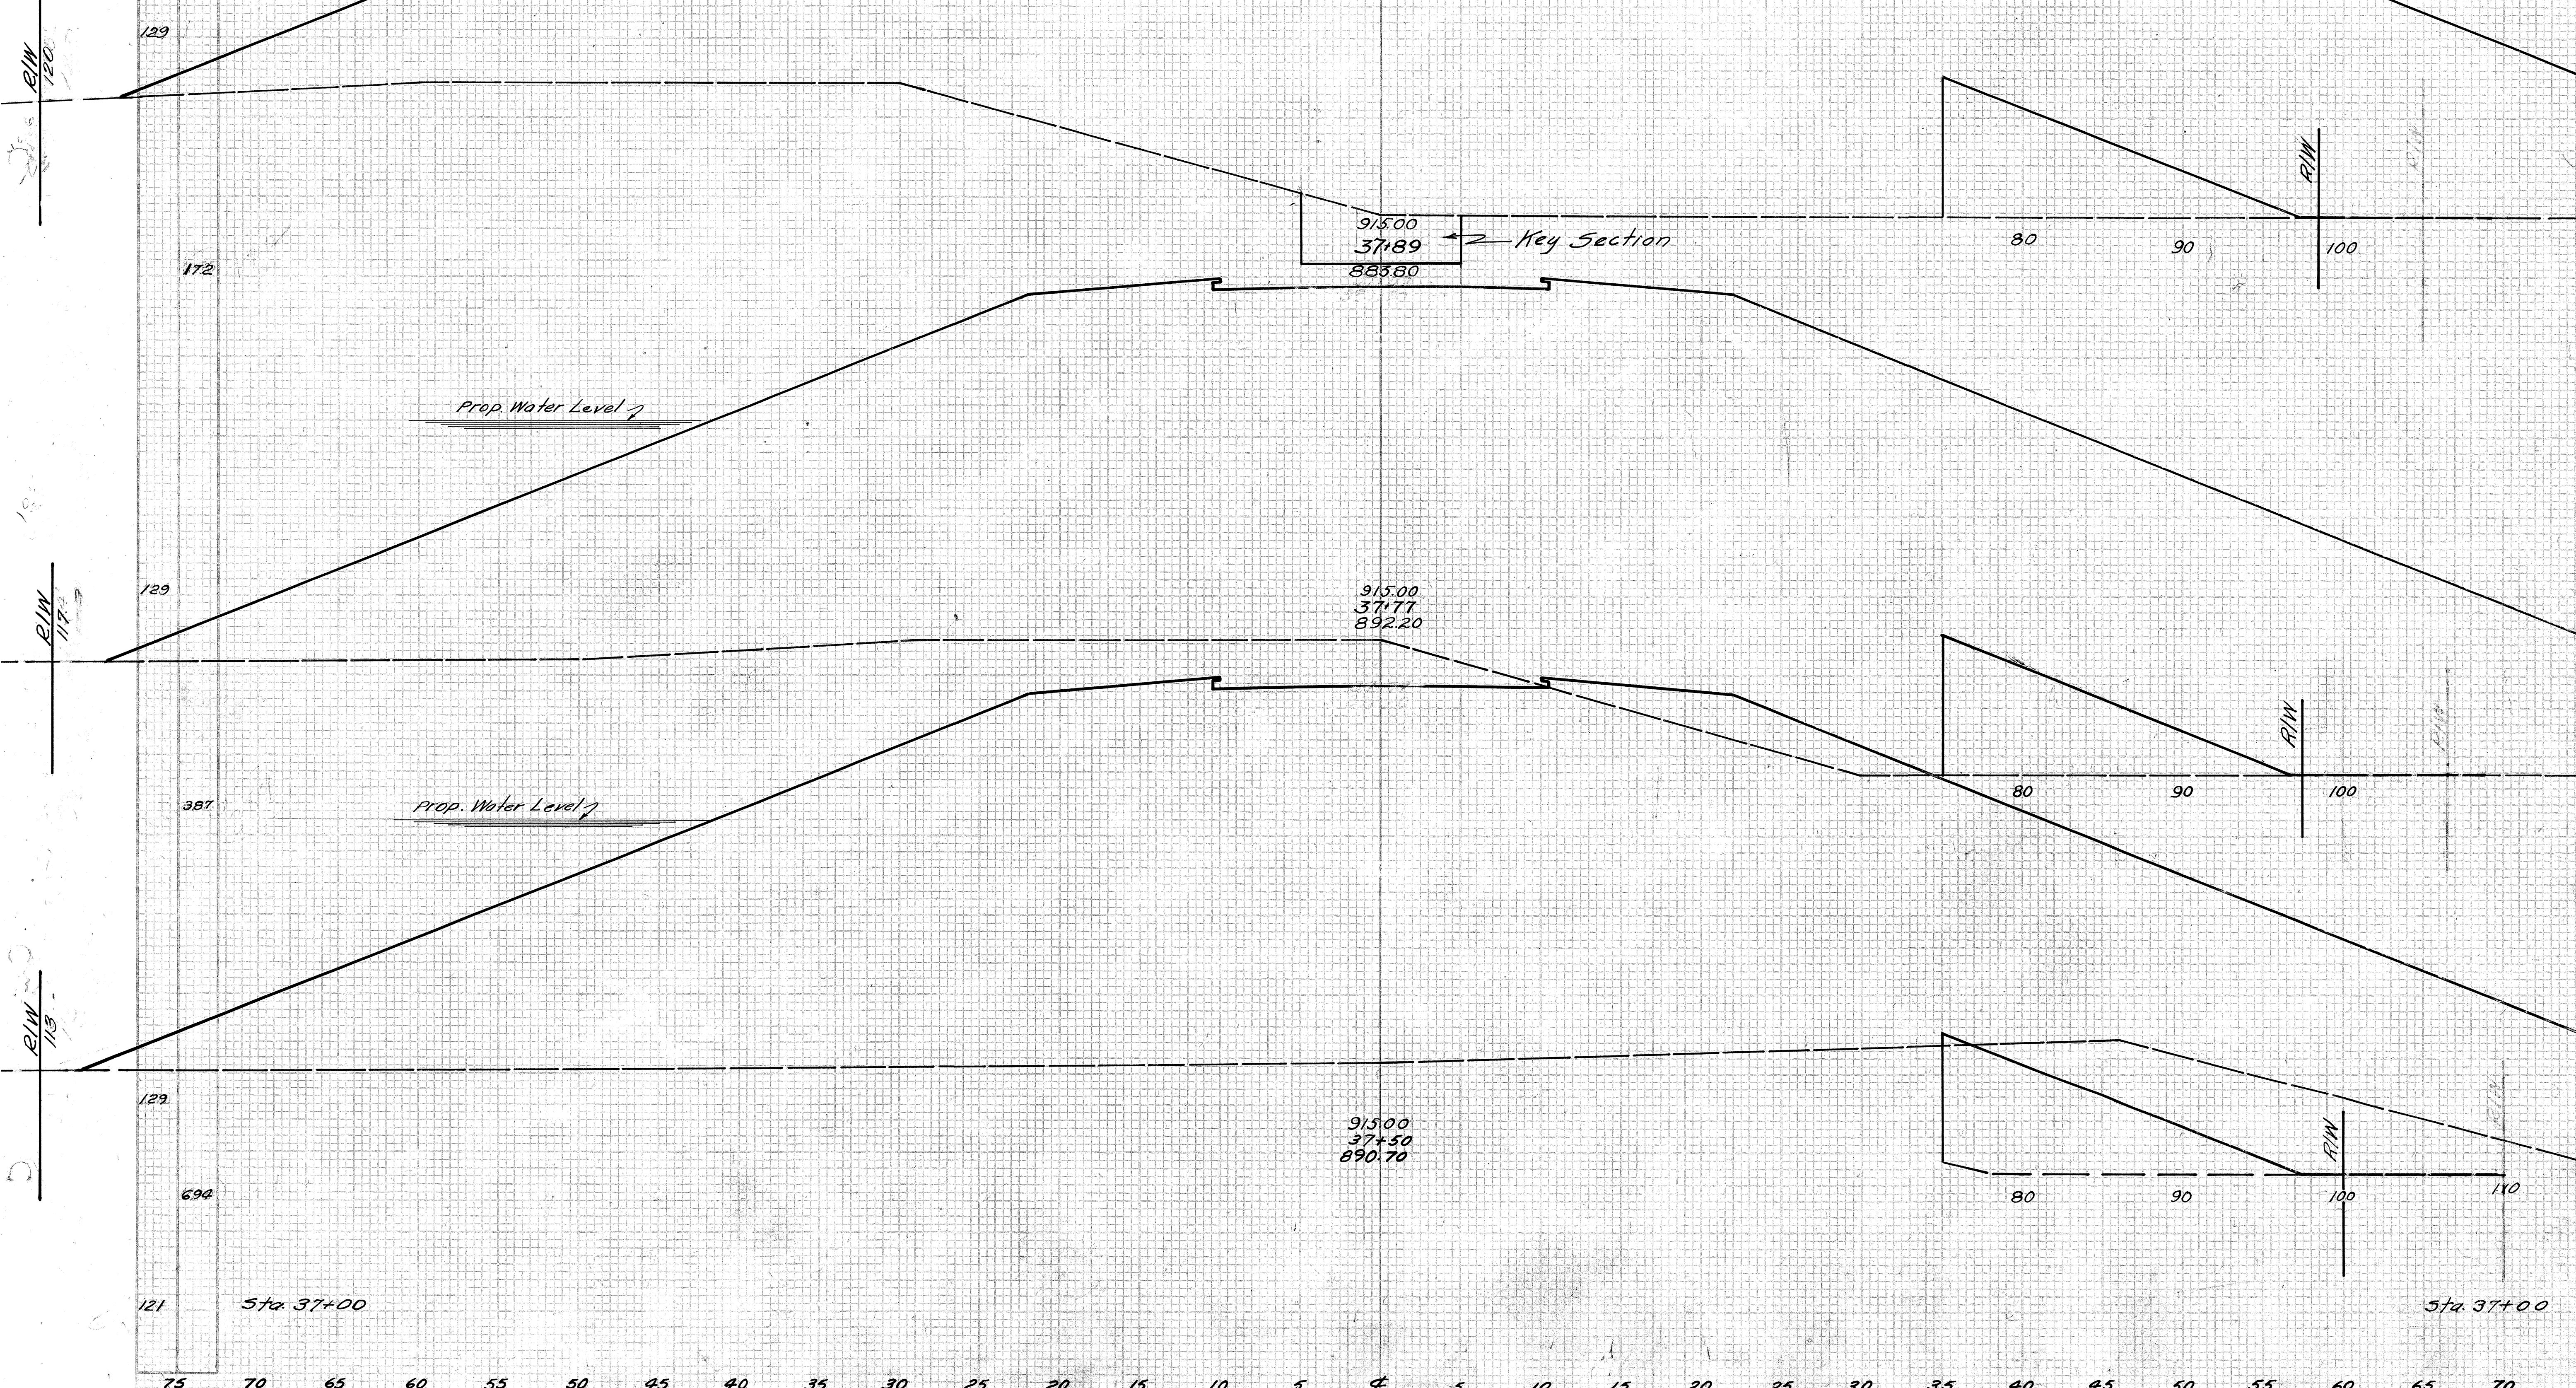

34 3076

8 1334

0 2927

0 2741

0 2555

0 4624

0 2439

75 70 65 60 55 50 45 40 35 30 25 20 15 10 5 0 5 10 15 20 25 30 35 40 45 50 55 60 65 70

STA. 37+50 TO STA. 37+89.

75 70 65 60 55 50 45 40 35 30 25 20 15 10 5 0 5 10 15 20 25 30 35 40 45 50 55 60

DIVISION	STATE	PROJECT	FISCAL YEAR
12	OHIO	5-135 (1)	1947


25
44

S.H. 951 SEC. E (PT)
BROWN COUNTY

Seeding
End Sq.
Width Yds.

Plat. E.R.T.
chk. B.N.
Temp. Chk.
Pri. Chk.
yds. Chk.


N/W
119.5'

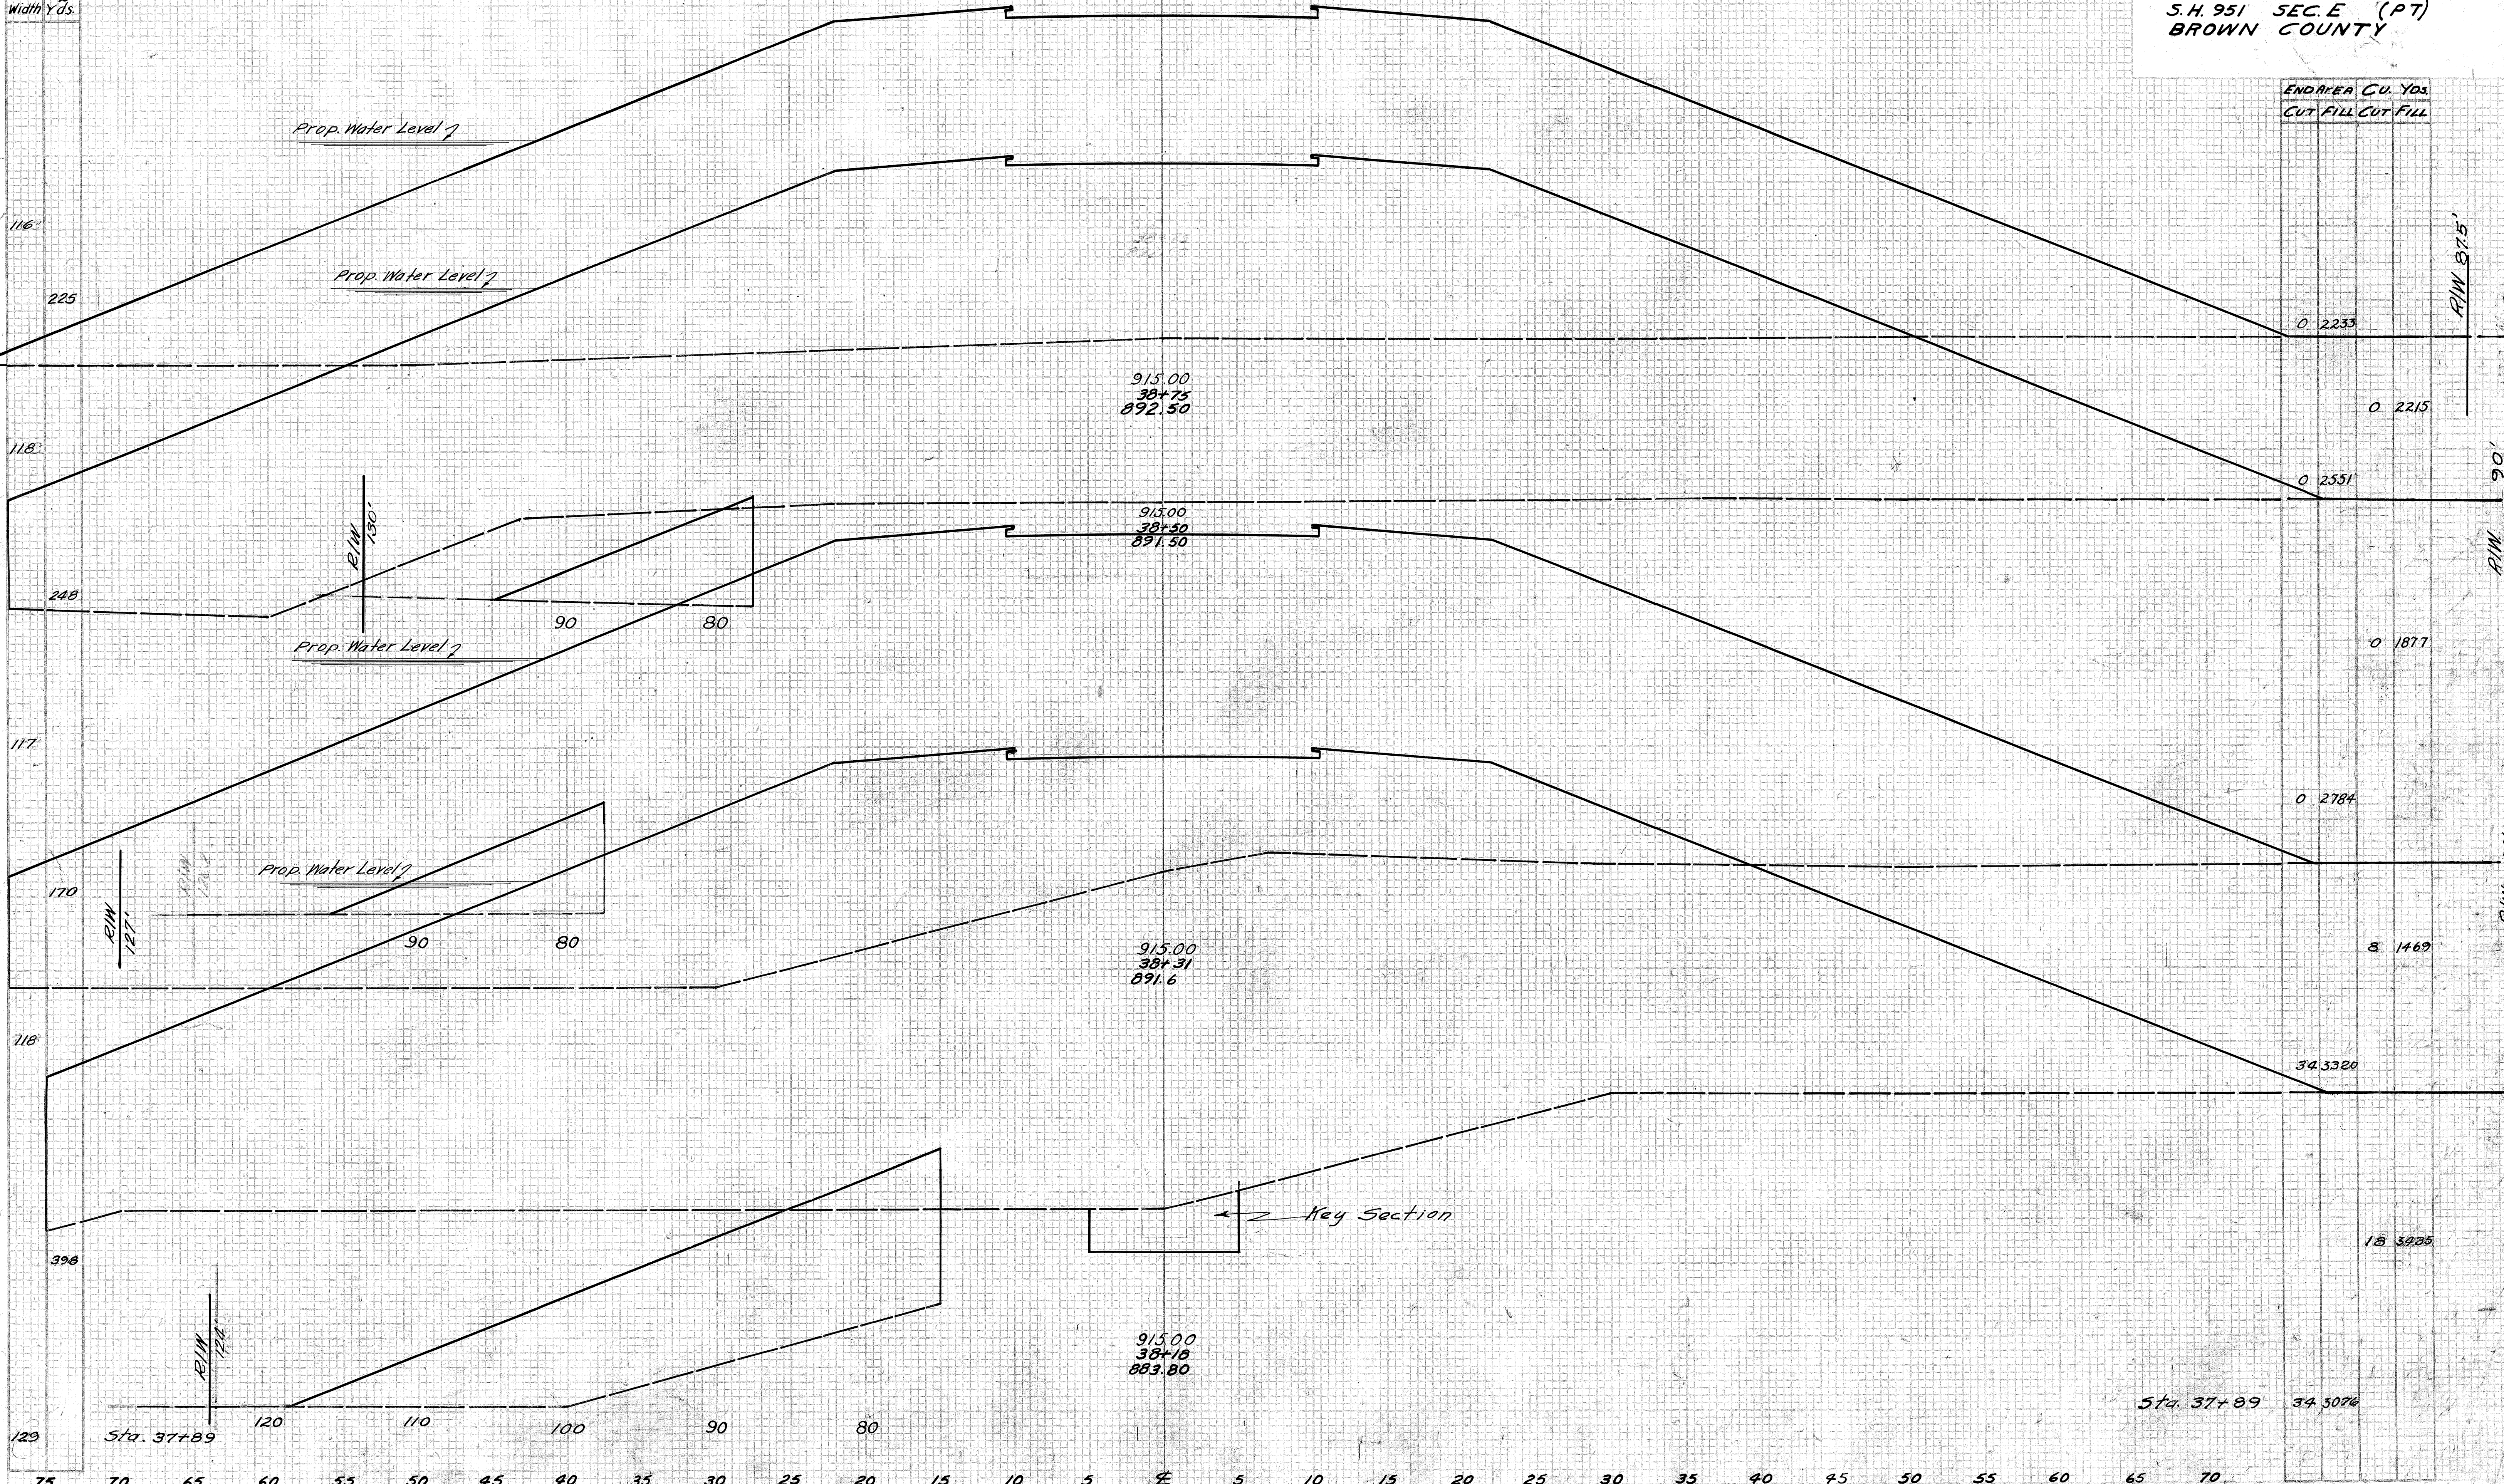

END AREA CU. YDS.	
CUT	FILL
0	2235
0	2215
0	2551
0	1877
0	2784
8	1469
34	3320
18	3935
Sta. 37+89	34 5076

STA. 38+18 TO STA. 38+75.


Plot
chk.
Temp.
chk.
rears
chk.
ydg.
chk.

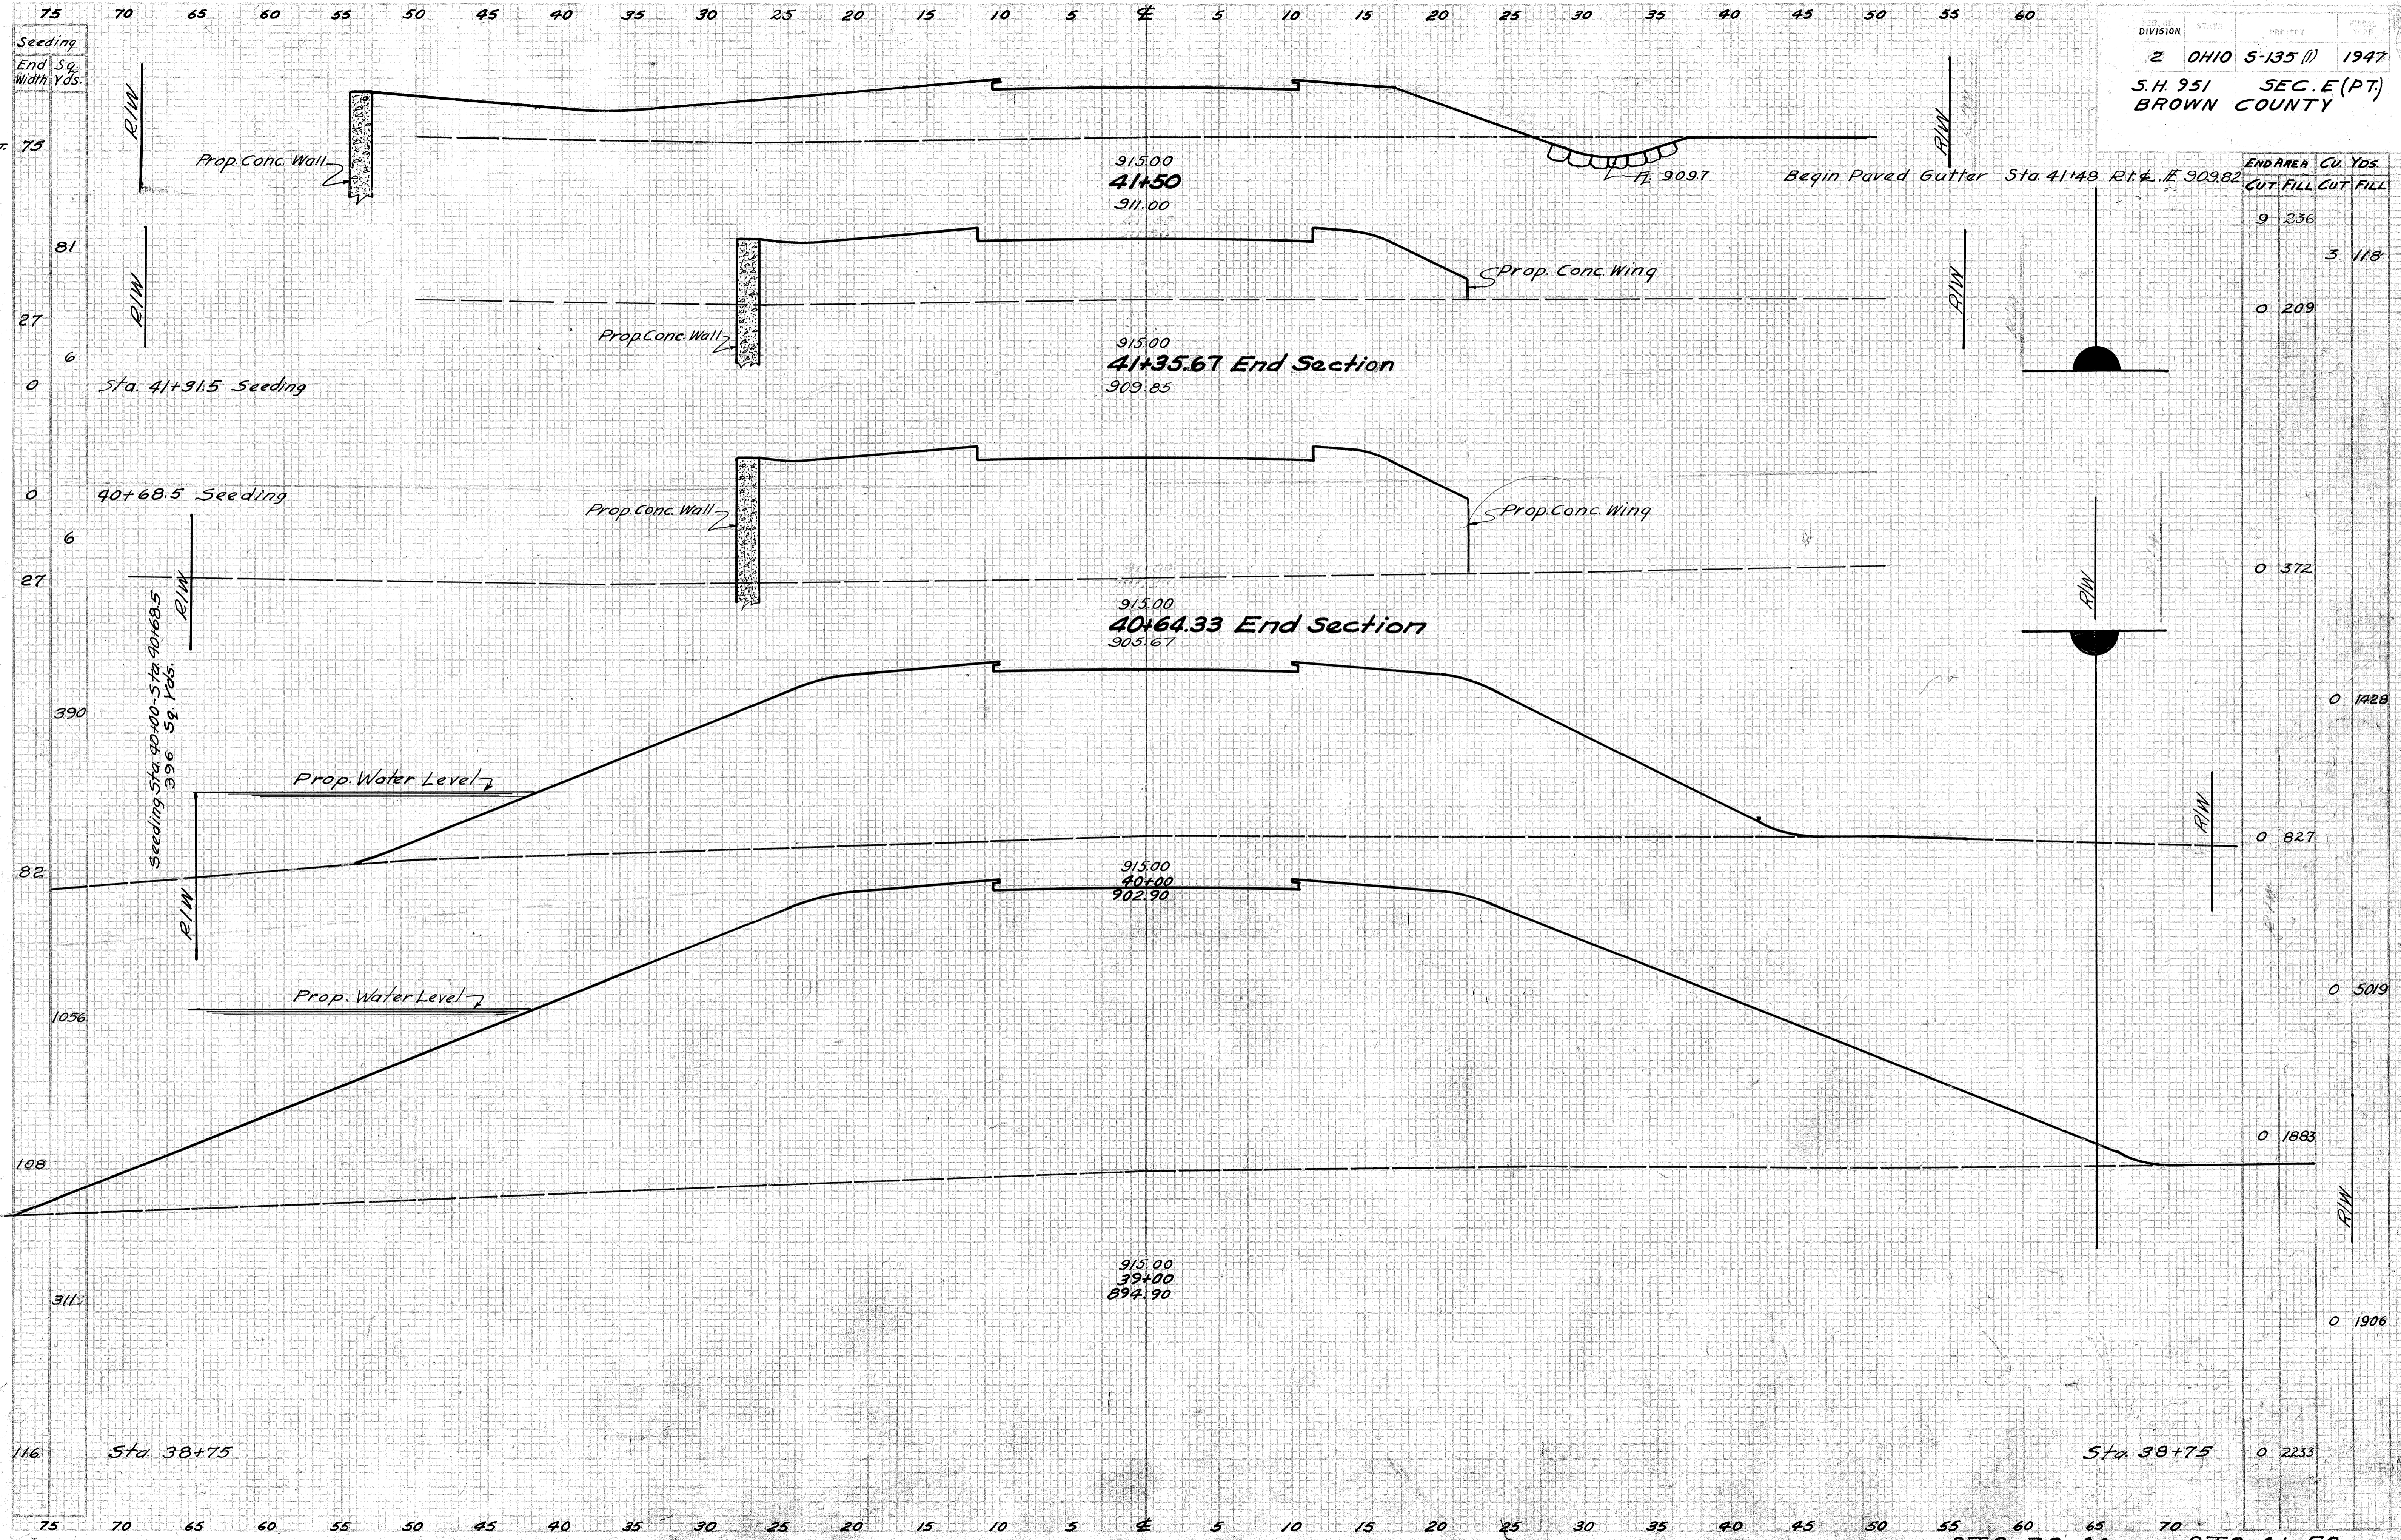

END AREA Cu. Yds.	
CUT	FILL

Seeding	End Sq. Width Yds.
---------	--------------------

END WORK STA. 63+02

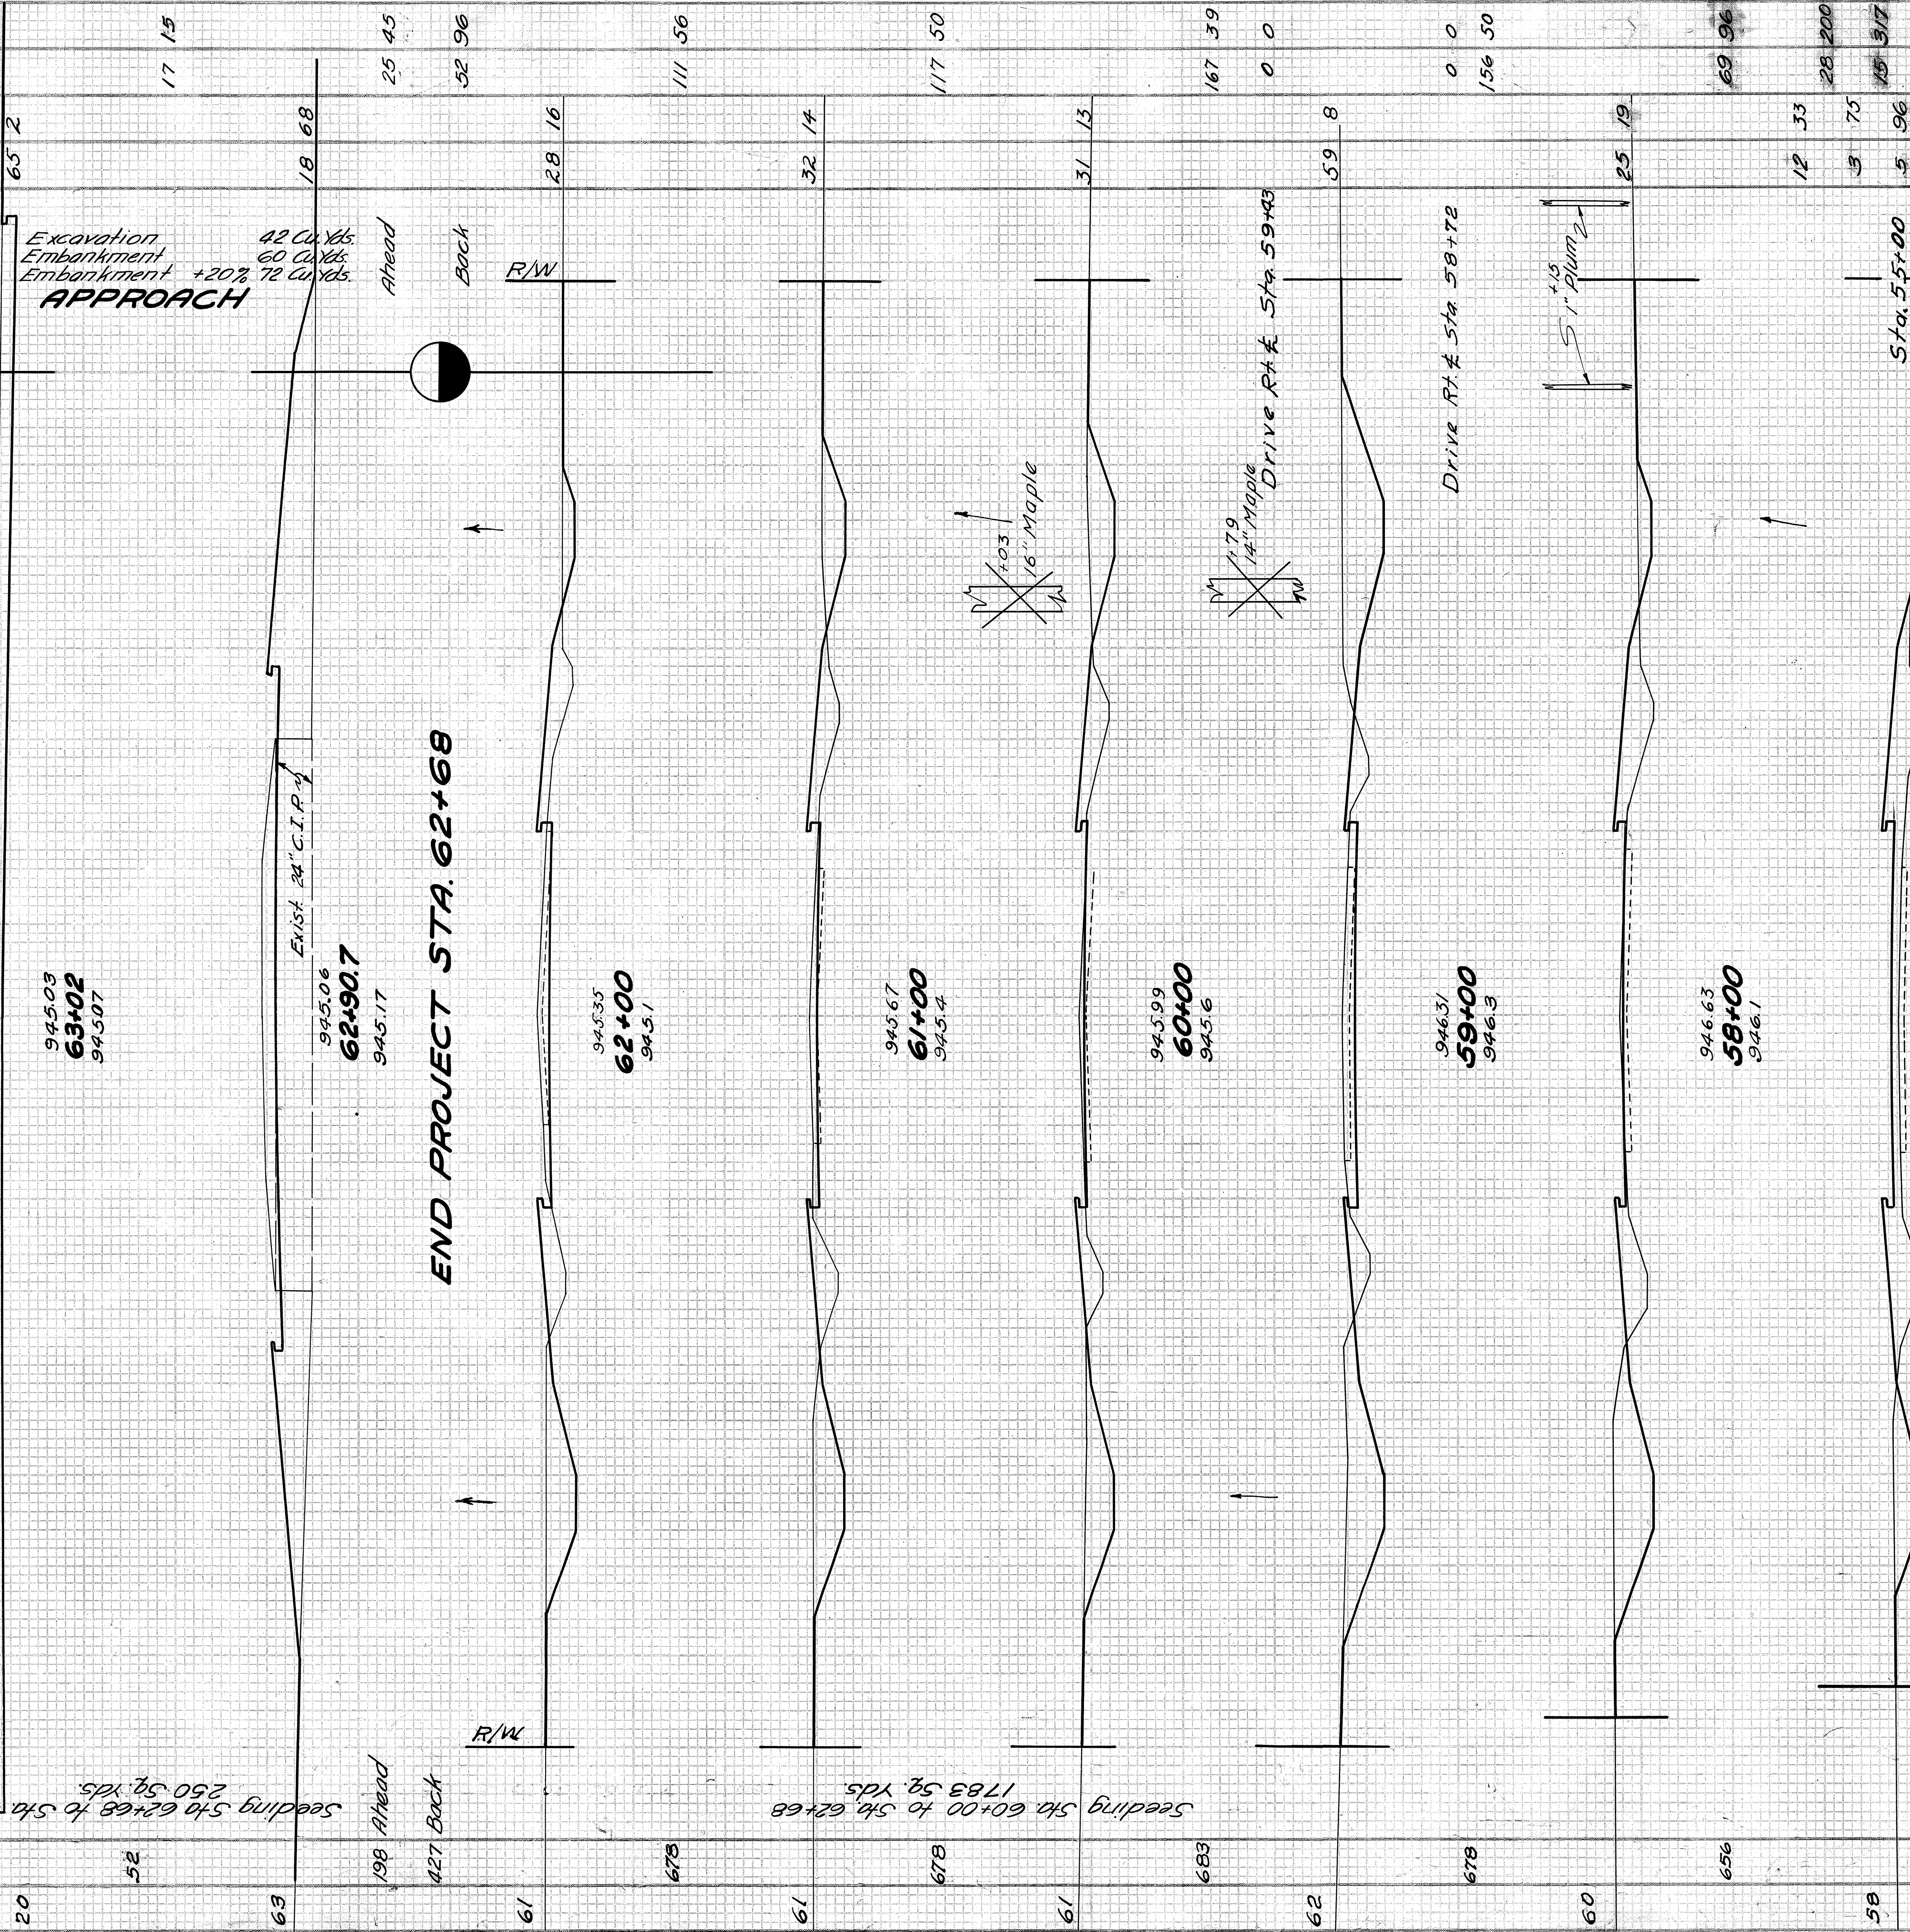

63	18	68	25	45	52	96	111	56	117	50	167	39	0	0	156	50	69	96	28	200	15	317
65	2																					

20	52	63	198	427	61	678	61	678	683	62	678	60	656	633	56	667	64
----	----	----	-----	-----	----	-----	----	-----	-----	----	-----	----	-----	-----	----	-----	----

29	44
----	----


SH. 951 SEC. E (PT)
BROWN COUNTY

STA 56+00 TO STA 63+02.

**BROWN COUNTY
S.H. 951 - SEC. E (PT)**

ESTIMATED QUANTITIES


Item E-1 Excavation (Carried to Rdwy Quantities)	3 Cu. Yds.
Embankment (Carried to Rdwy Quantities)	25 Cu. Yds.
Item T-32 Bituminous Road Mix Surface Course	53 Sq. Yds.
Item T-30 Bituminous Prime Coat	54 Sq. Yds.
Item F-17 Side Approaches, Mailbox Turnouts & Berm Mat'l.	14 Cu. Yds.
Item SS-112 8" Classified Embankment	54 Sq. Yds.
Item L-9.5 Seeding (Carried to Rdwy Quantities)	181 Sq. Yds.

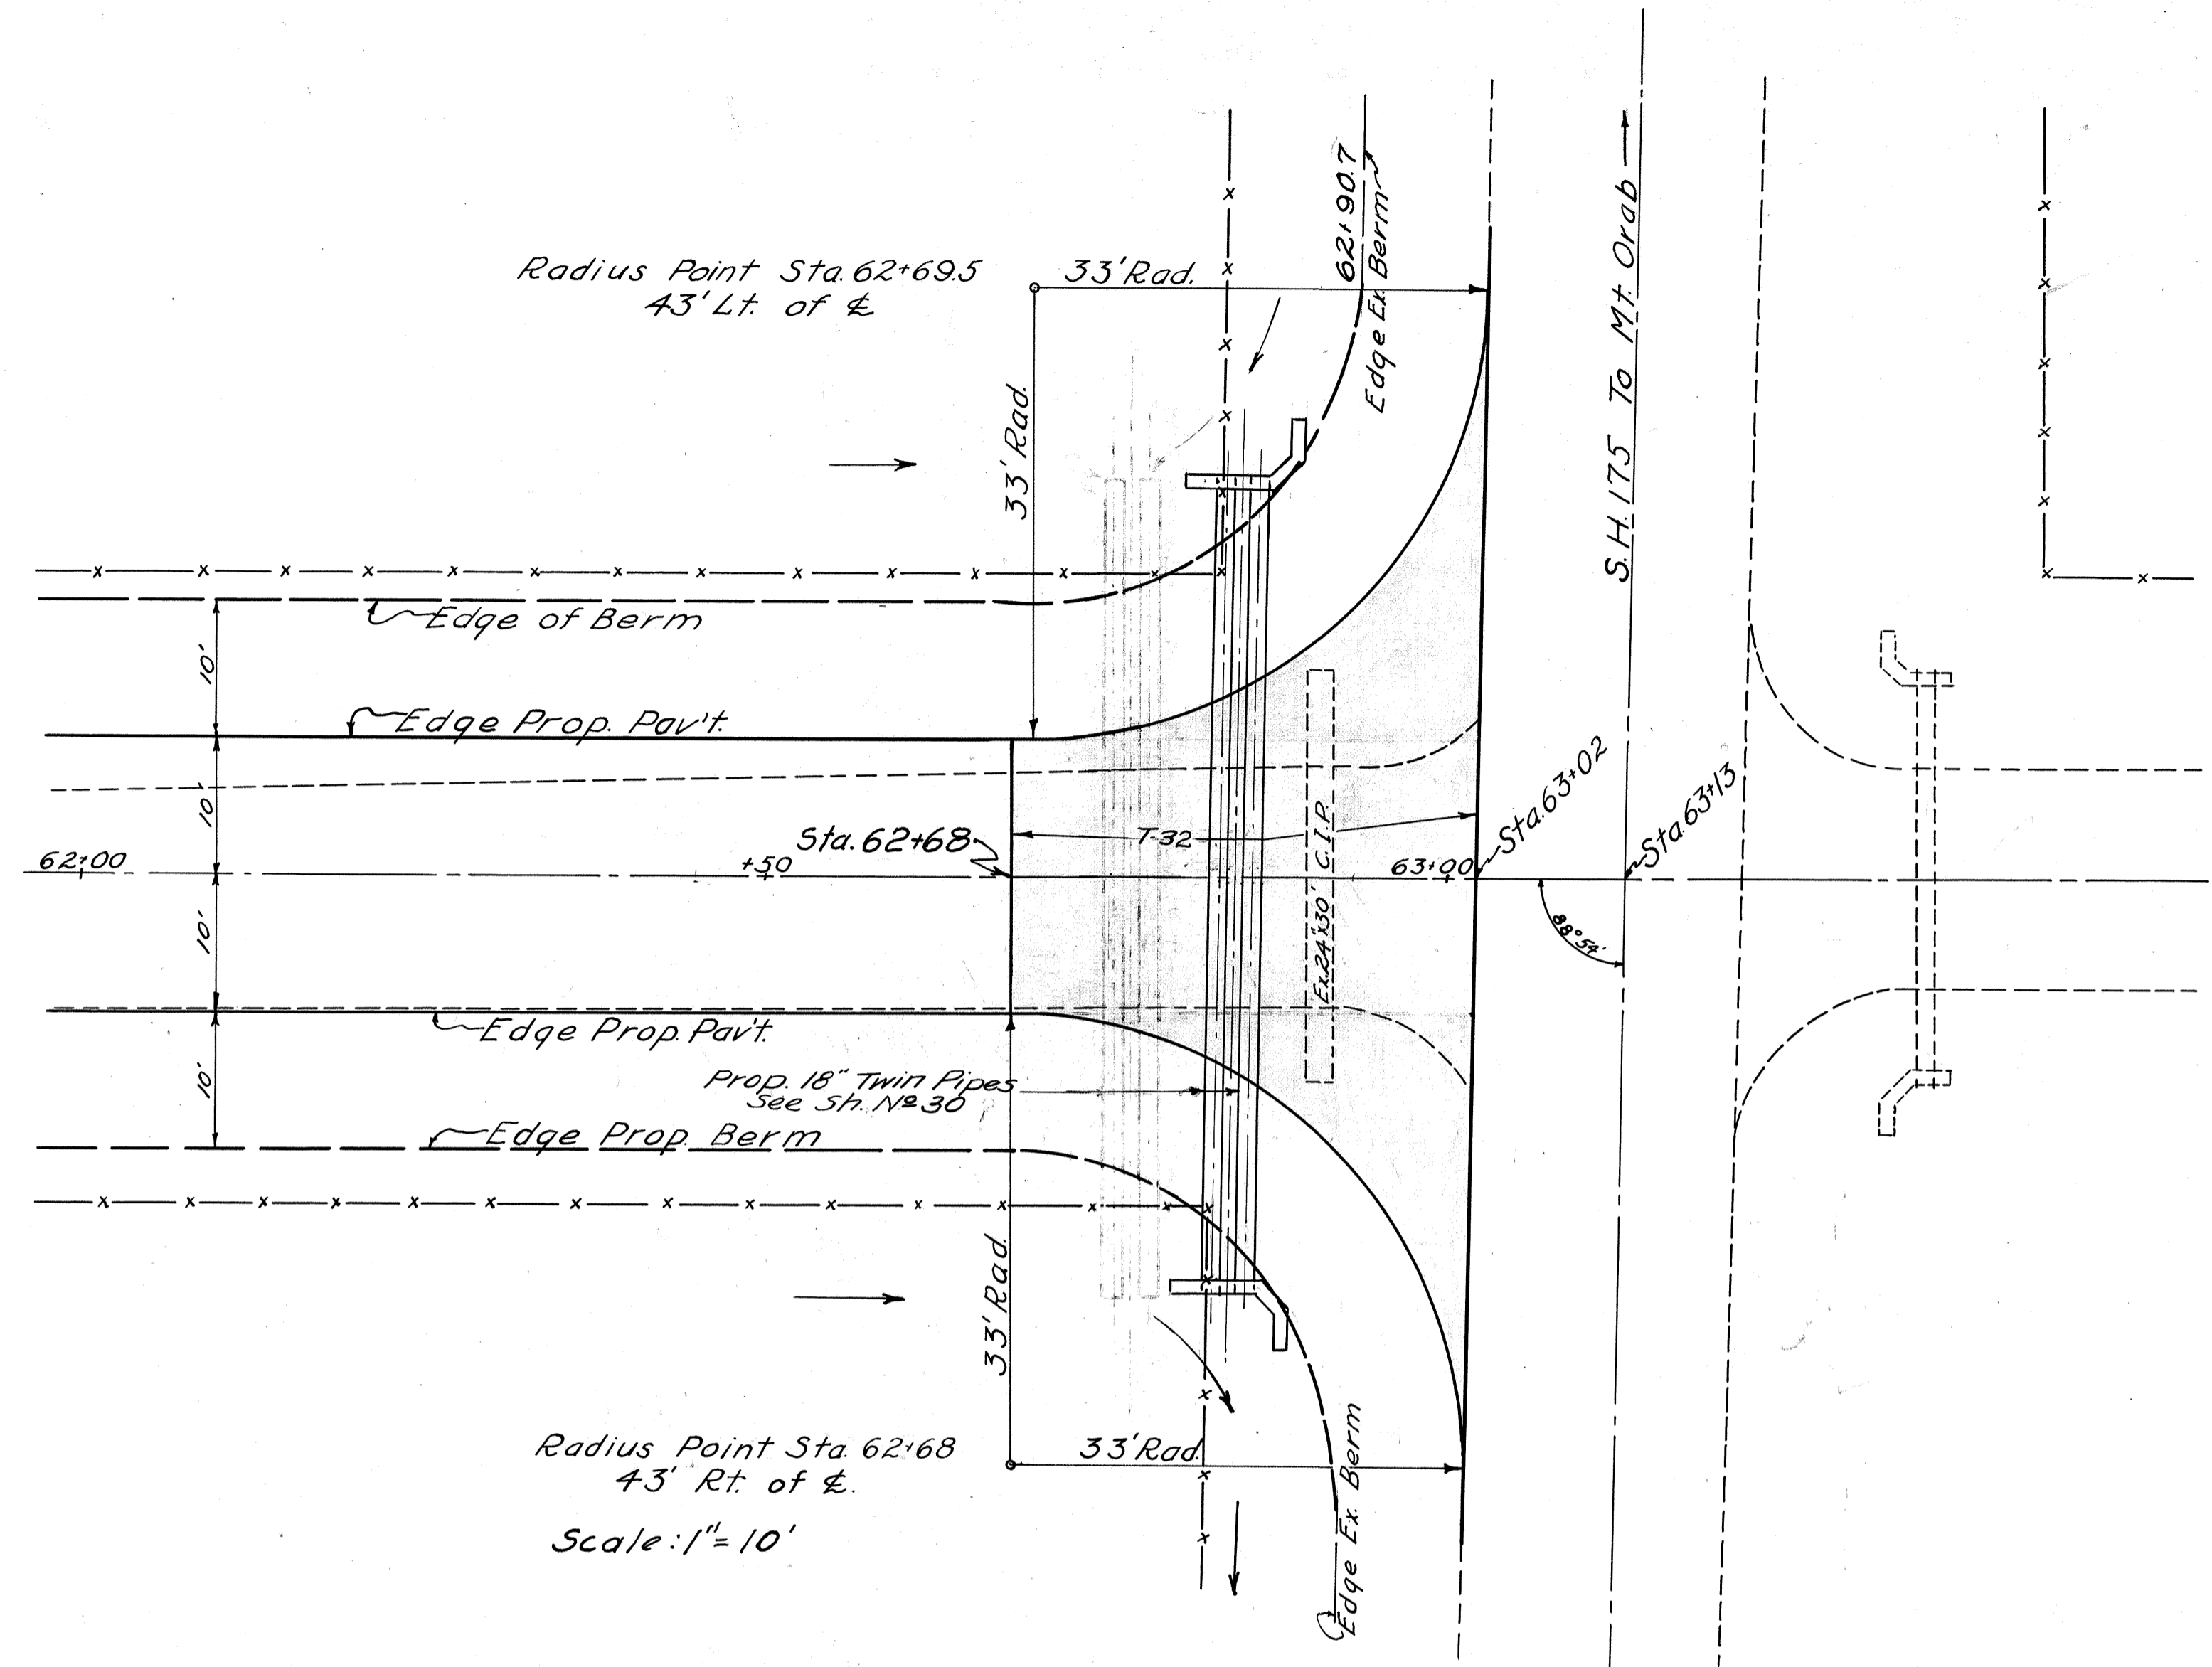


ESTIMATED QUANTITIES

Item T-32 Bituminous Road Mix Surface Course	127	Sq. Yds.
Item T-30 Bituminous Prime Coat	133	Sq. Yds.
Item SS-112 8" Classified Embankment	133	Sq. Yds.

DETAIL ROAD APPROACH STA. 63+02.

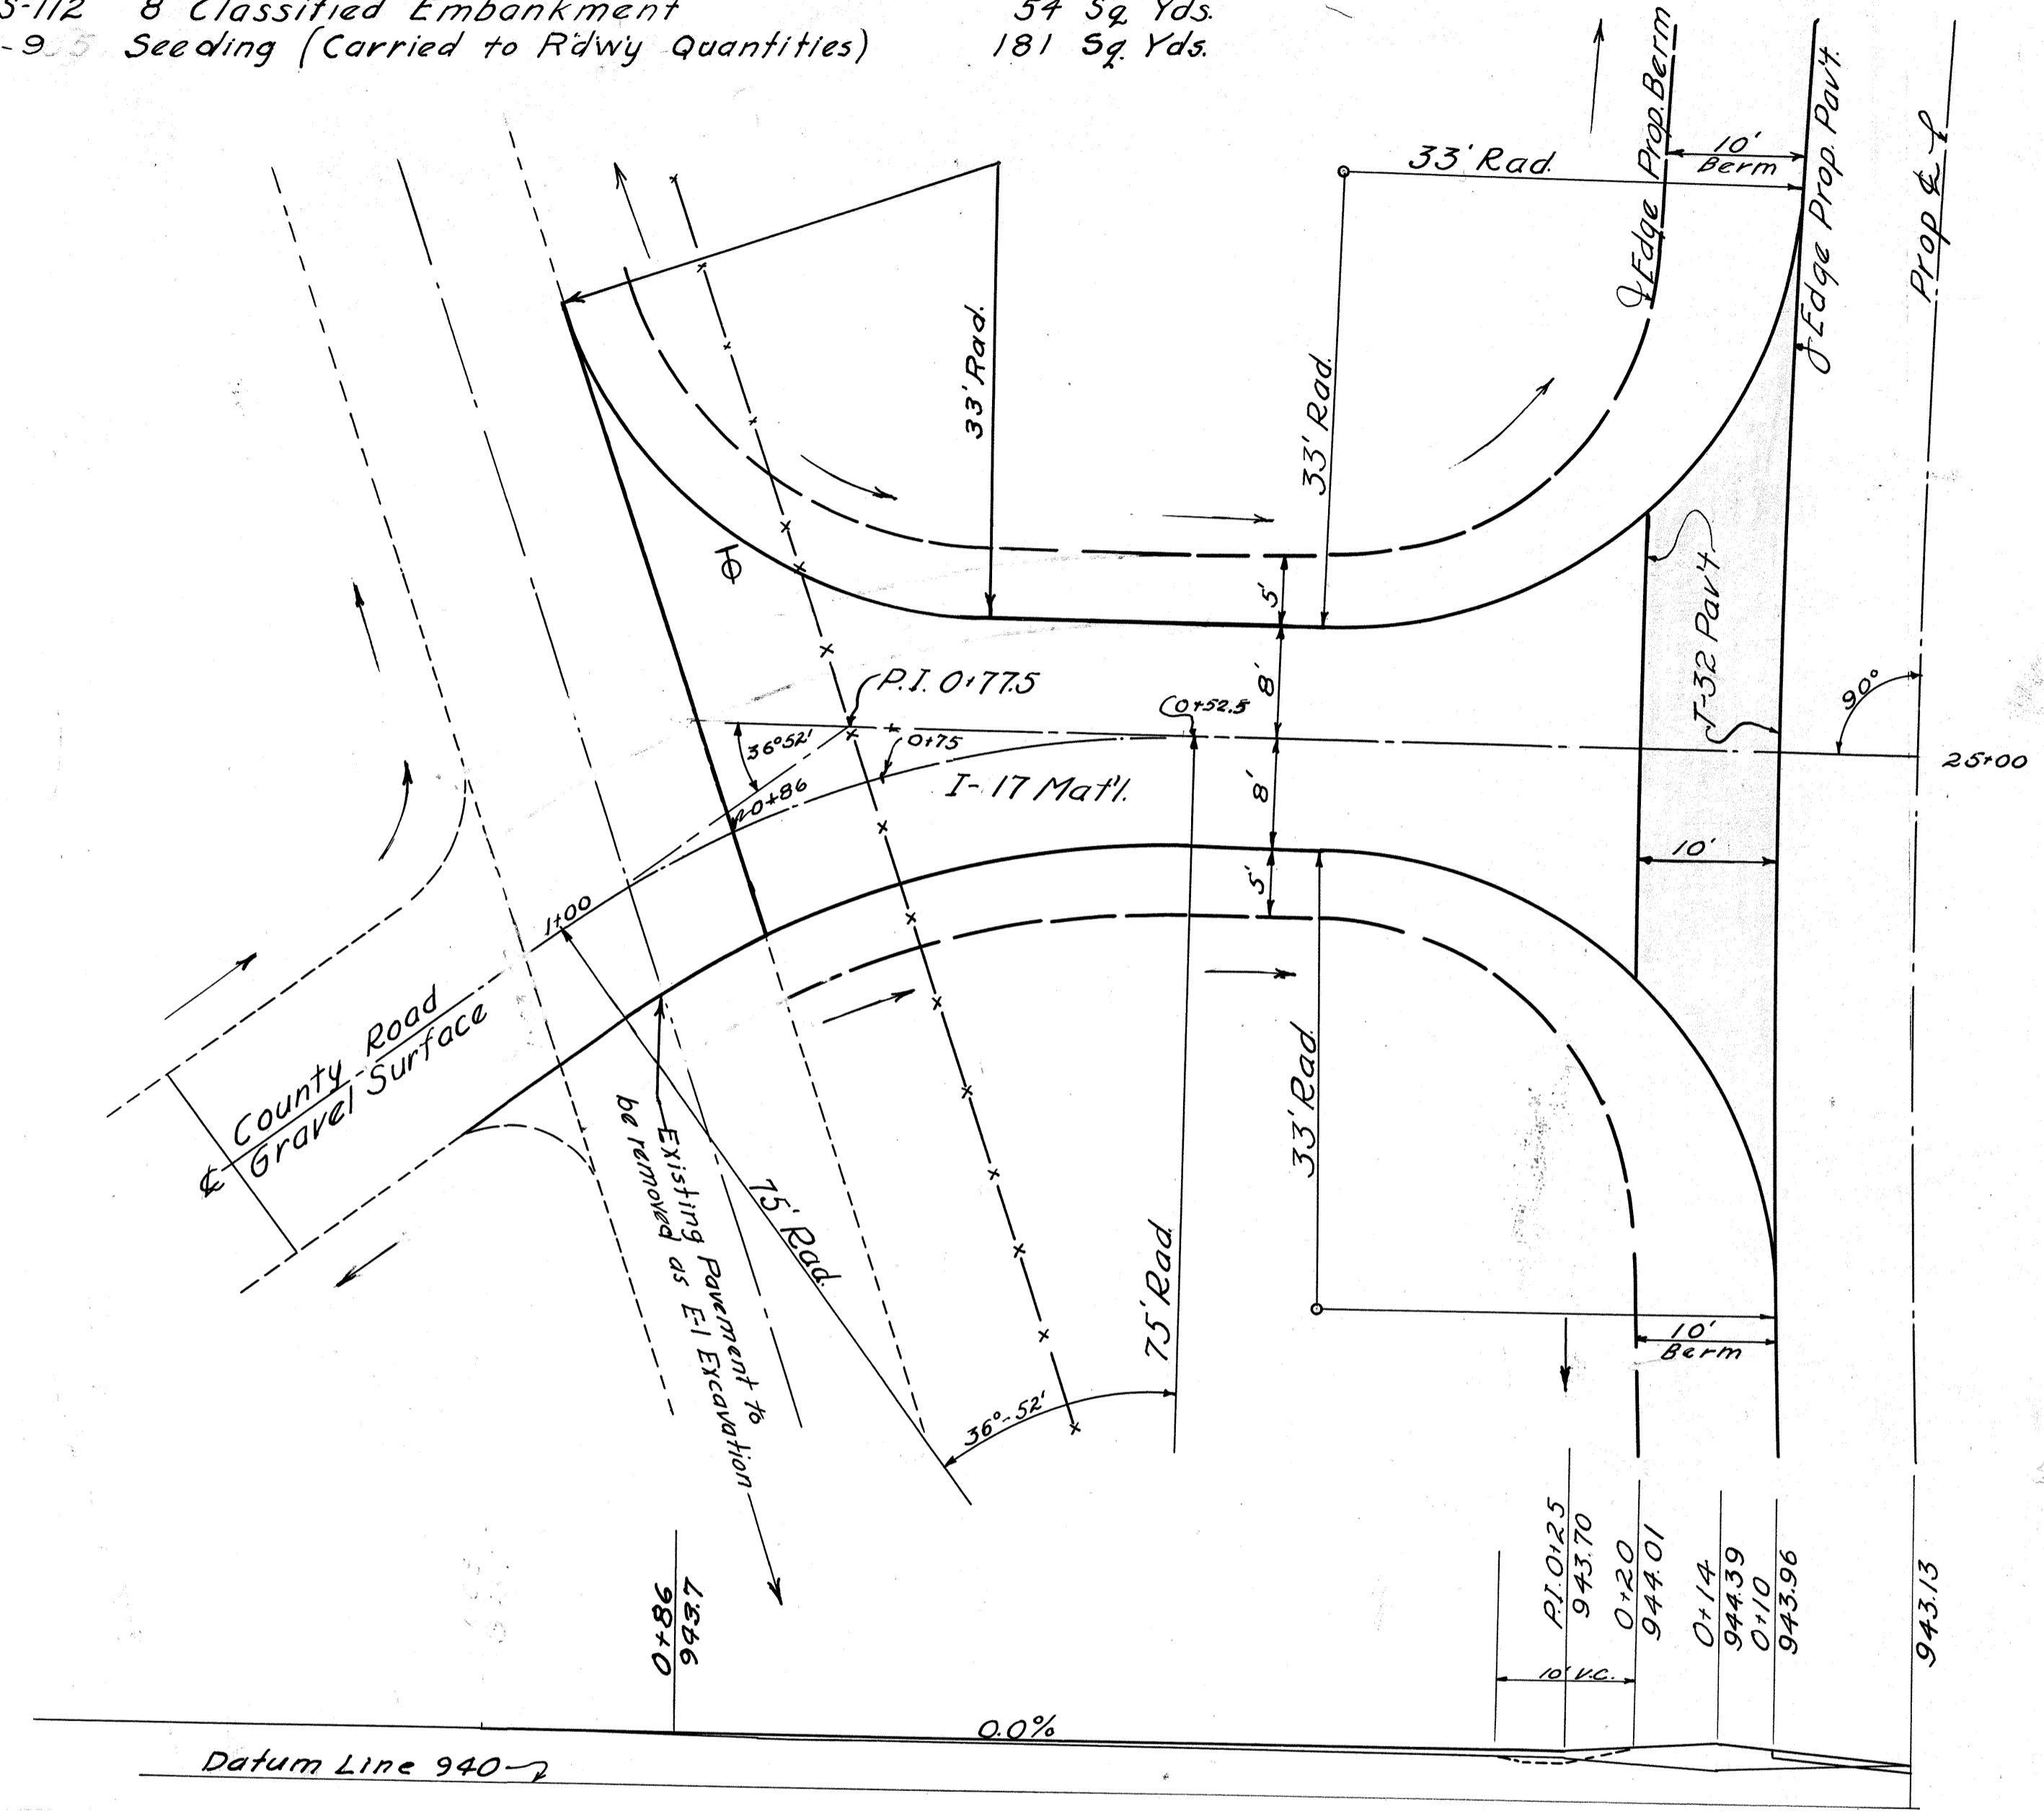


Seeding	End Area	Sq. Yds.
20	543.0	
30	75	
30	75	
30	0+30	
Total		181 Sq. Yds.

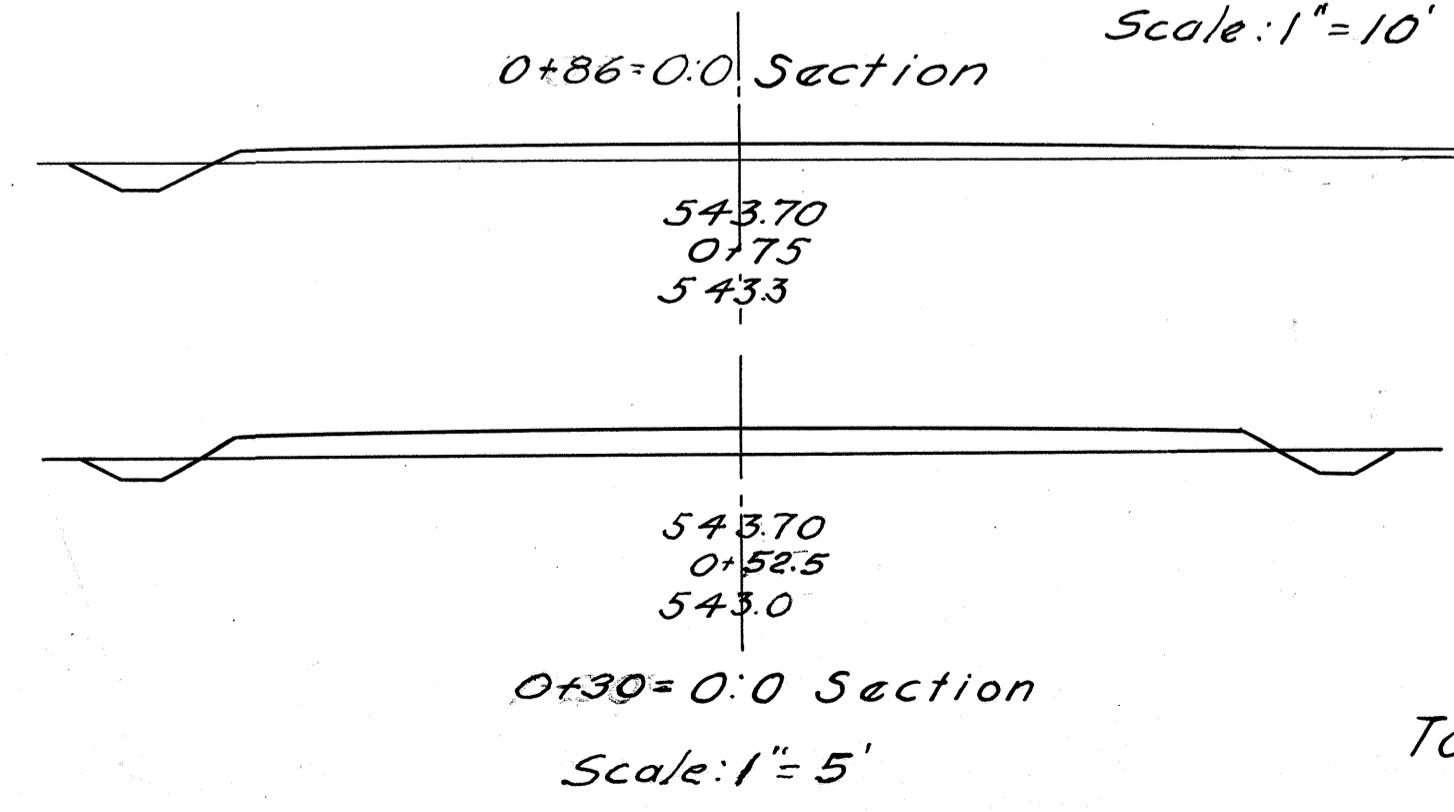

End Area	Cu. Yds.		
Cut	Fill	Cut	Fill
0	0	0	2
1	11	2	12
2	18	1	7
0	0		
Total		3	27

COUNTY ROAD APPROACH STA. 25+00 Lt. ϵ .

BR. NO. BR-774-106
STERLING RUN

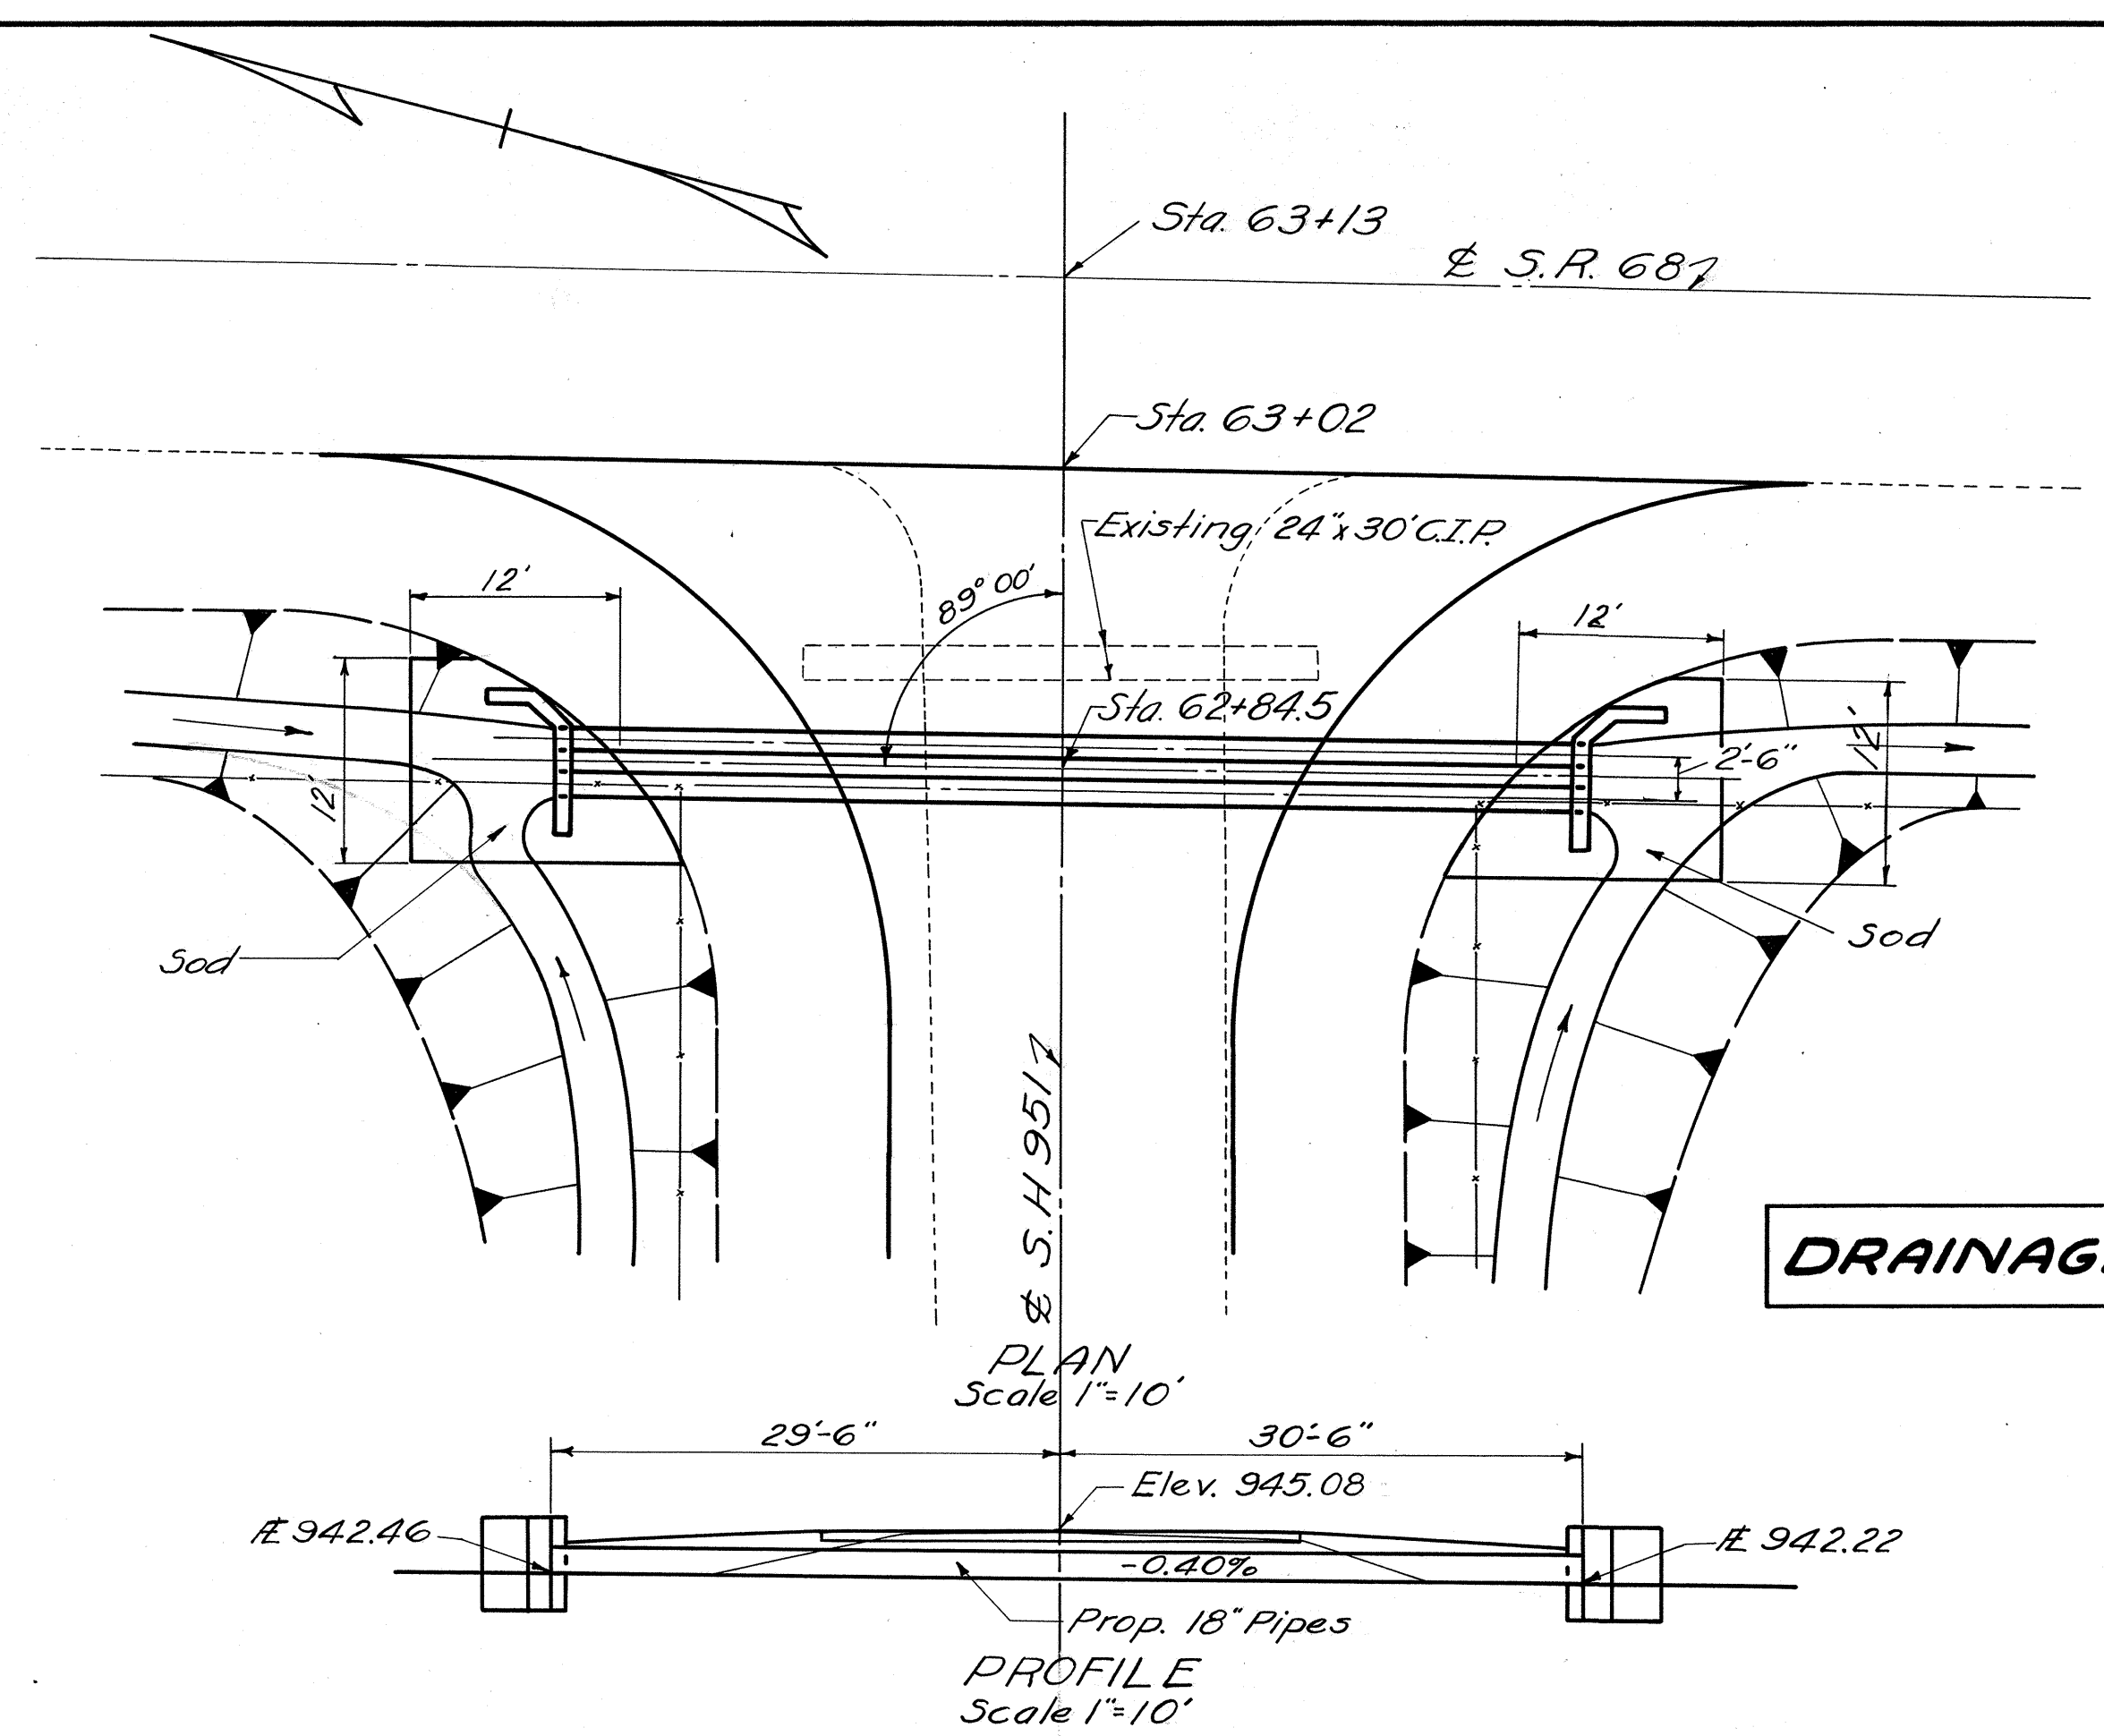

DRAINAGE AREA 30 ACRES


ESTIMATED QUANTITIES

Item E-2	Excavation for Structures	27	Cu.Yds.
Item E-12	24" C.I.P. Removed and Stored	30	Lin. Ft.
Item L-10	Sodding	32	Sq. Yds.
Item S-1	Concrete for Structure (Class "C")	3.8	Cu. Yds.
Item S-4	Reinforcing Steel	93	Lbs.
Item S-27	18" Pipe for Roadway Culverts	120	Lin. Ft.

CULVERT DATA


TYPE: Twin Pipe
 SIZE: 18" x 60'
 WORK REQUIRED: Build two standard 18" x 60' Pipe Culverts in Battery with standard Side Road Culvert Headwalls (Modified). See standard Drawings S-27-PC-3 and S-27-PC-1. Remove and Store existing 24" x 30' Cast Iron Pipe

"D" Diameter of Pipe	QUANTITIES IN TWO HEADWALLS										
	"L-1"	"L-2"	"H"								
	No.	Length	No.	Length	No.	Length	Lbs.	Cu.Yds.			
18"	6'-3"	2'-9"	5'-0"	2	11'-0"	2	12'-0"	18	4'-6"	93	3.8

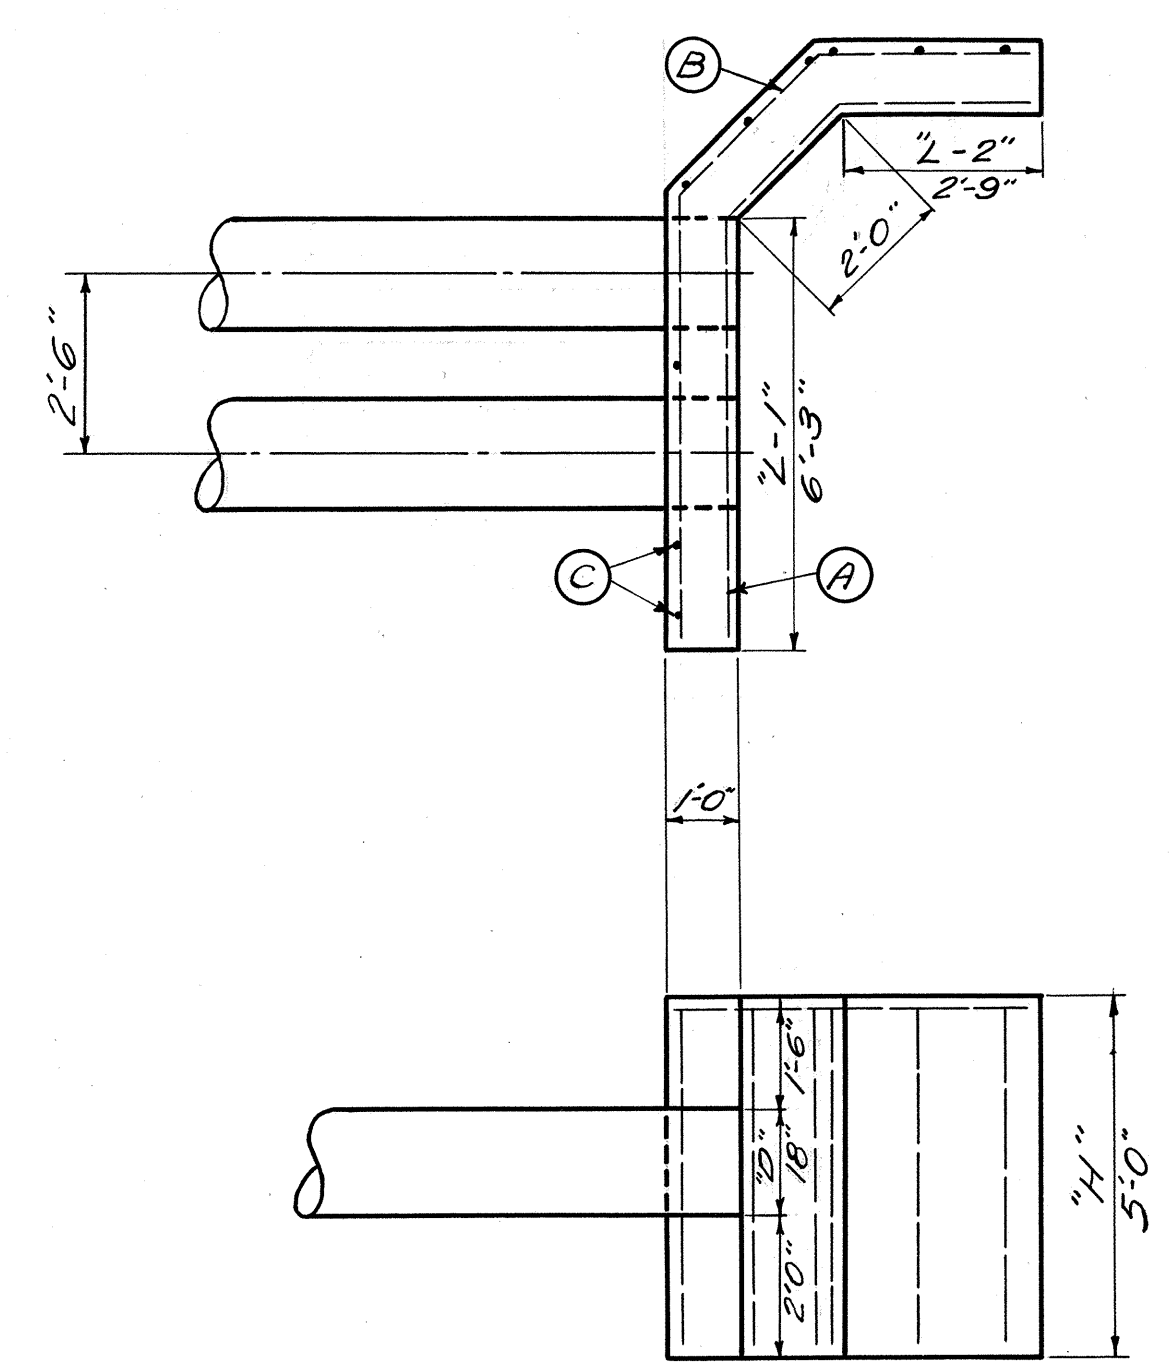


DETAIL OF SIDE ROAD CULVERT (MODIFIED)

PIPE CULVERT STA. 62+84.5

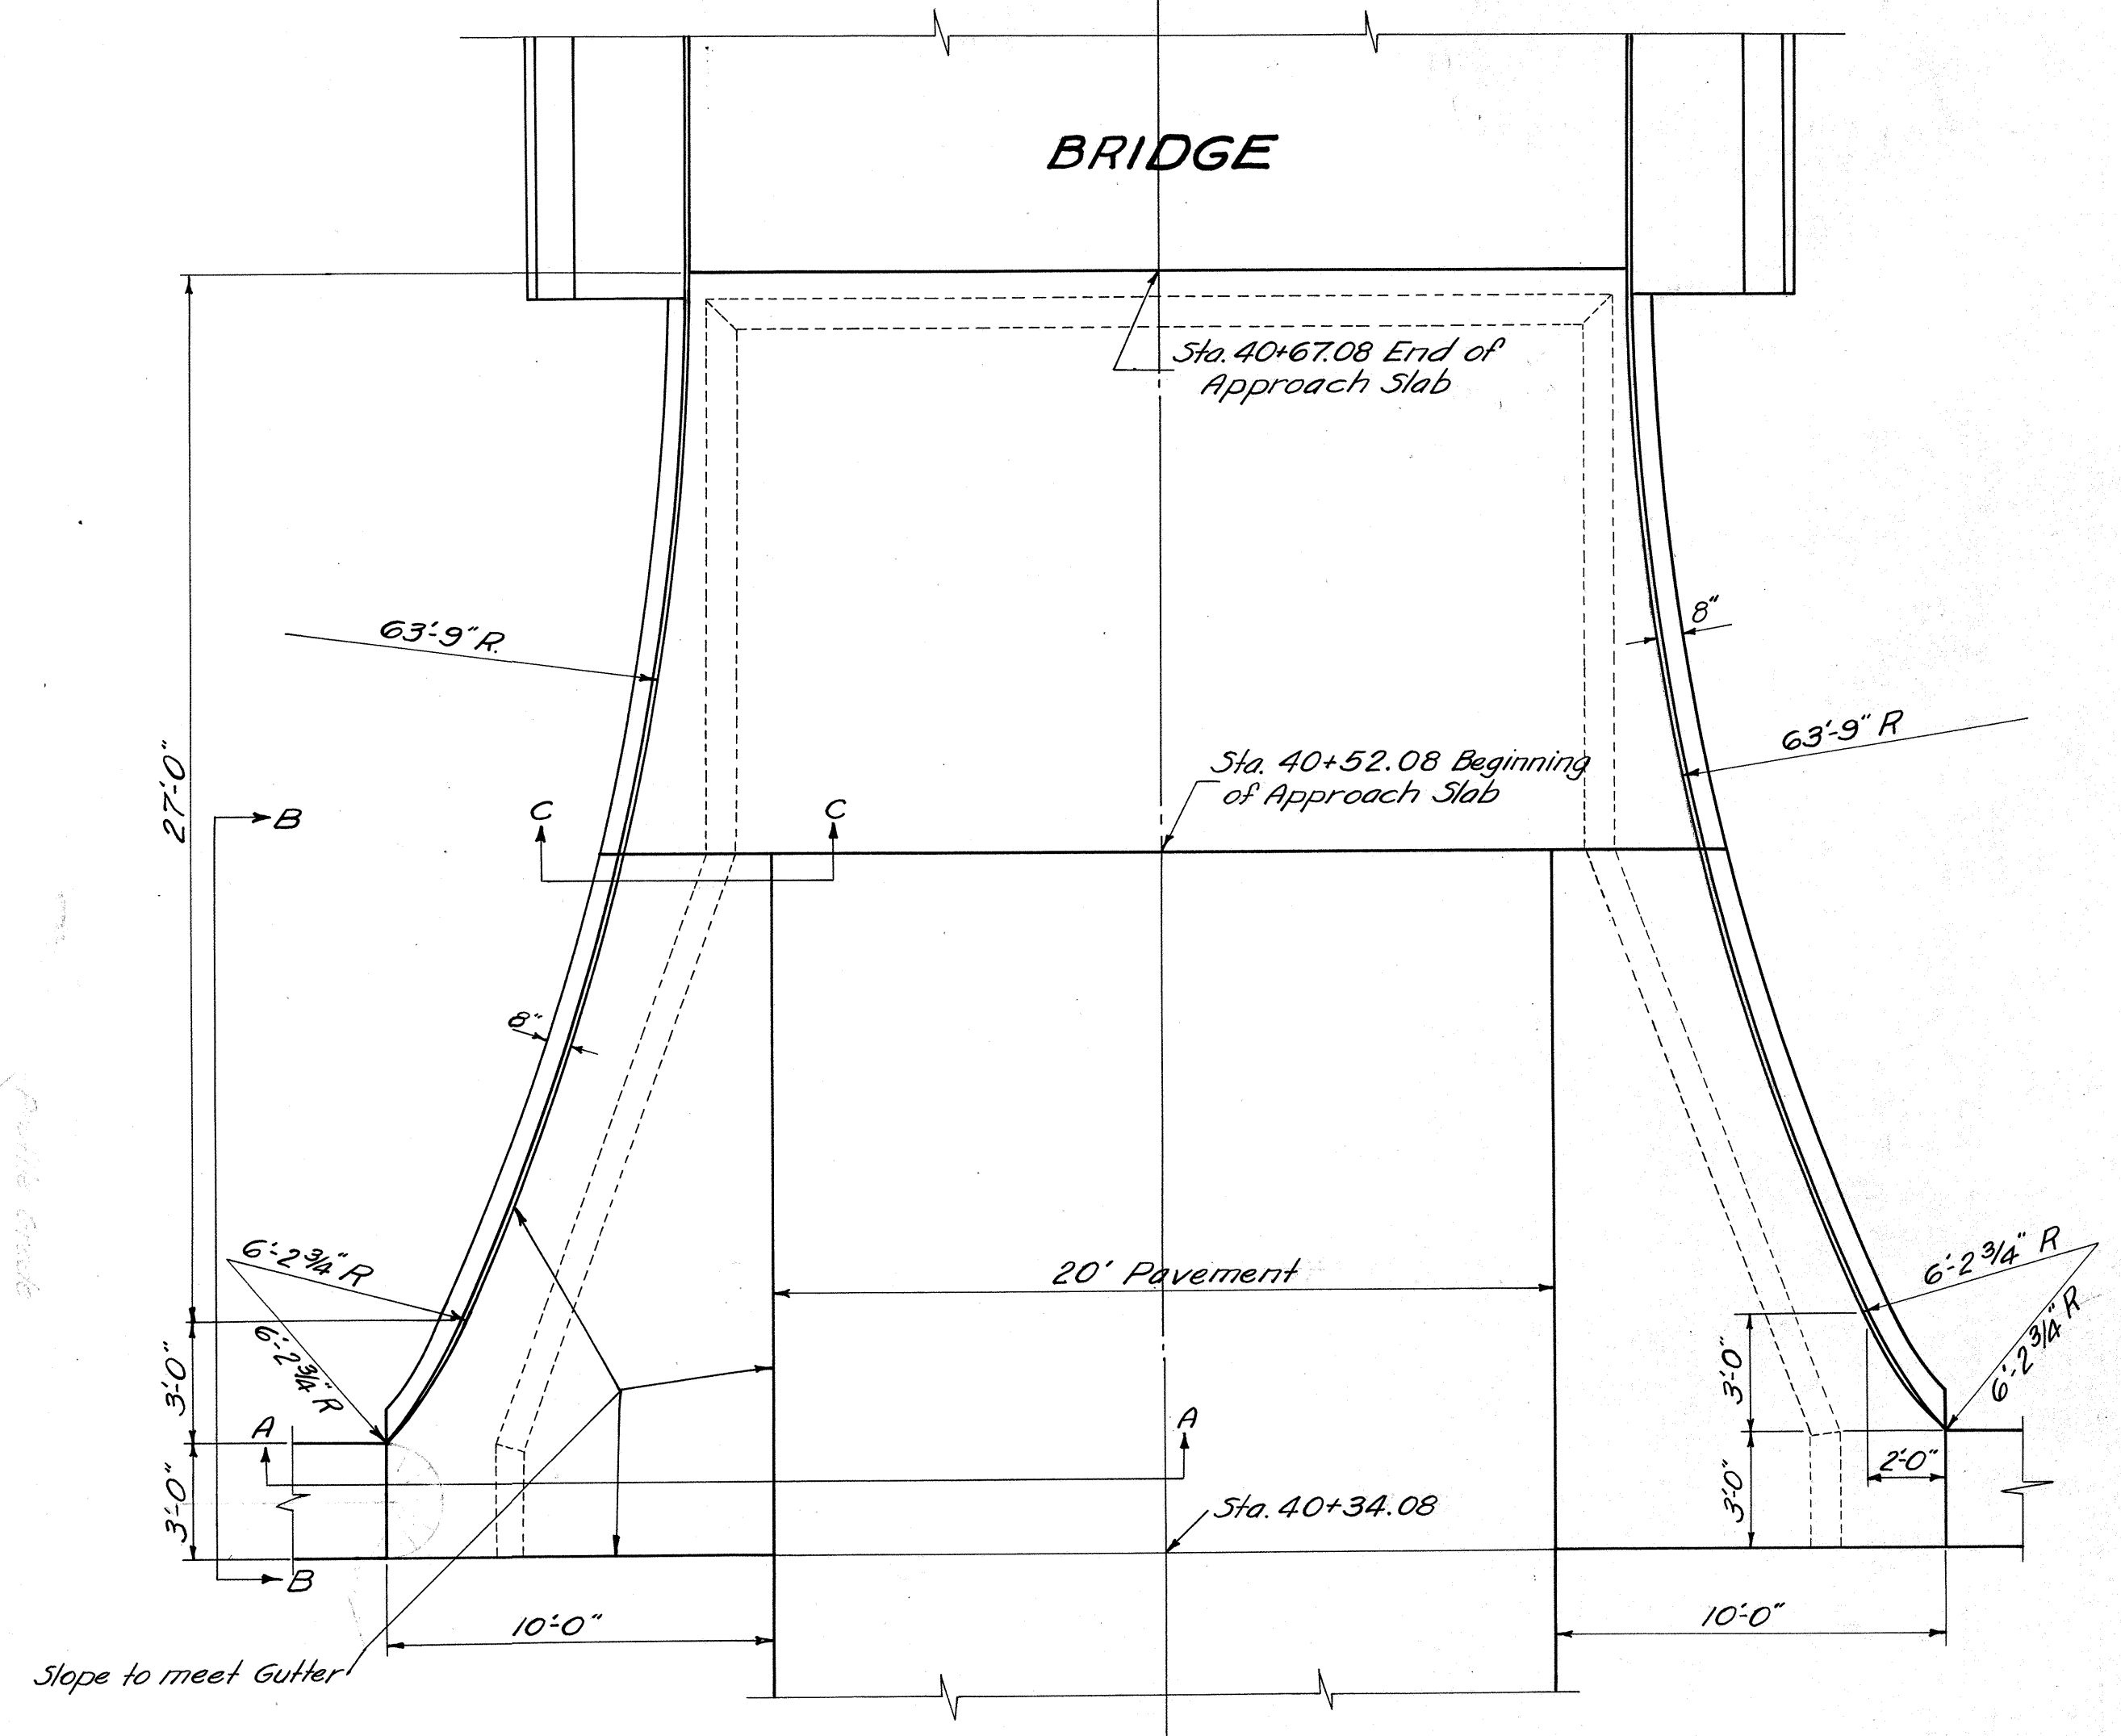


DETAIL OF APPROACH GUTTERS
Scale 1/4" = 1'-0"


Notes:
 Height of Curb varies from height of Bridge Curb at Bridge to 3" at end of Gutter.
 See Std. Dwg. AS-44-F (Rev. 1-18-46)
 All Gutter Slabs similar.
 Make smooth transition from flat slope to fit crown at beginning of Approach Slab

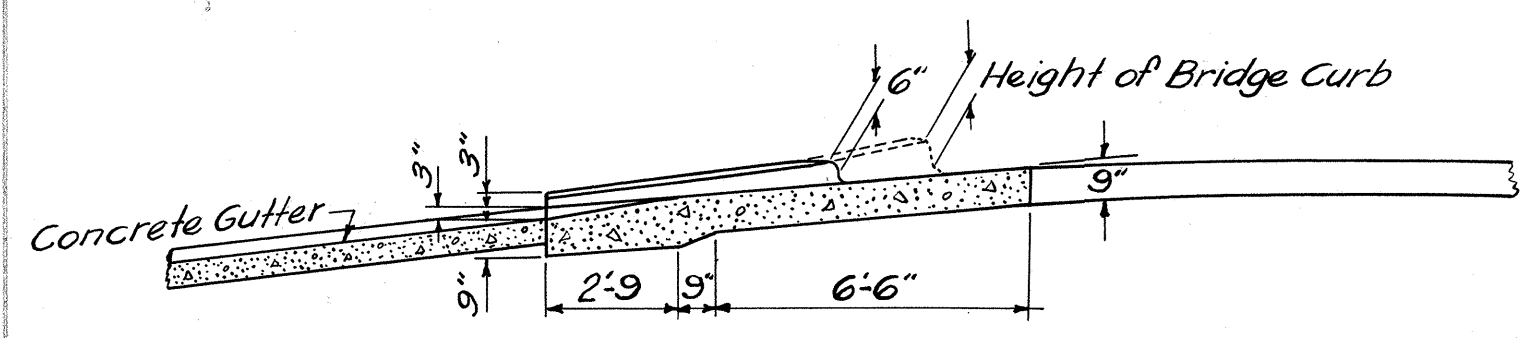

SECTION A-A
Scale 1/4" = 1'-0"

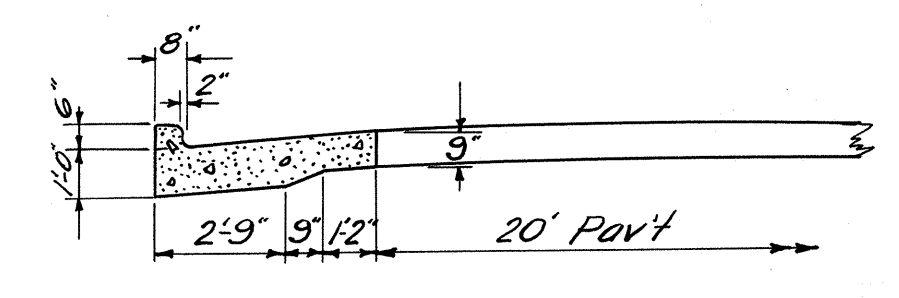

SECTION C-C
Scale 1/4" = 1'-0"

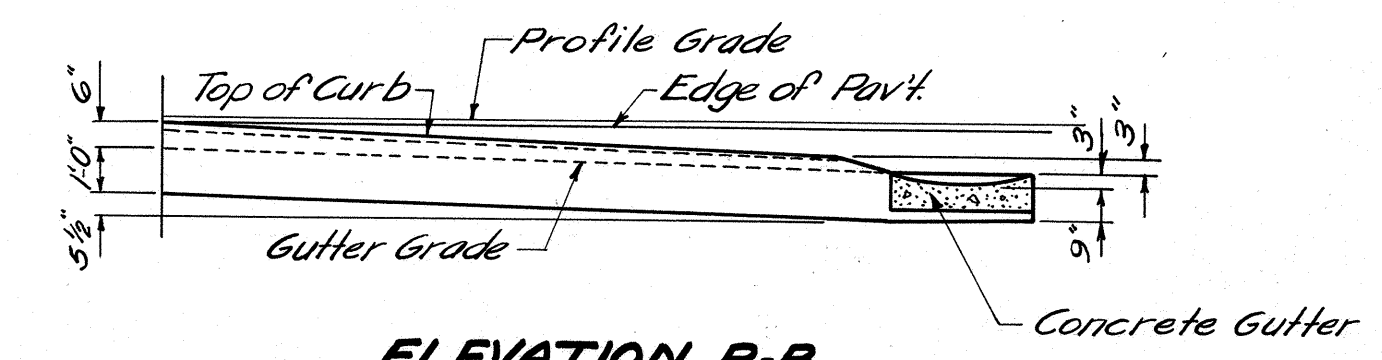

ELEVATION B-B
Scale 1/4" = 1'-0"

DETAIL OF CONCRETE APPROACH GUTTERS


EXISTING STRUCTURE

Old masonry abutments and temporary bridge. (To be Removed)
 LOAD: S-15-40
 SKEW: None
 FLOOR: 3" bituminous
 ALIGNMENT: No skew, curved approaches.


FED. RD. DIV. NO.	STATE	PROJECT	FISCAL YEAR
2	OHIO	S-135(1)	1947

32
44

S.H. 951 SEC. E (PT.)
 BROWN COUNTY
 7.4 mi. ± N. of Hamersville
 2.5 ± mi. S. of Mt. Orab

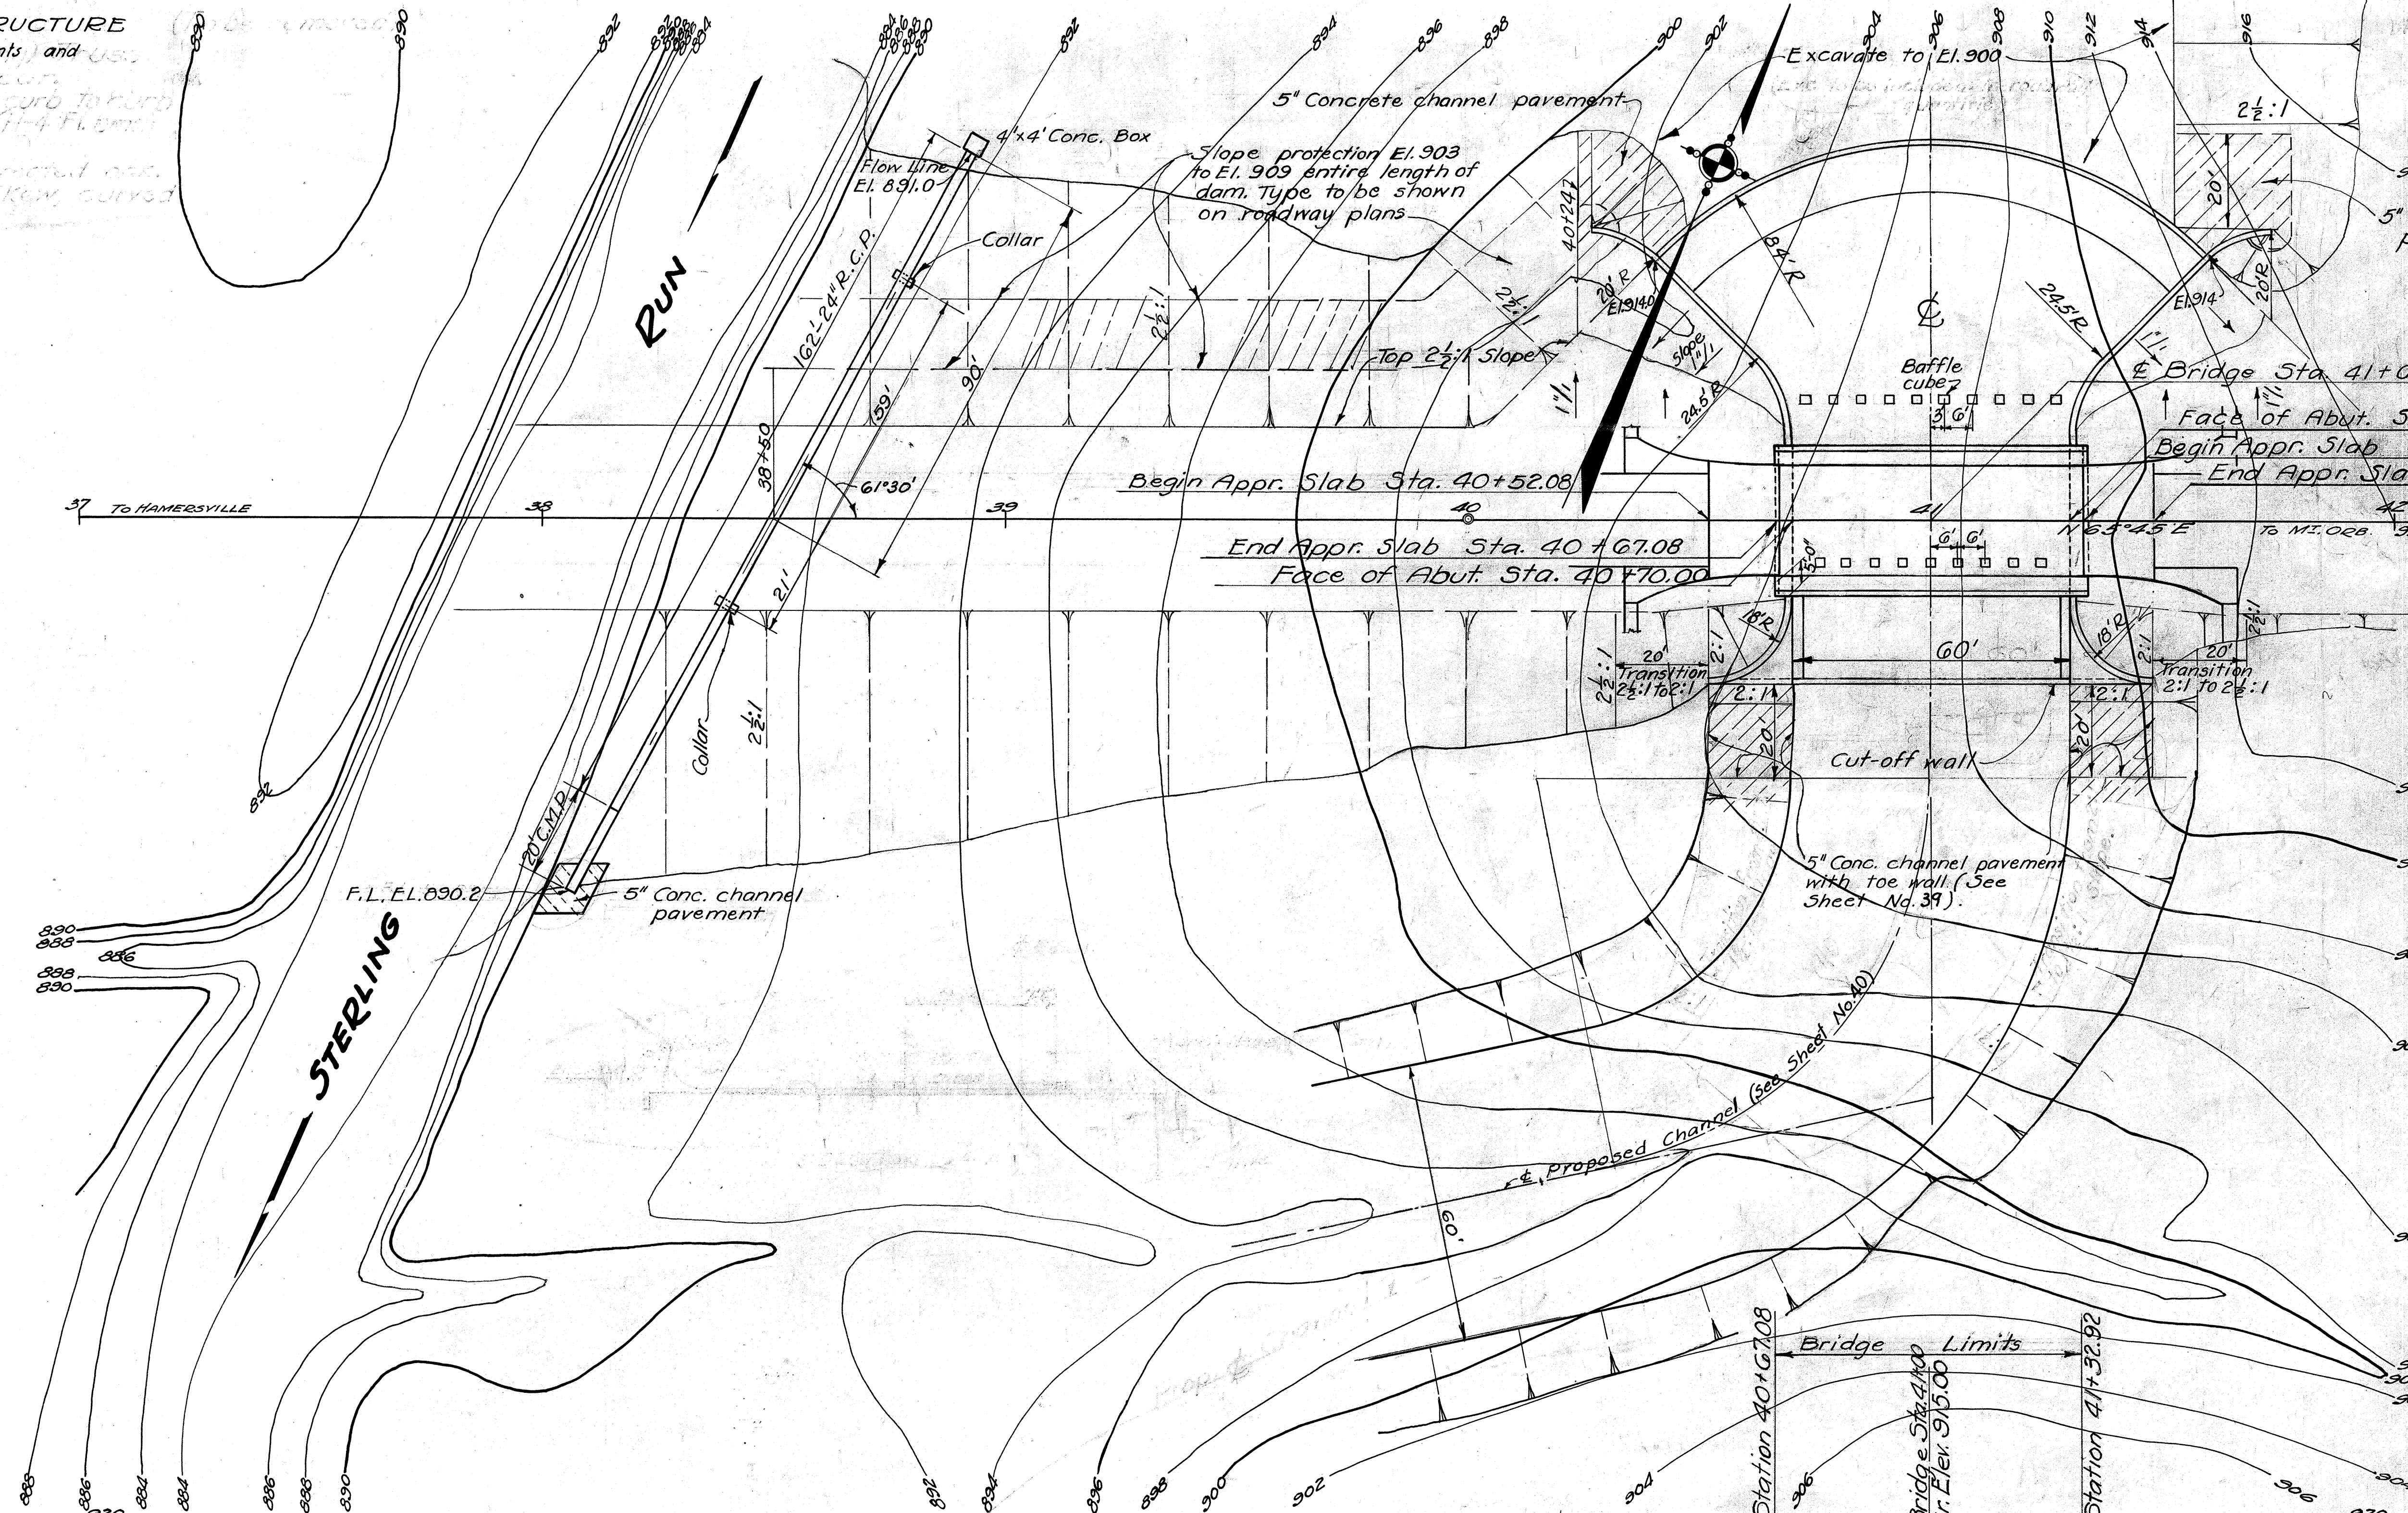

PROPOSED STRUCTURE
 TYPE: Concrete rigid frame.
 SPAN: 60' clear.
 ROADWAY: 24' plus two 3'-0" sidewalks.
 LOADING: S-15-40.
 SKEW: None.
 Surf. Course: Bituminous.
 APPR. SLABS: 15' long (A5-44-F, type II.)







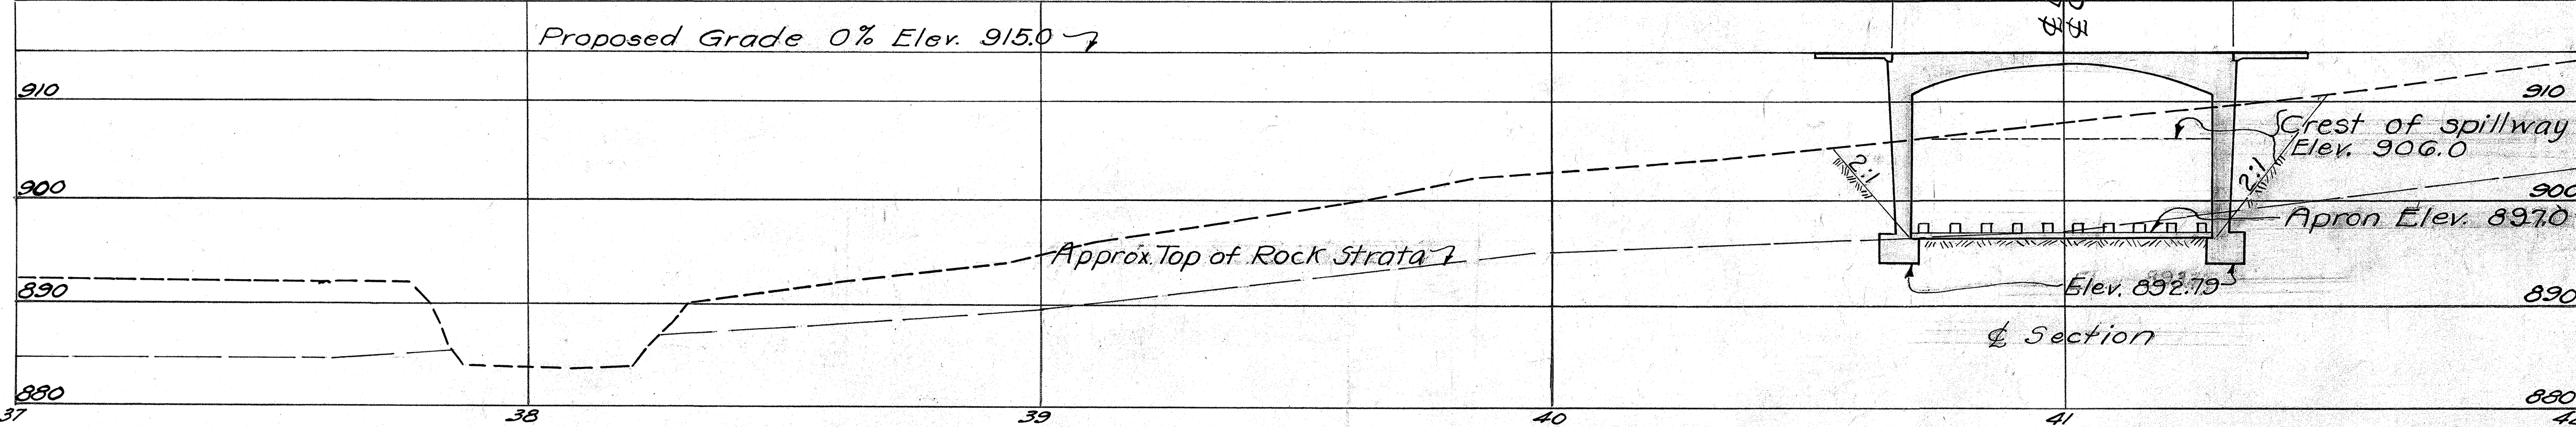


DRAINAGE AREA 27 Sq. Mi.

SITE PLAN
 BR. NO. BR-774-106
STERLING RUN
 S.H. NO. 951 SECTION E
 BROWN COUNTY
 STATE OF OHIO
 SCALE 1"=20' STATION 41+00


PRESENT WORK	PROPOSED WORK
DESIGNED BY C.H.A. mcb	DRAWN BY C.F.B. BTG

REVISED 4-1-47
 REV. 11-29-46

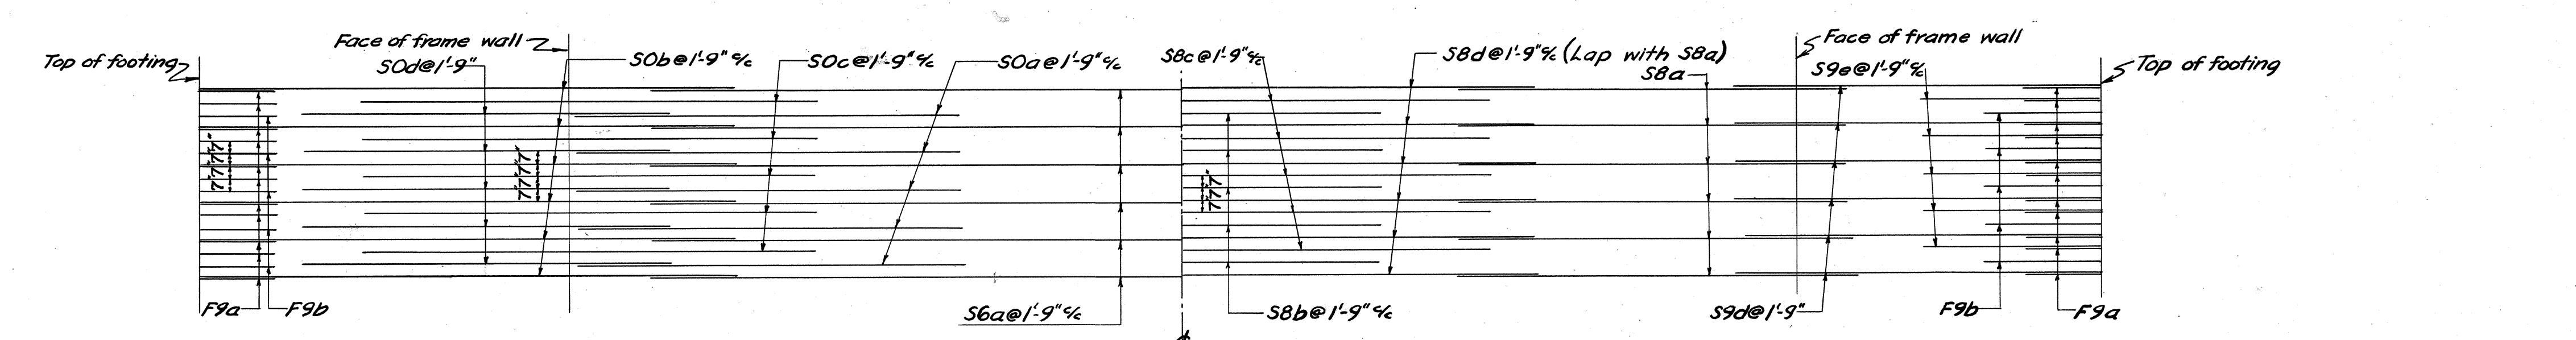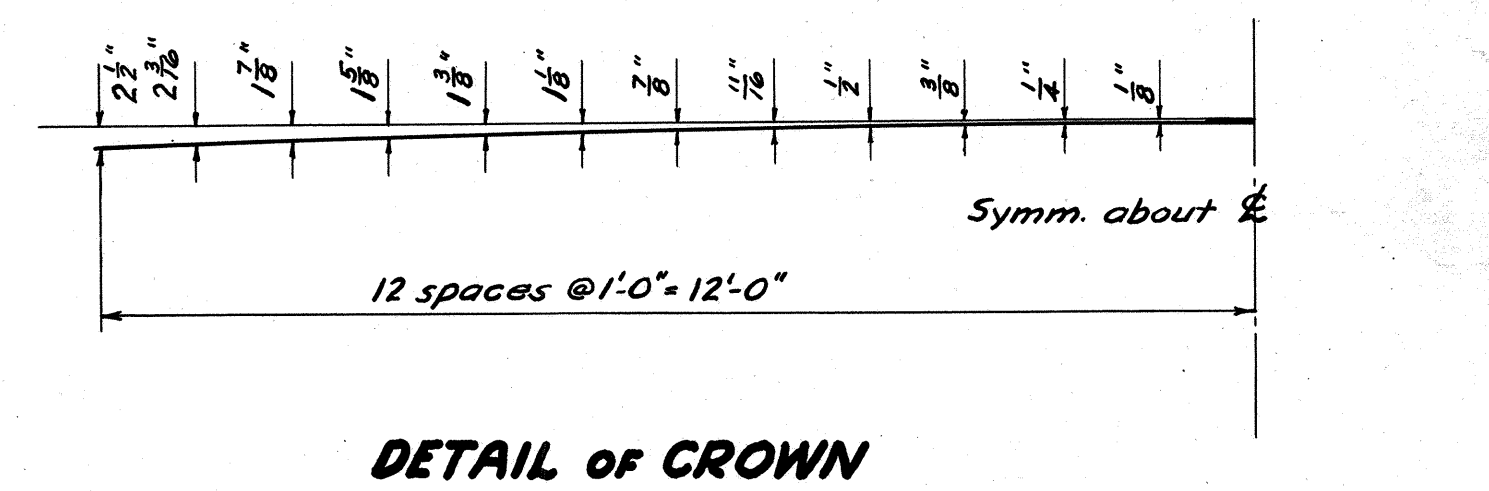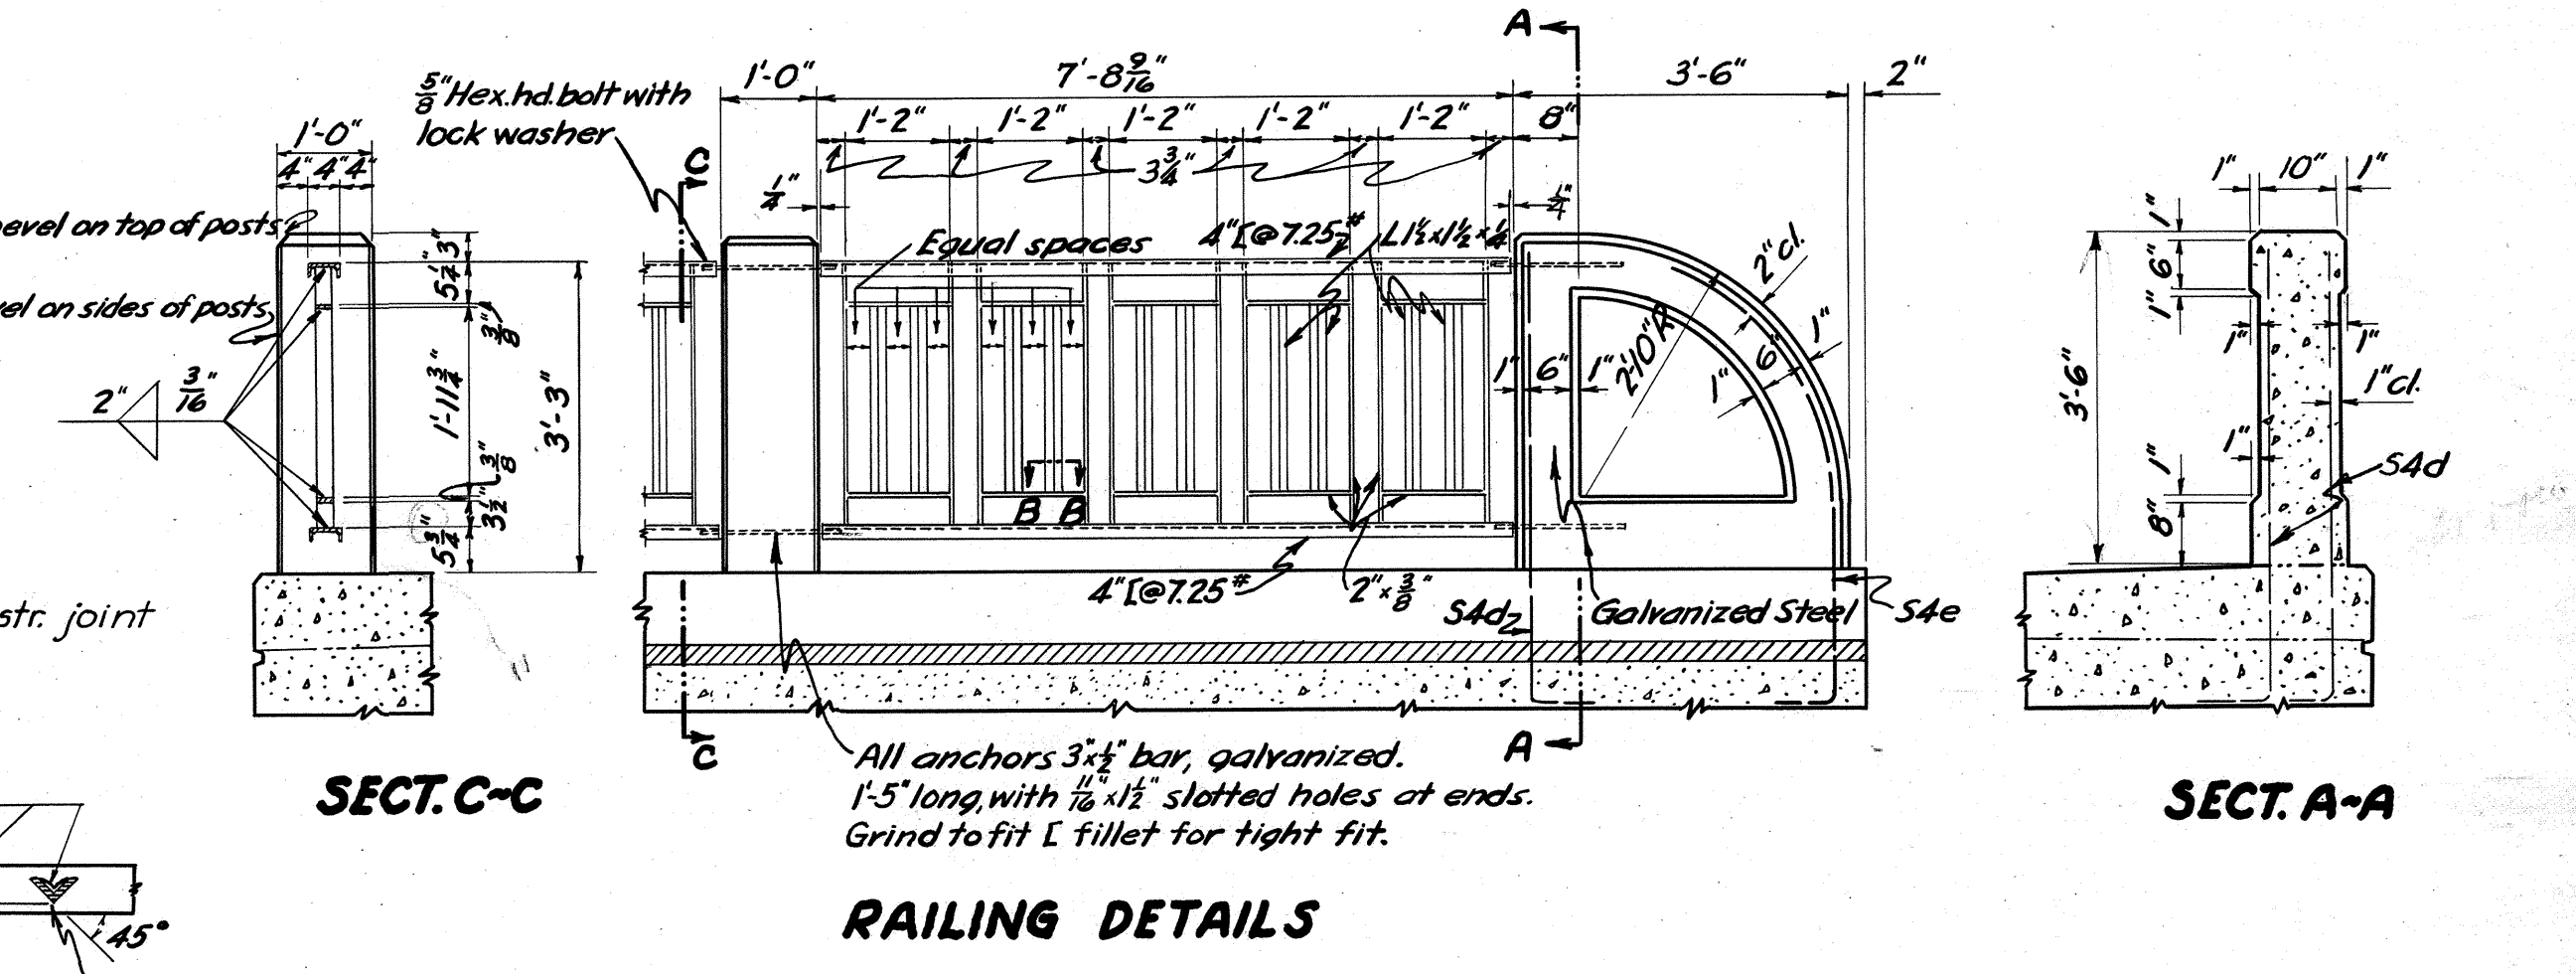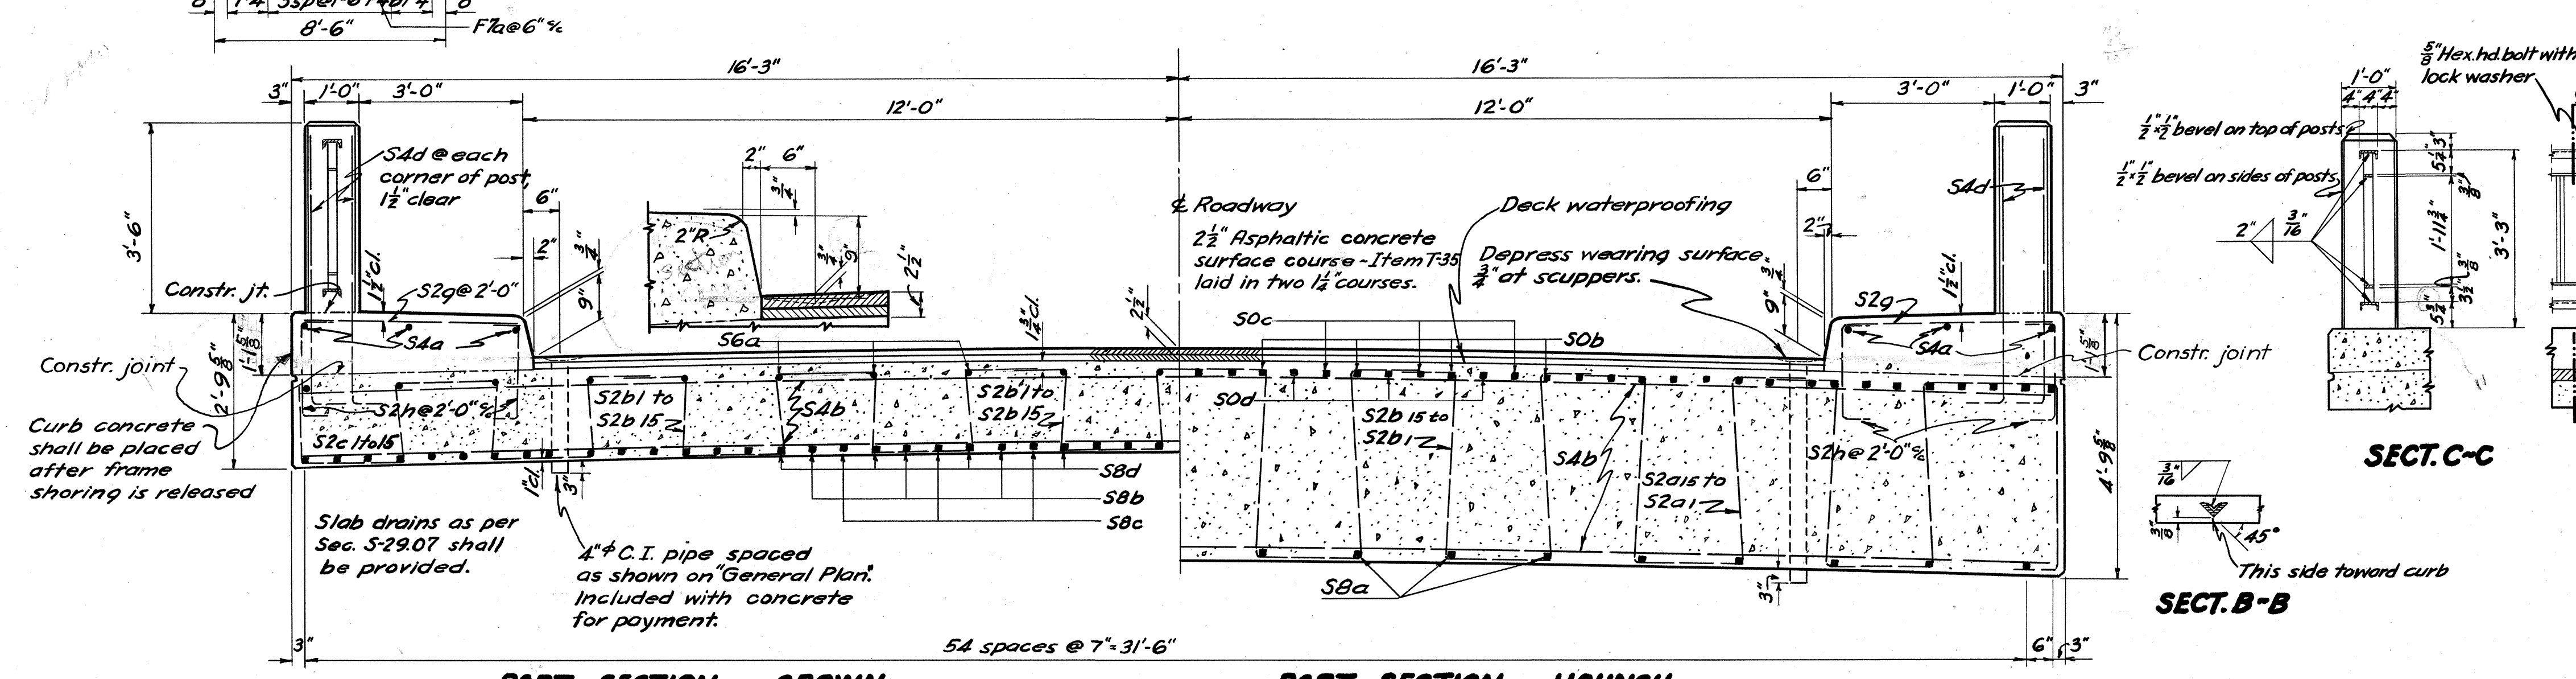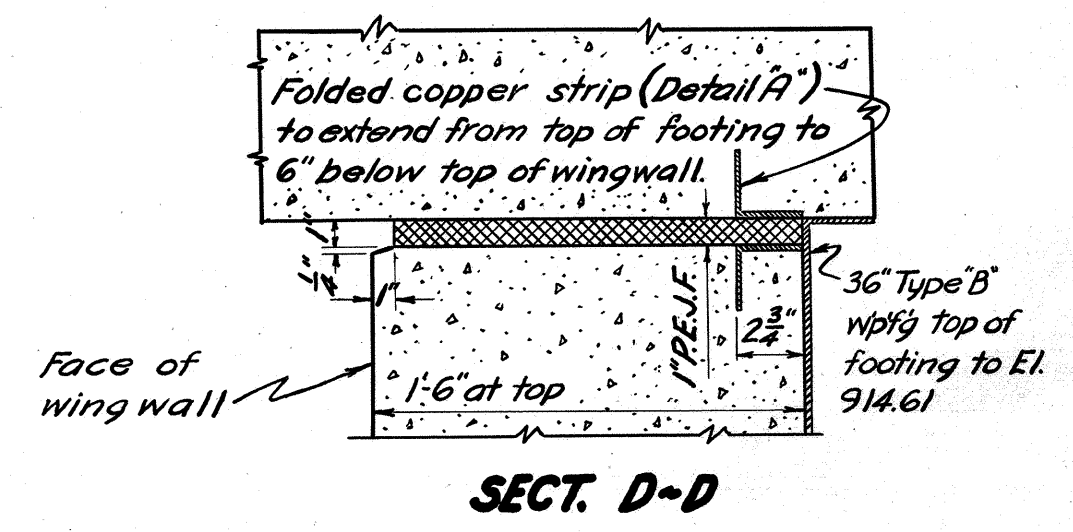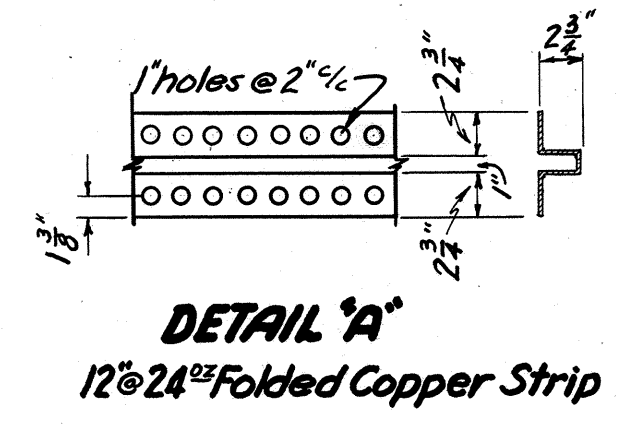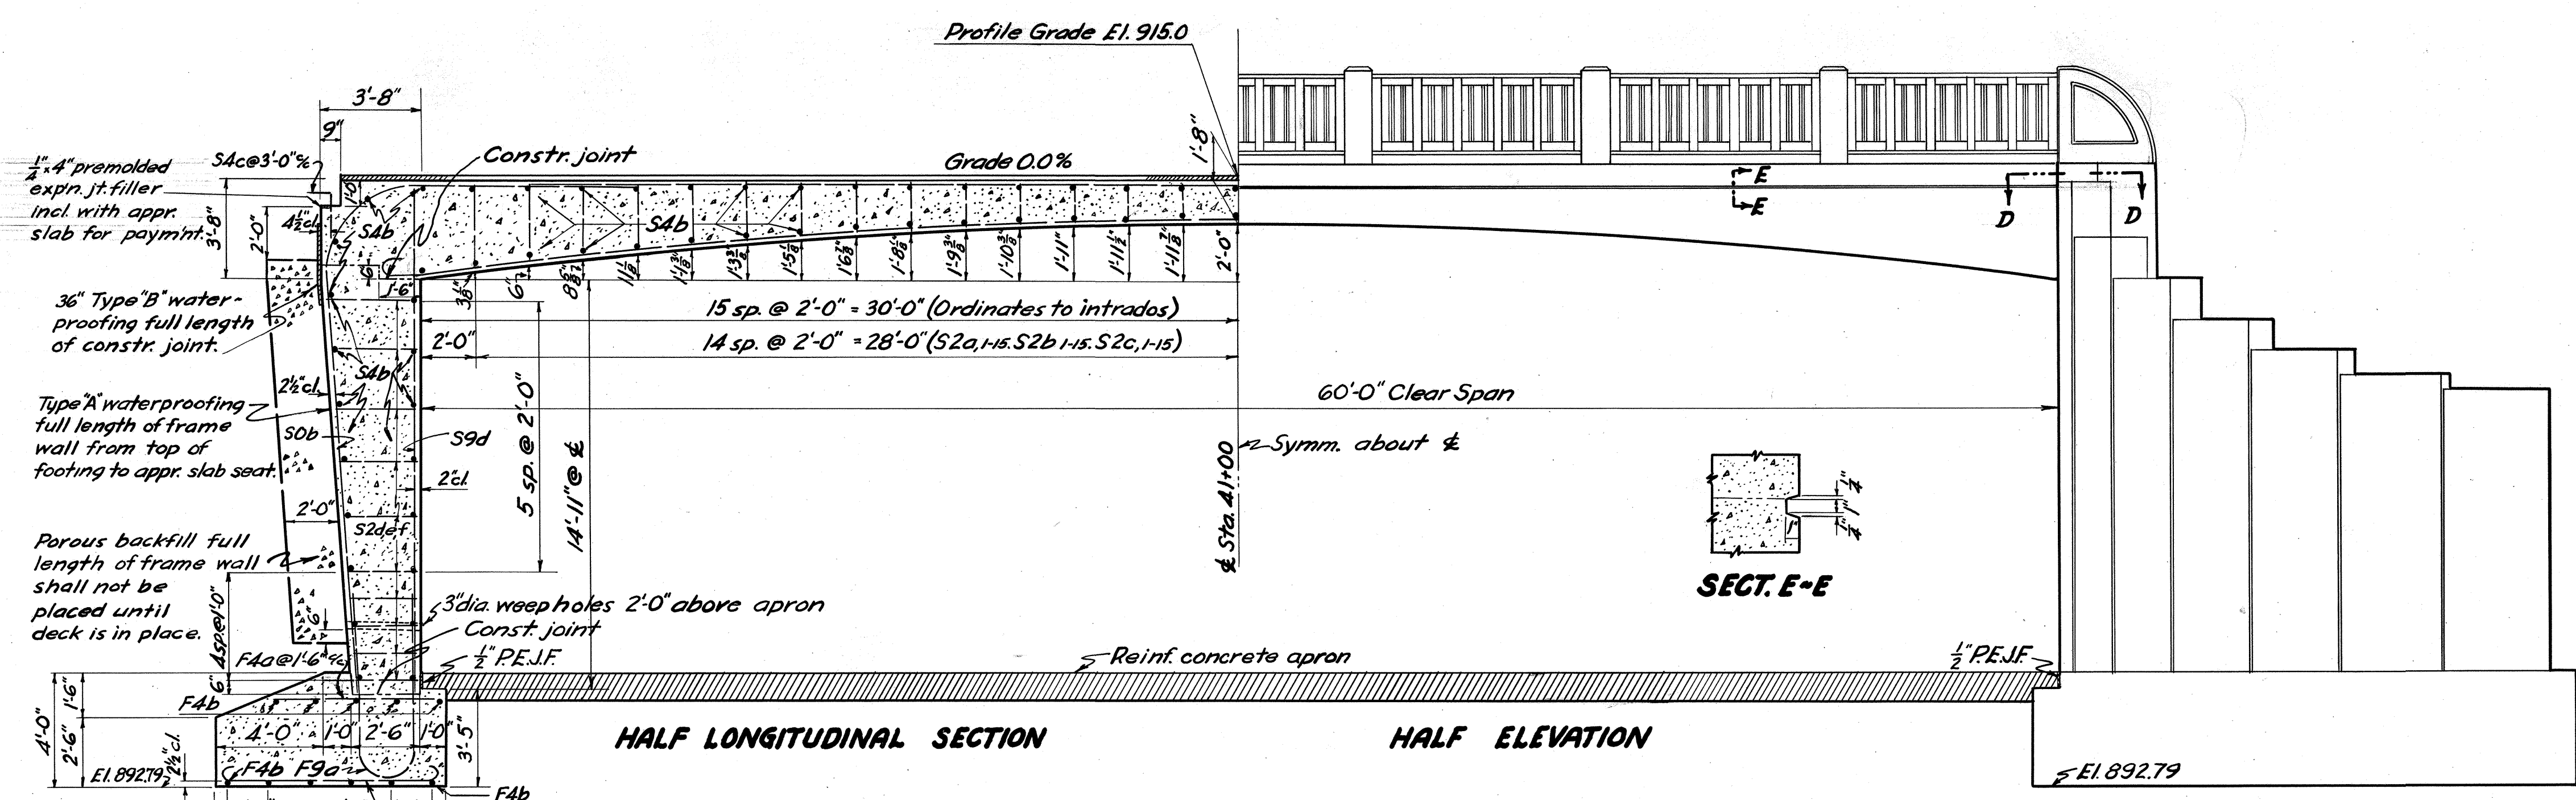


PATTERN OF EXTRADOS STEEL PATTERN OF INTRADOS STEEL


STATE OF OHIO DEPARTMENT OF HIGHWAYS BUREAU OF BRIDGES					
FRAME & RAILING DETAILS					
BRIDGE No. Br.-774-106 OVER STERLING RUN					
BROWN COUNTY SEC. E					S.H. 951 STA. 41+00
DESIGNED	DRAWN	TRACED	CHECKED	REVIEWED	DATE
		KBL	W.C.L.	D.F.G.	11-8-46

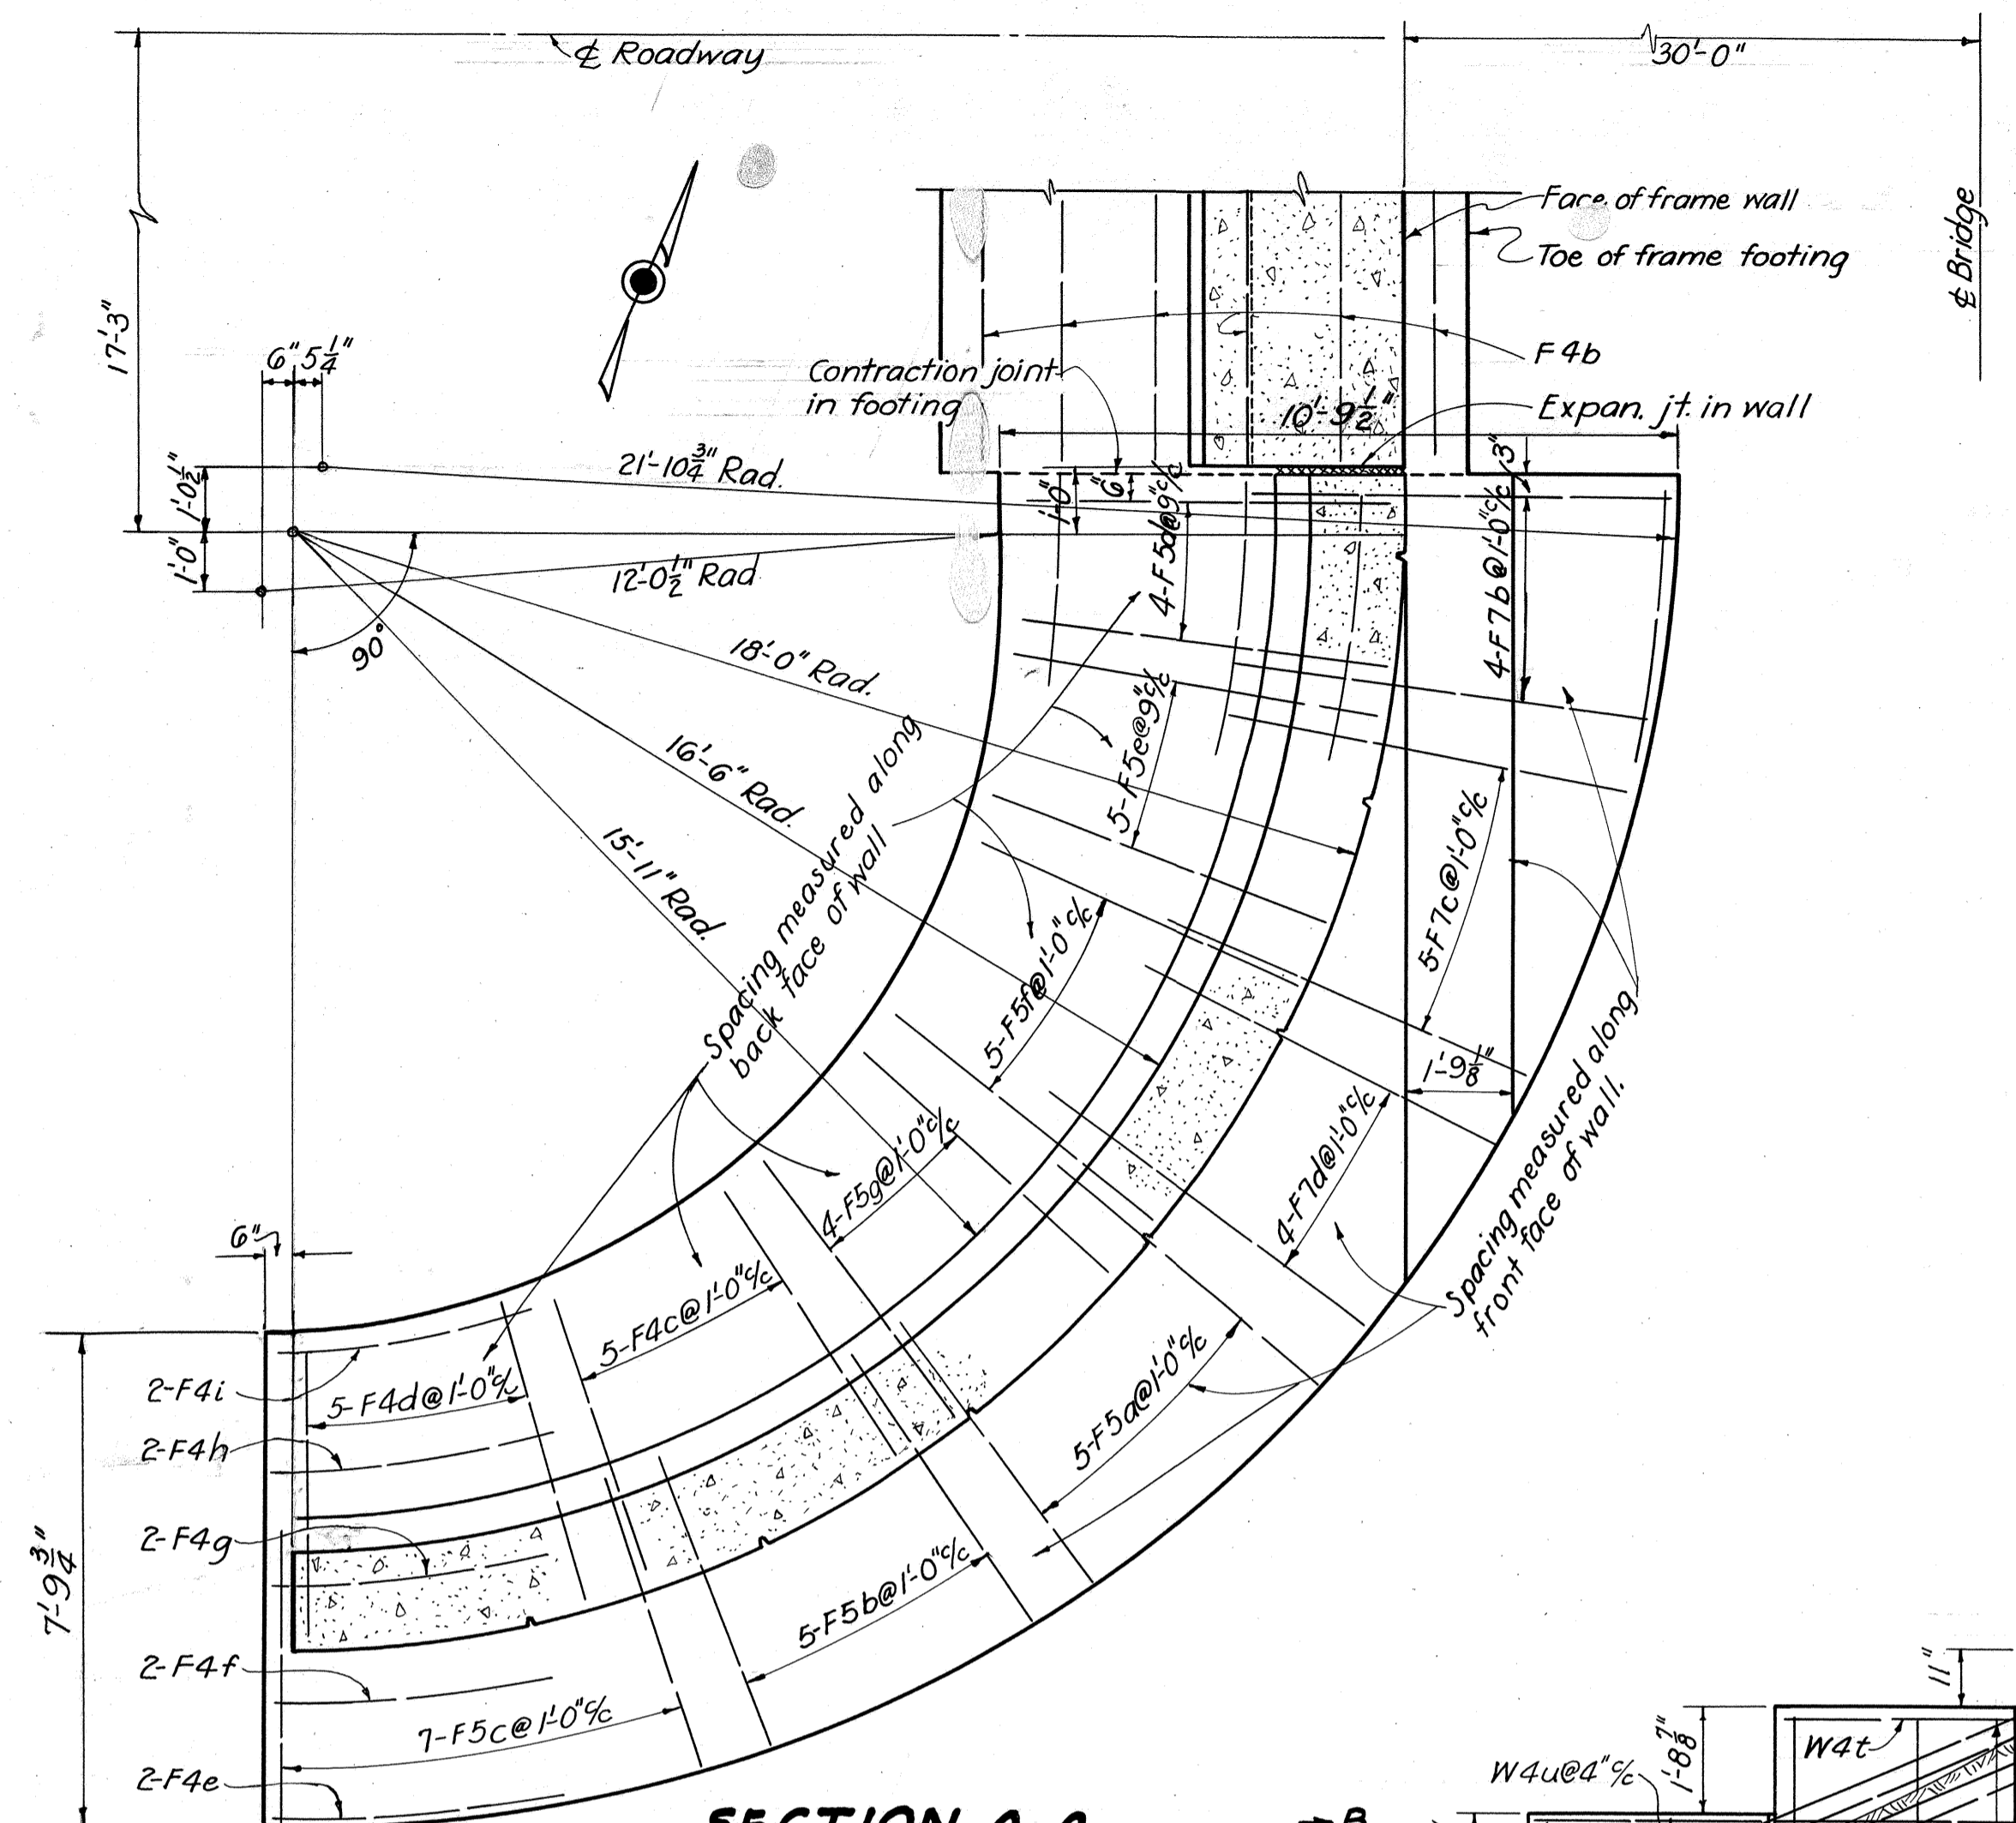


SECTION A-A

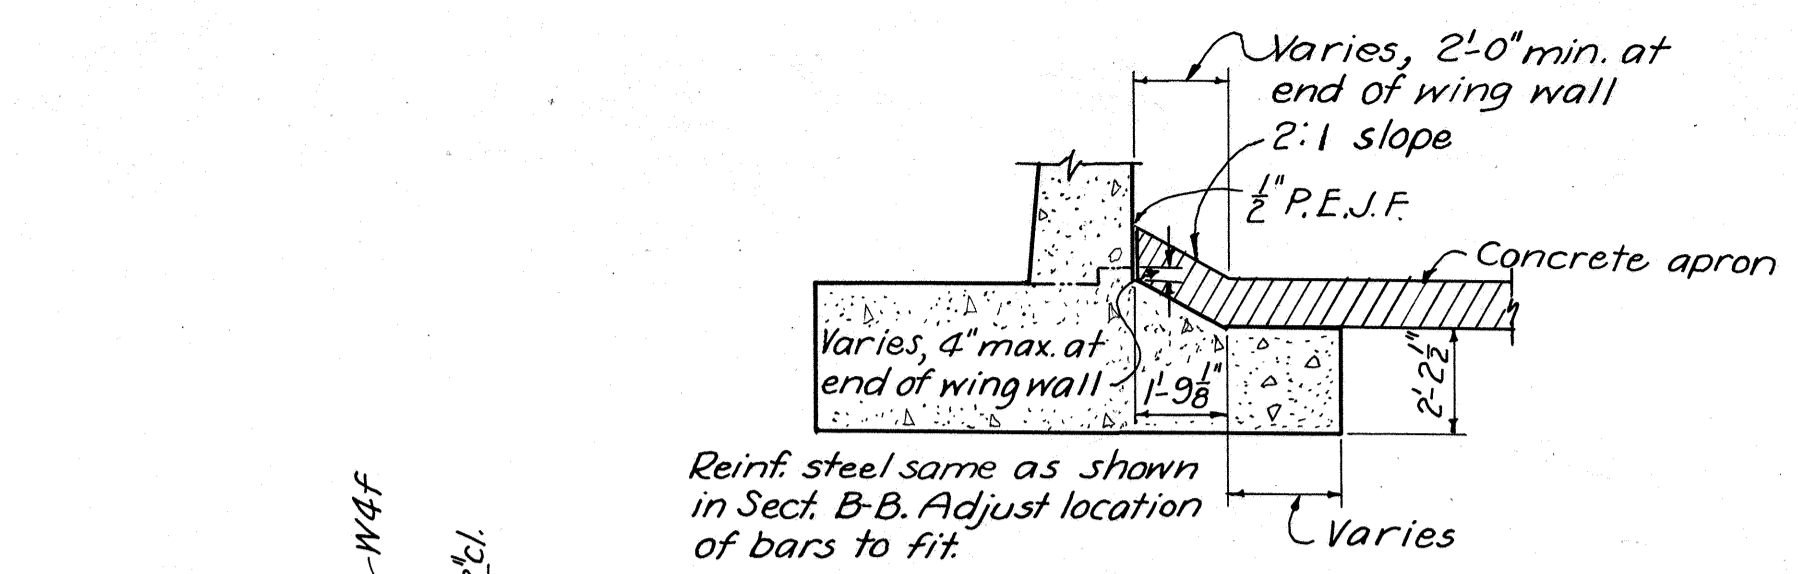


SECTION C-C

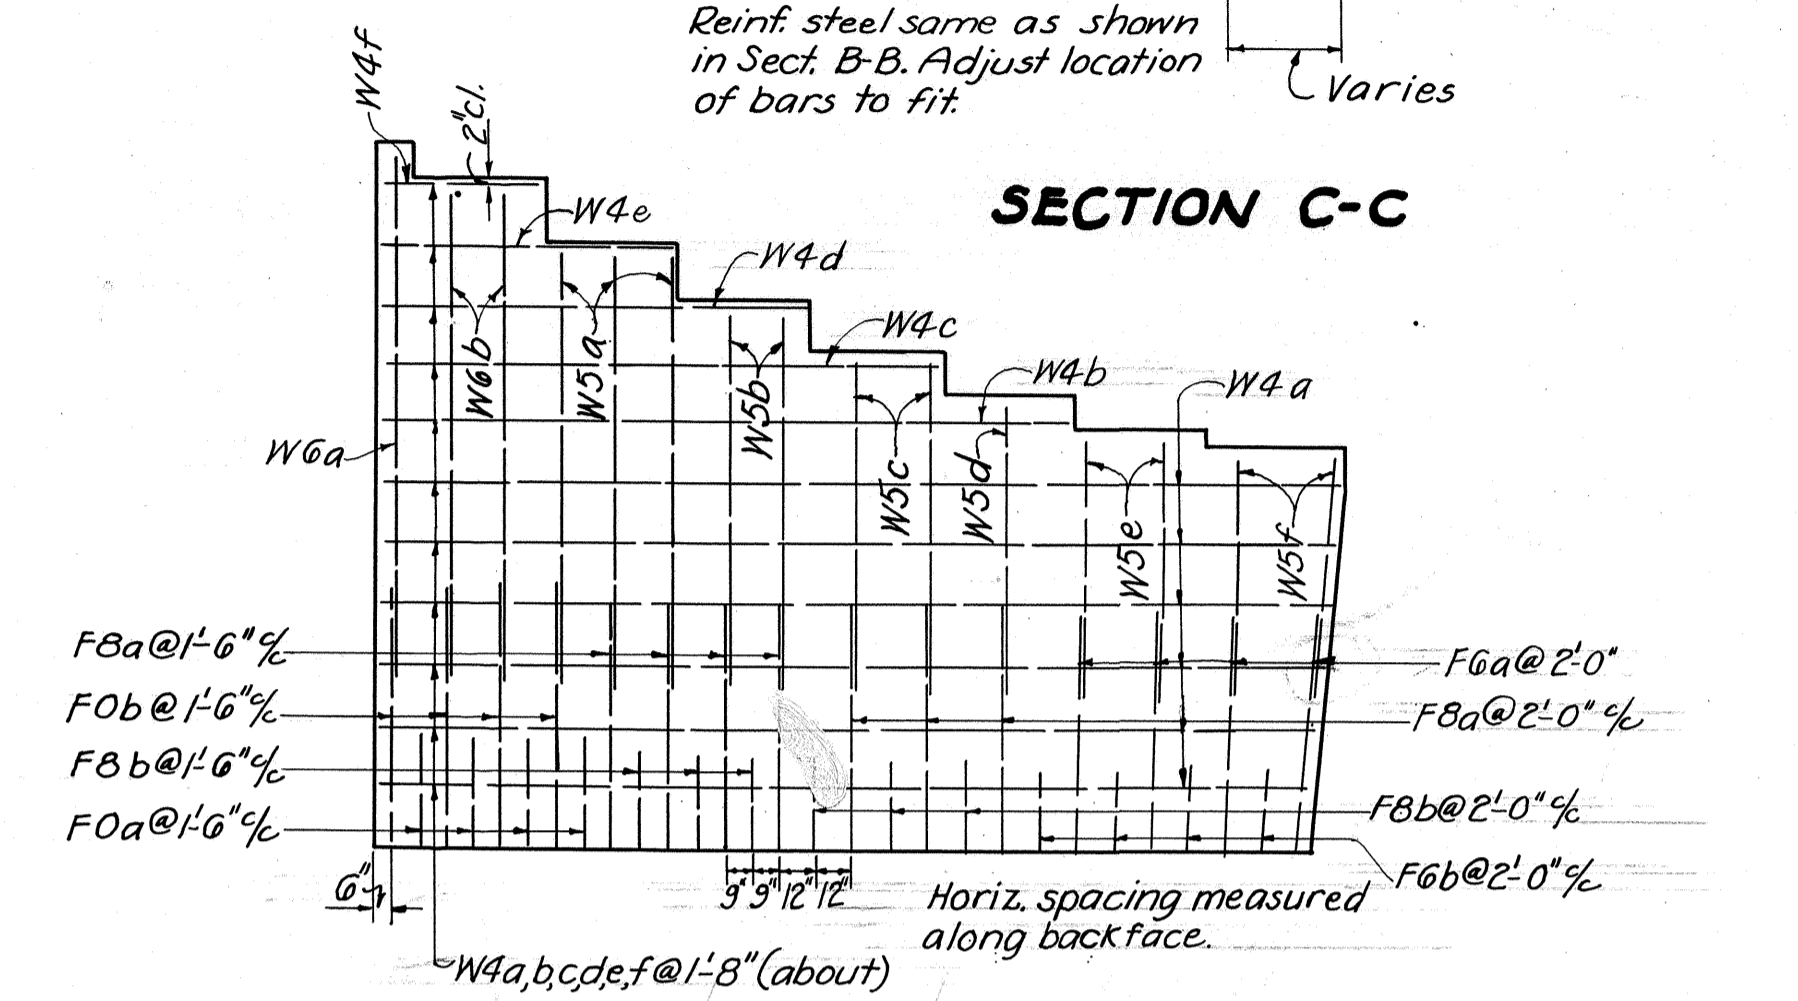

STEEL PATTERN-BACK FACE
DEVELOPED VIEW

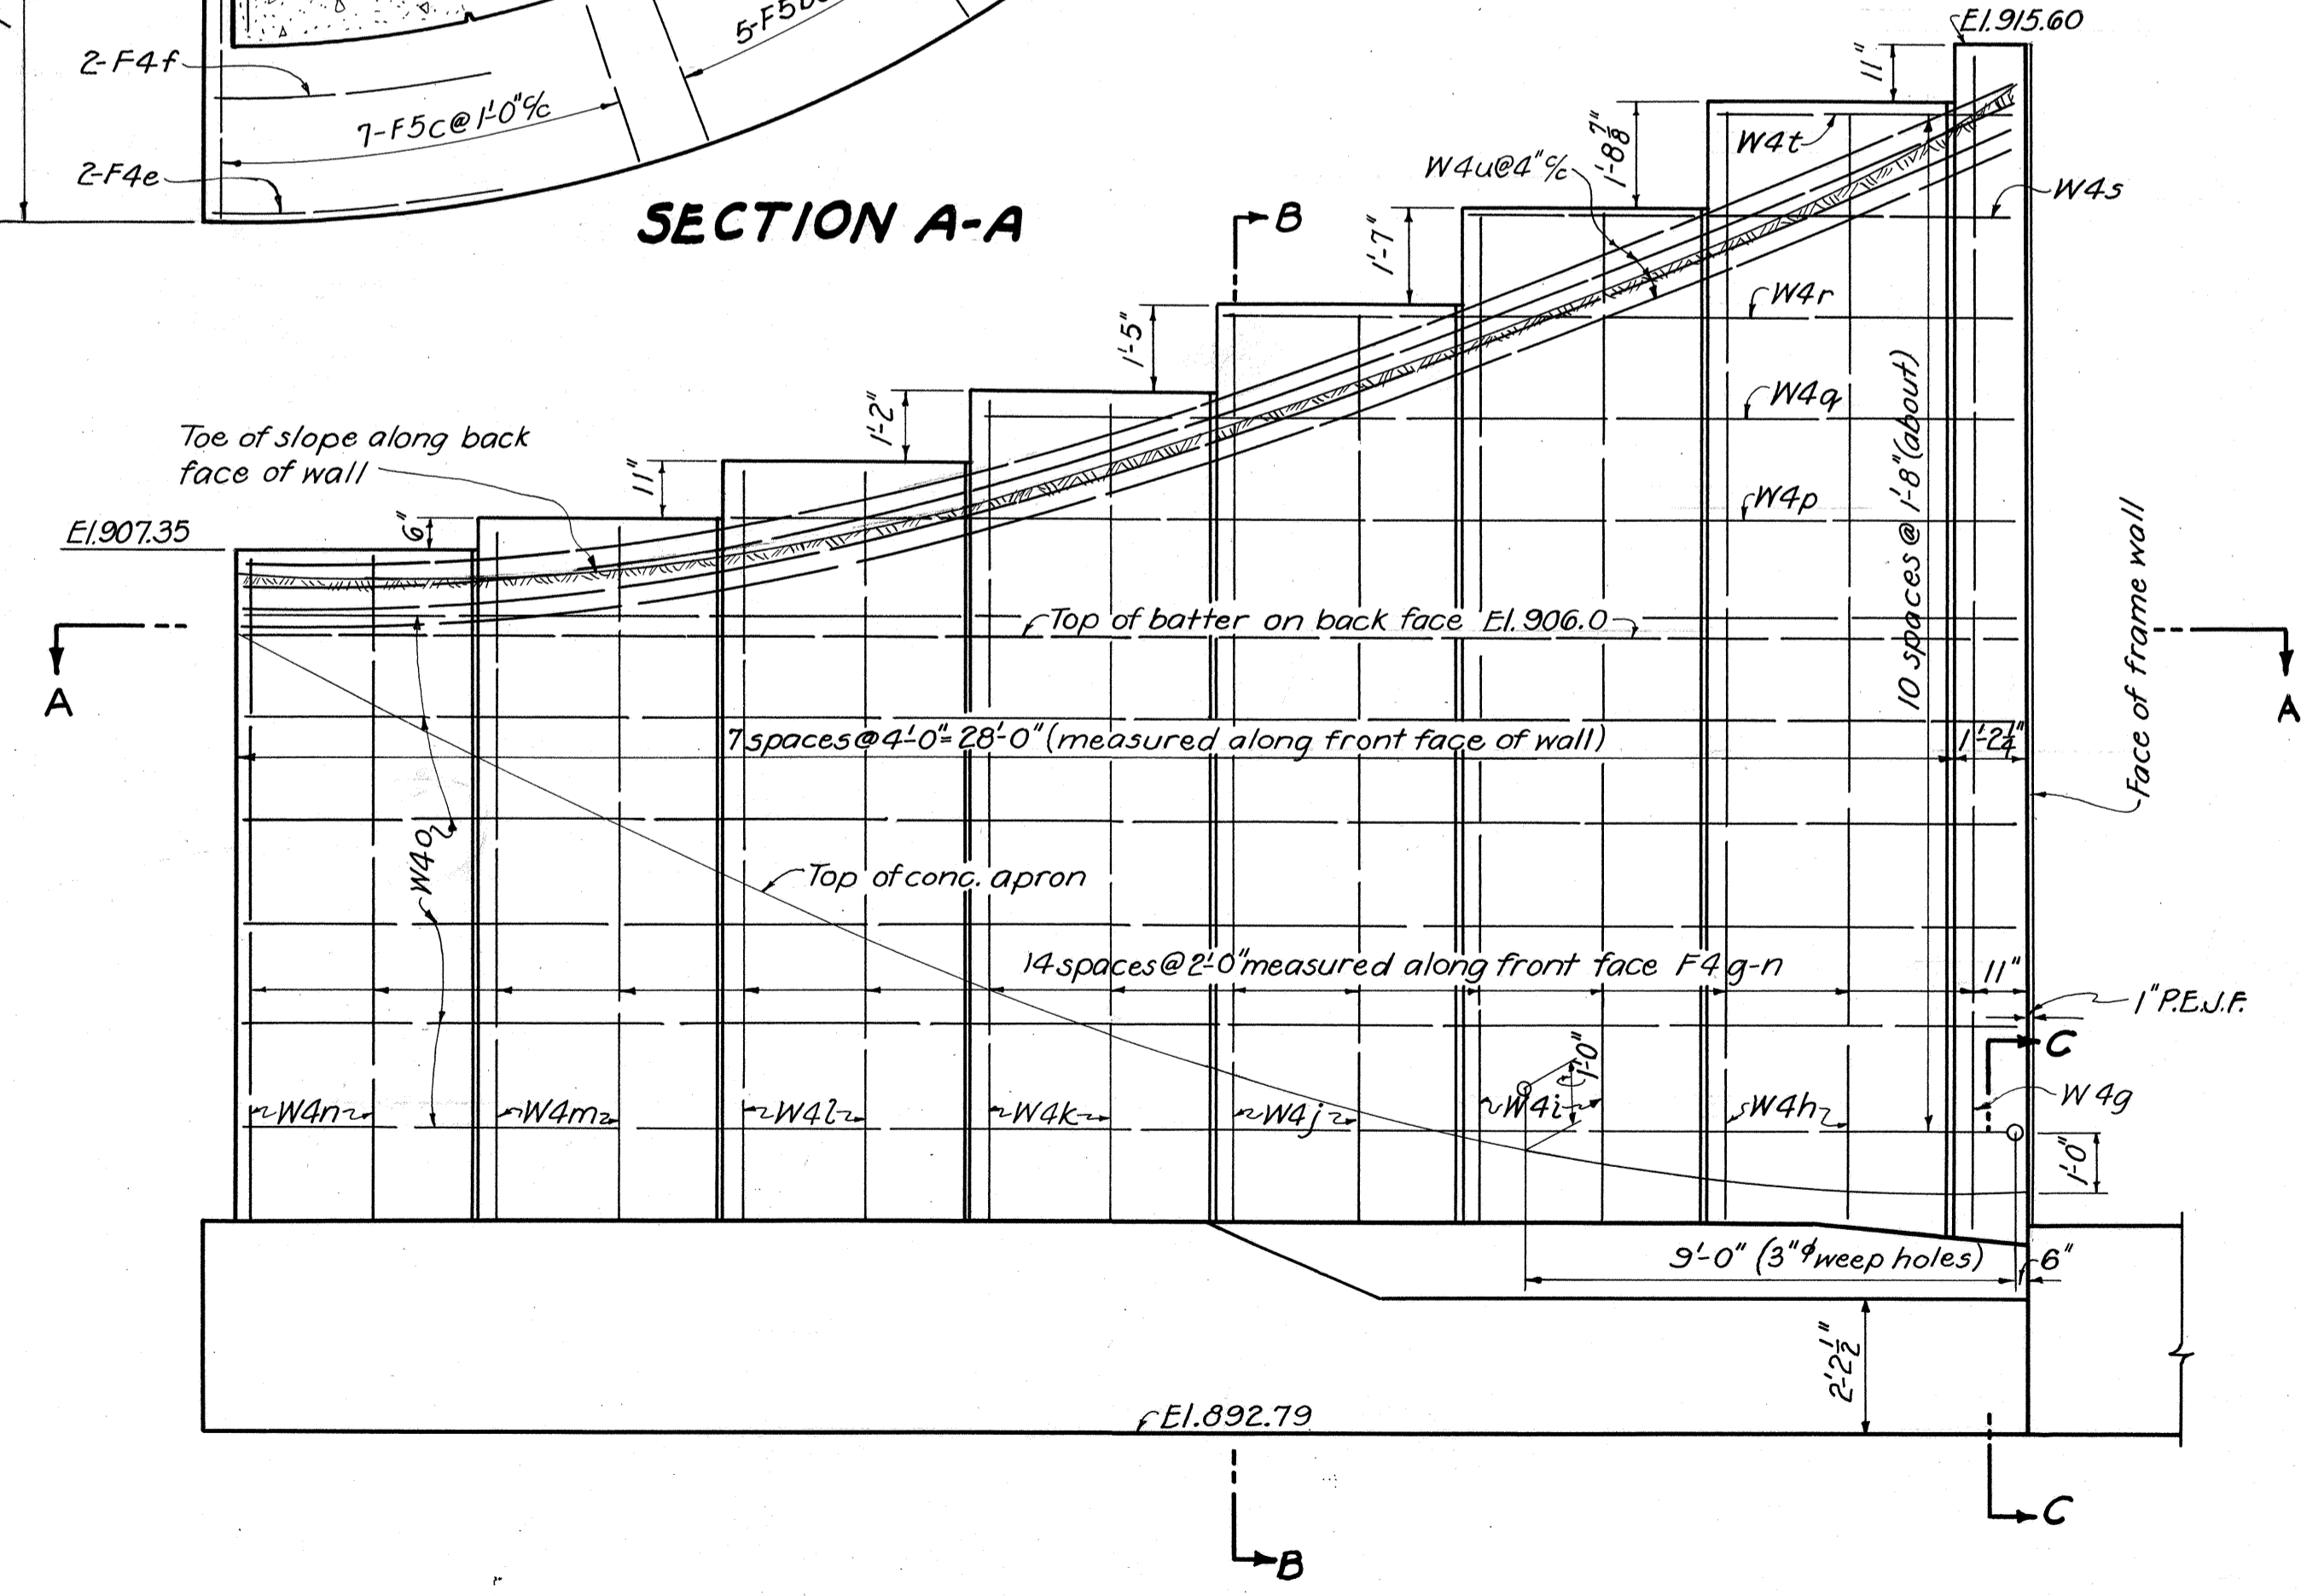

ELEVATION OF S.W. WING
DEVELOPED ALONG FRONT FACE
S.E. WING OPP. HAND

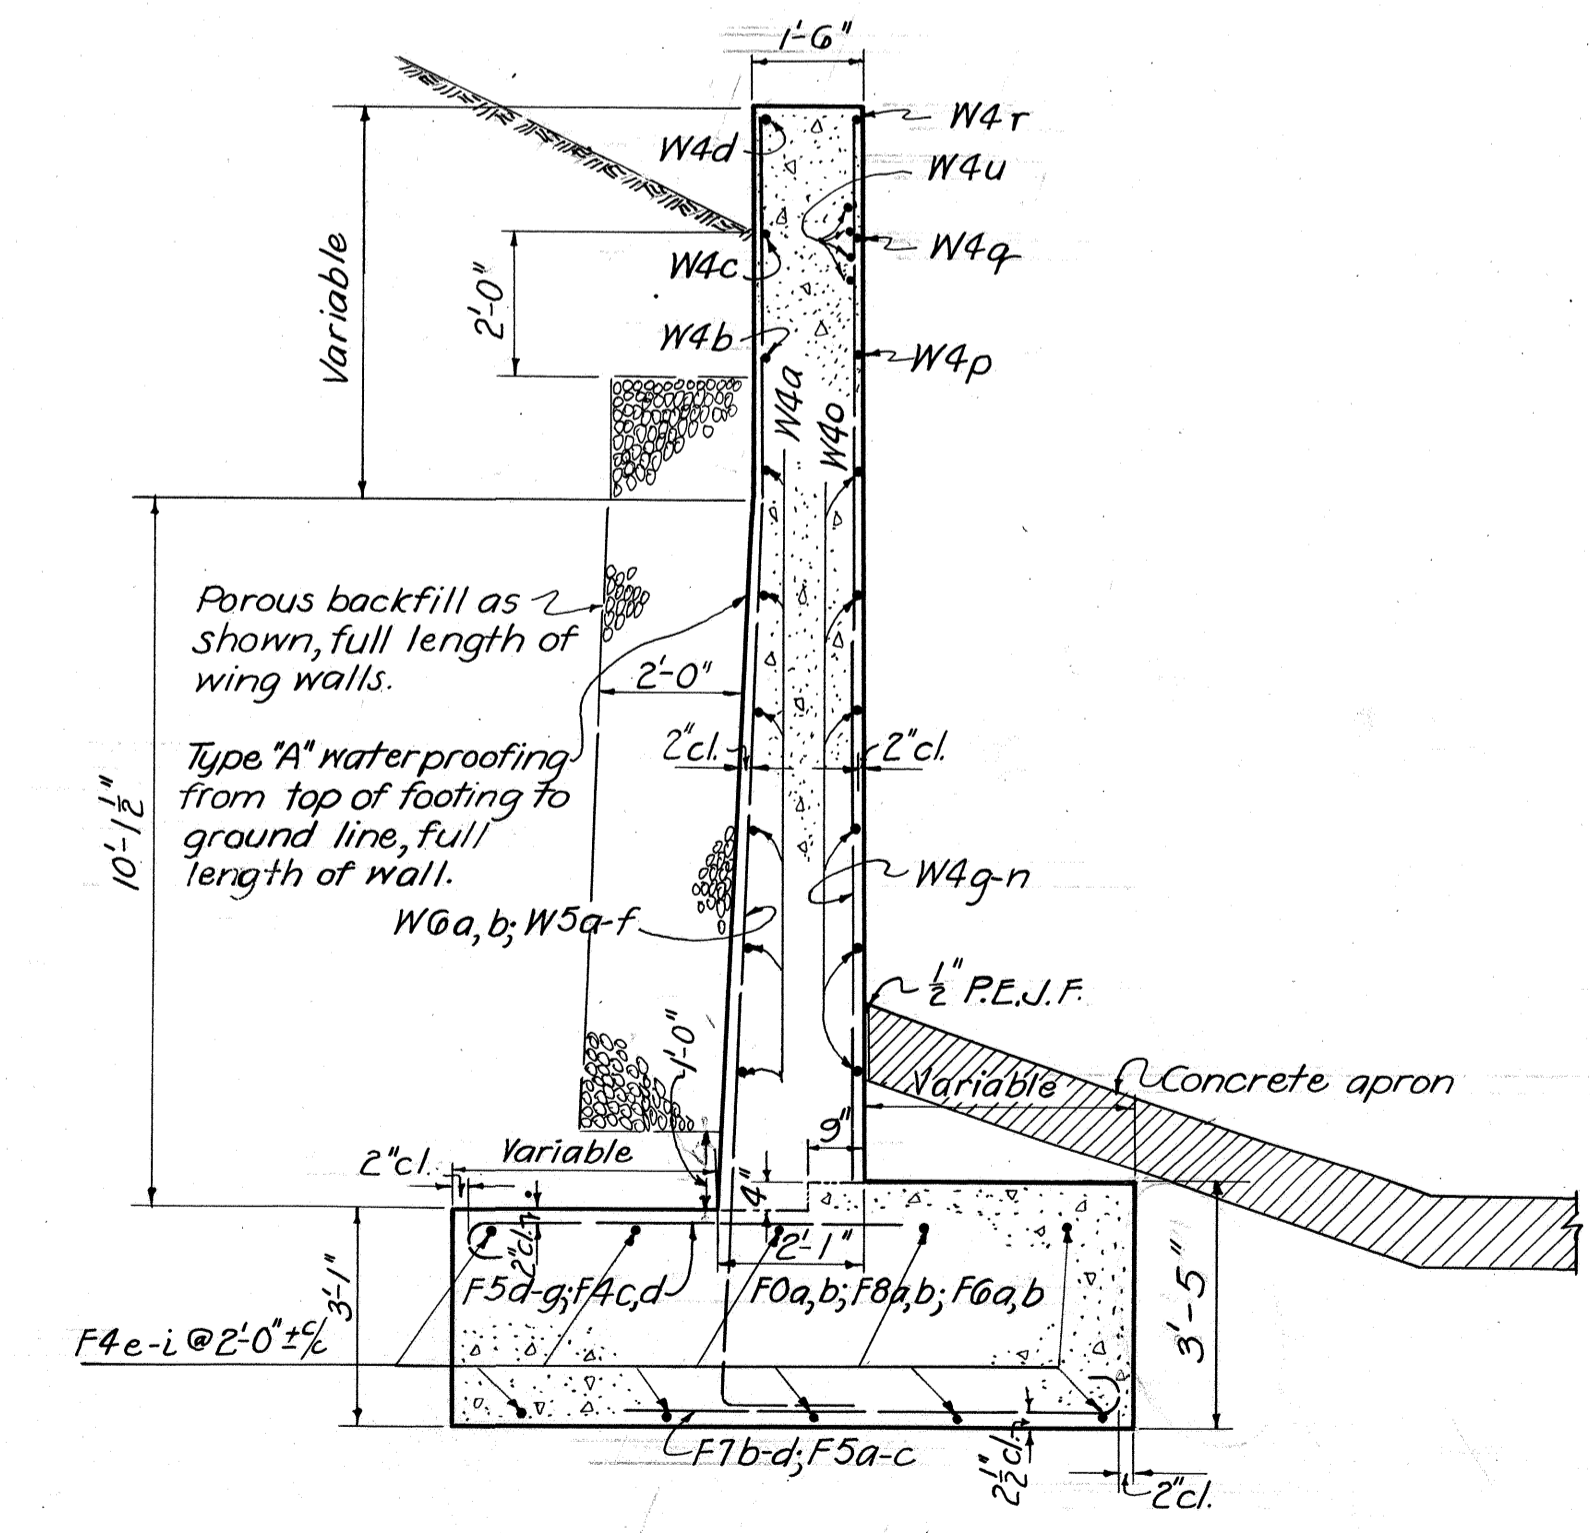


TYPICAL SECTION B-B

STATE OF OHIO DEPARTMENT OF HIGHWAYS BUREAU OF BRIDGES					
WING WALL DETAILS					
BRIDGE NO. BR. 774-106 OVER STERLING RUN					
BROWN COUNTY SEC. E				S.H. 951 STA. 41+00	
DESIGNED	DRAWN	TRACED	CHECKED	REVIEWED	DATE
		K.E.T.	W.C.L.	BFG	
					11-8-46


BROWN COUNTY
S. H. 951 SEC. E

REINFORCING STEEL LIST


Mark	Size	No.	Length	Weight	Shp.
FRAME					
S0a	1/4"	38	18'-6"	37.35	Str.
S0b	1/4"	38	28'-6"	57.54	Bt.
S0c	1/4"	36	24'-3"	46.38	Bt.
S0d	1/4"	36	20'-0"	40.38	Bt.
S9d	1 1/8"	38	18'-0"	29.43	Str.
S9e	1 1/8"	36	9'-0"	13.94	Str.
S8a	1"	38	18'-9"	24.22	Bt.
S8b	1"	19	20'-0"	12.92	Bt.
S8c	1"	18	28'-0"	17.14	Bt.
S8d	1"	19	33'-0"	21.32	Bt.
S6a	3/8"	38	27'-6"	21.36	Str.
S4a	3/8"	12	33'-6"	4.19	Str.
S4b	3/8"	98	32'-0"	3.271	Str.
S4c	3/8"	16	3'-3"	.54	Bt.
S4d	3/8"	56	5'-3"	3.07	Bt.
S4e	3/8"	8	5'-6"	.46	Bt.
S2a1	1/2"	1	10'-9"	.7	Bt.
S2a2	1/2"	2	10'-9"	.14	Bt.
S2a3	1/2"	2	11'-0"	.15	Bt.
S2a4	1/2"	2	11'-0"	.15	Bt.
S2a5	1/2"	2	11'-3"	.15	Bt.
S2a6	1/2"	2	11'-6"	.15	Bt.
S2a7	1/2"	2	11'-9"	.16	Bt.
S2a8	1/2"	2	12'-0"	.16	Bt.
S2a9	1/2"	2	12'-6"	.17	Bt.
S2a10	1/2"	2	13'-0"	.17	Bt.
S2a11	1/2"	2	13'-6"	.18	Bt.
S2a12	1/2"	2	14'-0"	.19	Bt.
S2a13	1/2"	2	14'-9"	.20	Bt.
S2a14	1/2"	2	15'-3"	.20	Bt.
S2a15	1/2"	2	16'-0"	.21	Bt.
S2b1	1/2"	3	14'-3"	.29	Bt.
S2b2	1/2"	6	14'-3"	.57	Bt.
S2b3	1/2"	6	14'-6"	.58	Bt.
S2b4	1/2"	6	14'-6"	.58	Bt.
S2b5	1/2"	6	14'-9"	.59	Bt.
S2b6	1/2"	6	15'-0"	.60	Bt.
S2b7	1/2"	6	15'-6"	.62	Bt.
S2b8	1/2"	6	16'-0"	.64	Bt.
S2b9	1/2"	6	16'-6"	.66	Bt.
S2b10	1/2"	6	17'-0"	.68	Bt.
S2b11	1/2"	6	17'-9"	.71	Bt.
S2b12	1/2"	6	18'-6"	.74	Bt.
S2b13	1/2"	6	19'-3"	.77	Bt.
S2b14	1/2"	6	20'-3"	.81	Bt.
S2b15	1/2"	6	21'-3"	.85	Bt.
S2c1	1/2"	1	13'-3"	.9	Bt.
S2c2	1/2"	2	13'-3"	.18	Bt.
S2c3	1/2"	2	13'-3"	.18	Bt.
S2c4	1/2"	2	13'-6"	.18	Bt.
S2c5	1/2"	2	13'-9"	.18	Bt.
S2c6	1/2"	2	14'-0"	.19	Bt.
S2c7	1/2"	2	14'-6"	.19	Bt.
S2c8	1/2"	2	15'-0"	.20	Bt.
S2c9	1/2"	2	15'-6"	.21	Bt.
S2c10	1/2"	2	16'-0"	.21	Bt.
S2c11	1/2"	2	16'-9"	.22	Bt.
S2c12	1/2"	2	17'-6"	.23	Bt.
S2c13	1/2"	2	18'-3"	.24	Bt.
S2c14	1/2"	2	19'-3"	.26	Bt.
S2c15	1/2"	2	20'-3"	.27	Bt.

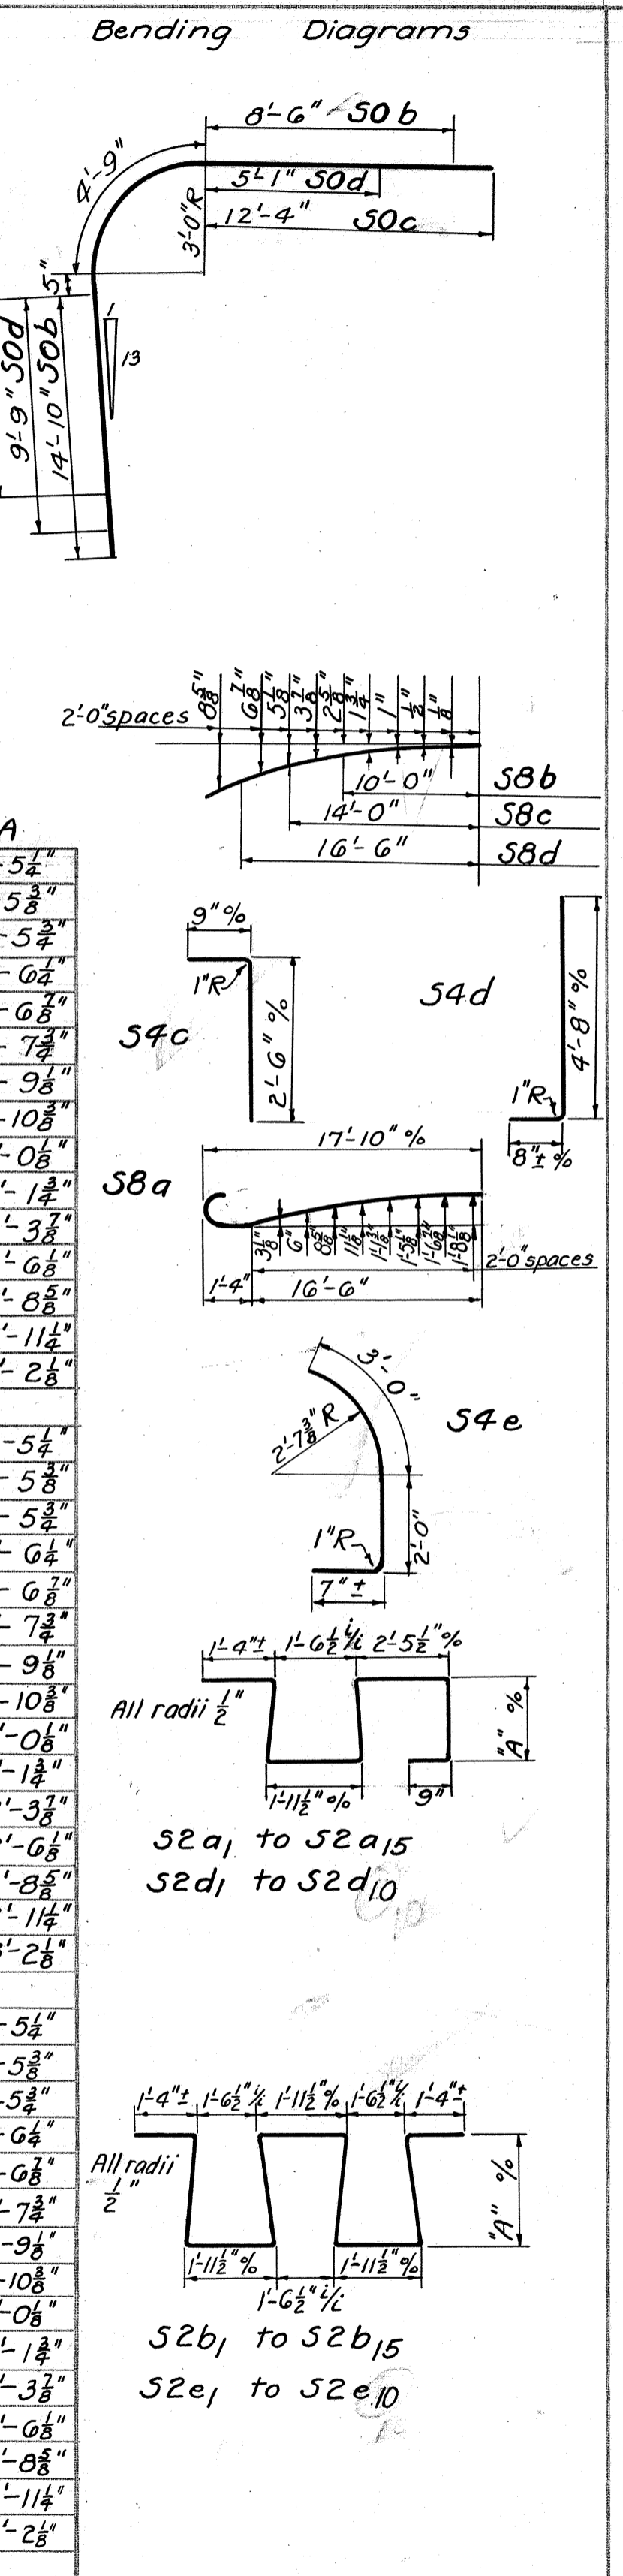

Mark	Size	No.	Length	Weight	Shp.
FRAME (CONTINUED)					
S2d1	1/2"	2	13'-3"	.18	Bt.
S2d2	1/2"	2	13'-6"	.18	Bt.
S2d3	1/2"	2	13'-9"	.18	Bt.
S2d4	1/2"	2	14'-0"	.19	Bt.
S2d5	1/2"	2	14'-3"	.19	Bt.
S2d6	1/2"	2	14'-6"	.19	Bt.
S2d7	1/2"	2	15'-0"	.20	Bt.
S2d8	1/2"	2	15'-6"	.21	Bt.
S2d9	1/2"	2	16'-0"	.21	Bt.
S2d10	1/2"	2	16'-6"	.22	Bt.
S2e1	1/2"	6	17'-9"	.71	Bt.
S2e2	1/2"	6	18'-0"	.72	Bt.
S2e3	1/2"	6	18'-3"	.73	Bt.
S2e4	1/2"	6	18'-6"	.74	Bt.
S2e5	1/2"	6	19'-0"	.76	Bt.
S2e6	1/2"	6	19'-6"	.78	Bt.
S2e7	1/2"	6	20'-0"	.80	Bt.
S2e8	1/2"	6	20'-6"	.82	Bt.
S2e9	1/2"	6	21'-3"	.85	Bt.
S2e10	1/2"	6	21'-9"	.87	Bt.
S2f1	1/2"	2	16'-6"	.22	Bt.
S2f2	1/2"	2	17'-0"	.23	Bt.
S2f3	1/2"	2	17'-3"	.23	Bt.
S2f4	1/2"	2	17'-6"	.23	Bt.
S2f5	1/2"	2	17'-9"	.24	Bt.
S2f6	1/2"	2	18'-3"	.24	Bt.
S2f7	1/2"	2	19'-0"	.25	Bt.
S2f8	1/2"	2	19'-6"	.26	Bt.
S2f9	1/2"	2	20'-0"	.27	Bt.
S2f10	1/2"	2	20'-9"	.28	Bt.
S2g	1/2"	66	3'-9"	166	Str.
S2h	1/2"	132	2'-6"	220	Bt.
WING WALLS					
W6a	3/8"	2	15'-0"	.61	Bt.
W6b	3/8"	4	14'-0"	.115	Bt.
W5a	3/8"	6	12'-9"	.115	Bt.
W5b	3/8"	4	11'-3"	.68	Bt.
W5c	3/8"	4	9'-9"	.59	Bt.
W5d	3/8"	2	8'-6"	.25	Bt.
W5e	3/8"	4	7'-9"	.47	Bt.
W5f	3/8"	4	7'-3"	.44	Bt.
W4a	3/8"	12	26'-0"	325	Bt.
W4b	3/8"	2	19'-0"	.40	Bt.
W4c	3/8"	2	15'-3"	.32	Bt.
W4d	3/8"	2	11'-6"	.24	Bt.
W4e	3/8"	2	7'-9"	.16	Bt.
W4f	3/8"	2	4'-3"	.9	Bt.
W4g	3/8"	2	19'-0"	.40	Str.
W4h	3/8"	4	18'-0"	.75	Str.
W4i	3/8"	4	16'-3"	.68	Str.
W4j	3/8"	4	14'-9"	.62	Str.
W4k	3/8"	4	13'-3"	.55	Str.
W4l	3/8"	4	12'-0"	.50	Str.
W4m	3/8"	4	11'-0"	.46	Str.
W4n	3/8"	4	10'-6"	.44	Str.
W4o	3/8"	12	28'-6"	357	Bt.

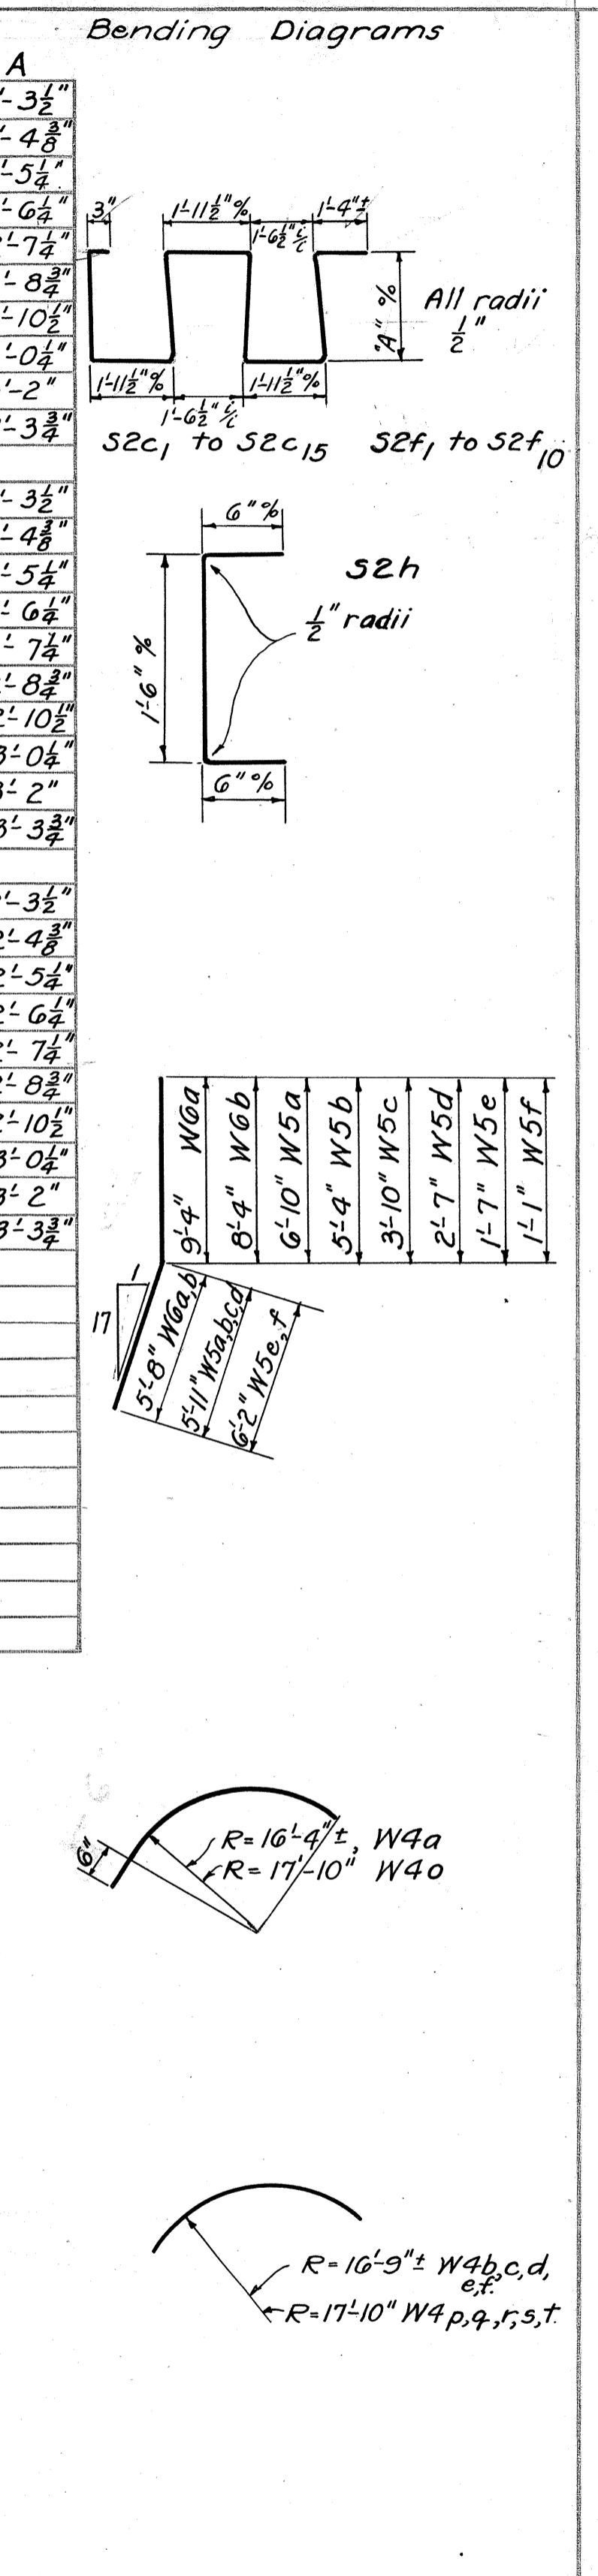

Mark	Size	No.	Length	Weight	Shp.
WING WALLS (CONT.)					
W4p	3/8"	2	20'-6"	.43	Bt.
W4q	3/8"	2	16'-6"	.34	Bt.
W4r	3/8"	2	12'-6"	.26	Bt.
W4s	3/8"	2	8'-6"	.18	Bt.
W4t	3/8"	2	4'-6"	.9	Bt.
W4u	3/8"	8	30'-0"	250	Bt.
FOOTING					
F0a	1 1/2"	8	7'-6"	319	Bt.
F0b	1 1/2"	8	10'-9"	457	Bt.
F9a	1 1/2"	74	15'-6"	4936	Bt.
F9b	1 1/2"	38	17'-6"	2861	Bt.
F8a	1"	14	10'-3"	488	Bt.
F8b	1"	12	5'-9"	235	Bt.
F7a	1"	130	9'-9"	3384	Bt.
F7b	1"	8	8'-6"	182	Bt.
F7c	1"	10	8'-3"	220	Bt.
F7d	1"	8	8'-0"	171	Bt.
F6a	3/4"	8	10'-0"	164	Bt.
F6b	3/4"	8	5'-9"	94	Bt.
F5a	3/4"	10	6'-6"	98	Bt.
F5b	3/4"	10	6'-3"	94	Bt.
F5c	3/4"	14	6'-0"	126	Bt.
F5d	3/4"	8	7'-6"	90	Bt.
F5e	3/4"	10	7'-3"	109	Bt.
F5f	3/4"	10	7'-0"	105	Bt.
F5g	3/4"	8	6'-9"	81	Bt.
F4a	3/4"	40	6'-3"	261	Str.
F4b	3/4"	22	32'-0"	734	Str.
F4c	3/4"	10	5'-9"	60	Bt.
F4d	3/4"	10	5'-6"	57	Bt.
F4e	3/4"	4	33'-3"	139	Bt.
F4f	3/4"	4	30'-0"	125	Bt.
F4g	3/4"	4	26'-9"	112	Bt.
F4h	3/4"	4	24'-0"	100	Bt.
F4i	3/4"	4	20'-9"	87	Bt.
REPLACEMENT BARS					
RE0	1 1/2"	1	9'-0"	48	Str.
RE9	1 1/2"	1	8'-6"	37	Str.
RE8	1"	1	8'-0"	27	Str.
RE7	1"	1	8'-0"	21	Str.
RE6	3/4"	1	7'-6"	15	Str.
RE5	3/4"	1	7'-0"	11	Str.
RE4	3/4"	1	6'-6"	7	Str.
RE2	3/4"	1	6'-0"	4	Str.

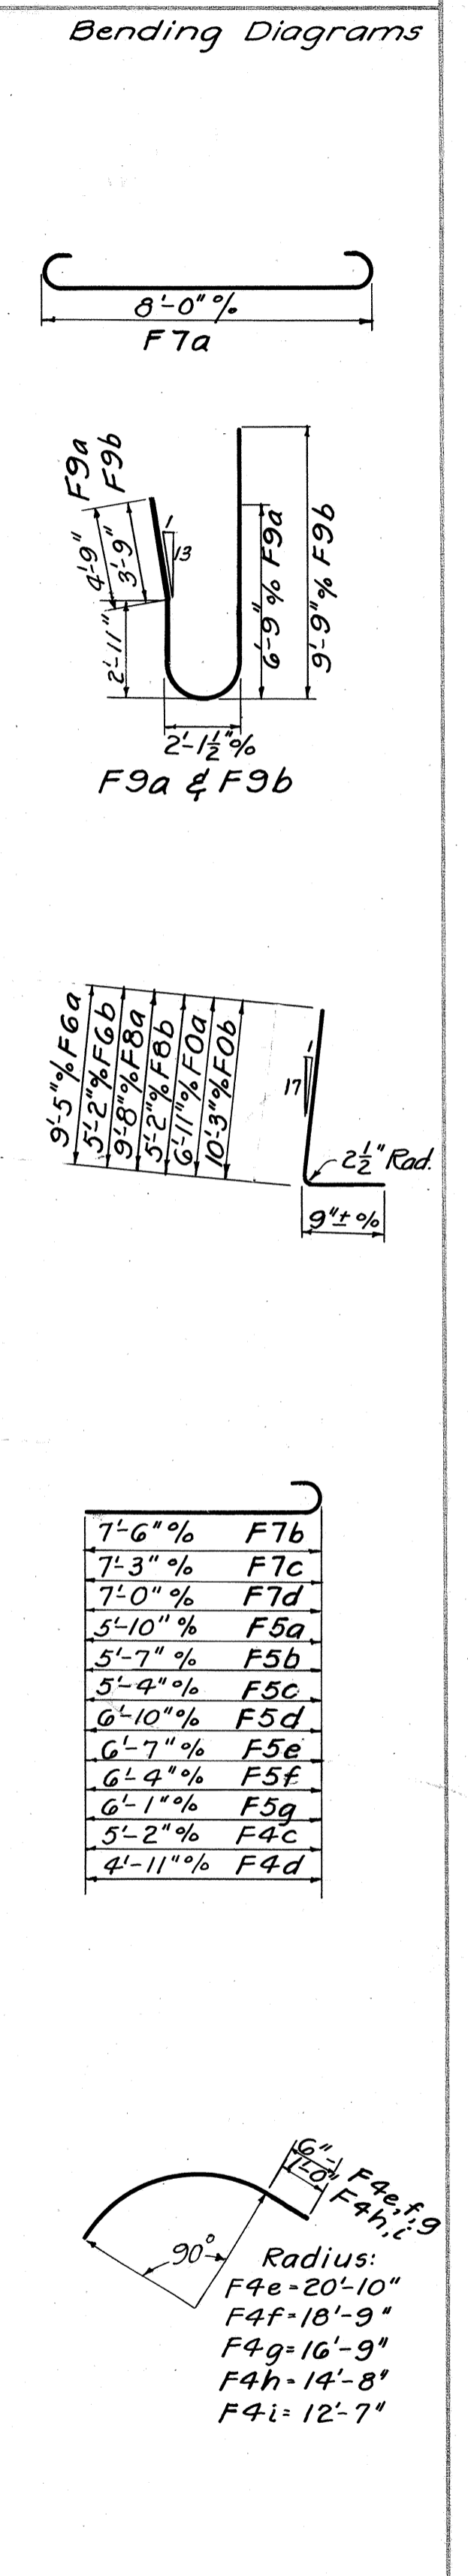



STATE OF OHIO
DEPARTMENT OF HIGHWAYS
BUREAU OF BRIDGES

REINFORCING STEEL LIST

BRIDGE NO. 774-106
OVER STERLING RUN
BROWN CO. S.H. 951
SEC. E STA. 41+00


DESIGNED	DRAWN	TRACED	CHECKED	REVIEWED	DATE	REVISED
		K.S.T.	W.C.L.	BFG	8/30 11-8-46	

BROWN COUNTY
S. H. 951 SEC. E

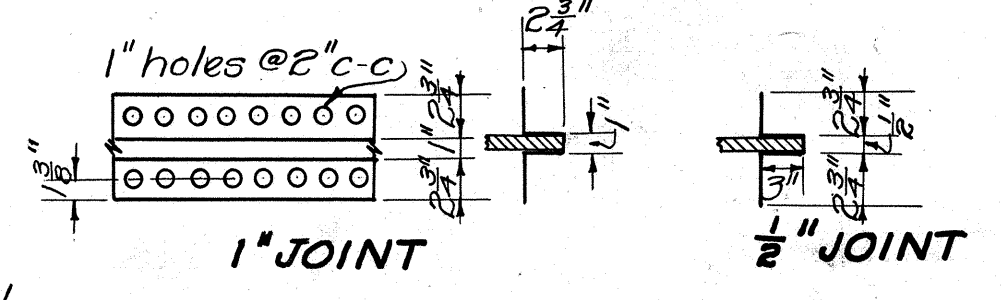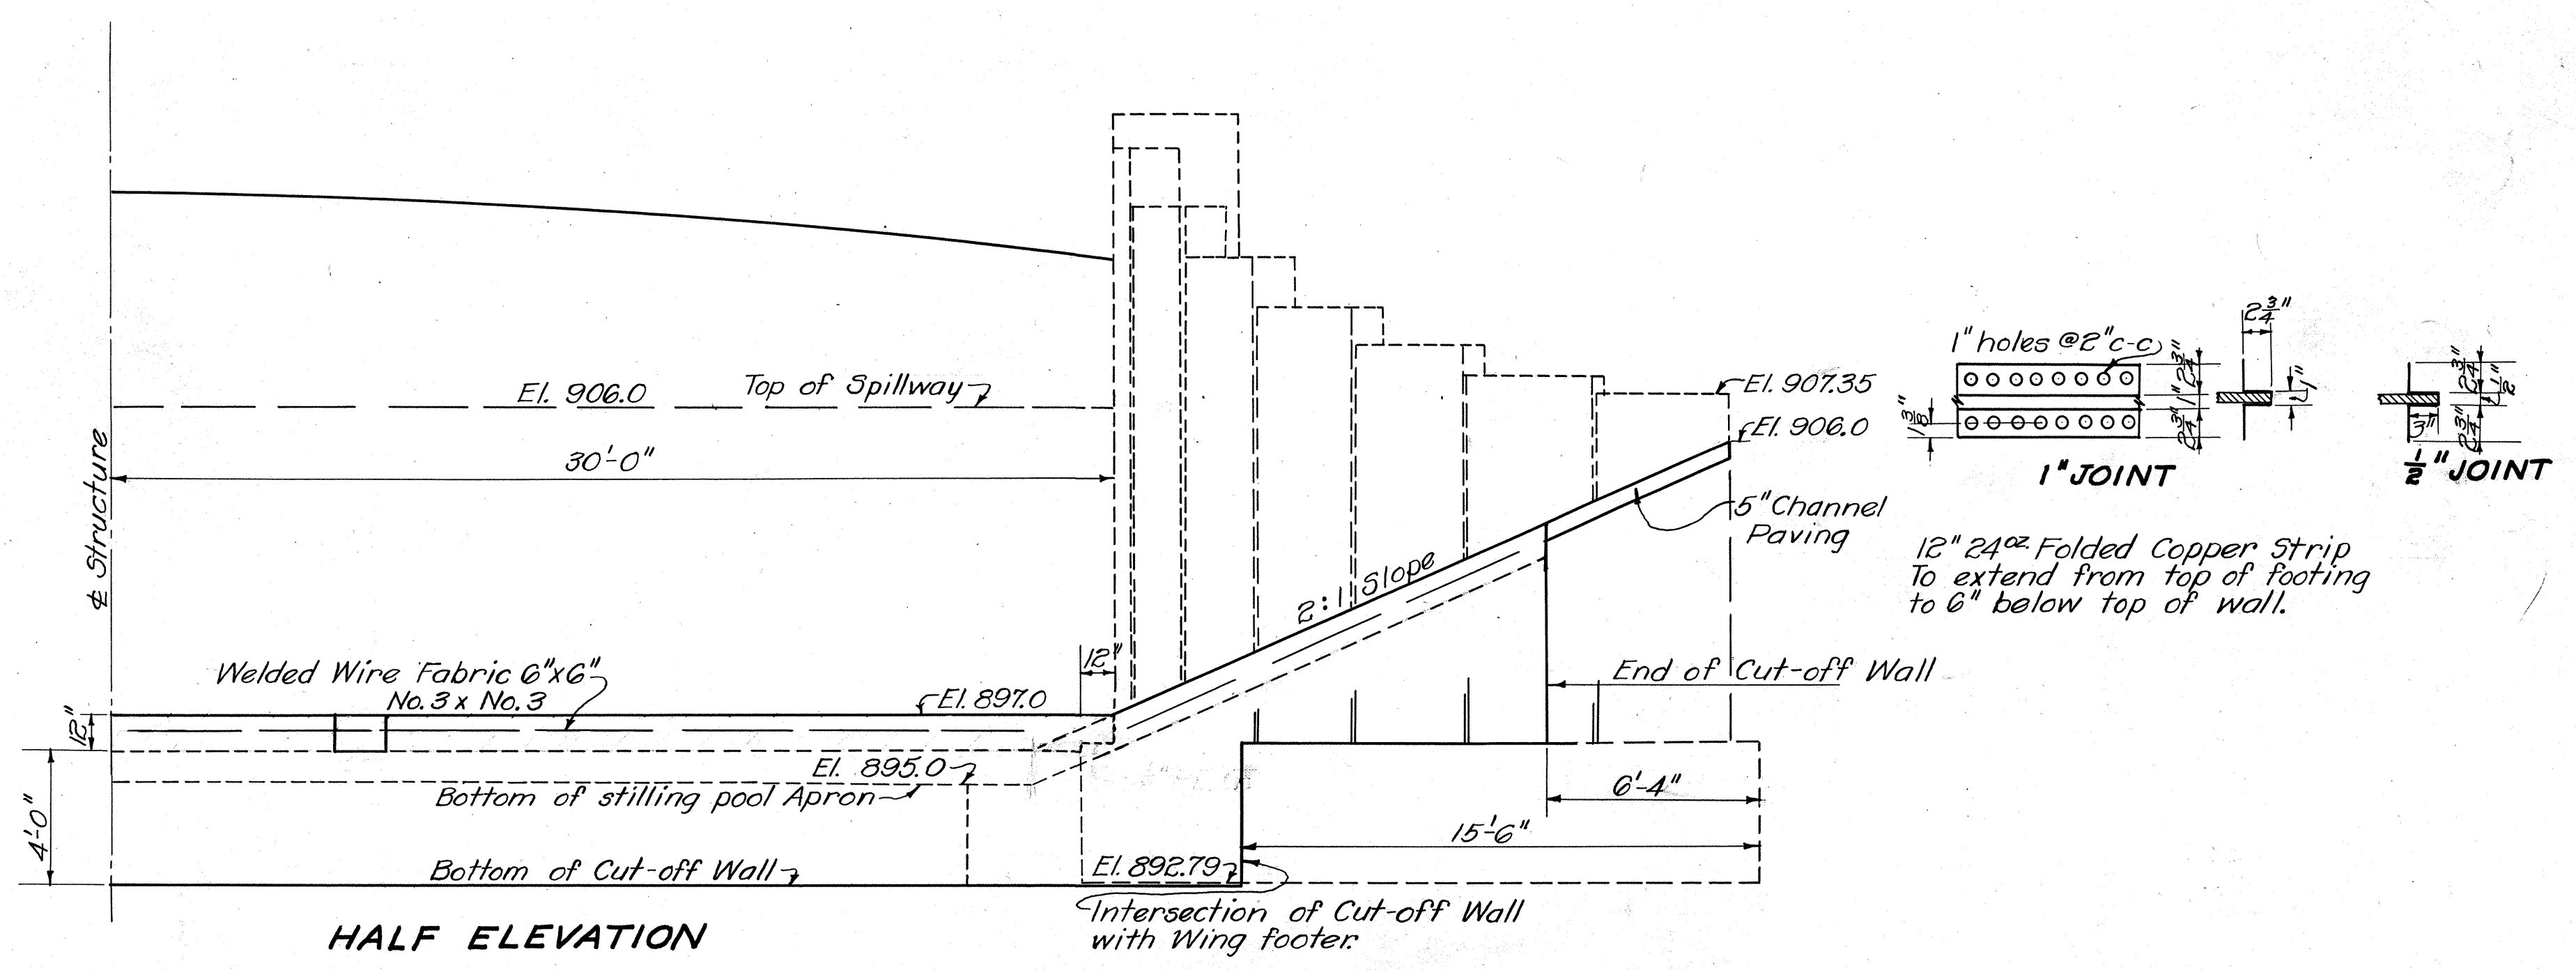


12" 24^{oz} Folded Copper Strip to extend from top of footing to 6" below top of wall.

REINFORCING STEEL						
Mark	Size	No.	Length	Weight	Shape	Rad.
BARREL						
F	3/8" φ	66	5'-0"	496	Str.	
E	3/8" φ	133	18'-6"	2566	Bt.	
R ₁	3/8" φ	16	33'-9"	563	Bt.	83'-9"
R ₂	3/8" φ	4	33'-3"	139	Bt.	82'-6"
R ₃	3/8" φ	4	32'-0"	134	Bt.	79'-6"
R ₄	3/8" φ	4	30'-9"	128	Bt.	76'-6"
R ₅	3/8" φ	4	29'-9"	124	Bt.	73'-6"
Dowels	3/8" φ	54	4'-0"	225	Str.	
BREAST WALLS						
M	1" φ	120	23'-6"	7529	Bt.	
N	1" φ	126	13'-6"	4542	Bt.	
P	3/8" φ	126	8'-0"	2060	Bt.	
O ₁	3/8" φ	134	19'-0"	3827	Str.	
O ₂	3/8" φ	8	18'-6"	222	Str.	
O ₃	3/8" φ	10	17'-0"	255	Str.	
O ₄	3/8" φ	8	15'-6"	186	Str.	
O ₅	3/8" φ	10	14'-0"	210	Str.	
R ₆	3/8" φ	4	20'-6"	86	Bt.	23'-3"
R ₇	3/8" φ	4	20'-3"	85	Bt.	22'-11"
R ₈	3/8" φ	12	20'-0"	250	Bt.	22'-7"
R ₉	3/8" φ	4	19'-9"	82	Bt.	22'-3"
R ₁₀	3/8" φ	4	19'-6"	81	Bt.	21'-11"
R ₁₁	3/8" φ	40	30'-0"	1252	Str.	
R ₁₂	3/8" φ	2	0'-0"	13	Bt.	18'-9"
R ₁₃	3/8" φ	2	10'-0"	21	Bt.	18'-5"
R ₁₄	3/8" φ	2	13'-0"	27	Bt.	18'-5"
R ₁₅	3/8" φ	4	16'-3"	68	Bt.	18'-1"
R ₁₆	3/8" φ	4	16'-0"	67	Bt.	17'-9"
R ₁₇	3/8" φ	4	15'-9"	66	Bt.	17'-5"
R ₁₈	3/8" φ	20	21'-3"	443	Bt.	24'-4"
R ₁₉	3/8" φ	12	17'-6"	219	Bt.	19'-10"
R ₂₀	3/8" φ	2	13'-0"	27	Bt.	19'-10"
R ₂₁	3/8" φ	2	10'-0"	21	Bt.	19'-10"
R ₂₂	3/8" φ	2	6'-0"	13	Bt.	19'-10"
R ₂₃	3/8" φ	4	23'-0"	96	Bt.	26'-6"
R ₂₄	3/8" φ	4	16'-9"	70	Bt.	18'-6"
R ₂₅	3/8" φ	4	19'-9"	82	Bt.	22'-6"
R ₂₆	3/8" φ	8	16'-6"	138	Bt.	18'-6"
R ₂₇	3/8" φ	4	13'-6"	56	Bt.	14'-6"
R ₂₈	3/8" φ	16	32'-3"	538	Str.	
BAFFLE CUBES						
B	3/8" φ	57	8'-0"	475	Bt.	
BH	1/2" φ	114	1'-2"	90	Str.	
OUTLET BOX						
W	1/2" φ	12	19'-6"	156	Str.	
H	1/2" φ	84	5'-0"	437	Str.	
APRON						
Dowels	3/8" φ	45	2'-0"	94	Str.	
Welded Wire Fabric 6" x 6" No. 3 x No. 3						
Total 28,259						



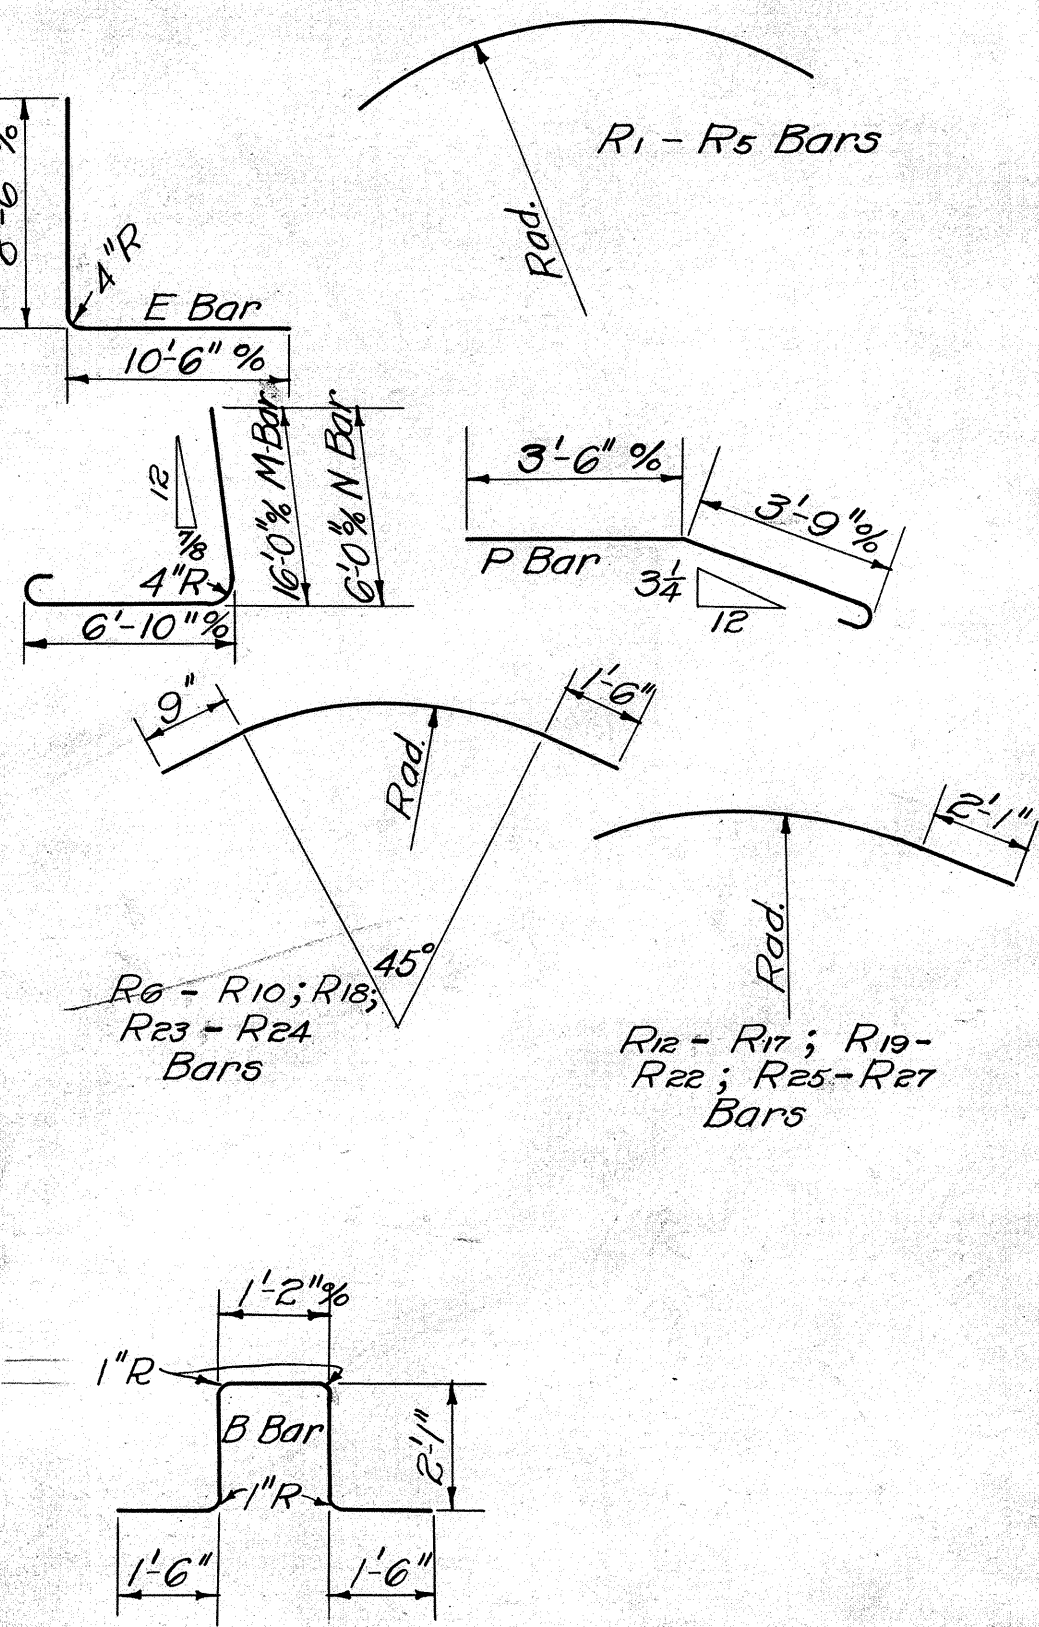


ESTIMATED QUANTITIES*			AS BUILT	
ITEM	DESCRIPTION	QUANTITY	Change Order	Final Quantity
SPILLWAY, APRON, OUTLET, NOWING WALLS, & CHANNEL				
E-2	Excavation for structure (unclassified)	363 cu. yd.		363
E-2	Excavation for structure (rock or shale)	316 cu. yd.		316
E-3	Channel Excavation	13504 cu. yd.		13,504
S-1	Class E Conc., Barrel, Apron, Cubes & Outlet Box	580 cu. yd.	*2, +17	598
S-1	Class E Conc., Wing Walls & Collars	210 cu. yd.		210
S-1	Class E Conc., Wing Wall Footings, Cut-off & Toe Walls	162 cu. yd.	*2, +26	188
S-3	Type A waterproofing	270 sq. yd.		270
S-3	Type B waterproofing, 36" wide	26 sq. yd.		26
S-4	Reinforcing steel	28,259 lbs.		28,259
S-9	Folded Copper Strip 12" - 24 Oz.	108 lin. ft.	*2, 34.5	73.5
S-9	1" Premolded Expansion Joint Filler	250 sq. ft.	*2, -5.5	195
S-9	1/2" Premolded Expansion Joint Filler	480 sq. ft.	*2, -40	440
S-29	Porous backfill	35 cu. yd.		35
Special	Water control gate, complete	Lump Sum		Lump Sum
I-3	24" Roadway Drain Reinf. Conc. Pipe (Sec. M-64(G))	148 lin. ft.		148
I-3	24" Roadway Drain Corr. Metal Pipe (Sec. M-64(G))	20 lin. ft.		20
Special	5" Concrete Channel Pavement	436 sq. yd.	*3, +62	498

* These quantities are non-participating by P.R.A.

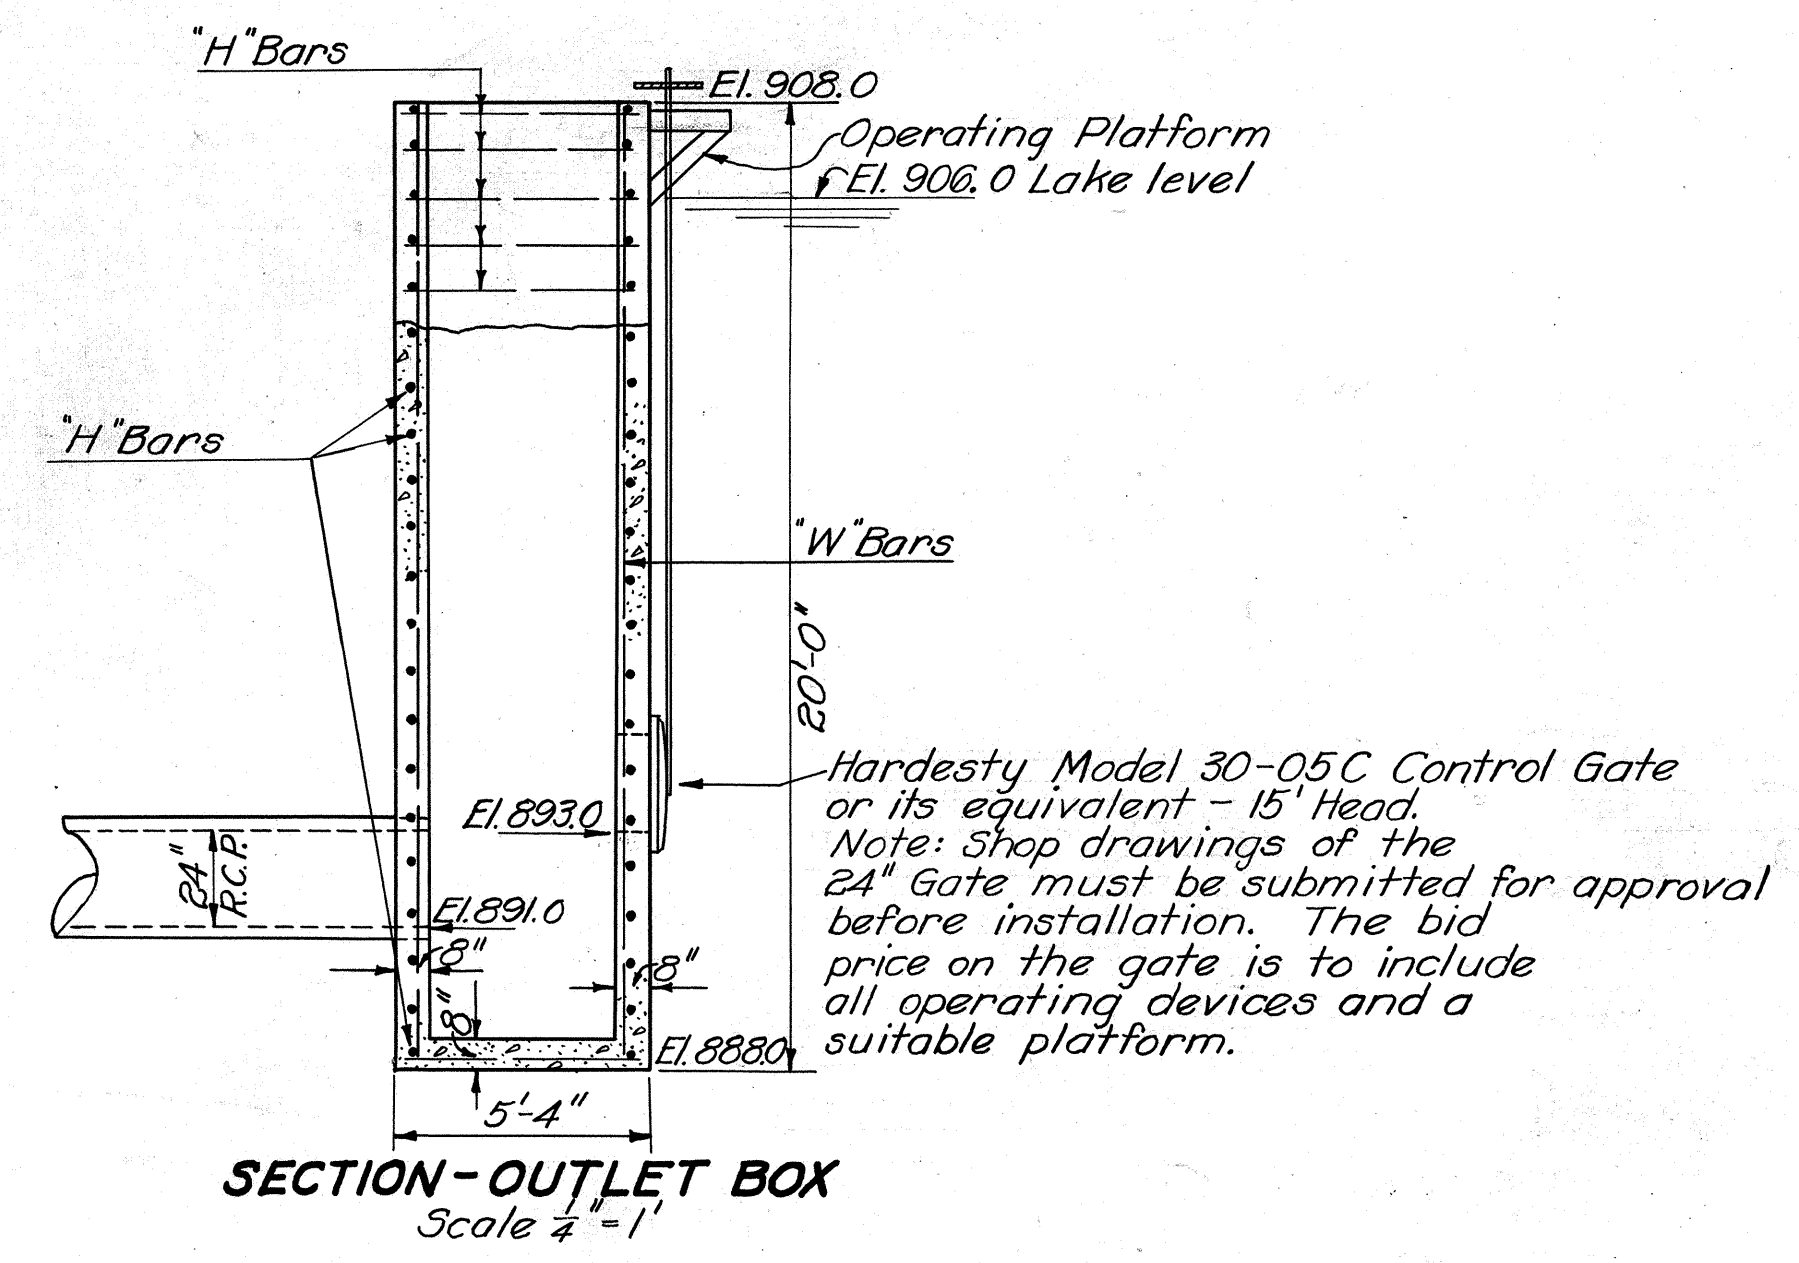

Welded wire fabric included with 5" concrete channel pavement for payment.

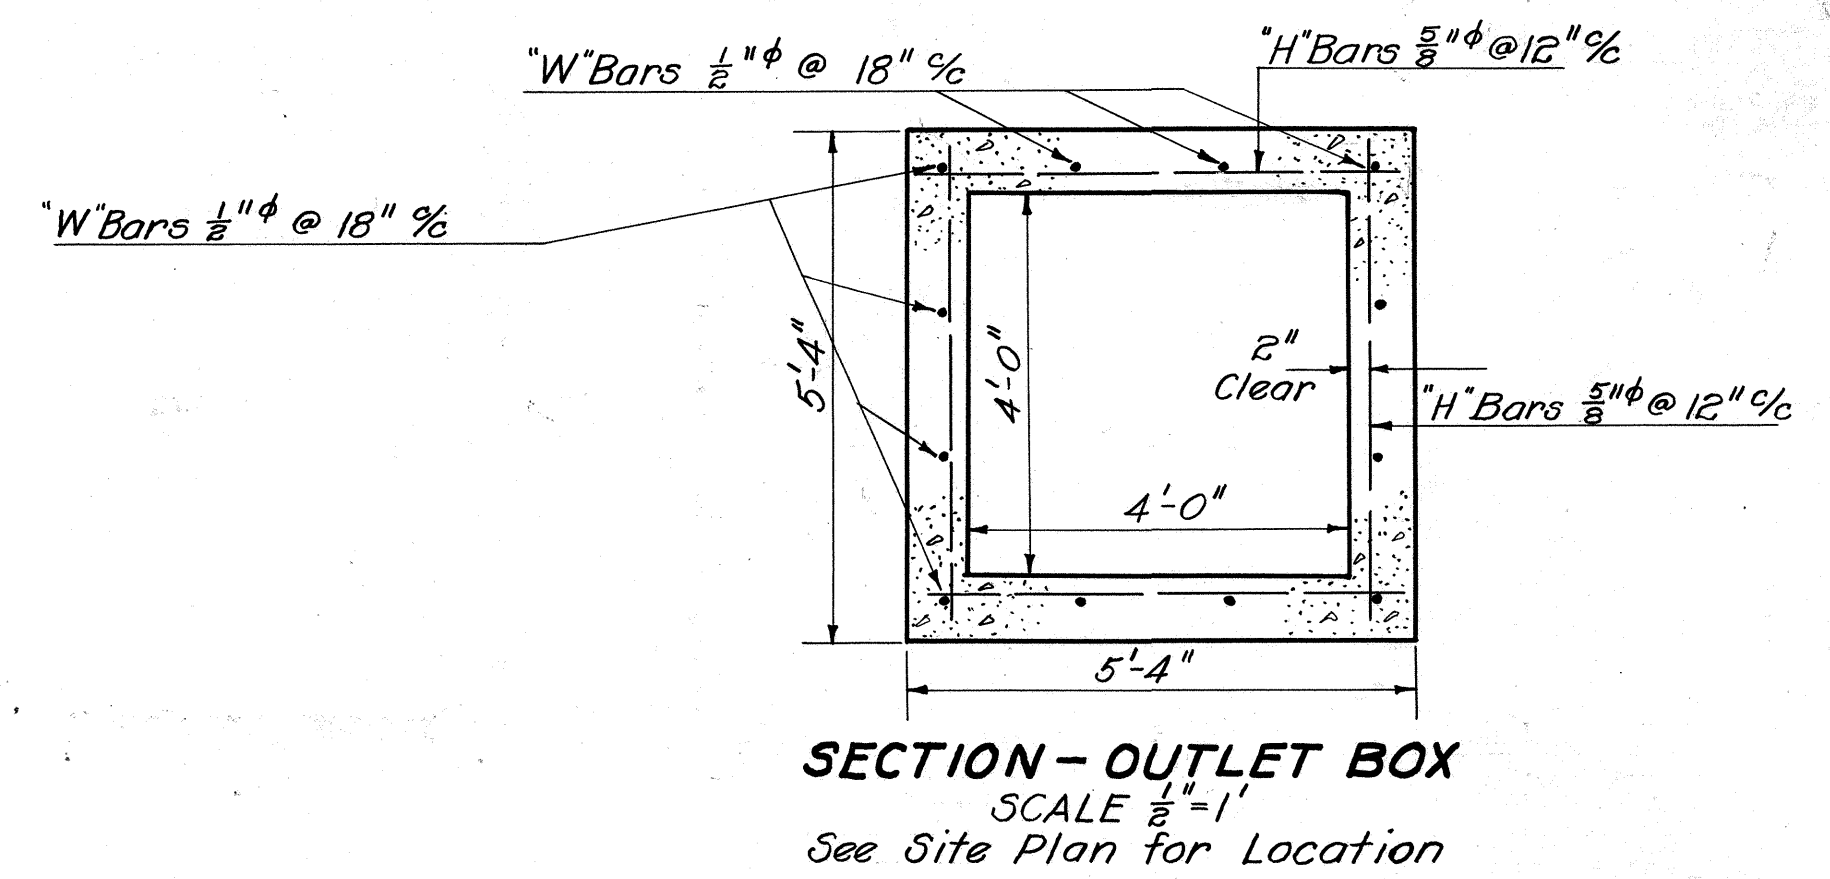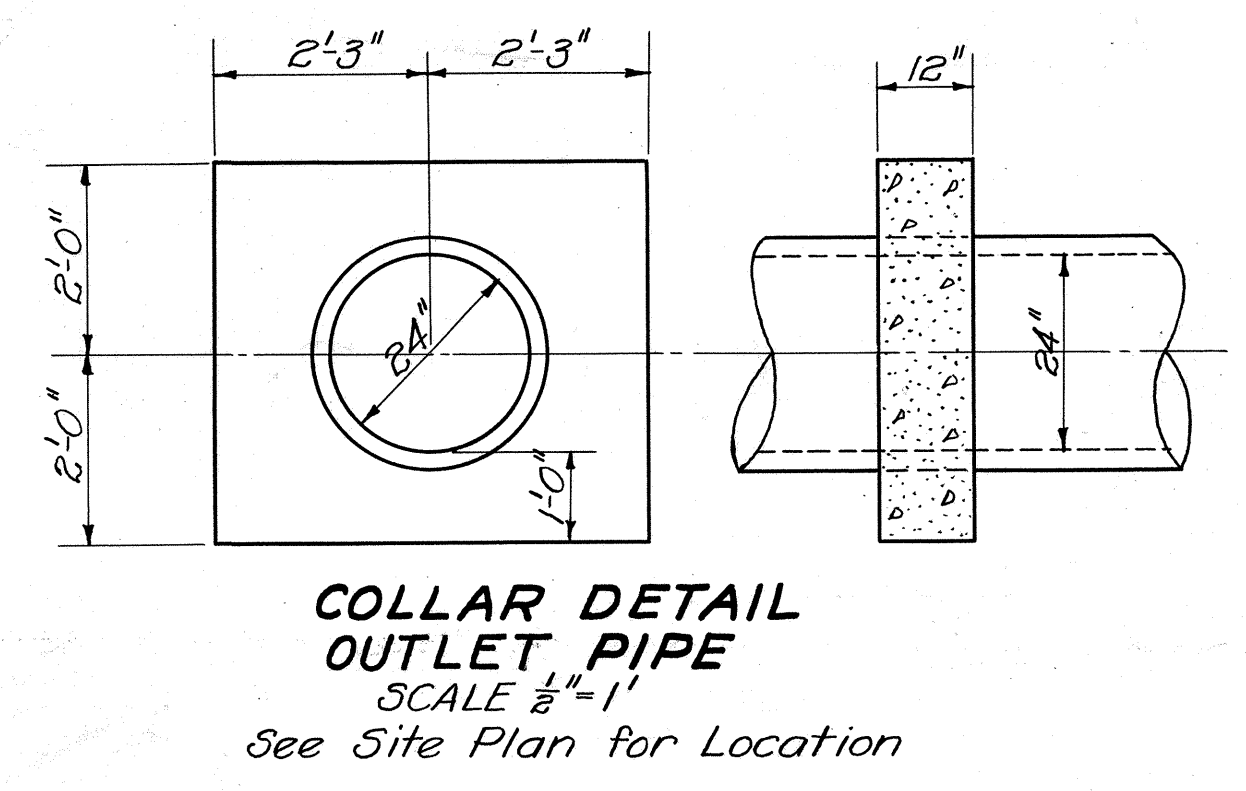
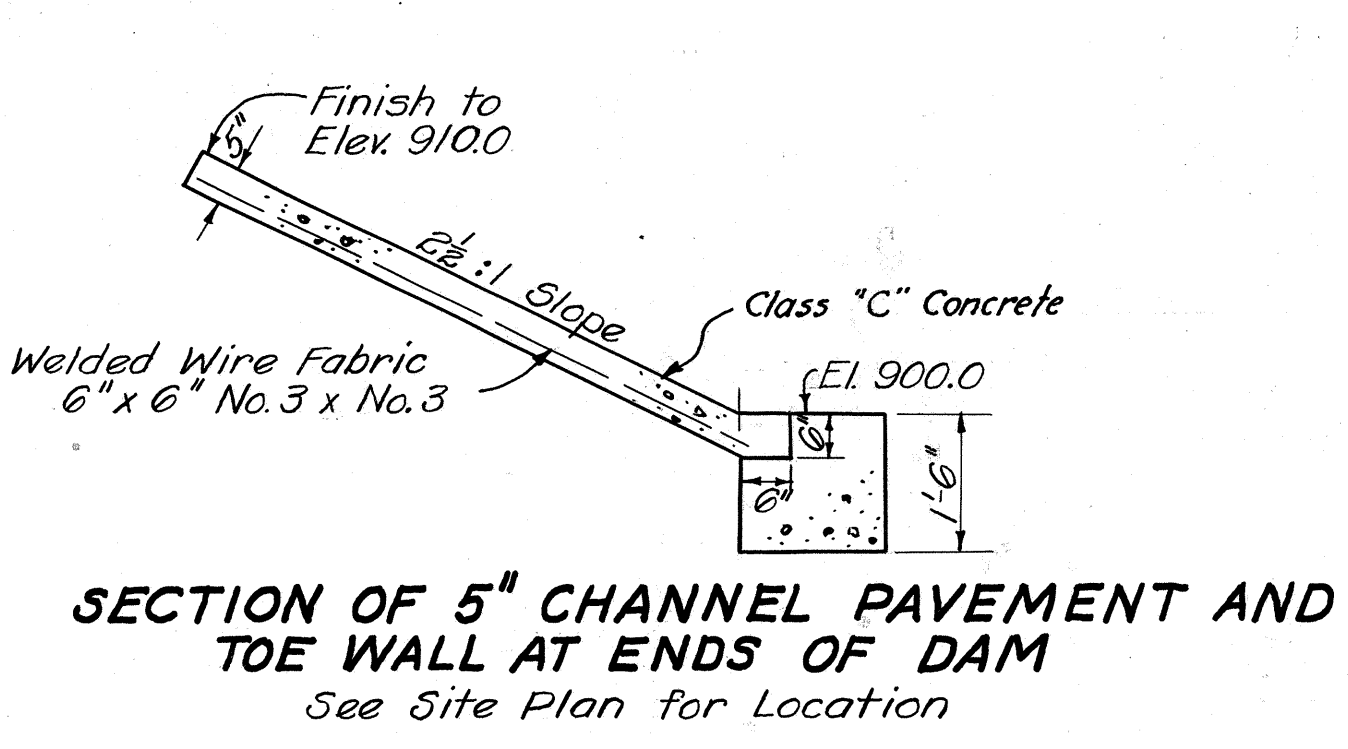


STATE OF OHIO
DEPARTMENT OF HIGHWAYS
BUREAU OF BRIDGES

APRON VIEW SUMMARY TABLES
BRIDGE NO. BR-774-106
OVER STERLING RUN

BROWN COUNTY S. H. 951
SEC. E STA. 41+00

DESIGNED	DRAWN	TRACED	CHECKED	REVIEWED	DATE	REVISED
W.H.	W.H.	N.E.	P.W.R.	BFG	11-29-46	12-2-46
					11-8-46	4-2-47

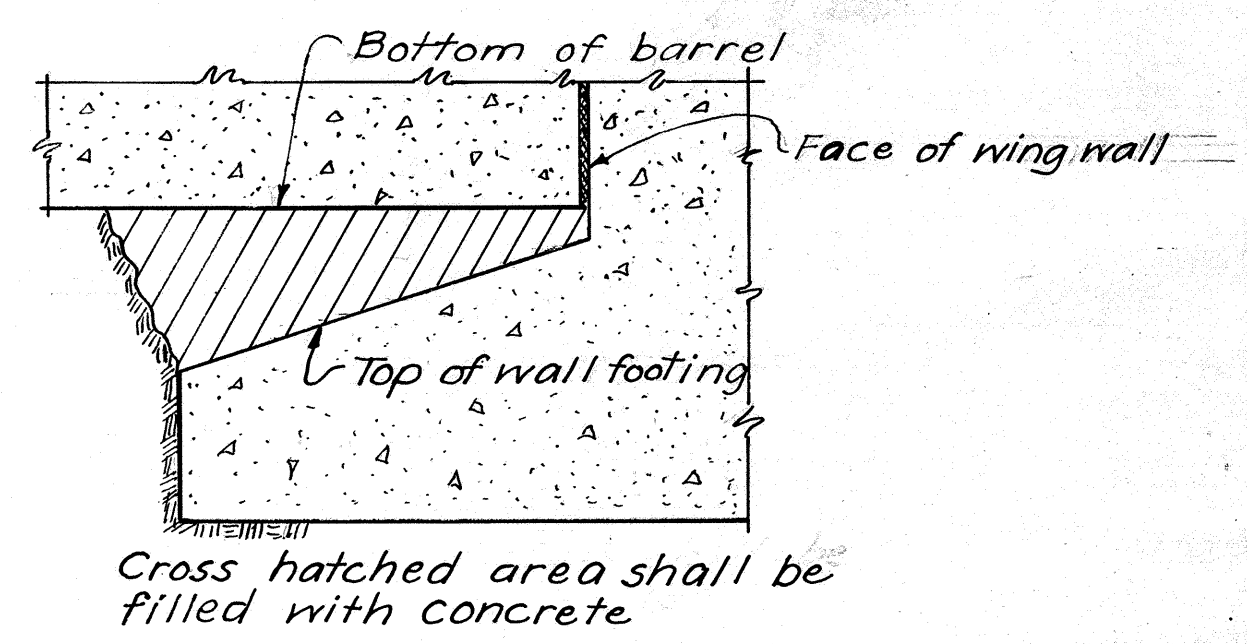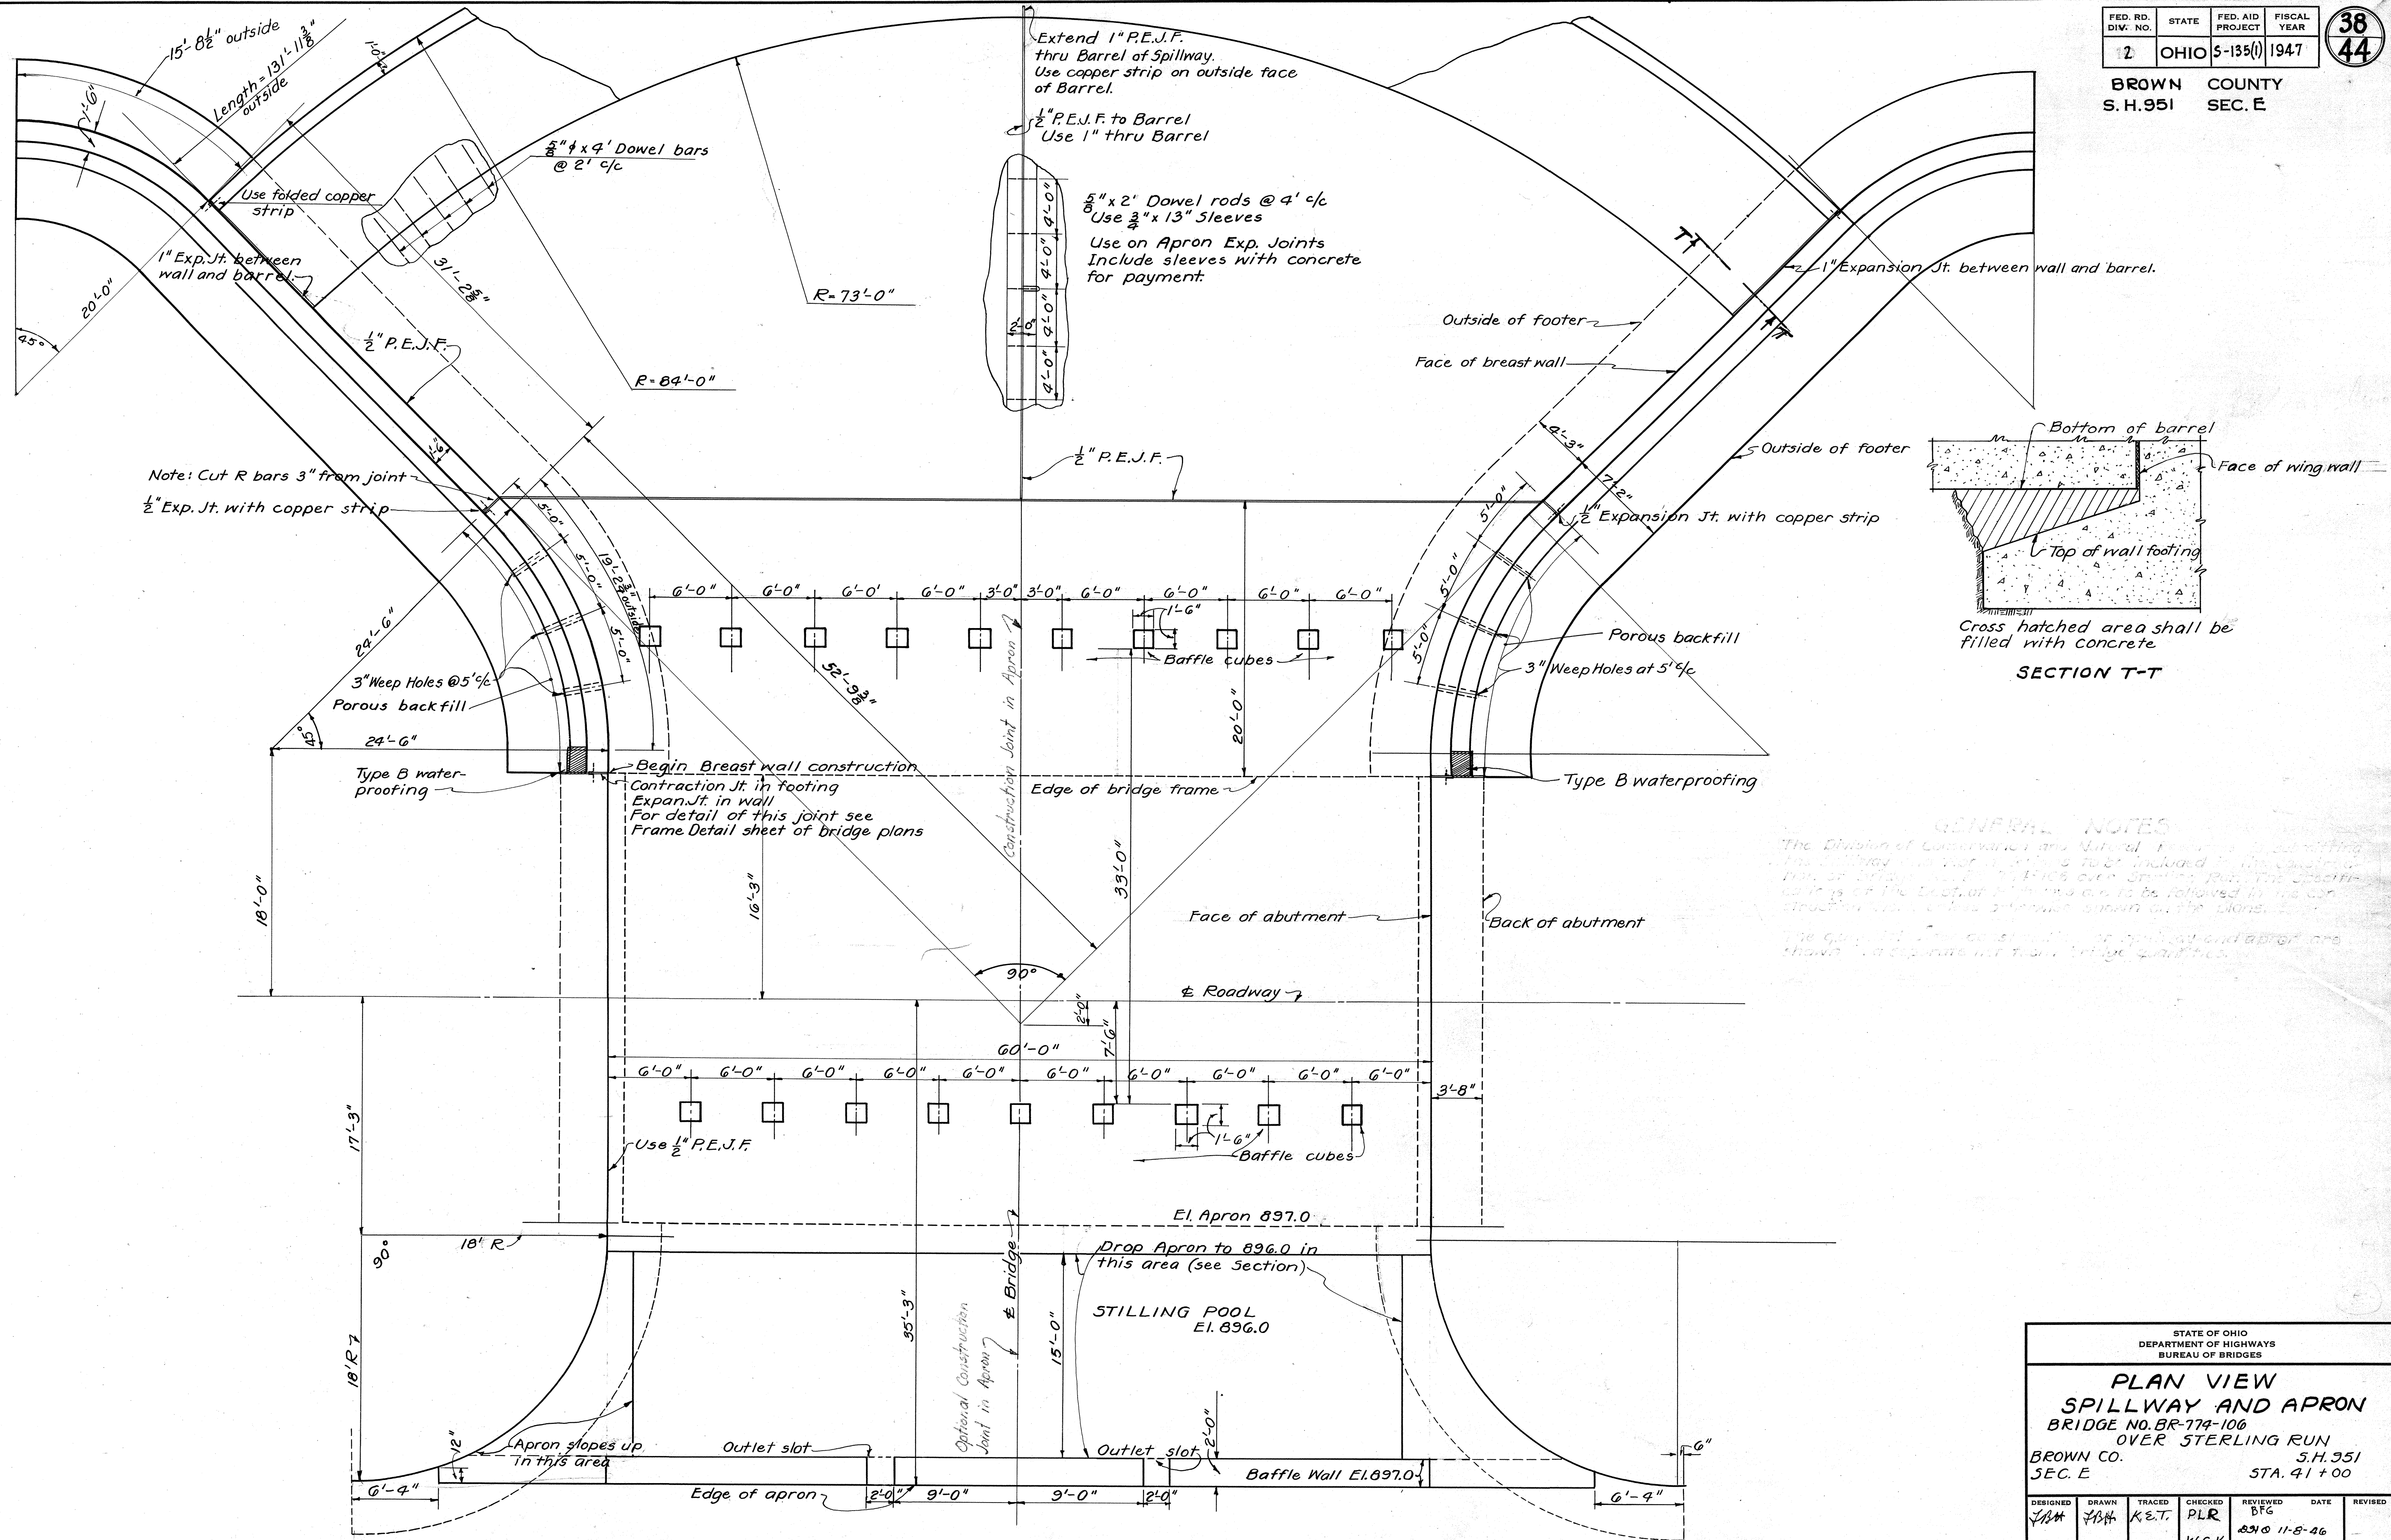

SECTION T-T

GENERAL NOTES

The Division of Conservation and Natural Resources is submitting this plan and specifications to be included in the construction of the spillway and apron over Sterling Run. The specifications are of the Department of Highways and shall be followed in the construction of the spillway and apron within the limits shown.

The general construction of the spillway and apron are shown in a separate set from bridge quantities.

STATE OF OHIO DEPARTMENT OF HIGHWAYS BUREAU OF BRIDGES						
PLAN VIEW						
SPILLWAY AND APRON						
BRIDGE NO. BR-774-106 OVER STERLING RUN						
BROWN CO. S.H. 951 SEC. E STA. 41 + 00						
DESIGNED	DRAWN	TRACED	CHECKED	REVIEWED	DATE	REVISED
J.A.H.	J.A.H.	K.E.T.	PLR	BFG	8/10 11-8-46	
			W.C.K.			

ESTIMATED QUANTITIES


Item E-3 Channel Excavation (Carried to Bridge Quantities Sheet No. 37)
 Item Special 5" Concrete Channel Paving (Carried to Bridge Quantities Sheet No. 37)
 Item L-9 Seeding and Protecting (Type 'A') Area (Carried to Line Sht. No. 12)

13,504 Cu. Yds.
 297 Sq. Yds.
 2,051 Cu. Yds.

FED. RD. DIVISION	STATE	PROJECT	FISCAL YEAR
2	OHIO	5-135 (1)	1947


40
44

BROWN COUNTY
S.H. 951 SEC. E (PT.)

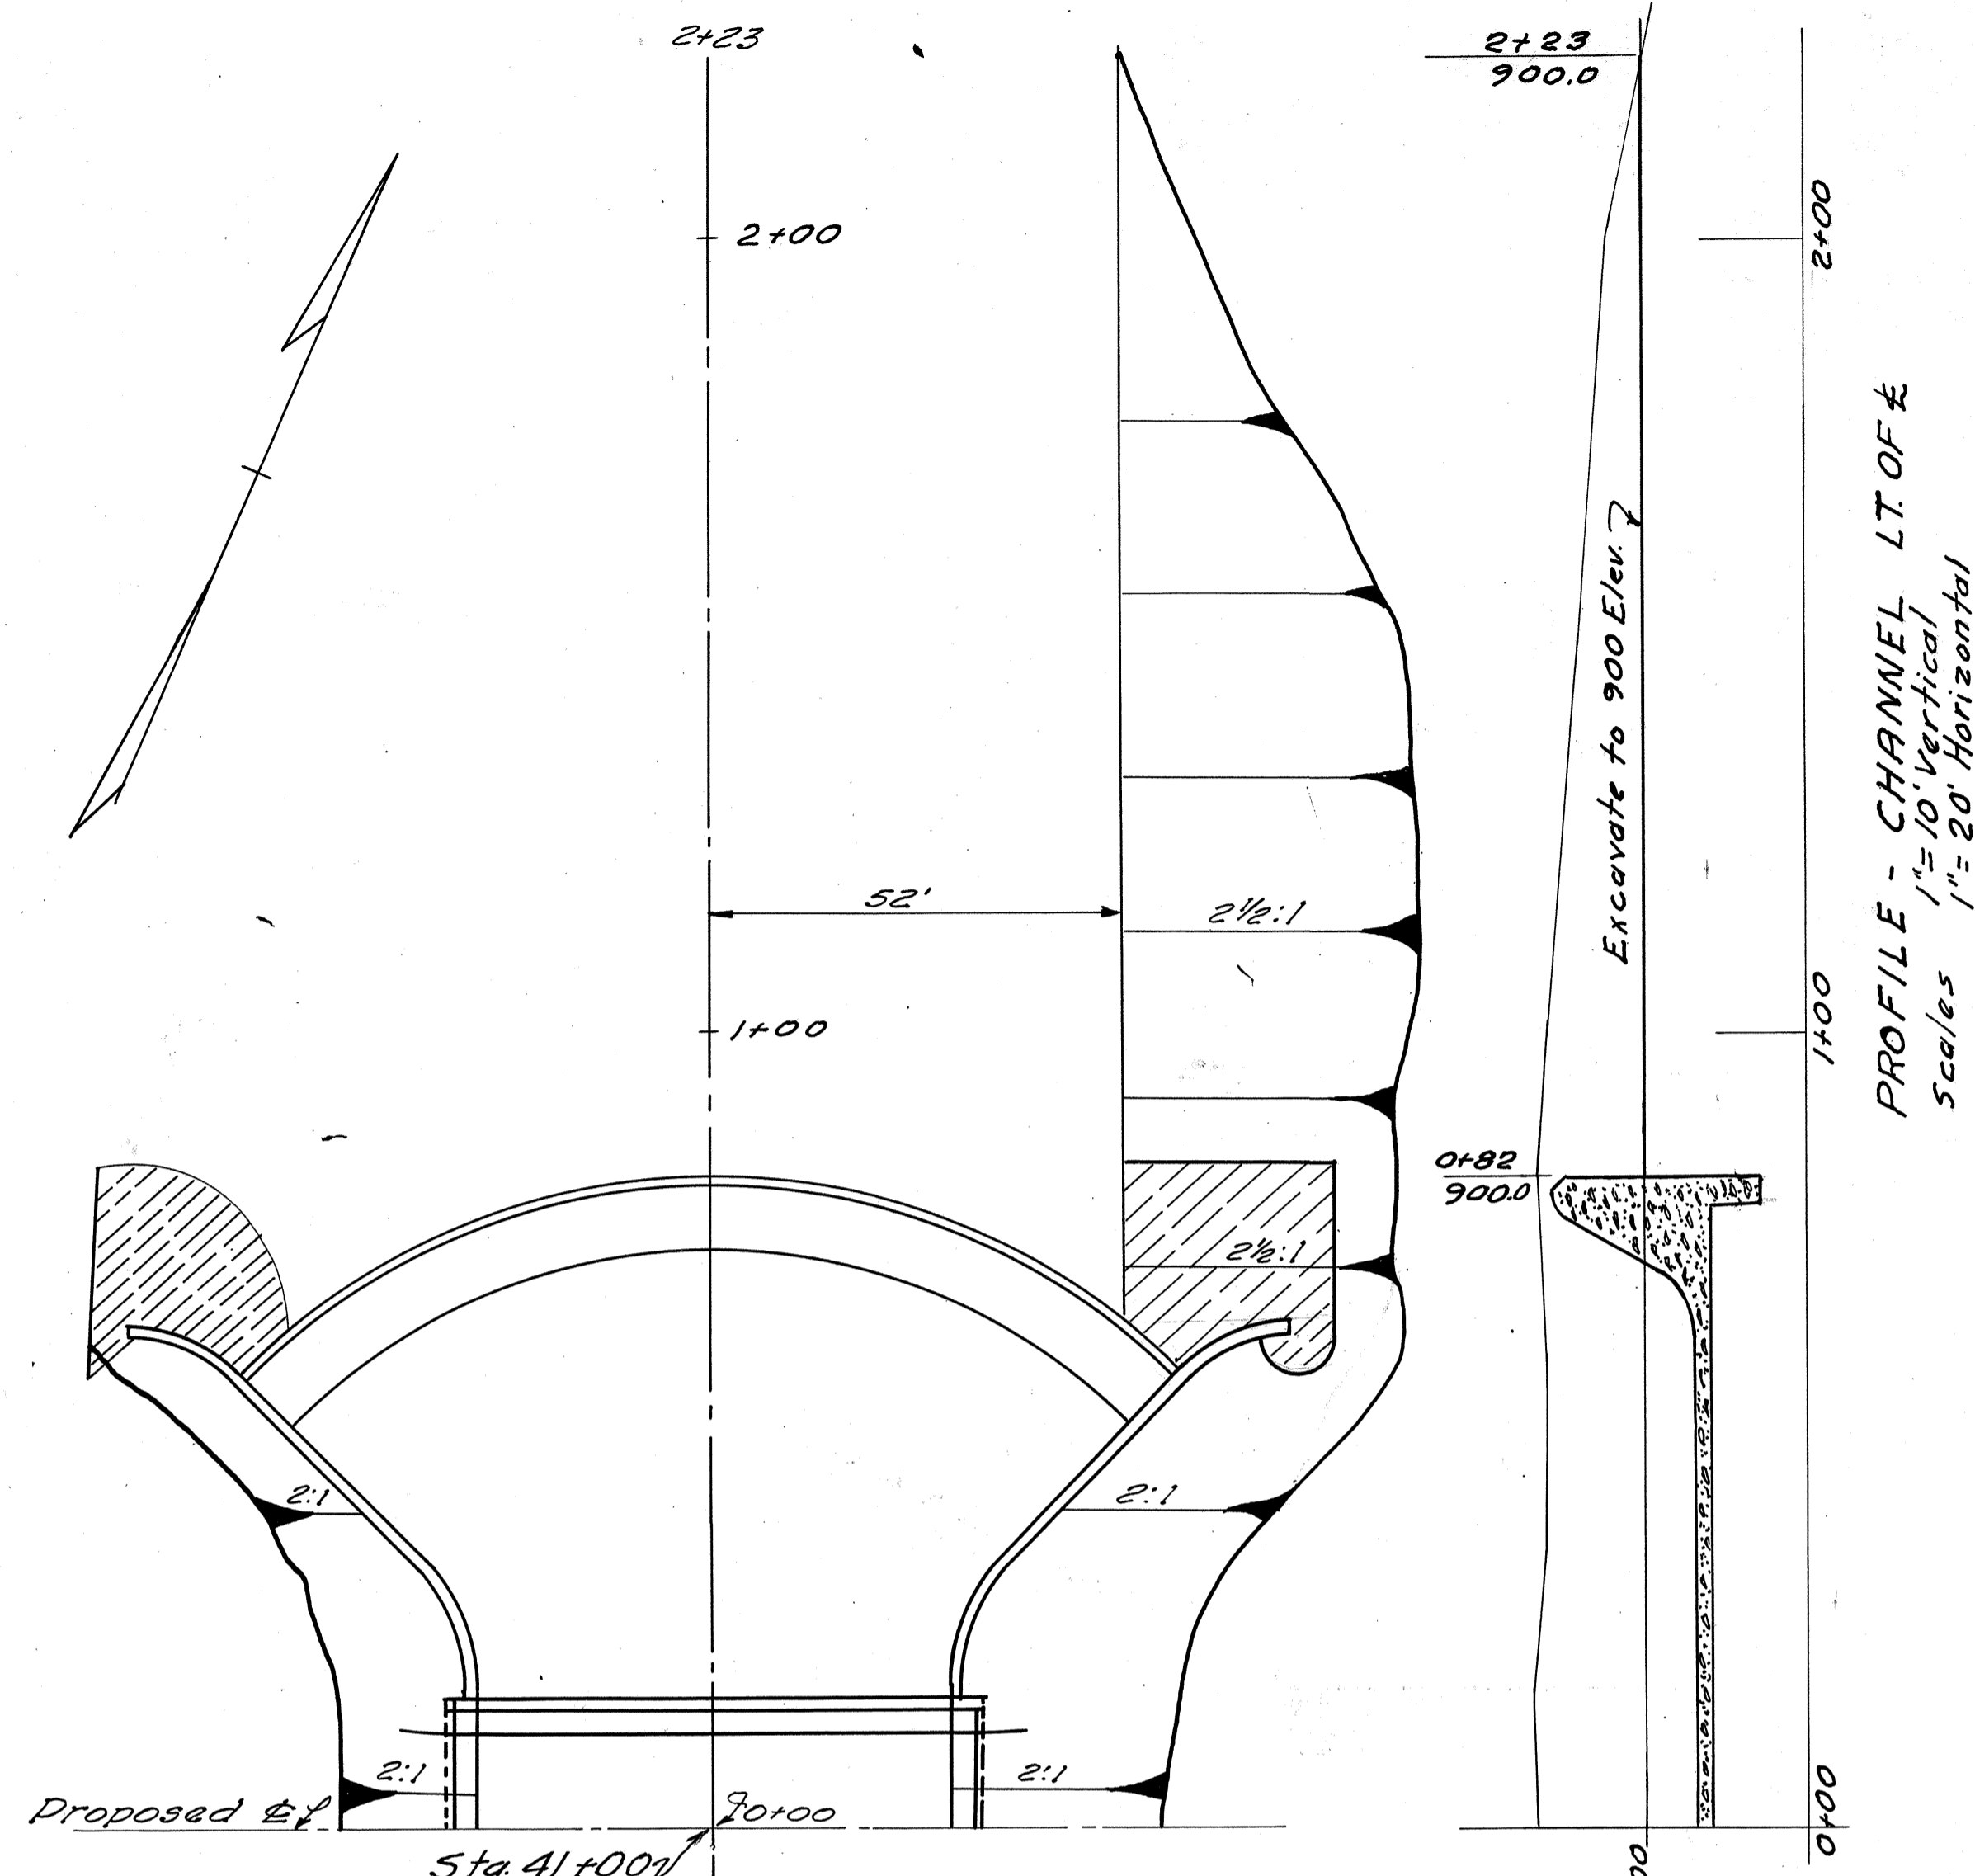


PROFILE - CHANNEL LT. OF C
 1"=10' Vertical
 5"=20' Horizontal

PLAN - CHANNEL LT. OF C
 Scale 1"=20'

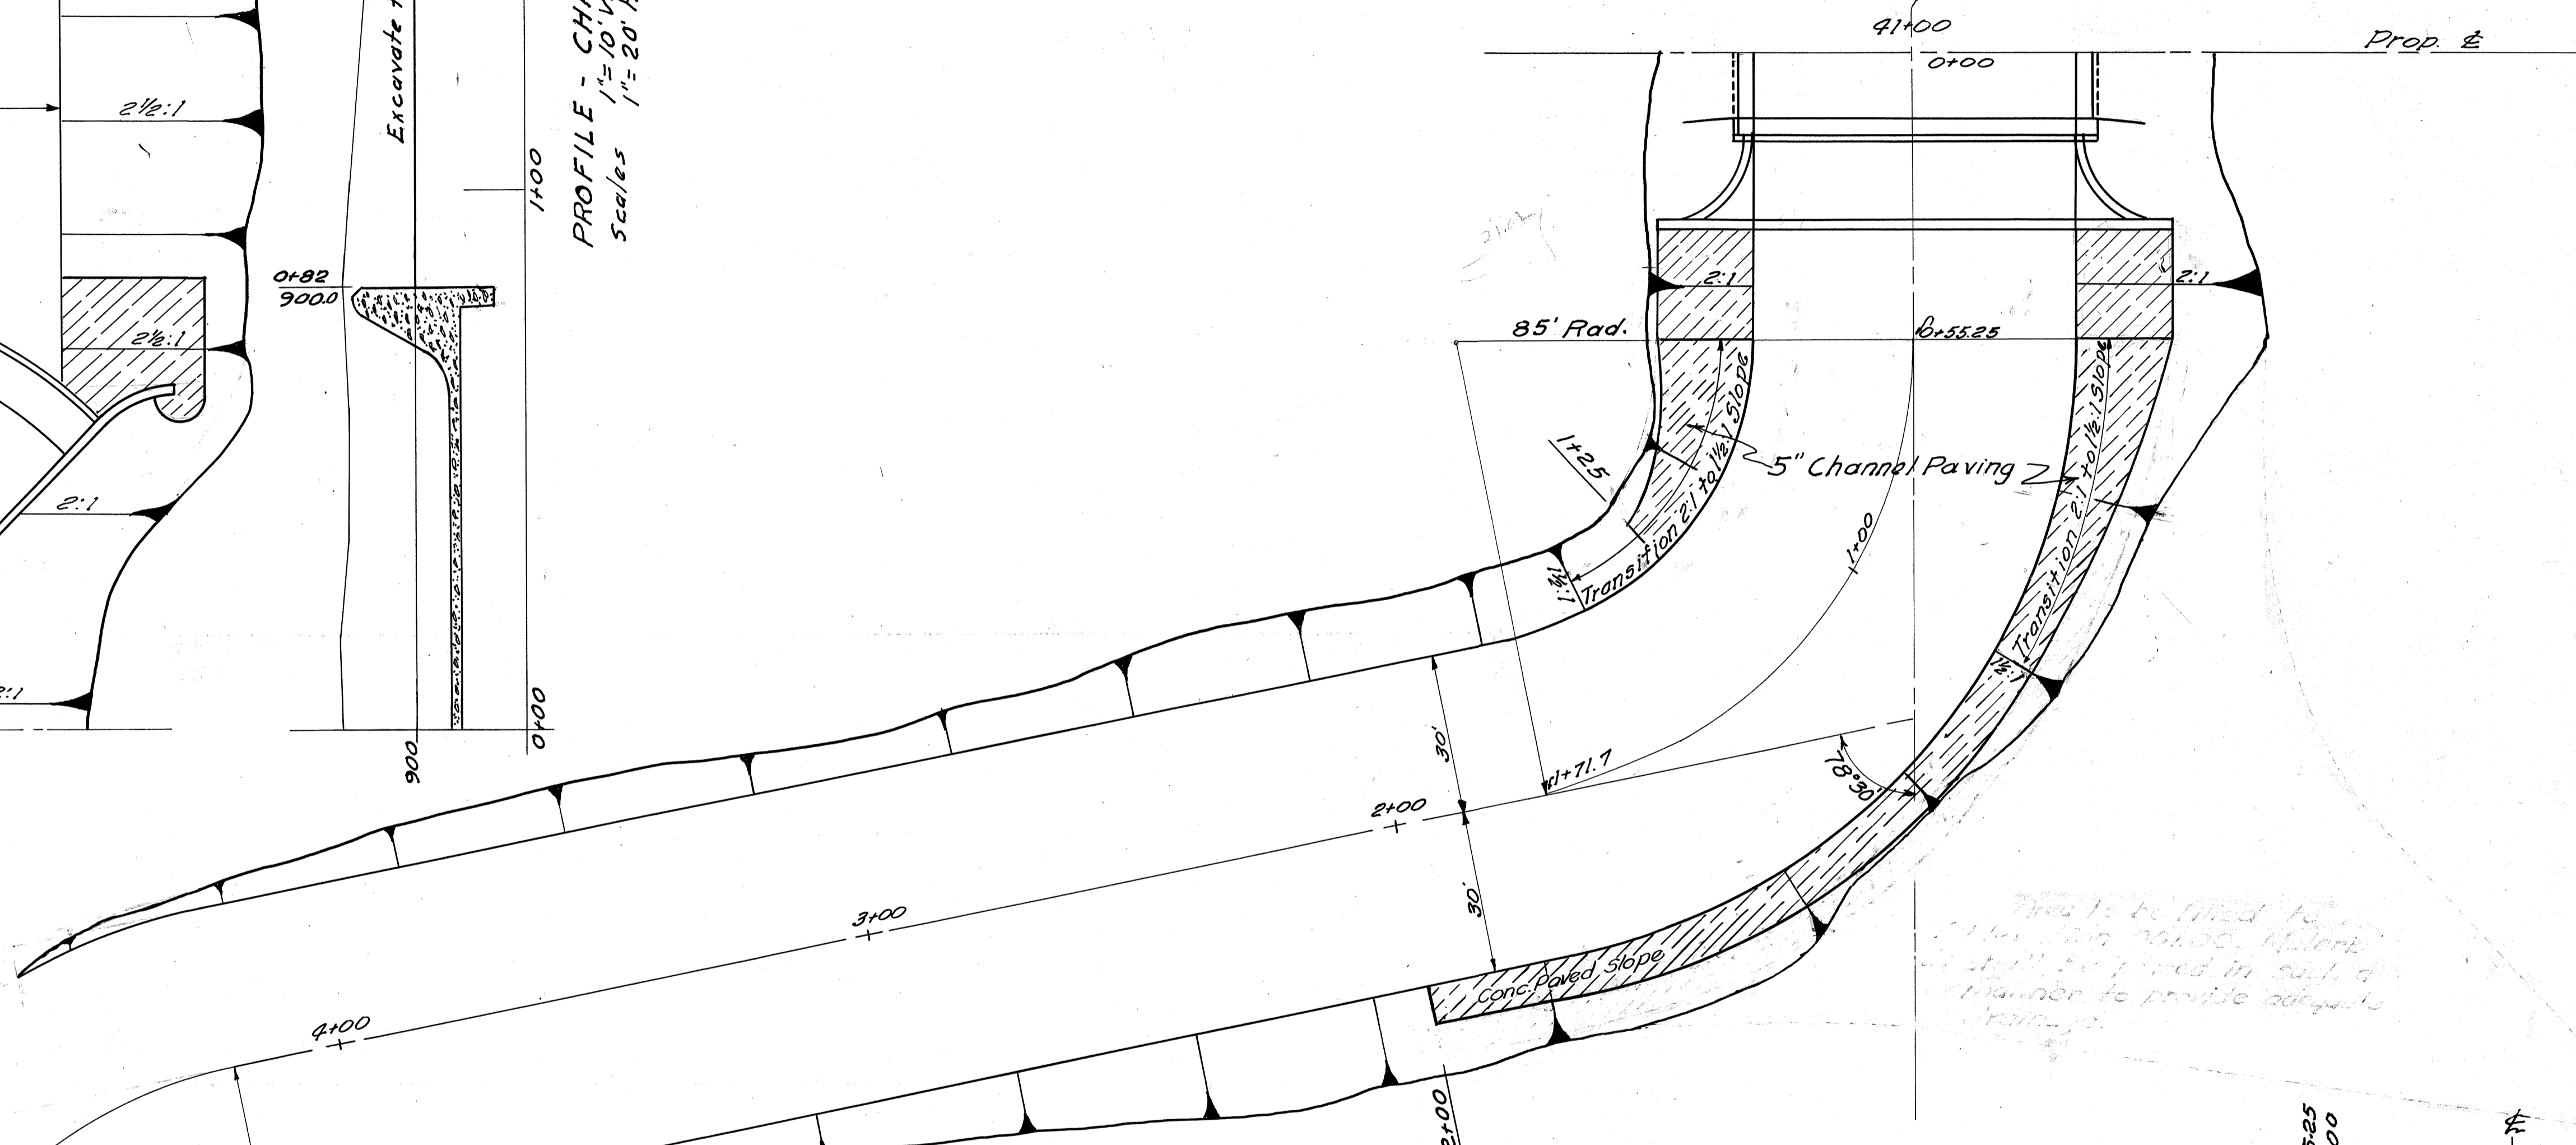

PLAN - CHANNEL RT. OF C
 Scale 1"=20'

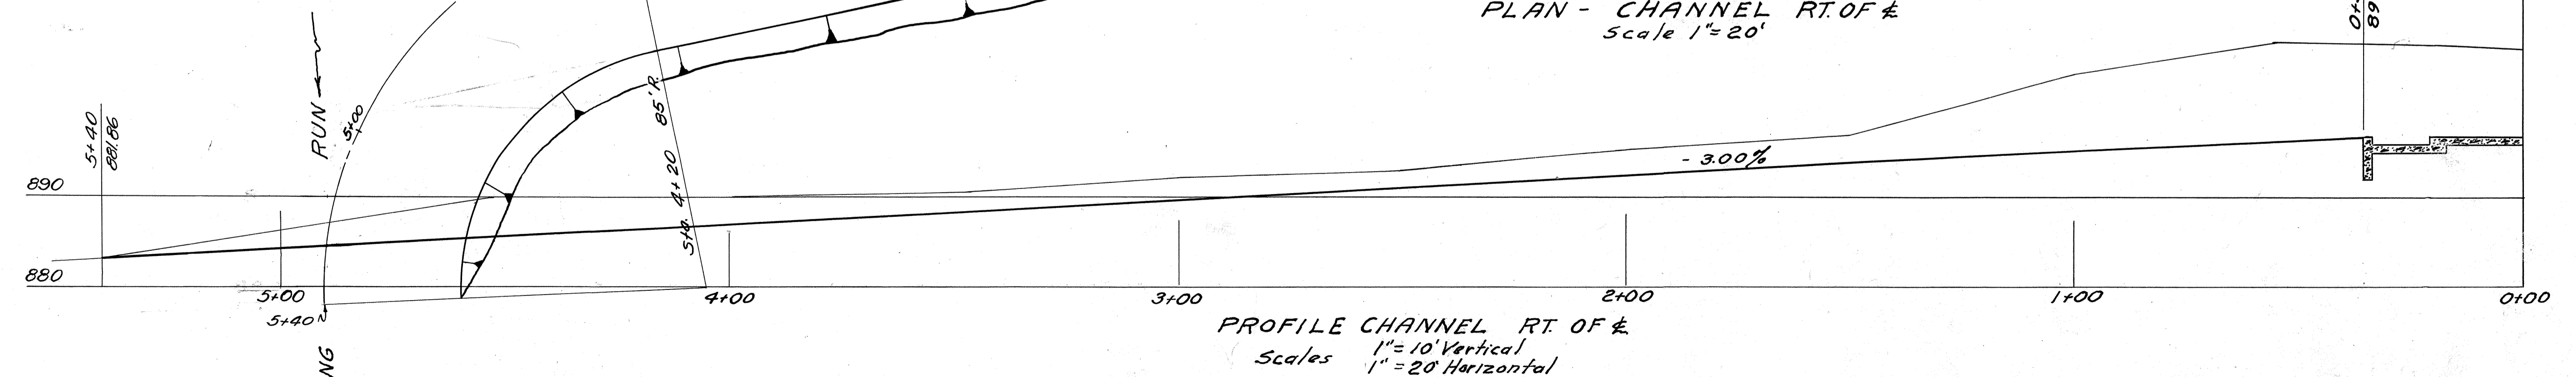


PROFILE CHANNEL RT. OF C
 Scales 1"=10' Vertical
 5"=20' Horizontal

PROPOSED CHANNEL STA. 41+00 RT. & LT. OF C

Seeding
End Sq.
Area Yds.

DIVISION 2 STATE OHIO PROJECT 5-135 (1) 1947 SHEET NO. 41 OF 44

**BROWN COUNTY
S.H. 951. SEC. E (PT)**

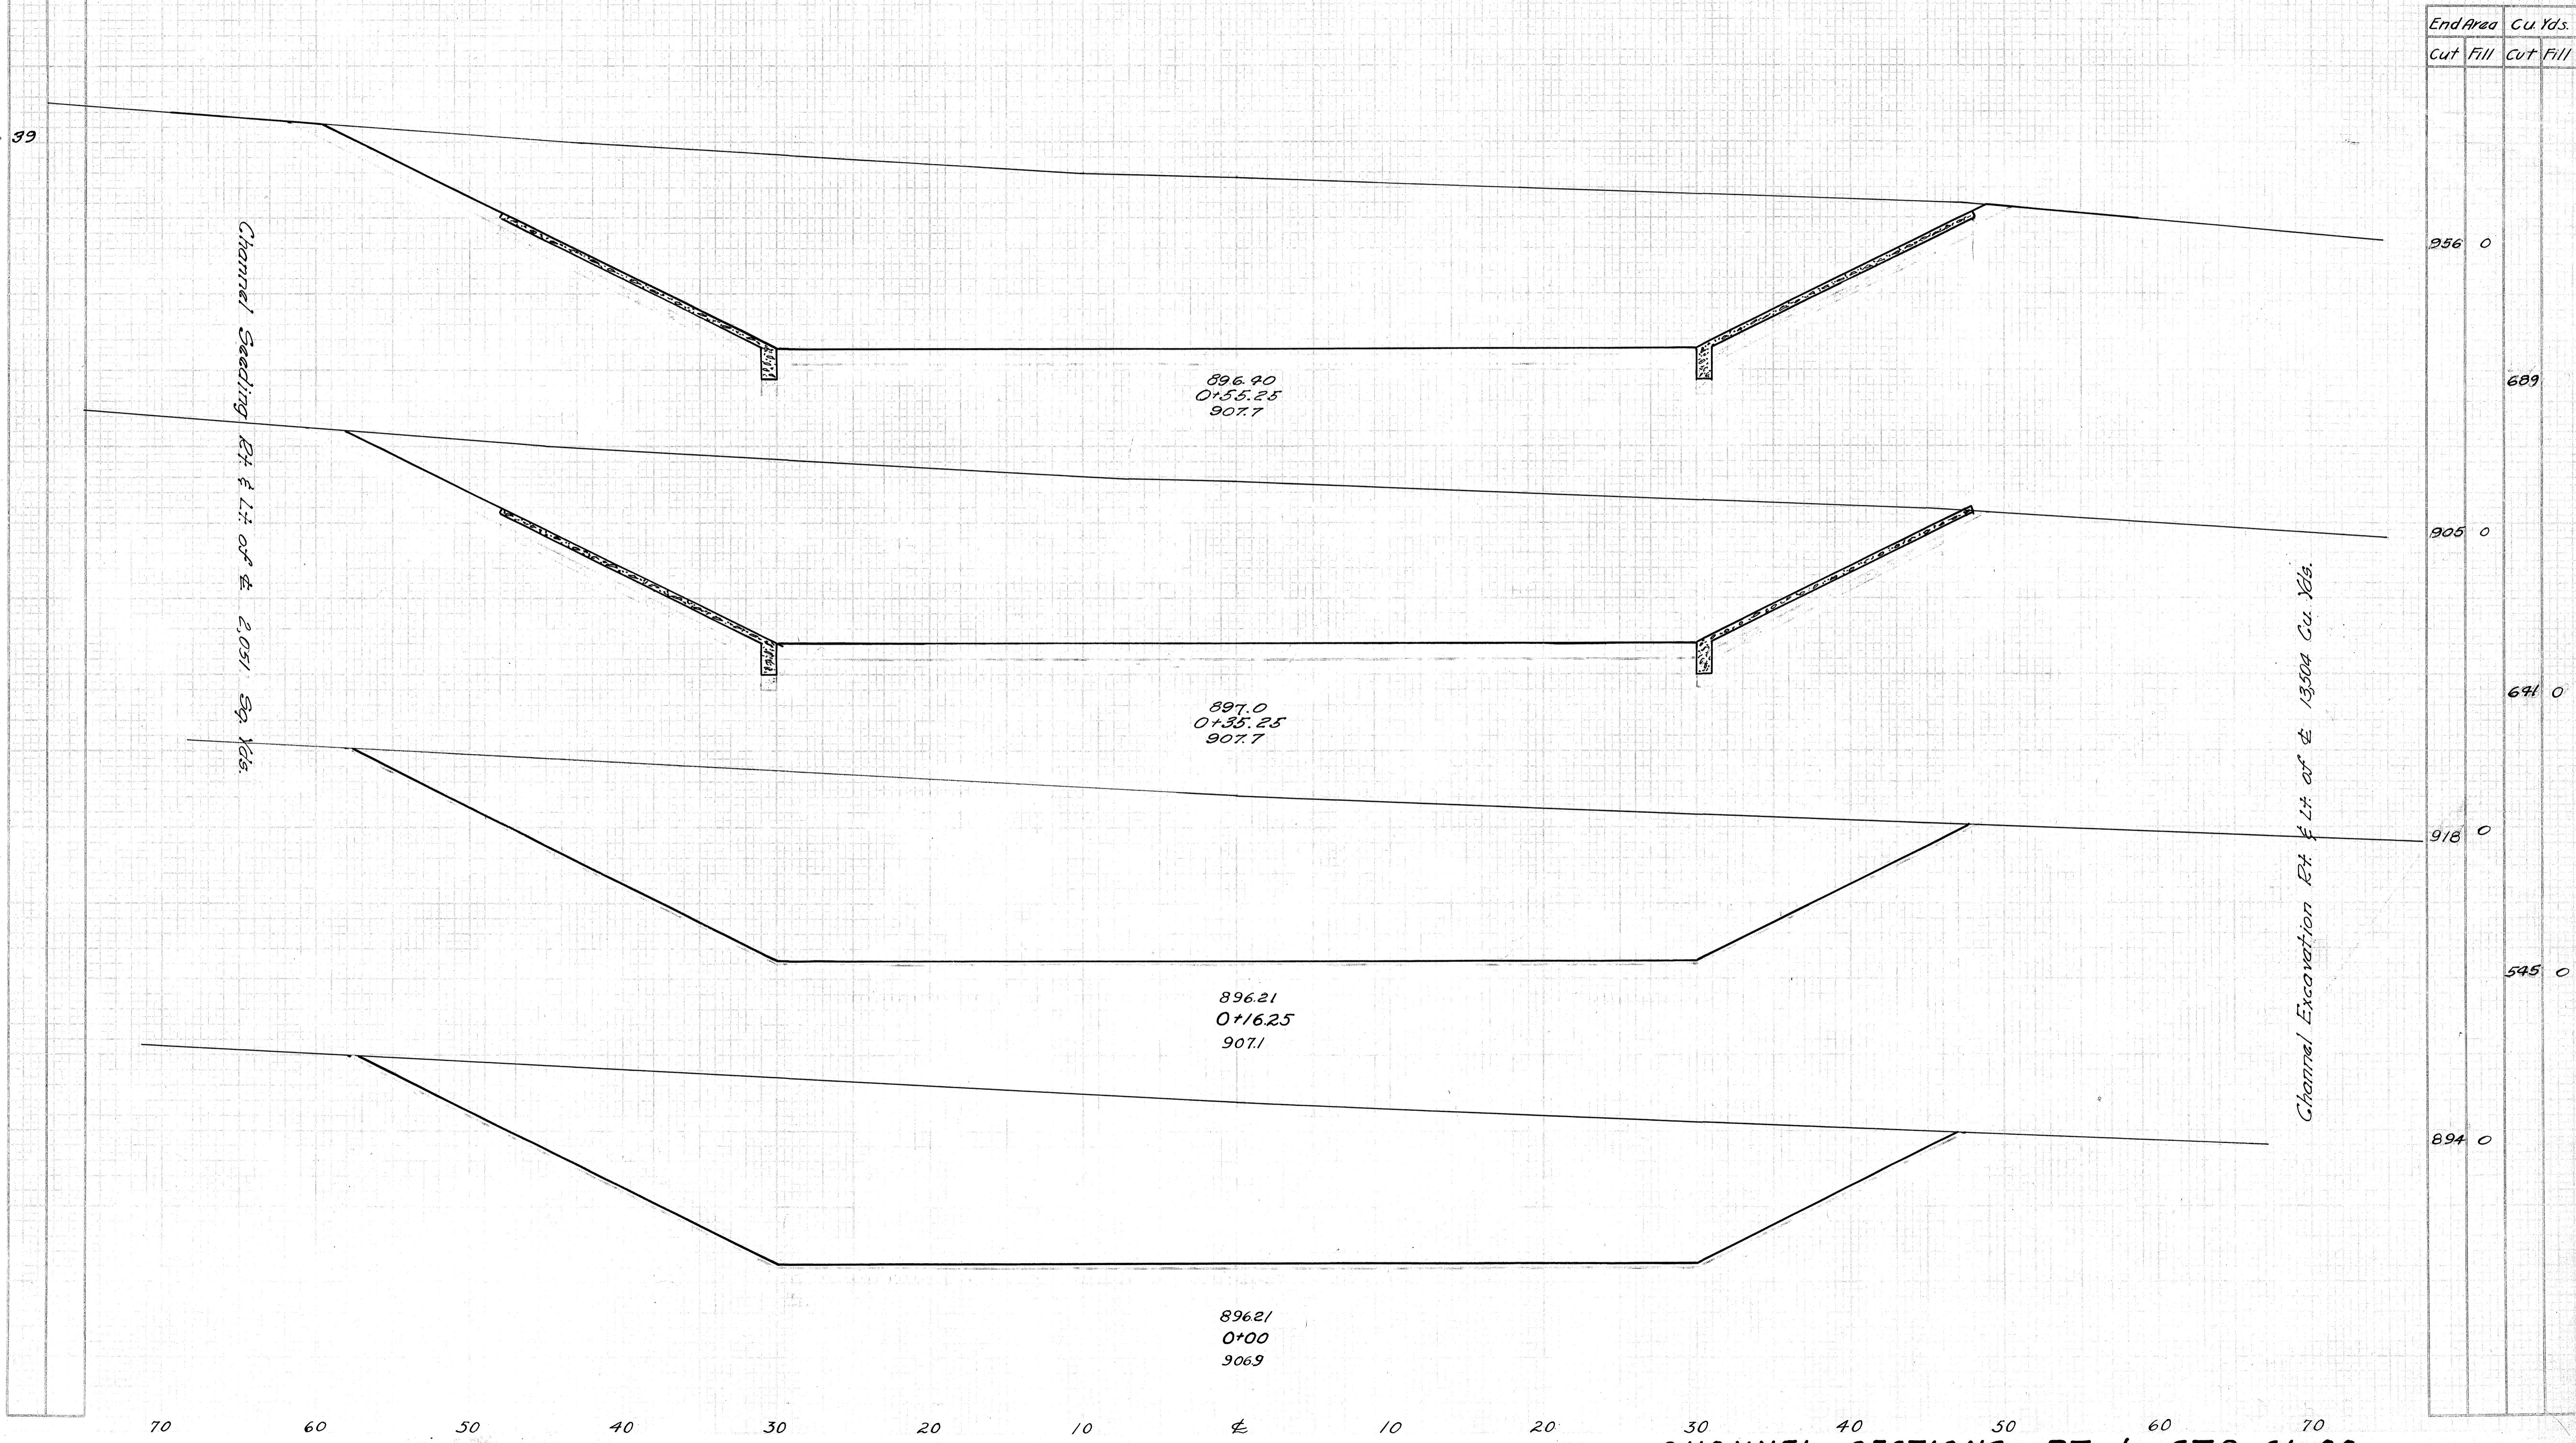

896.90
0+55.25
907.7


897.0
0+35.25
907.7

896.21
0+16.25
907.1

896.21
0+00
906.9

CHANNEL SECTIONS RT. & STA. 41+00

**BROWN COUNTY
S.H. 951 SEC. E (PT.)**

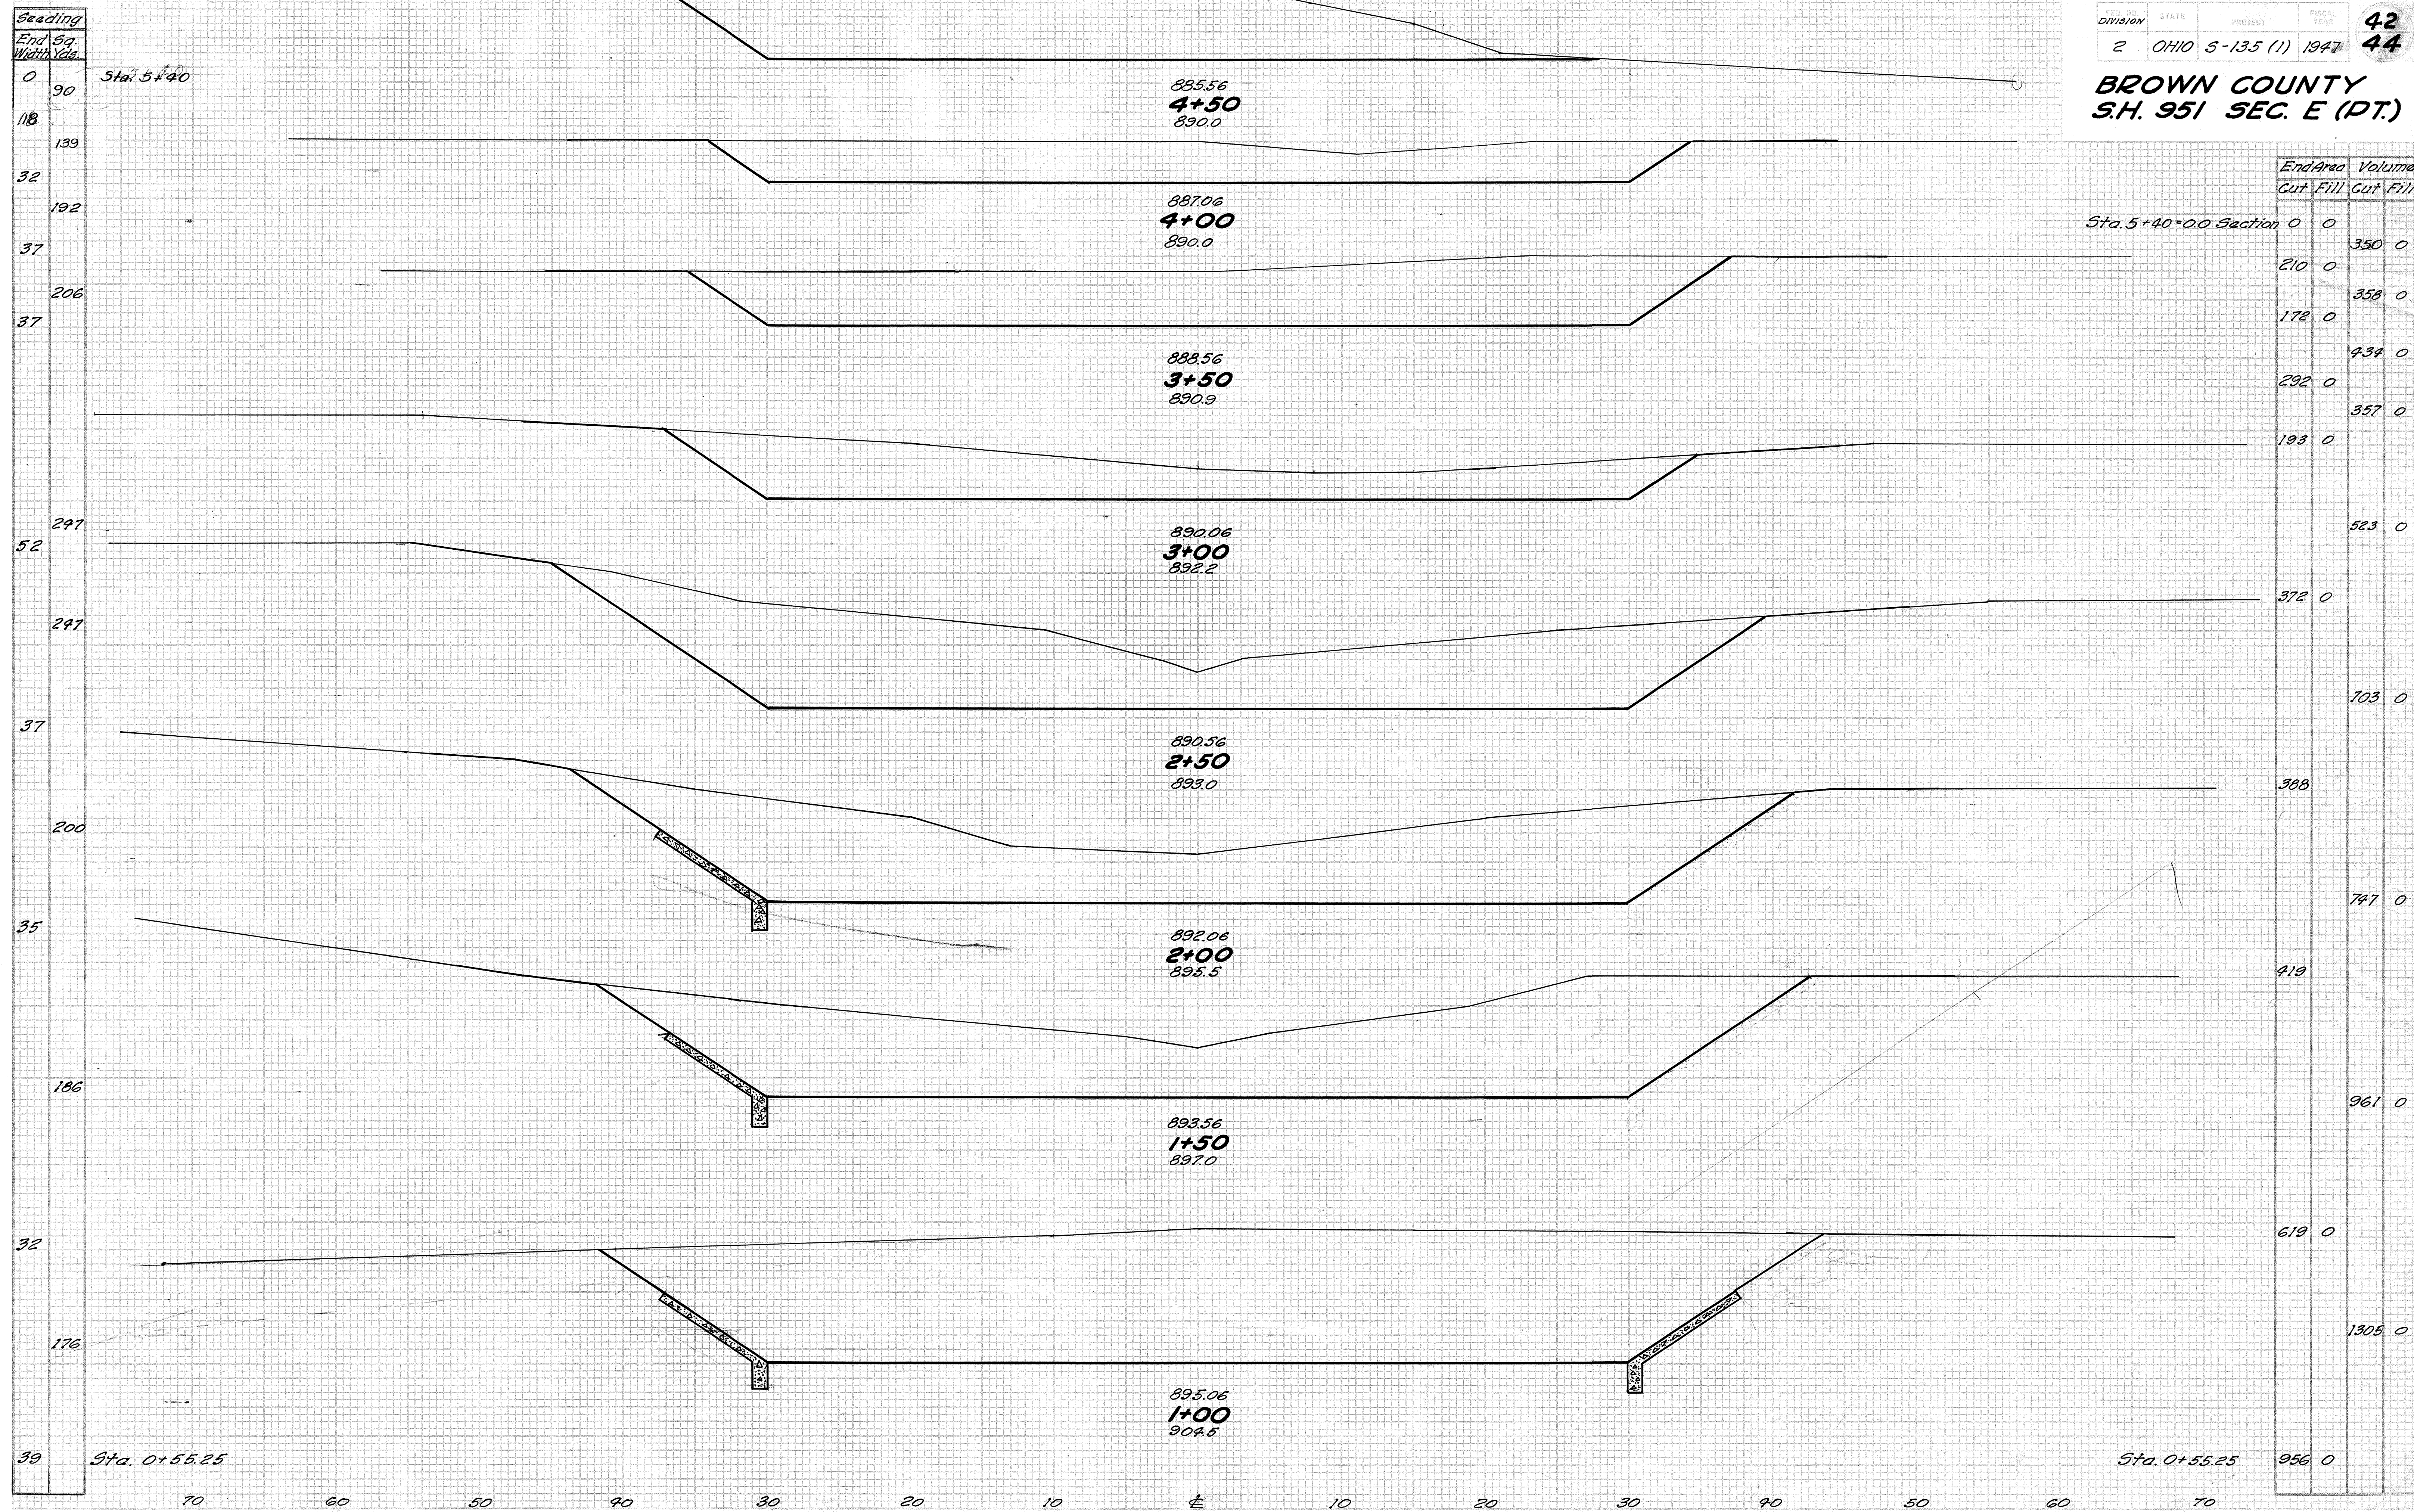


Sta. 5+40=00 Section 0

End Area		Volume	
Cut	Fill	Cut	Fill
0	0	0	0
210	0	350	0
172	0	358	0
292	0	434	0
193	0	357	0
297	0	523	0
372	0	703	0
368	0	747	0
419	0	919	0
361	0	961	0
619	0	1305	0
956	0		

**BROWN COUNTY
S.H. 951. SEC-E (PT)**

End Area		Cu. Yds.	
Cut	Fill	Cut	Fill
1305	0		

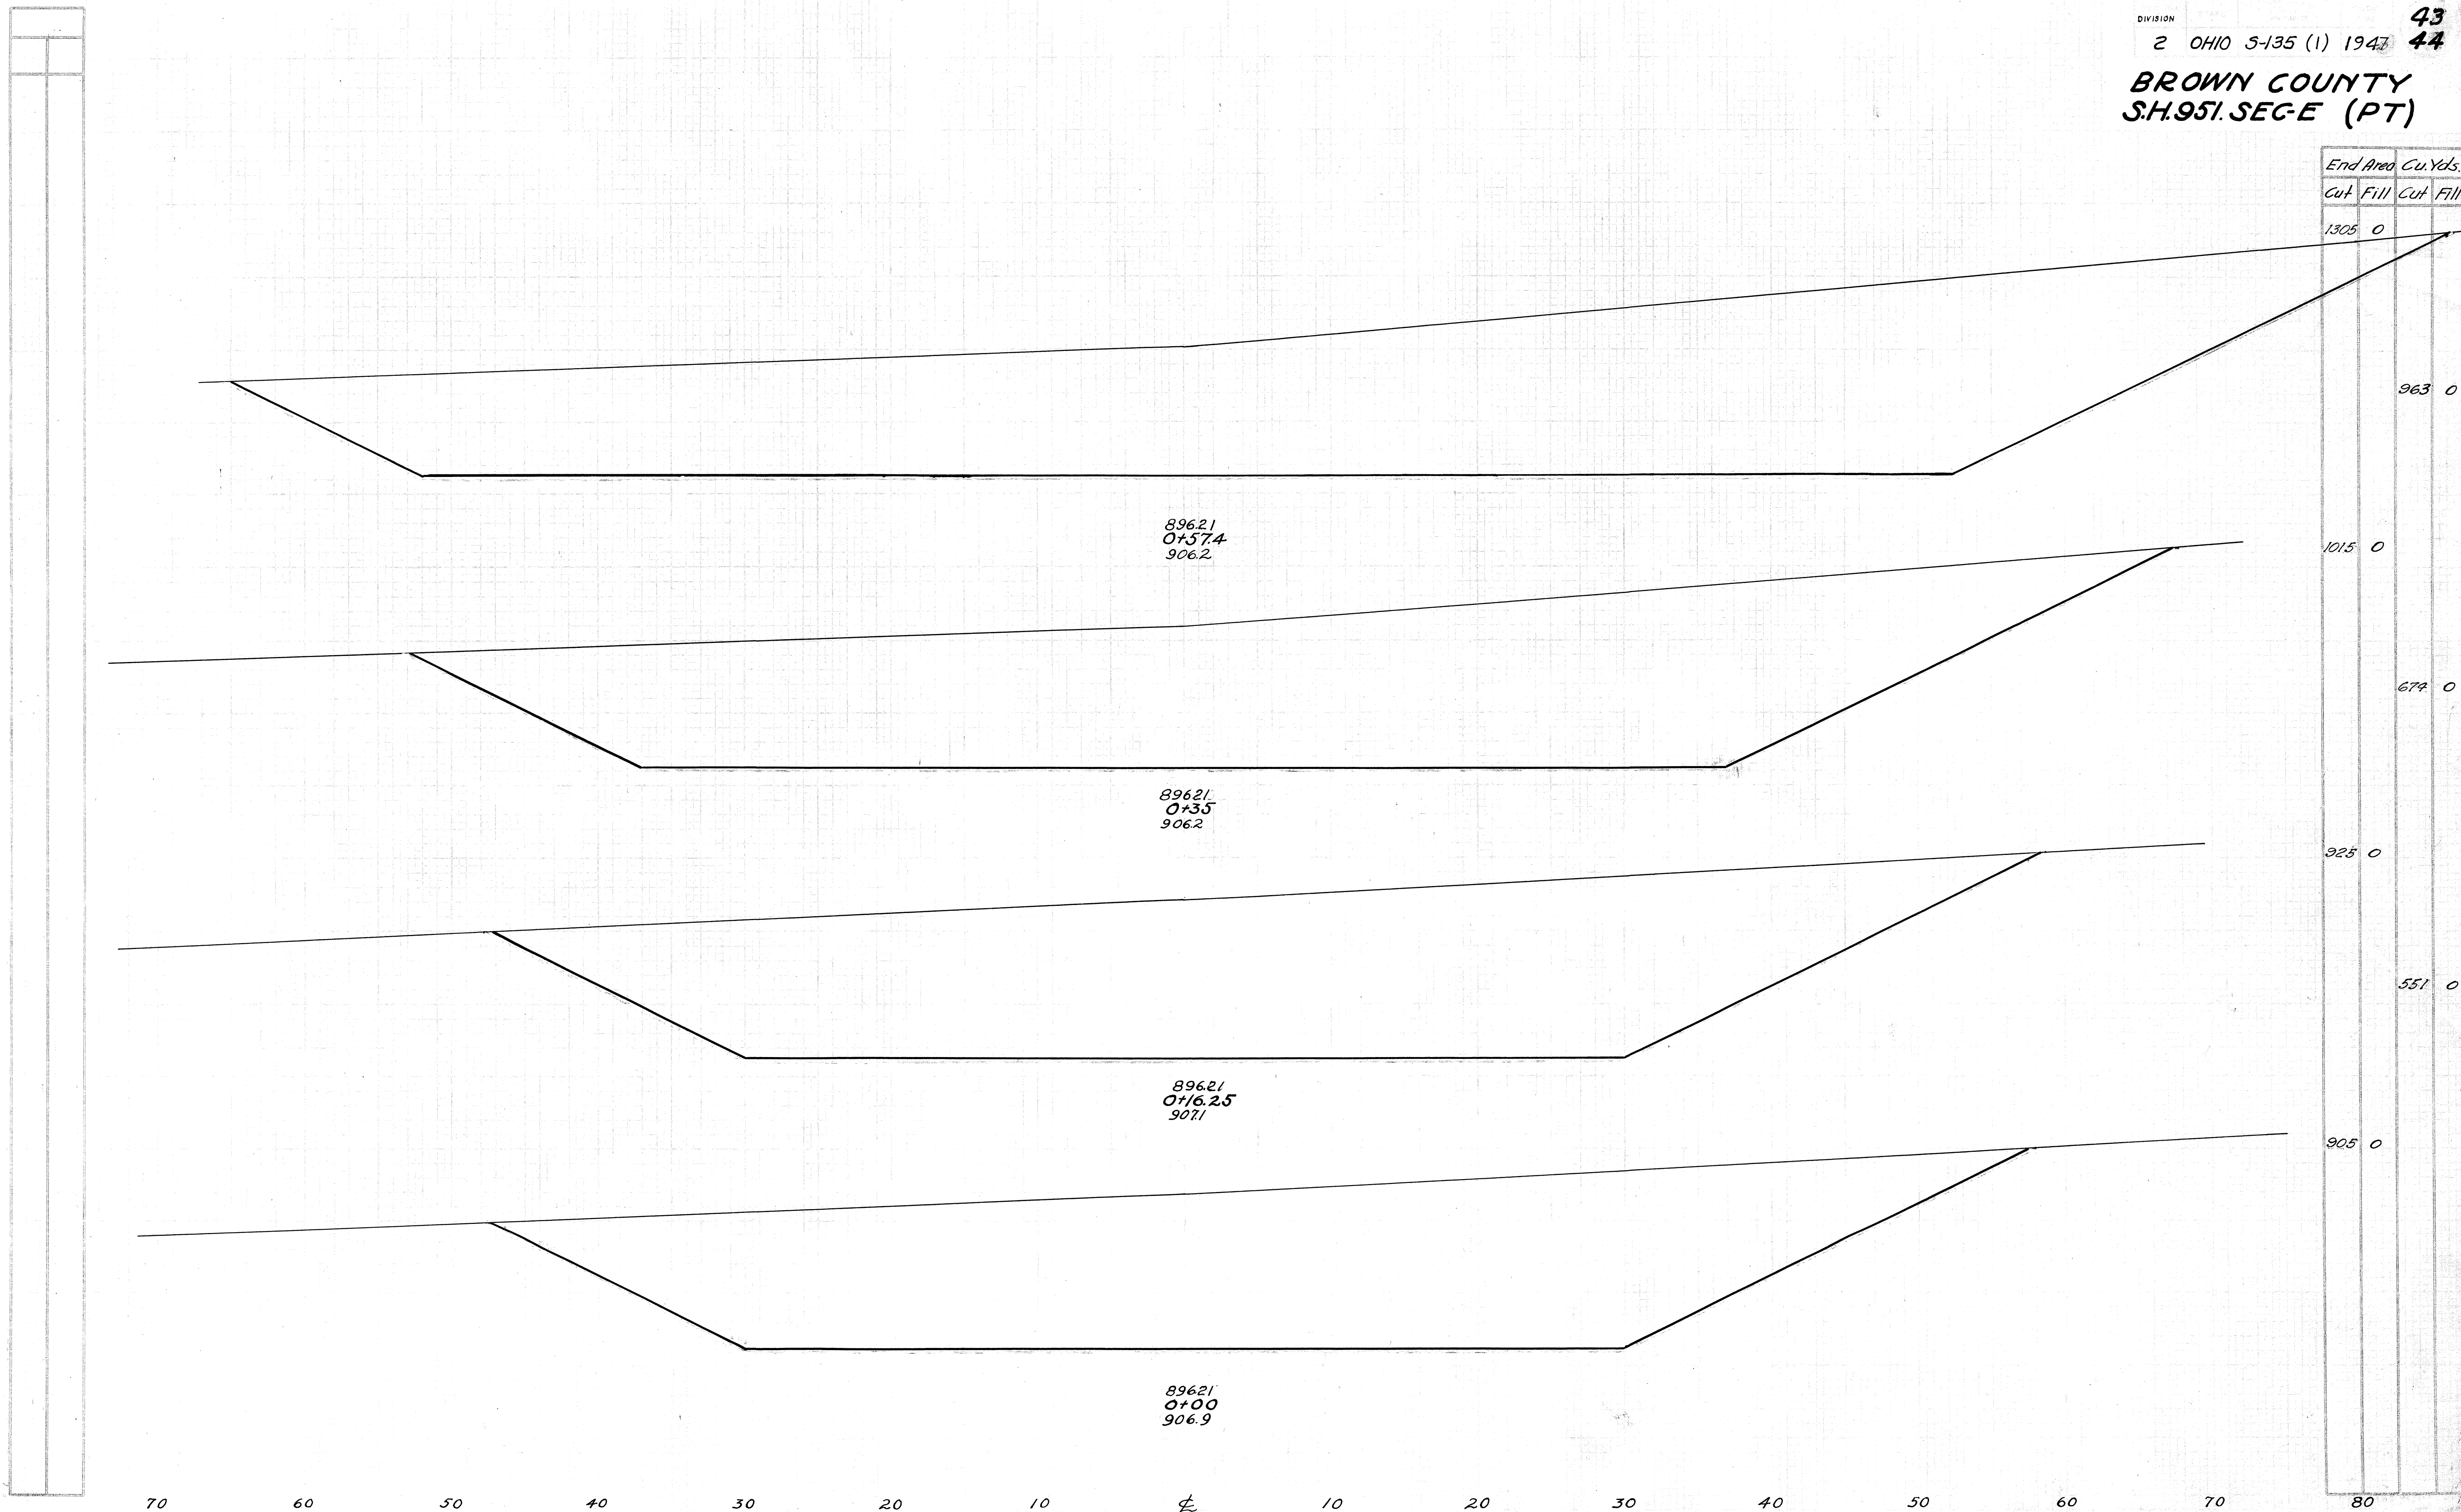

CHANNEL SECTIONS LT & STA. 41+00

Seeding
End Sq. Width Yds.
0
12
10
114
31
178
33
64
31


0:0 Section

2+23 = 0:0 Section

0:0 Section

End Area		Cu. Yds	
Cut	Fill	Cut	Fill
0			
		72	0
168	0	695	0
		582	0
		1373	0
		901	0
		625	0
		971	0
		1038	0
		1325	0

Bm B-5
 850-24321 - SEC. E (PT)

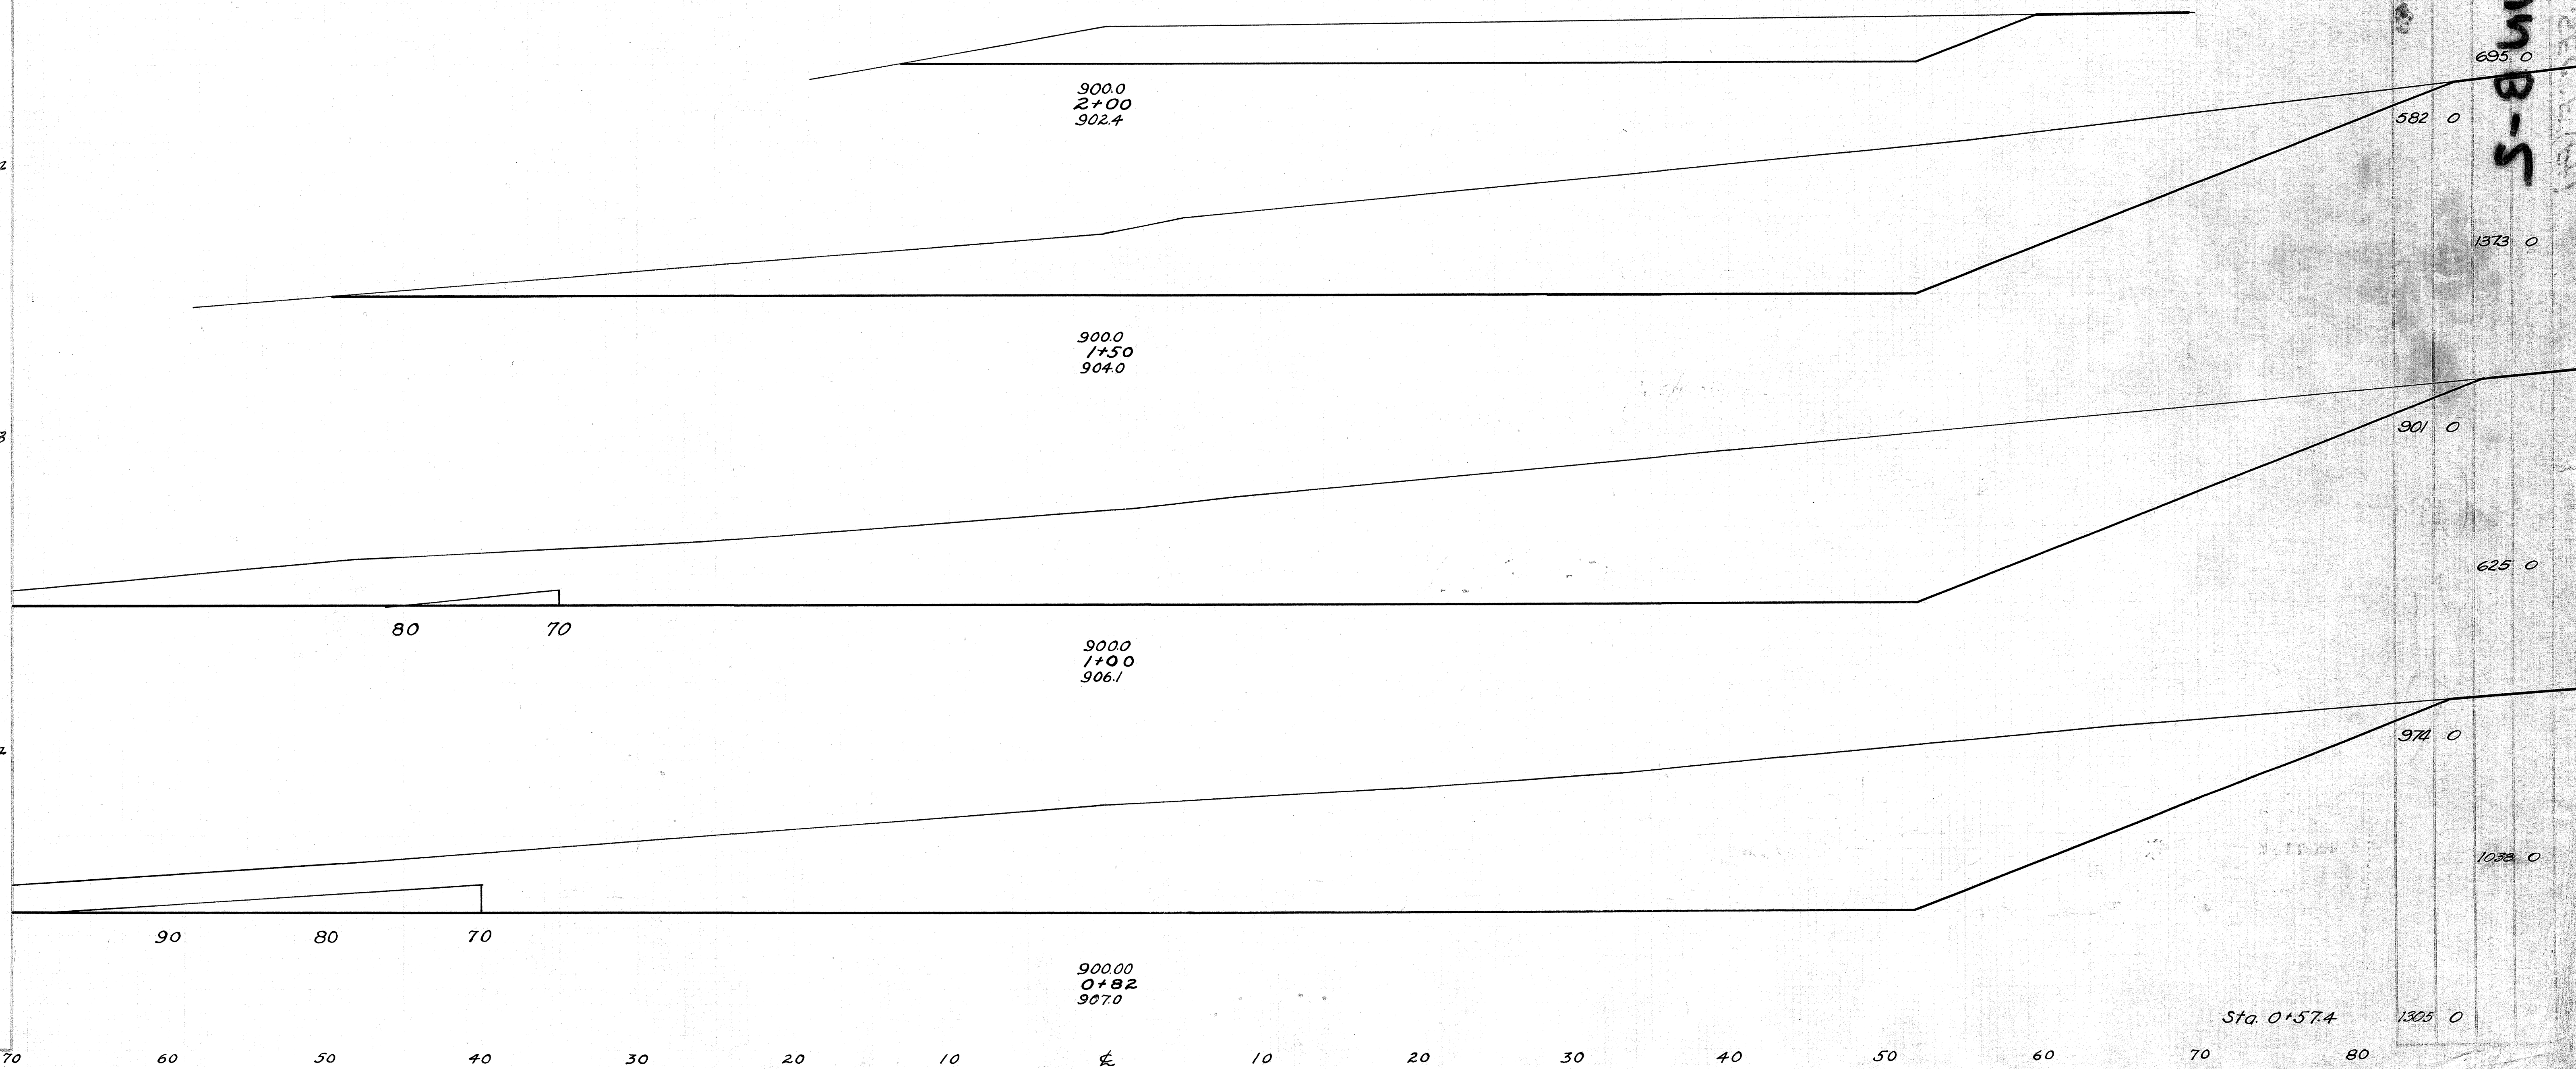



CHANNEL SECTIONS LT & STA 41+00

FED. RD. DIVISION	STATE	PROJECT	FISCAL YEAR
2	OHIO	S-135(1)	1946

1
2

R/W PLANS
SH. 951 SEC. E(PT)
BROWN COUNTY
PIKE TWP.
BRIDGE No. BR-774-106

774

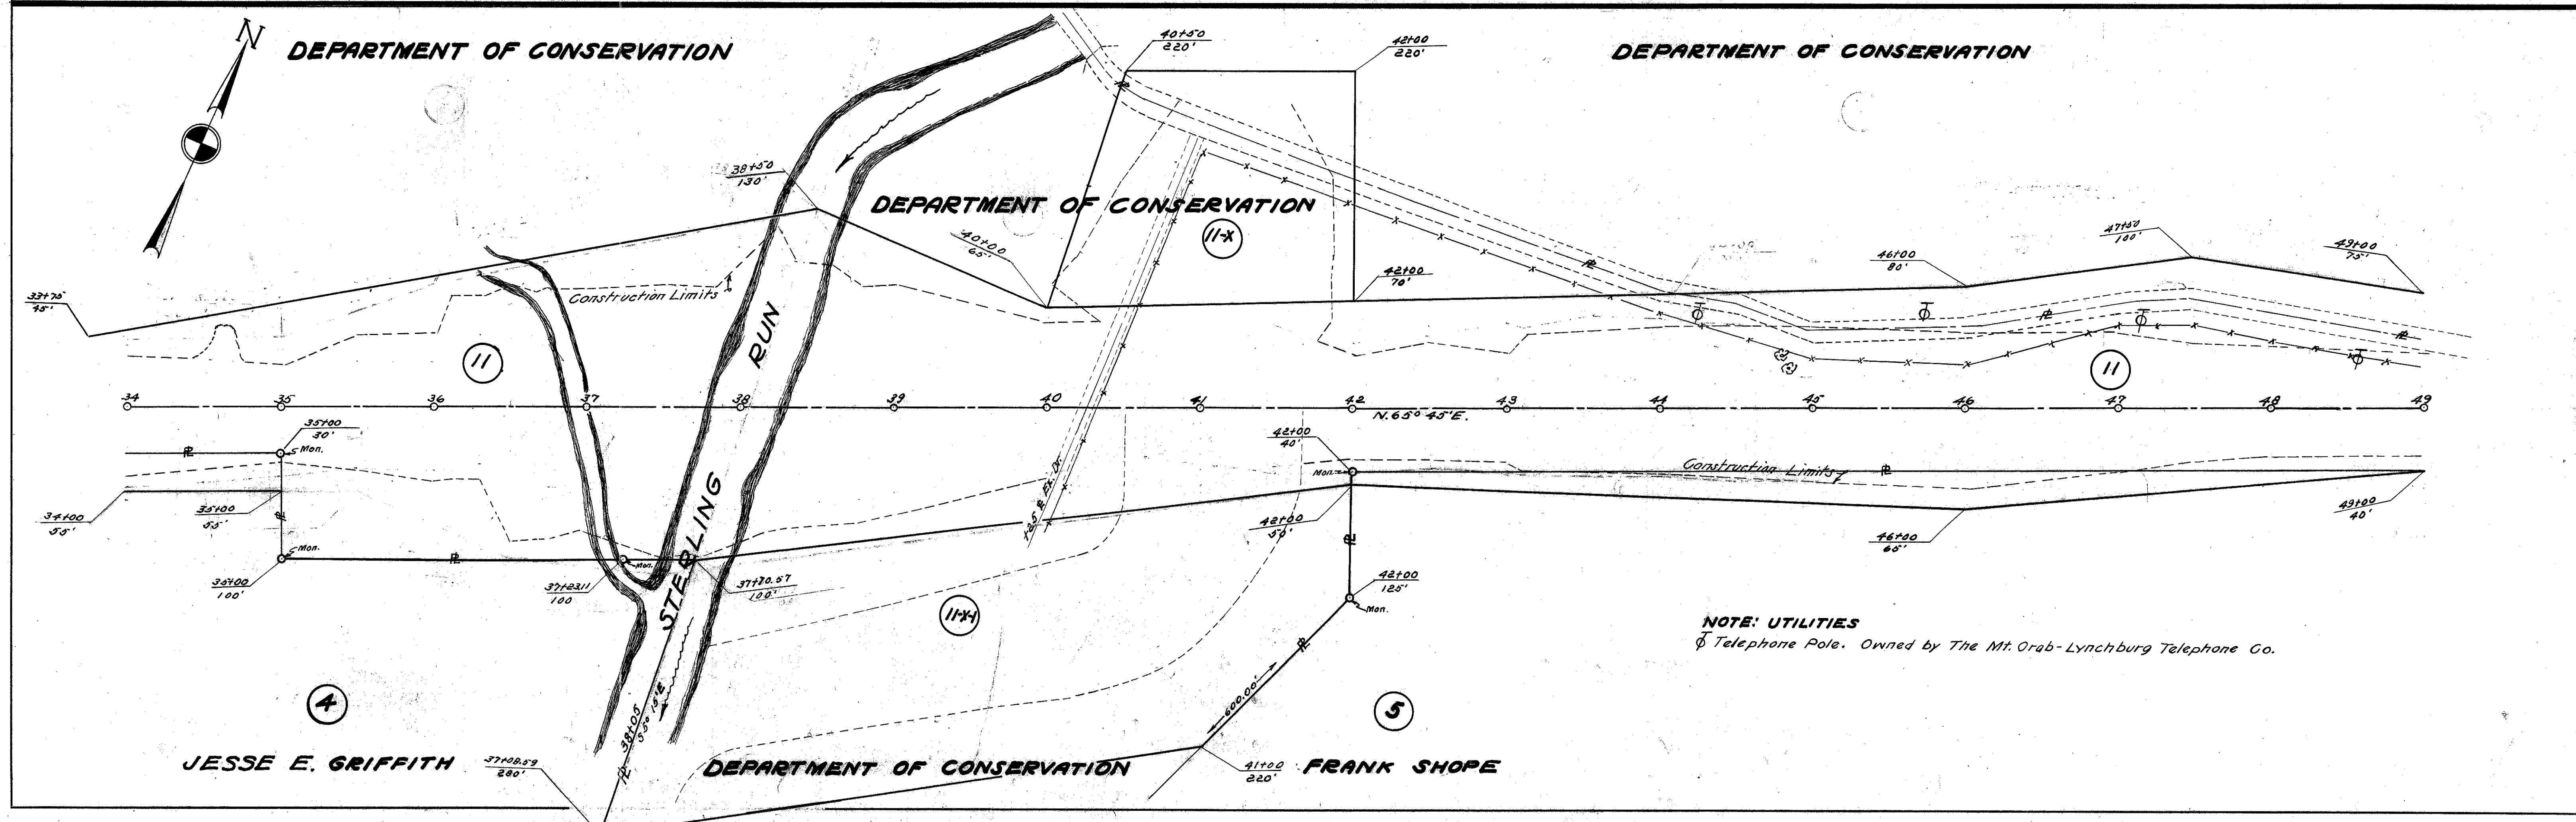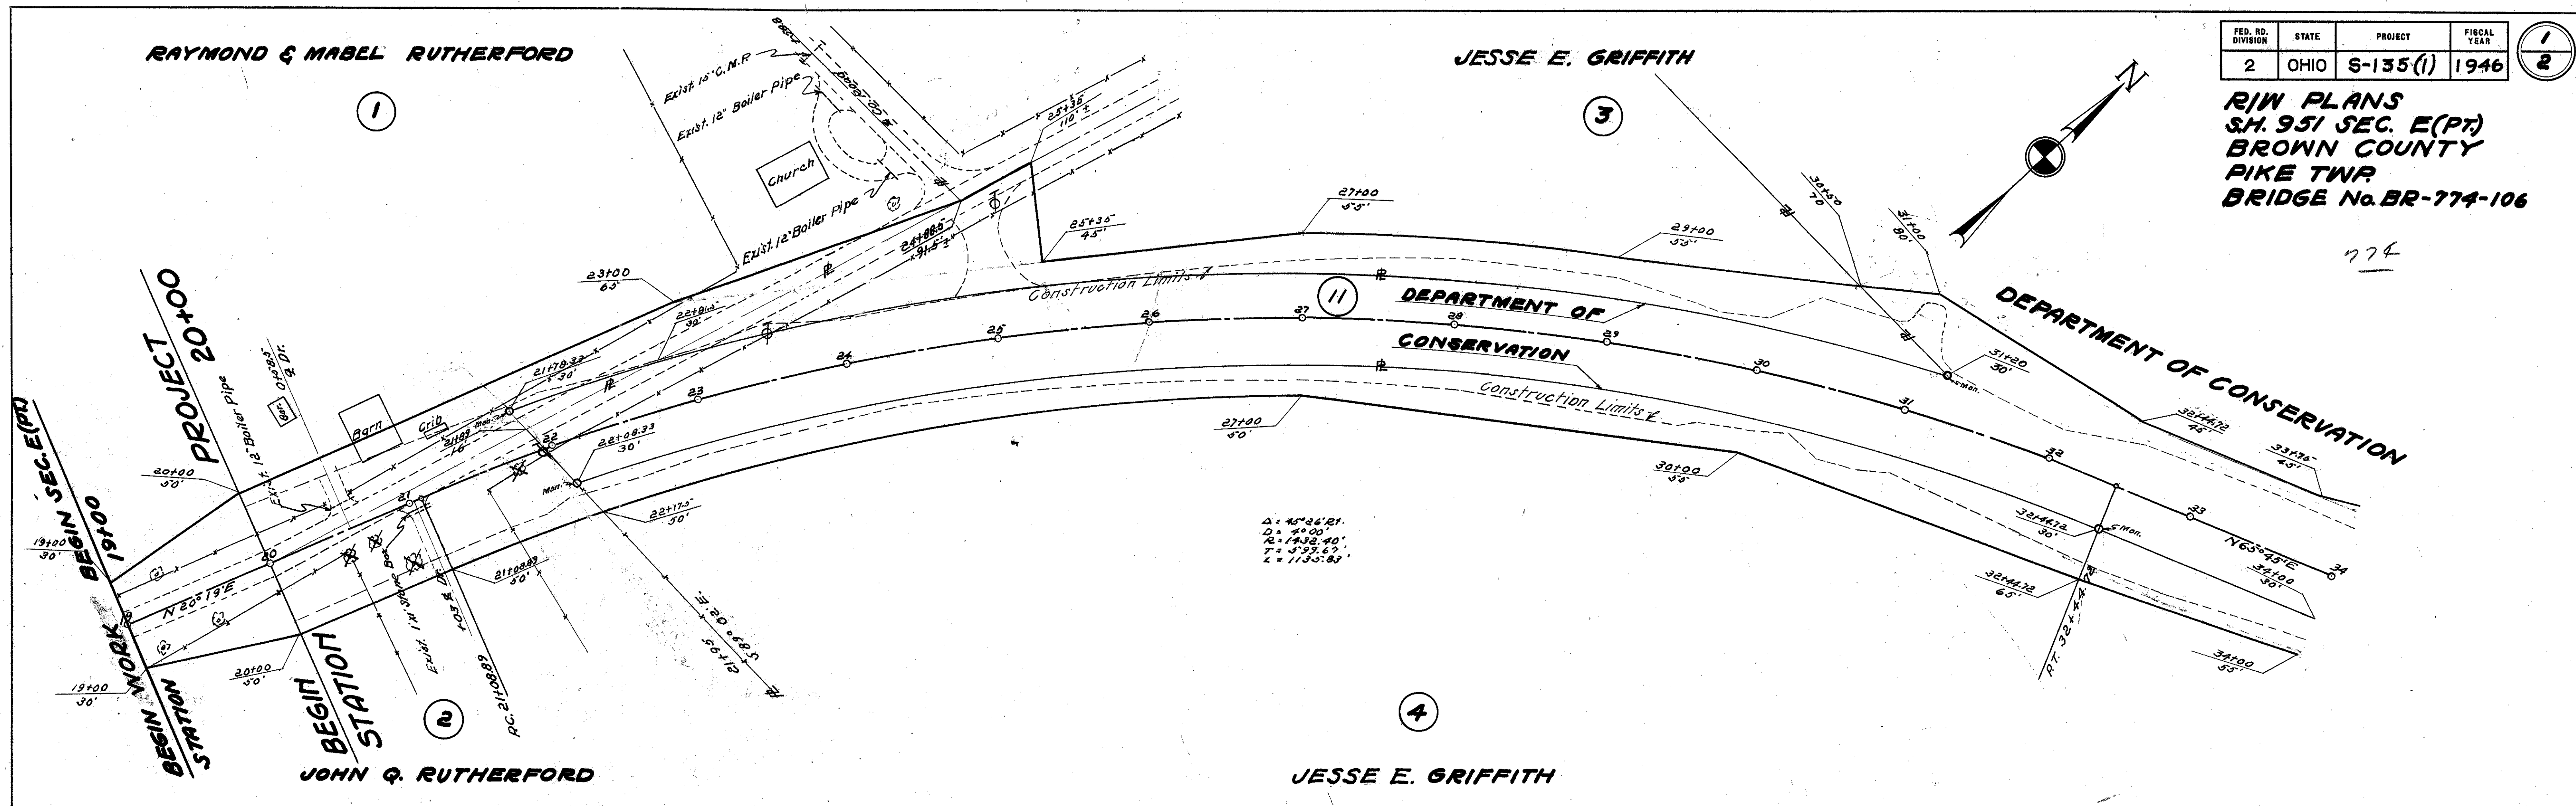

DEPARTMENT OF CONSERVATION



ELIZABETH HIGGINS

W.H. FOX

FED. RD. DIVISION	STATE	PROJECT	FISCAL YEAR
2	OHIO	S-135-1	1946

2/2

R/W PLANS
S.H. 951 SEC. E (PT.)
BROWN COUNTY
PIKE TWP.
BRIDGE No. BR-774-106

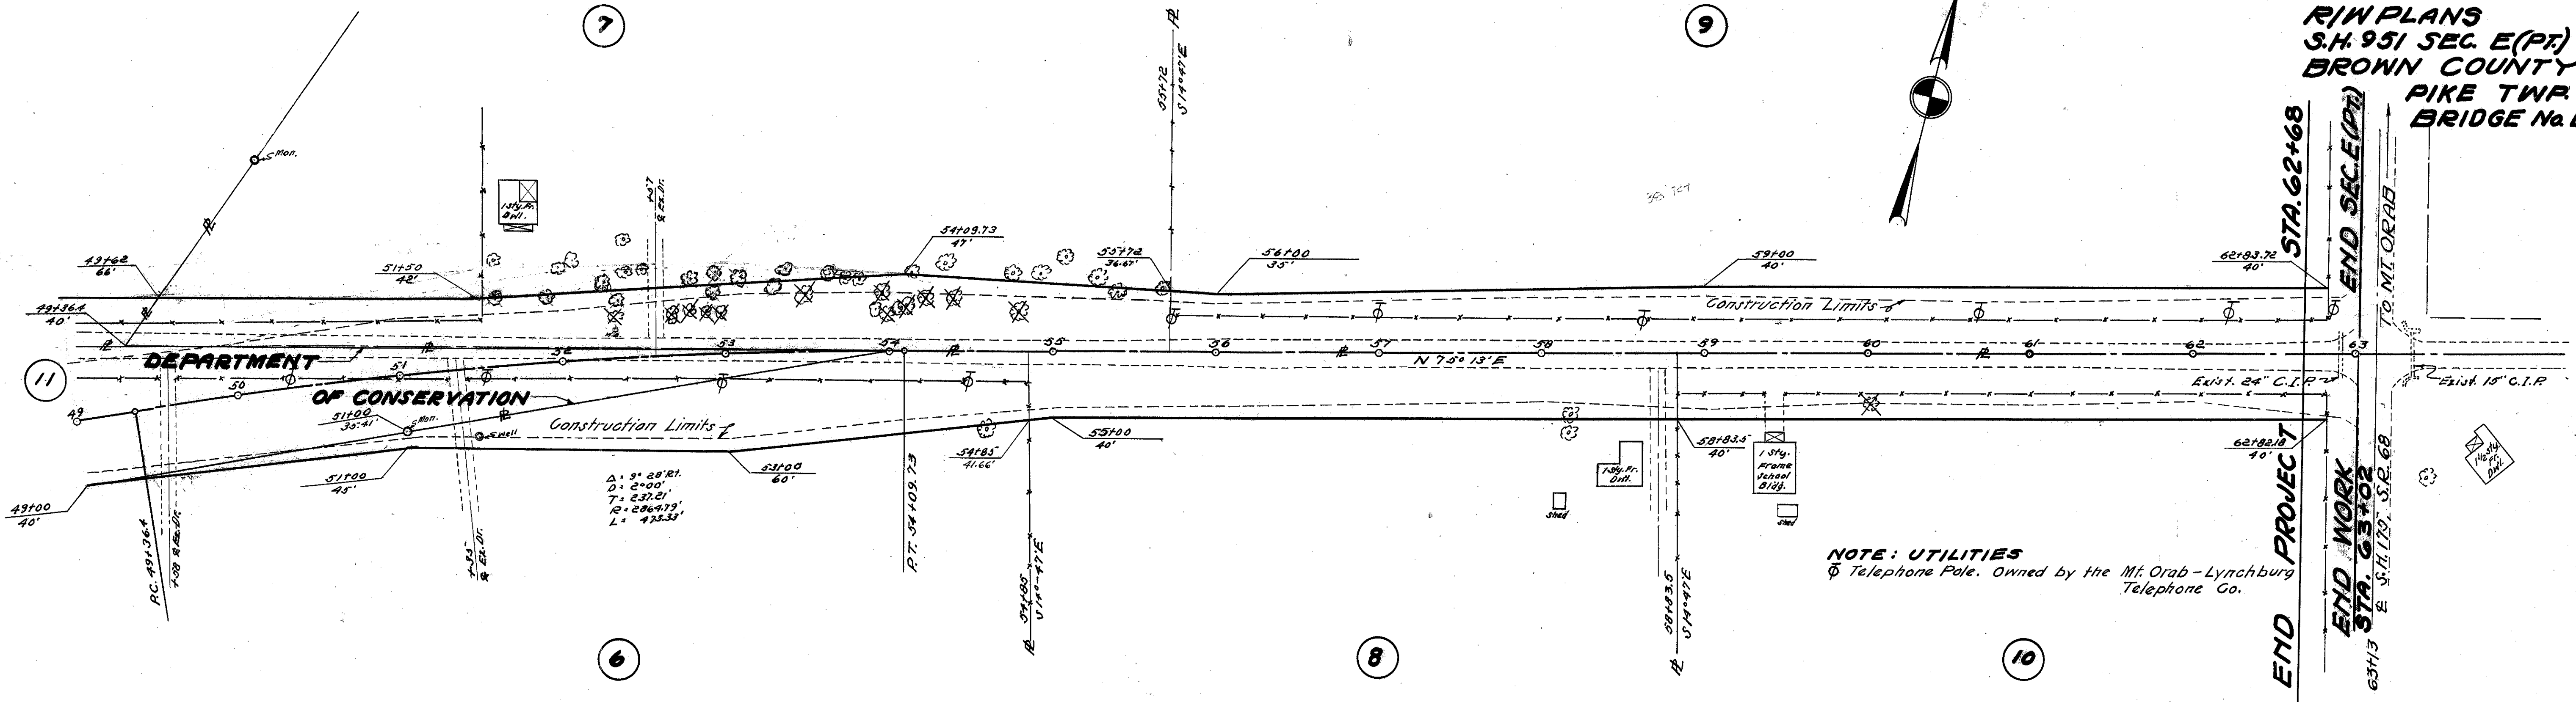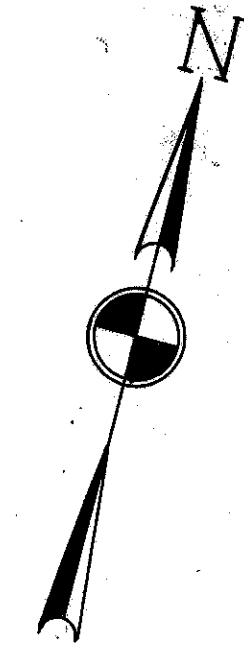

DEPARTMENT OF CONSERVATION

Construction Limits

Construction Limits

END PROJECT

END WORK STA. 63+02

7

9

11

6

8

10

FRANK SHOPE

CARRIE WATTERS

FRANK SHOPE