
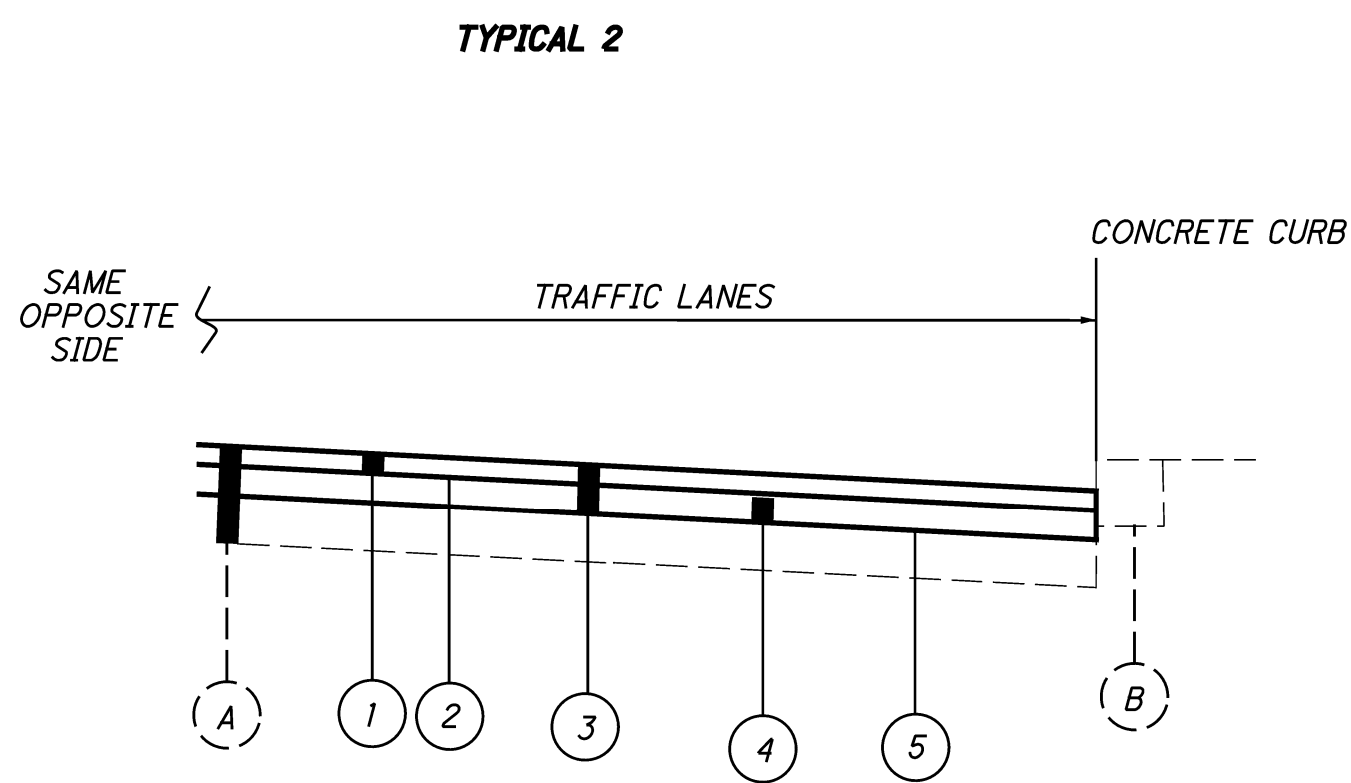
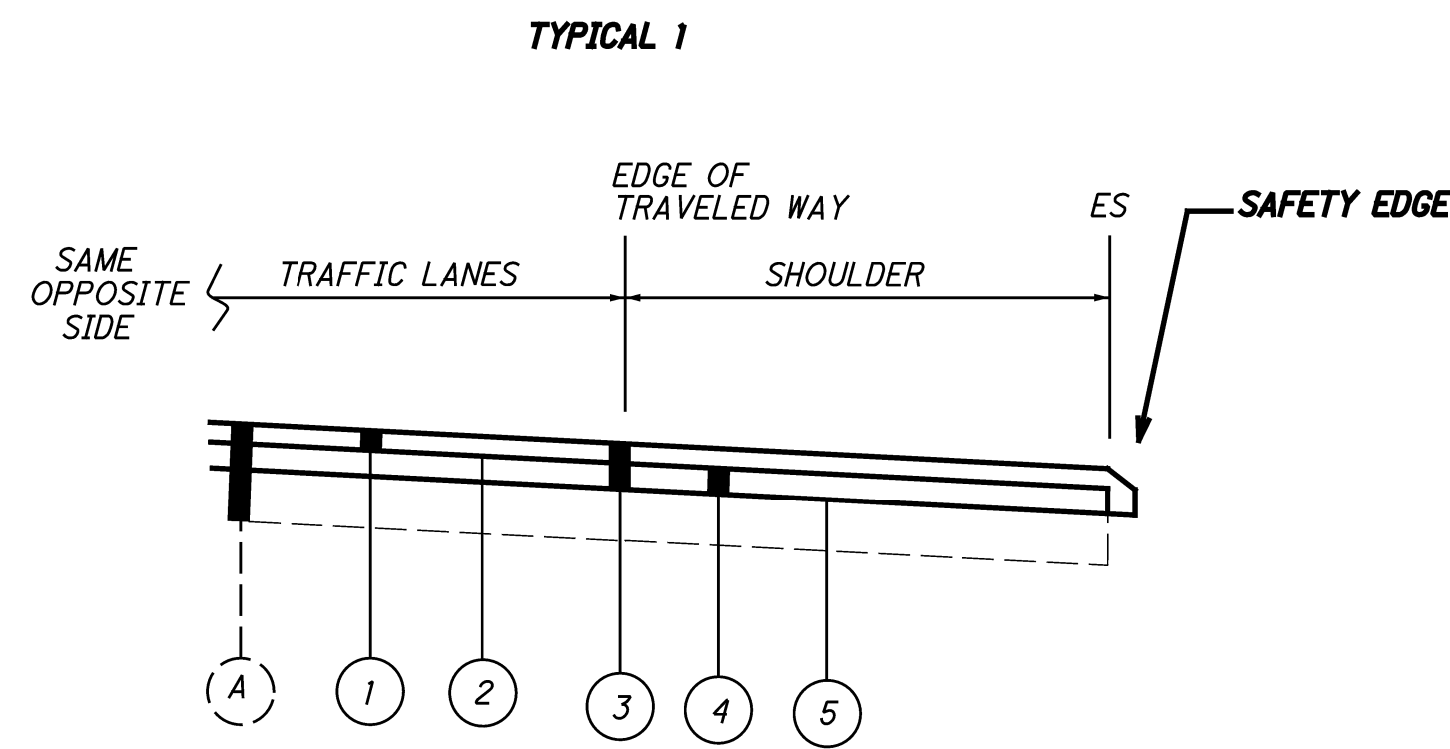


SHEET NUM.										PART.		ITEM	ITEM EXT	GRAND TOTAL	UNIT	DESCRIPTION	SEE SHEET NO.
3	4	7	8	9	10	01/5>2/05	02/STR/05										
ROADWAY																	
				1,600				400	1,200	202	38000	1,600	FT	GUARDRAIL REMOVED			
20								4	16	202	42001	20	EACH	ANCHOR ASSEMBLY REMOVED, TYPE A, AS PER PLAN	3		
								559		202	30000	559	SF	WALK REMOVED			
								23		202	32000	23	FT	CURB REMOVED			
								19		202	32500	19	FT	CURB AND GUTTER REMOVED			
	15.22							5	10.22	209	72050	15.22	MILE	PREPARING SUBGRADE FOR SHOULDER PAVING			
				1,150				350	800	606	15100	1,150	FT	GUARDRAIL, TYPE MGS WITH LONG POSTS			
				17				3	14	606	26150	17	EACH	ANCHOR ASSEMBLY, MGS TYPE E, (MASH 2016)			
				3				2	1	606	26150	3	EACH	ANCHOR ASSEMBLY, MGS TYPE E, SOFTSTOP (MASH 2016)			
					265			265		608	10000	265	SF	4" CONCRETE WALK			
					294			294		608	52000	294	SF	CURB RAMP			
DRAINAGE																	
16								16		611	99654	16	EACH	MANHOLE ADJUSTED TO GRADE			
56								56		611	98630	56	EACH	CATCH BASIN ADJUSTED TO GRADE			
PAVEMENT																	
400								200	200	253	02000	400	CY	PAVEMENT REPAIR (A)			
								5		253	02000	5	CY	PAVEMENT REPAIR (B)			
								2		253	02001	2	CY	PAVEMENT REPAIR, AS PER PLAN	10		
	204,877							119,914	84,963	254	01000	204,877	SY	PAVEMENT PLANING, ASPHALT CONCRETE, 3"			
	2,061							1,207	854	254	01600	2,061	SY	PATCHING PLANED SURFACE			
	30,732							17,987	12,745	407	20000	30,732	GAL	NON-TRACKING TACK COAT			
	7,275							4,217	3,058	441	50000	7,275	CY	ASPHALT CONCRETE SURFACE COURSE, TYPE 1, (448), PG64-22			
	9,959							5,829	4,130	441	50300	9,959	CY	ASPHALT CONCRETE INTERMEDIATE COURSE, TYPE 2, (448)			
								15		609	12000	15	FT	COMBINATION CURB AND GUTTER, TYPE 2			
								3		609	26000	3	FT	CURB, TYPE 6			
	703							346	357	617	10100	703	CY	COMPACTED AGGREGATE			
	5,867							4,693	1,174	617	20000	5,867	SY	SHOULDER PREPARATION			
	14							7	7	617	25000	14	M GAL	WATER			
	15.22							4	11.22	618	41000	15.22	MILE	RUMBLE STRIPES, EDGE LINE (ASPHALT CONCRETE)			
	8.11							2	6.11	618	43000	8.11	MILE	RUMBLE STRIPES, CENTER LINE (ASPHALT CONCRETE)			
	8.11							2	6.11	874	21000	8.11	MILE	LONGITUDINAL JOINT PREPARATION			
WATER WORK																	
14								14		638	10800	14	EACH	VALVE BOX ADJUSTED TO GRADE			
TRAFFIC CONTROL																	
1,090								430	660	621	00100	1,090	EACH	RPM			
1,090								430	660	621	54000	1,090	EACH	RAISED PAVEMENT MARKER REMOVED			
					25			5	20	626	00110	25	EACH	BARRIER REFLECTOR, TYPE 2(BIDIRECTIONAL)			
				25.66				11.78	13.88	644	00104	25.66	MILE	EDGE LINE, 6"			
				4.78				4.78		644	00204	4.78	MILE	LANE LINE, 6"			
				13.44				6.5	6.94	644	00300	13.44	MILE	CENTER LINE			
				260				260		644	00400	260	FT	CHANNELIZING LINE, 8"			
				152				128	24	644	00500	152	FT	STOP LINE			
				4				4		644	01300	4	EACH	LANE ARROW			
				2				2		644	01110	2	EACH	SCHOOL SYMBOL MARKING, 96"			
				5				3	2	644	01000	5	EACH	RAILROAD SYMBOL MARKING			
				615				615		644	00620	615	FT	CROSSWALK LINE, 12"			
				100				100		644	01520	100	FT	DOTTED LINE, 12"			
				0.6				0.34	0.26	646	10010	0.6	MILE	EDGE LINE, 6"			
				0.26				0.26		646	10110	0.26	MILE	LANE LINE, 6"			
				0.3				0.17	0.13	646	10200	0.3	MILE	CENTER LINE			
MAINTENANCE OF TRAFFIC																	
	80							40	40	614	11110	80	hour	LAW ENFORCEMENT OFFICER WITH PATROL CAR FOR ASSISTANCE			
	4.78							4.78		614	20110	4.78	MILE	WORK ZONE LANE LINE, CLASS I, 6", 642 PAINT			
	4.78							4.78		614	20560	4.78	MILE	WORK ZONE LANE LINE, CLASS III, 6", 642 PAINT			
	13.44							6.5	6.94	614	21100	13.44	MILE	WORK ZONE CENTER LINE, CLASS I, 642 PAINT			
	13.44							6.5	6.94	614	21550	13.44	MILE	WORK ZONE CENTER LINE, CLASS III, 642 PAINT			

DESIGN AGENCY

 DESIGNER
MLA
 REVIEWER
JDO 5-17-24
 PROJECT ID
100645
 SHEET TOTAL
P.5 13



- (A) EXISTING ASPHALT CONCRETE PAVEMENT
- (1) ITEM 441 - 1.25" ASPHALT CONCRETE SURFACE COURSE, TYPE 1, (448) PG64-22
- (2) ITEM 407 - NON-TRACKING TACK COAT @ 0.06 GAL/SQ YD
- (3) ITEM 254 - 3.00" PAVEMENT PLANNING ASPHALT CONCRETE
- (4) ITEM 441 - 1.75" ASPHALT INTERMEDIATE COURSE, TYPE 2 (448)
- (5) ITEM 407 - NON-TRACKING TACK COAT @ 0.09 GAL/SQ YD
- (B) EXISTING CONCRETE CURB

PLAN SPLIT	COUNTY-ROUTE	LOG POINT (MILE)		LENGTH		PAVEMENT AREA (Micro-Station Generated Area)	PAVEMENT AREA	209.00		254		407		407		441			441			617				618		618		874.00		NOTES
		FROM	TO	MILES	FT			SQ FT	SQ YD	PREPARING SUBGRADE FOR SHOULDER PAVING	PAVEMENT PLANNING ASPHALT CONCRETE		PATCHING PLANED SURFACE	NON TRACKING TACK COAT @ 0.09 GAL/SQ YD	NON TRACKING TACK COAT @ 0.06 GAL/SQ YD	ASPHALT CONCRETE SURFACE COURSE, TYPE 1 (448), PG64-22		ASPHALT CONCRETE INTERMEDIATE COURSE, TYPE 2 (448)		COMPACTED AGGREGATE, DEPTH = SURFACE + INTER. THICKNESS	COMPACTED AGGREGATE, 1.5" DEPTH, 12" WIDTH	SHOULDER PREPARATION	WATER @ 20 GAL/CU YD	WATER @ 20 GAL/CU YD	EDGE LINE, RUMBLE STRIPE (ASPHALT CONCRETE)	CENTER LINE, RUMBLE STRIPE (ASPHALT CONCRETE)	LONGITUDINAL JOINT PREPARATION					
											DEPTH	SQ YD				THICK-NESS	SAFETY EDGE	THICK-NESS	CU YD									CU YD	CU YD	CU YD	SQ YD	
01/S>2/05	US 127	7.48	7.98	0.50	2640	106912	11879	1.00	3.00	11879.1	119	1069.1	712.7	1.25	412.5	10.6	1.75	577.5	30.2													
01/S>2/05	US 127	7.98	8.48	0.50	2640	102867	11430	1.00	3.00	11429.6	115	1028.7	685.8	1.25	396.9	10.6	1.75	555.6	30.2											OMIT BRIDGE AND APPROACH SLABS (SLM 8.46)		
01/S>2/05	US 127	8.48	8.98	0.50	2640	109285	12143	1.00	3.00	12142.7	122	1092.8	728.6	1.25	421.6	10.6	1.75	590.3	30.2													
01/S>2/05	US 127	8.98	9.48	0.50	2640	117108	13012	1.00	3.00	13012.0	131	1171.1	780.7	1.25	451.8	10.6	1.75	632.5	30.2													
01/S>2/05	US 127	9.48	9.98	0.50	2640	84620	9402	1.00	3.00	9402.2	95	846.2	564.1	1.25	326.5	10.6	1.75	457.1	30.2													
01/S>2/05	US 127	9.98	10.48	0.50	2640	64532	7170		3.00	7170.2	72	645.3	430.2	1.25	249.0		1.75	348.6														
01/S>2/05	US 127	10.48	10.98	0.50	2640	63391	7043		3.00	7043.5	71	633.9	422.6	1.25	244.6		1.75	342.4												OMIT BRIDGE AND APPROACH SLABS (SLM 10.93)		
01/S>2/05	US 127	10.98	11.48	0.50	2640	62496	6944		3.00	6944.0	70	625.0	416.6	1.25	241.1		1.75	337.6														
01/S>2/05	US 127	11.48	11.98	0.50	2640	60367	6707		3.00	6707.5	68	603.7	402.4	1.25	232.9		1.75	326.1														
01/S>2/05	US 127	11.98	12.48	0.50	2640	69285	7698		3.00	7698.4	77	692.9	461.9	1.25	267.3		1.75	374.2														
01/S>2/05	US 127	12.48	12.98	0.50	2640	103001	11445		3.00	11444.6	115	1030.0	686.7	1.25	397.4		1.75	556.3														
01/S>2/05	US 127	12.98	13.48	0.50	2640	72206	8023		3.00	8022.9	81	722.1	481.4	1.25	278.6		1.75	390.0													TYPICAL 2 (SEVEN MILE)	
01/S>2/05	US 127	13.48	13.98	0.50	2640	63151	7017		3.00	7016.8	71	631.5	421.0	1.25	243.6		1.75	341.1														
02/STR/05	US 127	13.98	14.48	0.50	2640	64776	7197		3.00	7197.4	72	647.8	431.8	1.25	249.9		1.75	349.9													OMIT BRIDGE AND APPROACH SLABS (SLM 14.09)	
02/STR/05	US 127	14.48	14.98	0.50	2640	62075	6897		3.00	6897.3	69	620.8	413.8	1.25	239.5		1.75	335.3														
02/STR/05	US 127	14.98	15.48	0.50	2640	62601	6956	1.00	3.00	6955.7	70	626.0	417.3	1.25	241.5	10.6	1.75	338.1	30.2													
02/STR/05	US 127	15.48	15.98	0.50	2640	53995	5999	1.00	3.00	5999.4	60	539.9	360.0	1.25	208.3	10.6	1.75	291.6	30.2												OMIT BRIDGE AND APPROACH SLABS (SLM 15.61)	
02/STR/05	US 127	16.98	17.48	0.50	2640	63614	7068	1.00	3.00	7068.2	71	636.1	424.1	1.25	245.4	10.6	1.75	343.6	30.2													
02/STR/05	US 127	17.48	17.98	0.50	2640	64705	7189	1.00	3.00	7189.4	72	647.0	431.4	1.25	249.6	10.6	1.75	349.5	30.2													
02/STR/05	US 127	17.98	18.48	0.50	2640	62137	6904	1.00	3.00	6904.2	70	621.4	414.2	1.25	239.7	10.6	1.75	335.6	30.2													
02/STR/05	US 127	18.48	18.98	0.50	2640	64427	7159	1.00	3.00	7158.5	72	644.3	429.5	1.25	248.6	10.6	1.75	348.0	30.2													
02/STR/05	US 127	18.98	19.48	0.50	2640	62892	6988	1.00	3.00	6988.0	70	628.9	419.3	1.25	242.6	10.6	1.75	339.7	30.2													
02/STR/05	US 127	19.48	19.98	0.50	2640	63415	7046	1.00	3.00	7046.1	71	634.1	422.8	1.25	244.7	10.6	1.75	342.5	30.2													
02/STR/05	US 127	19.98	20.48	0.50	2640	64255	7139	1.00	3.00	7139.4	72	642.5	428.4	1.25	247.9	10.6	1.75	347.1	30.2													
02/STR/05	US 127	20.48	20.98	0.50	2640	65461	7273	1.00	3.00	7273.4	73	654.6	436.4	1.25	252.5	10.6	1.75	353.6	30.2													
02/STR/05	US 127	20.98	21.09	0.11	576	10322	1147	0.22	3.00	1146.8	12	103.2	68.8	1.25	89.8	2.3	1.75	58.7	6.6												STOP AT PRE AND BUT COUNTY LINE SIGN	
TOTALS CARRIED TO GENERAL SUMMARY								15.22		204877	2061	30732		7275		9959	703	5867	14	15.22	8.11	8.11										

BUT-127-7.48

MODEL: Sheet: PAPER/SIZE: 34x22 (in.) DATE: 10/28/2024 TIME: 9:54:10 AM USER: jdavies4
 pww:\ohodot-pw-bentley.com\ohodot-pw-02\Documents\01 Active Projects\District 08\Butter\100645\400-Engineering\Roadway\Sheets\100645_P\001.dgn

PAVEMENT QUANTITIES

DESIGN AGENCY



DESIGNER
 REVIEWER
 PROJECT ID
 SHEET TOTAL
 P.7 13