


STATE OF OHIO DEPARTMENT OF TRANSPORTATION

BUT-732-3.04


REILY TOWNSHIP
BUTLER COUNTY

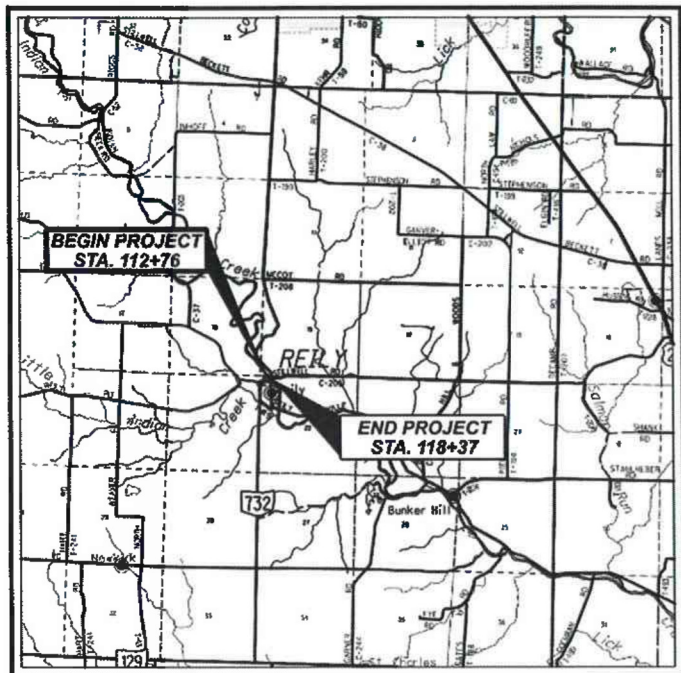

LOCATION MAP

LATITUDE: 39°26'2.8" LONGITUDE: 84°45'33.7"

SCALE IN MILES

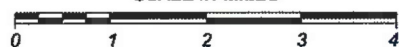

PORTION TO BE IMPROVED	—————
INTERSTATE HIGHWAY	—————
FEDERAL ROUTES	—————
STATE ROUTES	—————
COUNTY & TOWNSHIP ROADS	—————
OTHER ROADS	—————

DESIGN DESIGNATION

CURRENT ADT (2021)	2,000
DESIGN YEAR ADT (2041)	2,600
DESIGN HOURLY VOLUME (2041)	340
DIRECTIONAL DISTRIBUTION	0.13
TRUCKS (24 HOUR B&C)	7%
DESIGN SPEED	35 MPH
LEGAL SPEED	35 MPH
DESIGN FUNCTIONAL CLASSIFICATION:	
05 - MAJOR COLLECTOR (RURAL)	
NHS PROJECT	NO

DESIGN EXCEPTIONS

NONE

UNDERGROUND UTILITIES

Contact Two Working Days Before You Dig



OHIO811.org
Before You Dig

OHIO811, 8-1-1, or 1-800-362-2764
(Non-members must be called directly)


PLAN PREPARED BY:
OHIO DEPARTMENT OF TRANSPORTATION
DISTRICT 8 PRODUCTION - BRIDGE OFFICE
505 SOUTH S.R. 741 LEBANON, OH 45036

ENGINEER'S SEAL:

STATE OF OHIO

GARRET T. FREEMAN
E-83489

REGISTERED PROFESSIONAL ENGINEER

SIGNED: 
DATE: 6/17/2021

STANDARD CONSTRUCTION DRAWINGS				SUPPLEMENTAL SPECIFICATIONS	SPECIAL PROVISIONS
MGS-2.1	1/19/18	DM-1.1	7/17/20	800-2019	1/15/21
MGS-4.3	1/18/13	DM-1.2	1/18/13	832	10/19/18
		DM-4.3	1/15/16	846	4/17/15
BP-3.1	1/17/20	DM-4.4	1/15/16	878	1/17/20
AS-1-15	7/17/15	TC-61.10	1/17/20		
AS-2-15	1/18/19	TC-65.10	1/17/14		
DBR-2-73	7/19/02	TC-65.11	7/21/17		
DBR-3-11	7/15/11				
DS-1-92	7/18/03	MT-97.10	4/19/19		
EXJ-4-87	1/19/18	MT-97.11	1/20/17		
GSD-1-19	1/18/19	MT-101.60	1/17/20		

FEDERAL PROJECT NUMBER

E161 (445)

RAILROAD INVOLVEMENT

NONE

PROJECT DESCRIPTION

REHABILITATION OF A BRIDGE CARRYING STATE ROUTE 732 OVER INDIAN CREEK IN REILY TOWNSHIP BY REMOVING AND REPLACING EXISTING REINFORCED CONCRETE DECK, REPLACING APPROACH SLABS, PROVIDING NEW BEARINGS AND PAINTING ALL STRUCTURAL STEEL.


EARTH DISTURBED AREAS

PROJECT EARTH DISTURBED AREA:	0.14 ACRES
ESTIMATED CONTRACTOR EARTH DISTURBED AREA:	0.13 ACRES
NOTICE OF INTENT EARTH DISTURBED AREA:	N/A (NOI NOT REQUIRED)

2019 SPECIFICATIONS

THE STANDARD SPECIFICATIONS OF THE STATE OF OHIO, DEPARTMENT OF TRANSPORTATION, INCLUDING SUPPLEMENTAL SPECIFICATIONS LISTED IN THE PLANS AND CHANGES LISTED IN THE PROPOSAL SHALL GOVERN THIS IMPROVEMENT.

I HEREBY APPROVE THESE PLANS AND DECLARE THAT THE MAKING OF THIS IMPROVEMENT WILL REQUIRE THE CLOSING TO TRAFFIC OF THE HIGHWAY, AND THAT DETOURS WILL BE PROVIDED AS INDICATED ON THE PLANS.

APPROVED: 
DATE: 6/21/2021 DISTRICT DEPUTY DIRECTOR

APPROVED: _____
DATE: _____ DIRECTOR, DEPARTMENT OF TRANSPORTATION

TITLE SHEET

DESIGN AGENCY	
DESIGNER	GTF
REVIEWER	CAH 05/28/21
PROJECT ID	100829
SHEET TOTAL	1 28

BUT-732-3.04

MODEL: Sheet PAPER: 11x17 DATE: 6/21/2021 TIME: 5:45:04 AM USER: gfreeman