
× 6 ×

END PROJECT STA. 118+37

LOCATION MAP

LATITUDE: 39 °26'2.8" LONGITUDE: 84 °45' 33.7"

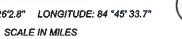

| PORTION TO BE IMPROVED | |
|-------------------------|--|
| INTERSTATE HIGHWAY | |
| FEDERAL ROUTES | |
| STATE ROUTES | |
| COUNTY & TOWNSHIP ROADS | |
| OTHER ROADS | |

DESIGN DESIGNATION

| CURRENT ADT (2021) | 2,000 |
|-----------------------------------|--------|
| DESIGN YEAR ADT (2041) | 2,600 |
| DESIGN HOURLY VOLUME (2041) | 340 |
| DIRECTIONAL DISTRIBUTION | 0.13 |
| TRUCKS (24 HOUR B&C) | 7% |
| DESIGN SPEED | 35 MPH |
| LEGAL SPEED | 35 MPH |
| DESIGN FUNCTIONAL CLASSIFICATION: | |
| 05 - MAJOR COLLECTOR (RURAL) | |
| NHS PROJECT | NO |
| | |

DESIGN EXCEPTIONS

UNDERGROUND UTILITIES Contact Two Working Days Before You Dig Before You Dig

OHIO811, 8-1-1, or 1-800-362-2764 (Non-members must be called directly)

PLAN PREPARED BY: OHIO DEPARTMENT OF TRANSPORTATION DISTRICT 8 PRODUCTION - BRIDGE OFFICE 505 SOUTH S.R. 741 LEBANON, OH 45036

STATE OF OHIO **DEPARTMENT OF TRANSPORTATION**

BUT-732-3.04

REILY TOWNSHIP **BUTLER COUNTY**

INDEX OF SHEETS:

| TITLE SHEET | 1 |
|---|-------|
| GENERAL NOTES | 2 |
| MAINTENANCE OF TRAFFIC NOTES | 3 |
| DETOUR PLAN | 4 |
| GENERAL SUMMARY | 5 |
| PAVEMENT CALCULATIONS | 6 |
| CENTERLINE REFERENCE AND BENCHMARK DATA | 7 |
| ROAD PROFILES | 8 |
| SUPERELEVATION TABLE | 9 |
| INTERSECTION DETAILS | 10-11 |
| STRUCTURES OVER 20' SPAN | |
| BUT-732-0304 | 12-28 |

FEDERAL PROJECT NUMBER

E161 (445)

RAILROAD INVOLVEMENT

NONE

PROJECT DESCRIPTION

REHABILITATION OF A BRIDGE CARRYING STATE ROUTE 732 OVER INDIAN CREEK IN REILY TOWNSHIP BY REMOVING AND REPLACING EXISTING REINFORCED CONCRETE DECK REPLACING APPROACH SLABS, PROVIDING NEW BEARINGS AND PAINTING ALL STRUCTURAL STEEL.

EARTH DISTURBED AREAS

PROJECT EARTH DISTURBED AREA: 0.14 ACRES ESTIMATED CONTRACTOR EARTH DISTURBED AREA: 0.13 ACRES N/A (NOI NOT REQUIRED) NOTICE OF INTENT EARTH DISTURBED AREA:

2019 SPECIFICATIONS

THE STANDARD SPECIFICATIONS OF THE STATE OF OHIO, DEPARTMENT OF TRANSPORTATION, INCLUDING SUPPLEMENTAL SPECIFICATIONS LISTED IN THE PLANS AND CHANGES LISTED IN THE PROPOSAL SHALL GOVERN THIS IMPROVEMENT.

SUPPLEMENTAL SPECIAL STANDARD CONSTRUCTION DRAWINGS SPECIFICATIONS **PROVISIONS** 7/16/21 WATERWAY PERMIT 1/19/18 DM-1.1 7/17/20 MGS-2.1 ENGINEER'S SEAL: 1/18/13 DM-1.2 1/18/13 BUT-SR 732-3.04 DM-4.3 4/17/1 1/15/16 1/17/20 DM-4.4 1/15/16 1/17/20 GARRET T. FREEMAN DBR-2-73 7/19/02 70-65 10 147414 E-83489 DBR-3-11 7/15/11 TC-65.11 7/21/17 1/19/18 MJ-97.10 4/19/19 1/17/20 7/17/20 MT-105.10 1/17/20 DATE:

I HEREBY APPROVE THESE PLANS AND DECLARE THAT THE MAKING OF THIS IMPROVEMENT WILL REQUIRE THE CLOSING TO TRAFFIC OF THE HIGHWAY, AND THAT DETOURS WILL BE PROVIDED AS INDICATED ON THE PLANS.

| APPROVED | |
|----------|-------------------------|
| DATE | DIRECTOR, DEPARTMENT OF |
| | TRANSPORTATION |



GTF CAH 05/28/2

100829

ကု 32 BUT

LISTED BELOW ARE ALL UTILITIES LOCATED WITHIN THE PROJECT CONSTRUCTION LIMITS TOGETHER WITH THEIR RESPECTIVE OWNERS:

BUTLER RURAL ELECTRIC COOPERATIVE, INC. 3888 STILLWELL-BECKETT ROAD OXFORD, OH 45056 513-867-4438 (RAY BRUNNER) RAYB@BUTLÈRRURAL.COOP

DUKE ENERGY - ELECTRIC (DISTRIBUTION) 2010 DANA AVE CINCINNATI OH 45207 513-514-8211 (AARON WRIGHT) AARON.WRIGHT@DUKE-ENEŔGY.COM

CINCINNATI BELL - AERIAL & PLACING 221 E. 4TH ST., BLDG. 121-900 CINCINNATI. OH 45201 513-565-6014 (ROB STROCHINSKY) ROBERT.STROCHINSKY@CINBELL.COM ROADPROJECTS@CINBELL.COM

CINCINNATI BELL - UNDERGROUND STRUCTURES 221 E. 4TH ST., BLDG. 121-900 CINCINNATI, OH 45201 513-565-7187 (OFFICE) BRECK.COWAN@CINBELL.COM ROADPROJECTS@CINBELL.COM

SOUTHWEST REGIONAL WATER DISTRICT 3640 OLD OXFORD HIGHWAY HAMILTON. OH 45013 513-863-0828 (TOM PUCKETT) PUCKETTT@SWWATER.ORG

CHARTER COMMUNICATIONS 10920 KENWOOD ROAD BLUE ASH. OHIO 45242 DL-SOUTHERN-OHIO-OUTSIDE-PLANT@CHARTER.COM 513-386-5499 (KENT RIEGER) KENT.RIEGER@CHARTER.COM

THE LOCATION OF THE UNDERGROUND UTILITIES SHOWN ON THE PLANS ARE AS OBTAINED FROM THE OWNERS AS REQUIRED BY SECTION 153.64 O.R.C.

CONSTRUCTION NOISE

ACTIVITIES AND LAND USE ADJACENT TO THIS PROJECT MAY BE AFFECTED BY CONSTRUCTION NOISE. IN ORDER TO MINIMIZE ANY ADVERSE CONSTRUCTION NOISE IMPACTS, FOLLOW ALL LOCAL NOISE ORDINANCE RESTRICTIONS. IN ADDITION, DO NOT OPERATE AT ANY TIME ANY DEVICE IN SUCH A MANNER THAT THE NOISE CREATED SUBSTANTIALLY EXCEEDS THE NOISE CUSTOMARILY AND NECESSARILY ATTENDANT TO THE REASONABLE AND EFFICIENT PERFORMANCE OF SUCH EQUIPMENT.

SOLE SOURCE AQUIFER

THIS PROJECT IS LOCATED WITHIN THE GREAT MIAMI SOLE SOURCE AQUIFER. USE PROPER CONTAINMENT AND DIKING IN REFUELING AREAS. DO NOT STORE FUELS, TOXIC/HAZARDOUS MATERIALS, AND CHEMICALS NEAR DRAINAGE WAYS, DITCHES, OR STREAMS. MAINTAIN A SPILL KIT ON-SITE THROUGHOUT CONSTRUCTION ACTIVITIES. IMMEDIATELY MITIGATE ANY EVENT. SUCH AS A SPILL OF FUELS, OILS, OR CHEMICALS, THAT COULD THREATEN TO CONTAMINATE THE DRINKING WATER SUPPLY. REPORT ALL SPILLS OR EVENTS TO BUTLER COUNTY WATER AND SEWER, (513) 887-3066. IF THE SPILL IS A REPORTABLE AMOUNT (PER OHIO EPA'S RELEASE REPORTING REQUIREMENTS), CONTACT REILY TOWNSHIP FIRE DEPARTMENT & EMS (STATION 131), (513) 756-0814 OR THE OHIO EPA'S SPILLS HOTLINE 1-800-282-9378 FOR CLEAN-UP OF THE SPILL

INDIANA BAT HABITAT

ENSURE IMPACTS TO THE FEDERALLY LISTED AND PROTECTED INDIANA BAT AND NORTHERN LONG-EARED BAT AND THE STATE LISTED AND PROTECTED LITTLE BROWN BAT AND TRICOLORED BAT ARE AVOIDED AND MINIMIZED. DO NOT REMOVE TREES FROM APRIL 1 THROUGH SEPTEMBER 30. PERFORM ALL NECESSARY TREE REMOVAL FROM OCTOBER 1 THROUGH MARCH 31. FOR THE PURPOSES OF THIS NOTE. A TREE IS DEFINED AS A LIVE, DYING. OR DEAD WOODY PLANT, WITH A TRUNK THREE INCHES OR GREATER IN DIAMETER AT A HEIGHT OF 4.5 FEET ABOVE THE GROUND SURFACE, AND WITH A MINIMUM HEIGHT OF 13 FEET.

SURVEYING PARAMETERS

PRIMARY PROJECT CONTROL MONUMENTS GOVERN ALL POSITIONING ON ODOT PROJECTS. SEE SHEET 7 OF THE PLANS FOR A TABLE CONTAINING PROJECT CONTROL INFORMATION. USE THE FOLLOWING PROJECT CONTROL, VERTICAL POSITIONING AND HORIZONTAL POSITIONING PARAMETERS FOR ALL SURVEYING:

PROJECT CONTROL

POSITIONING METHOD: ODOT VRS MONUMENT TYPE: IRON PINS

VERTICAL POSITIONING

ORTHOMETRIC HEIGHT DATUM: NAV 88

HORIZONTAL POSITIONING

REFERENCE FRAME:

NAD 83 (2011) ELLIPSOID: GRS 80

MAP PROJECTION:

LAMBERT CONFORMAL CONIC OHIO STATE PLANE SOUTH ZONE (3402) COORDINATE SYSTEM.

COMBINED SCALE FACTOR: 1.00000000

ORIGIN OF COORDINATE

SYSTEM: N=0 E=0

USE THE POSITIONING METHODS AND MONUMENT TYPE USED IN THE ORIGINAL SURVEY TO RESTORE ALL MONUMENTS RELATED TO PRIMARY PROJECT CONTROL THAT ARE DAMAGED OR DESTROYED BY CONSTRUCTION ACTIVITIES. RESTORE THE DAMAGED OR DESTROYED MONUMENTS IN ACCORDANCE WITH

UNITS ARE IN U.S. SURVEY FEET

CONNECTION BETWEEN EXISTING AND PROPOSED GUARDRAIL

WHEN IT IS NECESSARY TO SPLICE PROPOSED GUARDRAIL TO EXISTING GUARDRAIL, ONLY THE EXISTING GUARDRAIL SHALL BE CUT, DRILLED, OR PUNCHED. THE CONNECTION SHALL BE MADE USING A W-BEAM, BEAM SPLICE AS SHOWN IN AASHTO M 180-12, EXCEPT THE BEAM WASHERS ARE NOT TO BE USED. PAYMENT SHALL BE INCLUDED IN THE CONTRACT PRICE FOR THE RESPECTIVE GUARDRAIL ITEMS.

CLEARING AND GRUBBING, AS PER PLAN

ALTHOUGH THERE ARE NO TREES OR STUMPS SPECIFICALLY MARKED FOR REMOVAL WITHIN THE LIMITS OF THE PROJECT. A LUMP SUM QUANTITY IS INCLUDED IN THE GENERAL SUMMARY FOR ITEM 201, CLEARING AND GRUBBING. ALL PROVISIONS AS SET FORTH IN THE SPECIFICATIONS UNDER THIS ITEM ARE INCLUDED IN THE LUMP SUM PRICE BID FOR ITEM 201. CLEARING AND GRUBBING. WORK TO BE INCLUDED IN THIS PAY ITEM IS TO INCLUDE THE REMOVAL OF ALL DEBRIS WITHIN THE VICINITY OF THE PIER

WORK LIMITS

THE WORK LIMITS SHOWN ON THESE PLANS ARE FOR PHYSICAL CONSTRUCTION ONLY. PROVIDE THE INSTALLATION AND OPERATION OF ALL WORK ZONE TRAFFIC CONTROL AND WORK ZONE TRAFFIC CONTROL DEVICES REQUIRED BY THESE PLANS WHETHER INSIDE OR OUTSIDE THESE WORK LIMITS

SEEDING AND MULCHING

THE FOLLOWING QUANTITIES ARE PROVIDED TO PROMOTE GROWTH AND CARE OF PERMANENT SEEDED AREAS:

659, SEEDING AND MULCHING 500 SQ. YD. 659. COMMERCIAL FERTILIZER 0.05 TON 0.1 ACRES 659. LIME 659. WATER 1.4 M. GAL

SEEDING AND MULCHING SHALL BE APPLIED TO ALL AREAS OF EXPOSED SOIL BETWEEN THE RIGHT-OF-WAY LINES, AND WITHIN THE CONSTRUCTION LIMITS FOR AREAS OUTSIDE THE RIGHT-OF-WAY LINES COVERED BY WORK AGREEMENT OR SLOPE EASEMENT. QUANTITY CALCULATIONS FOR SEEDING AND MULCHING ARE BASED ON THESE LIMITS.

A+B BIDDING CONTRACT TABLE

USE THE FOLLOWING INFORMATION IN COMBINATION WITH THE PROPOSAL NECESSARY PERMITS AND APPROVALS AND TO TRANSPORT THE NOT 124 A+B BIDDING

THE CONTRACTOR WILL BID THE NUMBER OF CALENDER DAYS TO COMPLETE THE PROJECT AS LISTED IN THE PROPOSAL.

| LOCATION OF CRITICAL WORK | MINIMUM DAYS | MAXIMUM DAYS | INCENTIVE/E | MAXIMUM DISIICIENENIVE/I \$ |
|---|-----------------|-----------------|-------------|-----------------------------------|
| COMPLETE BRIDGE DECK REPLACEMENT, APPROACH PAVEMENT WORK, FIELD PAINTING OF STRUCTURAL STEEL AND OPEN TRAFFIC UP TO THE ORIGINAL CONFIGURATION (STRUCTURE NO. BUT-732-0304) | 60 | 80 | \$3,000 | \$30,000 |

ENVIRONMENTAL EXCLUSIONARY DATES (AQUATIC SPECIES)

TEMPORARY ACCESS FILLS PLACING FILL MATERIAL IN THE STREAM AS PART OF ITEM 503 - COFFERDAMS AND EXCAVATION BRACING SHALL NOT BE CONSTRUCTED FROM THE DATES BEGINNING 4/15 TO 7/1 AND ANY TEMPORARY ACCESS FILLS THAT FULLY SPAN THE ENTIRE WIDTH OF THE STREAM SHALL NOT BE CONSTRUCTED FROM THE DATES BEGINNING 9/15 TO 7/1. TEMPORARY ACCESS FILLS CONSTRUCTED OUTSIDE OF THESE EXCLUSIONARY DATES ARE PERMITTED TO STAY IN PLACE DURING THE EXLCUSIONARY PERIODS SET FORTH ABOVE. ANY WORK INVOLVING PLACEMENT OF FILL MATERIAL IN THE STREAM SHALL BE PERFORMED WITHIN THE DATES PROVIDED IN THE TABLE BELOW AND OUTSIDE OF THE EXCLUSIONARY DATES.

| DESCRIPTION OF | CALENDER DAYS TO | WORK WINDOW | | | | |
|------------------|---------------------|-------------|-----------|--|--|--|
| WORK | COMPLETE | START | END | | | |
| CONSTRUCTION OF | | | | | | |
| PART-WIDTH | 137 | 3/1/2022 | 10/1/2022 | | | |
| TEMPORARY ACCESS | | | | | | |
| FILLS IN STREAM. | | | | | | |

PETROLEUM CONTAMINATED SOILS NOTES

ENVIRONMENTAL STUDIES HAVE SHOWN THAT THERE IS THE POTENTIAL FOR ENCOUNTERING PETROLEUM CONTAMINATED MATERIALS WITHIN THE PROJECT LIMITS. IN THE EVENT PETROLEUM-CONTAMINATED MATERIALS ARE ENCOUNTERED, THE CONTRACTOR SHALL MANAGE THIS MATERIAL ACCORDING TO THE FOLLOWING NOTES. THE ESTIMATED QUANTITIES HAVE BEEN INCLUDED IN THE GENERAL SUMMARY FOR THIS WORK. ALL EXCAVATIONS WITHIN THE AFOREMENTIONED LIMITS SHALL BE PAID FOR UNDER THE ORIGINAL PLAN BID ITEMS.

PETROLEUM CONTAMINATED SOILS NOTES (CONT.)

MATERIAL SAMPLING

THE CONTRACTOR SHALL PROVIDE THE ENGINEER WITH TEN (10) DAYS NOTICE PRIOR TO BEGINNING ANY EXCAVATION WITHIN THE AFOREMENTIONED LIMITS TO ARRANGE FOR THE NECESSARY SCREENING AND SEGREGATION OPERATIONS. ALL MATERIAL EXCAVATED BY THE CONTRACTOR BY DURING CONSTRUCTION AND WITHIN THE SPECIFIED LIMITS SHALL BE SCREENED, SEGREGATED AND TESTED BY AN INSPECTOR PROVIDED BY THE CONTRACTOR AND APPROVED BY THE ENGINEER.

MATERIAL EVALUATION

THE ENGINEER SHALL DETERMINE THE REGULATORY CLASSIFICATION OF THE SPECIFIED EXCAVATED MATERIALS BASED ON TEST RESULTS PROVIDED BY THE CONTRACTOR. THE EXCAVATED MATERIALS MAY BE CLASSIFIED INTO PCS OR INTO MATERIALS WHICH MAY BE USED AS BACKFILL OR OTHER PROJECT PURPOSES, PROVIDED IT MEETS THE APPROPRIATE ODOT SPECIFICATIONS.

ITEM SPECIAL - WORK INVOLVING PETROLEUM CONTAMINATED SOIL

THE CONTRACTOR SHALL BE RESPONSIBLE FOR OBTAINING ALL MATERIALS TO A LICENSED (BY THE LOCAL HEALTH DEPARTMENT) AND PERMITTED (BY THE OHIO ENVIRONMENTAL PROTECTION AGENCY) SOLID WASTE DISPOSAL FACILITY OR A PETROLEUM CONTAMINATED SOIL REMEDIATION FACILITY (PCSRF) FOR PROPER DISPOSAL OR REMEDIATION. PRIOR TO DISPOSAL, THE CONTRACTOR SHALL CONTACT THE PROPOSED FACILITY TO DETERMINE THE ADDITIONAL TESTING REQUIRED FOR DISPOSAL OR REMEDIATION AT THAT FACILITY. THE PRICES FOR THESE TESTS ARE TO BE INCLUDED IN THE ABOVE PAY ITEM. THE WORK INVOLVED WITH THIS PAY ITEM INCLUDES HANDLING, STORAGE, TESTING (FOR DISPOSAL OR REMEDIATION) AND DISPOSAL OR REMEDIATION OF PCS. WHEN DIRECTED BY THE PROPOSED FACILITY, THE CONTRACTOR SHALL HAVE AN INDEPENDENT LABORATORY COLLECT SAMPLES AND TEST THE EXCAVATED OR STORED MATERIALS FOR PCS DISPOSAL OR REMEDIATION APPROVAL

AS AN ALTERNATIVE, THE ENGINEER MAY PERMIT THE CONTRACTOR TO DIRECT LOAD THE EXCAVATED MATERIALS FROM THE AFOREMENTIONED LIMITS INTO TRUCKS FOR SUBSEQUENT DISPOSAL APPROPRIATE FOR PETROLEUM CONTAMINATED SOILS AS DETAILED

TEMPORARY STORAGE OF CONTAMINATED SOILS

ALL MATERIALS EXCAVATED BY THE CONTRACTOR BETWEEN THESE LIMITS MAY BE STOCKPILED IN AN AREA PROVIDED BY THE CONTRACTOR AND APPROVED BY THE ENGINEER. THE ENGINEER MAY PERMIT TEMPORARY STORAGE OF THE EXCAVATED MATERIAL IN A LINED AND COVERED ROLL OFF BOX. THE ENGINEER MAY PERMIT TEMPORARY STORAGE OF THE EXCAVATED MATERIAL ON AN IMPERMEABLE MEMBRANE. THE MEMBRANE SHALL BE SURROUNDED BY BALES OF STRAW TO PREVENT THE SUSPECTED SOILS FROM COMING IN CONTACT WITH PRECIPITATION AND/OR SURFACE RUNOFF AN IMPERMEABLE MEMBRANE SHALL BE PLACED OVER THE STOCKPILE TO PREVENT CONTACT WITH PRECIPITATION AND/OR SURFACE RUN-OFF. THE ENGINEER MAY ALSO PERMIT THE CONTRACTOR TO DIRECT LOAD THE EXCAVATED CONTAMINATED MATERIAL INTO TRUCKS UNTIL A DETERMINATION OF PROPOSED USE IS MADE BY THE ENGINEER.

GENERAL NOTES

ALL TRANSPORT VEHICLES USED FOR THE MOVEMENT OF REGULATED SOILS AND/OR WATER SHALL MEET APPLICABLE FEDERAL, STATE, AND LOCAL REGULATIONS. THE CONTRACTOR SHALL MAINTAIN RECORDS (SUCH AS DAILY LOGS, LANDFILL TICKETS, MANIFESTS, ETC.) THAT DOCUMENT THE SOURCE, MOVEMENT AND DESTINATION OF EACH TRUCK LOAD OF CONTAMINATED MATERIAL. ONE COPY OF EACH OF THESE RECORDS SHALL BE SUBMITTED TO THE ENGINEER.

BASIS OF PAYMENT

THE CONTRACTOR SHALL FURNISH ALL LABOR, EQUIPMENT AND MATERIALS NECESSARY TO PROPERLY EXCAVATE, STORE, TEST (FOR DISPOSAL) TRANSPORT AND DISPOSE OF CONTAMINATED MATERIALS. INCLUDING ANY REQUIRED APPROVALS OR FEES WITHIN THE SPECIFIED LIMITS. PAYMENT FOR THIS WORK SHALL BE MADE AT THE CONTRACT BID PRICE PER TON AND PER GALLON. THE FOLLOWING ESTIMATED QUANTITIES HAVE BEEN INCLUDED IN THE GENERAL SUMMARY FOR THE WORK NOTED HEREIN. A CONVERSION FACTOR OF 1.5 TONS PER CUBIC YARD SHALL BE USED TO CONVERT CUBIC YARDS TO TONS:

690E65016 ITEM SPECIAL - WORK INVOLVING PETROLEUM CONTAMINATED SOIL



GTF CAH 05/28/2

100829

ITEM 614, MAINTAINING TRAFFIC (NOTICE OF CLOSURE SIGN)

A MINIMUM OF ONE LANE OF TRAFFIC IN EACH DIRECTION SHALL BE MAINTAINED AT ALL TIMES, EXCEPT FOR A PERIOD NOT TO EXCEED 80 CONSECUTIVE CALENDAR DAYS BEGINNING NO EARLIER THAN 4/1/2022, WHEN TRAFFIC IS TO BE DETOURED. MAINTAIN ACCESS TO ALL ADJACENT DRIVES AT ALL TIMES. MAINTAIN TRAFFIC ON REILY-MILLVILLE RD. AT ALL TIMES, EXCEPT ONE LANE OF TWO -WAY TRAFFIC MAY BE MAINTAINED BY THE USE OF FLAGGERS DURING PAVING OPERATIONS.

NOTICE OF CLOSURE SIGNS (W20-H13) SHALL BE ERECTED BY THE CONTRACTOR PRIOR TO THE SCHEDULED ROAD OR RAMP CLOSURE IN ACCORDANCE WITH THE NOTICE OF CLOSURE TIME TABLE BELOW. [AT THE APPROVAL OF THE ENGINEER, PORTABLE CHANGEABLE MESSAGE SIGNS MAY BE USED IN LIEU OF THE STANDARD FLATSHEET SIGN FOR CLOSURE DURATIONS OF LESS THAN 1 WEEK.]

CLOSED ----FOR ----DAYS
OHIO DEPT. OF TRANSPORTATION

W20-H14

THE SIGNS SHALL BE ERECTED ON THE RIGHT-HAND SIDE OF THE ROAD/RAMP FACING TRAFFIC. THEY SHALL BE PLACED SO AS NOT TO INTERFERE WITH THE VISIBILITY OF ANY OTHER TRAFFIC CONTROL SIGNS. ON ROADWAYS, THEY SHOULD BE ERECTED AT OR NEAR THE POINT OF CLOSURE. THE SIGNS MAY BE ERECTED ANYWHERE ON RAMPS AS LONG AS THEY ARE VISIBLE TO THE MOTORISTS USING THE RAMP. ON ENTRANCE RAMPS, THE SIGN SHALL BE ERECTED WELL IN ADVANCE OF THE MERGE AREA TO AVOID DISTRACTING MOTORISTS.

| | NOTICE OF CLOSURE SIGN TIME TABLE | | | | | | | | | |
|----------|-----------------------------------|-----------------------------------|--|--|--|--|--|--|--|--|
| ITEM | DURATION OF CLOSURE | SIGN DISPLAYED TO PUBLIC | | | | | | | | |
| RAMP & | > 2 WEEKS | 14 CALENDER DAYS PRIOR TO CLOSURE | | | | | | | | |
| ROAD | > 12 HOURS < 2 WEEKS | 7 CALENDER DAYS PRIOR TO CLOSURE | | | | | | | | |
| CLOSURES | < 12 HOURS | 2 BUSINESS DAYS PRIOR TO CLOSURE | | | | | | | | |

THE SIGN SHALL DISPLAY THE DATE OF THE CLOSURE IN MMM-DD FORMAT AND THE NUMBER OF DAYS OF THE CLOSURE. THE LAST LINE OF THE W20-H13 SIGN LISTS A PHONE NUMBER WHICH A MOTORIST MAY CALL FOR ADDITIONAL INFORMATION. THIS IS TO BE A SPECIFIC OFFICE WITHIN THE DISTRICT RATHER THAN THE GENERAL SWITCHBOARD NUMBER.

THE CONTRACTOR SHALL PROVIDE, ERECT AND MAINTAIN STANDARD 48 X 30 INCH ROAD CLOSED SIGNS, SIGN SUPPORTS, BARRICADES AND LIGHTS, AS DETAILED IN SCD MT-101.60 AT THE FOLLOWING LOCATIONS DURING PERIODS IN WHICH THE AFFECTED ROADS ARE CLOSED TO TRAFFIC.

S.R. 732 JUST NORTH OF STILLWELL RD. INTERSECTION S.R. 732 JUST NORTHEAST OF REILY-MILLVILE RD. INTERSECTION STILLWELL RD. JUST EAST OF THE S.R. 732 INTERSECTION

ALL WORK AND TRAFFIC CONTROL DEVICES SHALL BE IN ACCORDANCE WITH C&MS 614 AND OTHER APPLICABLE PORTIONS OF THE SPECIFICATIONS, AS WELL AS THE OHIO MANUAL OF UNIFORM TRAFFIC CONTROL DEVICES. PAYMENT FOR ALL LABOR, EQUIPMENT AND MATERIALS SHALL BE INCLUDED IN THE LUMP SUM CONTRACT PRICE FOR ITEM 614, MAINTAINING TRAFFIC, UNLESS SEPARATELY ITEMIZED IN THE PLAN

ITEM 614, DETOUR SIGNING

THE CONTRACTOR SHALL PROVIDE, MAINTAIN, AND SUBSEQUENTLY REMOVE ALL DETOUR SIGNING AND SUPPORTS AS SHOWN ON SHEET 4 AND ON STANDARD CONSTRUCTION DRAWING MT-101.60. ALL WORK SHALL BE PAID FOR UNDER ITEM 614, DETOUR SIGNING.

NOTIFICATION OF TRAFFIC RESTRICTIONS

THROUGHOUT THE DURATION OF THE PROJECT, THE CONTRACTOR SHALL NOTIFY THE PROJECT ENGINEER IN WRITING OF ALL TRAFFIC RESTRICTIONS AND UPCOMING MAINTENANCE OF TRAFFIC CHANGES. THE CONTRACTOR SHALL ENSURE THE WRITTEN NOTIFICATION IS SUBMITTED IN A TIMELY MANNER TO ALLOW THE PROJECT ENGINEER TO MEET THE REQUIRED TIME FRAMES SET FORTH IN THE TABLE BELOW TO INFORM THE SPECIAL HAULING PERMITS SECTION (HAULING.PERMITS@DOT.OHIO.GOV) AND THE DISTRICT PUBLIC INFORMATION OFFICE (PIO). THIS NOTIFICATION SHALL BE RECEIVED BY THE PROJECT ENGINEER PRIOR TO THE PHYSICAL SETUP OF ANY APPLICABLE SIGNS OR MESSAGE BOARDS.


INFORMATION SHOULD INCLUDE, BUT IS NOT LIMITED TO, ALL CONSTRUCTION ACTIVITIES THAT IMPACT OR INTERFERE WITH TRAFFIC AND SHALL LIST THE SPECIFIC LOCATION, TYPE OF WORK, ROAD STATUS, DATE AND TIME OF RESTRICTION, DURATION OF RESTRICTION, NUMBER OF LANES MAINTAINED, NUMBER OF LANES CLOSED, MINIMUM VERTICAL CLEARANCE, MINIMUM WIDTH OF DRIVABLE PAVEMENT, DETOUR ROUTES, IF APPLICABLE, AND ANY OTHER INFORMATION REQUESTED BY THE PROJECT ENGINEER.

| NOTIFICATION TIME TABLE | | | | | | | | |
|----------------------------|--------------|------------------|--|--|--|--|--|--|
| ITFM | DURATION OF | NOTICE DUE TO | | | | | | |
| TTEIVI | CLOSURE | LISTED CONTACTS | | | | | | |
| | >= 2 WEEKS | 21 CALENDAR DAYS | | | | | | |
| | >= 2 WEEKS | PRIOR TO CLOSURE | | | | | | |
| RAMP & ROAD | > 12 HOURS & | 14 CALENDAR DAYS | | | | | | |
| CLOSURES | < 2 WEEKS | PRIOR TO CLOSURE | | | | | | |
| | < 12 HOURS | 4 BUSINESS DAYS | | | | | | |
| | < 12 HOURS | PRIOR TO CLOSURE | | | | | | |
| | >= 2 WEEKS | 14 CALENDAR DAYS | | | | | | |
| LANE CLOSURES & | >- 2 WEENS | PRIOR TO CLOSURE | | | | | | |
| RESTRICTIONS | < 2 WEEKS | 5 BUSINESS DAYS | | | | | | |
| | < 2 WEEKS | PRIOR TO CLOSURE | | | | | | |
| START OF CONSTRUCTION & | | 14 CALENDAR DAYS | | | | | | |
| TRAFFIC PATTERN | N/A | PRIOR TO | | | | | | |
| CHANGES | | IMPLEMENTATION | | | | | | |


ANY UNFORESEEN CONDITIONS NOT SPECIFIED IN THE PLANS REQUIRING TRAFFIC RESTRICTIONS SHALL ALSO BE REPORTED TO THE PROJECT ENGINEER USING THE NOTIFICATION TIME TABLE.



DESIGNER
GTF
REVIEWER
CAH 05/28/21
PROJECT ID
100829
SHEET TOTAL

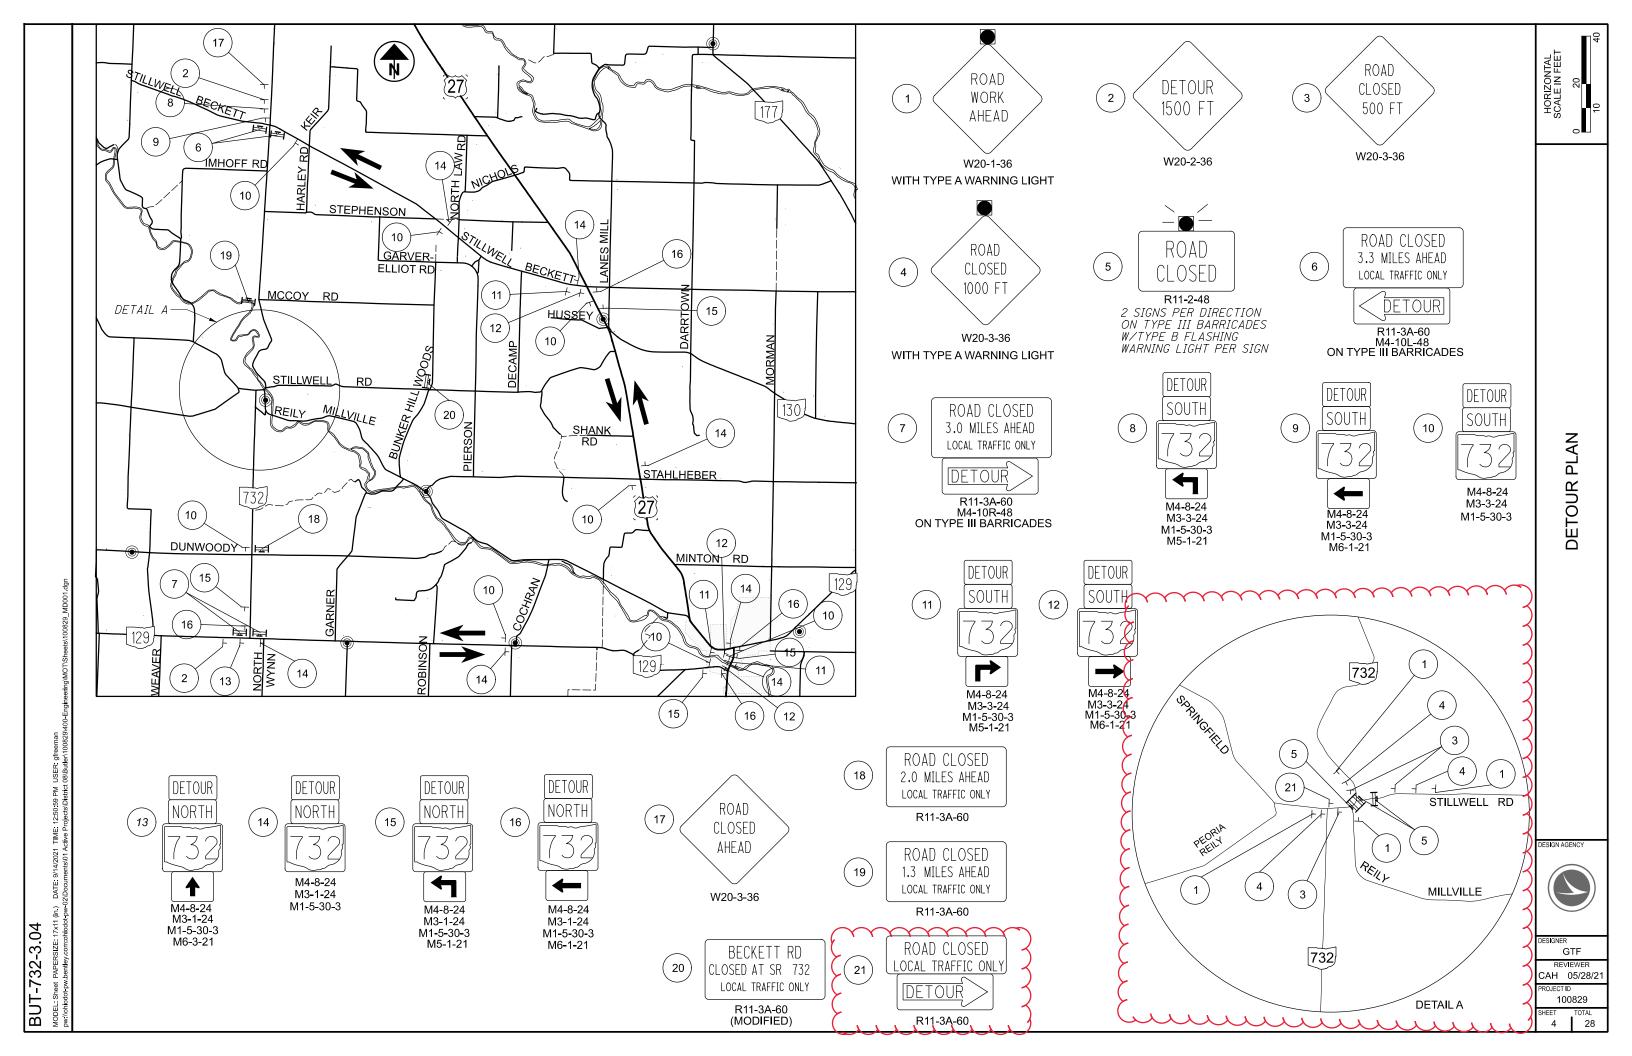

| | | | | SI | HEET NUM | И. | | | PART. | ITEM | ITEM | GRAND | UNIT | DESCRIPTION | SEE |
|------|------------|----------|---|----|----------|----|--|---|------------|------------|----------------|-------------|--------------|--|-----------|
| 2 | 6 | | | | | | | | 01/STR/BR | ITEIVI | EXT | TOTAL | UNIT | DESCRIPTION | SHEET NO. |
| _UMP | | | | | | | | | LUMP | 201 | 11001 | LS | | ROADWAY CLEARING AND GRUBBING, AS PER PLAN | 2 |
| | 184 | | | | | | | | 184 | 202 | 22900 | 184 | SY | APPROACH SLAB REMOVED | |
| | 243 | | | | | | | | 243 | 202 | 23000 | 243 | SY | PAVEMENT REMOVED | |
| | | | | | | | | | 50 | 202 | 38000 | 50 | FT | GUARDRAIL REMOVED | |
| | | | | | | | | | 1 1 | 202 | 42040 | 1 | EACH | ANCHOR ASSEMBLY REMOVED, TYPE T | |
| | 470 | | | | | | | | 4 | 202 | 47000 | 4 | EACH | BRIDGE TERMINAL ASSEMBLY REMOVED | |
| | 178 534 | | | | | | | | 178 534 | 204 204 | 30020 10000 | 178 534 | CY SY | GRANULAR MATERIAL, TYPE C SUBGRADE COMPACTION | |
| | 178 | | | | | | | | 178 | 204 | 13000 | 178 | CY | EXCAVATION OF SUBGRADE 12" DEPTH | |
| | 534 | | | | | | | | 534 | 204 | 50000 | 534 | SY | GEOTEXTILE FABRIC | |
| | 0.09 | | | | | | | | 0.09 | 209 | 15050 | 0.09 | MILE | RESHAPING UNDER GUARDRAIL | |
| | | | | | | | | | 50 | 606 | 15050 | 50 | FT | GUARDRAIL, TYPE MGS | |
| | | | | | | | | | 1 1 | 606 | 26550 | 1 | EACH | ANCHOR ASSEMBLY, MGS TYPE T | |
| | | | | | | | | | 4 LUMP | 606 878 | 35140 25000 | LS | EACH | BRIDGE TERMINAL ASSEMBLY, TYPE 4 INSPECTION AND COMPACTION TESTING OF UNBOUND MATERIALS | |
| | | | | | | | | | LOWIF | 070 | 23000 | Lo | | INSPECTION AND COMPACTION LESTING OF UNBOOND MATERIALS | |
| | | | | | | | | | | | | | | EROSION CONTROL | |
| 500 | | | | | | | | | 500 | 659 | 10000 | 500 | SY | SEEDING AND MULCHING | |
| 0.05 | | | | | | | | | 0.05 | 659 | 20000 | 0.05 | TON | COMMERCIAL FERTILIZER | |
| 0.1 | | | | | | | | | 0.1 | 659 | 31000 | 0.1 | ACRE | LIME | |
| 1.4 | | | | | | | | | 1.4 | 659 832 | 35000 30000 | 1.4 | MGAL EACH | WATER EROSION CONTROL | |
| | | | | | | | | | 1,000 | 032 | 30000 | 1,000 | EACH | EROSION CONTROL | |
| | | | | | | | | | | | | | | ENVIRONMENTAL / REMEDIATION | |
| | | | | | | | | | 1 | 202 | 66500 | 1 | EACH | UNDERGROUND STORAGE TANK REMOVED | |
| | | | | | | | | | 9 | SPECIAL | 69065016 | 9 | TON | WORK INVOLVING PETROLEUM CONTAMINATED SOIL | 2 |
| | | | | | | | | | | | | | | DAVENDA | |
| | 479 | | | | | | | | 470 | 254 | 01000 | 479 | SY | PAVEMENT PLANING, ASPHALT CONCRETE (T=1.25") | |
| | 57 | | | | | | | | 479 57 | 254 301 | 46000 | 57 | CY | ASPHALT CONCRETE BASE, PG64-22 | |
| | 83 | | | | | | | | 83 | 304 | 20000 | 83 | CY | AGGREGATE BASE | |
| | 265 | | | | | | | | 265 | 407 | 20000 | 265 | GAL | NON-TRACKING TACK COAT | |
| | 26 | | | | | | | | 26 | 441 | 50000 | 26 | CY | ASPHALT CONCRETE SURFACE COURSE, TYPE 1, (448), PG64-22 | |
| | 53 | | | | | | | | 53 | 441 | 50300 | 53 | CY | ASPHALT CONCRETE INTERMEDIATE COURSE, TYPE 2, (448) | |
| | | | | | | | | | | | | | | TRAFFIC CONTROL | |
| | | | | | | | | | 3 | 621 | 00100 | 3 | EACH | TRAFFIC CONTROL RPM | |
| | | | | | | | | | 3 | 621 | 54000 | 3 | EACH | RAISED PAVEMENT MARKER REMOVED | |
| | | | | | | | | | 6 | 626 | 00110 | 6 | EACH | BARRIER REFLECTOR, TYPE 2 (BI-DIRECTIONAL) | |
| | | | | | | | | | 0.1 | 644 | 00104 | 0.1 | MILE | EDGE LINE, 6" | |
| | | | | | | | | | 0.05 | 644 | 00300 | 0.05 | MILE | CENTER LINE | |
| | | | | | | | | | 0.1 | 646 646 | 10010 10200 | 0.1 0.05 | MILE MILE | EDGE LINE, 6" CENTER LINE | |
| | | | | | | | | | 0.05 | 040 | 10200 | 0.05 | IVIILE | CENTER LINE | |
| | | | | | | | | | | | | | | MAINTENANCE OF TRAFFIC | |
| | | | | | | | | | LUMP | 614 | 12420 | LS | | DETOUR SIGNING | |
| | | | | | | | | | | | | | | | |
| | | | | | | | | | LUMP | 61/ | 11000 | 10 | | INCIDENTALS MAINTAINING TRAFFIC | |
| | | | + | | | | | | LUMP | 614 623 | 11000 10000 | LS LS | | CONSTRUCTION LAYOUT STAKES AND SURVEYING | |
| | | | + | | | | | | LUMP | 624 | 10000 | LS | | MOBILIZATION | |
| | | | | | | | | | | | | | | | |
| | | | | | | | | | | | | | | | |
| | | | | | | | | | | | | | | | |
| | | | | | | | | | | | | | | | |
| | | | + | | | | | - | | - | | | | | |
| | | | | | | | | | | | | | | | |
| | | | | | | | | | | | | | | | |
| | | | + | | | | | | | | | | | | |
| | | <u> </u> | | | | | | | | | | | | | |
| | | | | | | | | | | | | | | | |
| | | | | | | | | | | | | | | | |
| | | | | | ı — | l | | | | 1 | 1 | 1 | I | | |

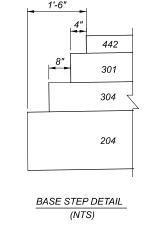

1'-6"

ITEM 202 -PAVEMENT REMOVED

LEGEND

11) ITEM 441 -

ITEM 204 -GRANULAR MATERIAL, TYPE C ITEM 204 -

SUBGRADE COMPACTION ITEM 204 -EXCAVATION OF SUBGRADE, 12" DEPTH

1234567890 ITEM 204 -GEOTEXTILE FABRIC

ITEM 209 -GRADING UNDER GUARDRAIL ITEM 301 -8" ASPHALT CONCRETE BASE, PG64-22

ITEM 304 -6" AGGREGATE BASE

ITEM 407 -NON-TRACKING TACK COAT ITEM 441 -

1.25" ASPHALT CONCRETE SURFACE COURSE, TYPE 1, (448), PG64-22

1.75" ASPHALT CONCRETE INTERMEDIATE COURSE,

TYPE 2, (448) 12) ITEM 441 -VARIABLE DEPTH ASPHALT CONCRETE INTERMEDIATE COURSE,

TYPE 2, (448) ITEM 254 -PAVEMENT PLANING (T=1.25")

(A) EXISTING PAVEMENT (AC SURFACE/INT.THICKNESS = `3")

(AC BASE THICKNESS = `8")

(AGGREGATE THICKNESS = `7")

| | | | | | | | | | | | PAN | /EMENT CALCUL | ATIONS | | | | | | | | | | | | | |
|----------|------------|------------------|----------|-------|------------------|---------------------|--------------------------|----------------------------|------------------------|--------------------------------|----------------------|------------------|--------|---------------|-------|-------------------------------|---------------------------------------|-----------------|------------------------------|----------------|--|----------------|---|-------------------------|--|-------|
| | | | | | | 202 | 202 | 204 | 204 | 204 | 204 209 254 301 304 | | | | | 407 | | | | 441 | | | | | | |
| R | OUTE . | STA ⁻ | ΓΙΟΝ | ENGTH | PAVEMENT AREA | PAVEMENT REMOVED | APPROACH SLAB REMOVED | GRANULAR MATERIAL, TYPE | SUBGRADE COMPACTION | EXCAVATION OF SUBGRADE, 12" | GEOTEXTILE FARRIC | FABRIC GUARDRAIL | | TILE LINDED | | MENT NING HALT CRETE | 8" ASPHALT CONCRETE BASE, PG64- | 6" AGGREGATE | NON TRACKING TACK COAT | SURFACI | ILT CONCRETE E COURSE, TYPE 48), PG64-22 | INTERMED | T CONCRETE DIATE COURSE, E 2, (448) | INTER COURSE, | CONCRETE RMEDIATE TYPE 2, (448) BLE THICK.) | NOTES |
| | | FROM | ТО | 1 | | KEWOVED | OL/ ID MEINOVED | С | GOWII / GOTION | DEPTH | TABINO | | | 2 | | EPTH | 22 | BASE | @ 0.09 GAL/SQ YD | THICK- NESS | | THICK- NESS | | AVE. THICK- NESS | | |
| | | | | FT | SQ YD | SQ YD | SQ YD | CU YD | SQ YD | CU YD | SQ YD | MILE | INCHES | SQ YD | CU YD | CU YD | GAL | INCHES | CU YD | INCHES | CU YD | INCHES | CU YD | | | |
| | SR 732 | 11+28.20 | 11+89.42 | 61 | 181 | | | | | | | 0.02 | 1.25 | 181 | | | 32.5 | 1.25 | 6 | | | 4.25 | 21 | PROFILE ADJUSTMENT | | |
| | SR 732 | 11+89.42 | 12+11.41 | 22 | 78 | 78 | | 33 | 98 | 33 | 98 | 0.01 | | | 18 | 15 | 21.0 | 1.25 | 3 | 1.75 | 4 | | | FULL DEPTH AC PAVEMENT | | |
| | SR 732 | 12+11.41 | 12+36.39 | 25 | 89 | | 89 | 37 | 110 | 37 | 110 | 0.01 | | | | 17 | | | | | | | | REAR APPROACH SLAB | | |
| BUT | SR 732 | 12+36.39 | 13+40.61 | 104 | 0 | | | | | | | | | | | | | | | | | | | | | |
| BUT | SR 732 | 13+40.61 | 13+61.32 | 21 | 95 | | 95 | 39 | 117 | 39 | 117 | 0.01 | | | | 18 | | | | | | | | FORWARD APPROACH SLA | | |
| BUT | SR 732 | 13+61.32 | 13+91.85 | 31 | 90 | 90 | | 37 | 111 | 37 | 111 | 0.01 | | | 21 | 17 | 24.2 | 1.25 | 3 | 1.75 | 4 | | | FULL DEPTH AC PAVEMENT | | |
| BUT | SR 732 | 13+91.85 | 14+20.00 | 28 | 103 | | | | | | | 0.01 | 1.25 | 103 | | | | 1.25 | 4 | | | 1.00 | 3 | PROFILE ADJUSTMENT | | |
| | | | | | | | | | | | | | | | | | | | | | | | | | | |
| REILLY | -MILLVILLE | 00+10.35 | 00+40.00 | 30 | 183 | | | | | | | 0.01 | 1.25 | 183 | | | 32.9 | 1.25 | 6 | | | 3.00 | 15 | PROFILE ADJUSTMENT | | |
| | | | | | | | | | | | | | | | | | | | | - | | | | | | |
| | RIVE | 00+16.79 | 00+25.00 | 8 | 12 | | | | | | | 0.01 | 1.25 | 12 | | | 2.2 | 1.25 | 1 | | | 3.00 | 1 | PROFILE ADJUSTMENT | | |
| | 110/511 | 00:40.57 | 00.40.00 | 00 | 75 | 75 | | 00 | 0.7 | 00 | 0.7 | 0.04 | | | 40 | 45 | 00.0 | 4.05 | 2 | 4 75 | 4 | | | FULL DEDTILLAG DAVEMENT | | |
| SIII | LWELL | 00+13.57 | 00+40.00 | 26 | 75 | 75 | | 32 | 97 | 32 | 97 | 0.01 | | | 18 | 15 | 20.3 | 1.25 | 3 | 1.75 | 4 | | | FULL DEPTH AC PAVEMENT | | |
| \vdash | | | | | | | | | | | | | | | | | | | | | | | | | | |
| тот | ALS CAF | RRIED TO |) GENER | AL SU | IMMARY | 243 | 184 | 178 | 534 | 178 | 534 | 0.10 | | 479 | 57 | 83 | 265 | | 26 | | 12 | | 41 | | | |

PROFILE ADJUSTMENT

SAME OPPOSITE ζ

SIDE

TRAFFIC LANES

(12)

EDGE OF TRAVELED WAY

SHOULDER



GTF CAH 05/28/21 100829 SHEET TOTAL 6 28

BUT-732-3.04

FULL DEPTH AC PAVEMENT

TRAFFIC LANES


SAME

SIDE

OPPOSITE 4

EDGE OF TRAVELED WAY

SHOULDER

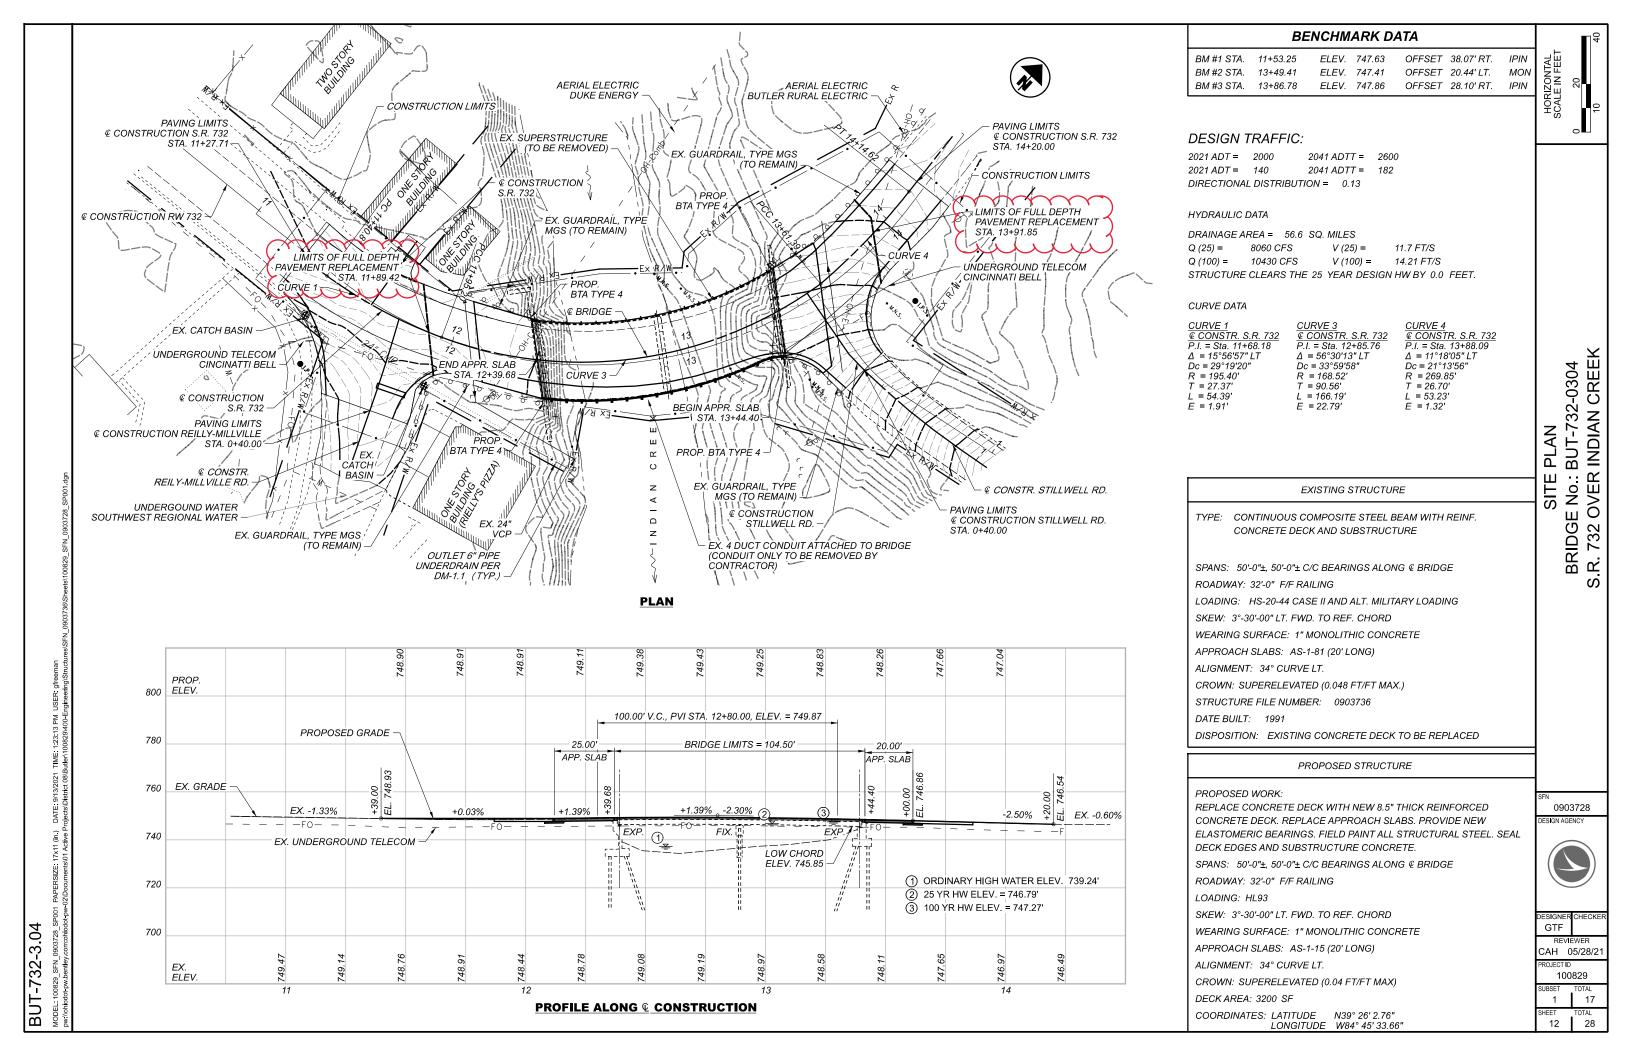


| ٧ | |
|---|--|
| | |
| | |
| | |

| 0903728 |
|---------------|
| DESIGN AGENCY |
| |

|) | |
|-------------------|------------------|
| DESIGNER GTF | CHECKER |
| CAH C | EWER 05/28/21 |
| PROJECT ID 100 | 829 |
| SUBSET 4 | 17 |
| SHEET 15 | TOTAL 28 |

| | | ESTIMATED QUANTITIES - STRUCTURE No.: BUT-732-0304 (01/STR/BR FUNDING SPLIT) | | | | | | | |
|-----|------|--|-------|------|--|-------|-------|-------------|------|
| - | ITEM | EXTENSION | TOTAL | UNIT | DESCRIPTION | ABUT. | PIERS | SUPER. GEN. | |
| | 202 | 11203 | LS | LS | PORTIONS OF STRUCTURE REMOVED, OVER 20 FOOT SPAN, AS PER PLAN | | | LUMP | |
| _ [| | | | | | | | | |
| | 503 | 11100 | LS | LS | COFFERDAMS AND EXCAVATION BRACING | | | LUMP | |
| | | | | | | | | | - |
| - [| 509 | 10000 | 35977 | LB | EPOXY COATED REINFORCING STEEL | 765 | | 35212 | |
| - [| 509 | 20001 | 100 | LB | REINFORCING STEEL, REPLACEMENT OF EXISTING REINFORCING STEEL, AS PER PLAN | 100 | | | |
| _ | 510 | 10001 | 59 | EACH | DOWEL HOLES, AS PER PLAN | 59 | | | |
| ا ـ | | | | | | | | | |
| | 511 | 53014 | 93 | CY | CLASS QC3 CONCRETE, MISC.: SUPERSTRUCTURE CONCRETE WITH QC/QA, AS PER PLAN | | | 93 | |
| | 511 | 53014 | 4 | CY | CLASS QC3 CONCRETE, MISC.: SUBSTRUCTURE CONCRETE WITH QC/QA, AS PER PLAN | 4 | | | |
| | 512 | 10101 | 208 | SY | SEALING OF CONCRETE SURFACES (EPOXY-URETHANE), AS PER PLAN (PERMANENT GRAFFITI PROTECTION) | 137 | 29 | 42 | _ |
| - [| 512 | 74000 | 50 | SY | REMOVAL OF EXISTING COATINGS FROM CONCRETE SURFACES | 50 | | | |
| - [| | | | | | | | | |
| | 513 | 10200 | 1812 | LB | STRUCTURAL STEEL MEMBERS, LEVEL UF | | | 1812 | |
| | 513 | 20000 | 480 | EACH | WELDED STUD SHEAR CONNECTORS | | | 480 | |
| | | | | | | | | | |
| | 514 | 00050 | | | SURFACE PREPARATION OF EXISTING STRUCTURAL STEEL | | | 5052 | _ |
| - | 514 | 00056 | 5066 | SF | FIELD PAINTING OF EXISTING STRUCTURAL STEEL, PRIME COAT | | | 5,066 | |
| - | 514 | 00060 | | | FIELD PAINTING STRUCTURAL STEEL, INTERMEDIATE COAT | | | 5,066 | |
| _ | 514 | 00066 | 5066 | SF | FIELD PAINTING STRUCTURAL STEEL, FINISH COAT | | | 5,066 | ╛, |
| _ | 514 | 00504 | 8 | MNHR | GRINDING FINS, TEARS, SLIVERS ON EXISTING STRUCTURAL STEEL | | | 8 | ַן ' |
| | 514 | 10000 | 5 | EACH | FINAL INSPECTION REPAIR | | | 5 | |
| | | | | | | | | | |
| ٠ | 516 | 11210 | | FT | STRUCTURAL EXPANSION JOINT INCLUDING ELASTOMERIC STRIP SEAL | | | 70 | |
| ٠ | 516 | 13600 | 4 | SF | 1" PREFORMED EXPANSION JOINT FILLER | 4 | | | _ - |
| - | 516 | 44300 | 5 | EACH | ELASTOMERIC BEARING WITH INTERNAL LAMINATES AND LOAD PLATE (NEOPRENE) (T=4.073") | 5 | | | ╛, |
| . | 516 | 47001 | | LS | JACKING AND TEMPORARY SUPPORT OF SUPERSTRUCTURE, AS PER PLAN | | | LUMP | _ |
| ļ | 518 | 22300 | 195 | FT | SPECIAL - STEEL DRIP STRIP | | | 195 | վ 1 |
| 1 | | | | | | | | | _ * |
| ٠ | 517 | 72200 | | | RAILING (DEEP BEAM RAIL WITH STEEL TUBULAR BACKUP AND TYPE 1 STEEL POSTS AND ANCHOR BOLTS) | | | 206.25 | _ |
| - | 526 | 15011 | | SY | REINFORCED CONCRETE APPROACH SLABS WITH QC/QA (T=13"), AS PER PLAN | | | 9 | |
| - | 526 | 25011 | | SY | REINFORCED CONCRETE APPROACH SLABS WITH QC/QA (T=15"), AS PER PLAN | | | 8 | _ |
| . | 526 | 90010 | | FT | TYPE A INSTALLATION | | | 9 | _ |
| | 846 | 00110 | 26 | CF | POLYMER MODIFIED ASPHALT EXPANSION JOINT SYSTEM | | | 2 | 6 |
| | | | | | | | | | _ 1 |
| ۱. | | | | | | | | | |

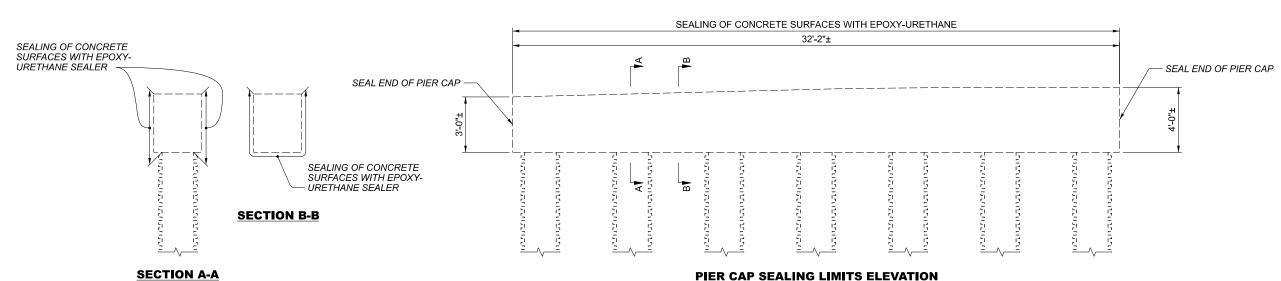

BUT-732-3.04

PIER CAP SEALING LIMITS ELEVATION

100829 17 21 28

ITEM 516 - ELASTOMERIC BEARING WITH INTERNAL LAMINATES AND LOAD PLATES (NEOPRENE), AS PER PLAN ELASTOMERIC BEARINGS: THE ELASTOMER SHALL HAVE A HARDNESS OF 60 DUROMETER. THE BEARINGS WERE DESIGNED UNDER DIVISION I, SECTION 14.6.6 (METHOD A) OF THE AASHTO STANDARD SPECIFICATIONS FOR HIGHWAY BRIDGES.

WELDING: CONTROL WELDING SO THAT THE PLATE TEMPERATURE AT THE ELASTOMER BONDED SURFACE DOES NOT EXCEED 300° F AS DETERMINED BY USE OF PYROMETRIC STICKS OR OTHER TEMPERATURE MONITORING DEVICES.

BEARING REPOSITIONING: IF STEEL IS ERECTED AT AN AMBIENT TEMPERATURE HIGHER THAN 80° F OR LOWER THAN 40°F AND THE BEARING SHEAR DEFLECTION EXCEEDS 1/6 OF THE BEARING HEIGHT AT 60° F (±) 10° F, THE BEAMS SHALL BE RAISED TO ALLOW THE BEARINGS TO RETURN TO THEIR UNDEFORMED SHAPE AT 60° F (±) 10° F.

STRUCTURAL STEEL FOR BEARING LOAD PLATE, MASONRY PLATE, AND SHIMS SHALL BE A709 GRADE 50 AND INCLUDED ITEM 516 FOR PAYMENT. ALL STRUCTURAL STEEL USED FOR THE PROPOSED BEARING SHALL BE FIELD PAINTED PER OZEU. PAINT COLOR SHALL BE FEDERAL COLOR 14277 AND BE INCLUDED IN ITEM 514 FOR PAYMENT.

THE CONTRACTOR IS REQUIRED TO FIELD VERIFY THE EXISTING BOTTOM OF BEAM AND BEAM SEAT ELEVATIONS PRIOR TO JACKING OPERATIONS. THE CONTRACTOR IS TO SUBMIT THE VERIFIED ELEVATIONS TO THE DISTRICT 8 BRIDGE ENGINEER PRIOR TO JACKING. APPROVAL OF THE ELEVATIONS IS NOT REQUIRED.


ANY BEARING HP-SECTION HEIGHTS OR DIMENSIONS SHOWN SHALL BE CONSIDERED APPROXIMATE AND ARE SHOWN FOR INFORMATION PURPOSES ONLY. THE CONTRACTOR SHALL VERIFY THE HEIGHT OF REQUIRED BEARING ASSEMBLY AND THICKNESS OF ANY ADDITIONAL SHIMS BY MEASURING THE DISTANCE BETWEEN THE BEAM SEAT ELEVATION AND THE BOTTOM OF THE EXISTING BEAM FLANGE AND THEN SUBTRACTING FROM THAT DISTANCE THE THICKNESS OF THE BEARING AND LOAD PLATES. EACH BEARING ASSEMBLY SHALL HAVE A MAXIMUM OF ONE SHIM. STACKING OF MULTIPLE SHIMS ARE NOT PERMITTED.

ANY PLATE THICKNESS ADJUSTMENTS AND/OR SHIMS REQUIRED TO COMPLETE THE BEARINGS INSTALLATIONS SHALL BE THE RESPONSIBILITY OF THE CONTRACTOR. A MAXIMUM OF ONE SHIM PLATE SHALL BE ALLOWED PER BEARING.

IN ADDITION TO THE REQUIREMENTS OF 516 AND THE DETAILS SHOWN ON THESE PLANS, THE CONTRACTOR SHALL ASSURE THAT THERE IS A SNUG FIT BETWEEN THE BEARING DEVICE AND BEARING SEAT. THE CONTRACTOR SHALL ASSURE THAT NO BEAMS OR BEARING DEVICES ARE FLOATING.

SET MASONARY PLATES ON BRIDGE SEATS THAT ARE FLAT AND SMOOTHLY FINISHED. IF THE BRIDGE SEAT AREA IS UNEVEN, USE A BUSHHAMMER OR GRINDER FOLLOWED BY A THIN FILM OF PORTLAND CEMENT MORTAR OR PASTE TO FILL THE PITTED SURFACE TO BRING THE SEAT AREA TO THE PROPER ELEVATION AND PROVIDE A LEVEL, EVEN SURFACE.

BASIS OF PAYMENT: THE UNIT PRICE BIDS SHALL INCLUDE ALL MATERIALS, LABOR AND INCIDENTALS NECESSARY TO FURNISH AND INSTALL THE LAMINATED ELASTOMERIC BEARINGS WITH STEEL LOAD PLATES INCLUDING GRINDING OF WELDS. PAYMENT WILL BE MADE AT THE CONTRACT PRICE FOR ITEM 516 - ELASTOMERIC BEARING WITH INTERNAL LAMINATES AND LOAD PLATE (NEOPRENE), AS PER PLAN.

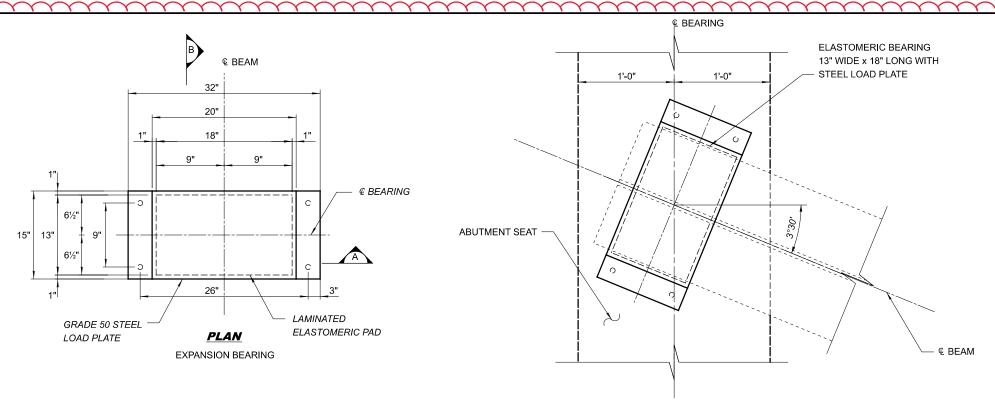

FORWARD ABUTMENT BEARING DETAIL

| FORWARD ELASTOMERIC PAD DATA FOR EXISTING BEAMS | | | | | | | | | | | |
|---|-------------------|--------|------------------|---------|-----------|-----|------------------|------|--|-------|------------------------------|
| | | | | ELASTON | IERIC PAD | | | | REAC | TIONS | 5 ^ |
| | SUB- STRUCTURE | т | NO. OF INTER. | ti | te | | STEEL MINATES | 'PE | DEAD LOAD (KIPS) LIVE * LOAD (KIPS) | | 1AXIMUN DESIGN OAD (K) |
| | | , | LAYERS | ď | | NO. | THICK. | | | | > |
| BUT-732-0304 | FWD. ABUT. | 4.073" | 5 | 0.625" | 0.250" | 6 | 0.0747" | EXP. | 24.01 | 31.51 | 55.52 |

ti = THICKNESS OF INTERNAL ELASTOMER LAYER


te = THICKNESS OF EXTERNAL ELASTOMER LAYER

32-3.04


BUT-7

| * | W//O | IMPACT | |
|---|------|--------|--|

| FORWARD ABUTMENT ELASTOMERIC BEARING PAD DATA | | | | | | | |
|---|----------------------------------|-------------------------------|---|---|--|--|--|
| | Α | В | С | D | | | |
| BEAM No. | FIELD MEASURED BEARING HEIGHT | PROPOSED BEARING THICKNESS | REQ'D LOAD P THICKNESS AT Q BEARING (TOP) | REQ'D MASONARY ₱ THICKNESS AT ₱ BEARING | | | |
| 1 | ±6.50" | 4.073" | 1.25" | .875" | | | |
| 2 | ±6.25" | 4.073" | 1.00" | .875" | | | |
| 3 | ±6.25" | 4.073" | 1.00" | .875" | | | |
| 4 ±6.25" 5 ±6.00" | | 4.073" | 1.00" | .875" | | | |
| | | 4.073" | 1.00" | .875" | | | |

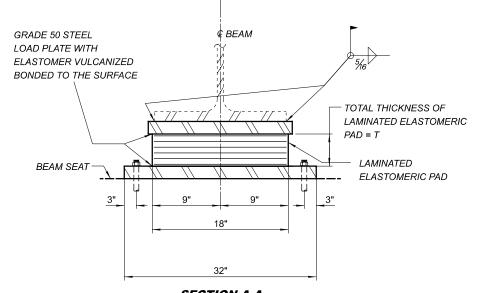

SECTION A-A

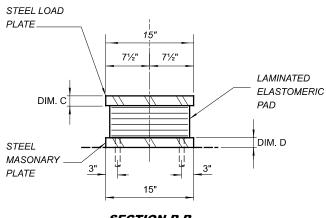

SECTION B-B