



- NOTE:
 1. DRUMS ARE 25' SPACING UNLESS LABELED OTHERWISE
 2. CONTRACTOR SHALL PLACE ADVANCED WORK ZONE SIGNAGE PER SCD MT-95.31.
 3. CONTRACTOR SHALL REMOVE CONFLICTING PAVEMENT MARKINGS DURING MAINTENANCE OF TRAFFIC AND REPLACE ORIGINAL PAVEMENT MARKINGS AFTER CONSTRUCTION.
 4. ROAD WORK AHEAD SIGNS ON SR4 AND PERIMETER SIGNS ON CARMODY BLVD ARE NOT SHOWN FOR CLARITY.

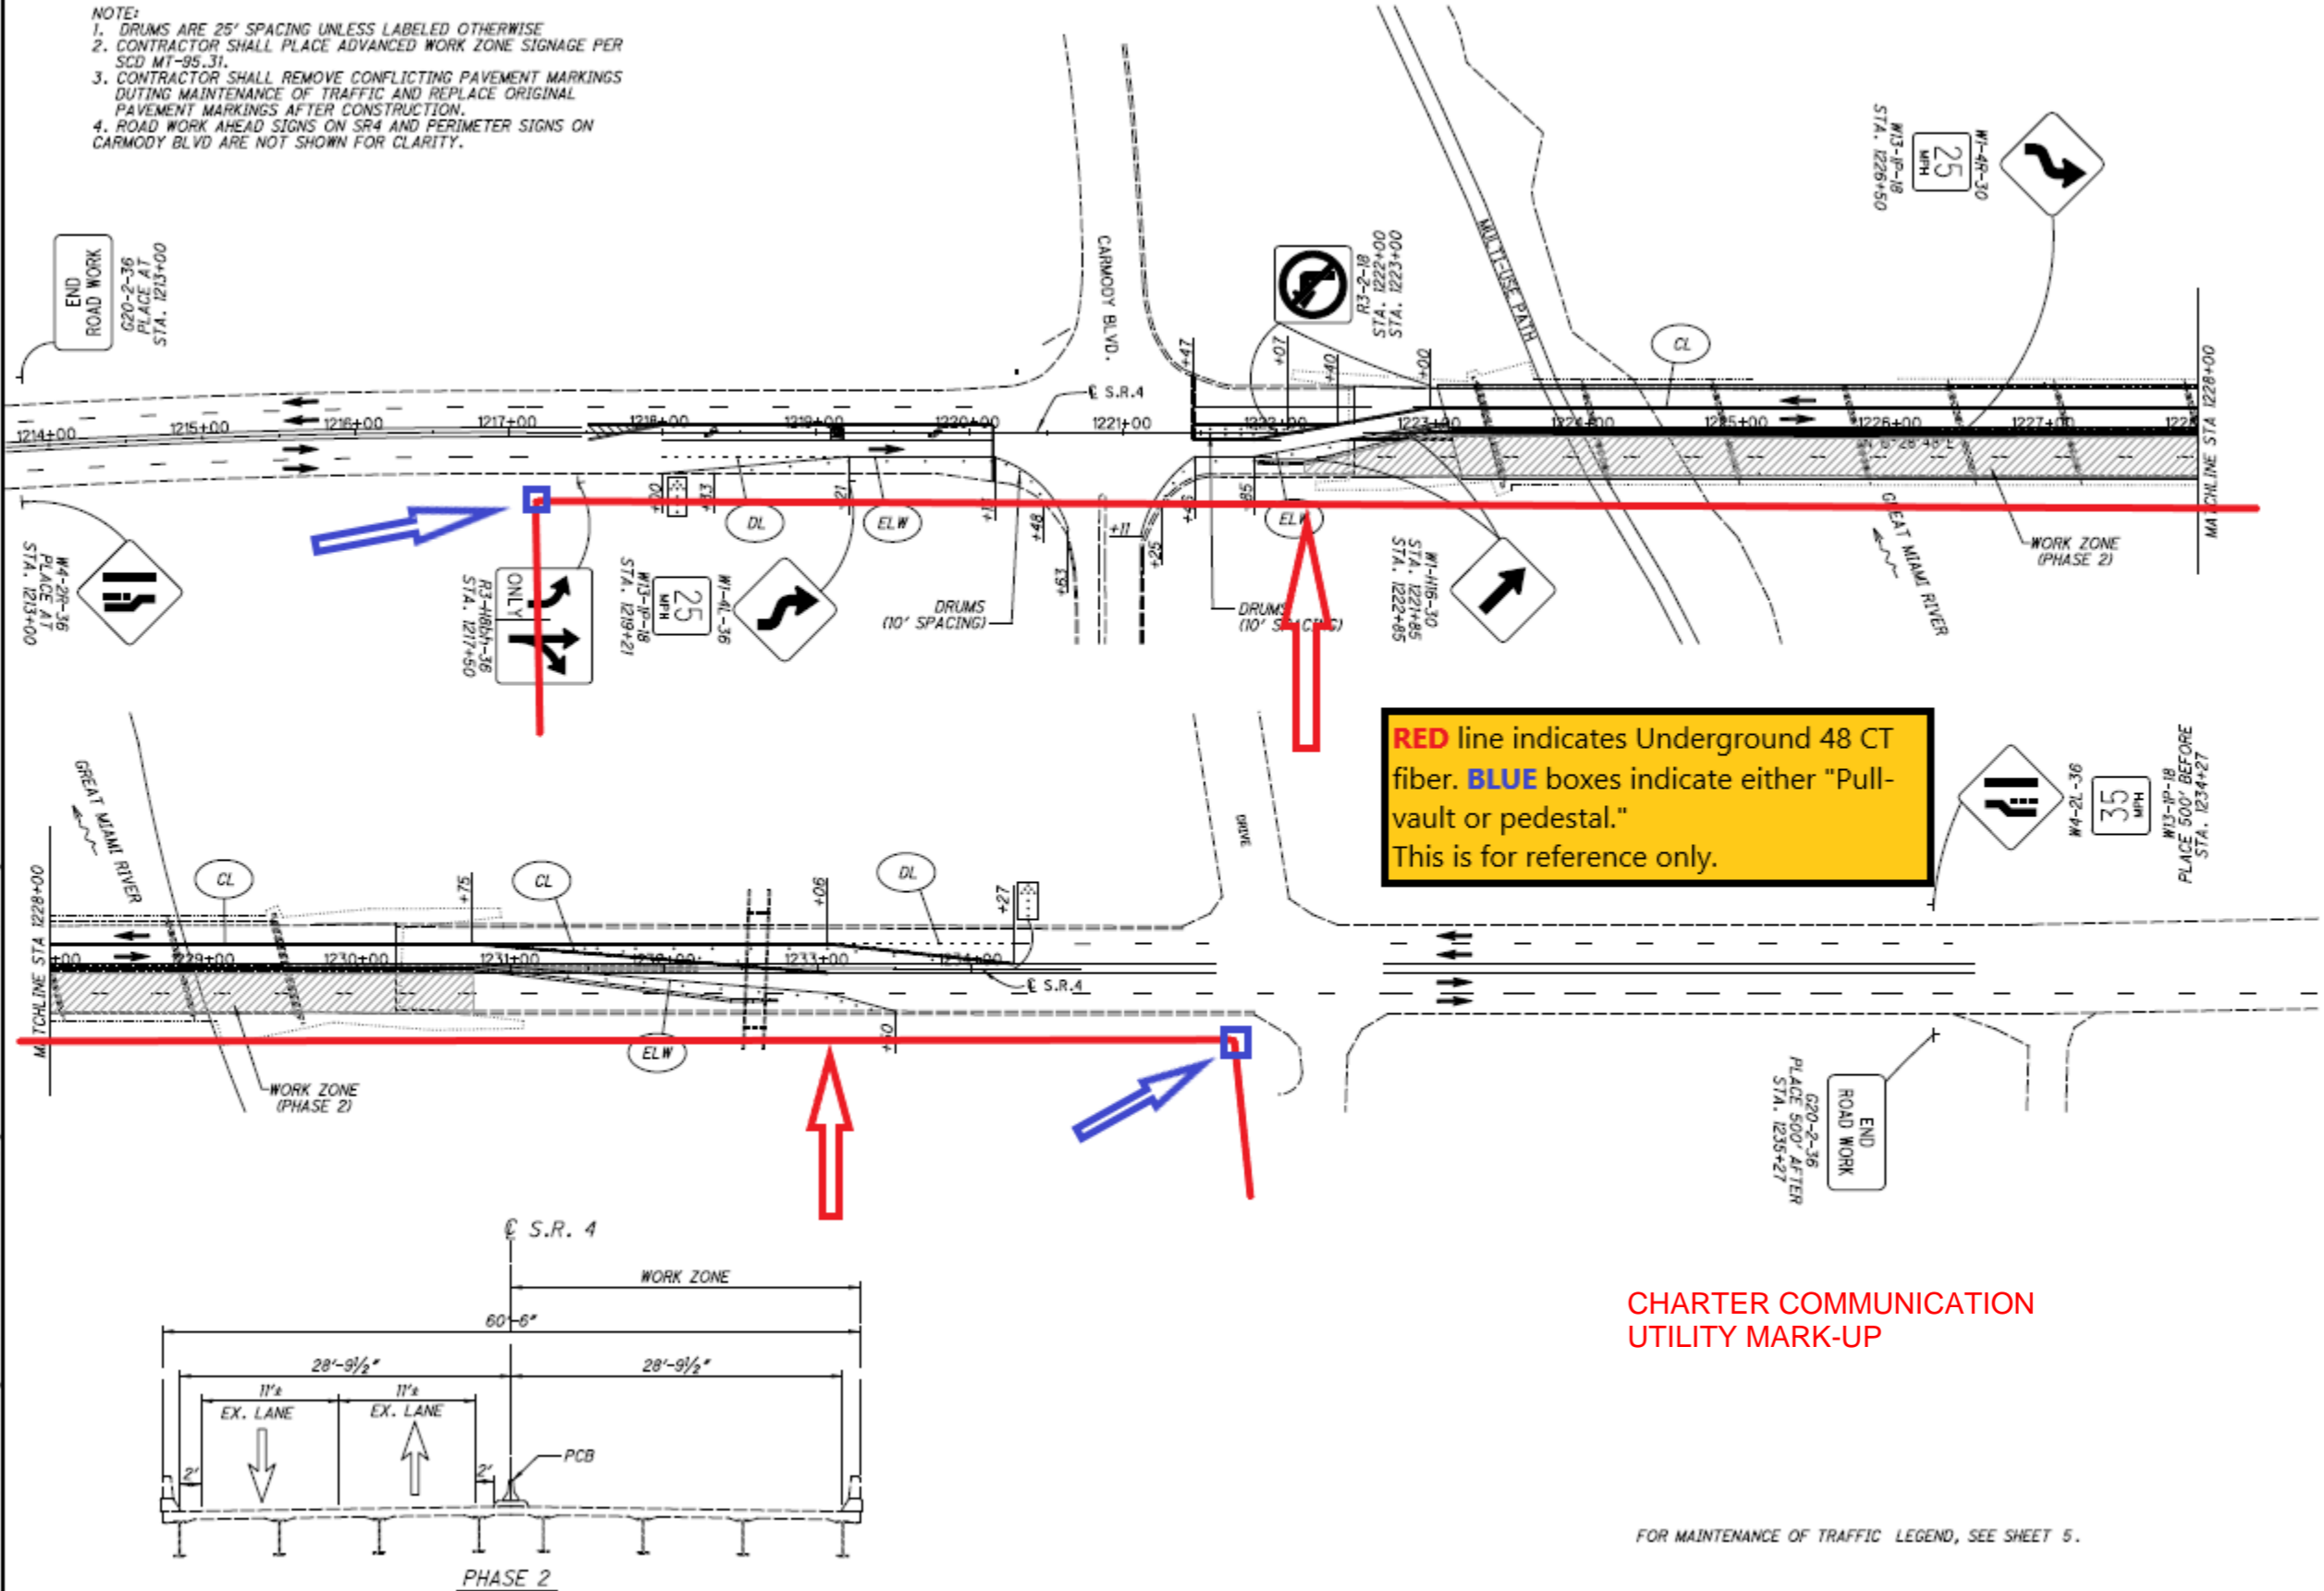

RED line indicates Underground 48 CT fiber. **BLUE** boxes indicate either "Pull-vault or pedestal."
 This is for reference only.

CHARTER COMMUNICATION
 UTILITY MARK-UP

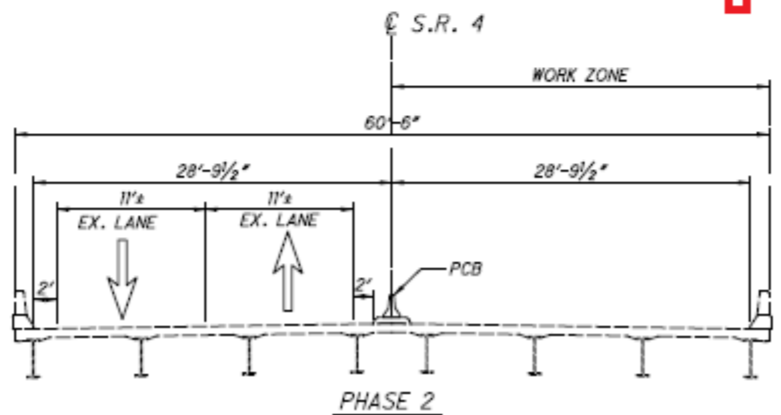

N

0 25 50 100
 HORIZONTAL SCALE IN FEET

CALCULATED	MTH	CHECKED	STB
------------	-----	---------	-----

**MAINTENANCE OF TRAFFIC
 PHASE 2**



BUT-SR4-23.17

6
 21

FOR MAINTENANCE OF TRAFFIC LEGEND, SEE SHEET 5.


MIDDLETOWN 422
 GERMANTOWN RD.
 MH#167211-CARMODY BLVD.

GERMANTOWN ROAD (SR #4)

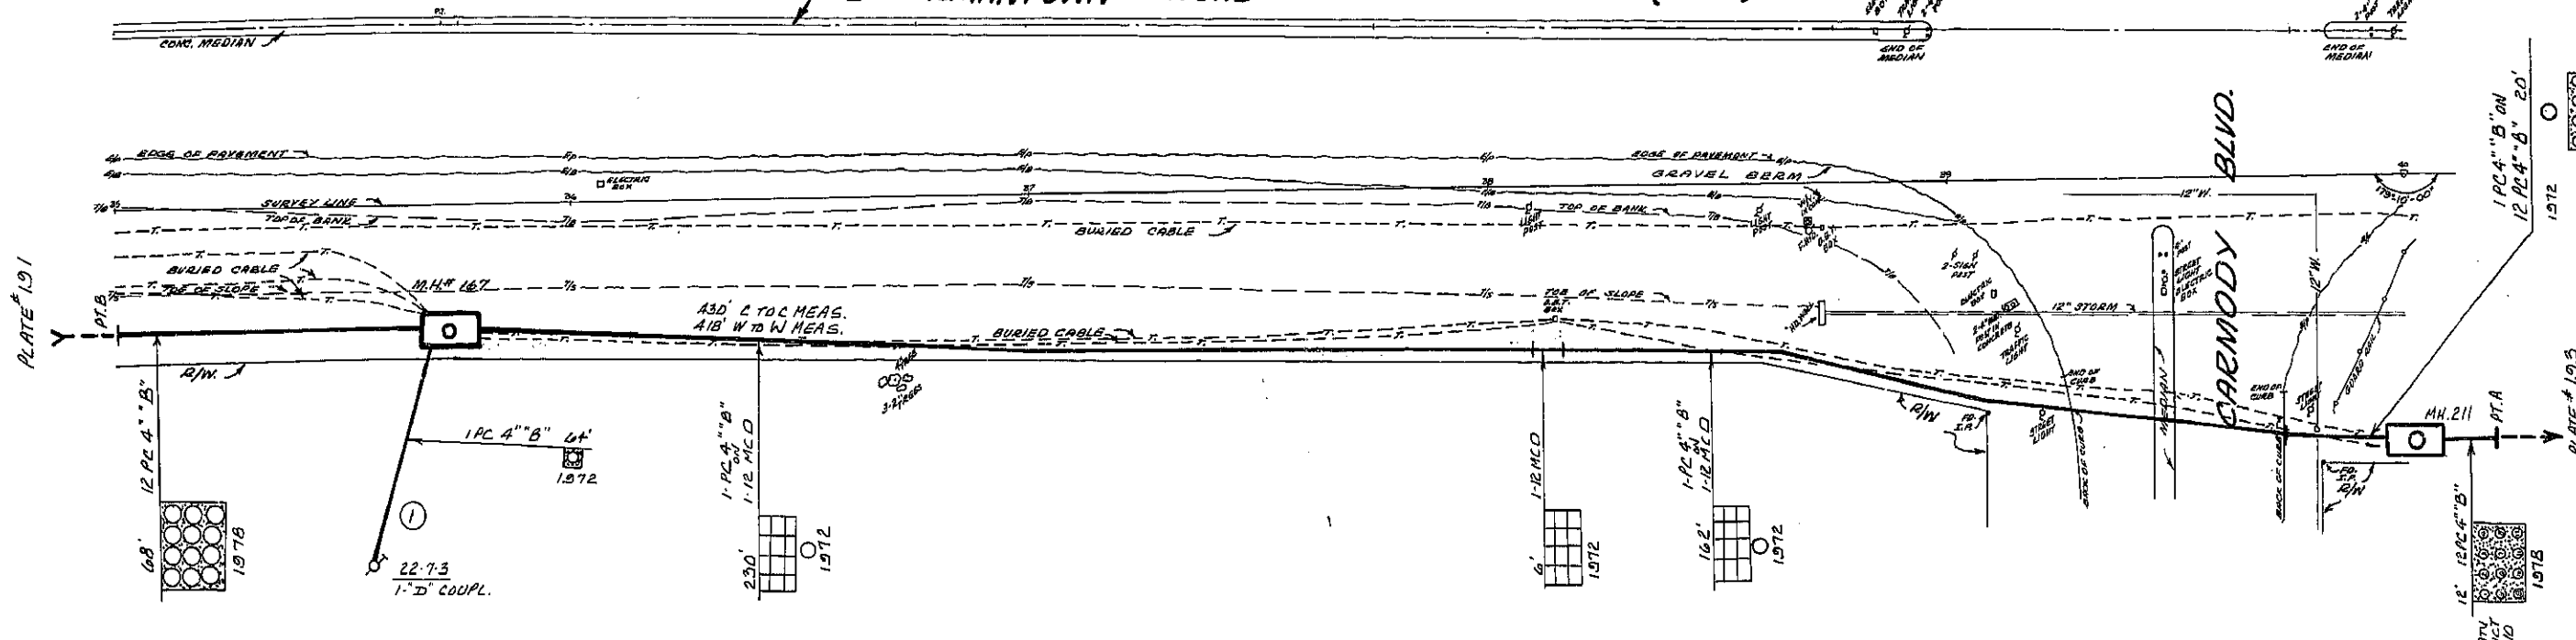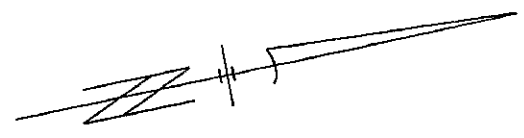

SCALE
 HORIZ. 1"=20'
 VERT. 1"=5'

ACCY CLASS	AC
DATE	11-13-84
BY	SMG
ORDER NO.	E.5543
OLD RECORD	1501 COND. 2034
ORDER NO.	E.5543
DATE	11-13-84
BY	SMG
ORDER NO.	58269-82
DATE	7-1-88
BY	SMG
ORDER NO.	INN
DATE	
BY	A.E.

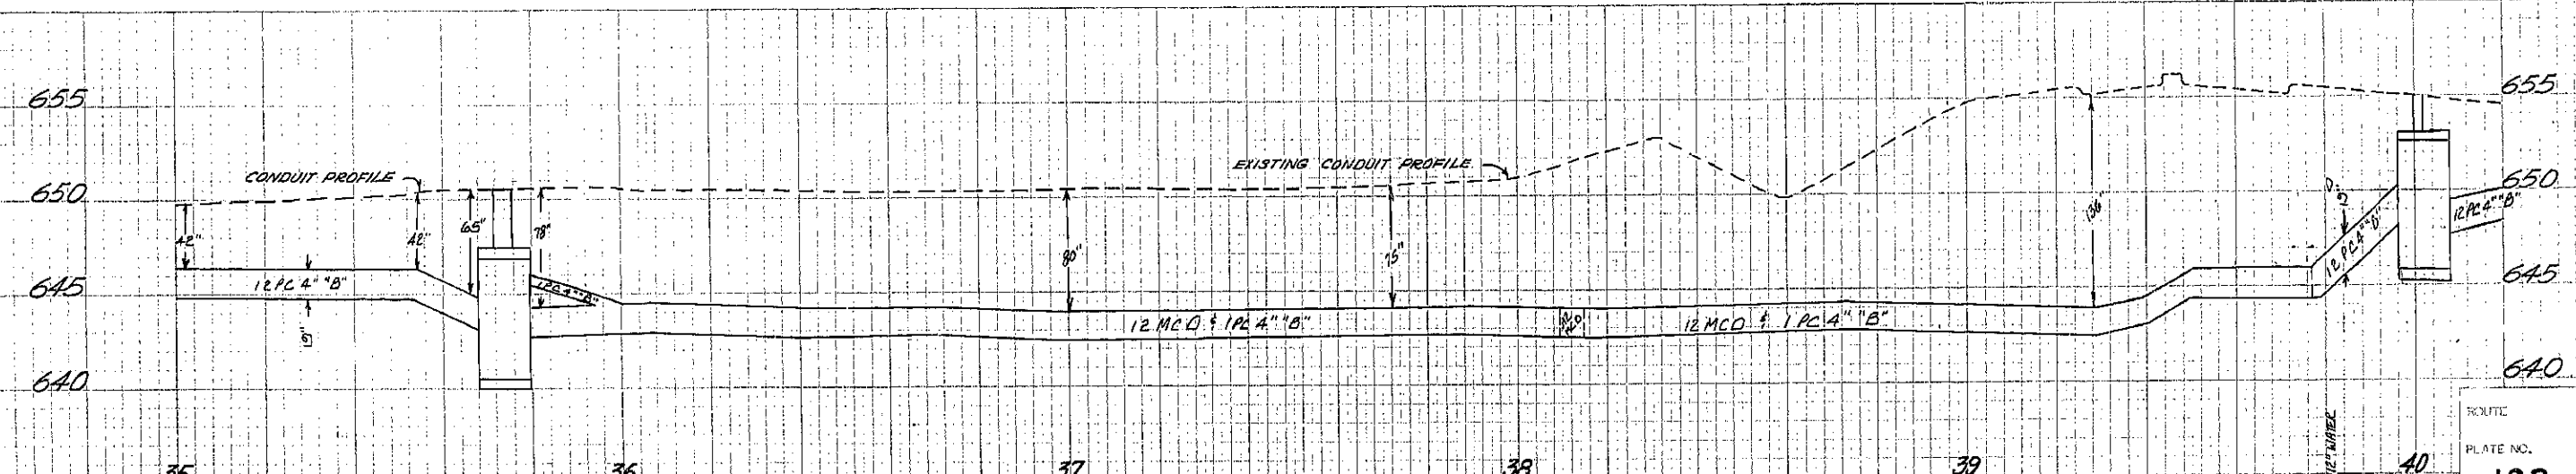


MANHOLES										MAIN CONDUIT				MAIN CONDUIT				LATERALS				LATERALS							
NO.	INSIDE DIMENS.			MIN. OPEN ING.	SHAPE	TOTAL DEPTH OF EXCAVATION	WALLS	ROOF	FLOOR	TYPE	DATE	REMARKS	FROM	TO	TYPE COVER		SUB-SURFACE		DATE	REMARKS	NO.	TYPE COVER		SUB-SURFACE		DATE	REMARKS		
	L	W	H												TYPE	LENGTH	TYPE	LENGTH				TYPE	LENGTH	TYPE	LENGTH			TYPE	LENGTH
167	12"	6'	8 1/2"	468	27"	RECT. A	11' 2"	5"	6"	5"	"B"	SUMP	1972	77257-72	PT. B	167	FIELD GRASS	68'	68'	1978	E.5543								
211	12"	6'	7'	504	30"	PRECAST A	11' 7"	5"	6"	5"	"B"	SUMP	1978	E.5543	167	211	SOD GRASS	34'	LOAM	418'	1972	77257-12	1978	E.5543					
													211	PT. A	FIELD GRASS	12'	CLAY	12'	1978	E.5543									

ROUTE
 PLATE NO.
 192

THE OHIO BELL TELEPHONE CO.
 ENG. DEPT. 513 DIST.
 EXCHANGE MIDDLETOWN 422
 COUNTY BUTLER
 PREPARED BY
 TAX DIST. NO.
 TOTAL SHEETS

MIDDLETOWN 422
GERMANTOWN RD.

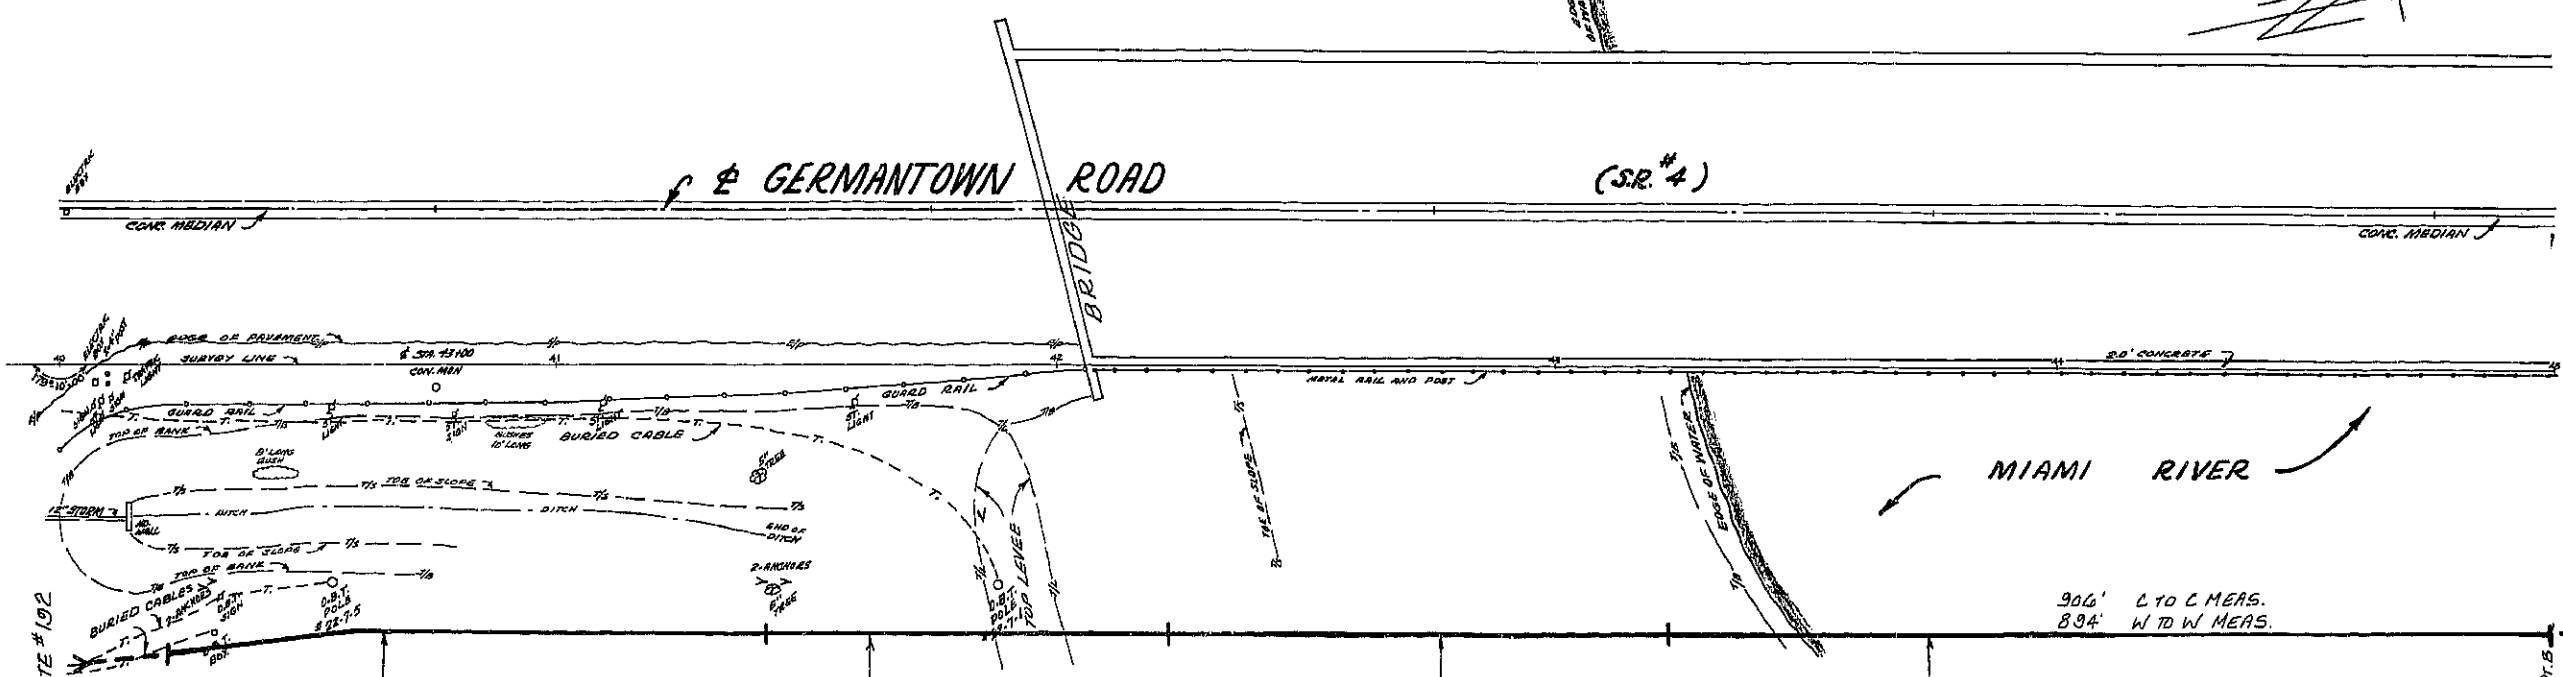

SCALE
Horiz. 1"=20'
Vert. 1"=5'

ACCY CLASS	AC
DATE	11-13-84
BY	SMG
ORDER NO	E.5543
OLD RECORD	NONE
CORRECTIONS	
ORDER NO	E.5543
DATE	11-13-84
BY	SMG
ORDER NO	E.5543
BY	A.E.

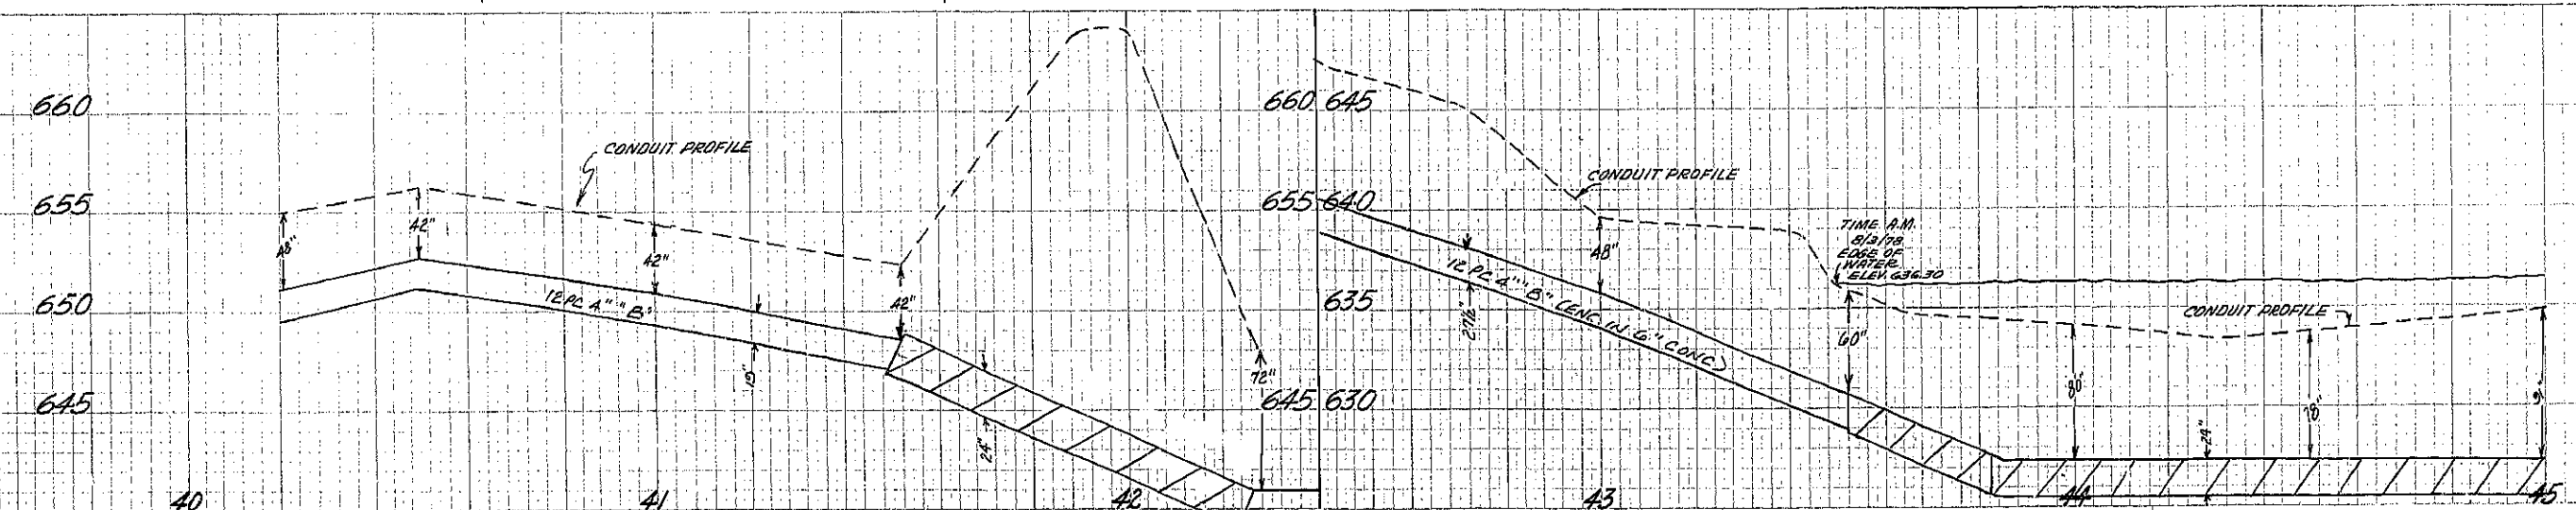


PLATE NO.
193

MANHOLES										MAIN CONDUIT				MAIN CONDUIT				LATERALS				LATERALS								
M.H. NO.	INSIDE DIMENS.			MIN. OPENING	SHAPE	TOTAL DEPTH OF DEWATER	WALLS	ROOF	FLOOR	TYPE, TR. & COV.	DRAIN	DATE	REMARKS	FROM M.H.	TO M.H.	TYPE COVER		SUBSURFACE		DATE	REMARKS	NO.	TYPE COVER		SUBSURFACE		DATE	REMARKS		
	L	W	H													SURFACE	LENGTH	TYPE	LENGTH				DATE	REMARKS	SURFACE	LENGTH			TYPE	LENGTH
														P.T.A.	P.T.B.	FIELD GRASS	371'	CLAY	528'	1978	E.5543									
																RIVER CROSSING	197'													

THE OHIO BELL TELEPHONE CO.
ENG. DEPT. 513 DIST.
JOB NO. MIDDLETOWN 422
EQUIP BY BUTLER
PREPARED BY DATE
TAX DIST. NO. DATE
TOTAL SHEETS SHEET NO.

