

ROUNDING

THE ROUNDING AT SLOPE BREAKPOINTS SHOWN ON THE TYPICAL SECTIONS APPLIES TO ALL CROSS-SECTIONS, EVEN THOUGH OTHERWISE SHOWN.

UTILITIES

LISTED BELOW ARE ALL UTILITIES LOCATED WITHIN THE PROJECT CONSTRUCTION LIMITS TOGETHER WITH THEIR RESPECTIVE OWNERS:

BUTLER RURAL ELECTRIC COOPERATIVE, INC. 3888 STILLWELL BECKETT ROAD OXFORD, OHIO 45056 PHONE: (513) 867-4400 (RAY BRUNNER)	ROCKIES EXPRESS PIPELINES (REX) TALLGRASS ENERGY PARTNERS, LP 370 VAN GORDON STREET LAKEWOOD, COLORADO 80228-1519 PHONE: (303) 763-3417 (GREGG MCALEXANDER)
--	--

SOUTHWEST REGIONAL WATER DISTRICT 3640 OLD OXFORD ROAD HAMILTON, OHIO 45013 PHONE:(513) 863-0828 (TOM PUCKETT)	ALTAFIBER - AERIAL 221 EAST 4TH STREET, BLDG. 121-900 CINCINNATI, OHIO 45201 PHONE: (513) 566-8039 (NANCY MORRIS)
--	---

EXISTING PLANS

EXISTING PLANS MAY BE INSPECTED IN THE ODOT DISTRICT 8 OFFICE IN LEBANON.

CONSTRUCTION NOISE

ACTIVITIES AND LAND USE ADJACENT TO THIS PROJECT MAY BE AFFECTED BY CONSTRUCTION NOISE. IN ORDER TO MINIMIZE ANY ADVERSE CONSTRUCTION NOISE IMPACTS, DO NOT OPERATE POWER-OPERATED CONSTRUCTION-TYPE DEVICES BETWEEN THE HOURS OF 7 AM AND 8 PM. IN ADDITION, DO NOT OPERATE AT ANY TIME ANY DEVICE IN SUCH A MANNER THAT THE NOISE CREATED SUBSTANTIALLY EXCEEDS THE NOISE CUSTOMARILY AND NECESSARILY ATTENDANT TO THE REASONABLE AND EFFICIENT PERFORMANCE OF SUCH EQUIPMENT.

SURVEYING PARAMETERS

PRIMARY PROJECT CONTROL MONUMENTS GOVERN ALL POSITIONING ON ODOT PROJECTS. SEE BELOW FOR A TABLE CONTAINING PROJECT CONTROL INFORMATION.

USE THE FOLLOWING PROJECT CONTROL, VERTICAL POSITIONING, AND HORIZONTAL POSITIONING PARAMETERS FOR ALL SURVEYING:

PROJECT CONTROL

POSITIONING METHOD:	ODOT-VRS
MONUMENT TYPE:	N/A

VERTICAL POSITIONING

ORTHOMETRIC HEIGHT DATUM:	NAVD 88
GEOID:	18

HORIZONTAL POSITIONING

SURVEYING PARAMETERS (CONTINUED)

REFERENCE FRAME:	NAD83 (2011) (EPOCH 2010.0)
ELLIPSOID:	GRS80
MAP PROJECTION:	LAMBERT CONFORMAL
COORDINATE SYSTEM:	OHIO STATE PLANE: SOUTH ZONE
COMBINED SCALE FACTOR:	1.000090868
ORIGIN OF COORDINATE SYSTEM:	(0,0)

USE THE POSITIONING METHODS AND MONUMENT TYPE USED IN THE ORIGINAL SURVEY TO RESTORE ALL MONUMENTS RELATED TO PRIMARY PROJECT CONTROL THAT ARE DAMAGED OR DESTROYED BY CONSTRUCTION ACTIVITIES. RESTORE THE DAMAGED OR DESTROYED MONUMENTS IN ACCORDANCE WITH CMS 623.

UNITS ARE IN U.S. SURVEY FEET.

CONTROL POINTS						
POINT	NORTHING	EASTING	ELEVATION	STATION	OFFSET	DESC.
100	505032.015	1325617.463	671.52	20+42.14	14.206 R	IPINS
101	505302.947	1325331.102	675.03	16+49.17	17.084 L	IPINS
102	505460.259	1325049.021	675.80	13+25.34	17.158 R	IPINS
103	505578.239	1324812.842	680.44	10+63.18	19.523 L	IPINS

WORK LIMITS

THE WORK LIMITS SHOWN ON THESE PLANS ARE FOR PHYSICAL CONSTRUCTION ONLY. PROVIDE THE INSTALLATION AND OPERATION OF ALL WORK ZONE TRAFFIC CONTROL AND WORK ZONE TRAFFIC CONTROL DEVICES REQUIRED BY THESE PLANS WHETHER INSIDE OR OUTSIDE THESE WORK LIMITS.

CLEARING AND GRUBBING

ALTHOUGH THERE ARE NO TREES OR STUMPS SPECIFICALLY MARKED FOR REMOVAL WITHIN THE LIMITS OF THE PROJECT, A LUMP SUM QUANTITY IS INCLUDED IN THE GENERAL SUMMARY FOR ITEM 201, CLEARING AND GRUBBING. ALL PROVISIONS AS SET FORTH IN THE SPECIFICATIONS UNDER THIS ITEM ARE INCLUDED IN THE LUMP SUM PRICE BID FOR ITEM 201, CLEARING AND GRUBBING.

CLEARING AND GRUBBING SHALL ALSO INCLUDE THE REMOVAL OF THE ITEMS IDENTIFIED IN THE PLANS INCLUDING GATES, GATE POSTS, FENCE POSTS, STEEL BEAMS, POST FOUNDATIONS, SHEETING WALL AND OTHER EROSION PROTECTION MATERIALS WITHIN ODOT'S RIGHT OF WAY.

SOLE SOURCE AQUIFER

THIS PROJECT IS LOCATED WITHIN A SOLE SOURCE AQUIFER. IN ORDER TO MINIMIZE THE POTENTIAL FOR CONTAMINATION, THE CONTRACTOR SHALL UTILIZE PROPER CONTAINMENT AND DIKING IN REFUELING AREAS. FUELS, TOXIC/HAZARDOUS MATERIALS, AND CHEMICALS SHALL NOT BE STORED NEAR DRAINAGE WAYS, DITCHES, OR STREAMS. A SPILL KIT IS TO BE MAINTAINED ON-SITE THROUGHOUT CONSTRUCTION ACTIVITIES. THE CONTRACTOR SHALL IMMEDIATELY TAKE STEPS TO MITIGATE ANY EVENT, SUCH AS A SPILL OF FUELS, OILS, OR CHEMICALS, THAT COULD THREATEN TO CONTAMINATE THE DRINKING WATER SUPPLY. IF THE SPILL IS A REPORTABLE AMOUNT (PER OHIO EPA'S RELEASE REPORTING REQUIREMENTS), THE CONTRACTOR SHALL CONTACT MORGAN TOWNSHIP FIRE DEPARTMENT 513-738-4513 OR THE OHIO EPA'S SPILLS HOTLINE 1-800-282-9378 FOR CLEAN-UP OF THE SPILL.

NO IMPACTS TO ANY AQUATIC RESOURCE

THE CONTRACTOR SHALL NOT PLACE ANY TEMPORARY OR PERMANENT FILL WITHIN THE JURISDICTIONAL BOUNDARIES OF ANY WATERWAYS, INCLUDING WETLANDS, DURING CONSTRUCTION OF THIS PROJECT, INCLUDING SCAFFOLDING OR BRACING. THE CONTRACTOR SHALL NOT PLACE ANY EQUIPMENT WITHIN THE JURISDICTIONAL BOUNDARY OF ANY WATERWAY. IF DEBRIS ENTERS THE WATERWAY DURING CONSTRUCTION, THE CONTRACTOR SHALL REMOVE THE DEBRIS IMMEDIATELY UTILIZING EQUIPMENT STAGED OUTSIDE THE JURISDICTIONAL BOUNDARY.

ITEM 606 - ANCHOR ASSEMBLY, MGS TYPE E

THIS ITEM SHALL CONSIST OF FURNISHING AND INSTALLING ANY OF THE GUARDRAIL END TERMINALS FOR TYPE MGS GUARDRAIL AS LISTED ON ROADWAY ENGINEERING'S WEB PAGE UNDER ROADSIDE SAFETY DEVICES FOR APPROVED GUARDRAIL END TREATMENTS. INSTALLATION SHALL BE AT THE LOCATIONS SPECIFIED IN THE PLANS, IN ACCORDANCE WITH THE MANUFACTURER'S SPECIFICATIONS.

THE FACE OF THE TYPE E IMPACT HEAD SHALL BE COVERED WITH REBOUNDABLE RETROREFLECTIVE SHEETING, PER CMS 730.191.

REFER TO THE MANUFACTURER'S INSTRUCTIONS REGARDING THE INSTALLATION OF, AND THE GRADING AROUND THE FOUNDATION TUBES AND GROUND STRUT. THE TOP OF ANY FOUNDATION TUBE SHOULD BE LESS THAN 4 INCHES ABOVE THE GROUND. THE PLACEMENT OF THE FOUNDATION TUBES SHOULD BE AN APPROPRIATE DEPTH BELOW THE LEVEL LINE IN ORDER TO MAINTAIN THE FINISHED GUARDRAIL HEIGHT OF 31 INCHES FROM THE EDGE OF THE SHOULDER.

ON-SITE GRADING IS REQUIRED IF THE TOP OF THE FOUNDATION TUBES OR TOP OF THE GROUND STRUT DOES PROJECT MORE THAN 4 INCHES ABOVE THE GROUND LINE.

PAYMENT FOR THE ABOVE WORK SHALL BE MADE AT THE UNIT PRICE BID FOR ITEM 606, ANCHOR ASSEMBLY, MGS TYPE E, EACH, AND SHALL INCLUDE ALL LABOR, TOOLS, EQUIPMENT AND MATERIALS NECESSARY TO CONSTRUCT A COMPLETE AND FUNCTIONAL ANCHOR ASSEMBLY SYSTEM, INCLUDING ALL RELATED TRANSITIONS, REFLECTIVE SHEETING, HARDWARE, GRADING, EMBANKMENT AND EXCAVATION NOT SEPARATELY SPECIFIED, AS REQUIRED BY THE MANUFACTURER.

CROSSINGS AND CONNECTIONS TO EXISTING PIPES AND UTILITIES

WHERE PLANS PROVIDE FOR A PROPOSED CONDUIT TO BE CONNECTED TO, OR CROSS OVER OR UNDER AN EXISTING SEWER OR UNDERGROUND UTILITY, LOCATE THE EXISTING PIPES OR UTILITIES BOTH AS TO LINE AND GRADE BEFORE STARTING TO LAY THE PROPOSED CONDUIT.

IF IT IS DETERMINED THAT THE ELEVATION OF THE EXISTING CONDUIT, OR EXISTING APPURTENANCE TO BE CONNECTED, DIFFERS FROM THE PLAN ELEVATION OR RESULTS IN A CHANGE IN THE PLAN CONDUIT SLOPE, NOTIFY THE ENGINEER BEFORE STARTING CONSTRUCTION OF ANY PORTION OF THE PROPOSED CONDUIT WHICH WILL BE AFFECTED BY THE VARIANCE IN THE EXISTING ELEVATIONS.

CROSSINGS AND CONNECTIONS TO EXISTING PIPES AND UTILITIES (CONTINUED)

IF IT IS DETERMINED THAT THE PROPOSED CONDUIT WILL INTERSECT AN EXISTING SEWER OR UNDERGROUND UTILITY IF CONSTRUCTED AS SHOWN ON THE PLAN, NOTIFY THE ENGINEER BEFORE STARTING CONSTRUCTION OF ANY PORTION OF THE PROPOSED CONDUIT WHICH WOULD BE AFFECTED BY THE INTERFERENCE WITH AN EXISTING FACILITY.

PAYMENT FOR ALL THE OPERATIONS DESCRIBED ABOVE IS INCLUDED IN THE CONTRACT PRICE FOR THE PERTINENT 611 CONDUIT ITEM.

SEEDING AND MULCHING

THE FOLLOWING QUANTITIES ARE PROVIDED TO PROMOTE GROWTH AND CARE OF PERMANENT SEEDED AREAS:

ITEM 659 - COMMERCIAL FERTILIZER	0.1 TON
ITEM 659 - LIME	0.15 ACRES
ITEM 659 - WATER	4 M. GAL

SEEDING AND MULCHING SHALL BE APPLIED TO ALL AREAS OF EXPOSED SOIL BETWEEN THE RIGHT-OF-WAY LINES, AND WITHIN THE CONSTRUCTION LIMITS FOR AREAS OUTSIDE THE RIGHT-OF-WAY LINES COVERED BY WORK AGREEMENT OR SLOPE EASEMENT. QUANTITY CALCULATIONS FOR SEEDING AND MULCHING ARE BASED ON THESE LIMITS.

DESIGN AGENCY



10200 Alliance Road,
Suite 300
Cincinnati, OH 45242
(513) 842-8200

DESIGNER

ZTM

REVIEWER

TCM 11/22/24

PROJECT ID

116204

SHEET

P.3

TOTAL

39

GENERAL SUMMARY	
DESIGN AGENCY	
 Stantec 10200 Alliance Road, Suite 300 Cincinnati, OH 45242 (513) 842-8200	
DESIGNER	ZTM
REVIEWER	TCM 11/22/24
PROJECT ID	116204
SHEET	P.7
TOTAL	39

MODEL: Sheet 02 PAPERSIZE: 34x22 (in.) DATE: 4/3/2025 TIME: 1:39:36 PM USER: zsmoran
 pw:\vhohdi-pw.bentley.com:ohiodi-pw-02\Documents\01 Active Projects\District 08\Butler1162024\401-Engineering_StartecRoadway\Sheets\116204_GG001.dgn

SEE SHEET NO.		GENERAL SUMMARY
22	22	
DESIGN AGENCY		
 Stantec 10200 Alliance Road, Suite 300 Cincinnati, OH 45242 (513) 842-8200		
DESIGNER		
ZTM		
REVIEWER		
TCM	11/22/24	
PROJECT ID		
116204		
SHEET	TOTAL	
P.8	39	

ROADWAY AND DRAINAGE SUBSUMMARY														
SHEET NO.	REF NO.	STATION		SIDE	202	601		605	606			611	626	690
					GUARDRAIL REMOVED	TIED CONCRETE BLOCK MAT WITH TYPE 2 UNDERLAYMENT	ROCK CHANNEL PROTECTION, TYPE A WITH GEOTEXTILE FABRIC	6" UNCLASSIFIED PIPE UNDERDRAINS	GUARDRAIL, TYPE MGS HALF POST SPACING	ANCHOR ASSEMBLY, MGS TYPE E	ANCHOR ASSEMBLY, MGS TYPE T	6" CONDUIT, TYPE F FOR UNDERDRAIN OUTLETS	BARRIER REFLECTOR, TYPE 2, BIDIRECTIONAL	MAILBOX REMOVED AND RESET
		FROM	TO		FT	SY	CY	FT	FT	EA	EA	FT	EACH	EACH
10, 11	R-1	10+43.24	15+22.30	RT	479									
10, 11	GR-1	10+25.00	16+83.66	RT					587.5	1	1		8	
10	M-1	12+50.00												1
10	D-1	11+44.42		RT		6.11								
11	D-2	16+01.13		RT		7.94								
10, 11	D-3	13+80.00	15+00.00				60.00							
10, 11	UD-1	11+25.00	16+25.00	RT				480				20		
TOTALS CARRIED TO GENERAL SUMMARY					479	14.1	60.00	480	587.5	1	1	20	8	1

PAVEMENT MARKING SUBSUMMARY							
SHEET NO.	REF NO.	STATION		SIDE	621		642
					RPM, TWO-WAY YELLOW/YELLOW	RAISED PAVEMENT MARKER REMOVED	EDGE LINE, 6", TYPE 1
		FROM	TO		EACH	EACH	MI
32	EL-1	11+00.00	17+00.00	RT			0.12
32	EL-2	11+00.00	17+00.00	LT			0.12
32	CL-1	11+00.00	17+00.00	C	8	8	0.12
TOTALS CARRIED TO GENERAL SUMMARY					8	8	0.24

PAVEMENT CALCULATIONS																	
SHEET NO.	REF NO.	STATION		LENGTH	WIDTH	AREA / CADD AREA	SIDE	202	204		254	301	304	407	441		609
								PAVEMENT REMOVED	SUBGRADE COMPACTION		PROOF ROLLING	1.25" PAVEMENT PLANING, ASPHALT CONCRETE	8" ASPHALT CONCRETE BASE, PG64-22, (449)	6" AGGREGATE BASE	NON-TRACKING TACK COAT (AREA X 0.055 /9) THREE LAYERS FOR P-1	1.25" ASPHALT CONCRETE SURFACE COURSE, TYPE 1, (448), PG64-22	1.75" ASPHALT CONCRETE INTERMEDIATE COURSE, TYPE 1, (448)
		SY	SY	HR	SY	CY		CY	GAL	CY	CY	FT					
10, 11	P-1	11+00.00	17+00.00	600	11	7843	RT	783	871	0.5		194	146	144	30	42	500
10, 11	P-2	11+00.00	17+00.00	600	11 +/-	7737	LT				860			48	30	42	
TOTALS								783	871	0.5	860	194	146	192	60	84	500
TOTALS CARRIED TO GENERAL SUMMARY								783	871	0.5	860	194	146	192	60	84	500

EARTHWORK AND SEEDING TABLE				
STATION		203	203	659
		EXCAVATION	EMBANKMENT	SEEDING AND MULCHING
FROM	TO	CY	CY	SY
10+50.00	11+00.00	17	20	67
11+00.00	11+50.00	38	22	64
11+50.00	12+00.00	50	13	56
12+00.00	12+50.00	51	10	56
12+50.00	13+00.00	50	7	56
13+00.00	13+50.00	47	8	56
13+50.00	14+00.00	56	10	56
14+00.00	14+50.00	73	12	56
14+50.00	15+00.00	76	11	56
15+00.00	15+50.00	81	9	56
15+50.00	16+00.00	67	9	56
16+00.00	16+50.00	43	6	42
16+50.00	17+00.00	0	3	37
DEDUCT FOR PAVEMENT PLANING		27		
DEDUCT FOR PAVEMENT REMOVED		391		
TOTALS CARRIED TO GENERAL SUMMARY		231	140	714

SUBSUMMARIES

MODEL: Sheet PAPER:SIZE: 2.83333x1.83333 (ft.) DATE: 4/2/2025 TIME: 1:57:34 PM USER: msturdevant pw:\ohiodot-pw.bentley.com\ohiodot-pw-02\Documents\01 Active Projects\District 08\Butler\116204\01-Engineering_Stantec\Roadway\Sheets\116204_VN0001.dgn

STANDARD DRAWINGS AND SUPPLEMENTAL SPECIFICATIONS

REFER TO THE FOLLOWING SUPPLEMENTAL SPECIFICATION(S):

866 DATED 04-21-17
878 DATED 01-21-22

DESIGN SPECIFICATIONS

THIS STRUCTURE CONFORMS TO THE 9th EDITION OF THE "LRFD BRIDGE DESIGN SPECIFICATIONS" ADOPTED BY THE AMERICAN ASSOCIATION OF STATE HIGHWAY AND TRANSPORTATION OFFICIALS, 2020 AND THE ODOT BRIDGE DESIGN MANUAL, 2020.

OPERATIONAL IMPORTANCE

A LOAD MODIFIER OF 1.0 HAS BEEN ASSUMED FOR THE DESIGN OF THIS STRUCTURE IN ACCORDANCE WITH THE AASHTO LRFD BRIDGE DESIGN SPECIFICATIONS, ARTICLE 1.3.5 AND THE ODOT BRIDGE DESIGN MANUAL.

DESIGN LOADING

DESIGN LOADING INCLUDES:
VEHICULAR LIVE LOAD: HL-93

DESIGN DATA

CONCRETE CLASS QC1:
COMPRESSIVE STRENGTH 4.0 KSI (SUBSTRUCTURE)

CONCRETE REINFORCEMENT:

EPOXY COATED STEEL REINFORCEMENT - MINIMUM YIELD STRENGTH 60-KSI (RETAINING WALL & FOOTING)

STEEL SHEET PILING ASTM A572 GRADE 50 - YIELD STRENGTH 50 KSI

ITEM 202, PORTIONS OF STRUCTURE REMOVED, AS PER PLAN

THIS ITEM SHALL INCLUDE THE ELEMENTS INDICATED IN THE PLANS AND GENERAL NOTES AND THAT ARE NOT SEPARATELY LISTED FOR PAYMENT, EXCEPT FOR WEARING COURSE REMOVAL. ITEMS TO BE REMOVED INCLUDE EXISTING SHEET PILING WALL, SOLDIER PILE WALL WITH LAGGING, AND GABION BASKET WALL ALONG WITH THE DUMPED ROCK BUTTRESS AND ALL EXISTING MATERIALS BEING REPLACED BY NEW CONSTRUCTION AND MISCELLANEOUS ITEMS THAT ARE NOT SHOWN TO BE INCORPORATED INTO THE FINAL CONSTRUCTION AND ARE DIRECTED TO BE REMOVED BY THE ENGINEER. REMOVALS SHALL BE RESTRICTED TO ITEMS WITHIN THE EXISTING RIGHT OF WAY LIMITS.

ITEM 503 - COFFERDAMS AND EXCAVATION BRACING, AS PER PLAN

THE DESIGN SHOWN ON THE PLANS FOR TEMPORARY SUPPORT OF EXCAVATION IS ONE REPRESENTATIVE DESIGN THAT MAY BE USED TO CONSTRUCT THE PROJECT. THE CONTRACTOR MAY CONSTRUCT THE DESIGN SHOWN ON THE PLANS OR PREPARE AN ALTERNATE DESIGN TO SUPPORT THE SIDES OF EXCAVATION. IF CONSTRUCTING AN ALTERNATE DESIGN FOR TEMPORARY SUPPORT OF EXCAVATION, PREPARE AND PROVIDE PLANS IN ACCORDANCE WITH C&MS 501.05. THE DEPARTMENT WILL PAY FOR THE TEMPORARY SUPPORT OF EXCAVATION AT THE CONTRACT LUMP SUM PRICE FOR COFFERDAMS AND EXCAVATION BRACING. THE DEPARTMENT WILL NOT MAKE ADDITIONAL PAYMENT FOR PROVIDING AN ALTERNATE DESIGN.


ITEM	EXTENSION	TOTAL	UNIT	DESCRIPTION	WALL	GEN.	SEE SHEET
202	11201	LUMP	LS	PORTIONS OF STRUCTURE REMOVED, AS PER PLAN		LUMP	22
503	11101	LUMP	LS	COFFERDAMS AND EXCAVATION BRACING, AS PER PLAN		LUMP	22
503	21330	LUMP	LS	UNCLASSIFIED EXCAVATION, INCLUDING ROCK AND/OR SHALE		LUMP	
504	11100	12540	SF	STEEL SHEET PILING LEFT IN PLACE		12540	
509	10000	121,830	LB	EPOXY COATED STEEL REINFORCEMENT	121,830		
511	46012	732	CY	CLASS QC1 CONCRETE WITH QC/QA, RETAINING/WINGWALL NOT INCLUDING FOOTING	732		
511	46512	755	CY	CLASS QC1 CONCRETE WITH QC/QA, FOOTING	755		
512	10100	957	SY	SEALING OF CONCRETE SURFACES (EPOXY-URETHANE)	957		
512	33000	81	SY	TYPE 2 WATERPROOFING	81		
516	13600	225	SF	1" PREFORMED EXPANSION JOINT FILLER	225		
518	20000	658	SY	PREFABRICATED GEOCOMPOSITE DRAIN	658		
518	21200	66	CY	POROUS BACKFILL WITH GEOTEXTILE FABRIC	66		
518	40000	444	FT	6" PERFORATED CORRUGATED PLASTIC PIPE	444		
518	40010	210	FT	6" NON-PERFORATED CORRUGATED PLASTIC PIPE, INCLUDING SPECIALS	210		
613	41200	313	CY	LOW STRENGTH MORTAR BACKFILL	313		

ITEM 503,UNCLASSIFIED EXCAVATION, INCLUDING ROCK AND/OR SHALE

EXCAVATION AND BACKFILL SHALL BE PER CMS 503 WITH THE FOLLOWING EXCEPTIONS. BACKFILL BETWEEN BACK OF WALL AND TEMPORARY SHEET PILING SHALL BE STRUCTURAL BACKFILL, TYPE 3. BACKFILL BETWEEN PERMANENT SHEET PILING AND FACE OF WALL SHALL BE LOW STRENGTH MORTAR BACKFILL AND/OR CLASS QC1 CONCRETE AS SHOWN IN PLANS. ALL LABOR, MATERIALS, EQUIPMENT, AND INCIDENTALS REQUIRED TO COMPLETE THIS WORK SHALL BE INCLUDED FOR PAYMENT WITH ITEM 503, UNCLASSIFIED EXCAVATION, INCLUDING ROCK AND/OR SHALE.

FOUNDATION BEARING RESISTANCE

RETAINING WALL FOOTING, AS DESIGNED, PRODUCE A MAXIMUM SERVICE LOAD PRESSURE OF 3.9 KIPS PER SQUARE FOOT AND A MAXIMUM STRENGTH LOAD PRESSURE OF 5.5 KIPS PER SQUARE FOOT. THE FACTORED BEARING RESISTANCE IS 7.4 KIPS PER SQUARE FOOT.

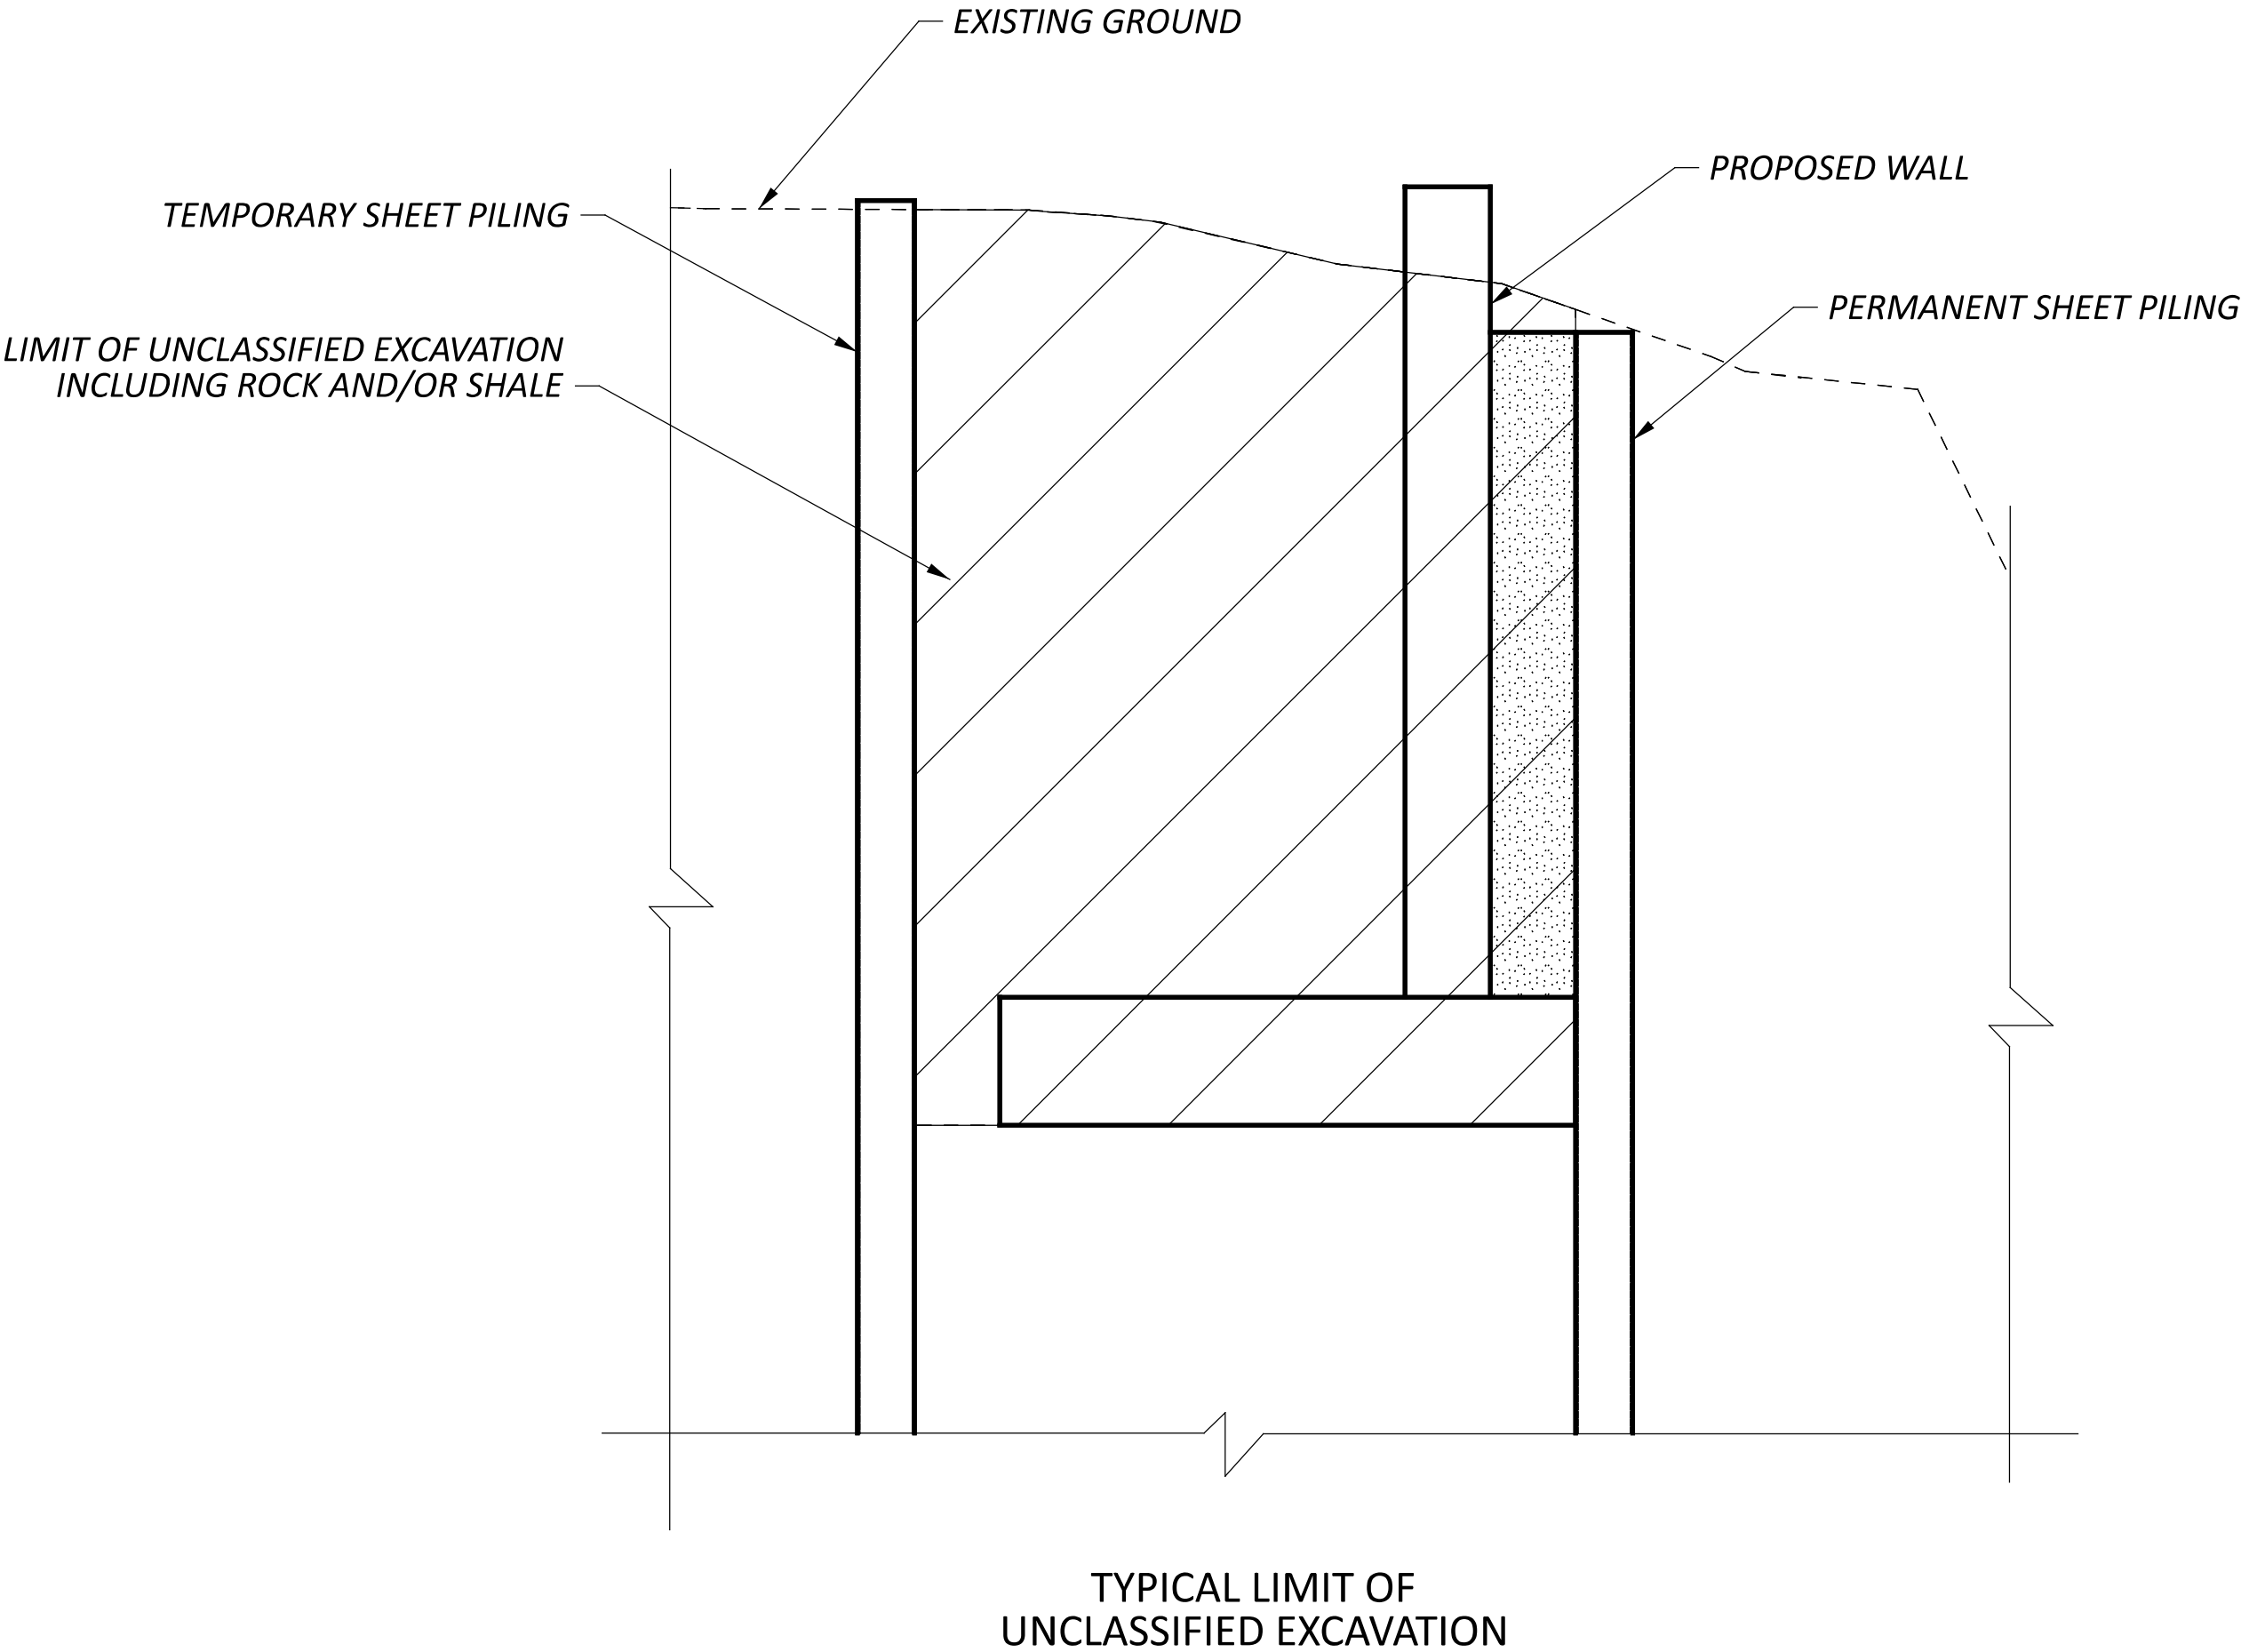

WALL GENERAL NOTES & ESTIMATED QUANTITIES
WALL 1 STA 11+50.00 TO 16+02.32

DESIGN AGENCY



Stantec
10200 Alliance Road,
Suite 300
Cincinnati, OH 45242
(513) 842-8200

DESIGNER

MRS

REVIEWER

BSM 11/22/24

PROJECT ID


116204

SHEET

P.22

TOTAL

39

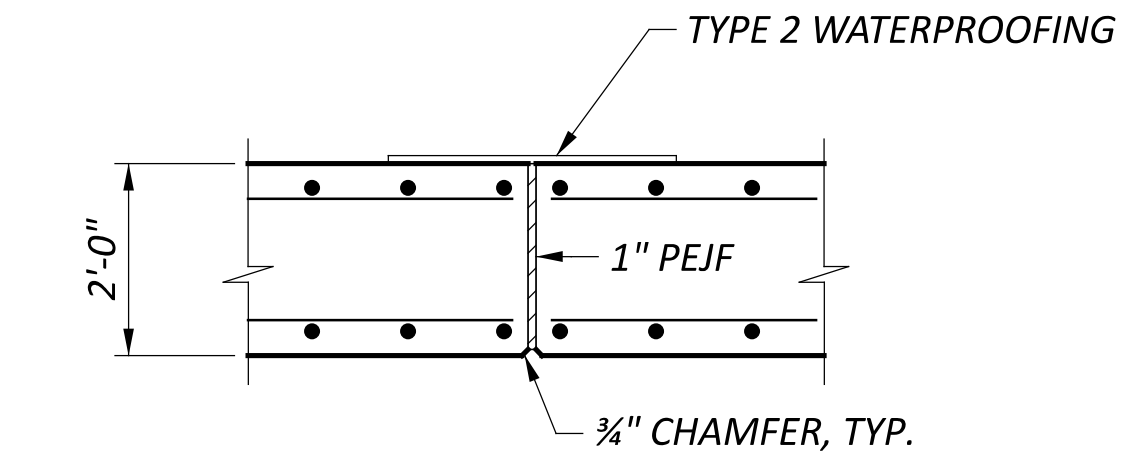

2" x 6" KEY,
CENTERED ON JOINT


TYPE 2 WATERPROOFING

2'-0"


¾" CHAMFER, TYP.

This diagram shows a cross-section of a concrete wall with a vertical joint. The wall is 2 feet high. A 2-inch by 6-inch key is centered on the joint. Type 2 waterproofing is applied to the joint surface. A 3/4-inch chamfer is shown on the joint surface. Reinforcement bars are shown on both sides of the joint, with some bars extending through the joint.


ELEVATION (DEVELOPED)

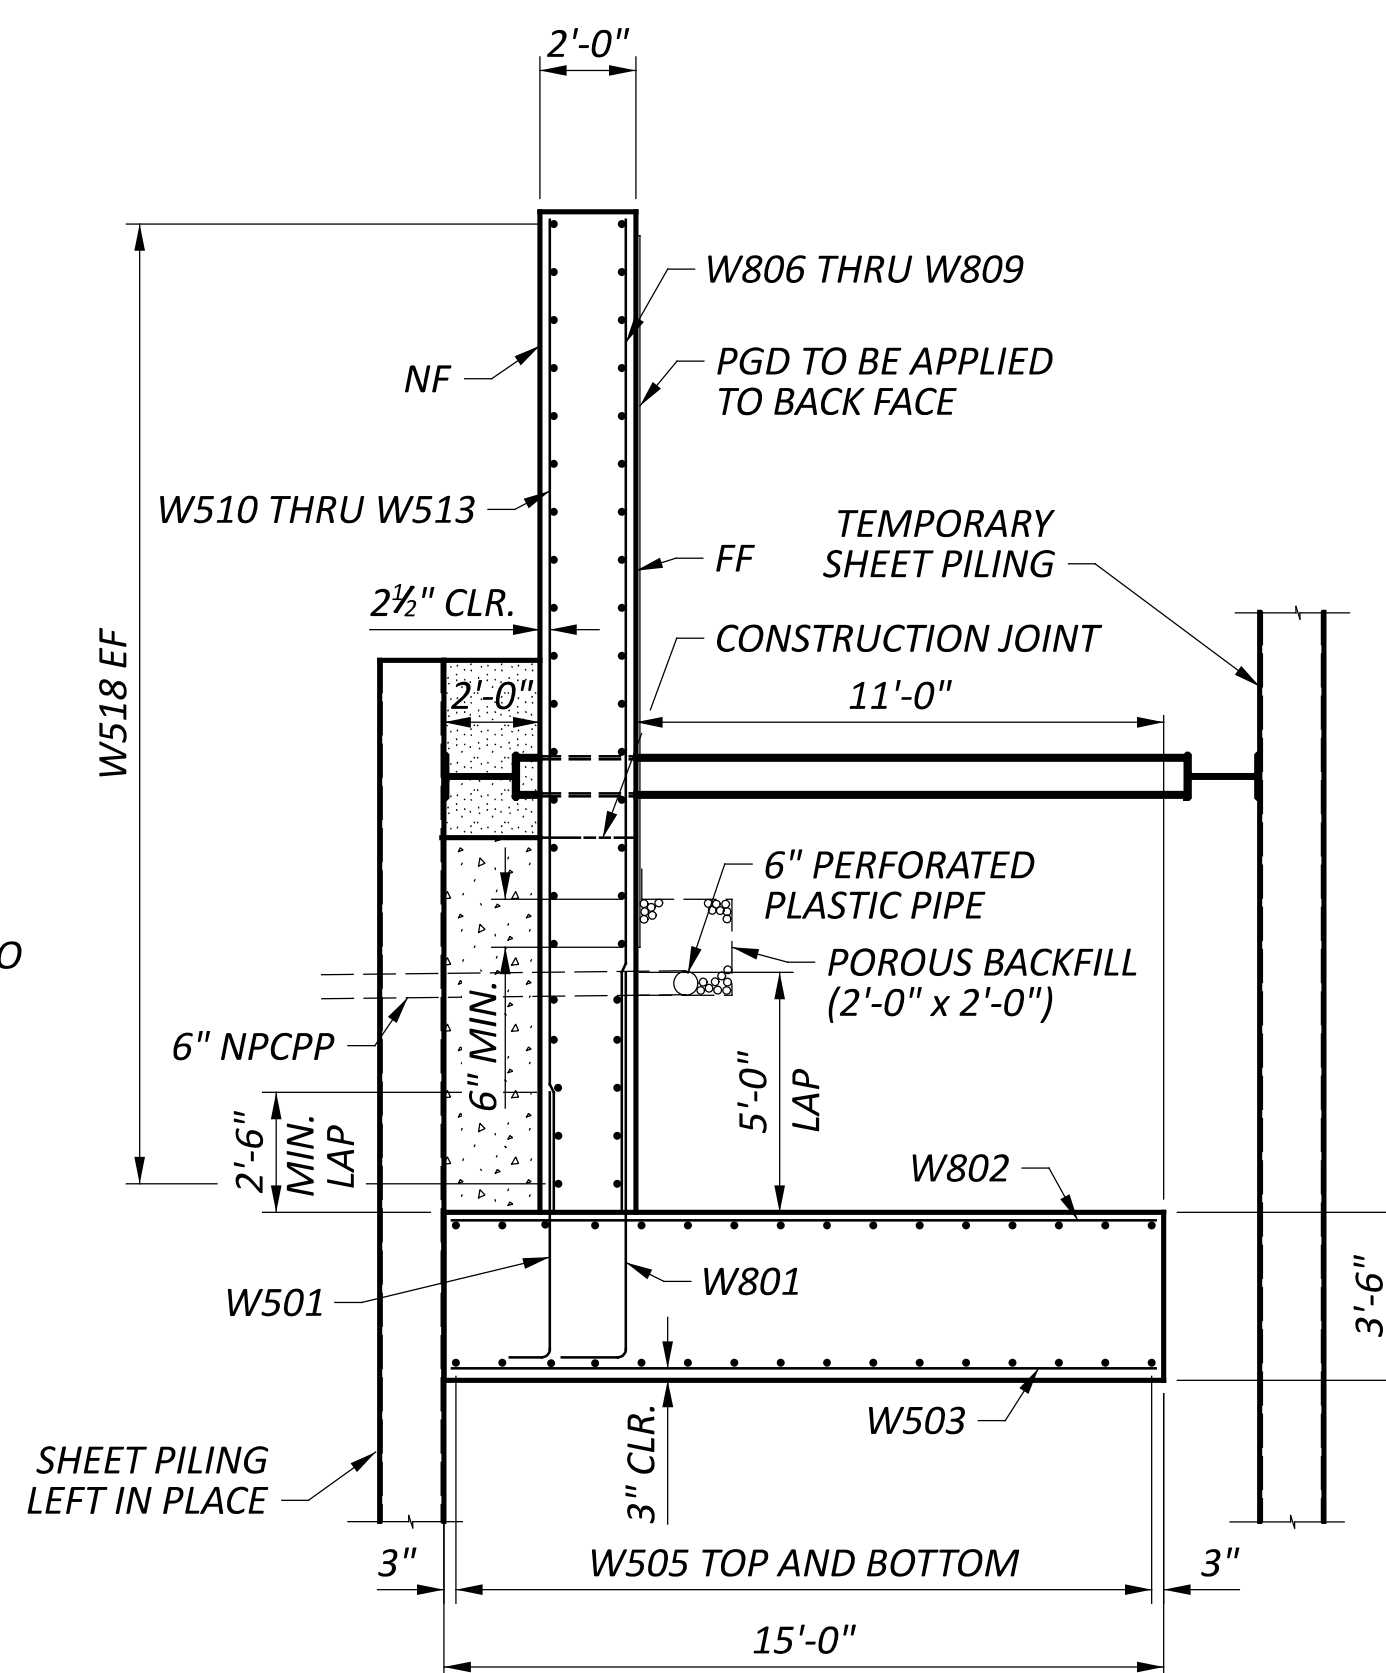

STA. 12+21.00± TO 13+58.00±

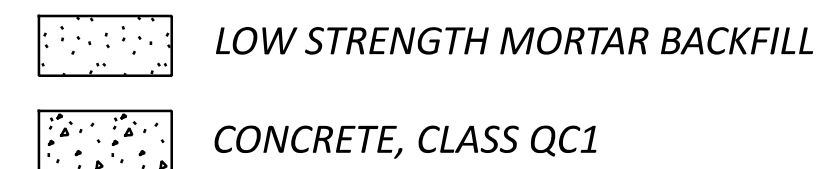

1. ALL DIMENSIONS AND STATIONS ARE ALONG FRONT FACE OF WALL.
2. FOR PLAN VIEW OF WALL, SEE SHEET [25][39] .
3. FOR TEMPORARY SHORING DETAILS, SEE SHEET [29][39] .
3. NPCPP = NON-PERFORATED CORRUGATED PLASTIC PIPE
4. SHEET PILING SHALL BE PZ40. ALTERNATIVE SHEETING WITH SECTION PROPERTIES EQUAL TO OR GREATER THAN PZ40 SHEETING MAY BE USED.
5. LIMITS SHOWN FOR SECTION B-B ARE APPROXIMATE. SECTION B-B SHALL APPLY WHERE TOP OF ROCK IS BELOW BOTTOM OF FOOTING AND WHERE REQUIRED EMBEDMENT OF 18' CANNOT BE ATTAINED. FOR ADDITIONAL DETAILS, SEE SHEET [30][39] .
6. BACKFILL BETWEEN TEMPORARY SHEETING AND BACK OF WALL WITH STRUCTURAL BACKFILL, TYPE 3 PER CMS 703.11.
7. WITHIN LIMITS OF SECTION B-B, FILL BETWEEN PERMANENT SHEETING AND FRONT OF WALL WITH CLASS QC1 CONCRETE TO CONSTRUCTION JOINT IN WALL. ABOVE THIS, AND FOR FULL HEIGHT ON REMAINDER OF WALL, FILL GAP BETWEEN FACE OF WALL AND PERMANENT SHEETING WITH LOW STRENGTH MORTAR BACKFILL.

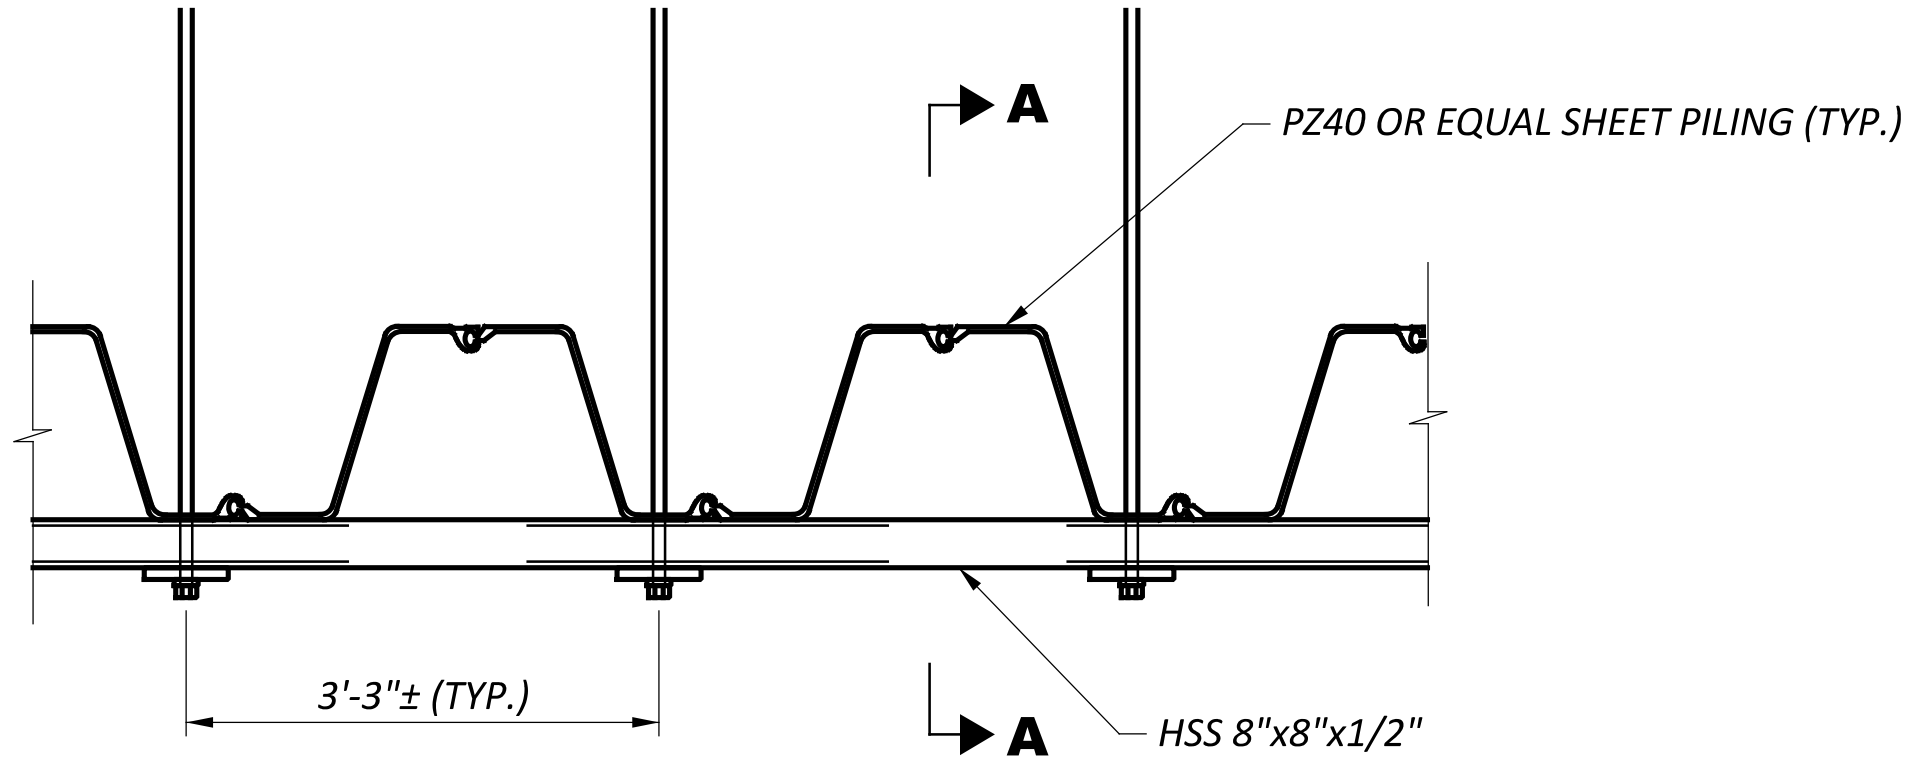

SOIL PARAMETERS

PARAMETER	ASSUMED VALUE
RETAINED SOIL UNIT WEIGHT (PCF)	130
RETAINED SOIL DRAINED FRICTION ANGLE (DEGREES)	30
ACTIVE EARTH PRESSURE COEFFICIENT (Ka)	0.33
ULTIMATE BOND STRENGTH (KSF)	1.05

GROUND ANCHOR DATA

LOCATION	ROW	TEST LOAD	LOCK-OFF LOAD
STA 11+50 - 12+91	TOP	10.6 K	10.6 K
	BOTTOM	33.7 K	33.7 K
STA 12+91 - 16+02.32	TOP	20.5 K	20.5 K
	BOTTOM	---	---

NOTES:

- PZ40 OR EQUIVALENT SHEET PILING SHALL BE PROVIDED WITH GROUND ANCHORS AS SHOWN AND MINIMUM EMBEDMENT OF 10 FEET.
- BOTTOM GROUND ANCHOR TO BE INSTALLED ONLY WHERE SUFFICIENT EMBEDMENT IS NOT AVAILABLE DUE TO PRESENCE OF INTERBEDDED SHALE AND LIMESTONE. THIS REGION IS ESTIMATED TO BE FROM STA 11+50 TO STA 12+91. SPACING OF ANCHORS TO BE THE SAME AS FOR TOP GROUND ANCHOR.
- GROUND ANCHORS TO BE DESIGNED AND PROVIDED IN ACCORDANCE WITH SS 866. ANCHORS TO BE INCLUDED FOR PAYMENT WITH ITEM 503, COFFERDAMS AND EXCAVATION BRACING, AS PER PLAN

