CROSSINGS AND CONNECTIONS TO EXISTING PIPES AND UTILITIES

WHERE PLANS PROVIDE FOR A PROPOSED CONDUIT TO BE CONNECTED TO, OR CROSS OVER OR UNDER AN EXISTING SEWER OR UNDERGROUND UTILITY, THE CONTRACTOR SHALL LOCATE THE EXISTING PIPES OR UTILITIES BOTH AS TO LINE AND GRADE BEFORE STARTING TO LAY THE PROPOSED CONDUIT.

IT IS IS DETERMINED THAT THE ELEVATION OF THE EXISTING CONDUIT, OR EXISTING APPURTENANCE TO BE CONNECTED. DIFFERS FROM THE PLAN ELEVATION OR RESULTS IN A CHANGE IN THE PLAN CONDUIT SLOPE, THE ENGINEER SHALL BE NOTIFIED BEFORE STARTING CONSTRUCTION OF ANY PORTION OF THE PROPOSED CONDUIT WHICH WILL BE AFFECTED BY THE VARIANCE IN THE EXISTING ELEVATIONS.

IF IT IS DETERMINED THAT THE PROPOSED CONDUIT WILL INTERSECT AN EXISTING SEWER OR UNDERGROUND UTILITY IF CONSTRUCTED AS SHOWN ON THE PLAN, THE ENGINEER SHALL BE NOTIFIED BEFORE STARTING CONSTRUCTION OF ANY PORTION OF THE PROPOSED CONDIT WHICH WOULD BE AFFECTED BY THE INTERFERENCE WITH AN EXISTING FACILITY.

PAYMENT FOR ALL THE OPERATIONS DESCRIBED ABOVE SHALL BE INCLUDED IN THE CONTRACT PRICE FOR THE PERTINENT 611 CONDUIT ITEM.

CLEAN WATER CONNECTIONS TO SANITARY SEWERS

ROOF DRAINS, FOUNDATION DRAINS, DRAIN TILES, AND OTHER CLEAN WATER CONNECTIONS TO THE SANITARY SYSTEM ARE PROHIBITED.

PONDING

THE CONTRACTOR IS RESPONSIBLE FOR REPAIRS TO ALL AREAS THAT HOLD WATER AFTER CONSTRUCTION OF THE CURB RAMPS. THESE AREAS INCLUDE ANY AND ALL AREAS WITHIN THE PEDESTRIAN RIGHT-OF-WAY APPROACHING AND LEAVING THE NEWLY CONSTRUCTED CURB RAMP. AREAS OF PONDING CANNOT BE IDENTIFIED UNTIL AFTER ADEQUATE RAINFALL HAS OCCURRED AND REPAIR TO THESE AREAS WILL NOT OCCUR UNTIL AFTER SUCH TIME.

TYING INTO EXISTING DRAINAGE STRUCTURES

WHEN A PROPOSED CONDUIT IS BEING TIED INTO AN EXISTING DRAINAGE STRUCTURE, THE HOLE BEING MADE IN THE EXISTING STRUCTURE TO RECEIVE THE PROPOSED CONDUIT SHALL BE A CORED HOLE. FOR CONDUITS OVER 24". THE HOLE CAN BE NEATLY SAWED INSTEAD OF CORED.

THE COST OF TYING INTO AN EXISTING DRAINAGE STRUCTURE SHALL BE INCLUDED IN THE COST OF INSTALLING ITEM 611 CONDUIT.

CATCH BASIN RECONSTRUCTED TO GRADE. AS PER PLAN

145+41.31: ADJUST CATCH BASIN TO PROPOSED GRADE AND REMOVE GRATE AND REPLACE WITH A SQUARE SOLID TRAFFIC BEARING BOLTED LID AND FRAME PER 711.14.

151+40.68: ADD WINDOW OPENING TO WEST SIDE OF CATCH BASIN.

ITEM 601 - PAVED GUTTER, TYPE 3, AS PER PLAN

PAVED GUTTER SHALL BE AS PER DM-2.1, EXCEPT NO BAFFLES ARE REQUIRED.

EXISTING SUBSURFACE DRAINAGE

PROVIDE UNOBSTRUCTED OUTLETS FOR ALL EXISTING UNDERDRAINS OR AGGREGATE DRAINS ENCOUNTERED DURING CONSTRUCTION.

PROVIDE AN OUTLET PER STANDARD CONSTRUCTION DRAWING DM-1.1 FOR ALL UNDERDRAINS THAT OUTLET TO A SLOPE.

UNDERDRAINS THAT CAN BE CONNECTED TO THE NEW OR EXISTING UNDERDRAINS AT THE END OF THE PROJECT LIMITS AS WELL AS ALL NECESSARY BENDS OR BRANCHES REQUIRED FOR CONNECTION ARE INCLUDED IN THE BASIS OF PAYMENT FOR UNCLASSIFIED PIPE UNDERDRAINS.

THE FOLLOWING ESTIMATED QUANTITIES HAVE BEEN INCLUDED IN THE GENERAL SUMMARY FOR THE WORK NOTED *ABOVE:*

601, TIED CONCRETE BLOCK	
MAÍ WITH TYPE 1 UNDERLAYMENT	8 SQ. YD.
611, 4" CONDUIT, TYPE F	200 FT.
<i>611, PRECAST REINFORCED CONCRETE OUTLET</i>	4 EACH
605, 6" UNCLASSIFIED PIPE UNDERDRAINS	200 FT.

PIPE CONNECTIONS TO CORRUGATED METAL STRUCTURES

CONNECTIONS OF PROPOSED LONGITUDINAL DRAINAGE TO CORRUGATED METAL STRUCTURES SHALL BE MADE BY MEANS OF A SHOP FABRICATED OR FIELD WELDED STUB ON THE STRUCTURE. THE STUB SHALL MEET THE REQUIREMENTS OF 707 AND HAVE A MINIMUM LENGTH OF 2 FEET AND A MINIMUM WALL THICKNESS OF 0.064 INCHES.

THE LOCATION AND ELEVATION OF THE STUB ARE TO BE CONSIDERED APPROXIMATE AND MAY BE ADJUSTED BY THE ENGINEER TO AVOID CUTTING THROUGH JOINTS IN THE STRUCTURE.

THE FIELD WELDED JOINT, IF USED, SHALL BE THOROUGHLY CLEANED AND REGALVANIZED OR OTHERWISE SUITABLY REPAIRED. WELDING SHALL MEET THE REQUIREMENTS OF 513.21.

A MASONRY COLLAR, AS PER STANDARD DRAWING DM-1.1, WILL BE REQUIRED TO CONNECT THE LONGITUDINAL DRAINAGE TO THE STUB, WHEN PIPE OTHER THAN CORRUGATED METAL IS PROVIDED FOR THE LONGITUDINAL DRAINAGE.

PAYMENT FOR CUTTING INTO THE STRUCTURE AND PROVIDING THE CONNECTION DESCRIBED. SHALL BE INCLUDED IN THE CONTRACT PRICE FOR ITEM 611 OR *522.*

ITEM 202 - REMOVAL MISC .: PRIVATE FLAG POLE

THIS ITEM CONSISTS OF A SINGLE STEEL POST, FLAG, AND FOUNDATION. THE FLAG POLE IS LOCATED ON PARCEL 711. JUST NORTH OF RAMP F NEAR STA 147+06.96, IN AN EXISTING LANDSCAPE AREA AT THE SOUTHWEST CORNER OF APPLEBEES, JUST EAST OF GLEN ESTE WITHAMSVILLE AS SHOWN ON SHEET 84 . THIS ITEM SHALL INCLUDE THE REMOVAL AND DISPOSAL OF ALL MATERIAL ASSOCIATED WITH THE POLE AND FOUNDATION. APPROXIMATE DIMENSIONS OF POLE IS 25' TALL. ANY REMAINING HOLE FROM THE REMOVAL OF THE FLAG POLE SHALL BE FILLED.

ITEM SPECIAL: CONSULTANT FOR CONCRETE QUALITY CONTROL INCLUDING TESTING AND INSPECTION

ALL CONCRETE SHALL BE TESTED. ALL TESTING, INSPECTION AND QUALITY CONTROL FOR CONCRETE, NOT INCLUDED UNDER QC/QA PAY ITEMS, SHALL BE THE RESPONSIBILITY OF THE CONTRACTOR. THE CONTRACTOR SHALL PROVIDE A CONCRETE TESTING CONSULTANT WITH PREVIOUS EXPERIENCE AND FAMILIARITY IN ODOT PROCEDURES. CONCRETE TESTING REQUIREMENTS AND CONCRETE TESTING DOCUMENTATION. AT LEAST 30 DAYS PRIOR TO CONCRETE PLACEMENT, SUBMIT TO THE ENGINEER FOR APPROVAL, THE PROPOSED CONCRETE TESTING CONSULTANT ALONG WITH THE RESUMES OF THE PROPOSED TESTING PERSONNEL.

TESTING CONCRETE FOR STRUCTURES AND PORTLAND CEMENT CONCRETE PAVEMENT SHALL BE PERFORMED AS OUTLINED IN CONSTRUCTION AND MATERIAL SPECIFICATIONS 455.

THROUGH THE CONTRACTOR, THE CONSULTANT SHALL BE RESPONSIBLE FOR ENSURING THAT ALL CONCRETE PLACED IS IN ACCORDANCE WITH THE SPECIFICATIONS, SUCH WORK SHALL BE IN ACCORDANCE WITH THE APPLICABLE CONSTRUCTION AND MATERIAL SPECIFICATIONS AND THE ODOT CONSTRUCTION INSPECTION MANUAL OF PROCEDURES FOR CONCRETE. THE CONCRETE CONSULTANT SHALL PROVIDE THE NECESSARY TRAINED TECHNICIAN(S) AND EQUIPMENT AND SHALL FURNISH THE PROJECT ENGINEER WITH TWO (2) COPIES OF ALL TEST RESULTS WITHIN 24 HOURS AFTER COMPLETION OF CONCRETE PLACEMENT.

THE TECHNICIANS SHALL BE ACI LEVEL 1 CERTIFIED AND WILL BE REQUIRED TO DEMONSTRATE HIS/HER COMPETENCE AND EXPERIENCE LEVELS TO THE ENGINEER PRIOR TO BEGINNING WORK. THE ENGINEER WILL ORDER THE CONTRACTOR TO REPLACE ANY TECHNICIAN THAT IS NOT VERSED IN THE REQUIRED TESTING PROCEDURE.

THE TECHNICIAN SHALL VERBALLY NOTIFY THE ODOT PROJECT ENGINEER OF ANY FAILING TESTS AND SHALL SUBMIT FOLLOW-UP WRITTEN NOTIFICATION TO THE PROJECT ENGINEER OF REMEDIAL ACTION(S) TAKEN. TESTS SHALL BE TAKEN AS SPECIFIED WITHIN THE CONSTRUCTION AND MATERIAL SPECIFICATIONS, CONCRETE MANUAL OR APPROPRIATE SUPPLEMENTAL SPECIFICATION AS LISTED IN THE PROPOSAL GOVERNING THE PROJECT. IT SHALL BE THE SOLE RESPONSIBILITY OF THE CONTRACTOR TO MAKE IMMEDIATE CORRECTIONS OR ADJUSTMENTS TO THE CONCRETE MIX VIA DIRECT COMMUNICATION WITH THE CONCRETE SUPPLIER'S PLANT PERSONNEL TO MAINTAIN UNINTERRUPTED COMPLIANCE WITH THE SPECIFICATIONS UPON NOTIFICATION OF CONCRETE MIX NON-COMPLIANCE BY THE CONSULTANT TECHNICIAN. THE PROJECT ENGINEER MAY REQUIRE MORE FREQUENT TESTING AS CONDITIONS WARRANT.

UPON COMPLETION OF DAILY CONCRETE PLACEMENT(S), THE CONCRETE CONSULTANT SHALL PROVIDE THE PROJECT ENGINEER WITH DAILY TEST REPORTS, TE-45'S, INSPECTORS DAILY REPORT AND SUPPORTING DOCUMENTATION FOR EACH ITEM OF CONCRETE WORK PERFORMED SEPARATED BY MIX DESIGN. SUBSEQUENTLY, UPON COMPLETION OF AN ENTIRE CONCRETE SPECIFICATION ITEM, THE CONCRETE CONSULTANT SHALL ALSO PROVIDE THE PROJECT ENGINEER WITH TWO (2) COPIES OF AN ADDITIONAL INSPECTION REPORT BY A REGISTERED PROFESSIONAL ENGINEER, STATE OF OHIO, WHICH CONTAINS THE TESTING RESULTS SUMMARY FOR EACH ITEM BY CONTRACT REFERENCE NUMBER AND THE CONSULTANT'S CONCLUSIONS RELATIVE TO SPECIFICATION COMPLIANCE FOR ALL CONCRETE TESTING WORK.

THE ODOT PROJECT ENGINEER RESERVES THE RIGHT TO MAKE UNANNOUNCED QUALITY-CONTROL TESTS TO VERIFY PROCEDURES USED AND RESULTS BEING OBTAINED BY THE CONTRACTOR.

ITEM SPECIAL: CONSULTANT FOR CONCRETE QUALITY CONTROL INCLUDING TESTING AND INSPECTION (CONTINUED)

THE CONCRETE TECHNICIAN SHALL WORK UNDER THE DIRECTION OF A REGISTERED PROFESSIONAL ENGINEER, STATE OF OHIO, WHO WILL MONITOR THE CONCRETE TEST RESULTS. THE FINAL INSPECTION REPORTS FOR EACH COMPLETED ITEM SHALL BE SIGNED BY A REGISTERED PROFESSIONAL ENGINEER, STATE OF OHIO. CERTIFYING THAT ALL CONCRETE TESTS PROVIDED BY THE CONTRACTOR MET APPLICABLE CONTRACT REQUIREMENTS. A FINAL REPORT ISSUED BY THE CONSULTING FIRM SHALL CONTAIN A CERTIFIED STATEMENT OF COMPLIANCE WITH ODOT SPECIFICATIONS AND ANY OTHER CONCLUSIONS REGARDING THE CONCRETE MATERIALS INCORPORATED INTO THE PROJECT. SUCH STATEMENT SHALL BE SIGNED BY A REGISTERED PROFESSIONAL ENGINEER, STATE OF OHIO. AND, THE CONCRETE CONSULTANT SHALL BE REQUIRED TO ATTEND MONTHLY PROGRESS MEETINGS AS REQUIRED BY THE PROJECT ENGINEER.

ADDITIONALLY. THE CONTRACTOR SHALL BE REQUIRED TO KEEP A POSTED LIST OF BEAM AND CYLINDER IDENTIFICATION NUMBERS FOR THE PURPOSE OF IDENTIFYING THE CORRESPONDING PLACEMENT LOCATION AND CONCRETE SPECIFICATION ITEM.

PAYMENT SHALL BE BID AS LUMP SUM FOR ITEM SPECIAL STRUCTURES: CONSULTANT FOR CONCRETE QUALITY CONTROL INCLUDING TESTING AND INSPECTION. THE ITEM WILL BE PAID FOR AS FOLLOWS:

UPON APPROVAL OF CONSULTANT .	20%	
PROGRESSIVE EQUIVALENT PAYMENTS	5	50%
UPON SUBMISSION OF FINAL REPORT	- 30%	,

THE TECHNICIAN SHALL HAVE THE FULL EFFECT AND AUTHORITY OF AN ODOT PROJECT INSPECTOR IN DETERMINING ACCEPTABILITY OF MATERIAL AND CONCRETE PLACEMENT PRACTICES.


ITEM 622 - CONCRETE BARRIER. SINGLE SLOPE. TYPE D. AS PER PLAN A & CONCRETE BARRIER, END ANCHORAGE, REINFORCED, TYPE D, AS PER PLAN

THESE ITEMS SHALL FOLLOW ALL DETAILS ON RM-4.5 WITH THE EXCEPTION OF THE FOLLOWING:

THE TOP WIDTH SHALL BE REDUCED BY 1" FOR A TOTAL WIDTH OF 11"

THE TOTAL WIDTH SHALL BE REDUCED BY 1" FOR A TOTAL WIDTH OF 19"


1" OF PEJF SHALL BE INCLUDED IN THE PRICE OF THE BARRIER.

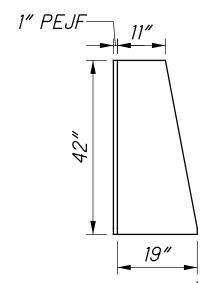


ITEM 622 - CONCRETE BARRIER, SINGLE SLOPE, TYPE D, AS PER PLAN B

 \sim

THIS ITEM SHALL FOLLOW ALL DETAILS ON RM-4.5 EXCEPT THAT THE BASE SHALL EXTEND 9" BELOW THE PAVEMENT SURFACE AS SHOWN. THE 1" PEJF SHALL EXTEND FOR THE FULL HEIGHT OF THE BARRIER. THE COST OF THE PEJF SHALL BE INCLUDED IN THE UNIT PRICE OF THE BARRIER.

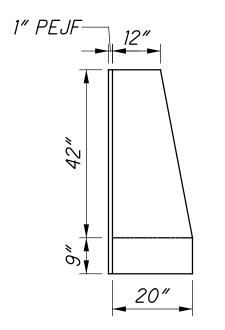

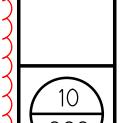

	SHEET NUM.									PART.					SEE	ATED	KED H			
	9	10	10A	67	68	69	71	72	73	77			01/NHS/04	ITEM	EXT	TOTAL	UNIT	DESCRIPTION SHEEN NO.	_	MH CHECK
																		ROADWAY		
	15												LS	201	11000	LS		CLEARING AND GRUBBING		
				2									2	202	20010	2	EACH	HEADWALL REMOVED		
				7,084			524						7,608	202	23000	7,608	SY	PAVEMENT REMOVED		
							842						842	202	23500	842		WEARING COURSE REMOVED		
				145							<u> </u>		145	202	30000	145	SF	WALK REMOVED		
				970 404									970 404	202 202	<i>32000</i> <i>35100</i>	970 404		CURB REMOVED PIPE REMOVED, 24" AND UNDER		
				43									43	202	35200	43		PIPE REMOVED, OVER 24"		
				580									580	202	38000	580		GUARDRAIL REMOVED		
				7									7	200	50100	7	E A O.U.	CATOU BACIN BENOVED		
				2,970									2,970	202 202	58100 75000	2,970		CATCH BASIN REMOVED FENCE REMOVED		
				1									1	202	98100	1		REMOVAL MISC.: PRIVATE SIGN AND FOUNDATION 9		
		1											1	202	98100	1		REMOVAL MISC.: PRIVATE FLAG POLE		
			2										2	202	98100	2		REMOVAL MISC.: INSPECTION WELL 10A		
			20										20	202	98200	20	FT	REMOVAL MISC.: CONDUIT		>
								7,077					7,077	203	10000	7,077	CY	EXCAVATION		C
								5,016					5,016	203	20000	5,016		EMBANKMENT		4
			50										50	203	20001	50		EMBANKMENT, AS PER PLAN 10A		Σ
	11						1,946						1,946	204	10000	1,946		SUBGRADE COMPACTION		Σ
	11						19,350						19,350	204 206	45000 10010	19 , 350		PROOF ROLLING LIME STABILIZED SUBGRADE, 12 INCHES DEEP		
							501						501	206	10300	501		LIME		S
							19,350						19,350	206	11000	19,350	SY	CURING COAT		
	LS												LS	206	30001	LS		MIXTURE DESIGN FOR CHEMICALLY STABILIZED SOILS, AS PER PLAN 9		4
					262.5								262.5	606	15050	262.5	FT	GUARDRAIL, TYPE MGS		R
					625								625	606	15100	625		GUARDRAIL, TYPE MGS WITH LONG POSTS		Щ
					3								3	606	26150	3		ANCHOR ASSEMBLY, MGS TYPE E (MASH 2016)		E
					1								1	606	26550	1		ANCHOR ASSEMBLY, MGS TYPE T		5
					3	1							3	606 606	35002	3		MGS BRIDGE TERMINAL ASSEMBLY, TYPE 1		
					1	/							1	606 606	35102 60022	1		MGS BRIDGE TERMINAL ASSEMBLY, TYPE 2 IMPACT ATTENUATOR, TYPE 2 (UNIDIRECTIONAL) [60 MPH/24 IN]		
					2,349								2,349	607	23000	2,349		FENCE, TYPE CLT		
					2,349								2,349	607	70000	2,349	FT	FENCELINE SEEDING AND MULCHING		
					(1 0 4 7							1047		10,000	1047	ΓT	CONCRETE BARRIER CINCLE CLORE TYPE B		
						1,847 1,488	Š K						1,847	622 622	10060 10120	1,847 \		CONCRETE BARRIER, SINGLE SLOPE, TYPE B CONCRETE BARRIER, SINGLE SLOPE, TYPE C		
						825	/						1,488 825	622	10160	1,488 825	FT	CONCRETE BARRIER, SINGLE SLOPE, TYPE D		
						171							171	622	10161	171	FT	CONCRETE BARRIER, SINGLE SLOPE, TYPE D, AS PER PLAN A		
						879							879	622	10161	879		CONCRETE BARRIER, SINGLE SLOPE, TYPE D, AS PER PLAN B 10		
						5							5	622 622	24840 25000	<i>1</i> 5		CONCRETE BARRIER END SECTION, TYPE B CONCRETE BARRIER END SECTION, TYPE D		
						10							10	622	25000	10		CONCRETE BARRIER, END ANCHORAGE, REINFORCED, TYPE B		
+-						10							10	622	25008	10		CONCRETE BARRIER, END ANCHORAGE, REINFORCED, TYPE C		
§ v.						7							7	622	25050	7		CONCRETE BARRIER, END ANCHORAGE, REINFORCED, TYPE D		
		LS				2							2	622 SPECIAL	25051 69098400	LS		CONCRETE BARRIER, END ANCHORAGE, REINFORCED, TYPE D, AS PER PLAN 10 10		
∑ ⊲		LJ											LS	878	25000	LS		INSPECTION AND COMPACTION TESTING OF UNBOUND MATERIALS		
7																				
 C																		EROSION CONTROL		
لر ر		8							150				150	601	21050	8 150		TIED CONCRETE BLOCK MAT WITH TYPE 1 UNDERLAYMENT		7
	2								150				150	601 659	38501 00100	150 2		PAVED GUTTER, TYPE 3, AS PER PLAN SOIL ANALYSIS TEST	~	.33 8)
<u>(</u>	1,060												1,060	659	00300	1,060		TOPSOIL	_ C	N
	9,546												9,546	659	10000	9,546		SEEDING AND MULCHING		ТШ
	477												477	659	14000	477	SY	REPAIR SEEDING AND MULCHING	`~	-32- ASE
<u></u>	477							<u> </u>		<u> </u>	1		477	659	15000	477	SY	INTER-SEEDING		
000	1.33							1	1	1	1		1.33	659	20000	1.33		COMMERCIAL FERTILIZER	┤ 🖁	PH
	1.97												1.97	659	31000	1.97	ACRE	LIME		5
7	53												53	659	35000	53	MGAL	WATER		
0.53	21					-		1	-	 	1		21	659	40000	21	MSF	MOWING		
000										LS			LS	832	15000	LS		STORM WATER POLLUTION PREVENTION PLAN		
200										LS			LS	832	15002	LS		STORM WATER POLLUTION PREVENTION INSPECTIONS		60
C Y										LS			LS	832	15010	LS		STORM WATER POLLUTION PREVENTION INSPECTION SOFTWARE		262
				<u> </u>				<u> </u>		69,692			69,692	832	30000	69,692	EACH	EROSION CONTROL		

1	<u> </u>			DESCRIPTION	SEE SHEET	1 .							
194						01/NHS/0-	4	EXT	TOTAL			NO.	CAL
											RETAINING WALLS (004)		
31,440 200						31,440 200	509 511	10000	31,440 200		EPOXY COATED REINFORCING STEEL	205	_
792						792	512	53012 10100	792		CLASS QC2 CONCRETE, MISC.: MOMENT SLAB SEALING OF CONCRETE SURFACES (EPOXY-URETHANE)	203	-
302						802	516	13900	802		2" PREFORMED EXPANSION JOINT FILLER		
							070	70000			2 THE SAME EXTANOIST SOLIT FIELEN		
,861						5 , 861	840	20000	5 , 861	SF	MECHANICALLY STABILIZED EARTH WALL		
571						571	840	21000	571		WALL EXCAVATION		
773						773	840	22000	773		FOUNDATION PREPARATION		
,262 551						3,262 551	840 840	23000 25010	3,262 551		SELECT GRANULAR BACKFILL 6" DRAINAGE PIPE, PERFORATED		
27						27	840	25020	27	FT	6" DRAINAGE PIPE, NON-PERFORATED		
401						401	840	26000	401		CONCRETE COPING		
2						2	840	27000	2	DAY	ON-SITE ASSISTANCE		
<u>L</u> S						LS	840	28000	LS		SGB INSPECTION AND COMPACTION TESTING		
<u> </u>						LS	867	00100	LS		TEMPORARY WIRE FACED MECHANICALLY STABILIZED EARTH WALL		
													-
											RETAINING WALLS (009)		
74						274	203	20001	274	CY	EMBANKMENT, AS PER PLAN	193	
.5						LS	503	11101	LS		COFFERDAMS AND EXCAVATION BRACING, AS PER PLAN	193	
,650						<i>52,650</i>	509	10000	52,650		EPOXY COATED REINFORCING STEEL	225	_
33						333	511	53012	333	CY	CLASS QC2 CONCRETE, MISC.: MOMENT SLAB	205	-
312						1,312	512	10100	1,312	SY	SEALING OF CONCRETE SURFACES (EPOXY-URETHANE)		
212						1,212	516	13900	1,212		2" PREFORMED EXPANSION JOINT FILLER		
.5						LS	SPECIAL	53000200	LS		STRUCTURES MISC : VIBRATION MONITORING	193	
.5						LS	SPECIAL	(53000200	LS		STRUCTURES MISC.: PRECONSTRUCTION CONDITION SURVEY	193	
070						11 070				65			
,972 ,955						11,972 3,955	840 840	20000 21000	11,972 3,955		MECHANICALLY STABILIZED EARTH WALL WALL EXCAVATION		_
,275						1,275	840	22000	1,275		FOUNDATION PREPARATION		_
342						342	840	22001	342		FOUNDATION PREPARATION, AS PER PLAN	193	
7,166						7,166	840	23000	7,166		SELECT GRANULAR BACKFILL	,,,,,	-
77						77	840	23050	77	CY	NATURAL SOIL		
486 78						1,486 78	840 840	25010 25020	1,486 78		6" DRAINAGE PIPE, PERFORATED 6" DRAINAGE PIPE, NON-PERFORATED		
79						879	840	26000	879	FT FT	CONCRETE COPING		
3						3	840	27000	3	DAY	ON-SITE ASSISTANCE		_
						LS	840	28000	LS		SGB INSPECTION AND COMPACTION TESTING		
<u> </u>						LS	867	00100	LS		TEMPORARY WIRE FACED MECHANICALLY STABILIZED EARTH WALL		_
								00700			TEMI ONANT WINE TAGED MEGNATIONEET STADIETZED EANTH WALL		_
													_
													_
								1					-
													-
													_
		 		_	+ +				1				
													_
													_

			Ī			606		622	622	622	622	622	622	622	622	622	622	622		ED
SHEET NO.	FERENCE NO.	ALIGNMENT	STA	TION	SIDE	IGS BRIDGE TERMINAL ASSEMBLY, TYPE 2		CONCRETE BARRIER, SINGLE SLOPE, TYPE B	CONCRETE BARRIER, INGLE SLOPE, TYPE C	CONCRETE BARRIER, INGLE SLOPE, TYPE D	CONCRETE BARRIER, INGLE SLOPE, TYPE D AS PER PLAN A	CONCRETE BARRIER, INGLE SLOPE, TYPE D AS PER PLAN B	ONCRETE BARRIER END SECTION, TYPE B	ONCRETE BARRIER END SECTION, TYPE D	CONCRETE BARRIER, END ANCHORAGE, REINFORCED, TYPE B	CONCRETE BARRIER, END ANCHORAGE, REINFORCED, TYPE C	CONCRETE BARRIER, END ANCHORAGE, REINFORCED, TYPE D	CONCRETE BARRIER, END ANCHORAGE, REINFORCED, TYPE D, AS PER PLAN		CALCULAT
	R H		FROM	ТО		EACH		FT	FT	FT	FT	FT	EACH	EACH	EACH	EACH	EACH	EACH		
79	B1 B2	RAMP F	121+80.00 NOT USED	124+40.00	RT			(177.6	3						5				 _
80	B3	RAMP F	124+60.00	128+75.00	RT				385.0							2				
80	B4	RAMP F	128+95.00	133+65.00	RT				440.0							2				
81	B5 B6	RAMP F	133+85.00 NOT USED	134+75.00	RT				74.9							1				
82 82	B7 B8	RAMP F RAMP F	134+75.00 138+00.00	138+00.00 138+90.00	RT RT			325.5	90.2											 ┨┋
82	<i>B9</i>	RAMP F	138+90.00	141+50.00	RT			190.3	30.2						4					F
83 83	B10 B11	RAMP F RAMP F	141+50.00 142+50.00	142+50.00 150+25.00	RT RT			725.7	100.1						2					
85	B12	RAMP F	150+25.00	151+75.00	RT		(7777	150.0											
85	B13 B14	RAMP F	151+75.00 NOT USED	154+60.00	RT			215.0)						4					
86 86	B15 B16	RAMP F RAMP F	154+60.00 158+50.00	158+50.00 159+50.27	RT RT			390.0	70.3				1							
86	B17 B18	RAMP F	158+42.33 NOT USED	159+50.27	LT					93.0										
87	<i>B19</i>	RAMP F	159+50.27	161+00.00	LT					136.1				1						<u> </u>
	B20 B21		NOT USED NOT USED																	
88	B22 B23	SR 32	165+47.89 NOT USED	167+50.28	LT					188.9				1						
89	B24	RAMP R	144+74.85	147+40.44	RT							236.2					2			
90	B25	RAMP R RAMP R	144+32.62	150+78.88	L /						171.2	619.3					2	2		
90 90 90	B26 B27 B28	RAMP R RAMP R RAMP R	151+49.88 153+70.08 148+75.58	153+50.08 158+42.33 148+89.63	<i>LT LT RT</i>					406.7	1/1.2			1			3	2		
	B29	TOTAL TO	NOT USED	770.00.00										,						
92	B30	SR 32	190+83.61	191+34.79	LT	1						23.2		2						_
																				(m)
																				-32-2
																				_ С С
																				CLE
																				-
																				6
TO	TALS C	ARRIED	TO GENER	AL SUMMAI	RY	1		1,847	1,488	825	171	879	1	5	10	10	7	2		26

REFER TO THE FOLLOWING STANDARD BRIDGE DRAWING:

SBR-1-13

DATED

AND TO THE FOLLOWING SUPPLEMENTAL SPECIFICATIONS:

		, , , , , ,
800	DATED	1/20/23
840	DATED	4/15/22
867	DATED	4/15/22
878	DATED	1/21/22
		Luu

DESIGN SPECIFICATIONS:

THIS STRUCTURE CONFORMS TO THE 8TH EDITION OF THE "LRFD BRIDGE DESIGN SPECIFICATIONS" ADOPTED BY THE AMERICAN ASSOCIATION OF STATE HIGHWAY AND TRANSPORTATION OFFICIALS, 2017, AND THE ODOT BRIDGE DESIGN MANUAL, 2019.

7/20/18

DESIGN DATA:

CONCRETE CLASS QC1 - COMPRESSIVE STRENGTH 4.0 KSI (CONCRETE COPING)

CONCRETE CLASS QC2 - COMPRESSIVE STRENGTH 4.5 KSI (MOMENT SLAB AND PARAPET)

REINFORCING STEEL - MINIMUM YIELD STRENGTH 60 KSI.

MSE WALL FOUNDATION BEARING RESISTANCE:

THE FACTORED BEARING RESISTANCE FOR EACH WALL IS LISTED IN THE TABLE BELOW.

FOUND	ATION BE	ARING RE	SISTANCE						
W A / /	WALL	WALL LIMITS							
WALL NUMBER	FROM STA.	TO STA.	RESISTANCE (KSF)						
4	10+30.00	14+31.00	5.1						
9	11+51.00	20+26.97	5.2						

MINIMUM SOIL REINFORCEMENT LENGTHS:

BASED ON THE EXTERNAL STABILITY ANALYSIS OF THE MECHANICALLY STABILIZED EARTH WALLS, THE FOLLOWING MINIMUM LENGTHS ARE AS FOLLOWS:

WALL NO. 4: THE MINIMUM SOIL REINFORCEMENT LENGTH SHALL BE 0.90H FROM WALL NO. 4 STA. 10+30.00 TO WALL NO. 4 STA. 11+75.00

WALL NO. 4: THE MINIMUM SOIL REINFORCEMENT LENGTH SHALL BE 0.80H FROM WALL NO. 4 STA. 11+75.00 TO WALL NO. 4 STA. 14+31.00

WALL NO. 9: THE MINIMUM SOIL REINFORCEMENT LENGTH SHALL BE 0.70H FROM WALL NO. 9 STA. 11+51.00 TO WALL NO. 9 STA. 16+25.00

WALL NO. 9: THE MINIMUM SOIL REINFORCEMENT LENGTH SHALL BE 0.80H FROM WALL NO. 9 STA. 16+25.00 TO WALL NO. 9 STA. 18+50.00

WALL NO. 9: THE MINIMUM SOIL REINFORCEMENT LENGTH SHALL BE 1.00H FROM WALL NO. 9 STA. 18+50.00 TO WALL NO. 9 STA. 20+26.97

AT NO CASE SHALL THE MINIMUM SOIL REINFORCEMENT BE LESS THAN 8 FEET.

H = THE WALL HEIGHT AS DETERMINED ACCORDING TO SUPPLEMENTAL SPECIFICATION 840.04.

ITEM 203 - EMBANKMENT, AS PER PLAN:

PLACE AND COMPACT ITEM 203 EMBANKMENT MATERIAL IN 6 INCH LIFTS FOR THE CONSTRUCTION OF THE BACKFILL IN FRONT AND BEHIND THE MSE WALLS, AND WHERE SHOWN IN THE PLANS, FOR EMBANKMENT FILL BELOW THE MSE WALLS. THE DEPARTMENT WILL MEASURE WALL EMBANKMENT FOR BACKFILL IN FRONT OF AND BEHIND MSE WALLS ACCORDING TO THE PAYMENT LIMITS SHOWN ON THE MSE WALL SECTION SHEETS. PAYMENT WILL BE BOUNDED ABOVE BY THE PROPOSED OR EXISTING GRADE, WHICHEVER IS LOWER. PAYMENT WILL BE BOUNDED BELOW BY THE WALL FOUNDATION PREPARATION LIMIT.

ITEM 503 - COFFERDAMS AND EXCAVATION BRACING, AS PER PLAN:

THE DESIGN SHOWN ON THE PLANS FOR TEMPORARY SUPPORT OF EXCAVATION IS ONE REPRESENTATIVE DESIGN THAT MAY BE USED TO CONSTRUCT THE PROJECT. THE CONTRACTOR MAY CONSTRUCT THE DESIGN SHOWN ON THE PLANS OR PREPARE AN ALTERNATE DESIGN TO SUPPORT THE SIDES OF EXCAVATIONS. IF CONSTRUCTING AN ALTERNATE DESIGN FOR TEMPORARY SUPPORT OF EXCAVATION, PREPARE AND PROVIDE PLANS IN ACCORDANCE WITH C&MS 501.05. THE DEPARTMENT WILL PAY FOR THE TEMPORARY SUPPORT OF EXCAVATION AT THE CONTRACT LUMP SUM PRICE FOR COFFERDAMS AND EXCAVATION BRACING. NO ADDITIONAL PAYMENT WILL BE MADE FOR PROVIDING AN ALTERNATE DESIGN

ITEM SPECIAL - STRUCTURES MISC .: VIBRATION MONITORING

MONITOR GROUND VIBRATIONS CAUSED BY TEMPORARY SHEET PILING INSTALLATION TO MINIMIZE THE POTENTIAL FOR DAMAGE TO THE ADJACENT RESIDENTIAL STRUCTURES. THE RESIDENTIAL STRUCTURES INCLUDE, BUT ARE NOT LIMITED TO:

- EXISTING BUILDING, AUDITOR'S PARCEL NUMBER 414109C040, POSITIONED AT APPROXIMATELY & CONST RAMP R STA. 152+00. 50' LT.. NEAR WALL NO. 9.
- 2. EXISTING BUILDING, AUDITOR'S PARCEL NUMBER 414109C039, POSITIONED AT APPROXIMATELY & CONST RAMP R STA. 153+00, 40' LT., NEAR WALL NO. 9.

RETAIN AN EXPERIENCED VIBRATION SPECIALIST TO ESTABLISH THE ACCEPTABLE VIBRATION LIMITS AND TO PERFORM THE VIBRATION MONITORING. USE A VIBRATION SPECIALIST THAT IS AN EXPERT IN THE INTERPRETATION OF VIBRATION DATA, AND WHO MEETS ONE OF THE FOLLOWING CRITERIA: 1) IS A REGISTERED ENGINEER WITH AT LEAST TWO YEARS OF PROVEN EXPERIENCE IN MONITORING VIBRATIONS ON SIMILAR CONSTRUCTION PROJECTS, OR 2) HAS AT LEAST FIVE YEARS OF PROVEN EXPERIENCE IN MONITORING VIBRATIONS ON SIMILAR CONSTRUCTION PROJECTS. DO NOT USE A VIBRATION SPECIALIST THAT IS AN EMPLOYEE OF THE CONTRACTOR.

SUBMIT A RESUME OF THE CREDENTIALS OF THE PROPOSED VIBRATION SPECIALIST AT OR BEFORE THE PRECONSTRUCTION MEETING. INCLUDE IN THE RESUME A LIST OF CONSTRUCTION PROJECTS ON WHICH THE VIBRATION SPECIALIST WAS
RESPONSIBLY IN CHARGE OF MONITORING THE VIBRATIONS. LIST A DESCRIPTION OF THE PROJECTS, WITH DETAILS OF THE VIBRATION INTERPRETATIONS MADE ON THE PROJECT. LIST THE NAMES AND TELEPHONE NUMBERS OF PROJECT OWNERS WITH SUFFICIENT KNOWLEDGE OF THE PROJECTS TO VERIFY THE SUBMITTED INFORMATION. OBTAIN THE ENGINEER'S ACCEPTANCE OF THE VIBRATION SPECIALIST BEFORE BEGINNING ANY TEMPORARY SHEET PILING INSTALLATION WORK. ALLOW 30 DAYS FOR THE REVIEW OF THIS DOCUMENTATION.

USE SEISMOGRAPHS CAPABLE OF CONTINUOUSLY RECORDING THE PEAK PARTICLE VELOCITY FOR THREE MUTUALLY PERPENDICULAR COMPONENTS OF VIBRATION, AND OF PROVIDING A PERMANENT RECORD OF THE ENTIRE VIBRATION EVENT. USE A SUFFICIENT NUMBER OF SEISMOGRAPHS TO PROVIDE REDUNDANCY IN CASE ONE DEVICE SHOULD FAIL. SUBMIT A PLAN OF THE PROPOSED SEISMOGRAPH LOCATIONS TO THE ENGINEER FOR REVIEW.

THE VIBRATION SPECIALIST SHALL PERFORM THE FOLLOWING:

- 1. MEASURE THE AMBIENT GROUND VIBRATIONS NEAR EXISTING STRUCTURES BEFORE TEMPORARY SHEET PILING INSTALLATION BEGINS.
- 2. ESTABLISH VIBRATION LIMITS TO MINIMIZE POTENTIAL DAMAGE TO EXISTING STRUCTURES AND EXPLAIN WHY THEY ARE BEING USED TO THE ENGINEER BEFORE INSTALLING TEMPORARY SHEET PILING NEAR EXISTING STRUCTURES.
- 3. MONITOR GROUND VIBRATIONS DURING TEMPORARY SHEET PILING INSTALLATION.
- 4. IMMEDIATELY INFORM THE CONTRACTOR AND ENGINEER IF THE VIBRATION LIMITS ARE REACHED OR EXCEEDED.
- 5. FURNISH THE DATA RECORDED AND INCLUDE THE FOLLOWING:
- A. IDENTIFICATION OF SEISMOGRAPH.
- B. DISTANCE AND DIRECTION OF SEISMOGRAPH FROM TEMPORARY SHEET PILING INSTALLATION.
- C. START TIME AND DURATION OF TEMPORARY SHEET PILING INSTALLATION. D. DETAILS OF TEMPORARY SHEET PILING INSTALLED DURING EACH MONITORING INTERVAL.

ITEM SPECIAL - STRUCTURES MISC .: VIBRATION MONITORING (CONTINUED).

IMMEDIATELY SUSPEND ALL TEMPORARY SHEET PILING INSTALLATION IF THE VIBRATION LIMITS ARE REACHED OR EXCEEDED. EVALUATE ALTERNATIVE CONSTRUCTION PROCEDURES TO REDUCE THE VIBRATIONS.

SUBMIT THREE COPIES OF THE FINAL REPORT WHICH CONTAINS ALL MEASUREMENTS. INTERPRETATIONS. AND RECOMMENDATIONS TO THE ENGINEER.

THE DEPARTMENT WILL PAY FOR THIS ITEM AT THE CONTRACT LUMP SUM PRICE FOR ITEM SPECIAL STRUCTURES MISC .: VIBRATION MONITORING. THE DEPARTMENT WILL PAY THE FINAL TWENTY PERCENT AFTER THE ENGINEER RECEIVES THE FINAL REPORT.

THE DEPARTMENT WILL PAY ACCORDING TO C&MS 109.05 FOR ALTERNATIVE CONSTRUCTION PROCEDURES THAT THE ENGINEER DETERMINES ARE NECESSARY TO REDUCE VIBRATIONS.

ITEM SPECIAL - STRUCTURES MISC .: PRECONSTRUCTION CONDITION SURVEY

BEFORE TEMPORARY SHEET PILING INSTALLATION BEGINS, CONDUCT A CONDITION SURVEY OF ALL EXISTING BUILDINGS, STRUCTURES, AND UTILITIES WITHIN 200-FT OF THE TEMPORARY SHEET PILING INSTALLATION WORK. THE PURPOSE OF THE SURVEY IS TO DOCUMENT THE CONDITION OF THE BUILDINGS, STRUCTURES, OR UTILITIES PRIOR TO TEMPORARY SHEET PILING INSTALLATION, SO THAT CLAIMS OF DAMAGE CAUSED BY THE TEMPORARY SHEET PILING INSTALLATION CAN BE VERIFIED.

RETAIN AN EXPERIENCED VIBRATION SPECIALIST TO PERFORM OR SUPERVISE THE CONDITION SURVEY. USE A VIBRATION SPECIALIST THAT MEETS THE QUALIFICATION REQUIREMENTS FOR VIBRATION MONITORING.

RECORD THE CONDITION OF EXISTING STRUCTURES AND BUILDING MATERIALS, USING WRITTEN TEXT, PHOTOGRAPHS, AND VIDEO RECORDINGS. INSPECT INTÉRIOR WALLS, CEILINGS, AND FLOORS THAT ARE ACCESSIBLE. INSPECT THE EXTERIOR OF THE BUILDING THAT IS VISIBLE FROM GROUND LEVEL. ALSO RECORD THE LOCATION, SIZE, AND TYPE OF ALL CRACKS AND OTHER STRUCTURAL DEFICIENCIES.

IF OWNERS OR OCCUPANTS FAIL TO ALLOW ACCESS TO THE PROPERTY FOR THE PRECONSTRUCTION CONDITION SURVEY, SEND A CERTIFIED LETTER TO THE OWNER OR OCCUPANT. DOCUMENT THE NOTIFICATION EFFORT AND THE CERTIFIED LETTER IN THE REPORT.

SUBMIT THREE COPIES OF A REPORT TO THE ENGINEER THAT SUMMARIZES THE PRECONSTRUCTION CONDITION OF THE BUILDINGS, STRUCTURES, AND UTILITIES, AND THAT IDENTIFIES AREAS OF CONCERN.

THE DEPARTMENT WILL PAY FOR THIS ITEM AT THE CONTRACT LUMP SUM PRICE FOR ITEM SPECIAL - STRUCTURES MISC .: PRECONSTRUCTION CONDITION SURVEY.

YITEM 840 POUNDATION PRÉPARATION, AS PÉR PLAN.

WALL NO. 9 REQUIRES 4 FEET OF UNDERCUT BENEATH THE BOTTOM OF LEVELING PAD ELEVATION FROM WALL NO. 9 STA. 19+25.00 TO WALL NO. 9 STA. 20+26.97. THE EXISTING SOILS WITHIN THIS 4 FEET OF UNDERCUT SHALL BE REPLACED WITH ITEM 304 - AGGREGATE BASE AND THE UNDERCUT AND ITEM 304 MATERIAL SHALL BE PAID FOR UNDER ITEM 840 - FOUNDATION PREPARATION. AS PER PLAN.

ABBREVIATIONS

BTM. BOTTOM	JT.	JOINT
BRG. BEARING	LT.	LEFT
© CENTERLINE	MAX.	MAXIMUM
C.J. CONSTRUCTION JOIN		MINIMUM
CLR. CLEAR	MISC.	MISCELLANEOUS
CMS CONSTRUCTION AND		NUMBER
MATERIAL	P.E.J.F.	PREFORMED
<i>SPECIFICATIONS</i>		EXPANSION JOINT
CONC. CONCRETE		FILLER
CONST. CONSTRUCTION	PROP.	PROPOSED
C.P.P. CORRUGATED	R	RADIUS
PLASTIC PIPE	REINF.	REINFORCEMENT
CU YD CUBIC YARD	RT.	RIGHT
DIA. DIAMETER	SER.	SERIES
DWG. DRAWING	SQ FT	SQUARE FEET
EL. ELEVATION	SQ YD	SQUARE YARD
EST. ESTIMATED	STA.	STATION
EX. EXISTING	STD.	STANDARD
FT. FOOT/FEET	STR.	STRAIGHT
IN. INCHES	TEMP.	TEMPORARY
INV. INVERT	TYP.	TYPICAL
INC. INCREMENT	1 1 1 •	IIIIUAL
	U.N.O.	UNLESS NOTED

DESIGN AGENCY	Svetems >		400 W. NATIONWIDE BLVD., SUITE 225 COLUMBUS, OHIO 43215
REVIEWED DATE	MSL 10/28/20	REVISED STRUCTURE FILE NUMBER	N/A
DRAWN RE	Z/9	REVISED ST	
DESIGNED	209	CHECKED	ZTW
SHITING CHIMATER)	MSE WALLS NO. 4 AND 9	
~	1		

ITEM	EXTENSION	TOTAL	UNIT	DESCRIPTION	WALL NO. 4	WALL NO. 9	REFERENCE SHEET NUMBER
203	20001	274	CY	EMBANKMENT, AS PER PLAN	-	274	1 / 14
503	11101	LS		COFFERDAMS AND EXCAVATION BRACING, AS PER PLAN	_	LS	1 / 14
509	10000	84090	LB	EPOXY COATED REINFORCING STEEL	31440	52650	
511	53012	533	CY	CLASS QC2 CONCRETE, MISC.: MOMENT SLAB	200	333	13 / 14
512	10100	2104	SY	SEALING OF CONCRETE SURFACES (EPOXY-URETHANE)	792	1312	
516	13900	2014	SF	2" PREFORMED EXPANSION JOINT FILLER	802	1212	
SPECIAL	53000200	LS		STRUCTURES MISC.: VIBRATION MONITORING	-	LS	1 / 14
SPECIAL	53000200	LS		STRUCTURES MISC.: PRECONSTRUCTION CONDITION SURVEY	-	LS	1 / 14
	tuur						
840	20000	17833	SF	MECHANICALLY STABILIZED EARTH WALL	5861	11972	
840	21000	4526	CY	WALL EXCAVATION	571	3955	
840	22000	2048	SY	FOUNDATION PREPARATION	773	1275	
840	22001	342	SY	FOUNDATION PREPARATION, AS PER PLAN	-	342	1 / 14
840	23000	10428	CY	SELECT GRANULAR BACKFILL	3262	7166	
840	23050	77	CY	NATURAL SOIL	_	77	
840	25010	2037	FT	6" DRAINAGE PIPE, PERFORATED	551	1486	
840	25020	105	FT	6" DRAINAGE PIPE, NON-PERFORATED	27	78	
840	26000	1280	FT	CONCRETE COPING	401	879	
840	27000	5	DAY	ON-SITE ASSISTANCE	2	3	
840	28000	LS		SGB INSPECTION AND COMPACTION TESTING	LS	LS	
867	00100	LS		TEMPORARY WIRE FACED MECHANICALLY STABILIZED EARTH WALL	LS	LS	

CLE-32-2,33 (PHASE 8) PID No. 103957