SEE SHEET 2 FOR PROJECT LOCATIONS

LOCATION MAP

STATE OF OHIO DEPARTMENT OF TRANSPORTATION

CLE/CLI CULVERTS FY24

TATE, FRANKLIN, BATAVIA, STONELICK, AND WASHINGTON TOWNSHIPS CLERMONT AND CLINTON COUNTIES

INDEX OF SHEETS:

TITLE SHEET	1
SCHEMATIC PLAN	2
TYPICAL SECTIONS	3
GENERAL NOTES	4
DETOUR PLAN	5-6
MAINTENANCE OF TRAFFIC NOTES	7
GENERAL SUMMARY	8
PAVEMENT CALCULATIONS	9
STRUCTURES:	
CLE-50-0667	
CULVERT PLAN & DETAIL	10
CLE-133-0770	
CULVERT PLAN & PROFILE	11
CROSS SECTIONS	12-14
CLE-133-0817	
CULVERT PLAN & PROFILE	15
CROSS SECTIONS	16-19
CLE-32-1099	
CULVERT PLAN & DETAIL	20
CLI-134-0856	
CULVERT PLAN & DETAIL	21
CLI-68-0859	
CULVERT PLAN & DETAIL	22
RIGHT-OF-WAY PLANS	23-25

FEDERAL PROJECT NUMBER

E191879

RAILROAD INVOLVEMENT

PROJECT DESCRIPTION

REHABILITATION OF VARIOUS CULVERTS THROUGHOUT CLERMONT AND CLINTON COUNTY. REPLACEMENT OF TWO SMALL CULVERTS LOCATED AT CLE-133-07.70 AND CLE-133-08.17.

EARTH DISTURBED AREAS

PROJECT EARTH DISTURBED AREA: * ACRES ESTIMATED CONTRACTOR EARTH DISTURBED AREA: * ACRES NOTICE OF INTENT EARTH DISTURBED AREA: * ACRES *SEE INDIVIDUAL CULVERT PLAN SHEETS AND DETAILS.

2023 SPECIFICATIONS

THE STANDARD SPECIFICATIONS OF THE STATE OF OHIO, DEPARTMENT OF TRANSPORTATION, INCLUDING SUPPLEMENTAL SPECIFICATIONS LISTED IN THE PLANS AND CHANGES LISTED IN THE PROPOSAL SHALL GOVERN THIS IMPROVEMENT.

I HEREBY APPROVE THESE PLANS AND DECLARE THAT THE MAKING OF THIS IMPROVEMENT WILL NOT REQUIRE THE CLOSING TO TRAFFIC OF THE HIGHWAY EXCEPT AS NOTED ON SHEETS 5 & 6, AND THAT PROVISIONS FOR THE MAINTENANCE AND SAFETY OF TRAFFIC WILL BE AS SET FORTH ON THE PLANS AND ESTIMATES.

DESIGN EXCEPTIONS

CLE-133-0770 LANE WIDTH	10/24/2022	3
CLE-133-0817 LANE WIDTH SHOULDER WIDTH	10/24/2022	<i>3</i>

APPROVAL DATES

ADA DESIGN WAIVERS

NONE REQUIRED

DESIGN FEATURE


UNDERGROUND UTILITIES Contact Two Working Days Before You Dig **→** Before You Dig

PLAN PREPARED BY: OHIO DEPARTMENT OF TRANSPORTATION

DISTRICT 8 - ENGINEERING

OHIO811, 8-1-1, or 1-800-362-2764

(Non members must be called directly)

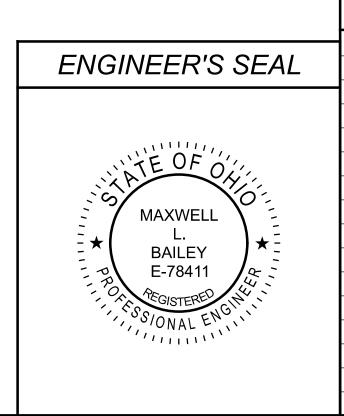

SHEET NUMBER

	STANDARD CONSTRUCTION DRAWINGS					SPECIFICATIONS	
CB-4	7/16/21 N	MT-95.30	7/19/19	7/19/19		800-2023 1/20/2	WATERWAY
		MT-95.61	4/19/19			832 10/19/18	PERMITS
DM-1.1	7/17/20	MT-97.10	4/19/19			843 10/18/19	CONDITIONS
		MT-101.60	4/26/23			878 1/21/22	08/07/23
MGS-1.1	7/16/21	MT-105.10	1/17/20				mm
MGS-2.1	1/19/18						
MGS-4.2	7/19/13	TC-61.30	7/19/19				
MGS-5.3	7/15/16						
MGS-6.1	1/19/18						
RM-1.1	1/15/21						
HW-1.1	7/20/18						
HW-2.1	7/20/18						

SUPPLEMENTAL

SPECIAL

District 08 Deputy Director

Director, Department of Transportation



ESIGNER MLB

REVIEWER TRB 11-10-22 ROJECT ID

110076