## 809 STOP-LINE RADAR DETECTION. AS PER PLAN 632 LOOP DETECTOR 809 ADVANCE RADAR DETECTION. AS PER PLAN THIS ITEM OF WORK SHALL CONSIST OF FURNISHING AND SR THIS ITEM OF WORK SHALL CONSIST OF FURNISHING AND INSTALLING A WAVETRONIX SMARTSENSOR MATRIX INSTALLING A WAVETRONIX SMARTSENSOR ADVANCE SR DETECTION UNIT. THE DETECTION UNIT SHALL INCLUDE DETECTION UNIT (MODEL SS-200E). THE DETECTION UNIT SR THE FOLLOWING SHALL INCLUDE THE FOLLOWING: SR 1. POWER SHALL BE PROVIDED FROM THE TRAFFIC CABINET. 1. POWER SHALL BE PROVIDED FROM THE TRAFFIC CABINET. SR 2. ALL REQUIRED INPUTS CARDS SHALL BE INCLUDED IN THE 2. ALL REQUIRED INPUTS CARDS SHALL BE INCLUDED IN THE TRAFFIC CABINET AND SHALL BE COMPATIBLE WITH CALTRANS, 632 LOOP DETECTOR TIE-IN TRAFFIC CABINET AND SHALL BE COMPATIBLE WITH CALTRANS, NEMA TS1 AND NEMA TS2 DETECTOR RACKS. THE CARDS SHALL NEMA TS1 AND NEMA TS2 DETECTOR RACKS. THE CARDS SHALL PROVIDE TRUE PRESENCE DETECTOR CALLS OR PROVIDE TRUE PRESENCE DETECTOR CALLS OR CONTACT CLOSURE TO THE TRAFFIC CONTROLLER. CONTACT CLOSURE TO THE TRAFFIC CONTROLLER. 3. THE UNIT SHALL BE MOUNTED DIRECTLY TO A POLE OR MAST 3. THE UNIT SHALL BE MOUNTED DIRECTLY TO A POLE OR MAST ARM, AS RECOMMENDED BY THE MANUFACTURER. CABLE(S) ARM. AS RECOMMENDED BY THE MANUFACTURER. CABLE(S) SHALL BE PROVIDED AS REQUIRED AND RECOMMENDED BY SHALL BE PROVIDED AS REQUIRED AND RECOMMENDED BY THE MANUFACTURER. THE MANUFACTURER. ADA WAIVER 4. SURGE PROTECTION DEVICES, AS RECOMMENDED BY THE 4. SURGE PROTECTION DEVICES, AS RECOMMENDED BY THE MANUFACTURER SHALL BE INCLUDED BOTH AT THE POLE MANUFACTURER SHALL BE INCLUDED BOTH AT THE POLE WHERE THE UNIT IS LOCATED TO PROTECT THE UNIT AND WHERE THE UNIT IS LOCATED TO PROTECT THE UNIT AND IN IN THE TRAFFIC CABINET TO PROTECT THE CABINET THE TRAFFIC CABINET TO PROTECT THE CABINET ELECTRONICS. ELECTRONICS. 5. THE MANUFACTURER'S REPRESENTATIVE SHALL BE ON SITE 5. THE MANUFACTURER'S REPRESENTATIVE SHALL BE ON SITE DURING INSTALLATION AND TESTING AND SHALL PROVIDE DURING INSTALLATION AND TESTING AND SHALL PROVIDE ONSITE TRAINING ON THE SETUP, OPERATION AND ONSITE TRAINING ON THE SETUP, OPERATION AND MAINTENANCE OF THE UNIT MAINTENANCE OF THE UNIT. 6. A SERIAL TO ETHERNET COMMUNICATIONS MODULE AND 6. A SERIAL TO ETHERNET COMMUNICATIONS MODULE AND ETHERNET CABLE (MINIMUM 7 FEET). ETHERNET CABLE (MINIMUM 7 FEET). 7. THE POWER SUPPLY AND COMMUNICATION MODULES SHALL 7. THE POWER SUPPLY AND COMMUNICATION MODULES SHALL CLE-125-6.032 RMP0007709 BE SECURED TO A SINGLE PANEL THAT CAN BE MOUNTED BE SECURED TO A SINGLE PANEL THAT CAN BE MOUNTED INTERIOR TO THE TRAFFIC CABINET. THE PANEL SHALL INTERIOR TO THE TRAFFIC CABINET. THE PANEL SHALL INCLUDE MODULAR-PLUG STYLE CONNECTIONS FOR UP TO INCLUDE MODULAR-PLUG STYLE CONNECTIONS FOR UP TO FOUR (4) SENSOR CABLES, ADDITIONAL SENSORS MAY BE FOUR (4) SENSOR CABLES. ADDITIONAL SENSORS MAY BE HARD-WIRED TO THE COMMUNICATION MODULES, AS HARD-WIRED TO THE COMMUNICATION MODULES. AS NECESSARY. NECESSARY. 8. THE CONTRACTOR SHALL INSTALL THE RADAR DETECTION 8. THE INSTALLATION SHALL INCLUDE ALL CONTROLLER PROGRAMMING FOR COMPLETE INSTALLATION. WHICH PRIOR TO MILLING/DISABLING EXISTING LOOPS. INCLUDES MODIFICATIONS FOR REMOVAL OF EXISTING 9. THE INSTALLATION SHALL INCLUDE ALL CONTROLLER DETECTION. PROGRAMMING FOR COMPLETE INSTALLATION, WHICH 9. UNLASHING AND RELASHING OF THE SIGNAL SPAN TO INCLUDES MODIFICATIONS FOR REMOVAL OF EXISTING INSTALL THE NECESSARY CABLING. DETECTION. 10. DISCONNECT ALL LOOP LEAD-IN CABLE AND REMOVE 10. UNLASHING AND RELASHING OF THE SIGNAL SPAN TO AND DISPOSE OF IT FROM ALL PULL BOXES. CONDUITS. INSTALL THE NECESSARY CABLING. AND THE CABINET AFTER IT IS CONFIRMED THAT THE RADAR UNITS ARE WORKING. EXISTING PULL BOXES 11. DISCONNECT ALL LOOP LEAD-IN CABLE AND REMOVE AND CONDUITS SHALL REMAIN IN PLACE. AND DISPOSE OF IT FROM ALL PULL BOXES. CONDUITS. AND THE CABINET AFTER IT IS CONFIRMED THAT THE RADAR UNITS ARE WORKING. EXISTING PULL BOXES AND CONDUITS SHALL REMAIN IN PLACE. PAYMENT FOR ITEM 809 STOP-LINE RADAR DETECTION, AS PER PAYMENT FOR ITEM 809 ADVANCE RADAR DETECTION. AS PER PLAN SHALL BE MADE AT THE CONTRACT UNIT PRICE FOR EACH PLAN SHALL BE MADE AT THE CONTRACT UNIT PRICE FOR EACH UNIT, COMPLETE AND IN PLACE INCLUDING ALL REQUIRED UNIT, COMPLETE AND IN PLACE INCLUDING ALL REQUIRED CABINET HARDWARE, MOUNTING BRACKETS, CABLES, CONDUIT, CABINET HARDWARE, MOUNTING BRACKETS, CABLES, CONDUIT AND CONNECTIONS TESTED AND ACCEPTED. CONNECTIONS TESTED AND ACCEPTED, AND ANY OTHER NECESSARY HARDWARE TO ESTABLISH A FULLY FUNCTIONAL DETECTION SYSTEM. SR 125 @ LORI LANE/HICKS LANE/KROGERS 4 EACH SR 125 @ LORI LANE/HICKS LANE/KROGERS 2 FACH <del>Maria</del>

 $\infty$ 

ഹ

25-

SR

ய்

5

R 125 @ CHAPEL RD./OAK ST./JENNY LIND RD.	5 EACH
R 125 @ S. KLINE AVE	1 EACH
R 125 @ CECELIA DR./HUNTSMAN TRACE	6 EACH
R 125 @ WALMART/MARTIN DR.	1 EACH
R 125 @ MT. HOLLEY LINDALE RD.	6 EACH


SR 125 @ CHAPEL RD./OAK ST./JENNY LIND RD.	5 EACH
SR 125 @ S. KLINE AVE	1 EACH
SR 125 @ CECELIA DR./HUNTSMAN TRACE	6 EACH
SR 125 @ WALMART/MARTIN DR.	1 EACH
SR 125 @ MT. HOLLEY LINDALE RD.	6 EACH

AN APPROVED ADA DESIGN WAIVER IS REQUIRED ON THIS PROJECT. THE FOLLOWING FEATURES LISTED BELOW CANNOT FEASIBLY BE CONSTRUCTED TO MEET ADA GUIDELINES.

ADA FEATL	ADA DESIGN JRE APPROV		SHEET NUMBERS						
CLE-125-6.236 RN CLE-125-6.133 RN CLE-125-6.740 RN CLE-125-6.095 RN	ИРООО7705 ИРООО7706 ИРООО7707 ИРООО7708	7/9/21 7/9/21 7/9/21 7/9/21 7/9/21	SHEET 19 SHEET 19 SHEET 20 SHEET 19	CLEVELAND STREET CHURCH STREET FLORAL AVE CLEVELAND STREET HOPKINS AVE KUINE AVE					

ALL CROSSWALKS SHALL BE UPGRADED TO HIGH VISIBILITY EXCEPT CROSSWALKS AT THE INTERSECTION OF WOODLANDS DR.

e ententito dento	
uuu	

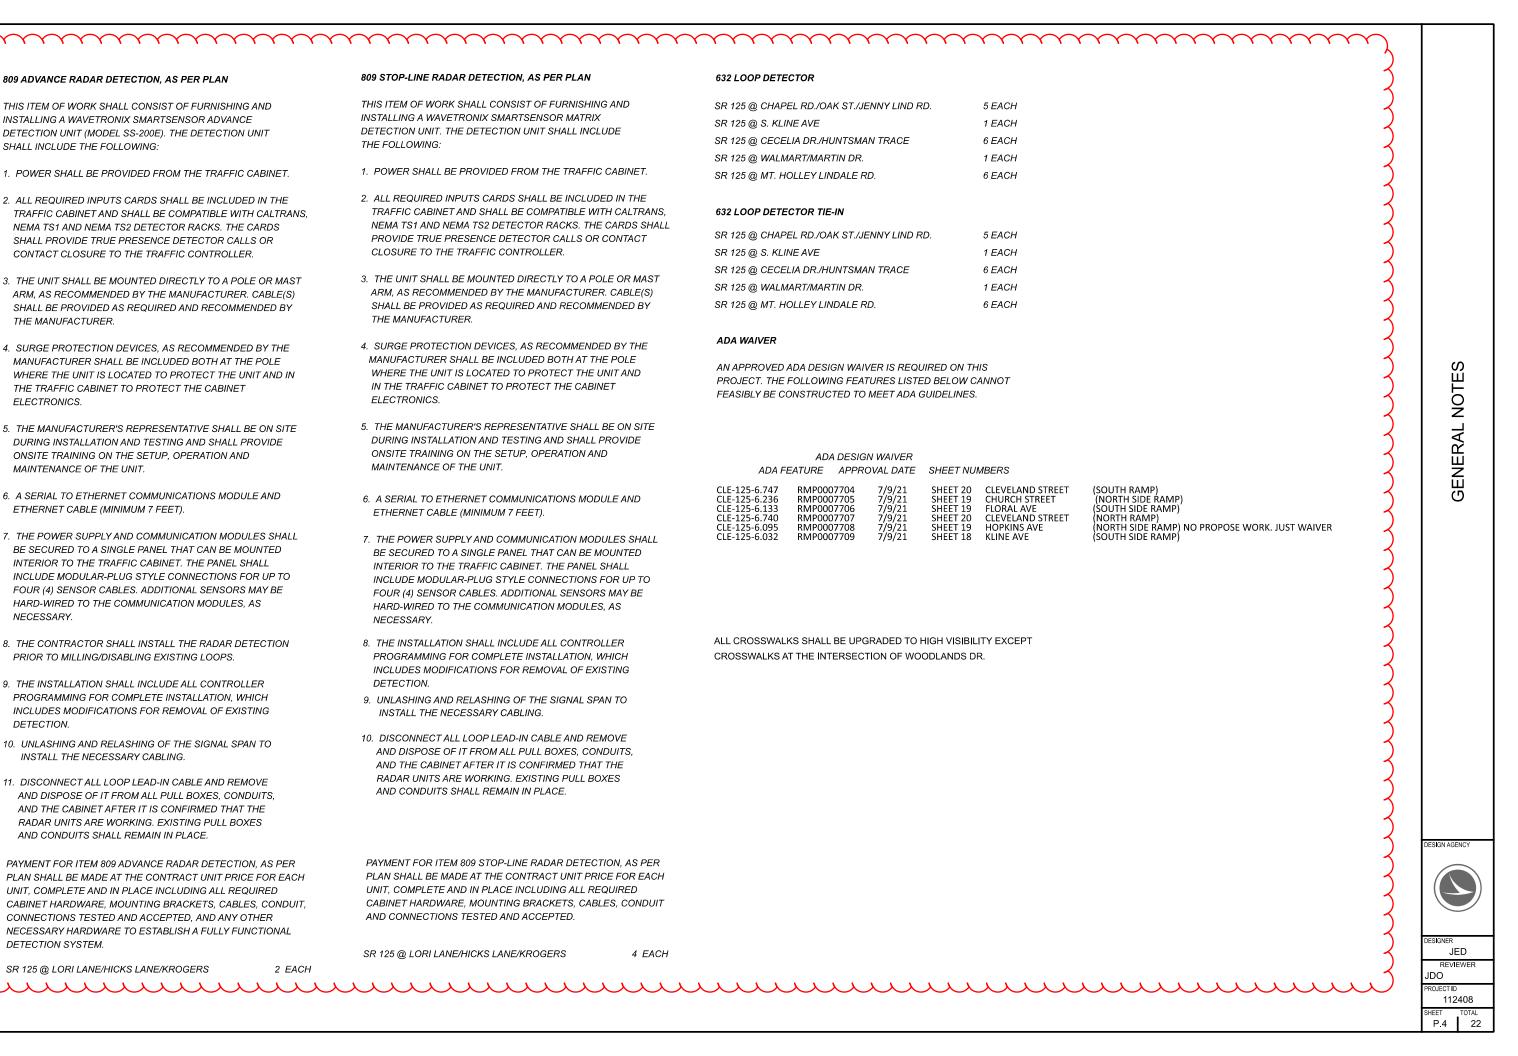

			,		SHEE	T NUM.						PART.		ITEM	ITEM	GRAND	UNIT	
	3	4	5	8	9	10	11	12	13	14	01/NHS/PV	02/NHS/CV	03/NHS/BR		EXT	TOTAL		
	923 923										923 923			621 621	00100 54000	923 923	EACH EACH	RPM RAISED PAVEMENT MARKER REMOVED
	323								730		730			644	00500	730	FT	STOP LINE
									2,261		2,261			644	00600	2,261	FT	CROSSWALK LINE
									180		180			644	00700	180	FT	TRANSVERSE/DIAGONAL LINE
									40		40			644	00900	40	SF	ISLAND MARKING
									4		4			644	01110	4	EACH	SCHOOL SYMBOL MARKING, 96"
									92		92			644 644	01300	92	EACH EACH	LANE ARROW WORD ON PAVEMENT, 96"
									7.64		7.64			807	13010	7.64	MILE	WET REFLECTIVE SPRAY THERMOPLASTIC
									7.64		 7.64			807	13110	7.64	MILE	WET REFLECTIVE SPRAY THERMOPLASTIC
									8.91		8.91			807	13110	8.91	MILE	WET REFLECTIVE SPRAY THERMOPLASTIC
									2,360		2,360			807	10310	2,360	FT	WET REFLECTIVE TRAFFIC PAINT, CHANNE
									12.32 15.28		12.32 15.28			850 850	10000 10010	12.32 15.28	MILE	GROOVING FOR 4" RECESSED PAVEMENT N GROOVING FOR 6" RECESSED PAVEMENT N
									13.20		13.20			000	10010	15.20		
									2,600		2,600			850	20130	2,600	FT	GROOVING FOR 12" RECESSED PAVEMENT
														$\sim$	$\sim$	$\sim$	$\sim$	
		19									19			632	26500	19	EACH	DETECTOR LOOP
		19									19			632	27200	19	EACH	LOOP DETECTOR TIE IN
		2									 2			80	69001 69101	131	EACH	ADVANCE RADAR DETECTION, AS PER PLA
																•		
																		STRUCTURE REP
		500											500	843	50000	500	SF	PATCHING CONCRETE STRUCTURES WITH
																		MA
			14.8								14.8			614	20110	14.8	MILE	WORK ZONE LANE LINE, CLASS I, 6", 642 PA
			17.44								 17.44			614	21100	17.44	MILE	WORK ZONE CENTER LINE, CLASS I, 642 PA
			15.28 4,720								15.28 4,720			614 614	22110 23200	15.28 4,720	MILE FT	WORK ZONE EDGE LINE, CLASS I, 6", 642 PA WORK ZONE CHANNELIZING LINE, CLASS I,
			1,396								1,396			614	26200	1,396	FT	WORK ZONE STOP LINE, CLASS I, 642 PAIN
			3,642								 3,642			614	27200	3,642	FT	WORK ZONE CROSSWALK LINE, CLASS I, 64
			176								176			614	30200	176	EACH	WORK ZONE ARROW, CLASS I, 642 PAINT
											LUMP	LUMP	LUMP	614	11000	LS		
											LUMP LUMP	LUMP LUMP	LUMP LUMP	623 624	10001 10000	LS LS		CONSTRUCTION LAYOUT STAKES AND SUR MOBILIZATION
+																		

		_	
	055		
DESCRIPTION	SEE SHEET NO.		
TRAFFIC CONTROL			
		1	
TIC PAVEMENT MARKING, EDGE LINE, 6"			~
		ĺ	Ŷ
TIC PAVEMENT MARKING, LANE LINE, 6"			GENERAL SUMMARY
TIC PAVEMENT MARKING, CENTER LINE			$\geq$
INELIZING LINE, 12"		1 1	2
IT MARKING, (ASPHALT)		ā	กั
IT MARKING, (ASPHALT)		-	Ļ
ENT MARKING, (ASPHALT)			
		ĭ	Ш
TRAFFIC SIGNALS	$\sim$		Z I
			<u>п</u>
		) `	•
PLAN X X X X X X X X X X X X X X X X X X X	4	)	
PLAN	$\overline{4}$	Í	
REPAIR (CLE-SR 125-5.13 BRIDGE NO. 0594)			
TH TROWELABLE MORTAR			
MAINTENANCE OF TRAFFIC			
PAINT			
2 PAINT			
S I, 8", 642 PAINT		1	
AINT			
		1	
I, 642 PAINT T		1	
INCIDENTALS			
URVEYING, AS PER PLAN	3	1	
	5	DESIGN AG	ENCY
		DESIGNER	
		JI REVI	ED EWER
		JDO	,
		PROJECT ID	
		SHEET	2408 TOTAL
		P.7	22