



DETAIL A

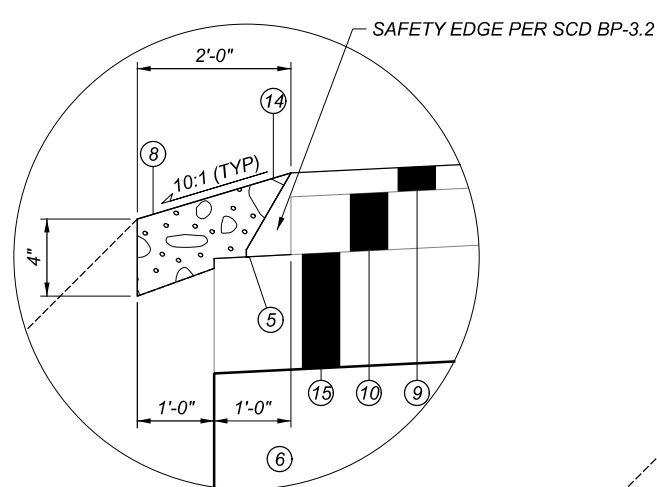


DETAIL B

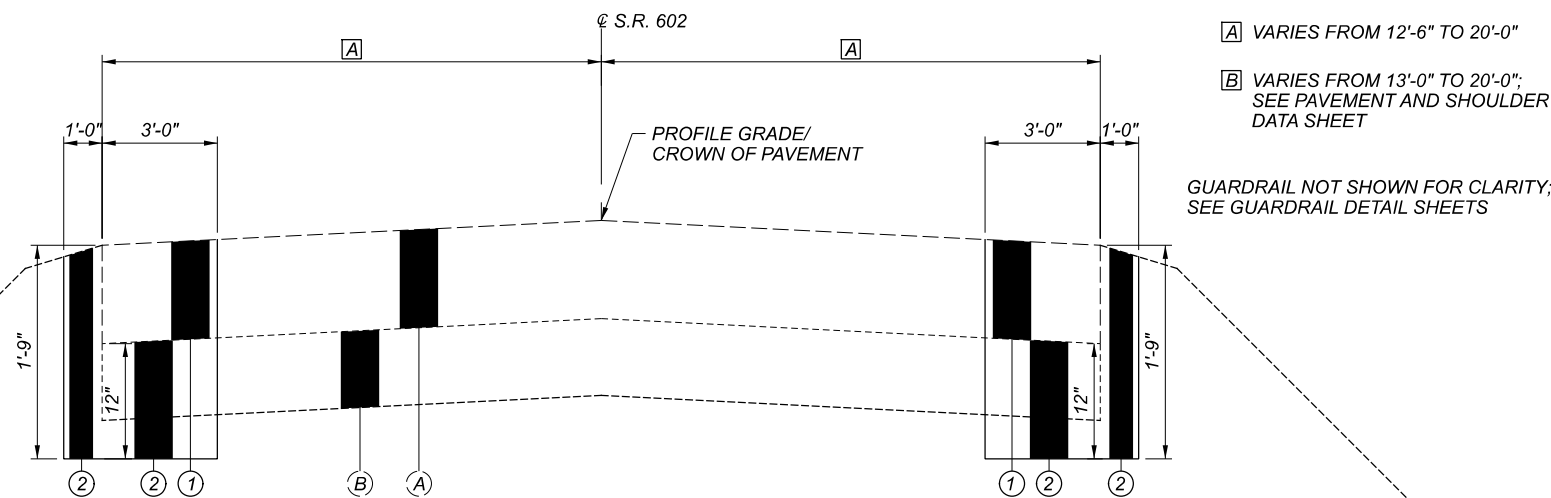

EXCAVATION TYPICAL SECTION

APPLIES TO: CRA-602-4.25 TO 13.64  
 APPROACH SLABS NOT SHOWN FOR CLARITY

[A] VARIES FROM 12'-6" TO 20'-0"  
 [B] VARIES FROM 13'-0" TO 20'-0";  
 SEE PAVEMENT AND SHOULDER  
 DATA SHEET  
 GUARDRAIL NOT SHOWN FOR CLARITY;  
 SEE GUARDRAIL DETAIL SHEETS

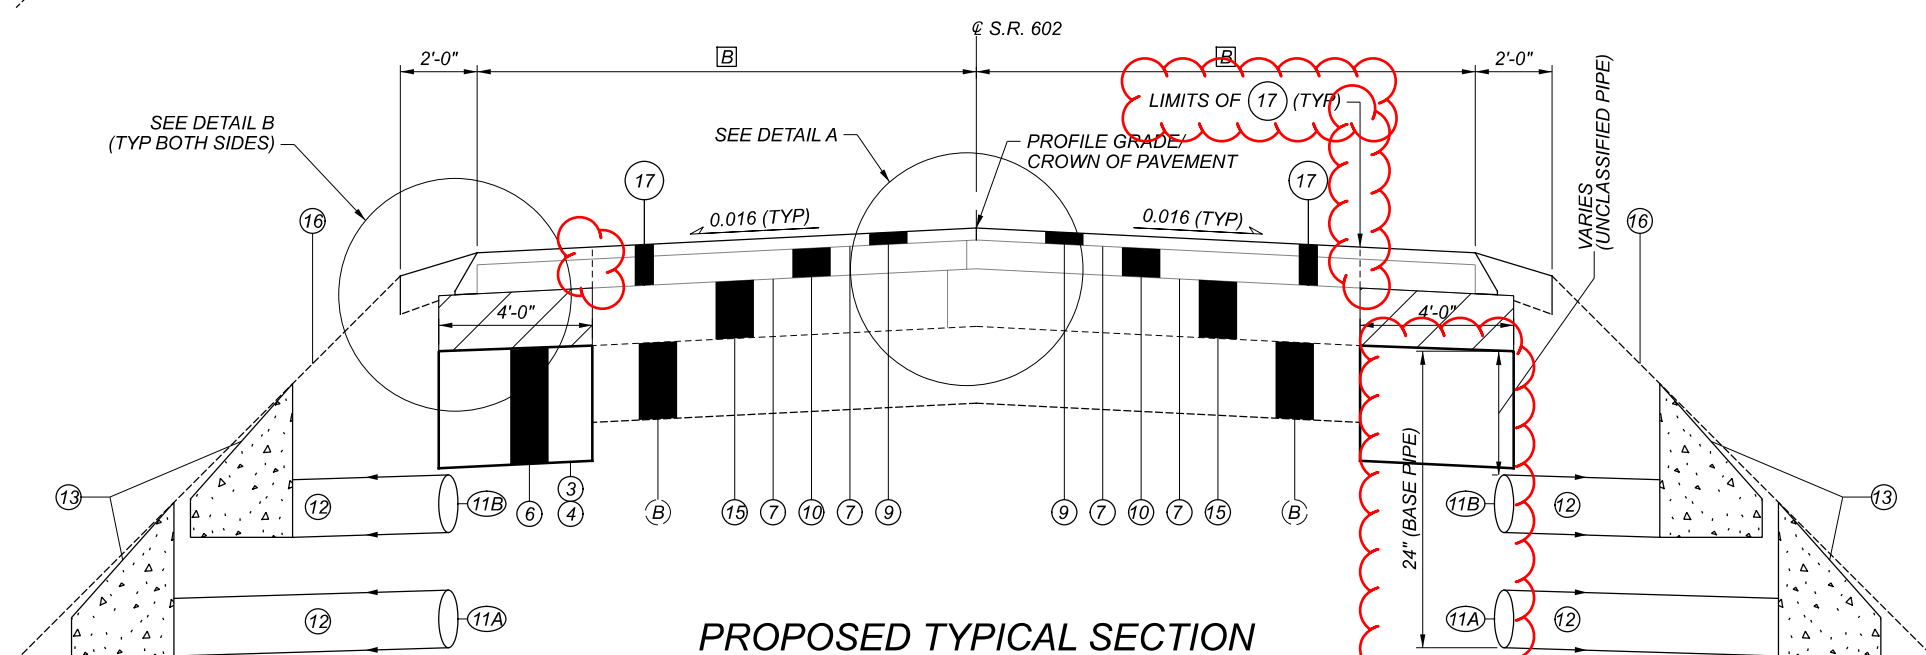

PROPOSED TYPICAL SECTION

APPLIES TO: CRA-602-4.25 TO 5.98  
 CRA-602-6.02 TO 9.49  
 CRA-602-9.51 TO 13.64

**PROPOSED LEGEND**


- ① ITEM 202 - PAVEMENT REMOVED (10.25"±)
- ② ITEM 203 - EXCAVATION (12" - 21" DEEP)
- ③ ITEM 204 - SUBGRADE COMPACTION
- ④ ITEM 204 - GEOGRID
- ⑤ ITEM 209 - PREPARING SUBGRADE FOR SHOULDER PAVING
- ⑥ ITEM 304 - AGGREGATE BASE (12" THICK)
- ⑦ ITEM 407 - TACK COAT (0.06 GAL/SY)
- ⑧ ITEM 408 - PRIME COAT, AS PER PLAN
- ⑨ ITEM 442 ASPHALT CONCRETE SURFACE COURSE, 9.5MM, TYPE A, (446), AS PER PLAN, PG64-22 (1.25")
- ⑩ ITEM 442 ASPHALT CONCRETE INTERMEDIATE COURSE, 19MM, TYPE A, (446), AS PER PLAN, PG64-22 (3.00")
- ⑪A ITEM 605 - 6" BASE PIPE UNDERDRAINS, AS PER PLAN (SEE UNDERDRAIN DATA SHEET FOR LOCATIONS)
- ⑪B ITEM 605 - 6" UNCLASSIFIED PIPE UNDERDRAINS
- ⑫ ITEM 611 - 6" CONDUIT, TYPE F FOR UNDERDRAIN OUTLETS
- ⑬ ITEM 611 - PRECAST REINFORCED CONCRETE OUTLET
- ⑭ ITEM 617 - COMPACTED AGGREGATE (4.00" THICK)
- ⑮ ITEM 690 - SPECIAL - FULL DEPTH RECLAIMED BASE COURSE, 6.00 INCHES DEEP
- ⑮ ITEM 690 - SPECIAL - EMULSIFIED ASPHALT
- ⑮ ITEM 690 - SPECIAL - ADDITIONAL ADDITIVES (CEMENT, FLY ASH, LIME)
- ⑮ ITEM 690 - SPECIAL - CORRECTIVE AGGREGATE FOR FDR (FINE, COARSE OR RAP)
- ⑮ ITEM 690 - SPECIAL - MIXTURE DESIGN FOR FULL DEPTH RECLAIMED BASE COURSE
- ⑯ ITEM 209 - LINEAR GRADING (6' AVERAGE WIDTH)
- ⑰ ITEM 202 - PAVEMENT REMOVED, AS PER PLAN (4.25" THICK), TO BE INCORPORATED INTO ITEM 690 - FULL DEPTH RECLAIMED BASE COURSE, 6.00 INCHES DEEP

**EXISTING LEGEND**


- (A) EXISTING ASPHALT PAVEMENT (10.25"±)
- (B) EXISTING MACADAM BASE (8.00"±)
- (C) EXISTING APPROACH SLAB (13.00"±)

VERTICAL DIMENSIONS SHOWN ON THIS SHEET EXAGGERATED BY A FACTOR OF 3.


DESIGN AGENCY	DISTRICT 3
ENGINEERING TEAM FOUR	
DESIGNER	JNC
REVIEWER	NRF
PROJECT ID	102939
SHEET	TOTAL
3	38

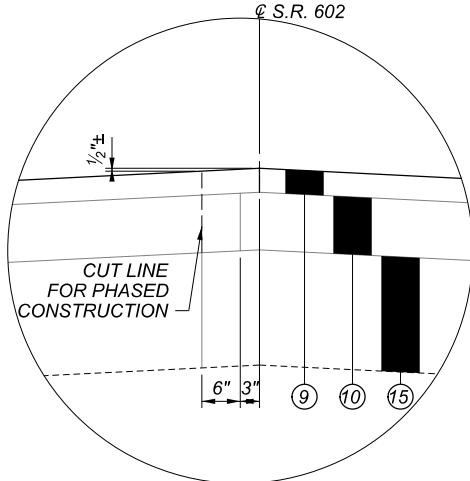

DETAIL A

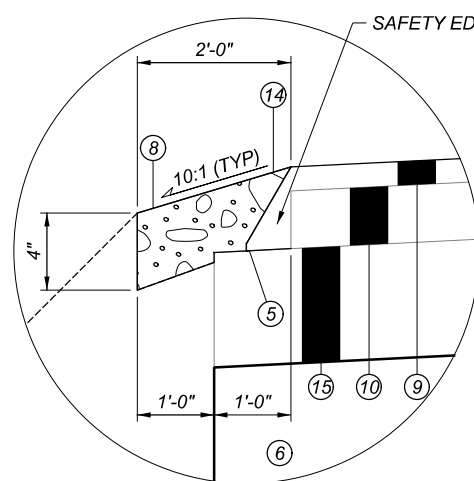

DETAIL B

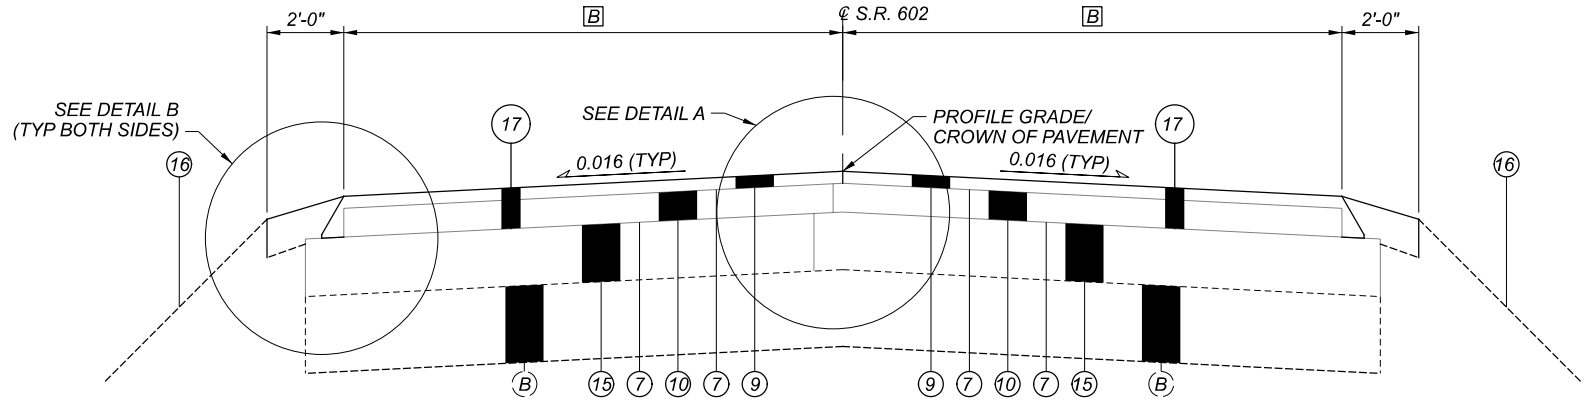

**PROPOSED TYPICAL SECTION**

APPLIES TO: 10' BEFORE AND AFTER CULVERTS AT THE FOLLOWING LOCATIONS:  
 CRA-602-4.36 CRA-602-7.86 CRA-602-4.58 CRA-602-8.24  
 CRA-602-4.93 CRA-602-8.43 CRA-602-5.68 CRA-602-8.93  
 CRA-602-5.77 CRA-602-9.19 CRA-602-6.26 CRA-602-10.50  
 CRA-602-6.74

[A] VARIES FROM 12'-6" TO 20'-0"  
 [B] VARIES FROM 13'-0" TO 20'-0";  
 SEE PAVEMENT AND SHOULDER  
 DATA SHEET  
 GUARDRAIL NOT SHOWN FOR CLARITY;  
 SEE GUARDRAIL DETAIL SHEETS

**PROPOSED LEGEND**


- ① ITEM 202 - PAVEMENT REMOVED (10.25"±)
- ② ITEM 203 - EXCAVATION (12" - 21" DEEP)
- ③ ITEM 204 - SUBGRADE COMPACTION
- ④ ITEM 204 - GEOGRID
- ⑤ ITEM 209 - PREPARING SUBGRADE FOR SHOULDER PAVING
- ⑥ ITEM 304 - AGGREGATE BASE (12" THICK)
- ⑦ ITEM 407 - TACK COAT (0.06 GAL/SY)
- ⑧ ITEM 408 - PRIME COAT, AS PER PLAN
- ⑨ ITEM 442 ASPHALT CONCRETE SURFACE COURSE, 9.5MM, TYPE A, (446), AS PER PLAN, PG64-22 (1.25")
- ⑩ ITEM 442 ASPHALT CONCRETE INTERMEDIATE COURSE, 19MM, TYPE A, (446), AS PER PLAN, PG64-22 (3.00")
- ⑪A ITEM 605 - 6" BASE PIPE UNDERDRAINS, AS PER PLAN (SEE UNDERDRAIN DATA SHEET FOR LOCATIONS)
- ⑪B ITEM 605 - 6" UNCLASSIFIED PIPE UNDERDRAINS
- ⑫ ITEM 611 - 6" CONDUIT, TYPE F FOR UNDERDRAIN OUTLETS
- ⑬ ITEM 611 - PRECAST REINFORCED CONCRETE OUTLET
- ⑭ ITEM 617 - COMPACTED AGGREGATE (4.00" THICK)
- ⑮ ITEM 690 - SPECIAL - FULL DEPTH RECLAIMED BASE COURSE, 6.00 INCHES DEEP
- ITEM 690 - SPECIAL - EMULSIFIED ASPHALT
- ITEM 690 - SPECIAL - ADDITIONAL ADDITIVES (CEMENT, FLY ASH, LIME)
- ITEM 690 - SPECIAL - CORRECTIVE AGGREGATE FOR FDR (FINE, COARSE OR RAP)
- ITEM 690 - SPECIAL - MIXTURE DESIGN FOR FULL DEPTH RECLAIMED BASE COURSE
- ⑯ ITEM 209 - LINEAR GRADING (6' AVERAGE WIDTH)
- ⑰ ITEM 202 - PAVEMENT REMOVED, AS PER PLAN (4.25" THICK)

6" THICK ASPHALT CONCRETE GRINDINGS RETAINED FROM ITEM 202 - PAVEMENT REMOVED AS PER PLAN (4.25" THICK), TO BE INCORPORATED INTO ITEM 690 - FULL DEPTH RECLAIMED BASE COURSE, 6.00 INCHES DEEP

**EXISTING LEGEND**

- (A) EXISTING ASPHALT PAVEMENT (10.25"±)
- (B) EXISTING MACADAM BASE (8.00"±)
- (C) EXISTING APPROACH SLAB (13.00"±)

VERTICAL DIMENSIONS SHOWN ON THIS SHEET EXAGGERATED BY A FACTOR OF 3.

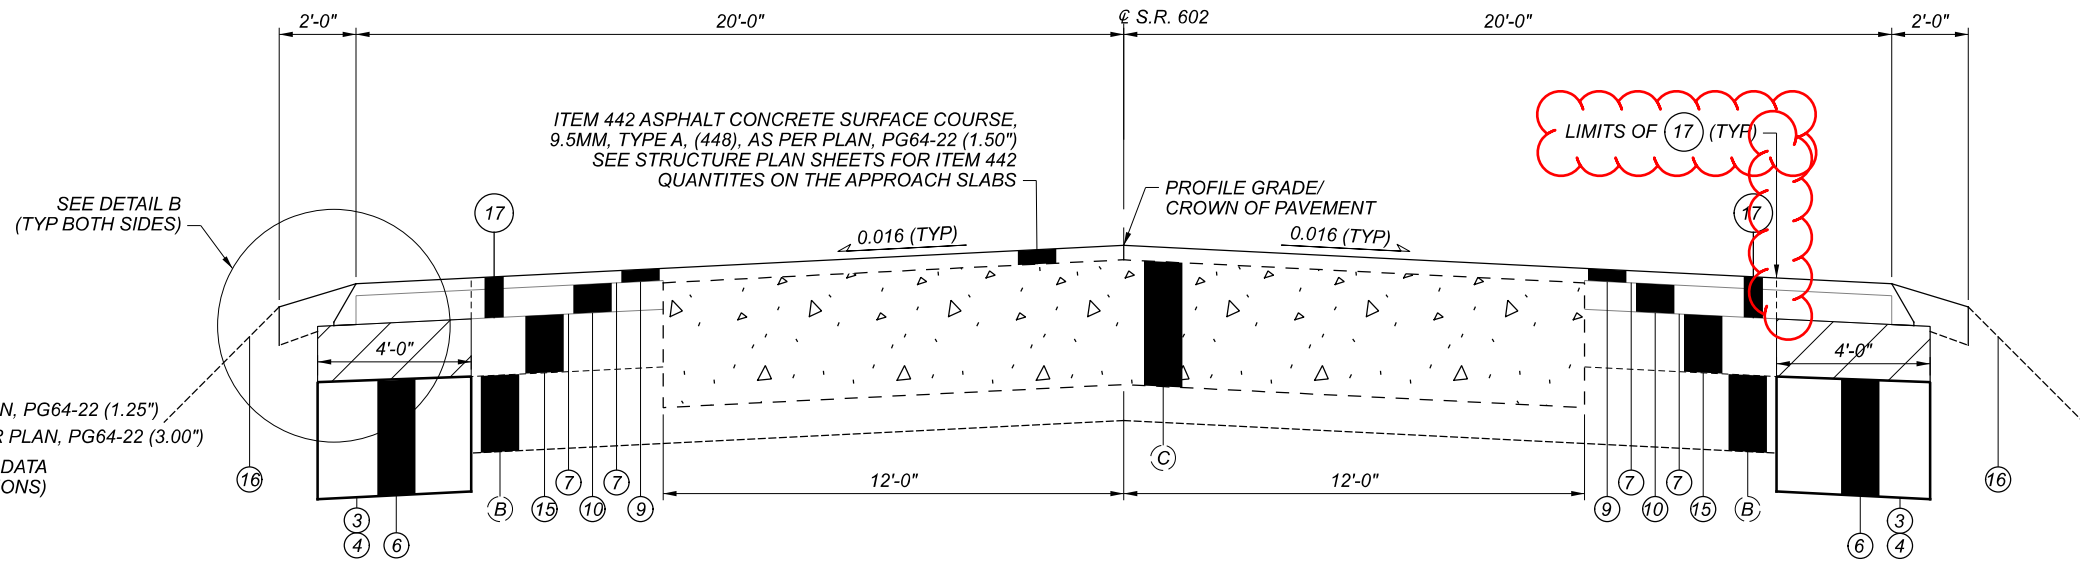

**PROPOSED TYPICAL SECTION AT APPROACH SLABS, STRUCTURE CRA-602-0949**

APPLIES TO: CRA-602-9.49 (25 FT) CRA-602-9.51 (25 FT)

DESIGN AGENCY  
 DISTRICT 3

ENGINEERING  
 TEAM FOUR

DESIGNER  
 JNC

REVIEWER  
 NRF 12-06-21

PROJECT ID  
 102939

SHEET TOTAL  
 4 38

**ITEM 202 - ANCHOR ASSEMBLY REMOVED, TYPE A**

THIS ITEM SHALL INCLUDE THE REMOVAL OF THE EXISTING TYPE A, ANCHOR ASSEMBLY INCLUDING ALL POSTS, HARDWARE, RAIL ELEMENTS, AND CONCRETE ANCHORS. ALL ITEMS REMOVED SHALL BECOME THE PROPERTY OF THE CONTRACTOR AND SHALL BE PROPERLY DISPOSED OF.

THE EXISTING CONCRETE ANCHOR AND CONCRETE AT POSTS SHALL BE REMOVED ENTIRELY. ALL HOLES REMAINING AFTER REMOVAL SHALL BE FILLED WITH GRANULAR MATERIAL OR EXCESS MATERIAL RESULTING FROM GUARDRAIL CONSTRUCTION. ALL FILL MATERIAL SHALL BE THOROUGHLY COMPACTED AND LEVELED, AS DIRECTED BY THE ENGINEER.

PAYMENT FOR ALL OF THE ABOVE SHALL BE INCLUDED IN THE UNIT BID PRICE FOR ITEM 202, ANCHOR ASSEMBLY REMOVED, TYPE A.

**ITEM 606 - ANCHOR ASSEMBLY, TYPE E  
ITEM 606 - ANCHOR ASSEMBLY, MGS TYPE E (MASH 2016)**

THESE ITEMS SHALL CONSIST OF FURNISHING AND INSTALLING ANY OF THE GUARDRAIL END TERMINALS AS LISTED ON ROADWAY ENGINEERING'S WEB PAGE UNDER ROADSIDE SAFETY DEVICES FOR APPROVED GUARDRAIL END TREATMENTS, FOR AN ASSOCIATED GUARDRAIL TYPE. INSTALLATION SHALL BE AT THE LOCATIONS SPECIFIED IN THE PLANS, IN ACCORDANCE WITH THE MANUFACTURER'S SPECIFICATIONS.

THE FACE OF THE TYPE E IMPACT HEAD SHALL BE COVERED WITH A SHEET OF TYPE G REFLECTIVE SHEETING, PER CMS 730.19.

THE CONTRACTOR MAY USE A SALVAGED EXTRUDER WHEN ASSEMBLING THE ITEM 606 ANCHOR ASSEMBLY, TYPE E OR ITEM 606 ANCHOR ASSEMBLY, MGS TYPE E. ALL WELDS ON THE EXTERIOR OF THE SALVAGED EXTRUDER SHALL NOT BE DAMAGED AND THE FEEDER SHUTE SHALL NOT BE BENT.

REFER TO THE MANUFACTURER'S INSTRUCTIONS REGARDING THE INSTALLATION OF, AND THE GRADING AROUND, THE FOUNDATION TUBES AND GROUND STRUT. THE TOP OF ANY FOUNDATION TUBE SHOULD BE LESS THAN 4 INCHES ABOVE THE GROUND. THE PLACEMENT OF THE FOUNDATION TUBES SHOULD BE AN APPROPRIATE DEPTH BELOW THE LEVEL LINE IN ORDER TO MAINTAIN THE FINISHED GUARDRAIL HEIGHT OF 27 3/4 INCHES FROM THE EDGE OF THE SHOULDER. ON SITE GRADING IS REQUIRED IF THE TOP OF THE FOUNDATION TUBES OR TOP OF THE GROUND STRUT PROJECT MORE THAN 4 INCHES ABOVE THE GROUND LINE.

PAYMENT FOR THE ABOVE WORK SHALL BE MADE AT THE UNIT PRICE BID FOR ITEM 606, ANCHOR ASSEMBLY, TYPE E, EACH, AND SHALL INCLUDE ALL LABOR, TOOLS, EQUIPMENT AND MATERIALS NECESSARY TO CONSTRUCT A COMPLETE AND FUNCTIONAL ANCHOR ASSEMBLY SYSTEM, INCLUDING ALL RELATED TRANSITIONS, REFLECTIVE SHEETING, HARDWARE, GRADING, EMBANKMENT AND EXCAVATION NOT SEPARATELY SPECIFIED, AS REQUIRED BY THE MANUFACTURER.

ALL TYPE E ANCHOR ASSEMBLIES SUPPLIED ON THIS PROJECT SHALL MEET THE REQUIREMENTS OF MASH 2016 TESTING.

**CONNECTION BETWEEN EXISTING AND PROPOSED GUARDRAIL**

WHEN IT IS NECESSARY TO SPLICE PROPOSED GUARDRAIL TO EXISTING GUARDRAIL, ONLY THE EXISTING GUARDRAIL SHALL BE CUT, DRILLED, OR PUNCHED. THE CONNECTION SHALL BE MADE USING A W-BEAM, BEAM SPLICE AS SHOWN IN AASHTO M 180-12, EXCEPT THE BEAM WASHERS ARE NOT TO BE USED. PAYMENT SHALL BE INCLUDED IN THE CONTRACT PRICE FOR THE RESPECTIVE GUARDRAIL ITEMS.

**ITEM 203 - EMBANKMENT, AS PER PLAN**

THE INTENT OF ITEM 203 - EMBANKMENT, AS PER PLAN, IS TO REPAIR WASHED-OUT OR OTHERWISE DEFICIENT SHOULDER LOCATIONS IDENTIFIED ON THE GUARDRAIL DETAIL SHEETS AND AS DIRECTED BY THE ENGINEER. PLACE AND COMPACT ACCORDING TO C&MS 203, TO MATCH SURROUNDING SLOPES AND PROVIDE ACCEPTABLE SLOPE AND ELEVATION UNDERNEATH AND SURROUNDING EXISTING OR PROPOSED GUARDRAIL.

PERFORM THE ABOVE WORK PRIOR TO PERFORMING ITEM 209 - PREPARATION FOR SHOULDER PAVING AND PLACEMENT OF ITEM 617 - COMPACTED AGGREGATE.

PAYMENT SHALL INCLUDE ALL LABOR, EQUIPMENT, AND MATERIALS NECESSARY TO COMPLETE THE WORK DESCRIBED ABOVE. PAYMENT WILL BE MADE AT THE UNIT BID PRICE PER CUBIC YARD OF ITEM 203 - EMBANKMENT, AS PER PLAN.

**ITEM 659 - SEEDING AND MULCHING**

THE FOLLOWING QUANTITIES ARE PROVIDED TO PROMOTE GROWTH AND CARE OF PERMANENT SEEDED AREAS:

659	COMMERCIAL FERTILIZER	0.93	TON
659	LIME	1.38	ACRE
659	WATER	37	M GAL
659	REPAIR SEEDING AND MULCHING	334	SQ YD
659	INTERSEEDING	334	SQ YD
659	TOPSOIL	741	CU YD
659	SOIL ANALYSIS TEST	2	EACH
659	SEEDING AND MULCHING	6672	SQ YD

SEEDING AND MULCHING SHALL BE APPLIED TO ALL AREAS OF PLACED ITEM 203 - EMBANKMENT, AS PER PLAN, AND ITEM 670 - SLOPE EROSION PROTECTION. QUANTITY CALCULATIONS FOR SEEDING AND MULCHING ARE BASED ON THESE LIMITS. QUANTITIES ARE CARRIED TO THE GENERAL SUMMARY.

**AC GAUGE OFFSET**

FOLLOW 403, EXCEPT AS FOLLOWS:

- OFFSET THE AC GAUGE FOR EACH JMF FOR THE PROJECT PRIOR TO THE PROJECT'S START USING 403.06.A. AND THE MODIFIED SUPPLEMENT 1043 PROCEDURE BELOW.
- DURING S-1043.07 PROCESS, A RAP SAMPLE OBTAINED FROM THE JMF-DESIGNATED RAP PILE WILL BE EXTRACTED IN THE ASPHALT LEVEL 3 LAB TO VERIFY THE RAP AC %. THE RAP AC % WILL BE WITHIN 0.3% OF THE AVERAGE RAP AC % FROM THE JMF. IF RAP AC % IS OUTSIDE OF THE 0.3%, THE VERIFICATION PAN PROCESS WILL STOP, AND DISTRICT TESTING WILL ALLOW ONE OPPORTUNITY TO REWORK THE RAP PILE AT THE MIX PLANT AND RESAMPLE. RESAMPLING REQUIRES DISTRICT TESTING TO BE PRESENT. IF THE RESAMPLE IS STILL OUTSIDE OF THE 0.3%, THE JMF WILL BE RESCINDED AND NEED TO BE REDESIGNED.

FOLLOW 403.06 EXCEPT AS FOLLOWS:

- ENSURE ASPHALT BINDER CONTENT DOES NOT EXCEED TABLE 403.06.G-1. ADJUSTMENTS TO MIX PLANT CONTROL SETTINGS MUST BE SUBMITTED TO AND APPROVED BY DISTRICT TESTING PRIOR TO MAKING THE ADJUSTMENT. THE ADJUSTMENT CANNOT EXCEED +/- 0.2% FROM DESIGN AC % FROM JMF. DO NOT LOWER VIRGIN BINDER CONTENT OR INCREASE RAP PERCENT. ENSURE PLANT TICKET SHOWS THE ADJUSTMENT AND IS SET TO THE ADJUSTED TOTAL AC % AT ALL TIMES AFTERWARDS.
- RECORD THE DAILY VERIFICATION PAN RESULTS IN A SEPARATE WORKSHEET AND MAKE SURE IT'S POSTED IN THE PLANT FACILITY AND AVAILABLE TO THE MONITORS. INCLUDE THE DATE RAN, VERIFICATION PAN RESULT, AND INITIALS OF WHO RAN IT. ENSURE A PRINTOUT OF THE DAILY VERIFICATION PAN IS ALSO INCLUDED WITH THE TE-199.

FOLLOW SUPPLEMENT 1043 FOR AC GAUGE OFFSET, EXCEPT AS MODIFIED BELOW:

- FOLLOW 1043.07 EXCEPT AS FOLLOWS:
  - NOTIFY DISTRICT TESTING A MINIMUM OF ONE WEEK PRIOR TO MAKING VERIFICATION PANS.
  - DISTRICT TESTING WILL WITNESS A SOLVENT EXTRACTION FROM A SAMPLE FROM THE RAP PILE THAT IS TO BE USED IN THE JMF TO VERIFY THE RAP AC %. RAP AC % WILL BE WITHIN 0.3% OF RAP AC % DETERMINED IN JMF. IF OUTSIDE OF 0.3%, DO NOT PROCEED AND THE JMF WILL NEED TO BE REDESIGNED.
  - DISTRICT TESTING WILL WITNESS THE VERIFICATION PANS BEING BLENDED, MIXED, AND COMPACTED.
  - MAKE A MINIMUM OF THREE VERIFICATION PANS FOR THE JMF THAT ARE AT THE JMF ASPHALT BINDER CONTENT. MAKE ONE ADDITIONAL VERIFICATION PAN FOR EACH ADDITIONAL DISTRICT THE JMF WILL BE USED IN.
  - IN ADDITION, TURN POSSESSION OVER OF THE CALIBRATION AC GAUGE PANS USED TO DETERMINE THE FIT COEFFICIENT TO DISTRICT TESTING.
- FOR AC CONTENT PAY ACCEPTANCE, REPLACE 1043.08 WITH THE FOLLOWING: CALCULATE AN AC GAUGE OFFSET AMOUNT FOR EACH JMF AND MIX PLANT IN ACCORDANCE WITH THE FOLLOWING PROCEDURE PRIOR TO START OF ANY PRODUCTION FOR THE JMF. NOTIFY DISTRICT TESTING 24 HOURS PRIOR TO OFFSETTING GAUGE.

1. ENSURE PRINTER IS ON AND PLACE THE FIRST VERIFICATION PAN IN THE AC GAUGE AND RUN.
2. AFTER THE 16-MINUTE TEST, TAKE THE VERIFICATION PAN OUT AND TURN 180 DEGREES AND PLACE BACK IN AC GAUGE AND RUN.
3. REPEAT STEPS 1 AND 2 WITH SECOND AND THIRD VERIFICATION PANS.
4. FOR EACH RUN, TAKE THE JMF ASPHALT BINDER CONTENT MINUS THE AC GAUGE AC % TO OBTAIN THE OFFSET FOR THAT RUN.
5. AVERAGE ALL OFFSETS FOR A FINAL OFFSET.
6. RETAIN ALL OF THE VERIFICATION PANS. AFTER THE FINAL OFFSET IS DETERMINED, DISTRICT TESTING WILL CHOOSE TWO OF THE VERIFICATION PANS AND SEND ONE OF THESE TWO TO OMM TO EXTRACT AND REFLUX.
7. DISTRICT TESTING WILL USE THE TWO VERIFICATION PANS TO OFFSET THEIR AC GAUGE.

BEFORE THE BEGINNING OF A PRODUCTION DAY, RUN THE VERIFICATION PAN IN THE AC GAUGE AND ENSURE THE OFFSET AC GAUGE AMOUNT IS WITHIN 0.14% OF THE JMF ASPHALT BINDER CONTENT. DURING THE START OF PRODUCTION FOR THE JMF, SOLVENT EXTRACT THE FIRST TWO QC SAMPLES AND COMPARE TO THE OFFSET AC GAUGE. ENSURE SOLVENT EXTRACTION IS WITHIN 0.3% OF OFFSET AC GAUGE. IF MORE THAN 0.3% OFF, IMMEDIATELY RESAMPLE AND RUN AC GAUGE AND SOLVENT EXTRACT IMMEDIATELY. IF TWO CONSECUTIVE SAMPLES ARE MORE THAN 0.3% OFF, IMMEDIATELY STOP PRODUCTION, CONTACT MONITORING TEAM, AND INVESTIGATE THE REASON FOR THE PROBLEM. ONCE TWO CONSECUTIVE QC SAMPLES ARE WITHIN 0.3% OF OFFSET AC GAUGE, THE FINAL OFFSET GAUGE IS CONFIRMED. AFTER CONFIRMING THE AC GAUGE OFFSET AMOUNT PROCEED WITH DETERMINING AC CONTENTS OF PRODUCTION SAMPLES BY THE AC GAUGE ACCORDING TO 1043.09. ONLY DETERMINE ONE AC GAUGE OFFSET AMOUNT PER JMF. IF MORE THAN 30 DAYS HAS LAPSED SINCE THE JMF WAS LAST TESTED, RE-DO THE OFFSET PROCEDURE ABOVE WITH TWO VERIFICATION PANS (ONE FROM THE CONTRACTOR AND ONE FROM THE DISTRICT). IF AN AC GAUGE OFFSET AMOUNT IS LATER DETERMINED, BY AN INVESTIGATION OF BOTH THE CONTRACTOR AND THE DISTRICT, TO BE INCORRECT RE-DO THE OFFSET PROCEDURE. IN ADDITION, ALSO DETERMINE THE AC GAUGE OFFSET FOLLOWING THE CURRENT PROCEDURE AS OUTLINED IN SUPPLEMENT 1043 DATED JANUARY 21, 2022 AND PROVIDE THE INFORMATION TO THE DEPARTMENT. THIS AC GAUGE OFFSET NUMBER WILL NOT BE USED DURING QC TESTING.

**IDEAL-CT MIX DESIGN ACCEPTANCE**

FOLLOW ALL REQUIREMENTS OF THE SPECIFICATIONS WITH THE ADDITION OF THE FOLLOWING:

PERFORM THE IDEAL-CT FOR THE MIX DESIGN SUBMITTAL PER SUPPLEMENT 1033 ON THE JMF ASPHALT BINDER CONTENT DETERMINED FROM THE DESIGN AIR VOIDS AND ENSURE THE MINIMUM IN THE TABLE BELOW IS MET FOR THE MIX TYPE. THE IDEAL-CT ONLY NEEDS TO BE RAN FOR MIX DESIGN ACCEPTANCE.

PROVIDE RESULTS PER SUPPLEMENT 1033 WITH THE MIX DESIGN. SUPPLY SIX GYRATORY COMPACTED SPECIMENS TO THE HEIGHT MENTIONED IN SUPPLEMENT 1033 FOR THE MIX TYPE SPECIFIED. ALLOW MORE THAN TWO WEEKS FOR MIX DESIGN REVIEW AND PRELIMINARY APPROVAL DUE TO OMM VERIFYING THE MIX.

MIX TYPE	MINIMUM CT <sub>INDEX</sub>
ITEM 442 (SUPERPAVE) 9.5 MM	80
ITEM 442 (SUPERPAVE) 19 MM (INTERMEDIATE)	60

**ELECTRONIC TICKETING**

PROVIDE ELECTRONIC MATERIAL TICKETS IN AN ELECTRONIC FORMAT DIRECTLY RECORDED FROM THE MATERIAL LOADING SOURCE FOR THE FOLLOWING MATERIALS:

- AGGREGATE
- ASPHALT CONCRETE
- PORTLAND CONCRETE

THIS NOTE IN NO WAY SUPERSEDES ANY OTHER COMMERCIAL REGULATIONS OR ANY OTHER LEGAL REQUIREMENTS REGULATING THE TRANSPORTATION OF COMMERCIAL MATERIALS.

AT THE PRE-CONSTRUCTION MEETING, SUBMIT AN ELECTRONIC TICKETING PLAN TO THE ENGINEER DESCRIBING THE PROPOSED ELECTRONIC TICKET DELIVERY METHOD. THE ELECTRONIC MATERIAL TICKET SHALL CONTAIN INFORMATION AS REQUIRED PER THE APPLICABLE MATERIAL SPECIFICATION FOR WEIGHT MEASUREMENT AND OTHER MATERIAL CHARACTERISTICS; PROVIDE AN EXAMPLE(S) OR A "MOCK-UP" OF THE PROPOSED ELECTRONIC TICKET TO SHOW THE DETAILS ON WHAT IS TO BE TRANSMITTED TO THE DEPARTMENT. NAMING OF THE ELECTRONIC MATERIAL TICKET FILES SHALL BE DISTINCT SUCH THAT THE TICKET'S REPRESENTED MATERIAL IS EASILY DETERMINED; INCLUDE THE PROPOSED NAMING CONVENTION. DELIVERY MAY BE THROUGH A PRODUCER WEBSITE UPLOAD ACCESSIBLE TO THE ENGINEER, ODOT PROJECT SPECIFIC SHAREPOINT DOCUMENTATION SITE UPLOAD, OR ANOTHER SECURE ELECTRONIC TRANSMITTAL MEANS. EMAILING OF A TICKET TO AN ODOT CONTACT IS ACCEPTABLE BUT IS NOT PREFERRED. THE ELECTRONIC TICKETING PLAN SHALL IDENTIFY A CONTINGENCY METHOD FOR MANUALLY CAPTURING AND DELIVERING TICKET INFORMATION IF ELECTRONIC TRANSMISSION IS TEMPORARILY UNAVAILABLE. AN ELECTRONIC TICKETING PLAN WHICH INCLUDES SOLELY THE USE OF DIGITAL PHOTOS OF PAPER TICKETS IS NOT ACCEPTABLE.

THE DEPARTMENT RECOGNIZES THAT VARIOUS DIGITAL TICKETING SYSTEMS MAY BE COMMERCIALY AVAILABLE AND USED TO ACCOMMODATE INDIVIDUAL CONTRACTORS AND MATERIAL SUPPLIER CAPABILITIES. THE CONTRACTOR MAY PROVIDE A DIGITAL TICKETING SYSTEM GIVING SECURE ACCESS TO ORGANIZED DIGITAL DATA. IF UTILIZED, THE DIGITAL TICKETING SYSTEM MAY ALSO BE ACCESSIBLE BY REAL-TIME MONITORING WITH A MOBILE COMMUNICATION DEVICE SUCH AS A TABLET, SMARTPHONE, ETC. THROUGH MOBILE DEVICE APPLICATIONS ("MOBILE APP") IF ACCEPTABLE TO THE DEPARTMENT. IF A DIGITAL TICKETING SYSTEM REQUIRES A MOBILE APP, THE MOBILE APP SHALL BE AT NO COST TO THE DEPARTMENT. THE DIGITAL DATA MUST BE ABLE TO BE EXPORTED IN A FORMAT USABLE BY THE ENGINEER UPON REQUEST (I.E. MICROSOFT WORD, MICROSOFT EXCEL, PDF FORMATS).

DELIVER EACH ELECTRONIC MATERIAL TICKET TO THE ENGINEER PRIOR TO THE PLACEMENT OF MATERIAL, BUT NOT PRIOR TO THE LOADING OF MATERIAL AT THE SOURCE.

PROVIDE THE ENGINEER A DAILY MATERIAL SUMMARY REPORT BY THE END OF THE DAY'S HAULING ACTIVITIES, OR AT A TIME AS APPROVED BY THE ENGINEER. THE DAILY MATERIAL SUMMARY REPORT INCLUDES SUMMARY INFORMATION LISTED FOR EACH MATERIAL AS OUTLINED IN THE RESPECTIVE MATERIAL SPECIFICATION.

COSTS FOR THE ELECTRONIC TICKETING SHALL BE INCIDENTAL TO THE RESPECTIVE ITEMS TO WHICH THE DELIVERED QUANTITIES BELONG.

**ITEM 605 - BASE PIPE UNDERDRAINS, AS PER PLAN**

BASE PIPE UNDERDRAINS SHALL BE INSTALLED PER C&MS 605, EXCEPT THE DEPTH SHALL BE MEASURED AT 24" FROM THE BOTTOM OF THE PROPOSED FOR BASE COURSE, RATHER THAN 18" THE BOTTOM OF THE EXISTING OR PROPOSED SUBGRADE. SEE TYPICAL SECTIONS.






COUNTY	ROUTE	LOG POINT TO LOG POINT		LENGTH		PLAN SPLIT:										01/STR/PV																						
				MILE	FEET	TRAVELLED WAY WIDTH FT	LEFT SHOULDER WIDTH FT	RIGHT SHOULDER WIDTH FT	TOTAL PAVED WIDTH FT	PAVEMENT AREA SY	202		203	204		209	254		304	407	407	442		690						209		408	617					
											PAVEMENT REMOVED (10.25"+)	PAVEMENT REMOVED, AS PER PLAN (4.25"+)	EXCAVATION (12"-21" DEEP)	SUBGRADE COMPACTION	GEOGRID	PROOF ROLLING HOURS	PREPARING SUBGRADE FOR SHOULDER PAVING MILE	PAVEMENT PLANING, ASPHALT CONCRETE (1.25" DEEP) SY	PATCHING PLANED SURFACE SY	AGGREGATE BASE (12" THICK) CY	TACK COAT (0.06 GAL/SY) GAL	TACK COAT (0.09 GAL/SY) GAL	ASPHALT CONCRETE SURFACE COURSE, 9.5MM, TYPE A, (446), AS PER PLAN, PG64-22 (1.25") CY	ASPHALT CONCRETE SURFACE COURSE, 9.5MM, TYPE A, (446), AS PER PLAN, PG64-22 (SAFETY EDGE) CY	ASPHALT CONCRETE INTERMEDIATE COURSE, 19MM, TYPE A, (446), AS PER PLAN, PG64-22 (3.00") CY	SPECIAL - FULL DEPTH RECLAIMED BASE COURSE, 6.00 INCHES DEEP SY	SPECIAL - EMULSIFIED ASPHALT* GAL	SPECIAL - ADDITIONAL ADDITIVES (CEMENT, FLY ASH, LIME)* TON	SPECIAL - CORRECTIVE AGGREGATE FOR FDR (FINE, COARSE OR RAP)* TON	AGGREGATE SHOULDER WIDTH		AGGREGATE SHOULDER AREA SY	LINEAR GRADING MILE	PRIME COAT, AS PER PLAN GAL	COMPACTED AGGREGATE (4.00" THICK) CY			
											L	R	FT	FT	SY	MILE	GAL	GAL	TON	TON	FT	FT	SY	MILE	GAL	CY												
CRA	602	4.25	4.50	0.25	1320	22	2	2	26	3814	880	2,934	465	1174	1,174	0.59	0.50			392	458		133	19	318	4107	9241	22	137	2.00	2.00	587	0.50	235	66			
CRA	602	4.50	5.00	0.50	2640	22	2	2	26	7627	1,760	5,867	929	2347	2,347	1.17	1.00			783	916		265	38	636	8214	18480	44	274	2.00	2.00	1174	1.00	470	131			
CRA	602	5.00	5.50	0.50	2640	22	2	2	26	7627	1,760	5,867	929	2347	2,347	1.17	1.00			783	916		265	38	636	8214	18480	44	274	2.00	2.00	1174	1.00	470	131			
CRA	602	5.50	5.97	0.47	2482	22	2	2	26	7170	1,655	5,515	874	2206	2,206	1.10	0.94			736	861		249	36	598	7721	17373	41	258	2.00	2.00	1103	0.94	442	123			
CRA	602	5.97	5.98	0.01	53	22	7	7	36	212	36	176	19	47	47	0.02	0.02			16	26		8	1	18	224	504	2	8	2.00	2.00	24	0.02	10	3			
SUSPEND AND RESUME PAVING OVER STRUCTURE CRA-602-0600																																						
CRA	602	6.02	6.04	0.02	125	22	7	7	36	500	84	416	44	112	112	0.06	0.05			38	60		18	2	42	528	1188	3	18	2.00	2.00	56	0.05	23	7			
CRA	602	6.04	6.50	0.46	2409	22	2	2	26	6961	1,607	5,354	848	2142	2,142	1.07	0.91			714	836		242	35	581	7496	16866	40	250	2.00	2.00	1071	0.91	429	119			
CRA	602	6.50	7.00	0.50	2640	22	2	2	26	7627	1,760	5,867	929	2347	2,347	1.17	1.00			783	916		265	38	636	8214	18480	44	274	2.00	2.00	1174	1.00	470	131			
CRA	602	7.00	7.50	0.50	2640	22	2	2	26	7627	1,760	5,867	929	2347	2,347	1.17	1.00			783	916		265	38	636	8214	18480	44	274	2.00	2.00	1174	1.00	470	131			
CRA	602	7.50	8.00	0.50	2640	22	2	2	26	7627	1,760	5,867	929	2347	2,347	1.17	1.00			783	916		265	38	636	8214	18480	44	274	2.00	2.00	1174	1.00	470	131			
CRA	602	8.00	8.50	0.50	2640	22	2	2	26	7627	1,760	5,867	929	2347	2,347	1.17	1.00			783	916		265	38	636	8214	18480	44	274	2.00	2.00	1174	1.00	470	131			
CRA	602	8.50	9.00	0.50	2640	22	2	2	26	7627	1,760	5,867	929	2347	2,347	1.17	1.00			783	916		265	38	636	8214	18480	44	274	2.00	2.00	1174	1.00	470	131			
CRA	602	9.00	9.45	0.45	2376	22	2	2	26	6864	1,584	5,280	836	2112	2,112	1.06	0.90			704	824		239	34	572	7392	16632	39	247	2.00	2.00	1056	0.90	423	118			
CRA	602	9.47	9.49	0.02	125	22	9	9	40	556	84	472	44	112	112	0.06	0.05			38	67		20	2	47	584	1314	4	20	2.00	2.00	56	0.05	23	7			
CRA	602	9.49	9.49	0.00	25		8	8	16	45	17	28	9	23	23	0.01	0.01			8	6		4	1	4	51	114	1	2	2.00	2.00	12	0.01	5	2			
SUSPEND AND RESUME PAVING OVER STRUCTURE CRA-602-0949																																						
CRA	602	9.51	9.51	0.00	25		8	8	16	45	17	28	9	23	23	0.01	0.01			8	6		2	1	4	51	114	1	2	2.00	2.00	12	0.01	5	2			
CRA	602	9.51	9.54	0.02	125	22	9	9	40	556	84	472	44	112	112	0.06	0.05			38	67		20	2	47	584	1314	4	20	2.00	2.00	56	0.05	23	7			
CRA	602	9.54	10.00	0.46	2438	22	2	2	26	7044	1,626	5,418	858	2168	2,168	1.08	0.92			723	846		245	35	587	7586	17068	40	253	2.00	2.00	1084	0.92	434	121			
CRA	602	10.00	10.50	0.50	2640	22	2	2	26	7627	1,760	5,867	929	2347	2,347	1.17	1.00			783	916		265	38	636	8214	18480	44	274	2.00	2.00	1174	1.00	470	131			
CRA	602	10.50	11.00	0.50	2640	22	2	2	26	7627	1,760	5,867	929	2347	2,347	1.17	1.00			783	916		265	38	636	8214	18480	44	274	2.00	2.00	1174	1.00	470	131			
CRA	602	11.00	11.50	0.50	2640	22	2	2	26	7627	1,760	5,867	929	2347	2,347	1.17	1.00			783	916		265	38	636	8214	18480	44	274	2.00	2.00	1174	1.00	470	131			
CRA	602	11.50	12.00	0.50	2640	22	2	2	26	7627	1,760	5,867	929	2347	2,347	1.17	1.00			783	916		265	38	636	8214	18480	44	274	2.00	2.00	1174	1.00	470	131			
CRA	602	12.00	12.50	0.50	2640	22	2	2	26	7627	1,760	5,867	929	2347	2,347	1.17	1.00			783	916		265	38	636	8214	18480	44	274	2.00	2.00	1174	1.00	470	131			
CRA	602	12.50	13.00	0.50	2640	22	2	2	26	7627	1,760	5,867	929	2347	2,347	1.17	1.00			783	916		265	38	636	8214	18480	44	274	2.00	2.00	1174	1.00	470	131			
CRA	602	13.00	13.50	0.50	2640	22	2	2	26	7627	1,760	5,867	929	2347	2,347	1.17	1.00			783	916		265	38	636	8214	18480	44	274	2.00	2.00	1174	1.00	470	131			
CRA	602	13.50	13.64	0.14	739	22	2	2	26	2136	493	1,643	261	658	658	0.33	0.28			220	257		75	11	178	2300	5176	13	77	2.00	2.00	329	0.28	132	37			
		RAMP TO S.R. 96			541					541										541	3		98	19														
		EXTRA AREA FOR INTERSECTIONS			1528					1528										1528	8		276	54														
		EXTRA AREA FOR PAVED DRIVES			63					63										63	1		12	3														
		EXTRA AREA FOR AGGREGATE DRIVES			486					486										486	3		88	17														
		EXTRA AREA FOR EX. MAILBOX APPROACHES			460					460										460	3		83	16														
TOTALS CARRIED TO GENERAL SUMMARY										145,759	32,807	109,874	17,317	43,747	43,747	22	19	3,078	18	14,597	17,695				5,785	11,900	153,615	345,624	826	5,128						19	8,800	2,456

\* THESE QUANTITIES ARE PROVIDED FOR ESTIMATION PURPOSES ONLY. ACTUAL QUANTITIES WILL BE AS DETERMINED PER ITEM 609 - MIXTURE DESIGN FOR RECLAIMED BASE COURSE, WHICH SHALL BE PAID FOR ON A LUMP SUM BASIS. SEE THE "FULL DEPTH RECLAMATION WITH EMULSIFIED ASPHALT" NOTE IN THESE PLANS.

PAVEMENT AND SHOULDER DATA

DESIGN AGENCY  
**DISTRICT 3**



ENGINEERING  
**TEAM FOUR**

DESIGNER  
**JNC**

REVIEWER  
**NRF 12-06-21**

PROJECT ID  
**102939**

SHEET TOTAL  
**18 38**

UNDERDRAIN LAYOUT & QUANTITIES - LEFT SIDE

COUNTY	ROUTE	PLAN SPLIT: LENGTH				01/STR/PV			
		LOG POINT		MILE	FEET	6" UNCLASSIFIED PIPE UNDERDRAINS	6" BASE PIPE UNDERDRAINS AS PER PLAN	6" CONDUIT, TYPE F FOR UNDERDRAIN OUTLETS	PRECAST REINFORCED CONCRETE OUTLET
		SLM	TO LOG POINT						
CRA	602	4.25	4.33	0.08	422	422		30	2
CRA	602	4.33	5.44	1.11	5861		5,861	210	14
CRA	602	5.44	6.07	0.63	3326		3,326	105	7
CRA	602	6.07	11.24	5.17	27298		27,298	1020	68
CRA	602	11.24	11.75	0.51	2693	2,693		105	7
CRA	602	11.75	13.55	1.80	9504		9,504	360	24
CRA	602	13.55	13.64	0.09	475	475		30	2
TOTALS CARRIED TO GENERAL SUMMARY						3,591	45,989	1,860	124

UNDERDRAIN LAYOUT & QUANTITIES- RIGHT SIDE

COUNTY	ROUTE	PLAN SPLIT: LENGTH				01/STR/PV			
		LOG POINT		MILE	FEET	6" UNCLASSIFIED PIPE UNDERDRAINS	6" BASE PIPE UNDERDRAINS AS PER PLAN	6" CONDUIT, TYPE F FOR UNDERDRAIN OUTLETS	PRECAST REINFORCED CONCRETE OUTLET
		SLM	TO LOG POINT						
CRA	602	4.25	4.55	0.30	1584	1,584		60	4
CRA	602	4.55	8.02	3.47	18322		18,322	360	24
CRA	602	8.02	9.53	1.51	7973	7,973		300	20
CRA	602	9.53	13.11	3.58	18902		18,902	405	27
CRA	602	13.11	13.21	0.10	528	528		30	2
CRA	602	13.21	13.53	0.32	1690		1,690	60	4
CRA	602	13.53	13.64	0.11	581	581		30	2
TOTALS CARRIED TO GENERAL SUMMARY						10,666	38,914	1245	83

LEFT SIDE ESTIMATED OUTLET LOCATIONS

SLM	DIST. FROM PREVIOUS OUTLET [FT]	UNDERDRAIN TYPE	SLM	DIST. FROM PREVIOUS OUTLET [FT]	UNDERDRAIN TYPE
4.27		UNCLASSIFIED	9.06	422	BASE PIPE
4.33	317	UNCLASSIFIED	9.14	422	BASE PIPE
4.40	370	BASE PIPE	9.21	370	BASE PIPE
4.48	422	BASE PIPE	9.29	422	BASE PIPE
4.55	370	BASE PIPE	9.36	370	BASE PIPE
4.63	422	BASE PIPE	9.44	422	BASE PIPE
4.70	370	BASE PIPE	9.52	422	BASE PIPE
4.78	422	BASE PIPE	9.59	370	BASE PIPE
4.86	422	BASE PIPE	9.67	422	BASE PIPE
4.93	370	BASE PIPE	9.74	370	BASE PIPE
5.01	422	BASE PIPE	9.82	422	BASE PIPE
5.08	370	BASE PIPE	9.89	370	BASE PIPE
5.16	422	BASE PIPE	9.97	422	BASE PIPE
5.23	370	BASE PIPE	10.05	422	BASE PIPE
5.31	422	BASE PIPE	10.12	370	BASE PIPE
5.39	422	BASE PIPE	10.20	422	BASE PIPE
5.44	264	BASE PIPE	10.27	370	BASE PIPE
5.52	422	BASE PIPE	10.35	422	BASE PIPE
5.59	370	BASE PIPE	10.42	370	BASE PIPE
5.67	422	BASE PIPE	10.50	422	BASE PIPE
5.78	581	BASE PIPE	10.58	422	BASE PIPE
5.97	1003	BASE PIPE	10.65	370	BASE PIPE
6.05	422	BASE PIPE	10.73	422	BASE PIPE
6.11	317	BASE PIPE	10.80	370	BASE PIPE
6.18	370	BASE PIPE	10.88	422	BASE PIPE
6.26	422	BASE PIPE	10.95	370	BASE PIPE
6.33	370	BASE PIPE	11.03	422	BASE PIPE
6.41	422	BASE PIPE	11.11	422	BASE PIPE
6.48	370	BASE PIPE	11.18	370	BASE PIPE
6.56	422	BASE PIPE	11.26	422	UNCLASSIFIED
6.64	422	BASE PIPE	11.33	370	UNCLASSIFIED
6.71	370	BASE PIPE	11.41	422	UNCLASSIFIED
6.79	422	BASE PIPE	11.48	370	UNCLASSIFIED
6.86	370	BASE PIPE	11.56	422	UNCLASSIFIED
6.94	422	BASE PIPE	11.64	422	UNCLASSIFIED
7.02	422	BASE PIPE	11.71	370	UNCLASSIFIED
7.09	370	BASE PIPE	11.79	422	BASE PIPE
7.17	422	BASE PIPE	11.86	370	BASE PIPE
7.24	370	BASE PIPE	11.94	422	BASE PIPE
7.32	422	BASE PIPE	12.02	422	BASE PIPE
7.39	370	BASE PIPE	12.09	370	BASE PIPE
7.47	422	BASE PIPE	12.17	422	BASE PIPE
7.55	422	BASE PIPE	12.24	370	BASE PIPE
7.62	370	BASE PIPE	12.32	422	BASE PIPE
7.70	422	BASE PIPE	12.39	370	BASE PIPE
7.77	370	BASE PIPE	12.47	422	BASE PIPE
7.85	422	BASE PIPE	12.55	422	BASE PIPE
7.92	370	BASE PIPE	12.62	370	BASE PIPE
8.00	422	BASE PIPE	12.70	422	BASE PIPE
8.08	422	BASE PIPE	12.77	370	BASE PIPE
8.15	370	BASE PIPE	12.85	422	BASE PIPE
8.23	422	BASE PIPE	12.92	370	BASE PIPE
8.30	370	BASE PIPE	13.00	422	BASE PIPE
8.38	422	BASE PIPE	13.08	422	BASE PIPE
8.45	370	BASE PIPE	13.15	370	BASE PIPE
8.53	422	BASE PIPE	13.23	422	BASE PIPE
8.61	422	BASE PIPE	13.30	370	BASE PIPE
8.68	370	BASE PIPE	13.38	422	BASE PIPE
8.76	422	BASE PIPE	13.45	370	BASE PIPE
8.83	370	BASE PIPE	13.53	422	BASE PIPE
8.91	422	BASE PIPE	13.55	106	UNCLASSIFIED
8.98	370	BASE PIPE	13.63	422	UNCLASSIFIED

RIGHT SIDE ESTIMATED OUTLET LOCATIONS

SLM	DIST. FROM PREVIOUS OUTLET [FT]	UNDERDRAIN TYPE	SLM	DIST. FROM PREVIOUS OUTLET [FT]	UNDERDRAIN TYPE
4.27		UNCLASSIFIED	9.00	370	UNCLASSIFIED
4.34	370	UNCLASSIFIED	9.08	422	UNCLASSIFIED
4.42	422	UNCLASSIFIED	9.16	422	UNCLASSIFIED
4.50	422	UNCLASSIFIED	9.23	370	UNCLASSIFIED
4.57	370	BASE PIPE	9.31	422	UNCLASSIFIED
4.65	422	BASE PIPE	9.38	370	UNCLASSIFIED
4.72	370	BASE PIPE	9.46	422	UNCLASSIFIED
4.80	422	BASE PIPE	9.55	475	BASE PIPE
4.88	422	BASE PIPE	9.63	422	BASE PIPE
4.95	370	BASE PIPE	9.70	370	BASE PIPE
5.03	422	BASE PIPE	9.78	422	BASE PIPE
5.10	370	BASE PIPE	9.86	422	BASE PIPE
5.18	422	BASE PIPE	9.93	370	BASE PIPE
5.25	370	BASE PIPE	10.01	422	BASE PIPE
5.33	422	BASE PIPE	10.08	370	BASE PIPE
5.41	422	BASE PIPE	10.16	422	BASE PIPE
5.48	370	BASE PIPE	10.23	370	BASE PIPE
5.56	422	BASE PIPE	10.31	422	BASE PIPE
5.63	370	BASE PIPE	10.39	422	BASE PIPE
5.71	422	BASE PIPE	10.46	370	BASE PIPE
5.78	370	BASE PIPE	10.54	422	BASE PIPE
5.86	422	BASE PIPE	10.61	370	BASE PIPE
5.94	422	BASE PIPE	10.69	422	BASE PIPE
6.01	370	BASE PIPE	10.77	422	BASE PIPE
6.09	422	BASE PIPE	10.84	370	BASE PIPE
6.16	370	BASE PIPE	10.92	422	BASE PIPE
6.24	422	BASE PIPE	10.99	370	BASE PIPE
6.31	370	BASE PIPE	11.07	422	BASE PIPE
6.39	422	BASE PIPE	11.14	370	BASE PIPE
6.47	422	BASE PIPE	11.22	422	BASE PIPE
6.54	370	BASE PIPE	11.30	422	BASE PIPE
6.62	422	BASE PIPE	11.37	370	BASE PIPE
6.69	370	BASE PIPE	11.45	422	BASE PIPE
6.77	422	BASE PIPE	11.52	370	BASE PIPE
6.84	370	BASE PIPE	11.60	422	BASE PIPE
6.92	422	BASE PIPE	11.67	370	BASE PIPE
7.00	422	BASE PIPE	11.75	422	BASE PIPE
7.07	370	BASE PIPE	11.83	422	BASE PIPE
7.15	422	BASE PIPE	11.90	370	BASE PIPE
7.24	475	BASE PIPE	11.98	422	BASE PIPE
7.32	422	BASE PIPE	12.05	370	BASE PIPE
7.39	370	BASE PIPE	12.13	422	BASE PIPE
7.47	422	BASE PIPE	12.20	370	BASE PIPE
7.55	422	BASE PIPE	12.28	422	BASE PIPE
7.62	370	BASE PIPE	12.36	422	BASE PIPE
7.70	422	BASE PIPE	12.43	370	BASE PIPE
7.77	370	BASE PIPE	12.51	422	BASE PIPE
7.85	422	BASE PIPE	12.58	370	BASE PIPE
7.92	370	BASE PIPE	12.66	422	BASE PIPE
8.02	528	UNCLASSIFIED	12.73	370	BASE PIPE
8.09	370	UNCLASSIFIED	12.81	422	BASE PIPE
8.17	422	UNCLASSIFIED	12.89	422	BASE PIPE
8.25	422	UNCLASSIFIED	12.96	370	BASE PIPE
8.32	370	UNCLASSIFIED	13.04	422	BASE PIPE
8.40	422	UNCLASSIFIED	13.11	370	UNCLASSIFIED
8.47	370	UNCLASSIFIED	13.19	422	UNCLASSIFIED
8.55	422	UNCLASSIFIED	13.25	317	BASE PIPE
8.63	422	UNCLASSIFIED	13.32	370	BASE PIPE
8.70	370	UNCLASSIFIED	13.40	422	BASE PIPE
8.78	422	UNCLASSIFIED	13.47	370	BASE PIPE
8.85	370	UNCLASSIFIED	13.55	422	UNCLASSIFIED
8.93	422	UNCLASSIFIED	13.63	422	UNCLASSIFIED

NOTE: THE LOCATIONS, LENGTHS, AND UNDERDRAIN TYPES SHOWN ON THIS SHEET ARE BASED ON AERIAL LIDAR DATA AND SHALL BE CONSIDERED APPROXIMATE. THE CONTRACTOR IS RESPONSIBLE FOR ENSURING THAT THE OUTLET LOCATIONS AND UNDERDRAIN TYPE INSTALLED AT EACH LOCATION ALLOW FOR POSITIVE DRAINAGE OUTLETTING NOT LESS THAN 6" ABOVE THE DITCHLINE.

THE OUTLET TYPES, SPACING, AND QUANTITIES SHOWN ARE CONSERVATIVE, AND ARE INTENDED TO ALLOW FOR ADJUSTMENT AND/OR LIMITED OMISSION OF OUTLET LOCATIONS AT THE DISCRETION OF THE ENGINEER, AS FIELD CONDITIONS INDICATE. SPACING OF OUTLETS AT 500' OR LESS IS PREFERRED, WITH 1000' MAXIMUM SPACING.