PROPOSED WORK

THE PROJECT IS A DECK REPLACEMENT PROJECT OVER IR 71 WITH MINIMAL APPROACH WORK. MOST OF THE WORK CAN BE COMPLETED WITHOUT IMPACT TO TRAFFIC. FOR CONSTRUCTION WORK THAT REQUIRES LANE CLOSURES ON IR 71 AND/OR THE IR 71, IR 90/IR 490, AND SR 176 RAMPS BELOW THE BRIDGE, PERFORM ALL CLOSURES IN ACCORDANCE WITH ODOT STANDARD CONSTRUCTION DRAWINGS AND AT THE APPROVAL OF THE ENGINEER.

ITEM 614 - MAINTAINING TRAFFIC

ALL WORK AND TRAFFIC CONTROL DEVICES SHALL BE IN ACCORDANCE WITH CMS 614 AND OTHER APPLICABLE PORTIONS OF THE SPECIFICATIONS, AS WELL AS THE OHIO MANUAL OF UNIFORM TRAFFIC CONTROL DEVICES, CURRENT EDITION, LATEST REVISION.

THE BUHRER AVENUE BRIDGE WILL BE CLOSED AND ALL PEDESTRIANS WILL BE DETOURED DURING CONSTRUCTION. PEDESTRIANS SHALL BE WARNED, GUIDED, AND PROTECTED IN ACCORDANCE WITH THE DETAILS PROVIDED ON SHEET 10 AND THE APPLICABLE PORTIONS OF ODOT STANDARD CONSTRUCTION DRAWING MT-110.10.

THE EXISTING NUMBER OF TRAVEL LANES FOR EACH UNDERPASS ROADWAY BELOW THE BUHREER AVENUE BRIDGE SHALL BE MAINTAINED AT ALL TIMES EXCEPT AS PER THE PERMITTED LANE CLOSURE CHARTS ON ODOT'S WEBSITE.

ALL'LANE OLOSURES AND WORK ZONES ON 18-71 AND THE 18-71: IR 90/IR 490. AND SR 176 RAMPS SHALL BE IN ACCORDANCE WITH ODOT STANDARD CONSTRUCTION DRAWINGS.

LENGTH AND DURATION OF LANE CLOSURES AND RESTRICTIONS SHALL NOT EXCEED THE PERMITTED LANE CLOSURE RESTRICTIONS AND SHALL BE AT THE APPROVAL OF THE ENGINEER. THE DURATION OF ANY COMPLETE CLOSURE OF A ROADWAY SHALL NOT EXCEED 15 MINUTES. IT IS THE INTENT TO MINIMIZE THE IMPACT TO THE TRAVELING PUBLIC. LANE CLOSURES OR RESTRICTIONS OVER SEGMENTS OF THE PROJECT IN WHICH NO WORK IS ANTICIPATED WITHIN A REASONABLE TIME FRAME, AS DETERMINED BY THE ENGINEER, SHALL NOT BE PERMITTED. THE LEVEL OF UTILIZATION OF MAINTENANCE OF TRAFFIC DEVICES SHALL BE COMMENSURATE WITH THE WORK IN PROGRESS. A

THE CONTRACTOR SHALL FURNISH AND MAINTAIN ALL FLAGS, FLAGGERS, WATCHERS, BARRICADES, SIGNS, SIGN SUPPORTS, AND INCIDENTALS RELATED TO TRAFFIC CONTROL.

SIGNS FURNISHED SHALL BE IN NEW OR LIKE NEW CONDITIONS. LIKE NEW SIGNS SHALL BE SUBJECT TO THE APPROVAL OF THE PROJECT ENGINEER. THE CONTRACTOR SHALL BE RESPONSIBLE AT ALL TIMES FOR PROVIDING AND MAINTAINING LIGHTS, SIGNS, AND BARRICADES FOR THE MAINTENANCE OF TRAFFIC AND SAFETY OF HIS/HER WORK AT THE LOCATIONS SHOWN IN THESE PLANS OR AS DIRECTED BY THE ENGINEER

IF THE CONTRACTOR FAILS TO COMPLY WITH THE PROVISIONS FOR TRAFFIC CONTROL AS SET FORTH IN THESE PLANS AND PROVISIONS OF THE OMUTCD AND THE FAILURE RESULTS IN A CONDITION AT THE WORK SITE WHICH IS UNSAFE FOR TRAFFIC. THE ENGINEER SHALL SUSPEND WORK UNTIL THE CONTRACTOR COMPLIES WITH THE NECESSARY REQUIREMENTS.

THE CONTRACTOR SHALL NOTIFY THE CITY OF CLEVELAND (216) 664- 3194 AND THE ODOT DISTRICT OFFICE (216) 584- 2005 EIGHTEEN (18) DAYS IN ADVANCE OF WHEN THE PEDESTRIAN DETOUR ROUTE SHOULD BE IN EFFECT.

THE CONTRACTOR WILL COVER ANY EXISTING AND/OR PROPOSED SIGN INSTALLATION WHICH IS IN CONFLICT WITH THE MAINTENANCE OF TRAFFIC PLANS. THE SIGNS SHALL BE COVERED IN SUCH A MANNER AS TO AVOID DAMAGING THE SIGN WHEN THE COVER IS REMOVED. THE COVER SHALL BE TOTALLY OPAQUE AND COVER THE ENTIRE SIGN FACE. THE USE OF ADHESIVE TAPE APPLIED DIRECTLY TO THE SIGN FACE IS STRICTLY PROHIBITED. THE CONTRACTOR WILL PROVIDE ALL OF "CLOSED" PLAQUES NECESSARY. THE OVERLAY MAY BE RIVETED TO THE SIGN. THE LUMP SUM PRICE BID FOR ITEM 614 -MAINTAINING TRAFFIC SHALL INCLUDE ALL COSTS NECESSARY TO COVER AND/OR MODIFY CONFLICTING SIGN INSTALLATIONS.

RESTRICTION FOR BUHRER AVENUE BRIDGE PEDESTRIANS DETOUR

THE CONTRACTOR SHALL SCHEDULE CONSTRUCTION ACTIVITIES SUCH THAT DURATION OF BUHRER AVENUE BRIDGE PEDESTRIAN DETOUR SHALL BE LIMITED TO SUMMER CLOSURE OF BUHRER DUAL LANGUAGE ACADEMY

ITEM 614, MAINTAINING TRAFFIC (LANES OPEN DURING HOLIDAYS OR SPECIAL EVENTS)

NO WORK SHALL BE PERFORMED AND ALL EXISTING LANES SHALL BE OPEN TO TRAFFIC DURING THE FOLLOWING DESIGNATED HOLIDAYS OR SPECIAL EVENTS

NEW YEAR'S (OBSERVED) GENERAL/REGULAR ELECTION DAY (NOV) THANKSGIVING TOTAL SOLAR ECLIPSE (4/8/24) MEMORIAL DAY CHRISTMAS (OBSERVED) FOURTH OF JULY (OBSERVED) LABOR DAY (OTHER HOLIDAY OR SPECIAL EVENT)

THE PERIOD OF TIME THAT THE LANES ARE TO BE OPEN DEPENDS ON THE DAY OF THE WEEK ON WHICH THE HOLIDAY OR SPECIAL EVENT FALLS. THE FOLLOWING SCHEDULE SHALL BE USED TO DETERMINE THIS PERIOD.

DAY OF HOLIDAY OR EVENT

TIME ALL LANES MUST BE OPEN TO TRAFFIC

SUNDAY 12:00N FRIDAY THROUGH 6:00AM MONDAY MONDAY 12:00N FRIDAY THROUGH 6:00AM TUESDAY MONDAY (4/8/24) 12:00N FRIDAY THROUGH 6:00AM WEDNESDAY 12:00N MONDAY THROUGH 6:00AM WEDNESDAY THESDAY TUESDAY (GEN./REG. ELECT.) 5:00 AM TUES. THRU 12:00 AM WED. 12:00N TUEŚDAY THROUGH 6:00AM THURSDAY WEDNESDAY 12:00N WEDNESDAY THROUGH 6:00AM FRIDAY THURSDAY THANKSGIVING 6:00AM WEDNESDAY THROUGH 6:00AM MONDAY 12:00N THURSDAY THROUGH 6:00AM MONDAY SATURDAY 12:00N FRIDAY THROUGH 6:00AM MONDAY

DURING THE SAME PERIODS, MAINTAIN PEDESTRIAN ACCESS IF PEDESTRIAN ACCESS WAS PRESENT PRIOR TO CONSTRUCTION.

SHOULD THE CONTRACTOR FAIL TO MEET ANY OF THESE REQUIREMENTS, THE CONTRACTOR SHALL BE ASSESSED A DISINCENTIVE PER THE LANE VALUE CONTRACT (PN 127).

ITEM 614, MAINTAINING TRAFFIC (NOTICE OF CLOSURE SIGN)

NOTICE OF CLOSURE SIGNS SHALL BE ERECTED BY THE CONTRACTOR PRIOR TO THE SCHEDULED PEDESTRIAN BRIDGE CLOSURE IN ACCORDANCE WITH THE NOTICE OF CLOSURE TABLE BELOW. THE SIGNS SHALL BE ERECTED ON THE RIGHT-HAND SIDE OF SIDEWALK, FACING PEDESTRIAN TRAFFIC. THEY SHALL BE PLACED SO AS NOT TO INTERFERE WITH THE VISIBILITY OF ANY OTHER TRAFFIC CONTROL SIGNS.

NOTICE OF CLOSURE SIGN TIME TABLE SIGN DISPLAYED TO PUBLIC **DURATION OF CLOSURE** 14 CALENDAR DAYS

THE SIGN SHALL DISPLAY THE DATE OF THE CLOSURE IN MM-DD FORMAT. THE LAST LINE OF THE CLOSURE SIGN SHALL LIST A PHONE NUMBER WHICH A PEDESTRIAN MAY CALL FOR ADDITIONAL INFORMATION. THIS IS TO BE A SPECIFIC OFFICE WITHIN THE DISTRICT RATHER THAN THE GENERAL SWITCHBOARD NUMBER.

ALL WORK AND TRAFFIC CONTROL DEVICES SHALL BE IN ACCORDANCE WITH CMS 614 AND OTHER APPLICABLE PORTIONS OF THE SPECIFICATIONS. AS WELL AS THE OHIO MANUAL OF UNIFORM TRAFFIC CONTROL DEVICES. PAYMENT FOR ALL LABOR EQUIPMENT AND MATERIALS SHALL BE INCLUDED IN THE LUMP SUM CONTRACT PRICE FOR ITEM 614 - MAINTAINING TRAFFIC UNLESS SEPARATELY ITEMIZED IN THE PLAN.

LANE VALUE CONTRACT:

THE CONTRACTOR SHALL BE ASSESSED DISINCENTIVES AS DESIGNATED IN THE LANE VALUE CONTRACT TABLE FOR EACH UNIT OF TIME THE DESCRIBED CRITICAL LANE/RAMP IS RESTRICTED FROM FULL USE BY THE TRAVELING PUBLIC WITHIN THE RESTRICTED TIME PERIOD. THE LANE VALUE CONTRACT TABLE IS LOCATED IN THE PLAN GENERAL NOTES. THE DISINCENTIVES WILL BE ASSESSED FOR ALL RESTRICTIONS OF THE CRITICAL WORK

CRITICAL WORK IS SHOWN IN THE LANE VALUE CONTRACT TABLE.

CRITICAL WORK IS DEFINED AS HAVING THE DESIGNATED SECTIONS OPEN TO UNRESTRICTED TRAFFIC AS SHOWN IN THE TABLE, OR THE ENTIRE PROJECT IF NOT OTHERWISE LISTED.

UNRESTRICTED TRAFFIC IS DEFINED AS ALL TRAFFIC LANES BEING AVAILABLE FOR USE WITH SPECIFIED STRIPING AND SAFETY FEATURES IN PLACE

LANE VALUE CONTRACT TABLE

| DESCRIPTION OF CRITICAL LANE/RAMP TO BE MAINTAINED | RESTRICTED TIMIĘ∕PĘRIØD | | DISINCENTIVE \$ PER TIME UNIT |
|---|-----------------------------|------|----------------------------------|
| 3 LANES OF CUY IR 71 SOUTH FROM MM 247.01TO MM 247.84 | ≻ PER PLCS ` | MIN. | \$500 |
| 2 LANES OF CUY IR 71 NORTH FROM MM 247.01TO MM 247.84 | \succ PER PLCS $^{\prec}$ | MIN. | \$750 |
| (| 11/6/2023 | | , |

SCHEDULE OF THROUGH LANES TO BE MAINTAINED

ALL LANE CLOSURES MAY ONLY BE IMPLEMENTED AT THE TIMES PERMITTED BY THE "DISTRICT 12 PERMITTED LANE CLOSURE TIMES" LIST, WHICH IS LOCATED ON THE ODOT WEBSITE.

https://www.dot.state.oh.us/districts/D12/HighwayManagement/Pages/ PermittedLaneClosures.aspx

THE LATEST REVISION, AT 14 DAYS PRIOR TO THE BID DATE. SHALL BE IN EFFECT FOR THIS PROJECT.

NO LANE OR SHOULDER CLOSURES SHALL BE IN PLACE WHEN NO WORK IS BEING PERFORMED, UNLESS DIRECTED BY THE ENGINEER

SHOULDER CLOSURES SHALL ONLY BE ALLOWED AT THE TIMES SPECIFIED FOR LANE CLOSURES.

ANY ROADWAY NOT LISTED SHALL NOT HAVE ANY LANE CLOSURES ON WEEKDAYS FROM 6:30AM TO 9:00AM AND 3:00PM TO 6:00PM. CONTACT TROY ONESTI, DISTRICT 12 WORK ZONE TRAFFIC MANAGER, AT (216) 584 2204 IF THERE ARE ANY

ALL NOTES ON THE PERMITTED LANE CLOSURE TIMES SHALL BE PART OF THE PROJECT.

WORK ZONE INCREASED PENALTIES SIGN (R11-H5a)

R11- H5A- 48 SIGNS SHALL BE FURNISHED FRECTED AND MAINTAINED IN GOOD CONDITION AND/OR REPLACED AS NECESSARY AND SUBSEQUENTLY REMOVED BY THE CONTRACTOR. SIGNS SHALL BE MOUNTED AT THE APPROPRIATE OFFSETS AND ELEVATIONS AS PRESCRIBED BY THE OHIO MANUAL OF UNIFORM TRAFFIC CONTROL DEVICES. THEY SHALL BE MAINTAINED ON SUPPORTS MEETING CURRENT SAFETY CRITERIA

THE SIGNS MAY BE ERECTED OR UNCOVERED NO MORE THAN FOUR HOURS BEFORE THE ACTUAL START OF WORK. THE SIGNS SHALL BE REMOVED OR COVERED NO LATER THAN FOUR HOUR FOLLOWING RESTORATION OF ALL LANES TO TRAFFIC WITH NO RESTRICTIONS, OR SOONER AS DIRECTED BY THE ENGINEER. TEMPORARY SIGN COVERING AND UNCOVERING DUE TO TEMPORARY LANE RESTORATIONS SHALL BE GUIDED BY THE FOUR- HOUR LIMITATIONS STATED ABOVE. SUCH LAN RESTORATIONS SHOULD BE EXPECTED TO REMAIN IN EFFECT FOR 30 OR MORE CONSECUTIVE CALENDAR DAYS, SUCH AS DURING WINTER SHUT-DOWNS.

THE SIGNS ON THE MAINLINE SHALL BE DUAL MOUNTED UNLESS NOT PHYSICALLY POSSIBLE. THE FIRST SIGN SHALL BE PLACED BETWEEN THE ROAD WORK AHEAD (W20-1) SIGN AND THE NEXT SIGN IN THE SEQUENCE. SIGNS SHALL BE ERECTED ON EACH ENTRANCE RAMP AND EVERY 2 MILES THROUGH THE CONSTRUCTION WORK LIMITS. SIGNS ON THE MAINLINE SHALLBE R11-H5A-48. SIGNS USED ON THE RAMPS SHALL BE R11-H5A-24. R11-H5A-24 SIGNS MAY BE USED IN THE MEDIAN IN LIEU OFR11-H5A-48 SIGNS IF IT IS NOT PHYSICALLY POSSIBLE TO PROVIDE R11-H5A-48 SIGNS IN THE MEDIAN.

THE R11-H5A-48 SIGNS SHALL BE MOUNTED ON 2 NO. 3 POSTS WHEN LOCATED WITHIN CLEAR ZONES.

THE CONTRACTOR MAY USE SIGNS AND SUPPORTS IN USED, BUT GOOD CONDITION PROVIDED THE SIGNS MEET CURRENT ODOT SPECIFICATIONS. SIGN FACES SHALL BE RETROREFLECTORIZED WITH TYPE G SHEETING COMPLYING WITH THE REQUIREMENTS OF C&MS 730 19

WORK ZONE INCREASED PENALTIES SIGNS AND SUPPORTS WILL BE MEASURED AS THE NUMBER OF SIGN INSTALLATIONS, INCLUDING THE SIGN AND NECESSARY SUPPORTS. IF A SIGN AND SUPPORT COMBINATION IS REMOVED AND REERECTED AT ANOTHER LOCATION AS DIRECTED BY THE ENGINEER, IT SHALL BE CONSIDERED ANOTHER UNIT.

PAYMENT FOR ACCEPTED QUANTITIES, COMPLETE, IN PLACE WILL BE MADE AT THE CONTRACT UNIT PRICE. PAYMENT SHALLBE FULL COMPENSATION FOR ALL MATERIALS, LABOR, INCIDENTALS AND EQUIPMENT FOR FURNISHING, ERECTING, MAINTAINING, COVERING DURING SUSPENSION OF WORK, AND REMOVAL OF THE SIGN AND SUPPORT

ITEM 614, WORK ZONE INCREASED PENALTIES SIGN

UTHENICS 回

MRC ARP 12/21/21

105793 P.8 40






1 4" X 4" STRUCTURAL TUBING

 $3 L 5" X 3\frac{1}{2}" X \frac{3}{8}" X 3" LONG.$

2) 3" X 3/8" BAR

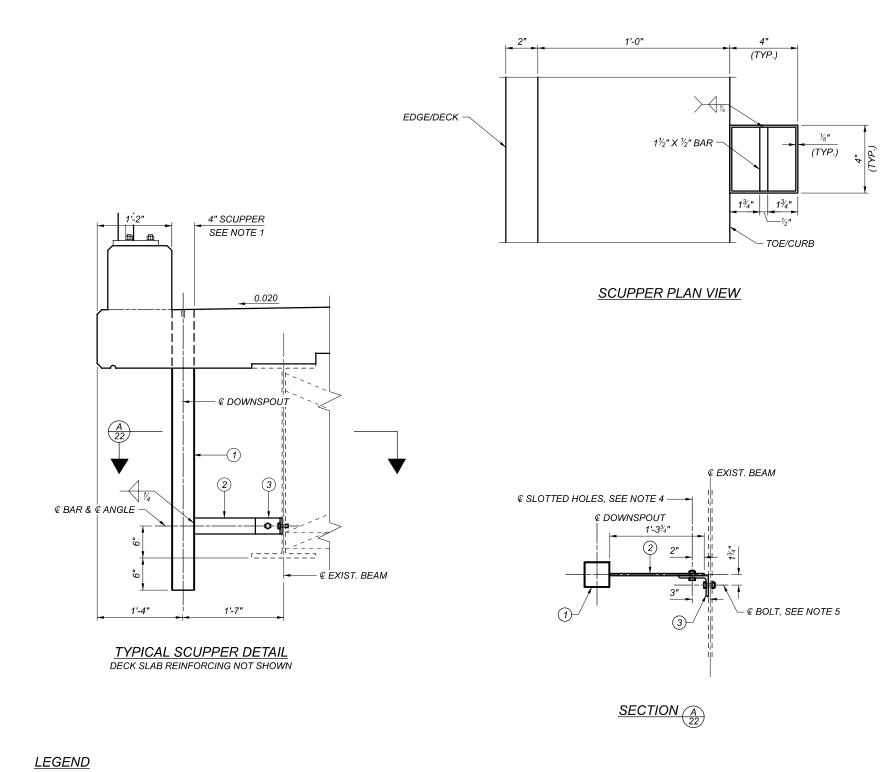

<u>NOTES</u>

- 1. FABRICATE THE SCUPPERS FROM 4" X 4" STRUCTURAL TUBING WITH A 1%" X %" BAR CENTERED IN THE OPENING AND ORIENTED PARALLEL TO THE CURB. SCUPPER TO BE FLUSH WITH THE DECK SURFACE.
- 2. STRUCTURAL TUBING SHALL BE ASTM A500 GRADE C WITH A MINIMUM YIELD STRENGTH OF 50 KSI. STEEL ANGLES AND BARS SHALL BE ASTM A709, GRADE 50. GALVANIZE ALL STRUCTURAL STEEL PER CMS 711.02. 11/6/20 3. ALL BOLTS SHALL BE A325 HIGH STRENGTH BOLTS.
- 4. THE SIZE OF SLOTTED HOLES SHALL BE 1 /₁₆" X 1 9 /₁₆". THE SLOT SHALL BE HORIZONTAL IN THE 3 X 9 /* BAR AND VERTICAL IN THE ANGLE. THE BOLTS SHALL BE 5/8" DIAMETER A325 TYPE I, GALVANIZED, WITH HEX NUT AND TWO WASHERS. TIGHTEN BOLTS ACCORDING TO CMS 513.
- 5. THE BOLTS SHALL BE %" DIAMETER A325 TYPE I, GALVANIZED. EACH ASSEMBLY SHALL INCLUDE A BOLT, NUT, AND TWO WASHERS. TIGHT BOLTS ACCORDING TO CMS 513. AFTER DECK CONCRETE HAS BEEN POURED, FIELD DRILL THE $^{1}\%_{16}$ " DIAMETER HOLE IN THE EXISTING BEAM WEB.
- 6. FOR SCUPPER LOCATIONS, SEE FRAMING PLAN ON SHEETS 13/23 AND 14/23.

1805495

EUTHENICS 2235 Mohawit Dr. | Cleveland, OH 44336

SRW BPS ARP 12/21/21 105793 22 23 P.39 40