

ITEM SPECIAL - MAILBOX REMOVED AND RESET

THIS WORK SHALL CONSIST OF REMOVING THE EXISTING MAILBOX SUPPORTS AND FURNISHING AND ERECTING NEW MAILBOX SUPPORTS AND ANY ASSOCIATED MOUNTING HARDWARE IN ACCORDANCE WITH PLAN DETAILS, AND ATTACHING THE SALVAGED MAILBOX OR OTHERWISE ESTABLISHED BY THE ENGINEER.

THE MAILBOXES ARE AT THE FOLLOWING LOCATIONS:
 STA. 82+68, LT. STA. 83+35, RT.
 STA. 84+07, LT. STA. 85+37, LT.
 STA. 85+94, LT. STA. 87+31, LT.
 STA. 88+32, LT. STA. 88+56, RT.
 STA. 89+09, LT. STA. 89+27, RT.
 STA. 89+52, LT. STA. 90+01, RT.
 STA. 90+81, RT. STA. 91+05, LT.
 STA. 91+51, LT. STA. 99+42, RT.

WOOD POSTS SHALL BE NOMINAL 4 INCHES BY 4 INCHES SQUARE OR 4.5 INCHES DIAMETER ROUND, AND CONFORM TO 710.14.

STEEL POSTS SHALL BE NOMINAL PIPE SIZE 2 INCHES I.D., AND CONFORM TO AASHTO M 181.

ALL HARDWARE INCLUDING BUT NOT LIMITED TO PLATES, SCREWS, BOLTS, AND ETC. SHALL BE COMMERCIAL-GRADE GALVANIZED STEEL.

POSTS SHALL BE SET PER THE FIRST PARAGRAPH OF 606.03, AND SHALL IN NO INSTANCE BE ENCASED IN CONCRETE.

SUPPORT HARDWARE SHALL ACCOMMODATE EITHER A SINGLE OR A DOUBLE MAILBOX INSTALLATION, AND NO MORE THAN TWO BOXES MAY BE MOUNTED ON A SINGLE POST.

THE MAILBOX SHALL BE SECURELY AND NEATLY ATTACHED BY THE CONTRACTOR TO THE NEW SUPPORT. THE CONTRACTOR SHALL FURNISH ALL NECESSARY ATTACHMENT HARDWARE (NUTS, BOLTS, PLATES, SPACERS, AND WASHERS) AS NECESSARY TO ACCOMMODATE THE COMPLETE INSTALLATION.


THE CONTRACTOR SHALL SALVAGE THE EXISTING BOX AND PLACE IT ON THE NEW SUPPORT. DUE CARE SHALL BE EXERCISED IN SUCH AN OPERATION, AND THE CONTRACTOR SHALL BE RESPONSIBLE FOR REPAIRING OR REPLACING ANY BOX DAMAGED BY IMPROPER HANDLING ON HIS PART, AS JUDGED AND DIRECTED BY THE ENGINEER.

THE CONTRACTOR SHALL BE RESPONSIBLE FOR COORDINATING WITH THE LOCAL POST MASTER REGARDING THE TIMING OF THE MOVEMENT OF ANY MAILBOX TO A NEW LOCATION.

PAYMENT UNDER THIS ITEM SHALL BE LIMITED TO FINAL PERMANENT INSTALLATIONS, TEMPORARY INSTALLATIONS SHALL BE IN ACCORDANCE WITH 107.10. HOWEVER, THE SAME MATERIAL AND SIZE LIMITATIONS AS FOR PERMANENT INSTALLATIONS SHALL APPLY.

MAILBOX REMOVAL AND RESET, INCLUDING THE NEW SUPPORTS, WILL BE PAID FOR AT THE CONTRACT UNIT PRICE PER EACH, FOR ITEM SPECIAL MAILBOX REMOVED AND RESET. THE FOLLOWING QUANTITY HAS BEEN CARRIED TO THE GENERAL SUMMARY FOR USE AS DIRECTED BY THE ENGINEER:

SPECIAL, MAILBOX REMOVED AND RESET 16 EACH

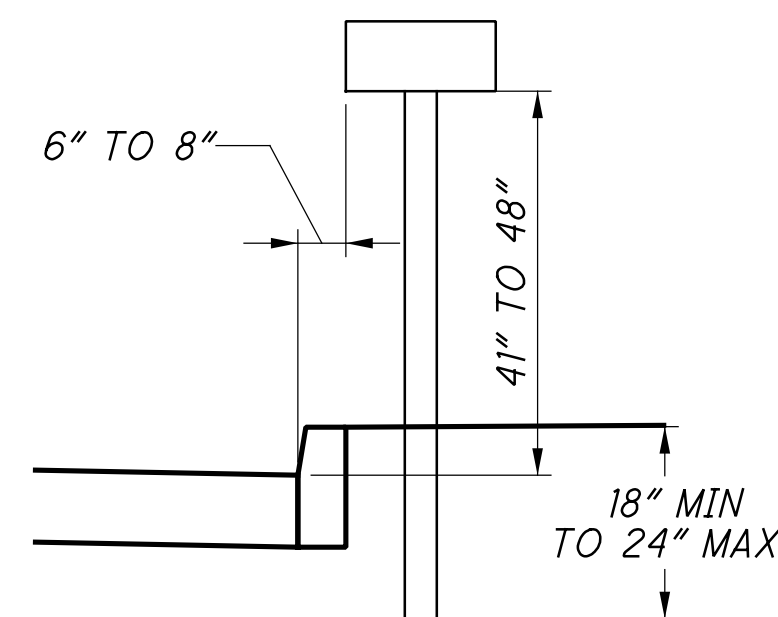

MAILBOX SUPPORT DETAIL

CROSSINGS AND CONNECTIONS TO EXISTING PIPES AND UTILITIES

WHERE PLANS PROVIDE FOR A PROPOSED CONDUIT TO BE CONNECTED TO, OR CROSS OVER OR UNDER AN EXISTING SEWER OR UNDERGROUND UTILITY, LOCATE THE EXISTING PIPES OR UTILITIES BOTH AS TO LINE AND GRADE BEFORE STARTING TO LAY THE PROPOSED CONDUIT.

IF IT IS DETERMINED THAT THE ELEVATION OF THE EXISTING CONDUIT, OR EXISTING APPURTENANCE TO BE CONNECTED, DIFFERS FROM THE PLAN ELEVATION OR RESULTS IN A CHANGE IN THE PLAN CONDUIT SLOPE, NOTIFY THE ENGINEER BEFORE STARTING CONSTRUCTION OF ANY PORTION OF THE PROPOSED CONDUIT WHICH WILL BE AFFECTED BY THE VARIANCE IN THE EXISTING ELEVATIONS.

IF IT IS DETERMINED THAT THE PROPOSED CONDUIT WILL INTERSECT AN EXISTING SEWER OR UNDERGROUND UTILITY IF CONSTRUCTED AS SHOWN ON THE PLAN, NOTIFY THE ENGINEER BEFORE STARTING CONSTRUCTION OF ANY PORTION OF THE PROPOSED CONDUIT WHICH WOULD BE AFFECTED BY THE INTERFERENCE WITH AN EXISTING FACILITY.

PAYMENT FOR ALL THE OPERATIONS DESCRIBED ABOVE IS INCLUDED IN THE CONTRACT PRICE FOR THE PERTINENT 611 CONDUIT ITEM.

REVIEW OF DRAINAGE FACILITIES

PRIOR TO THE START OF WORK AND AGAIN BEFORE FINAL ACCEPTANCE, PERFORM AN INSPECTION WITH REPRESENTATIVES OF THE DEPARTMENT, CONTRACTOR AND LOCALS OF ALL EXISTING DRAINAGE FACILITIES THAT ARE TO REMAIN IN SERVICE WHICH MAY BE AFFECTED BY THE WORK. THE CONDITION OF THE EXISTING CONDUITS AND THEIR APPURTENANCES IS DETERMINED FROM FIELD OBSERVATIONS. RECORDS OF THE INSPECTION ARE MAINTAINED BY THE DEPARTMENT.

CONFIRM ALL EXISTING SEWERS INSPECTED INITIALLY BY THE ABOVE-MENTIONED PARTIES ARE MAINTAINED AND LEFT IN A CONDITION COMPARABLE TO THAT DETERMINED BY THE ORIGINAL INSPECTION. THE CONTRACTOR IS RESPONSIBLE TO CORRECT ANY CHANGE IN THE CONDITION RESULTING FROM THEIR OPERATIONS AS DIRECTED AND APPROVED BY THE ENGINEER.

PAYMENT FOR ALL OPERATIONS DESCRIBED ABOVE IS INCLUDED IN THE CONTRACT PRICE FOR THE PERTINENT 611 CONDUIT ITEMS.

ITEM 611 - INSPECTION WELL, AS PER PLAN

ANY EXISTING SANITARY CLEAN OUTS OR INSPECTION WELLS ENCOUNTERED WITHIN THE PROJECT LIMITS THAT ARE REQUIRED TO BE MAINTAINED SHALL BE ADJUSTED TO GRADE. ALL LABOR, MATERIALS, AND INCIDENTAL ITEMS REQUIRED FOR THIS WORK SHALL BE INCLUDED IN THE UNIT BID PRICE FOR THIS ITEM INCLUDING ANY REQUIRED TRAFFIC BEARING COVERS. THE FOLLOWING QUANTITY HAS BEEN CARRIED TO THE GENERAL SUMMARY FOR THIS WORK:

611, INSPECTION WELL, AS PER PLAN 4 EACH

MANHOLE COVER REPLACEMENT

ALL COVER CASTINGS FOR THE SANITARY SEWER MANHOLES OR STORM SEWER MANHOLES THAT ARE TO BE ADJUSTED TO GRADE OR RECONSTRUCTED TO GRADE SHALL BE SOLID, HEAVY DUTY, AND SUITABLE FOR H-20 HIGHWAY TRAFFIC LOADS WHEN WITHIN THE PAVEMENT AREA. ANY EXISTING COVERS THAT ARE FOUND TO BE UNSUITABLE SHALL BE REPLACED.

THE FOLLOWING QUANTITIES HAVE BEEN CARRIED TO THE GENERAL SUMMARY FOR REPLACING ANY UNSUITABLE MANHOLE CASTINGS:

611, MANHOLE FRAME AND COVER, AS PER PLAN (FOR DRAINAGE) 3 EACH
 611, MANHOLE FRAME AND COVER, AS PER PLAN (FOR SANITARY) 2 EACH

ITEM SPECIAL - MISCELLANEOUS METAL

EXISTING CASTINGS MAY PROVE TO BE UNSUITABLE FOR REUSE, AS DETERMINED BY THE ENGINEER. THE CONTRACTOR IS RESPONSIBLE TO PROVIDE THE CASTINGS OF THE REQUIRED TYPE, SIZE AND STRENGTH (HEAVY OR LIGHT DUTY) FOR THE PARTICULAR STRUCTURE IN QUESTION. FURNISH MATERIALS PER 611 WITH PRIOR APPROVAL OF THE ENGINEER.

THE FOLLOWING ESTIMATED QUANTITY HAS BEEN CARRIED TO THE GENERAL SUMMARY FOR USE AS DIRECTED BY THE ENGINEER.

SPECIAL, MISCELLANEOUS METAL 3,000 POUNDS

THE CONTRACTOR IS CAUTIONED TO USE EXTREME CARE IN THE REMOVAL, STORAGE AND REPLACEMENT OF ALL EXISTING CASTINGS. CASTINGS DAMAGED BY THE NEGLIGENCE OF THE CONTRACTOR, AS DETERMINED BY THE ENGINEER, SHALL BE REPLACED WITH THE PROPER NEW CASTINGS AT THE EXPENSE OF THE CONTRACTOR.

POST CONSTRUCTION STORM WATER TREATMENT

THIS PLAN UTILIZES STRUCTURAL BEST MANAGEMENT PRACTICES (BMP'S) FOR POST CONSTRUCTION STORM WATER TREATMENT.

VEGETATED FILTER STRIP

LIMIT DISTURBANCE OF THE VEGETATED FILTER STRIP TO THOSE AREAS THAT MUST BE GRADED TO MEET THE PROPOSED CONDITIONS OF THIS PLAN SET. EXISTING GRASS AREAS THAT ARE NOT DISTURBED MUST ACHIEVE AT LEAST 70% GRASS COVERAGE. THE FOLLOWING ITEM HAS BEEN CARRIED TO THE GENERAL SUMMARY TO USE ON EXISTING GRASS AREAS NOT MEETING THE MINIMUM VEGETATIVE COVERAGE:

659, REPAIR SEEDING AND MULCHING 2,597 SY

UTILITY PIPE REPLACEMENT

ESTIMATED QUANTITIES ARE PROVIDED FOR PIPE TO BE REPLACED, AS DIRECTED BY THE ENGINEER, WHEN EXISTING STORM AND SANITARY PIPES ARE FOUND TO BE DAMAGED AND THE DAMAGE IS NOT A RESULT OF CONTRACTOR ACTIVITIES. REPLACEMENT OF PIPES DAMAGED DURING CONSTRUCTION DUE TO CONTRACTOR ACTIVITIES SHALL BE THE SOLE RESPONSIBILITY OF THE CONTRACTOR.

ESTIMATED QUANTITIES OF 6" CONDUIT ARE PROVIDED IF EXISTING HOUSE CONNECTIONS TO STORM SEWER ARE ENCOUNTERED DURING CONSTRUCTION TO CONNECT TO THE NEW STORM SYSTEM.

THE FOLLOWING QUANTITIES ARE CARRIED TO GENERAL SUMMARY:

611, 6" CONDUIT, TYPE B 100 FT
 611, 12" CONDUIT, TYPE B 100 FT
 611, 15" CONDUIT, TYPE B 150 FT

PAVEMENT RESTORATION FOR PIPE INSTALLATIONS AND/OR REMOVALS

THE FOLLOWING QUANTITY HAS BEEN PROVIDED FOR PAVEMENT RESTORATION FOLLOWING INSTALLATION AND/OR REMOVAL OF PIPES.

301, ASPHALT CONCRETE BASE, PG64-22, (449) 86 CY

THE ABOVE QUANTITY IS BASED ON A 301 THICKNESS OF 6 INCHES AND A PAVEMENT RESTORATION WIDTH THAT INCLUDES THE TRENCH WIDTH PLUS TWO FEET ON EACH SIDE OF THE TRENCH.

PROVIDE ANY MATERIALS USED OUTSIDE THE LIMITS STATED ABOVE AT NO ADDITIONAL COST.

ITEM 611 - CATCH BASIN, NO. 6, AS PER PLAN

THE CONTRACTOR SHALL PERFORM ALL WORK AS DEFINED IN THE CMS AND SHOWN ON ODOT SCD CB-6 EXCEPT THAT THE INTERIOR WIDTH OF THE STRUCTURE ON SECTION B-B SHALL BE 36".

SANITARY SEWER MANHOLE REPLACEMENT

THE CONTRACTOR SHALL EXERCISE EXTREME CAUTION WHEN PERFORMING THE PAVEMENT RECONSTRUCTION AND CURB PLACEMENT IN THE VICINITY OF THE EXISTING MANHOLES AT STA. 85+15, 25.9' LT; STA. 91+83, 25.2' LT; AND STA. 101+45, 25.5' LT. THESE ITEMS SHALL BE USED FOR REALIGNMENT OF THE EXISTING SANITARY MANHOLES AND SEWER WHEN ITEM 611 - MANHOLE RECONSTRUCTED TO GRADE, AS PER PLAN DESCRIBED ON SHEET 13 IS NOT POSSIBLE. THE MANHOLE CASTINGS SHALL BE HEAVY DUTY, SUITABLE FOR H-20 HIGHWAY TRAFFIC LOADINGS; NO FROST UPLIFT WILL BE PERMITTED. SANITARY SERVICES SHALL NOT BE INTERRUPTED DURING CONSTRUCTION.

THE FOLLOWING QUANTITIES HAVE BEEN CARRIED TO THE GENERAL SUMMARY FOR USE AS DIRECTED BY THE ENGINEER:

611, 8" CONDUIT, TYPE B 60 FT
 611, MANHOLE, NO. 3 3 EACH

SEEDING AND MULCHING

THE FOLLOWING QUANTITIES ARE PROVIDED TO PROMOTE GROWTH AND CARE OF PERMANENT SEEDING AREAS:

659, SOIL ANALYSIS TEST 2 EACH
 659, TOPSOIL 426 CY
 659, REPAIR SEEDING AND MULCHING 192 SY
 659, INTER-SEEDING 192 SY
 659, COMMERCIAL FERTILIZER 0.52 TON
 659, LIME 0.79 ACRES
 659, WATER 21 MGAL

APPLY SEEDING AND MULCHING TO ALL AREAS OF EXPOSED SOIL BETWEEN THE RIGHT-OF-WAY LINES AND WITHIN THE CONSTRUCTION LIMITS FOR AREAS OUTSIDE THE RIGHT-OF-WAY LINES COVERED BY WORK AGREEMENT OR SLOPE EASEMENT. QUANTITY CALCULATIONS FOR SEEDING AND MULCHING ARE BASED ON THESE LIMITS.

ITEM 623 - CONSTRUCTION LAYOUT STAKES AND SURVEYING, AS PER PLAN

AFTER COMPLETION OF ALL WORK, BUT PRIOR TO FINAL ACCEPTANCE OF THE PROJECT, AN OHIO PROFESSIONAL SURVEYOR SHALL DETERMINE THE MINIMUM VERTICAL CLEARANCES OF ALL EXISTING AND NEW BRIDGES WITHIN THE PROJECT LIMITS. AT A MINIMUM, MEASUREMENTS SHALL BE TAKEN ALONG EACH FASCIA BEAM AT THE EDGE OF SHOULDERS, EDGE LINES, LANE LINES, AND CROWN OF THE ROADWAY BELOW. THE ODOT DISTRICT 12 VERTICAL CLEARANCE SURVEY FORM SHALL BE USED, WHERE APPLICABLE, TO DOCUMENT THE MEASUREMENTS. WHERE THE ODOT DISTRICT 12 VERTICAL CLEARANCE SURVEY FORM IS NOT APPLICABLE, THE MEASUREMENTS SHALL BE DOCUMENTED ON A CONTRACTOR-DEVELOPED FORM THAT CLOSELY RESEMBLES THE ODOT DISTRICT 12 VERTICAL CLEARANCE SURVEY FORM AND ACCURATELY DEPICTS THE BRIDGE AND THE LANE AND SHOULDER CONFIGURATION OF THE ROADWAY THAT PASSES BELOW THE BRIDGE. THE COMPLETED FORM SHALL BEAR THE STAMP OR SEAL OF THE OHIO PROFESSIONAL SURVEYOR WHO HAS TAKEN THE MEASUREMENTS AND SHALL BE SUBMITTED TO THE PROJECT ENGINEER PRIOR TO FINAL ACCEPTANCE OF THE PROJECT.

THE ODOT DISTRICT 12 VERTICAL CLEARANCE SURVEY FORM CAN BE DOWNLOADED FROM THE FOLLOWING FTP SITE:

<https://ftp.dot.state.oh.us/pub/Contracts/Attach/CUY-106239>

P:\3000-3499\302310010-CUY-CR57-4.43-(Wallings_Road)\001\06239-CUY-77-4.79-Design\Roadway\Sheets\106239_GN002.dgn 9/13/2024 4:09:37 PM khillegass

CALCULATED
 KAH
 CHECKED
 RAK
GENERAL NOTES
CUY-77-4.79
 12
 217

ITEM 611 - DRAINAGE STRUCTURE, MISC.: CATCH BASIN LINING

THE EXISTING CATCH BASIN AT STA. 94+66.12, RT SHALL BE LINED ON ALL SIDES AND THE BOTTOM WITH 1/8" PLATES MADE OF ALUMINUM, STAINLESS STEEL, OR HOT-DIPPED GALVANIZED STEEL. THE PLATES SHALL BE SECURELY FASTENED TO THE CATCH BASIN. THE PLATES SHALL NOT COVER ANY PIPE INLETS.

COSTS FOR ALL WORK, LABOR, EQUIPMENT, AND MATERIALS SHALL BE INCLUDED IN THE LUMP SUM BID FOR THIS ITEM. THE FOLLOWING QUANTITY HAS BEEN CARRIED TO THE GENERAL SUMMARY:

611, DRAINAGE STRUCTURE MISC.: CATCH BASIN LINING	LS
------------------------------------------------------	----

ITEM 611 - MANHOLE RECONSTRUCTED TO GRADE, AS PER PLAN

FOR EXISTING SANITARY MANHOLES ADJACENT TO OR WITHIN THE PROPOSED CURB AND GUTTER AREA (STA. 85+15, 25.9' LT; STA. 91+83, 25.2' LT; AND STA. 101+45, 25.5' LT) THAT INTERFERE WITH CONSTRUCTION OF THE CURB AND GUTTER, AS DETERMINED BY THE ENGINEER, THE CONTRACTOR SHALL REMOVE ENOUGH OF THE EXISTING MANHOLE STRUCTURE IN ORDER TO INSTALL AN ECCENTRIC CONE TOP, PER SCD MH-3, TO ENSURE THAT THE MANHOLE DOES NOT INTERFERE WITH CONSTRUCTION OF THE CURB AND GUTTER. THE CONTRACTOR SHALL APPLY A WATERTIGHT SEAL TO THE LID.

PAYMENT SHALL BE MADE AT THE UNIT PRICE PER EACH AND SHALL INCLUDE ALL LABOR, EQUIPMENT, AND MATERIALS NECESSARY TO COMPLETE THE WORK AS DESCRIBED INCLUDING THE ECCENTRIC CONE TOP.

ITEM 441 - ASPHALT CONCRETE SURFACE COURSE, TYPE 1, (446), AS PER PLAN, PG70-22M

THE COARSE VIRGIN AGGREGATE FOR THIS ITEM SHALL CONSIST OF A BLEND OF 60% MIN. AIR COOLED BLAST FURNACE SLAG (ACBFS) OR TRAP ROCK FROM ONTARIO WITH LIMESTONE COMPRISING THE REMAINING PERCENTAGE.

ASPHALT CONCRETE SURFACE COURSE SEALING REQUIREMENTS

IN ADDITION TO THE GUTTER SEALING REQUIREMENTS SPECIFIED IN SCD BP-3.1 AND C&MS 401.15, AFTER COMPLETION OF THE SURFACE COURSE, THE CONTRACTOR SHALL USE A CERTIFIED 702.01 PG BINDER TO SEAL THE FOLLOWING LOCATIONS:

- ALL CASTINGS INCLUDING BUT NOT LIMITED TO MONUMENTS, MANHOLES, WATER VALVES, CATCH BASINS, CURB INLETS.
- BUTT JOINTS AND FEATHER JOINTS INCLUDING BRIDGE APPROACHES.
- FORWARD JOINT FOR DRIVEWAY ASPHALT AND TRAILING JOINT WHEN BUTTING TO EXISTING ASPHALT DRIVE.
- PERIMETER OF ALL PAVEMENT REPAIRS OR OTHER ASPHALT INLAYS WHEN PAVEMENT REPAIRS/INLAYS ARE NOT OVERLAID WITH AN ASPHALT CONCRETE SURFACE COURSE.
- ALL COLD LONGITUDINAL JOINTS BETWEEN PAVED SHOULDERS AND GUARDRAIL ASPHALT.

THE MATERIAL USED SHALL BE A CERTIFIED 702.01 PG BINDER. THE WIDTH OF THE SEALER SHALL BE 2-3 INCHES.

ANY ADDITIONAL COSTS ASSOCIATED WITH THE WORK IDENTIFIED IN THIS NOTE SHALL BE INCLUDED IN THE APPROPRIATE ASPHALT CONCRETE SURFACE COURSE ITEM OF WORK.

ITEM 202 - REMOVAL MISC.: CONCRETE FOUNDATIONS

THE EXISTING CONCRETE FOUNDATIONS AT STA. 93+21, 20' RT AND STA. 99+04, 20.3' RT SHALL BE REMOVED AND DISPOSED OF. COSTS FOR ALL WORK, LABOR, EQUIPMENT, AND MATERIALS SHALL BE INCLUDED IN THE UNIT PRICE FOR THIS ITEM.

THE FOLLOWING QUANTITY HAS BEEN CARRIED TO THE GENERAL SUMMARY:

202, REMOVAL MISC.: CONCRETE FOUNDATIONS	2 EACH
------------------------------------------	--------

ITEM 202 - REMOVAL MISC.: STONES, POSTS, LANDSCAPING, AND WALLS

THE EXISTING STONES, POSTS, LANDSCAPING, AND WALLS MARKED SHALL BE REMOVED AND DISPOSED OF AS DIRECTED BY THE ENGINEER.

INCLUDED IN THE LUMP SUM COST OF THIS ITEM ARE THE FOLLOWING QUANTITIES AND LOCATIONS FOR INFORMATION ONLY:

STONES STA. 82+69, 22' LT; STA. 83+33, 18' RT; STA. 85+41, 30' LT; STA. 85+65, 35' LT; STA. 86+55, 31' RT TO STA. 86+66, 21' RT; STA. 91+32, 29' RT	11 EACH
POSTS STA. 82+81, 46' RT	1 EACH
LANDSCAPING STA. 85+41, 20' LT	1 EACH
WALLS STA. 82+67, 38' RT	1 EACH

COSTS FOR ALL WORK, LABOR, EQUIPMENT, AND MATERIALS SHALL BE INCLUDED IN THE UNIT PRICE FOR THIS ITEM.

THE FOLLOWING QUANTITY HAS BEEN CARRIED TO THE GENERAL SUMMARY:

202, REMOVAL MISC.: STONES, POSTS, LANDSCAPING, AND WALLS	LS
--------------------------------------------------------------	----

AIRWAY/HIGHWAY CLEARANCE FOR AIRPORTS AND HELIPORTS

THIS PROJECT HAS BEEN IDENTIFIED AS BEING WITHIN THE INFLUENCE AREA OF A PUBLIC USE AIRPORT OR HELIPORT. NO TEMPORARY STRUCTURES OR CONSTRUCTION EQUIPMENT AT MAXIMUM OPERATING HEIGHT SHALL EXCEED A HEIGHT OF 100 FT. IF ANY TEMPORARY STRUCTURES OR CONSTRUCTION EQUIPMENT WILL EXCEED THIS HEIGHT, FURTHER COORDINATION WITH THE FEDERAL AVIATION ADMINISTRATION (FAA), AND ODOT OFFICE OF AVIATION, WILL BE NECESSARY PRIOR TO ERECTING SUCH TEMPORARY STRUCTURES OR OPERATING SUCH EQUIPMENT ON THE PROJECT. THE CONTRACTOR WILL BE REQUIRED TO SUBMIT FORM 7460-1 TO THE FAA. NOTIFY THE ODOT OFFICE OF AVIATION WHEN SUBMITTING FAA FORM 7460-1.

NO TEMPORARY STRUCTURES OR CONSTRUCTION EQUIPMENT SHALL EXCEED THE PERMISSIBLE HEIGHT, UNTIL A COPY OF THE FAA APPROVAL AND THE ODOT OFFICE OF AVIATION PERMIT HAS BEEN FURNISHED TO THE PROJECT ENGINEER.

FEDERAL AVIATION ADMINISTRATION
SOUTHWEST REGIONAL OFFICE
OBSTRUCTION EVALUATION GROUP
10101 HILLWOOD PARKWAY
FORT WORTH, TX 76177
FAX: (817) 222-5920
<http://ceaaa.faa.gov>

OHIO DEPARTMENT OF TRANSPORTATION OFFICE OF AVIATION
2829 WEST DUBLIN-GRANVILLE ROAD
COLUMBUS, OHIO 43235
Ohio.airport.protection@dot.ohio.gov

ITEM 204 - SUBGRADE COMPACTION AND PROOF ROLLING

CONSTRUCT THE SUBGRADE AS FOLLOWS AND IN THE FOLLOWING SEQUENCE:

1. SHAPE THE SUBGRADE TO WITHIN 0.2 FEET OF THE PLAN SUBGRADE ELEVATION.
2. EXCAVATE AND REPLACE UNSUITABLE SUBGRADE BEFORE PROOF ROLLING. THE EXCAVATION LIMITS ARE SHOWN AND LABELED ON THE CROSS SECTIONS AS UNSUITABLE SUBGRADE. UNSUITABLE SUBGRADE INCLUDES UNSUITABLE SOIL (A-4B, A-2-5, A-5, A-7-5, AND SOIL WITH A LIQUID LIMIT GREATER THAN 65) AND ANY COAL, SHALE, OR ROCK WHICH NEEDS TO BE REMOVED ACCORDING TO SECTION 204.05 OF THE CONSTRUCTION AND MATERIAL SPECIFICATIONS (C&MS).

IF THERE IS UNSUITABLE SUBGRADE IN A SHALLOW FILL LOCATION, EXCAVATE AND REPLACE THE UNSUITABLE SUBGRADE BEFORE CONSTRUCTING THE SHALLOW FILL AND SHAPING THE SUBGRADE.
3. COMPACT THE SUBGRADE ACCORDING TO C&MS 204.03.
4. APPROXIMATE LIMITS FOR EXCAVATION OF UNSTABLE SUBGRADE ARE SHOWN AND LABELED ON THE CROSS SECTIONS AS UNSTABLE SUBGRADE. THE ENGINEER WILL IDENTIFY THE ACTUAL LIMITS OF EXCAVATION FOR UNSTABLE SUBGRADE BASED ON THE PROOF ROLLING RESULTS AND VISUAL OBSERVATIONS.

PROOF ROLL THE COMPACTED SUBGRADE ACCORDING TO C&MS 204.06.
5. EXCAVATE UNSTABLE SUBGRADE AS DIRECTED BY THE ENGINEER AND STABILIZE BY REPLACING WITH THE SPECIFIED MATERIALS ACCORDING TO C&MS 204.07. EXCAVATIONS WILL EXTEND 18 INCHES BEYOND THE EDGE OF THE SURFACE OF THE PAVEMENT, PAVED SHOULDERS, OR PAVED MEDIANS.
6. PROOF ROLL THE STABILIZED AREAS ACCORDING TO C&MS 204.06 TO VERIFY STABILITY.
7. FINE GRADE THE SUBGRADE TO THE SPECIFIED GRADE.

THE QUANTITIES FOR EXCAVATING THE UNSUITABLE SUBGRADE AND UNSTABLE SUBGRADE ARE BOTH PAID UNDER ITEM 204, EXCAVATION OF SUBGRADE.

ITEM SPECIAL - GAS VALVE BOX ADJUSTED TO GRADE

IN ADDITION TO THE REQUIREMENTS OF CMS 638.18 FOR VALVE BOXES, THE CONTRACTOR WILL MAKE A CLEAN CIRCULAR CUT AROUND THE CASTING (A MINIMUM OF 1'-0" OUTSIDE OF THE CASTING) AND ADJUST THE CASTING TO GRADE (ACCORDING TO THE TOLERANCES AS SHOWN ON STANDARD CONSTRUCTION DRAWING BP-3.1) AFTER THE PAVEMENT SURFACE COURSE HAS BEEN PLACED.

CMS 499 CONCRETE (DYE THE CONCRETE SUCH THAT ITS COLOR CLOSELY MATCHES THE COLOR OF THE SURROUNDING PAVEMENT) WILL BE USED FOR BACKFILLING THE FULL PAVEMENT SECTION AND THE JOINT BETWEEN THE ASPHALT AND CONCRETE WILL BE SEALED WITH CMS 702.01 PG BINDER. EPOXY COATED REBAR SHALL BE PLACED IN THE CONCRETE AT 6" MAXIMUM ON CENTER AND A MINIMUM OF 3.5" CLEARANCE FROM THE TOP, BOTTOM AND SIDES. THE CONCRETE WILL BE VIBRATED SUFFICIENTLY TO ELIMINATE AIR POCKETS UNDER THE FRAME.

PAYMENT WILL INCLUDE REMOVAL OF THE EXISTING MATERIAL, INSTALLATION AND FURNISHING OF A NEW CASTING, AND ALL LABOR AND MATERIALS REQUIRED TO COMPLETE THIS ITEM OF WORK AS DESCRIBED.

THE FOLLOWING ESTIMATED QUANTITY HAS BEEN CARRIED TO THE GENERAL SUMMARY FOR USE AS DIRECTED BY THE ENGINEER:

SPECIAL, GAS VALVE BOX ADJUSTED TO GRADE	13 EACH
------------------------------------------	---------

ENDANGERED BAT HABITAT REMOVAL

THIS PROJECT IS LOCATED WITHIN THE KNOWN HABITAT RANGES OF THE FEDERALLY LISTED AND PROTECTED INDIANA BAT AND NORTHERN LONG-EARED BAT AND THE STATE LISTED AND PROTECTED LITTLE BROWN BAT AND TRICOLORED BAT. NO TREES SHALL BE REMOVED UNDER THIS PROJECT FROM APRIL 1 THROUGH SEPTEMBER 30. ALL NECESSARY TREE REMOVAL SHALL OCCUR FROM OCTOBER 1 THROUGH MARCH 31. THIS REQUIREMENT IS NECESSARY TO AVOID AND MINIMIZE IMPACTS TO THESE SPECIES AS REQUIRED BY THE ENDANGERED SPECIES ACT (ESA). FOR THE PURPOSES OF THIS NOTE, A TREE IS DEFINED AS: A LIVE, DYING, OR DEAD WOODY PLANT, WITH A TRUNK THREE INCHES OR GREATER IN DIAMETER AT A HEIGHT OF 4.5 FEET ABOVE THE GROUND SURFACE, AND WITH A MINIMUM HEIGHT OF 13 FEET.

THE CONTRACTOR SHALL DEMARCATÉ CLEARING LIMITS IN THE FIELD TO AVOID ANY UNAUTHORIZED TREE CLEARING. AFTER CLEARING LIMITS ARE MARKED IN THE FIELD, SET UP A FIELD MEETING WITH THE ENGINEER FIVE (5) DAYS PRIOR TO ANY CLEARING ACTIVITY TO APPROVE THE LIMITS.

ITEM 619 - FIELD OFFICE, TYPE B, AS PER PLAN

A TYPE B FIELD OFFICE IS REQUIRED FOR THIS PROJECT. THE FOLLOWING REVISIONS TO EQUIPMENT SUPPLIED WITH THE TYPE B FIELD OFFICE, AS SPECIFIED IN TABLE 619.02-1, FIELD OFFICE, SHALL APPLY:

- THE BROADBAND INTERNET CONNECTION MUST MEET A MINIMUM UPLOAD SPEED OF 5MB PER SECOND.
- CONTRACTOR SHALL FURNISH AND SET UP A WI-FI ROUTER MEETING THE REQUIREMENTS OF IEEE 802.11AC FOR THE EXCLUSIVE USE OF THE DEPARTMENT.

ALL OTHER FIELD OFFICE ITEMS SUPPLIED SHALL MEET THE REQUIREMENTS OF A TYPE B, FIELD OFFICE.

ITEM 619 - FIELD OFFICE, TYPE B,
AS PER PLAN

18 MONTHS

ITEM 622 - CONCRETE BARRIER, SINGLE SLOPE, TYPE D, AS PER PLAN

THIS ITEM SHALL CONSIST OF CONSTRUCTING CONCRETE BARRIER, SINGLE SLOPE, TYPE D WITH A 9" FOOTER AND 6" OF ITEM 304 - AGGREGATE BASE.

FOR DETAIL SEE SHEET 127.

ALL LABOR, MATERIALS, EQUIPMENT, EXCAVATION AND INCIDENTALS NECESSARY TO COMPLETE THE WORK SHOWN ON THE PLANS SHALL BE INCLUDED FOR PAYMENT UNDER THE PER FOOT PRICE FOR ITEM 622, CONCRETE BARRIER, SINGLE SLOPE, TYPE D, AS PER PLAN.

P:\3000-3499\302317010_CUY-CR57-4.43_(Wallings_Road)\00T\06239_CUY-77-4.79\Design\Roadway\Sheets\06239_GN003.dgn 9/13/2024 4:19:59 PM Khllegass

ITEM SPECIAL - PAVEMENT OVERLAY FABRIC COMPOSITE

DESCRIPTION. THIS WORK SHALL CONSIST OF FURNISHING AND INSTALLING PAVEMENT OVERLAY FABRIC COMPOSITE AS SHOWN ON THE PLANS AND AT LOCATIONS DESIGNATED BY THE ENGINEER.

MATERIALS. PAVEMENT OVERLAY FABRIC COMPOSITE SHALL BE GLASGRID CG100 COMPOSITE ASPHALT REINFORCEMENT SOLUTION, TENCATE MIRAFI MPG100 (PGM-G100/100), OR APPROVED EQUAL. COMPOSITE SHALL BE CONSTRUCTED OF LONG CHAIN SYNTHETIC POLYMERS COMPOSED OF AT LEAST 85 PERCENT OF POLYOLEPHINES, POLYESTERS, AND POLYAMIDES BY WEIGHT, SHALL BE RESISTANT TO CHEMICAL ATTACK, MILDEW, ROT, AND ATTACHED TO A FIBERGLASS GRID. MATERIALS SHALL BE SUBMITTED TO THE ENGINEER A MINIMUM OF SEVEN (7) DAYS PRIOR TO INSTALLATION.

THE COMPOSITE FABRIC SHALL NOT BE EXPOSED TO ULTRAVIOLET RADIATION FOR MORE THAN 7 DAYS. THE FABRIC WIDTH SHALL BE INDICATED ON THE TYPICAL SECTION AND FURNISHED IN ROLLS.

THE ASPHALT SEALANT SHALL BE PG64-22 MEETING THE REQUIREMENTS OF 702.01.

CERTIFICATION SHALL BE FURNISHED IN ACCORDANCE WITH 106.01 BEFORE THE FABRIC IS PLACED. THE ENGINEER MAY REQUIRE SAMPLING FOR TESTING PURPOSES AS DIRECTED BY THE LABORATORY.

EQUIPMENT. THE CONTRACTOR SHALL PROVIDE EQUIPMENT FOR HEATING AND APPLYING BITUMINOUS MATERIAL. HEATING EQUIPMENT AND DISTRIBUTORS SHALL MEET THE REQUIREMENTS OF 407.

THE MECHANICAL LAYDOWN EQUIPMENT SHALL BE MOUNTED ON A FOUR-WHEELER VEHICLE THAT IS CAPABLE OF DRIVING OVER THE FABRIC WHILE IT IS BEING INSTALLED TO CONTROL THE TENSION ON THE MATERIAL. THE LAYDOWN MACHINE SHALL BE EQUIPPED WITH CLUTCHES TO ADJUST THE ROLL TENSION AND BROOMS TO SMOOTH OUT WRINKLES DURING INSTALLATION. MANUAL LAYDOWN MAY ONLY BE USED IN AREAS INACCESSIBLE TO THE LAYDOWN MACHINE.

CONSTRUCTION DETAILS

1. SURFACE PREPARATION. THE CRACKS AND ENTIRE ROAD SURFACE TO BE TREATED, AND AT LEAST ONE ADDITION FOOT ON EACH SIDE, SHALL BE CLEANED BY SWEEPING, BLOWING, OR OTHER METHODS UNTIL ALL DUST, MUD, CLAY LUMPS, VEGETATION, AND FOREIGN MATERIAL ARE REMOVED ENTIRELY FROM THE PAVEMENT BEFORE THE BITUMINOUS MATERIAL IS APPLIED. CARE SHALL BE EXERCISED TO PREVENT MATERIAL SO REMOVED FROM BECOMING MIXED WITH THE NEW SURFACE. LARGE CRACKS AND POTHoles SHOULD BE FILLED.

2. APPLICATION OF ASPHALT SEALANT. THE APPLICATION OF THE ASPHALT SEALANT SHALL CONFORM TO THE APPLICABLE PORTIONS OF 407. THE ASPHALT SEALANT SHALL BE UNIFORMLY SPRAYED OVER THE AREA TO BE COVERED BY FABRIC AT A RATE OF 0.25 TO 0.30 GALLON PER SQUARE YARD.

THE QUANTITY APPLIED WILL VARY WITH THE SURFACE CONDITION OF THE EXISTING PAVEMENT (DEGREE OF POROSITY, FOR EXAMPLE). THE FABRIC ALONE, UNDER HEAT OF THE OVERLAY, WILL ABSORB AT LEAST 0.20 GALLON PER SQUARE YARD. WITHIN INTERSECTIONS OR OTHER ZONES WHERE VEHICLE BRAKING IS COMMON PLACE, THE APPLICATION SHALL BE REDUCED 20 PERCENT. THE SEALANT SHALL BE APPLIED TO AN AREA TWO TO SIX INCHES WIDER THAN THE WIDTHS OF THE FABRIC BEING PLACED, BUT RESTRICTED TO THE AREA OF IMMEDIATE FABRIC LAYDOWN. APPLICATION SHALL BE BY DISTRIBUTOR WITH HAND SPRAYING ALLOWED ONLY WHERE THE DISTRIBUTOR CANNOT BE USED. ASPHALT SPILLS SHALL BE CLEANED FROM THE ROAD SURFACE TO AVOID FLUSHING AND POSSIBLE MOVEMENT AT THESE ASPHALT RICH AREAS.

THE ASPHALT CEMENT USED AS A SEALANT SHALL HAVE DISTRIBUTOR TANK TEMPERATURE BETWEEN 300 DEGREES AND 350 DEGREES F. APPLICATION TEMPERATURE IS NOT CRITICAL AFTER THE ASPHALT IS SPRAYED ON THE PAVEMENT. IF THE FABRIC IS TO BE OVER-SPRAYED, DISTRIBUTOR TANK TEMPERATURES SHOULD NOT EXCEED 350 DEGREES F TO AVOID DAMAGE TO THE FABRIC.

ITEM SPECIAL - PAVEMENT OVERLAY FABRIC COMPOSITE (CONT.)

3. COMPOSITE FABRIC PLACEMENT. THE COMPOSITE FABRIC SHALL BE PLACED ON THE ASPHALT SEALANT AS SOON AS PRACTICAL AND BEFORE THE TACKINESS OF THE SEALANT IS LOST. THE COMPOSITE SHALL BE PLACED AS SMOOTHLY AS POSSIBLE TO AVOID WRINKLES. IT SHALL BE UNROLLED SO THAT THE SOFT SIDE IS UNWOUND INTO THE SEALANT AND THE GRID SIDE UP, THUS PROVIDING OPTIMUM BOND BETWEEN FABRIC AND PAVEMENT DURING THE CONSTRUCTION PROCESS. WRINKLES SEVERE ENOUGH TO CAUSE FOLDS SHALL BE SLIT AND LAID FLAT. SMALL WRINKLES, WHICH FLATTEN UNDER COMPACTION ARE NOT DETRIMENTAL TO PERFORMANCE. THE COMPOSITE SHALL BE BROOMED OR SQUEEGED TO REMOVE AIR BUBBLES AND MAKE COMPLETE CONTACT WITH THE ROAD SURFACE AS RECOMMENDED BY THE FABRIC MANUFACTURER. THE FABRIC SHALL BE LAID STRAIGHT, WITHIN THE SEALANT AREA. MODERATE CURVES CAN BE NEGOTIATED BY STRETCHING THE FABRIC ON THE OUTSIDE OF THE CURVE BY ADJUSTING THE DRAG ON THE BRAKES OF THE LAYDOWN EQUIPMENT. TRANSVERSE JOINTS SHALL BE SHINGLED IN THE DIRECTION OF PAVING.

LONGITUDINAL JOINTS SHALL BE MADE BY OVERLAPPING THE FABRIC ONE TO TWO INCHES. TRANSVERSE JOINTS SHALL BE MADE BY OVERLAPPING THE FABRIC MINIMUM OF FOUR INCHES. ADDITIONAL SEALANT (ABOUT 0.20 GAL. PER SQ. YD.) SHALL BE ADDED TO THE JOINTS AS REQUIRED. THE ADDITIONAL SEALANT FOR TRANSVERSE JOINTS MAY BE APPLIED BY HAND SPRAYING OR WITH MOP AND BUCKET IF EXTREME CARE IS TAKEN TO NOT EXCEED THE SPECIFIED RATE.

TO ENHANCE THE BOND OF THE FABRIC WITH THE EXISTING PAVEMENT AND TO SMOOTH OUT ANY WRINKLES FOR FOLDS IN THE FABRIC, THE CONTRACTOR MAY BE REQUIRED TO PNEUMATICALLY ROLL THE FABRIC AFTER IT IS PLACED.

4. TREATMENT OF THE APPLIED COMPOSITE PRIOR TO THE ASPHALT CONCRETE. IT IS UNNECESSARY TO TACK COAT THE FABRIC PRIOR TO PLACEMENT OF THE OVERLAY UNLESS THERE ARE CIRCUMSTANCES SUCH AS DELAY OF OVERLAY, DUST ACCUMULATION OR UNDER APPLICATION OF SEALANT WHICH WOULD MAKE TACK COATING DESIRABLE. IF A TACK COAT IS REQUIRED, EMULSIFIED ASPHALT SHALL BE APPLIED AT A RATE OF 0.02 TO 0.05 GALLON PER SQUARE YARD RESIDUAL ASPHALT. PLACEMENT OF THE ASPHALT CONCRETE OVERLAY SHALL CLOSELY FOLLOW FABRIC LAYDOWN. IN THE EVENT THAT THE SEALANT BLEEDS THROUGH THE FABRIC BEFORE THE ASPHALT CONCRETE IS PLACED, IT MAY BE NECESSARY TO BLOT THE SEALANT BY SPREADING SAND OR ASPHALT CONCRETE OVER THE AFFECTED AREAS. THIS WILL PREVENT ANY TENDENCY FOR CONSTRUCTION EQUIPMENT TO PICK UP THE FABRIC WHEN DRIVING OVER IT.

TURNING OF THE PAVER AND OTHER VEHICLES SHALL BE GRADUAL TO AVOID MOVEMENT OR DAMAGE TO THE COMPOSITE. UNESSENTIAL TRAFFIC ON COMPOSITE SHOULD BE ELIMINATED. IF IT IS NECESSARY TO OPEN THE ROAD TO TRAFFIC AFTER FABRIC PLACEMENT, BUT PRIOR TO PAVING, IT IS ADVISABLE TO SPREAD A SMALL AMOUNT OF SAND OVER THE MEMBRANE TO PREVENT TIRES FROM STICKING TO THE SEALANT OR PULLING UP THE COMPOSITE. THIS PRACTICE IS TO BE AVOIDED IF POSSIBLE TO PREVENT DAMAGE TO THE MEMBRANE. QUICK STOPS AND SHARP TURNS MAY DAMAGE THE MATERIAL. IF RAIN PRIOR TO THE OVERLAY SHOULD CAUSE A BLISTERED APPEARANCE AND SOME BOND LOSS THROUGHOUT THE MEMBRANE, IT SHOULD BE CORRECTED BY PNEUMATIC ROLLING UNTIL ADHESION IS RESTORED.

5. ASPHALT CONCRETE. THE ASPHALT CONCRETE OVERLAY SHALL CONFORM TO 401 SPECIFICATION WITH A MINIMUM THICKNESS OF 1.5.

METHOD OF MEASUREMENT. THE ACCEPTED FABRIC COMPOSITE PLACED IN ACCORDANCE WITH THESE SPECIFICATIONS AND AS DIRECTED WILL BE MEASURED BY THE SQUARE YARD OF ROADWAY, RAMPS, AND TURNOUTS COVERED BY THE COMPOSITE FABRIC. LAPS IN COMPOSITE FABRIC WILL NOT BE MEASURED.

BLOTTING THE SEALANT, SPREADING SAND OR ASPHALT CONCRETE OVER THE MEMBRANE TO PREVENT TIRES FROM STICKING TO THE SEALANT OR PULLING UP THE FABRIC, ROLLING TO RESTORE BOND, OR APPLICATION OF A TACK COAT WILL NOT BE MEASURED FOR DIRECT PAYMENT BUT SHALL BE CONSIDERED A NECESSARY PART OF THE CONSTRUCTION INVOLVED AND THE COST THEREFORE SHALL BE INCLUDED IN OTHER APPROPRIATE CONTRACT UNIT PRICES.


ITEM SPECIAL - PAVEMENT OVERLAY FABRIC COMPOSITE (CONT.)

BASIS OF PAYMENT. THE ACCEPTED QUANTITIES OF PAVEMENT OVERLAY FABRIC COMPOSITE WILL BE PAID FOR AT THE CONTRACT UNIT PRICE PER SQUARE YARD, WHICH PRICE AND PAYMENT SHALL BE FULL COMPENSATION FOR FURNISHING ALL LABOR, MATERIALS (INCLUDING ASPHALT SEALANT AND OVERLAY), TOOLS, EQUIPMENT AND INCIDENTALS FOR DOING ALL THE WORK INVOLVED IN FURNISHING AND PLACING THE COMPOSITE COMPLETE IN PLACE AS SHOWN ON THE PLANS OR AS DIRECTED.

ITEM 251 - PARTIAL DEPTH PAVEMENT REPAIR (441)

A QUANTITY OF THIS ITEM SHALL BE PROVIDED FOR USE AS DIRECTED BY THE ENGINEER. THE ITEM SHALL CONSIST OF REPAIRING EXISTING LOCATIONS EXHIBITING SURFACE DETERIORATION AND PLACING ITEM 441 ASPHALT CONCRETE INTERMEDIATE COURSE, TYPE 2 AND ITEM 407 TACK COAT, 702.13, AS DIRECTED BY THE ENGINEER. IT IS NOT THE INTENT TO REPAIR EVERY DETERIORATED AREA WITHIN THE PROJECT. THE ENGINEER SHALL DETERMINE WHICH AREAS ARE TO BE REPAIRED. THIS ITEM SHALL COMMENCE WITHIN 7 DAYS OF THE COMPLETION OF PAVEMENT PLANING. PAYMENT SHALL BE BASED ON THE ACTUAL NUMBER OF SQUARE YARDS OF PAVEMENT REPAIR. THE FOLLOWING ESTIMATED QUANTITY HAS BEEN CARRIED TO THE GENERAL SUMMARY:

251, PARTIAL DEPTH PAVEMENT REPAIR (441) 66 SY

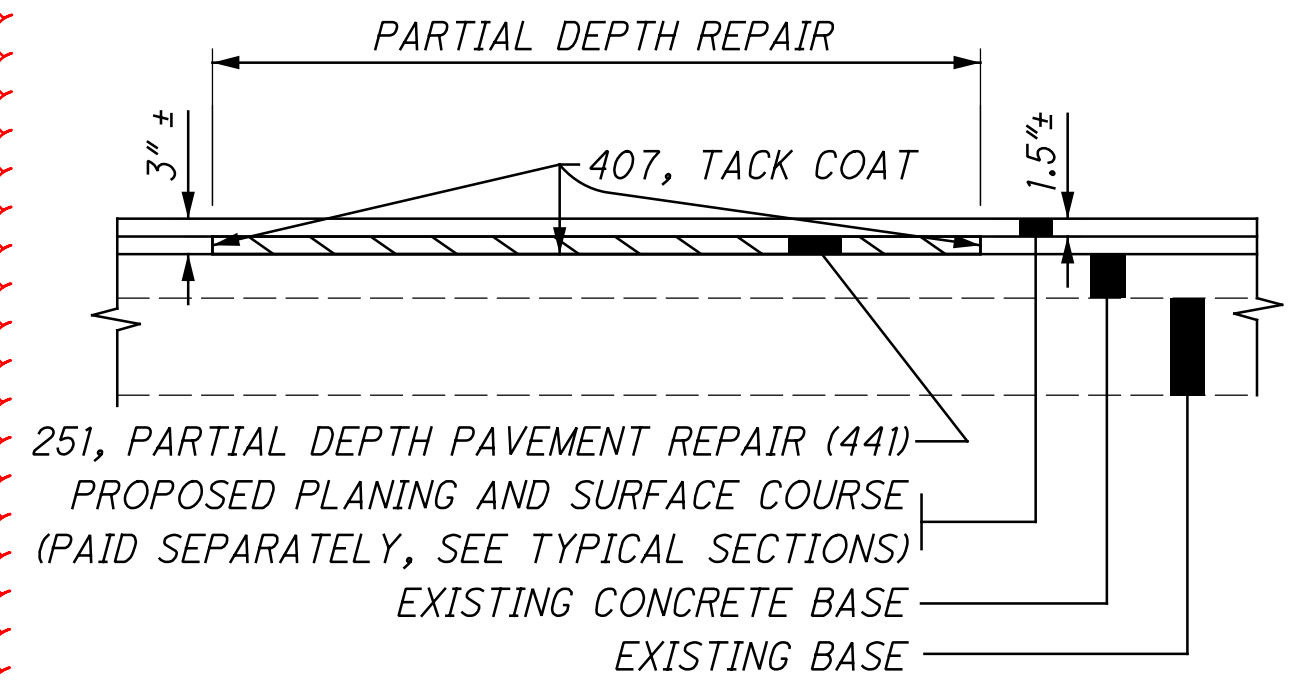


251, PARTIAL DEPTH PAVEMENT REPAIR (441)
PROPOSED PLANING AND SURFACE COURSE
(PAID SEPARATELY, SEE TYPICAL SECTIONS)
EXISTING CONCRETE BASE
EXISTING BASE

LOCATIONS OF EXISTING CONCRETE BASE

ITEM 253 - PAVEMENT REPAIR, AS PER PLAN

A QUANTITY OF THIS ITEM SHALL BE PROVIDED FOR USE AS DIRECTED BY THE ENGINEER. THE ITEM SHALL CONSIST OF REPAIRING EXISTING LOCATIONS EXHIBITING SURFACE DETERIORATION AND PLACING ITEM 301 ASPHALT CONCRETE BASE, PG64-22 AND ITEM 407 TACK COAT, AS DIRECTED BY THE ENGINEER. THE ASPHALT CONCRETE SHALL BE COMPACTED WITH A TYPE I PNEUMATIC TIRE ROLLER AND A STEEL WHEEL ROLLER AS PER 401.13. IT IS NOT THE INTENT TO REPAIR EVERY DETERIORATED AREA WITHIN THE PROJECT. THE ENGINEER SHALL DETERMINE WHICH AREAS ARE TO BE REPAIRED. THIS ITEM SHALL COMMENCE WITHIN 7 DAYS OF THE COMPLETION OF PAVEMENT PLANING OR BEFORE THE PLACEMENT OF INTERMEDIATE COURSE ON THE OVERLAY SECTION OF WALLINGS ROAD. PAYMENT SHALL BE BASED ON THE ACTUAL NUMBER OF SQUARE YARDS OF PAVEMENT REPAIR. THE FOLLOWING ESTIMATED QUANTITY HAS BEEN CARRIED TO THE GENERAL SUMMARY:

253, PAVEMENT REPAIR, AS PER PLAN 225 SY

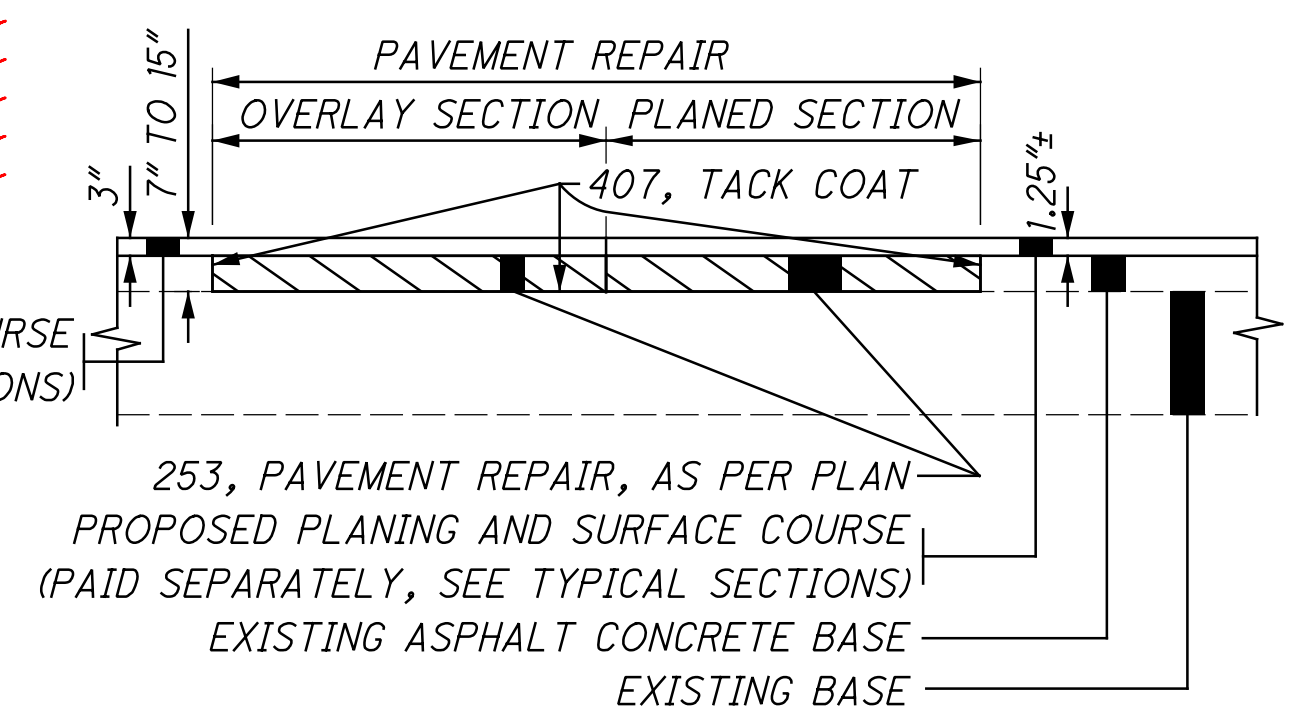

PROPOSED SURFACE & INTERMEDIATE COURSE
(PAID SEPARATELY, SEE TYPICAL SECTIONS)

253, PAVEMENT REPAIR, AS PER PLAN
PROPOSED PLANING AND SURFACE COURSE
(PAID SEPARATELY, SEE TYPICAL SECTIONS)
EXISTING ASPHALT CONCRETE BASE
EXISTING BASE

LOCATIONS OF EXISTING ASPHALT CONCRETE BASE


P:\3000-3499\3023170010_CUY-CR57-4.43_(Wallings_Road)\00T\06239_CUY-77-4.79_Design\Roadway\Sheets\06239_GN004.dgn 9/13/2024 4:48:00 PM khillegass

P:\3000_3499\3023170010_CUY-CR57-4.43 (Wallings_Road)\001\06239_CUY-77-4.79\Design\MOT\Sheets\106239_XM001.dgn 9/13/2024 4:04:04 PM Khillegass

SEEDING	
END WIDTH	SO. YDS.

FOR LEGEND, SEE SHEET 50.
ALL TEMPORARY PAVEMENT SHOWN SHALL BE CONSTRUCTED IN PHASE 2.

END AREA		VOLUME		CALCULATED	CHECKED
CUT	FILL	CUT	FILL	KAH	RAK

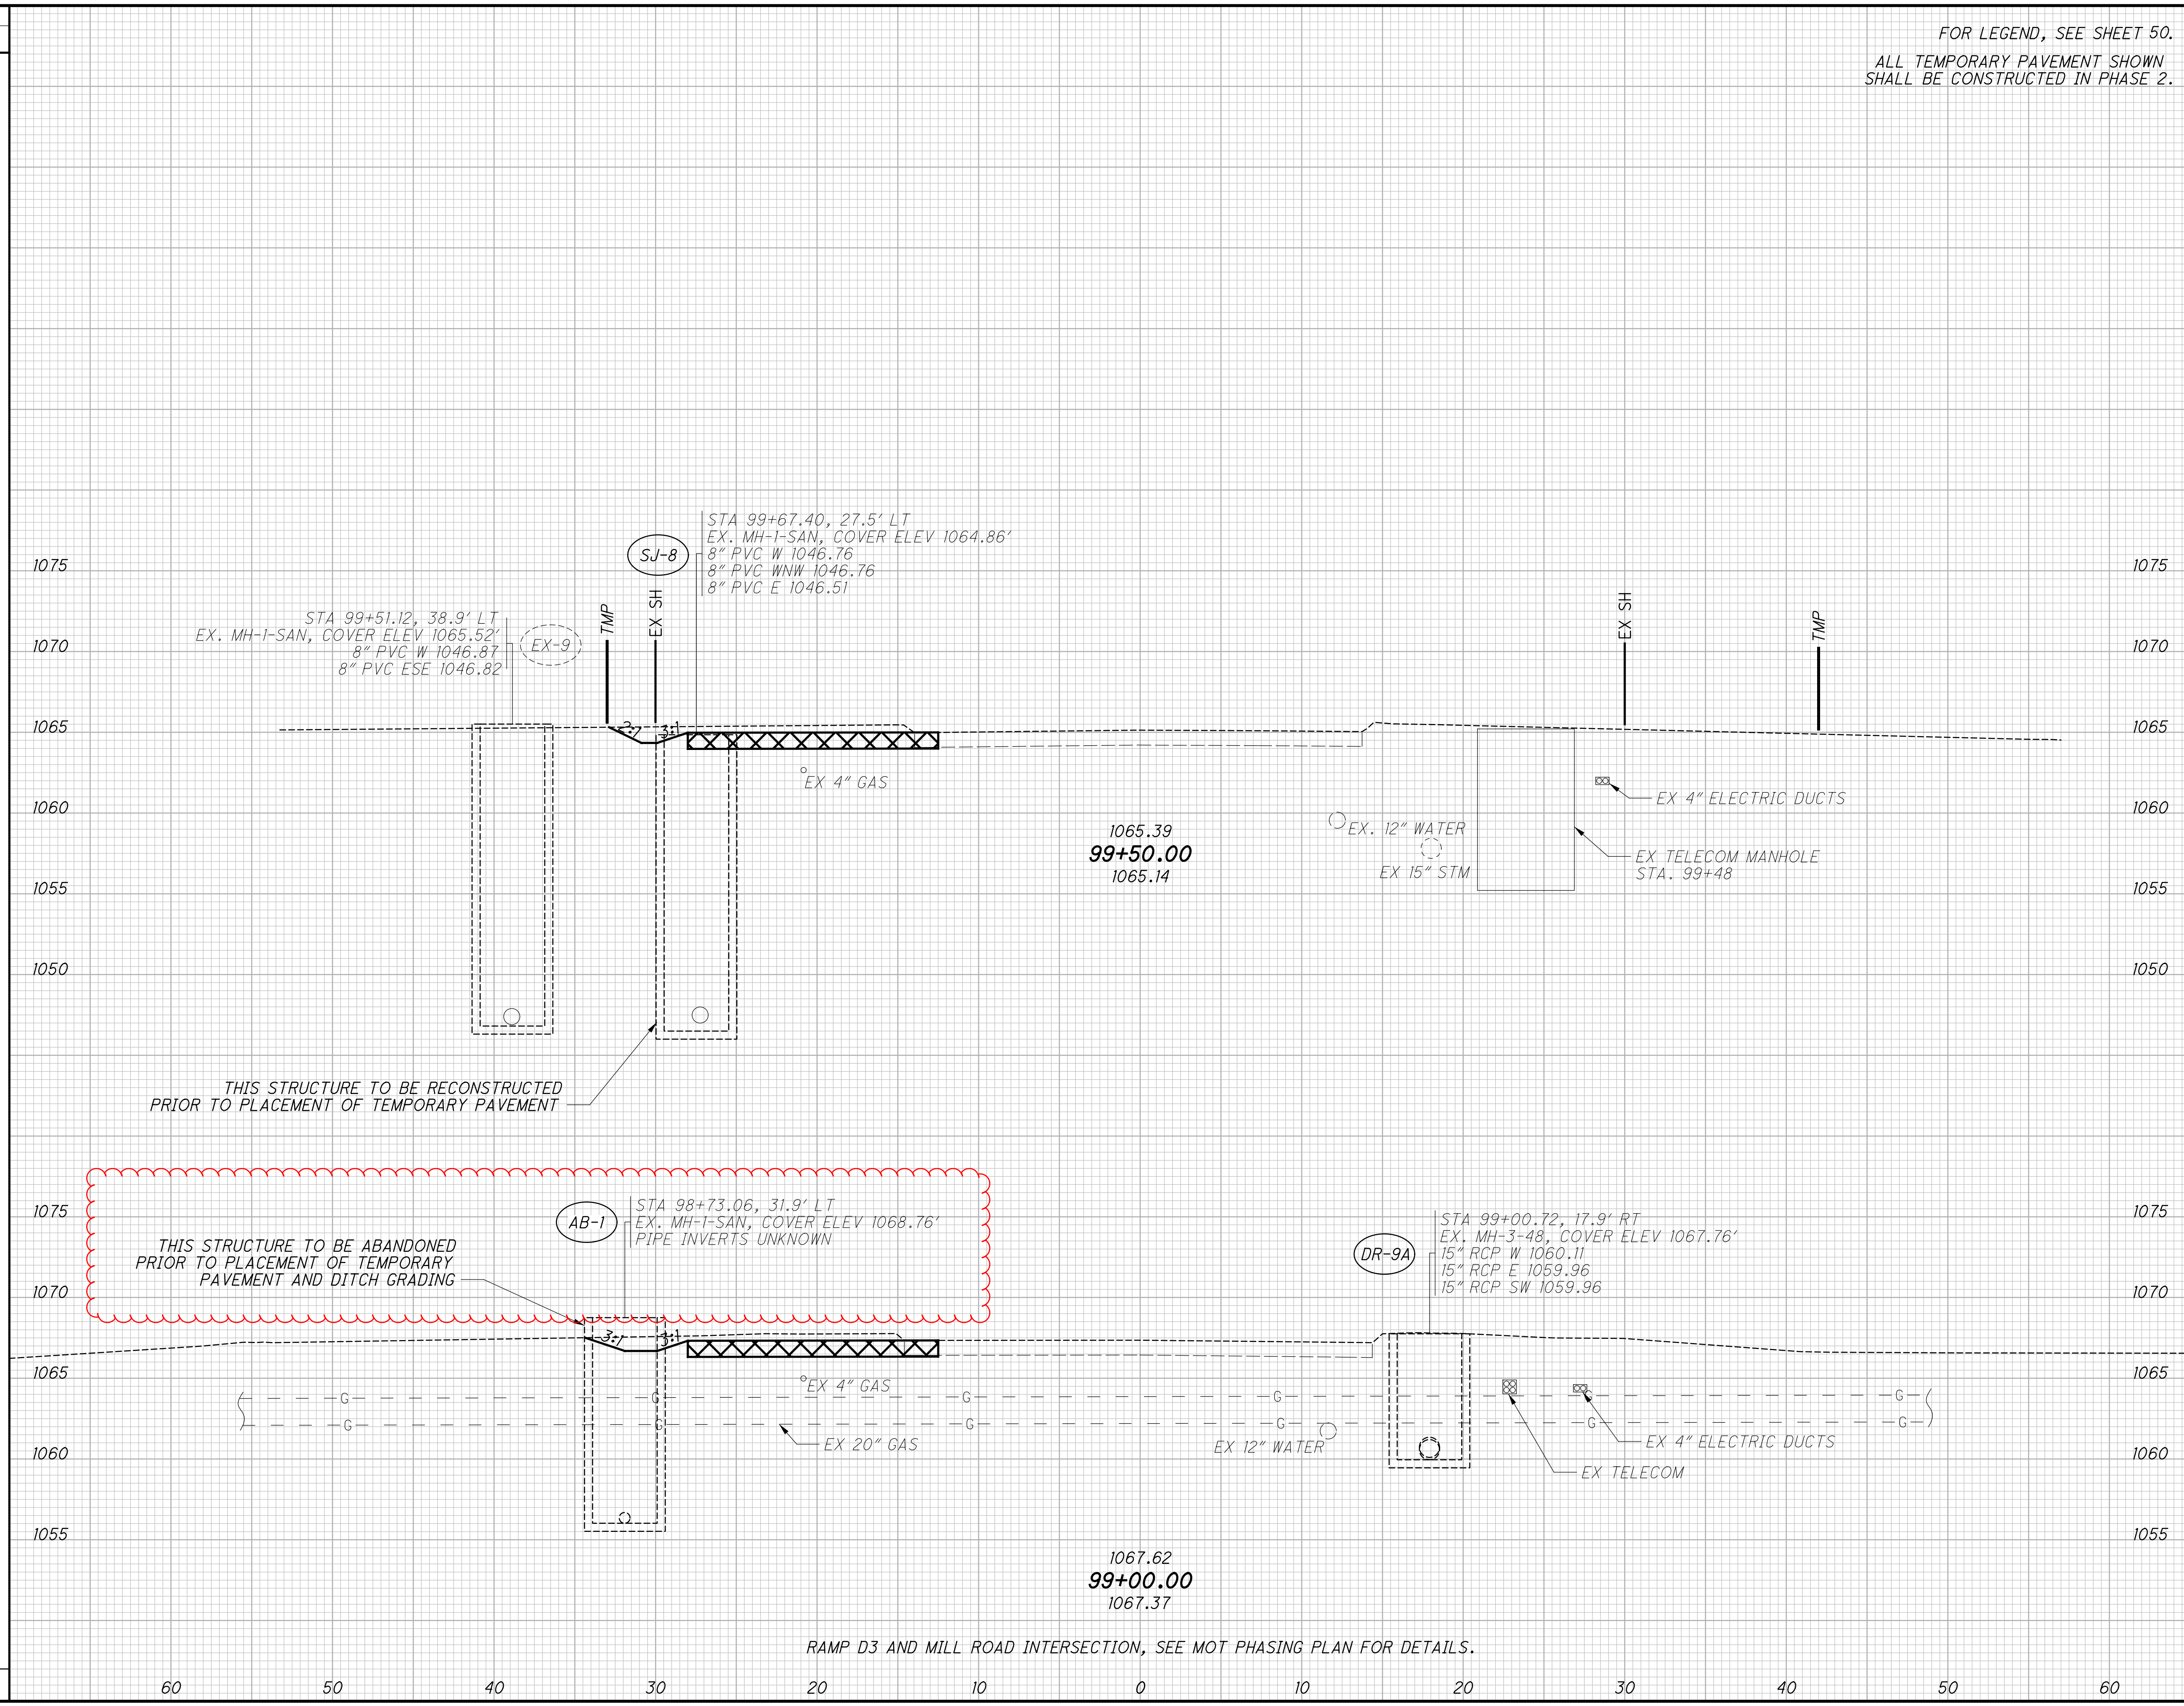

THIS STRUCTURE TO BE RECONSTRUCTED PRIOR TO PLACEMENT OF TEMPORARY PAVEMENT

THIS STRUCTURE TO BE ABANDONED PRIOR TO PLACEMENT OF TEMPORARY PAVEMENT AND DITCH GRADING

RAMP D3 AND MILL ROAD INTERSECTION, SEE MOT PHASING PLAN FOR DETAILS.

MAINTENANCE OF TRAFFIC CROSS SECTIONS
WALLINGS RD PHASE 3 - STA. 99+00.00 TO STA. 99+50.00

CUY-77-4.79

SHEET NUM.													PART.	ITEM	ITEM	GRAND	UNIT	DESCRIPTION	SEE SHEET NO.	CALCULATED	CHECKED
OFFICE CALCS	12	13	14	63	66	67	68	107	119	122	127		01/SAF/04	EXT	TOTAL						
						160							160	611	00510	160	FT	DRAINAGE (CONT.)			
	100												100	611	00900	100	FT	6" CONDUIT, TYPE F FOR UNDERDRAIN OUTLETS			
	100				509								609	611	04400	609	FT	6" CONDUIT, TYPE B			
					90								90	611	04400	90	FT	12" CONDUIT, TYPE B			
					10								10	611	04600	10	FT	12" CONDUIT, TYPE B, 706.02			
																		12" CONDUIT, TYPE C, 706.02			
	150				204								354	611	05900	354	FT	15" CONDUIT, TYPE B			
					60								60	611	05900	60	FT	15" CONDUIT, TYPE B, 706.02			
					30								30	611	05900	30	FT	15" CONDUIT, TYPE B, 706.08			
					85								85	611	06700	85	FT	15" CONDUIT, TYPE F, 707.05 TYPE C OR 707.21			
					1								1	611	98150	1	EACH	CATCH BASIN, NO. 3			
					13								13	611	98180	13	EACH	CATCH BASIN, NO. 3A			
					1								1	611	98371	1	EACH	CATCH BASIN, NO. 6, AS PER PLAN			12
					3								3	611	98630	3	EACH	CATCH BASIN ADJUSTED TO GRADE			
					10								10	611	99574	10	EACH	MANHOLE, NO. 3			
	3												3	611	99651	3	EACH	MANHOLE FRAME AND COVER, AS PER PLAN			12
	3,000												3,000	SPECIAL	61199820	3,000	LB	MISCELLANEOUS METAL			12
		LS											LS	611	99920	LS		DRAINAGE STRUCTURE, MISC.: CATCH BASIN LINING			13
																		PAVEMENT			
					66								66	251	01000	66	SY	PARTIAL DEPTH PAVEMENT REPAIR (441)			14
					225								225	253	01001	225	SY	PAVEMENT REPAIR, AS PER PLAN			14
1,607													1,607	254	01000	1,607	SY	PAVEMENT PLANING, ASPHALT CONCRETE, 1.25"			
1,321													1,321	254	01000	1,321	SY	PAVEMENT PLANING, ASPHALT CONCRETE, 1.5"			
	1,222	86											1,308	301	56000	1,308	CY	ASPHALT CONCRETE BASE, PG64-22, (449)			
								14					14	301	56100	14	CY	ASPHALT CONCRETE BASE, PG64-22, (449), (DRIVEWAYS), 3.5"			
	1,497							78					1,575	304	20000	1,575	CY	AGGREGATE BASE			
	1,454							7					1,461	407	20000	1,461	GAL	NON-TRACKING TACK COAT			
	471												471	441	10101	471	CY	ASPHALT CONCRETE SURFACE COURSE, TYPE 1, (446), AS PER PLAN, PG70-22M, 1.25" OR 1.5"			13
	497												497	441	10200	497	CY	ASPHALT CONCRETE INTERMEDIATE COURSE, TYPE 2, (446), 1.75"			
								5					5	441	70500	5	CY	ASPHALT CONCRETE SURFACE COURSE, TYPE 1, (449), (DRIVEWAYS), PG64-22, 1.25"			
								3					3	441	70700	3	CY	ASPHALT CONCRETE INTERMEDIATE COURSE, TYPE 2, (449), (DRIVEWAYS), PG64-22, 1.75"			
								485					485	452	10050	485	SY	6" NON-REINFORCED CONCRETE PAVEMENT, CLASS QC MS OR QC1 WITH ACCELERATOR			
								167					167	452	12050	167	SY	8" NON-REINFORCED CONCRETE PAVEMENT, CLASS QC MS OR QC1 WITH ACCELERATOR			
					2,896								2,896	609	12000	2,896	FT	COMBINATION CURB AND GUTTER, TYPE 2			
					36								36	609	24510	36	FT	CURB, TYPE 4-C			
					963			114					1,077	609	26000	1,077	FT	CURB, TYPE 6			
	128												128	SPECIAL	69012060	128	SY	PAVEMENT OVERLAY FABRIC COMPOSITE			14
											10		10	SPECIAL	69098300	10	SY	FULL DEPTH SHOULDER PAVEMENT REPLACEMENT			127
																		WATER WORK			
								28					28	638	00600	28	FT	6" WATER MAIN DUCTILE IRON PIPE ANSI CLASS 52, PUSH-ON JOINTS AND FITTINGS			
								45					45	638	01200	45	FT	8" WATER MAIN DUCTILE IRON PIPE ANSI CLASS 52, PUSH-ON JOINTS AND FITTINGS			
								178		150			328	638	02400	328	FT	12" WATER MAIN DUCTILE IRON PIPE ANSI CLASS 52, PUSH-ON JOINTS AND FITTINGS			
										268			268	638	04900	268	FT	1" COPPER SERVICE BRANCH			
								251					251	638	06200	251	FT	POLYETHYLENE ENCASEMENT			
								2					2	638	07800	2	EACH	6" GATE VALVE AND VALVE BOX			
								2					2	638	07900	2	EACH	8" GATE VALVE AND VALVE BOX			
								4		2			6	638	08100	6	EACH	12" GATE VALVE AND VALVE BOX			
								2					2	638	10200	2	EACH	6" FIRE HYDRANT			
								2					2	638	10700	2	EACH	FIRE HYDRANT REMOVED AND DISPOSED OF			
								3					3	638	10800	3	EACH	VALVE BOX ADJUSTED TO GRADE			
								3					3	638	10900	3	EACH	SERVICE BOX ADJUSTED TO GRADE			
								2					2	SPECIAL	63821002	2	EACH	INSTALL 1" METER SETTING, COMPLETE, CLEVELAND			121
										3			3	638	98000	3	EACH	WATER WORK, MISC.: 1" SERVICE VALVE & VALVE BOX, COMPLETE			122
								15					15	638	98000	15	EACH	WATER WORK, MISC.: POT-HOLING EXISTING WATER MAIN			119
								LS					LS	638	98100	LS		WATER WORK, MISC.: MAINTENANCE OF WATER SERVICE			119
								400					400	638	98600	400	FT	WATER WORK, MISC.: FROSTPROOFING FOR 8" WATER MAIN			119
										150			150	SPECIAL	69099400	150	LB	ADDITIONAL DUCTILE IRON FITTINGS			122

GENERAL SUMMARY

CUY - 77 - 4.79

58
217

P:\3000_3499\3023170010_CUY-CR57-4.43 (Wallings_Road)\0D0T\06239_CUY-77-4.79\Design\Roadway\Sheets\06239_G0002.dgn 9/12/2024 9:00:46 AM khillegass

P:\3000_3499\3023\7000_CUY-CR57-4.43_(Wallings_Road)\001\06239_CUY-77-4.79_Design\Roadway\Sheets\06239_G0003.dgn 9/13/2024 4:14:46 PM knillegass

SHEET NUM.											PART.	ITEM	ITEM	GRAND	UNIT	DESCRIPTION	SEE SHEET NO.	CALCULATED	KAH	CHECKED	RAK	
OFFICE CALCS	12	66				132	133	135	148	149		01/SAF/04	EXT	TOTAL								
	60											60	611	01800	60	FT	SANITARY SEWER					
	3											3	611	99574	3	EACH	MANHOLE, NO. 3					
	2											2	611	99651	2	EACH	MANHOLE FRAME AND COVER, AS PER PLAN					12
		6										6	611	99654	6	EACH	MANHOLE ADJUSTED TO GRADE					
		3										3	611	99661	3	EACH	MANHOLE RECONSTRUCTED TO GRADE, AS PER PLAN					13
	4											4	611	99721	4	EACH	INSPECTION WELL, AS PER PLAN					12
																	LIGHTING					
										6		6	625	00450	6	EACH	CONNECTION, FUSED PULL APART					
										9		9	625	00480	9	EACH	CONNECTION, UNFUSED PERMANENT					
										3		3	625	02600	3	EACH	TRANSFORMER BASE, TYPE AT-C					
										3		3	625	14000	3	EACH	LIGHT POLE FOUNDATION, 24" X 6' DEEP					
										486		486	625	23200	486	FT	NO. 4 AWG 2400 VOLT DISTRIBUTION CABLE					
										467		467	625	24320	467	FT	1-1/2" DUCT CABLE WITH THREE NO. 4 AWG 2400 VOLT CABLES					
										15		15	625	25402	15	FT	CONDUIT, 2", 725.05					
										452		452	625	29002	452	FT	TRENCH, 24" DEEP					
										1		1	625	30700	1	EACH	PULL BOX, 725.08, 18"					
										3		3	625	32000	3	EACH	GROUND ROD					
								1		1		1	625	33001	1	EACH	STRUCTURE GROUNDING SYSTEM, AS PER PLAN					148
										1		1	625	34001	1	EACH	POWER SERVICE, AS PER PLAN					148
										3		3	625	35011	3	EACH	REMOVE AND REERECT EXISTING LIGHT POLE, AS PER PLAN					148
									LS	452		452	625	36010	452	FT	UNDERGROUND WARNING/MARKING TAPE					
										LS	SPECIAL	LS	62540000	LS			MAINTAIN EXISTING LIGHTING					148
										4		4	625	75800	4	EACH	DISCONNECT CIRCUIT					
																	TRAFFIC CONTROL					
						42						42	621	00100	42	EACH	RPM					
												2	625	32000	2	EACH	GROUND ROD					
												195	630	02100	195	FT	GROUND MOUNTED SUPPORT, NO. 2 POST					
												257.9	630	03100	257.9	FT	GROUND MOUNTED SUPPORT, NO. 3 POST					
												55	630	06400	55	FT	GROUND MOUNTED STRUCTURAL BEAM SUPPORT, S4X7.7					
												71	630	07600	71	FT	GROUND MOUNTED STRUCTURAL BEAM SUPPORT, W10X12					
												30	630	08100	30	FT	ONE WAY SUPPORT, NO. 4 POST					
												25	630	08520	25	FT	STREET NAME SIGN SUPPORT, NO. 3 POST					
												7	630	08600	7	EACH	SIGN POST REFLECTOR					
												8	630	09000	8	EACH	BREAKAWAY STRUCTURAL BEAM CONNECTION					
												2	630	76520	2	EACH	SPAN WIRE SIGN SUPPORT, TYPE TC-17.II, DESIGN 8					
												2	630	79000	2	EACH	SIGN HANGER ASSEMBLY, SPAN WIRE					
												6	630	79100	6	EACH	SIGN HANGER ASSEMBLY, MAST ARM					
												348.95	630	80100	348.95	SF	SIGN, FLAT SHEET					
												166	630	80200	166	SF	SIGN, GROUND MOUNTED EXTRUSHEET					
												8	630	84500	8	EACH	GROUND MOUNTED STRUCTURAL BEAM SUPPORT FOUNDATION					
												2	630	84520	2	EACH	SPAN WIRE SIGN SUPPORT FOUNDATION					
												49	630	84900	49	EACH	REMOVAL OF GROUND MOUNTED SIGN AND DISPOSAL					
												23	630	86002	23	EACH	REMOVAL OF GROUND MOUNTED POST SUPPORT AND DISPOSAL					
												14	630	86102	14	EACH	REMOVAL OF GROUND MOUNTED STRUCTURAL BEAM SUPPORT AND DISPOSAL					
												1	630	86272	1	EACH	REMOVAL OF GROUND MOUNTED PIPE SUPPORT AND DISPOSAL					
												5	630	87500	5	EACH	REMOVAL OF POLE MOUNTED SIGN AND DISPOSAL					
												155	632	30200	155	FT	MESSENGER WIRE, 7 STRAND, 3/8" DIAMETER WITH ACCESSORIES					
												0.37	644	00104	0.37	MILE	EDGE LINE, 6"					
												0.04	644	00204	0.04	MILE	LANE LINE, 6"					
												0.68	644	00300	0.68	MILE	CENTER LINE					
												1,774	644	00404	1,774	FT	CHANNELIZING LINE, 12"					

GENERAL SUMMARY

CUY-77-4.79

P:\3000_3499\3023\70010_CUY-CR57-4.43_(Wallings_Road)\001\06239_CUY-77-4.79_Design\Drainage\Sheets\06239_DS002.dgn 9/13/2024 3:55:21 PM knillegass

REF NO.	SHEET NO.	STATION TO STATION	SIDE	611	611	611	611	611	611	611	611	611	611	611	611	611	611	611
				12" CONDUIT, TYPE B FT	12" CONDUIT, TYPE B, 706.02 FT	12" CONDUIT, TYPE C, 706.02 FT	15" CONDUIT, TYPE B FT	15" CONDUIT, TYPE B, 706.02 FT	15" CONDUIT, TYPE B, 706.08 FT	15" CONDUIT, TYPE F, 707.05 TYPE C OR 707.21 FT	CATCH BASIN, NO. 3 EACH	CATCH BASIN, NO. 3A EACH	CATCH BASIN, NO. 6, AS PER PLAN EACH	CATCH BASIN ADJUSTED TO GRADE EACH	MANHOLE, NO. 3 EACH	MANHOLE ADJUSTED TO GRADE (FOR SANITARY) EACH	MANHOLE RECONSTRUCTED TO GRADE, AS PER PLAN (FOR SANITARY) EACH	
DJ-1	70	82+50.88	TO															
DJ-2	70	82+60.38																
D-1	71	85+34.00	LT.															
D-2	71	85+68.59	LT.															
D-3	71	85+80.00	RT.															
D-4	71	87+00.00	LT.															
D-4A	71	85+90.54	RT.															
P-1	71	85+34.00	LT.	35														
P-2	71	85+68.59	LT.		5													
P-3	71	85+80.00	RT.	12														
P-3A	71	85+85.54	RT.			5												
P-3B	71	85+87.89	RT.		5													
P-3C	71	85+90.54	RT.			5												
P-4	71	87+00.00	LT.	212														
SJ-1	71	83+36.61	LT.															
SJ-2	71	84+87.55	LT.															
SJ-3	71	85+14.54	LT.															
D-5	72	89+05.00	LT.															
D-6	72	89+04.45	RT.															
D-7	72	91+98.50	LT.															
D-6A	72	89+12.30	LT.															
D-6B	72	90+83.61	RT.															
P-5	72	88+84.49	RT.		20													
P-6	72	89+05.00	LT.	9														
P-7	72	89+04.45	RT.															
P-8	72	89+04.45	RT.		20			5										
P-8A	72	89+11.18	LT.					5										
P-8B	72	90+78.61	RT.		5													
P-8C	72	90+83.61	RT.		5													
SJ-4	72	88+57.62	LT.															
SJ-5	72	91+82.94	LT.															
D-8	73	92+06.00	RT.															
D-9	73	92+07.50	RT.															
D-10	73	93+75.00	RT.															
D-11	73	93+87.97	RT.															
D-12	73	93+88.00	LT.															
D-13	73	93+88.74	RT.															
P-9	73	92+01.00	RT.		5													
P-10	73	91+98.50	LT./RT.	43														
P-11	73	92+06.00	RT.	17														
P-12	73	92+06.00	RT.															
P-13	73	93+75.00	RT.	17														
P-14	73	93+87.97	LT./RT.	30														
P-15	73	93+87.97	RT.															
P-16	73	93+88.74	RT.															
SJ-6	73	94+03.48	LT.															
SUBTOTAL				375	65	10	204	10		85		8	1	2	7	4	2	

MANHOLE RECONSTRUCTED TO GRADE, AS PER PLAN (FOR SANITARY)

CALCULATED
KAH
CHECKED
BLS

DRAINAGE SUBSUMMARY

CUY - 77 - 4.79

REF NO.	SHEET NO.	STATION TO STATION	SIDE	611	611	611	611	611	611	611	611	611	611	611	611	611	611	
				12" CONDUIT, TYPE B FT	12" CONDUIT, TYPE B, 706.02 FT	12" CONDUIT, TYPE C, 706.02 FT	15" CONDUIT, TYPE B FT	15" CONDUIT, TYPE B, 706.02 FT	15" CONDUIT, TYPE B, 706.08 FT	15" CONDUIT, TYPE F, 707.05 TYPE C OR 707.21 FT	CATCH BASIN, NO. 3 EACH	CATCH BASIN, NO. 3A EACH	CATCH BASIN, NO. 6, AS PER PLAN EACH	CATCH BASIN ADJUSTED TO GRADE EACH	MANHOLE, NO. 3 EACH	MANHOLE ADJUSTED TO GRADE (FOR SANITARY) EACH	MANHOLE RECONSTRUCTED TO GRADE, AS PER PLAN (FOR SANITARY) EACH	
D-14	74	97+84.00	TO															
D-15	74	97+97.91																
D-16	74	98+04.00																
D-16A	74	99+00.72																
D-17	74	29+07.00																
P-17	74	97+84.00	97+97.91	RT.	17													
P-18	74	97+97.91	98+04.00	LT./RT.	35													
P-19	74	97+97.91	98+02.91	RT.														
P-19A	74	98+95.72	99+00.72	RT.														
P-19B	74	98+98.32	99+00.72	RT.														
P-19C	74	99+00.72	99+05.72	RT.														
R-20	74	29+06.81	29+07.00	LT.														
SJ-8	74	99+67.40		LT.														
SJ-9	74	101+44.80		LT.														
D-18	75	102+50.00		RT.														
D-19	75	102+50.00		LT.														
D-20	75	102+54.69		RT.														
DJ-3	75	102+58.58		LT.														
P-21	75	102+25.00	102+54.69	RT.														
P-22	75	102+43.83	102+54.69	RT.	15													
P-23	75	102+50.00	102+54.69	RT.	6													
P-24	75	102+50.00	102+54.69	LT./RT.	35													
P-25	75	102+50.00	102+58.58	LT.	14													
P-26	75	102+54.69	102+84.93	RT.														
SJ-10	75	103+32.64		LT.														
D-21	77	28+25.00		LT.														
P-27	77	28+24.82	28+25.00	LT.	12													
P-28	77	28+25.00	28+25.00	LT.														
SUBTOTAL THIS SHEET					134	25			50	30		1	5		1	3	2	1
QUANTITIES CARRIED FROM SHEET				65	375	65	10	204	10	85		8	1	2	7	4	2	
TOTALS CARRIED TO GENERAL SUMMARY					509	90	10	204	60	30	85	1	13	1	3	10	6	3


CALCULATED KAH	CHECKED BLS	DRAINAGE SUBSUMMARY	CUY - 77 - 4.79	66
				217

P:\3000_3499\3023\70010_CUY-CR57-4.43 (Wallings_Road)\001\06239_CUY-77-4.79\Design\Drainage\Sheets\06239_DS003.dwg 9/13/2024 3:55:23 PM khillegass

P:\3000_3499_3023170010_CUY-CR57-4.43_(Wallings_Road)\001\06239_CUY-77-4.79_Design\Roadway\Sheets\06239_GP002.dgn 9/13/2024 4:06:01 PM khillegass

LEGEND


AB-# ABANDONED MANHOLE	R-# CURB REMOVED
C-# PROPOSED CURB	SJ-# SANITARY SEWER MANHOLE ADJUSTED OR RECONSTRUCTED TO GRADE
D-# PROPOSED STORM SEWER CATCH BASIN AND MANHOLE	SW-# PROPOSED WALK
DJ-# STORM SEWER CATCH BASIN AND MANHOLE ADJUSTED OR RECONSTRUCTED TO GRADE	SWR-# WALK REMOVED
DR-# STORM SEWER CATCH BASIN, MANHOLE, OR INLET REMOVED	WH-# PROPOSED FIRE HYDRANT
DV-# DRIVEWAY	WJ-# WATER WORK ITEM ADJUSTED TO GRADE
EX-# EXISTING CATCH BASIN, MANHOLE, OR INLET	WM-# PROPOSED WATER MAIN
FR-# FENCE REMOVED	WR-# WATER MAIN, WATER VALVE, OR FIRE HYDRANT REMOVED
P-# PROPOSED PIPE	WV-# PROPOSED WATER VALVE
PR-# PIPE REMOVED	WW-# PROPOSED WATER WORK ITEM

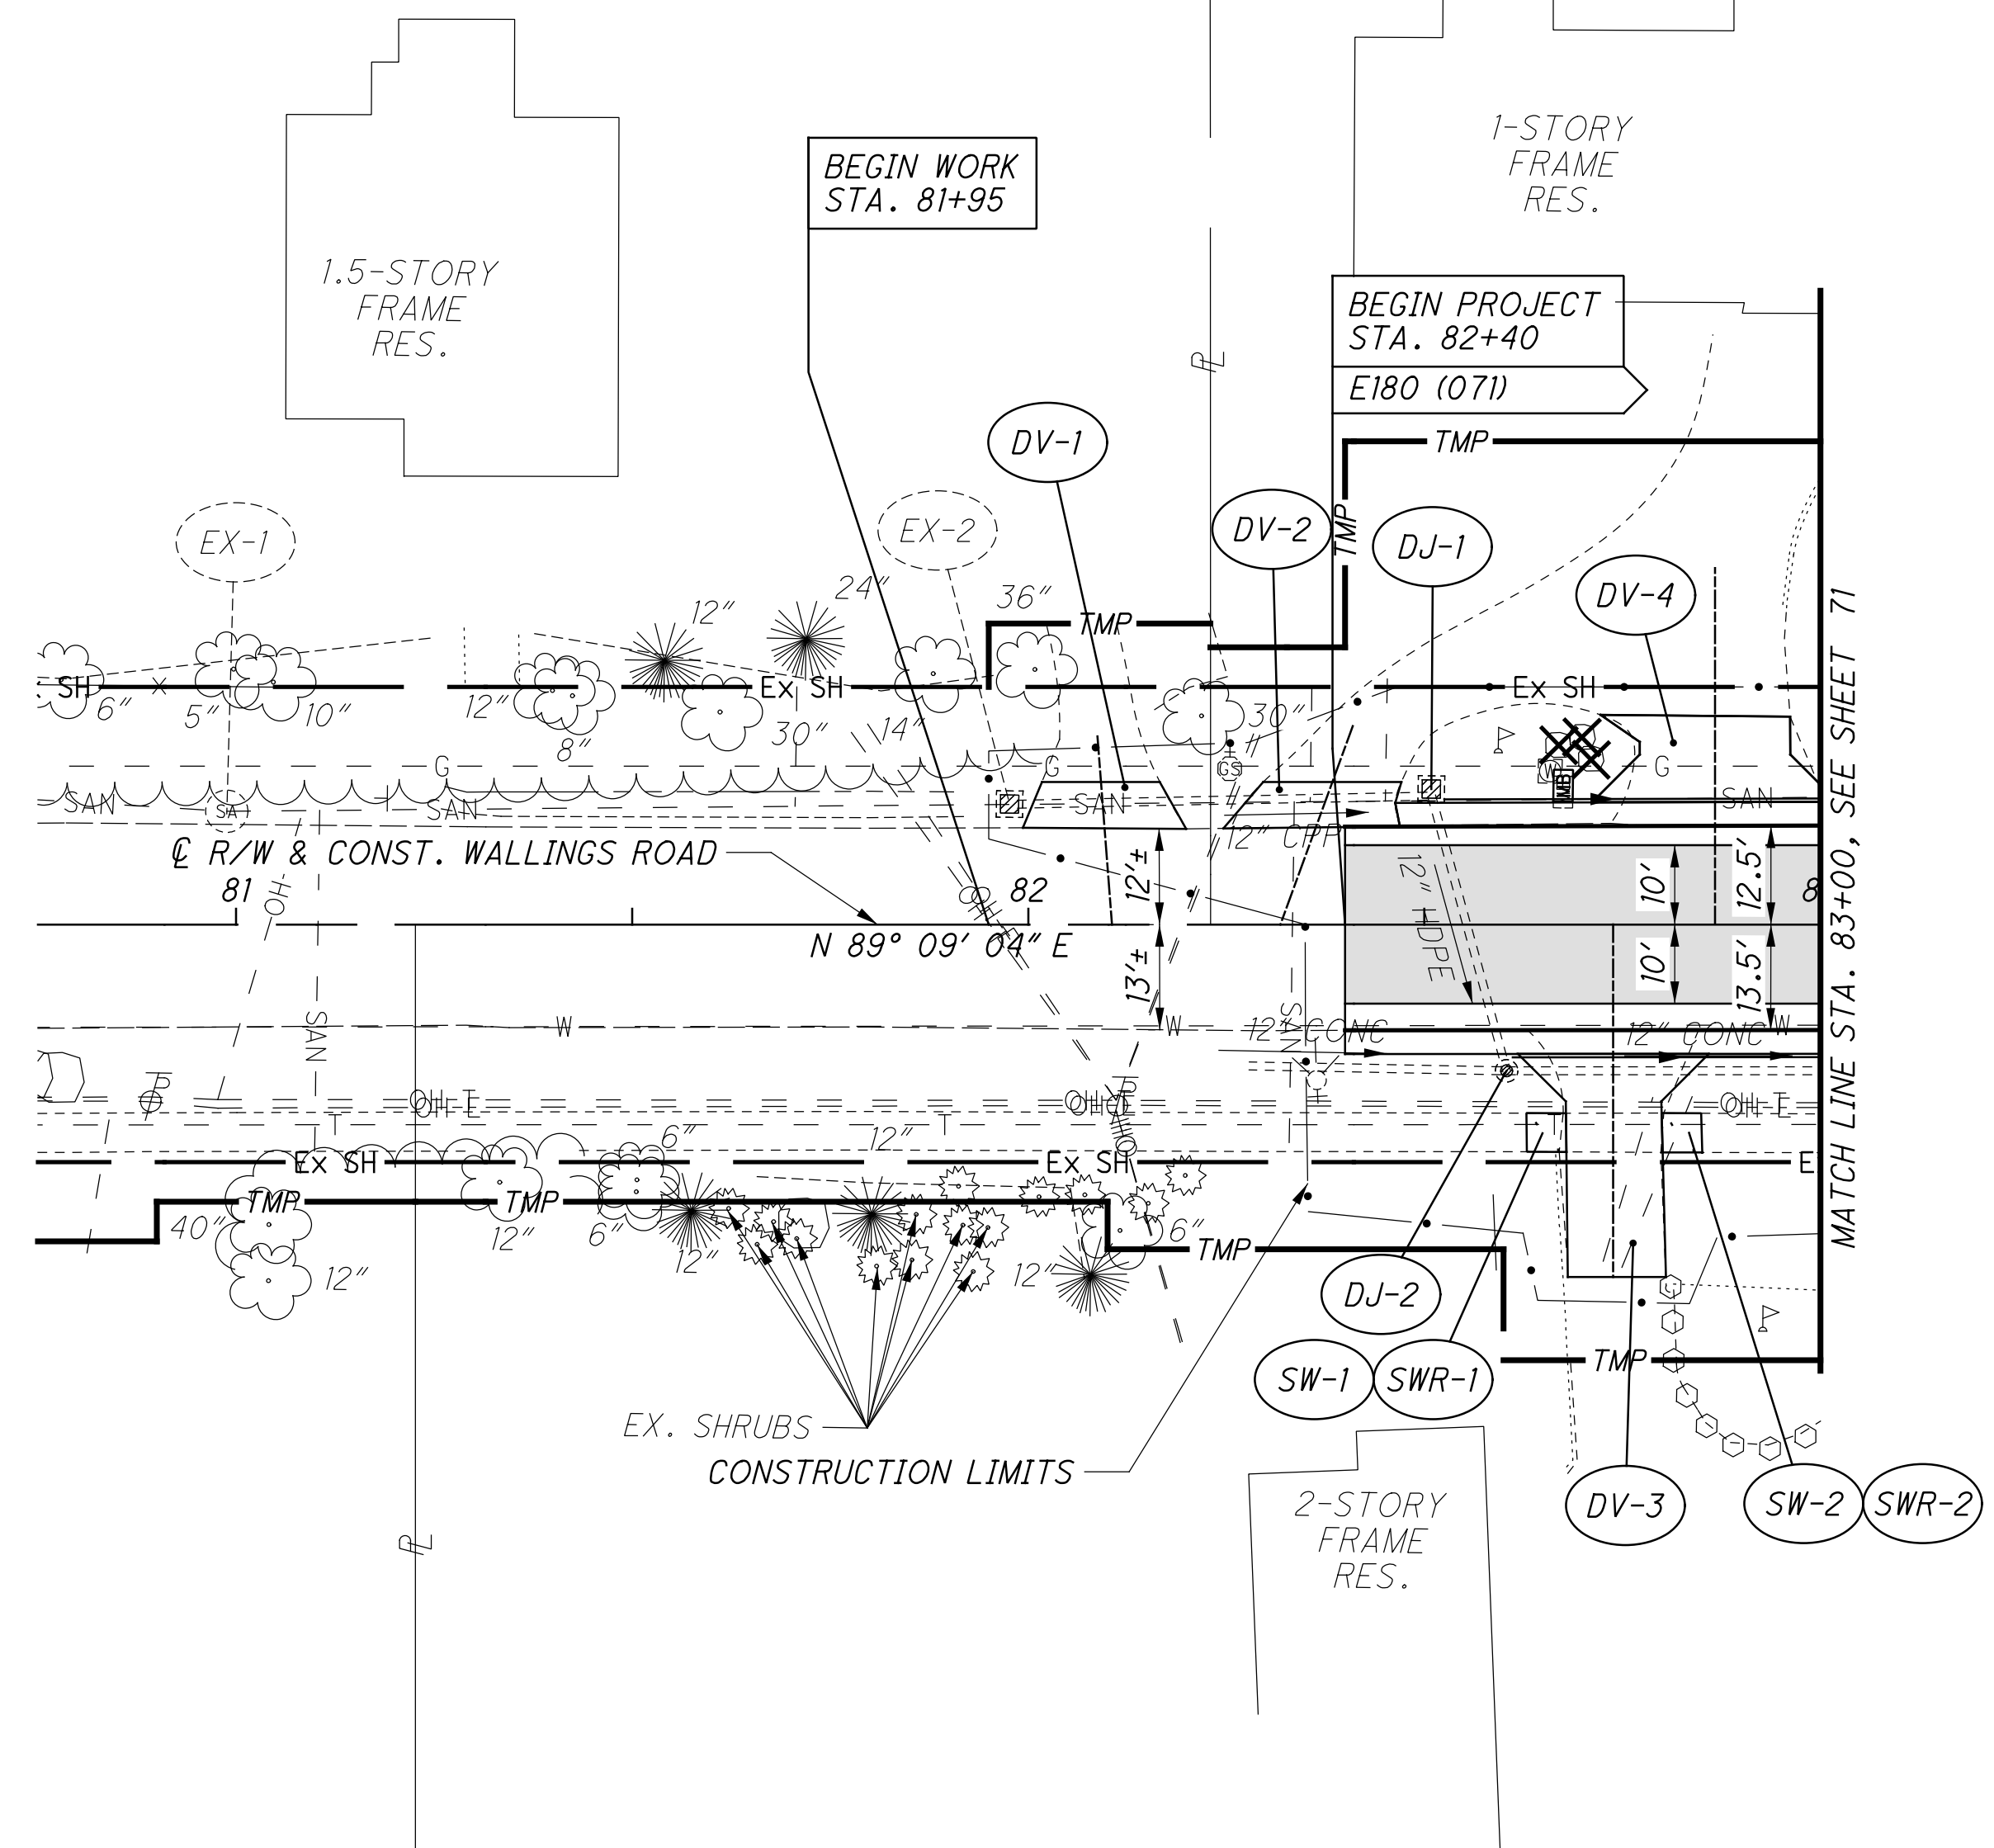

LEGEND

- CONCRETE WALK
- PAVEMENT OVERLAY OR RESURFACING

CROSS REFERENCES	
SHEET NO.	DESCRIPTION
11	BMs & PROJECT CONTROL
70	LEGEND
103 - 105	INTERSECTION DETAILS
106 - 112	DRIVEWAY DETAILS
128 - 129	UNDERDRAIN DETAILS

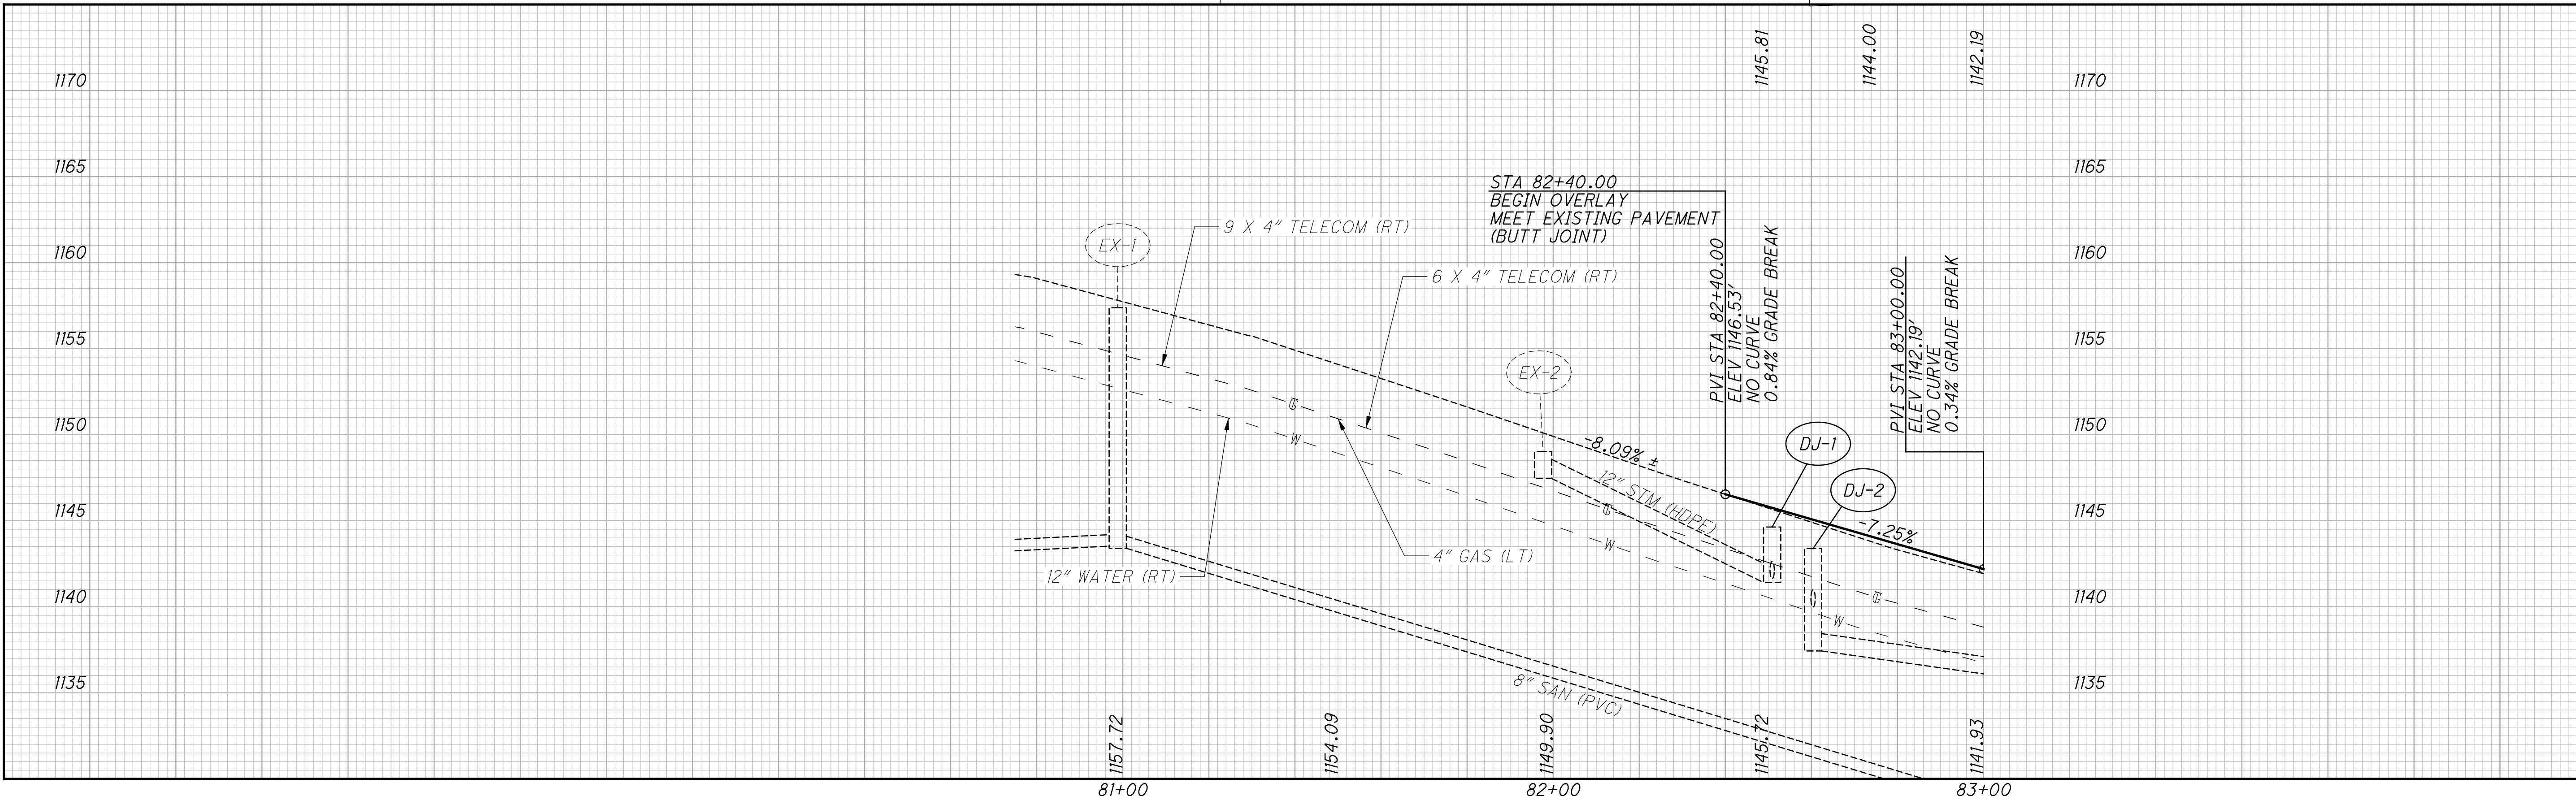

P:\3000_3499\3023170010_CUY-CR57-4.43 (Wallings_Road)\001\06239_CUY-77-4.79\Design\Roadway\Sheets\06239_X500.dgn 9/13/2024 4:30:39 PM knillegass

SEEDING	END AREA		VOLUME		CALCULATED	KAH	CHECKED	RAK
	END WIDTH	SO. YDS.	CUT	FILL				
-23	1075							
8	1070							
22	1065							
0	1060							
14	1055							
5	1085							
28	1080							
41	1075							
<0>	1070							
	1065							
	1060							
	1055							
	995							
	990							
	985							
	980							
	975							
	970							
	965							
	960							
	955							
	950							
	945							
	940							