

Cut Area (SF): 51	Cut Vol. (CY): 38
Fill Area (SF): 0	Fill Vol. (CY): 0
Seed Width (FT): 31	Seed Area (SY): 0

CROSS SECTIONS
BEGIN PROJECT

DESIGN AGENCY



DESIGNER

AS

REVIEWER




KKP 12/31/22

PROJECT ID

113156

Sheet Totals		
Seeding	Cut	Fill
0	38	0

SHEET	TOTAL
98	233

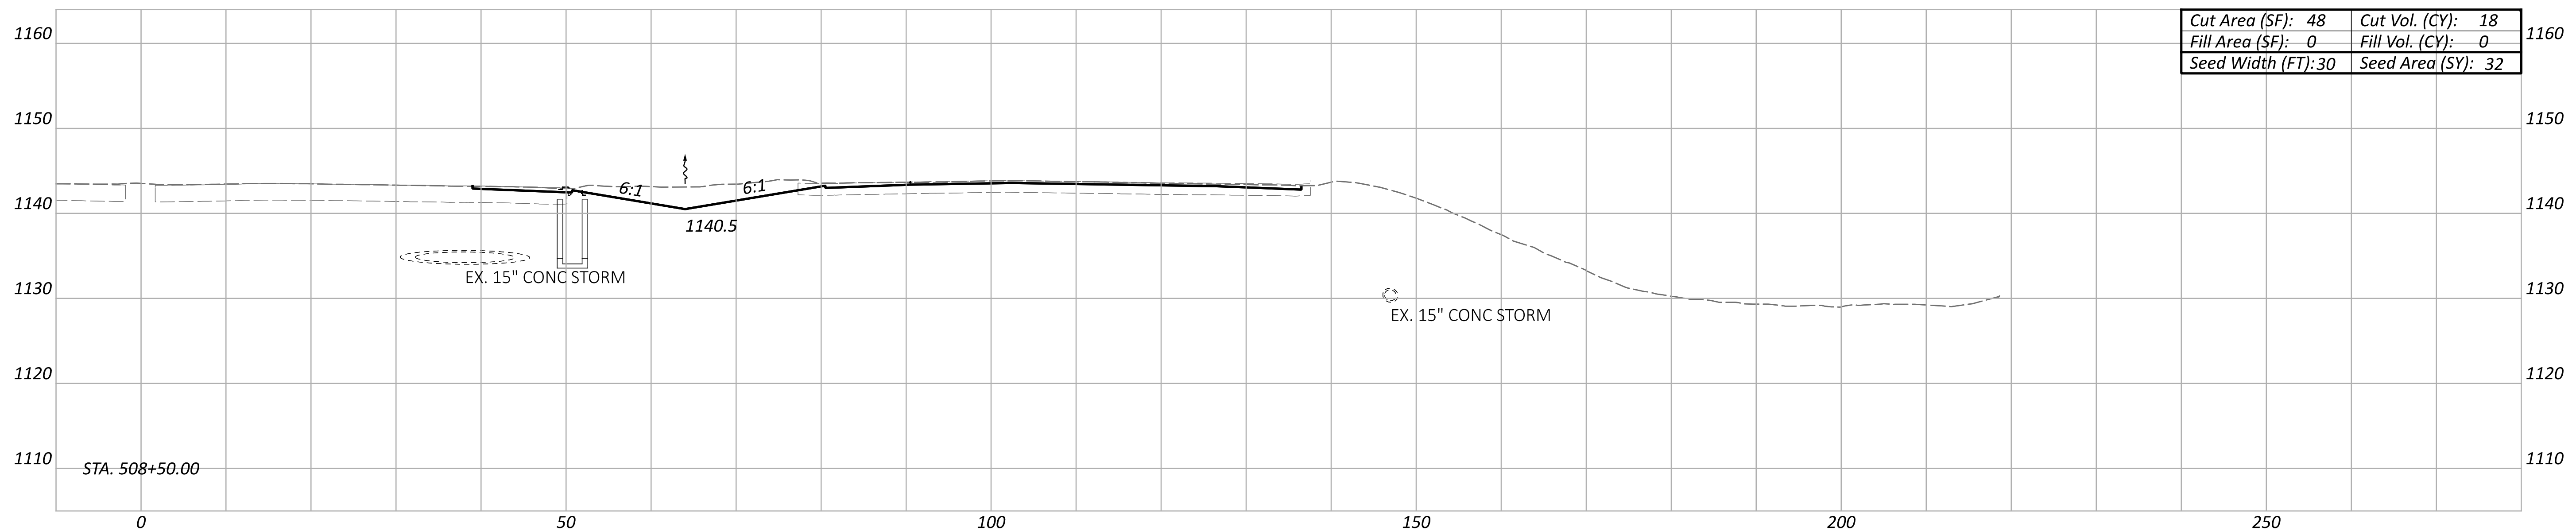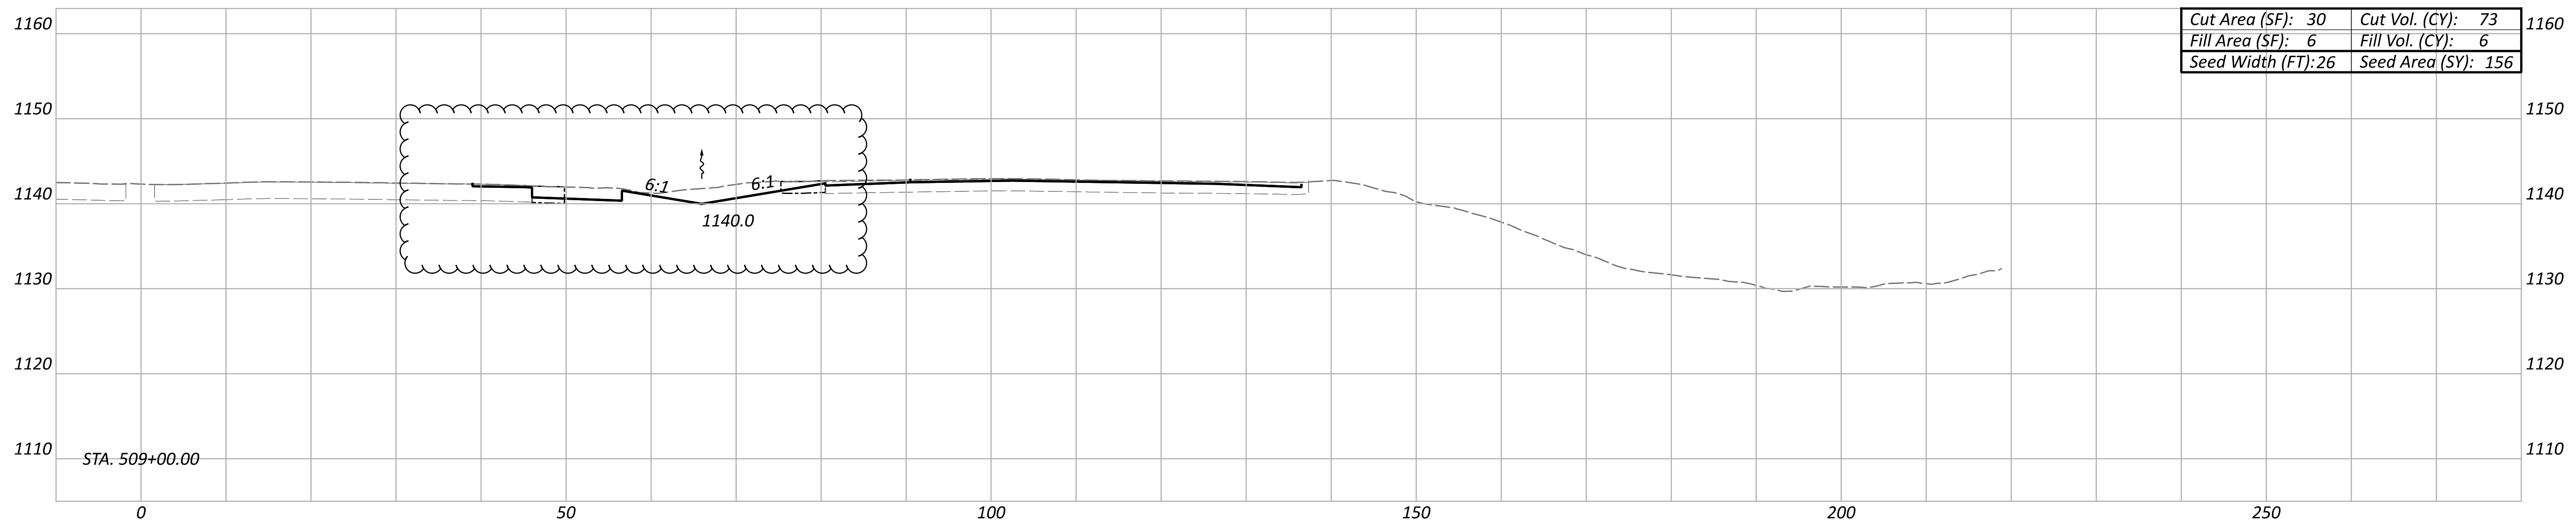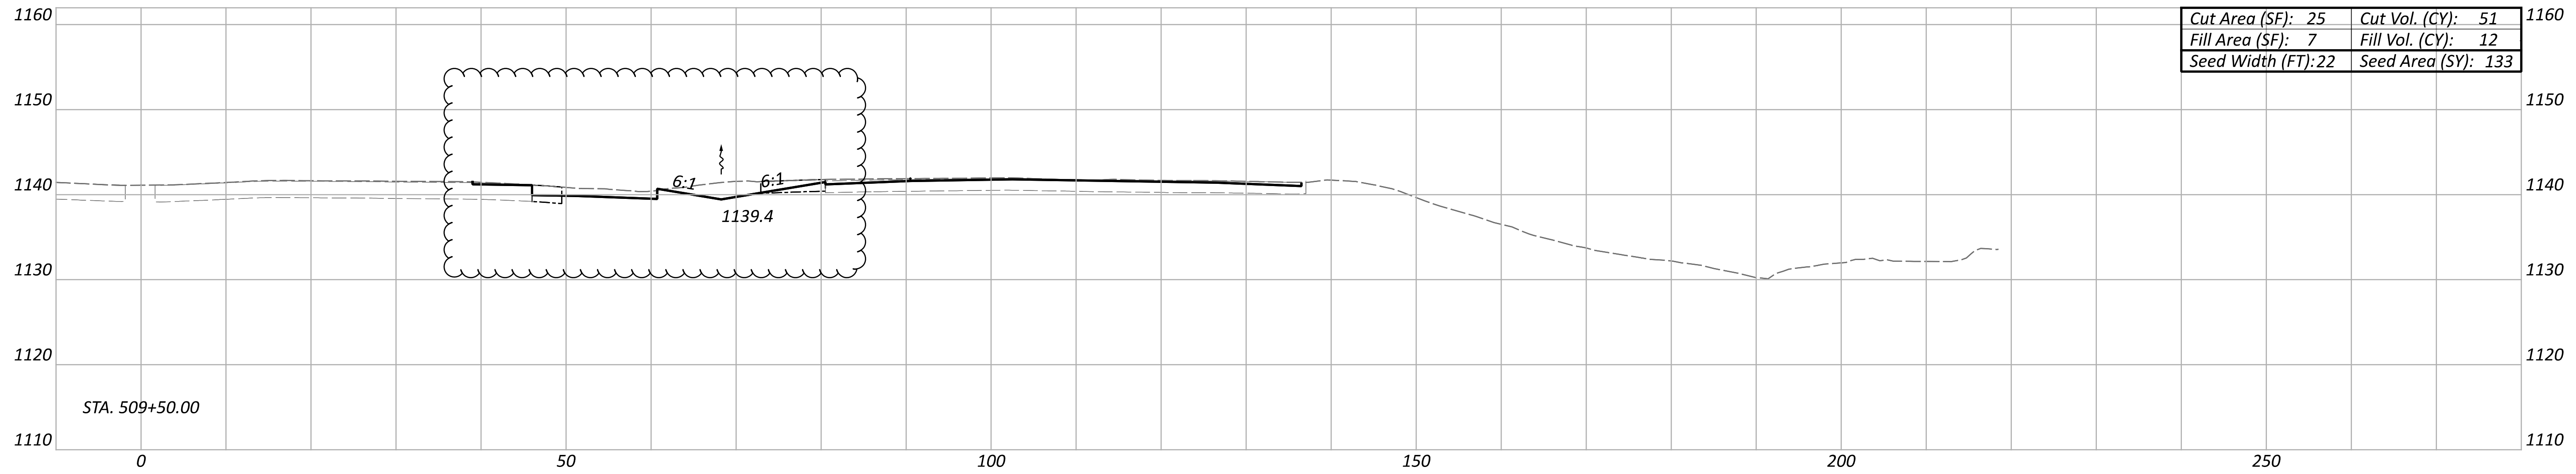

ITEM 202 - PAVEMENT REMOVED

CROSS SECTIONS
 STA. 508+50 TO STA. 509+50

DESIGN AGENCY



DESIGNER

AS

REVIEWER




KKP 12/31/22

PROJECT ID

113156

Sheet Totals		
Seeding	Cut	Fill
321	142	18

SHEET	TOTAL
99	233

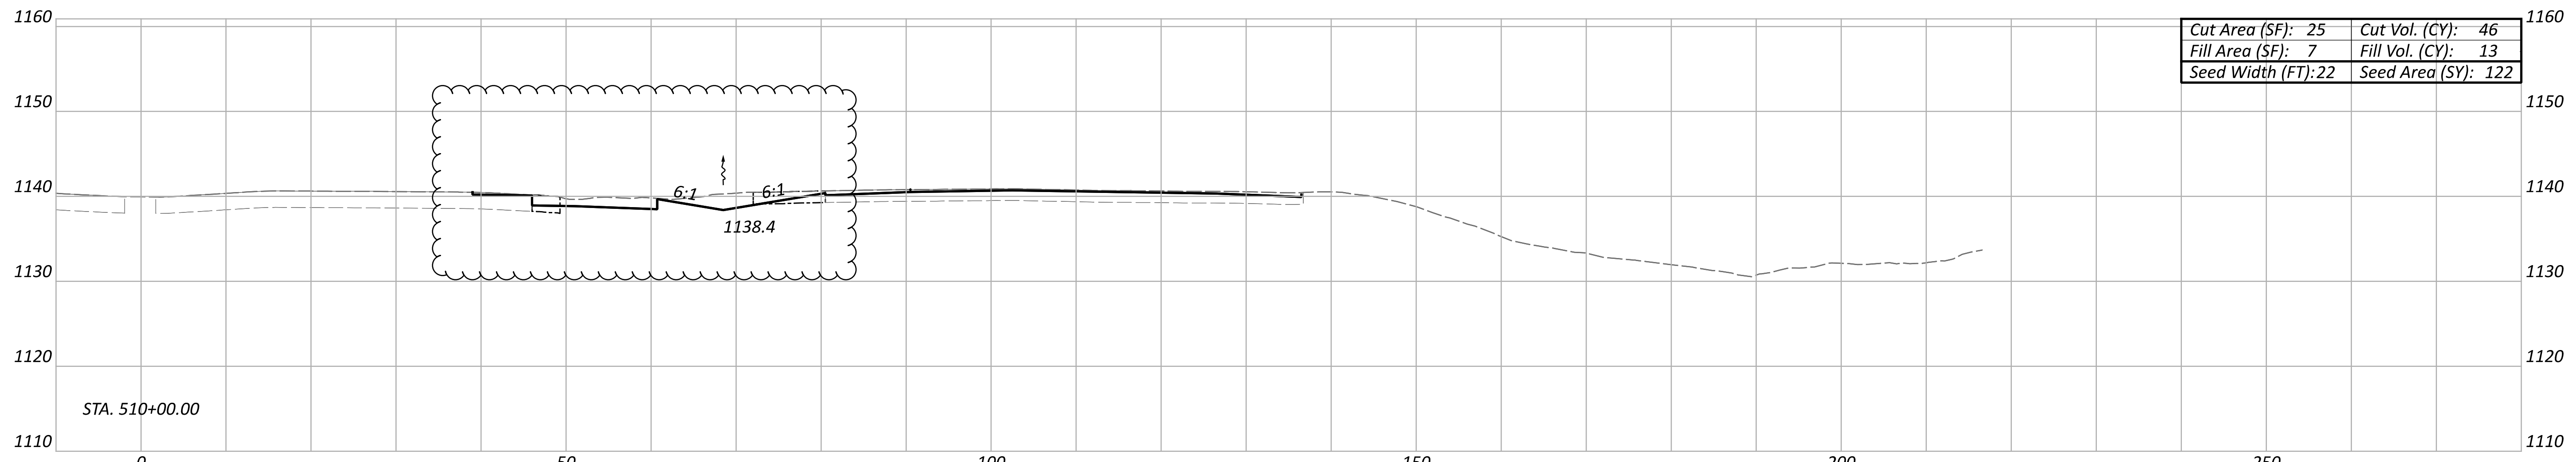
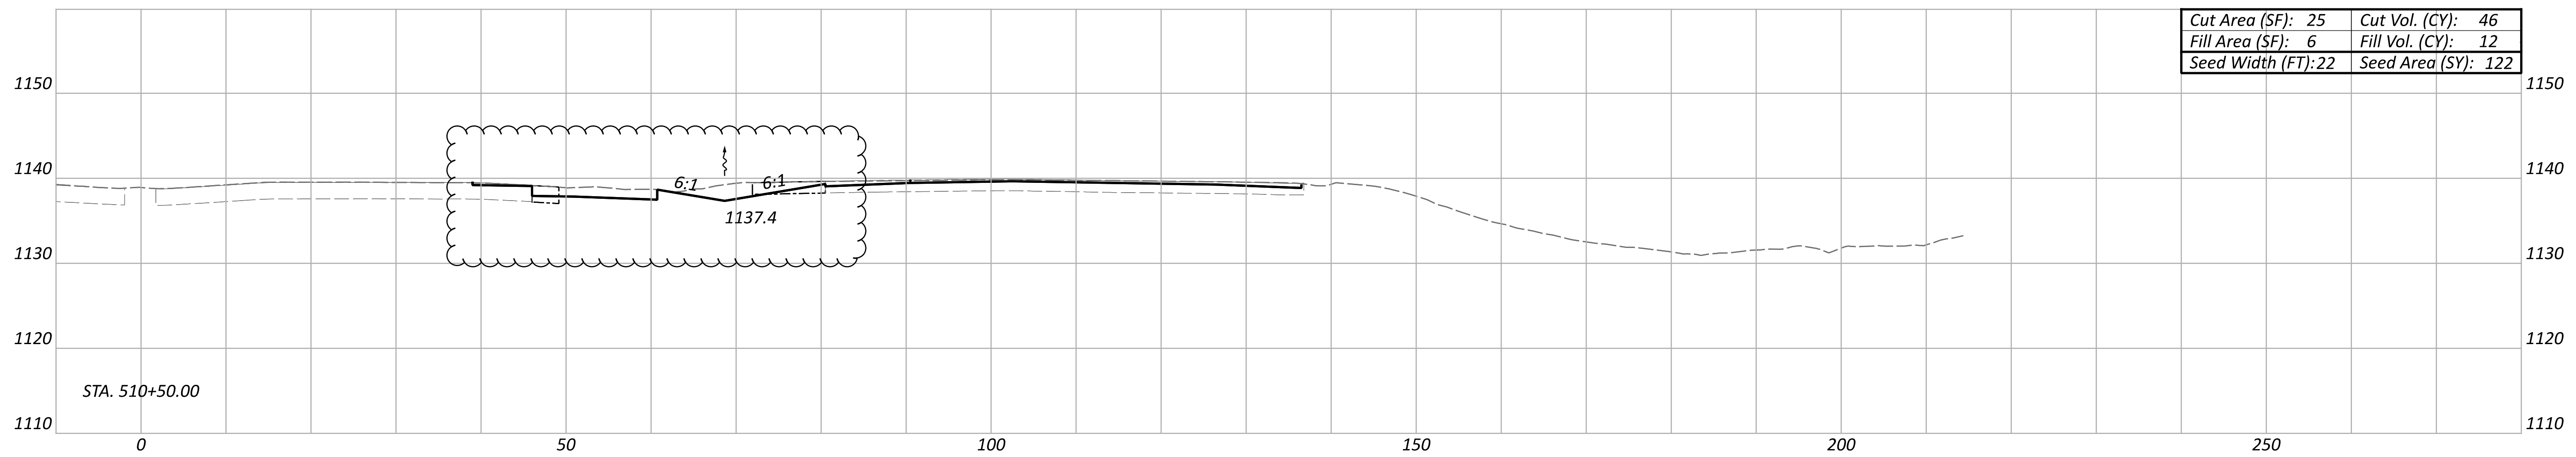
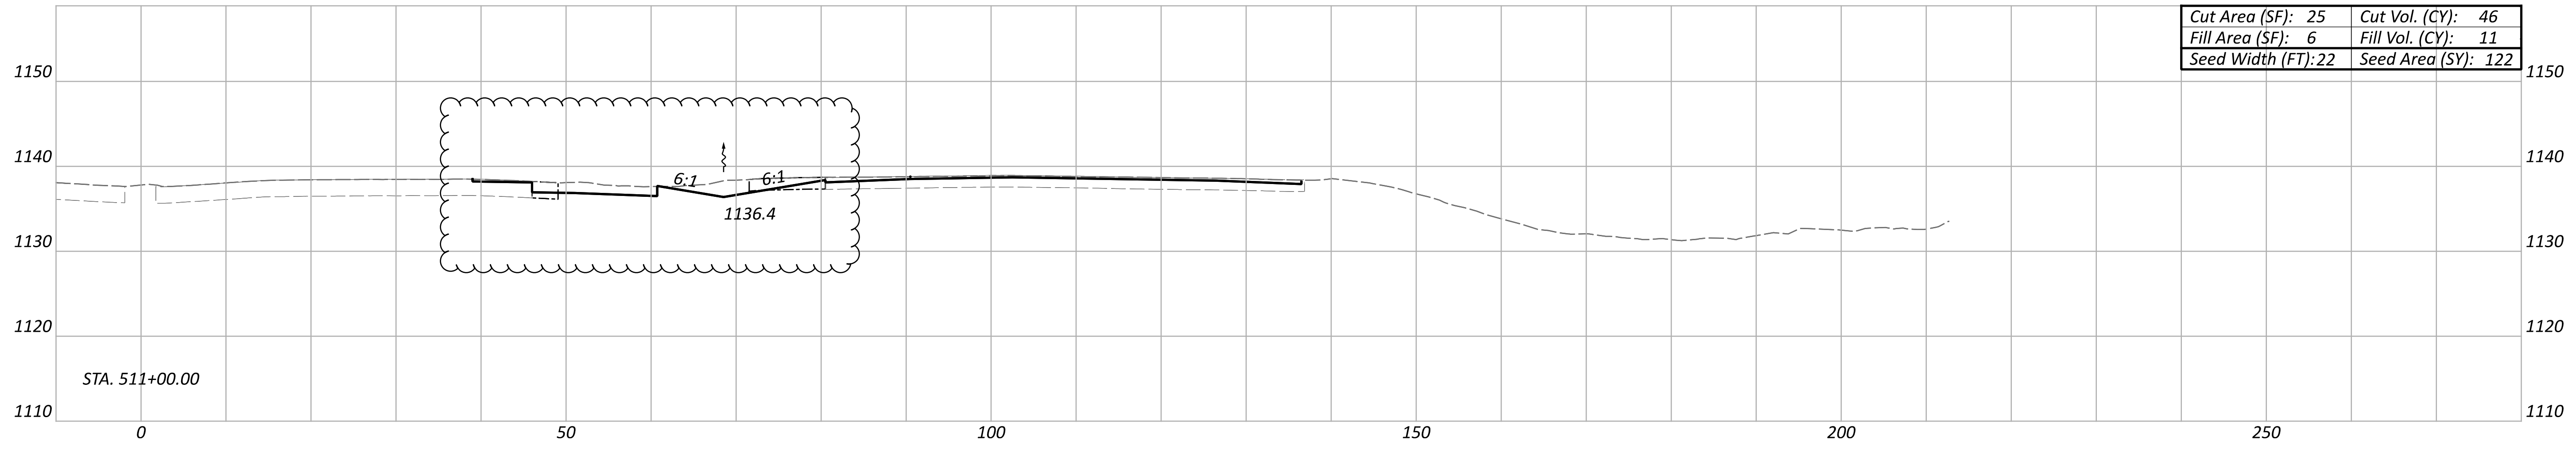


ITEM 202 - PAVEMENT REMOVED

Sheet Totals			113156	
Seeding	Cut	Fill	SHEET	TOTAL
366	139	37	100	233

CROSS SECTIONS
 STA. 510+00 TO STA. 511+00

DESIGN AGENCY
HNTB
 DESIGNER
 AS
 REVIEWER
 KKP 12/31/22
 PROJECT ID
 113156

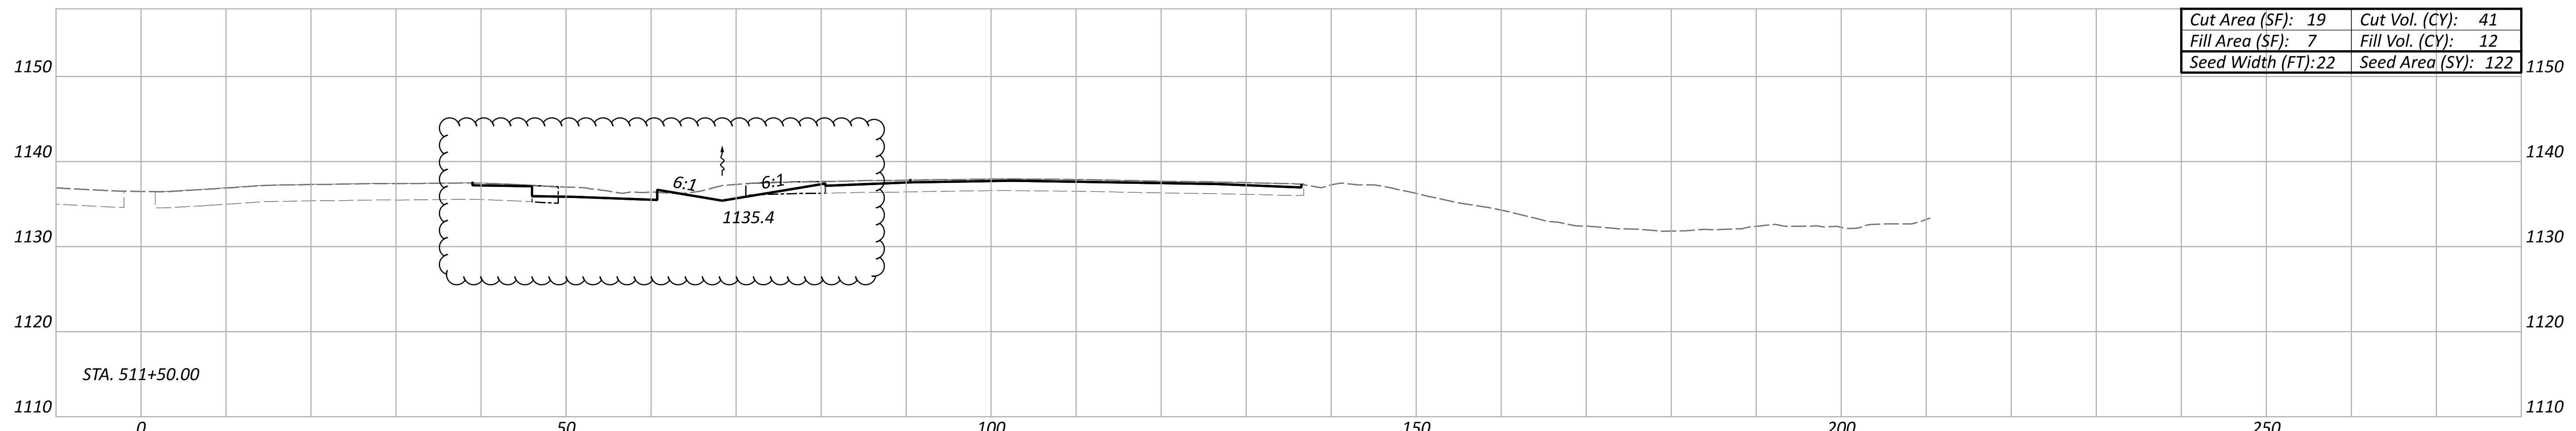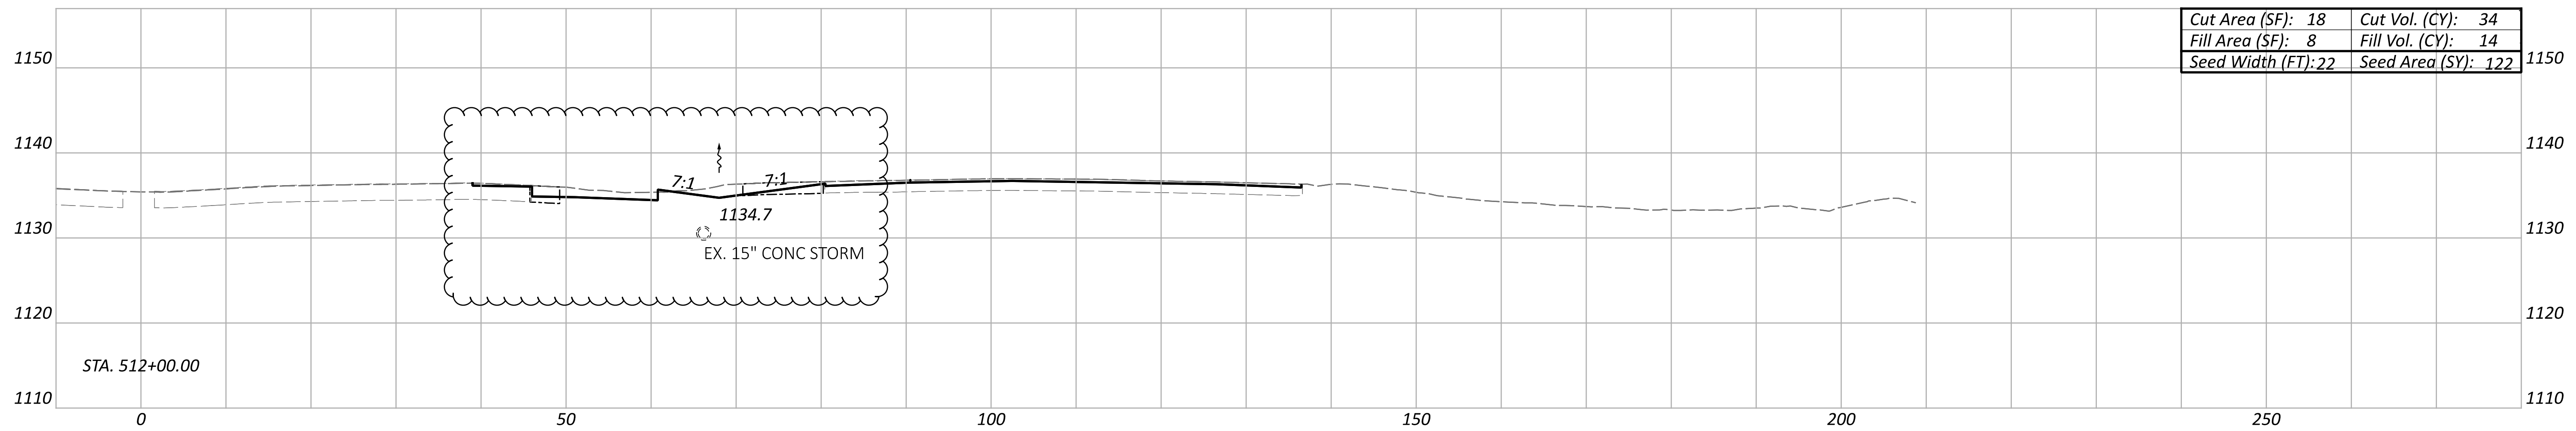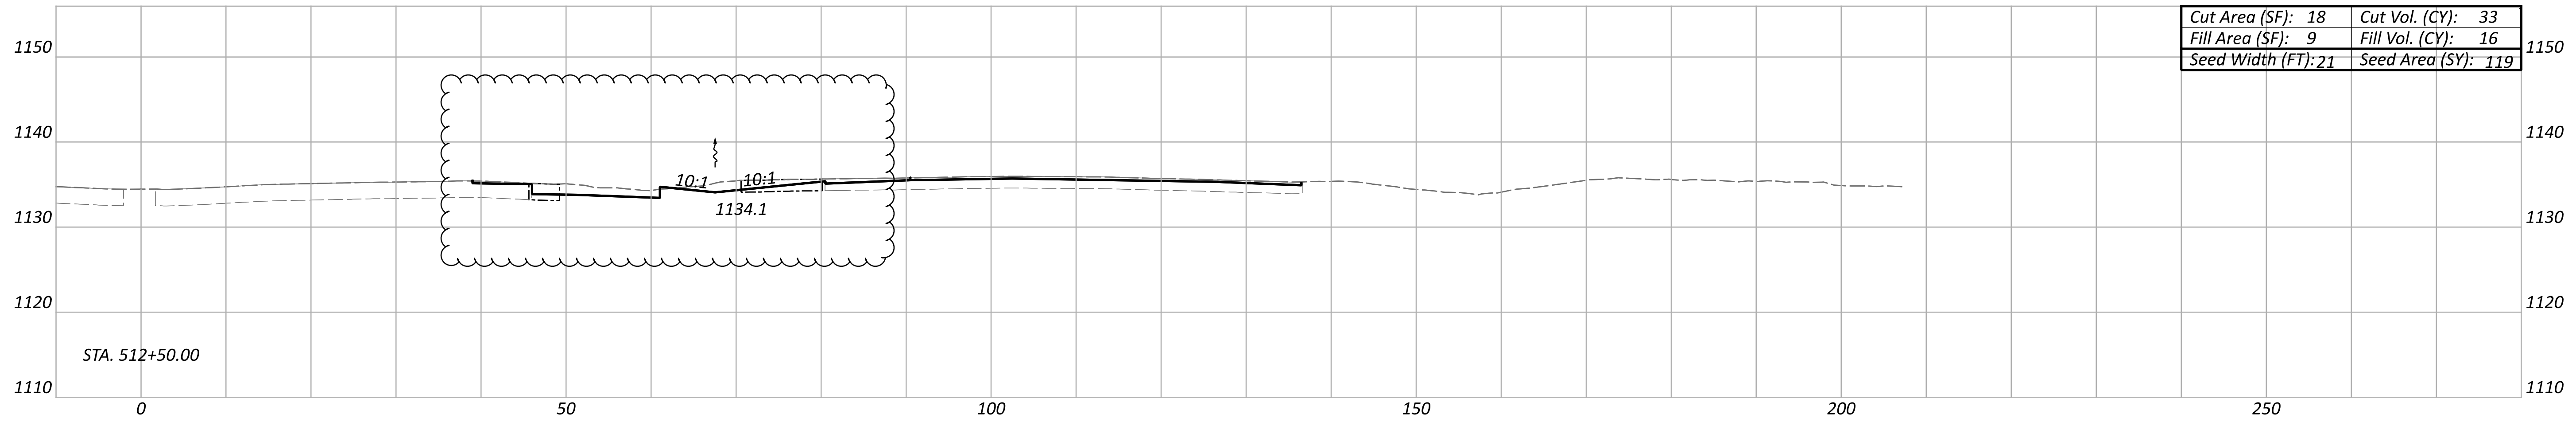

ITEM 202 - PAVEMENT REMOVED

CROSS SECTIONS
 STA. 511+50 TO STA. 512+50

DESIGN AGENCY



DESIGNER

AS

REVIEWER




KKP 12/31/22

PROJECT ID

113156

Sheet Totals		
Seeding	Cut	Fill
363	108	42

SHEET	TOTAL
101	233

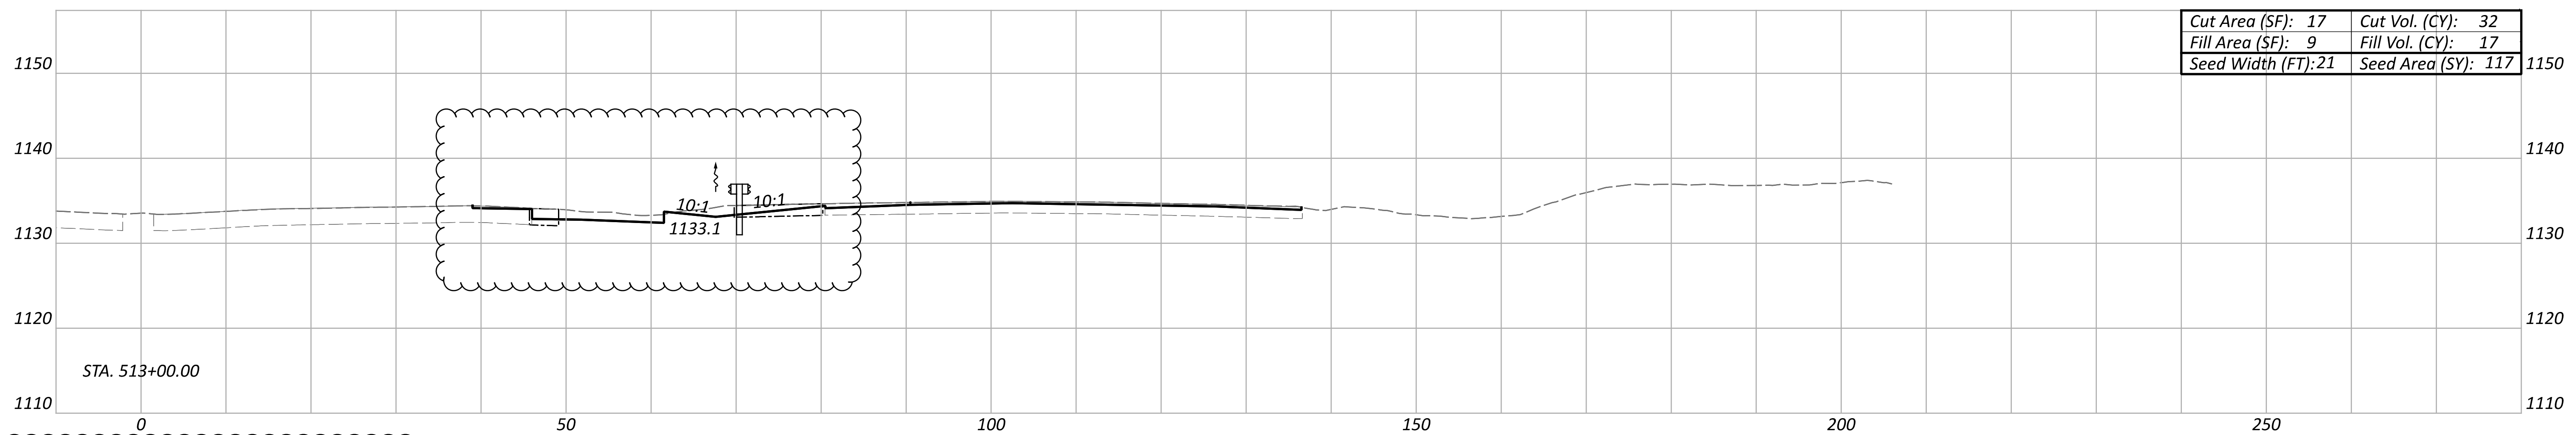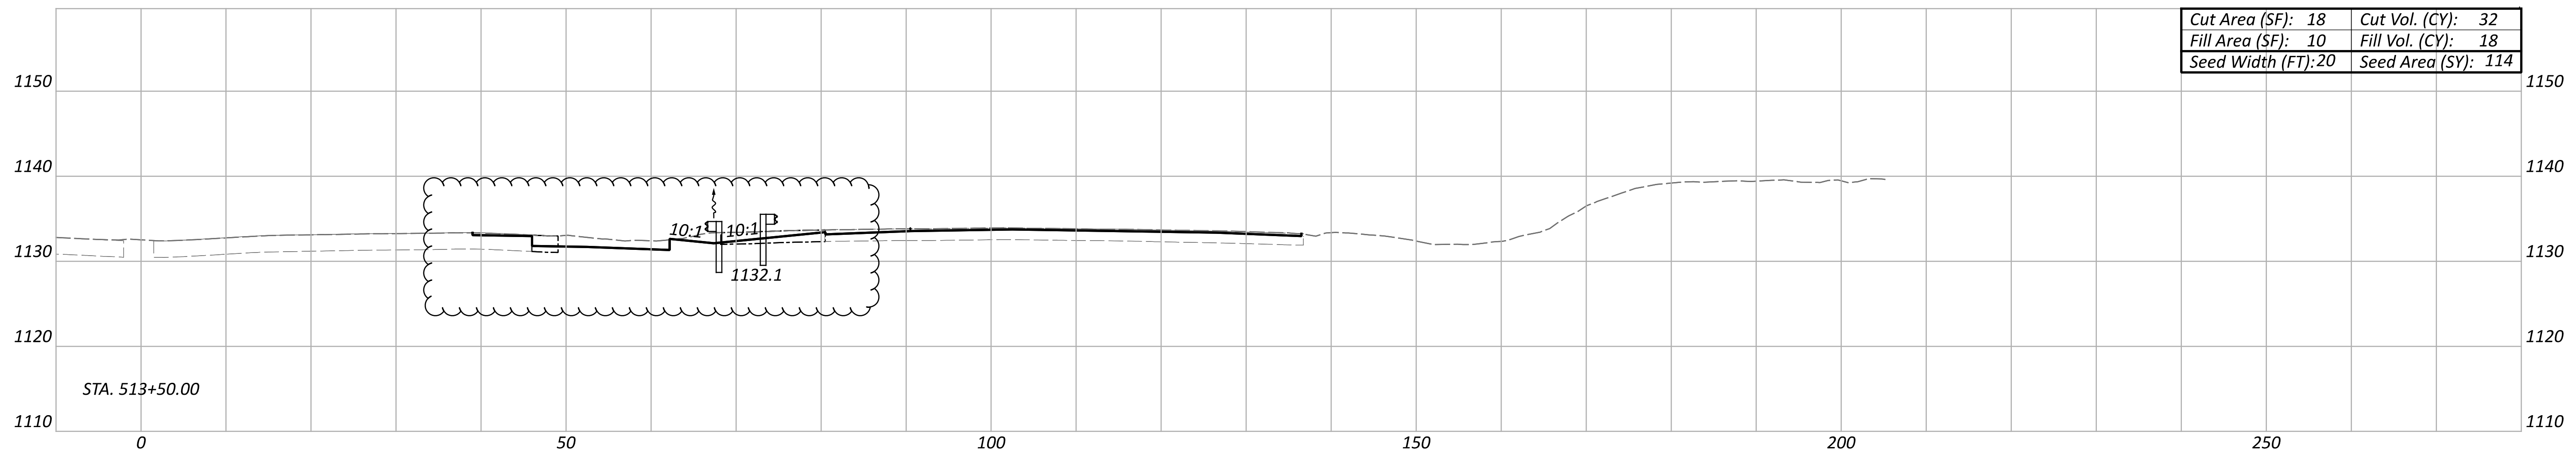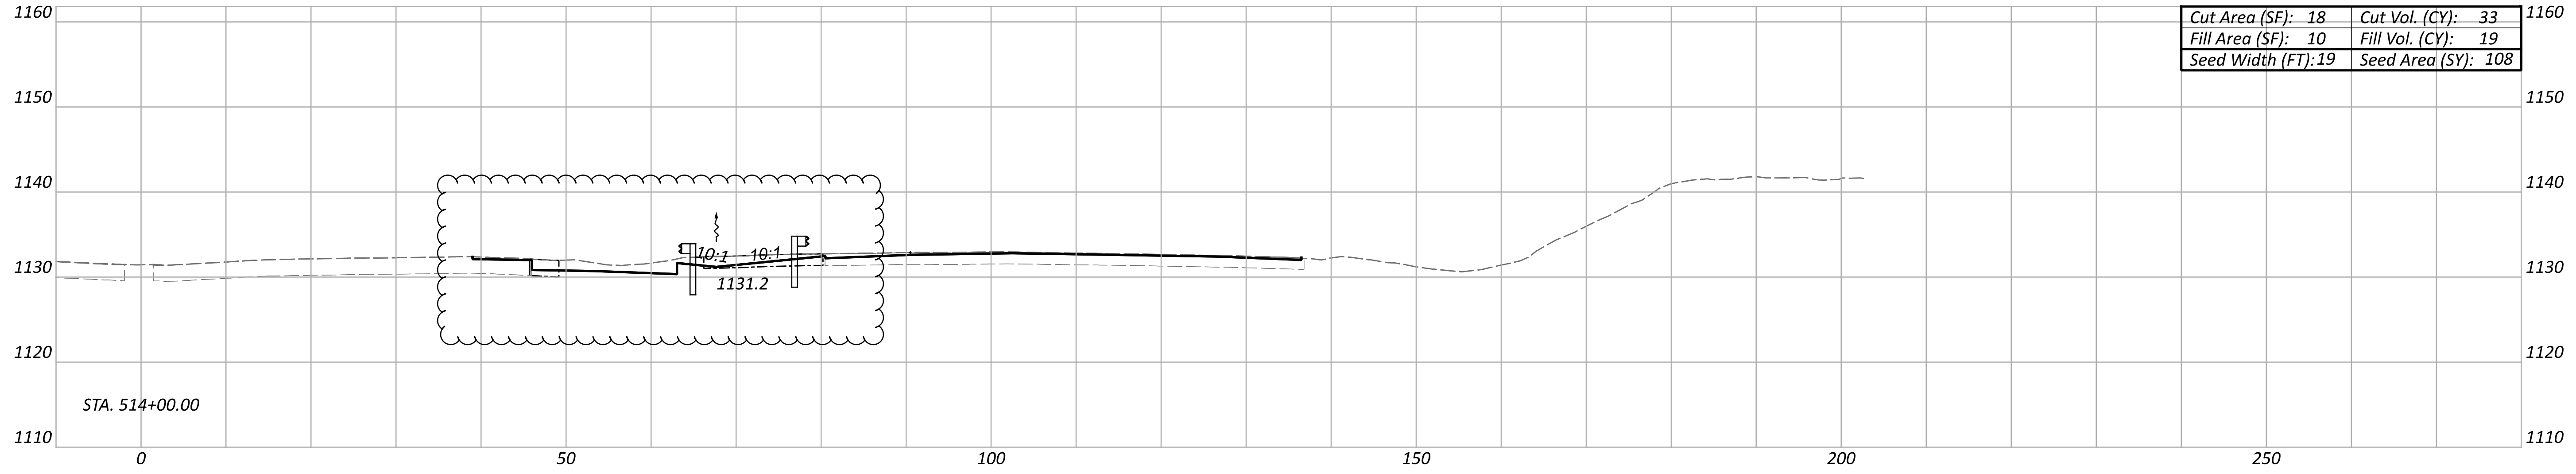

ITEM 202 - PAVEMENT REMOVED

CROSS SECTIONS
 STA. 513+00 TO STA. 514+00

DESIGN AGENCY



DESIGNER

AS

REVIEWER


KKP 12/31/22

PROJECT ID


113156

Sheet Totals		
Seeding	Cut	Fill
339	98	54


SHEET	TOTAL
102	233

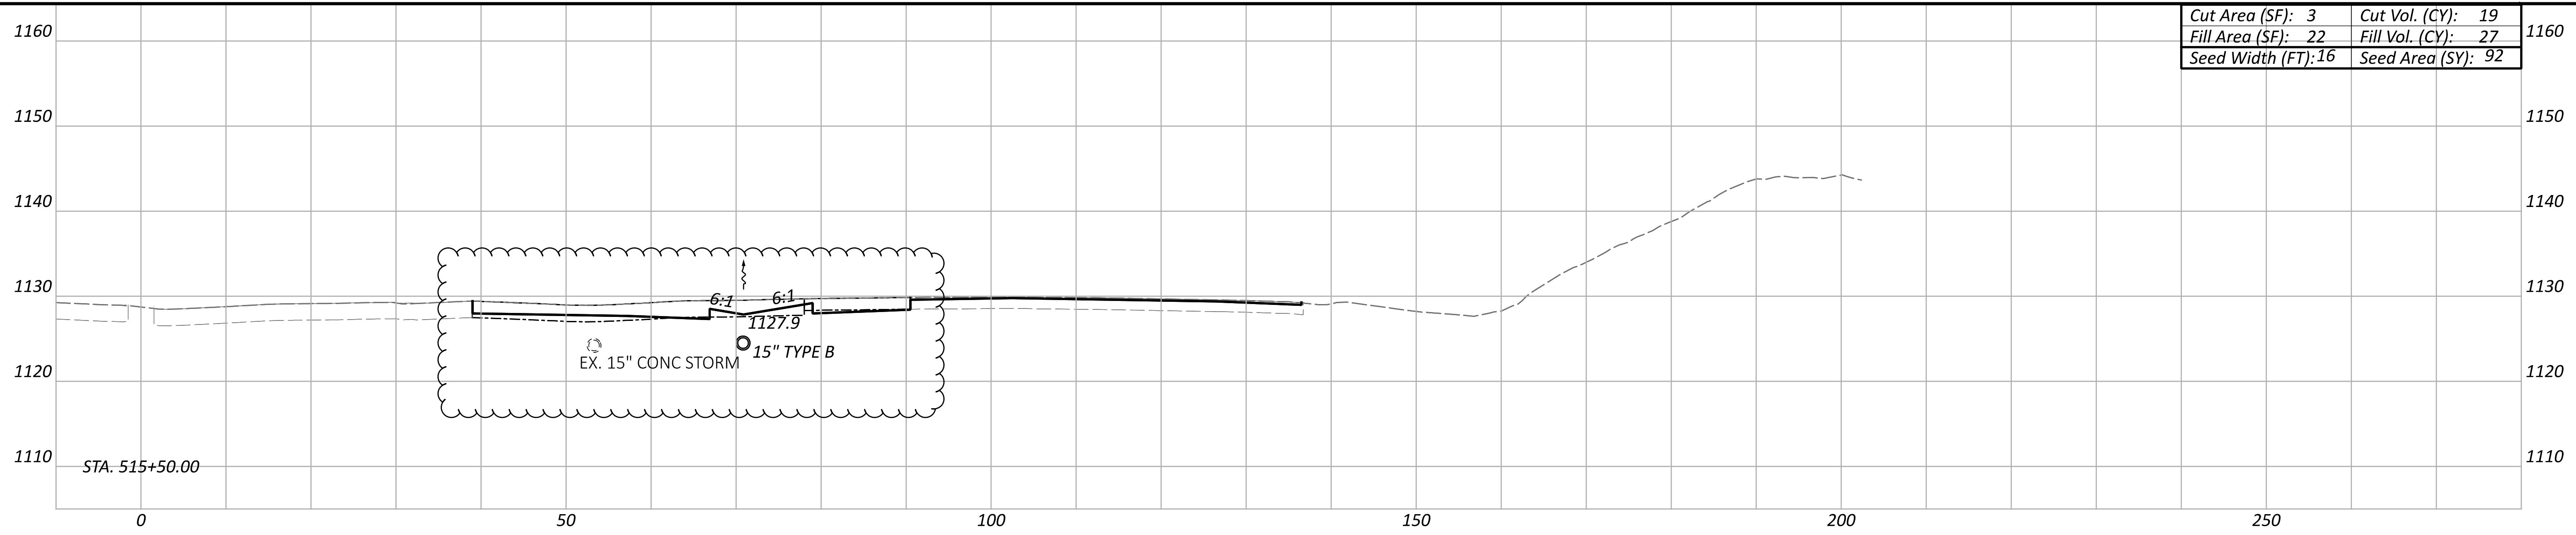

Cut Area (SF): 3	Cut Vol. (CY): 19
Fill Area (SF): 22	Fill Vol. (CY): 27
Seed Width (FT): 16	Seed Area (SY): 92

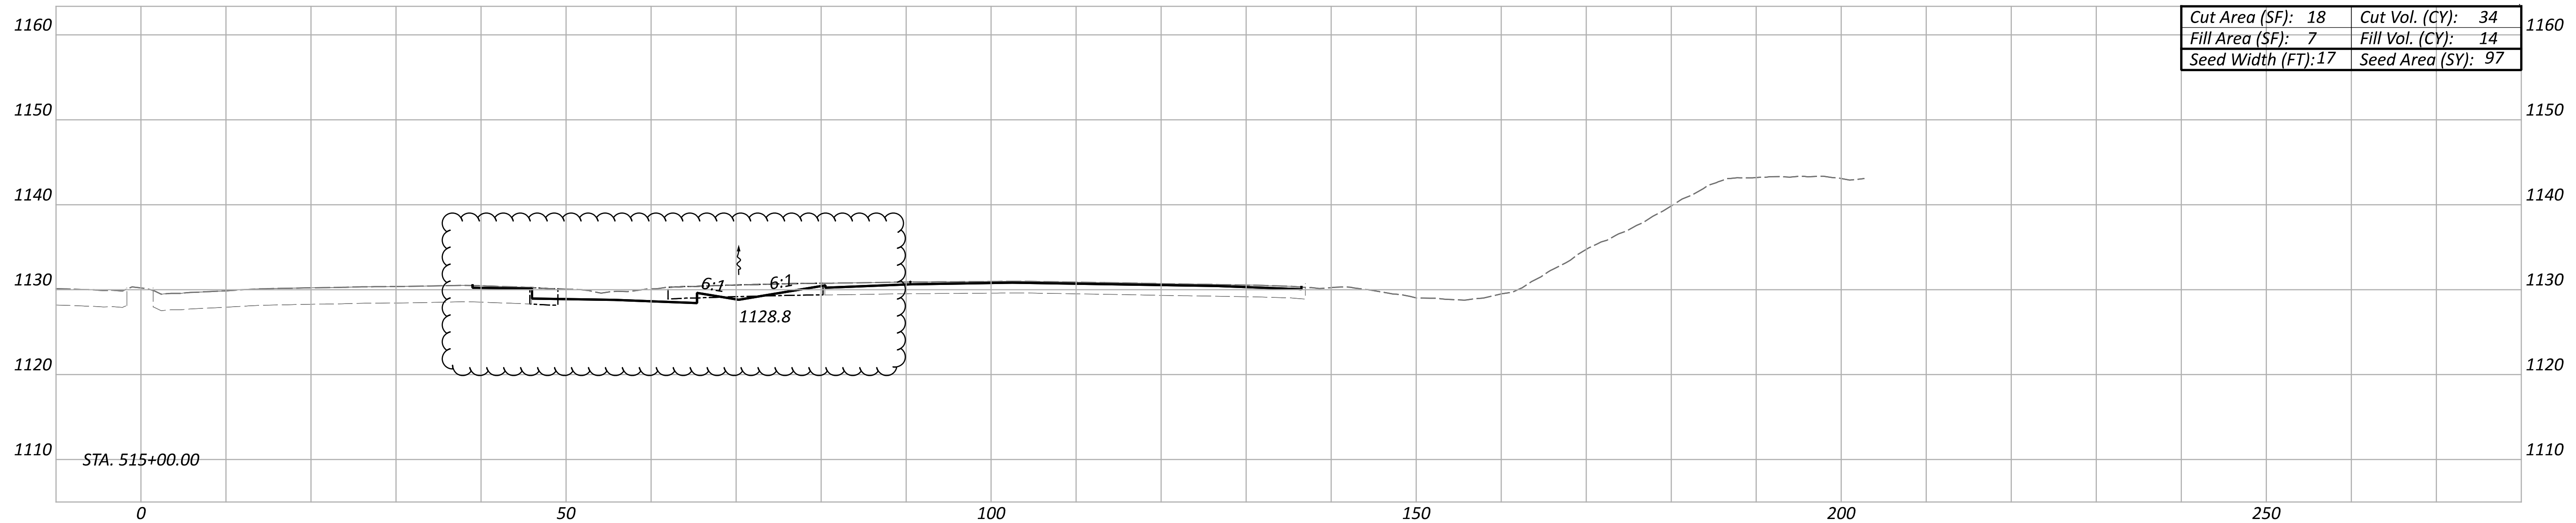

Cut Area (SF): 18	Cut Vol. (CY): 34
Fill Area (SF): 7	Fill Vol. (CY): 14
Seed Width (FT): 17	Seed Area (SY): 97

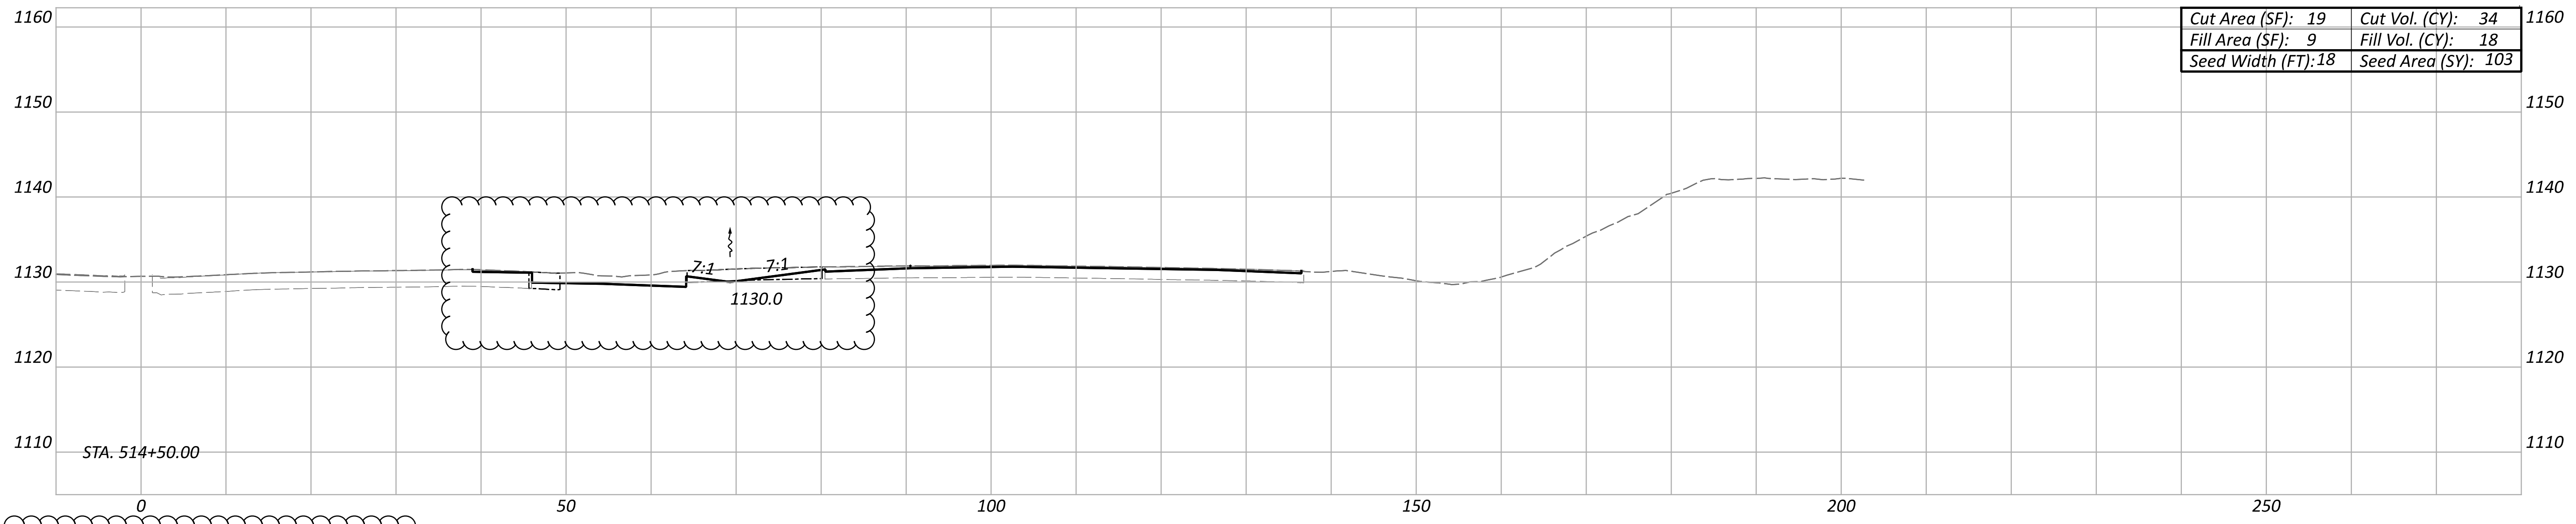

Cut Area (SF): 19	Cut Vol. (CY): 34
Fill Area (SF): 9	Fill Vol. (CY): 18
Seed Width (FT): 18	Seed Area (SY): 103

ITEM 202 - PAVEMENT REMOVED

CROSS SECTIONS
 STA. 514+50 TO STA. 515+50

DESIGN AGENCY




DESIGNER
 AS


REVIEWER
 KKP 12/31/22

PROJECT ID
 113156

Sheet Totals			SHEET TOTAL	
Seeding	Cut	Fill	103	233
292	87	59		

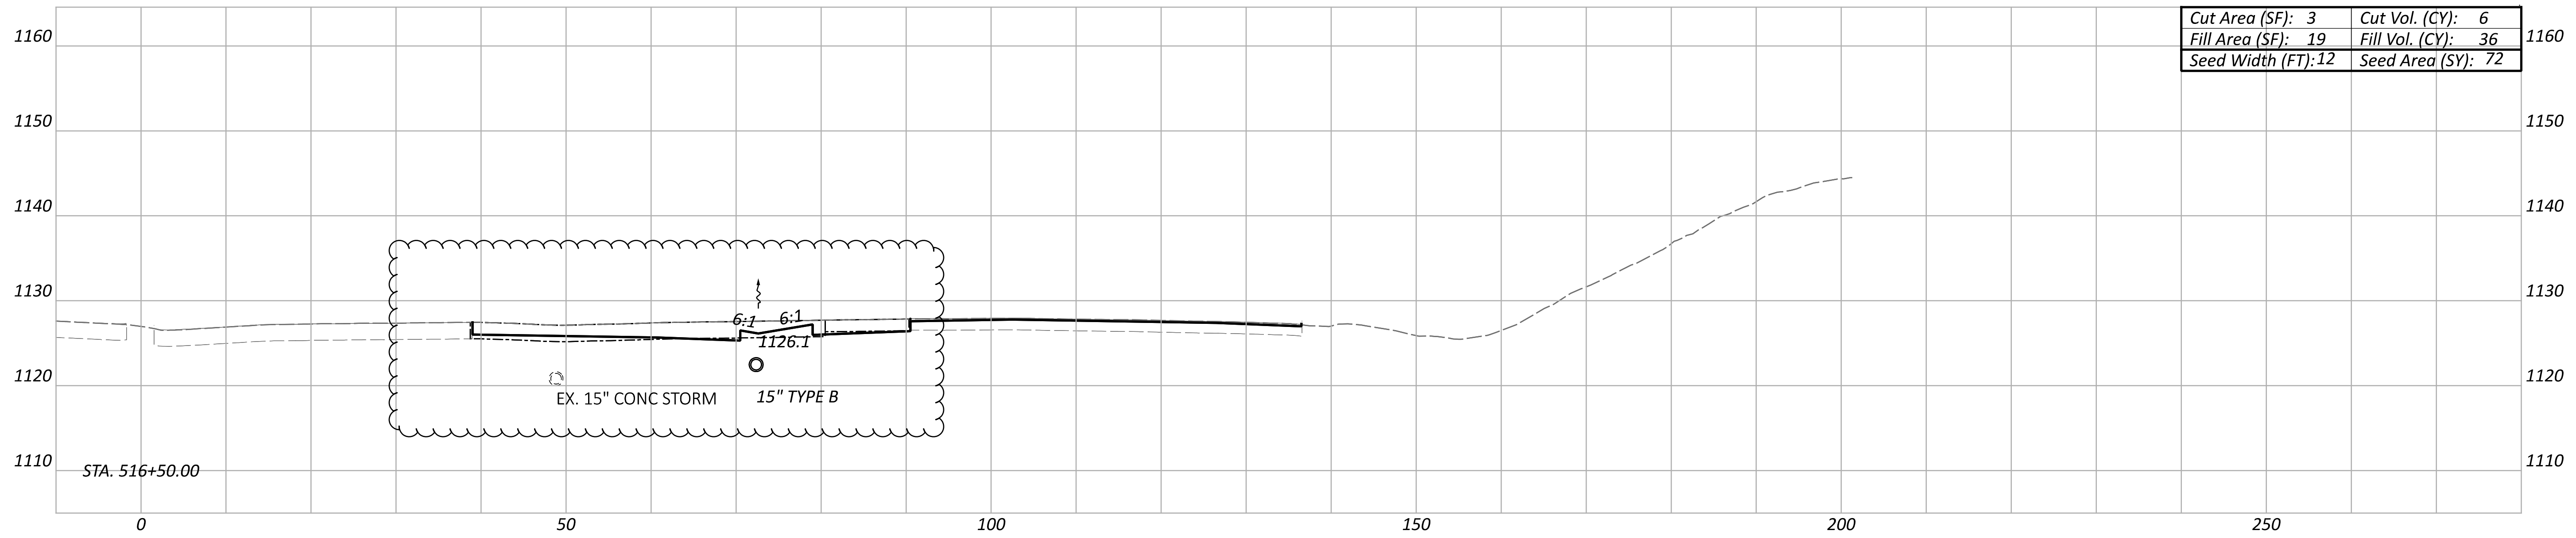

Cut Area (SF): 3	Cut Vol. (CY): 6
Fill Area (SF): 19	Fill Vol. (CY): 36
Seed Width (FT): 12	Seed Area (SY): 72

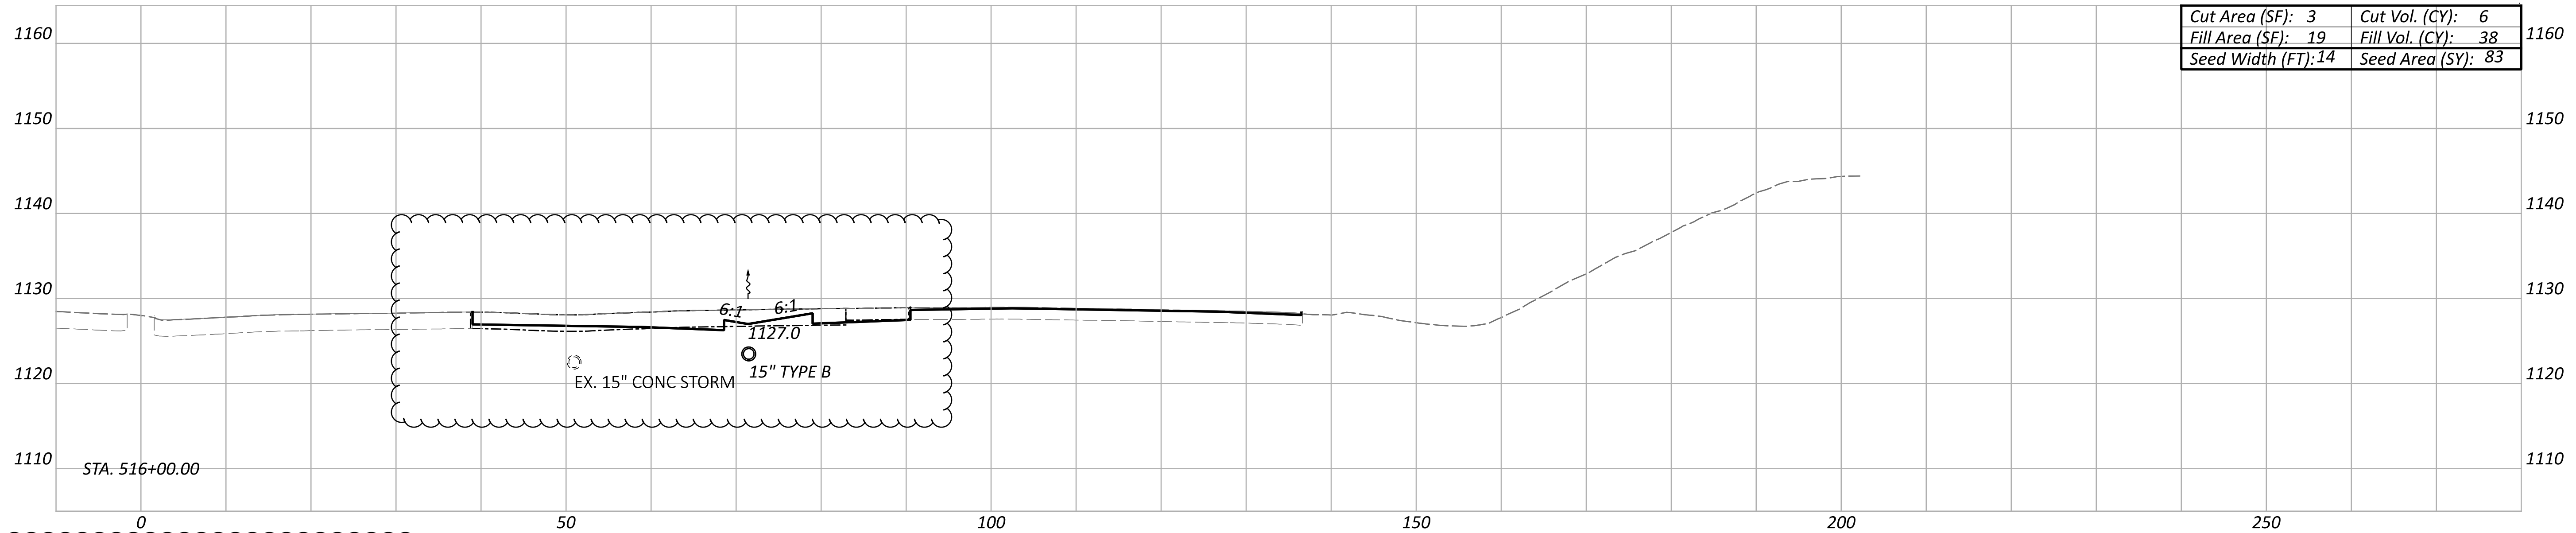

Cut Area (SF): 3	Cut Vol. (CY): 6
Fill Area (SF): 19	Fill Vol. (CY): 38
Seed Width (FT): 14	Seed Area (SY): 83

ITEM 202 - PAVEMENT REMOVED

CROSS SECTIONS
 STA. 516+00 TO STA. 516+50

DESIGN AGENCY





DESIGNER
 AS

REVIEWER
 KKP 12/31/22

PROJECT ID
 113156

Sheet Totals			SHEET TOTAL	
Seeding	Cut	Fill	SHEET	TOTAL
155	11	74	104	233

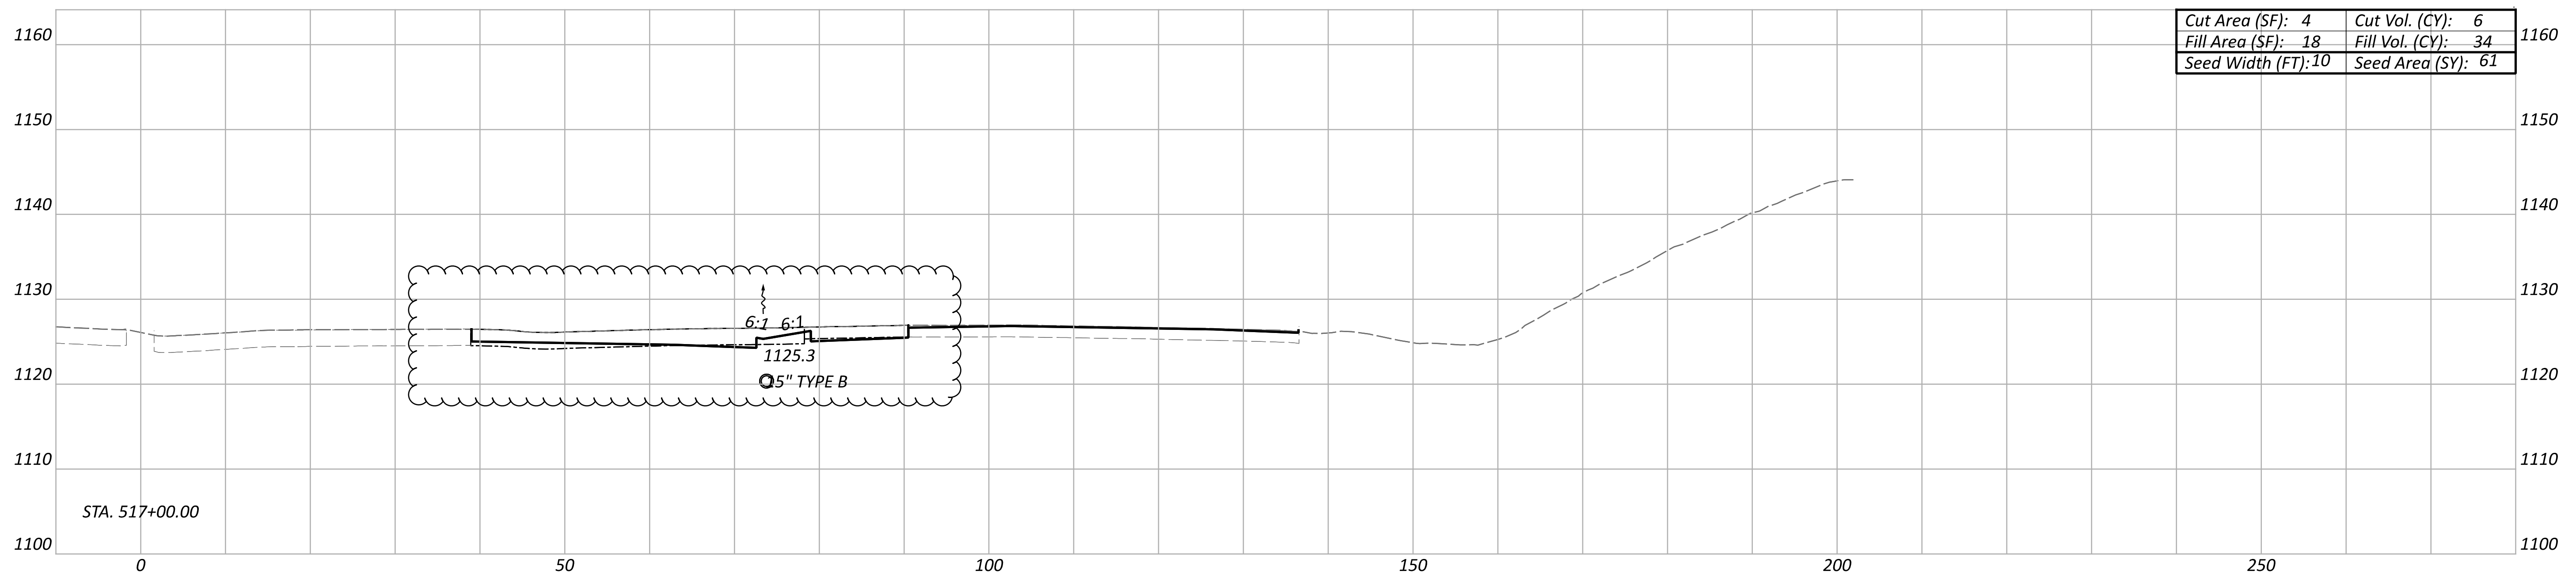
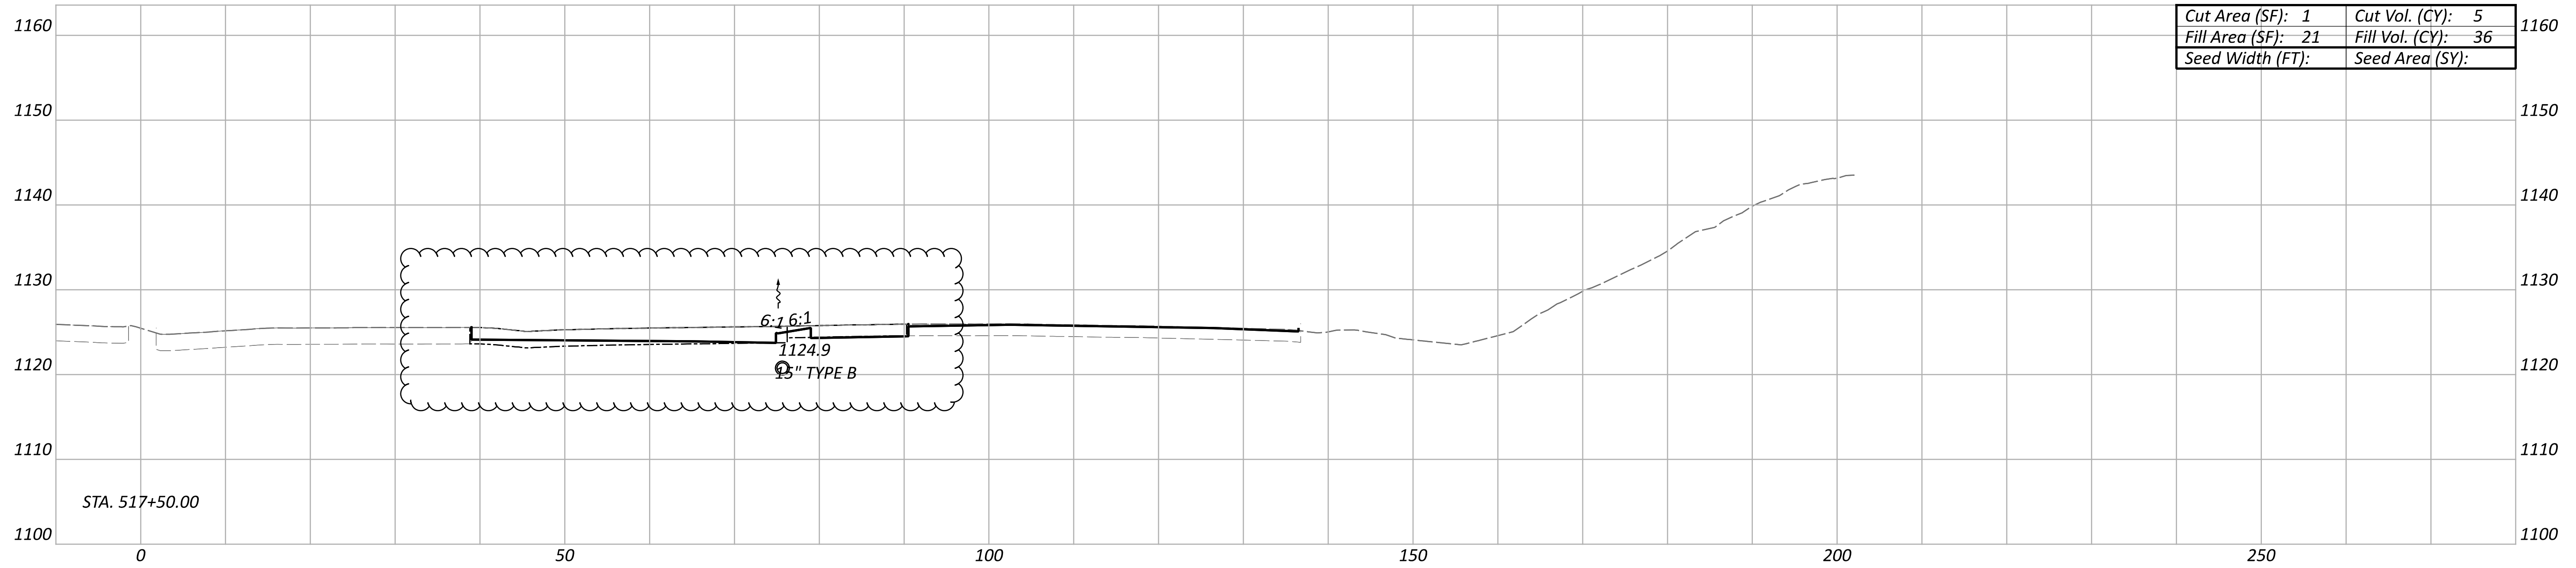


ITEM 202 - PAVEMENT REMOVED

CROSS SECTIONS
 STA. 517+00 TO STA. 517+50

DESIGN AGENCY
HNTB
 DESIGNER
 AS
 REVIEWER
 KKP 12/31/22
 PROJECT ID
 113156

Sheet Totals			SHEET TOTAL	
Seeding	Cut	Fill	105	233
108	11	70		

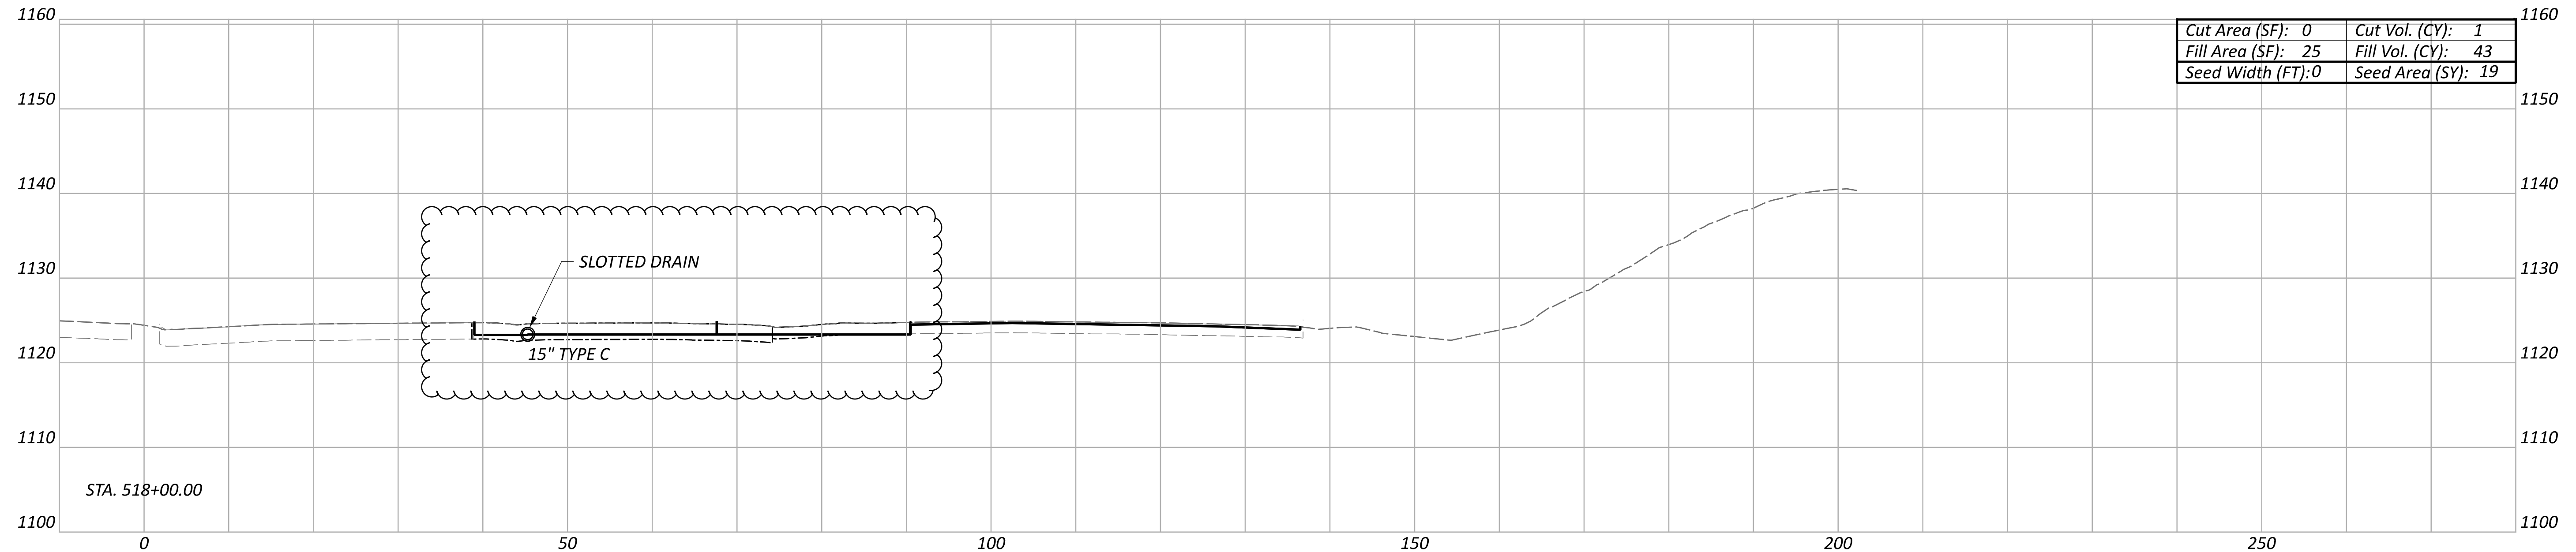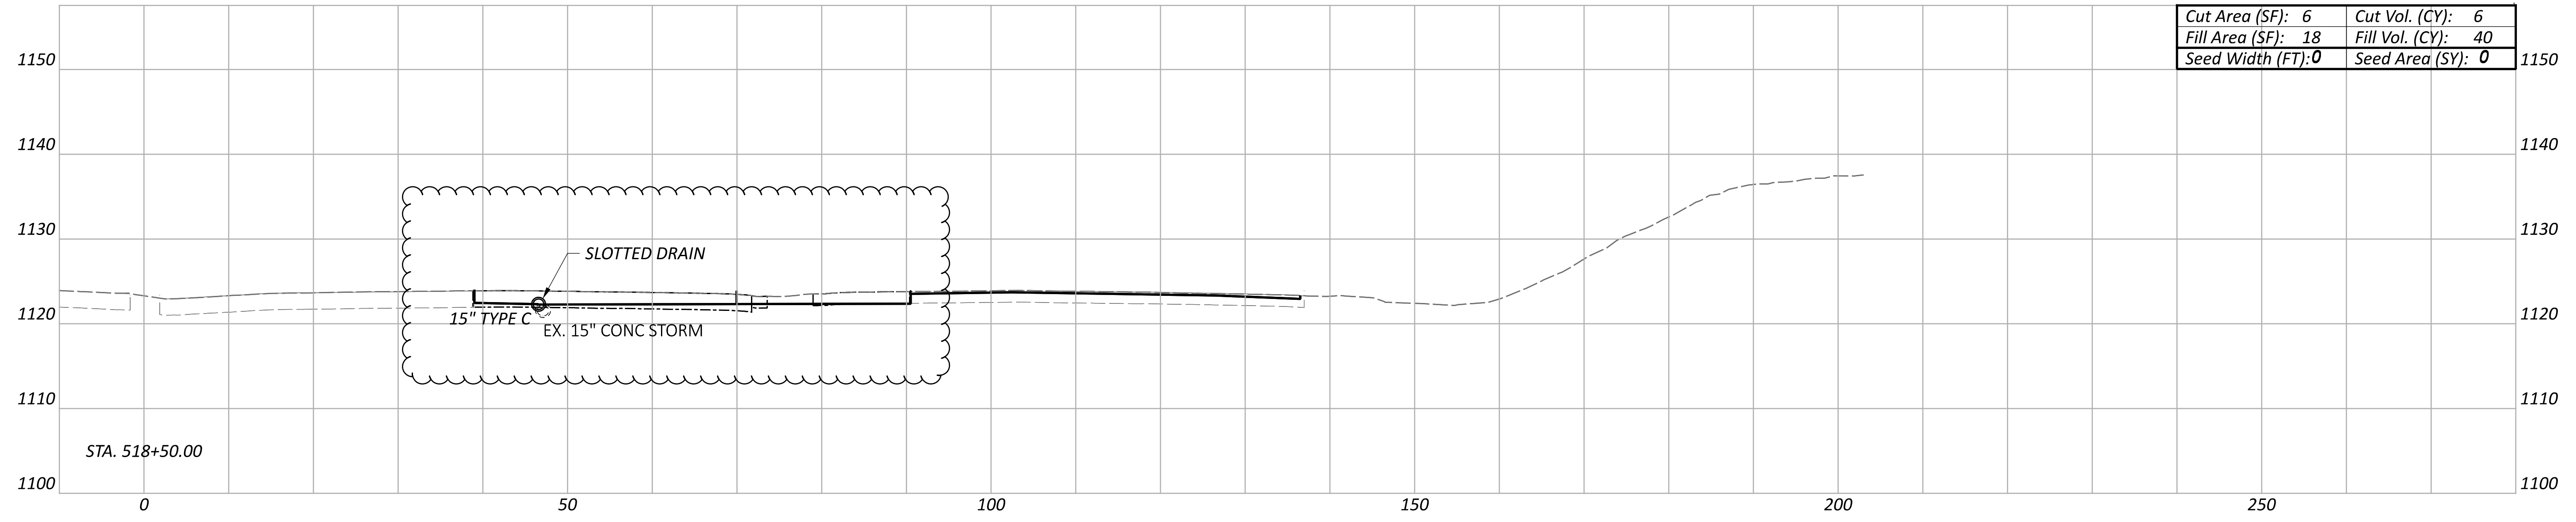

ITEM 202 - PAVEMENT REMOVED

CROSS SECTIONS
 STA. 518+00 TO STA. 518+50

DESIGN AGENCY




DESIGNER
 AS


REVIEWER
 KKP 12/31/22

PROJECT ID
 113156

Sheet Totals			SHEET TOTAL	
Seeding	Cut	Fill	106	233
19	7	83		

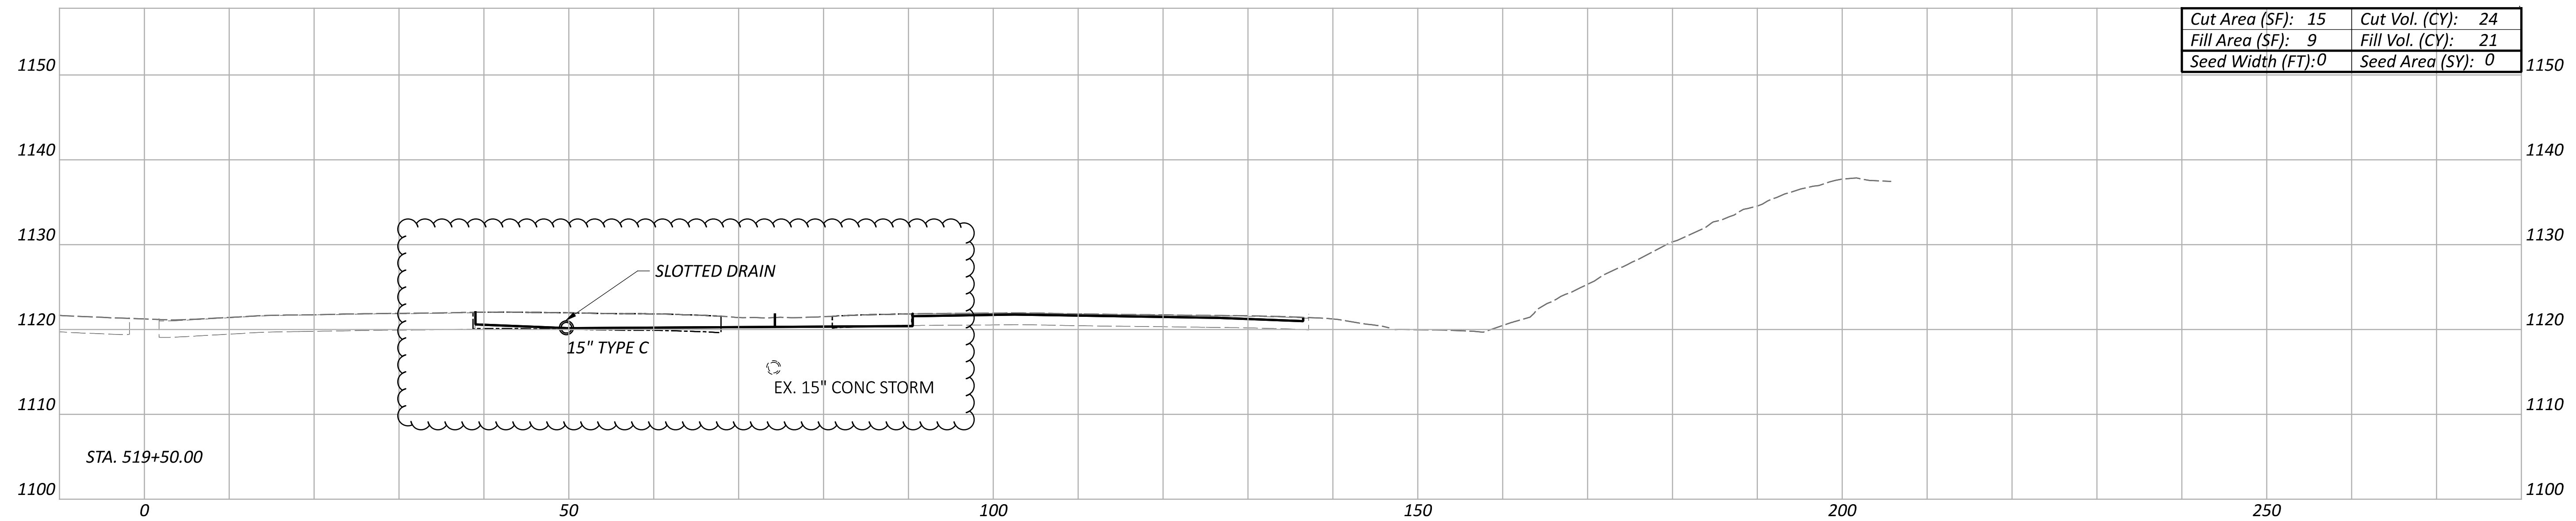

Cut Area (SF): 15	Cut Vol. (CY): 24
Fill Area (SF): 9	Fill Vol. (CY): 21
Seed Width (FT): 0	Seed Area (SY): 0

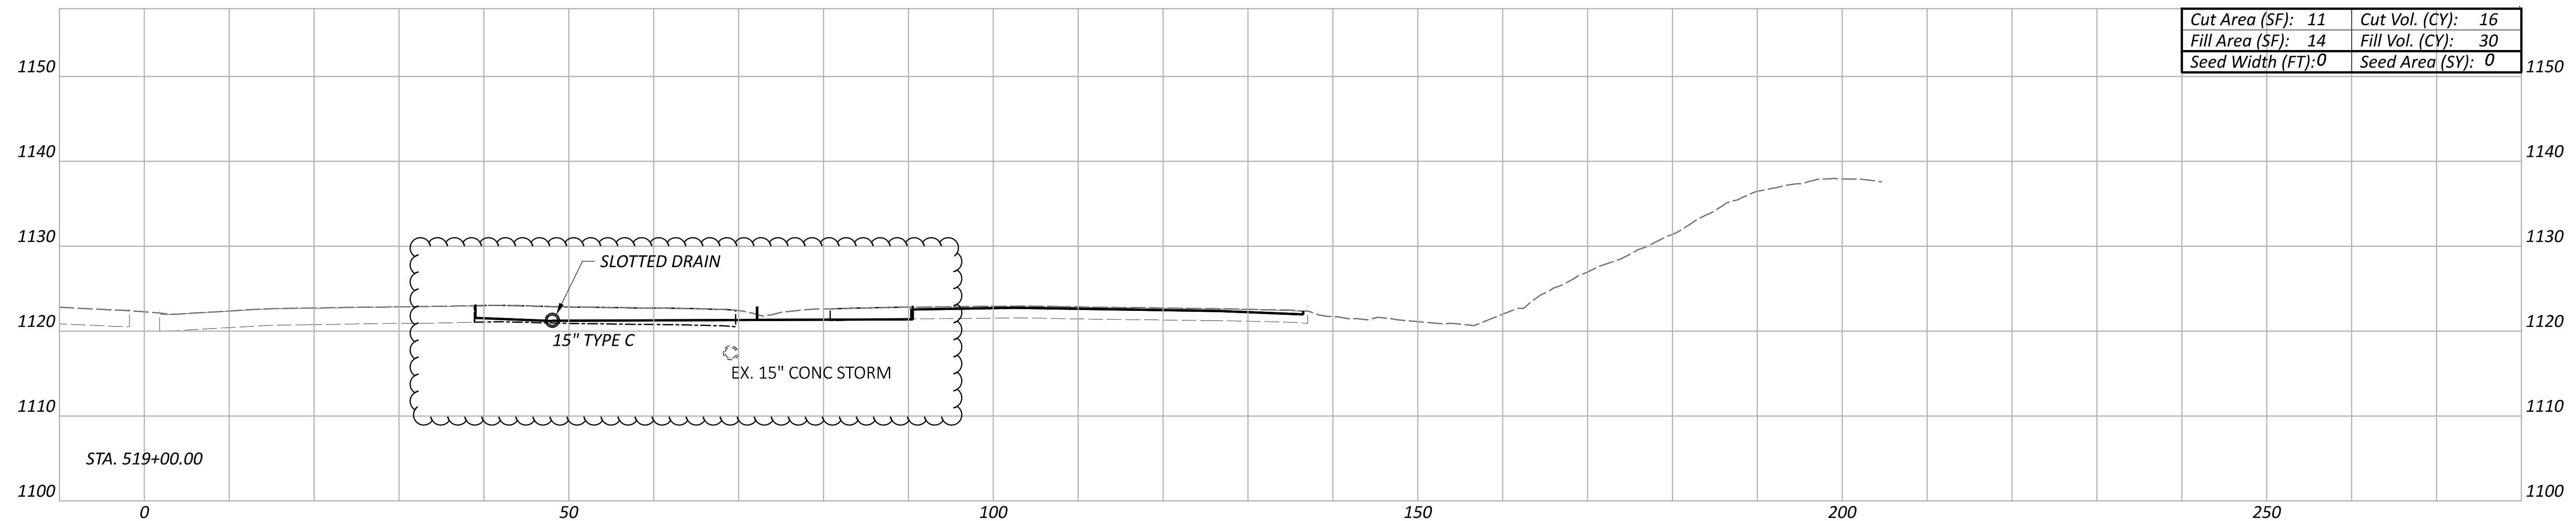



Cut Area (SF): 11	Cut Vol. (CY): 16
Fill Area (SF): 14	Fill Vol. (CY): 30
Seed Width (FT): 0	Seed Area (SY): 0

ITEM 202 - PAVEMENT REMOVED

CROSS SECTIONS
 STA. 519+00 TO STA. 519+50

DESIGN AGENCY	
HNTB	
DESIGNER	AS
REVIEWER	KKP 12/31/22
PROJECT ID	113156

Sheet Totals			SHEET	TOTAL
Seeding	Cut	Fill	107	233
0	40	51		

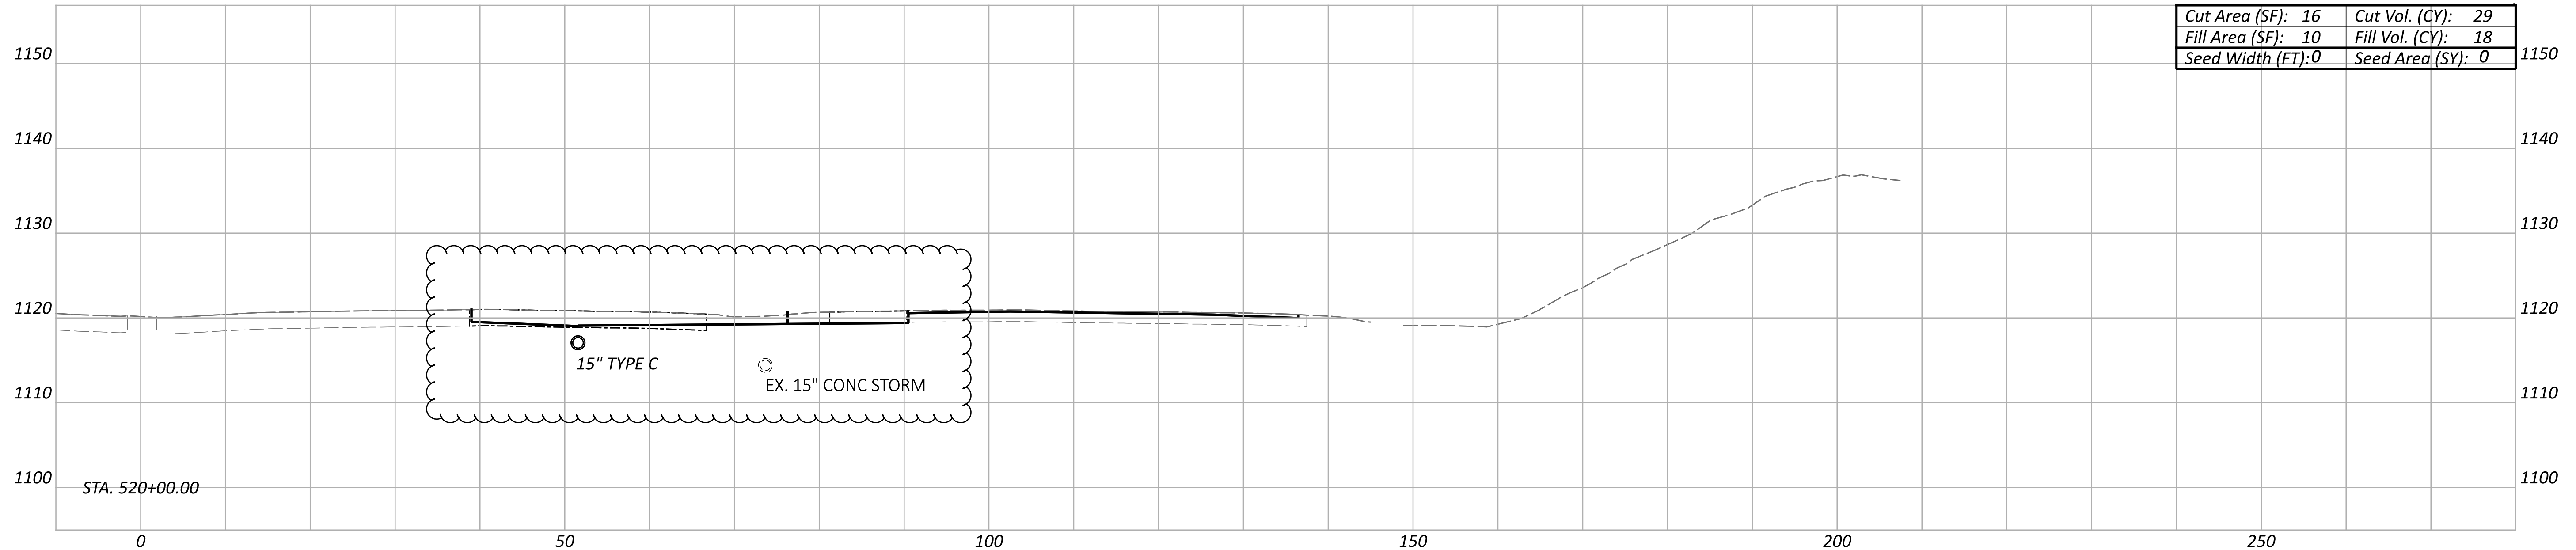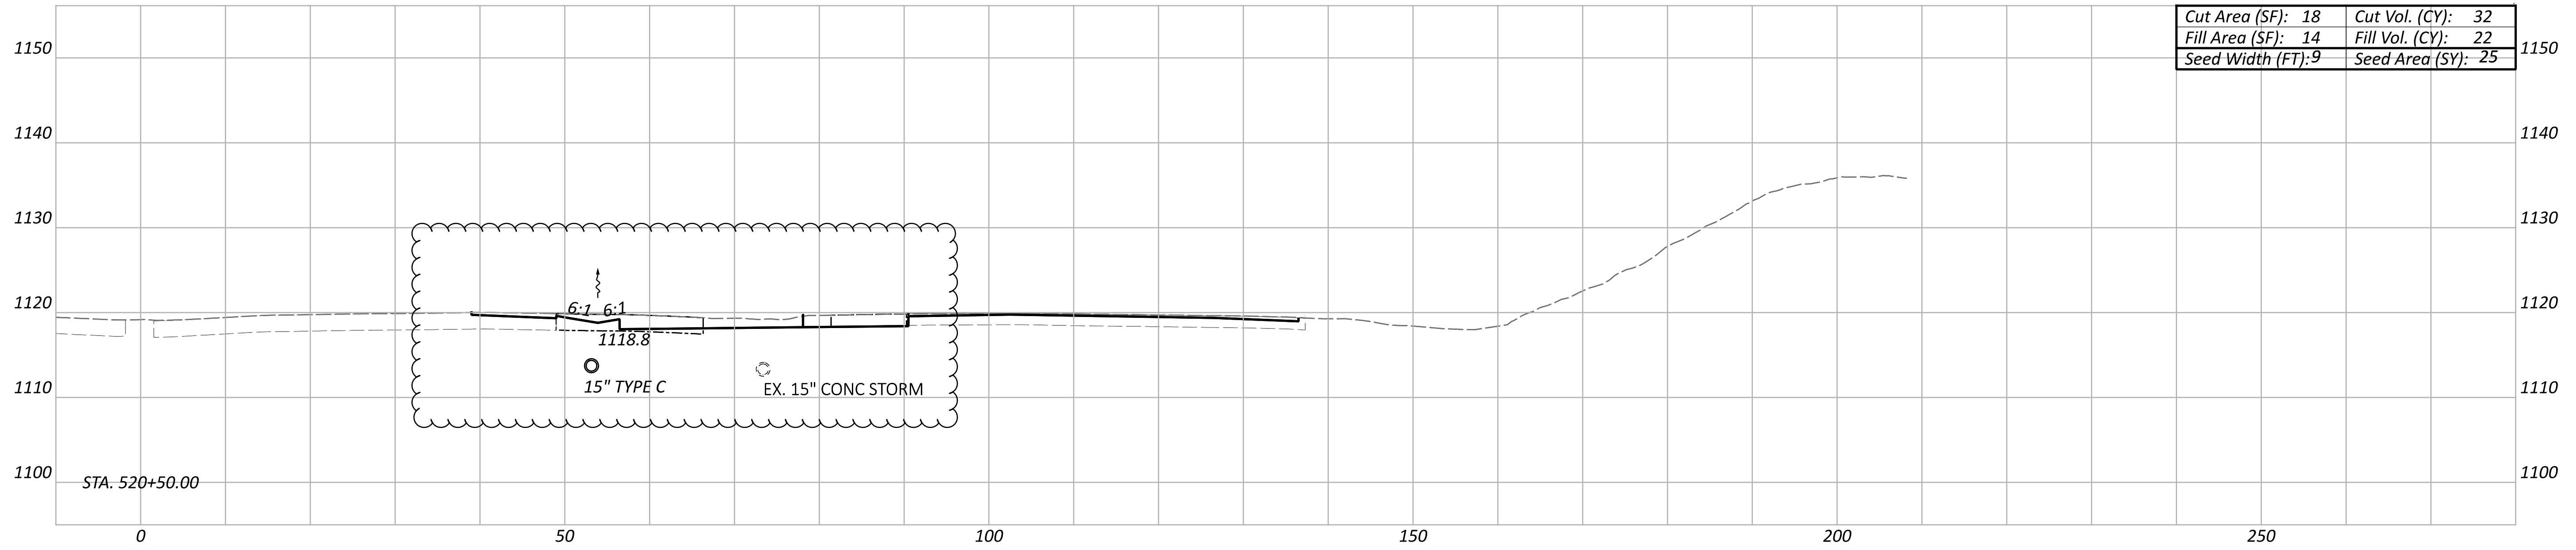

ITEM 202 - PAVEMENT REMOVED

CROSS SECTIONS
 STA. 520+00 TO STA. 520+50

DESIGN AGENCY





DESIGNER
 AS

REVIEWER
 KKP 12/31/22

PROJECT ID
 113156

Sheet Totals			SHEET TOTAL	
Seeding	Cut	Fill	SHEET	TOTAL
25	61	40	108	233

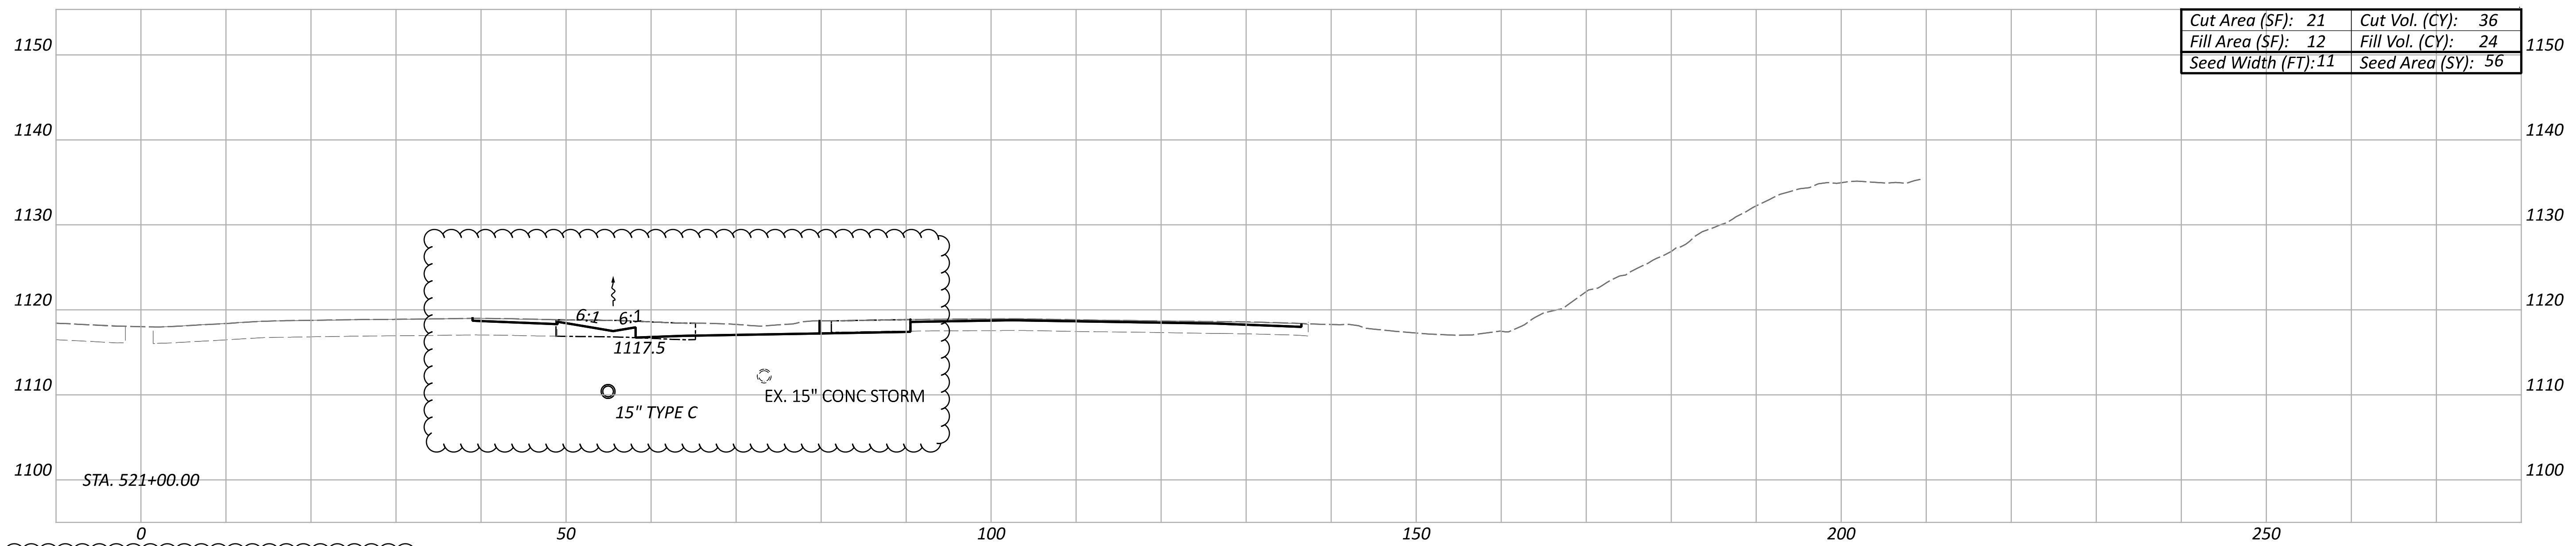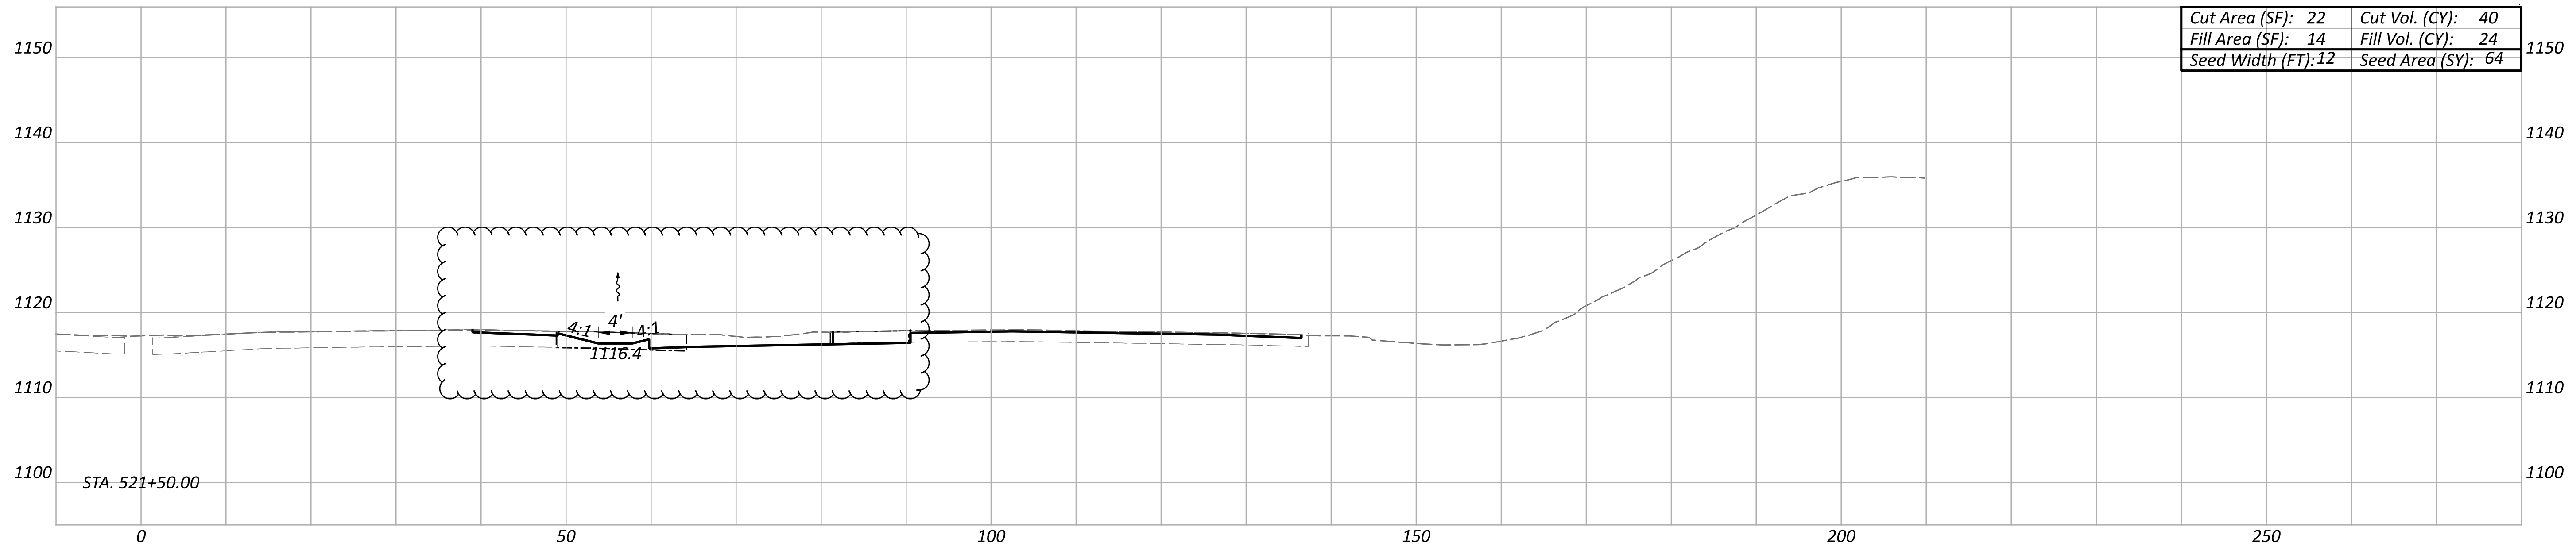

ITEM 202 - PAVEMENT REMOVED

CROSS SECTIONS
 STA. 521+00 TO STA. 521+50

DESIGN AGENCY



DESIGNER

AS

REVIEWER

KKP 12/31/22

PROJECT ID



113156

Sheet Totals

Seeding	Cut	Fill
120	76	48

SHEET TOTAL

109	233
-----	-----

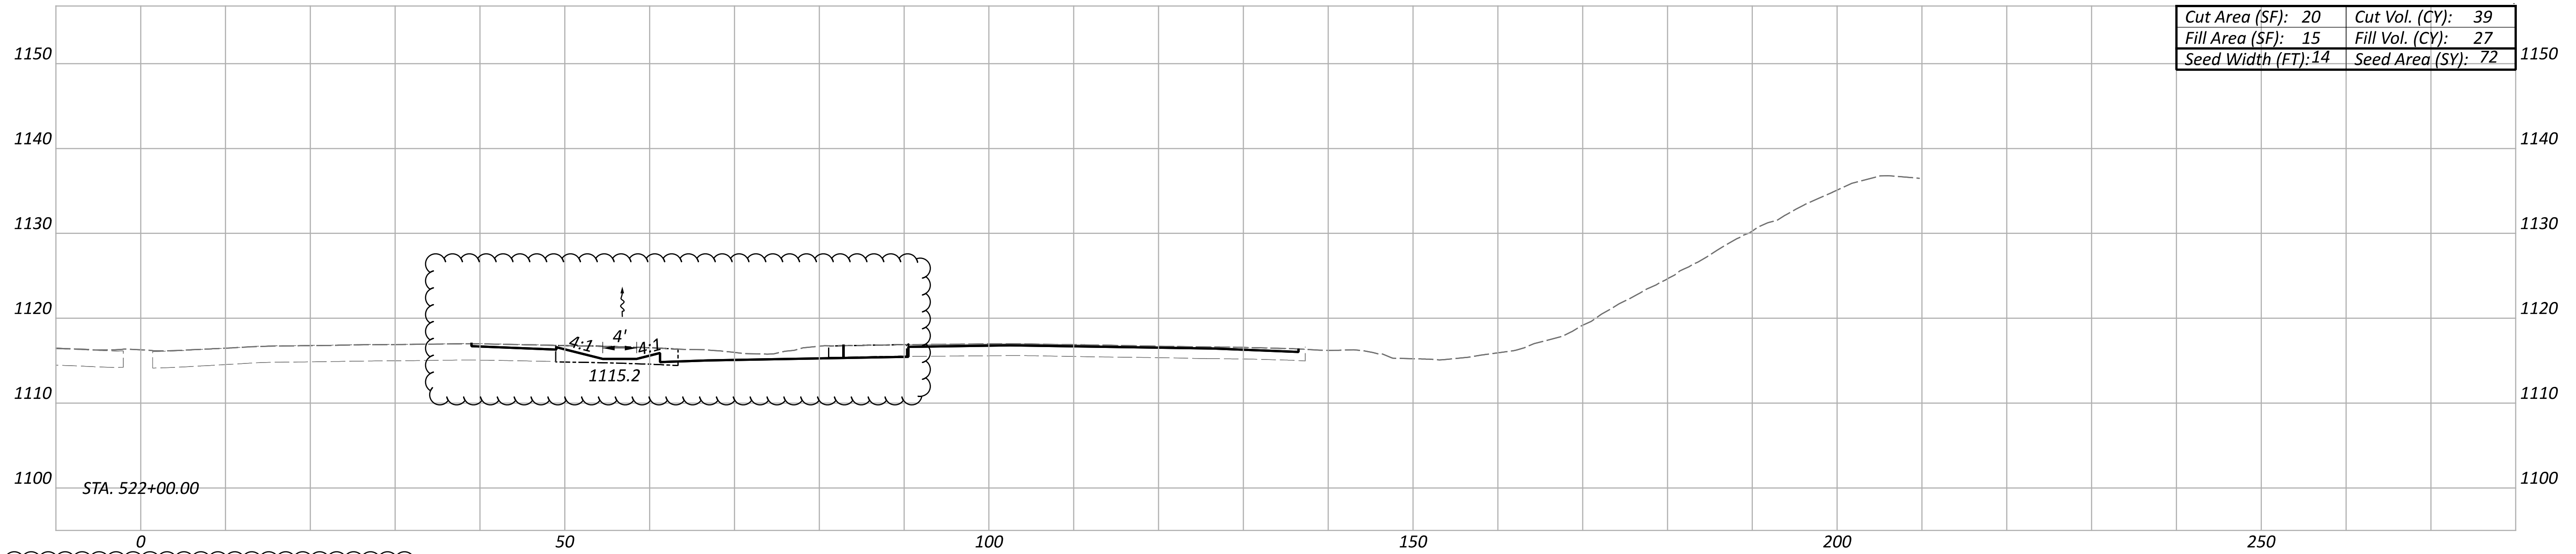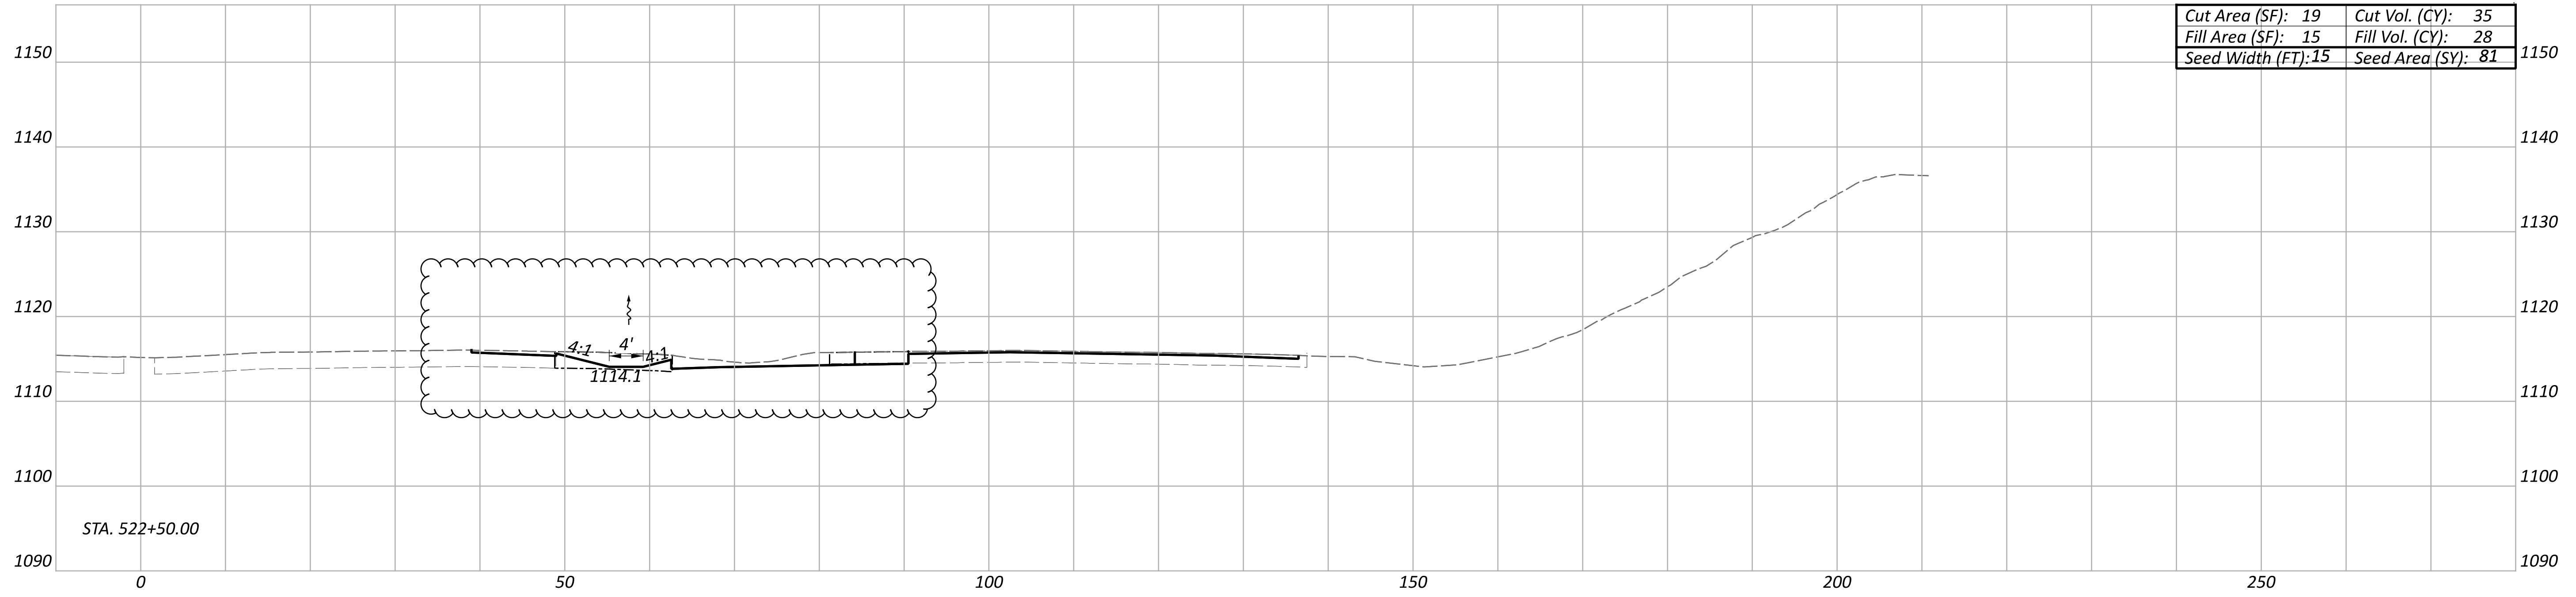

ITEM 202 - PAVEMENT REMOVED

CROSS SECTIONS
 STA. 522+00 TO STA. 522+50

DESIGN AGENCY





DESIGNER
 AS

REVIEWER
 KKP 12/31/22

PROJECT ID
 113156

Sheet Totals			SHEET TOTAL	
Seeding	Cut	Fill	110	233
153	74	55		

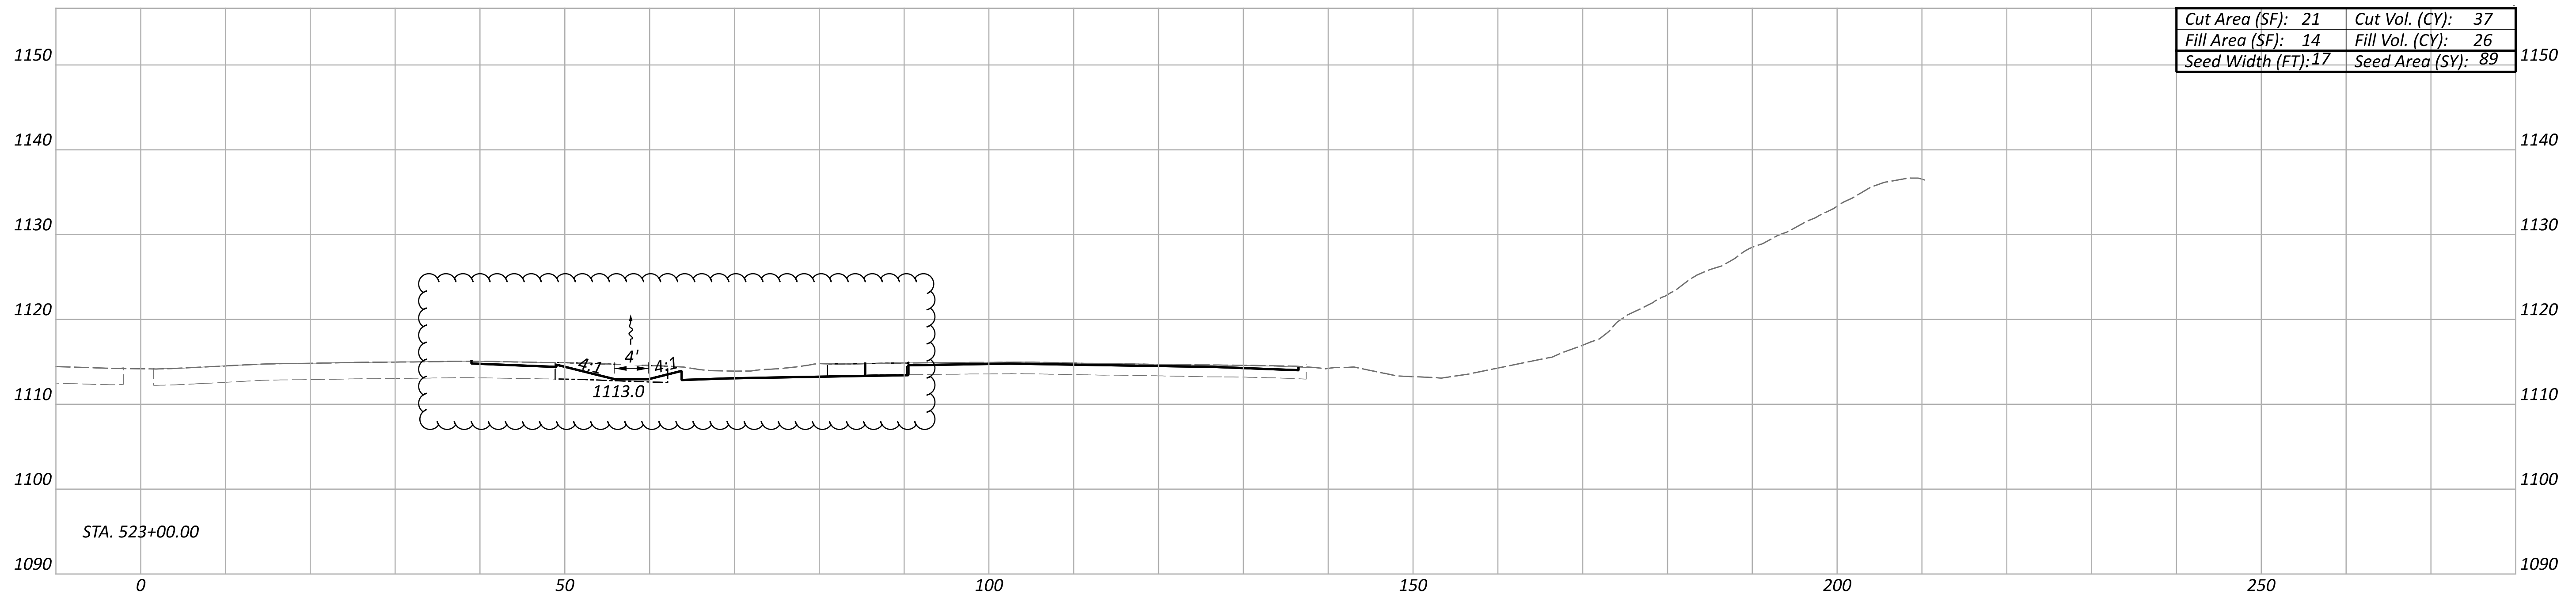
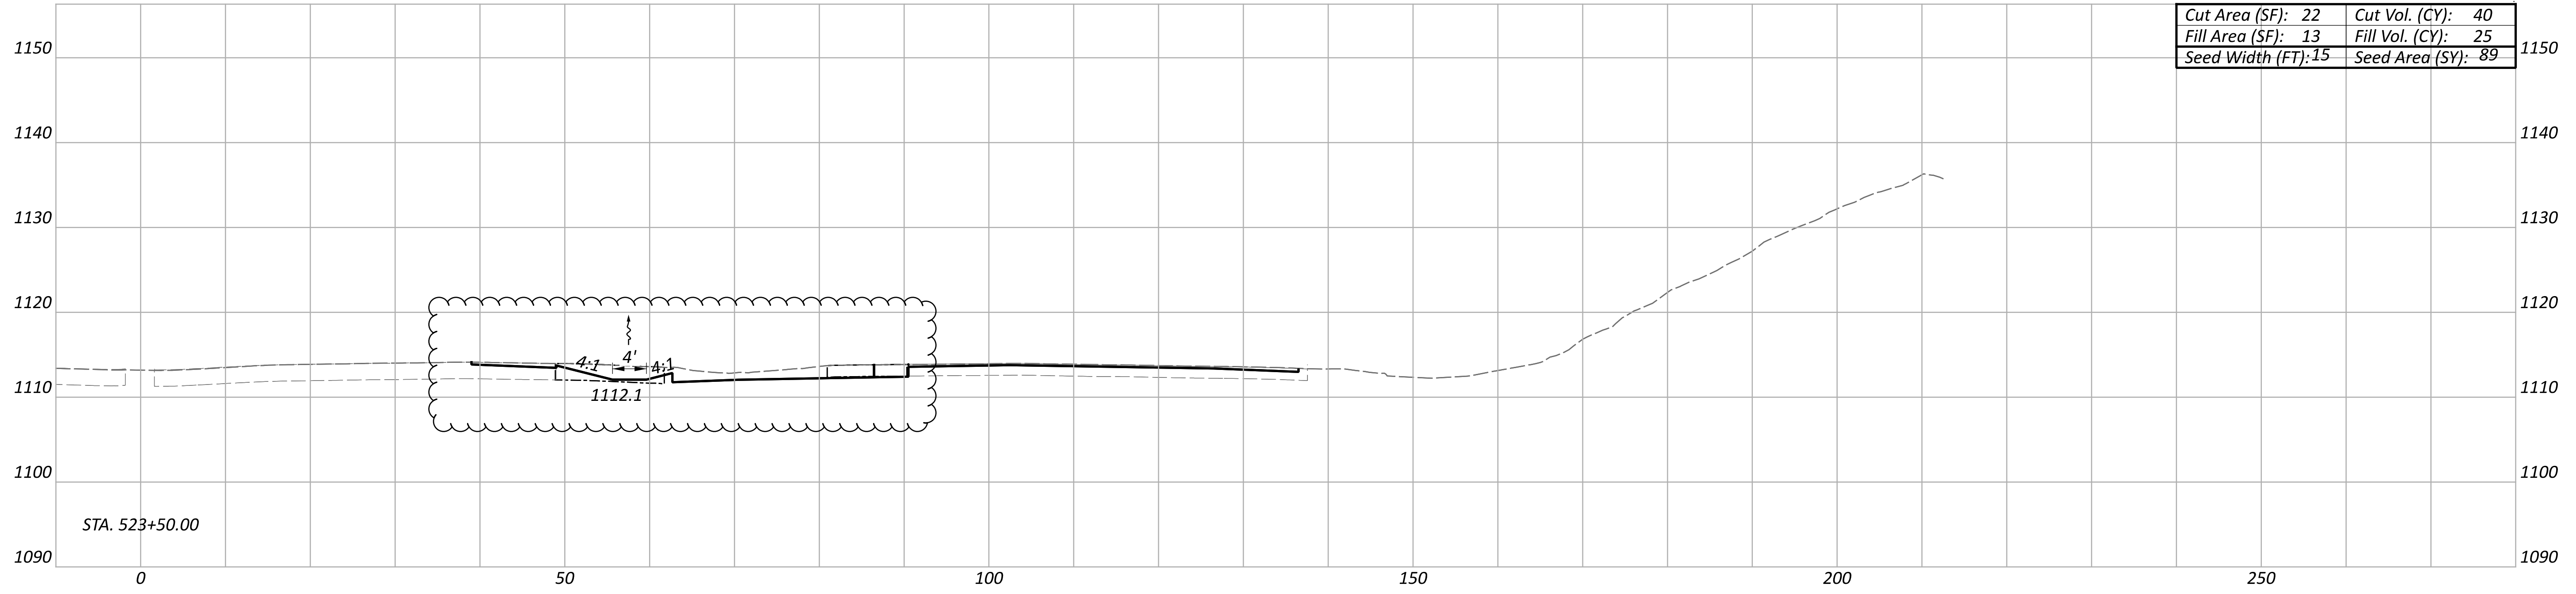


ITEM 202 - PAVEMENT REMOVED

CROSS SECTIONS
 STA. 523+00 TO STA. 523+50

DESIGN AGENCY
HNTB
 DESIGNER
 AS
 REVIEWER
 KKP 12/31/22
 PROJECT ID
 113156

Sheet Totals			SHEET TOTAL	
Seeding	Cut	Fill	111	233
178	77	51		

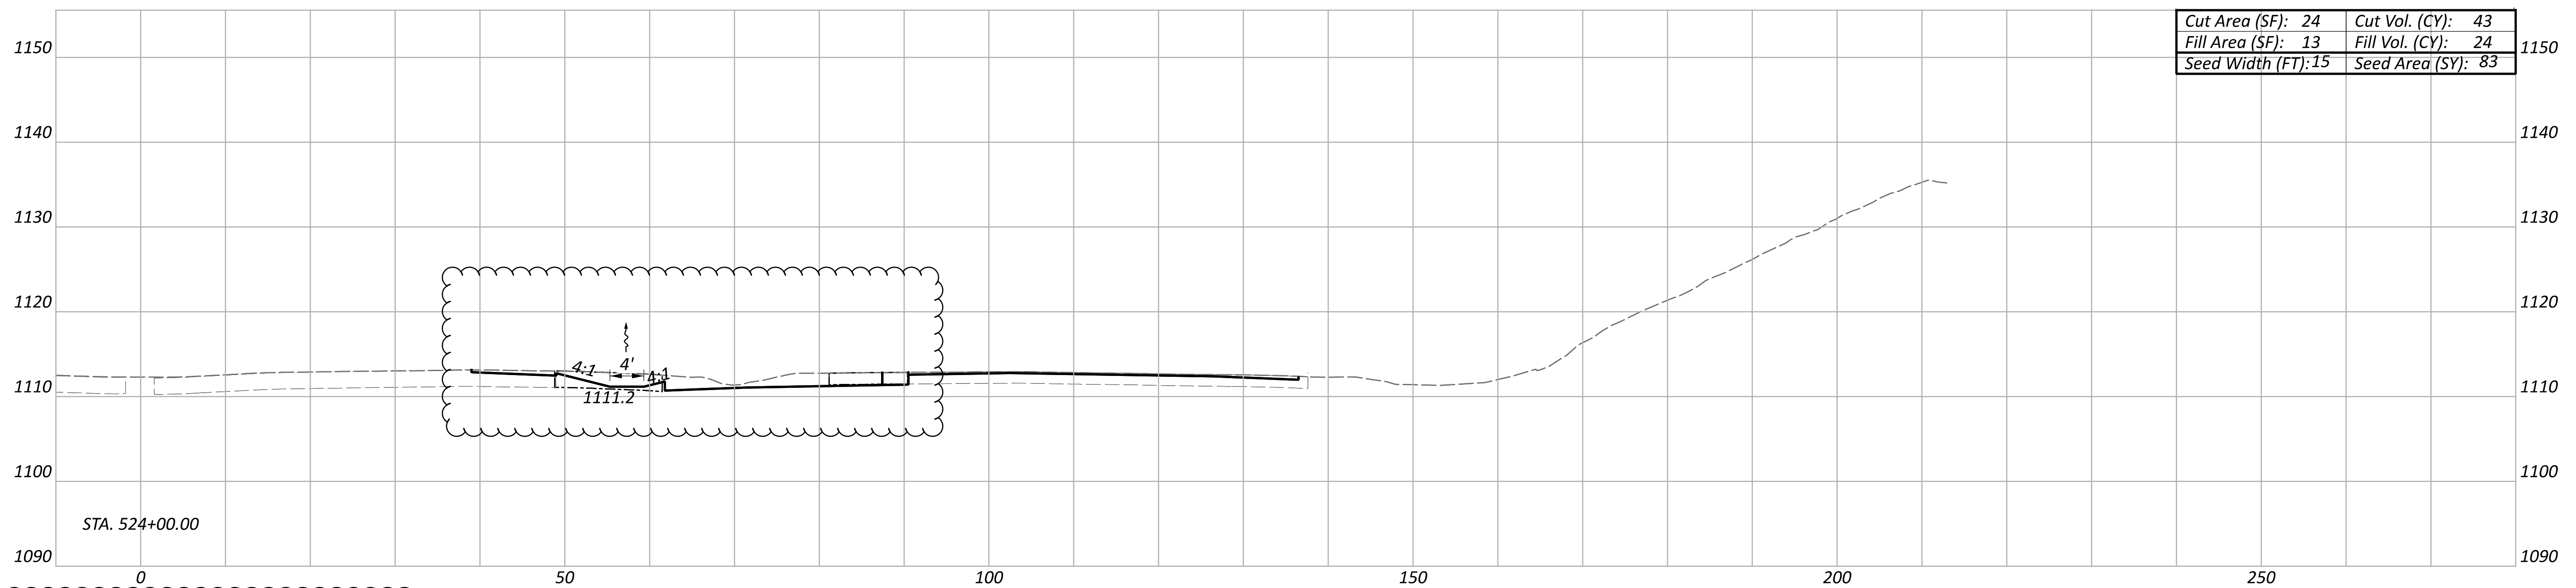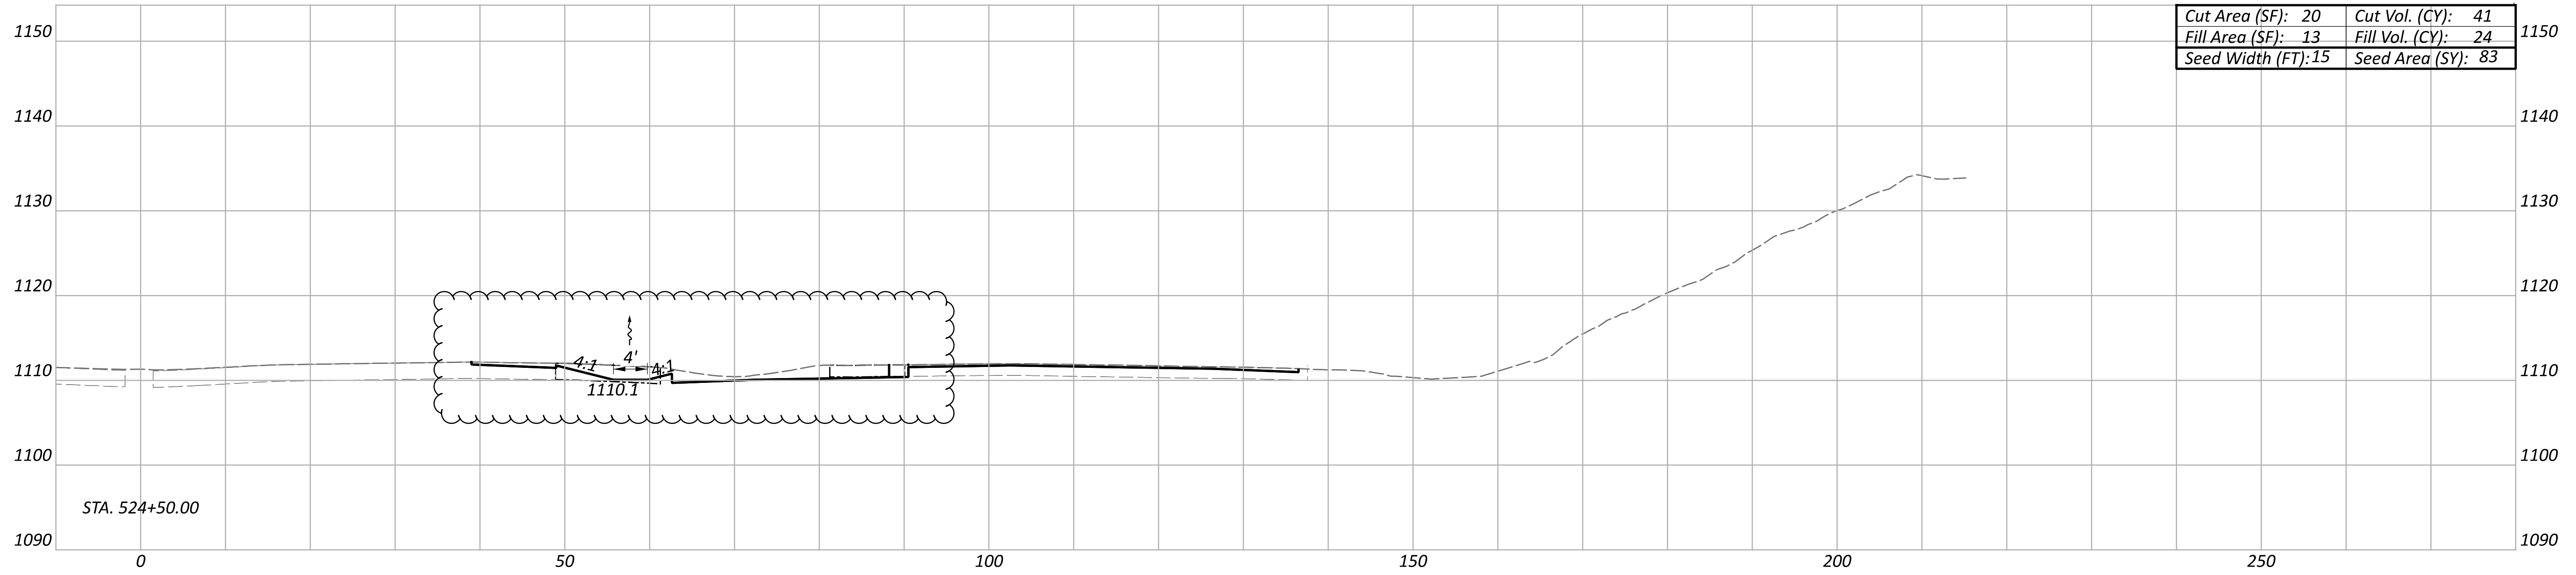

ITEM 202 - PAVEMENT REMOVED

CROSS SECTIONS
 STA. 524+00 TO STA. 524+50

DESIGN AGENCY





DESIGNER
 AS

REVIEWER
 KKP 12/31/22

PROJECT ID
 113156

Sheet Totals			SHEET	TOTAL
Seeding	Cut	Fill	112	233
166	84	48		

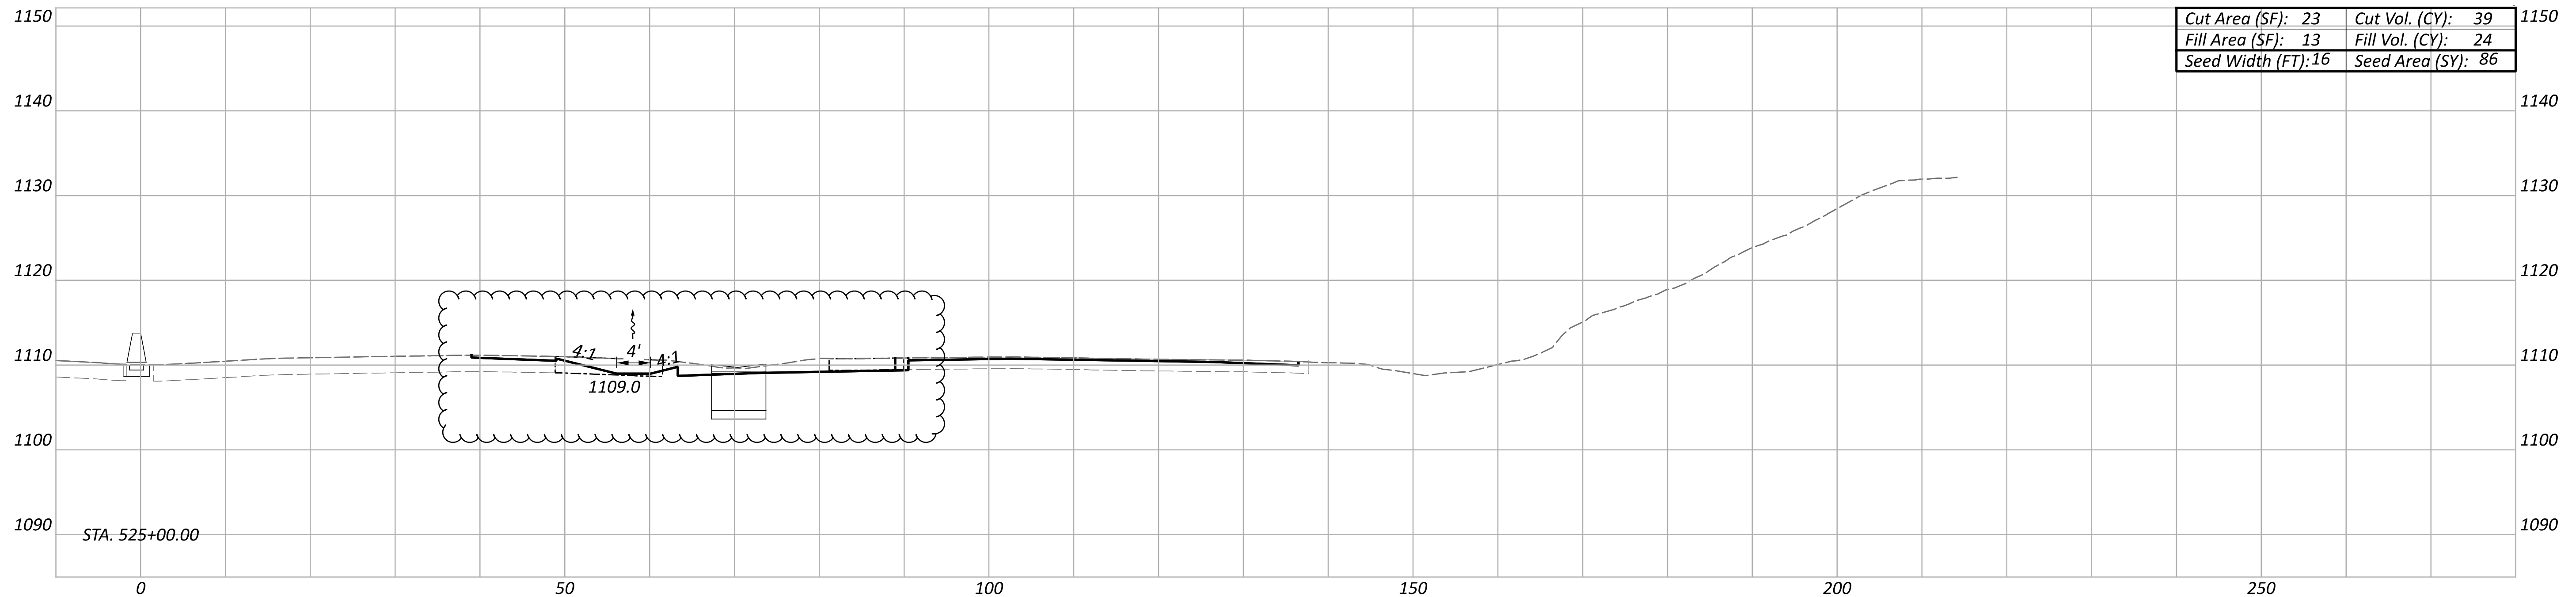
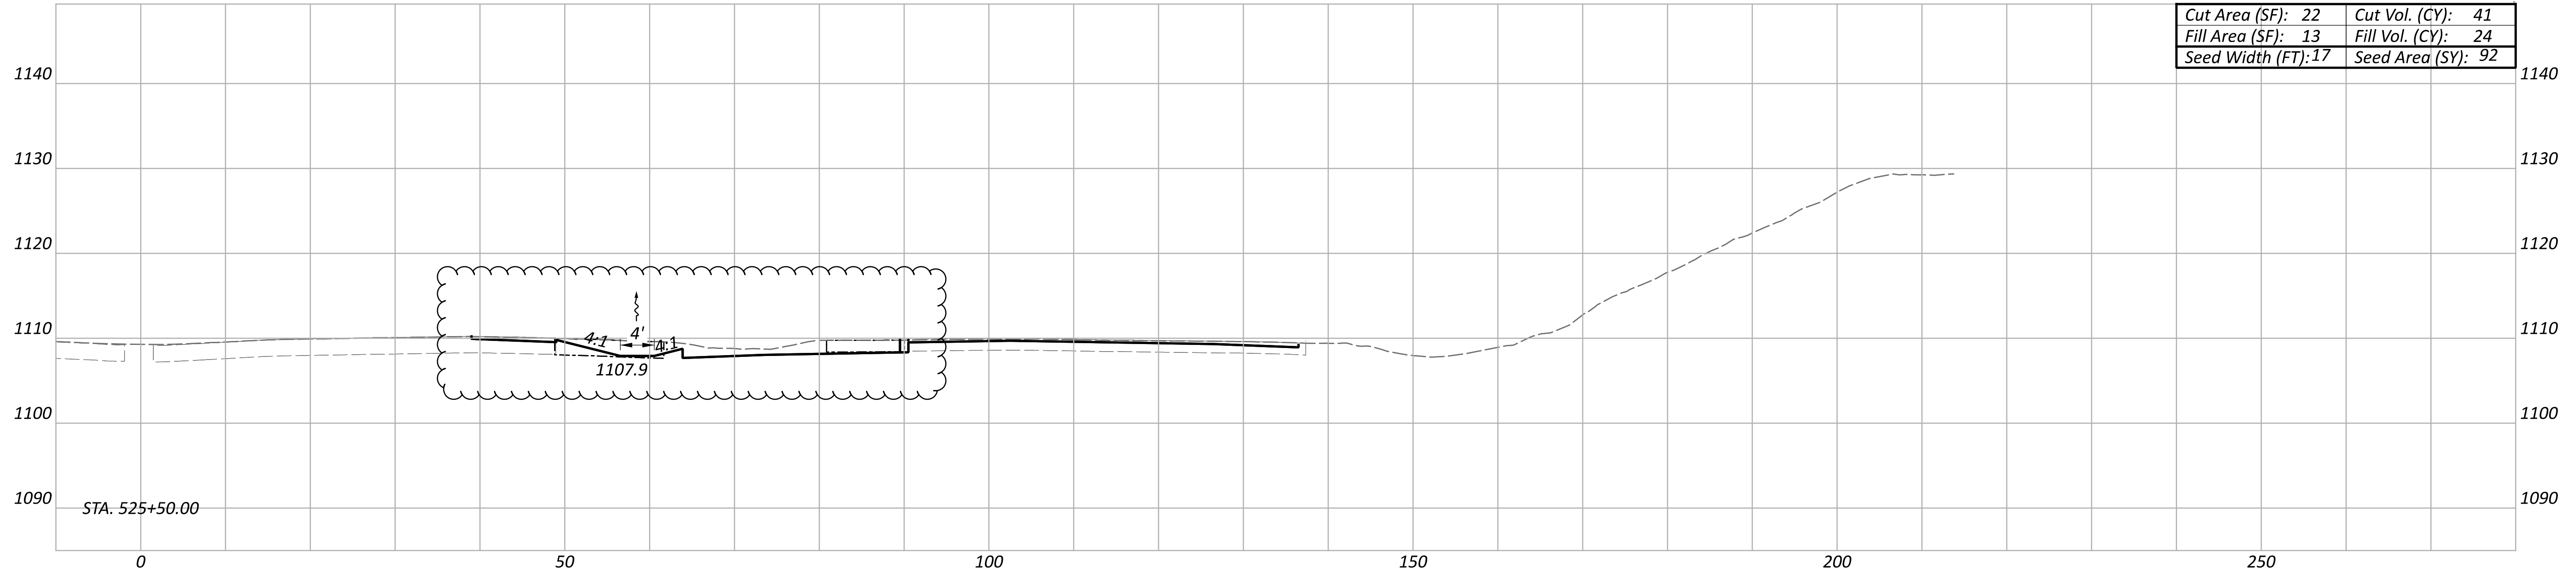


ITEM 202 - PAVEMENT REMOVED

CROSS SECTIONS
 STA. 525+00 TO STA. 525+50

DESIGN AGENCY
HNTB
 DESIGNER
 AS
 REVIEWER
 KKP 12/31/22
 PROJECT ID
 113156

Sheet Totals			SHEET TOTAL	
Seeding	Cut	Fill	113	233
178	91	48		

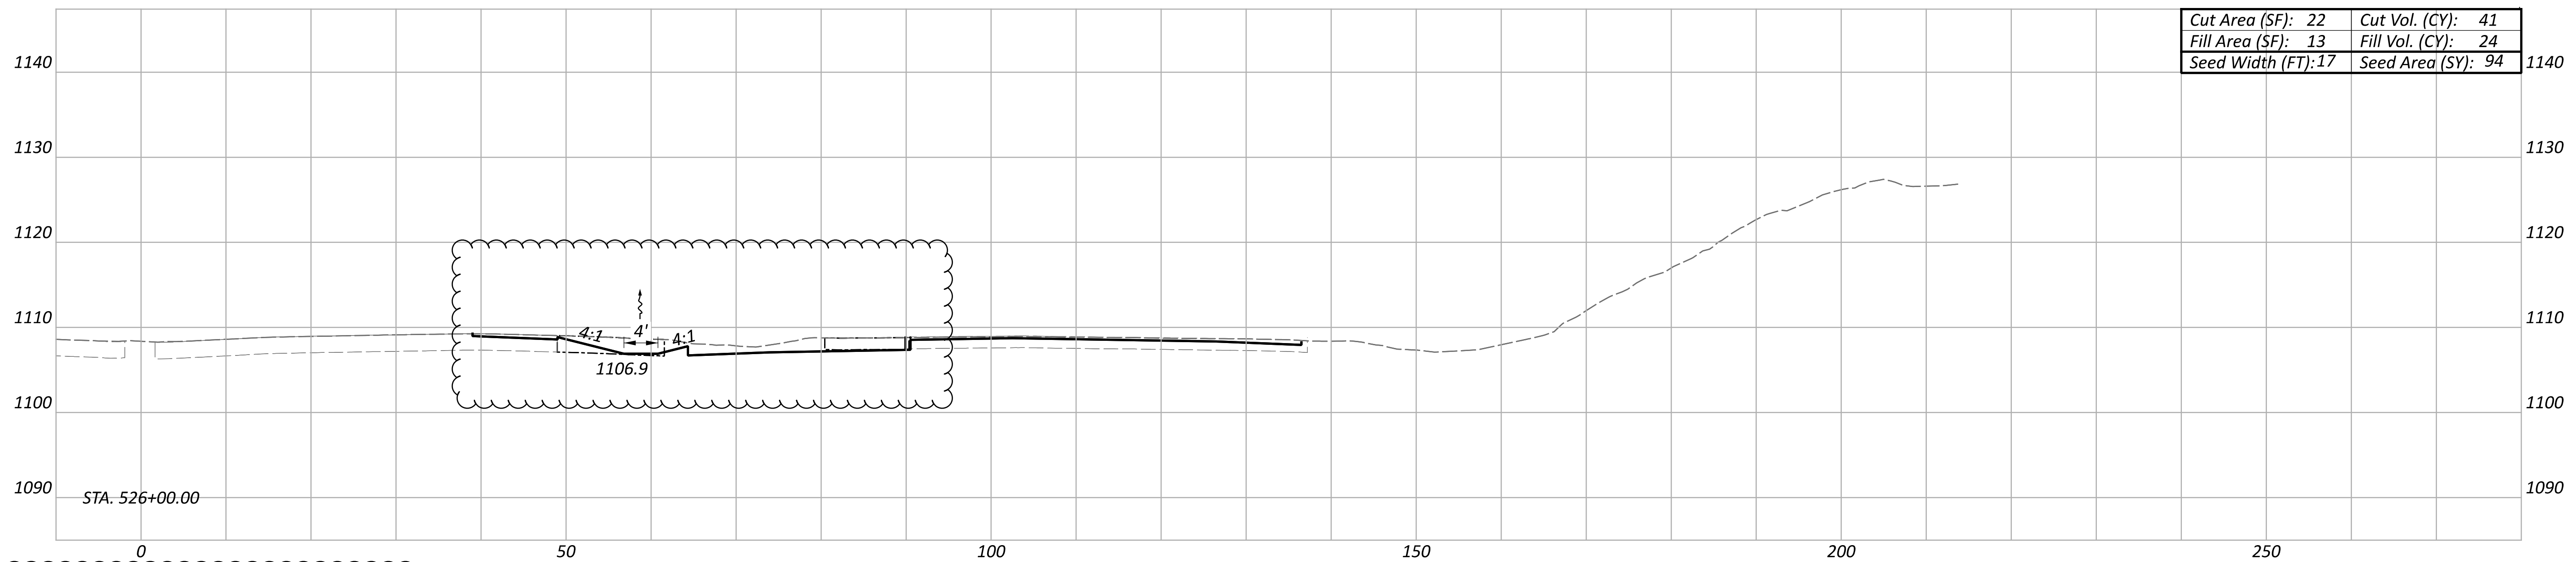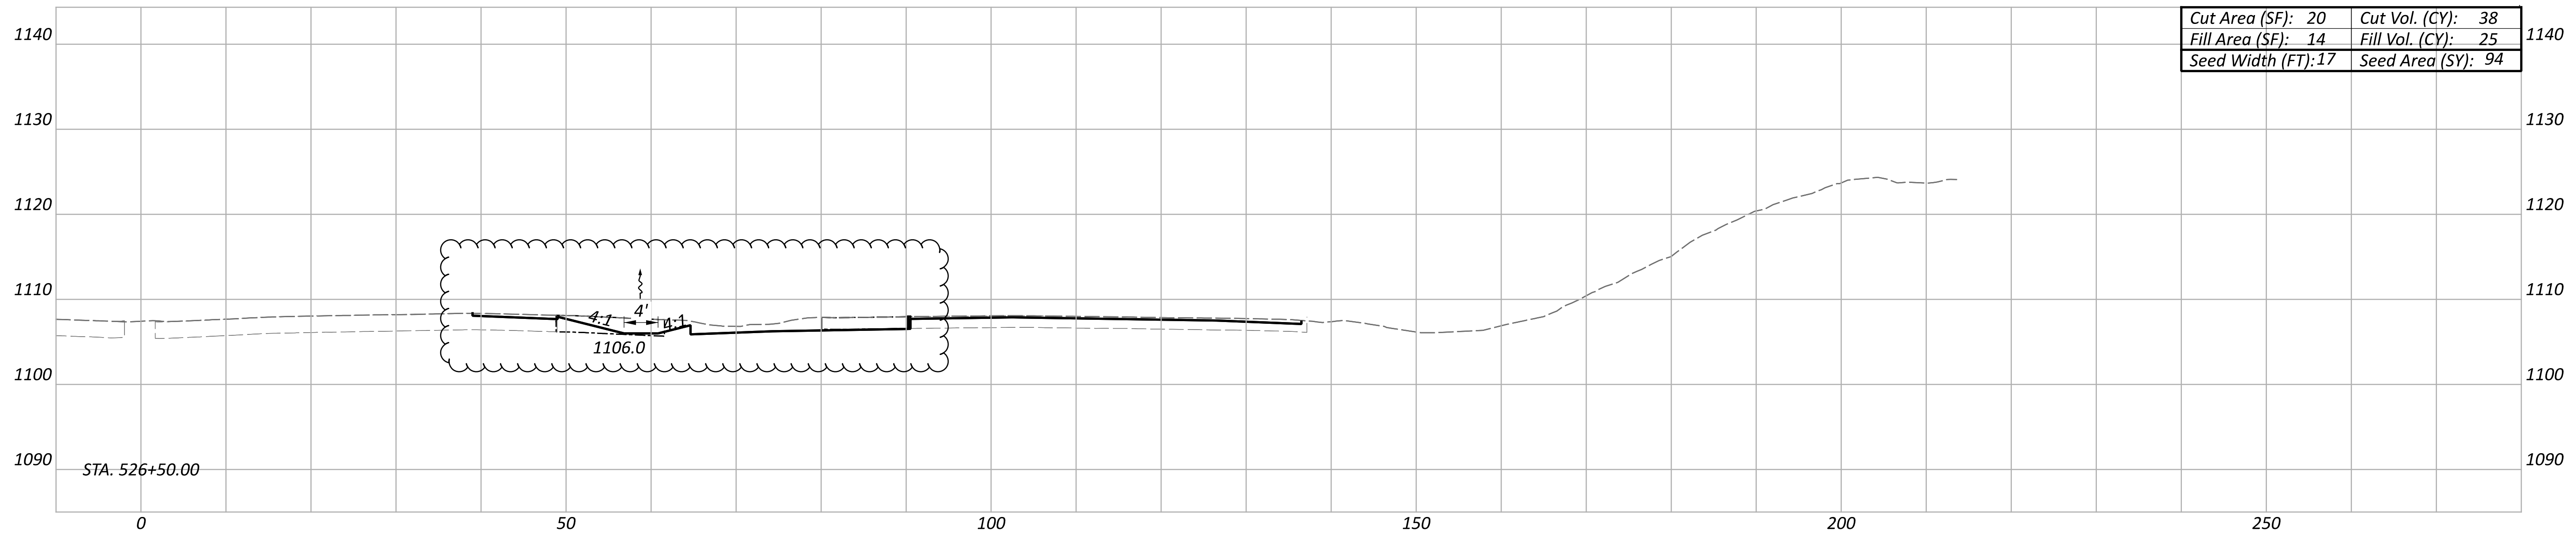

ITEM 202 - PAVEMENT REMOVED

CROSS SECTIONS
 STA. 526+00 TO STA. 526+50

DESIGN AGENCY



DESIGNER

AS

REVIEWER



KKP 12/31/22

PROJECT ID

113156

Sheet Totals		
Seeding	Cut	Fill
188	79	49

SHEET	TOTAL
114	233

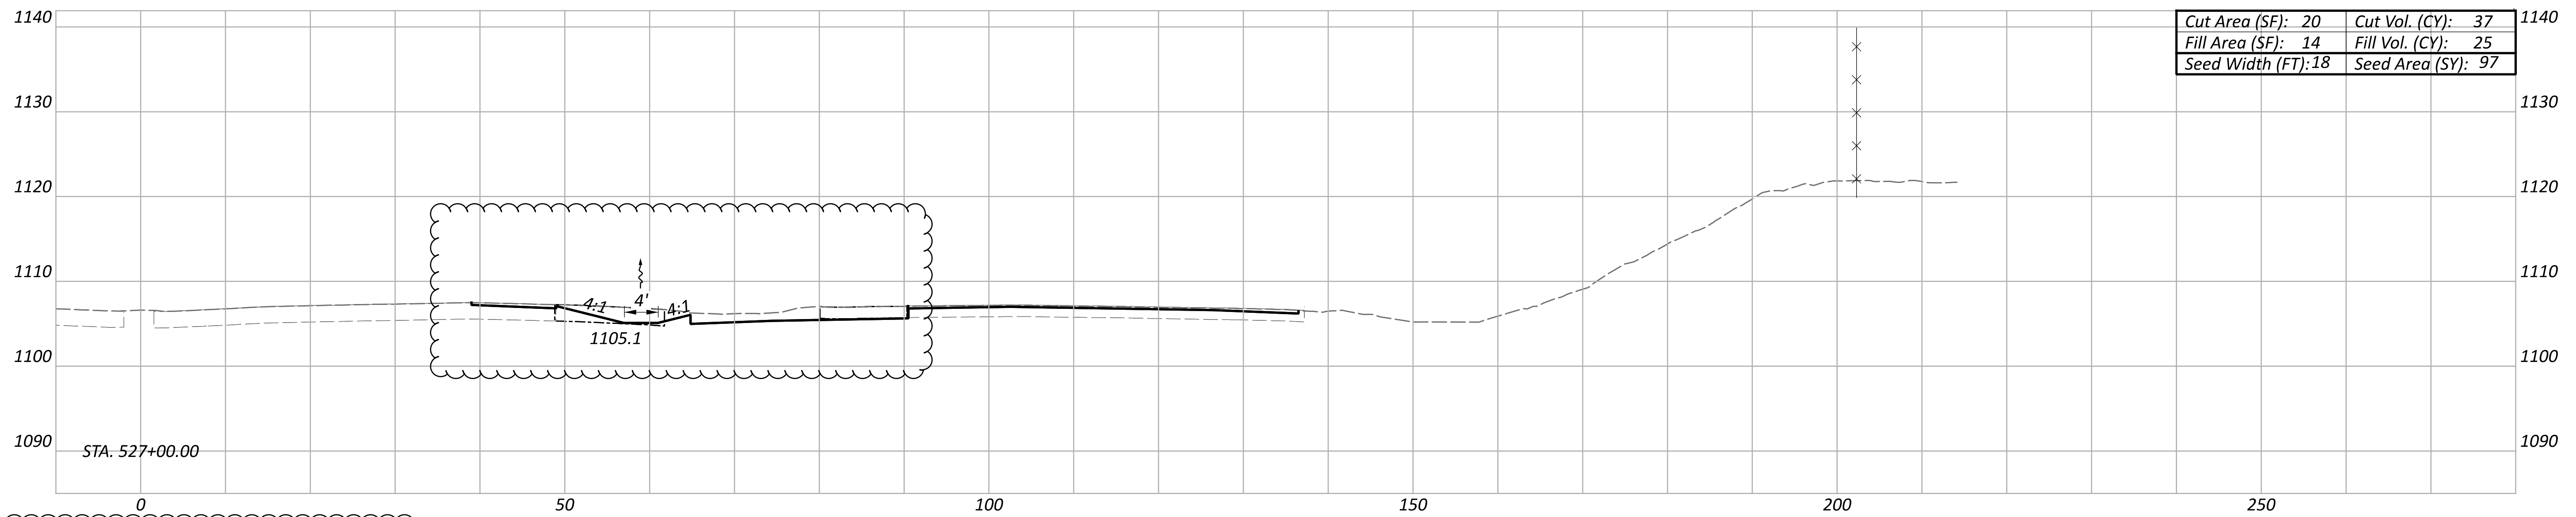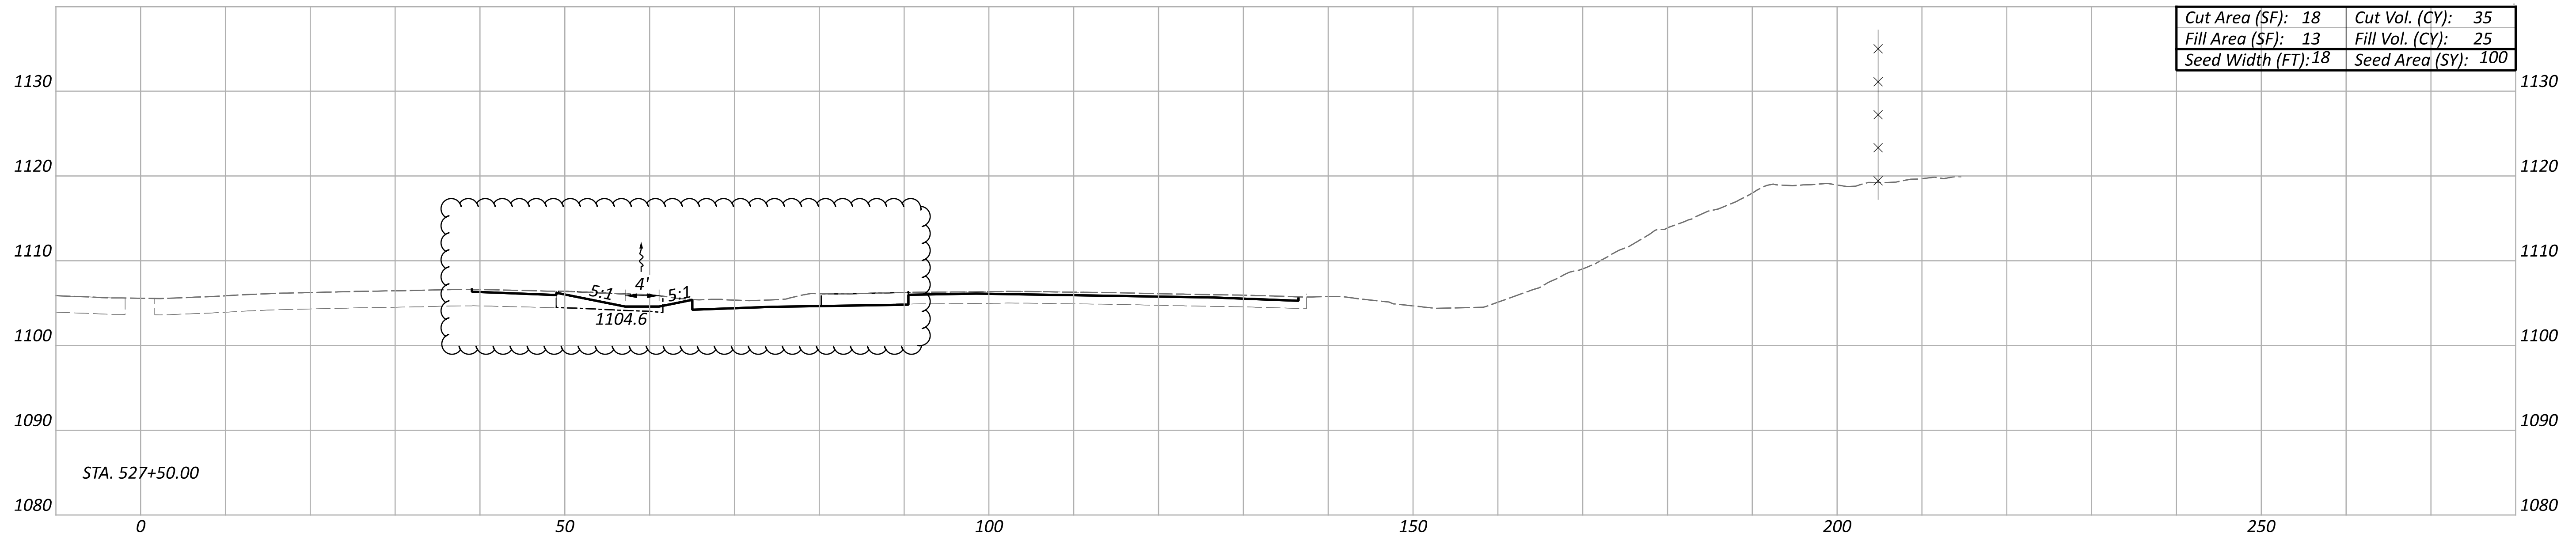

ITEM 202 - PAVEMENT REMOVED

CROSS SECTIONS
 STA. 527+00 TO STA. 527+50

DESIGN AGENCY






DESIGNER
 AS

REVIEWER
 KKP 12/31/22

PROJECT ID
 113156

Sheet Totals			SHEET TOTAL	
Seeding	Cut	Fill	115	233
197	73	50		

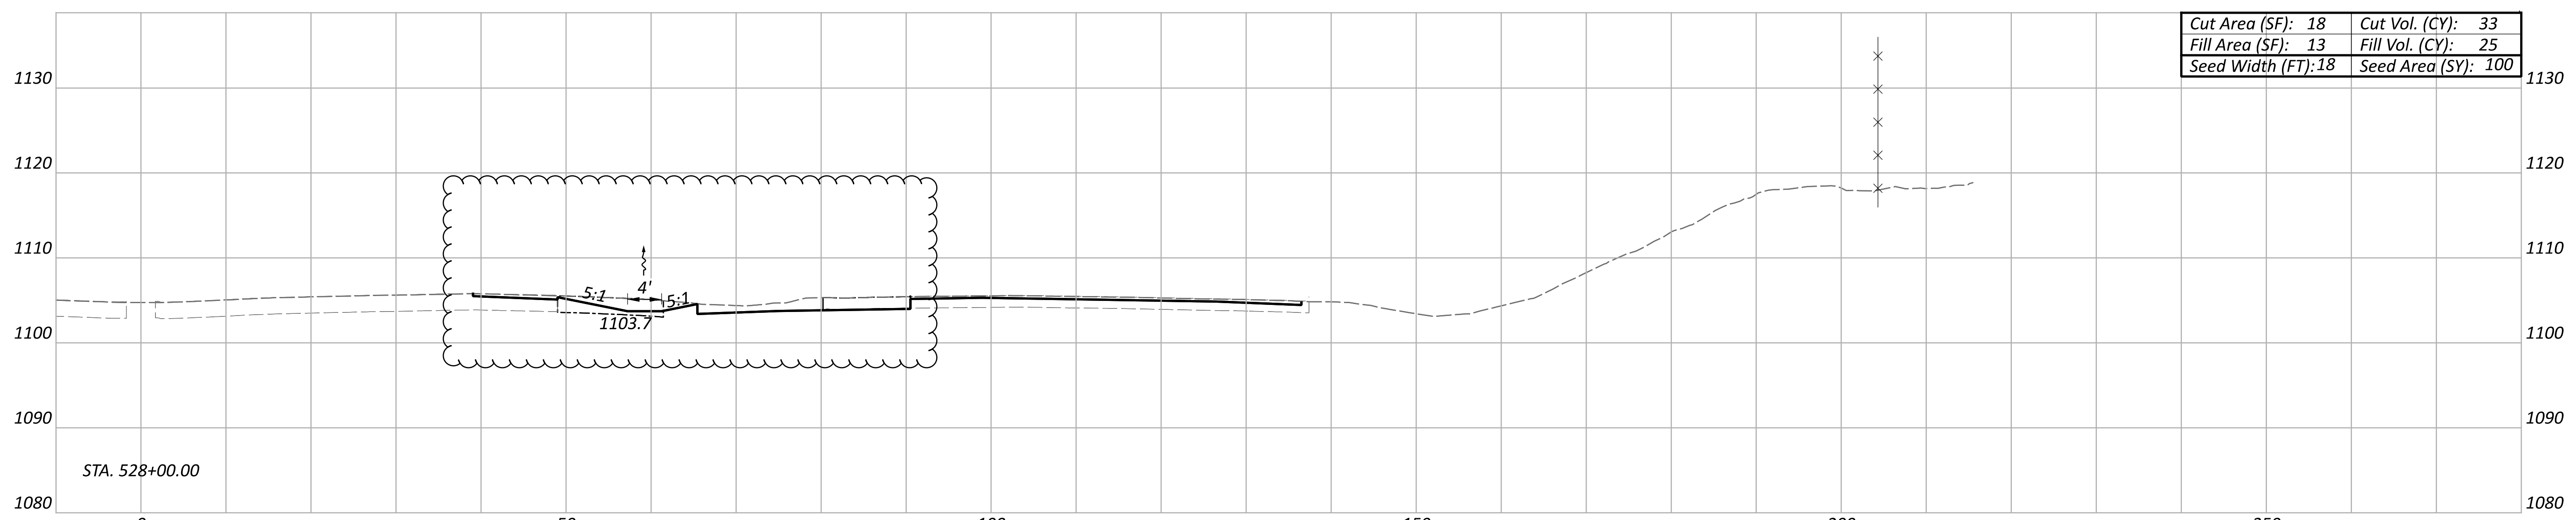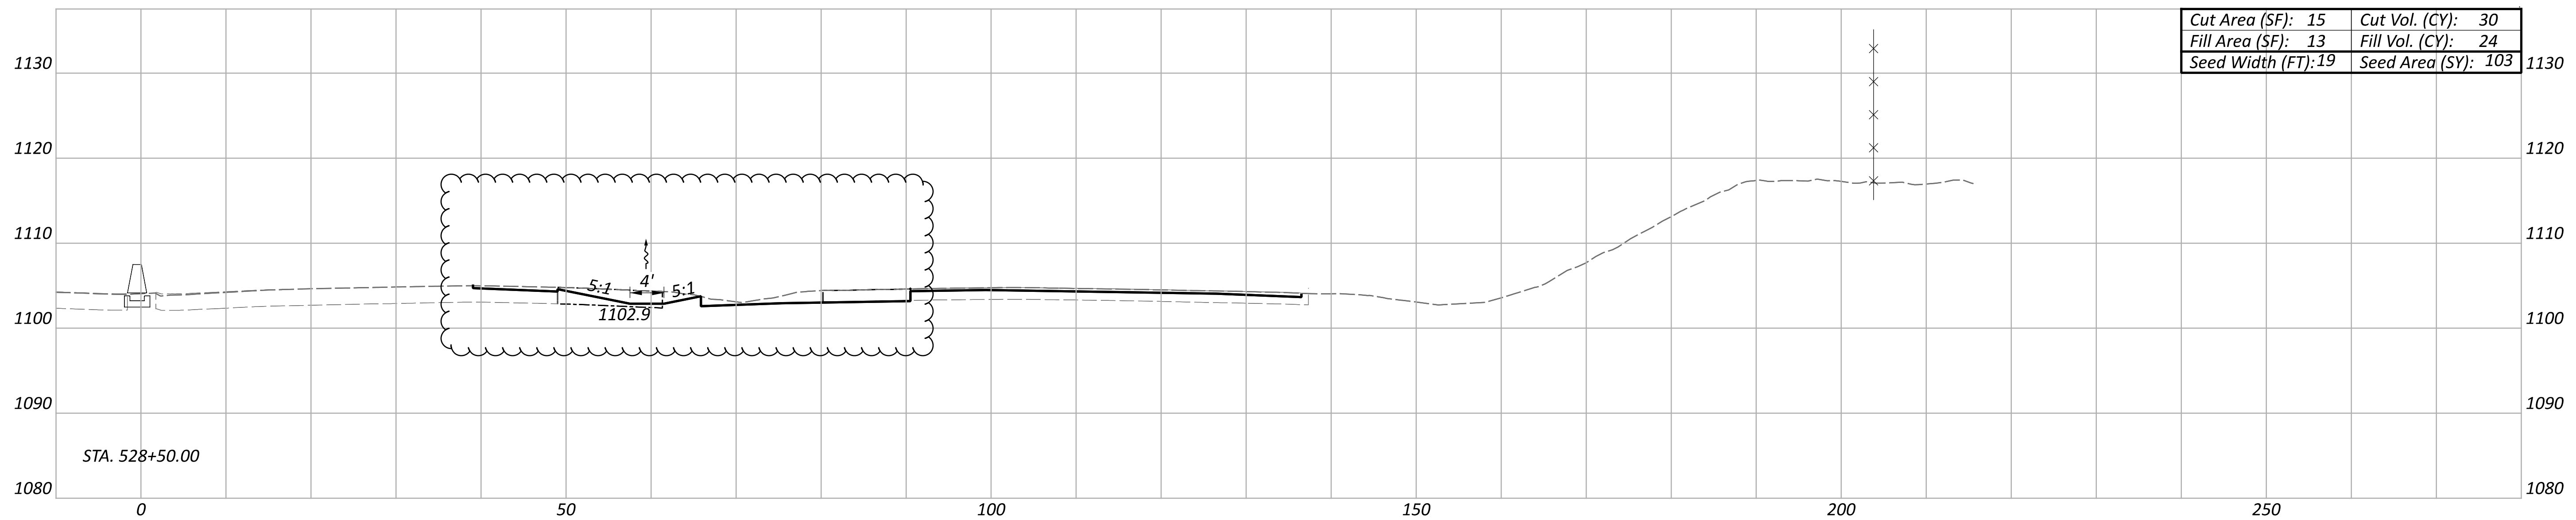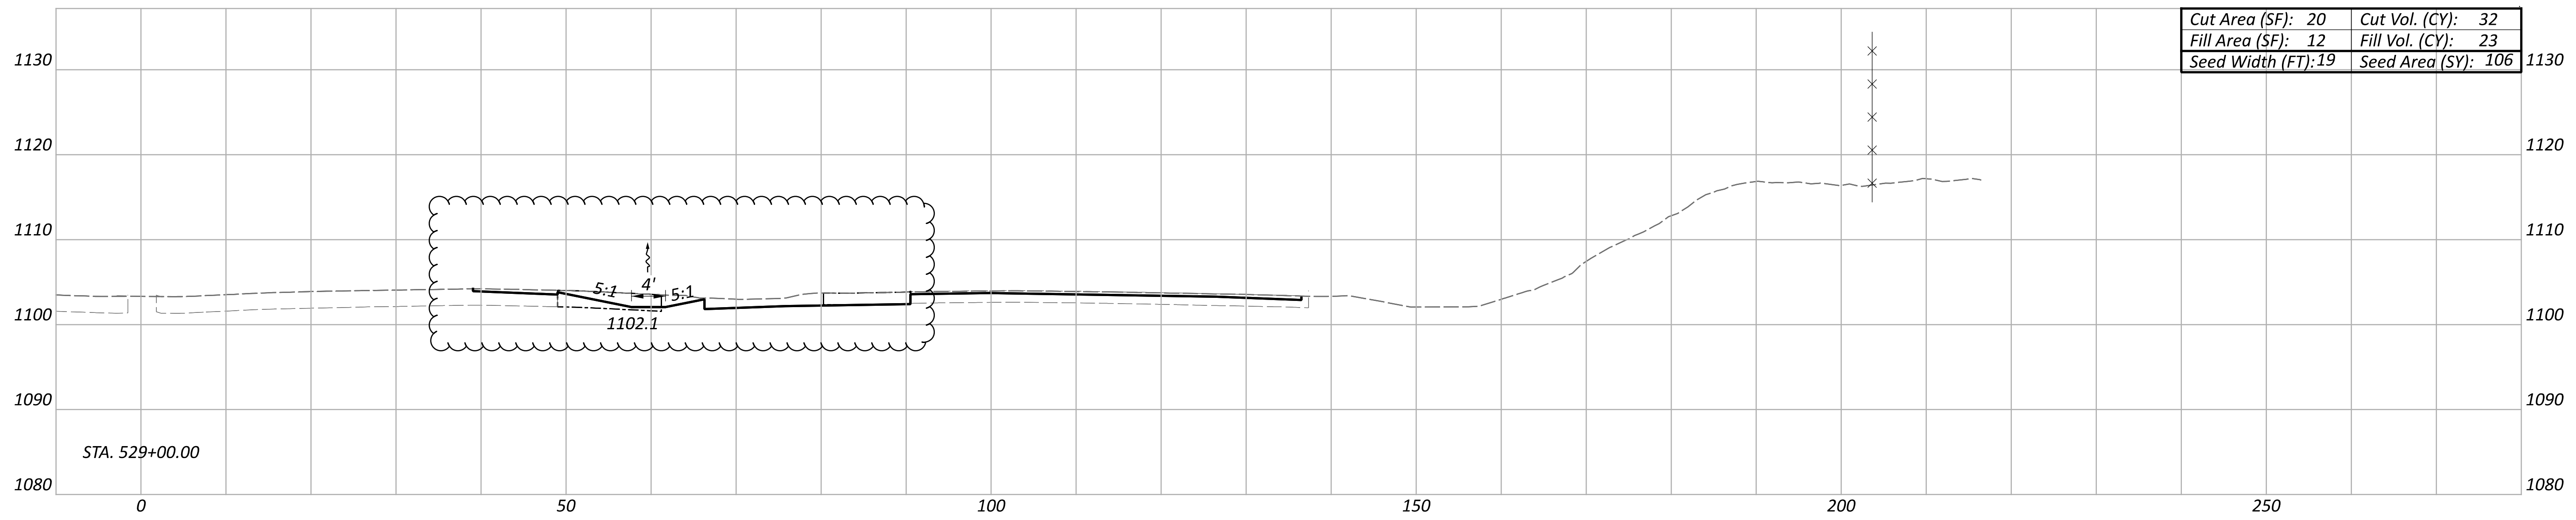

ITEM 202 - PAVEMENT REMOVED

CROSS SECTIONS
 STA. 528+00 TO STA. 528+50

DESIGN AGENCY






DESIGNER
 AS

REVIEWER
 KKP 12/31/22

PROJECT ID
 113156

Sheet Totals			113156	
Seeding	Cut	Fill	SHEET	TOTAL
203	64	49	116	233

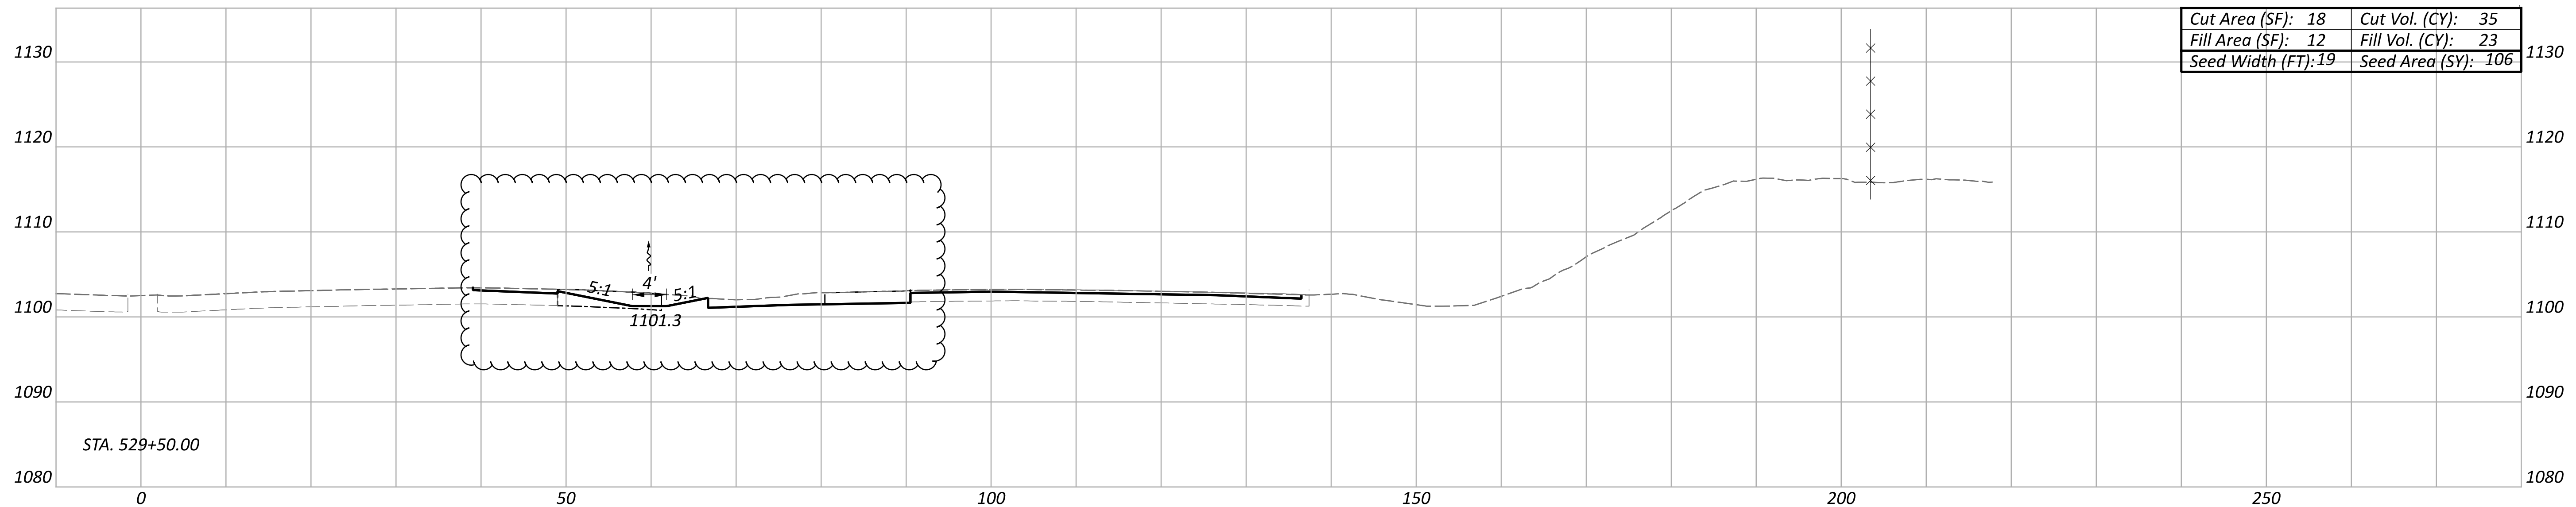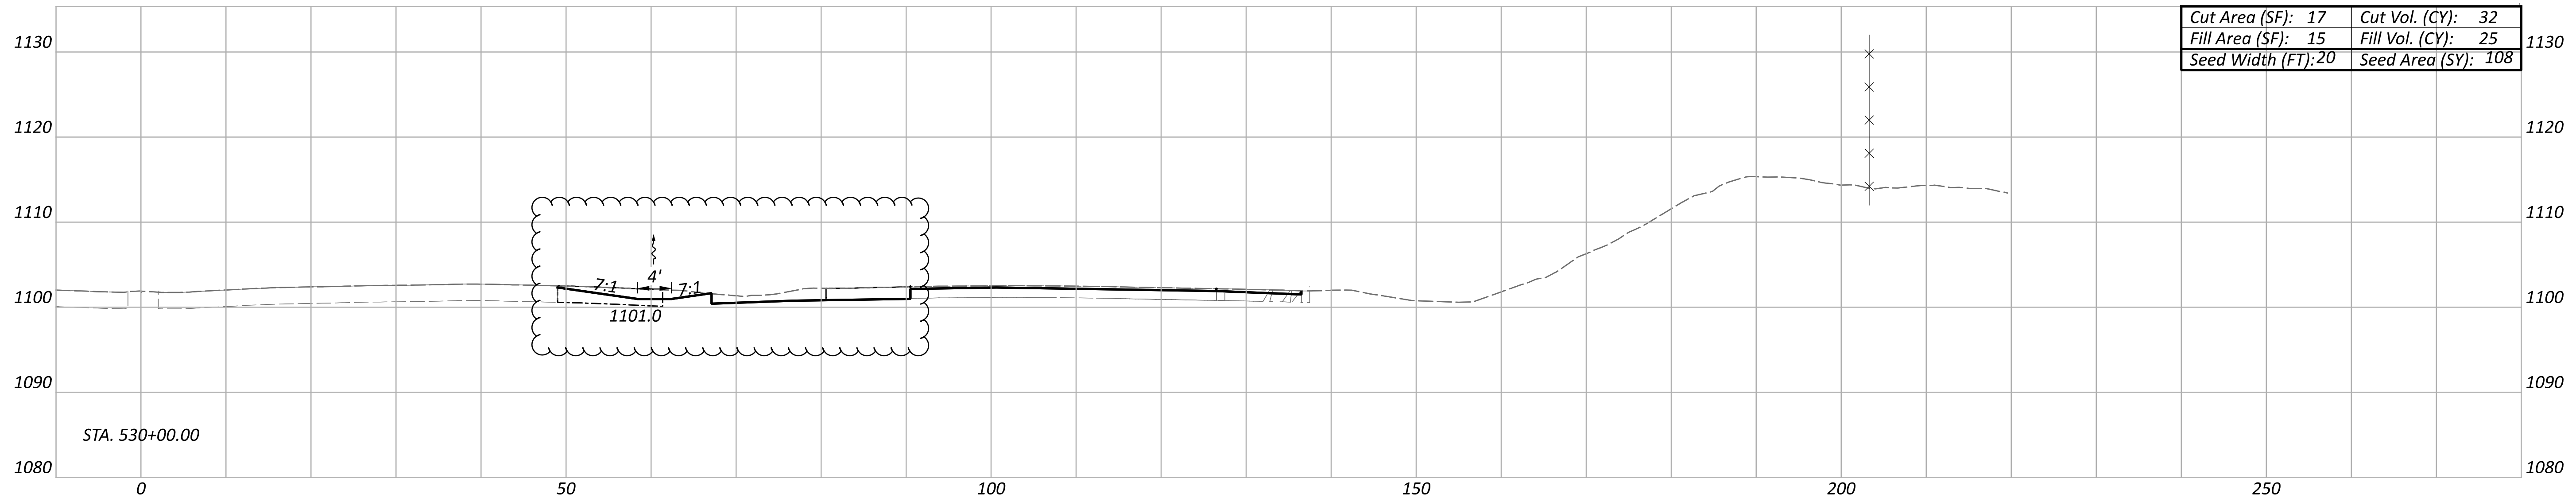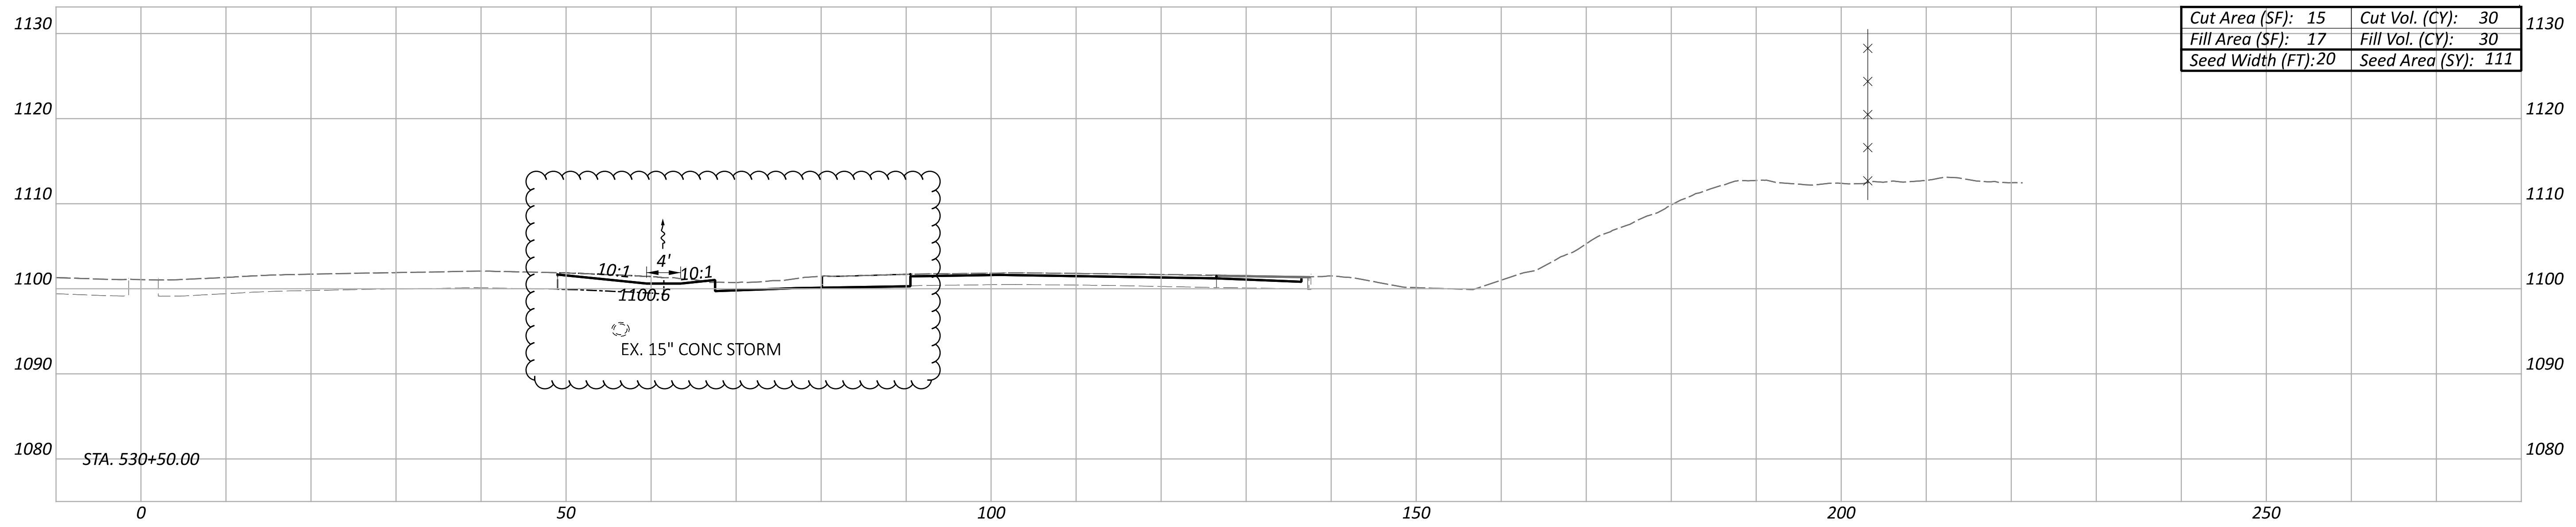

ITEM 202 - PAVEMENT REMOVED

CROSS SECTIONS
 STA. 529+50 TO STA. 530+50

DESIGN AGENCY






DESIGNER
 AS

REVIEWER
 KKP 12/31/22

PROJECT ID
 113156

Sheet Totals			SHEET TOTAL	
Seeding	Cut	Fill	117	233
325	97	78		

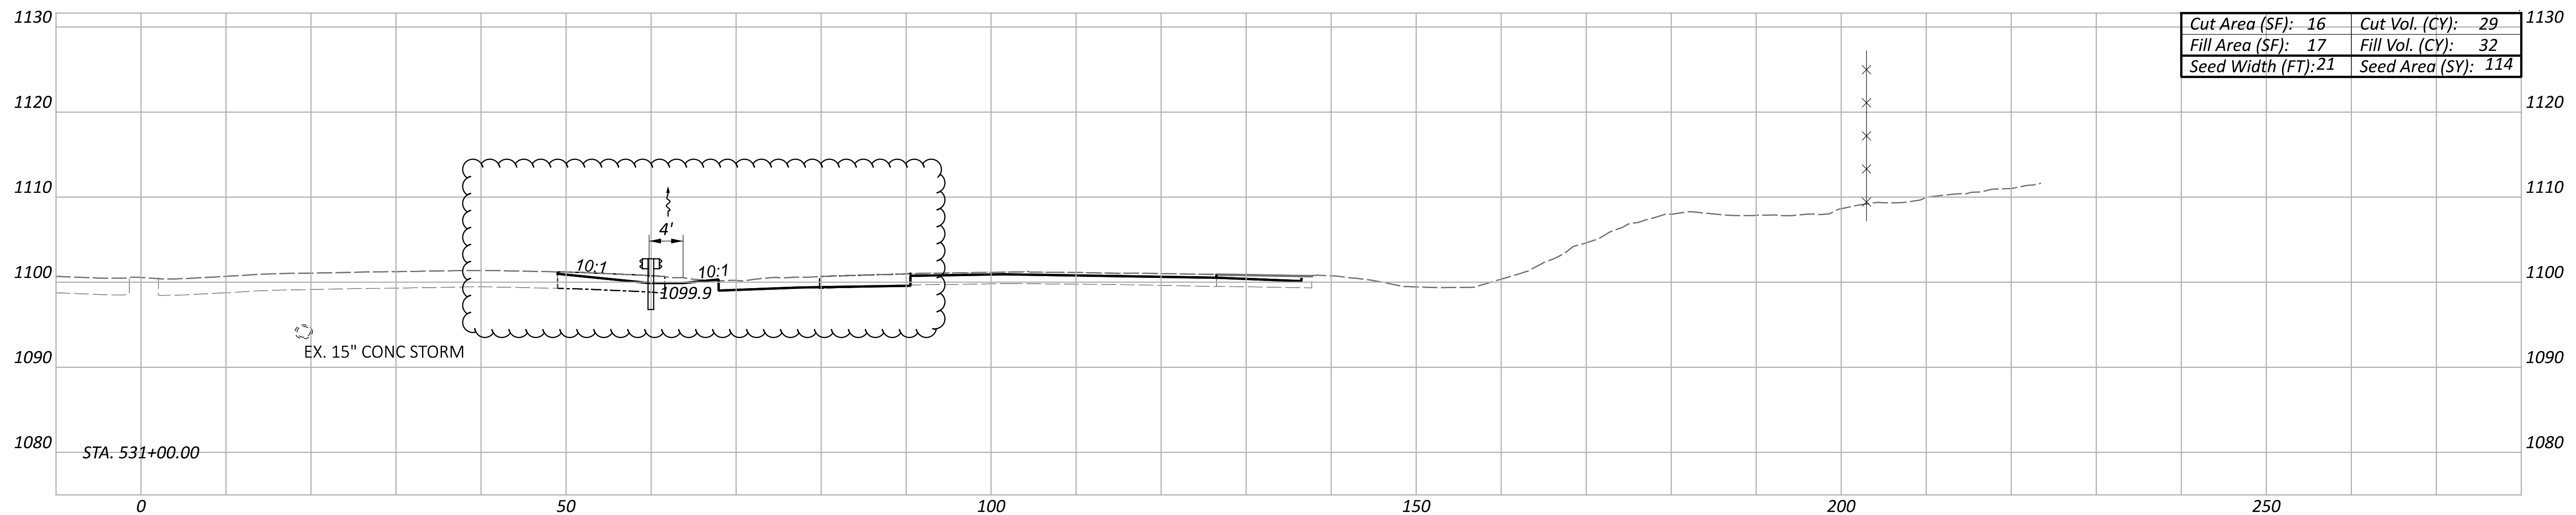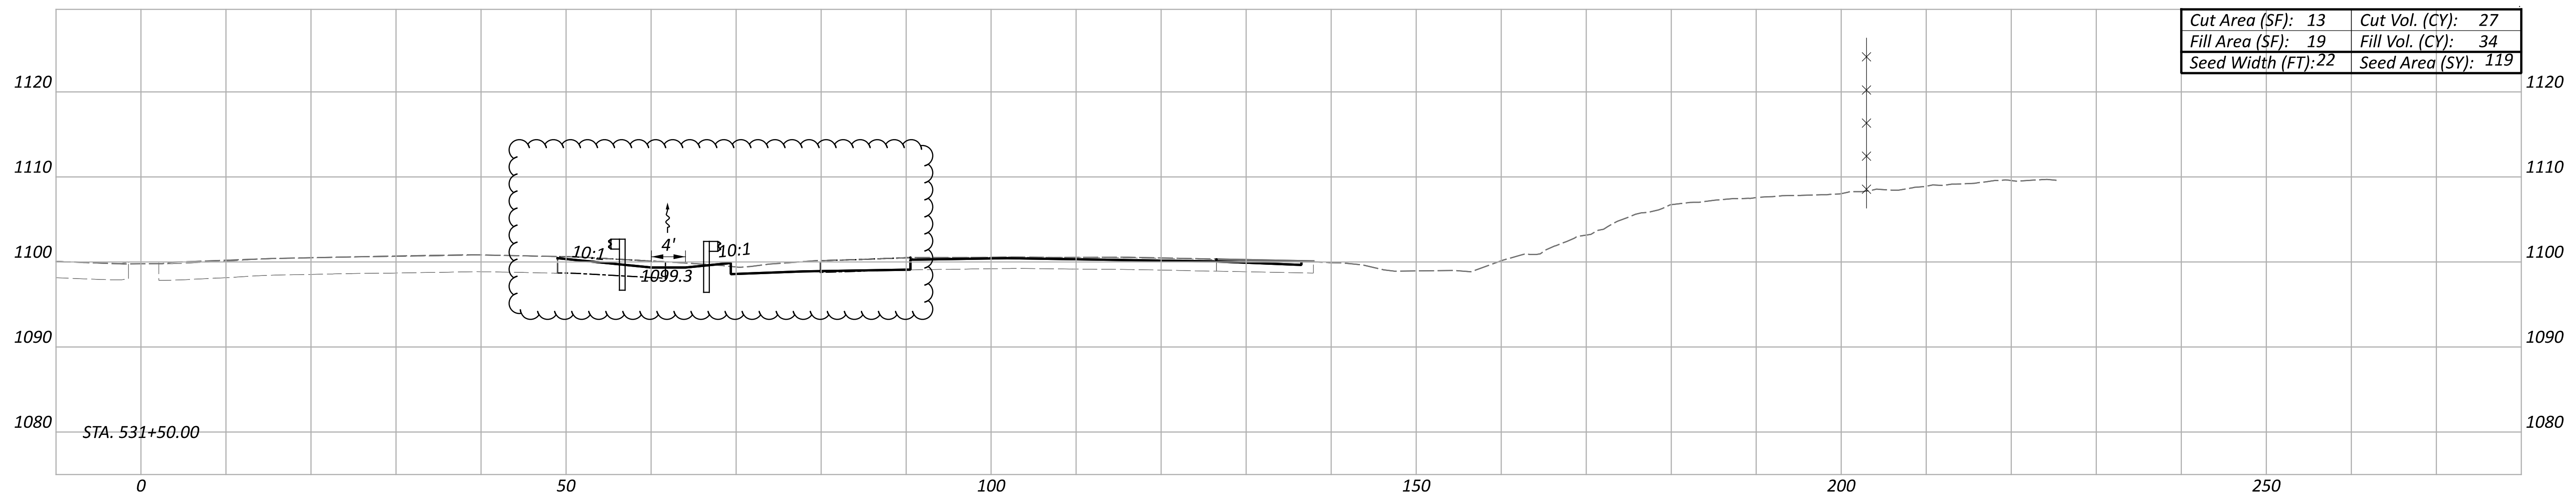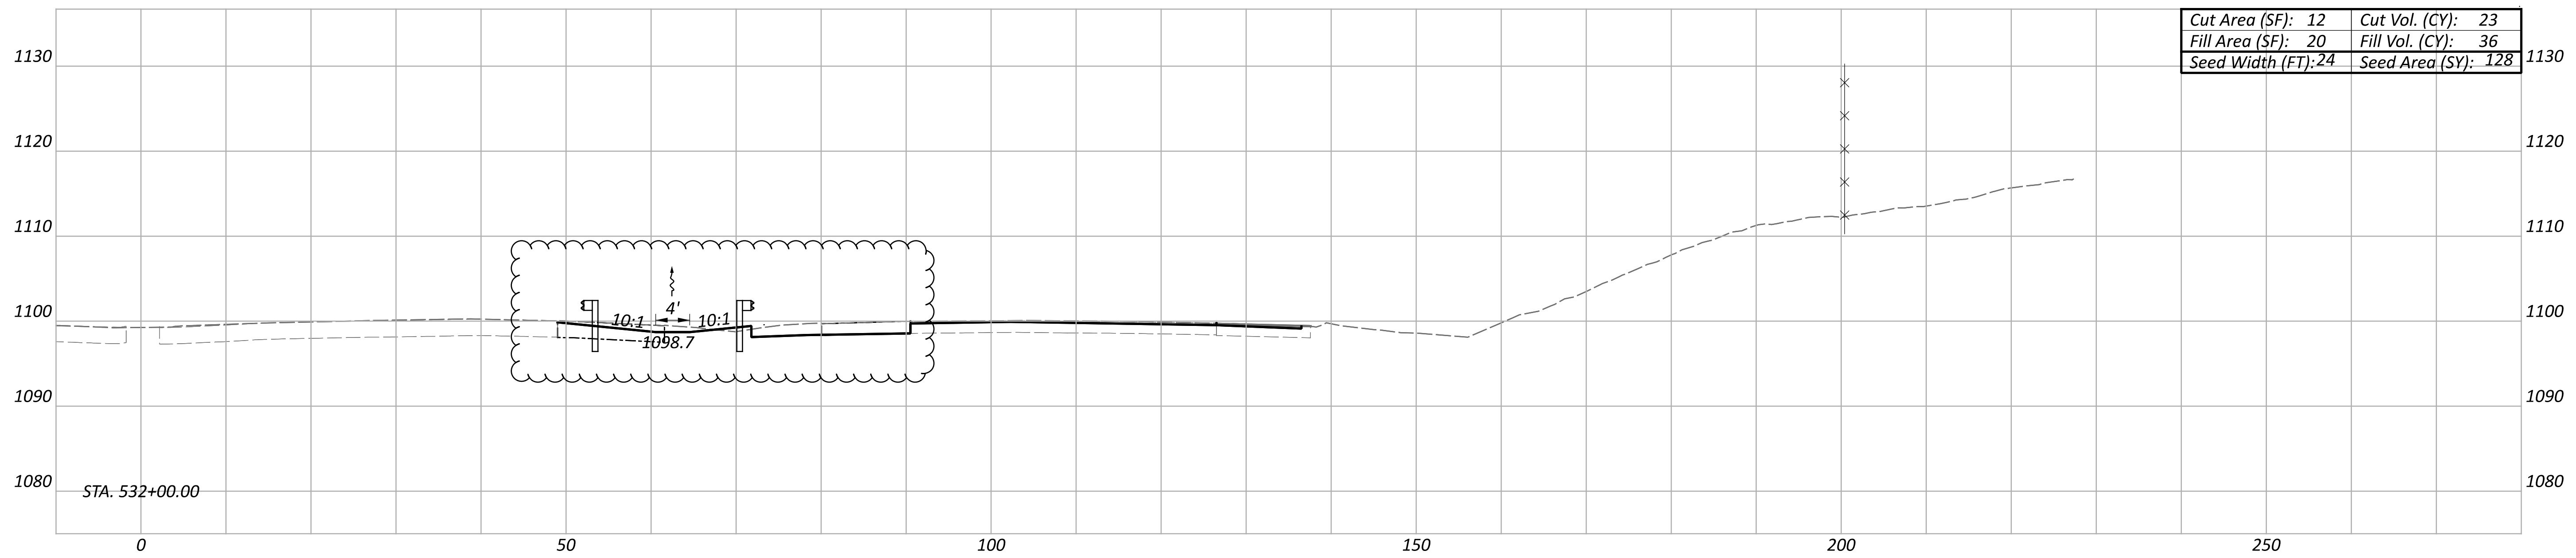

ITEM 202 - PAVEMENT REMOVED

CROSS SECTIONS
 STA. 531+00 TO STA. 531+50

DESIGN AGENCY



DESIGNER

AS

REVIEWER

KKP 12/31/22



PROJECT ID

113156

Sheet Totals

Seeding	Cut	Fill
233	56	66

SHEET	TOTAL
118	233

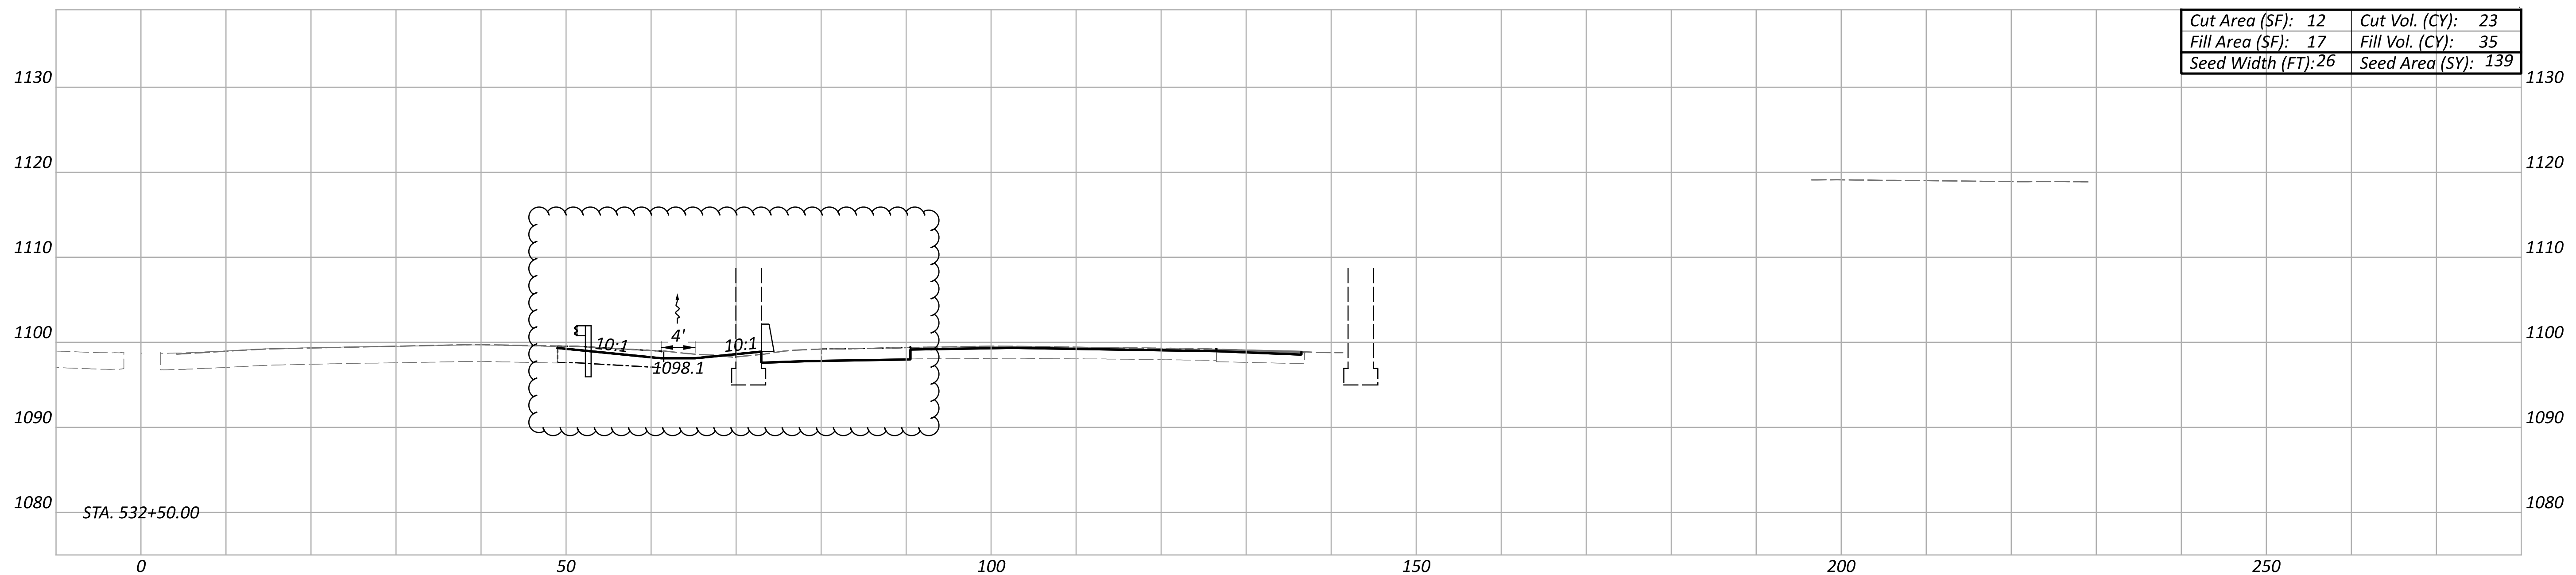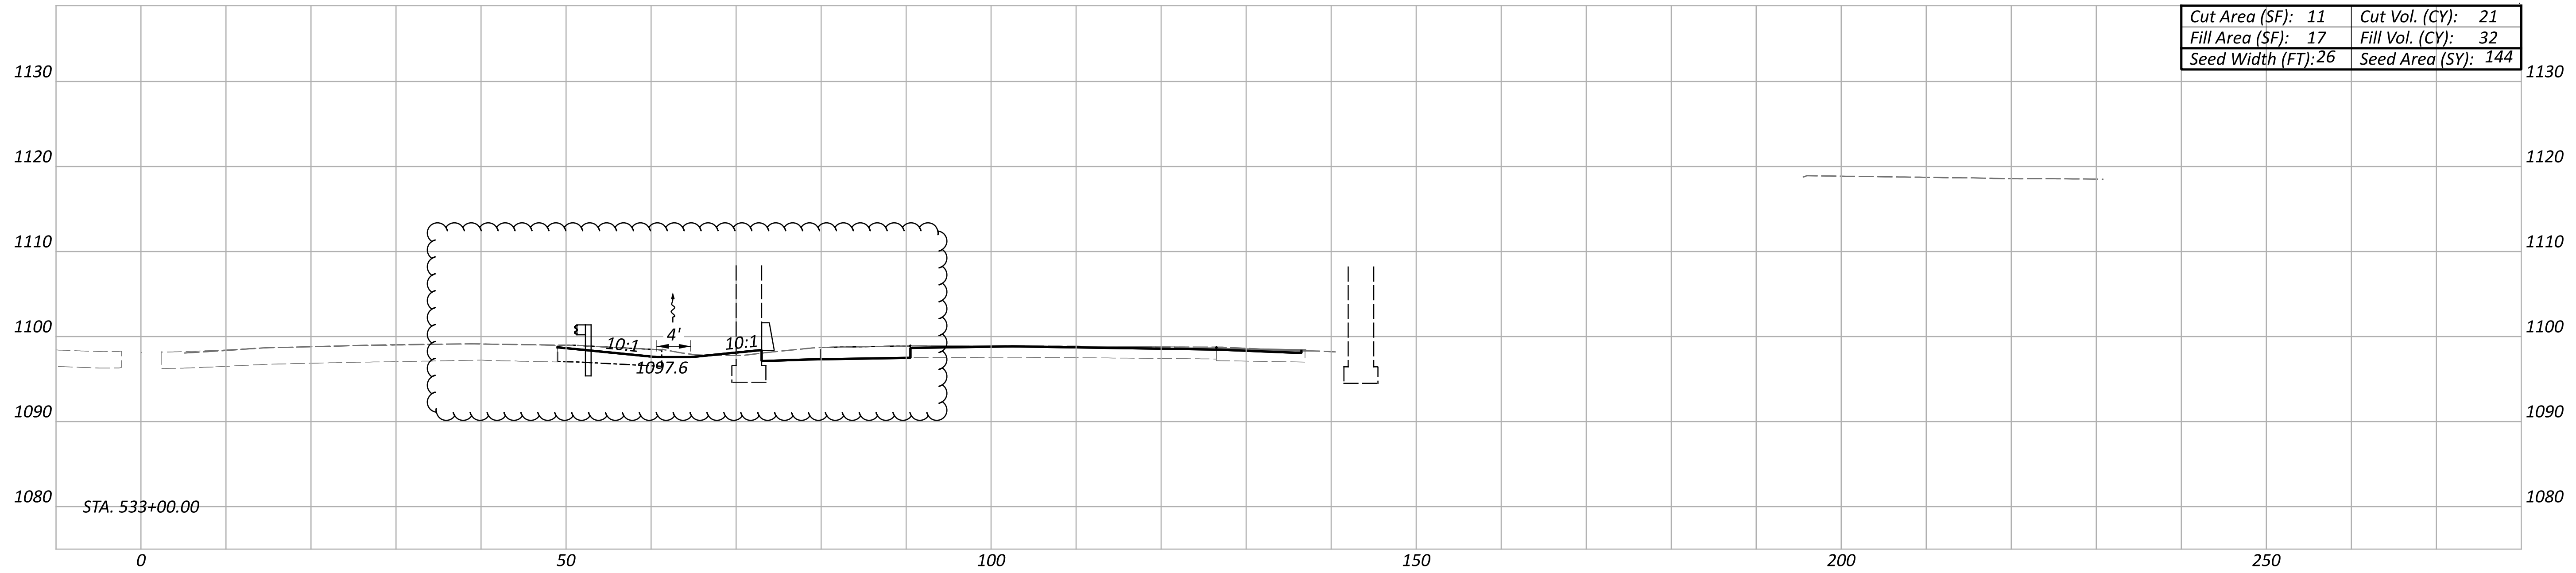

ITEM 202 - PAVEMENT REMOVED

CROSS SECTIONS
 STA. 532+50 TO STA. 533+00

DESIGN AGENCY






DESIGNER
 AS

REVIEWER
 KKP 12/31/22

PROJECT ID
 113156

Sheet Totals			SHEET TOTAL	
Seeding	Cut	Fill	119	233
277	44	66		

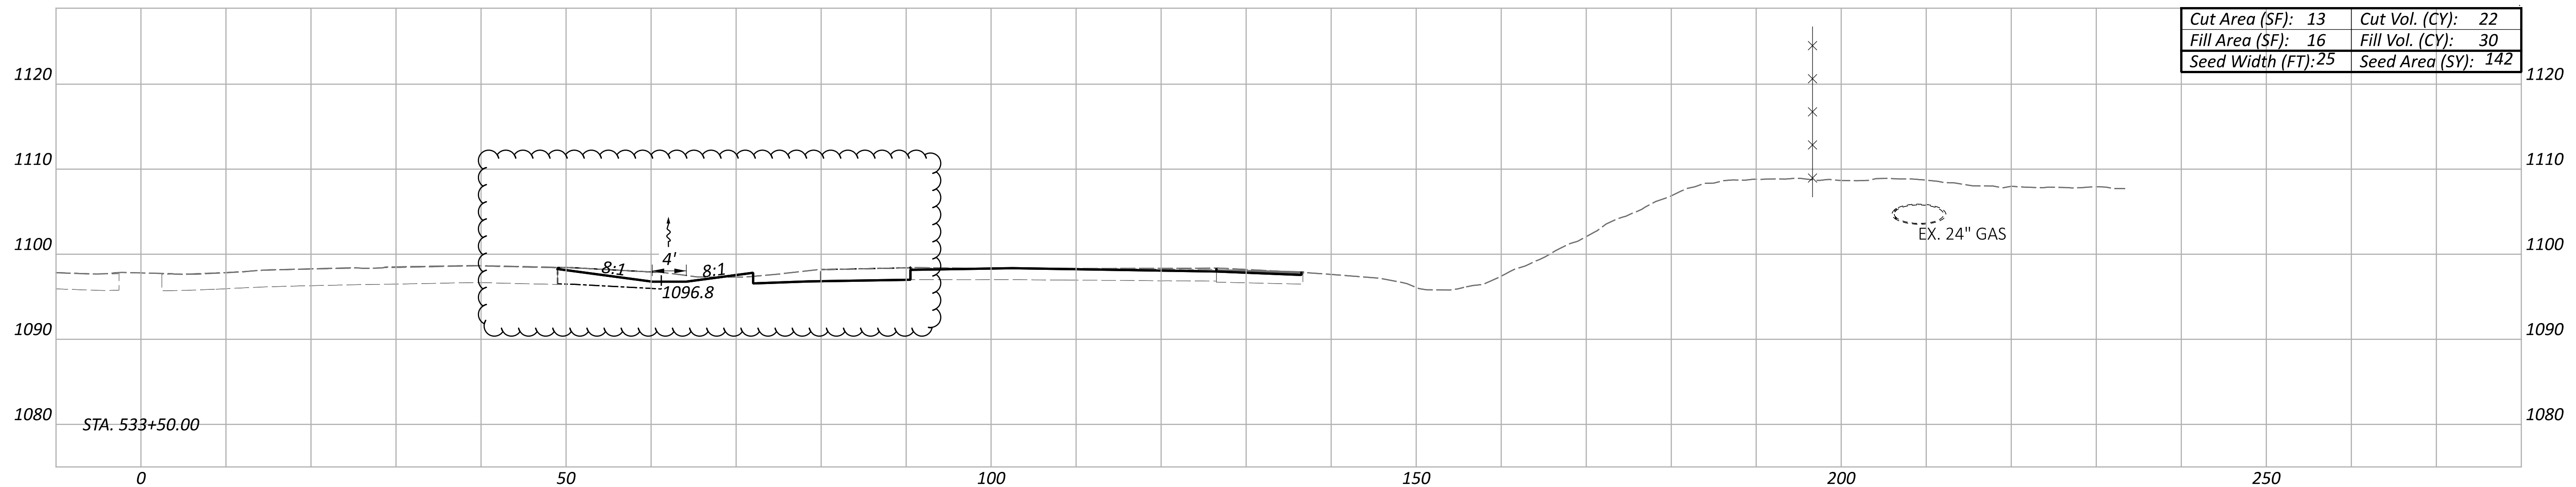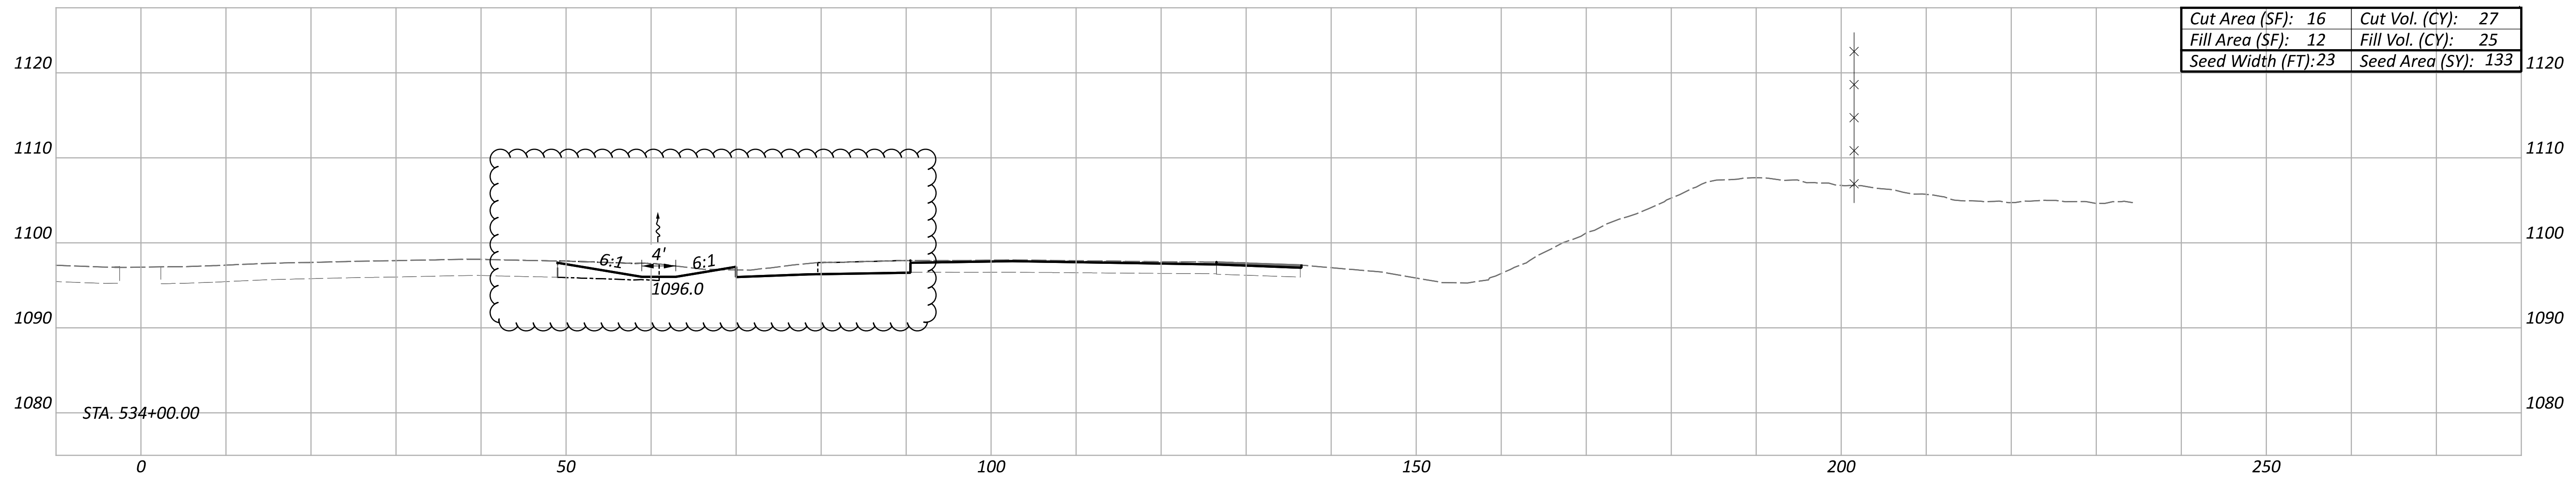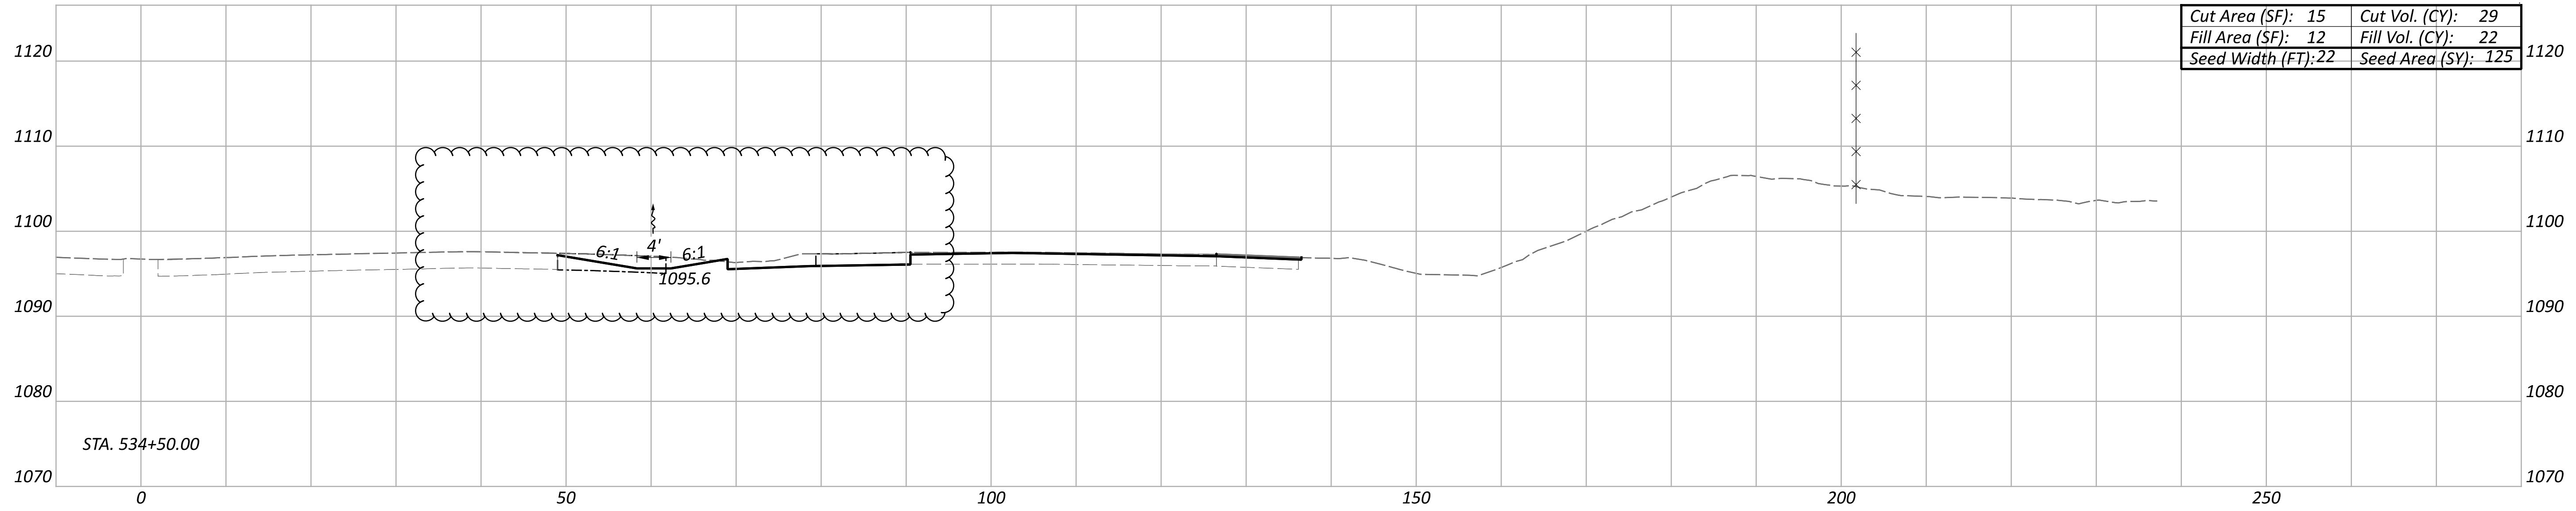

ITEM 202 - PAVEMENT REMOVED

CROSS SECTIONS
 STA. 533+50 TO STA. 534+50

DESIGN AGENCY






DESIGNER
 AS

REVIEWER
 KKP 12/31/22

PROJECT ID
 113156

Sheet Totals			SHEET TOTAL	
Seeding	Cut	Fill	120	233
397	78	77		

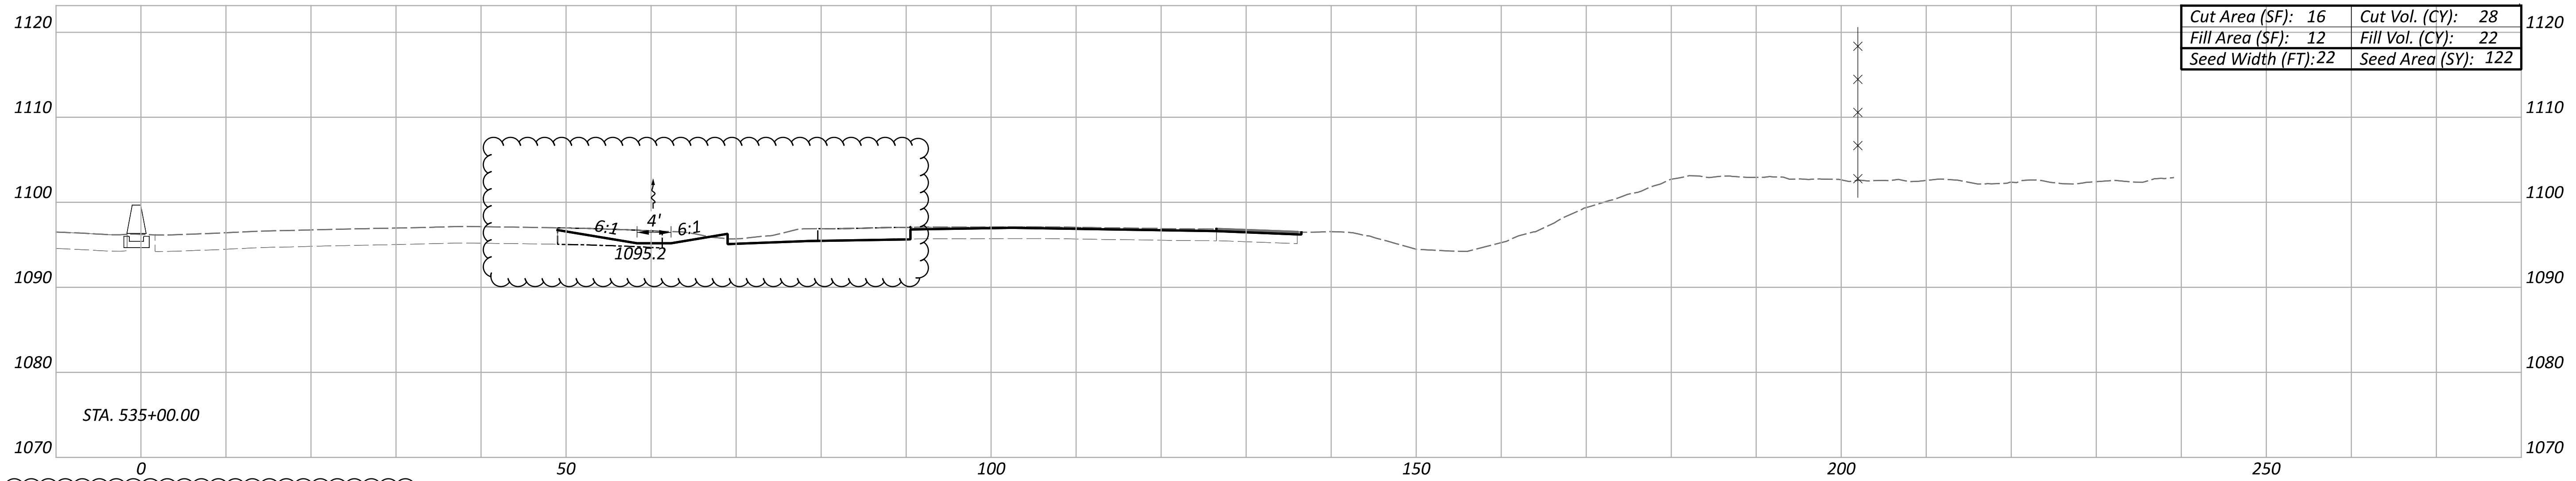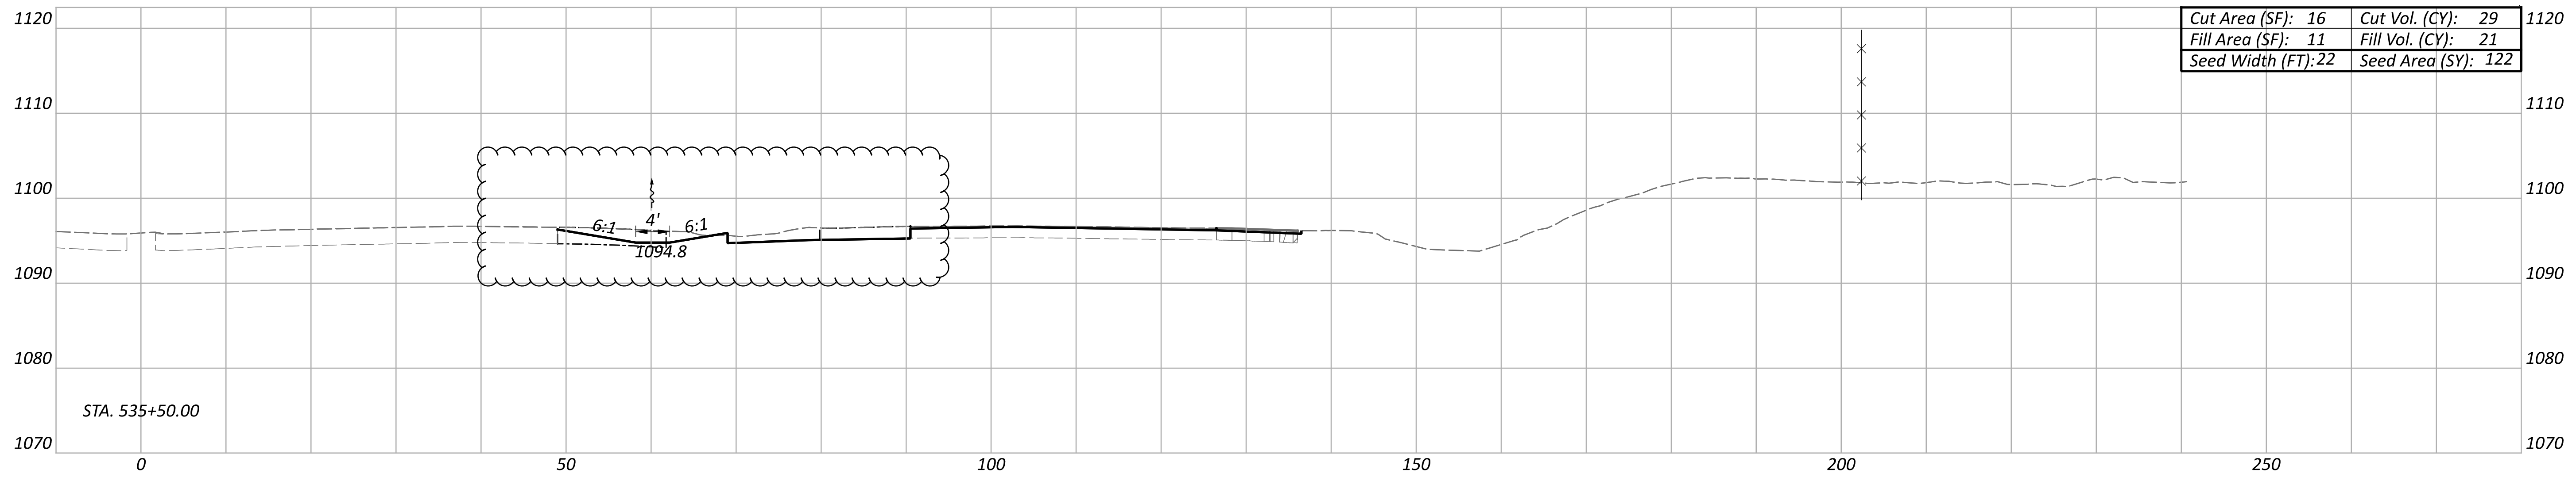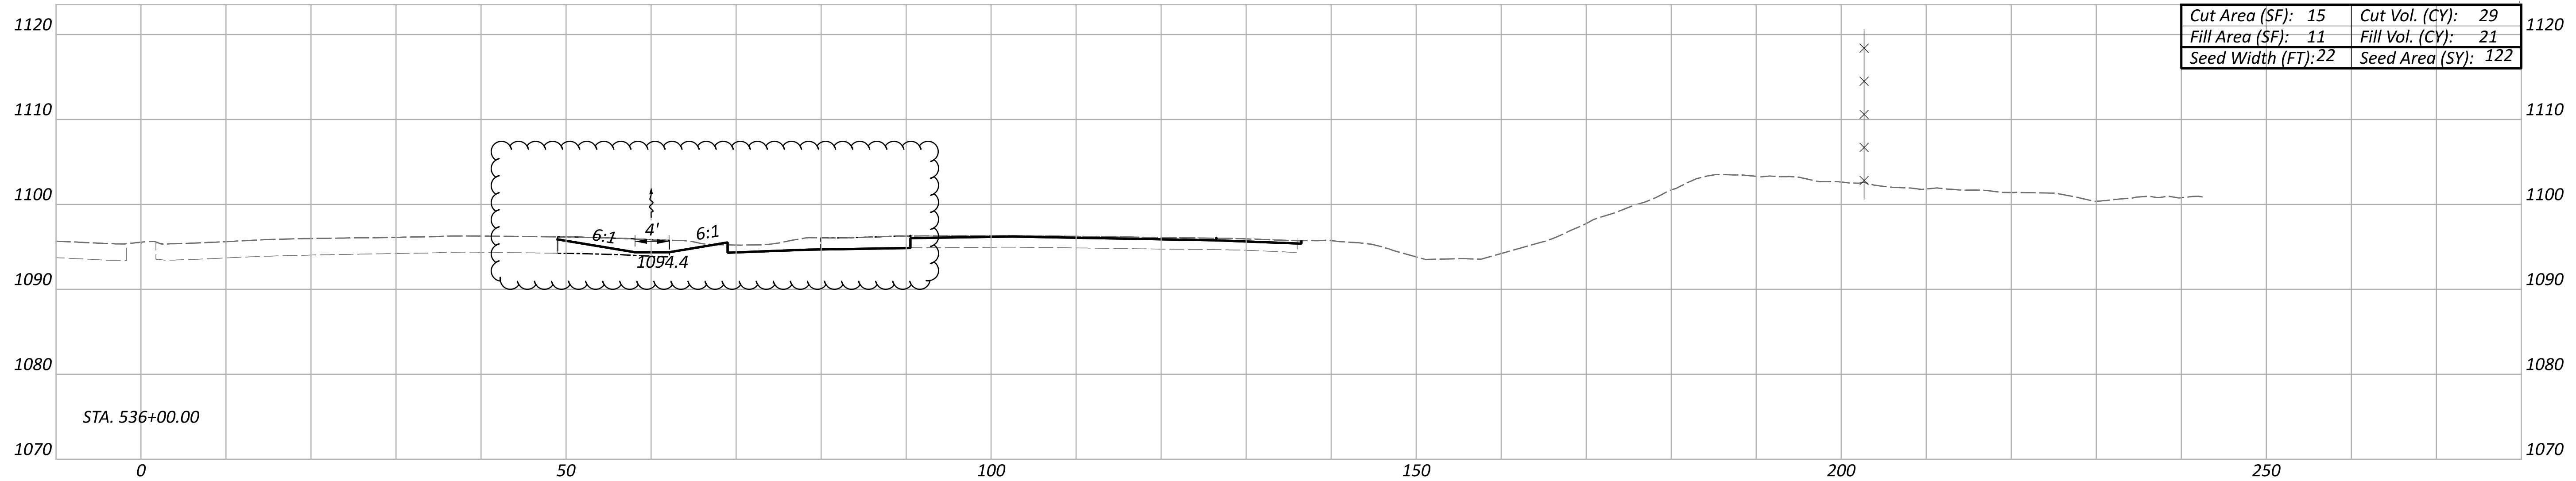

ITEM 202 - PAVEMENT REMOVED

CROSS SECTIONS
 STA. 535+00 TO STA. 536+00

DESIGN AGENCY






DESIGNER
 AS

REVIEWER
 KKP 12/31/22

PROJECT ID
 113156

Sheet Totals			SHEET TOTAL	
Seeding	Cut	Fill	121	233
366	86	64		

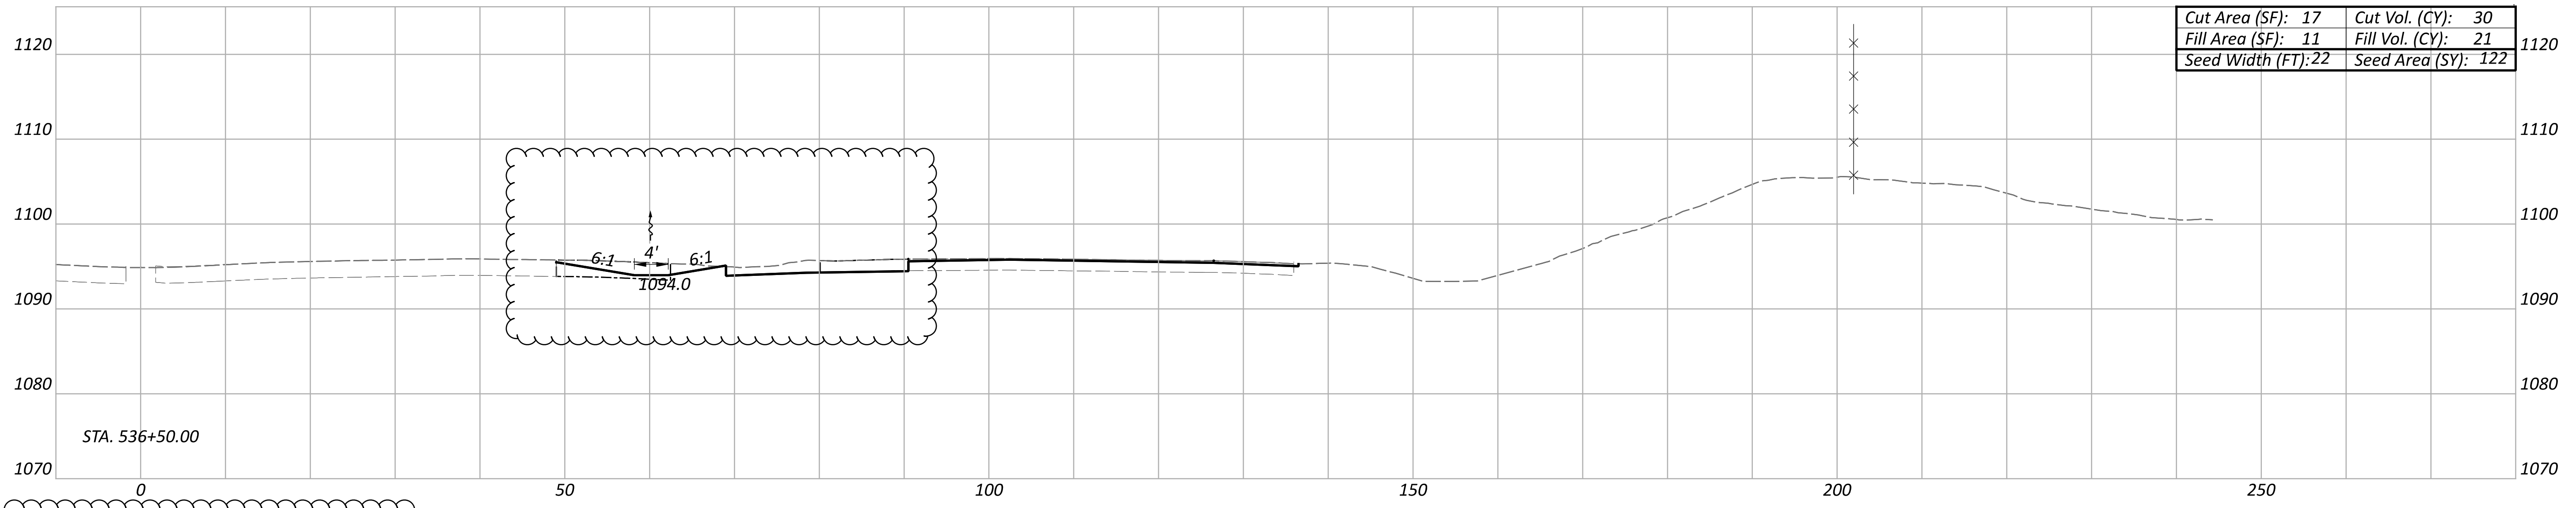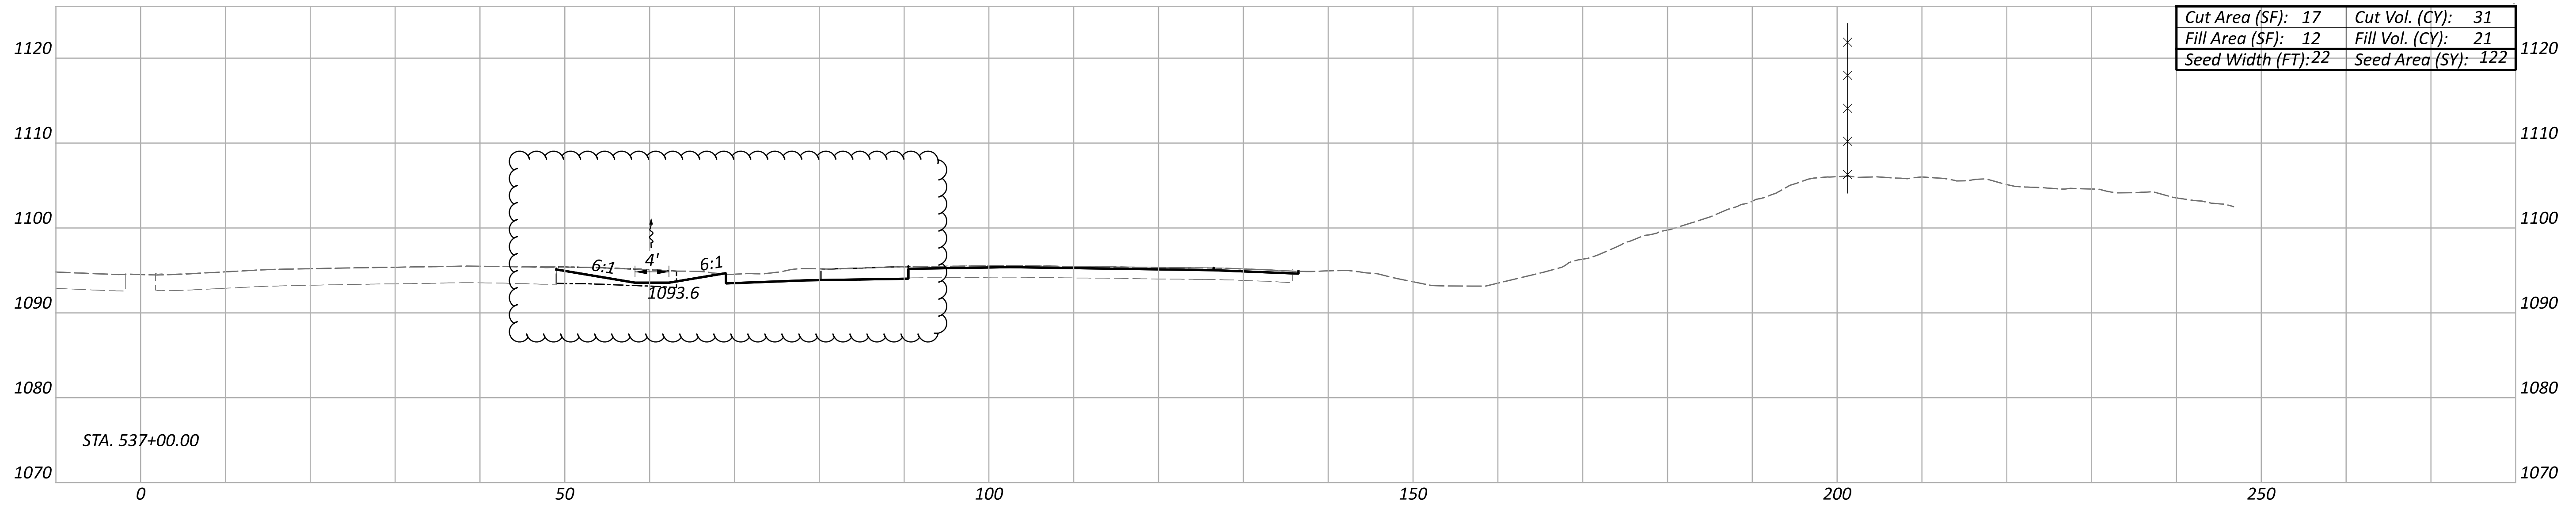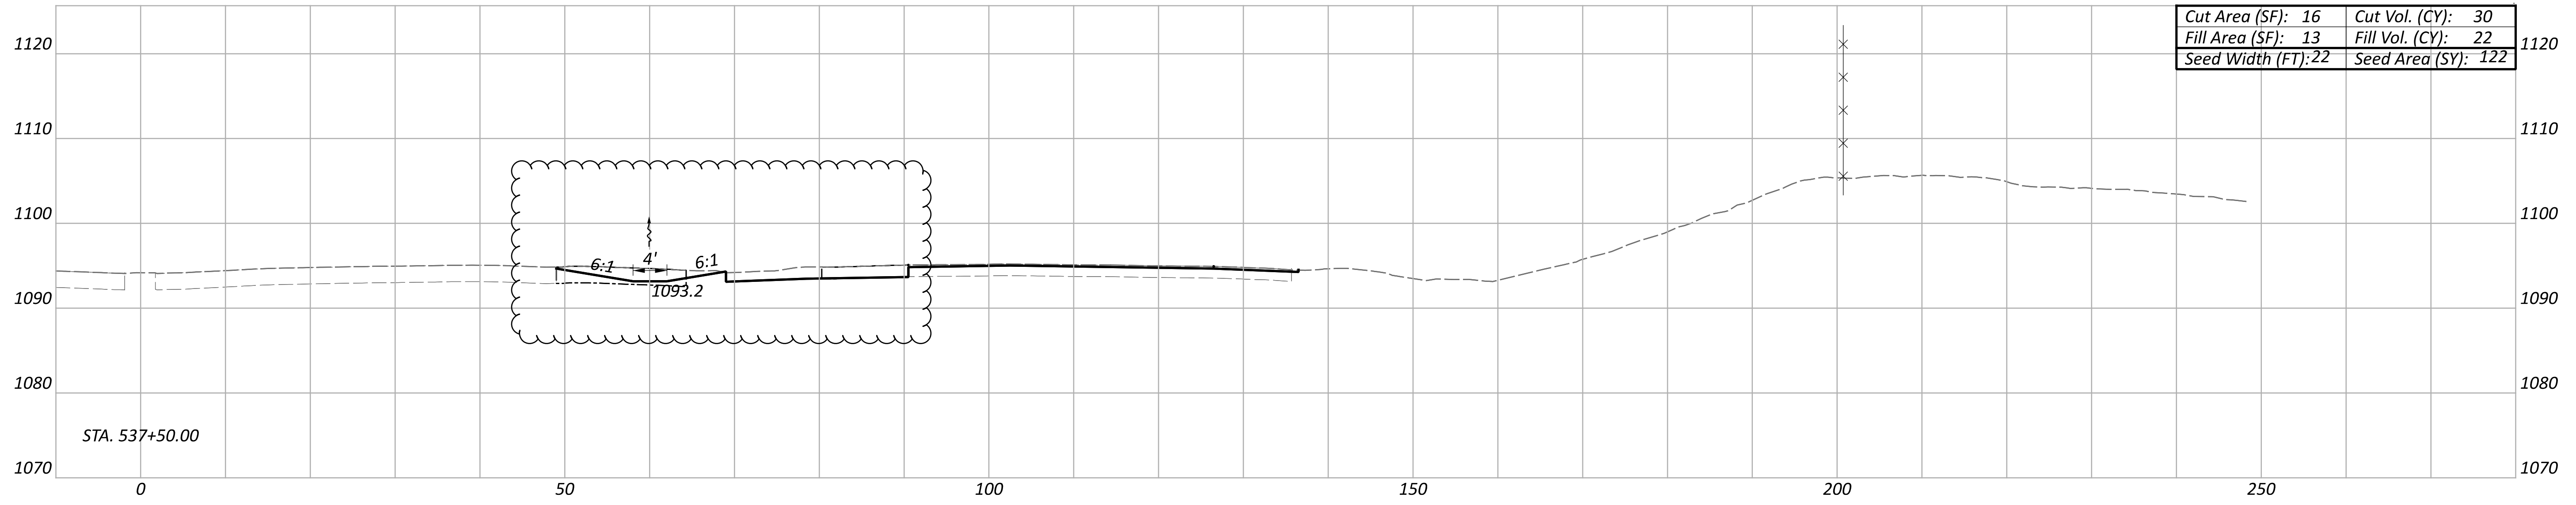

ITEM 202 - PAVEMENT REMOVED

CROSS SECTIONS
 STA. 536+50 TO STA. 537+50

DESIGN AGENCY






DESIGNER
 AS

REVIEWER
 KKP 12/31/22

PROJECT ID
 113156

Sheet Totals			SHEET	TOTAL
Seeding	Cut	Fill	122	233
366	90	65		

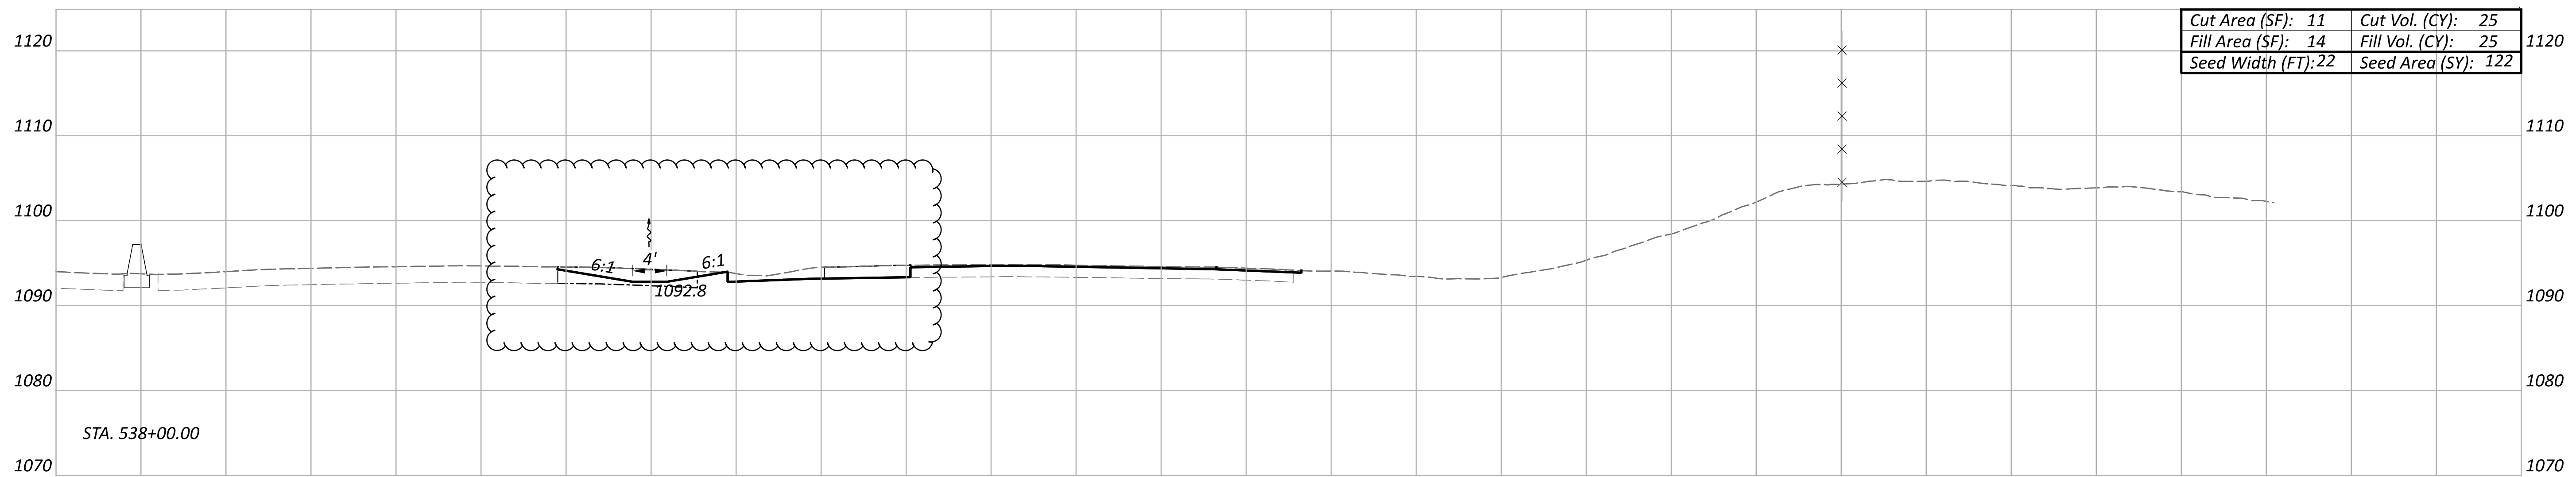
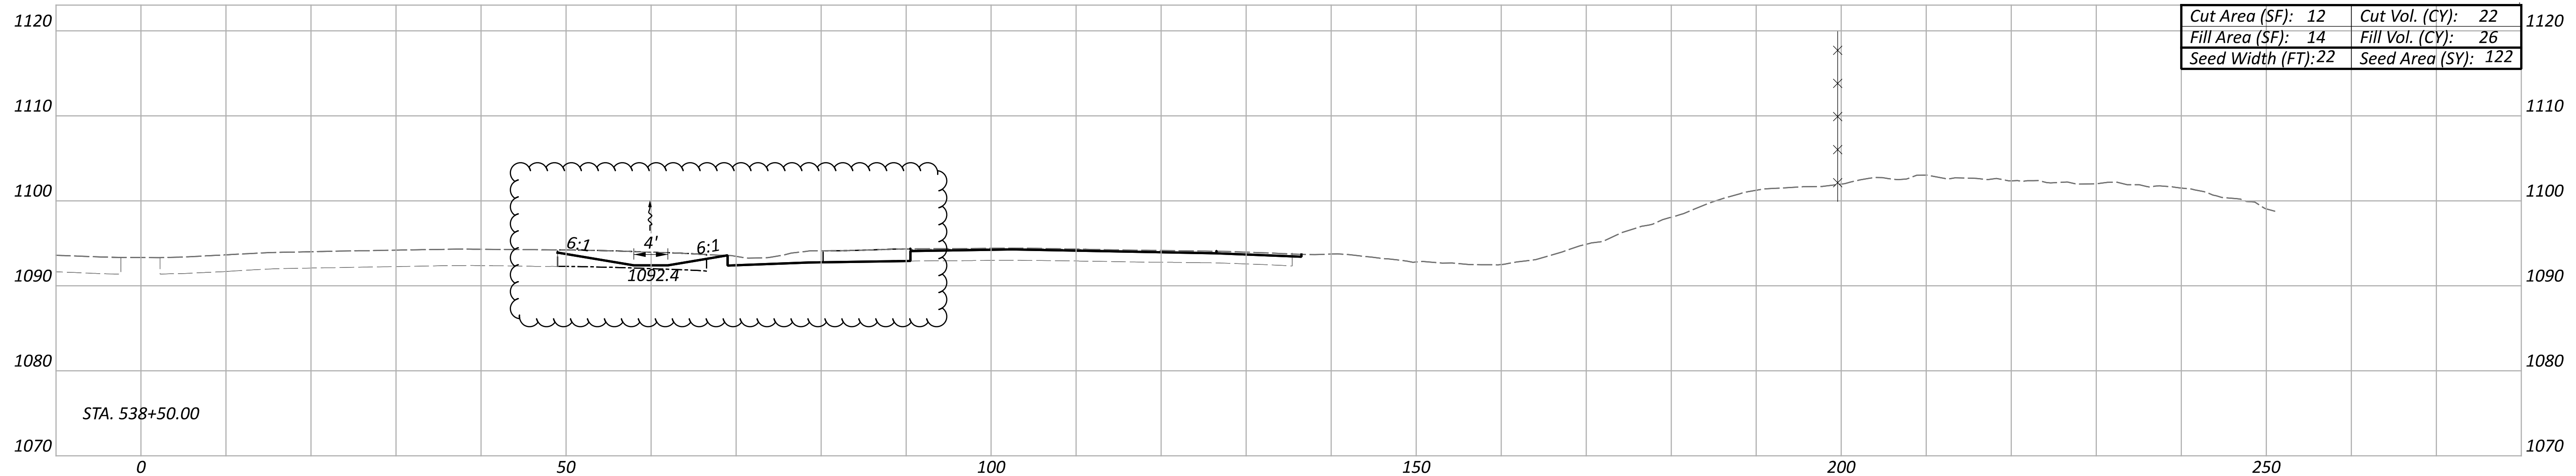
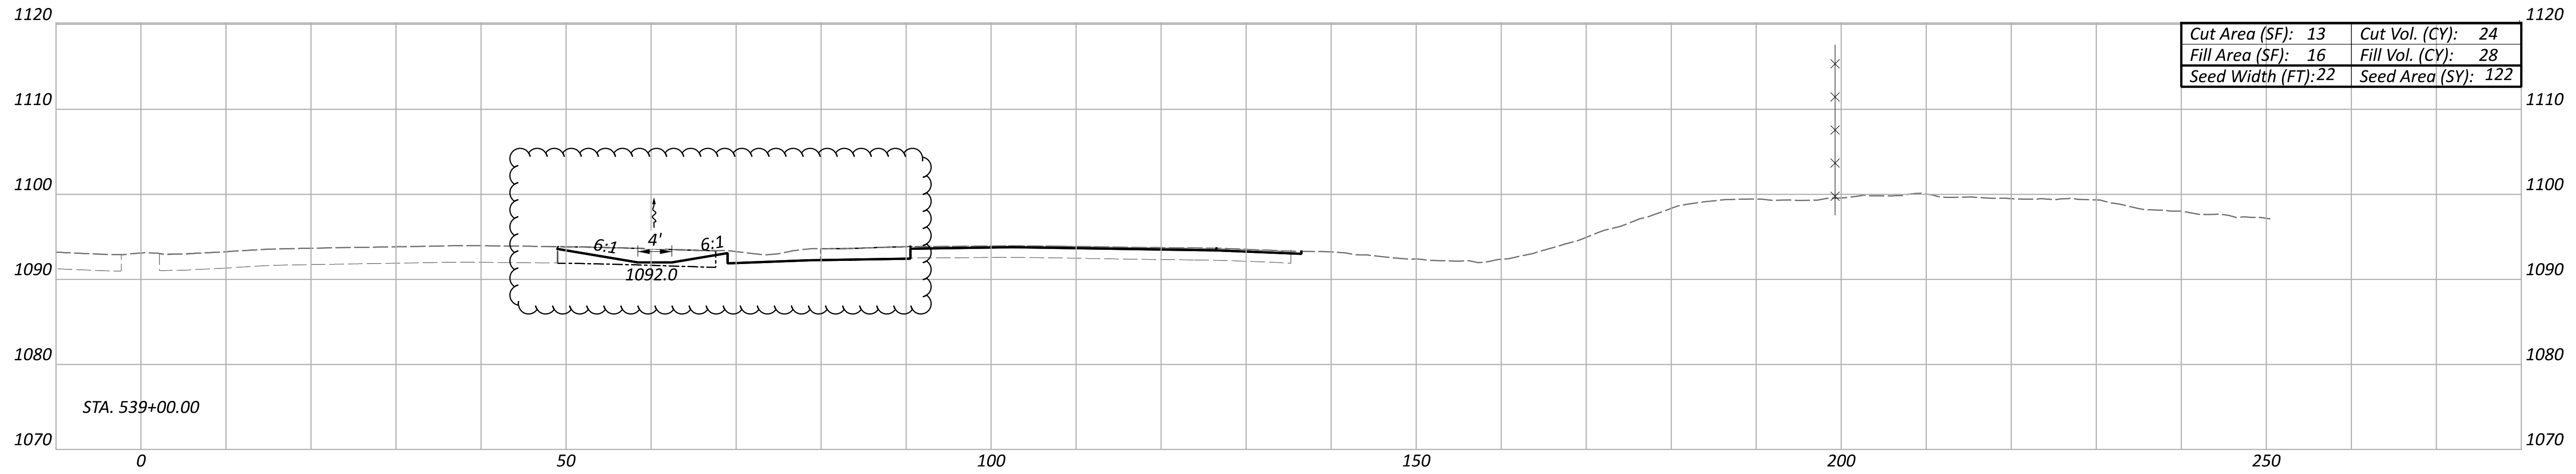


ITEM 202 - PAVEMENT REMOVED

CROSS SECTIONS
 STA. 538+00 TO STA. 539+00

DESIGN AGENCY
HNTB
 DESIGNER
 AS
 REVIEWER
 KKP 12/31/22
 PROJECT ID
 113156

Sheet Totals			SHEET TOTAL	
Seeding	Cut	Fill	123	233
366	71	79		

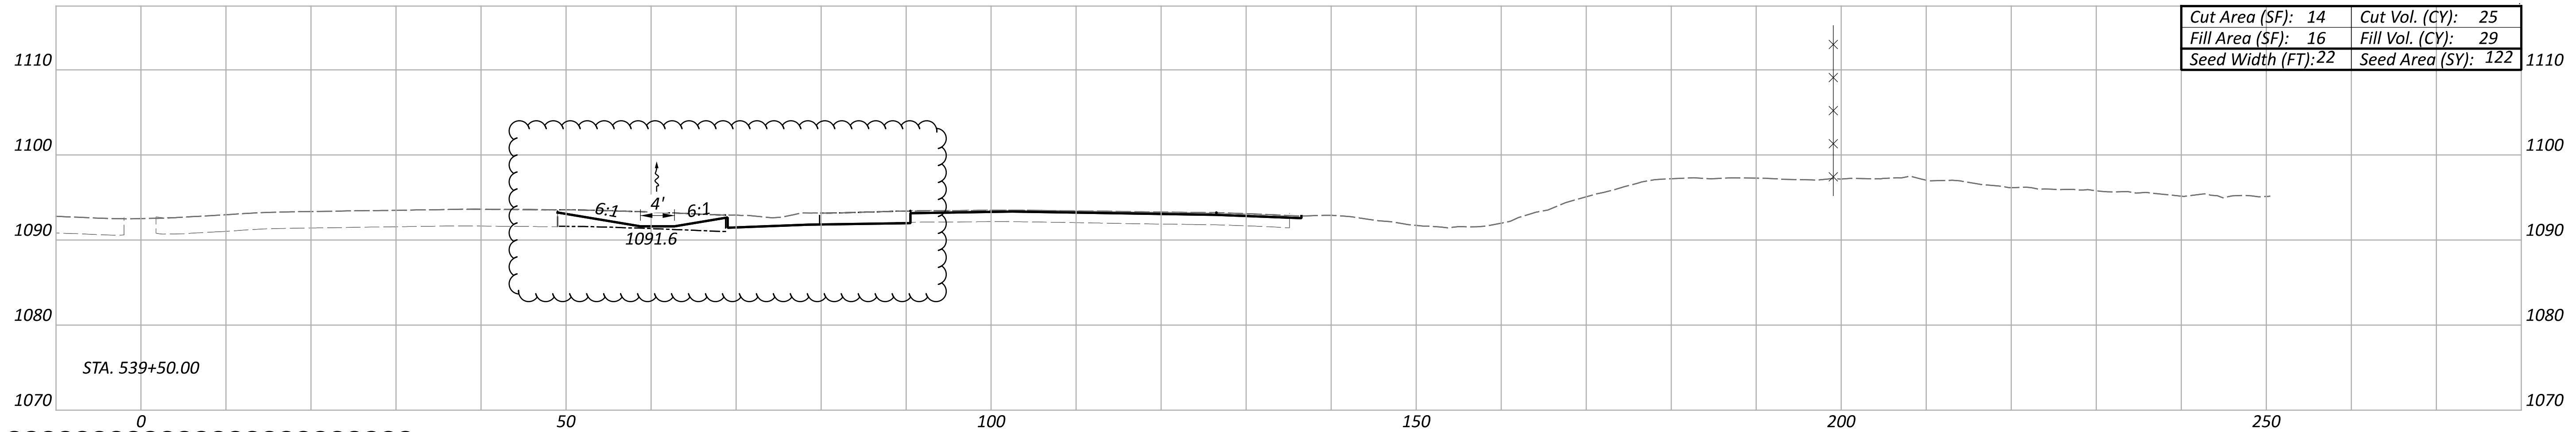
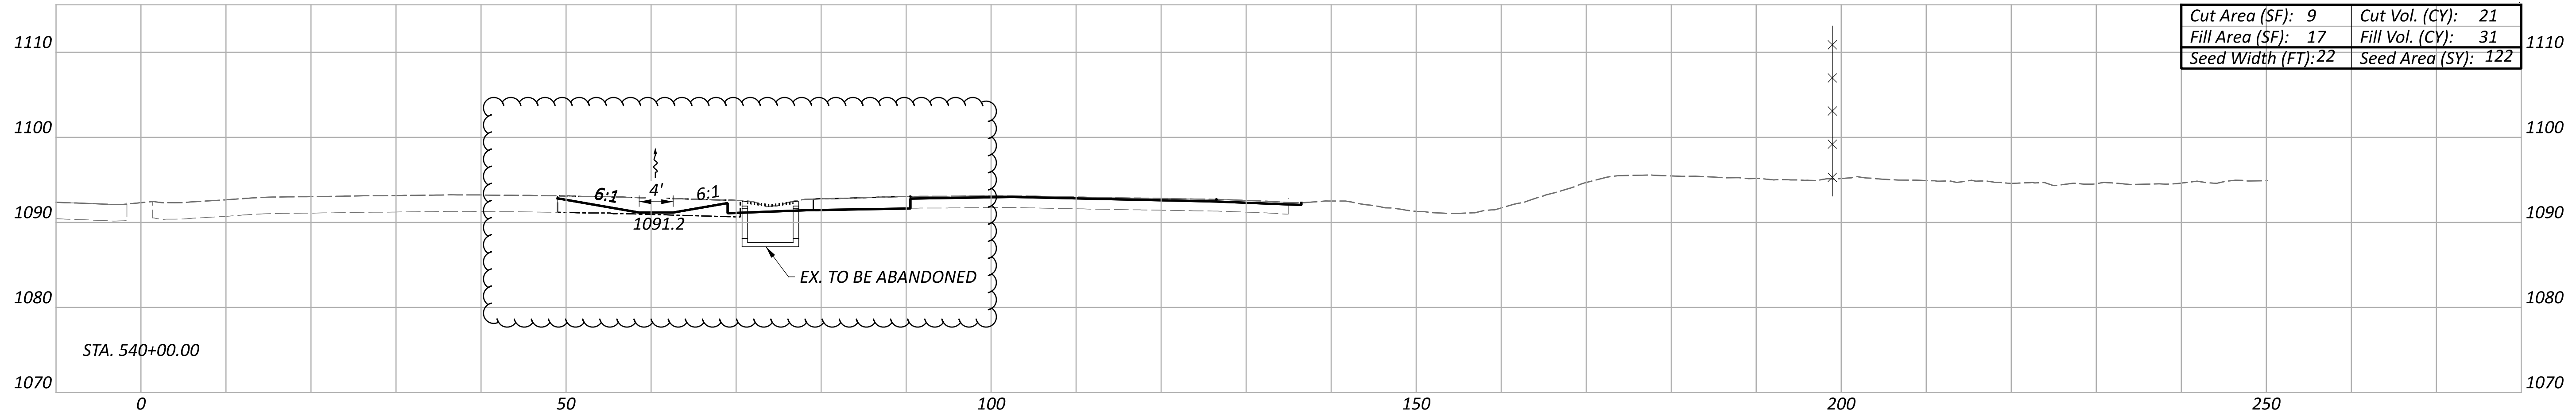
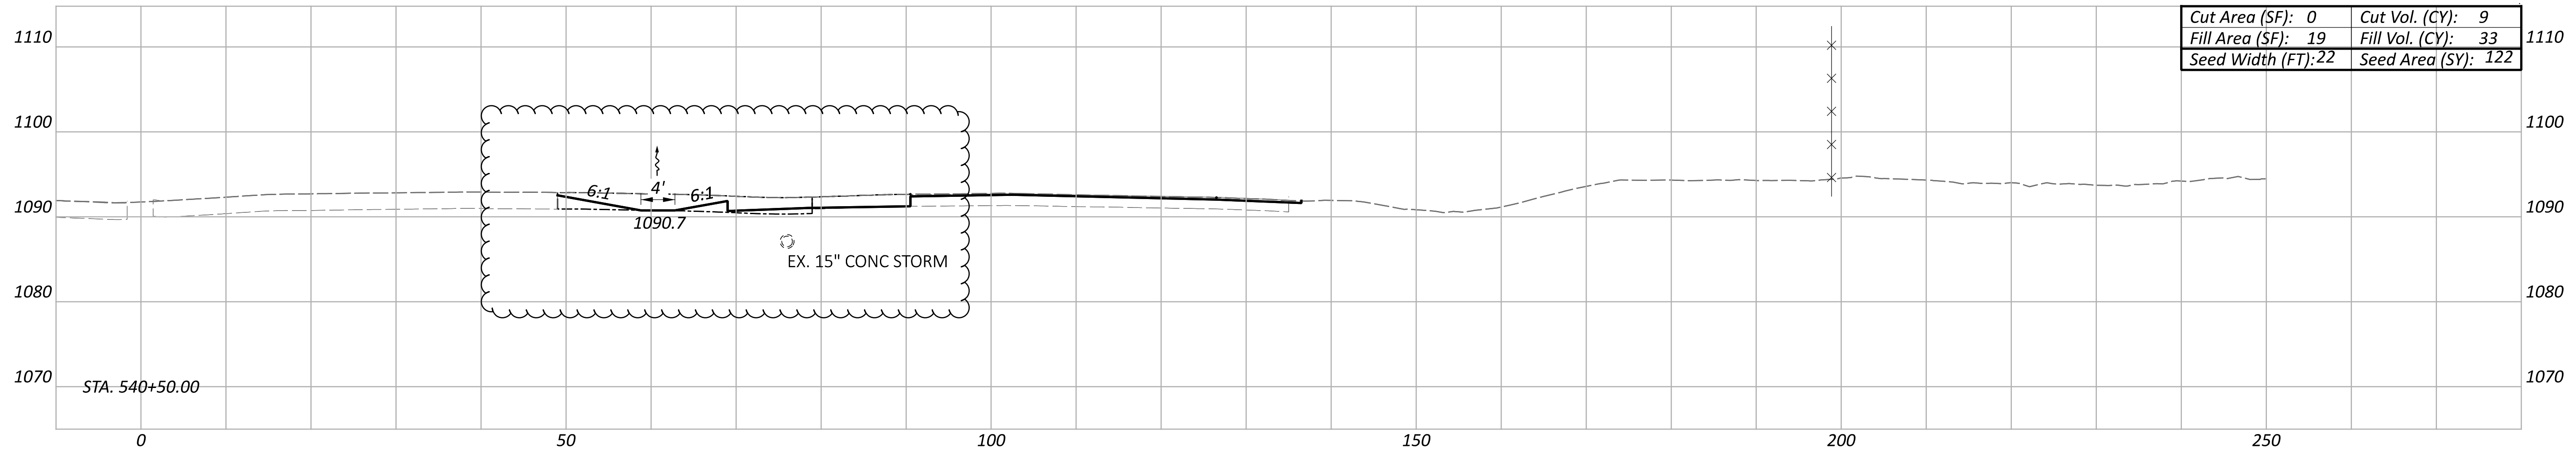


ITEM 202 - PAVEMENT REMOVED

CROSS SECTIONS
 STA. 539+50 TO STA. 540+50

DESIGN AGENCY	HNTB
DESIGNER	AS
REVIEWER	KKP 12/31/22
PROJECT ID	113156

Sheet Totals			SHEET TOTAL	
Seeding	Cut	Fill	124	233
366	55	94		

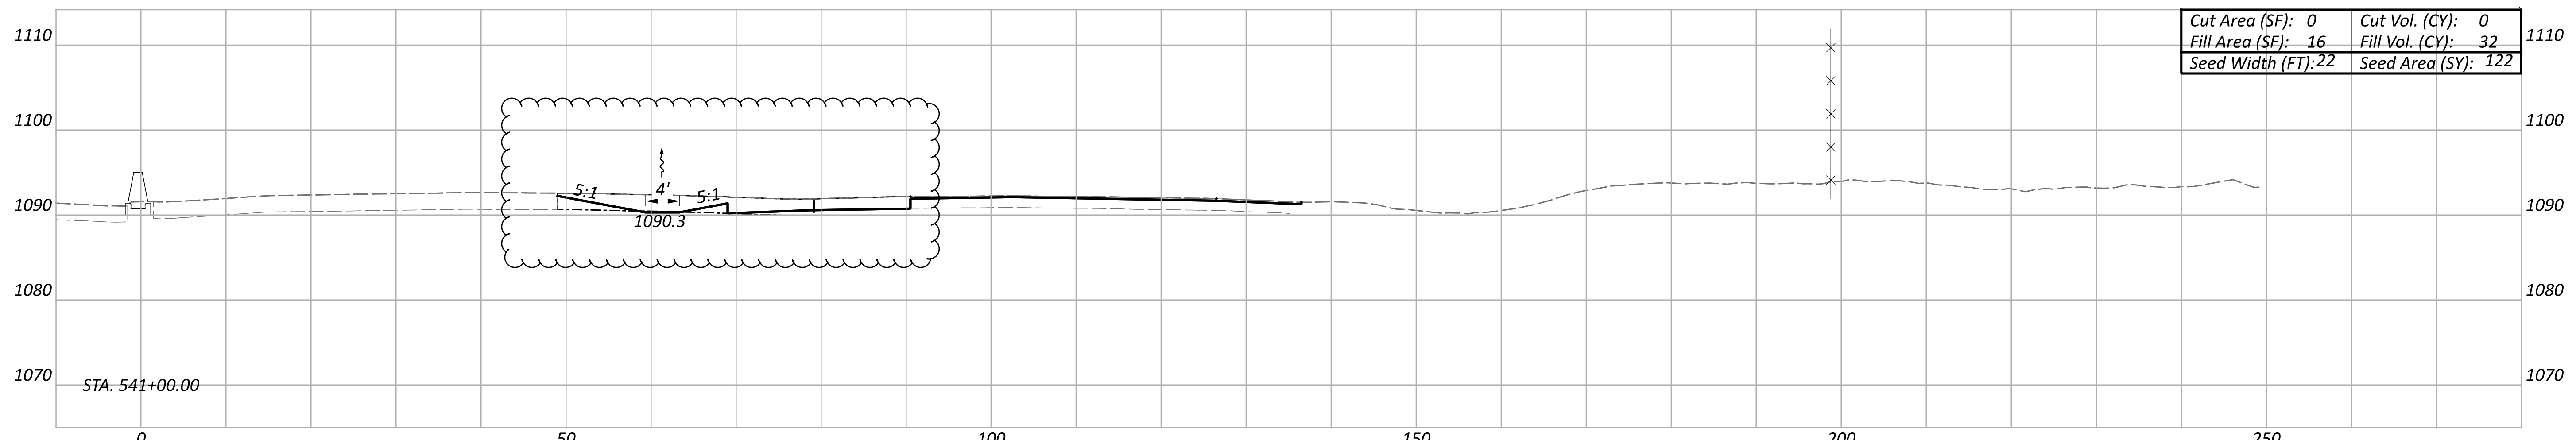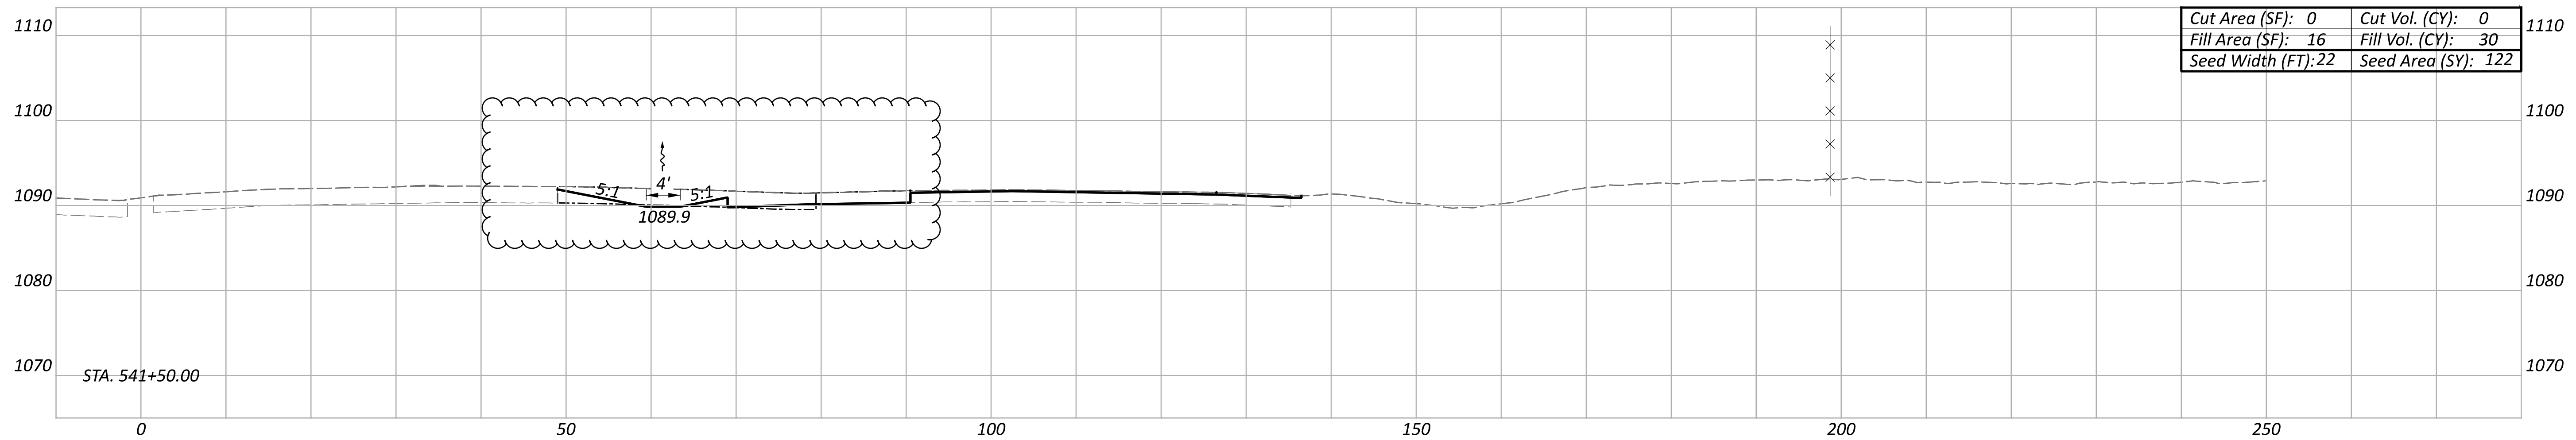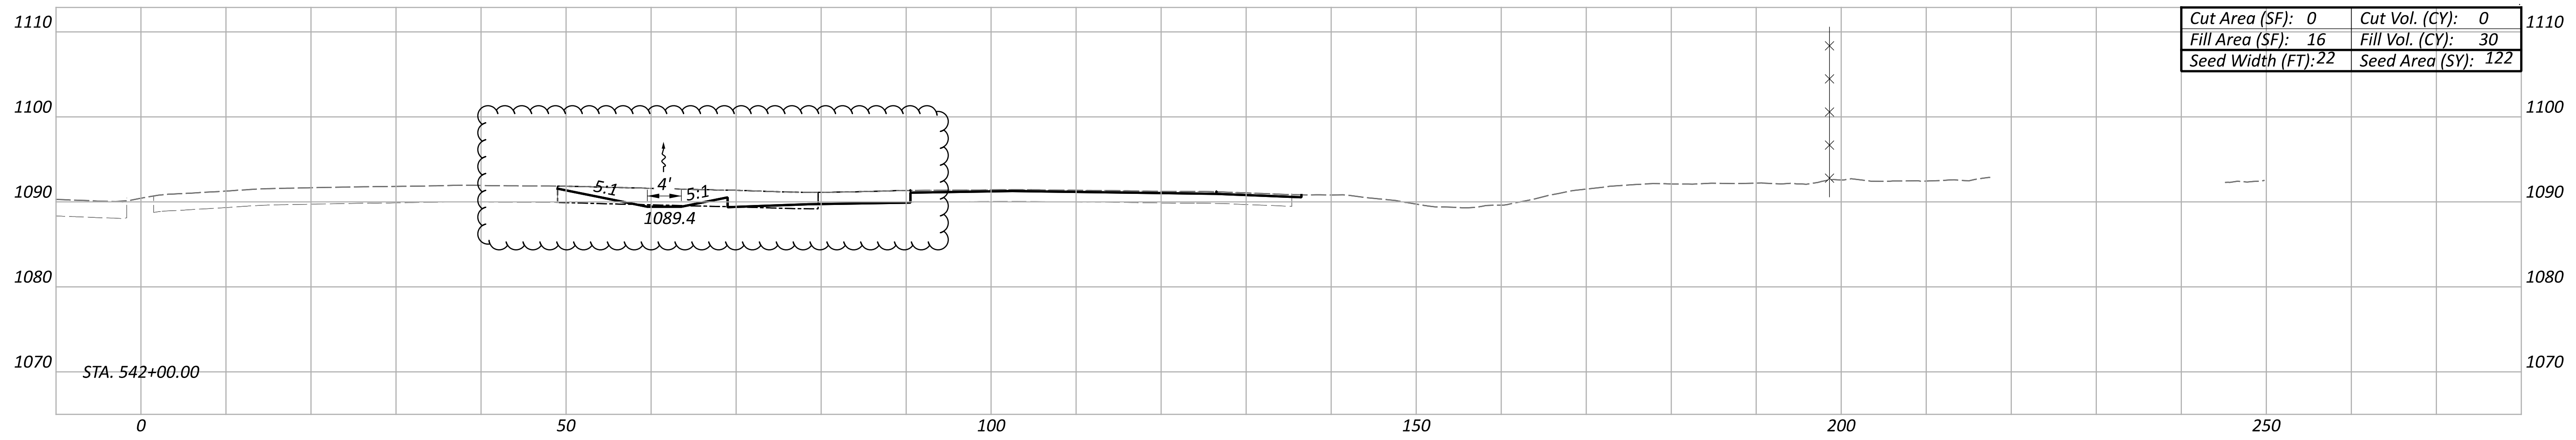

ITEM 202 - PAVEMENT REMOVED

CROSS SECTIONS
 STA. 541+00 TO STA. 542+00

DESIGN AGENCY



DESIGNER

AS

REVIEWER




KKP 12/31/22

PROJECT ID

113156

Sheet Totals		
Seeding	Cut	Fill
366	1	93

SHEET	TOTAL
125	233

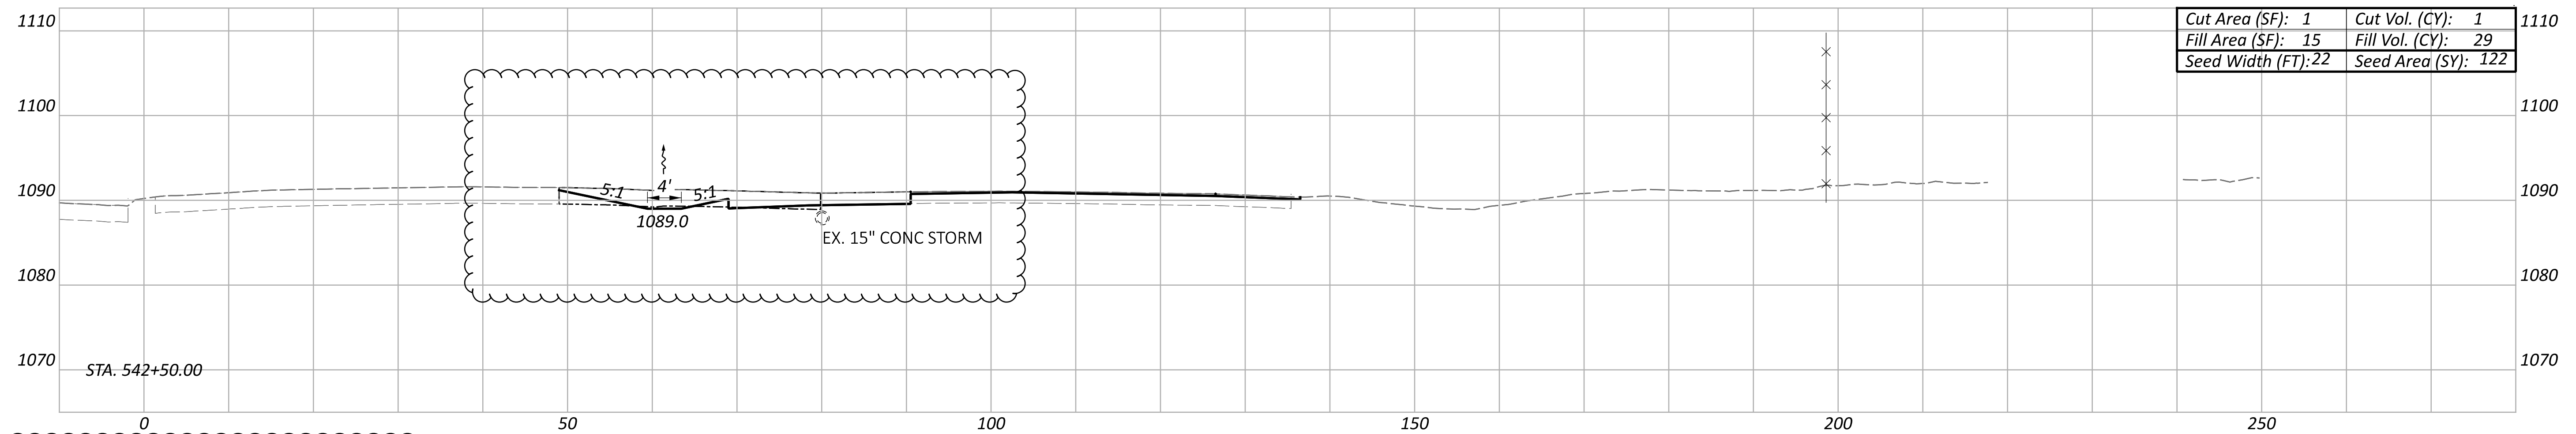
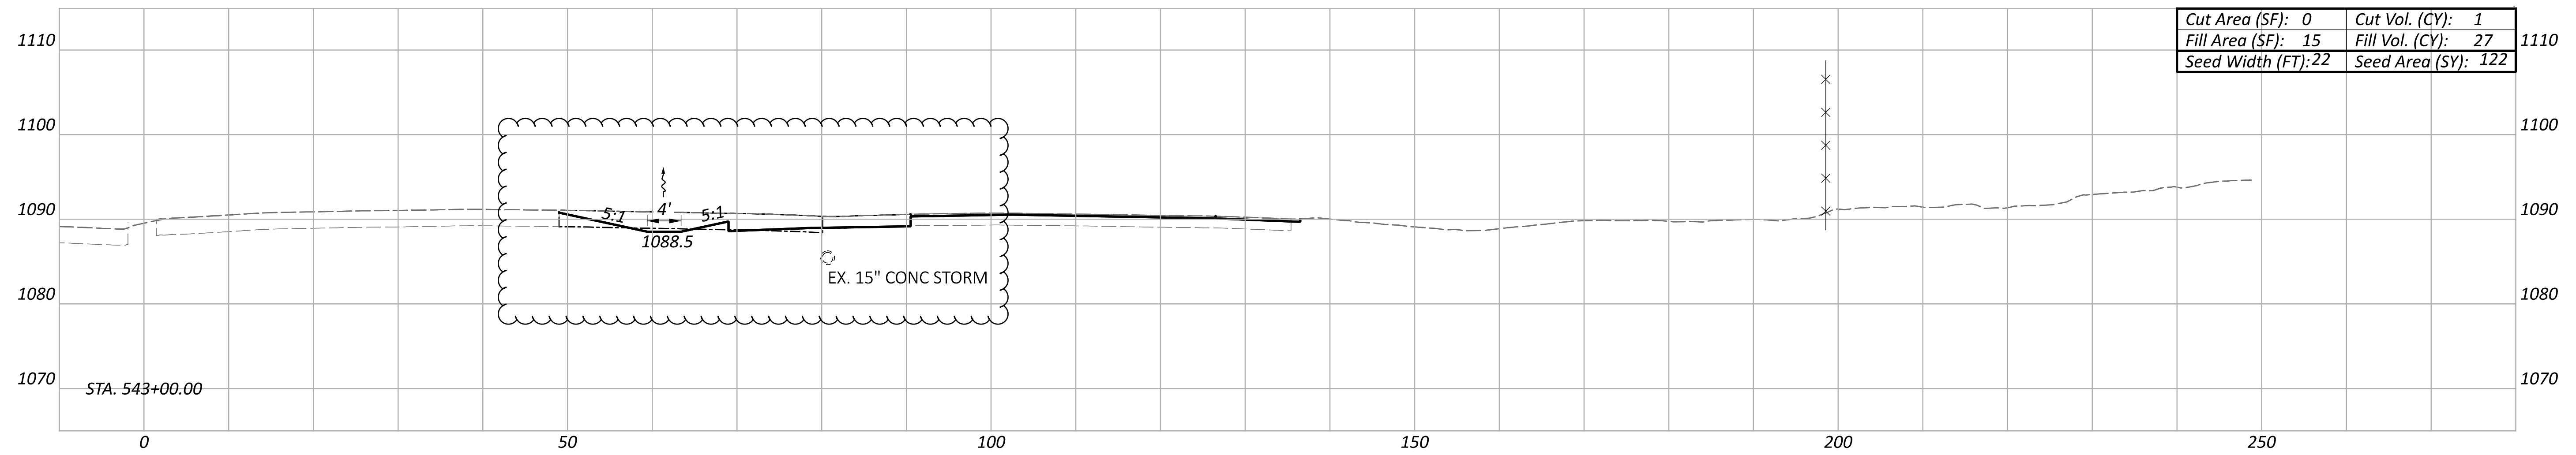
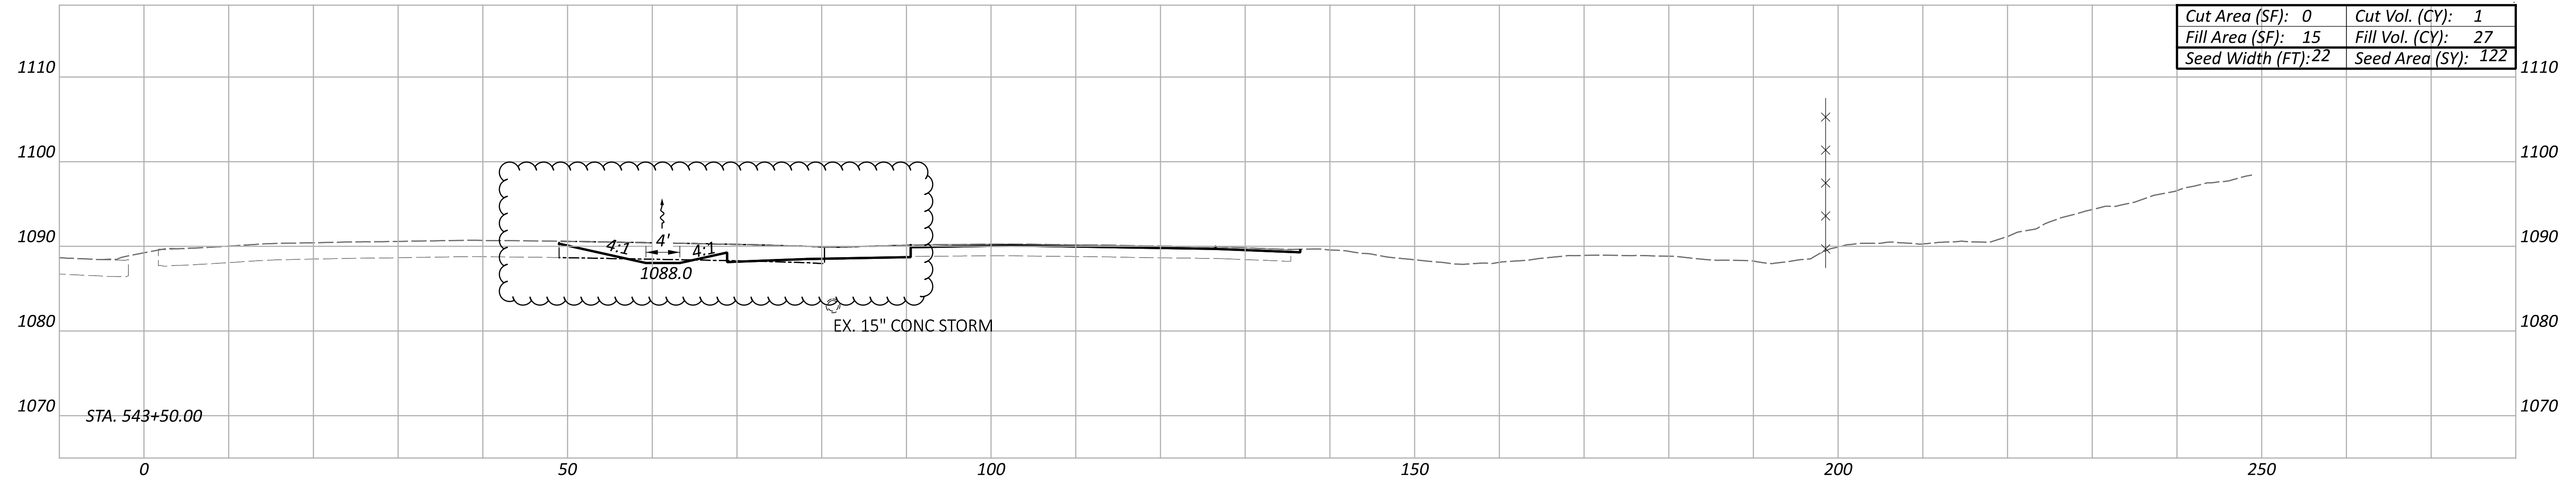


ITEM 202 - PAVEMENT REMOVED

CROSS SECTIONS
 STA. 542+50 TO STA. 543+50

DESIGN AGENCY
HNTB
 DESIGNER
 AS
 REVIEWER
 KKP 12/31/22
 PROJECT ID
 113156

Sheet Totals			SHEET TOTAL	
Seeding	Cut	Fill	126	233
366	3	83		

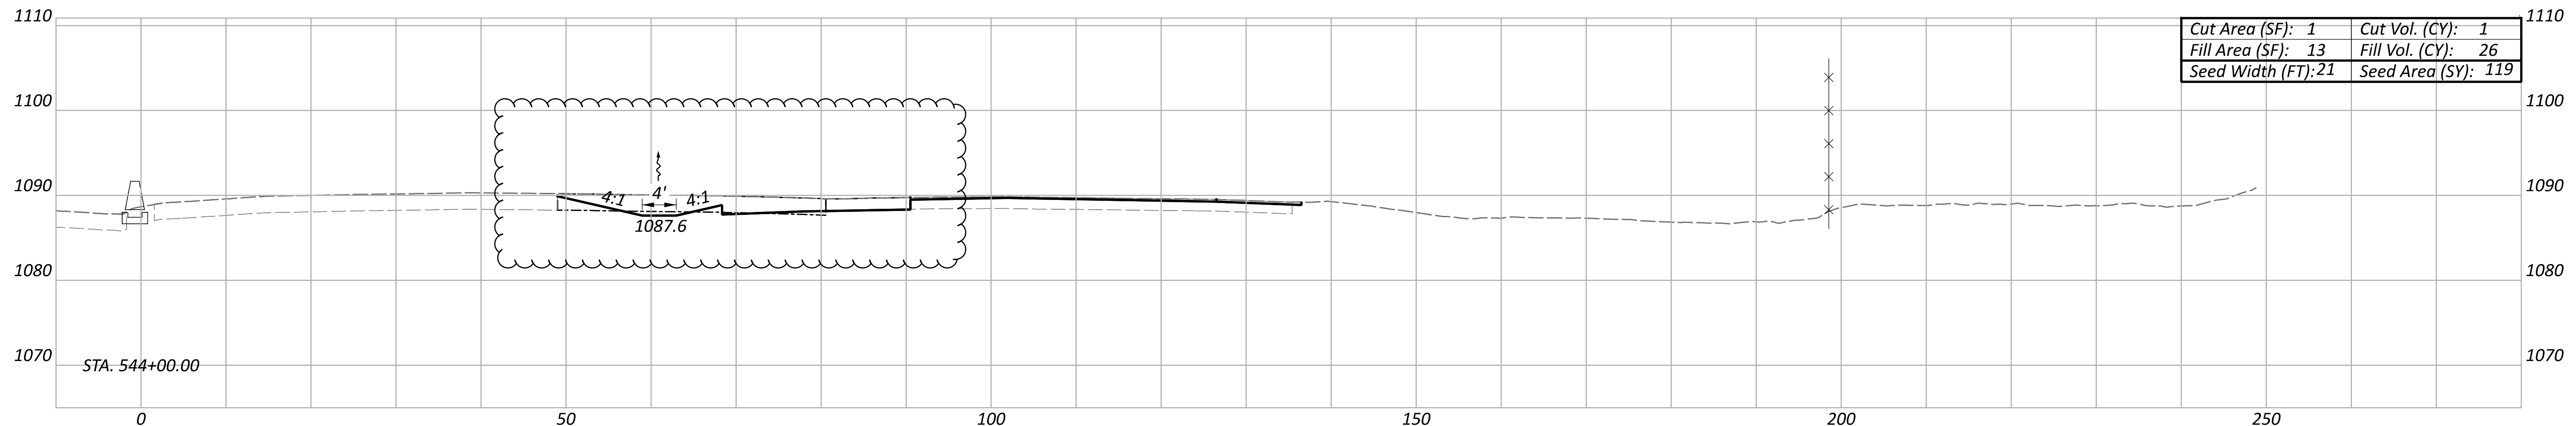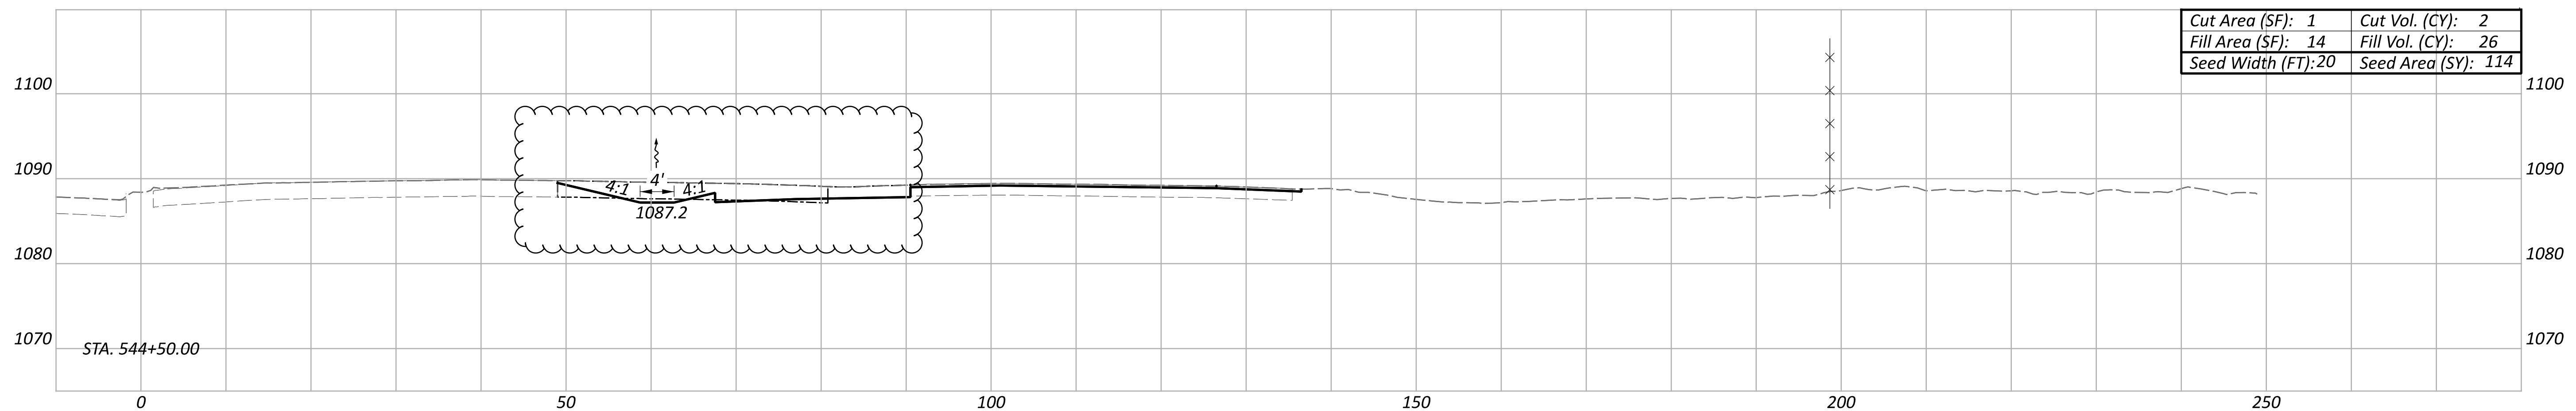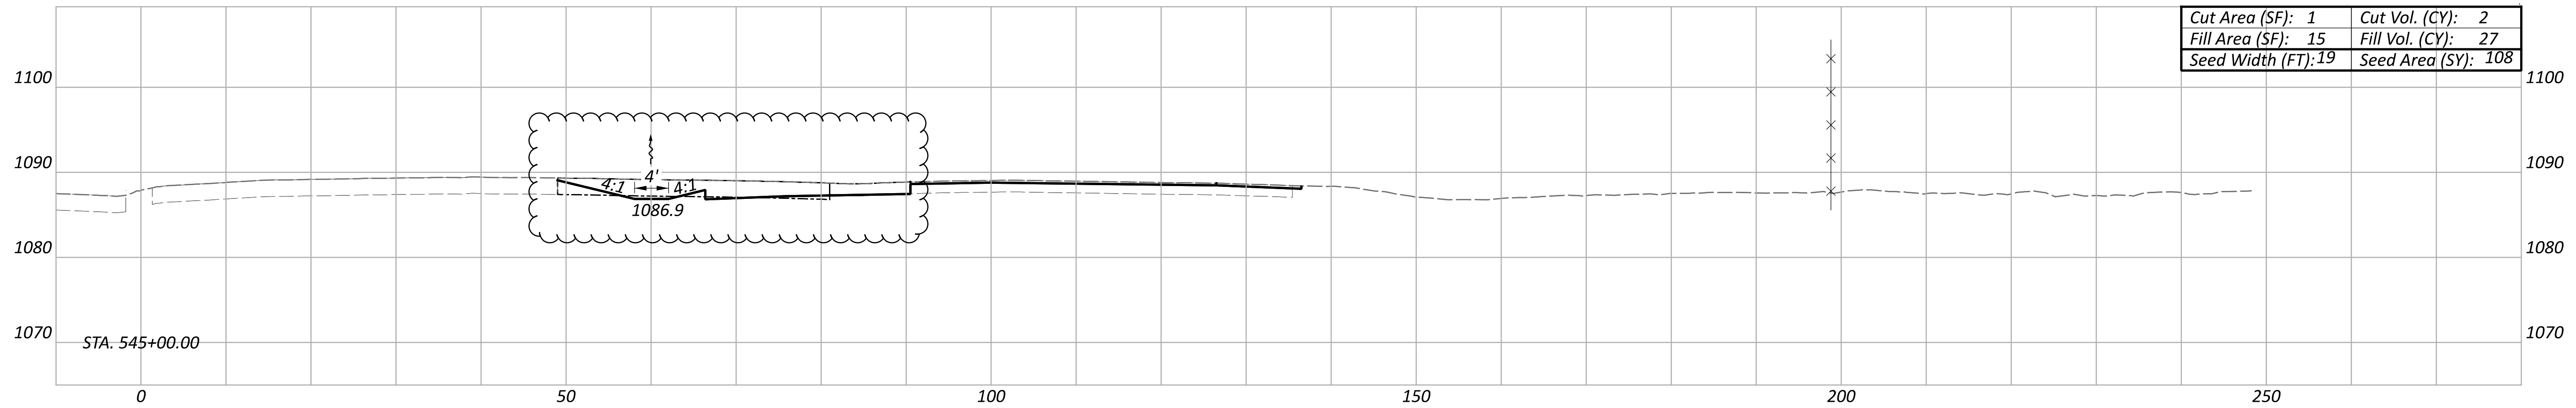

ITEM 202 - PAVEMENT REMOVED

CROSS SECTIONS
 STA. 544+00 TO STA. 545+00

DESIGN AGENCY



DESIGNER

AS

REVIEWER




KKP 12/31/22

PROJECT ID

113156

Sheet Totals		
Seeding	Cut	Fill
341	5	79

SHEET	TOTAL
127	233

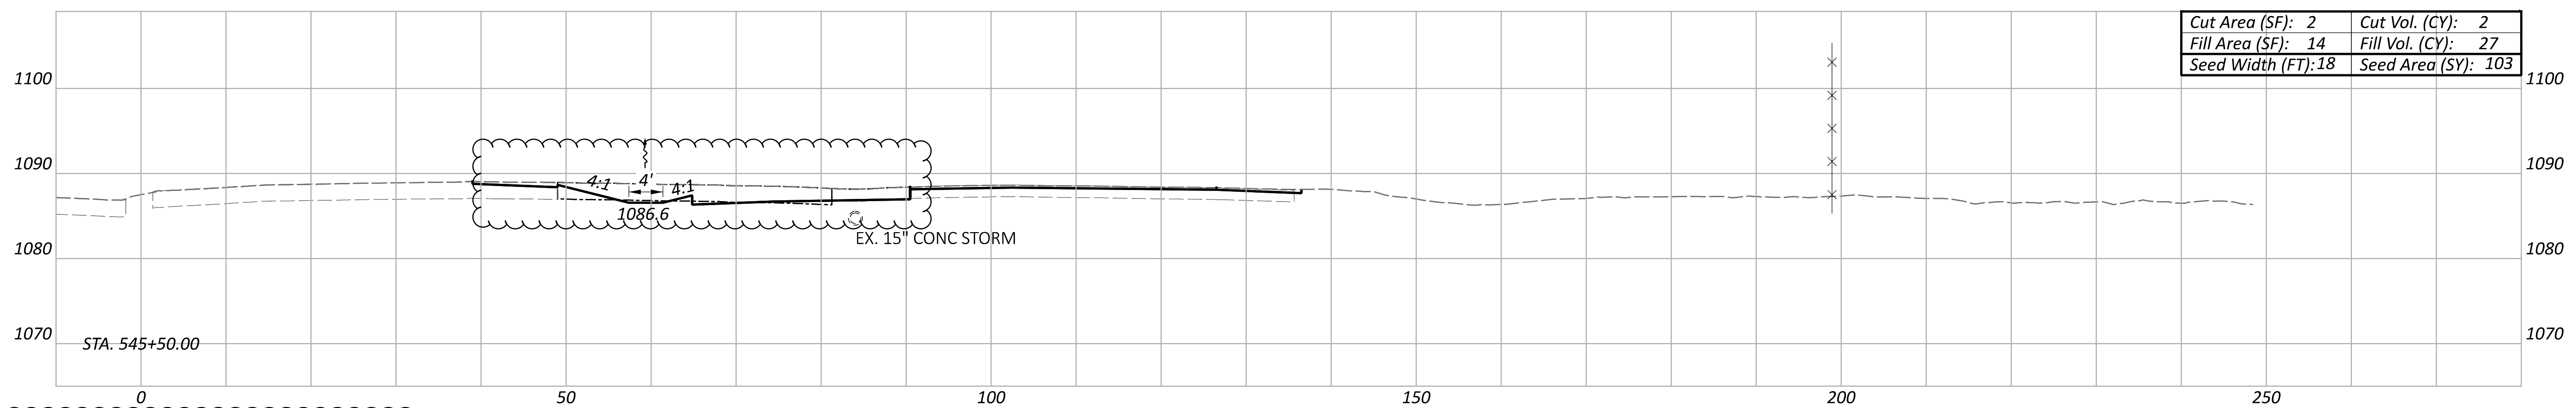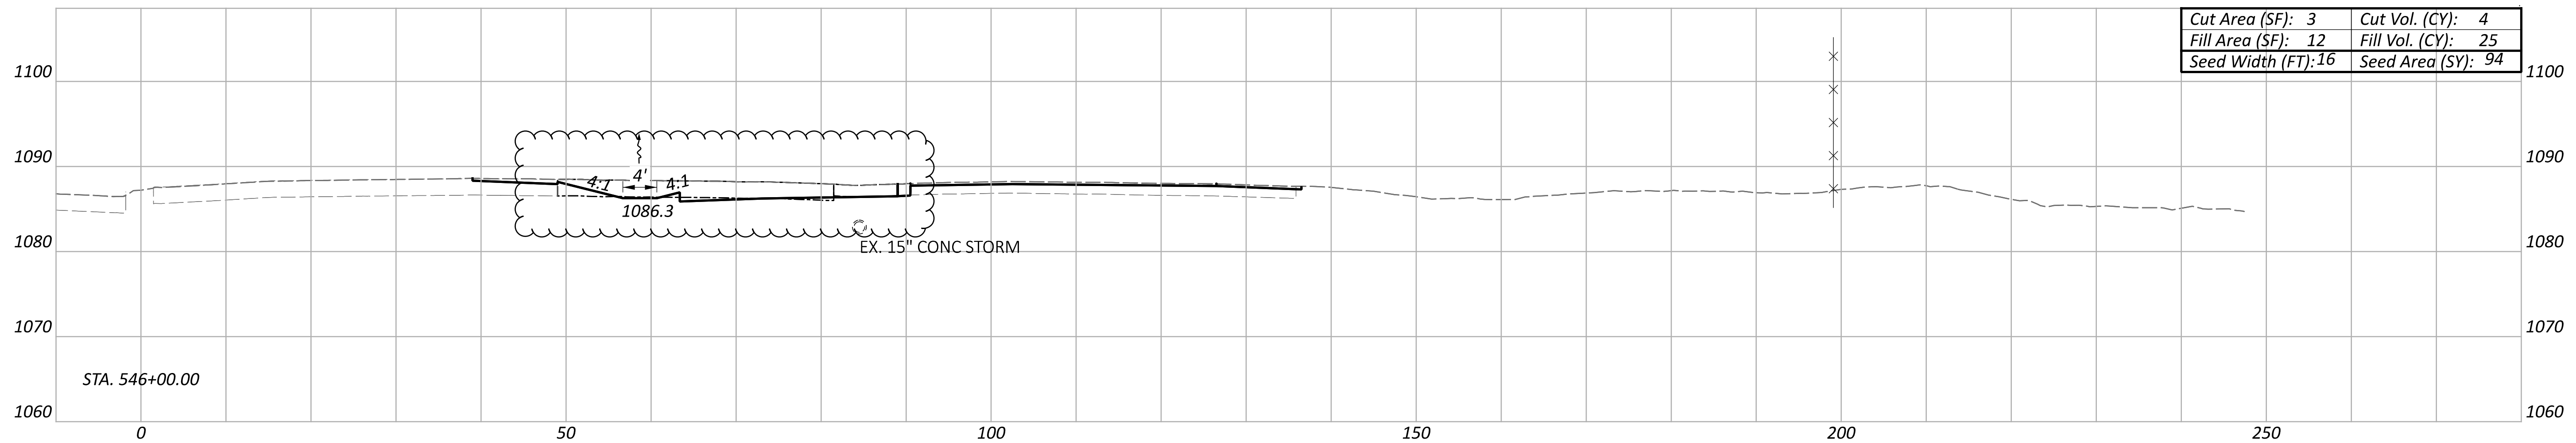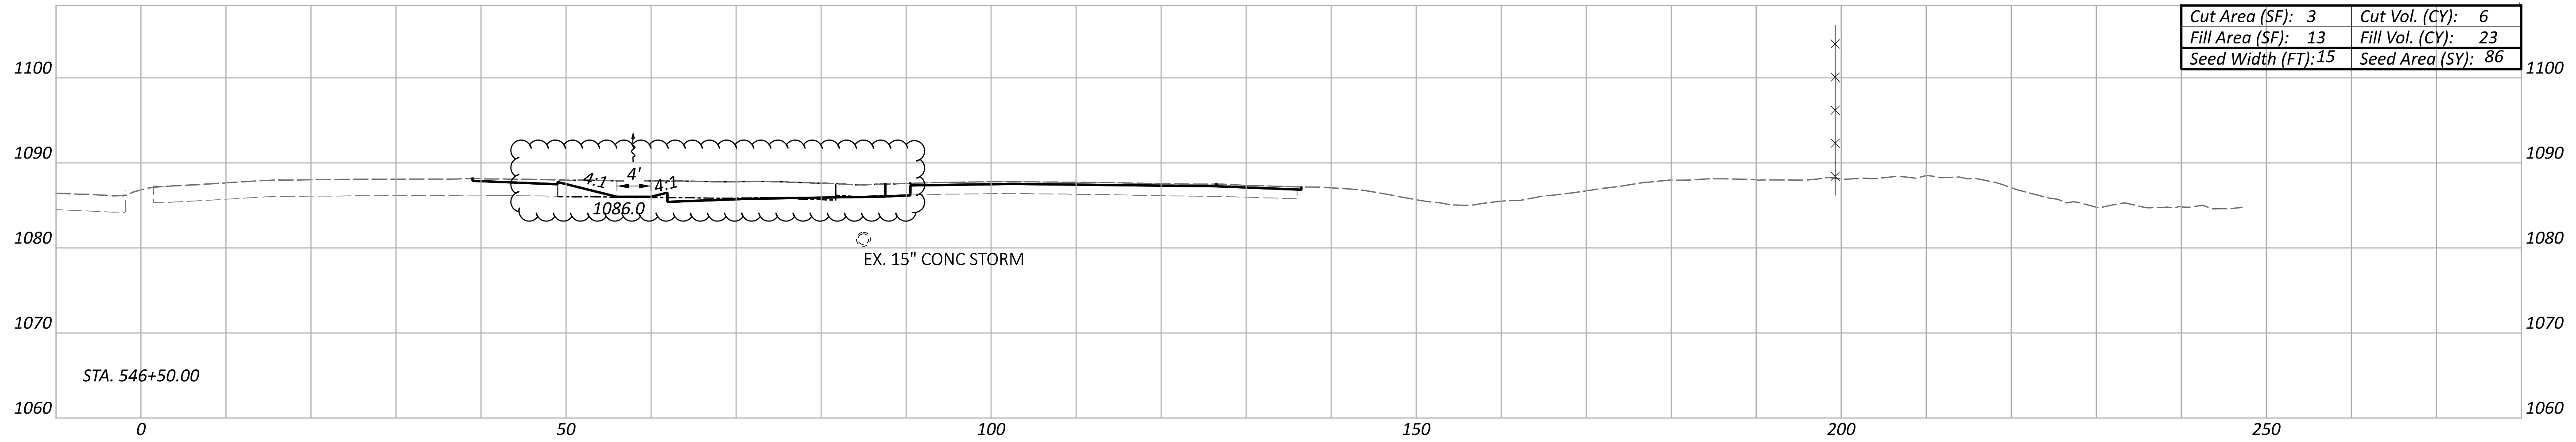

ITEM 202 - PAVEMENT REMOVED

CROSS SECTIONS
 STA. 545+50 TO STA. 546+50

DESIGN AGENCY



DESIGNER

AS

REVIEWER




KKP 12/31/22

PROJECT ID

113156

Sheet Totals		
Seeding	Cut	Fill
283	12	75

SHEET	TOTAL
128	233

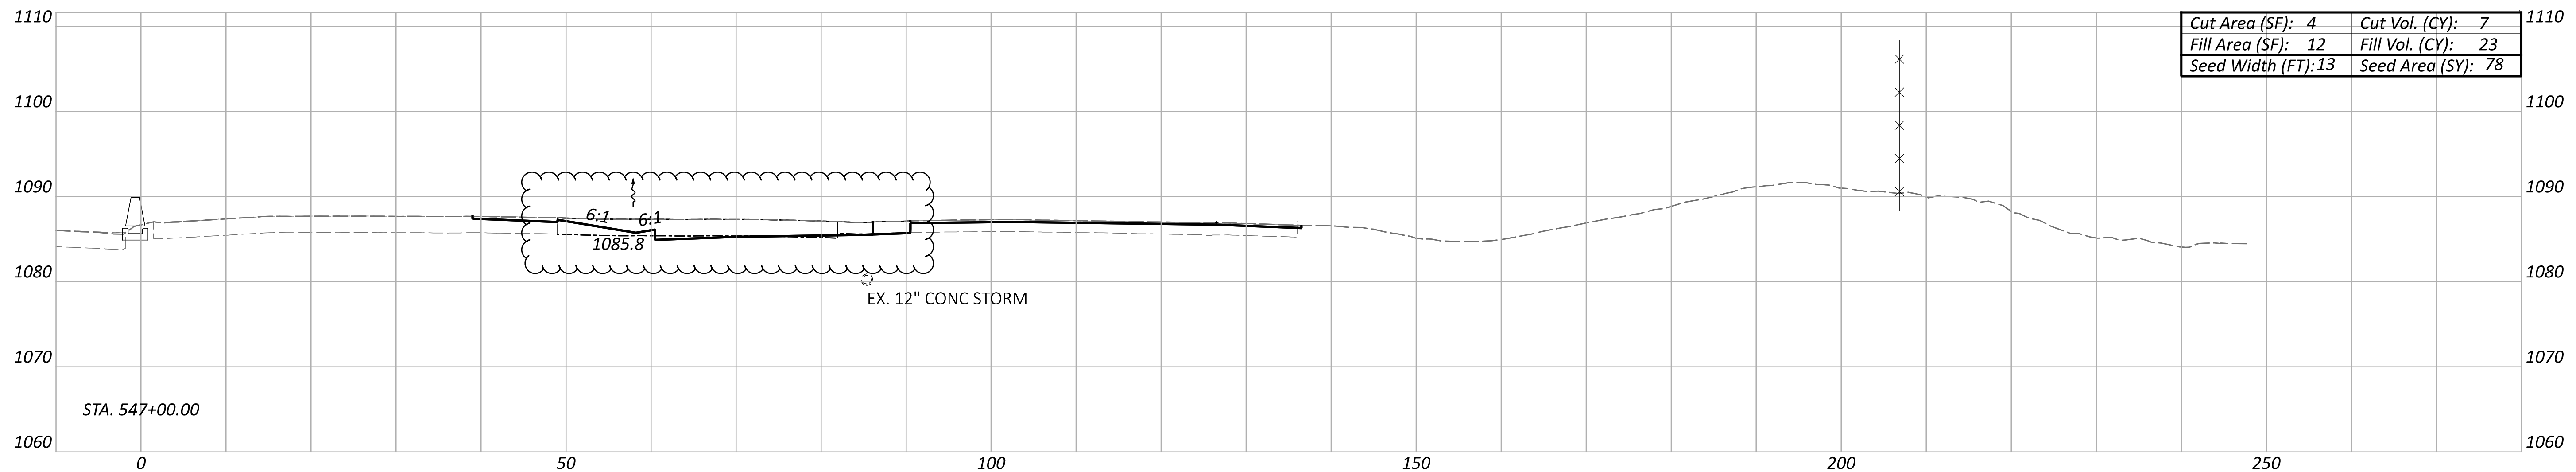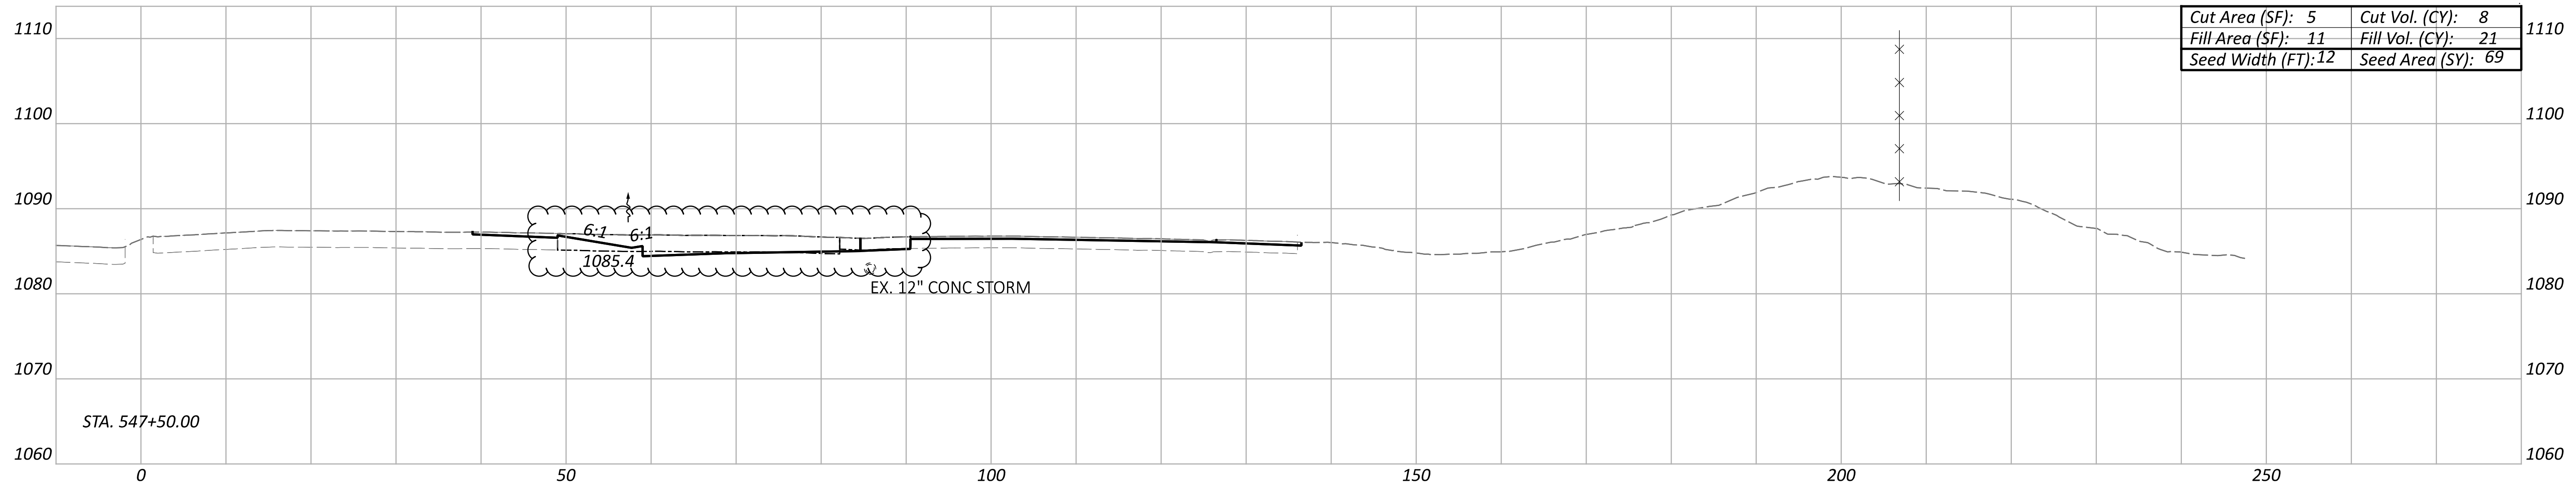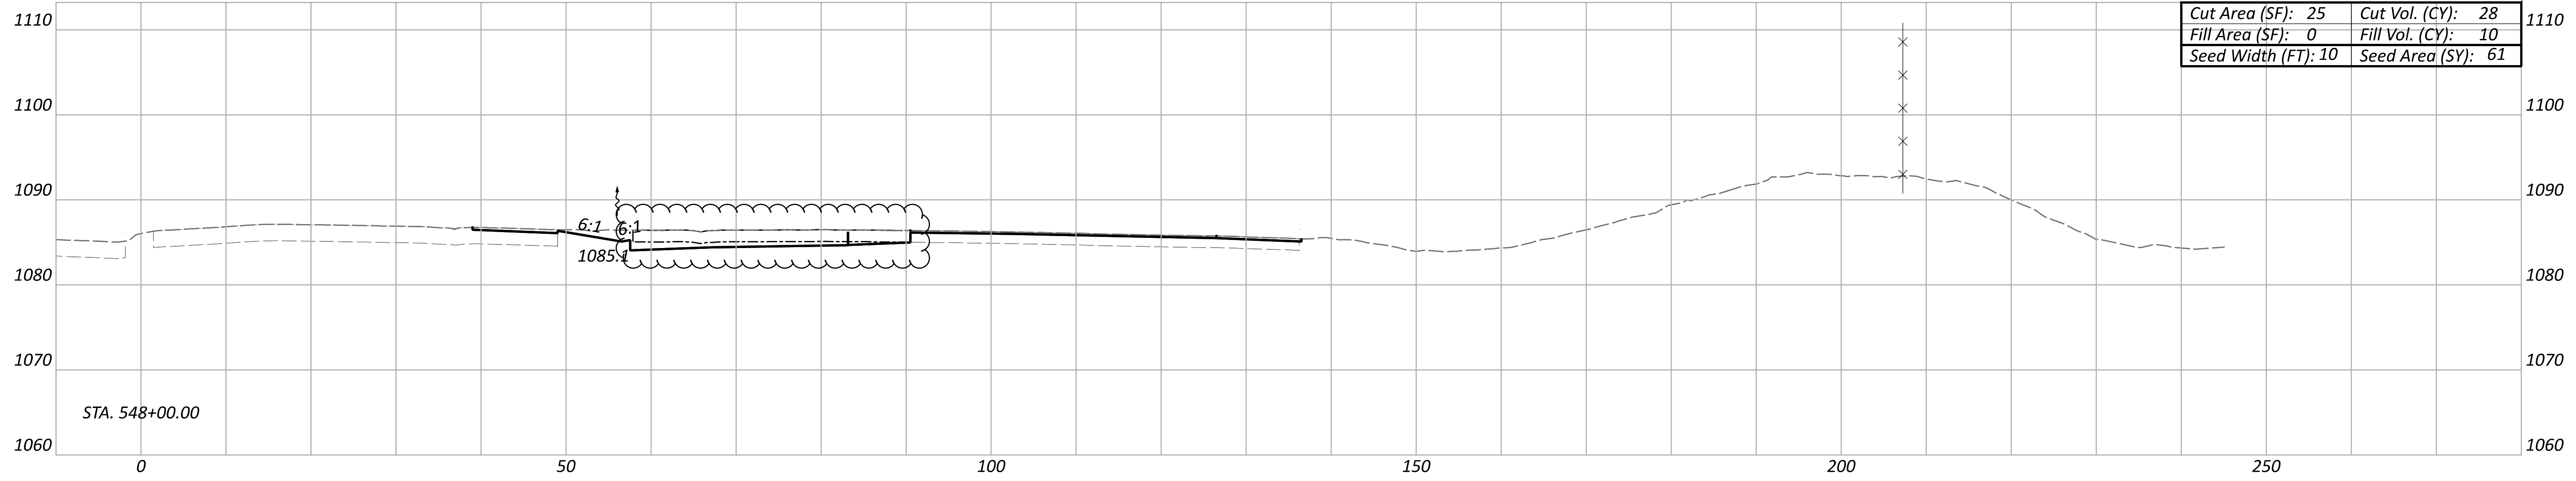

ITEM 202 - PAVEMENT REMOVED

CROSS SECTIONS
 STA. 547+00 TO STA. 548+00

DESIGN AGENCY



DESIGNER

AS

REVIEWER




KKP 12/31/22

PROJECT ID

113156

Sheet Totals		
Seeding	Cut	Fill
208	43	54

SHEET	TOTAL
129	233

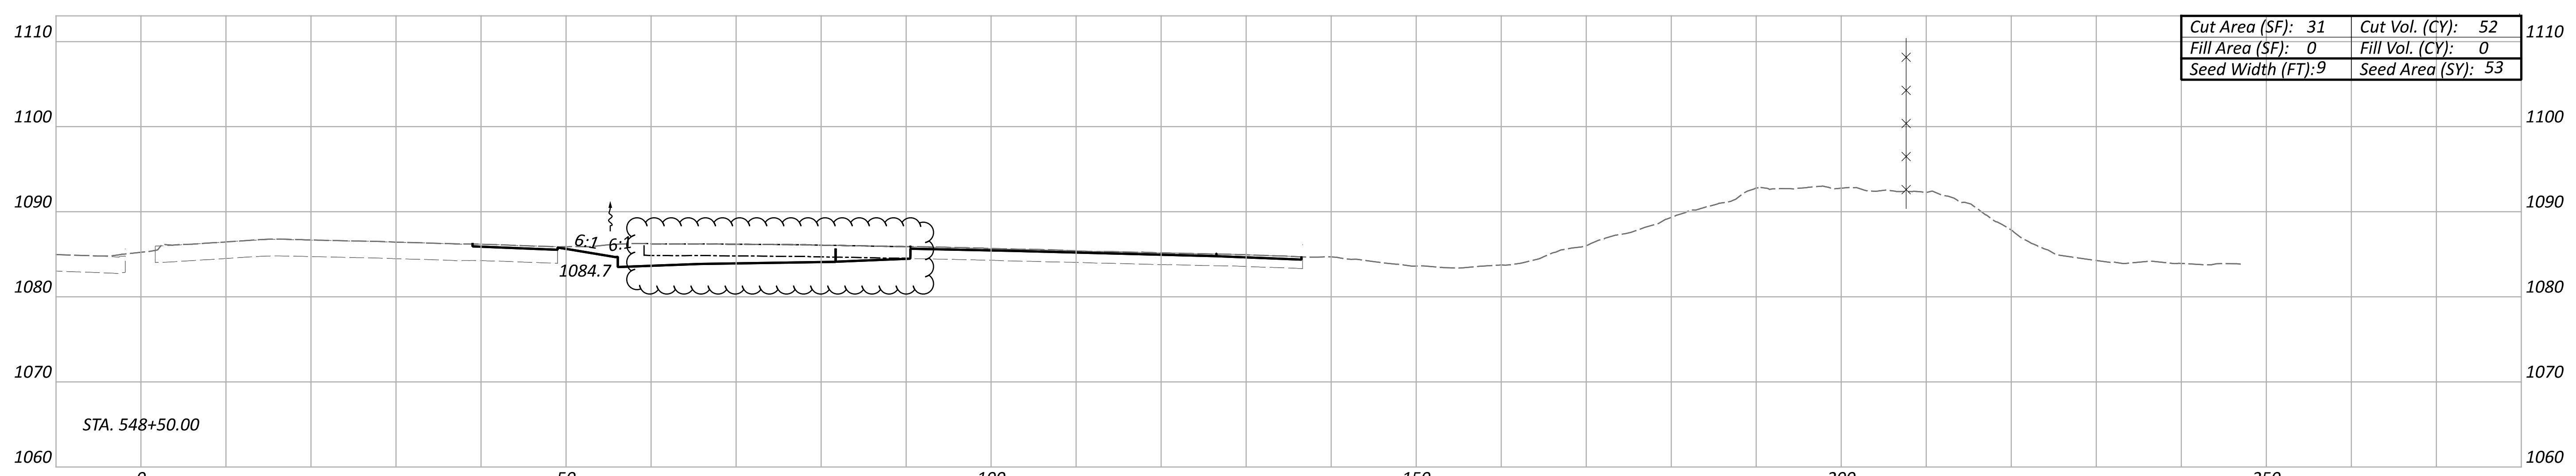
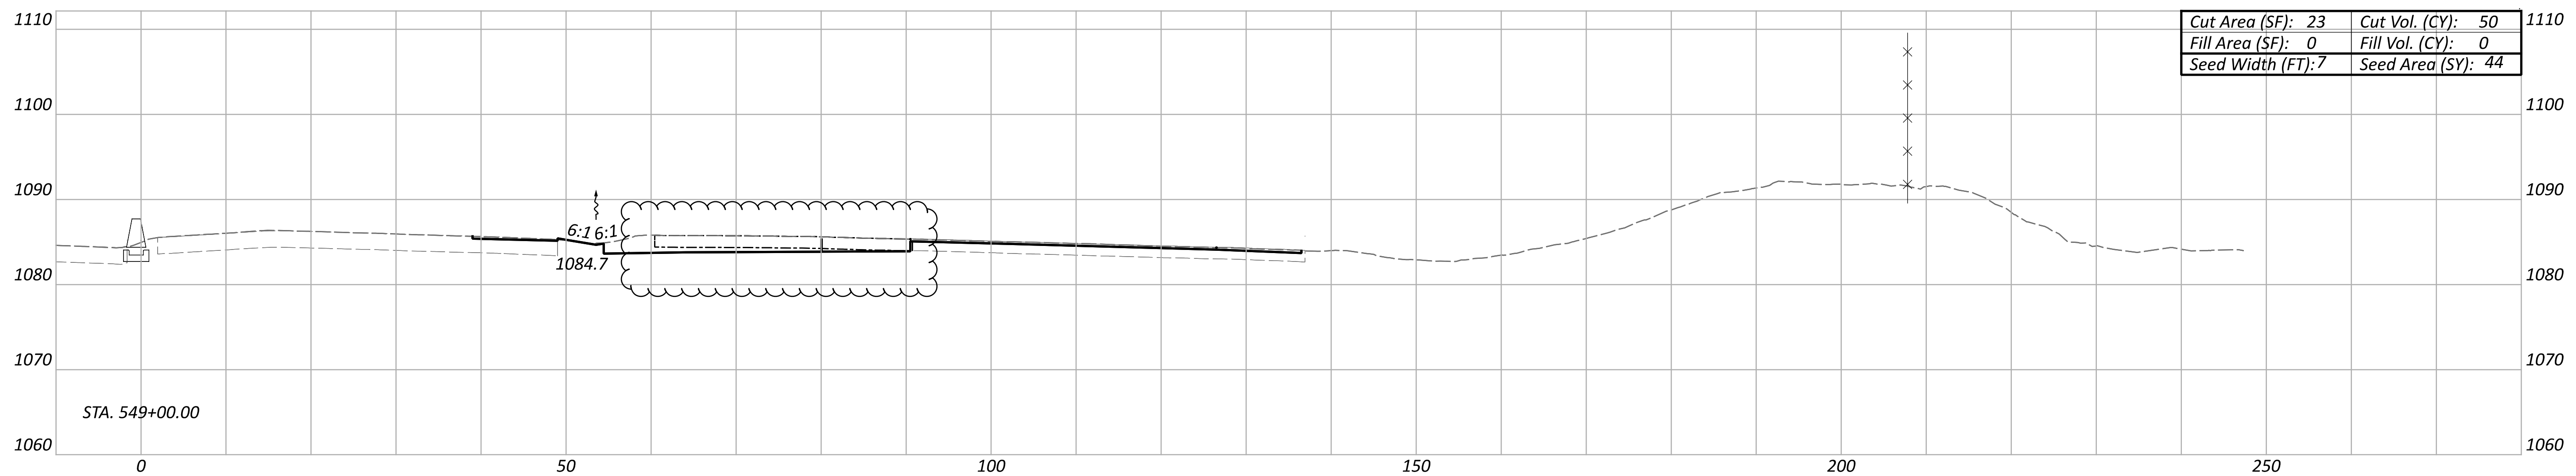
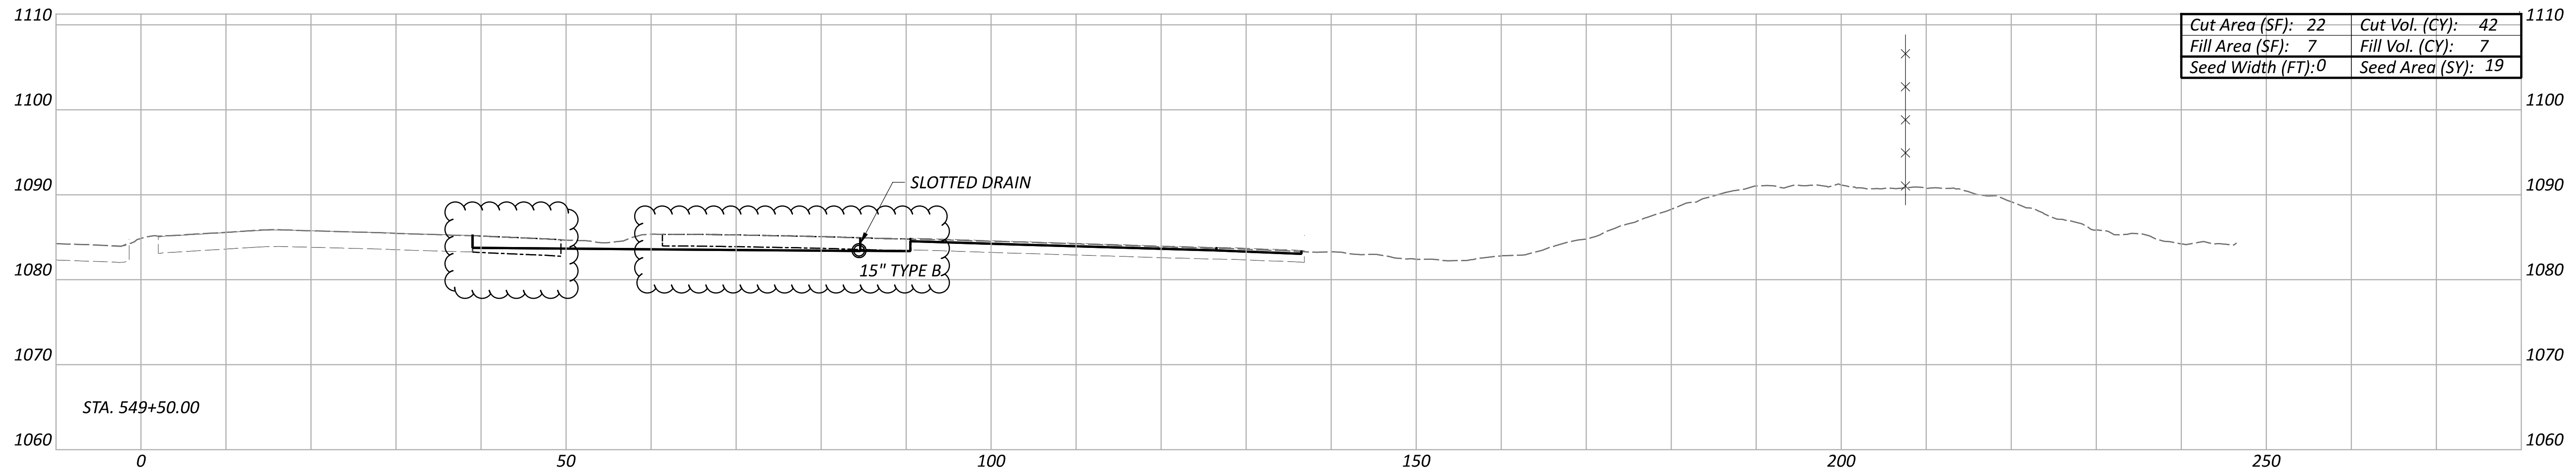


ITEM 202 - PAVEMENT REMOVED

CROSS SECTIONS
 STA. 548+50 TO STA. 549+50

DESIGN AGENCY	
HNTB	
DESIGNER	AS
REVIEWER	KKP 12/31/22
PROJECT ID	113156

Sheet Totals			SHEET TOTAL	
Seeding	Cut	Fill	130	233
116	143	7		

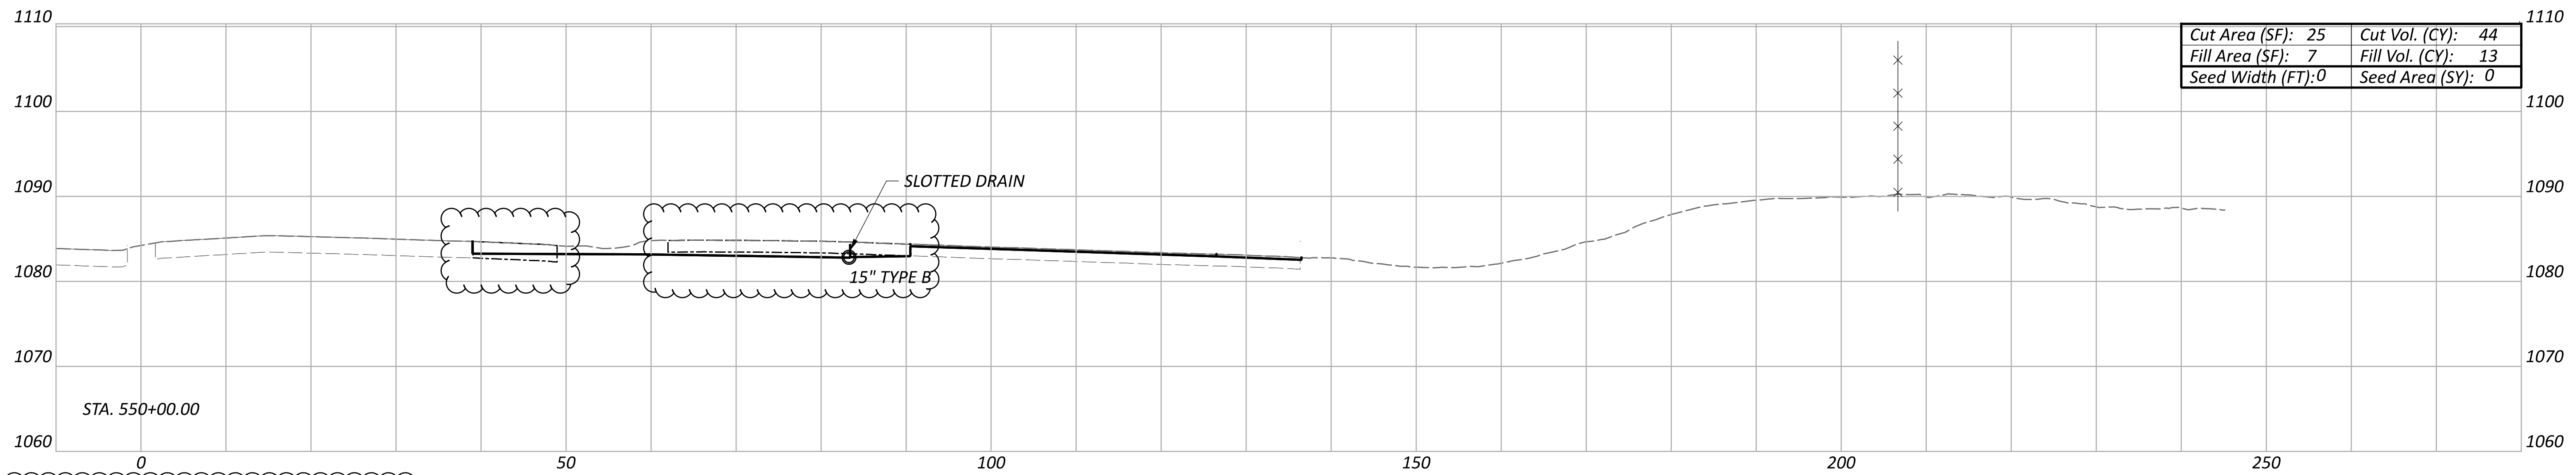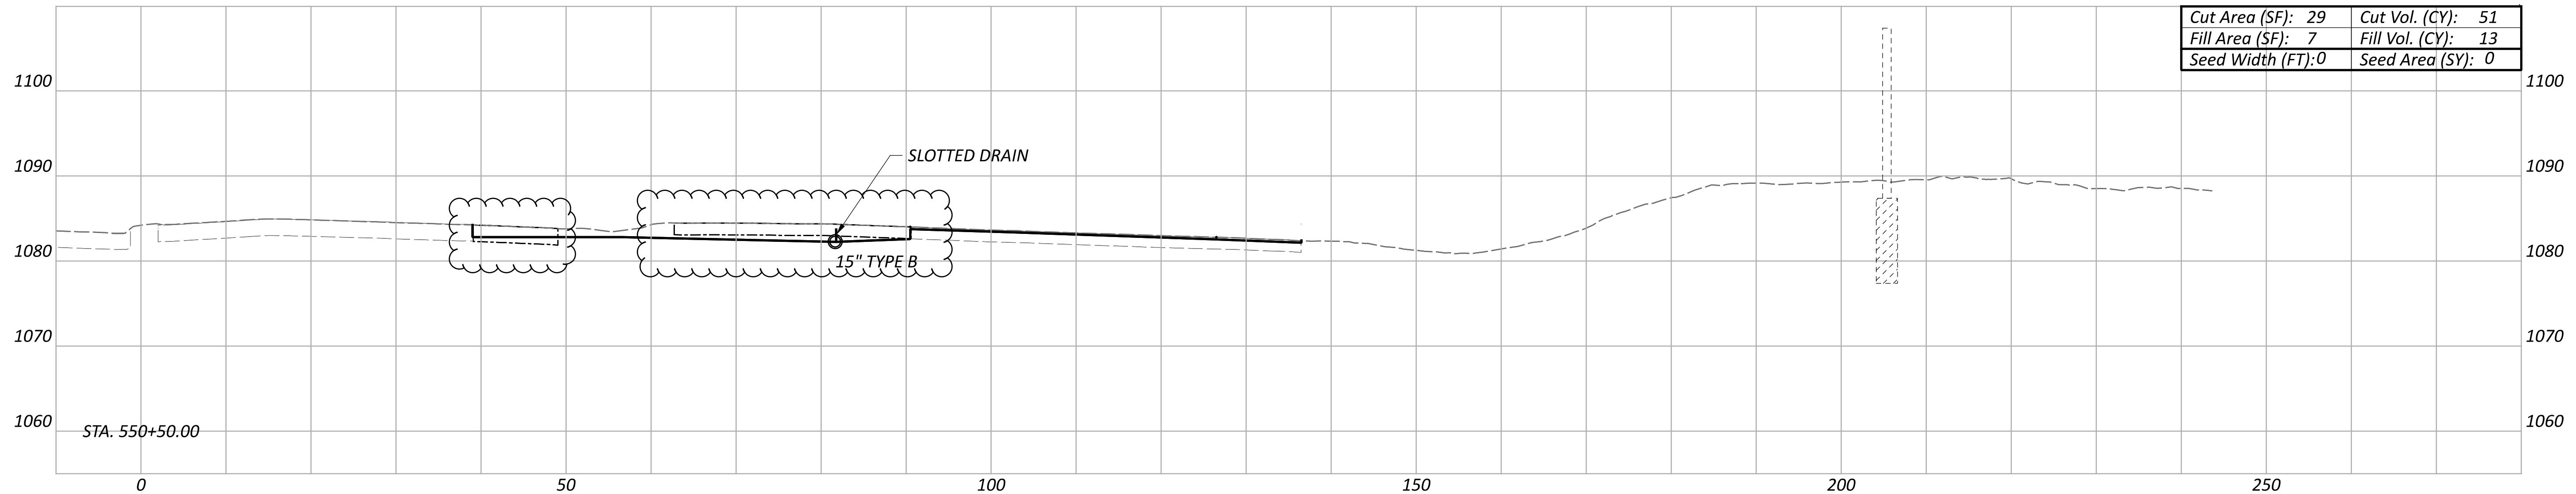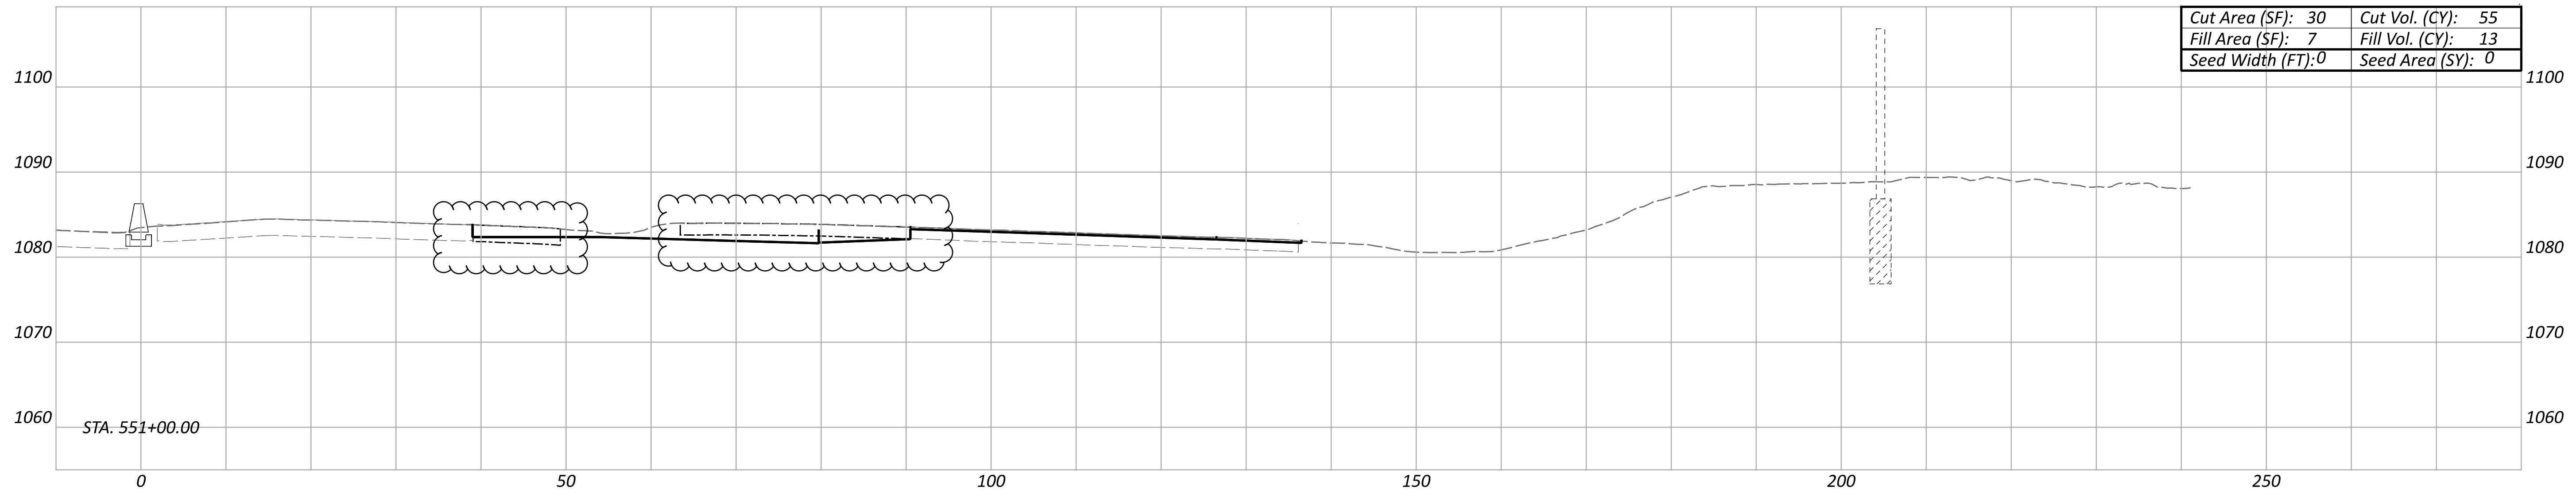

ITEM 202 - PAVEMENT REMOVED

CROSS SECTIONS
 STA. 550+50 TO STA. 551+00

DESIGN AGENCY



DESIGNER

AS

REVIEWER




KKP 12/31/22

PROJECT ID

113156

Sheet Totals		
Seeding	Cut	Fill
0	105	26

SHEET	TOTAL
131	233

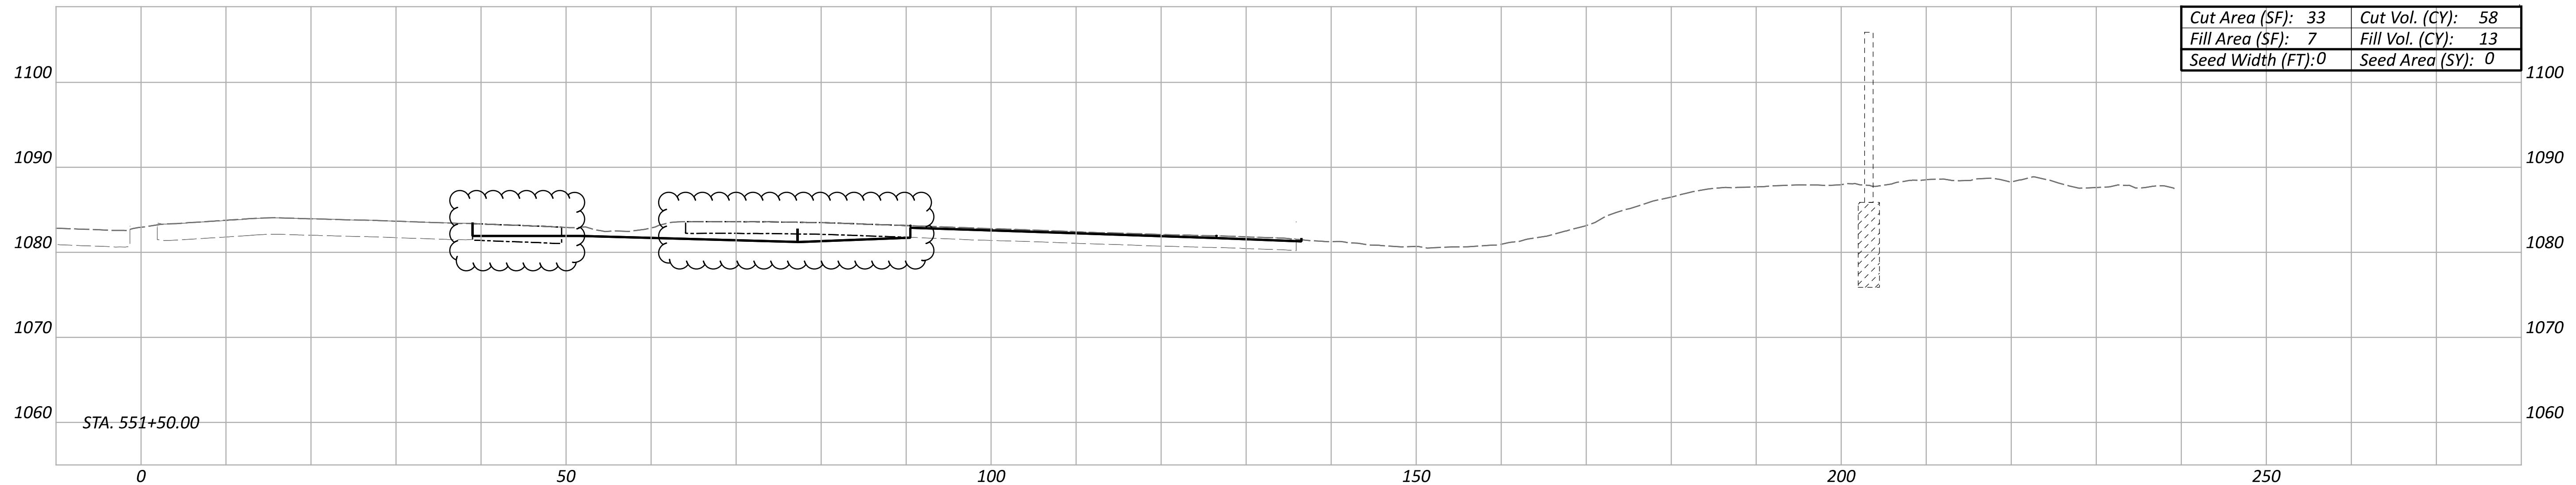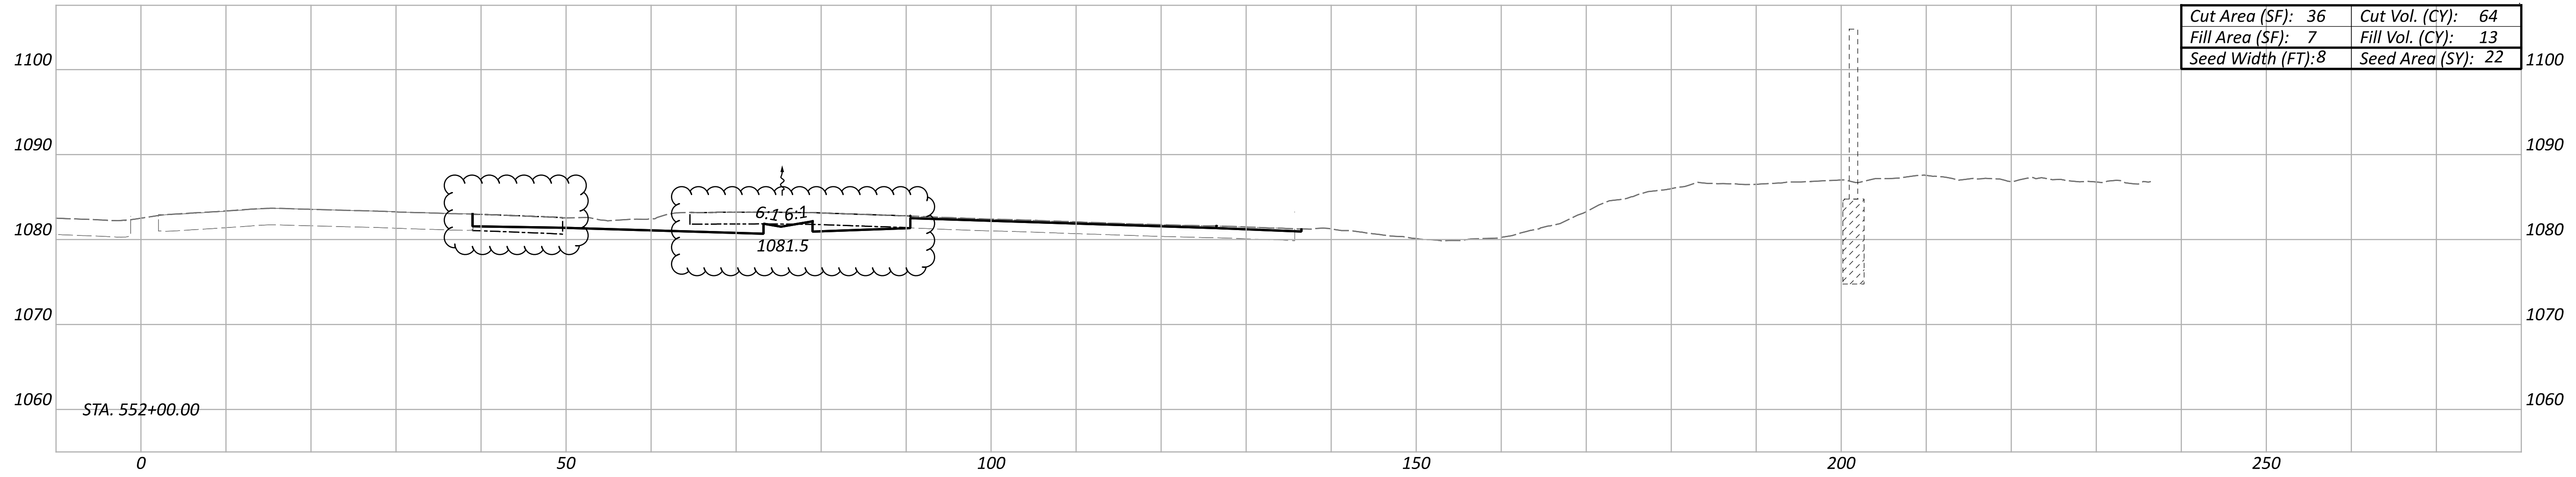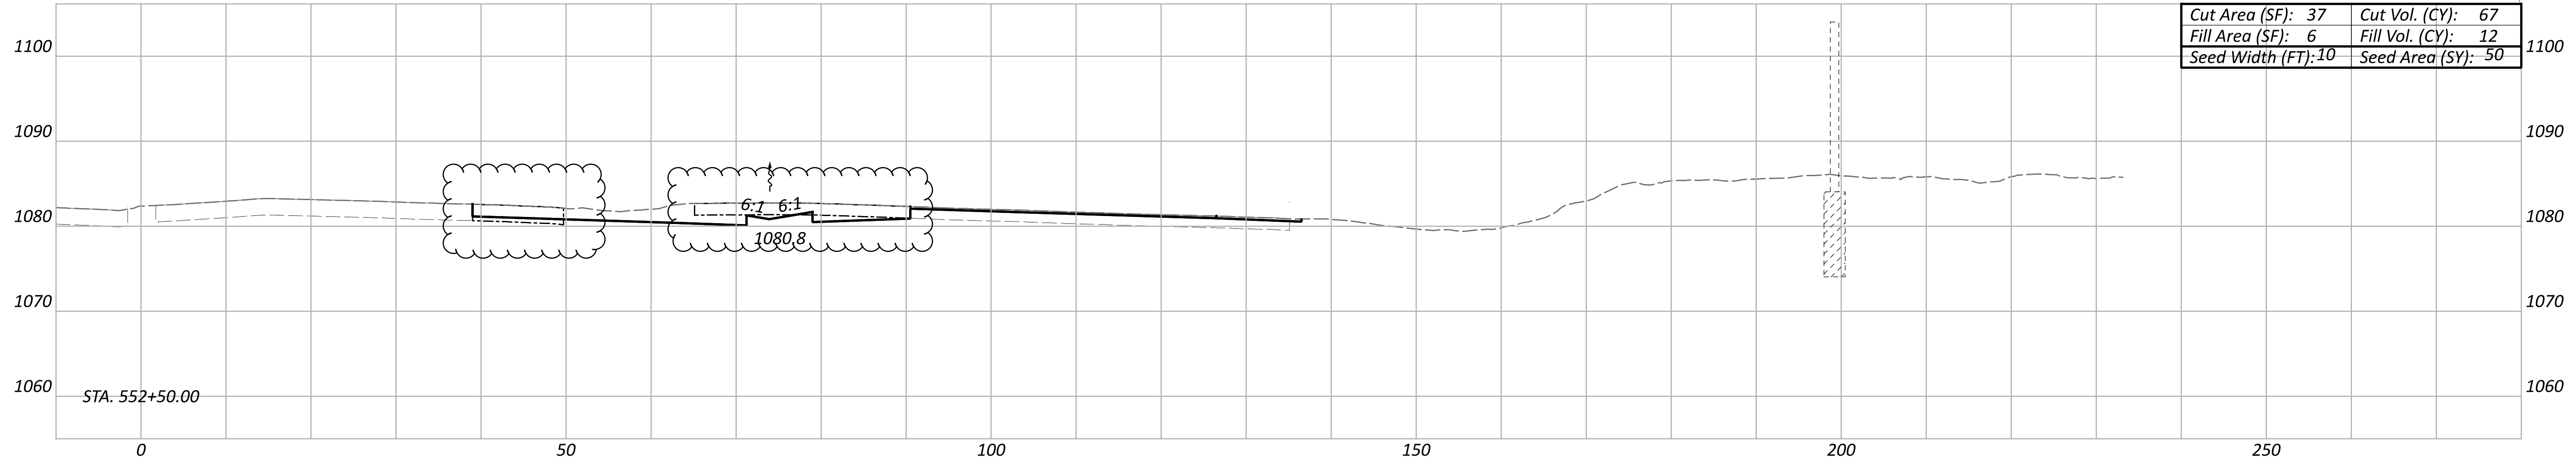

ITEM 202 - PAVEMENT REMOVED

CROSS SECTIONS
 STA. 551+50 TO STA. 552+50

DESIGN AGENCY






DESIGNER
 AS

REVIEWER
 KKP 12/31/22

PROJECT ID
 113156

Sheet Totals			SHEET TOTAL	
Seeding	Cut	Fill	132	233
72	189	39		

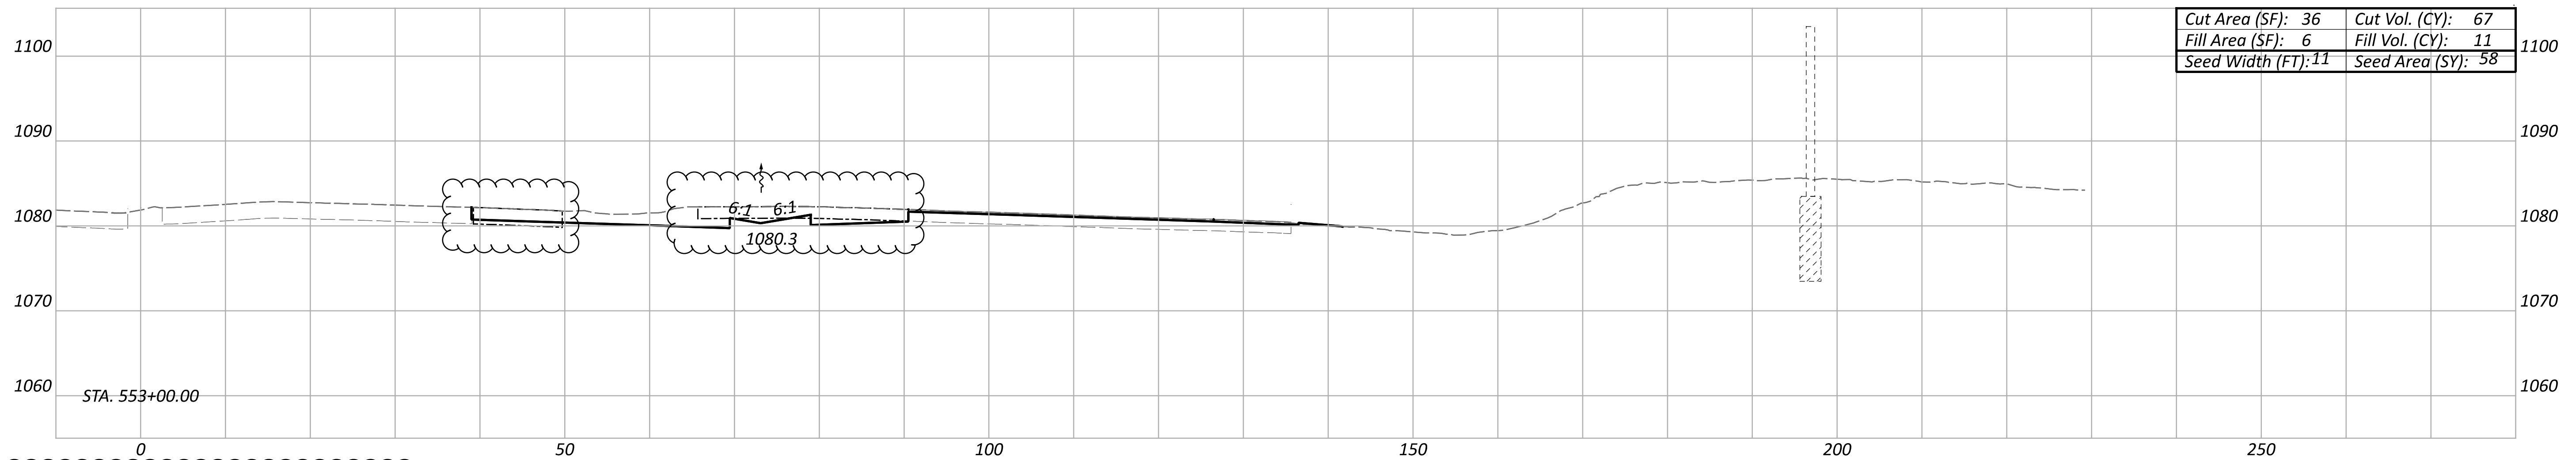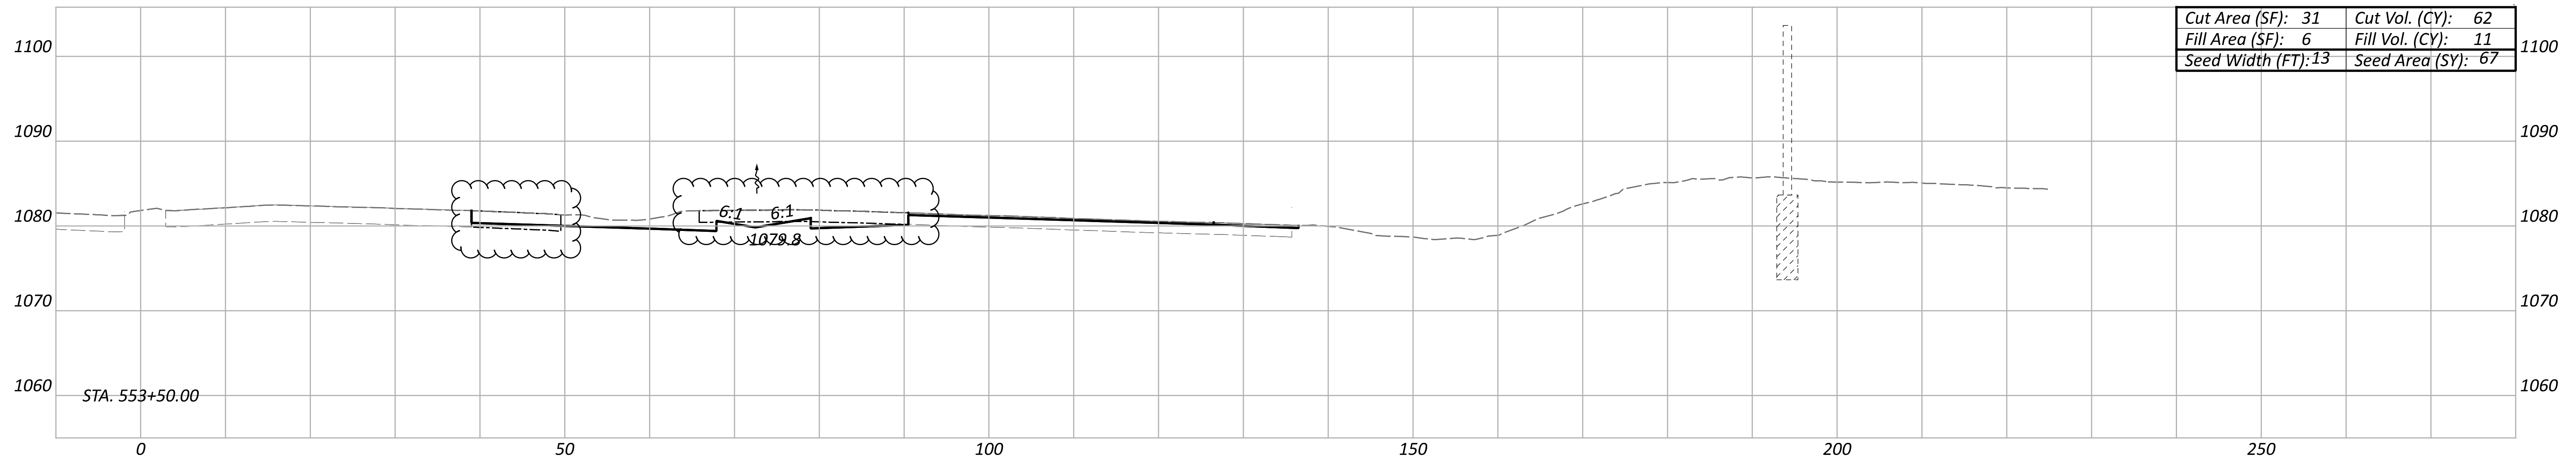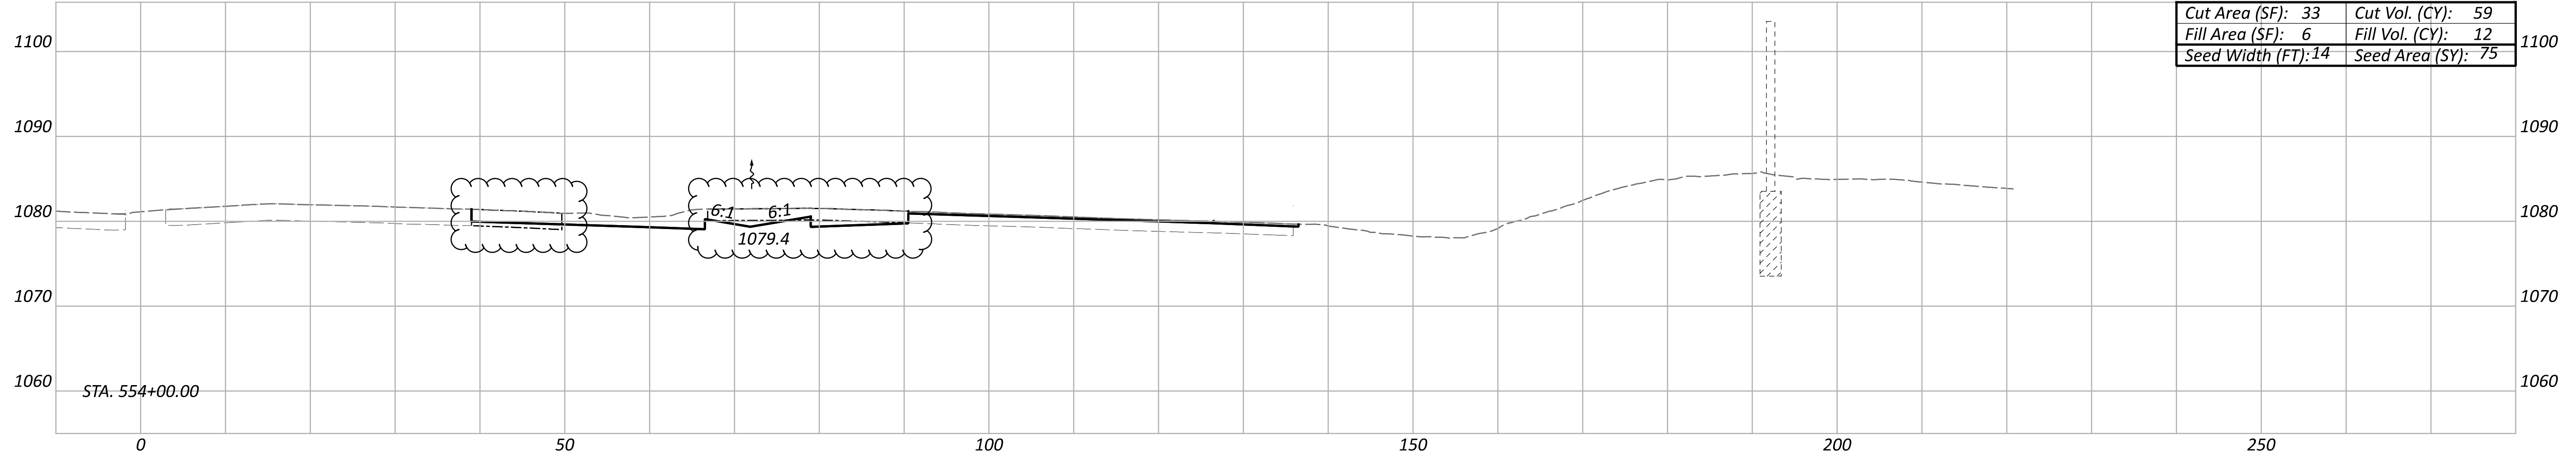

ITEM 202 - PAVEMENT REMOVED

CROSS SECTIONS
 STA. 553+00 TO STA. 554+00

DESIGN AGENCY






DESIGNER
 AS

REVIEWER
 KKP 12/31/22

PROJECT ID
 113156

Sheet Totals			SHEET TOTAL	
Seeding	Cut	Fill	SHEET	TOTAL
200	189	34	133	233

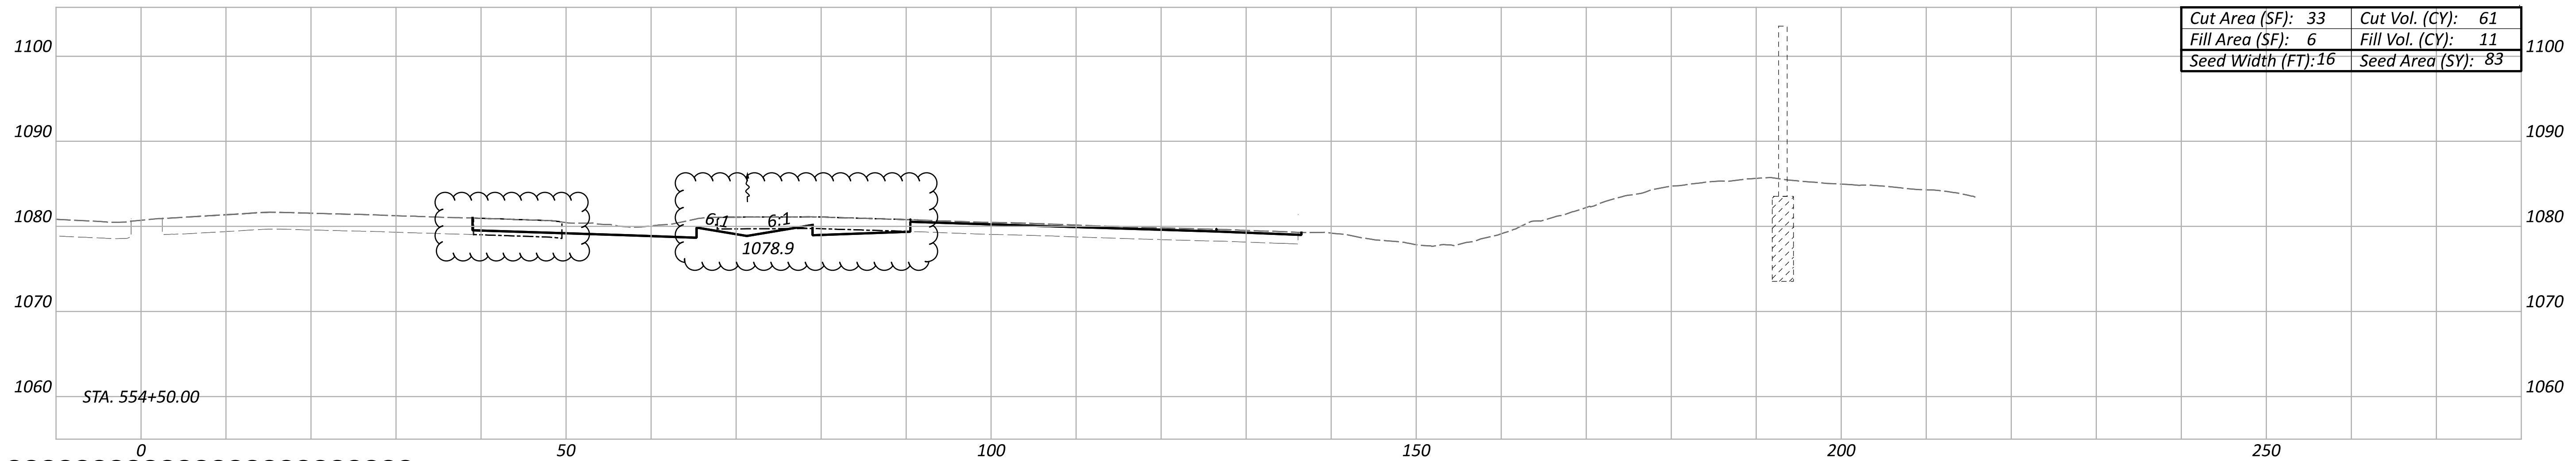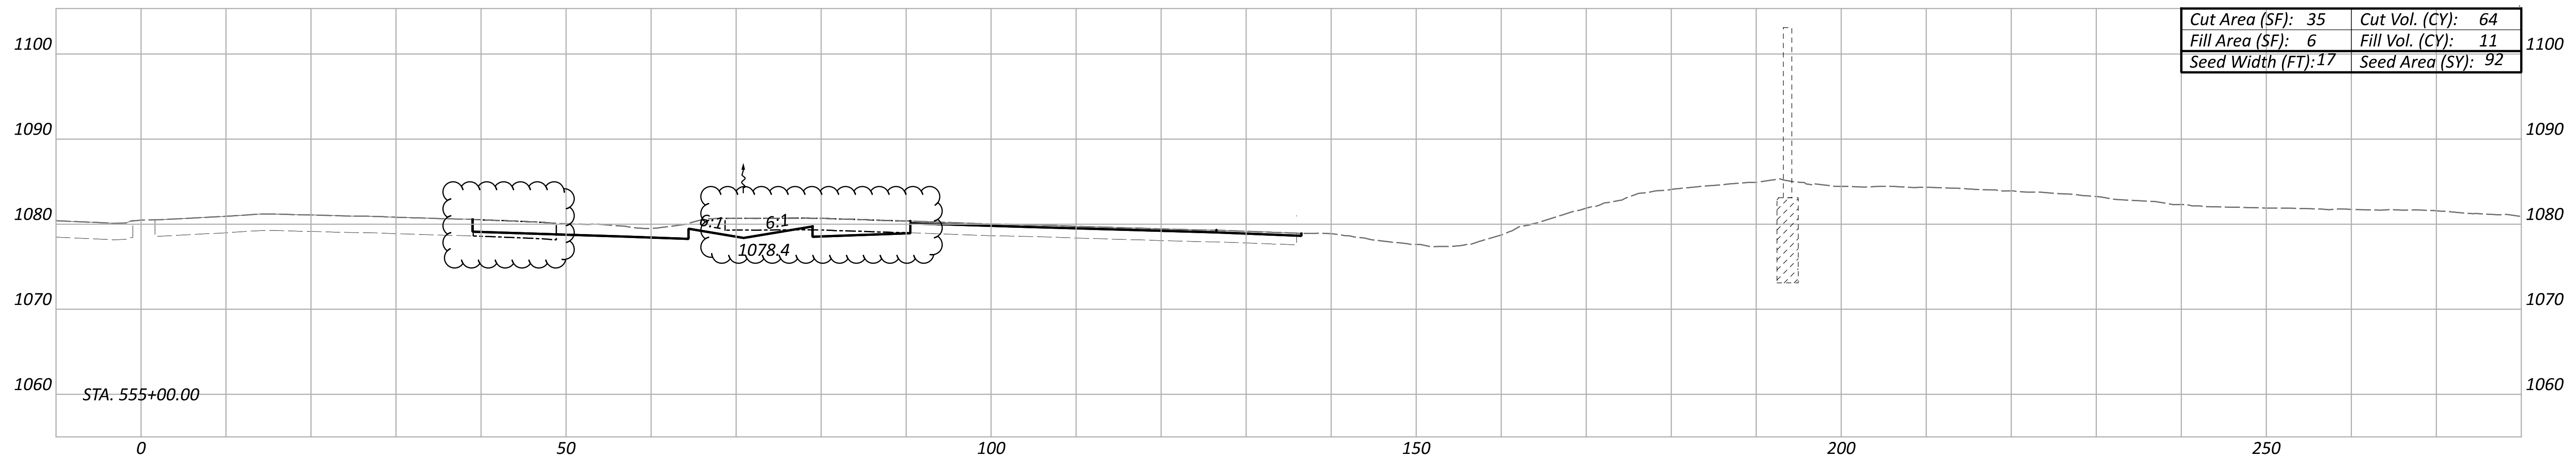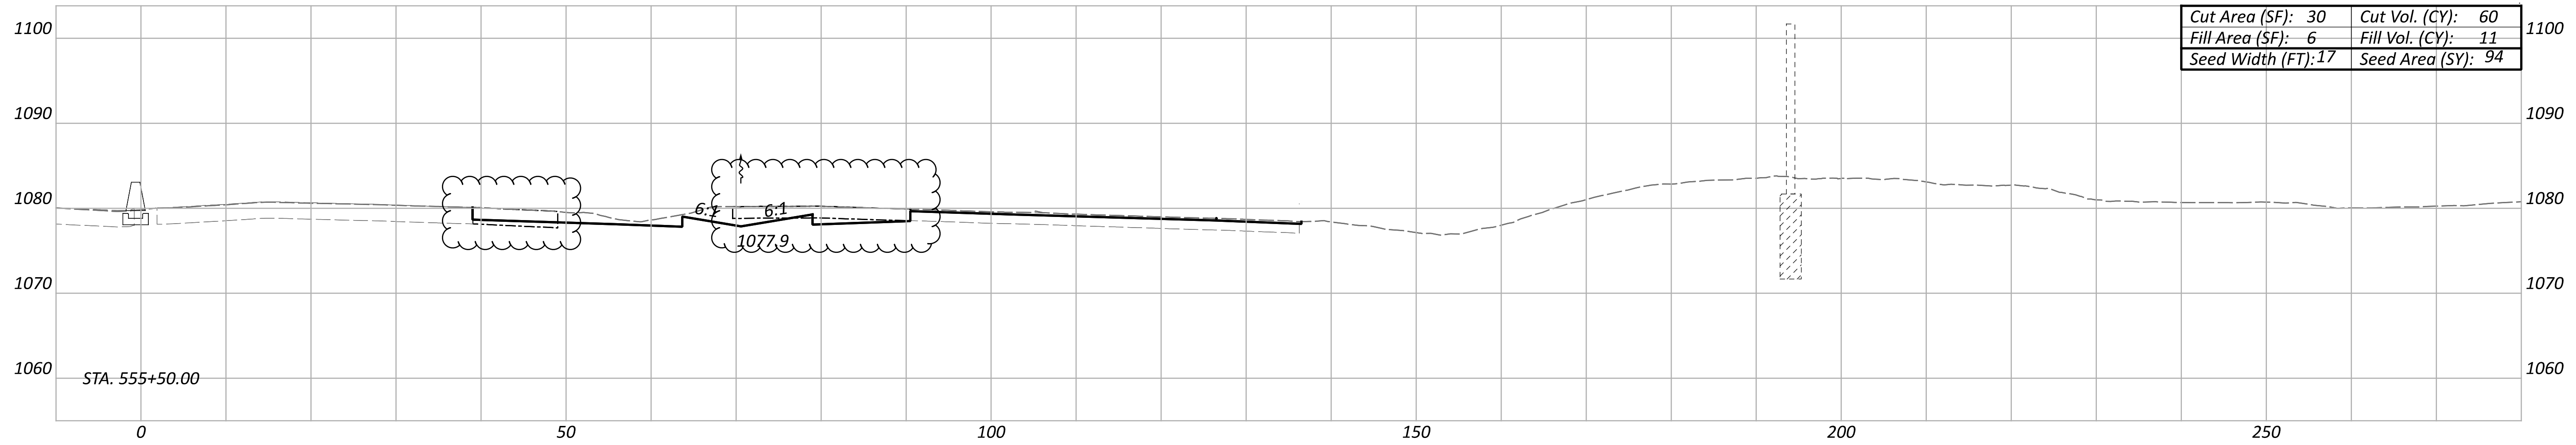

ITEM 202 - PAVEMENT REMOVED

CROSS SECTIONS
 STA. 554+50 TO STA. 555+50

DESIGN AGENCY



DESIGNER

AS




REVIEWER

KKP 12/31/22

PROJECT ID

113156

Sheet Totals			SHEET TOTAL	
Seeding	Cut	Fill	134	233
269	185	33		

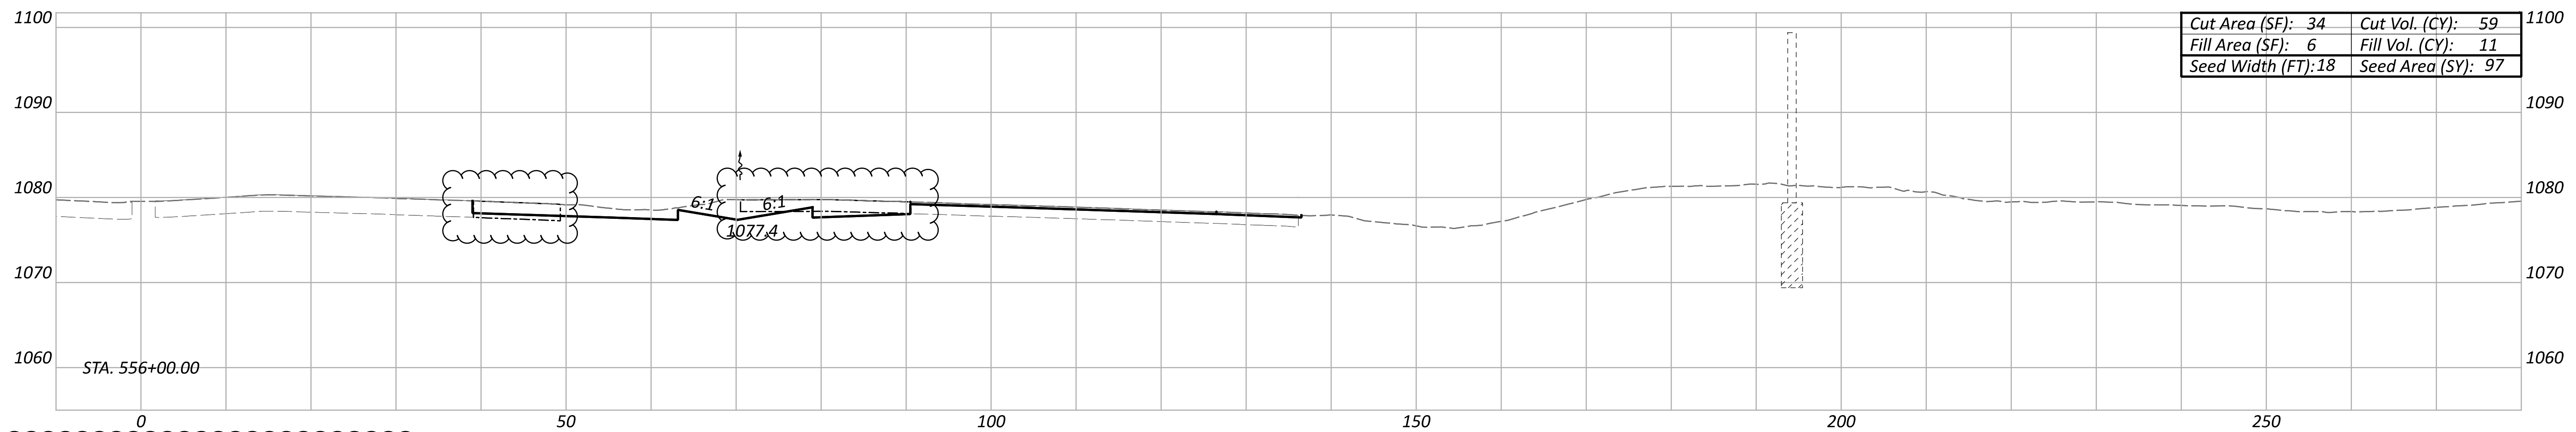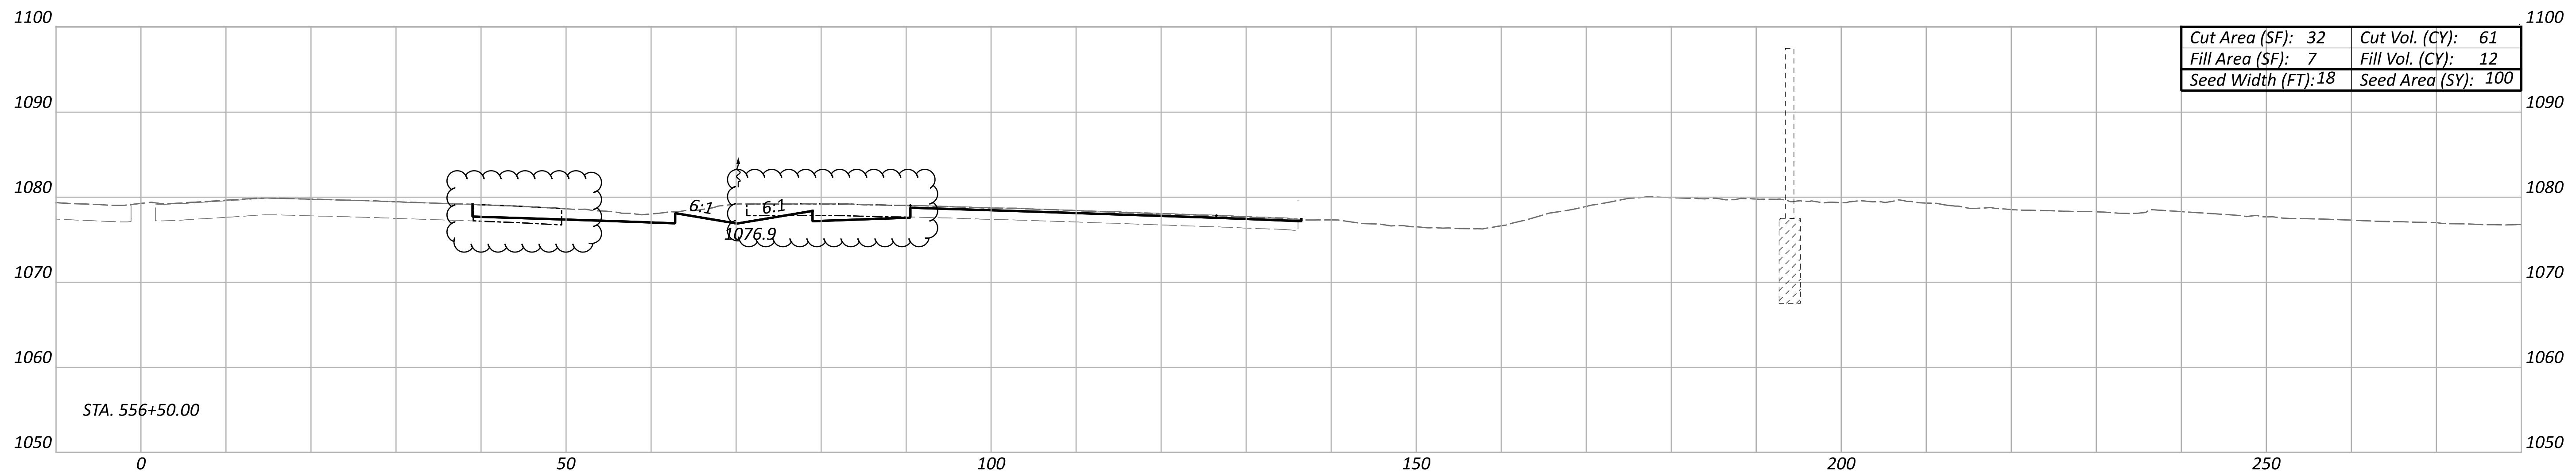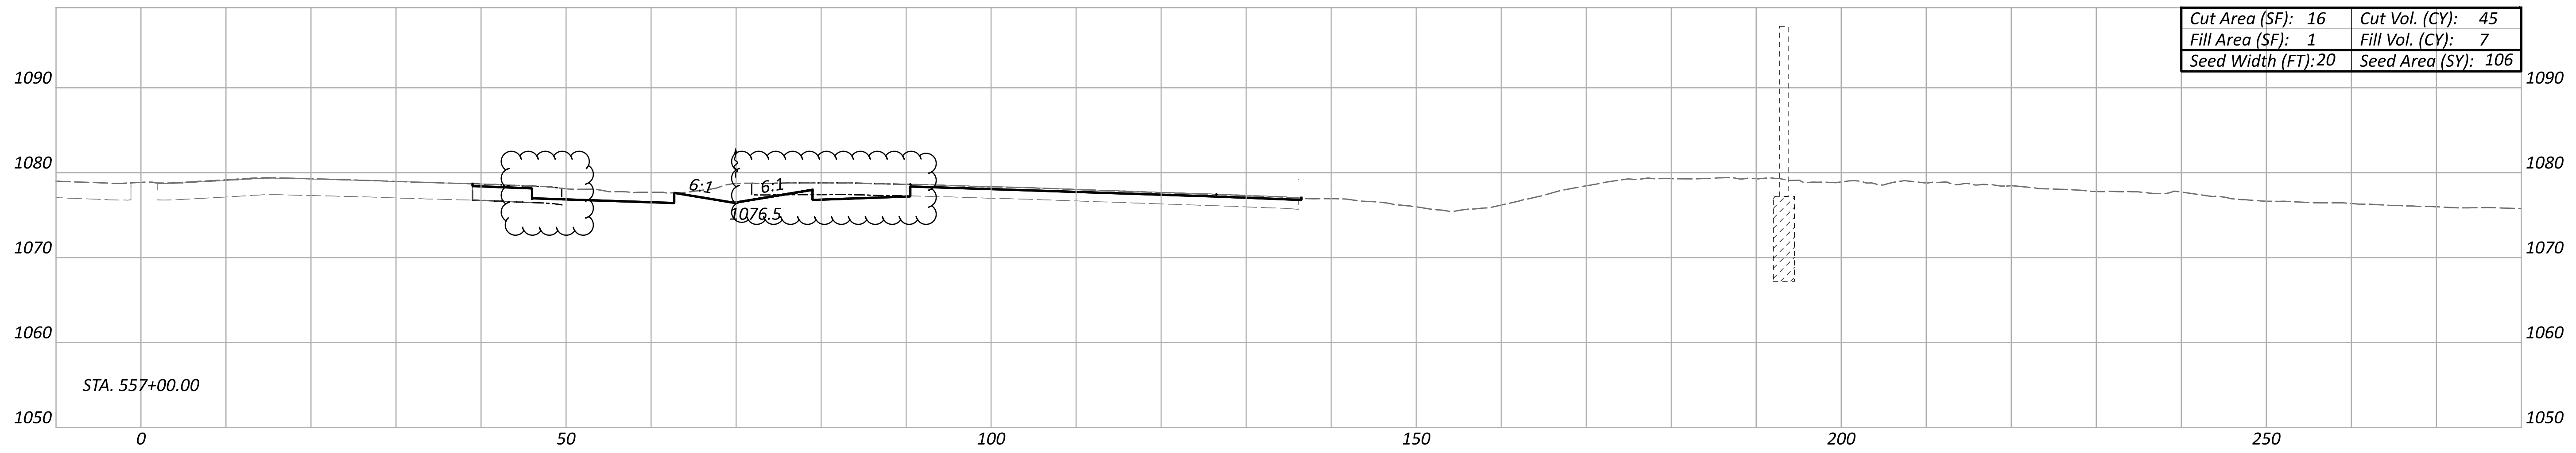

ITEM 202 - PAVEMENT REMOVED

CROSS SECTIONS
 STA. 556+00 TO STA. 557+00

DESIGN AGENCY



DESIGNER

AS




REVIEWER

KKP 12/31/22

PROJECT ID

113156

Sheet Totals			SHEET	TOTAL
Seeding	Cut	Fill	135	233
303	165	31		

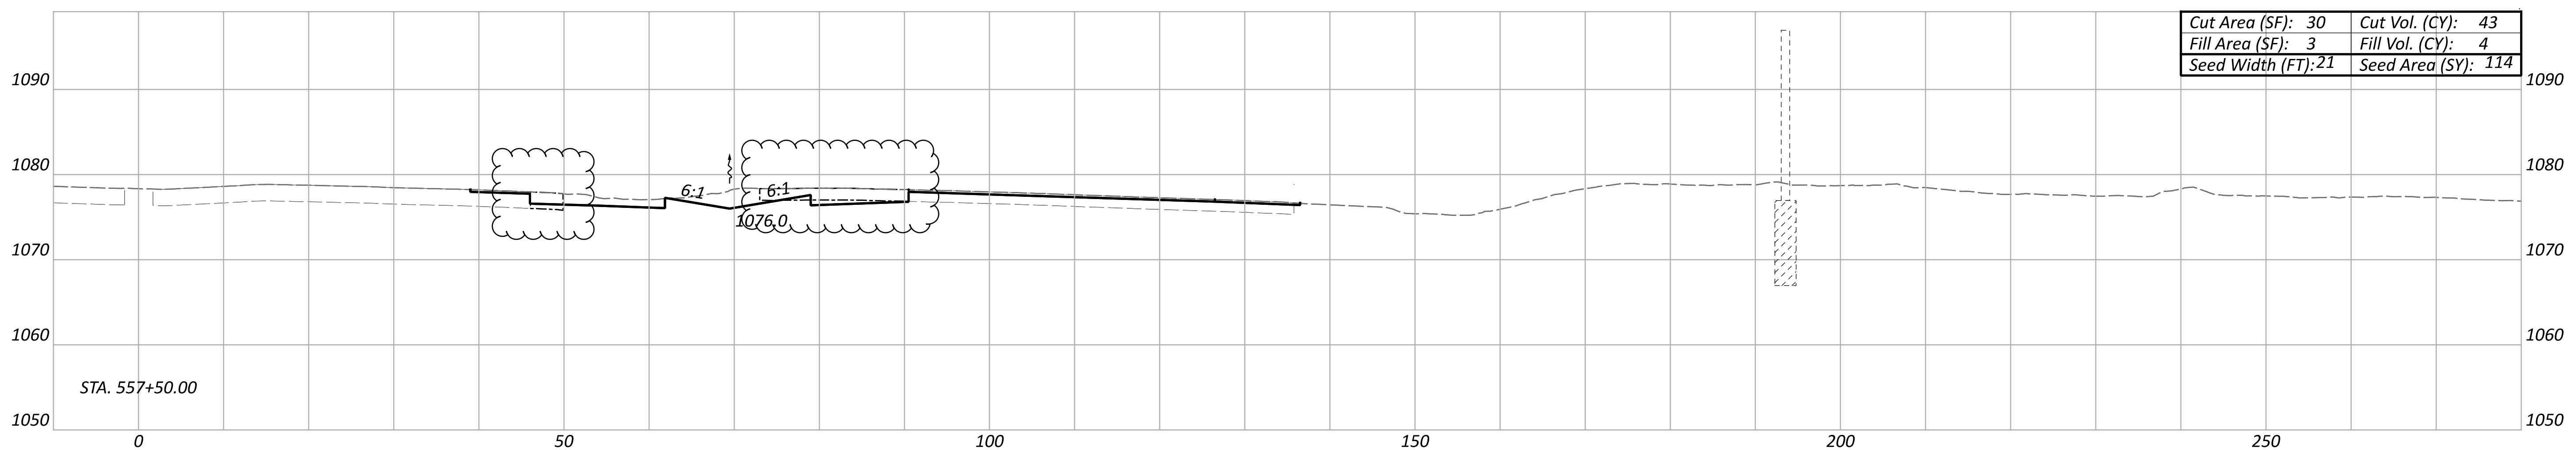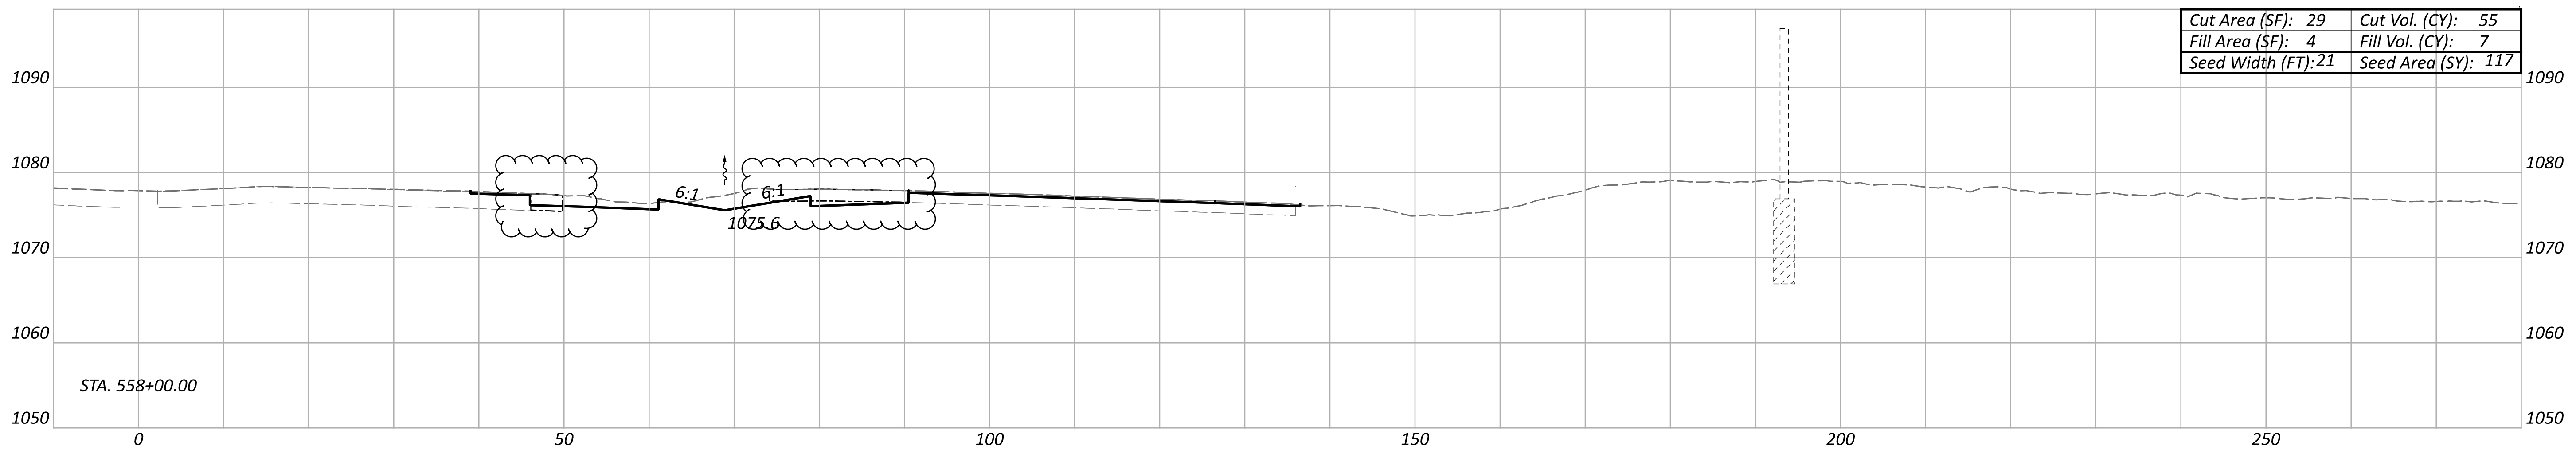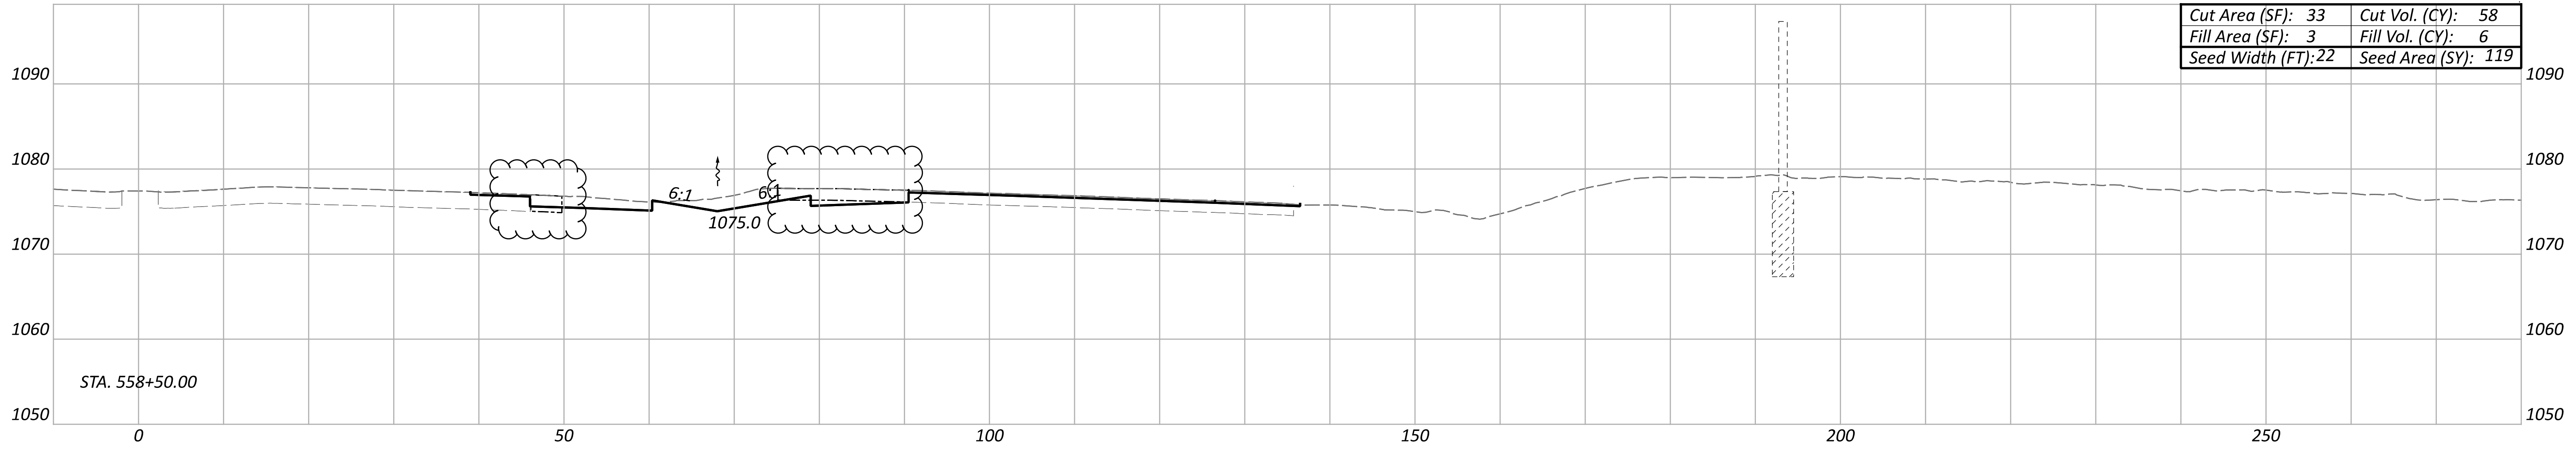

ITEM 202 - PAVEMENT REMOVED

CROSS SECTIONS
 STA. 557+50 TO STA. 558+50

DESIGN AGENCY



DESIGNER

AS

REVIEWER




KKP 12/31/22

PROJECT ID

113156

Sheet Totals		
Seeding	Cut	Fill
350	156	17

SHEET	TOTAL
136	233

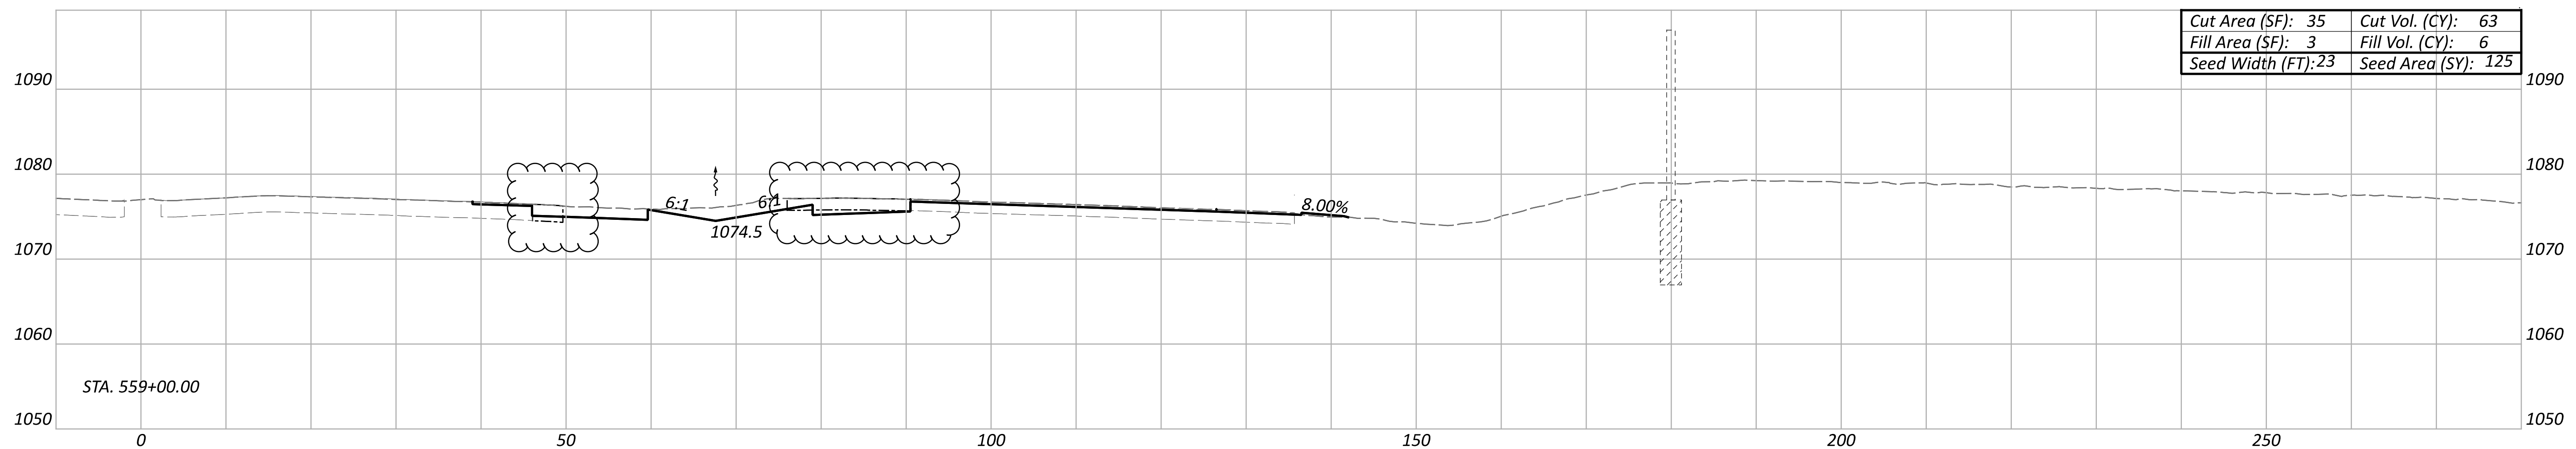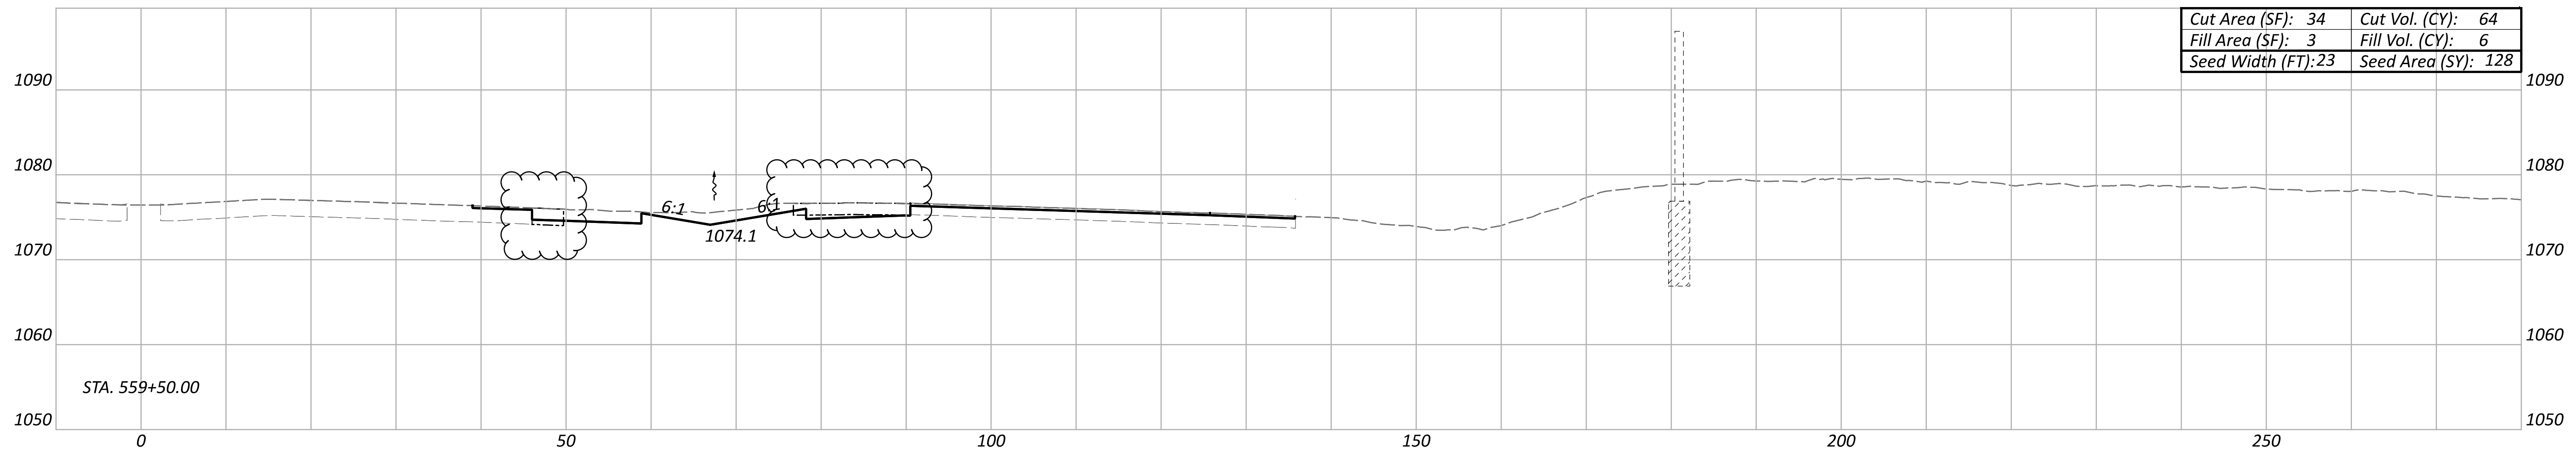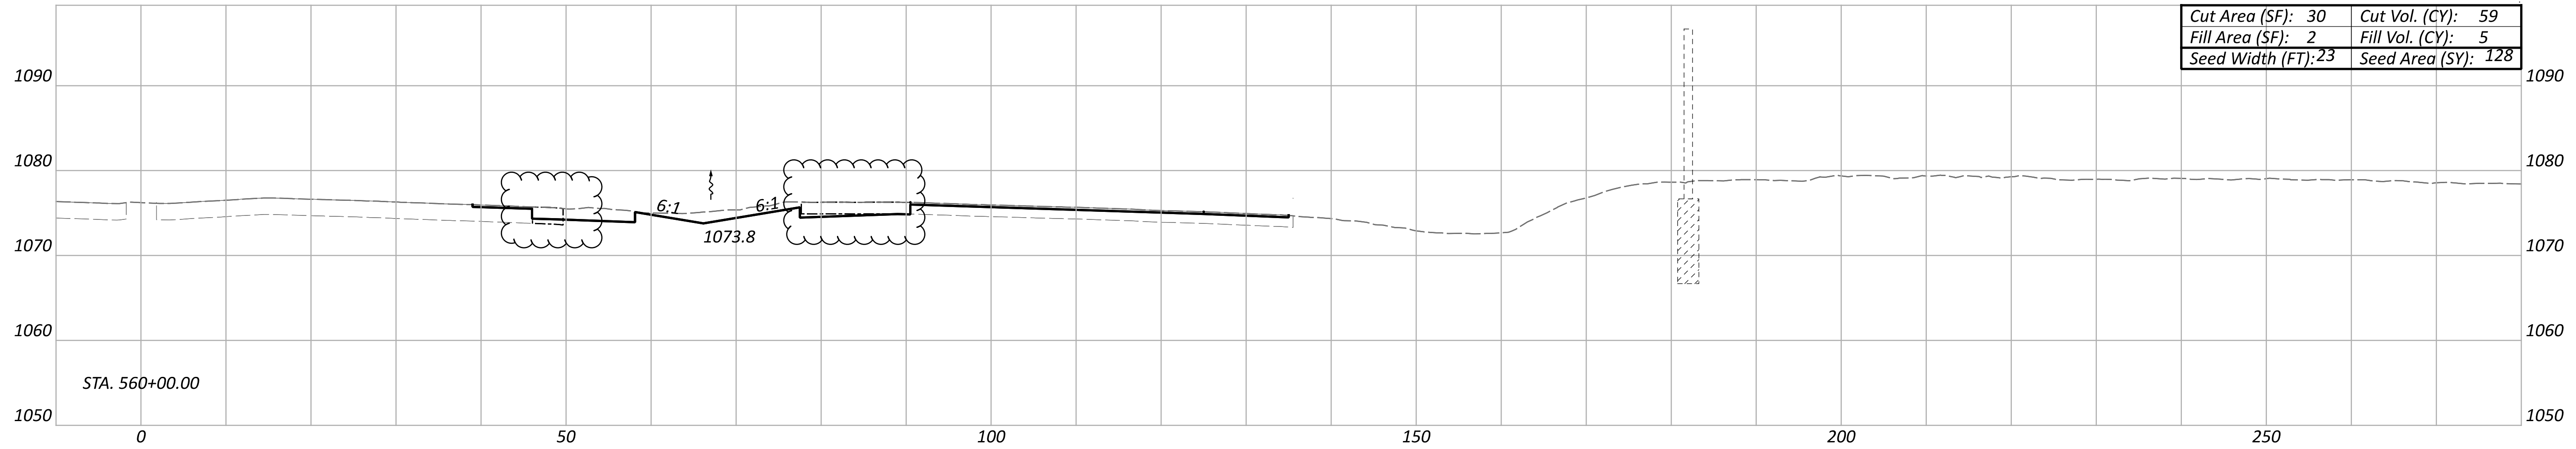

ITEM 202 - PAVEMENT REMOVED

CROSS SECTIONS
 STA. 559+00 TO STA. 560+00

DESIGN AGENCY



DESIGNER

AS

REVIEWER




KKP 12/31/22

PROJECT ID

113156

Sheet Totals		
Seeding	Cut	Fill
381	186	17

SHEET	TOTAL
137	233

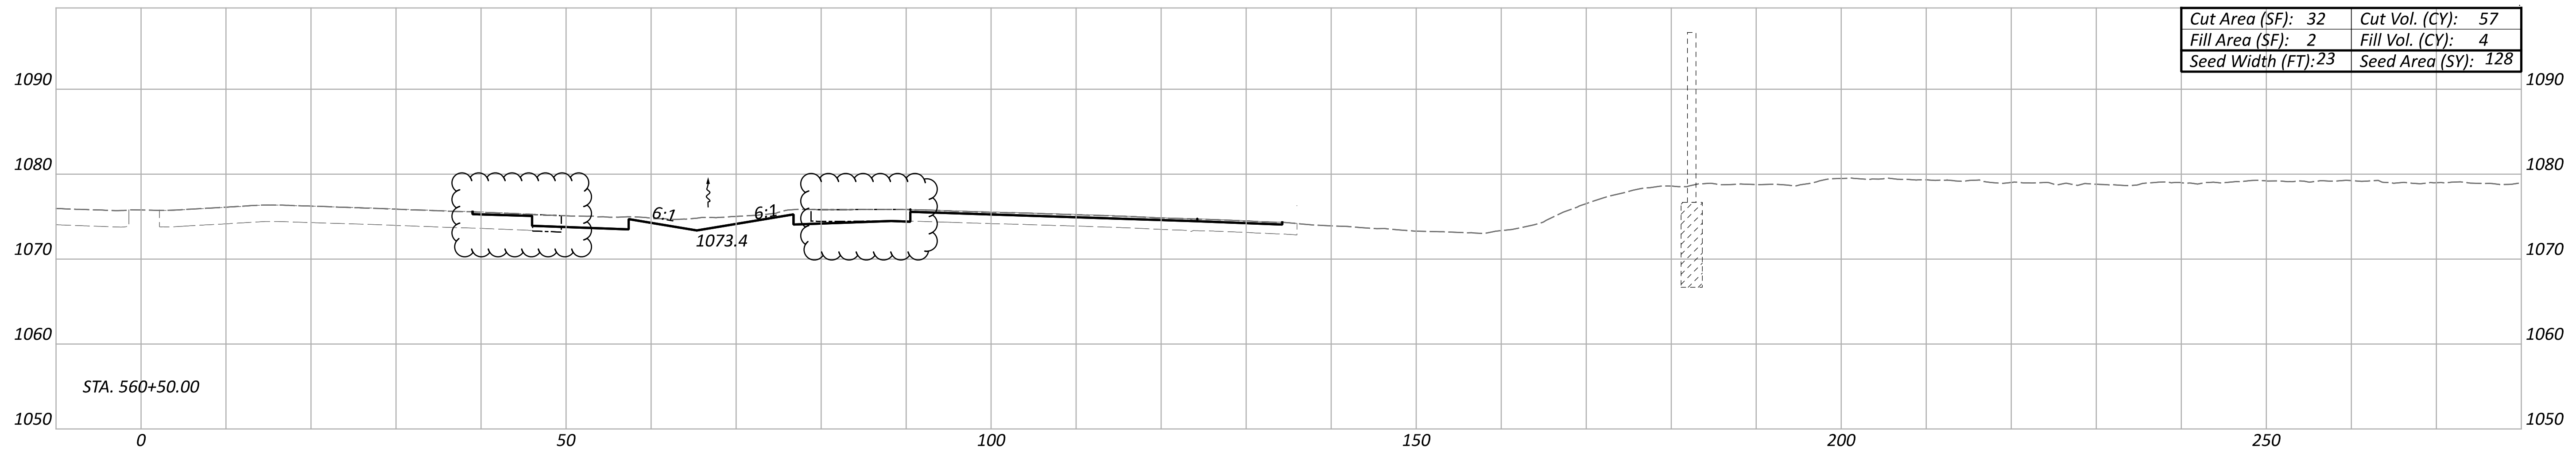
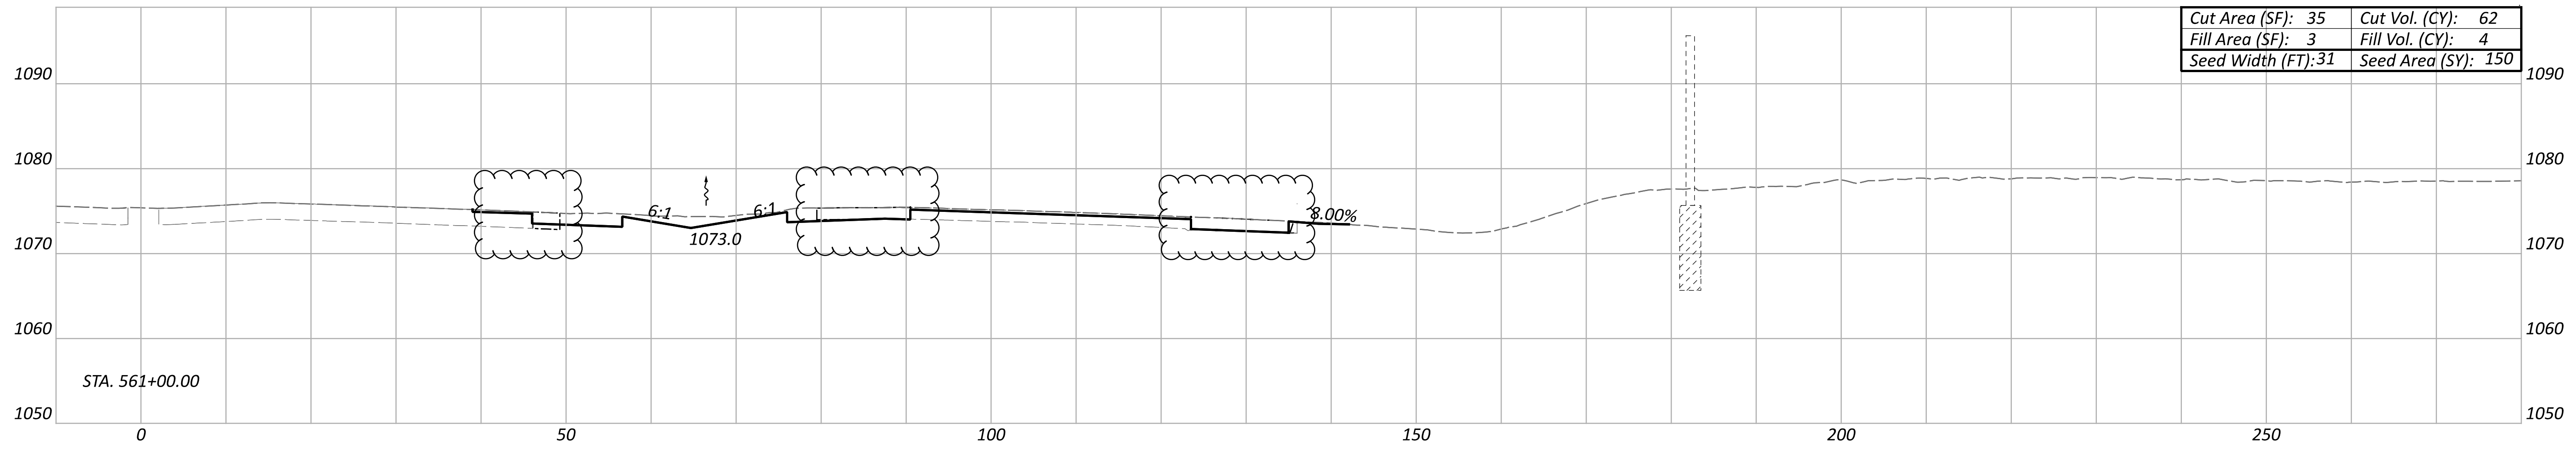
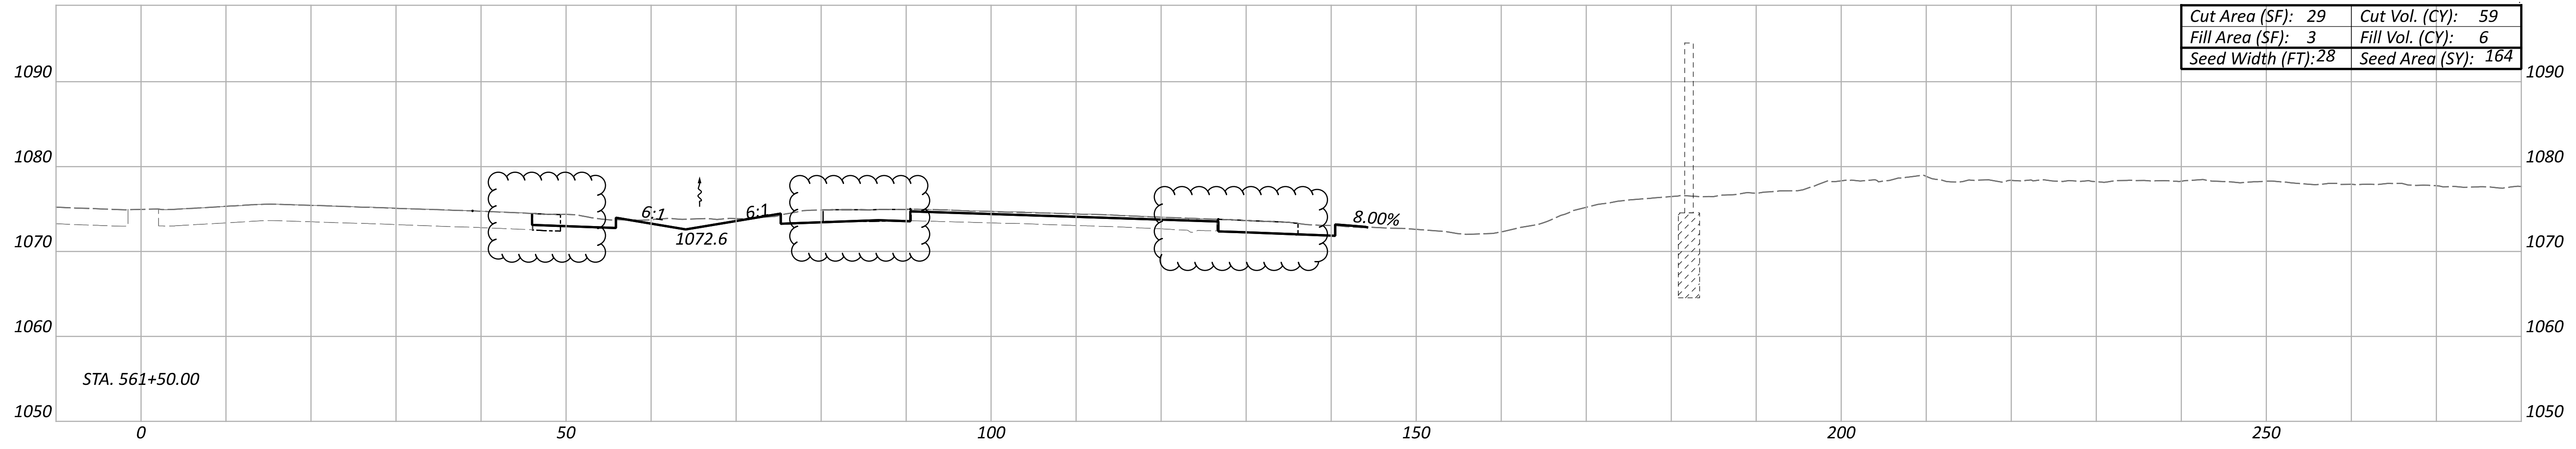


ITEM 202 - PAVEMENT REMOVED

CROSS SECTIONS
 STA. 560+50 TO STA 561+50

DESIGN AGENCY
HNTB
 DESIGNER
 AS
 REVIEWER
 KKP 12/31/22
 PROJECT ID
 113156

Sheet Totals			SHEET TOTAL	
Seeding	Cut	Fill	138	233
442	179	14		

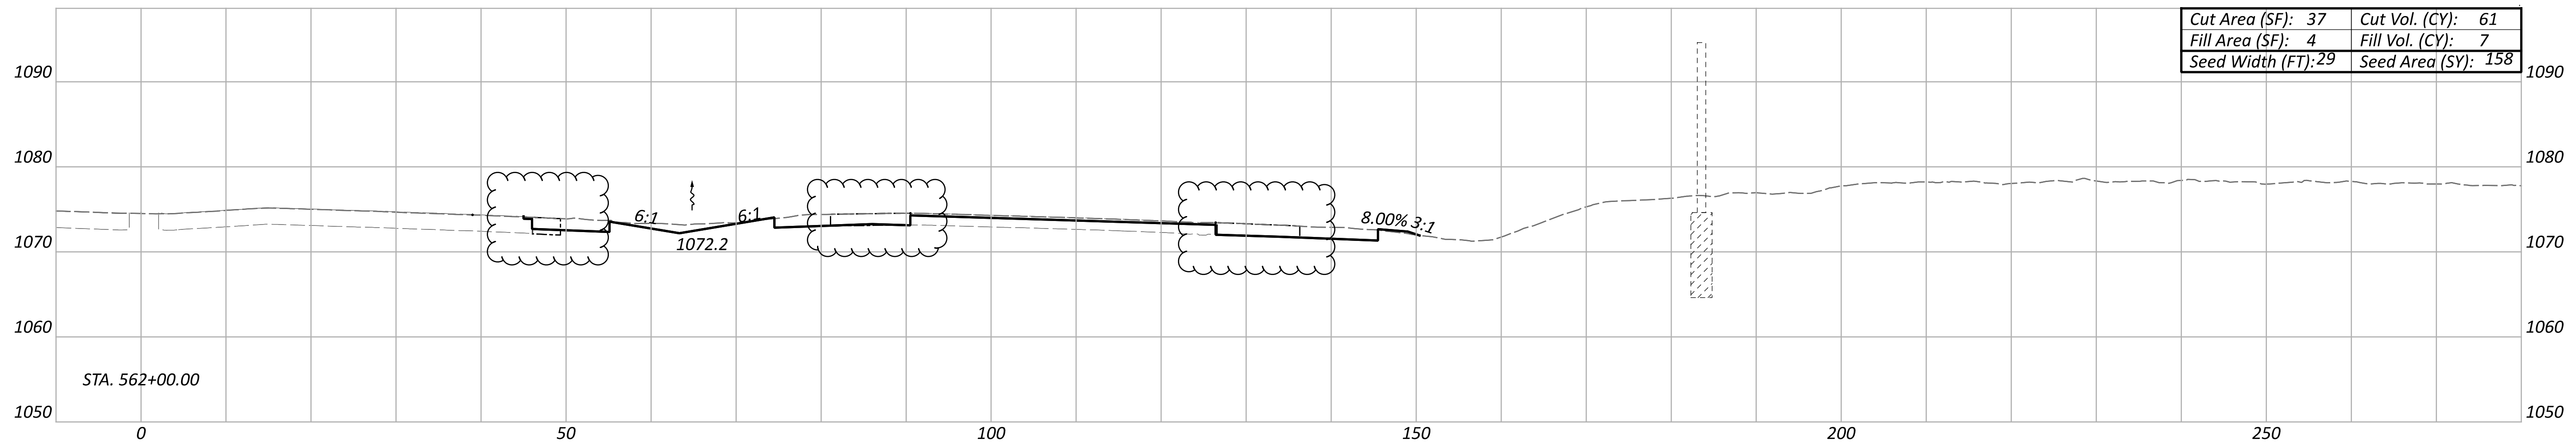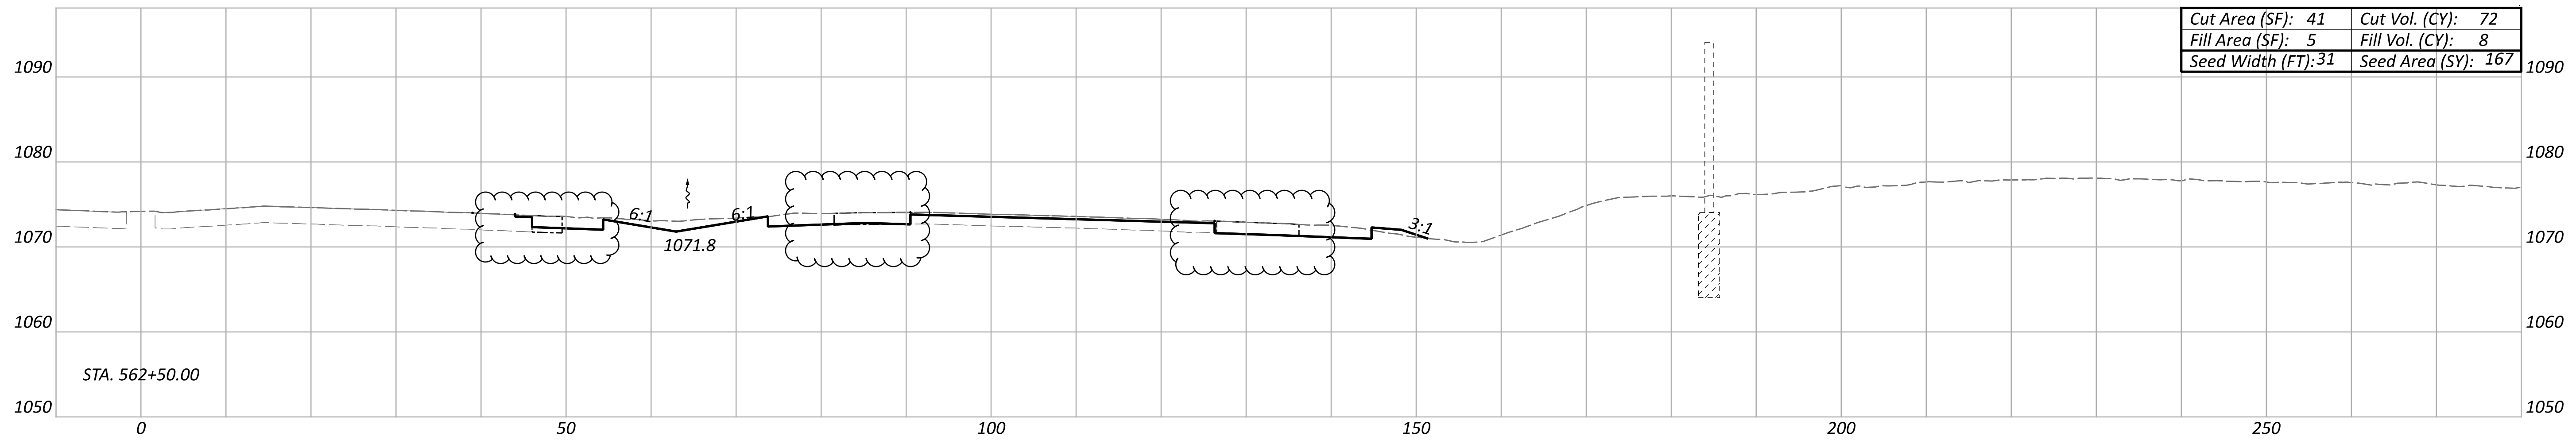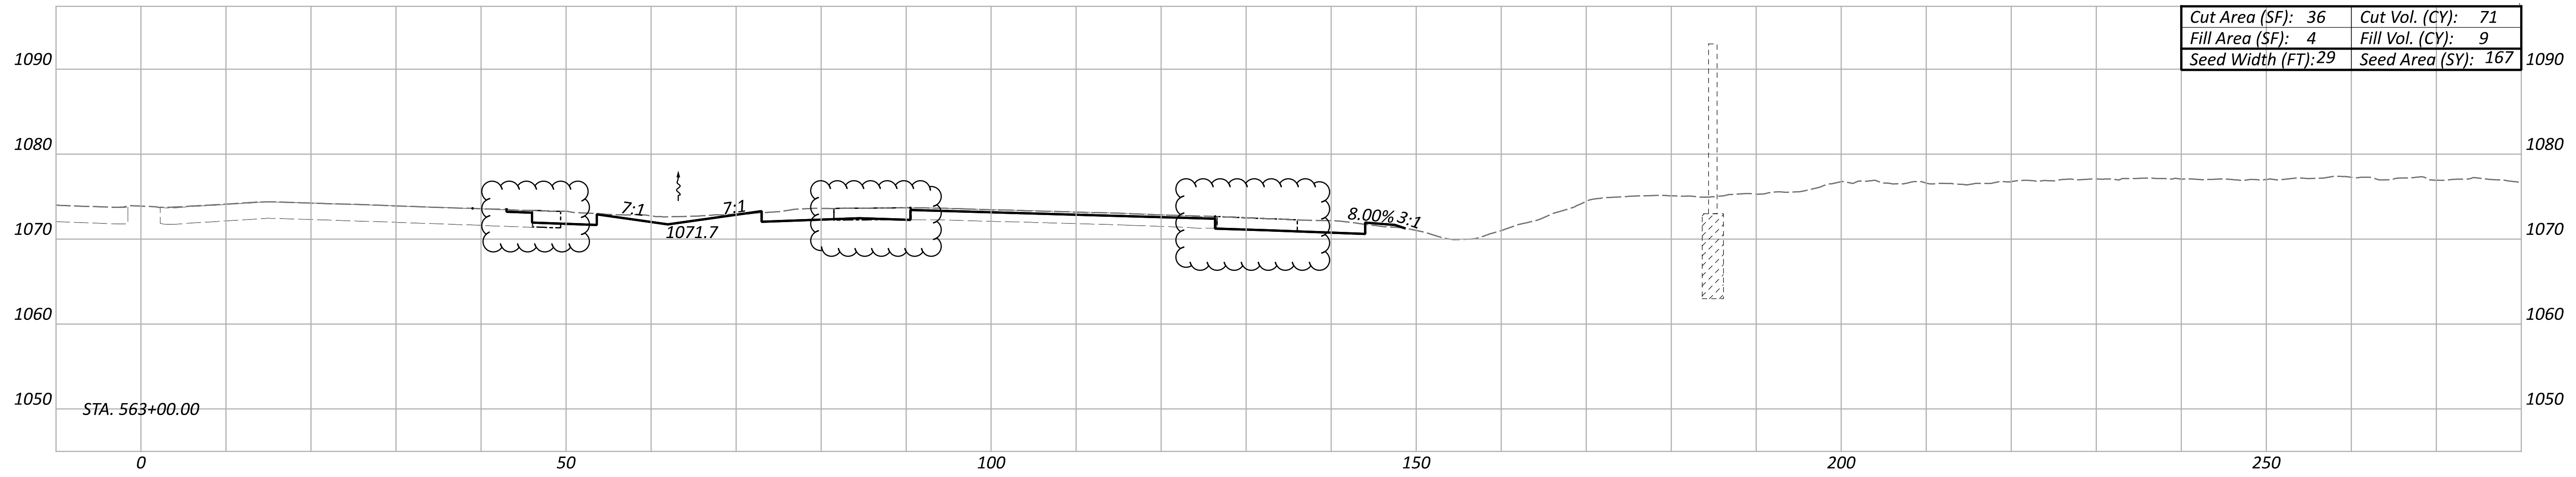

ITEM 202 - PAVEMENT REMOVED

CROSS SECTIONS
 STA. 562+00 TO STA. 563+00

DESIGN AGENCY



DESIGNER

AS

REVIEWER




KKP 12/31/22

PROJECT ID

113156

Sheet Totals		
Seeding	Cut	Fill
492	204	24

SHEET	TOTAL
139	233

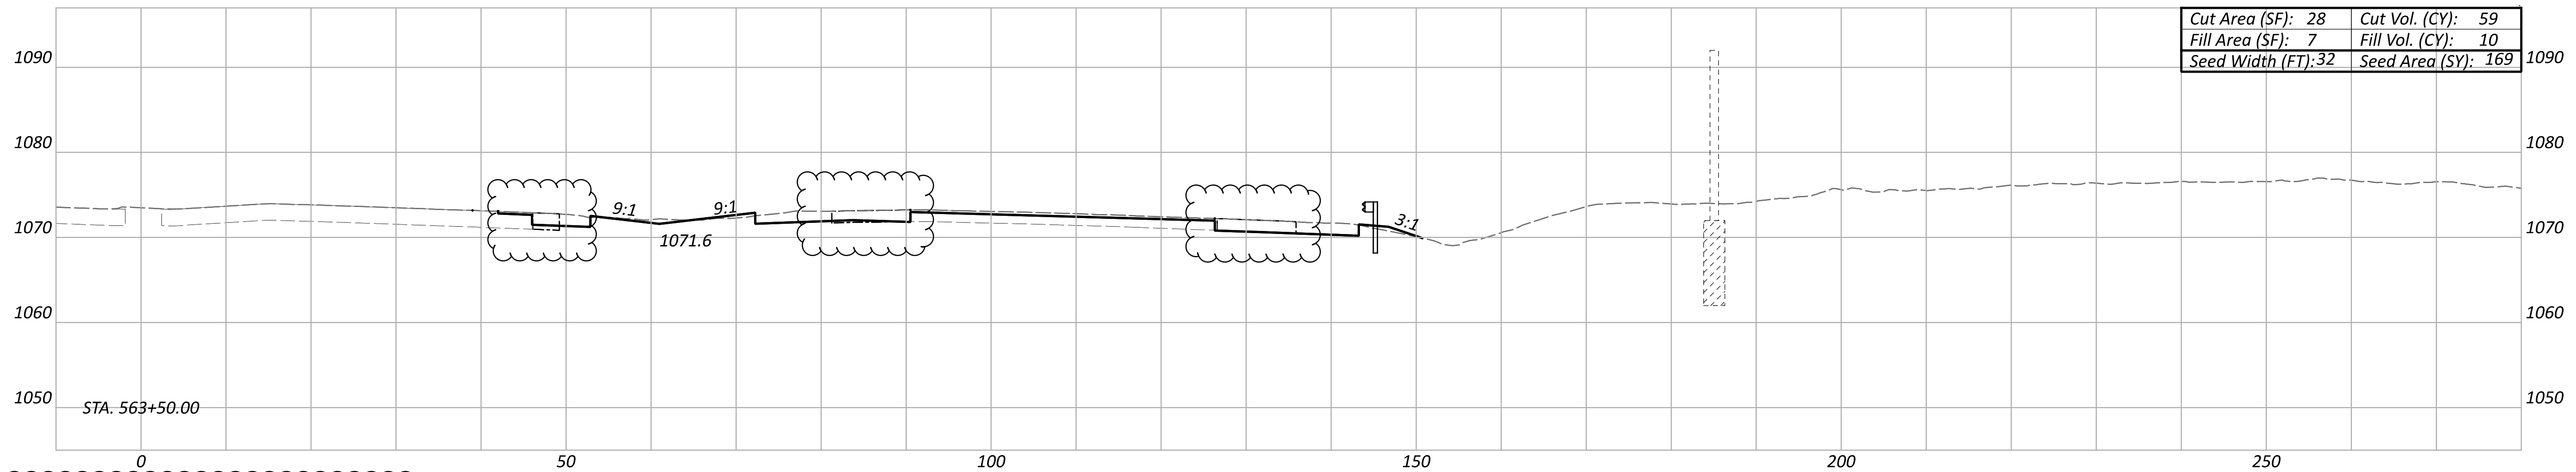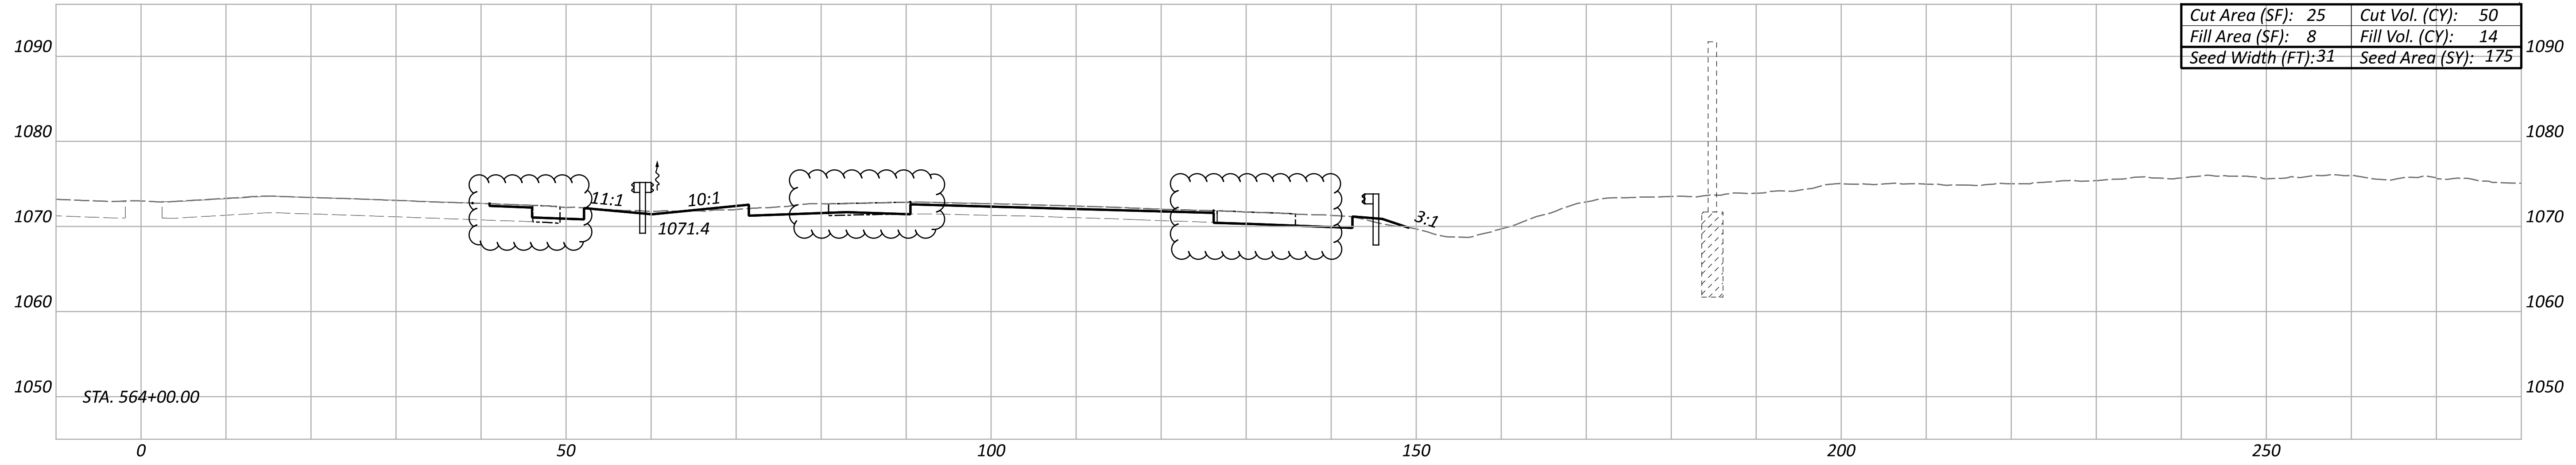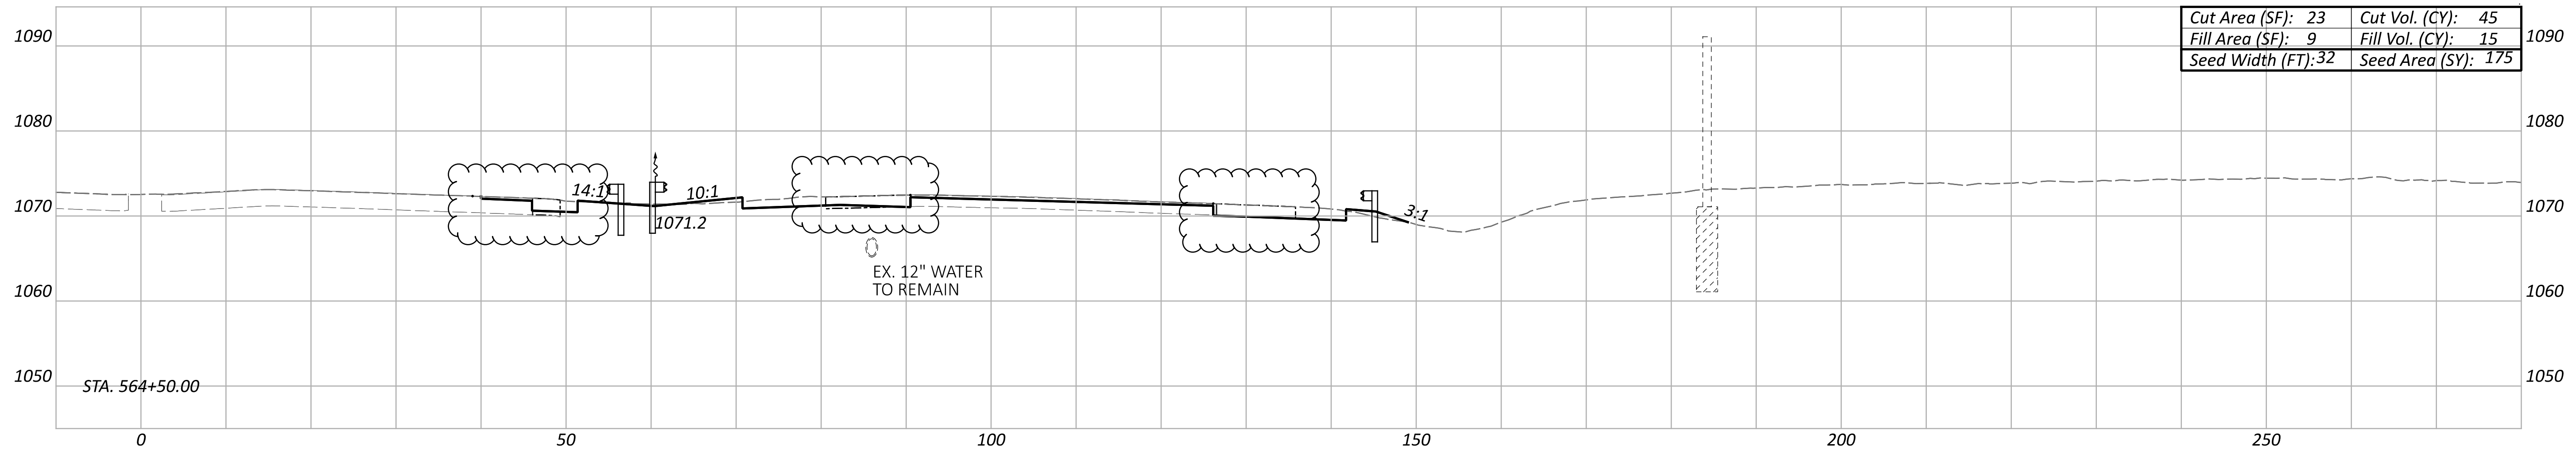

ITEM 202 - PAVEMENT REMOVED

CROSS SECTIONS
 STA. 563+50 TO STA. 564+50

DESIGN AGENCY



DESIGNER

AS




REVIEWER

KKP 12/31/22

PROJECT ID

113156

Sheet Totals			SHEET TOTAL	
Seeding	Cut	Fill	140	233
519	153	39		

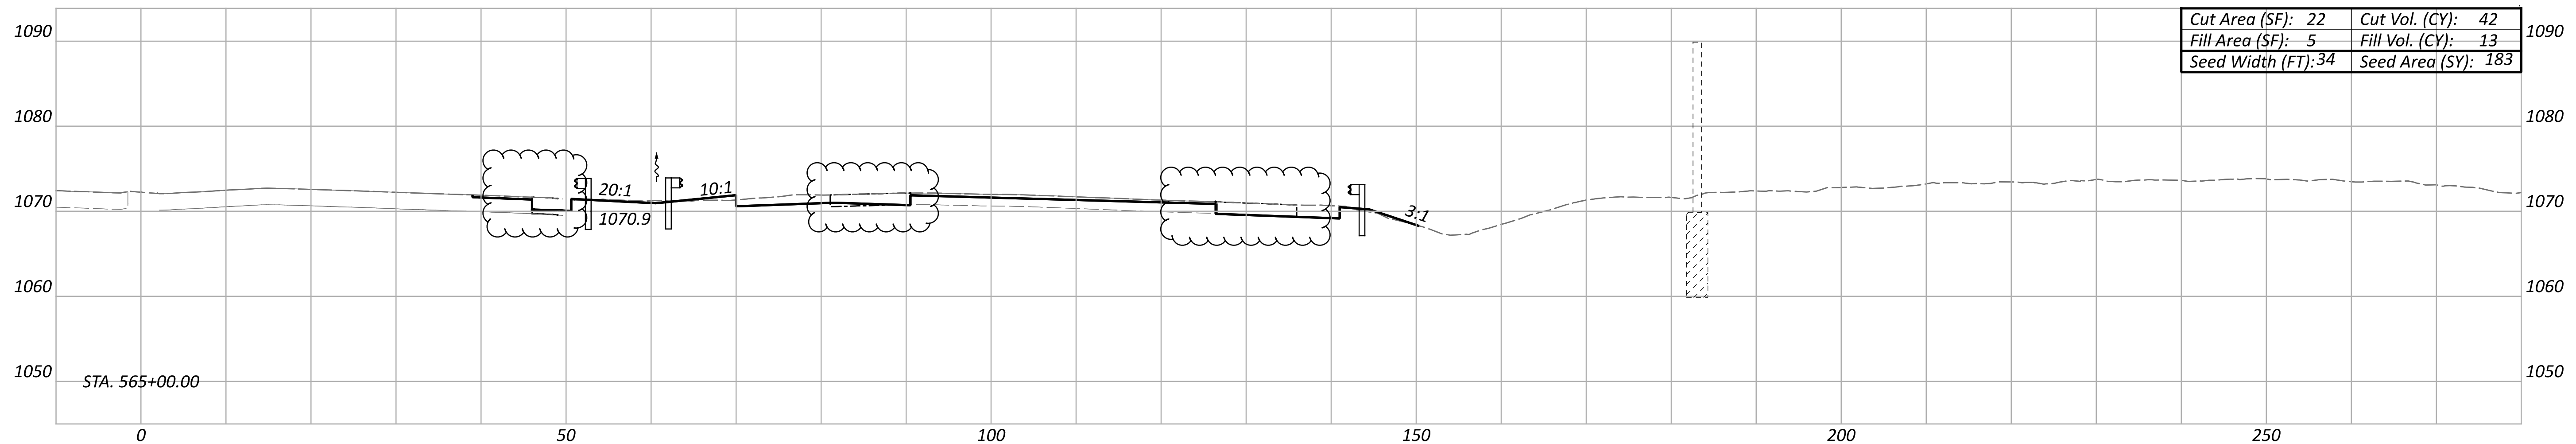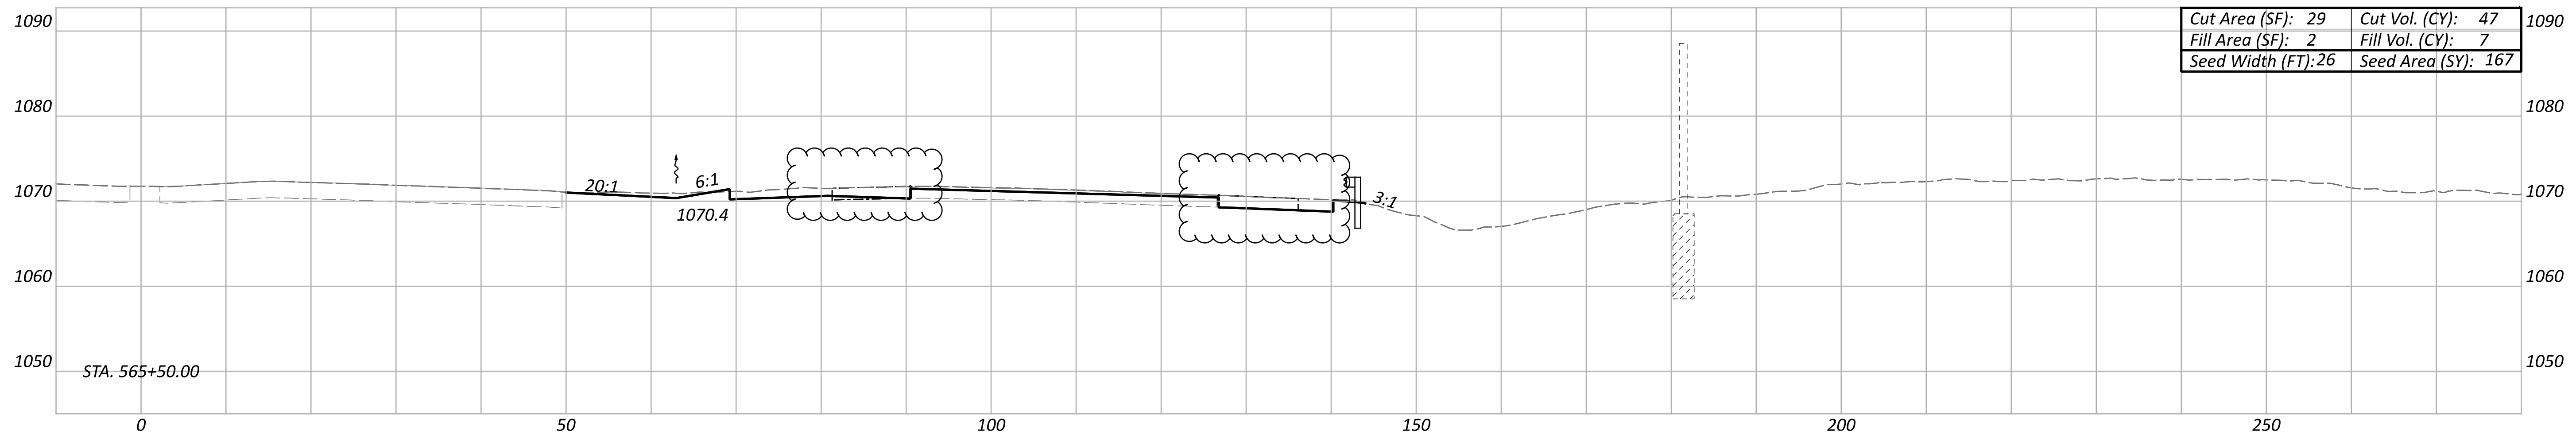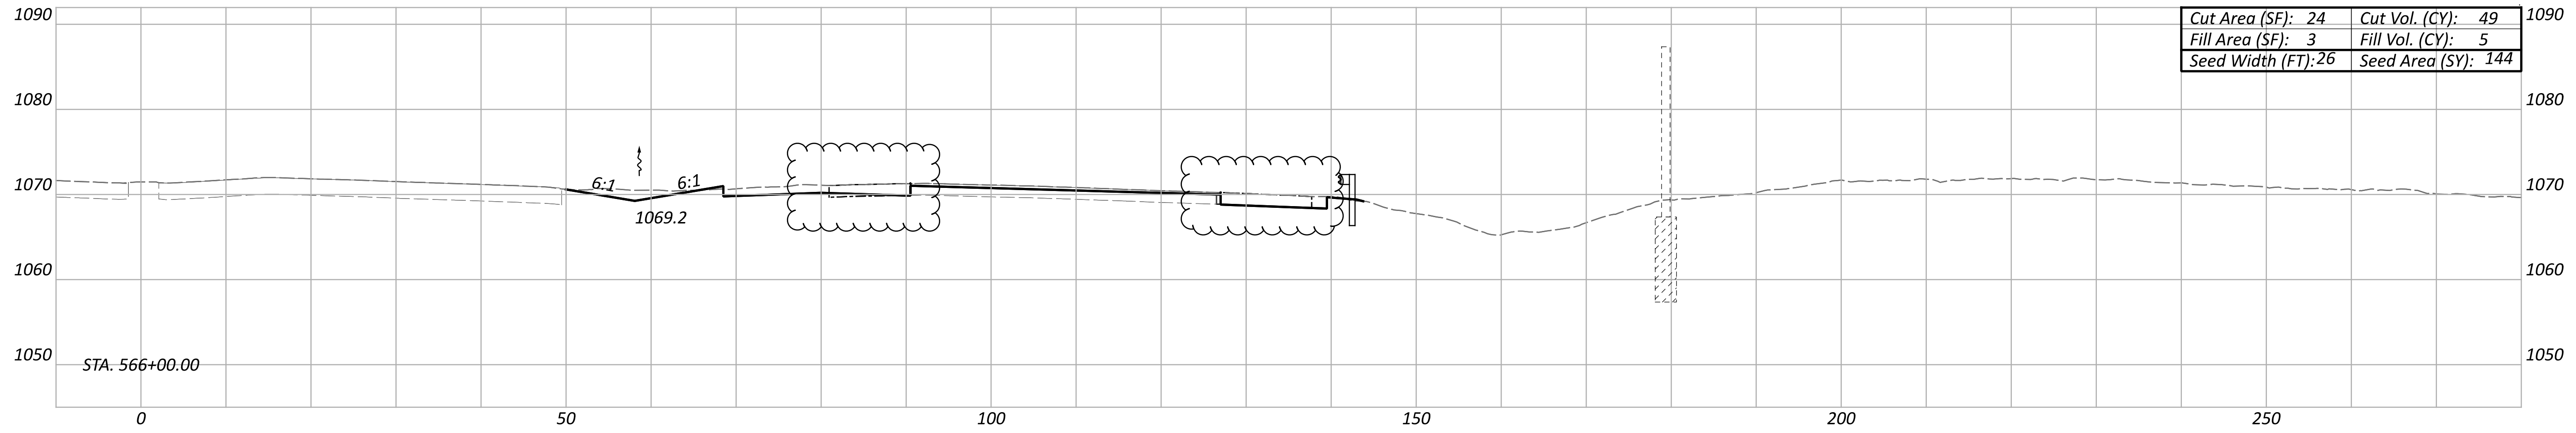

ITEM 202 - PAVEMENT REMOVED

CROSS SECTIONS
 STA. 565+00 TO STA. 566+00

DESIGN AGENCY



DESIGNER

AS




REVIEWER

KKP 12/31/22

PROJECT ID

113156

Sheet Totals			SHEET	TOTAL
Seeding	Cut	Fill	141	233
494	139	25		

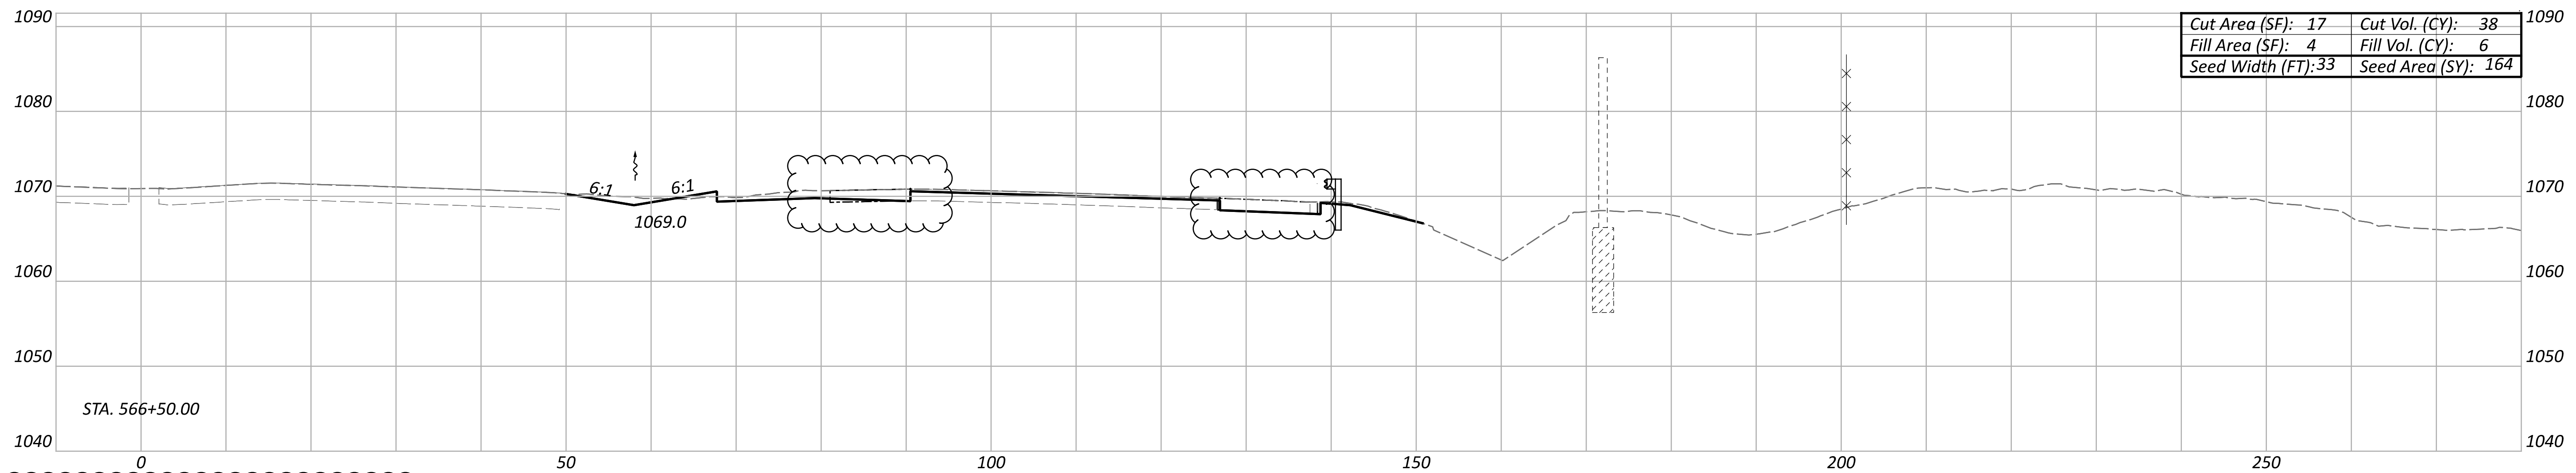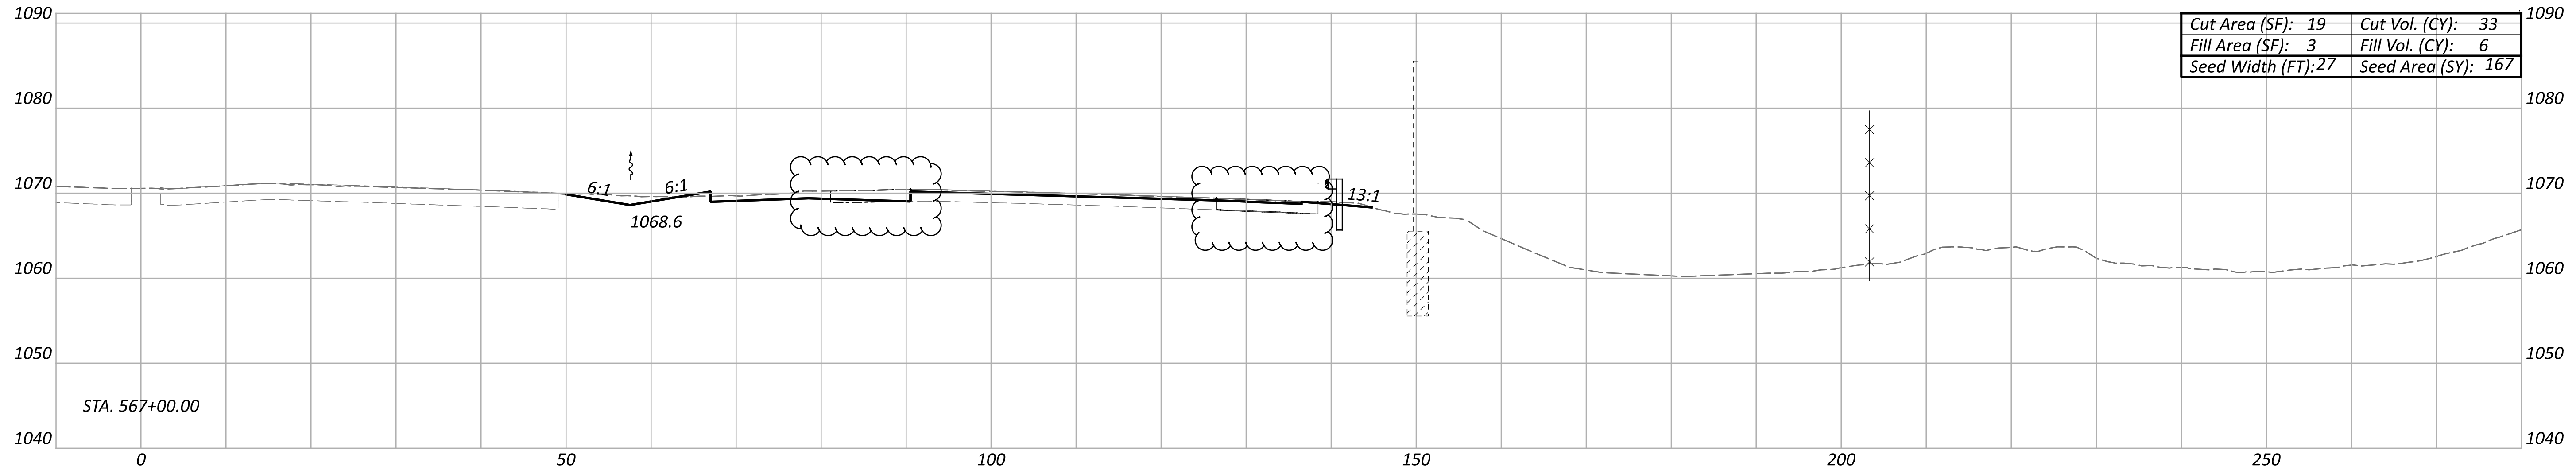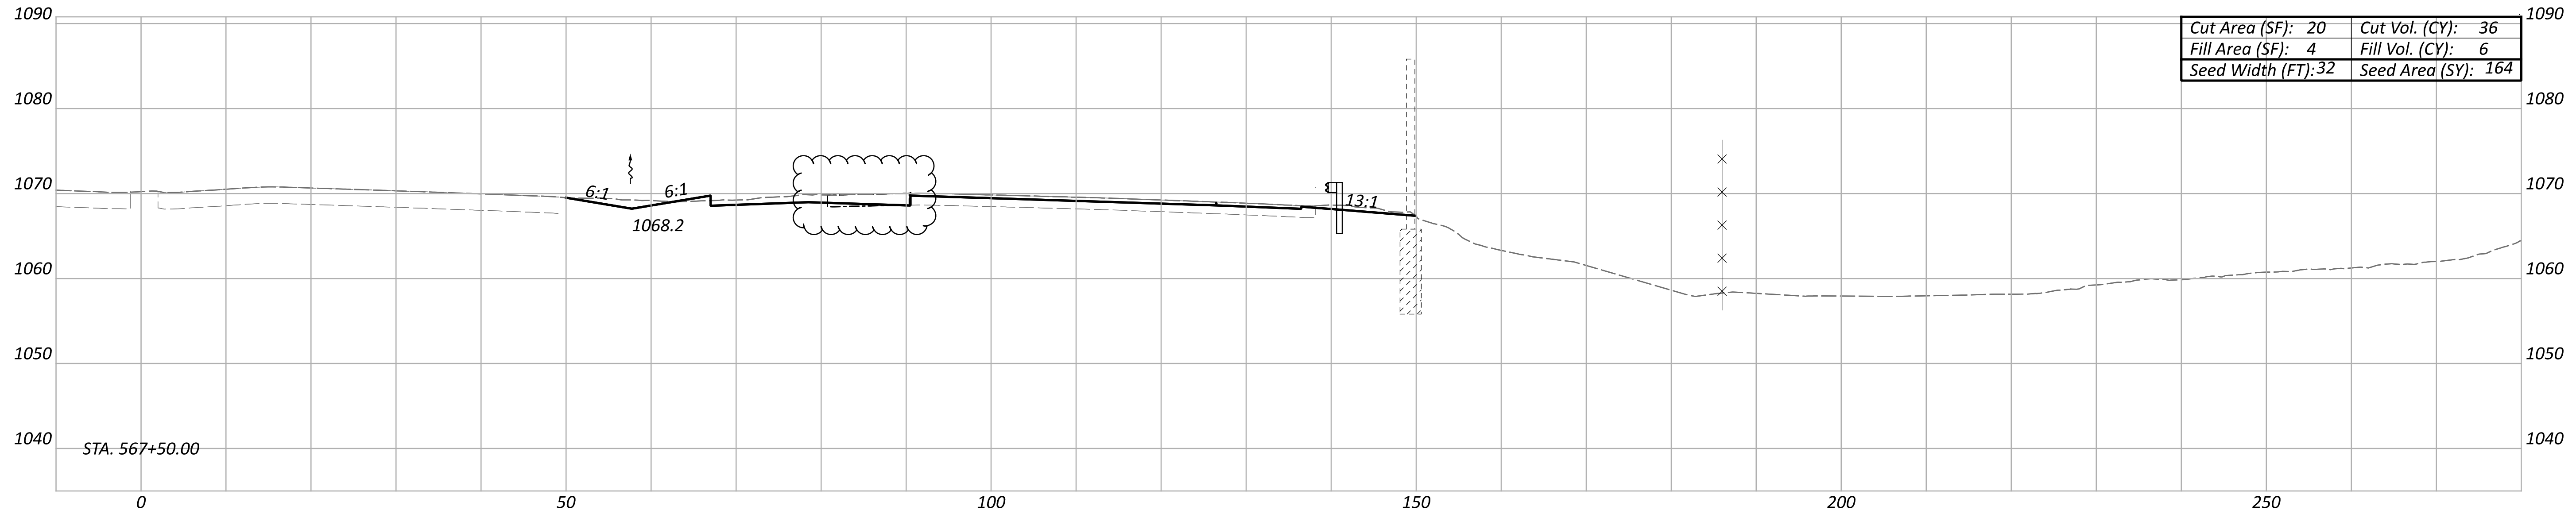

ITEM 202 - PAVEMENT REMOVED

CROSS SECTIONS
 STA. 566+50 TO STA. 567+50

DESIGN AGENCY



DESIGNER

AS

REVIEWER




KKP 12/31/22

PROJECT ID

113156

Sheet Totals		
Seeding	Cut	Fill
495	108	18

SHEET	TOTAL
142	233

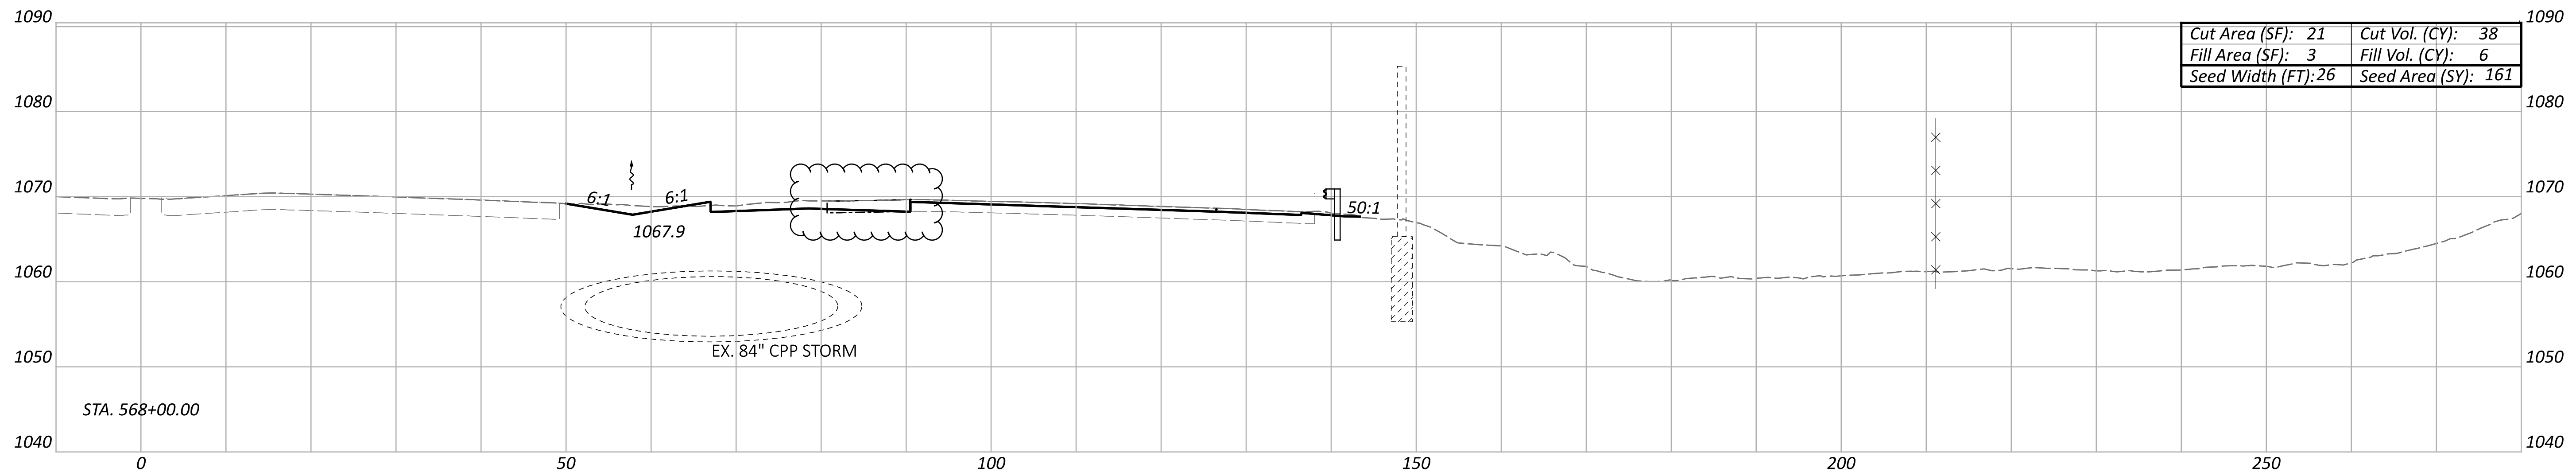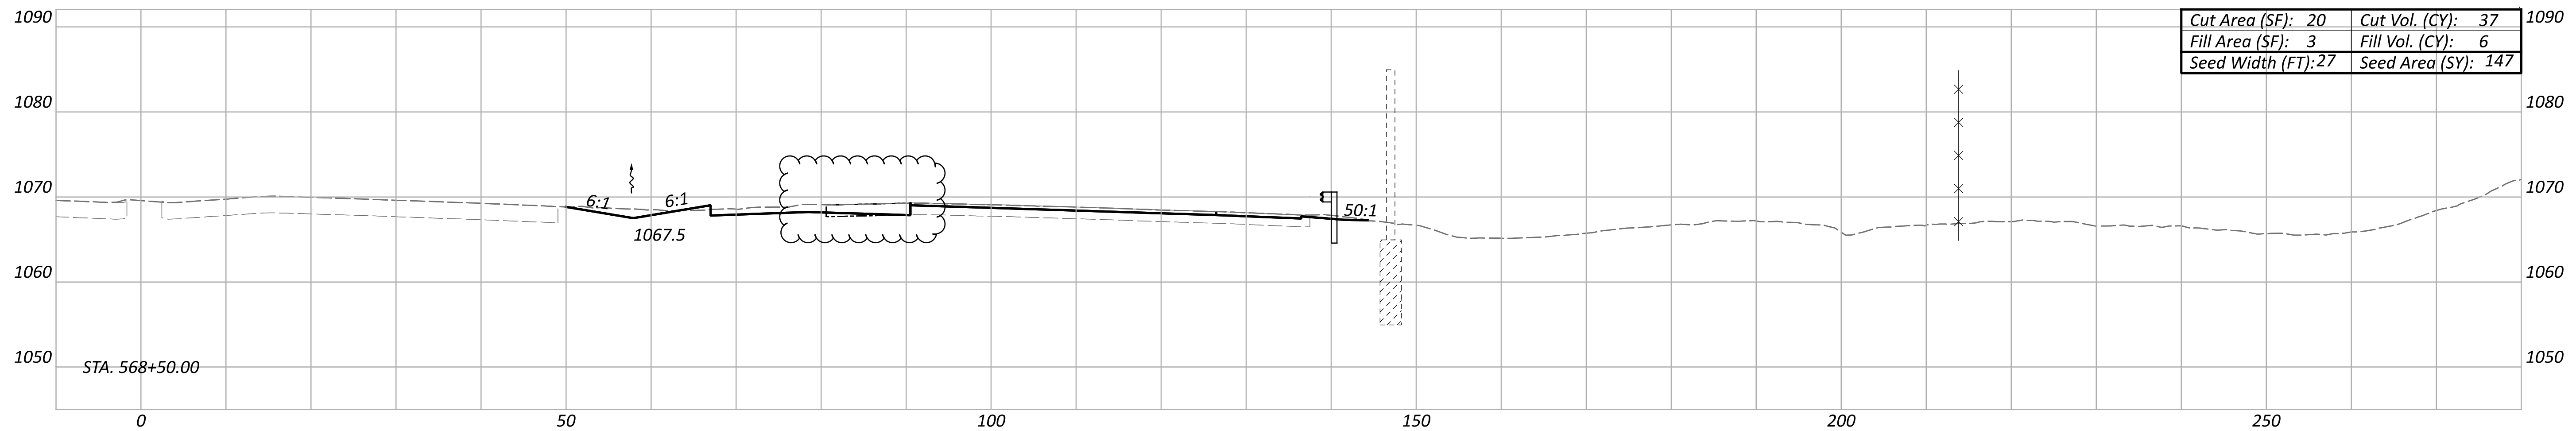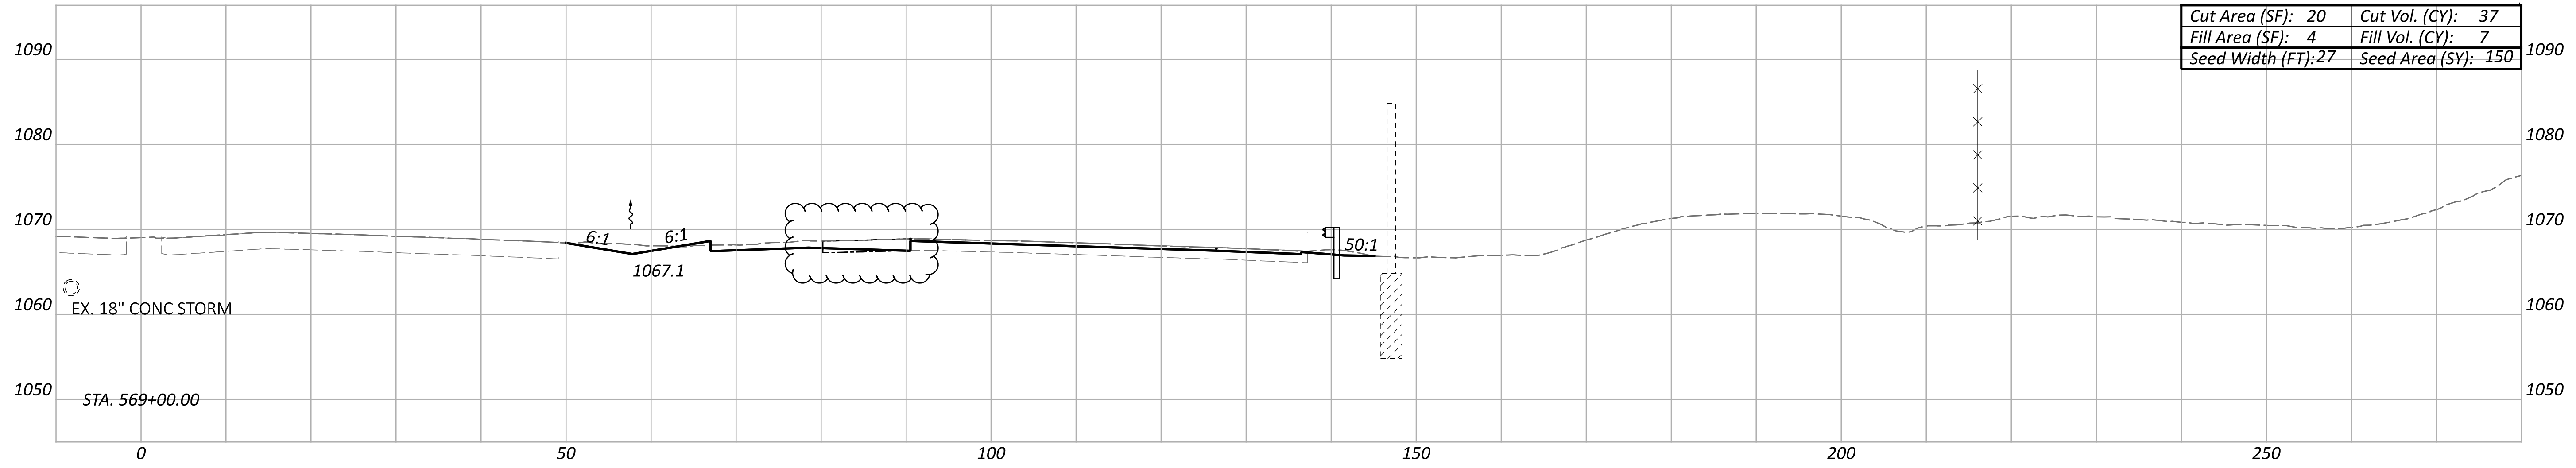

ITEM 202 - PAVEMENT REMOVED

CROSS SECTIONS
 STA. 568+00 TO STA. 569+00

DESIGN AGENCY



DESIGNER

AS

REVIEWER



KKP 12/31/22

PROJECT ID

113156

Sheet Totals		
Seeding	Cut	Fill
458	112	18

SHEET	TOTAL
143	233

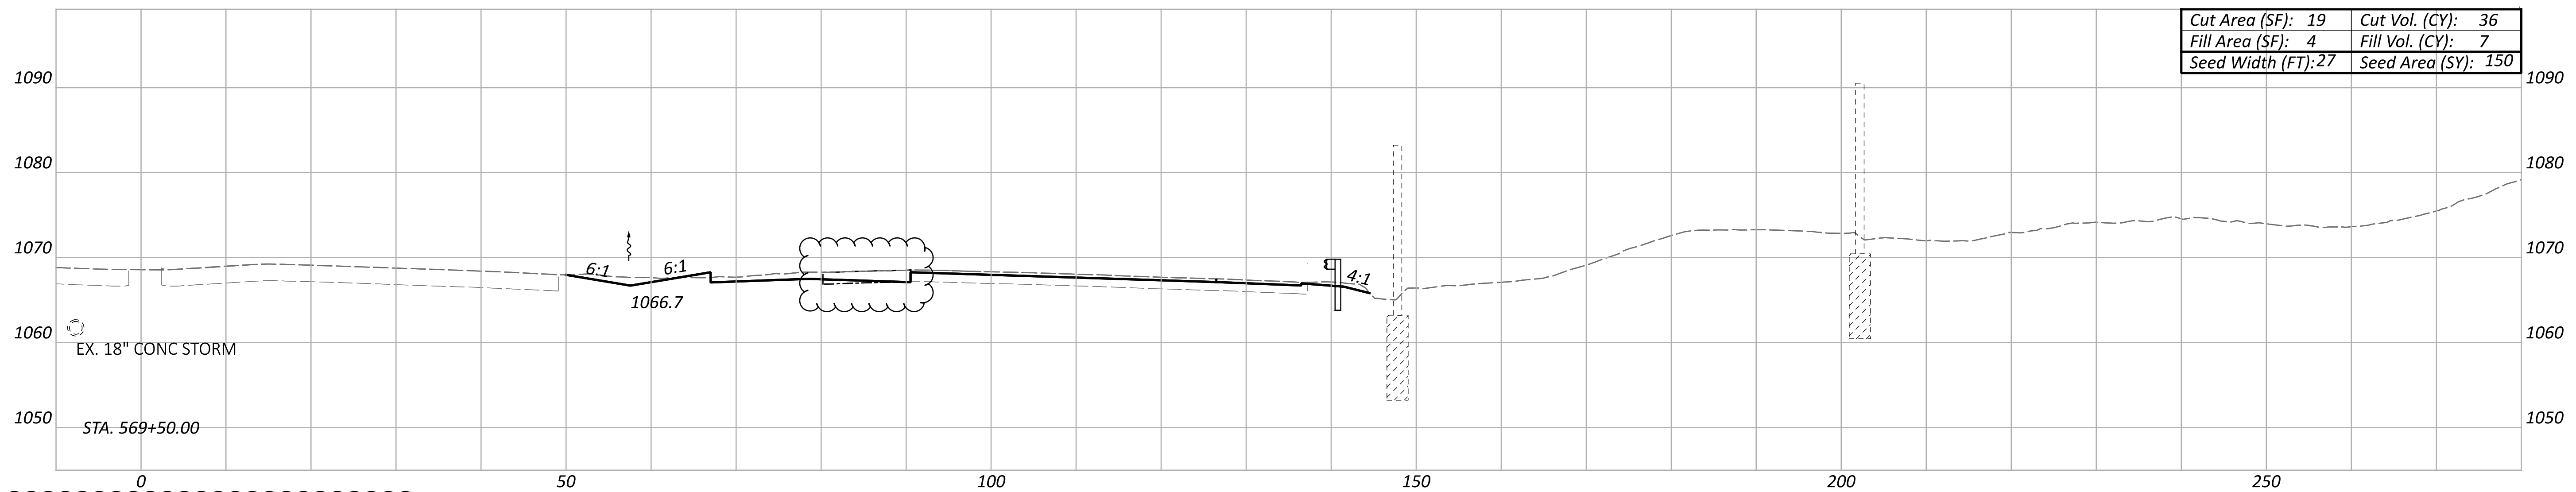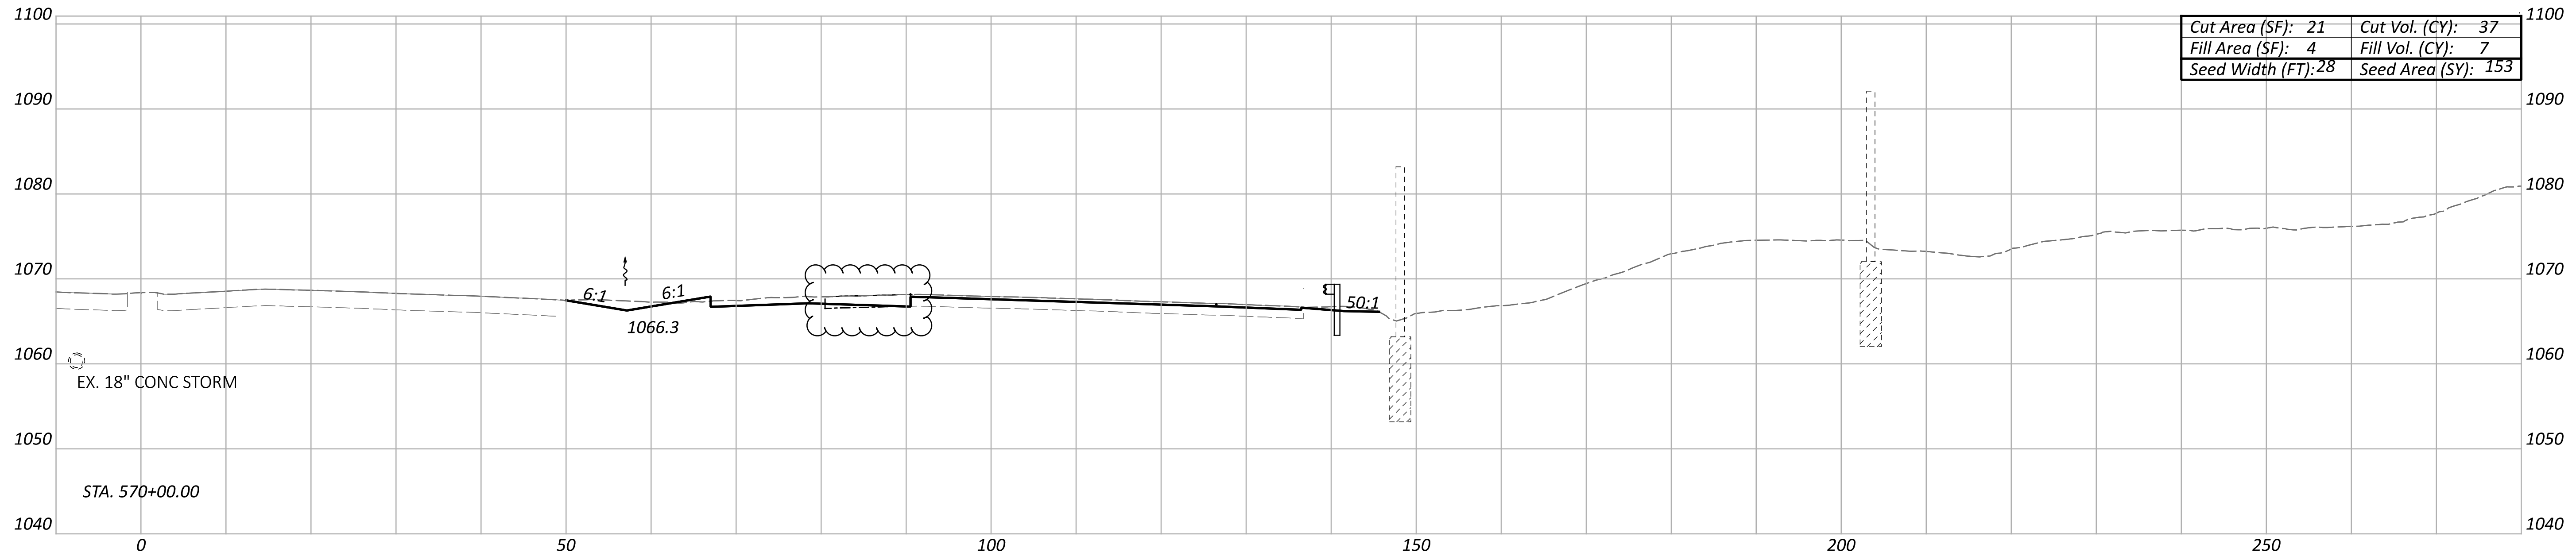

ITEM 202 - PAVEMENT REMOVED

CROSS SECTIONS
 STA. 569+50 TO STA. 570+00

DESIGN AGENCY





DESIGNER
 AS

REVIEWER
 KKP 12/31/22

PROJECT ID
 113156

Sheet Totals			SHEET	TOTAL
Seeding	Cut	Fill	144	233
303	73	14		

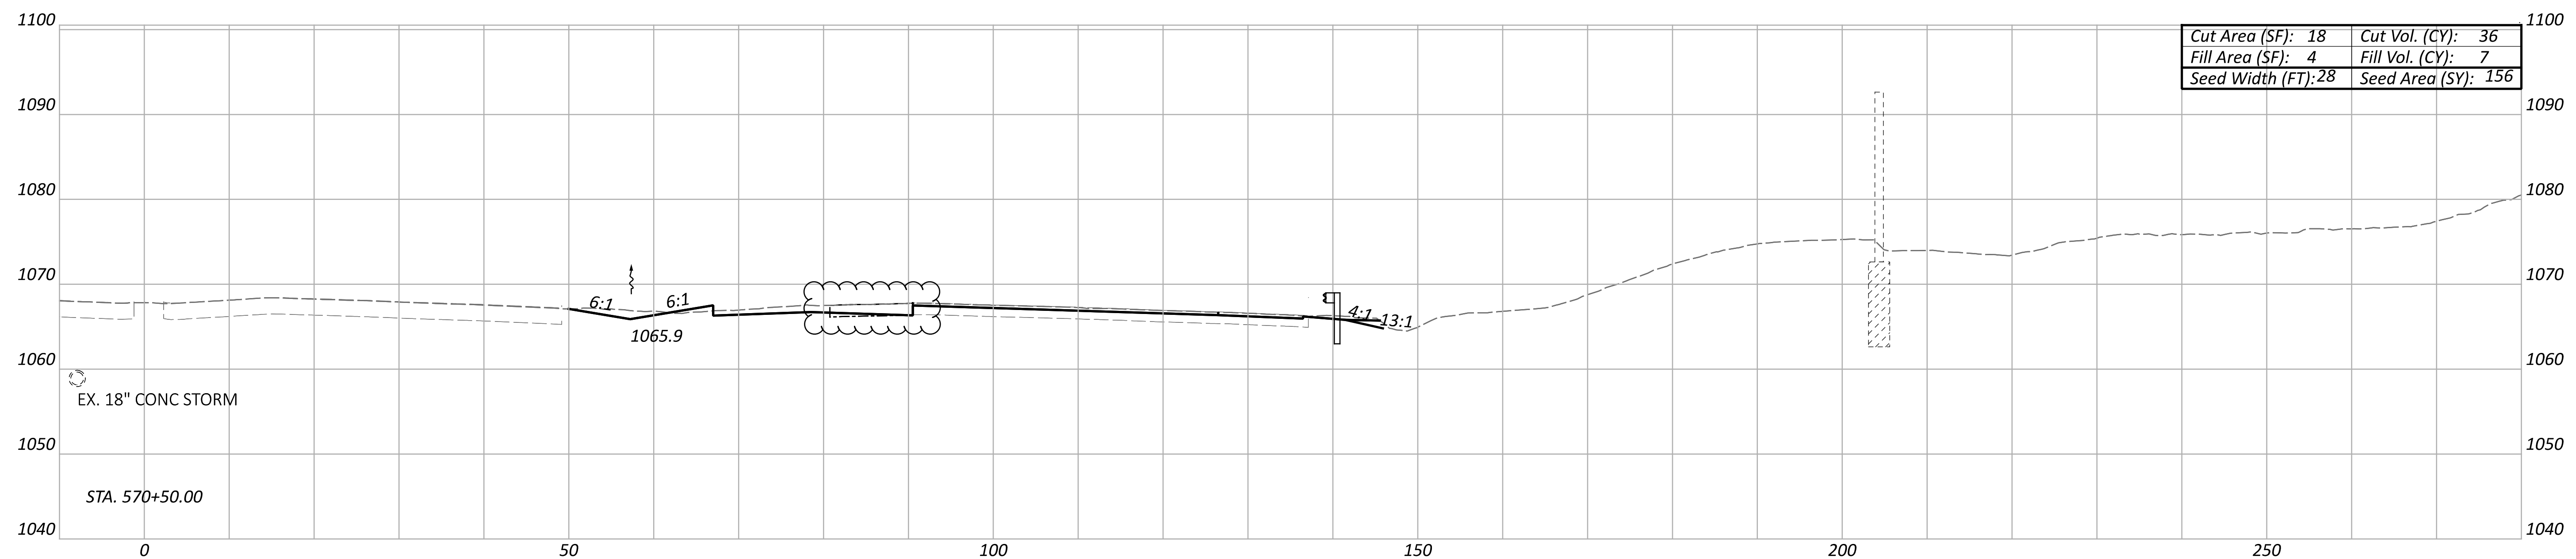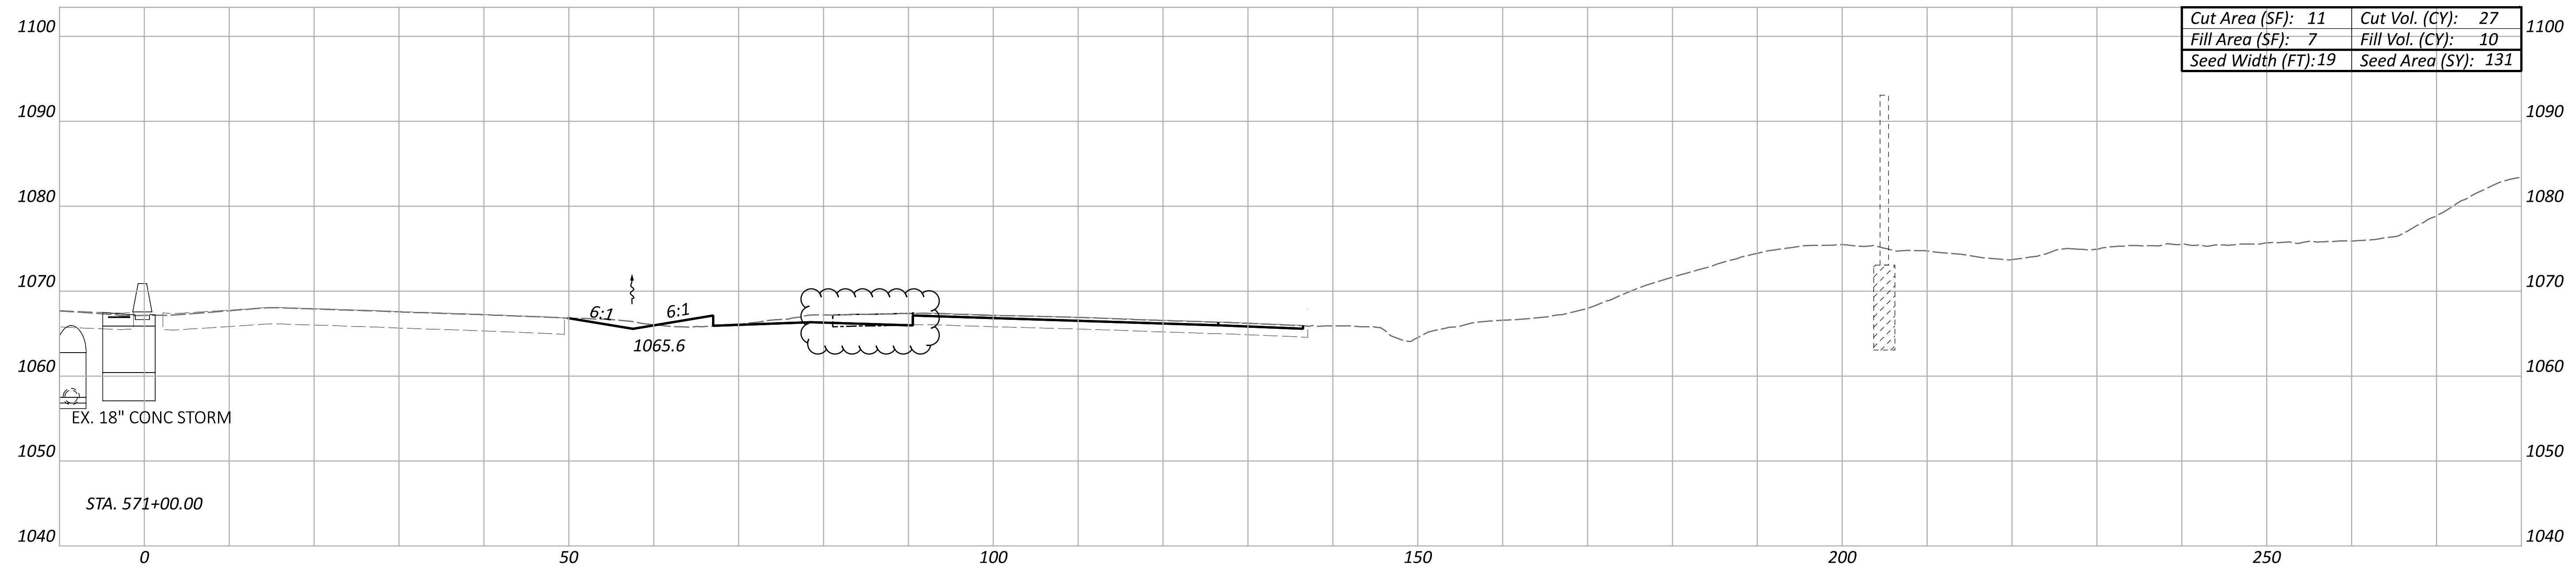

ITEM 202 - PAVEMENT REMOVED

CROSS SECTIONS
 STA. 570+50 TO STA. 571+00

DESIGN AGENCY



DESIGNER

AS

REVIEWER

KKP 12/31/22



PROJECT ID

113156

Sheet Totals

Seeding	Cut	Fill
287	62	18

SHEET	TOTAL
145	233

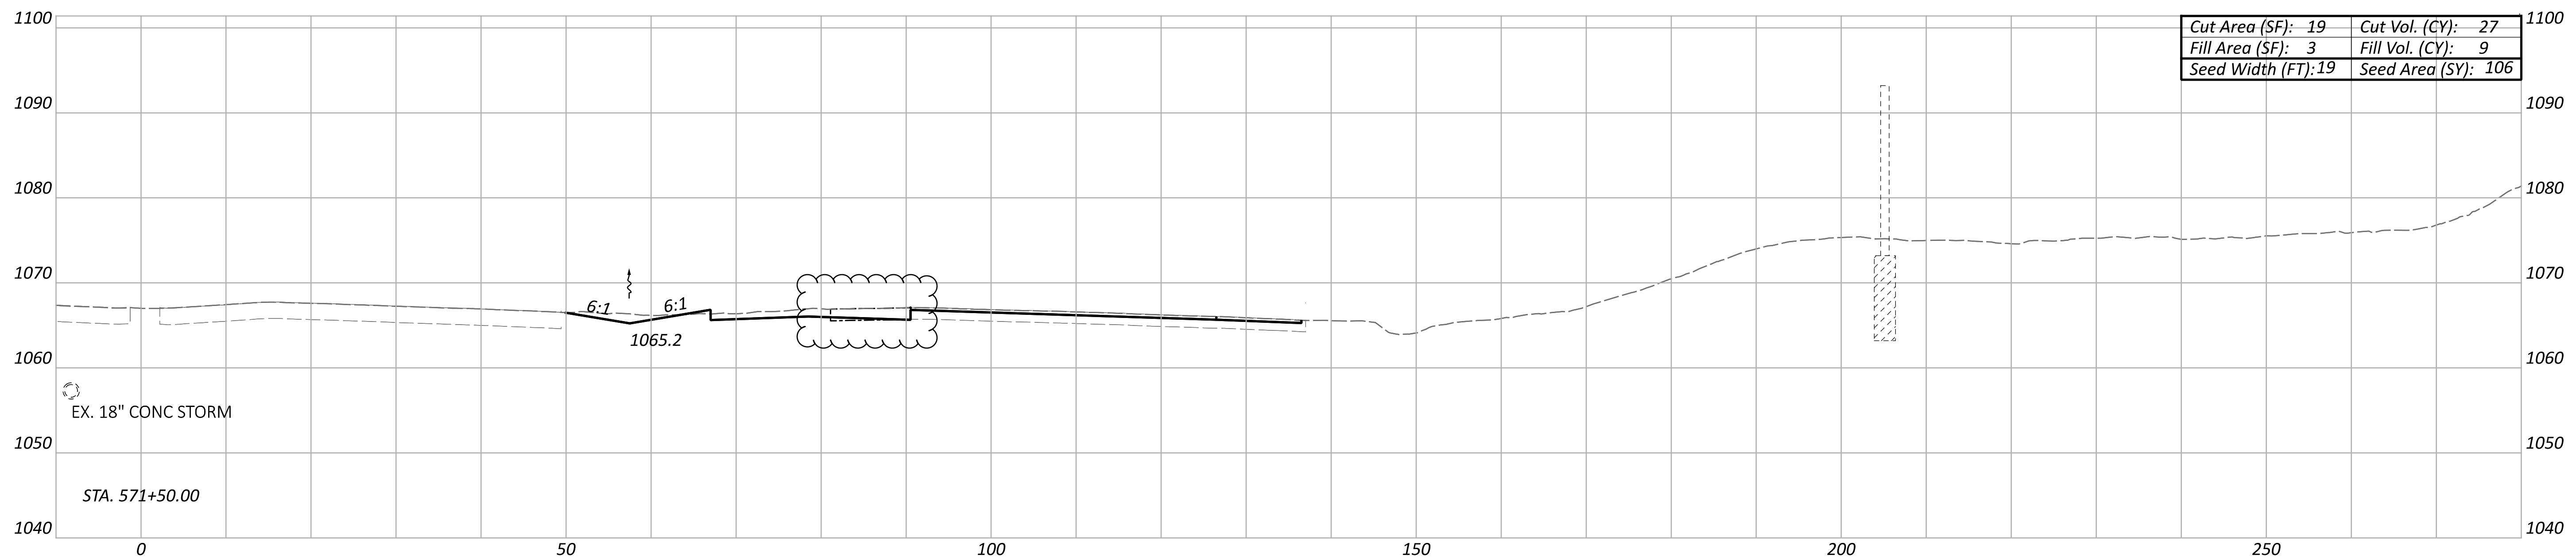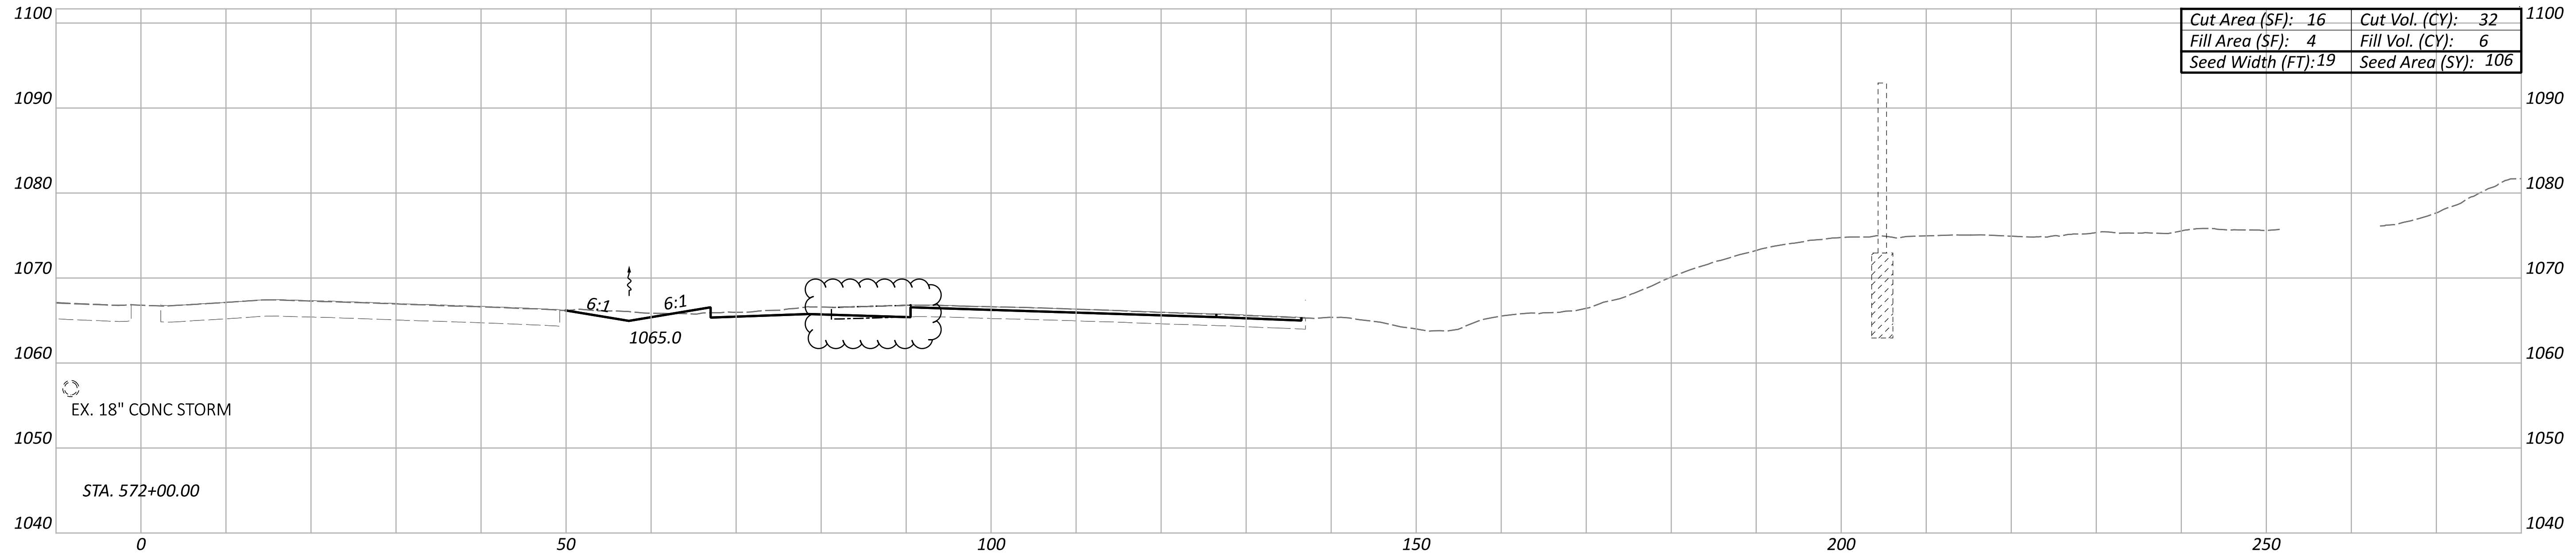

ITEM 202 - PAVEMENT REMOVED

CROSS SECTIONS
 STA. 571+50 TO STA. 572+00

DESIGN AGENCY





DESIGNER
 AS

REVIEWER
 KKP 12/31/22

PROJECT ID
 113156

Sheet Totals			SHEET	TOTAL
Seeding	Cut	Fill	146	233
212	59	15		

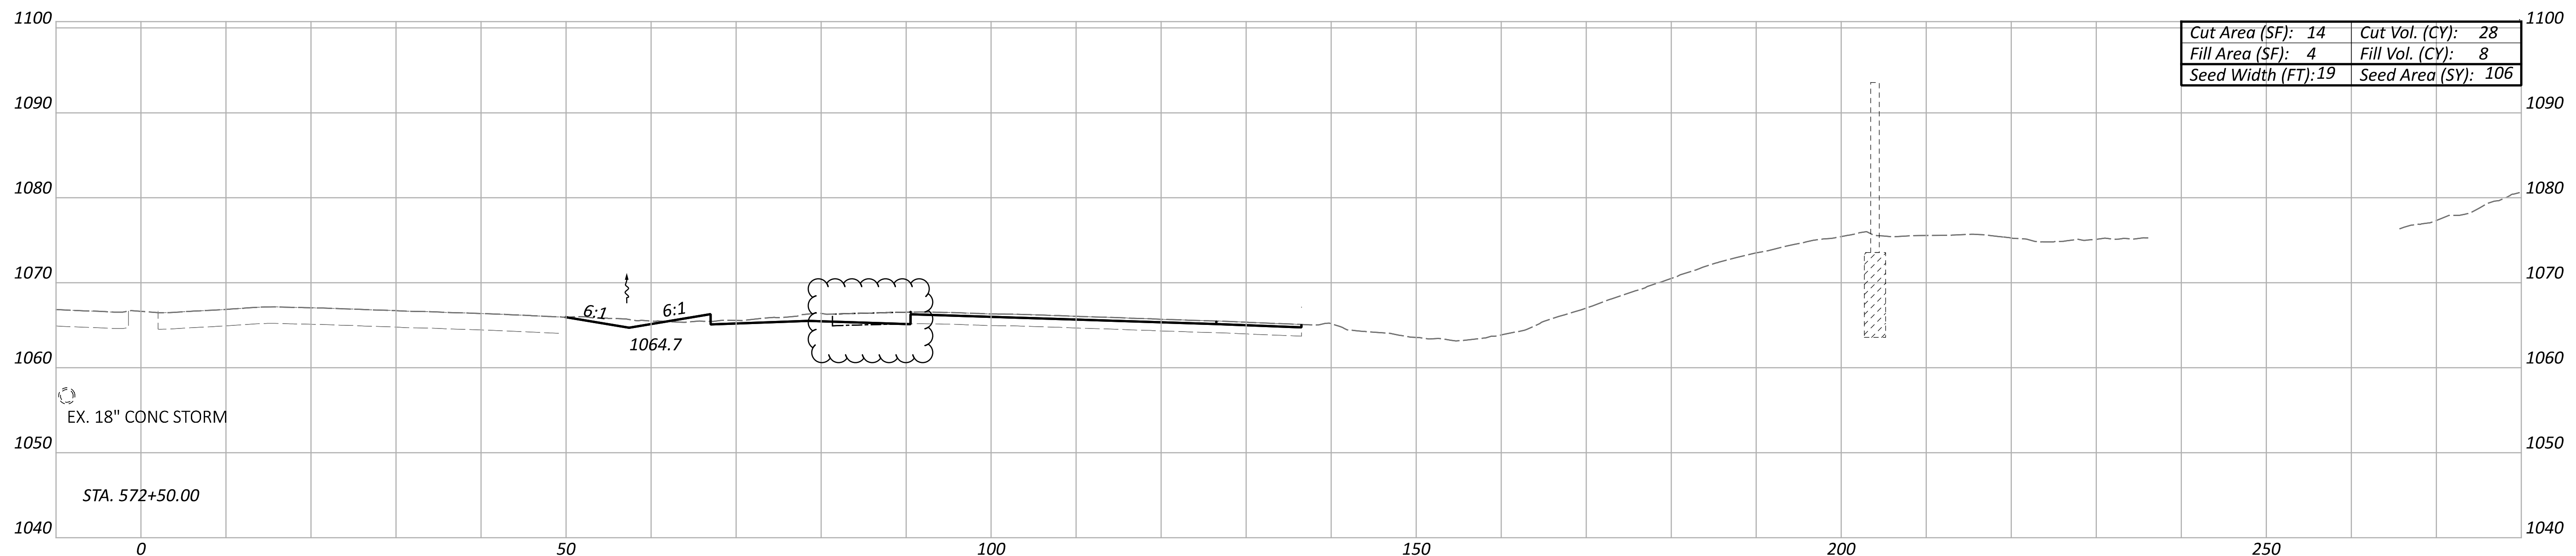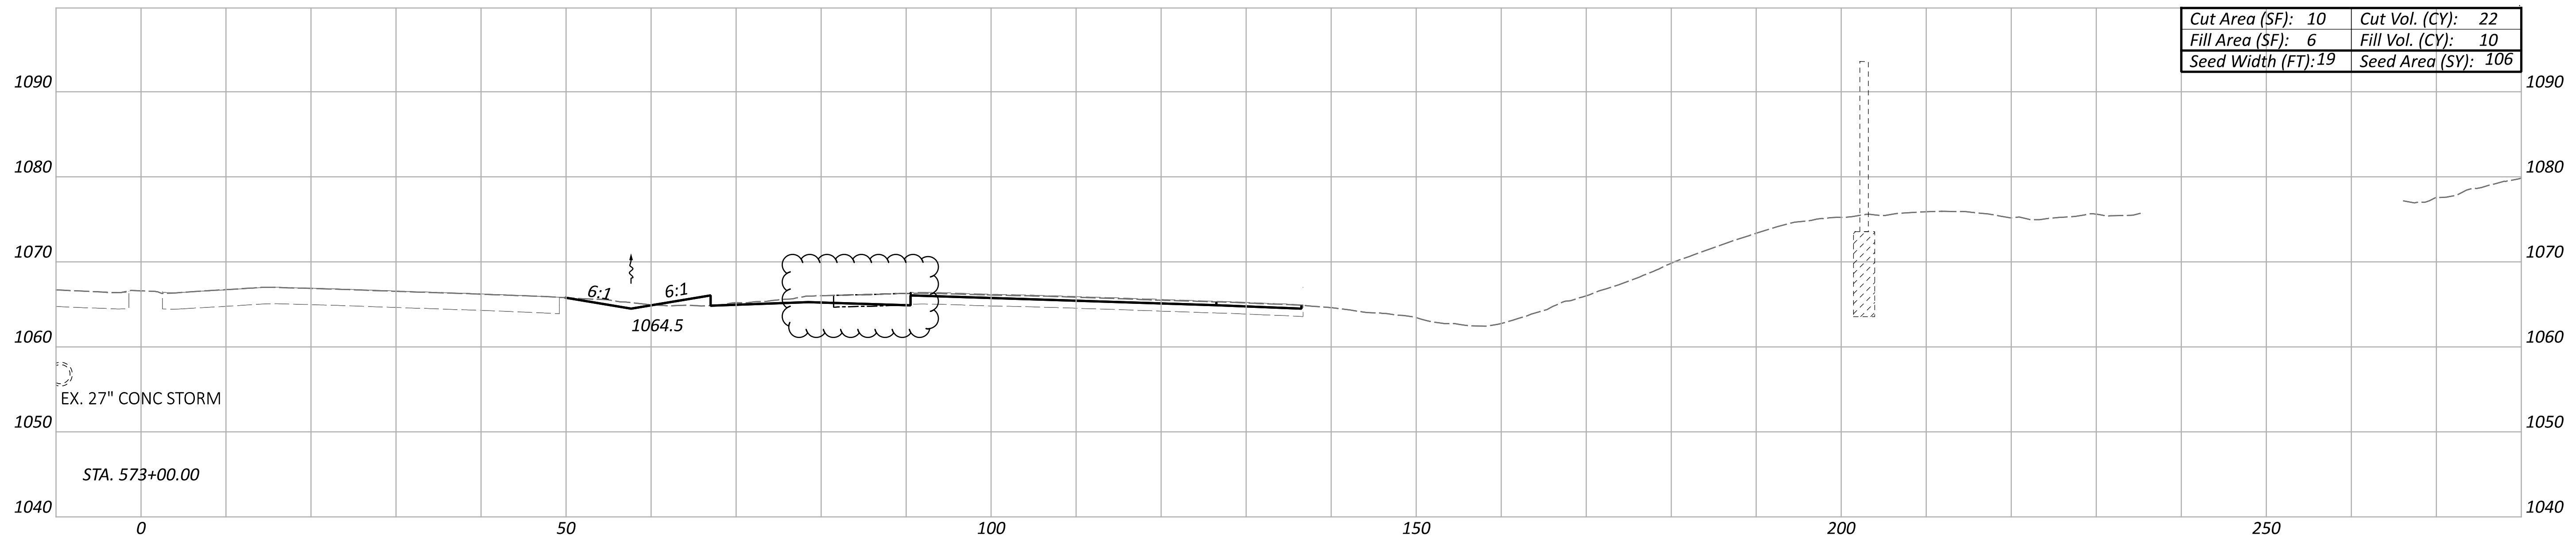

ITEM 202 - PAVEMENT REMOVED

CROSS SECTIONS
 STA. 572+50 TO STA. 573+00

DESIGN AGENCY





DESIGNER
 AS

REVIEWER
 KKP 12/31/22

PROJECT ID
 113156

Sheet Totals			SHEET	TOTAL
Seeding	Cut	Fill	147	233
212	51	17		

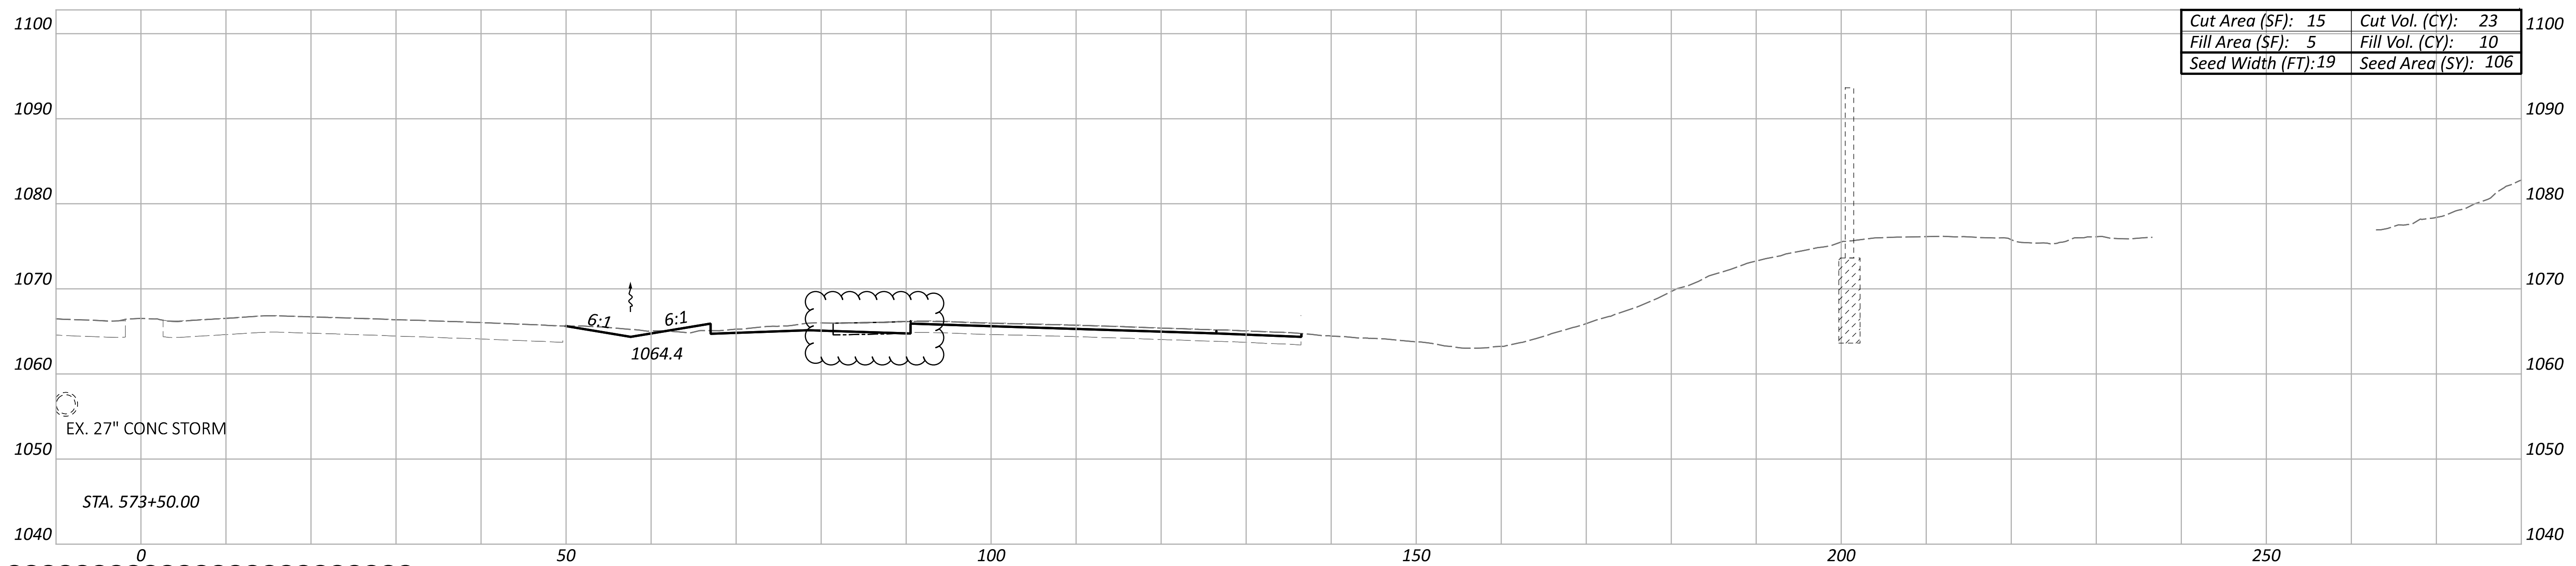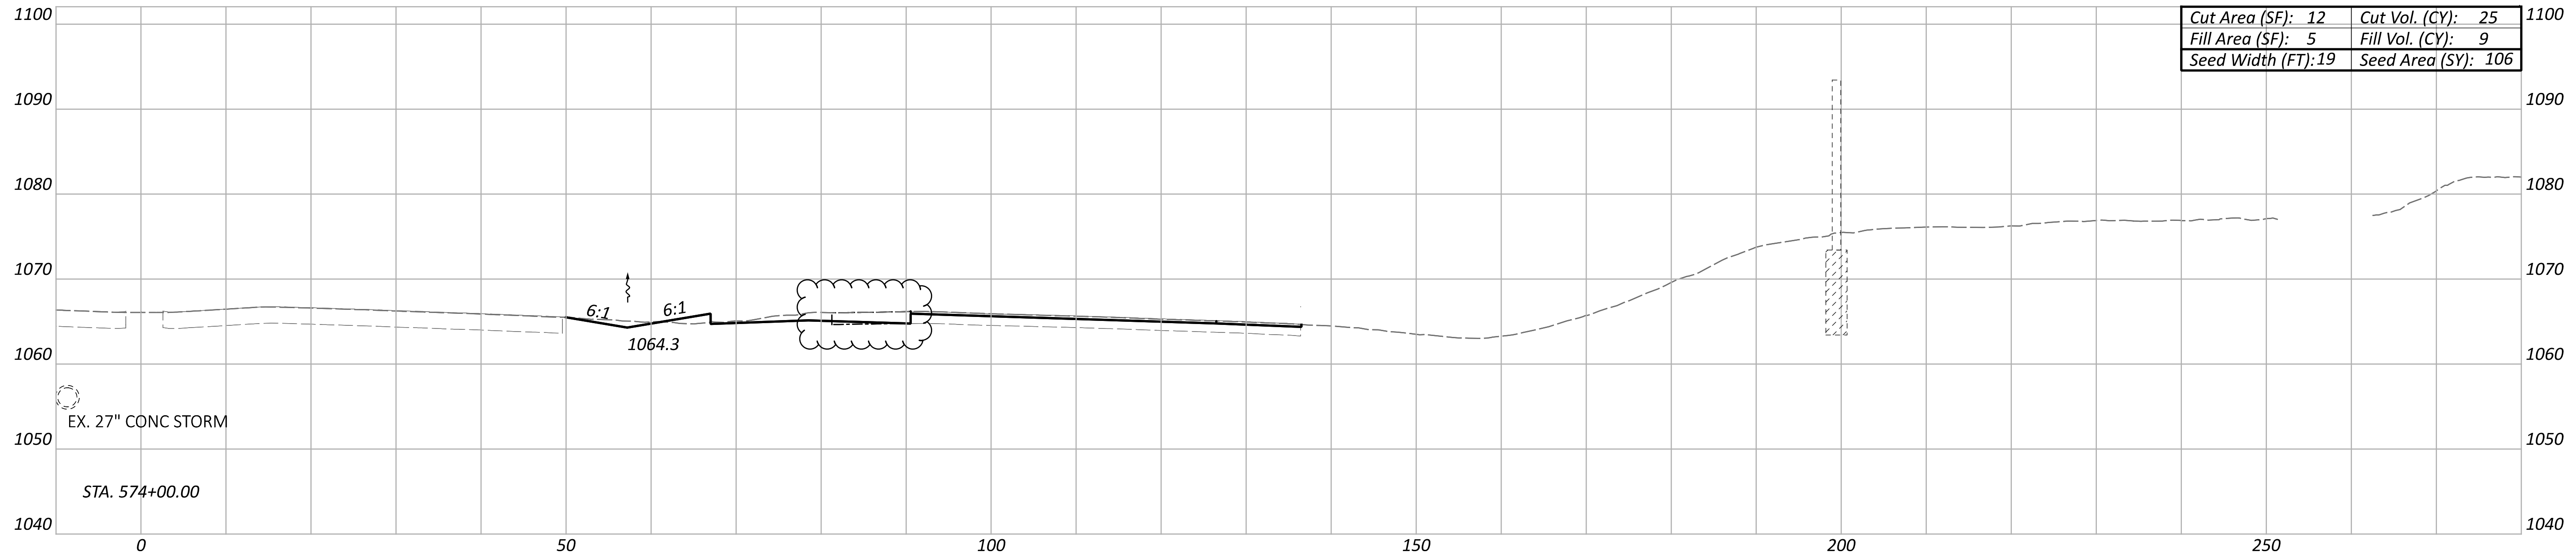

ITEM 202 - PAVEMENT REMOVED

CROSS SECTIONS
 STA. 573+50 TO STA. 574+00

DESIGN AGENCY



DESIGNER

AS

REVIEWER



KKP 12/31/22

PROJECT ID

113156

Sheet Totals		
Seeding	Cut	Fill
212	47	19

SHEET	TOTAL
148	233

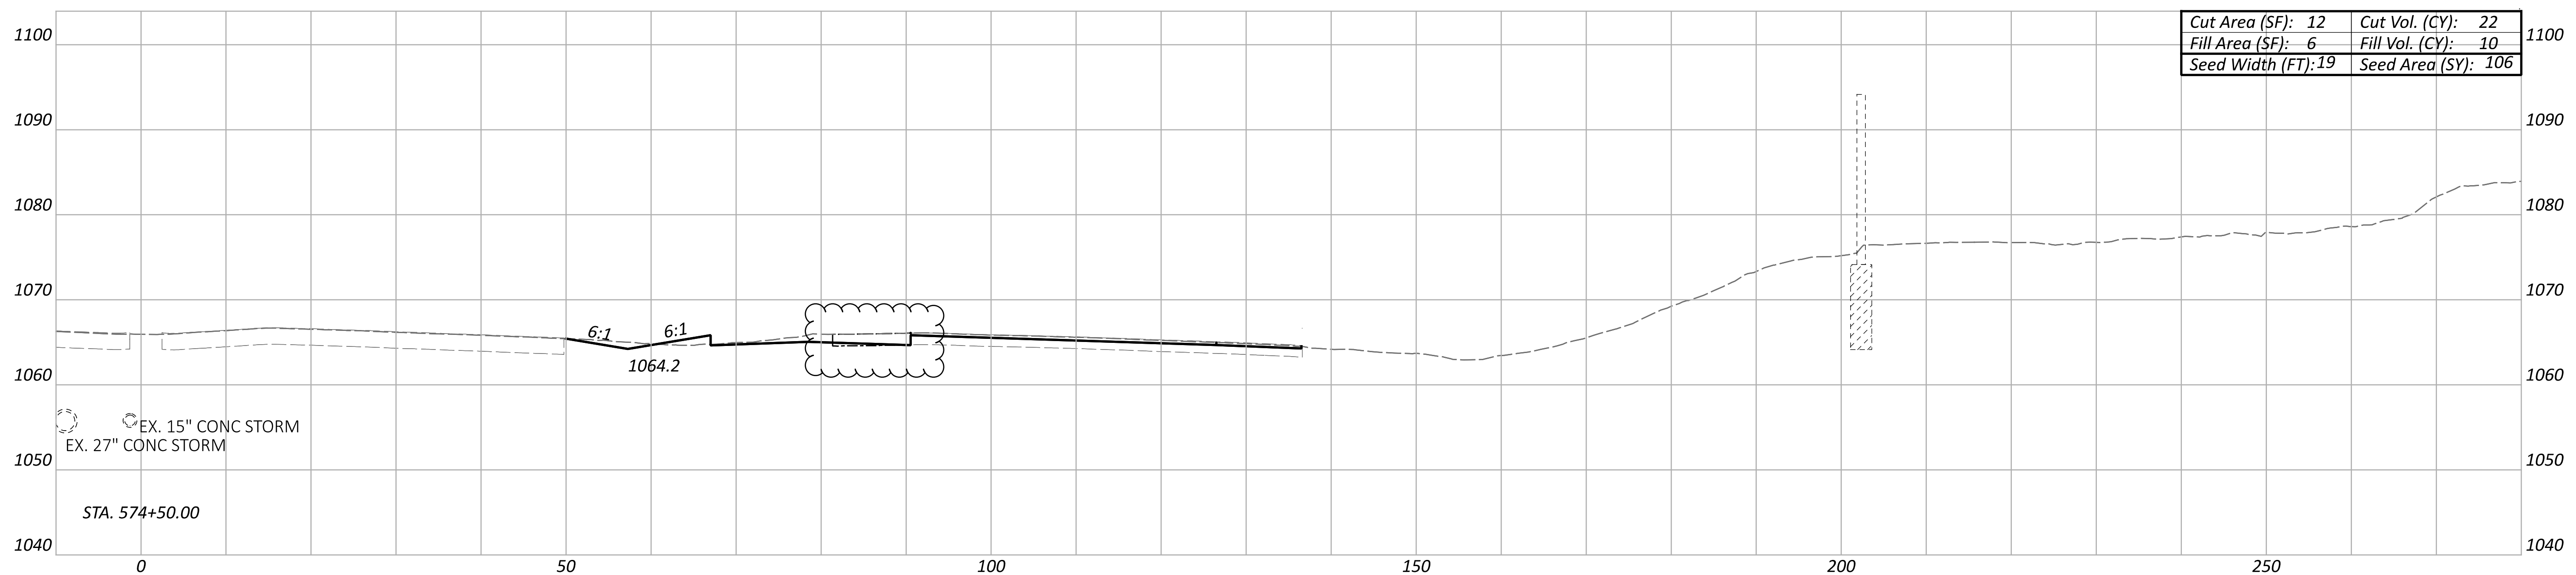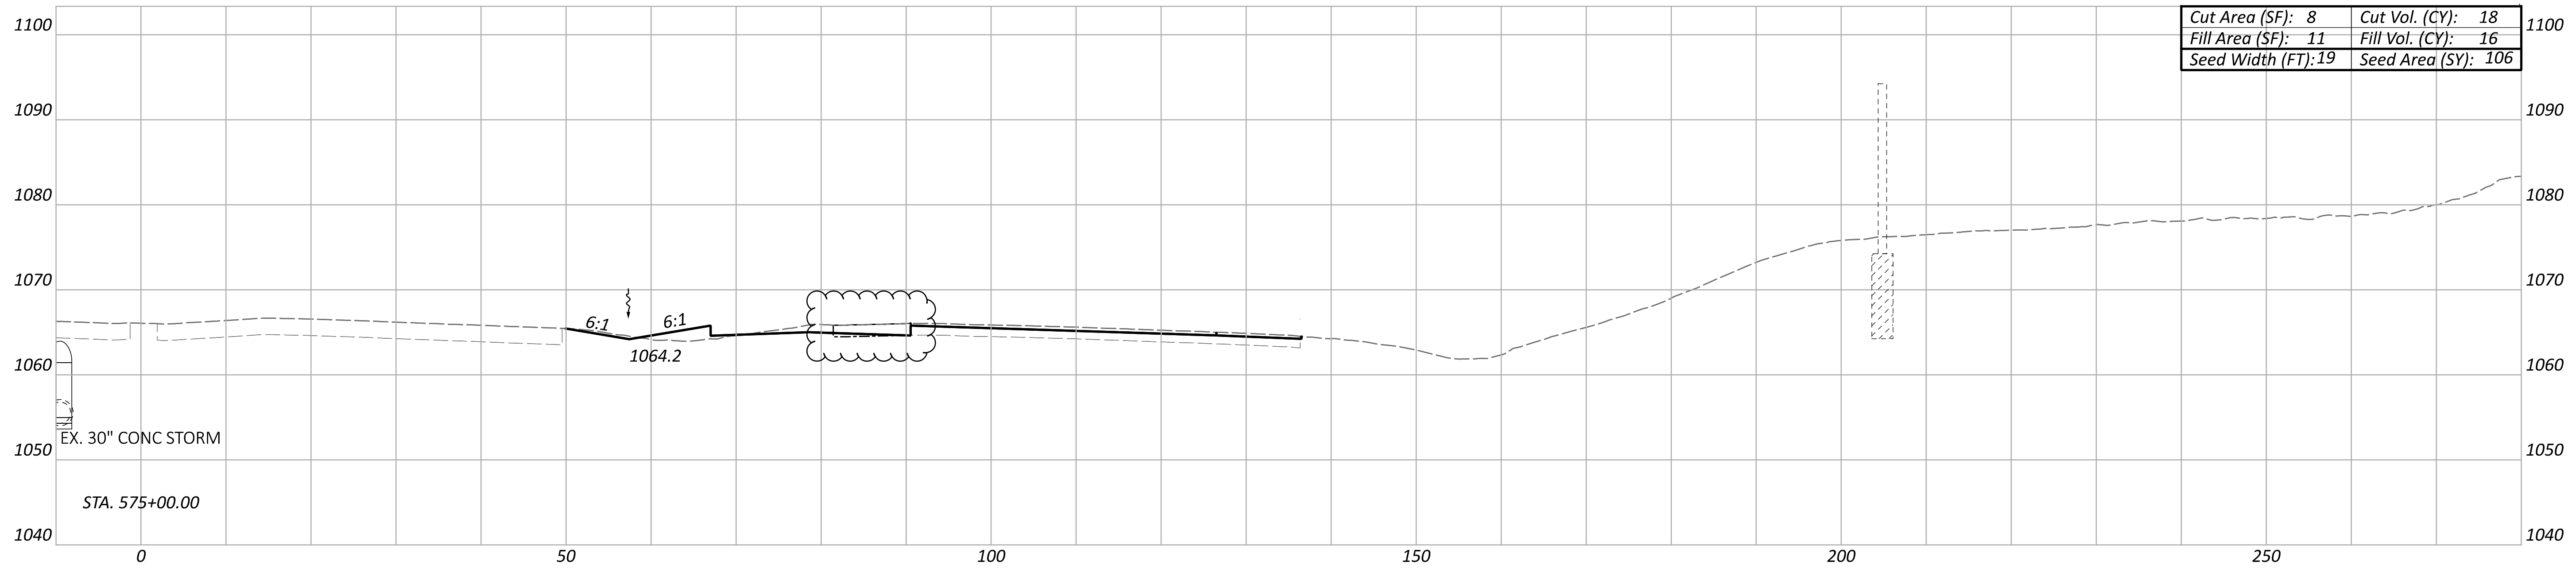

ITEM 202 - PAVEMENT REMOVED

CROSS SECTIONS
 STA. 574+50 TO STA. 575+00

DESIGN AGENCY



DESIGNER

AS

REVIEWER



KKP 12/31/22

PROJECT ID

113156

Sheet Totals		
Seeding	Cut	Fill
212	40	26

SHEET	TOTAL
149	233

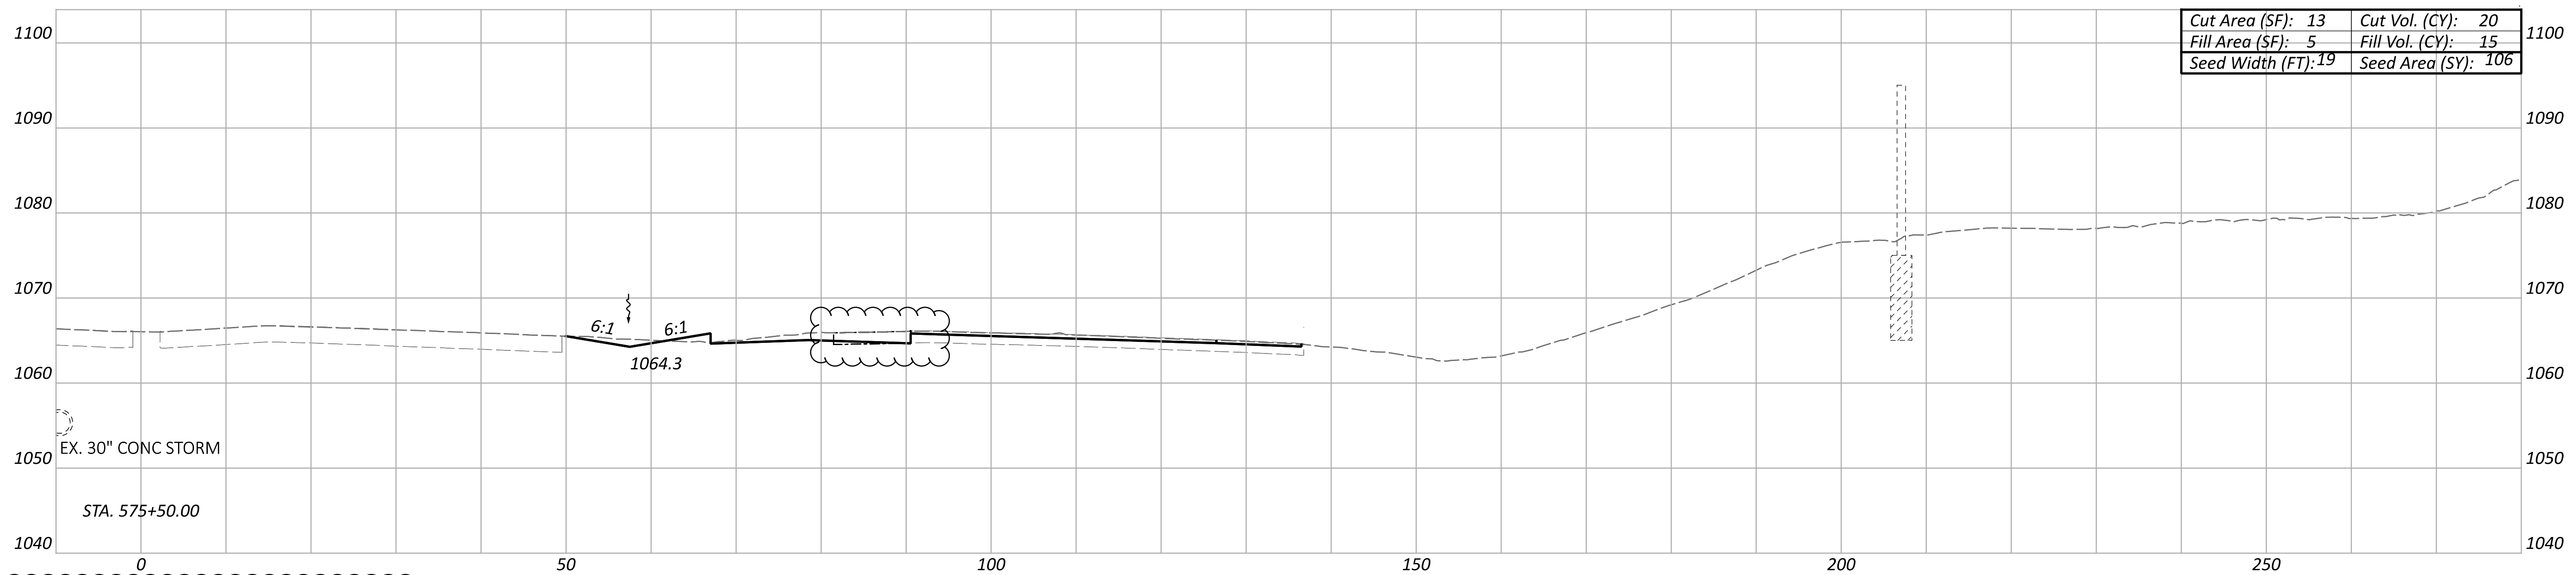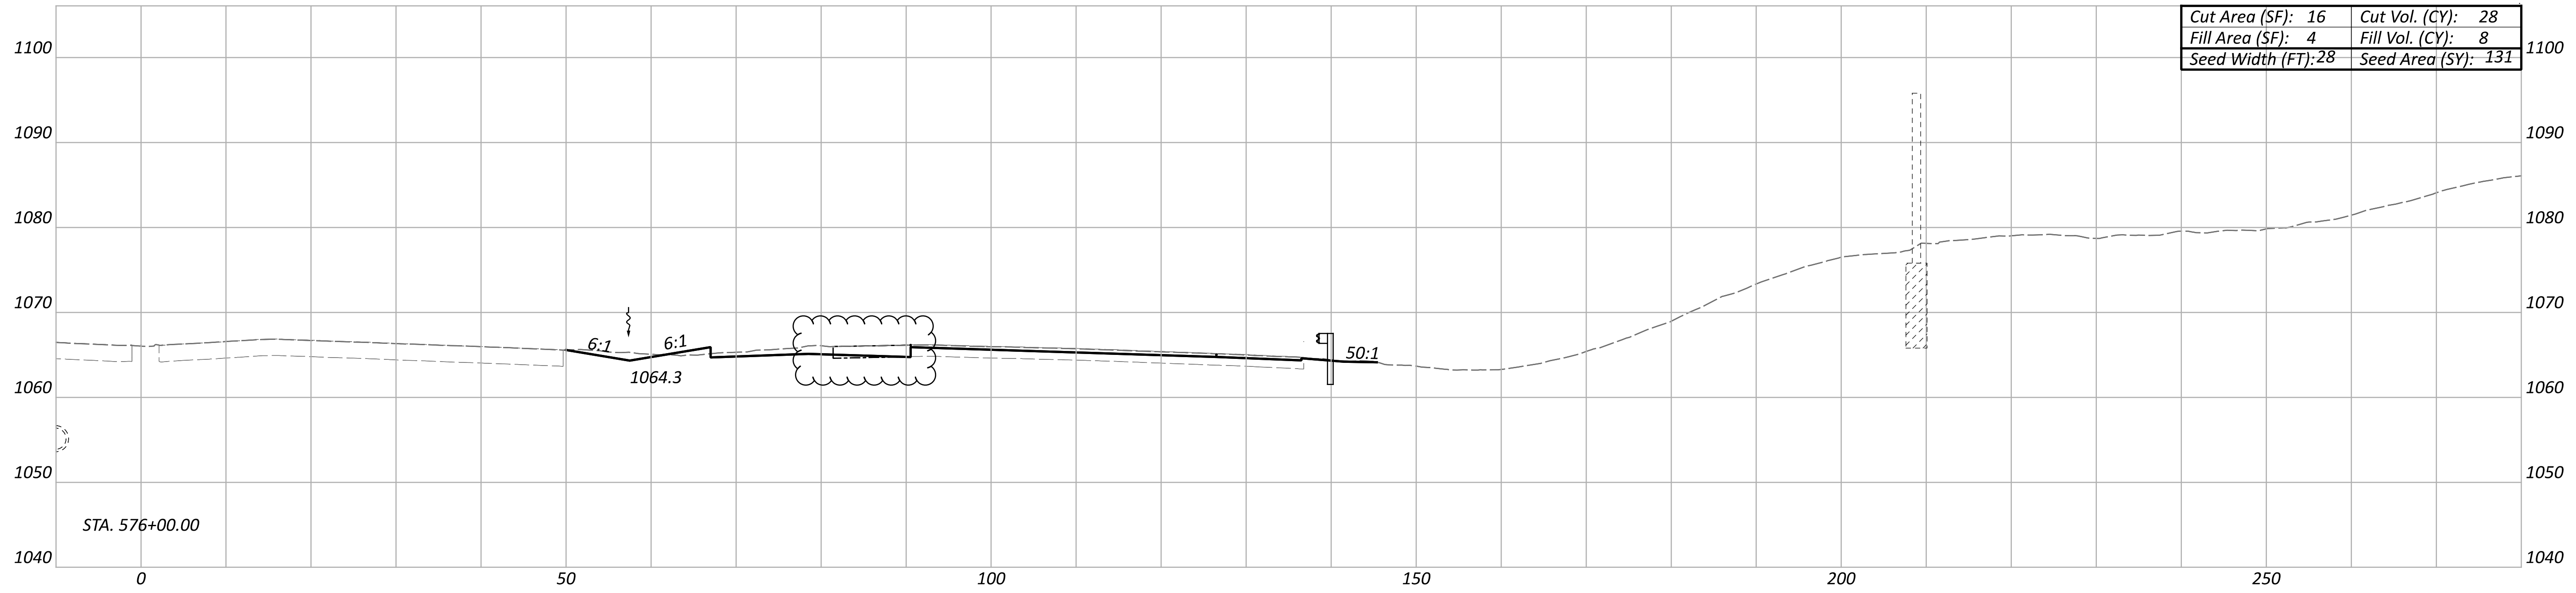

EX. 30" CONC STORM

ITEM 202 - PAVEMENT REMOVED

CROSS SECTIONS
 STA. 575+50 TO STA. 576+00

DESIGN AGENCY



DESIGNER

AS

REVIEWER



KKP 12/31/22

PROJECT ID

113156

Sheet Totals		
Seeding	Cut	Fill
237	47	23

SHEET	TOTAL
150	233

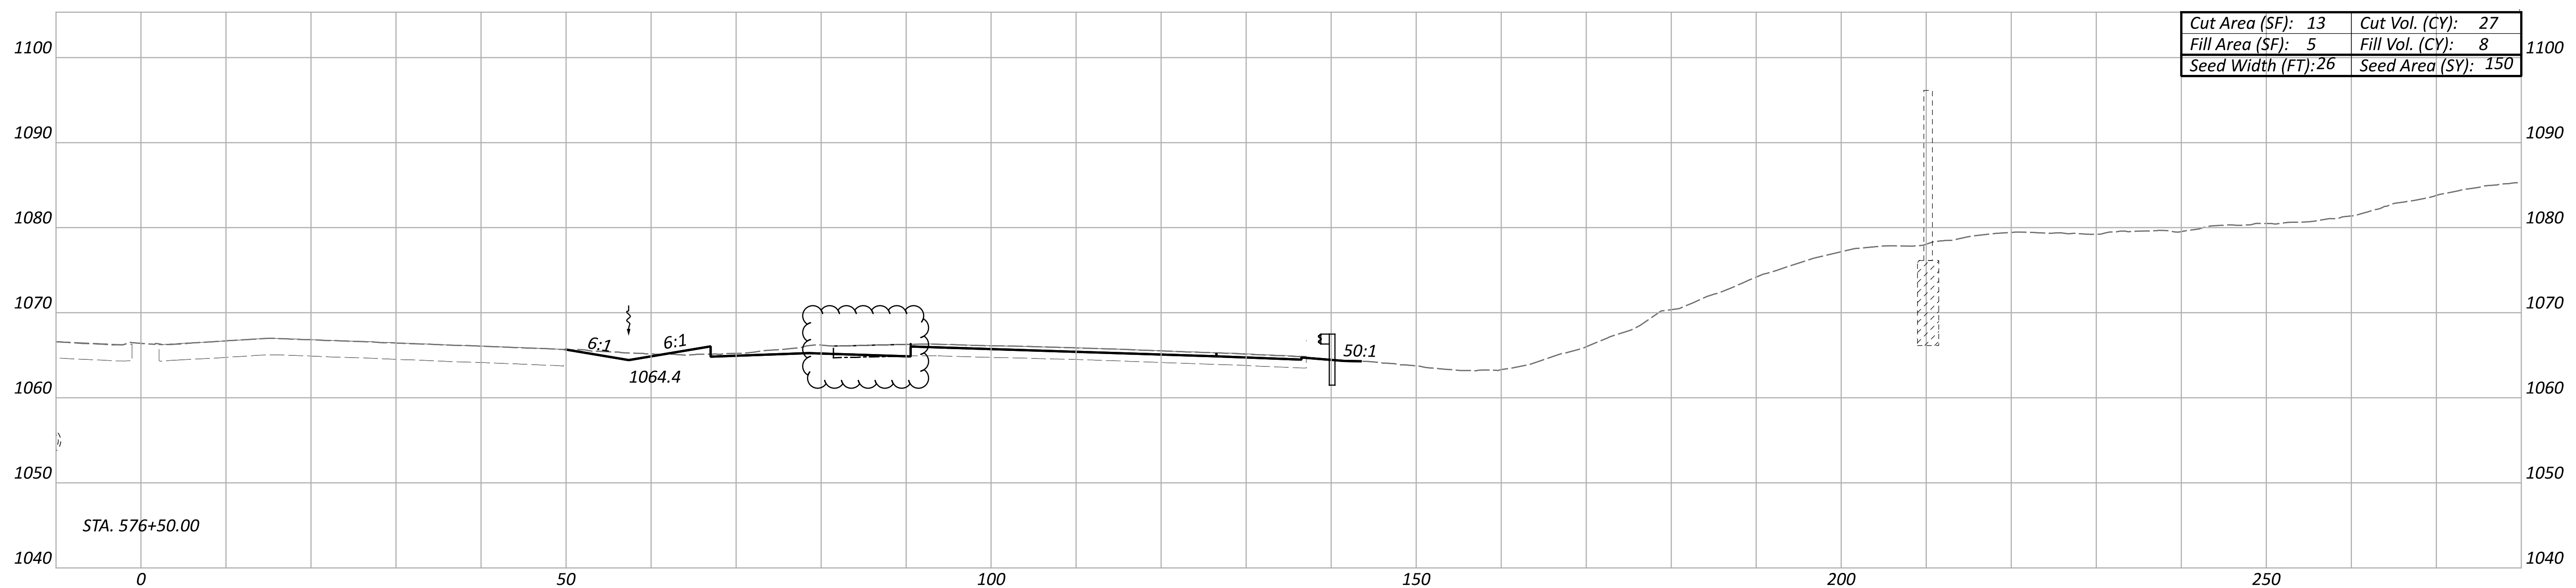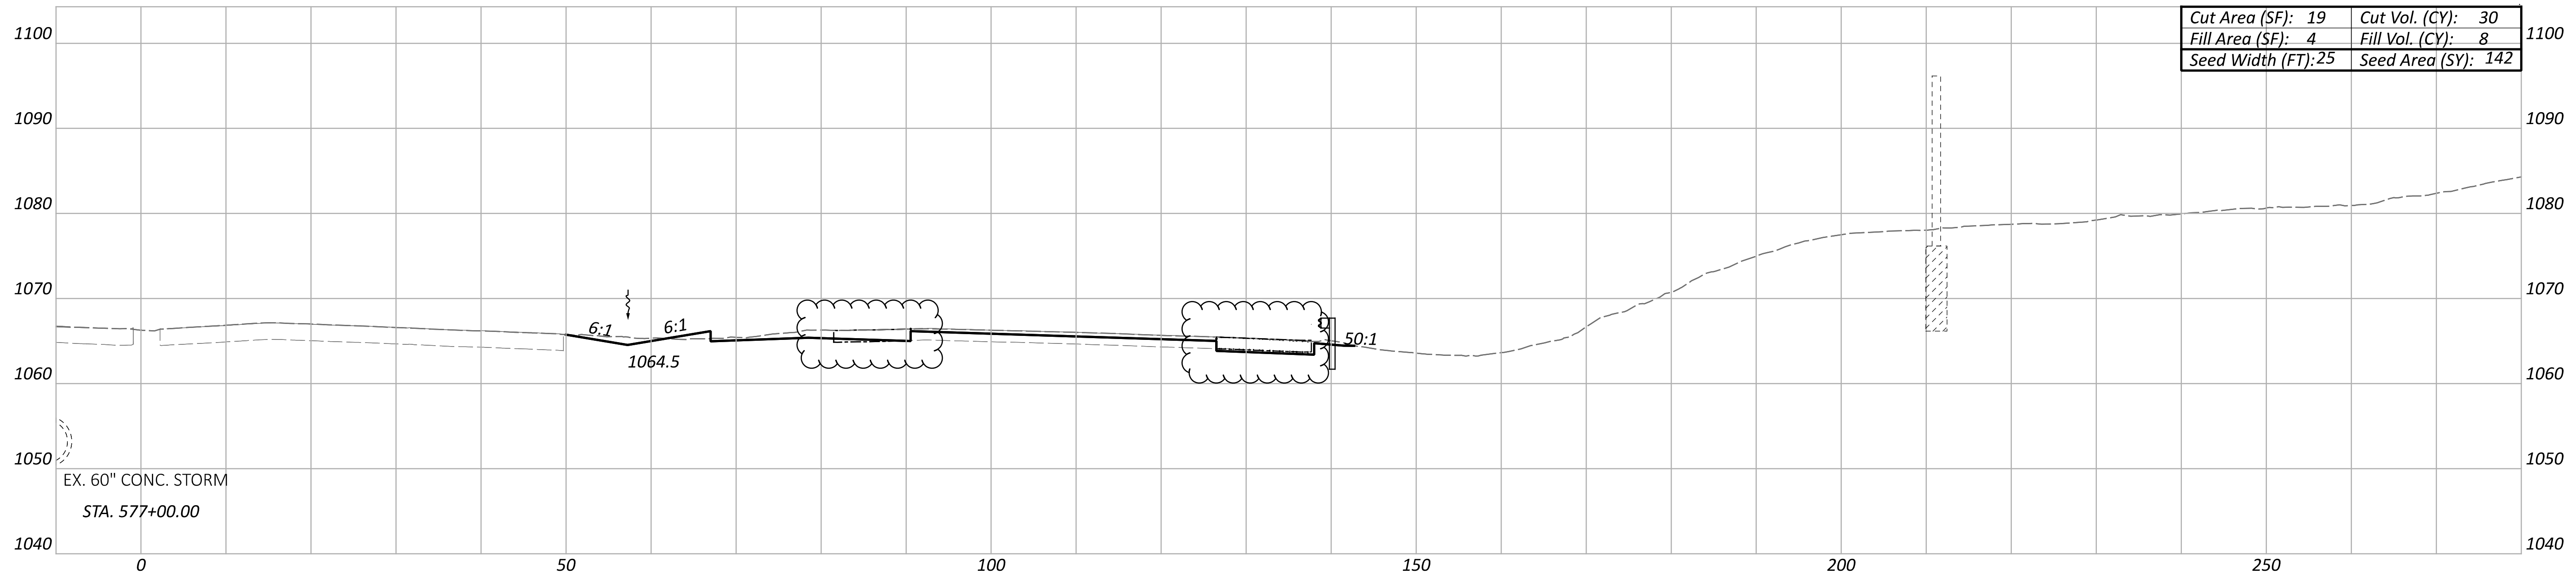

ITEM 202 - PAVEMENT REMOVED

CROSS SECTIONS
 STA. 576+50 TO STA. 577+00

DESIGN AGENCY



DESIGNER

AS

REVIEWER



KKP 12/31/22

PROJECT ID

113156

Sheet Totals		
Seeding	Cut	Fill
292	57	17

SHEET	TOTAL
151	233

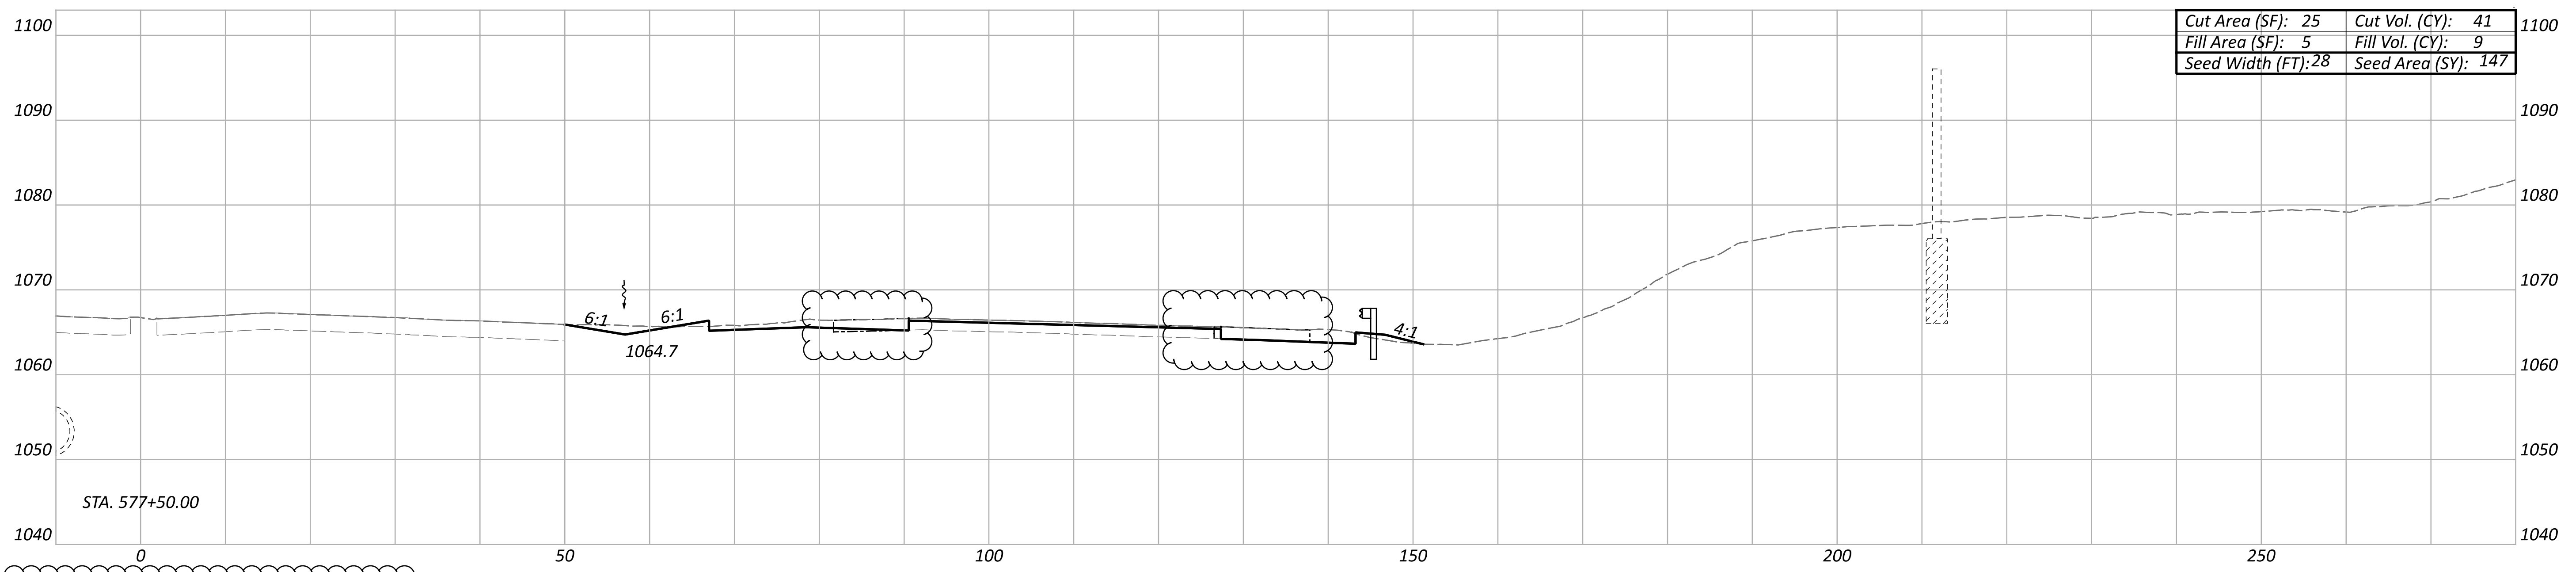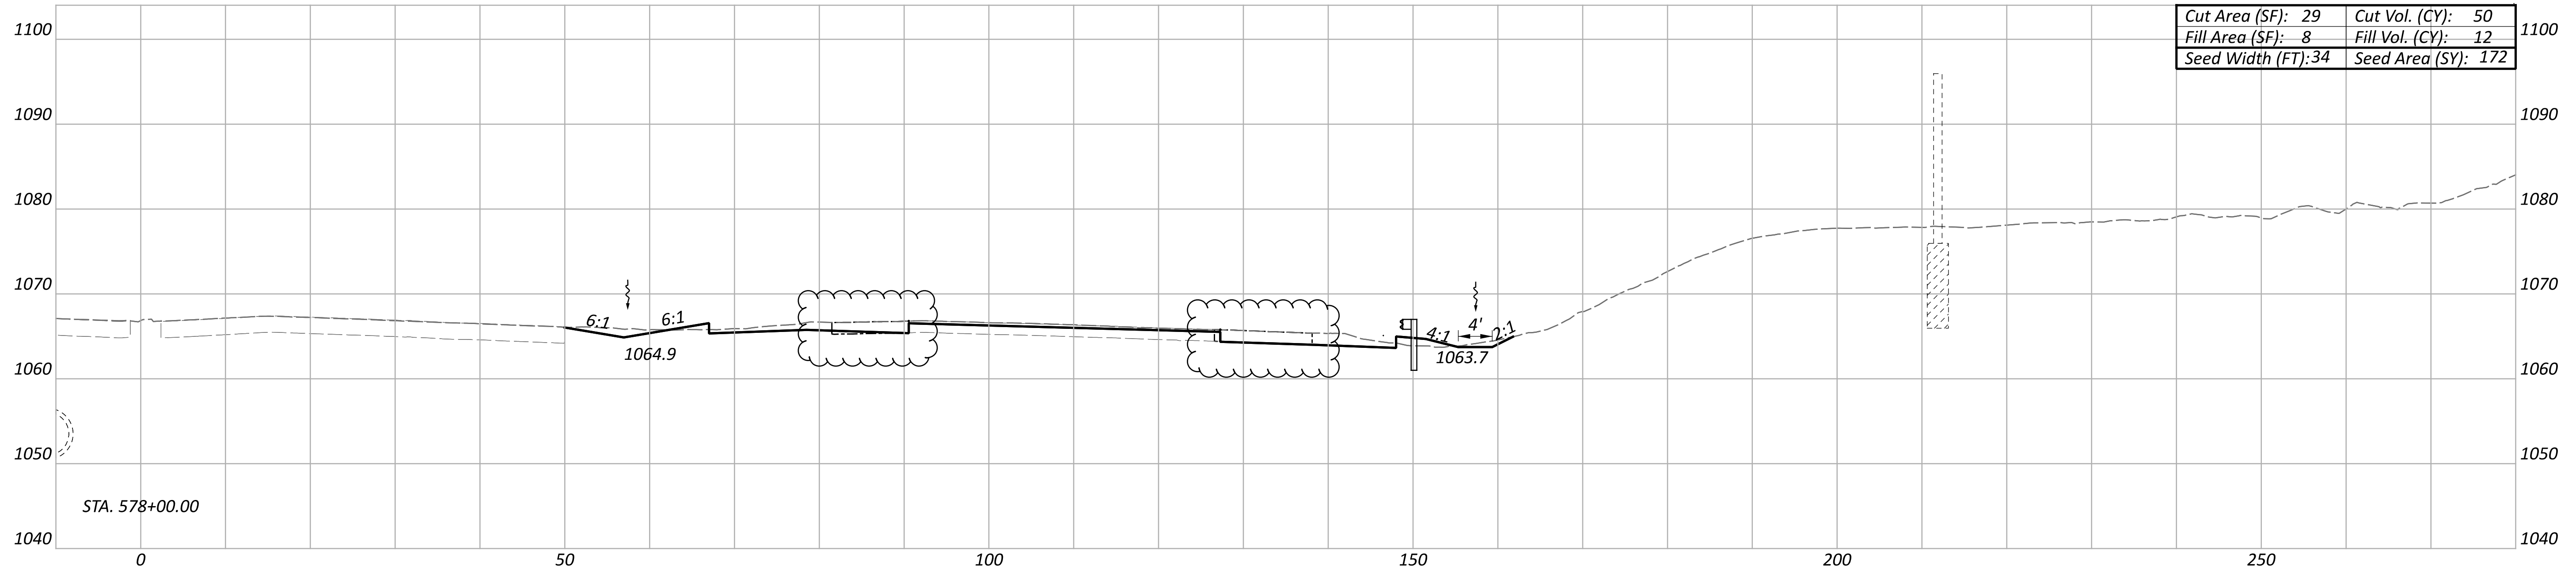

ITEM 202 - PAVEMENT REMOVED

CROSS SECTIONS
 STA. 577+50 TO STA. 578+00

DESIGN AGENCY





DESIGNER
 AS

REVIEWER
 KKP 12/31/22

PROJECT ID
 113156

Sheet Totals			SHEET	TOTAL
Seeding	Cut	Fill	152	233
319	90	21		

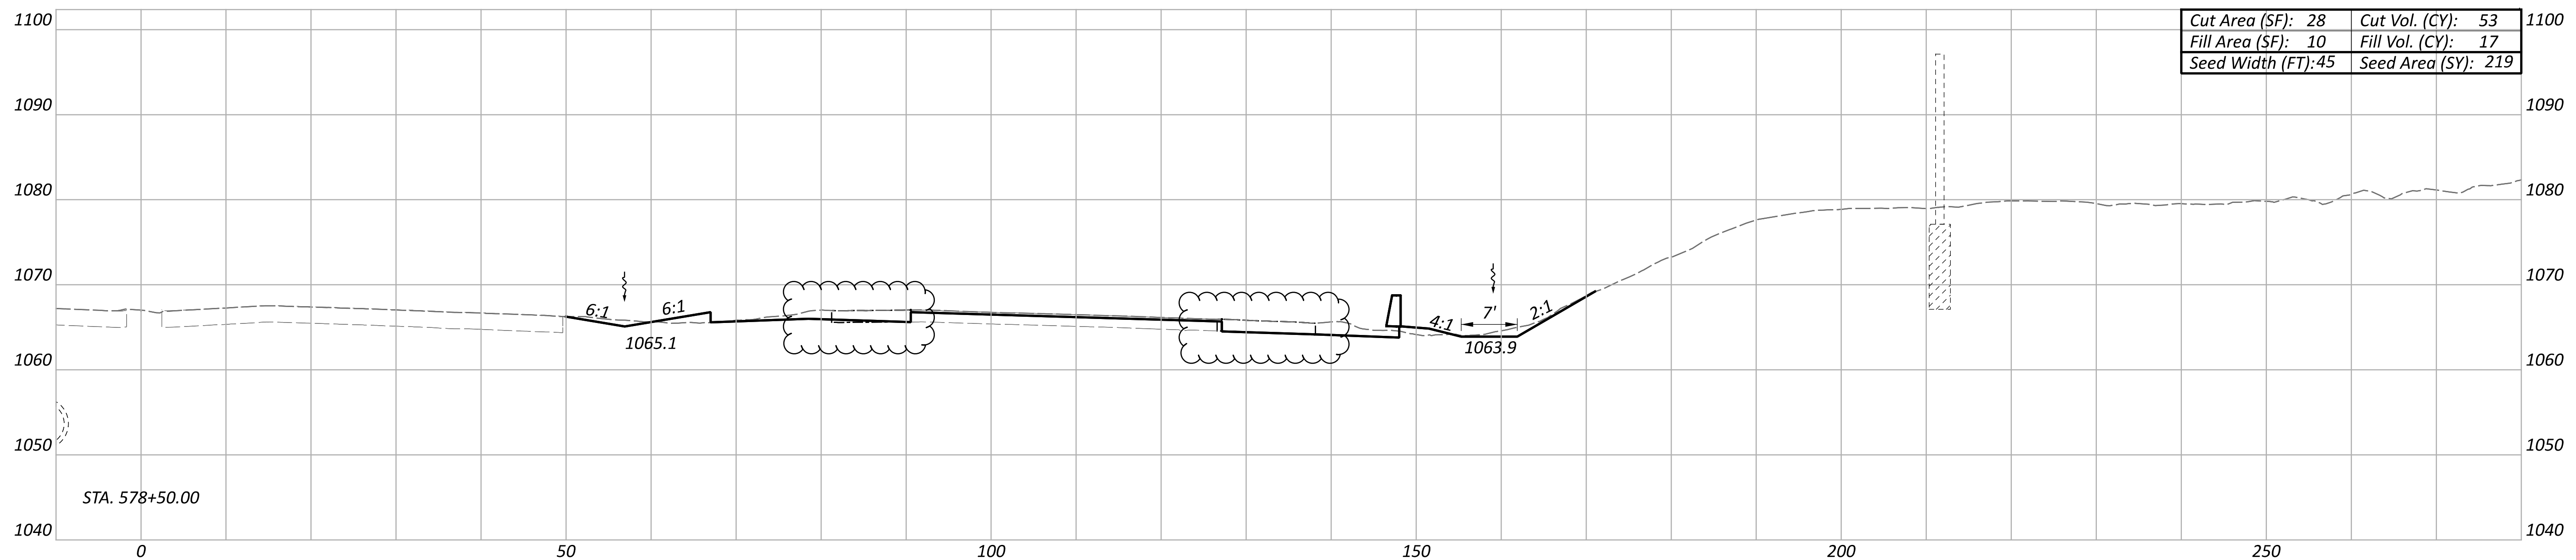
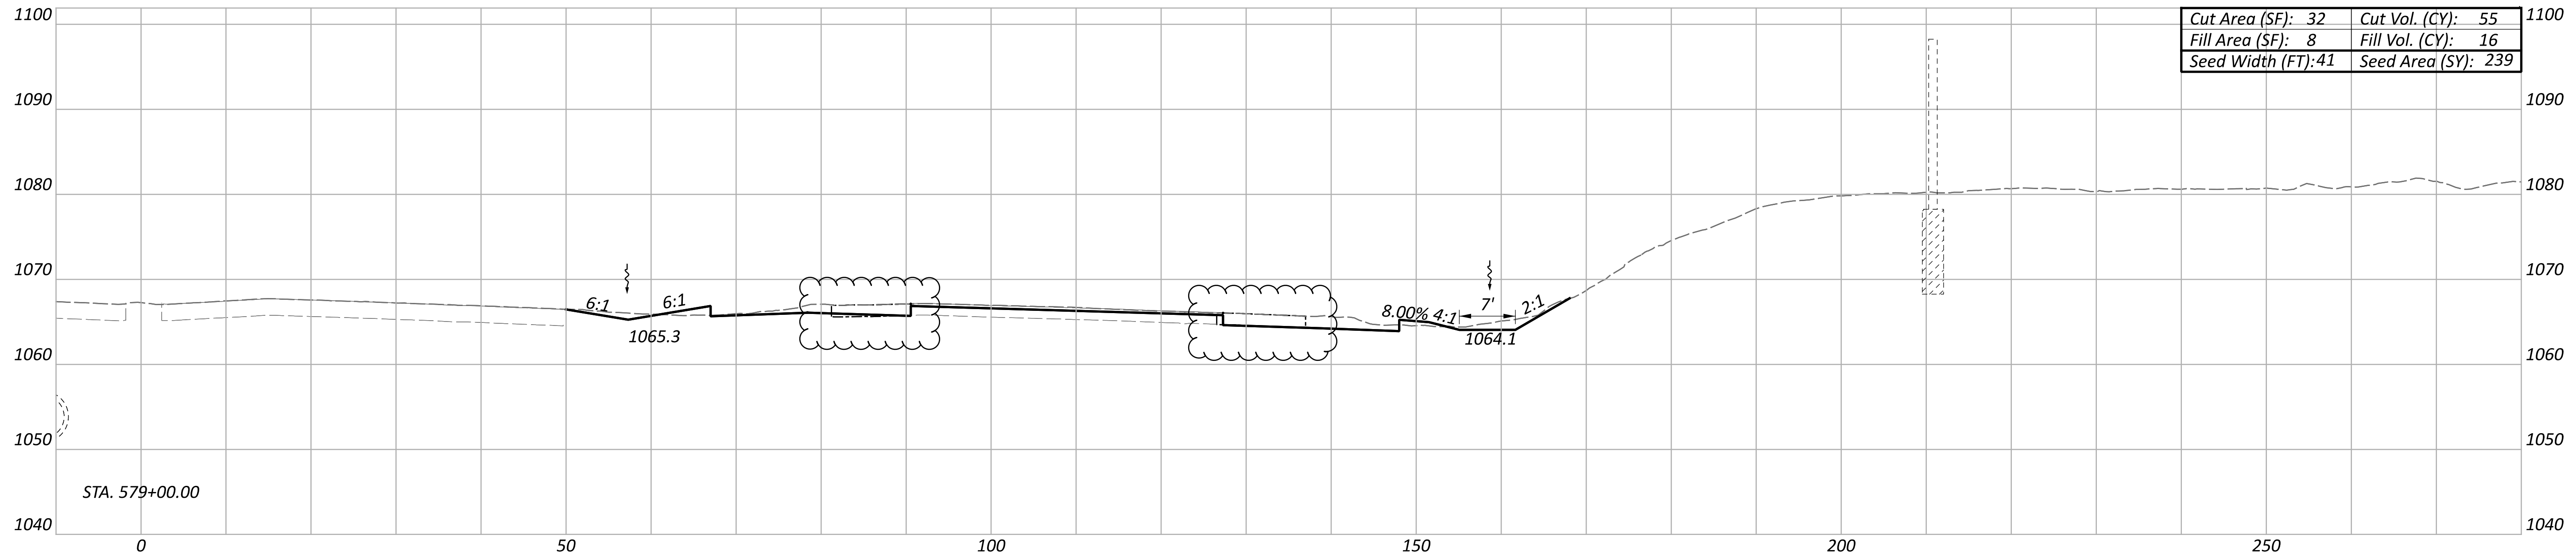


ITEM 202 - PAVEMENT REMOVED

CROSS SECTIONS
 STA. 578+50 TO STA. 579+00

DESIGN AGENCY
HNTB
 DESIGNER
 AS
 REVIEWER
 KKP 12/31/22
 PROJECT ID
 113156

Sheet Totals			SHEET	TOTAL
Seeding	Cut	Fill	153	233
458	108	33		

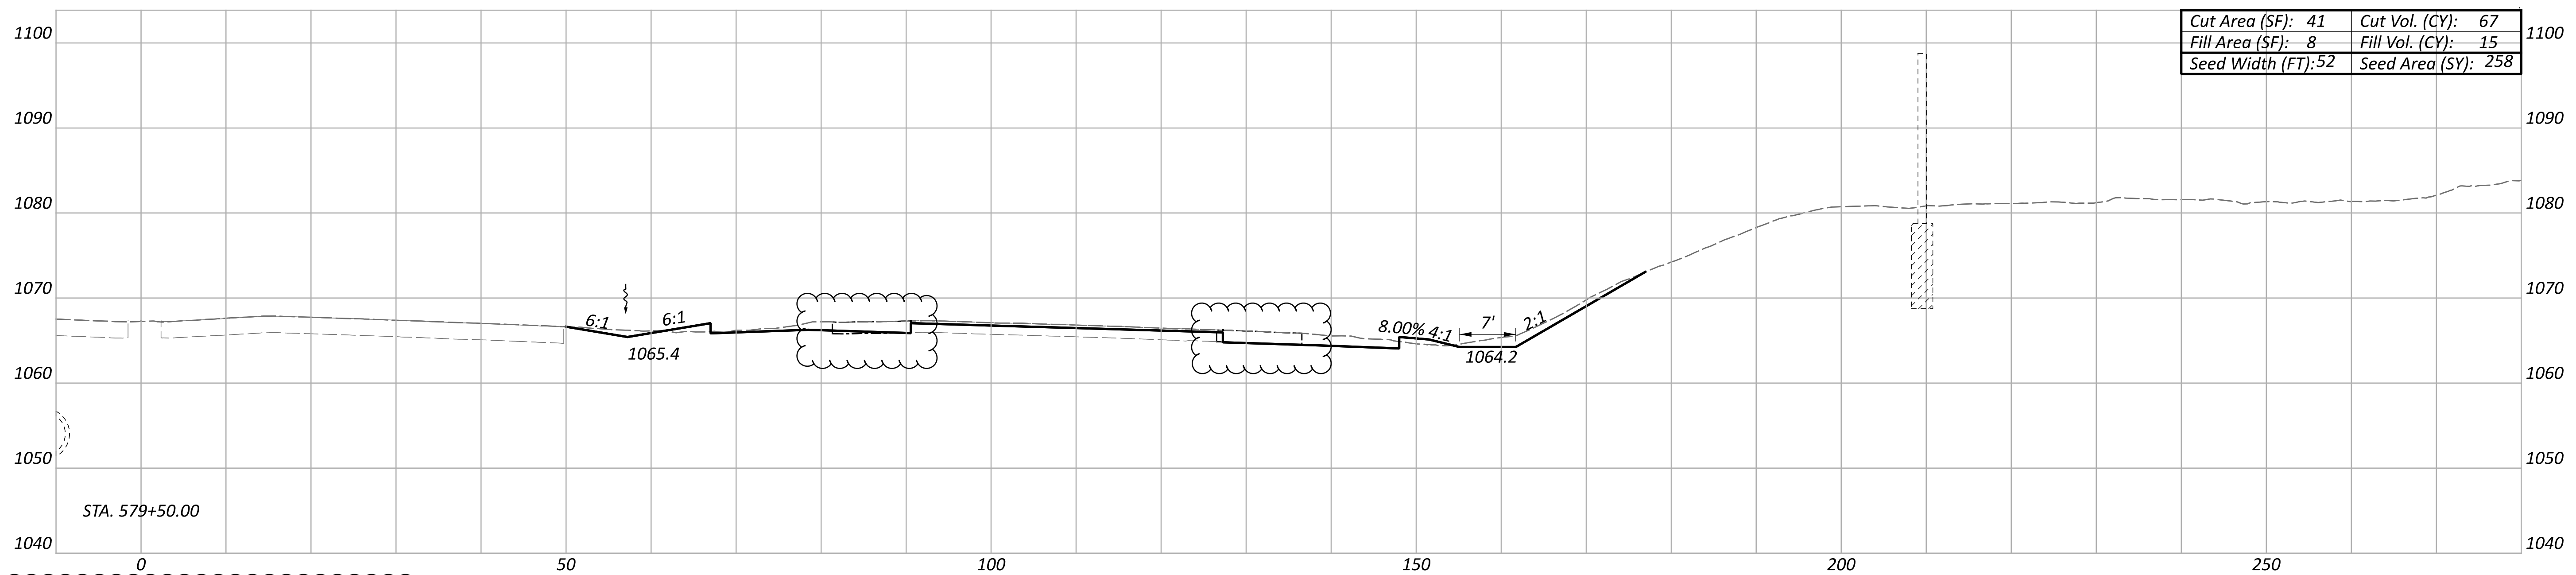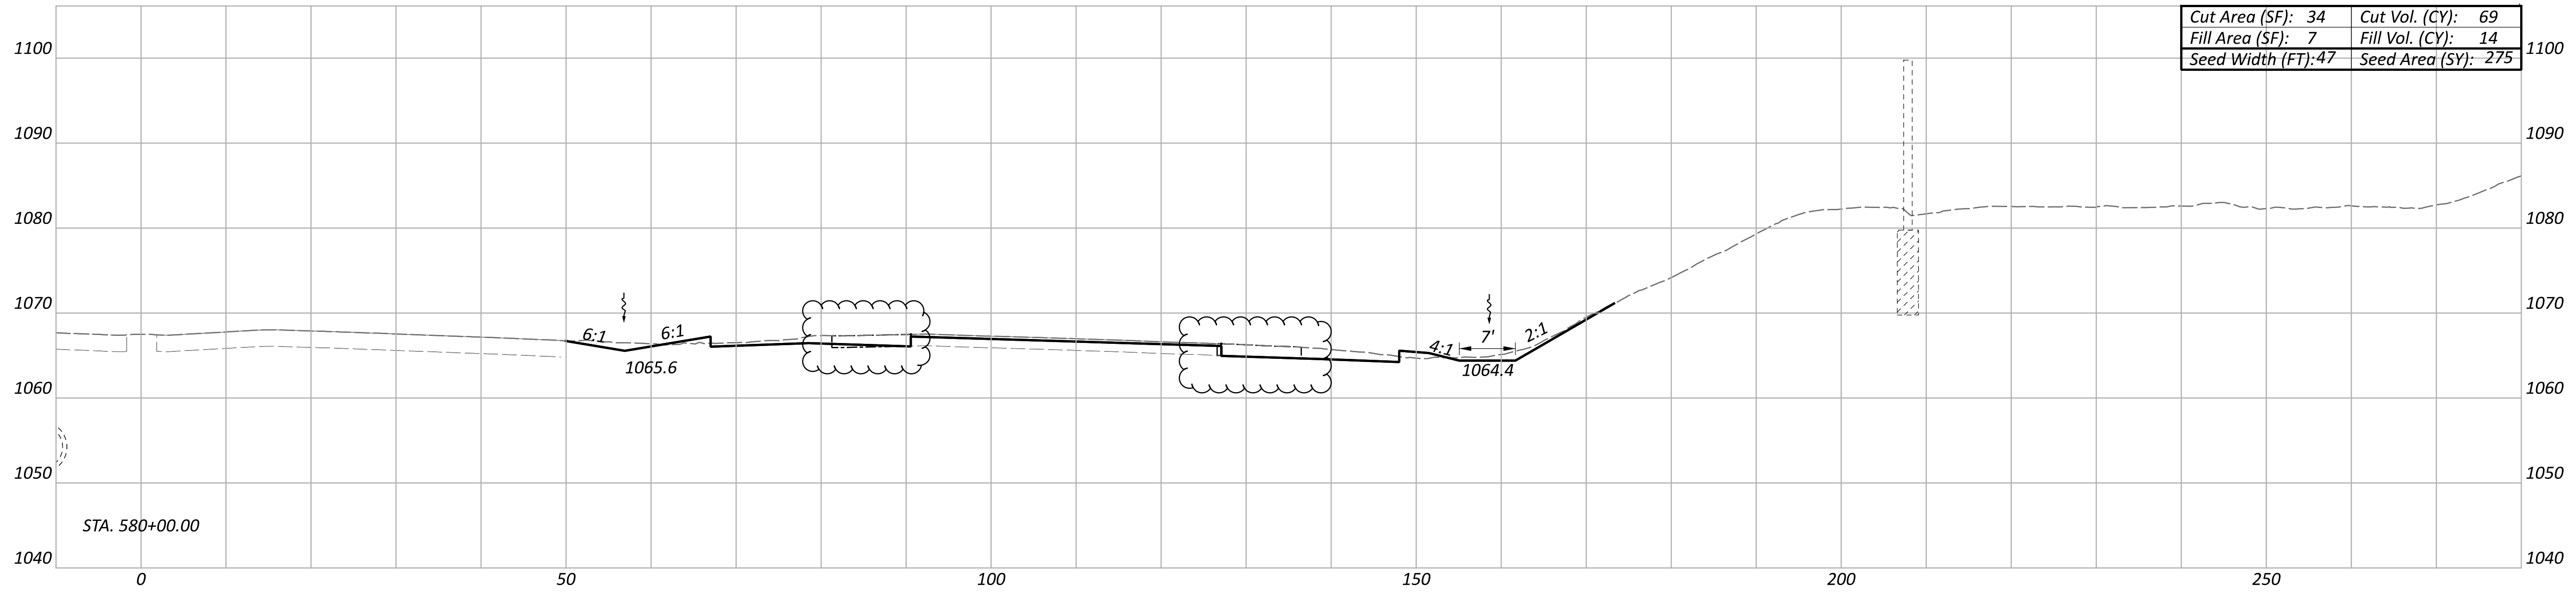

ITEM 202 - PAVEMENT REMOVED

CROSS SECTIONS
 STA. 579+50 TO STA. 580+00

DESIGN AGENCY



DESIGNER

AS

REVIEWER



KKP 12/31/22

PROJECT ID

113156

Sheet Totals		
Seeding	Cut	Fill
533	136	29

SHEET	TOTAL
154	233

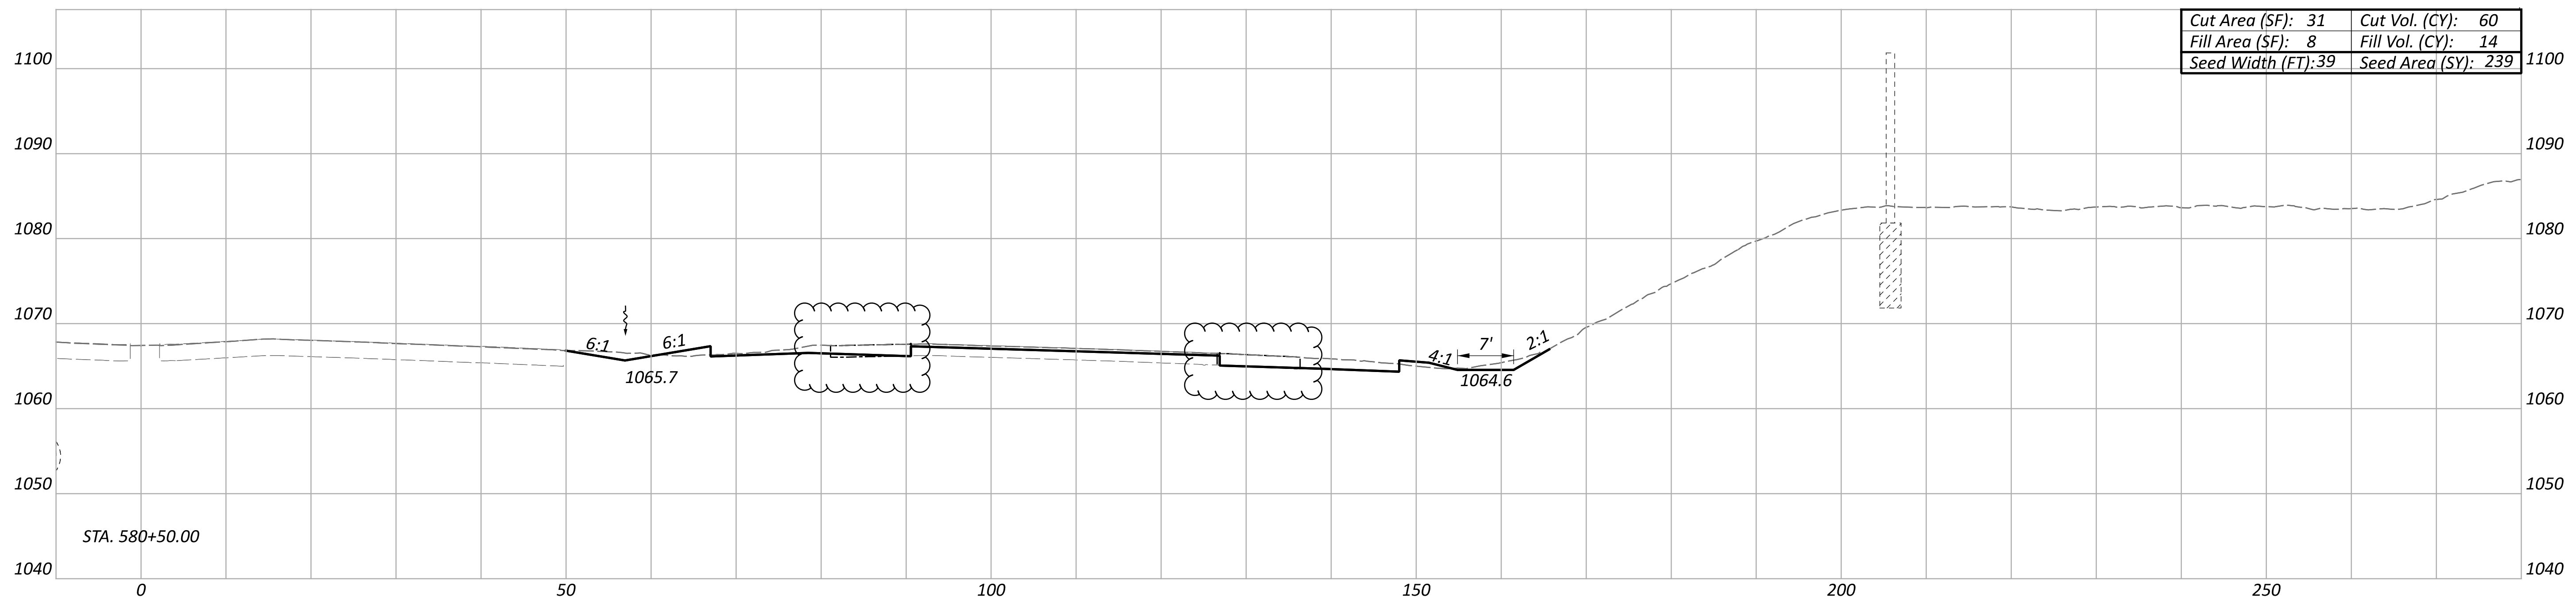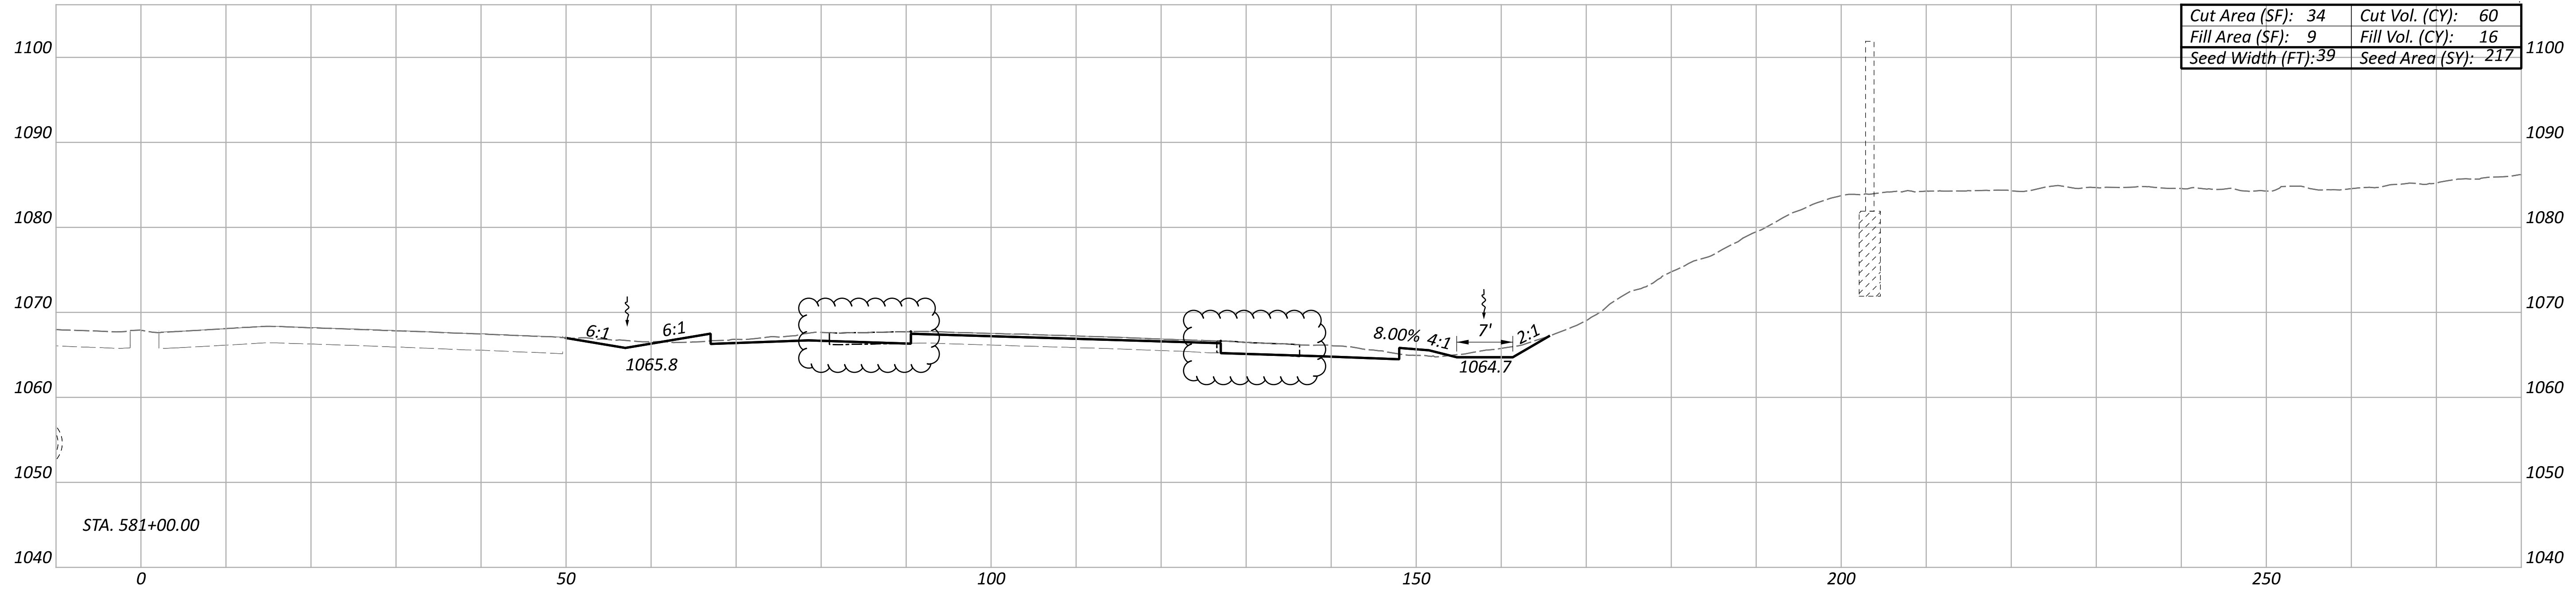

ITEM 202 - PAVEMENT REMOVED

CROSS SECTIONS
 STA. 580+50 TO STA. 581+00

DESIGN AGENCY



DESIGNER

AS

REVIEWER



KKP 12/31/22

PROJECT ID

113156

Sheet Totals		
Seeding	Cut	Fill
456	121	30

SHEET	TOTAL
155	233

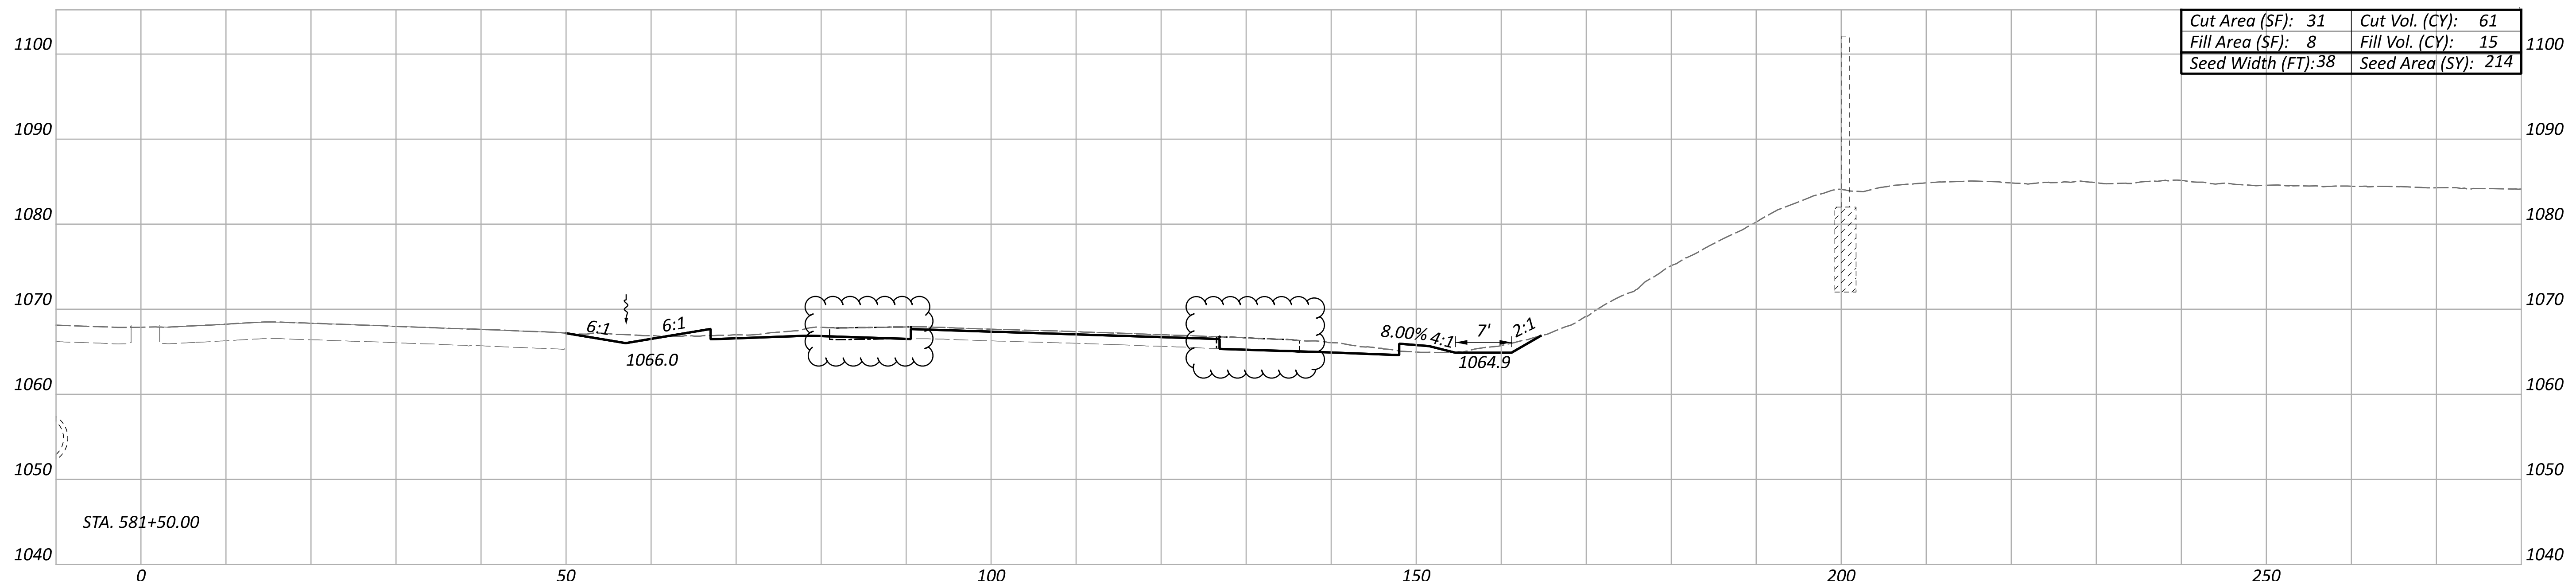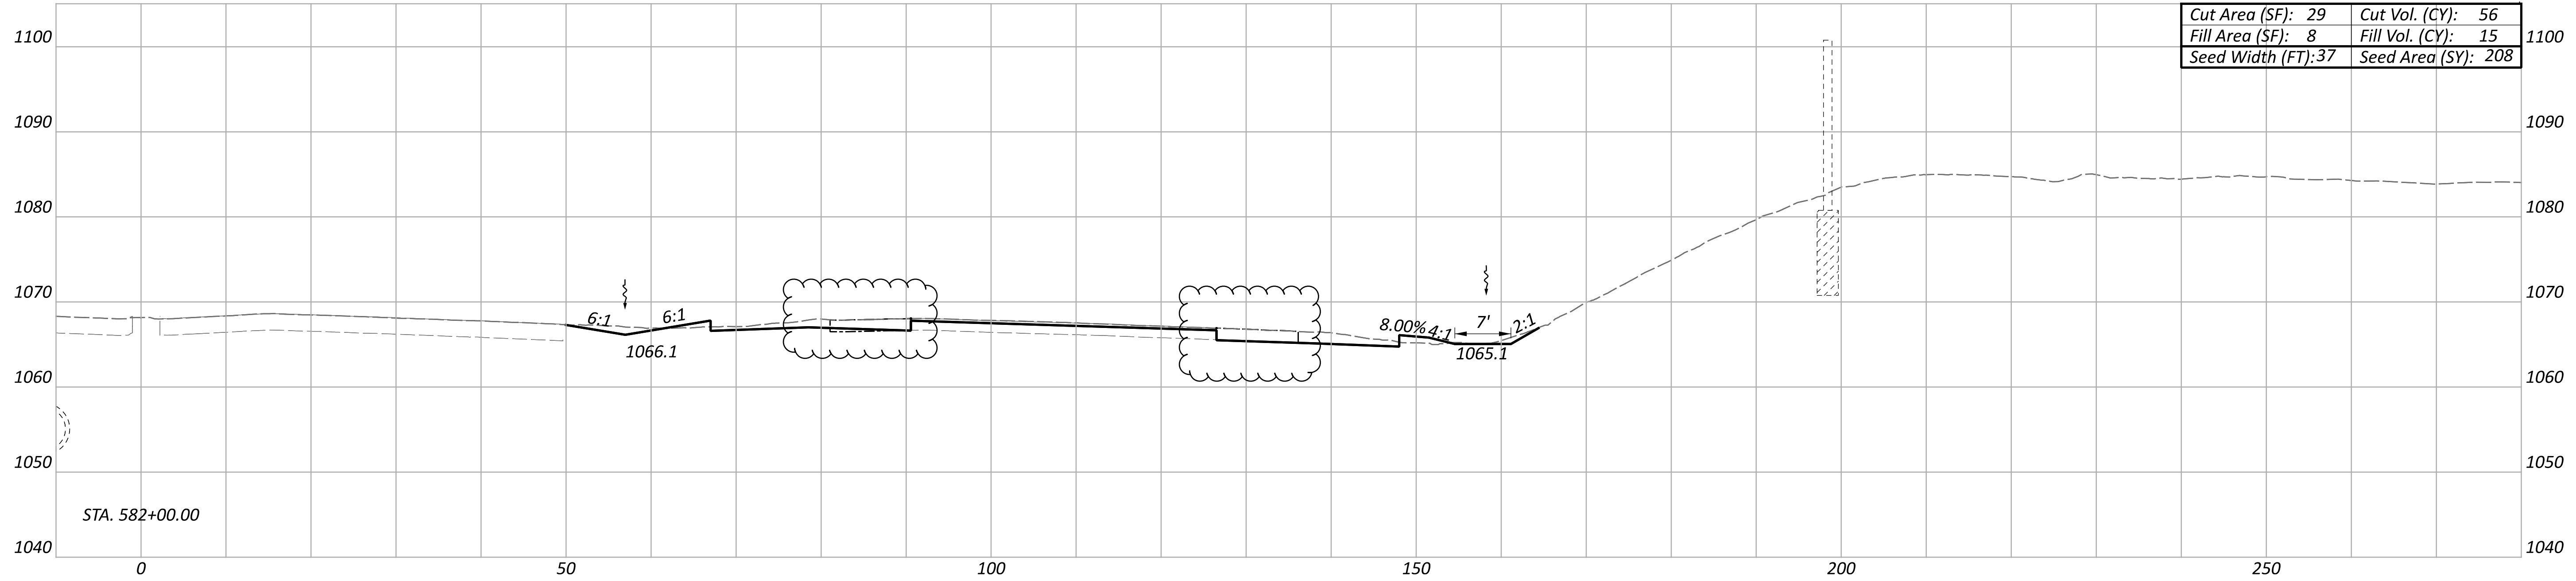

ITEM 202 - PAVEMENT REMOVED

CROSS SECTIONS
 STA. 581+50 TO STA. 582+00

DESIGN AGENCY





DESIGNER
 AS

REVIEWER
 KKP 12/31/22

PROJECT ID
 113156

Sheet Totals			SHEET TOTAL	
Seeding	Cut	Fill	156	233
422	117	30		

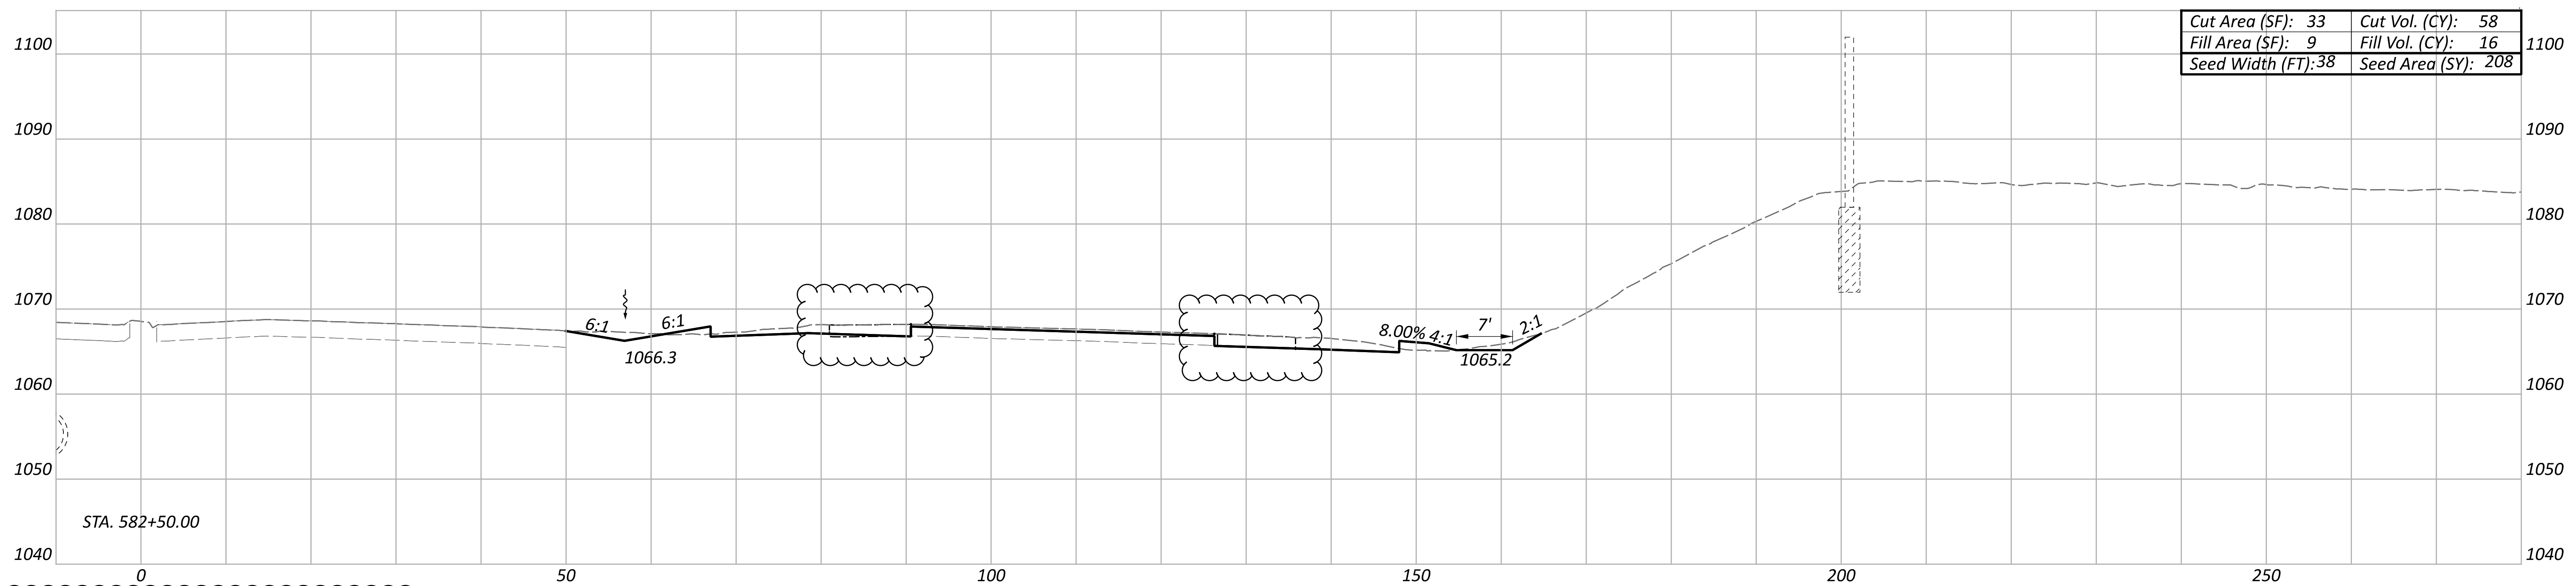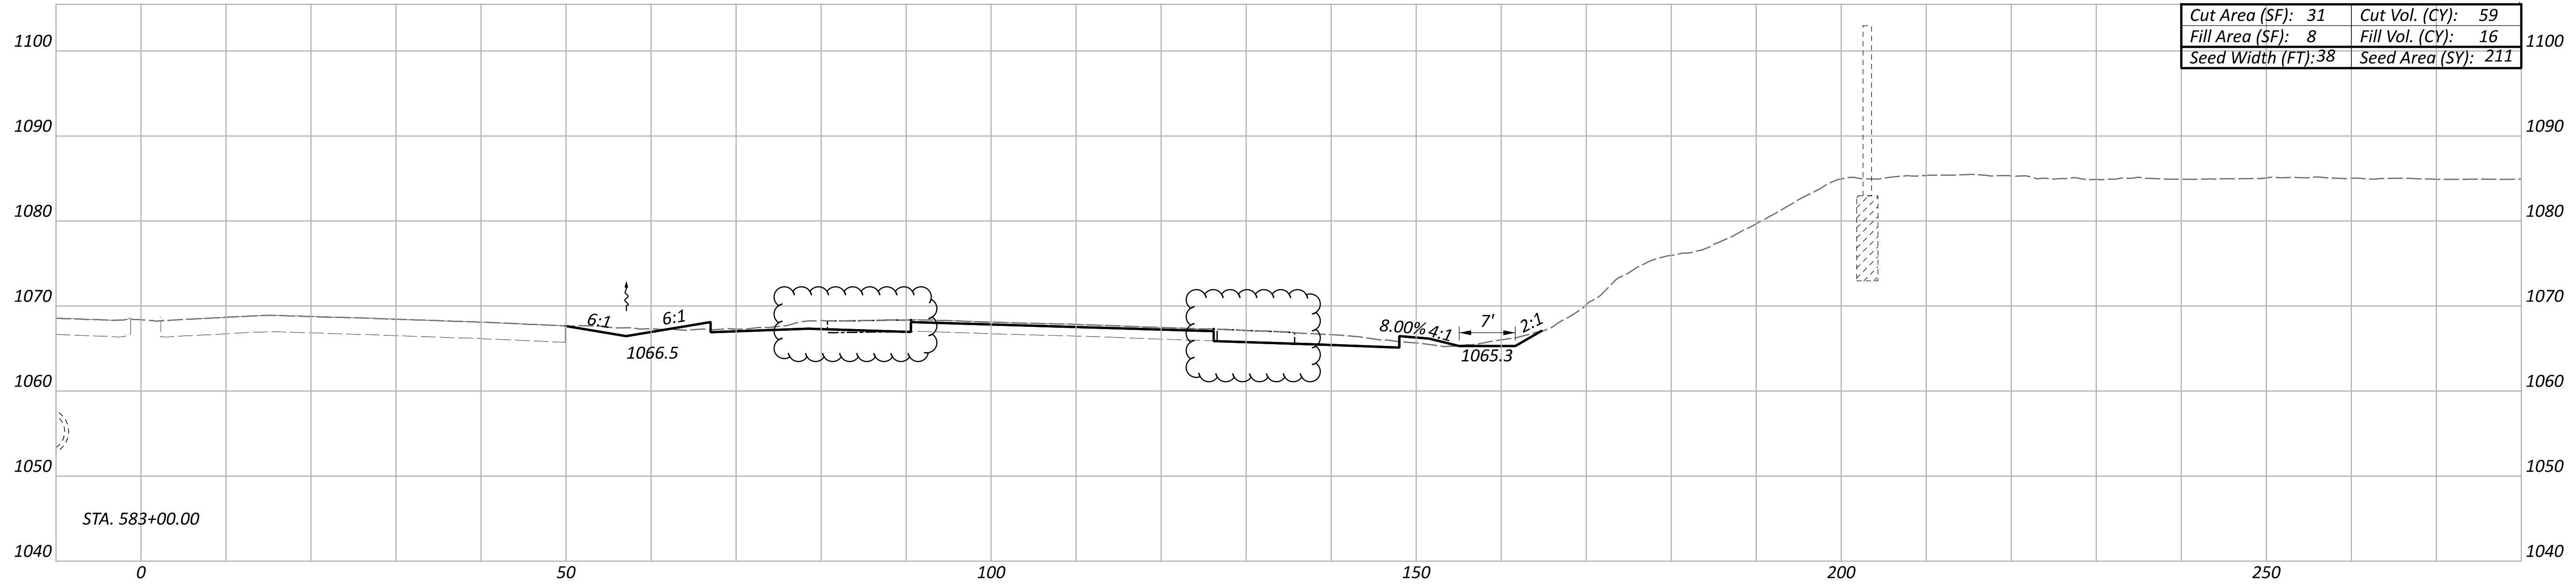

ITEM 202 - PAVEMENT REMOVED

CROSS SECTIONS
 STA. 582+50 TO STA. 583+00

DESIGN AGENCY



DESIGNER

AS

REVIEWER



KKP 12/31/22

PROJECT ID

113156

Sheet Totals		
Seeding	Cut	Fill
419	117	32

SHEET	TOTAL
157	233

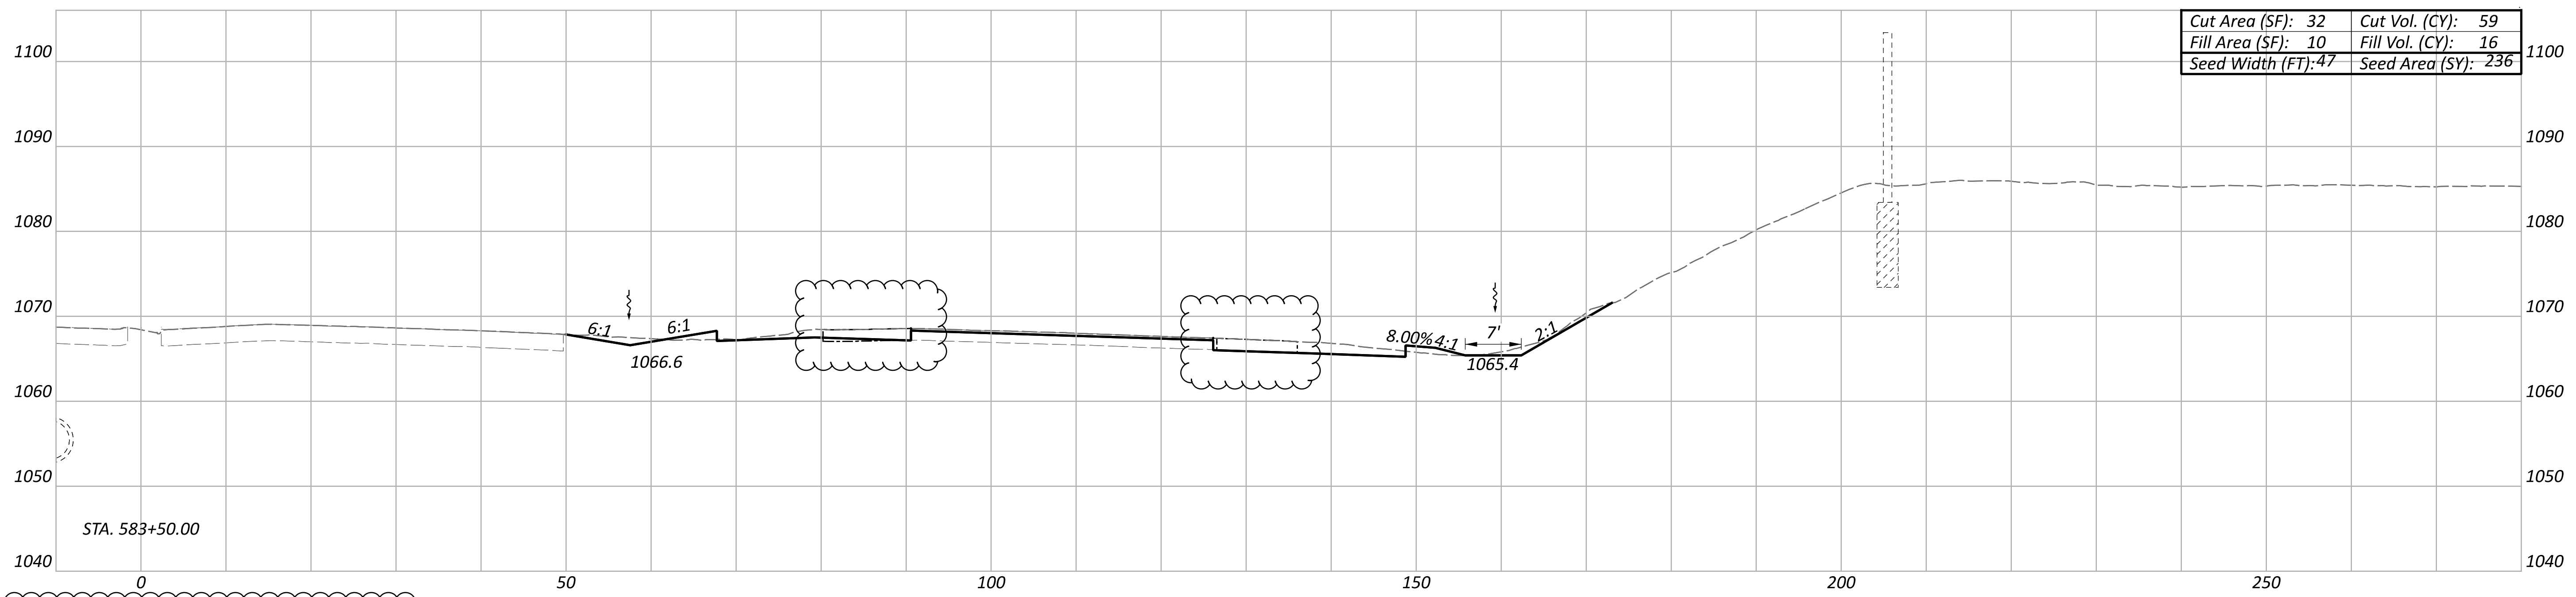
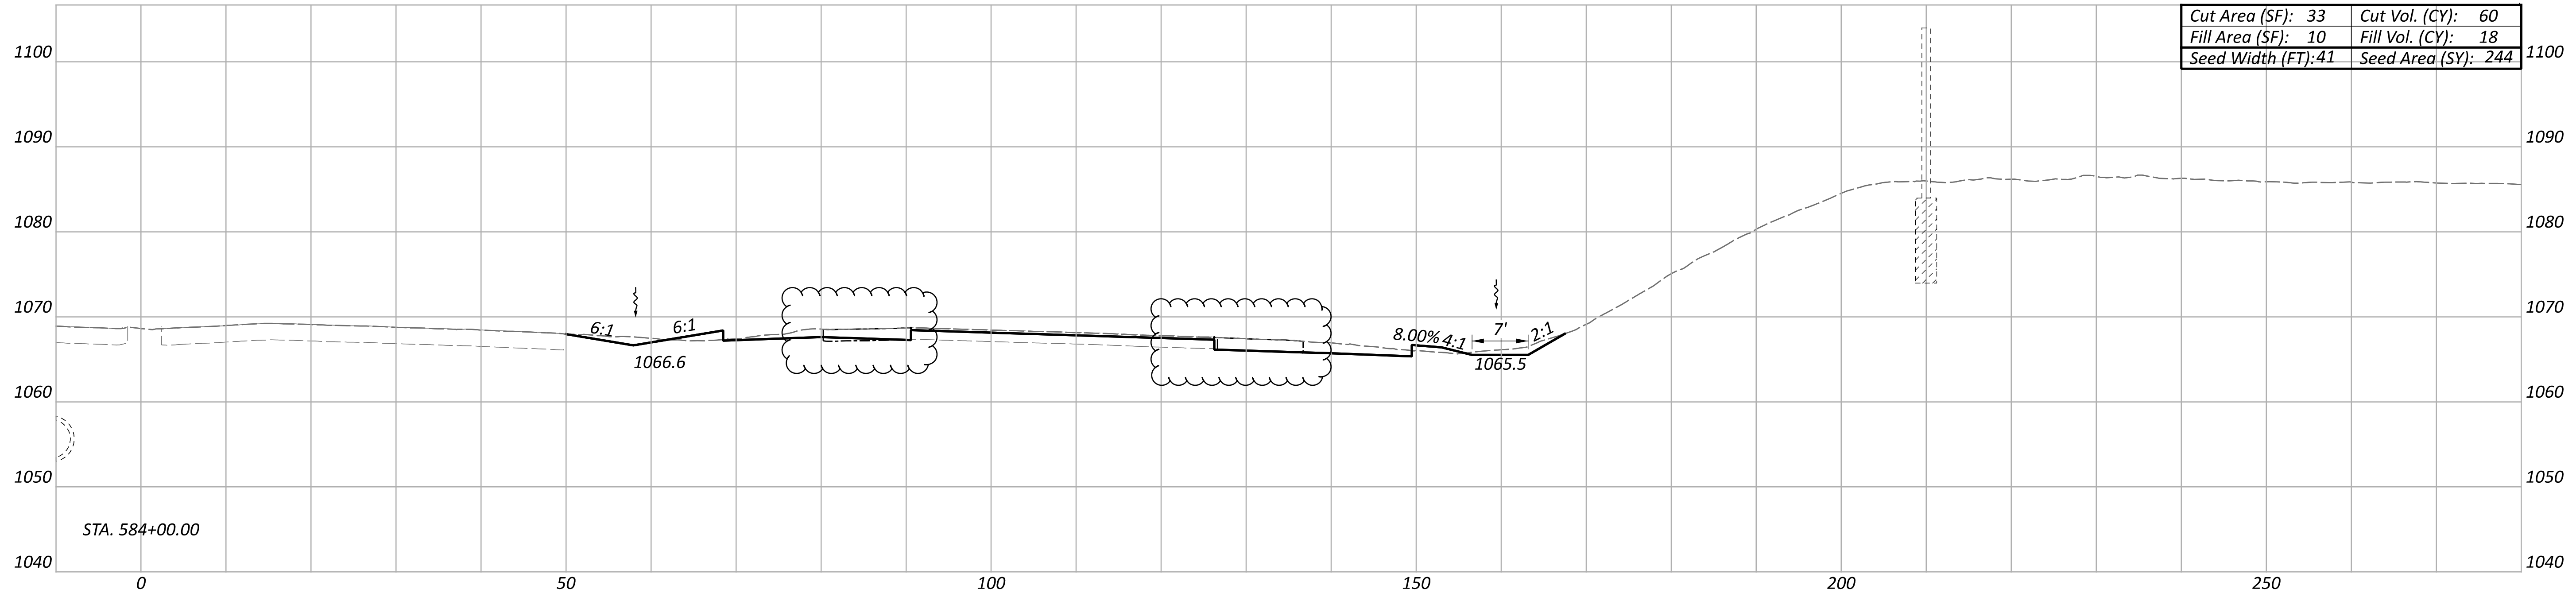


ITEM 202 - PAVEMENT REMOVED

CROSS SECTIONS
 STA. 583+50 TO STA. 584+00

DESIGN AGENCY
HNTB
 DESIGNER
 AS
 REVIEWER
 KKP 12/31/22
 PROJECT ID
 113156

Sheet Totals			SHEET TOTAL	
Seeding	Cut	Fill	SHEET	TOTAL
480	119	34	158	233

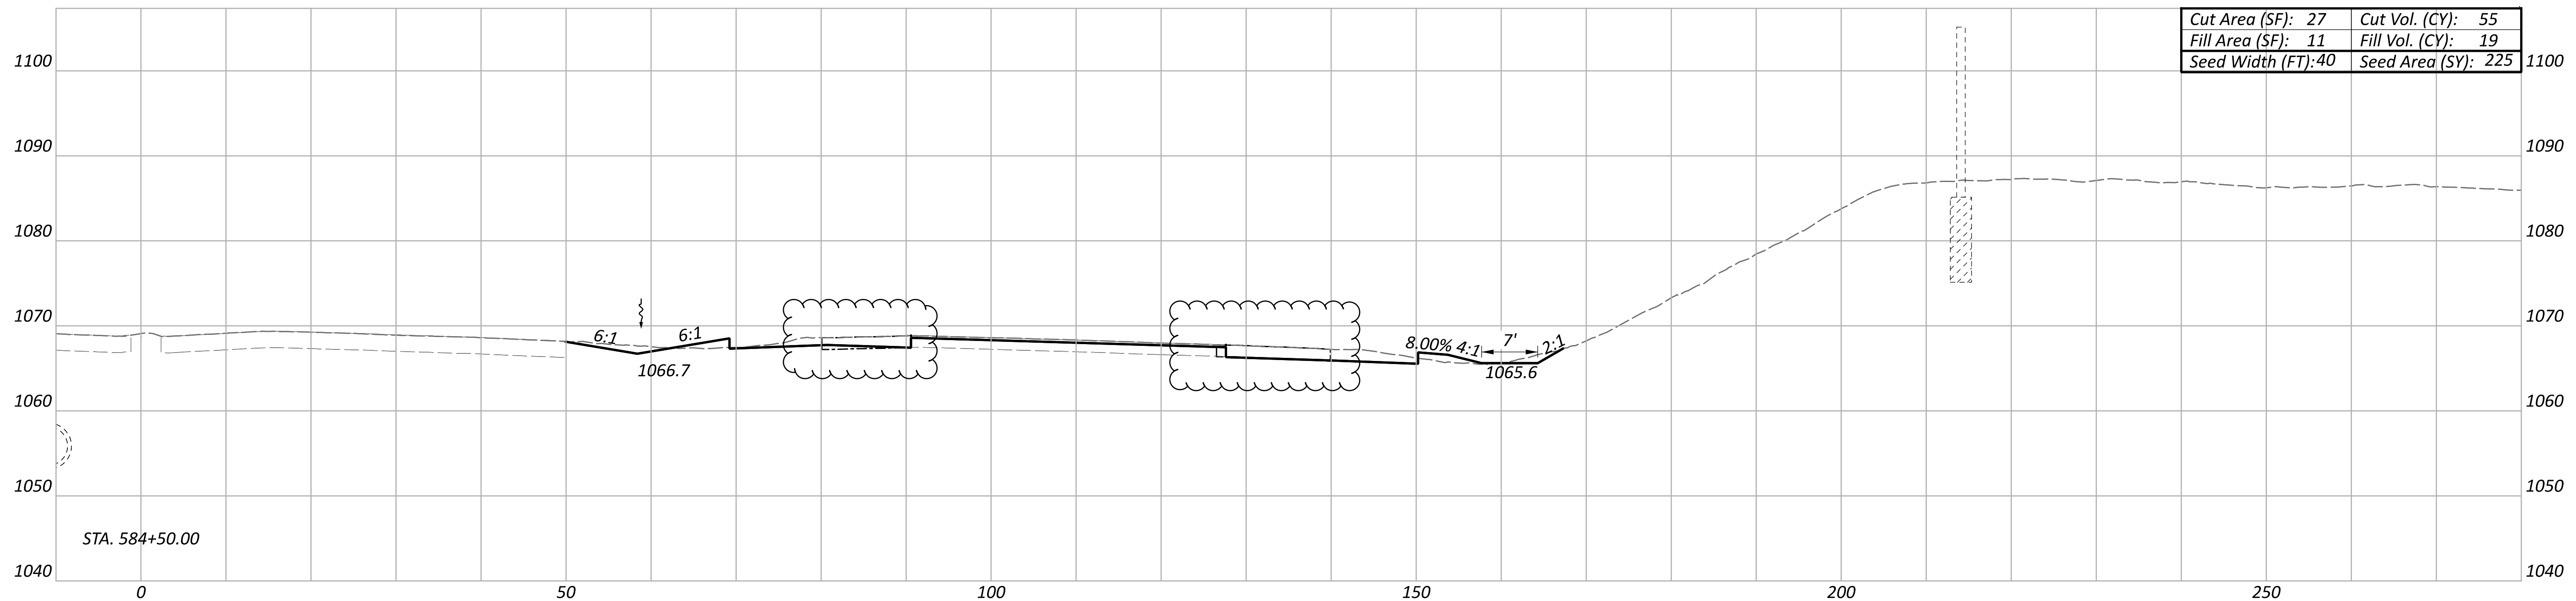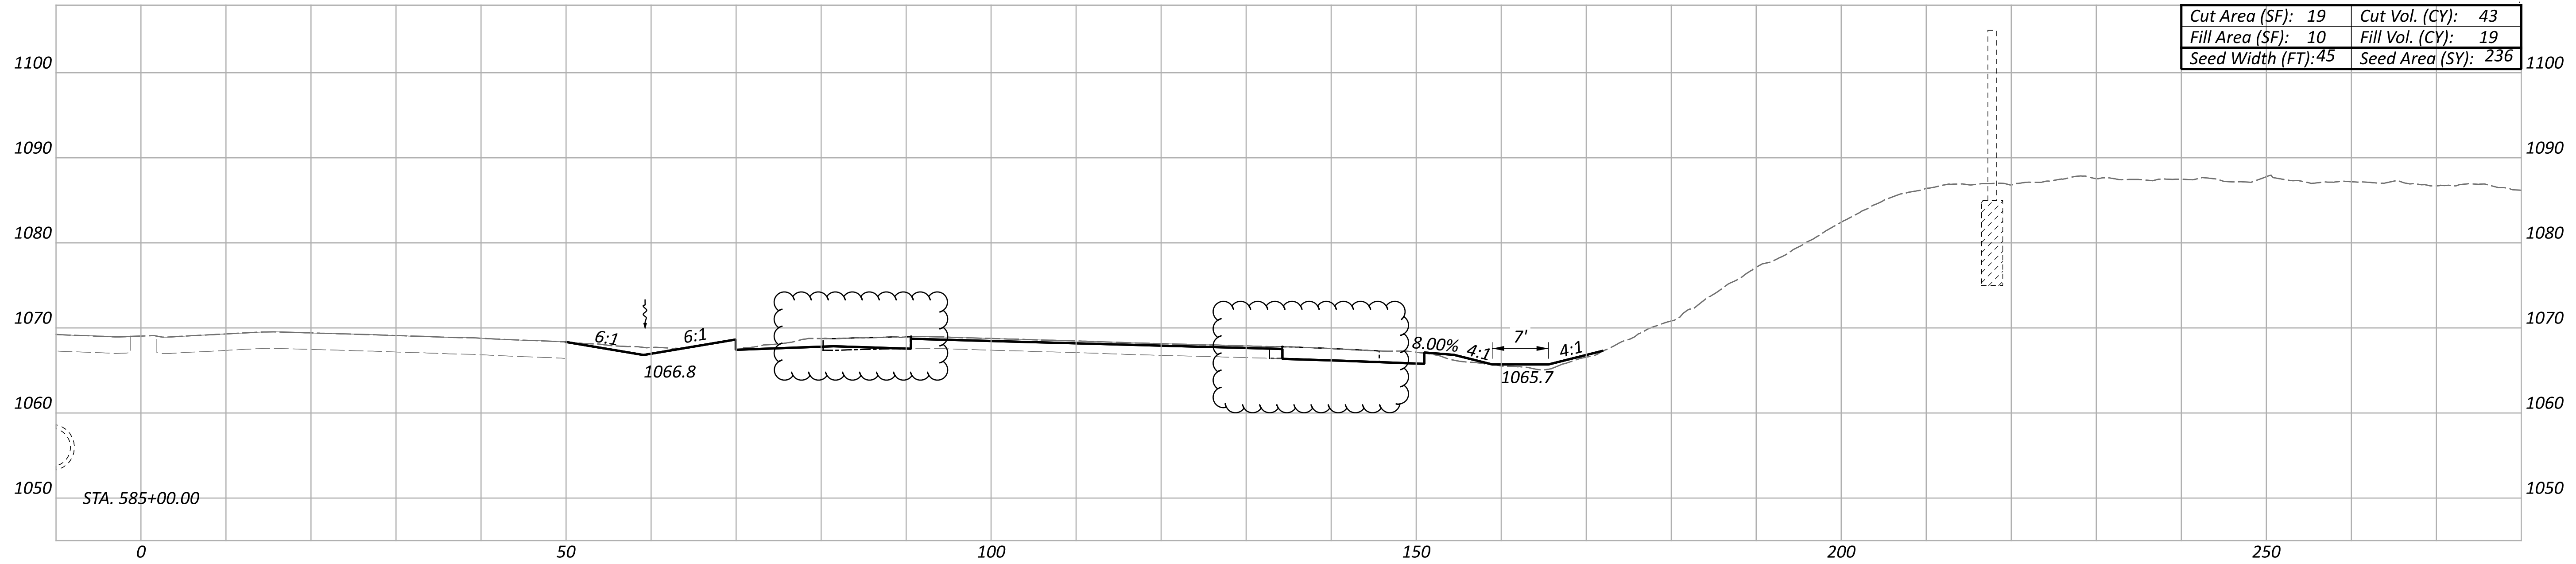

ITEM 202 - PAVEMENT REMOVED

CROSS SECTIONS
 STA. 584+50 TO STA. 585+00

DESIGN AGENCY





DESIGNER
 AS

REVIEWER
 KKP 12/31/22

PROJECT ID
 113156

Sheet Totals			SHEET TOTAL	
Seeding	Cut	Fill	SHEET	TOTAL
461	98	39	159	233

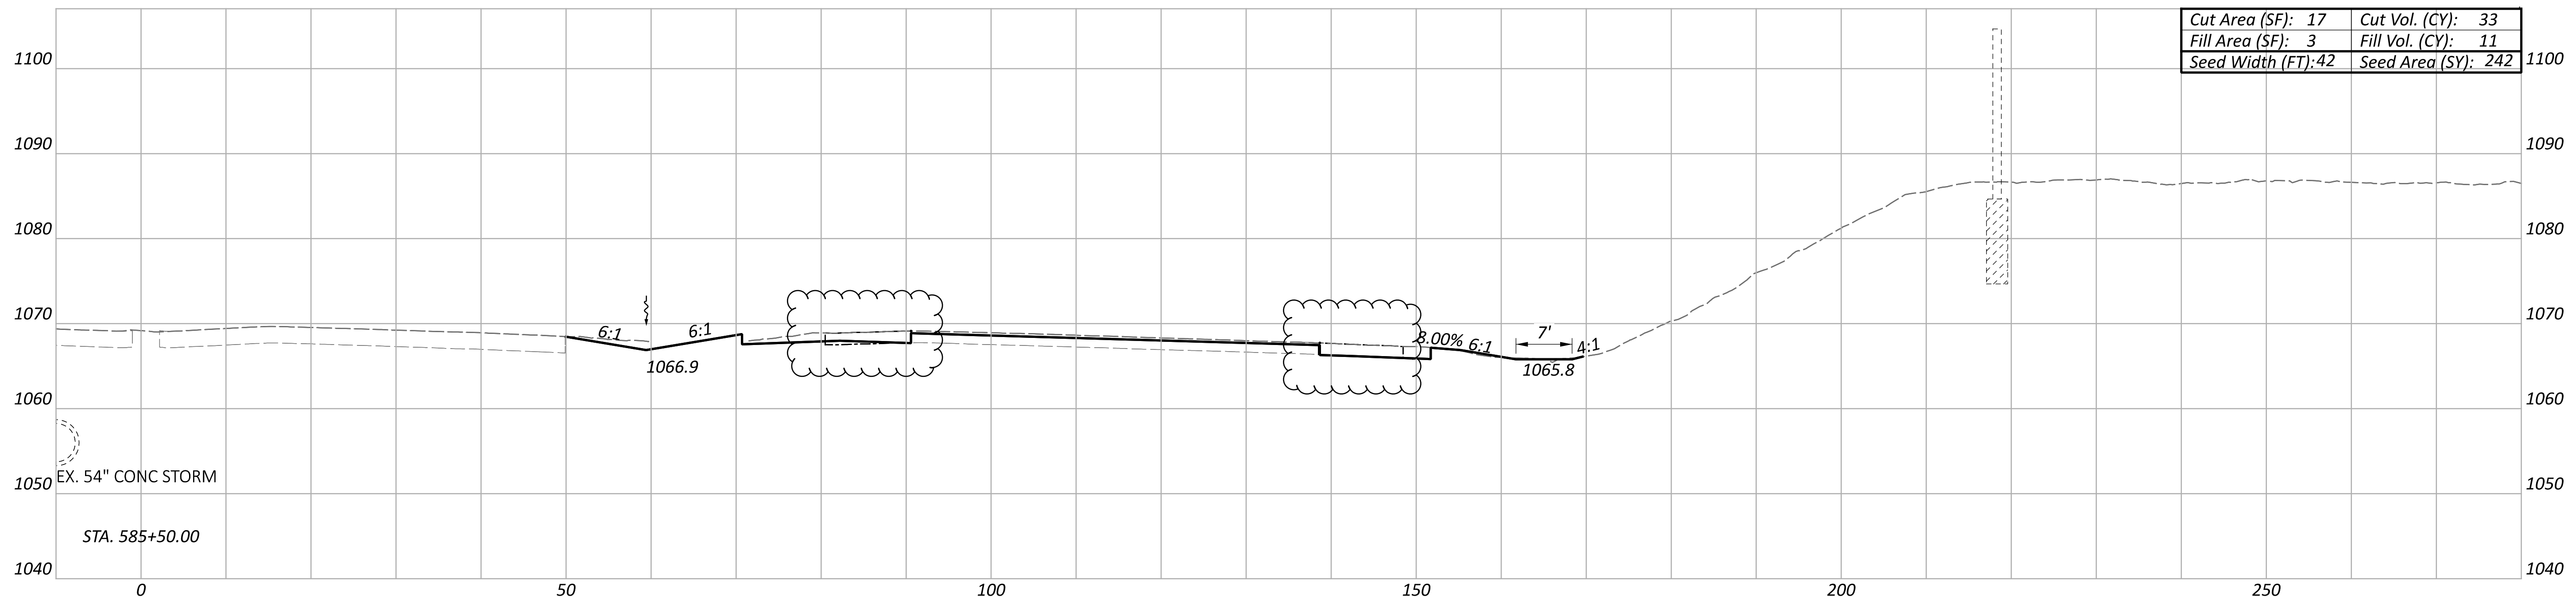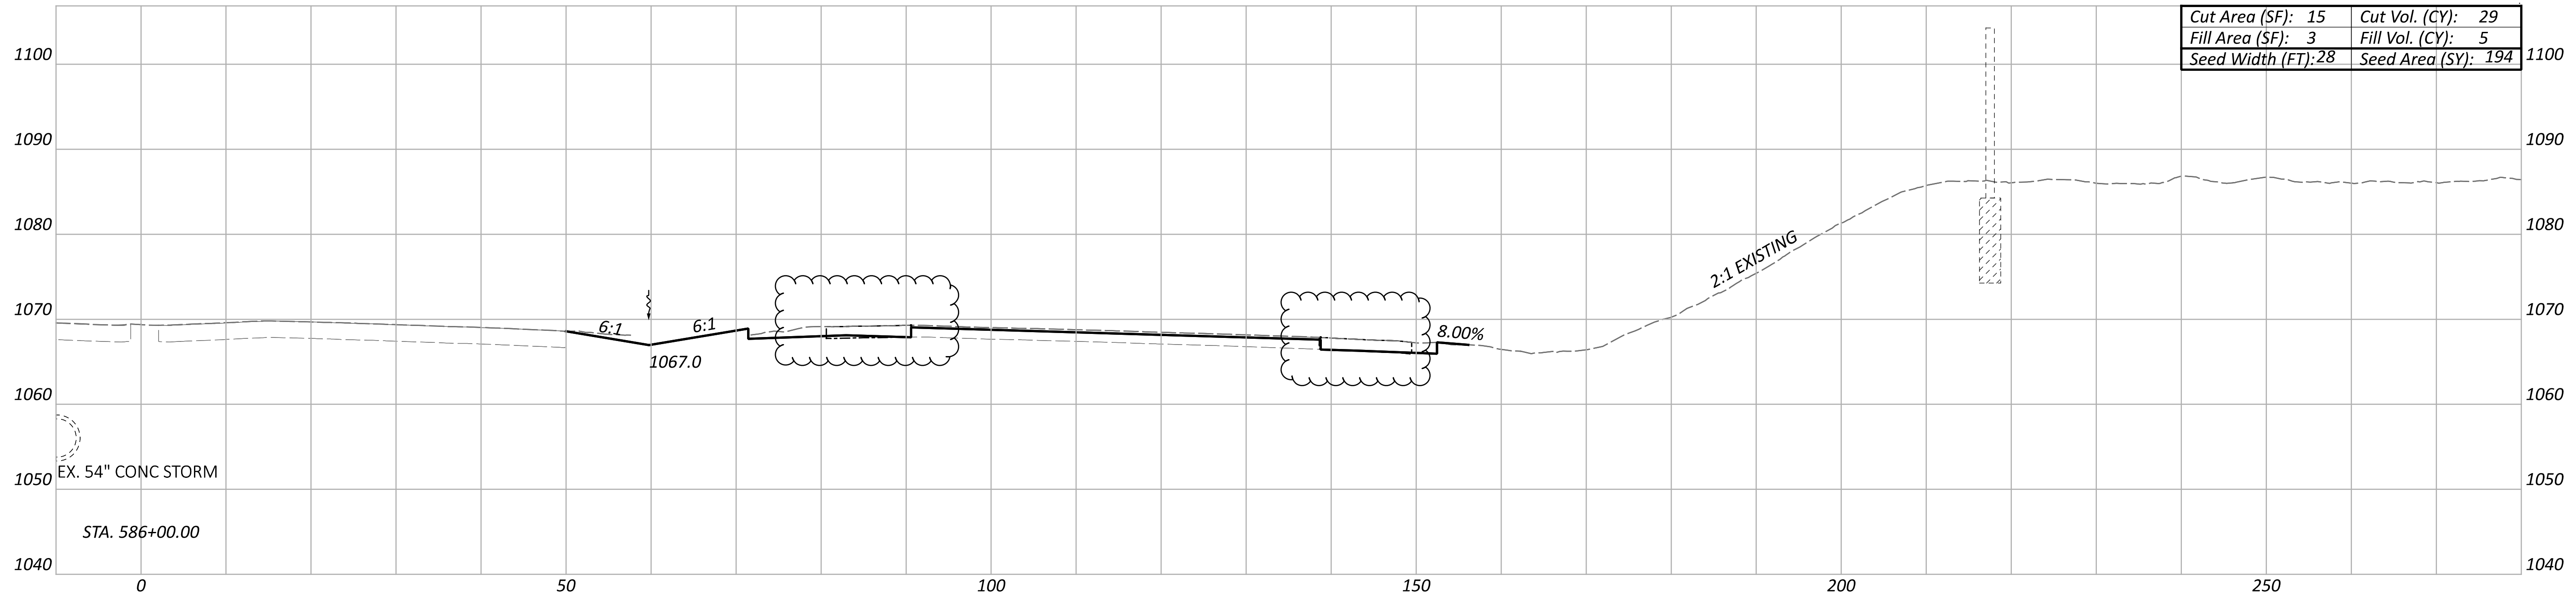

ITEM 202 - PAVEMENT REMOVED

CROSS SECTIONS
 STA. 585+50 TO STA. 586+00

DESIGN AGENCY



DESIGNER

AS

REVIEWER


KKP 12/31/22

PROJECT ID


113156

Sheet Totals		
Seeding	Cut	Fill
436	62	16

SHEET	TOTAL
160	233

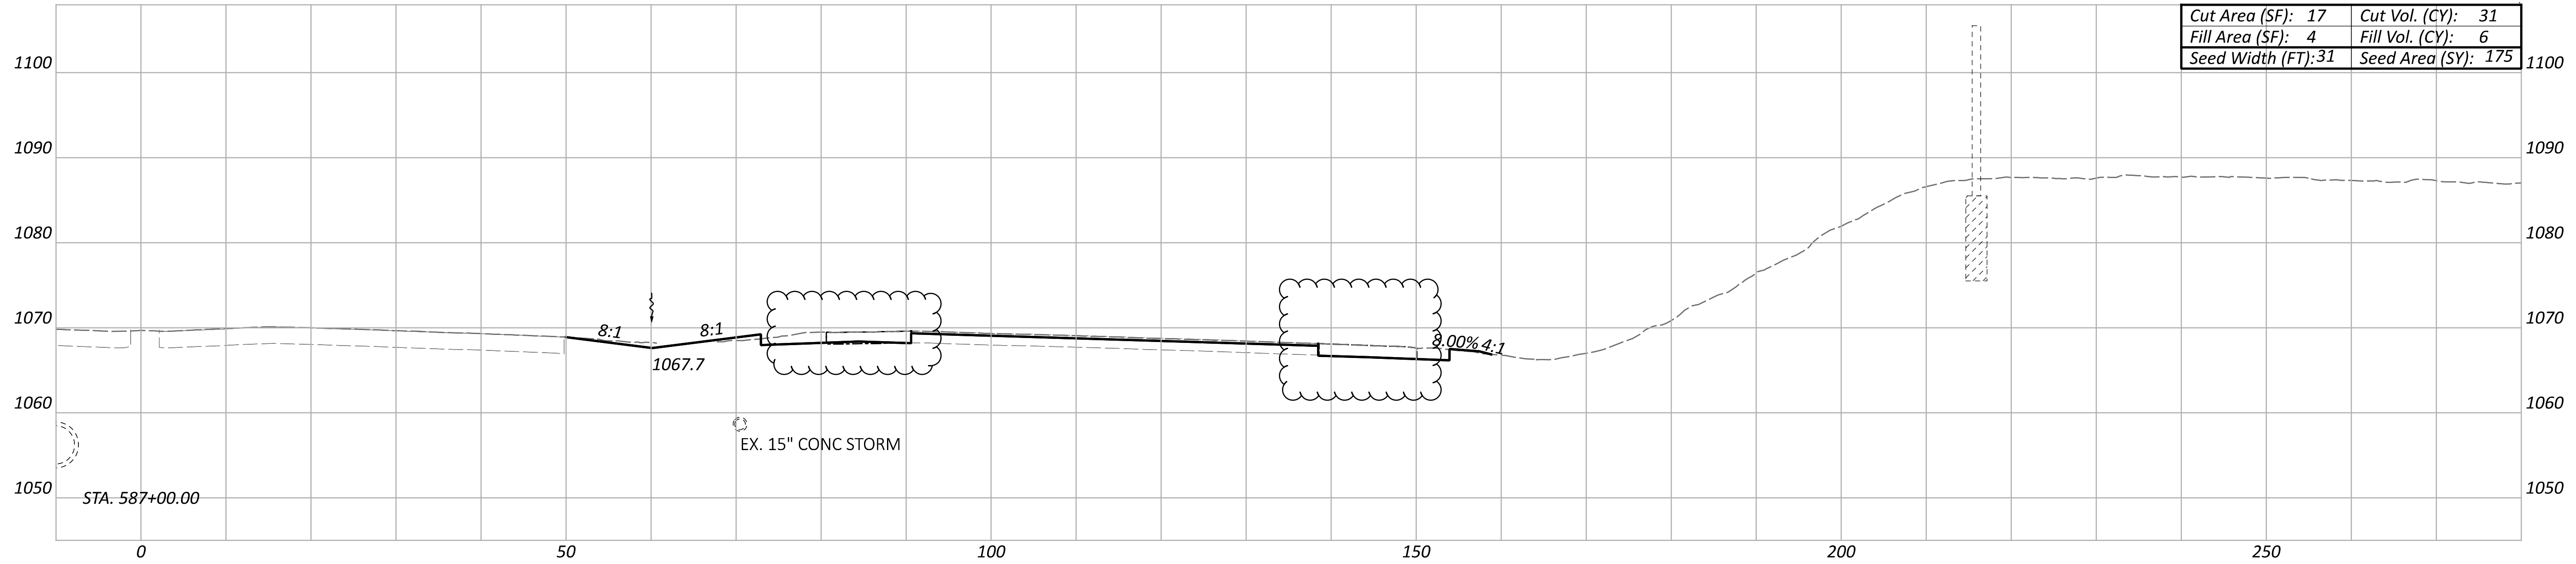

Cut Area (SF): 17	Cut Vol. (CY): 31
Fill Area (SF): 4	Fill Vol. (CY): 6
Seed Width (FT): 31	Seed Area (SY): 175

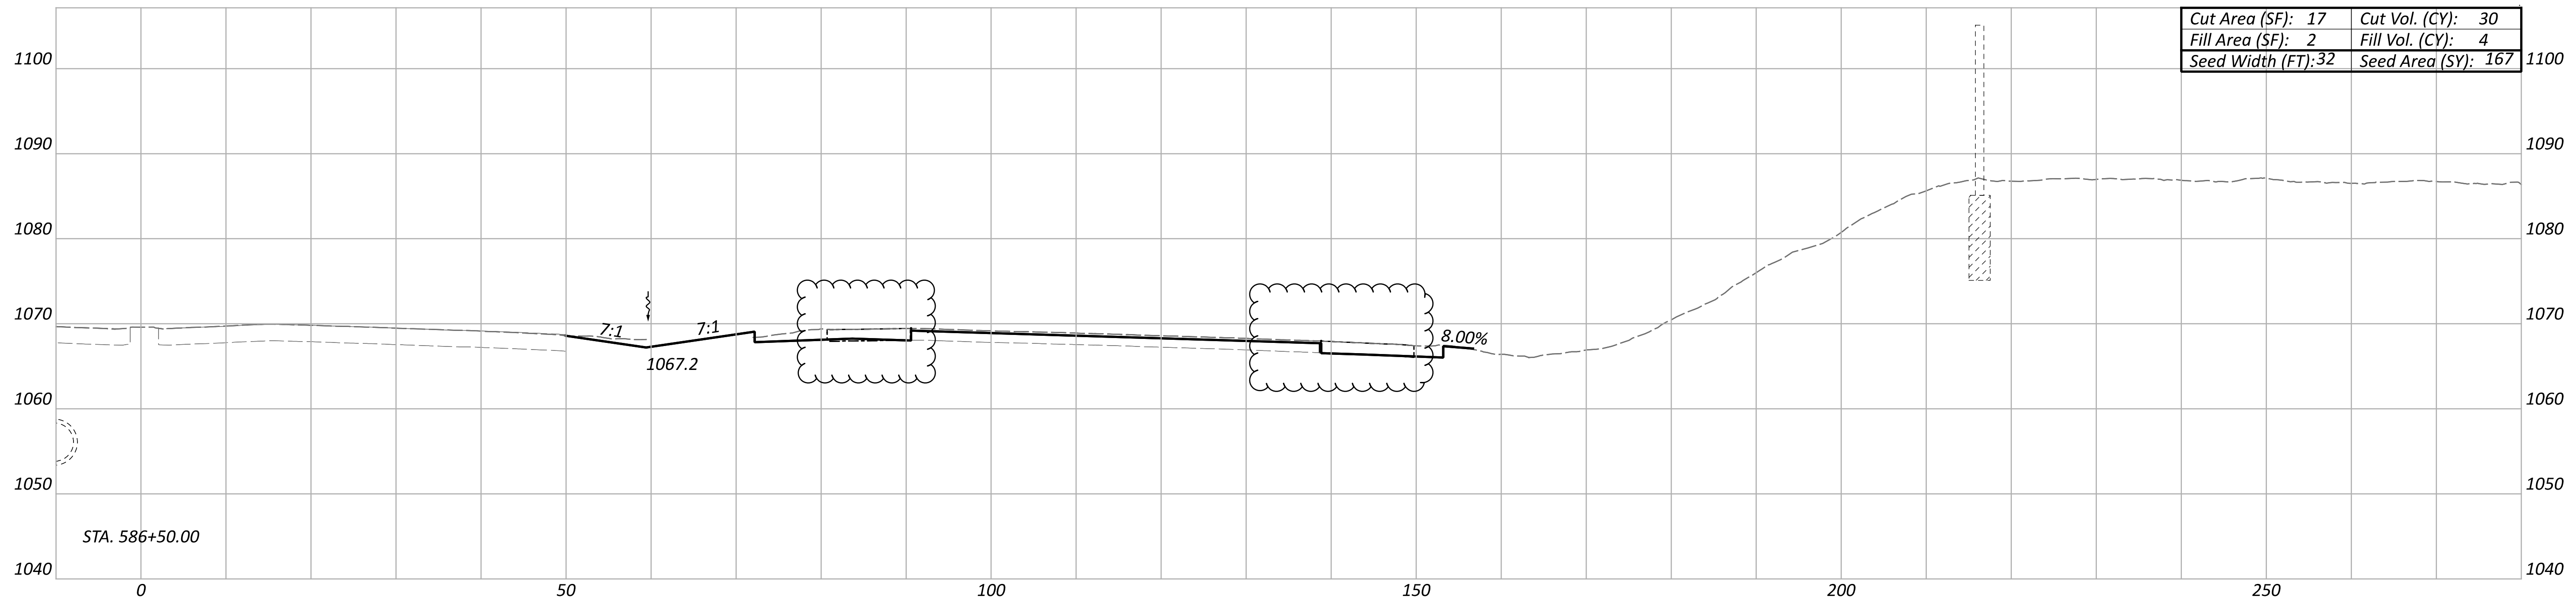


Cut Area (SF): 17	Cut Vol. (CY): 30
Fill Area (SF): 2	Fill Vol. (CY): 4
Seed Width (FT): 32	Seed Area (SY): 167

ITEM 202 - PAVEMENT REMOVED


CROSS SECTIONS
 STA. 586+50 TO STA. 587+00

DESIGN AGENCY
HNTB
 DESIGNER
 AS
 REVIEWER
 KKP 12/31/22
 PROJECT ID
 113156

Sheet Totals			SHEET TOTAL	
Seeding	Cut	Fill	SHEET	TOTAL
342	61	10	161	233

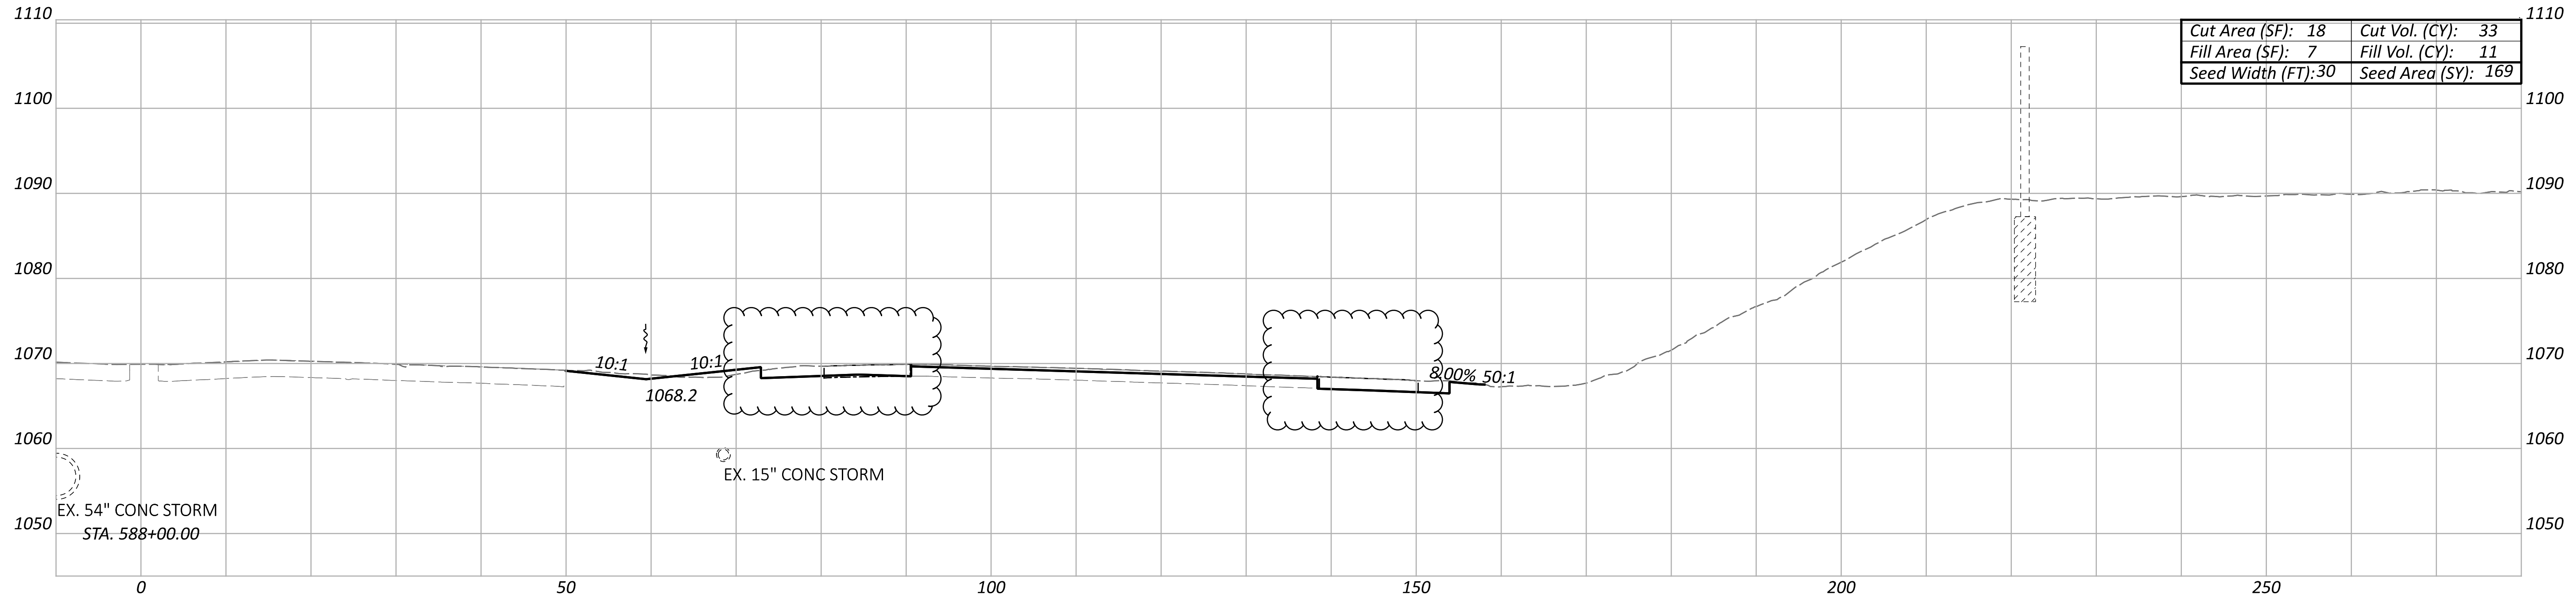

Cut Area (SF): 18	Cut Vol. (CY): 33
Fill Area (SF): 7	Fill Vol. (CY): 11
Seed Width (FT): 30	Seed Area (SY): 169

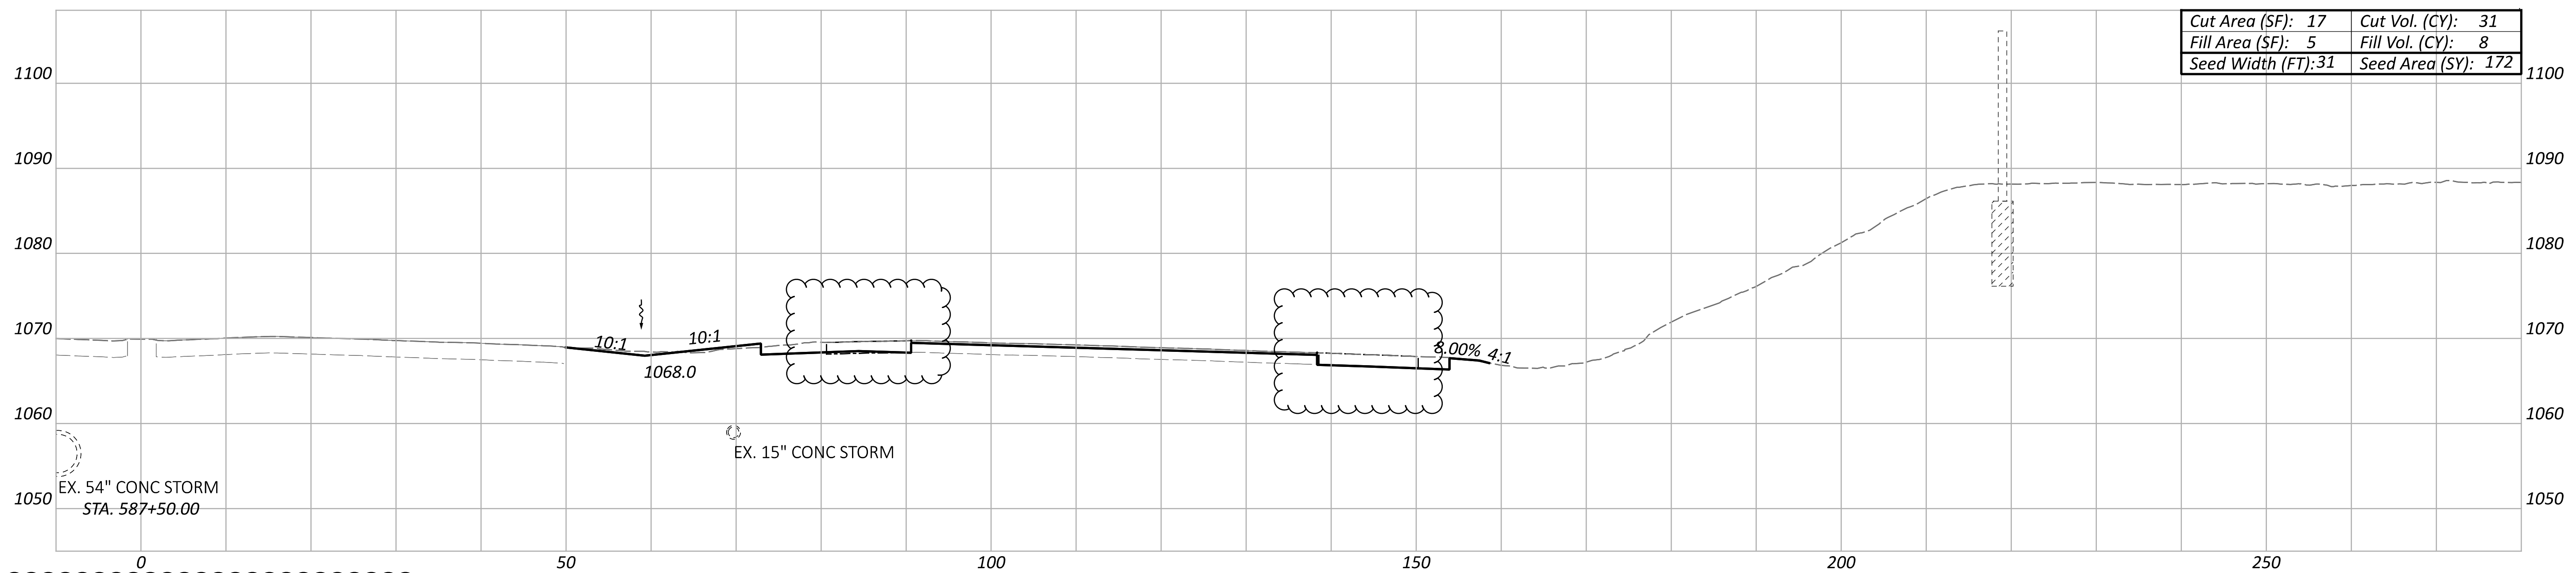

Cut Area (SF): 17	Cut Vol. (CY): 31
Fill Area (SF): 5	Fill Vol. (CY): 8
Seed Width (FT): 31	Seed Area (SY): 172

ITEM 202 - PAVEMENT REMOVED

CROSS SECTIONS
 STA. 587+50 TO STA. 588+00

DESIGN AGENCY



DESIGNER

AS

REVIEWER



KKP 12/31/22

PROJECT ID

113156

Sheet Totals		
Seeding	Cut	Fill
341	64	19

SHEET	TOTAL
162	233

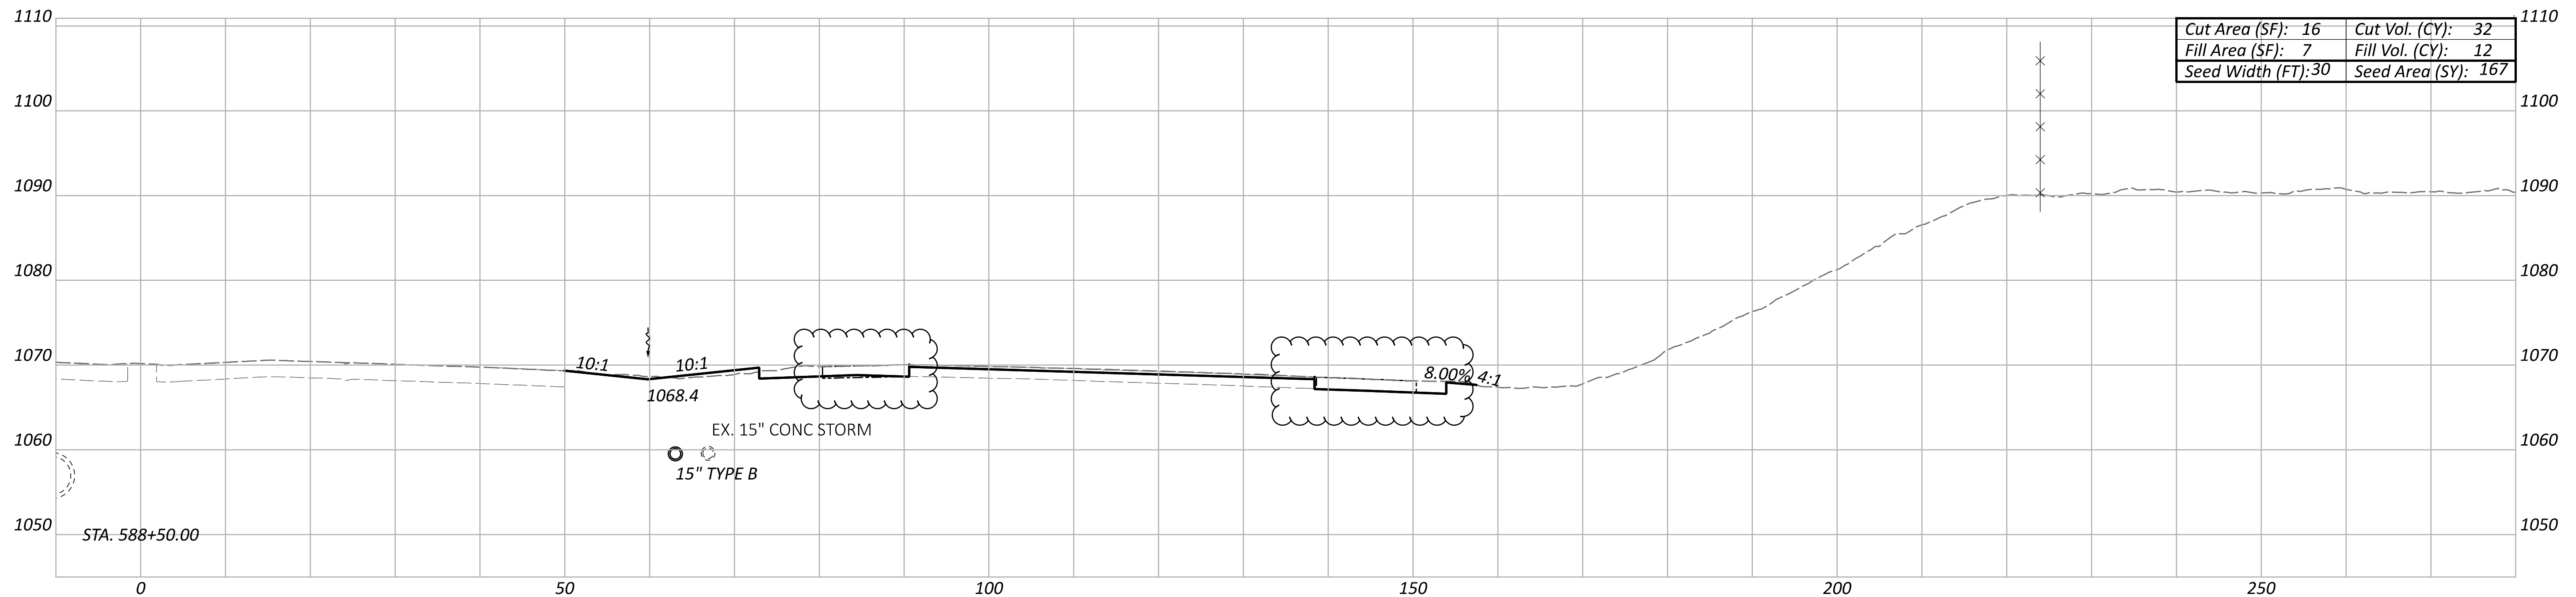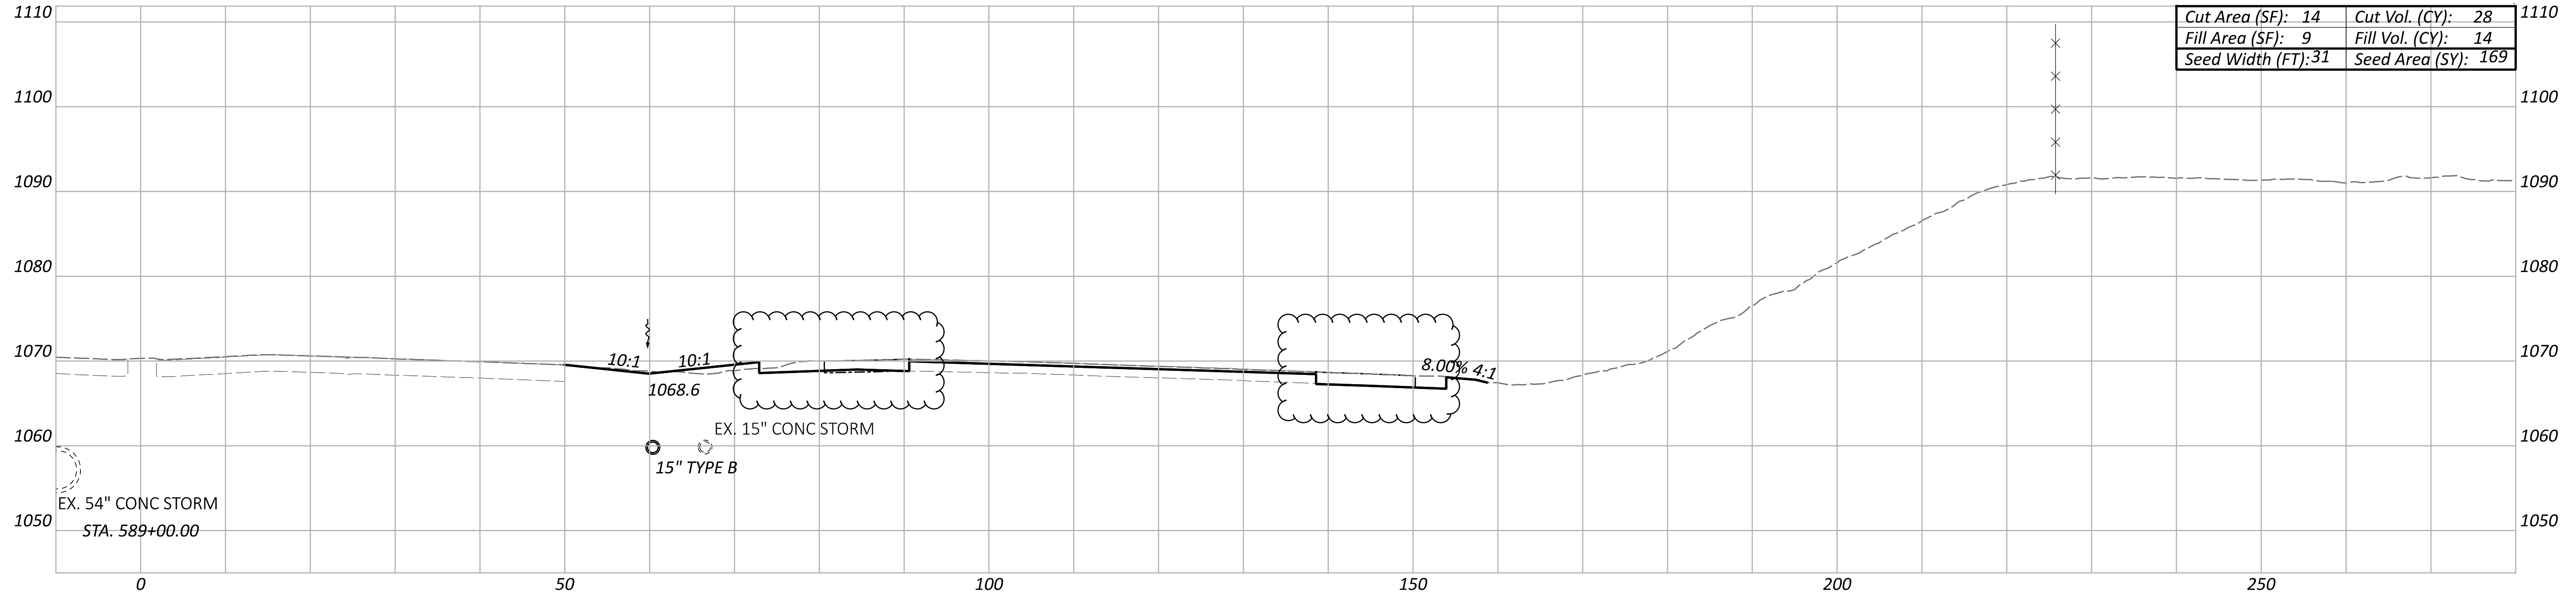

ITEM 202 - PAVEMENT REMOVED

CROSS SECTIONS
 STA. 588+50 TO STA. 589+00

DESIGN AGENCY





DESIGNER
 AS

REVIEWER
 KKP 12/31/22

PROJECT ID
 113156

Sheet Totals			SHEET TOTAL	
Seeding	Cut	Fill	163	233
336	59	26		

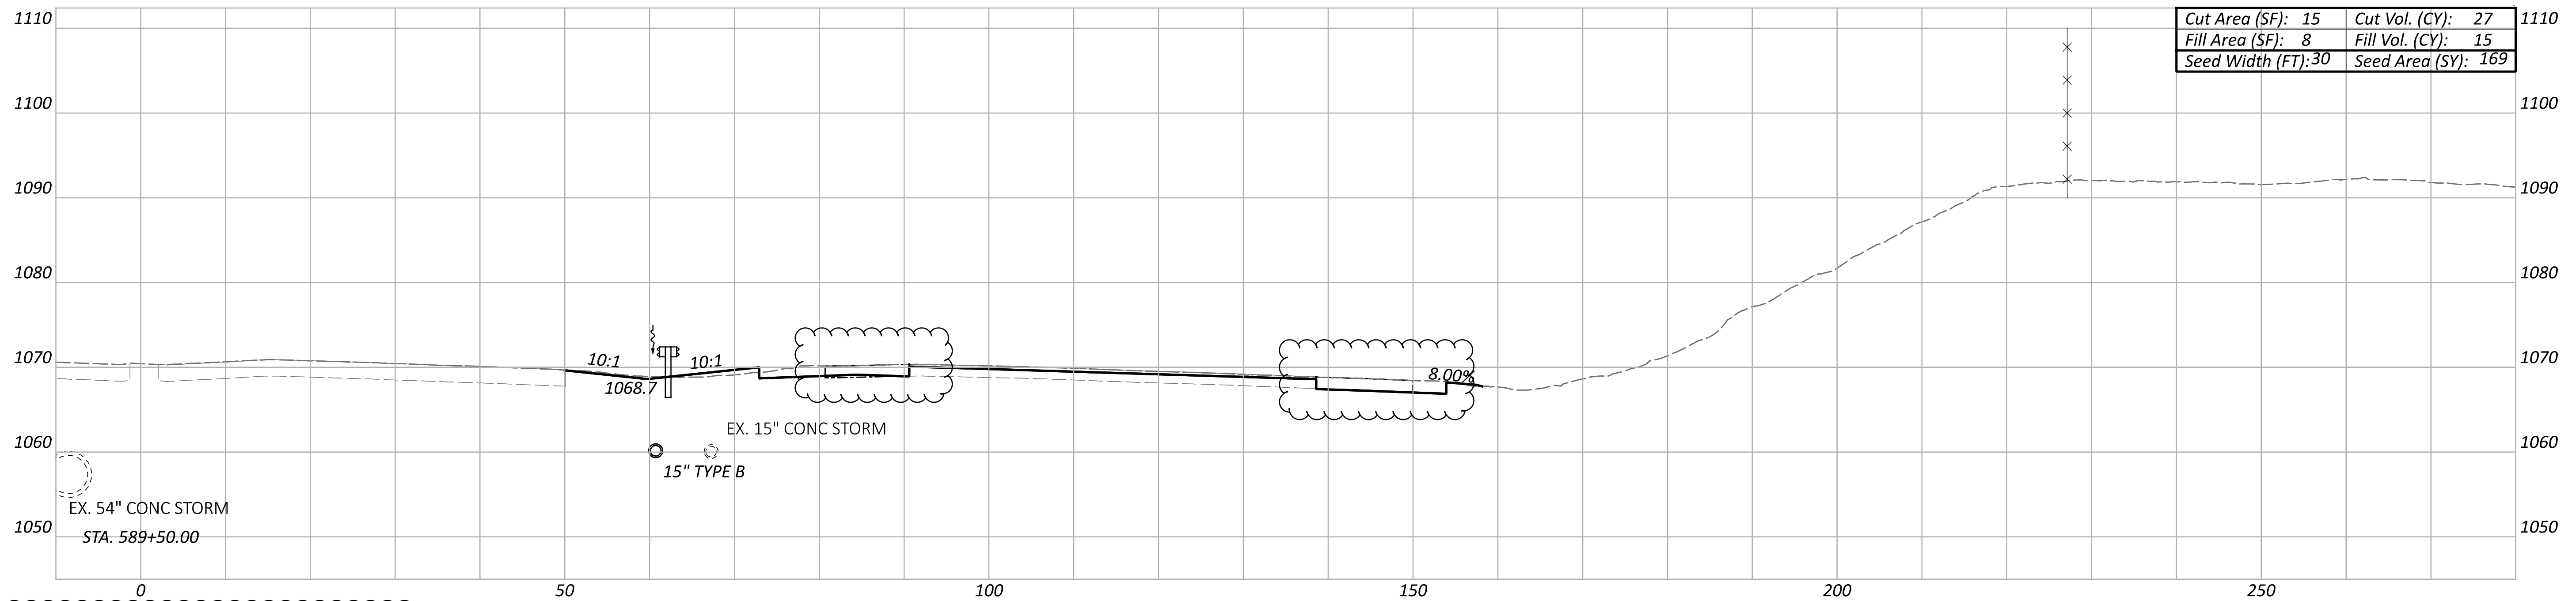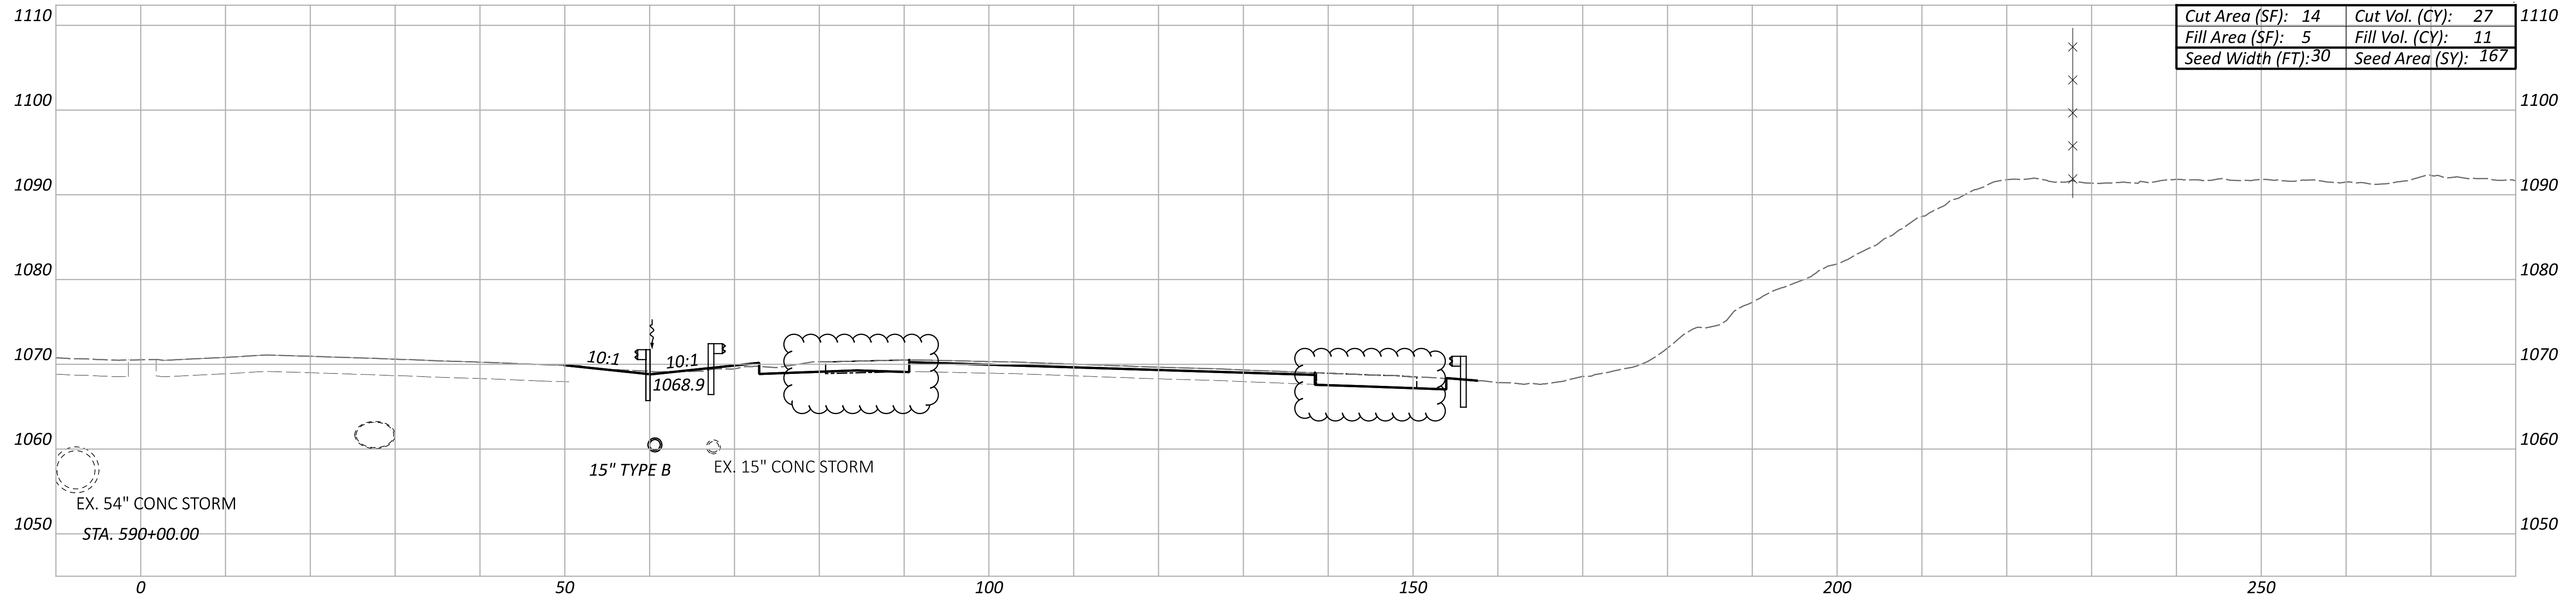

ITEM 202 - PAVEMENT REMOVED

CROSS SECTIONS
 STA. 589+50 TO STA. 590+00

DESIGN AGENCY



DESIGNER

AS


REVIEWER

KKP 12/31/22


PROJECT ID

113156

Sheet Totals			SHEET TOTAL	
Seeding	Cut	Fill	164	233
336	54	26		

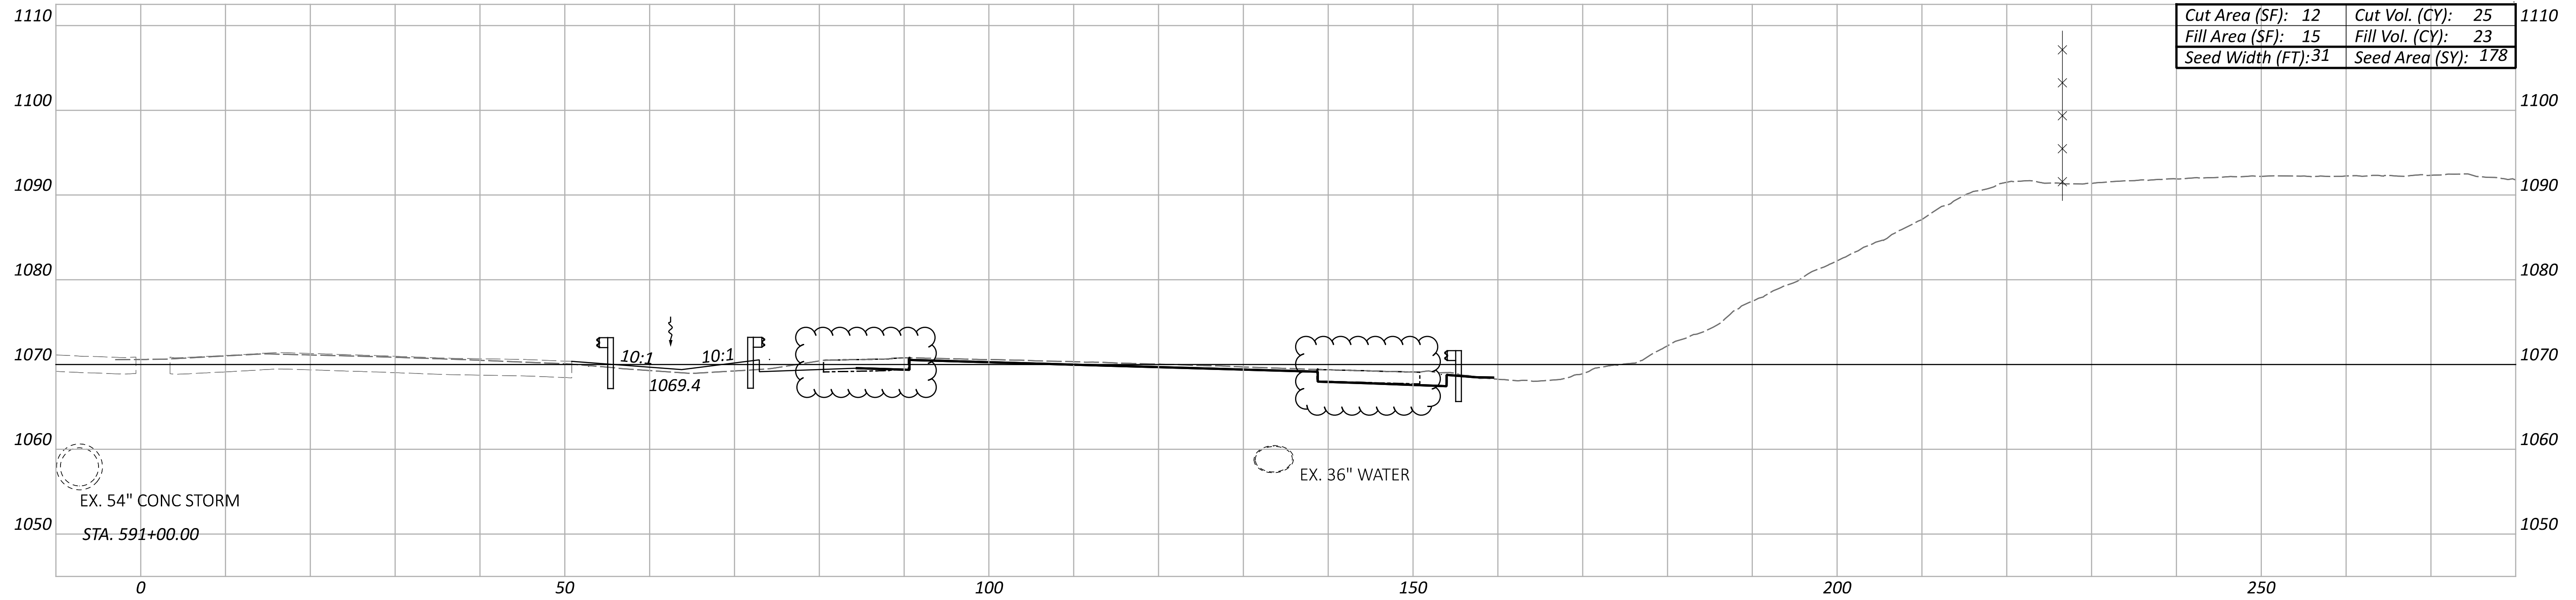

Cut Area (SF): 12	Cut Vol. (CY): 25
Fill Area (SF): 15	Fill Vol. (CY): 23
Seed Width (FT): 31	Seed Area (SY): 178

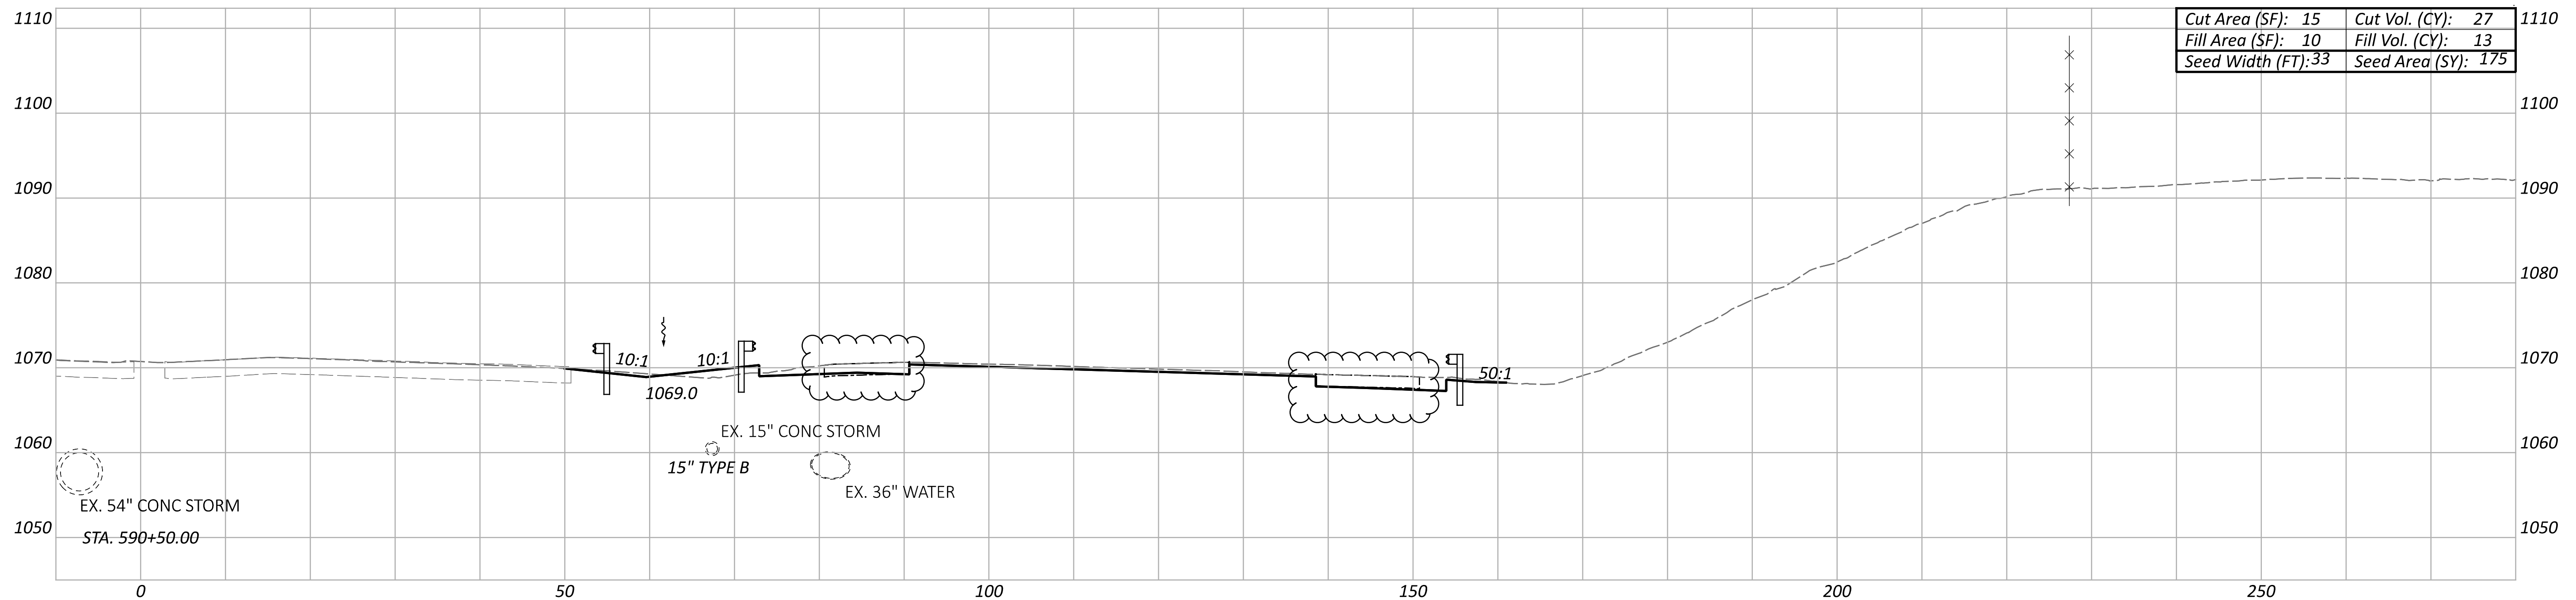

Cut Area (SF): 15	Cut Vol. (CY): 27
Fill Area (SF): 10	Fill Vol. (CY): 13
Seed Width (FT): 33	Seed Area (SY): 175

ITEM 202 - PAVEMENT REMOVED

CROSS SECTIONS
 STA. 590+50 TO STA. 591+00

DESIGN AGENCY





DESIGNER
 AS

REVIEWER
 KKP 12/31/22

PROJECT ID
 113156

Sheet Totals			SHEET	TOTAL
Seeding	Cut	Fill	165	233
353	52	36		

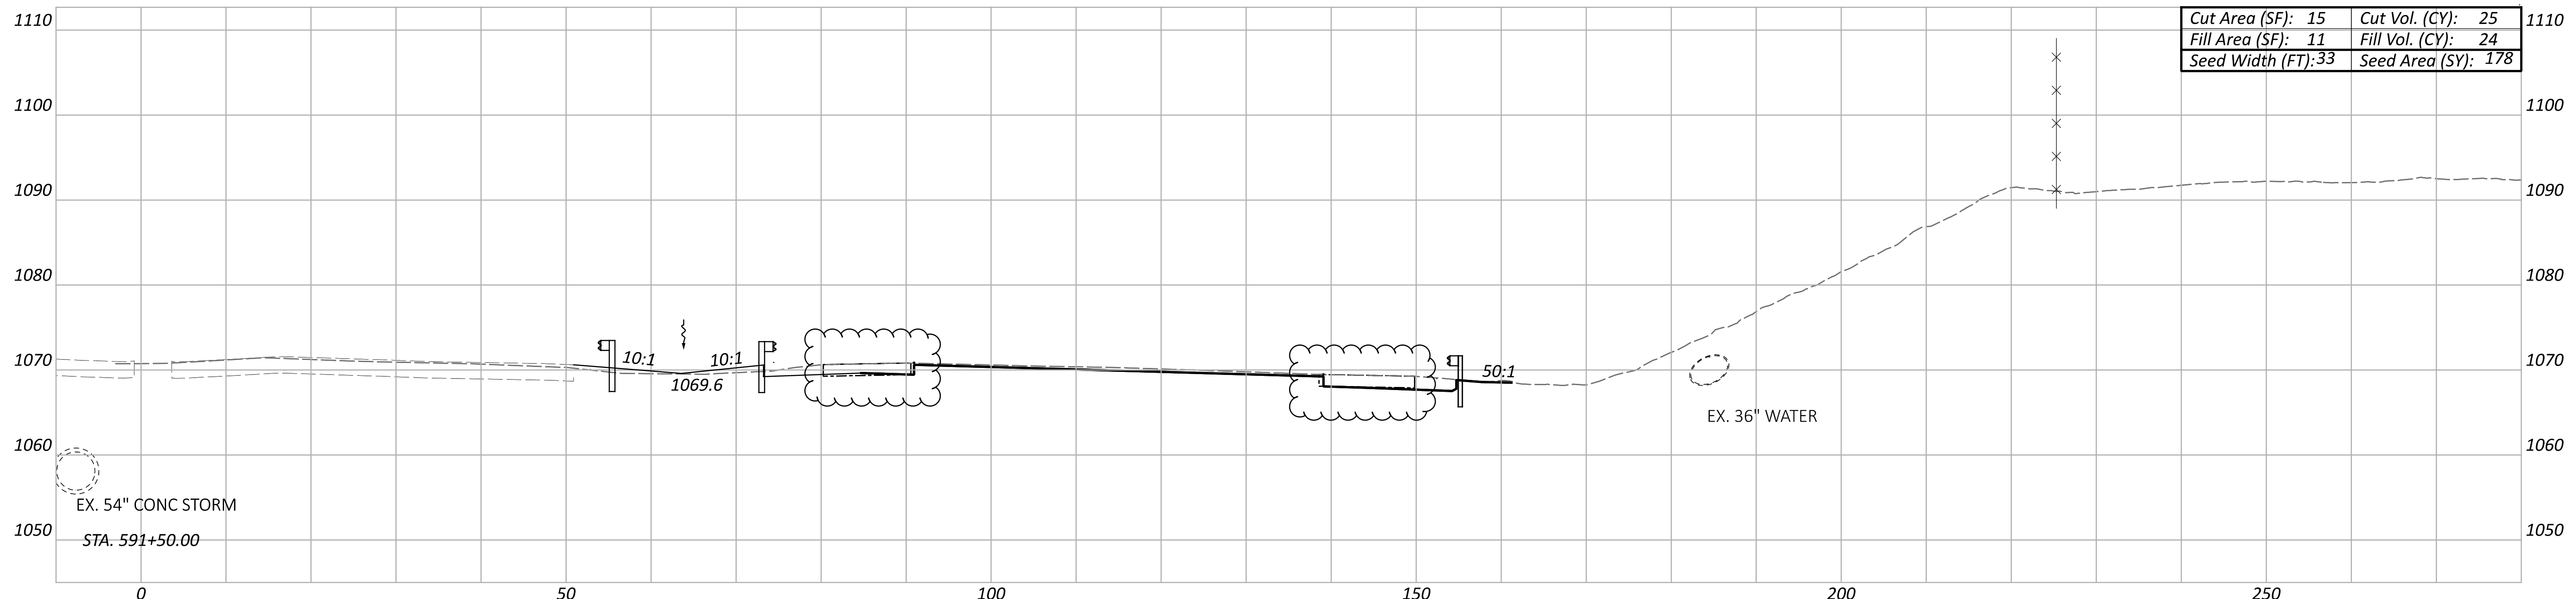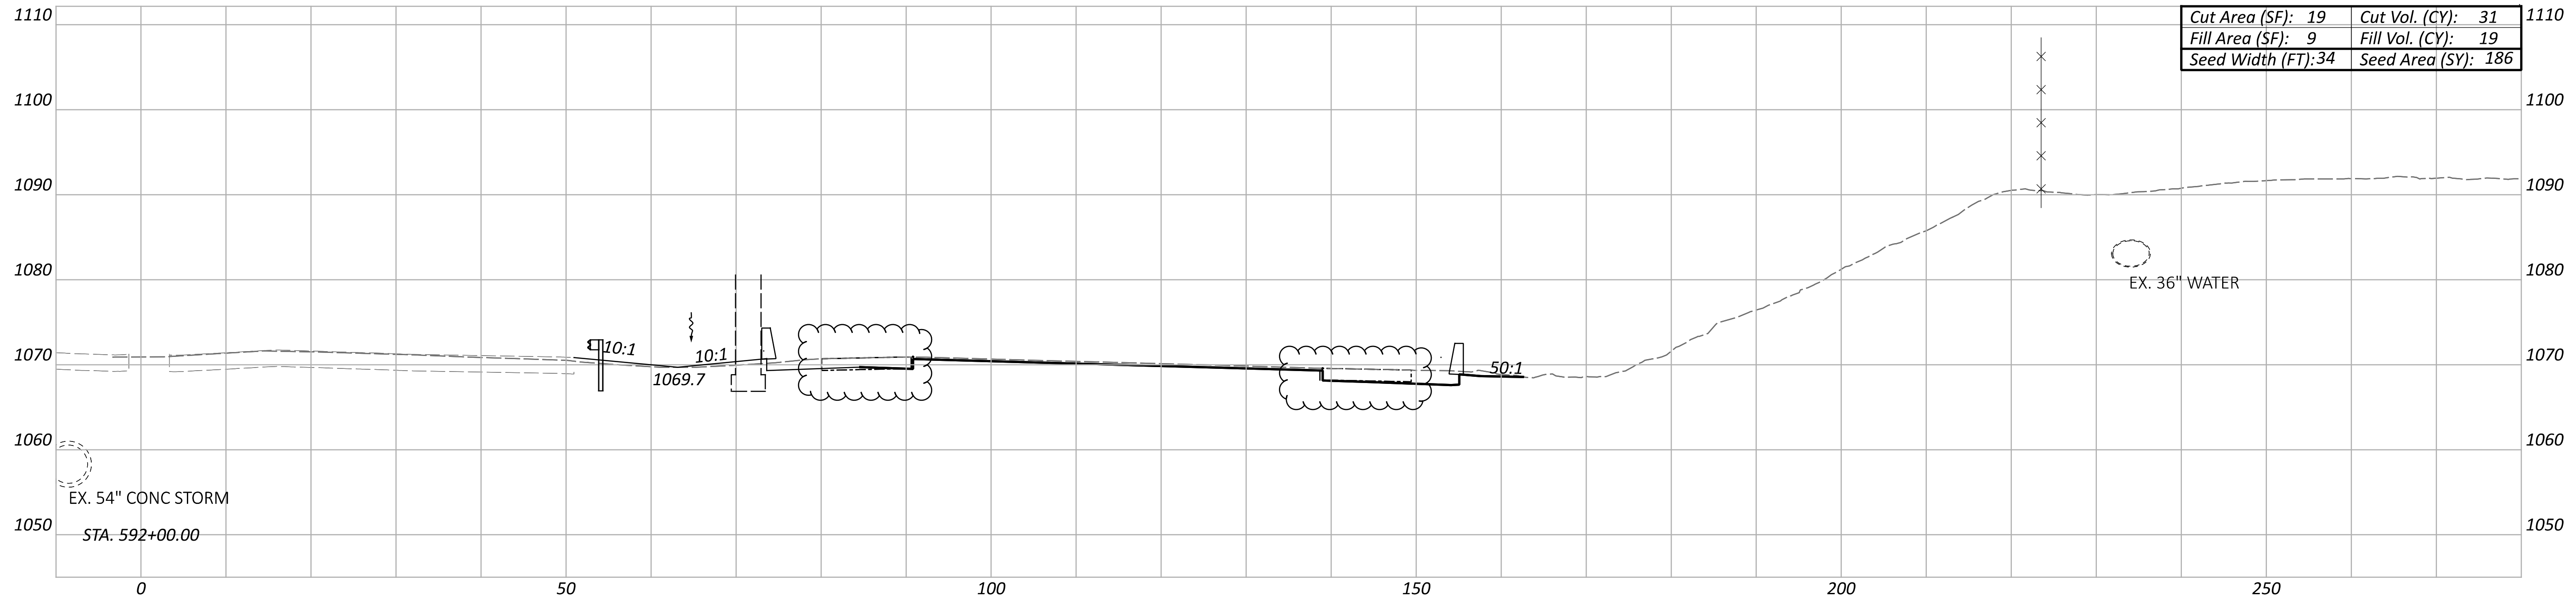

ITEM 202 - PAVEMENT REMOVED

CROSS SECTIONS
 STA. 591+50 TO STA. 592+00

DESIGN AGENCY





DESIGNER
 AS

REVIEWER
 KKP 12/31/22

PROJECT ID
 113156

Sheet Totals			SHEET	TOTAL
Seeding	Cut	Fill		
364	56	43	166	233

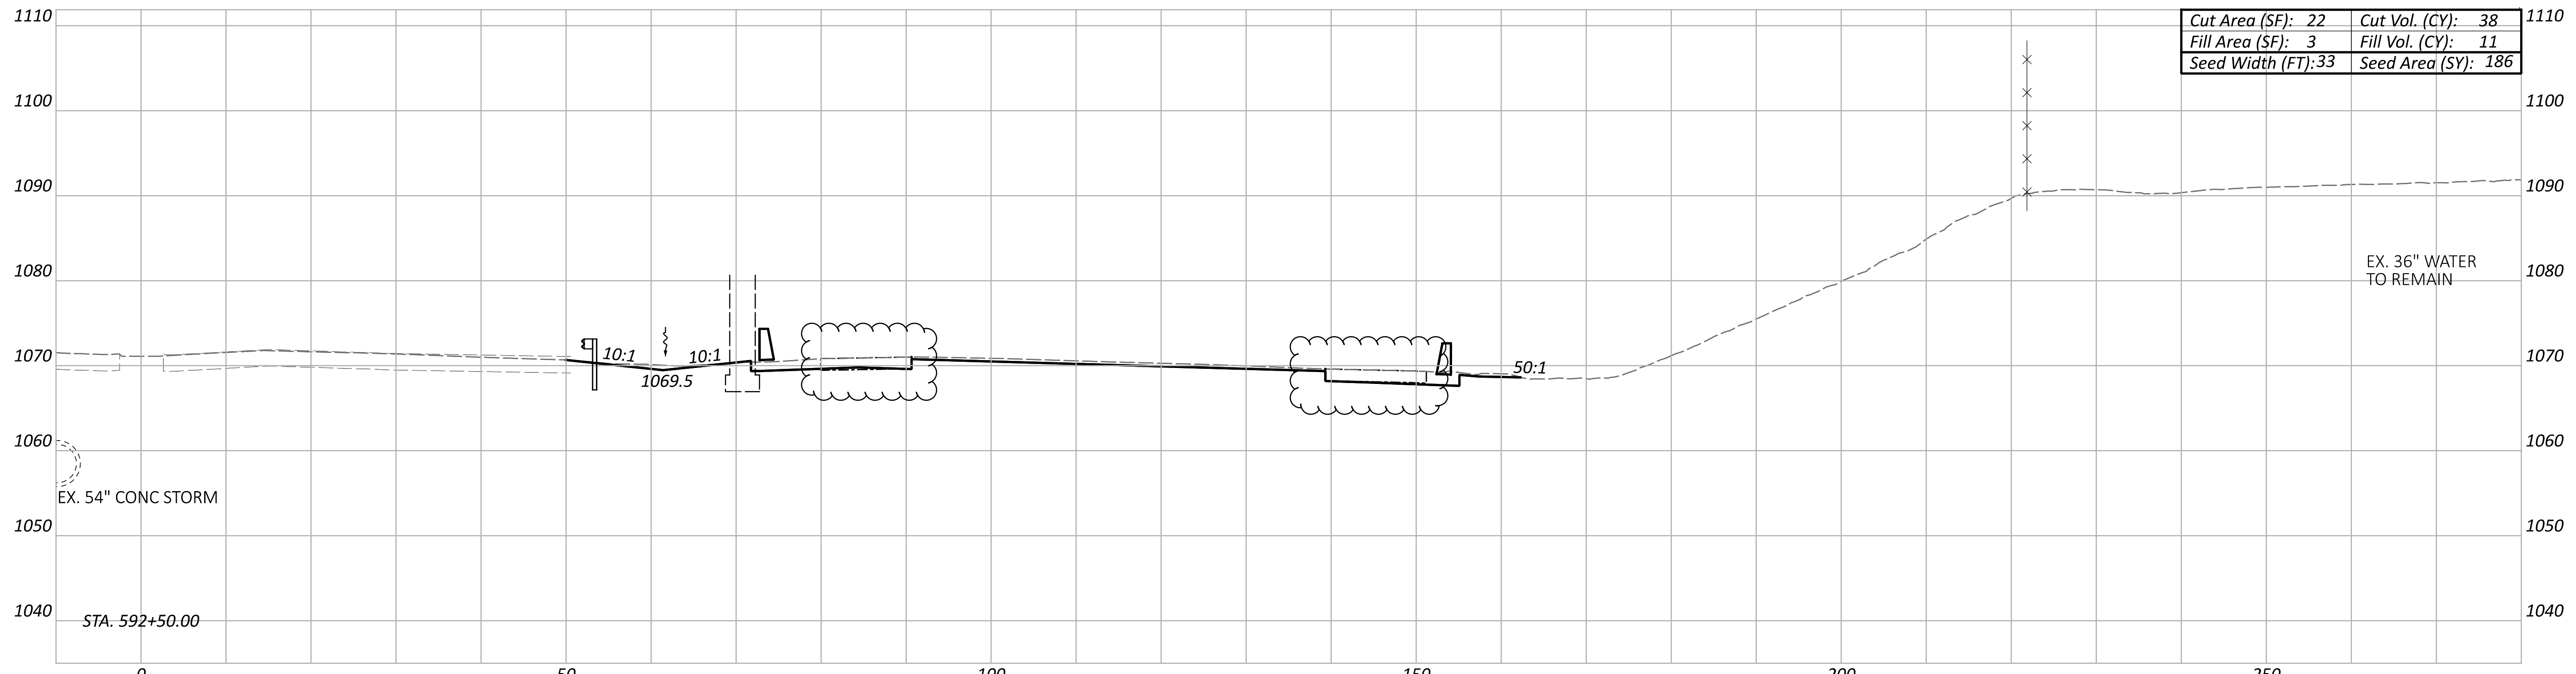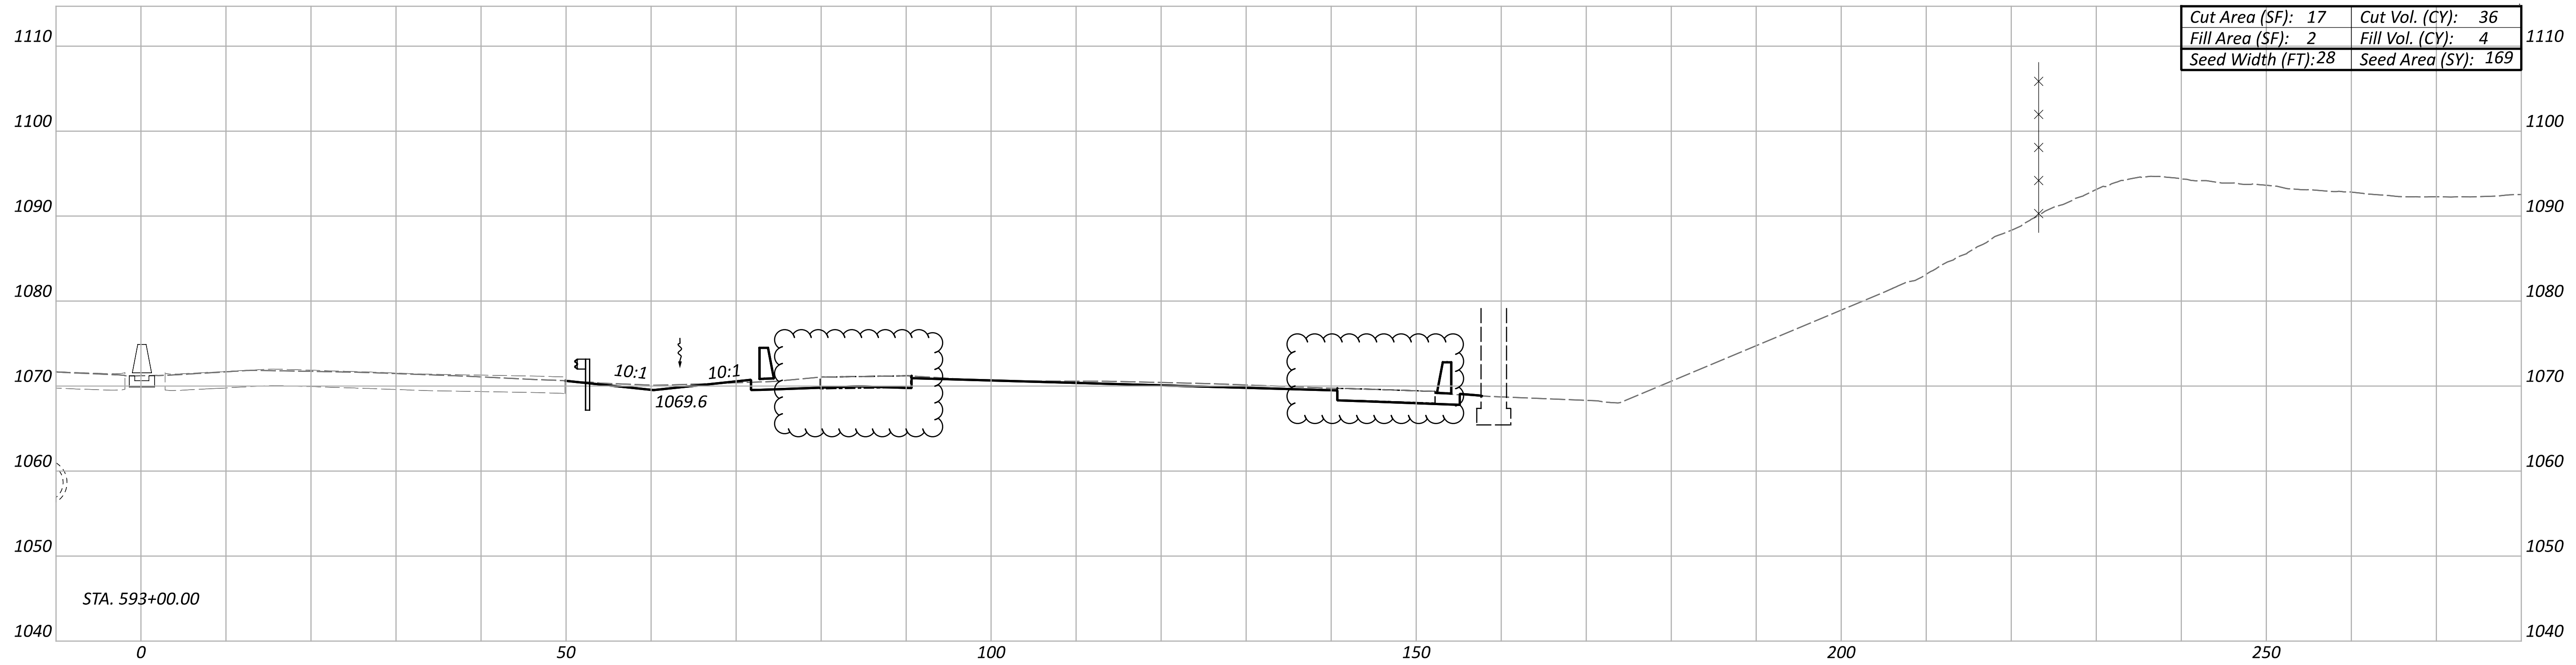

EX. 54" CONC STORM

ITEM 202 - PAVEMENT REMOVED

CROSS SECTIONS
 STA. 592+50 TO STA. 593+00

DESIGN AGENCY





DESIGNER
 AS

REVIEWER
 KKP 12/31/22

PROJECT ID
 113156

Sheet Totals			SHEET TOTAL	
Seeding	Cut	Fill	SHEET	TOTAL
355	74	15	167	233

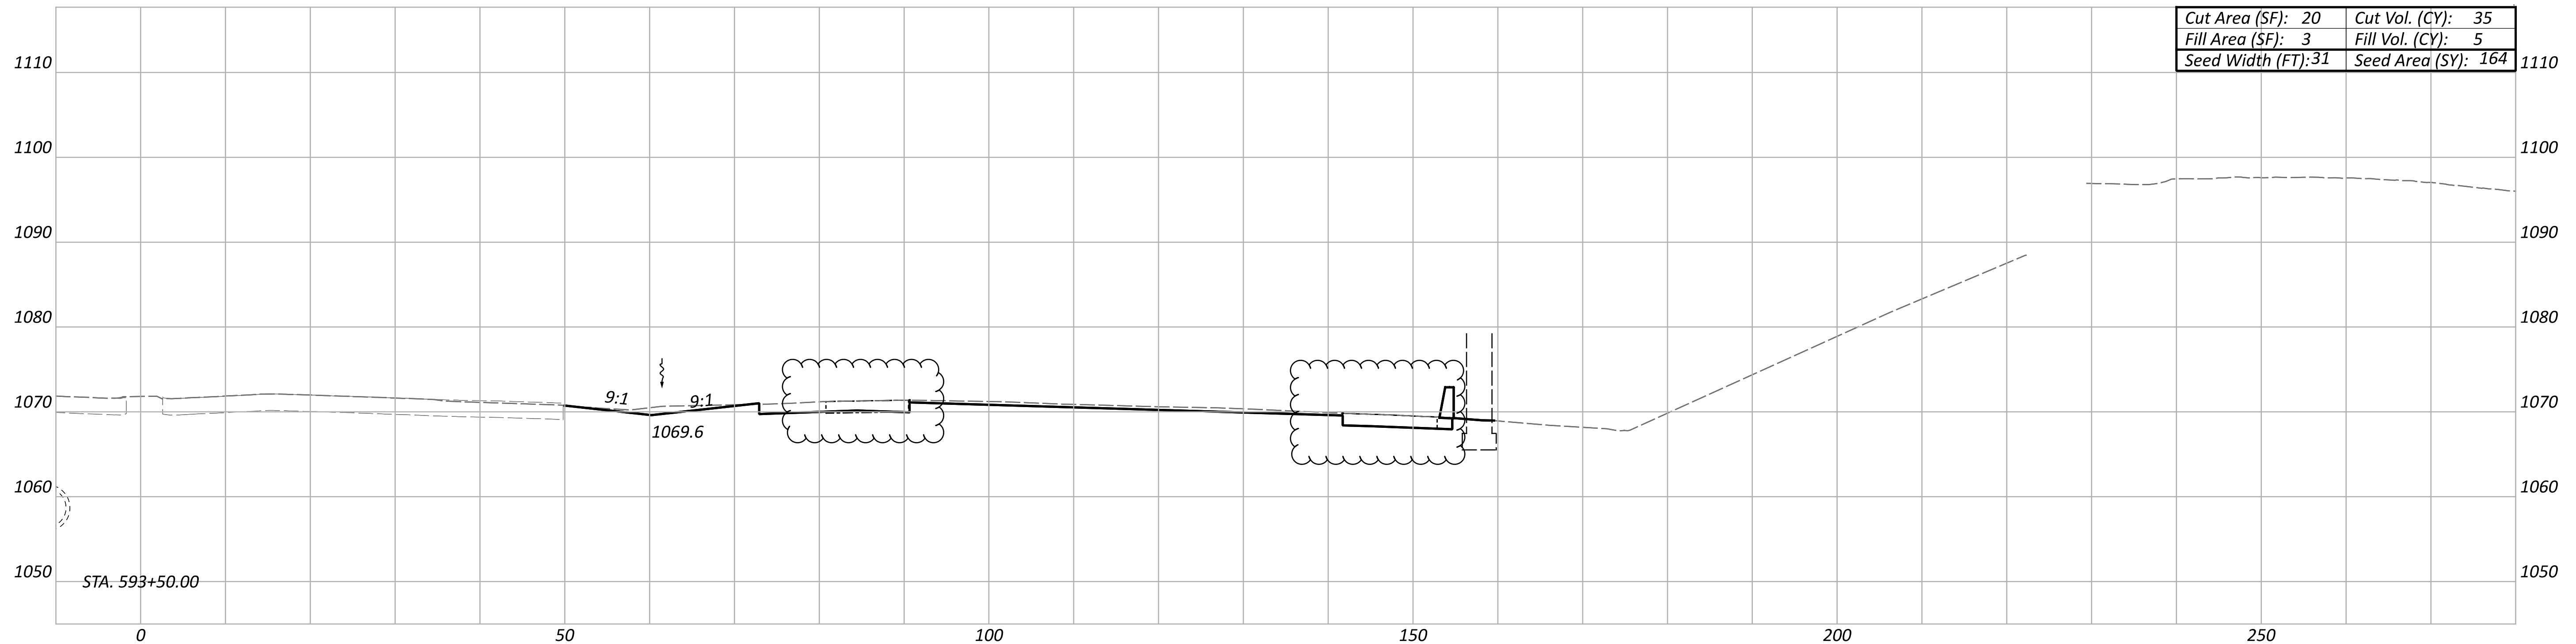
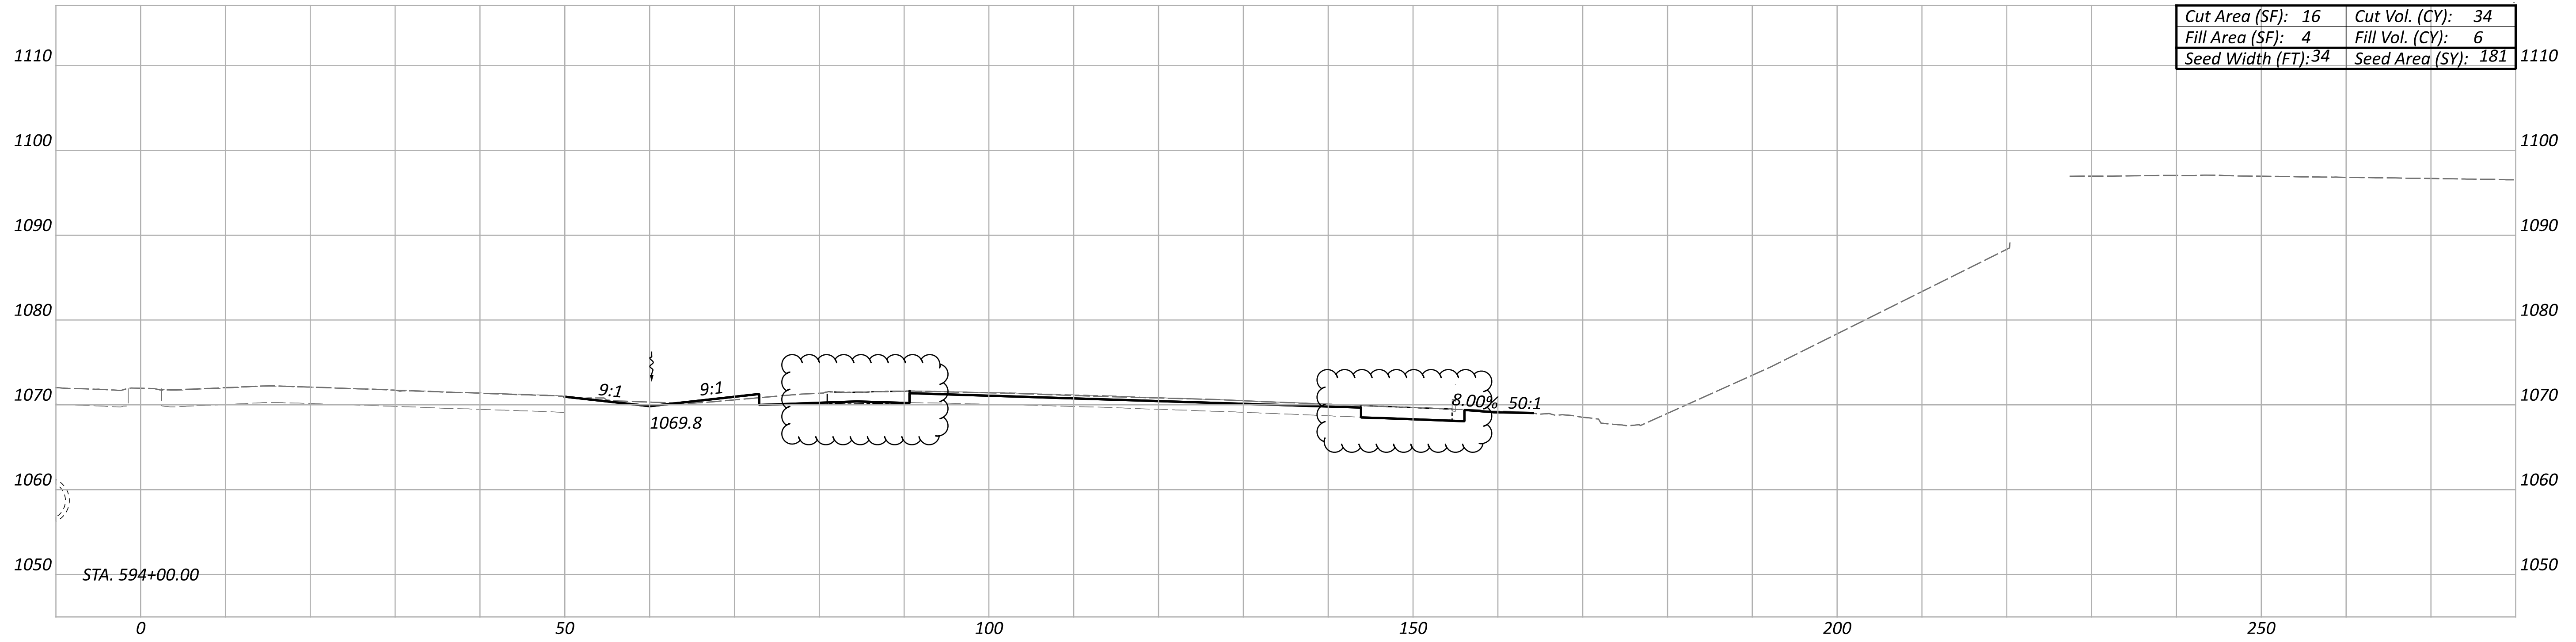


ITEM 202 - PAVEMENT REMOVED

CROSS SECTIONS
 STA. 593+50 TO STA. 594+00

DESIGN AGENCY
HNTB
 DESIGNER
 AS
 REVIEWER
 KKP 12/31/22
 PROJECT ID
 113156

Sheet Totals			SHEET TOTAL	
Seeding	Cut	Fill	168	233
345	69	11		

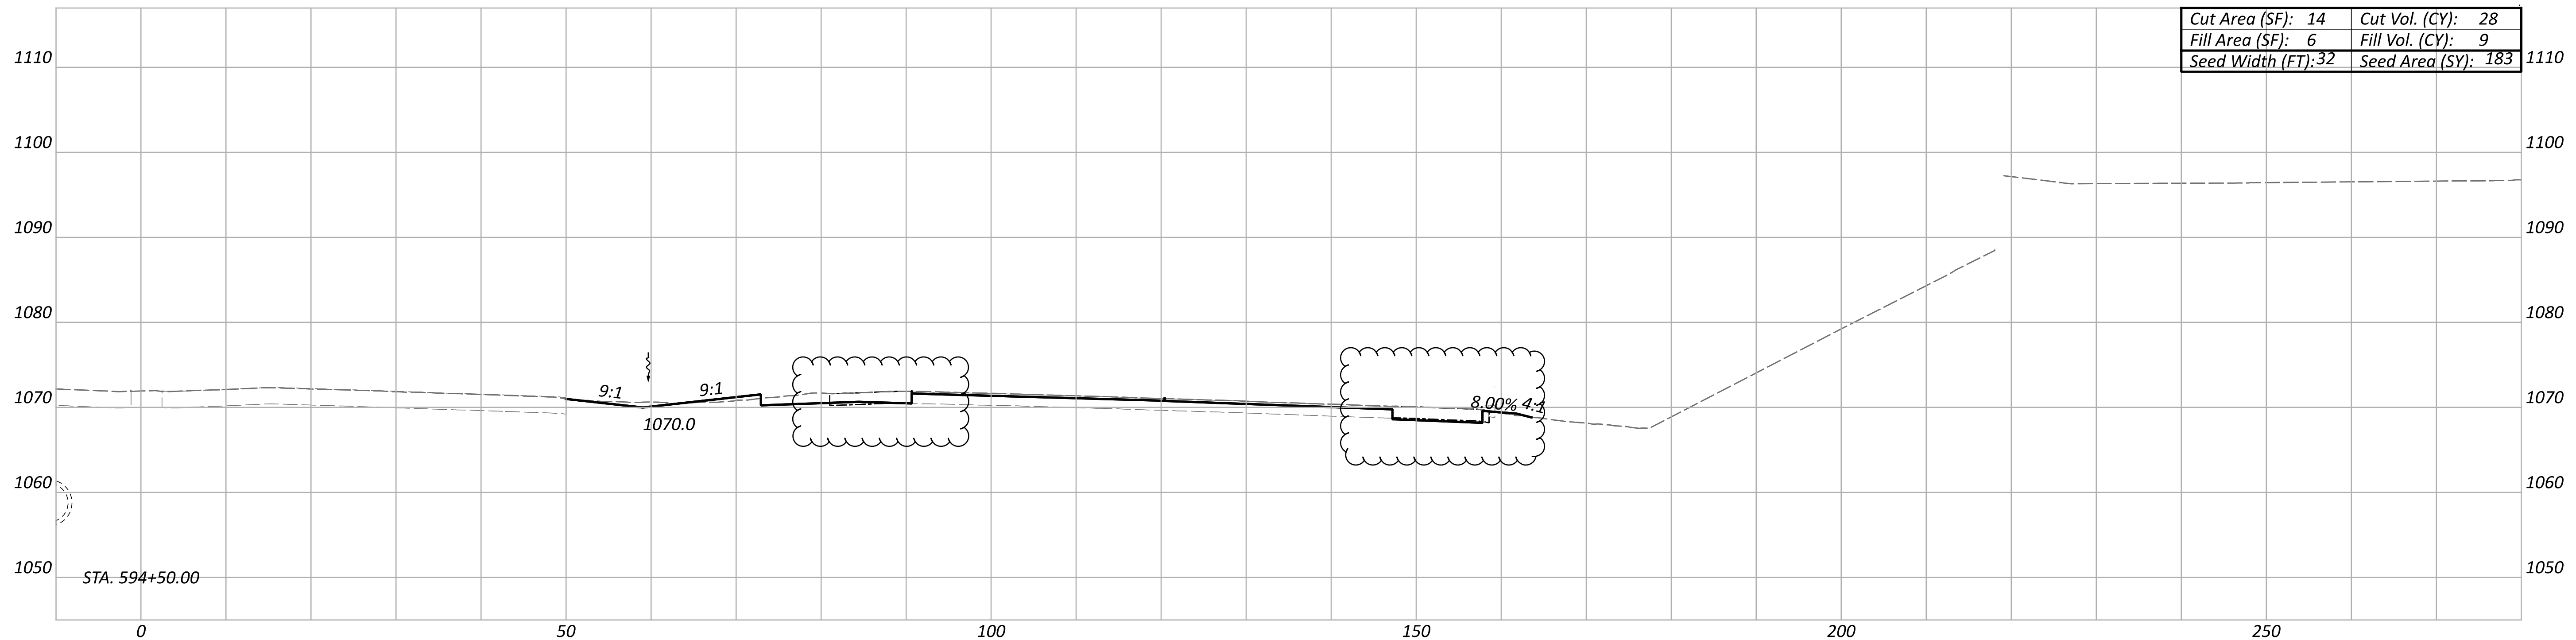
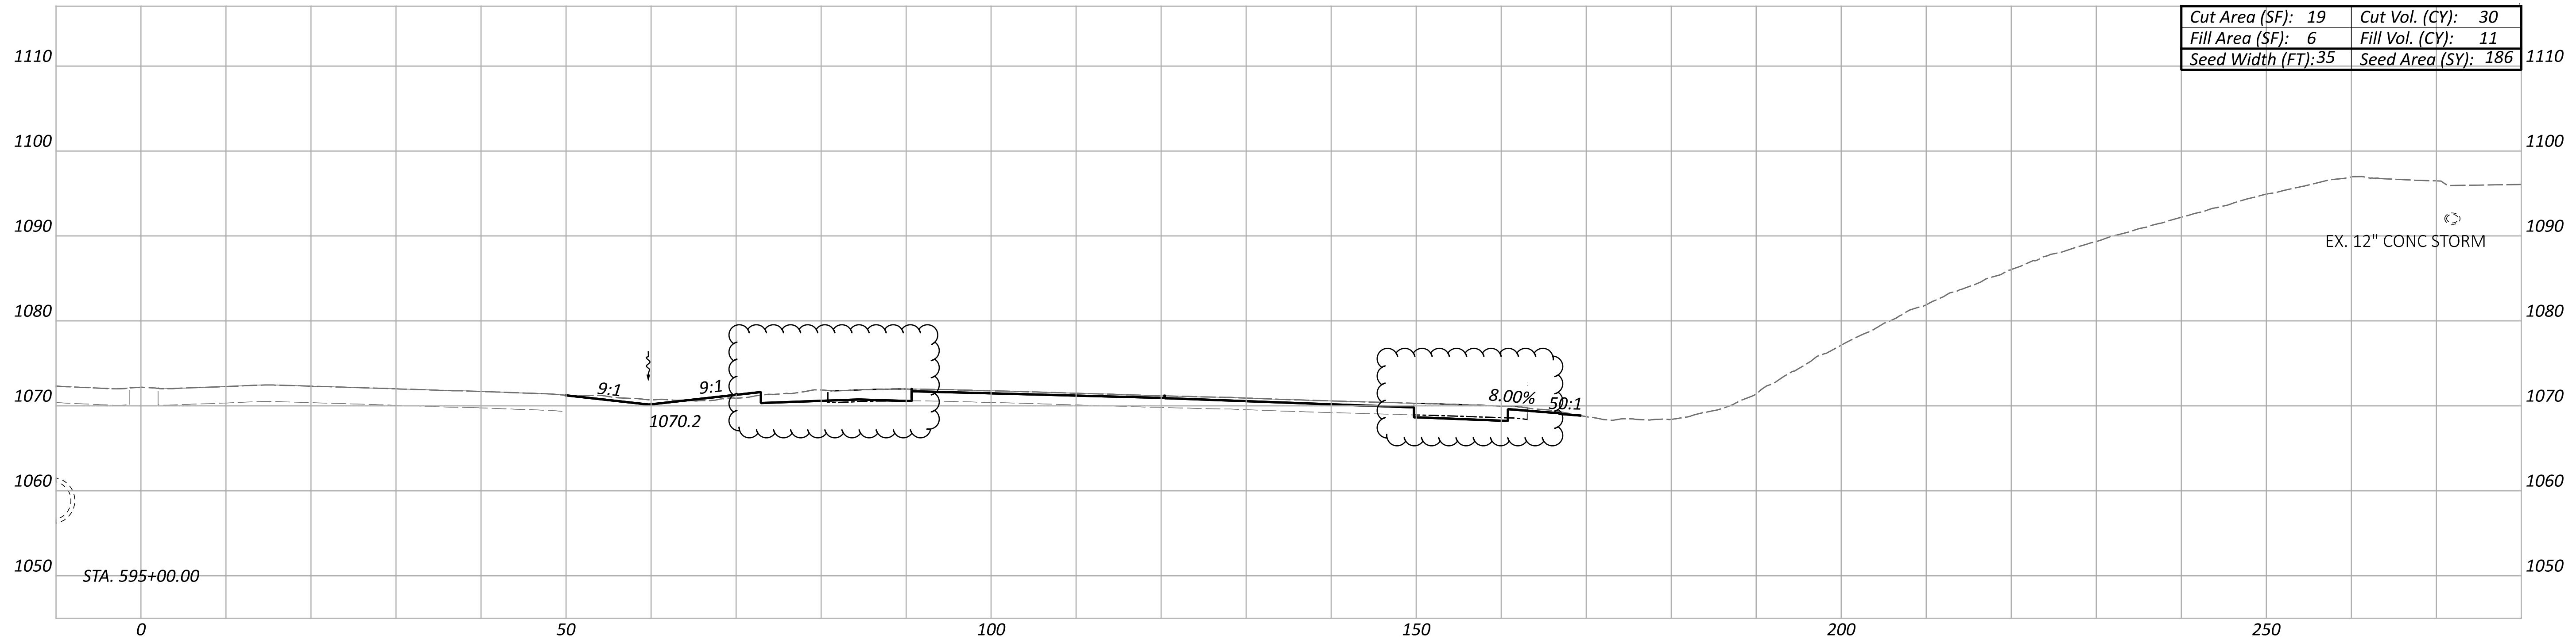


ITEM 202 - PAVEMENT REMOVED

CROSS SECTIONS
 STA. 594+50 TO STA. 595+00

DESIGN AGENCY
HNTB
 DESIGNER
 AS
 REVIEWER
 KKP 12/31/22
 PROJECT ID
 113156

Sheet Totals			SHEET TOTAL	
Seeding	Cut	Fill	169	233
369	59	20		

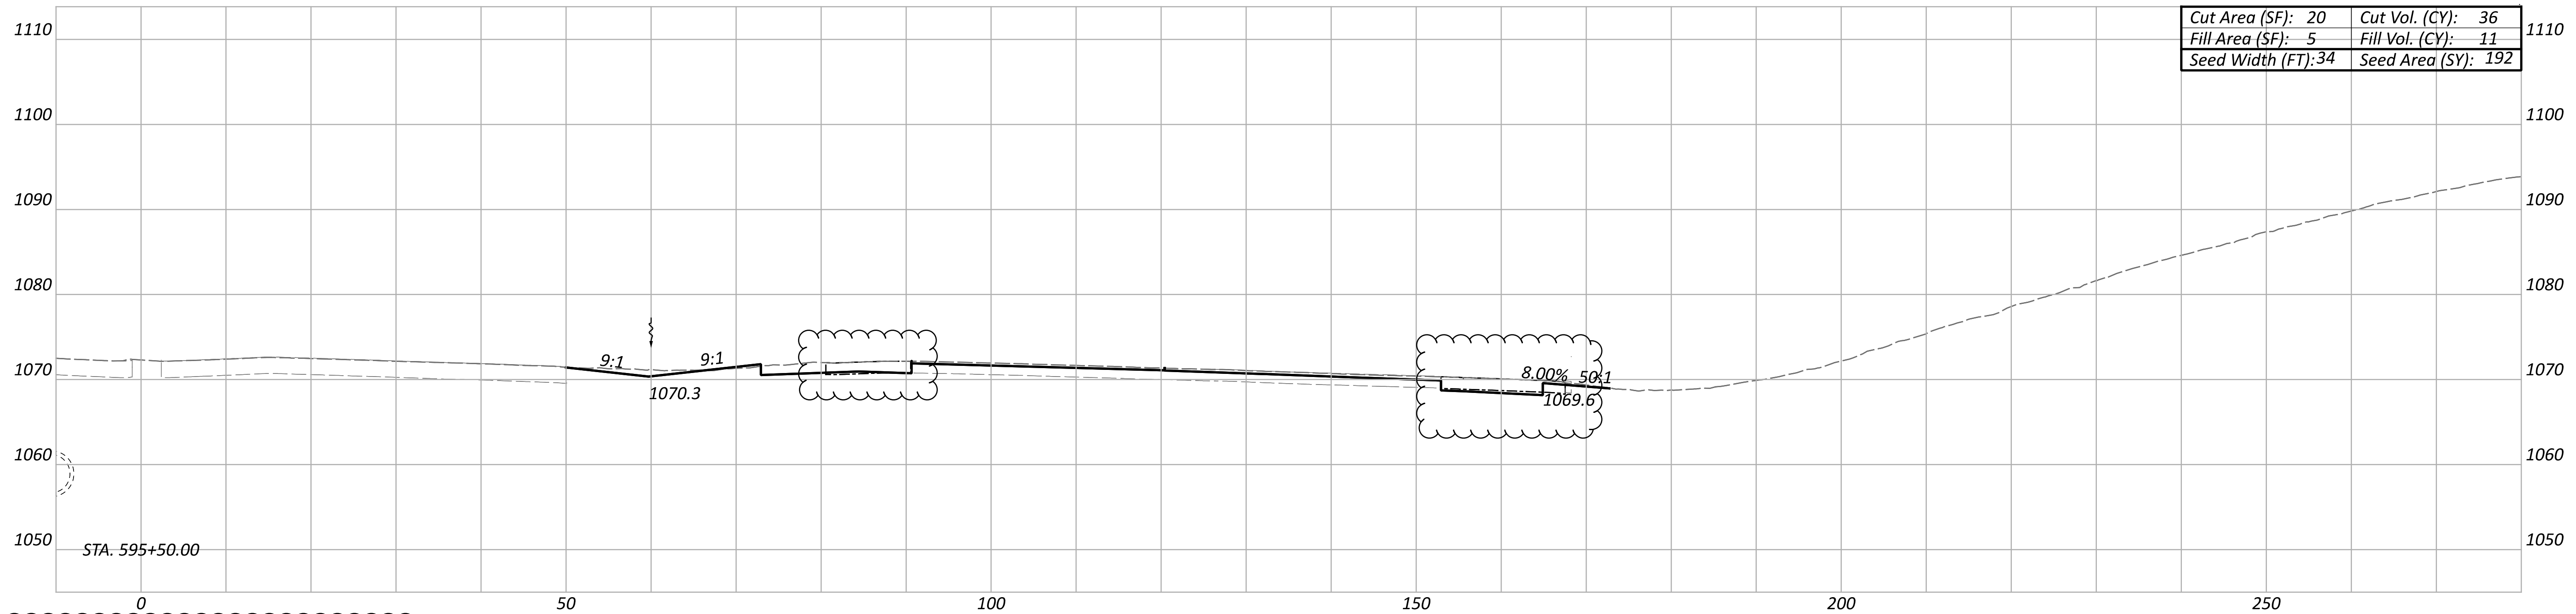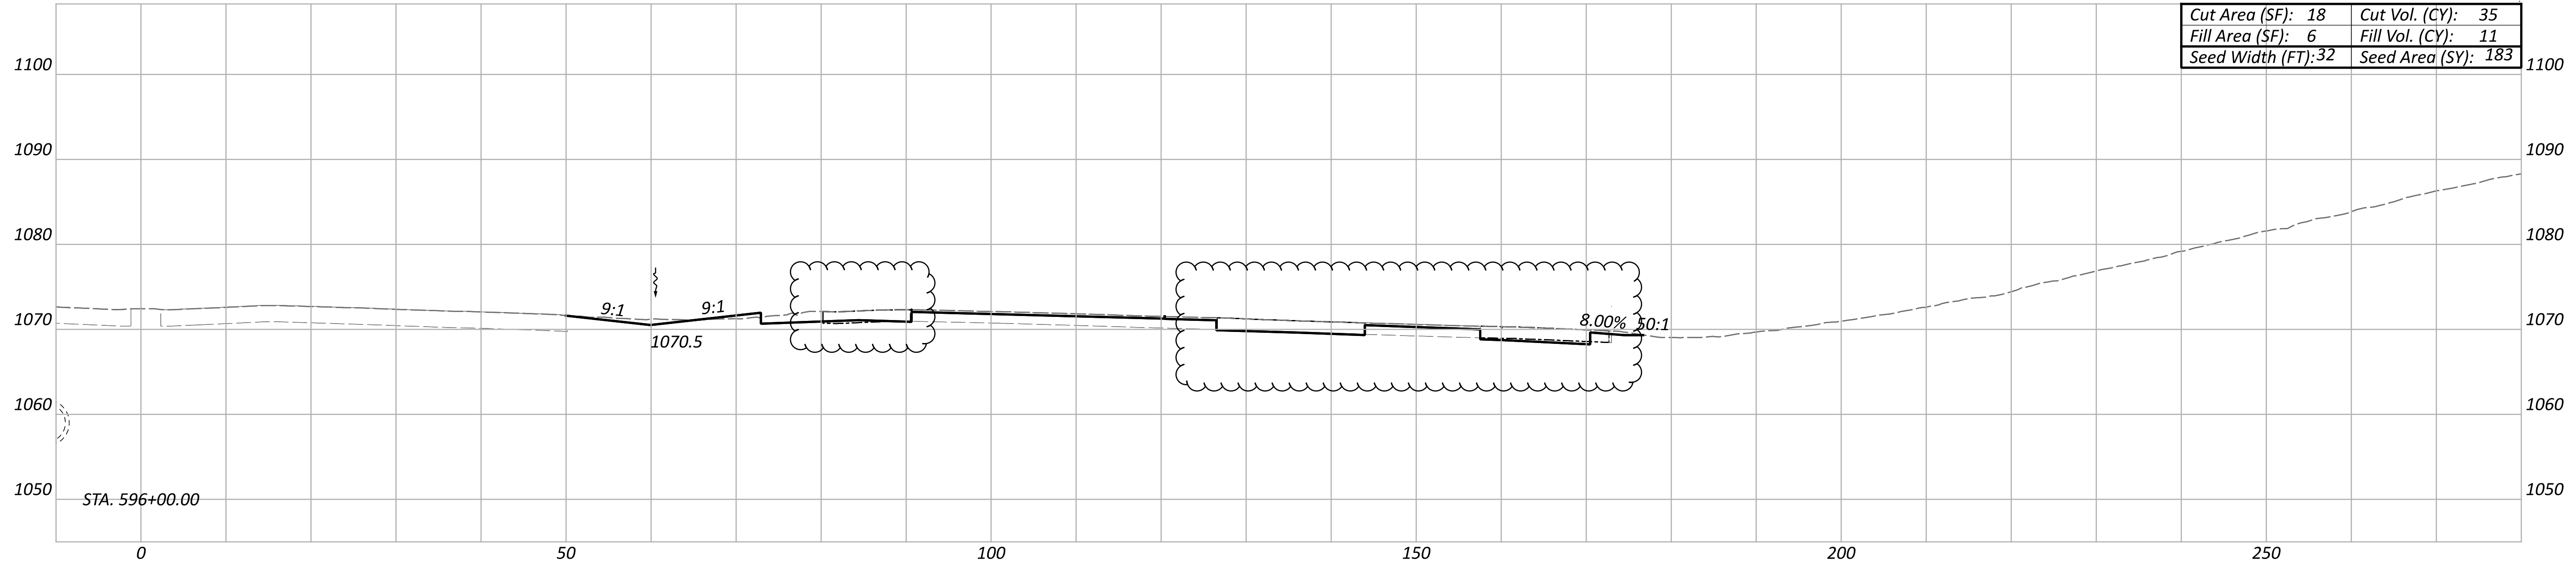

ITEM 202 - PAVEMENT REMOVED

Sheet Totals			SHEET TOTAL	
Seeding	Cut	Fill	170	233
375	71	22		

CROSS SECTIONS
 STA. 595+50 TO STA. 596+00




DESIGN AGENCY



DESIGNER
 AS

REVIEWER
 KKP 12/31/22

PROJECT ID
 113156

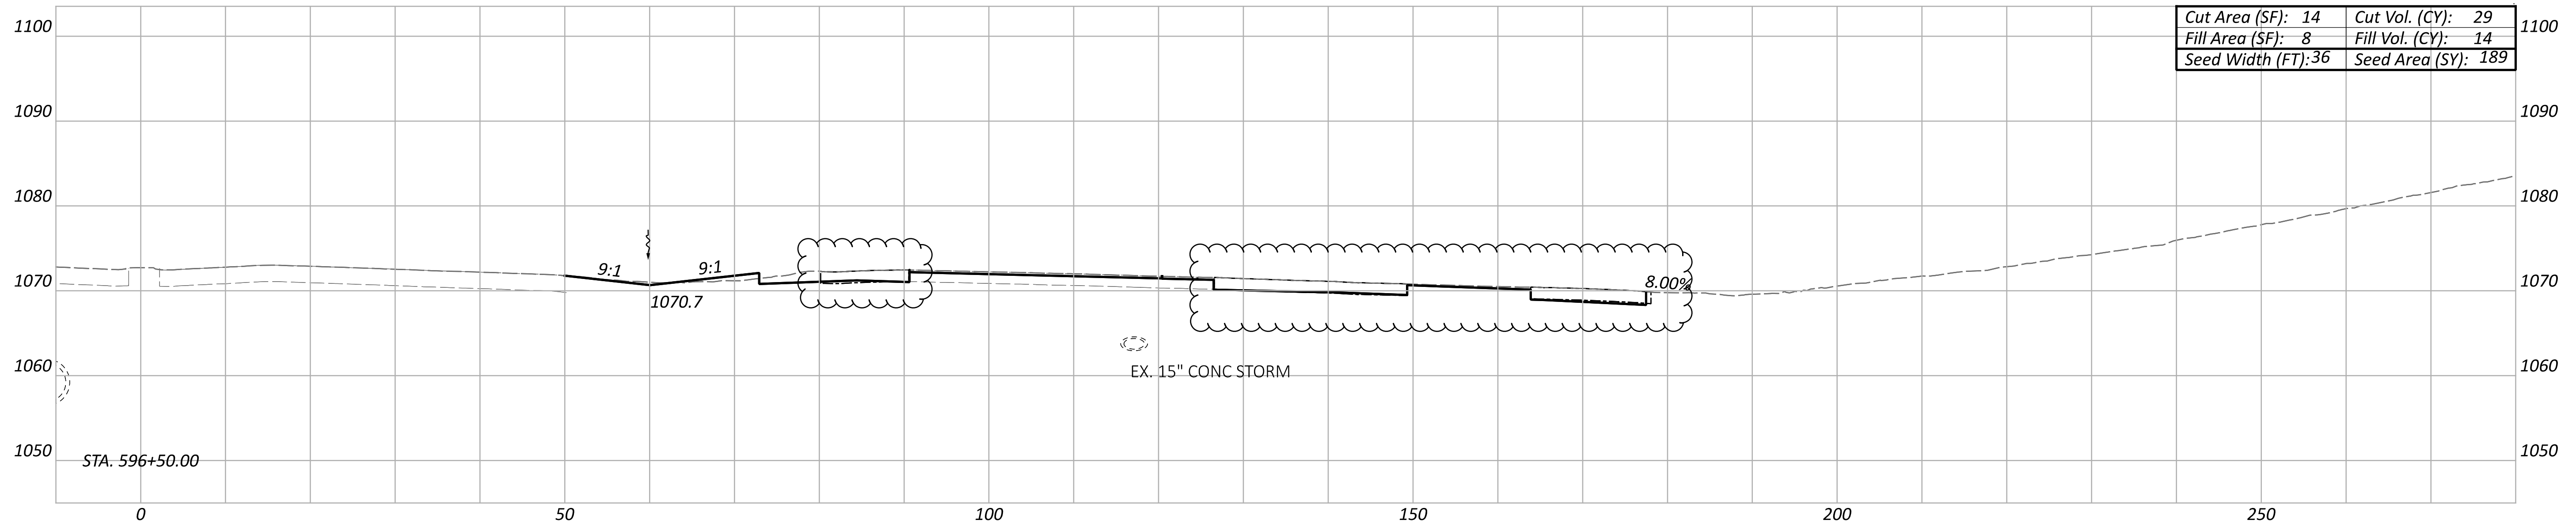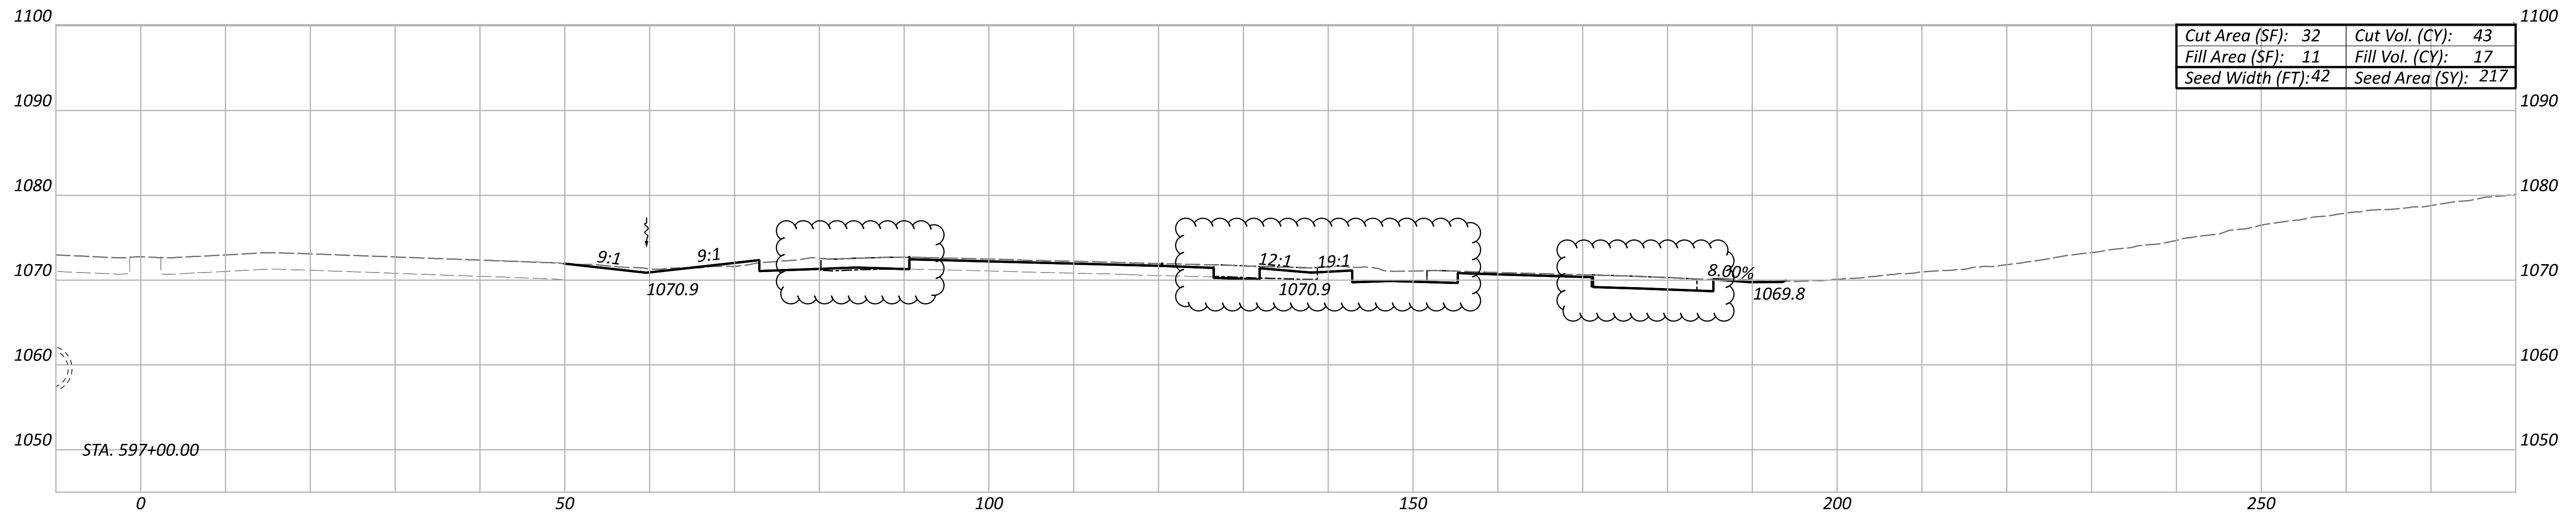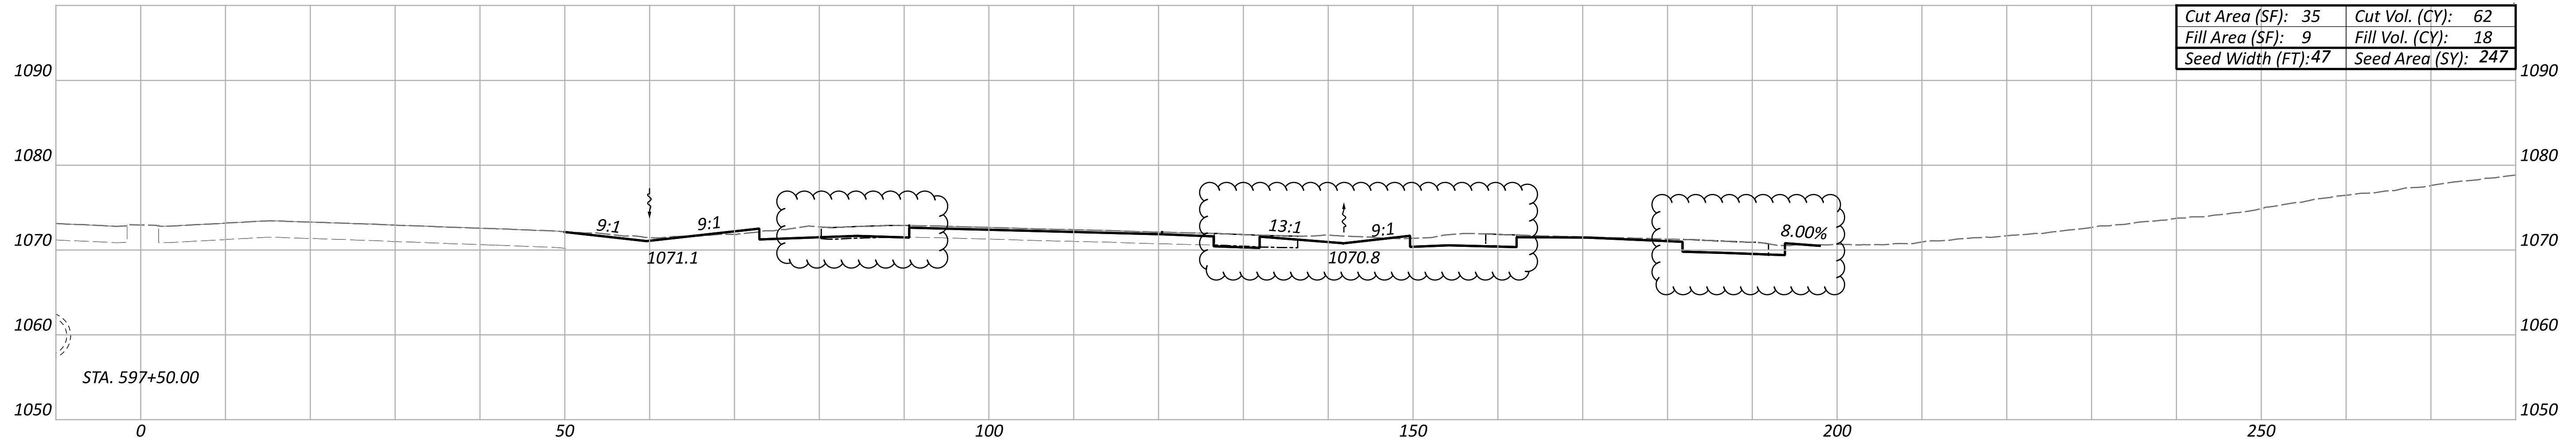

ITEM 202 - PAVEMENT REMOVED

CROSS SECTIONS
 STA. 596+50 TO STA. 597+50

DESIGN AGENCY






DESIGNER
 AS

REVIEWER
 KKP 12/31/22

PROJECT ID
 113156

Sheet Totals			SHEET TOTAL	
Seeding	Cut	Fill	171	233
653	134	49		

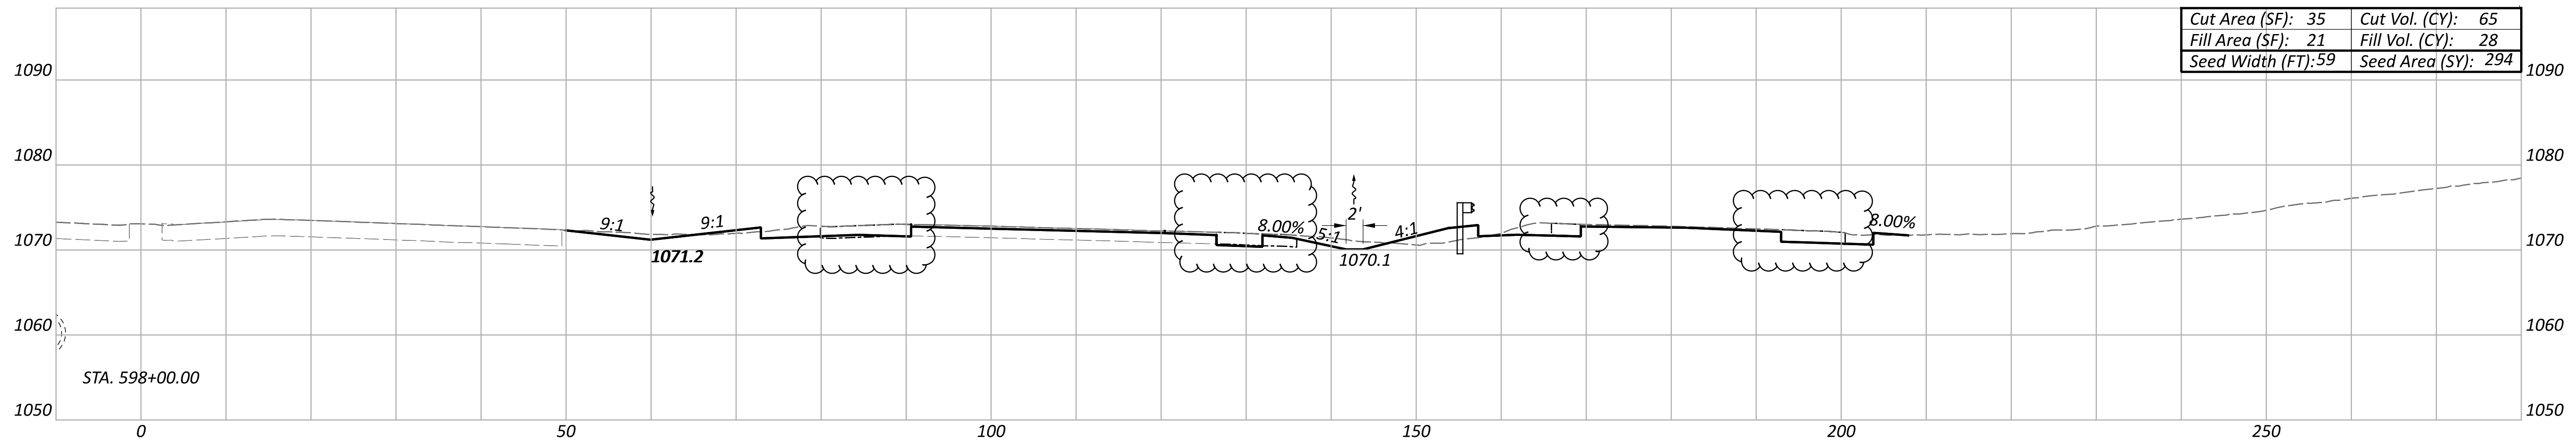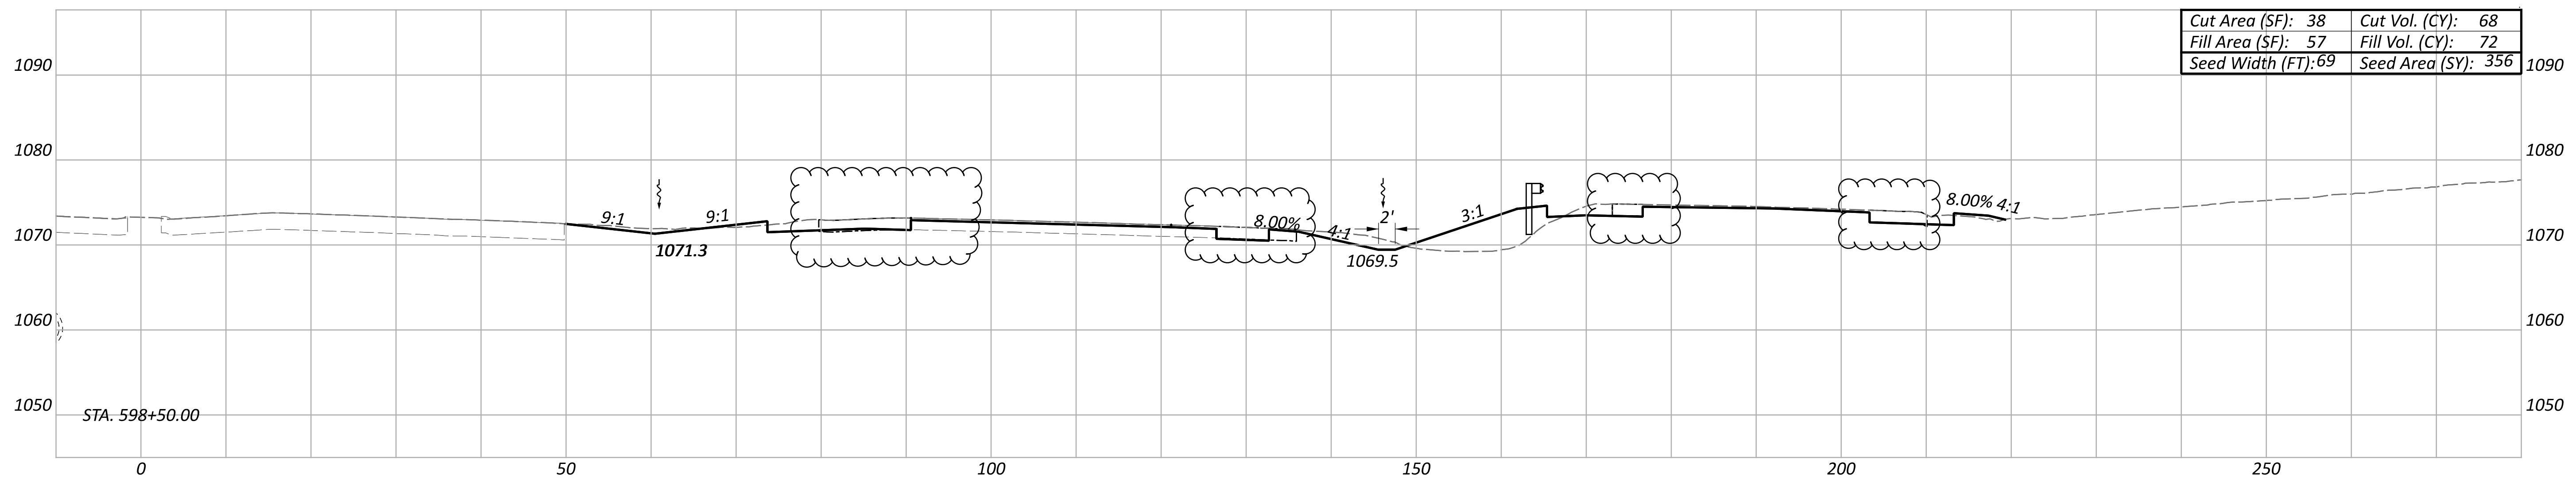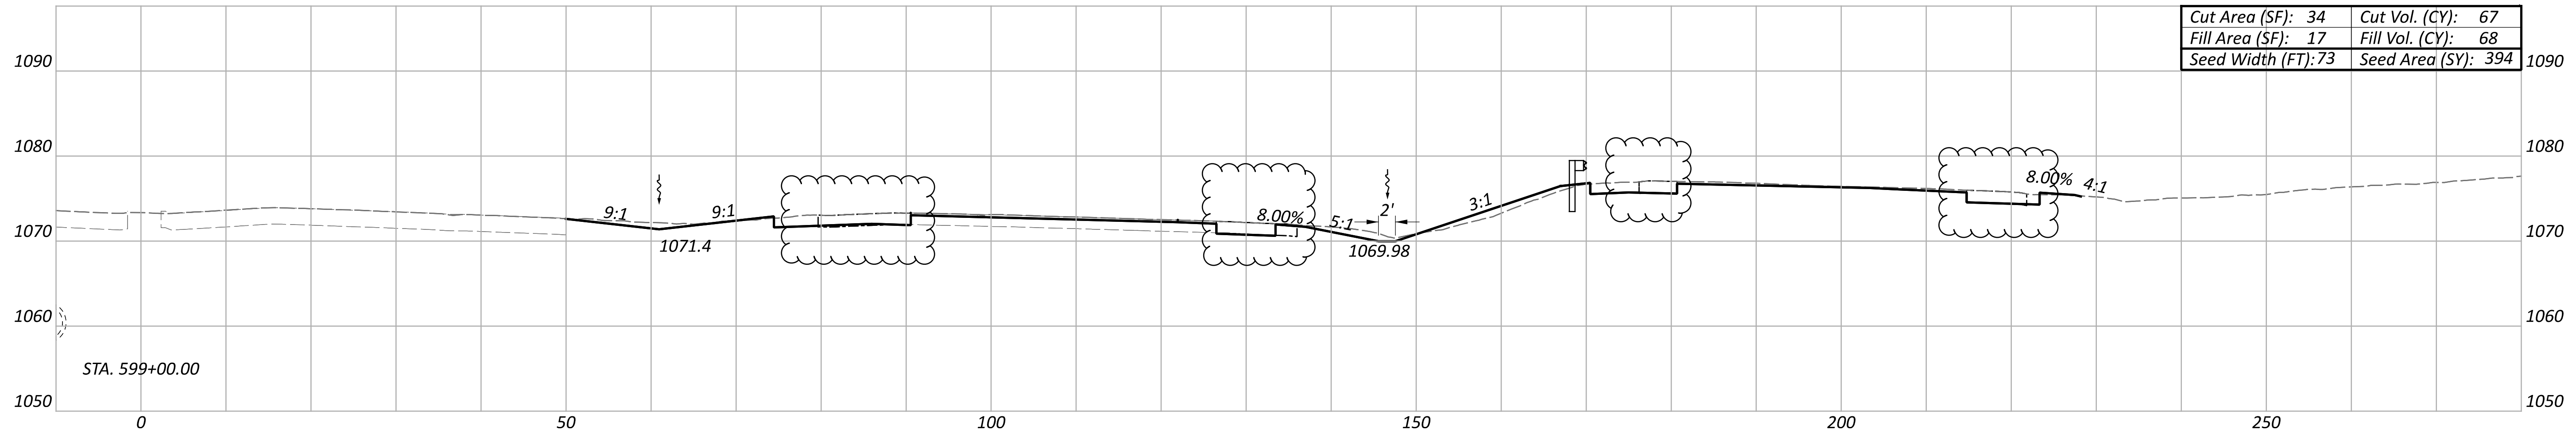

ITEM 202 - PAVEMENT REMOVED

CROSS SECTIONS
 STA. 598+00 TO STA. 599+00

DESIGN AGENCY



DESIGNER

AS

REVIEWER




KKP 12/31/22

PROJECT ID

113156

Sheet Totals		
Seeding	Cut	Fill
1044	200	169

SHEET	TOTAL
172	233

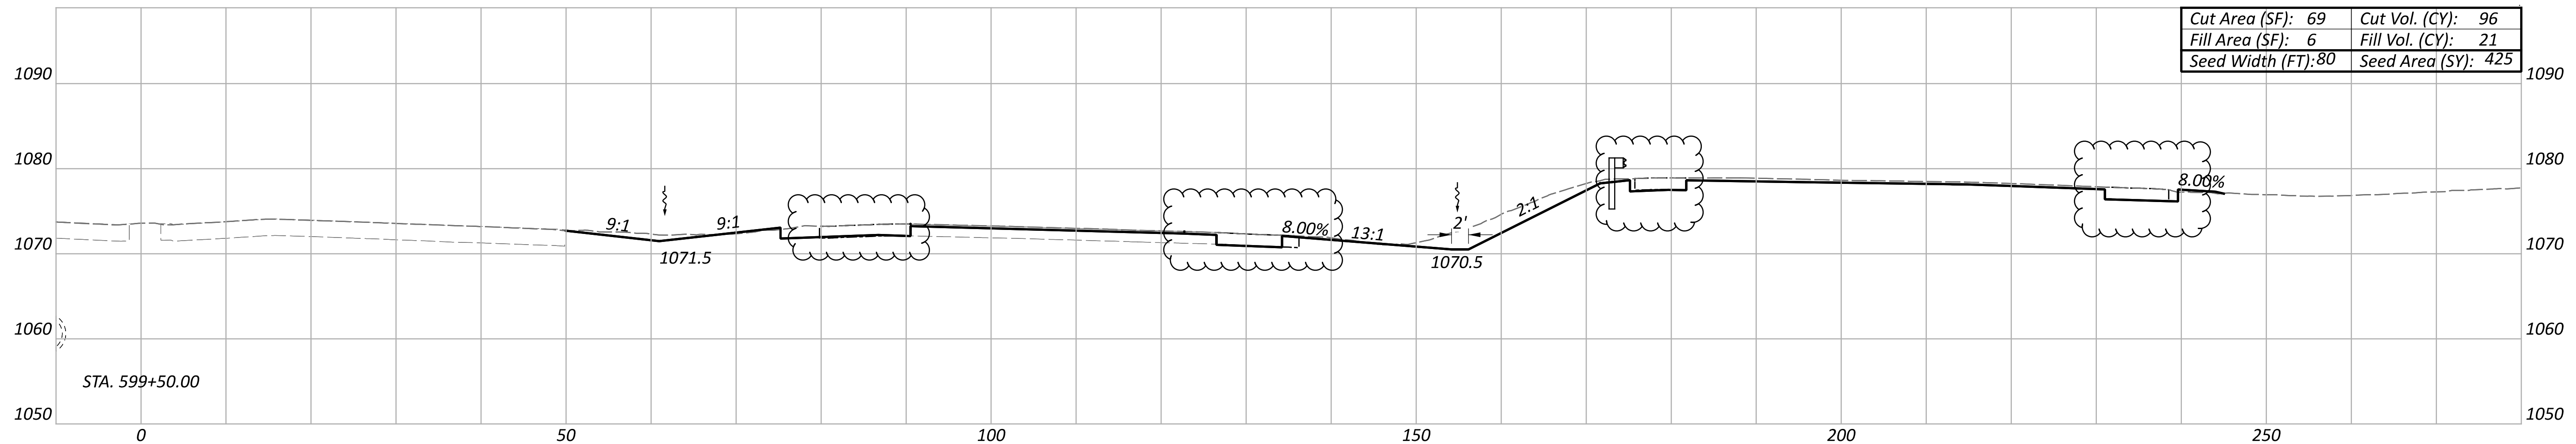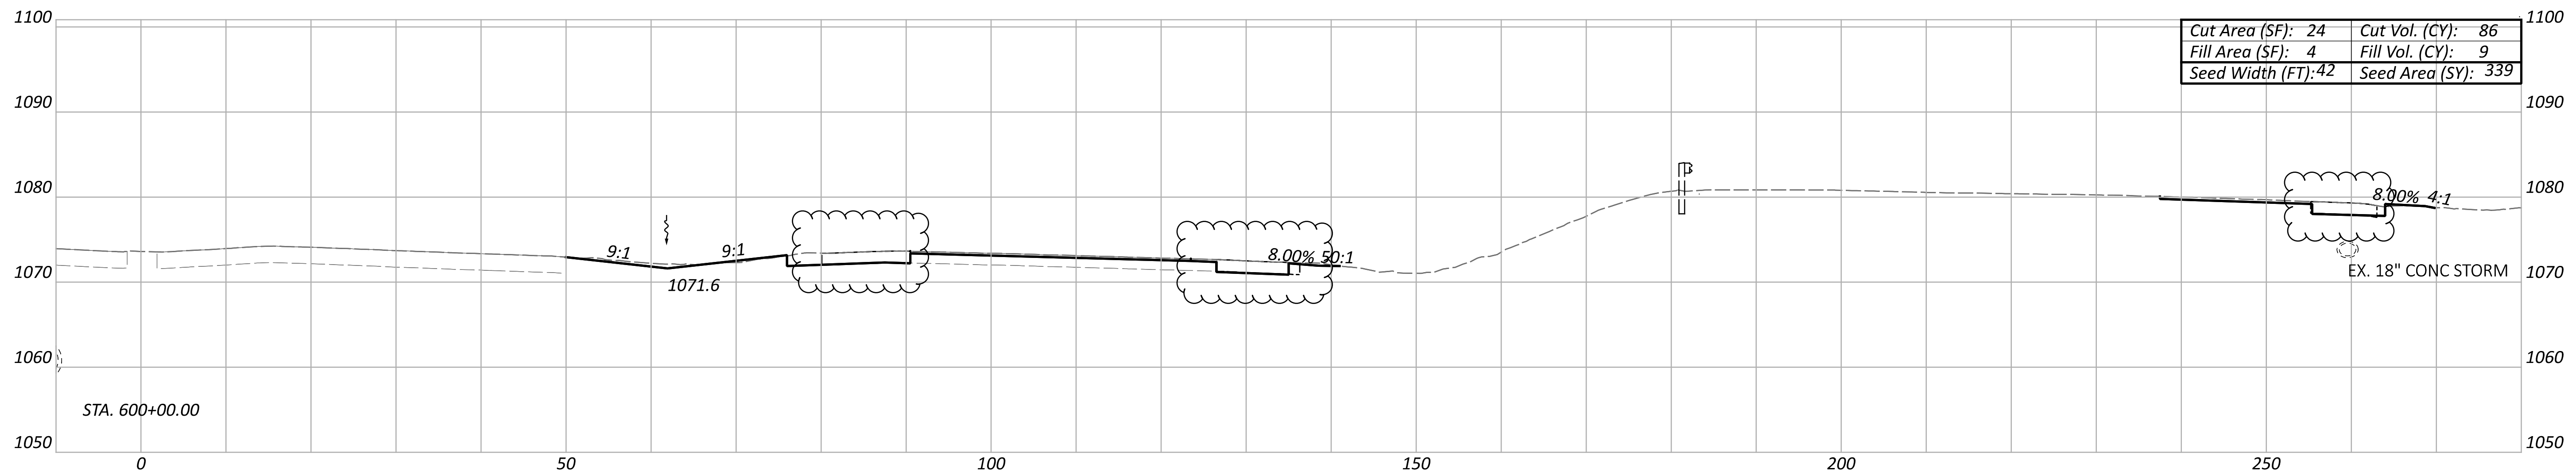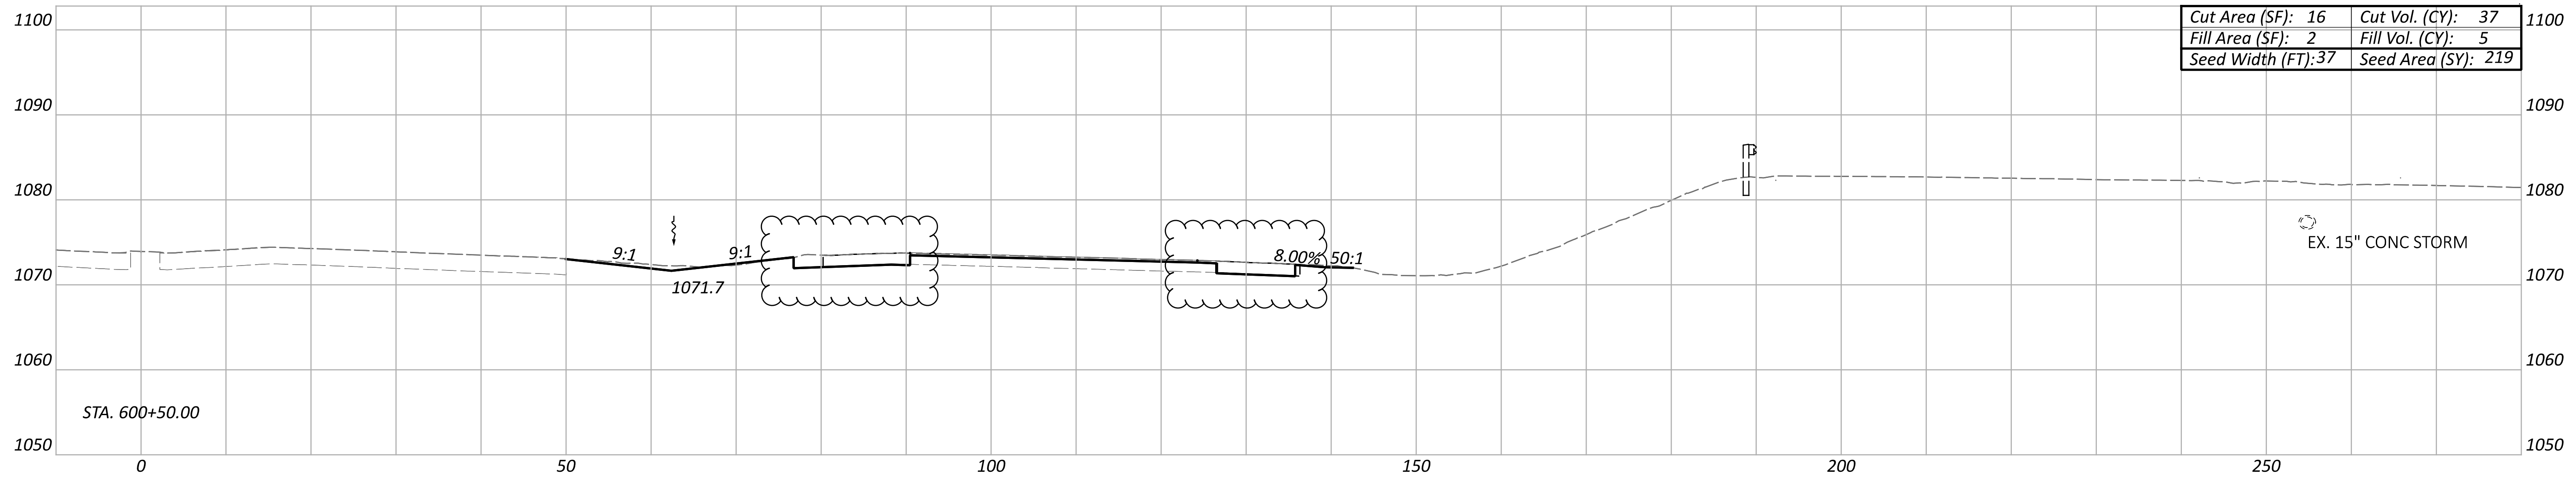

ITEM 202 - PAVEMENT REMOVED

CROSS SECTIONS
 STA. 599+50 TO STA. 600+50

DESIGN AGENCY



DESIGNER

AS

REVIEWER



KKP 12/31/22

PROJECT ID

113156

Sheet Totals		
Seeding	Cut	Fill
983	219	35

SHEET	TOTAL
173	233

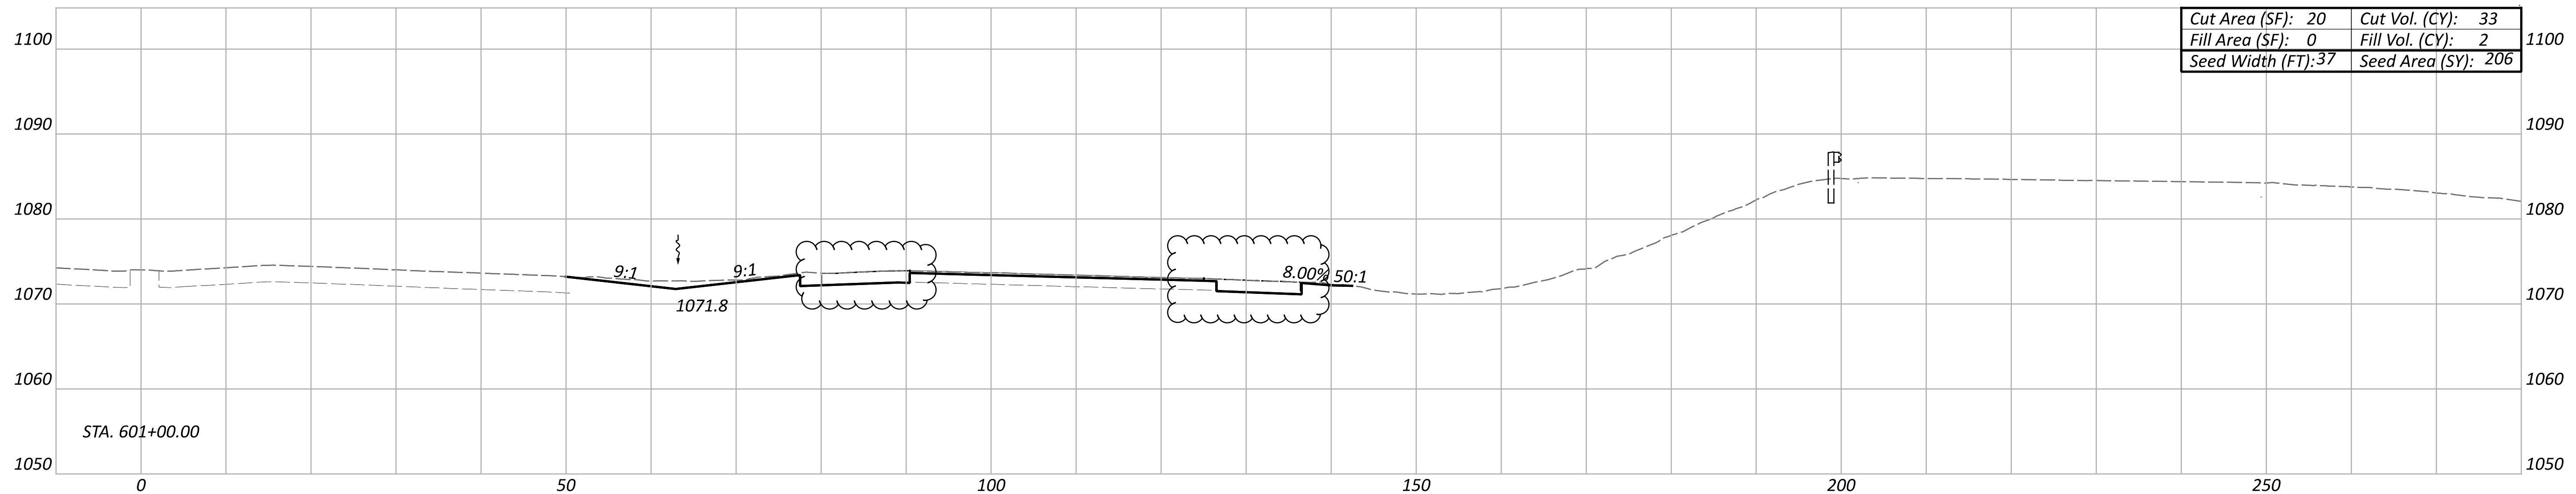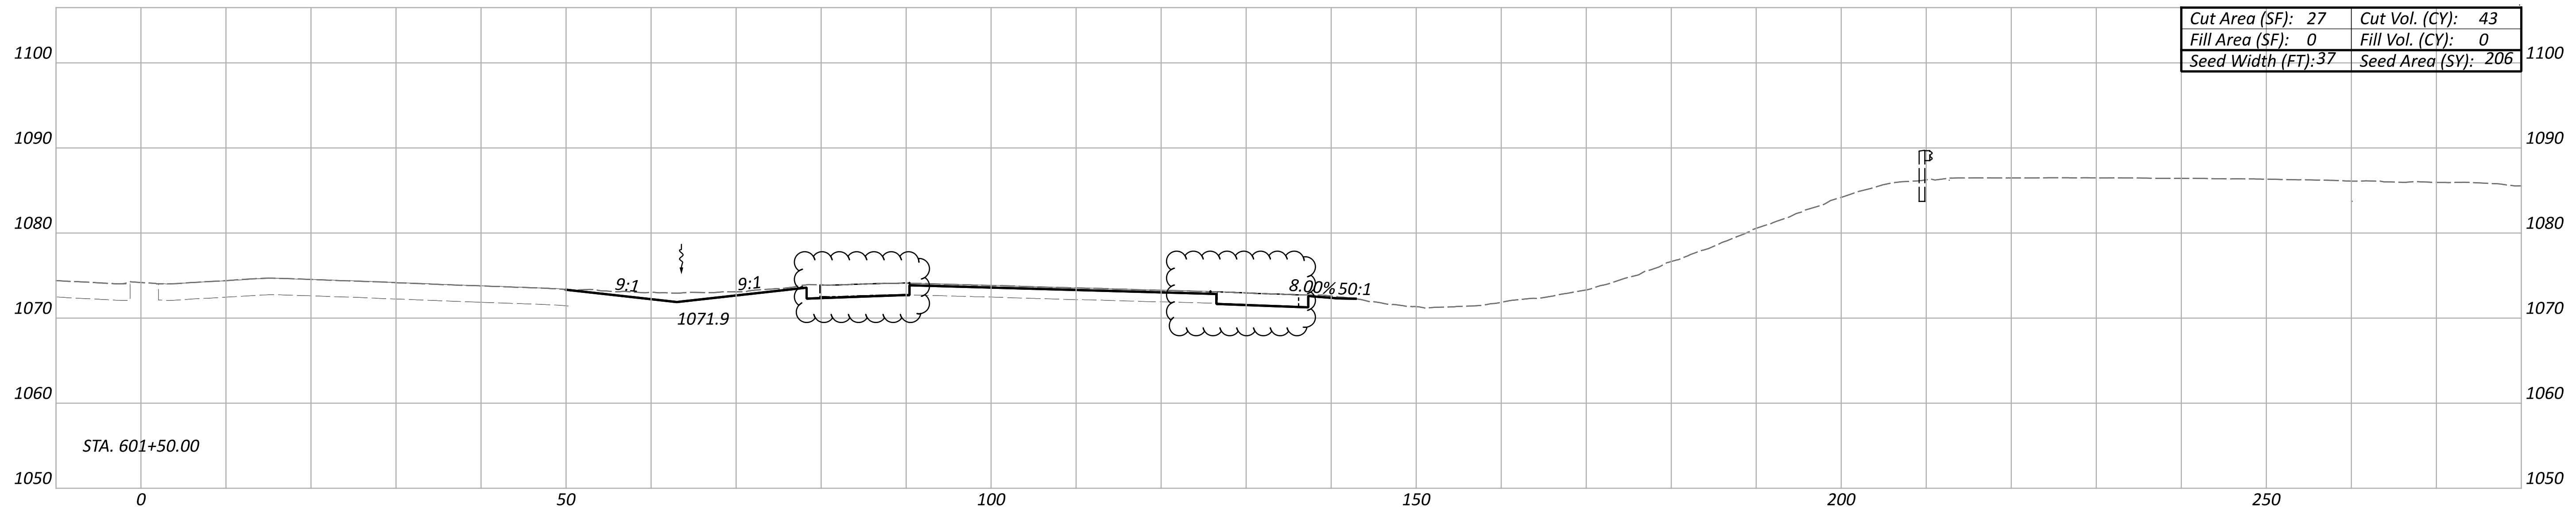

ITEM 202 - PAVEMENT REMOVED

CROSS SECTIONS
 STA. 601+00 TO STA. 601+50

DESIGN AGENCY



DESIGNER

AS

REVIEWER



KKP 12/31/22

PROJECT ID

113156

Sheet Totals		
Seeding	Cut	Fill
412	76	2

SHEET	TOTAL
174	233

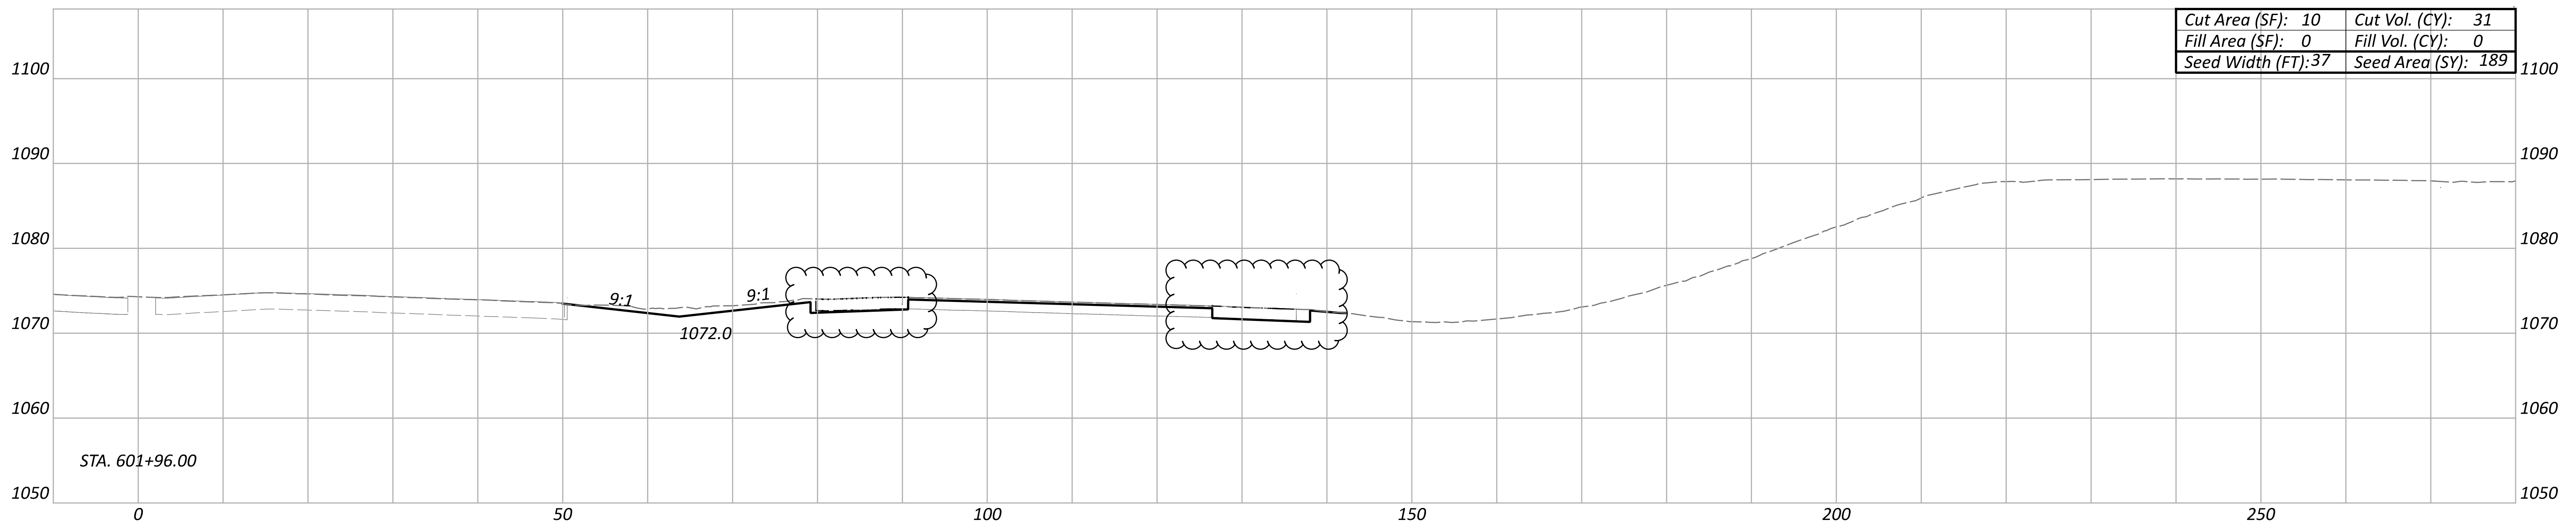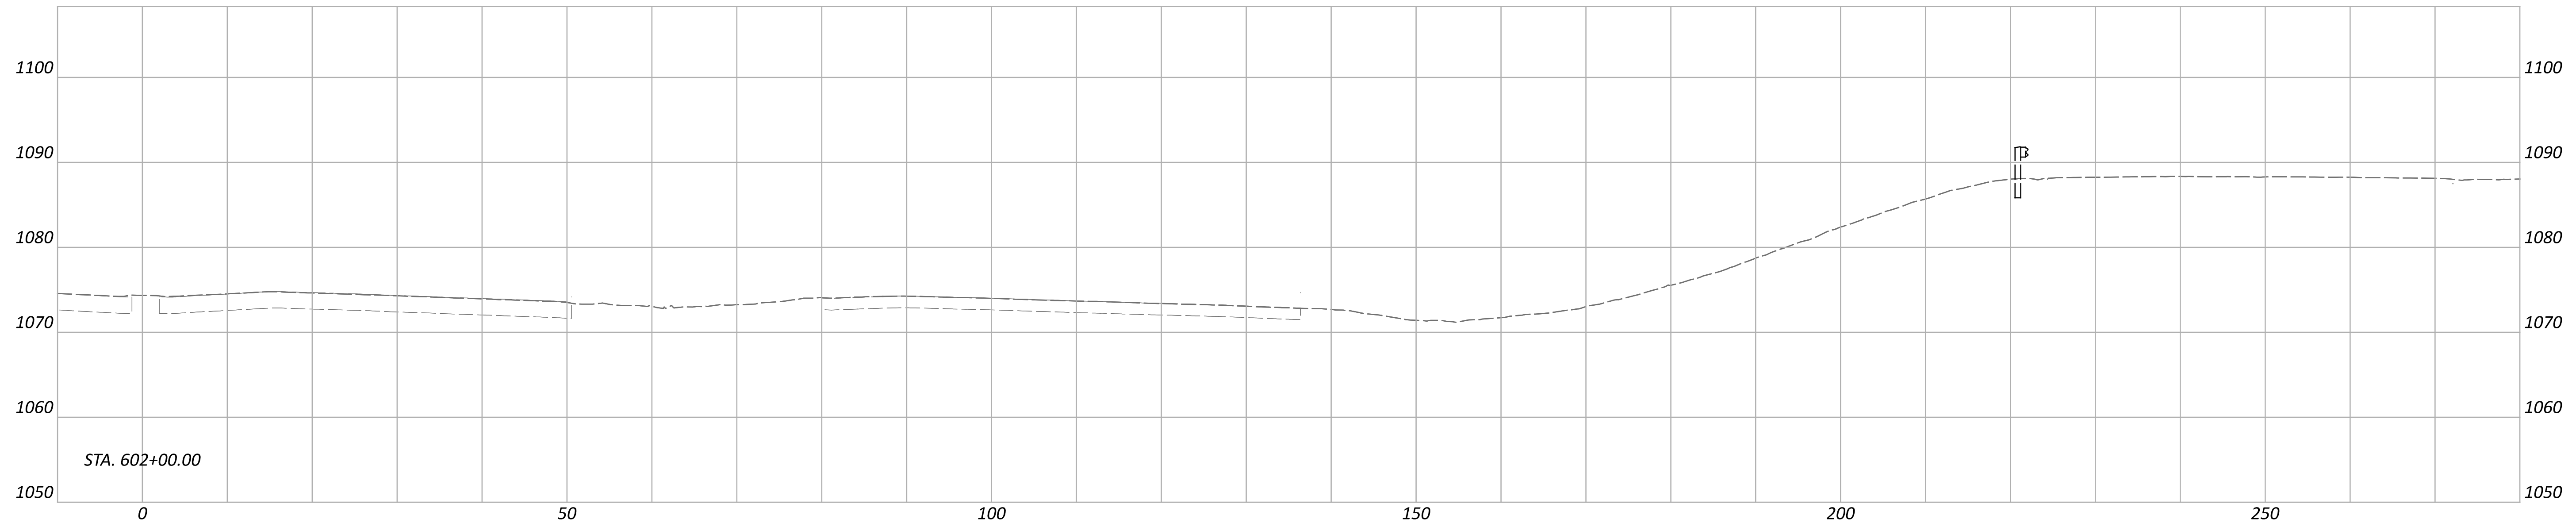

ITEM 202 - PAVEMENT REMOVED

Sheet Totals			113156	
Seeding	Cut	Fill	SHEET	TOTAL
189	33	0	175	233

CROSS SECTIONS
 END PROJECT TO STA. 602+00


DESIGN AGENCY



DESIGNER
 AS

REVIEWER
 KKP 12/31/22

PROJECT ID
 113156

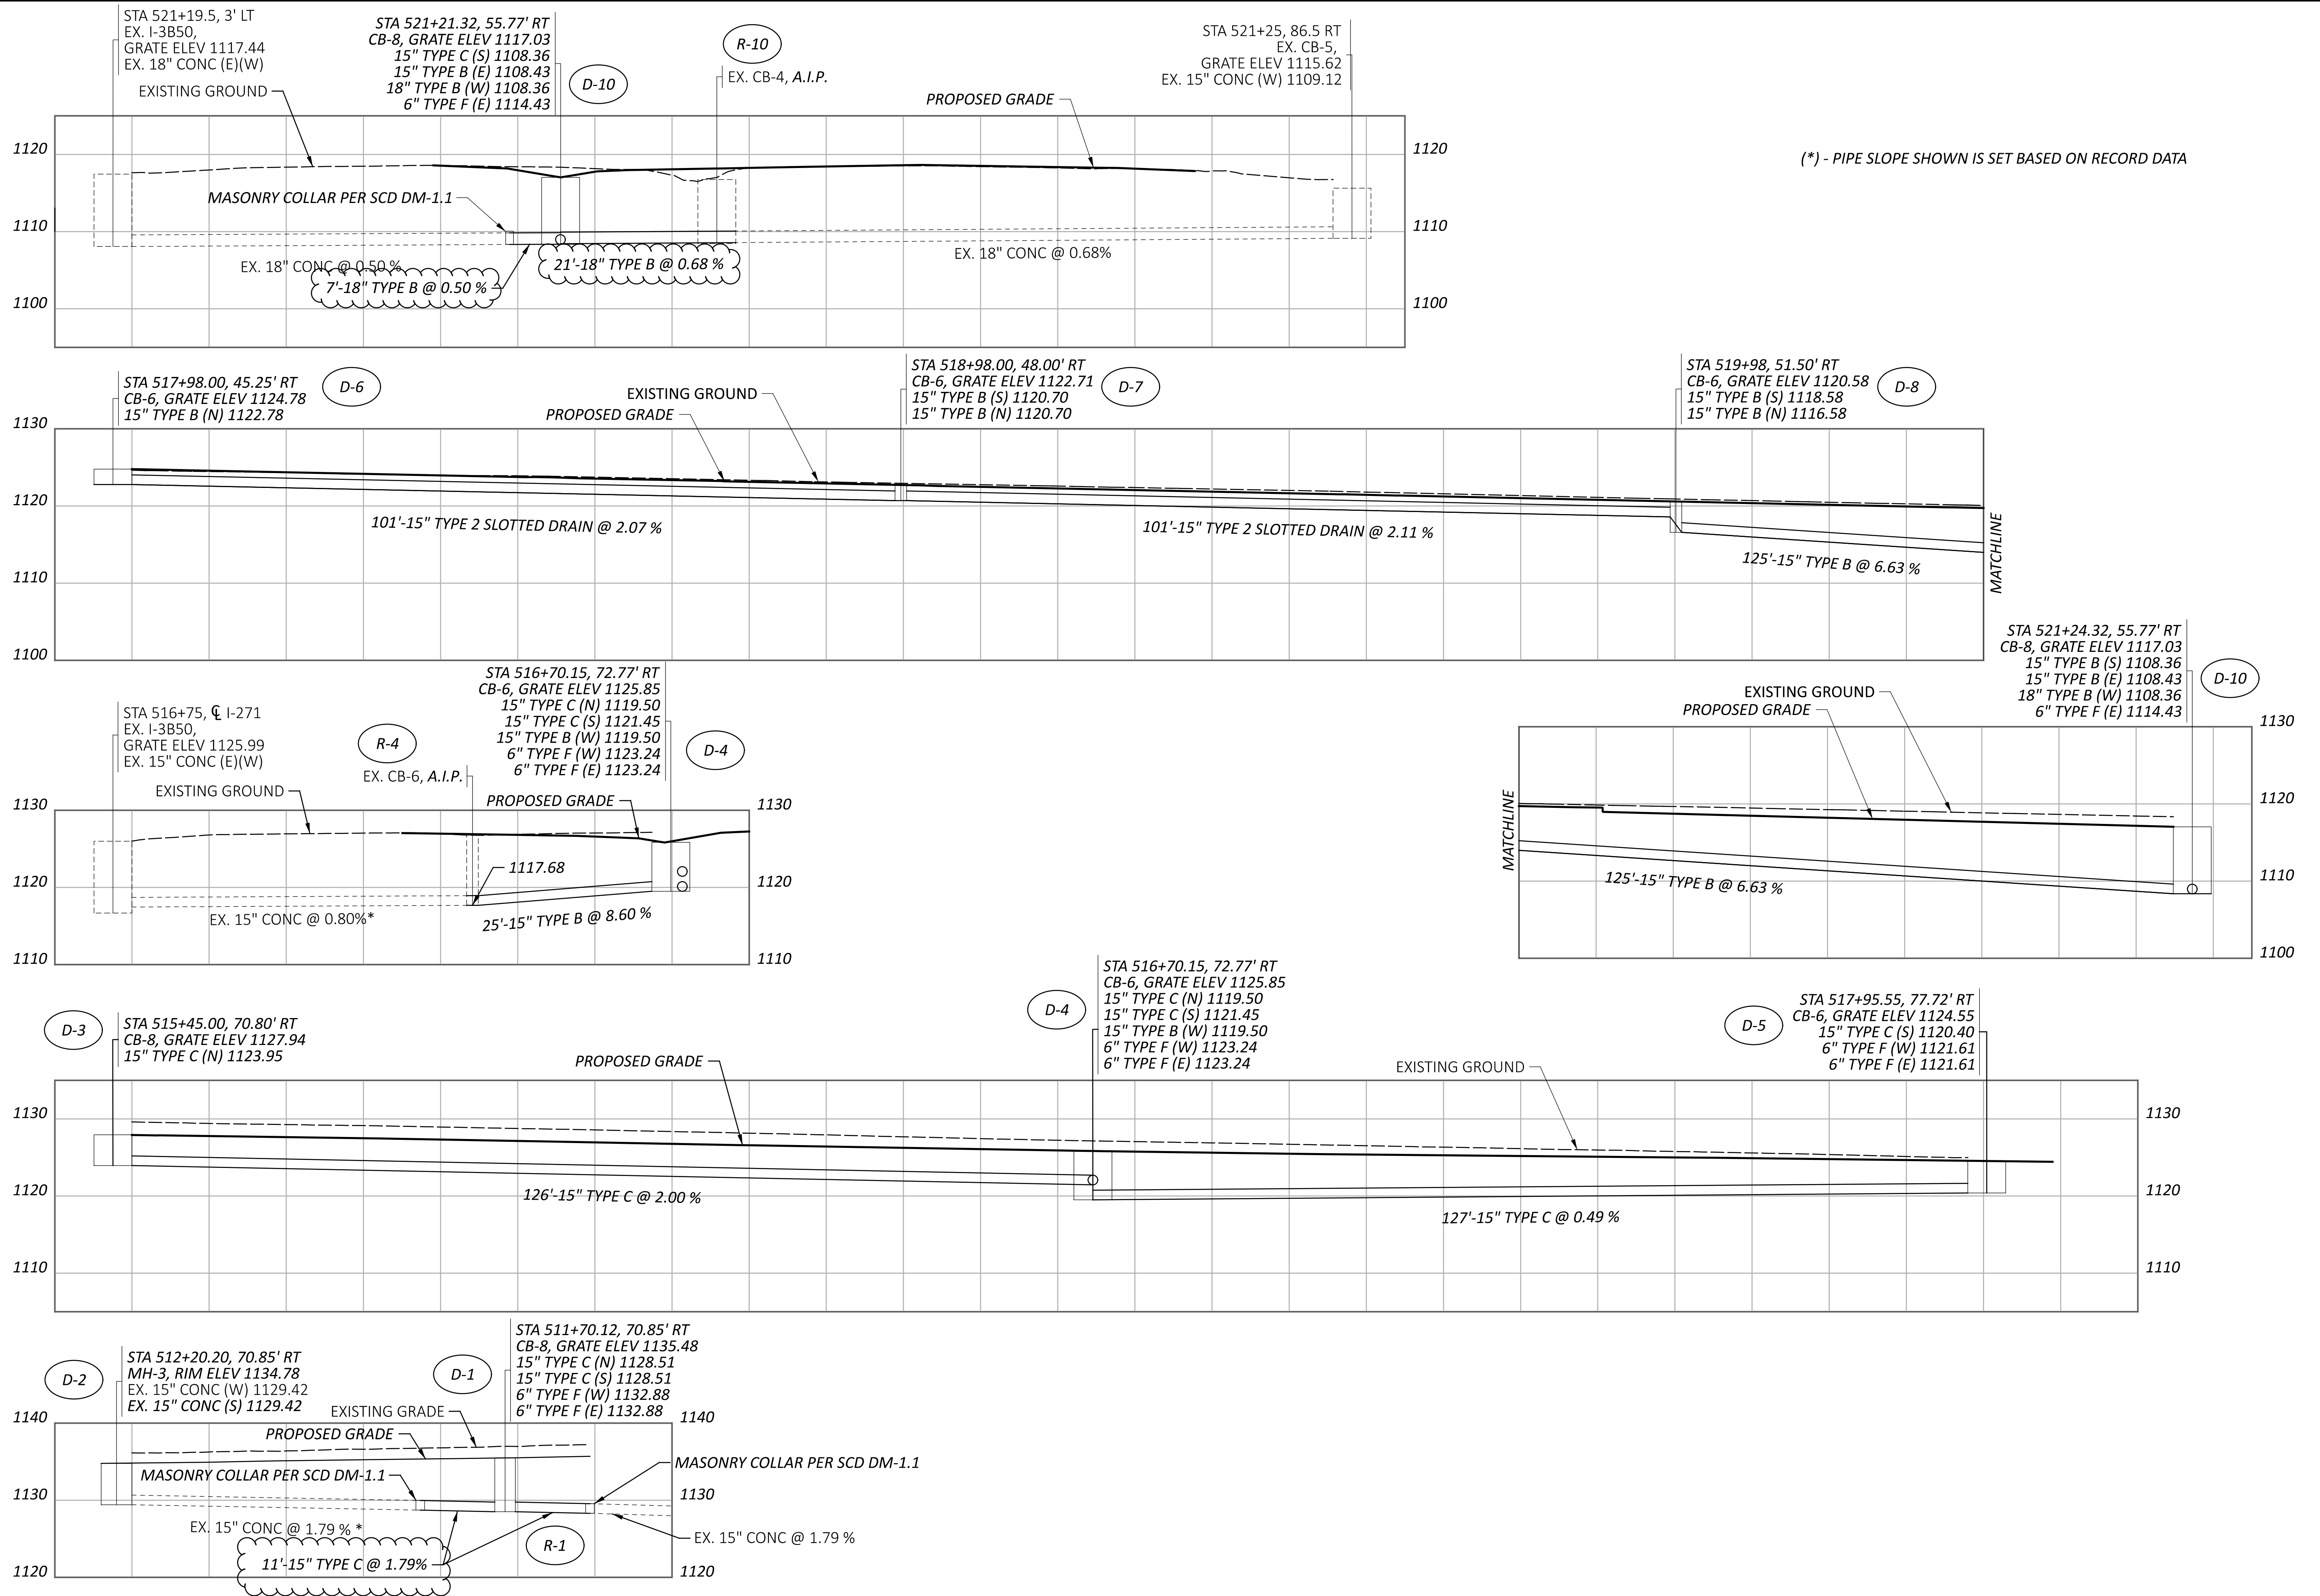


STORM SEWER PROFILES
I.R. 271


DESIGN AGENCY



DESIGNER	KKP
REVIEWER	
MTD	01/04/23
PROJECT ID	113156
SHEET	TOTAL
195	233

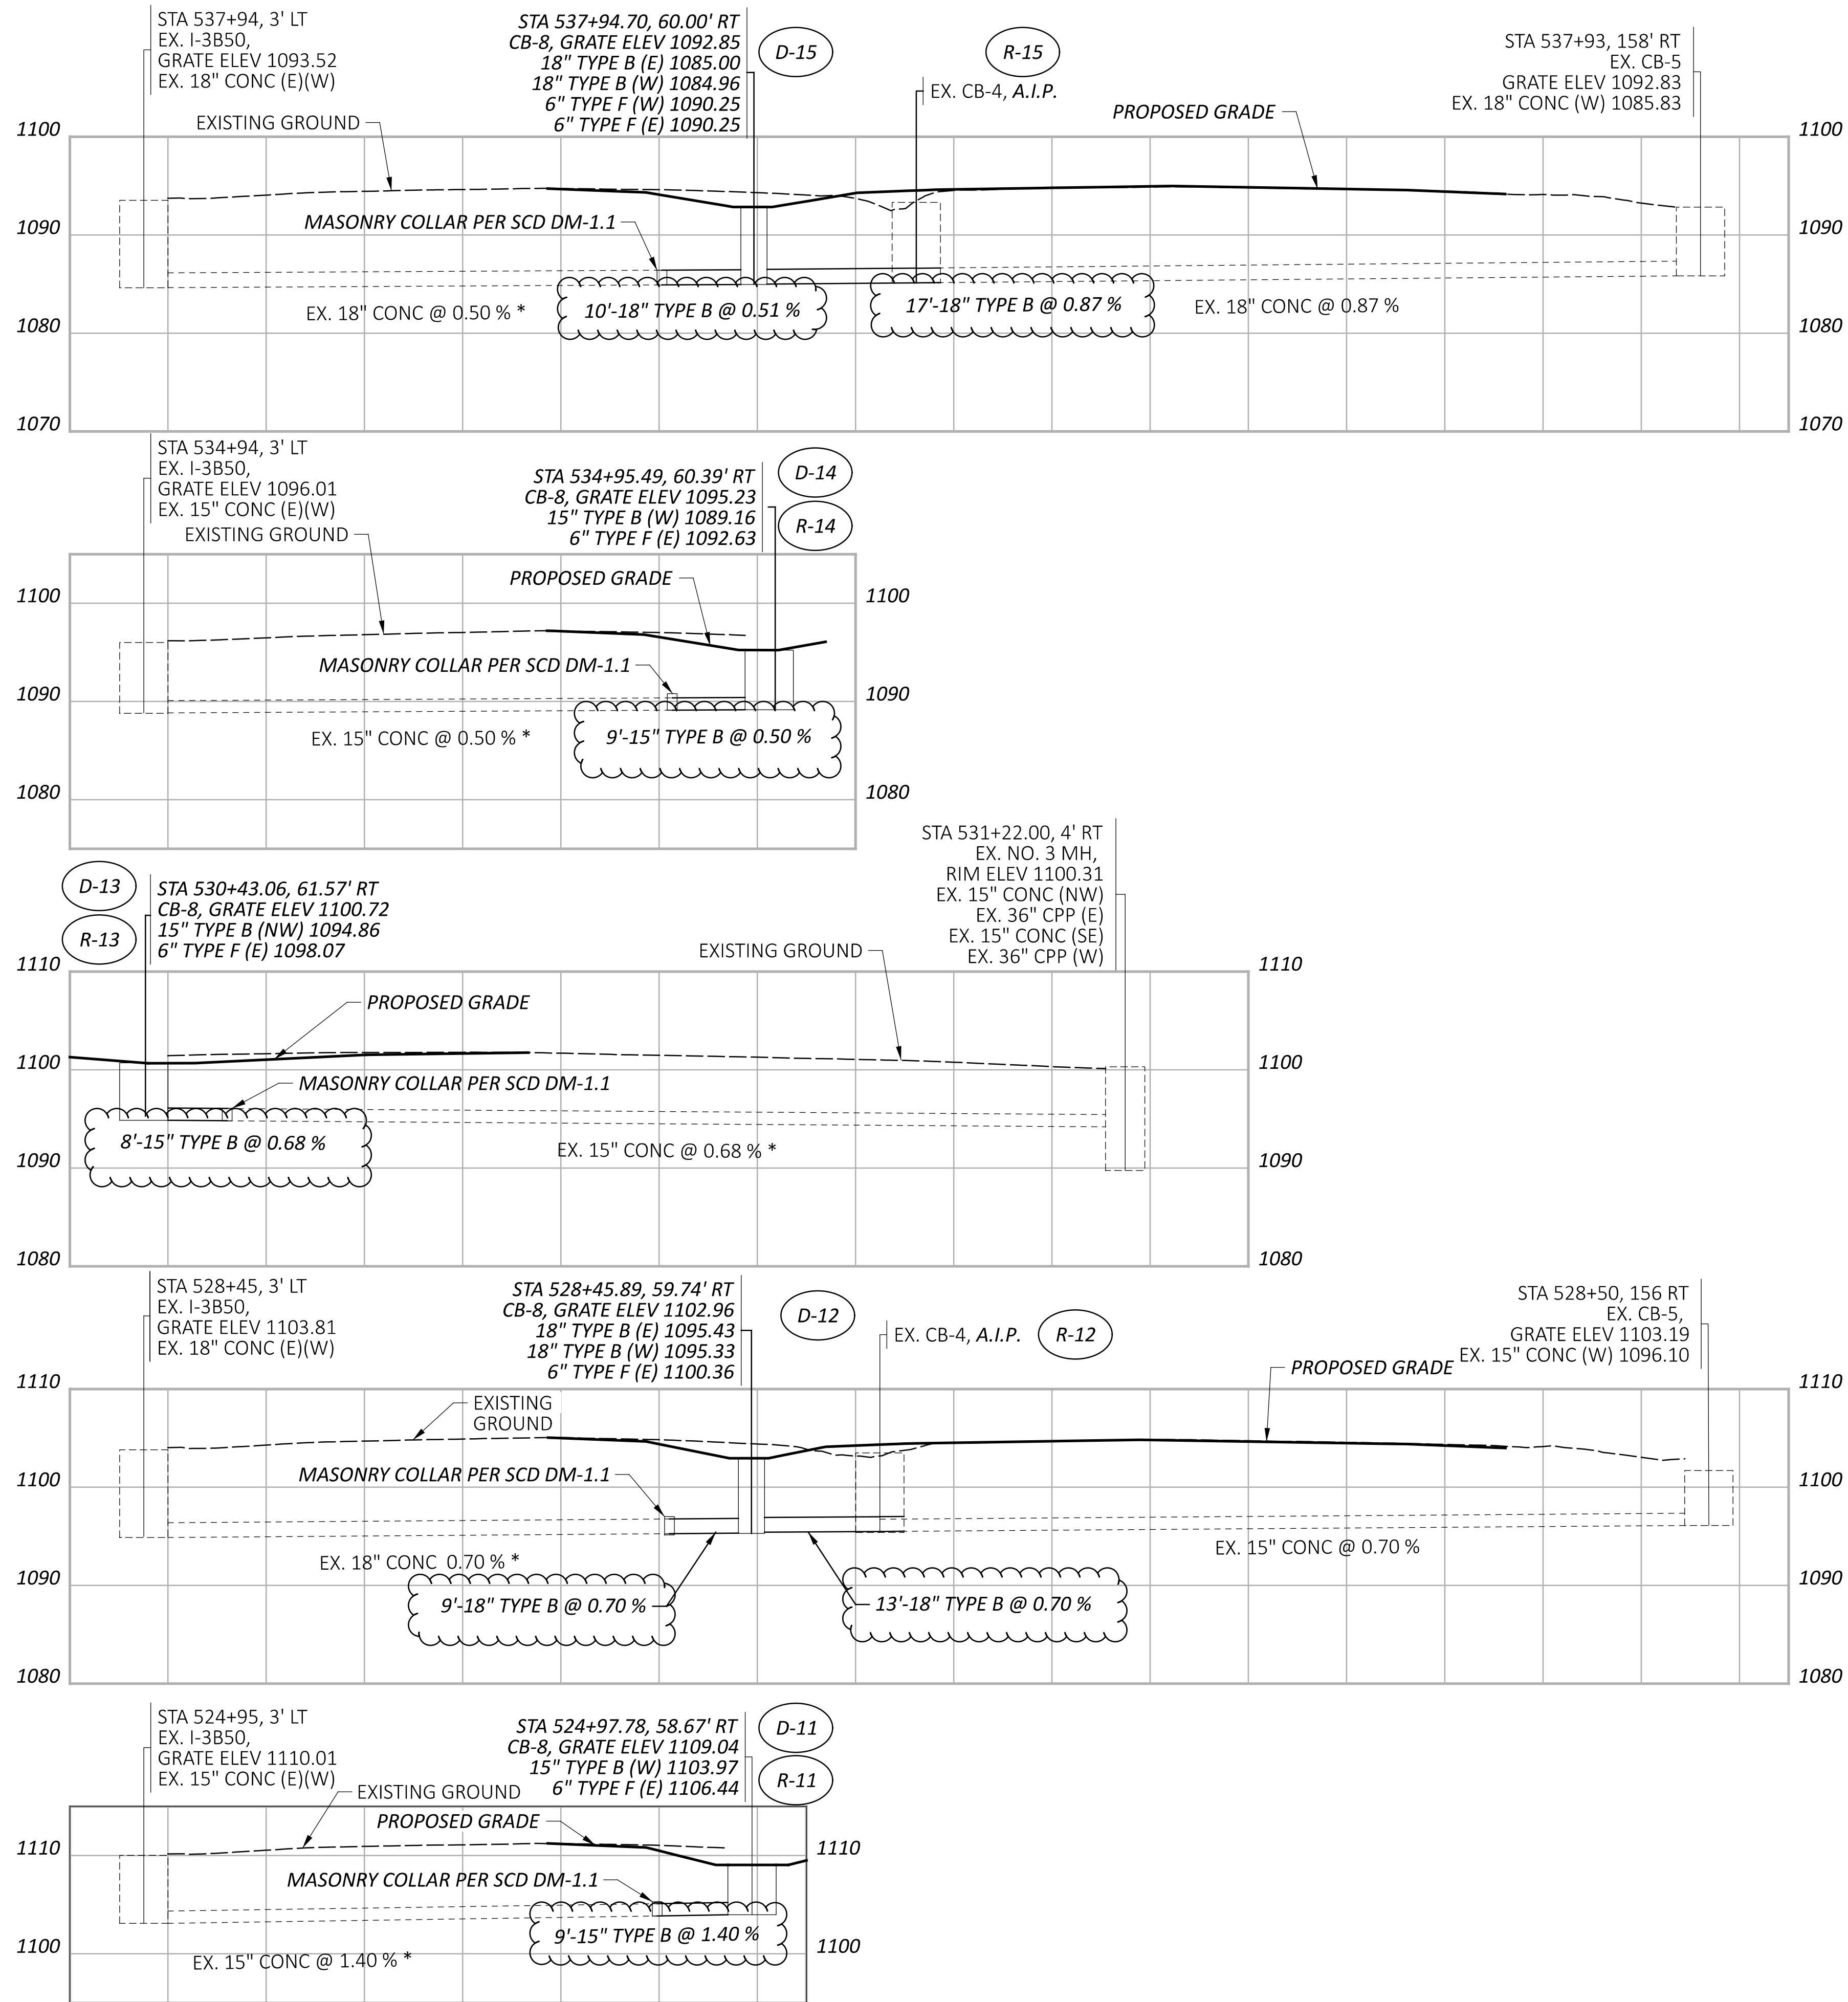

(*) PIPE SLOPE SHOWN IS SET BASED ON RECORD DATA

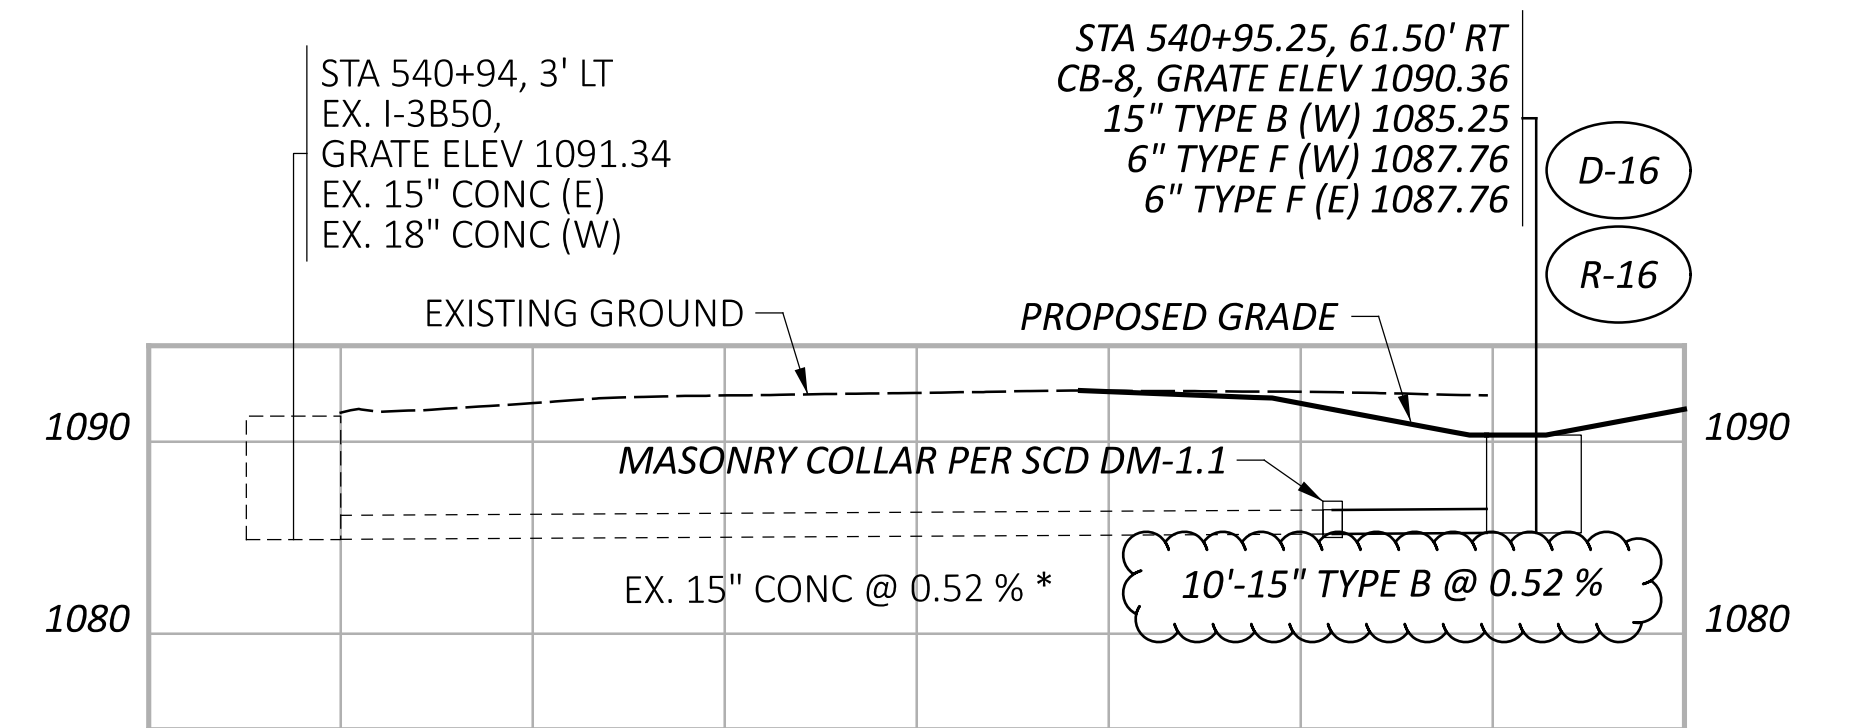

STORM SEWER PROFILES
I.R. 271

DESIGN AGENCY




DESIGNER
KKP






REVIEWER
MTD 01/04/23







PROJECT ID
113156

SHEET	TOTAL
196	233




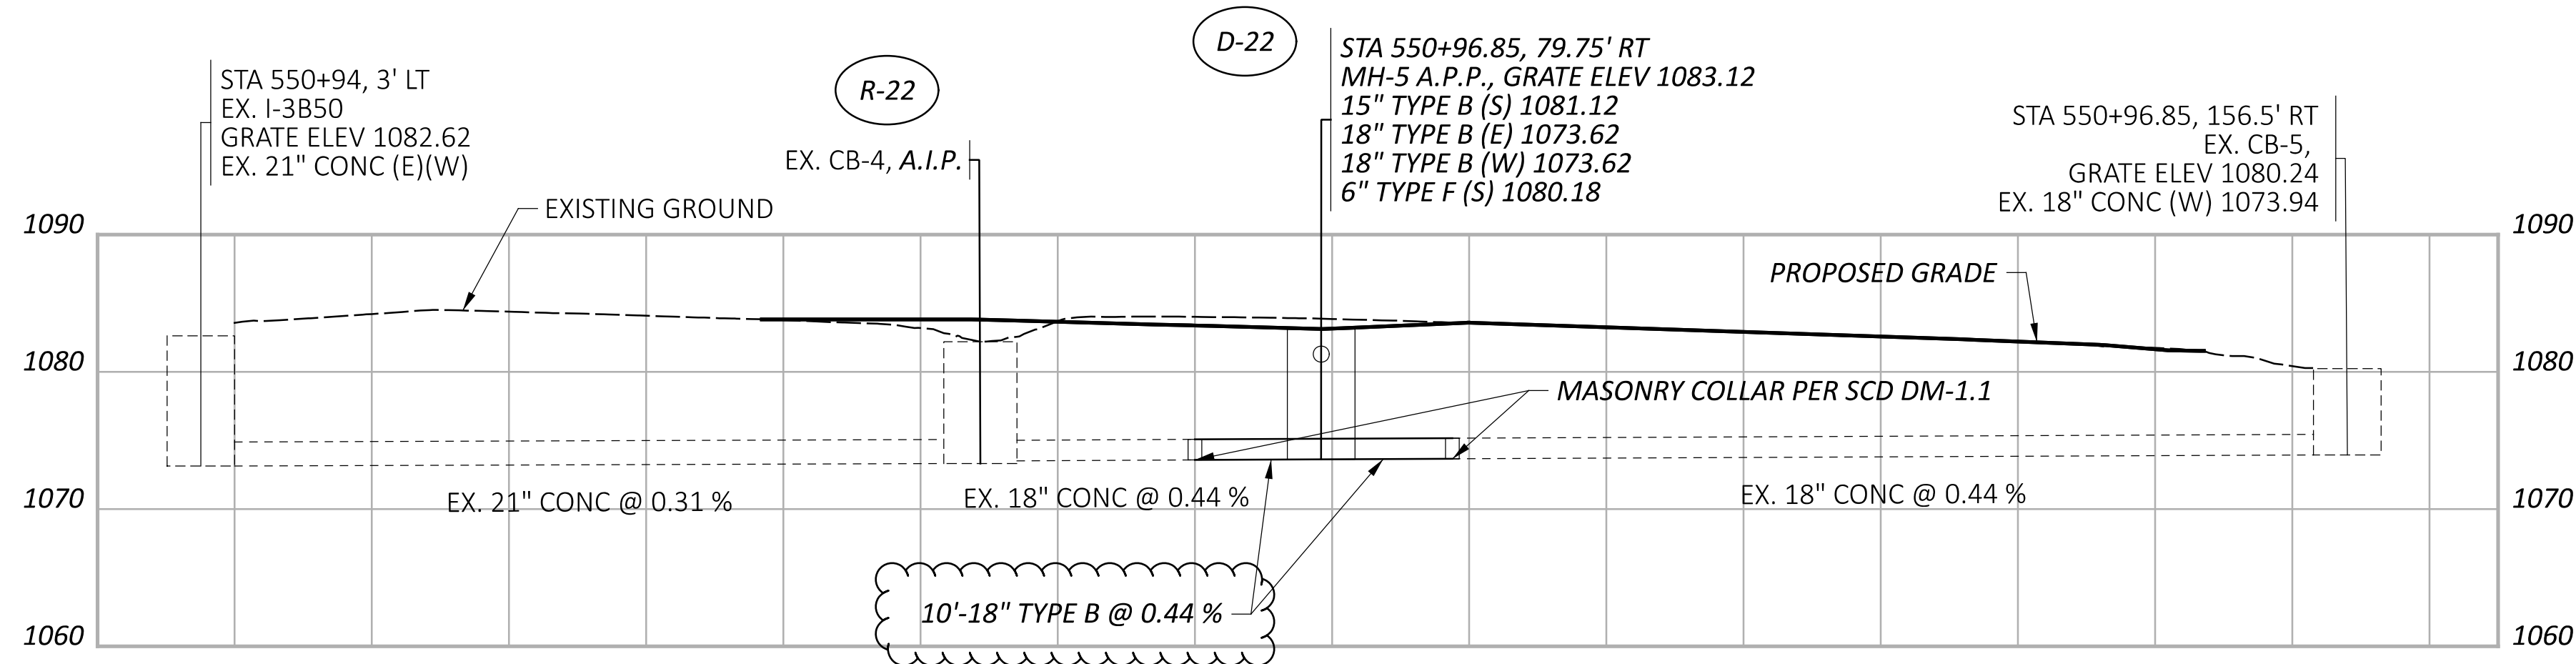



(* PIPE SLOPE SHOWN IS SET BASED ON RECORD DATA

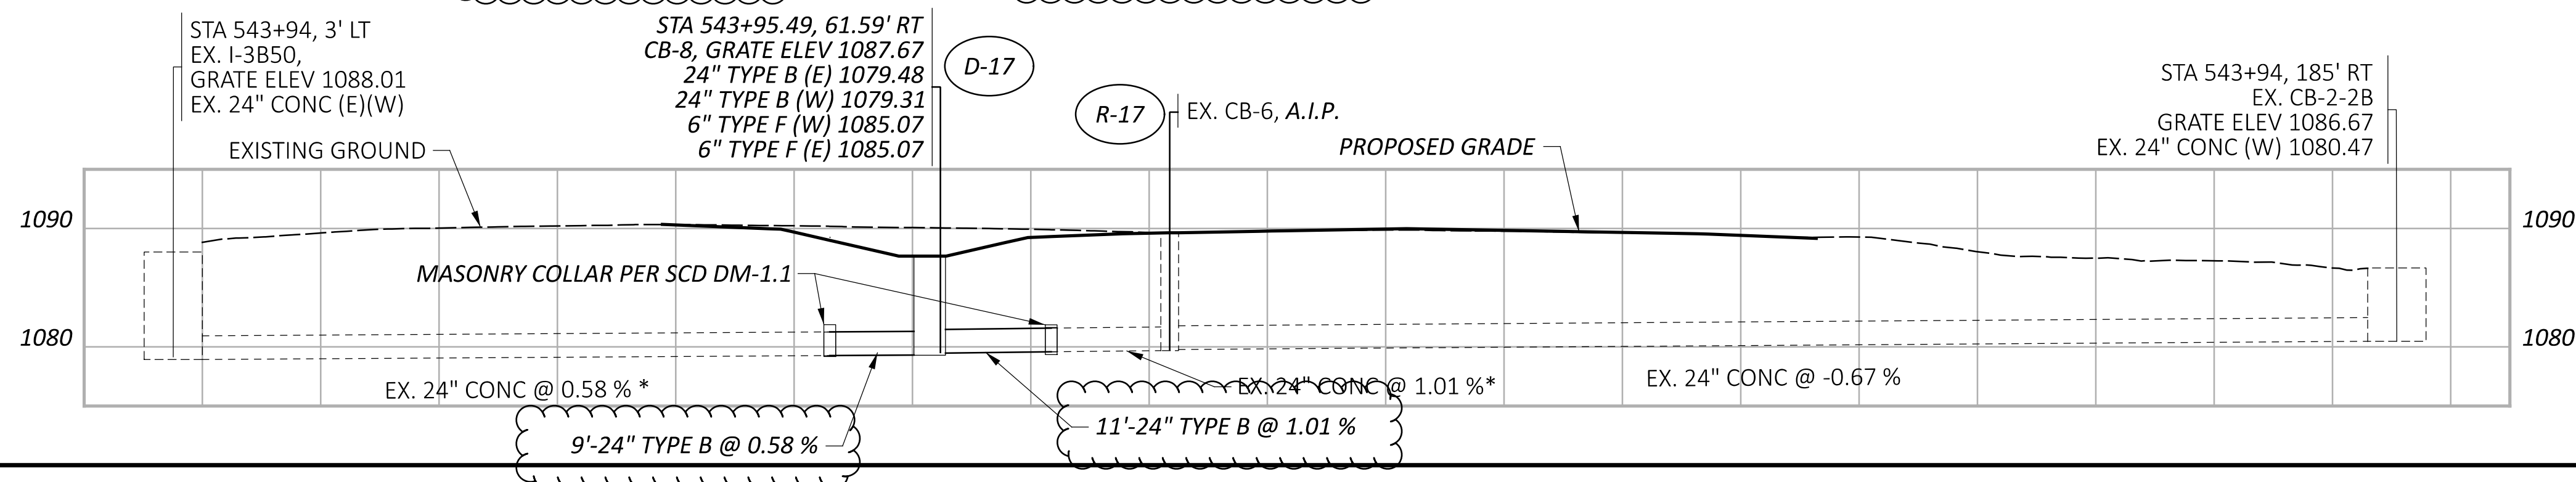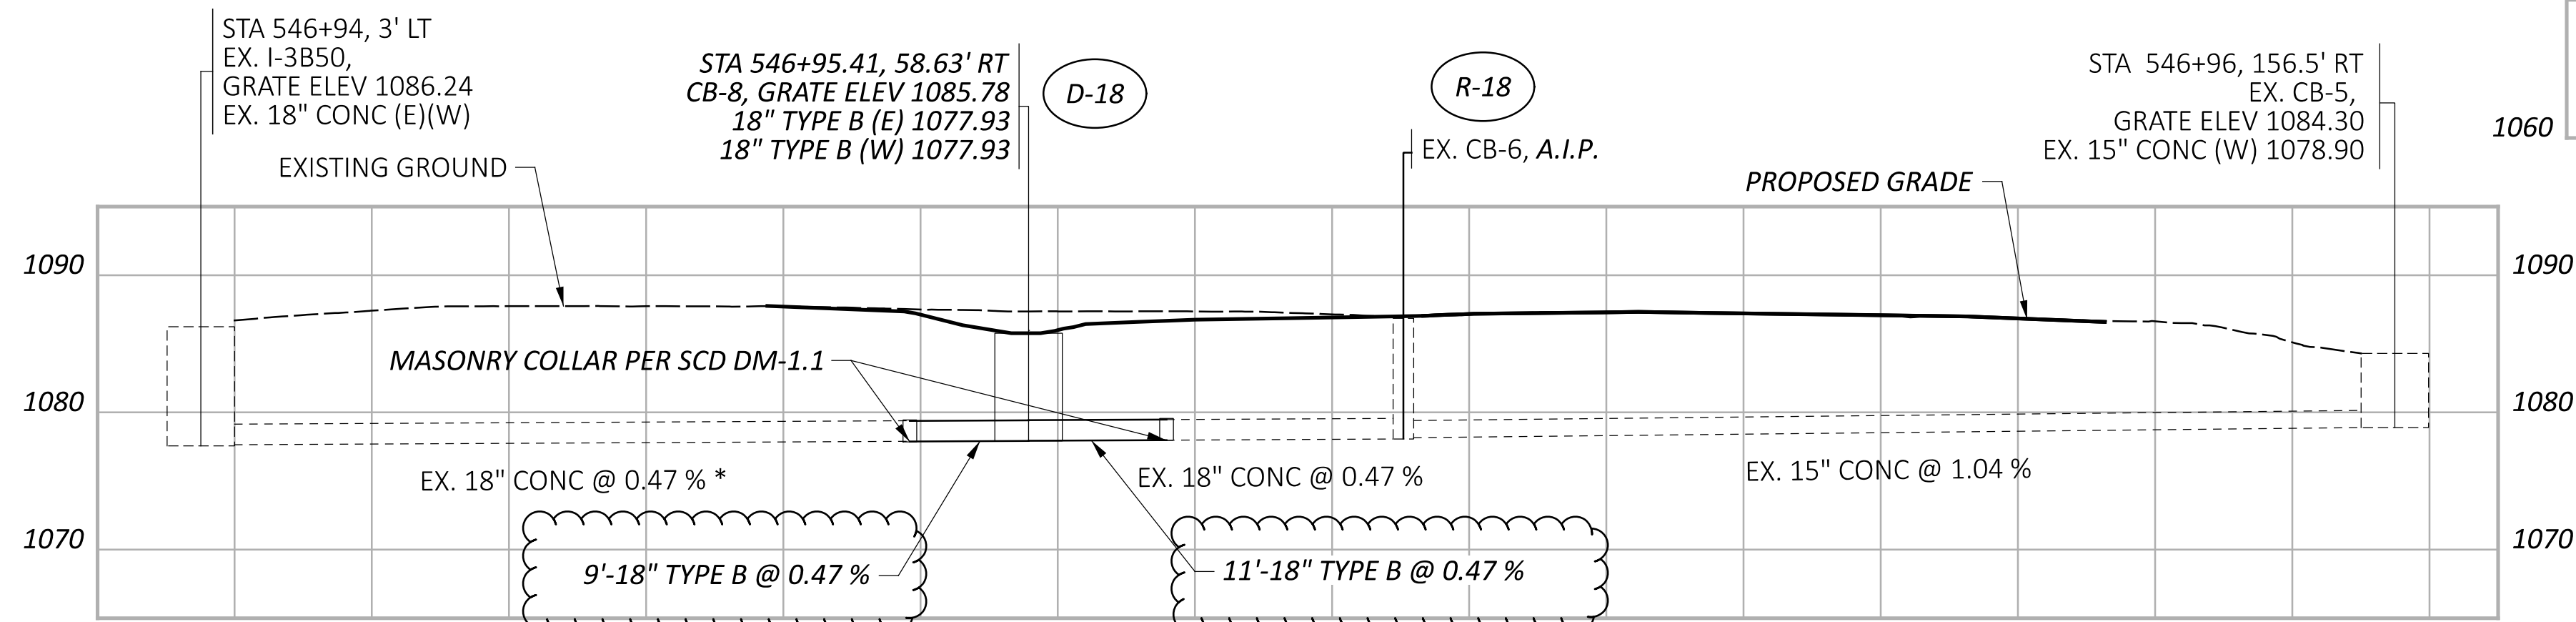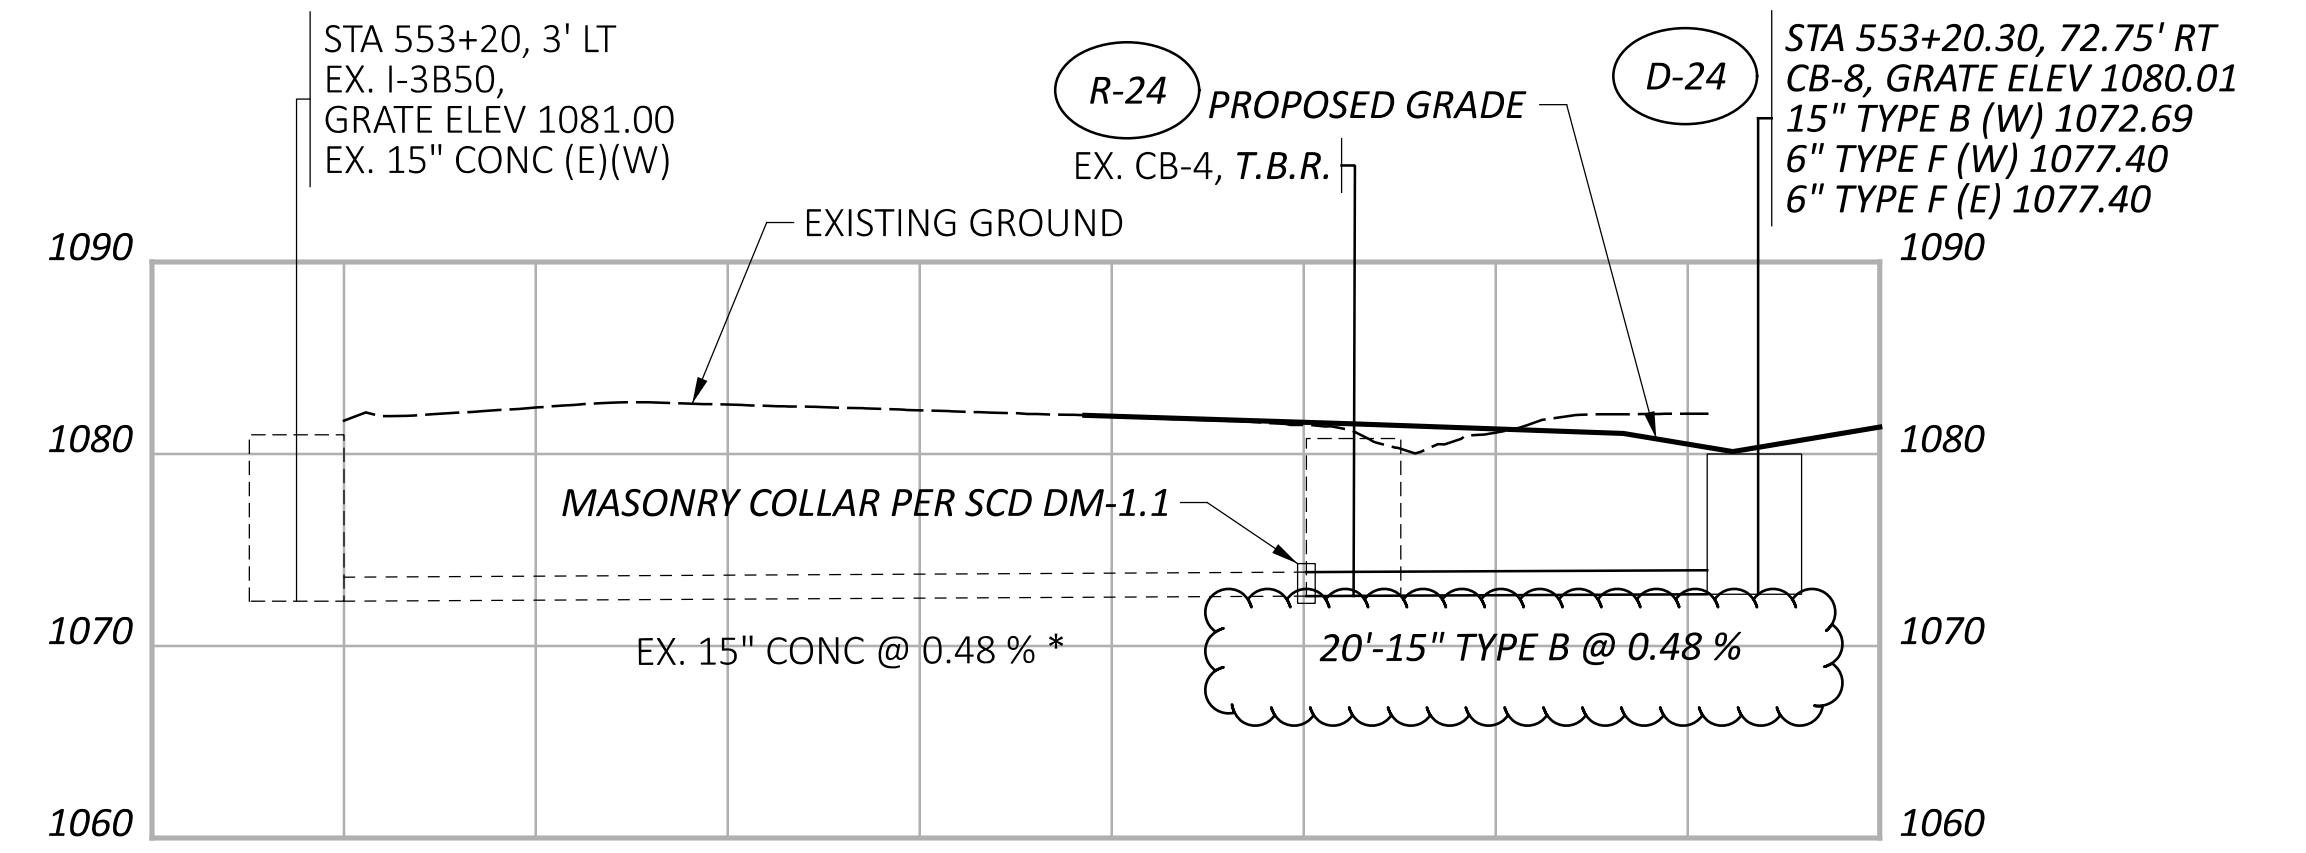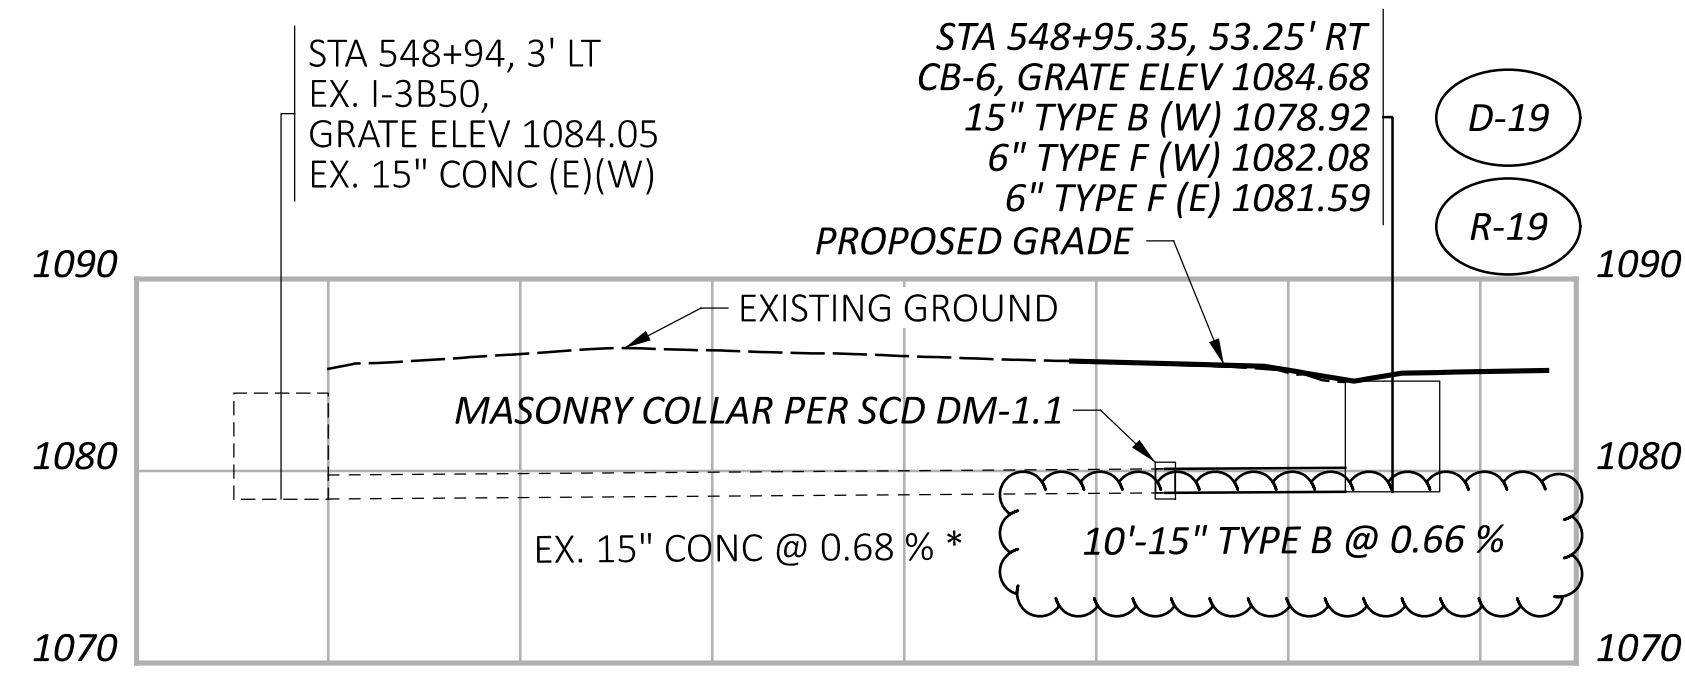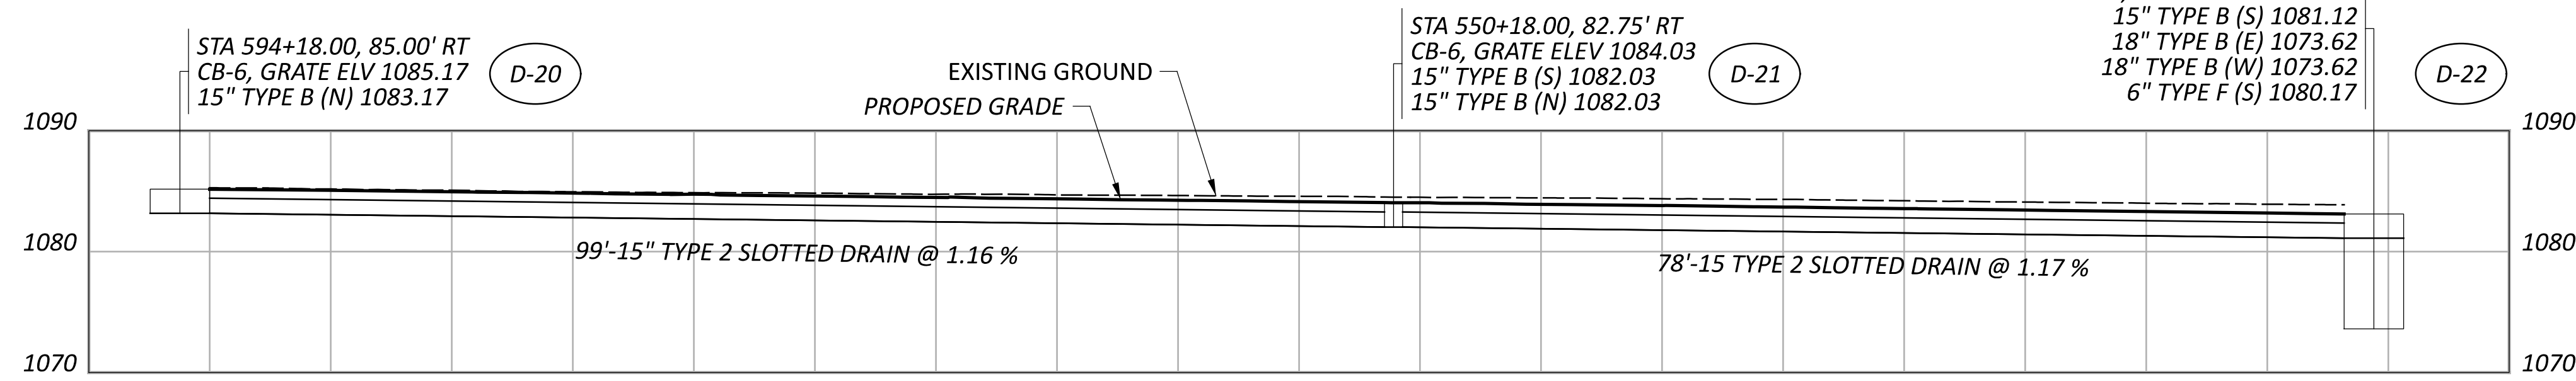

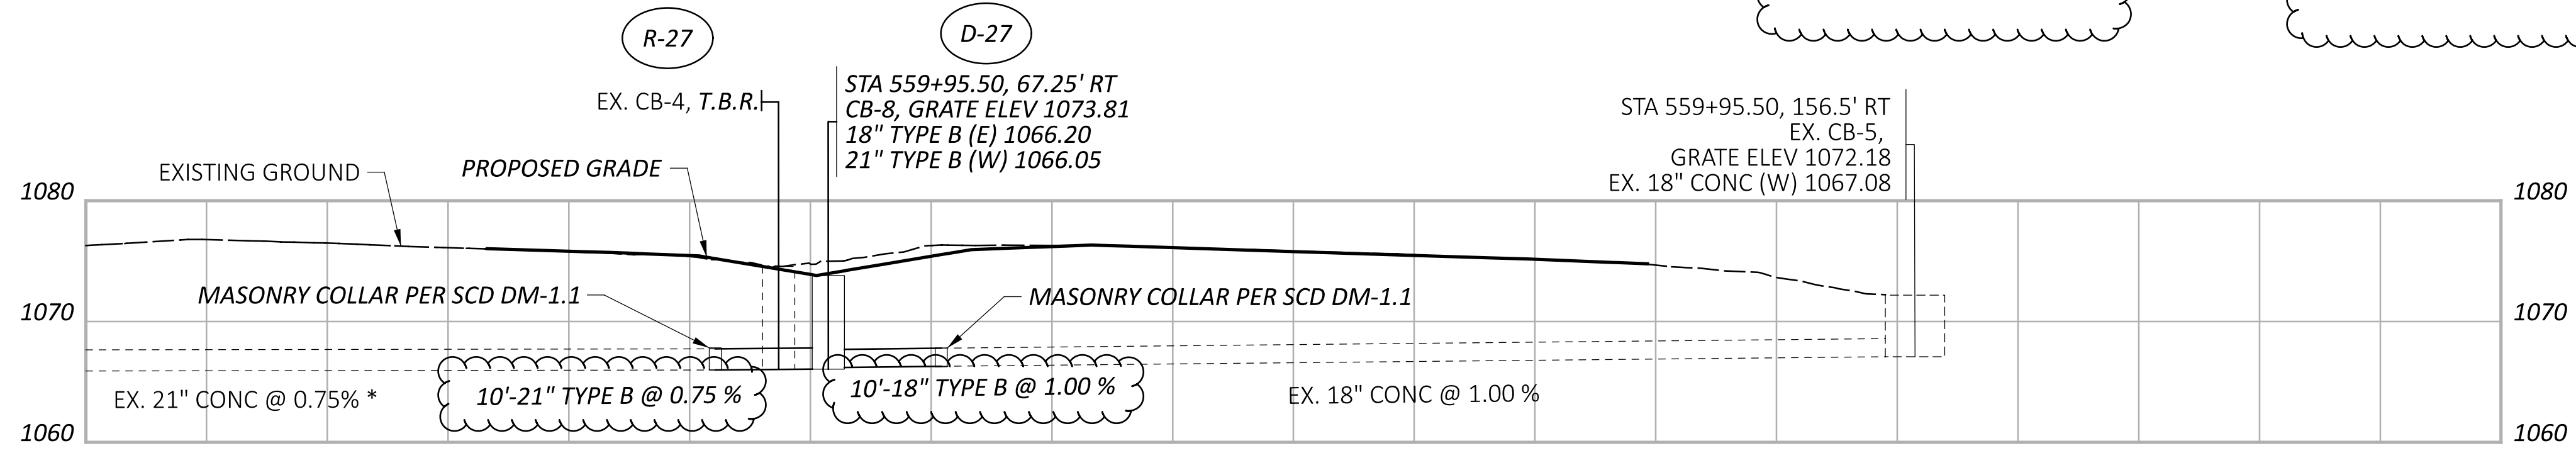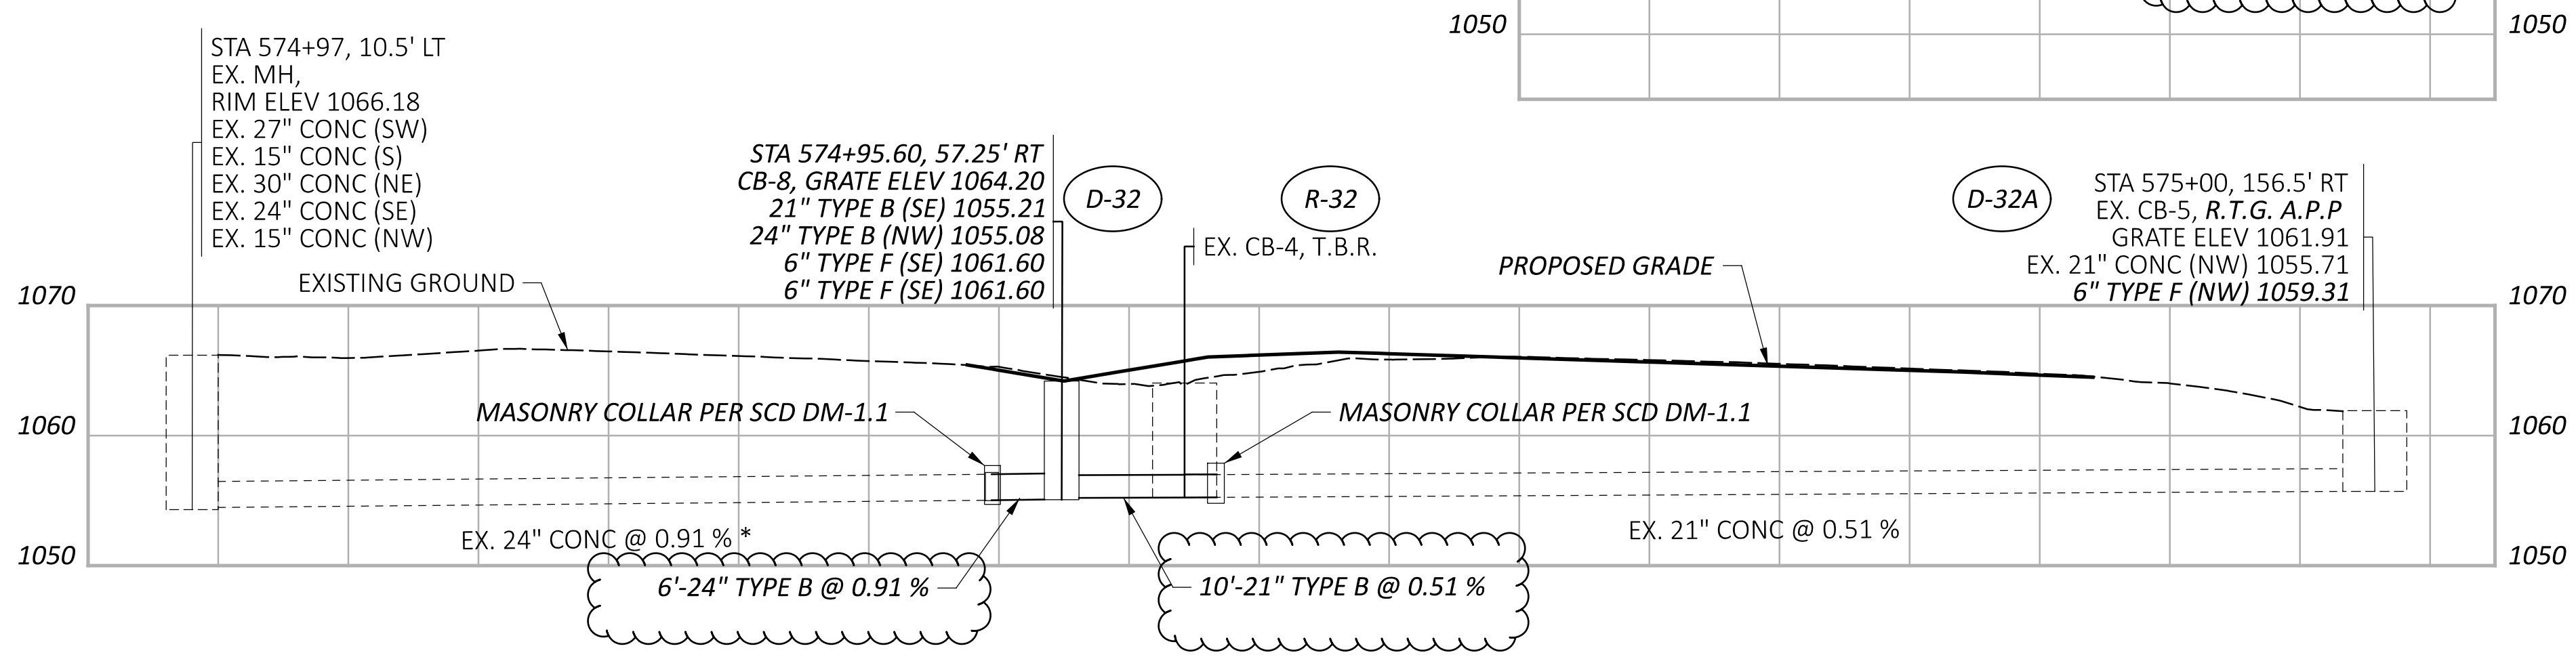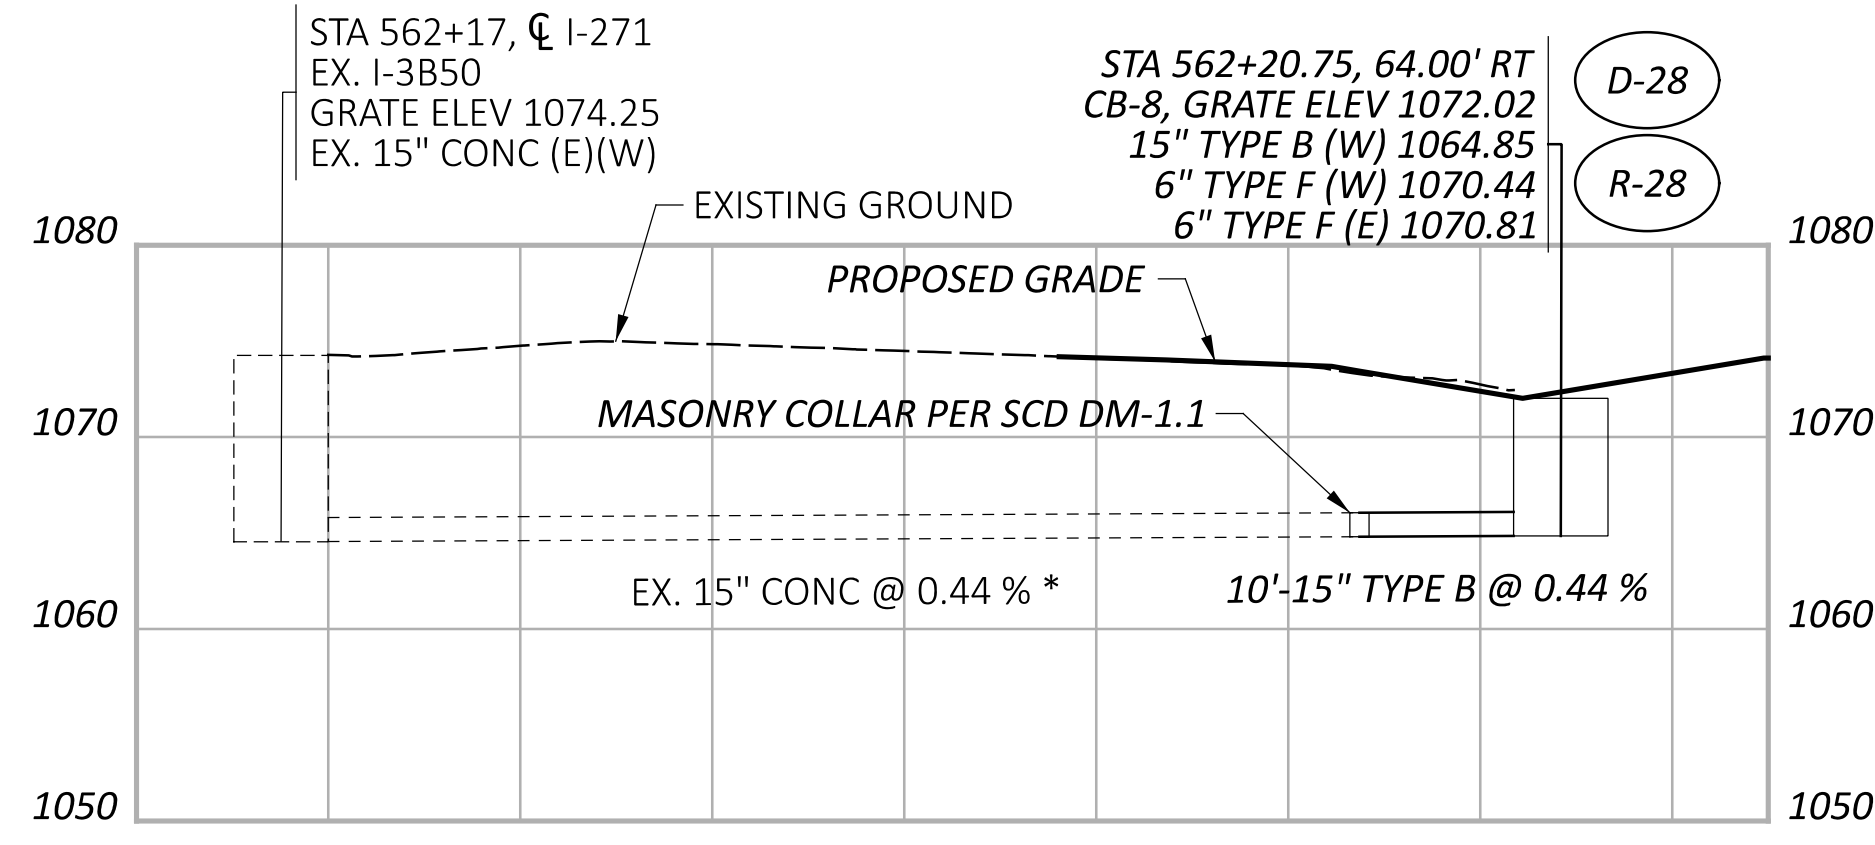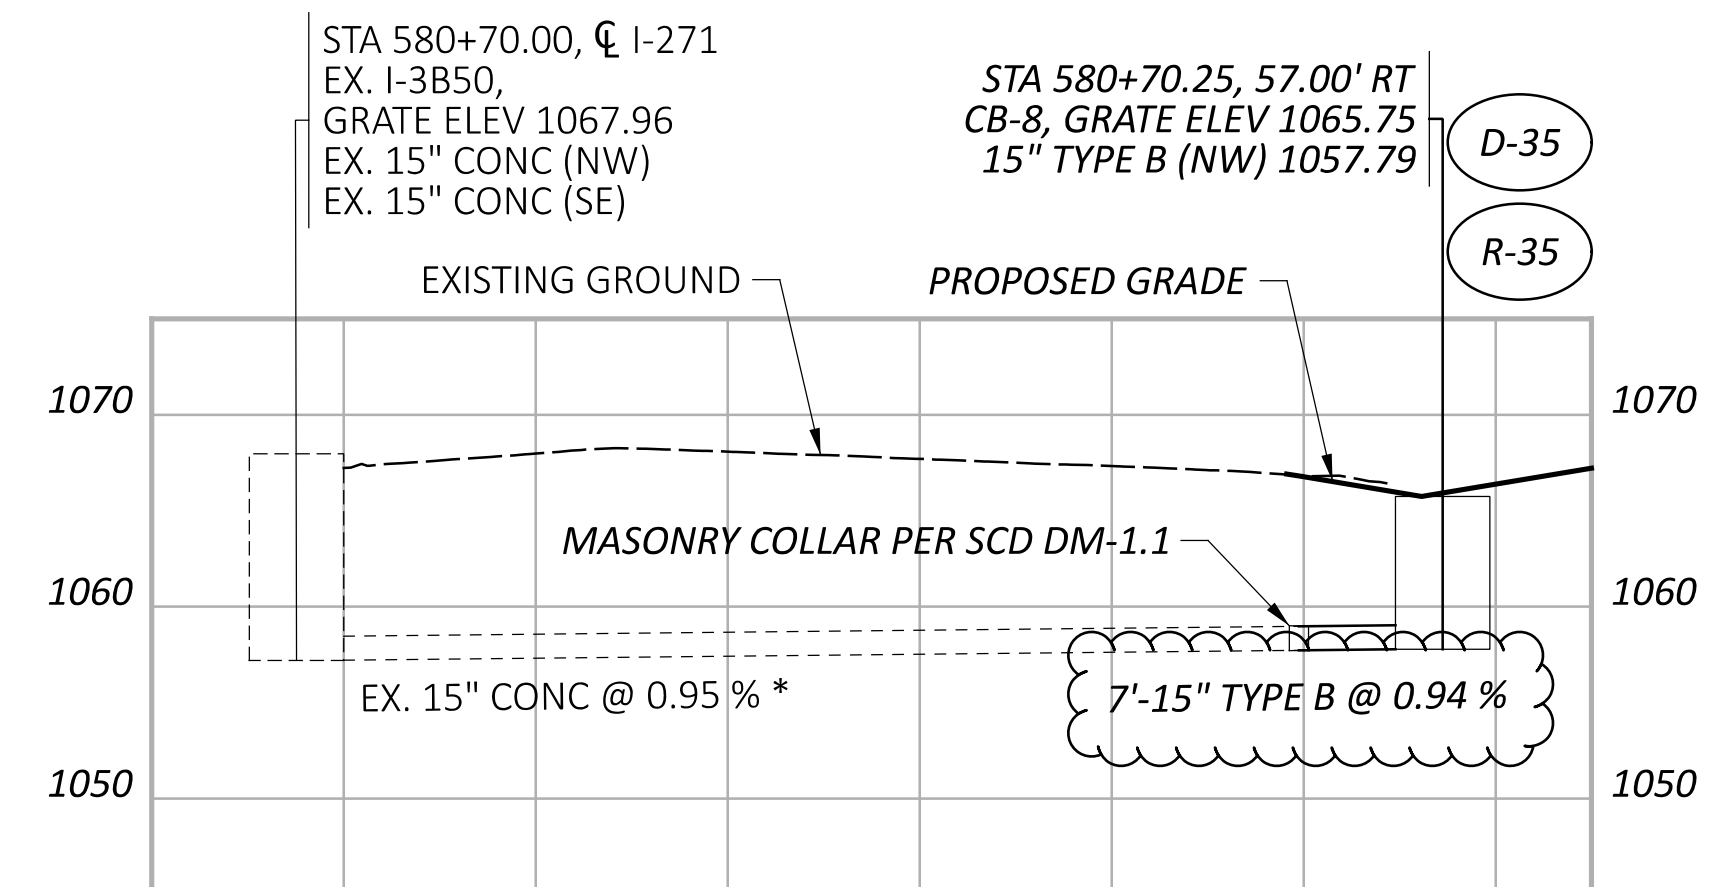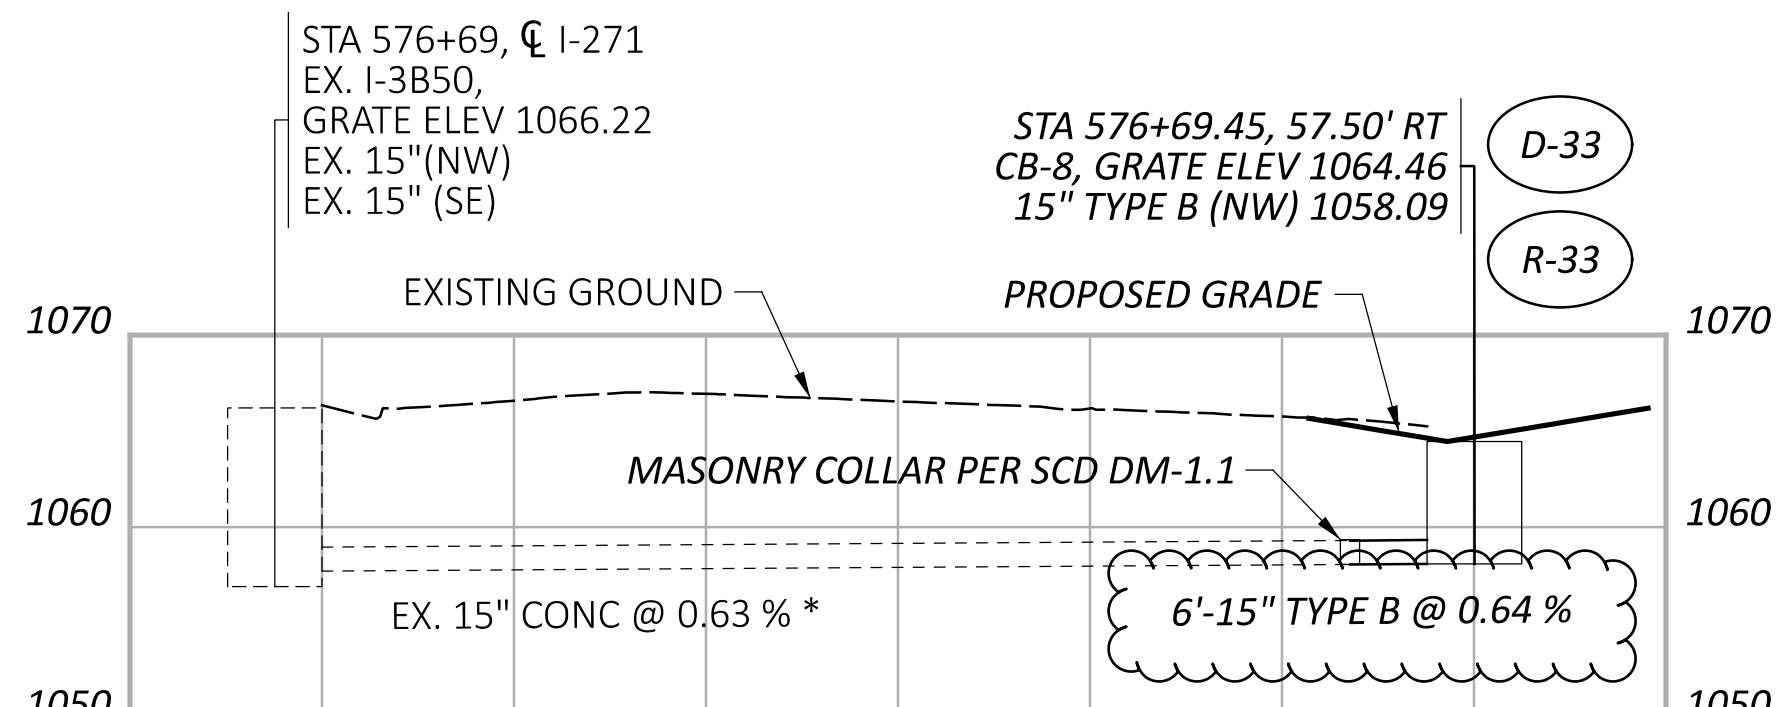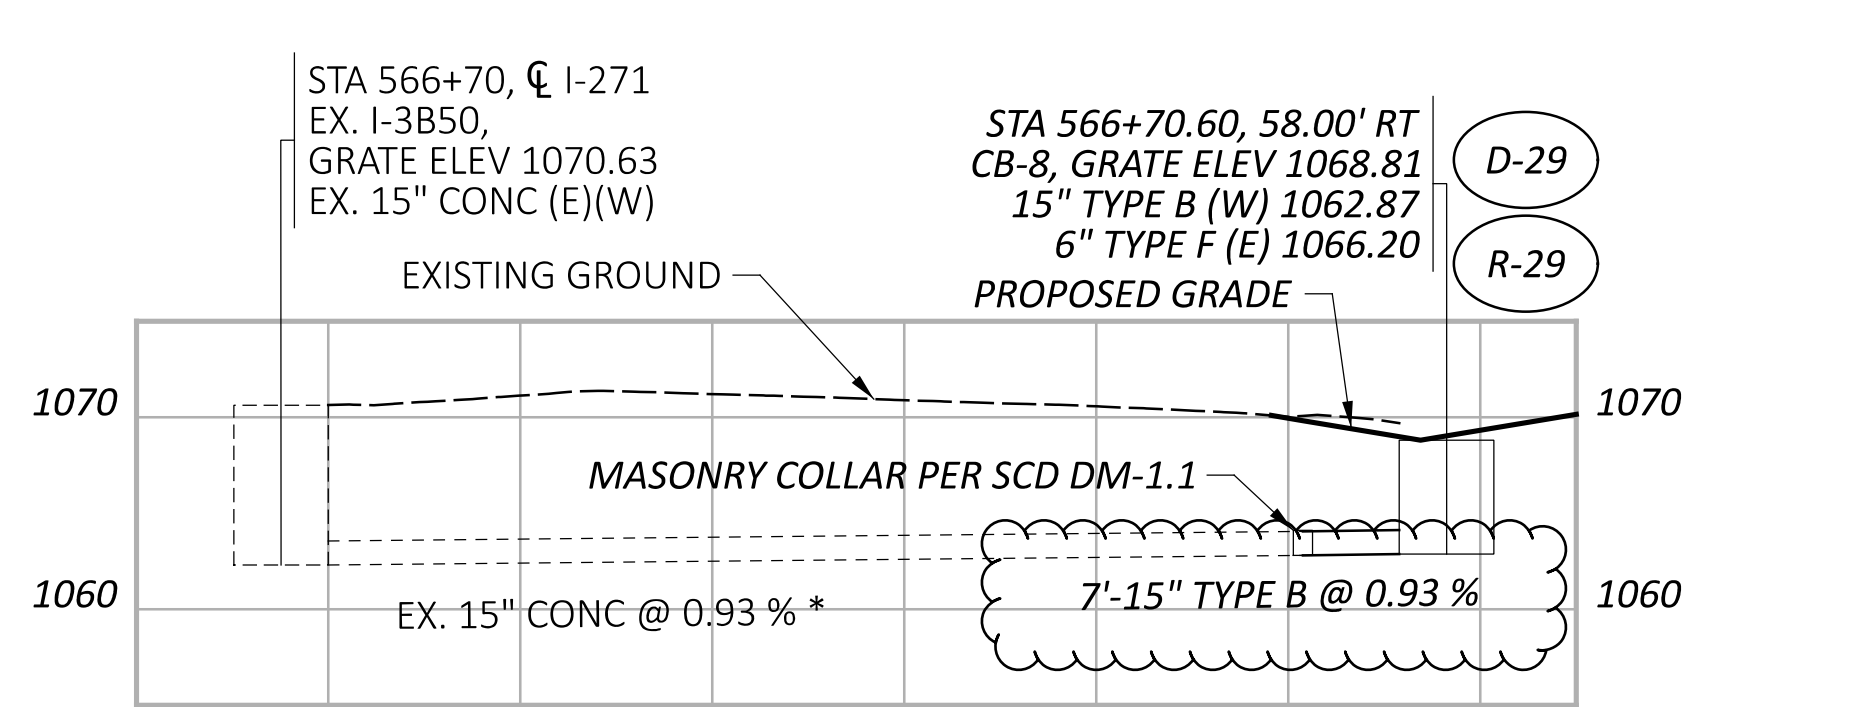

(*) - PIPE SLOPE SHOWN IS SET BASED ON RECORD DATA

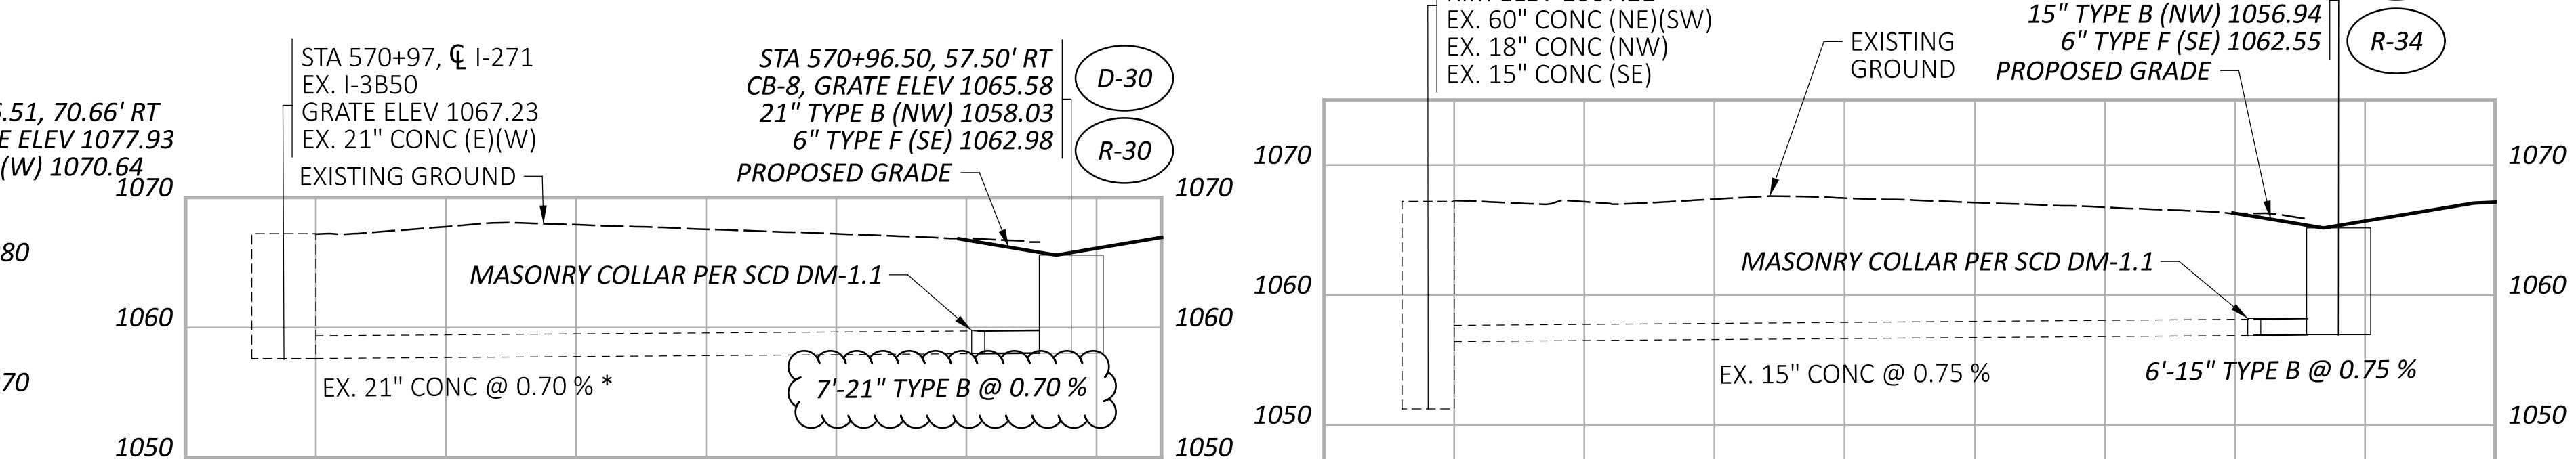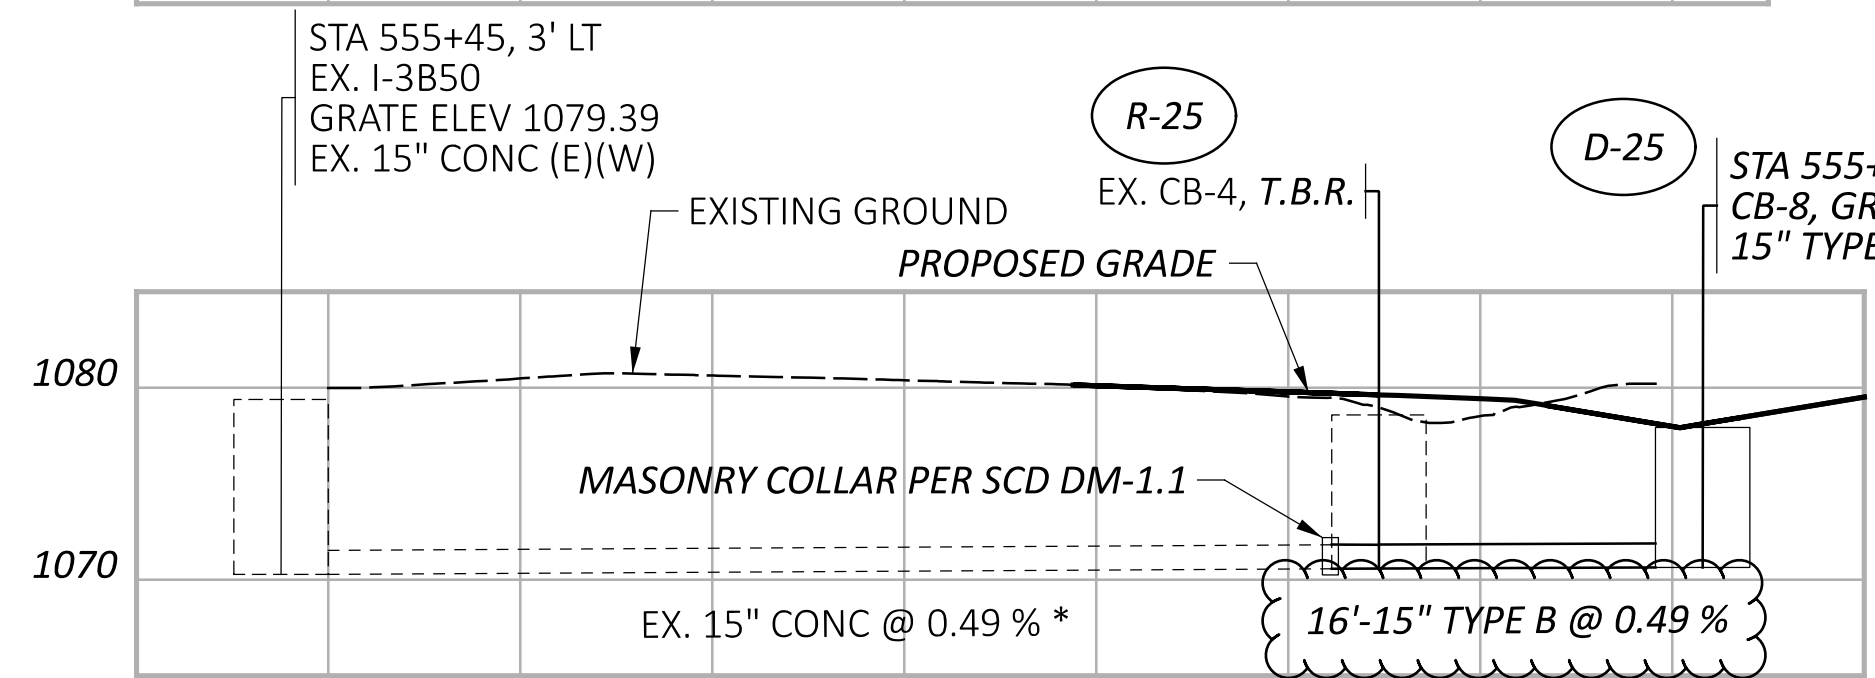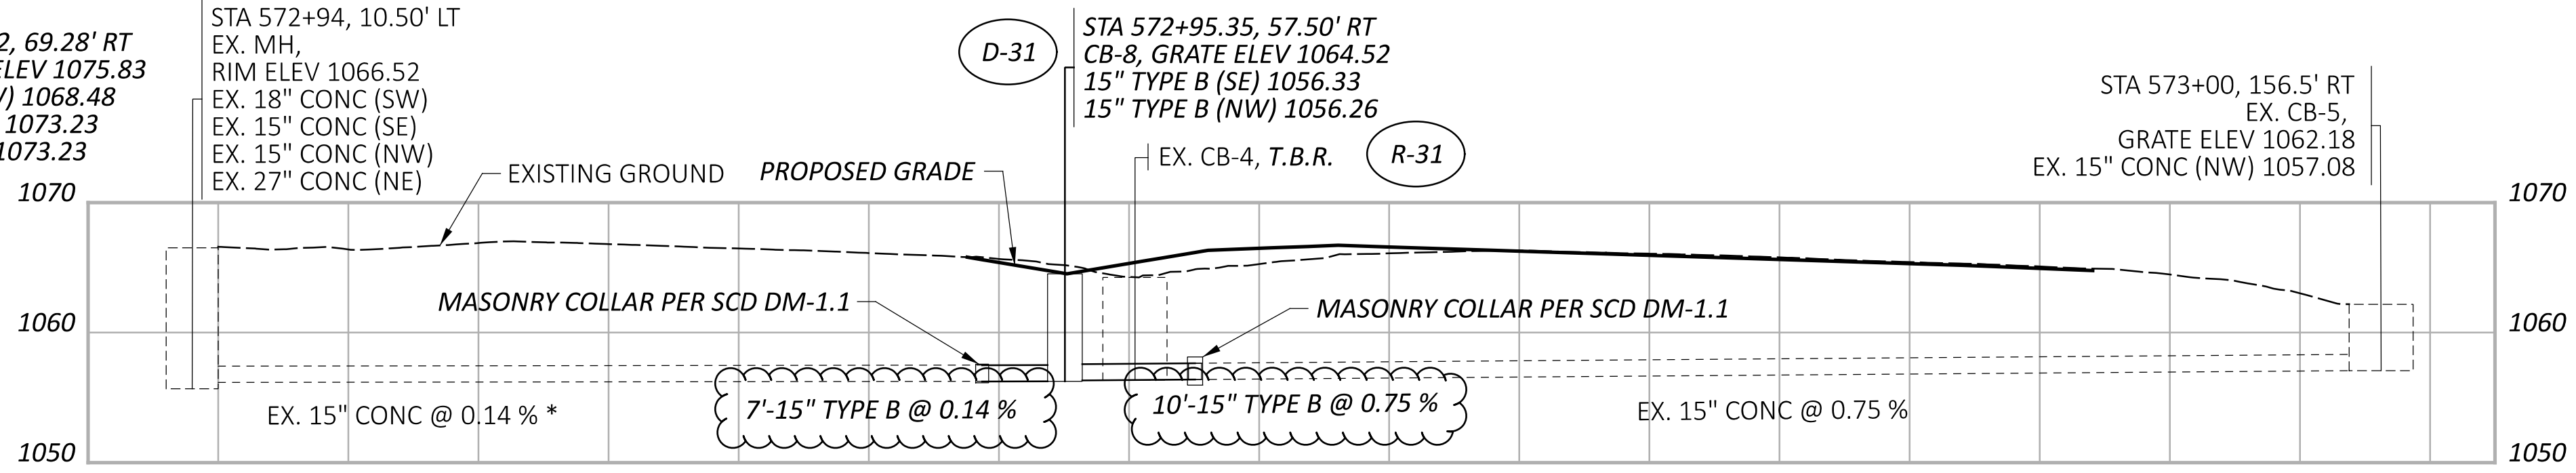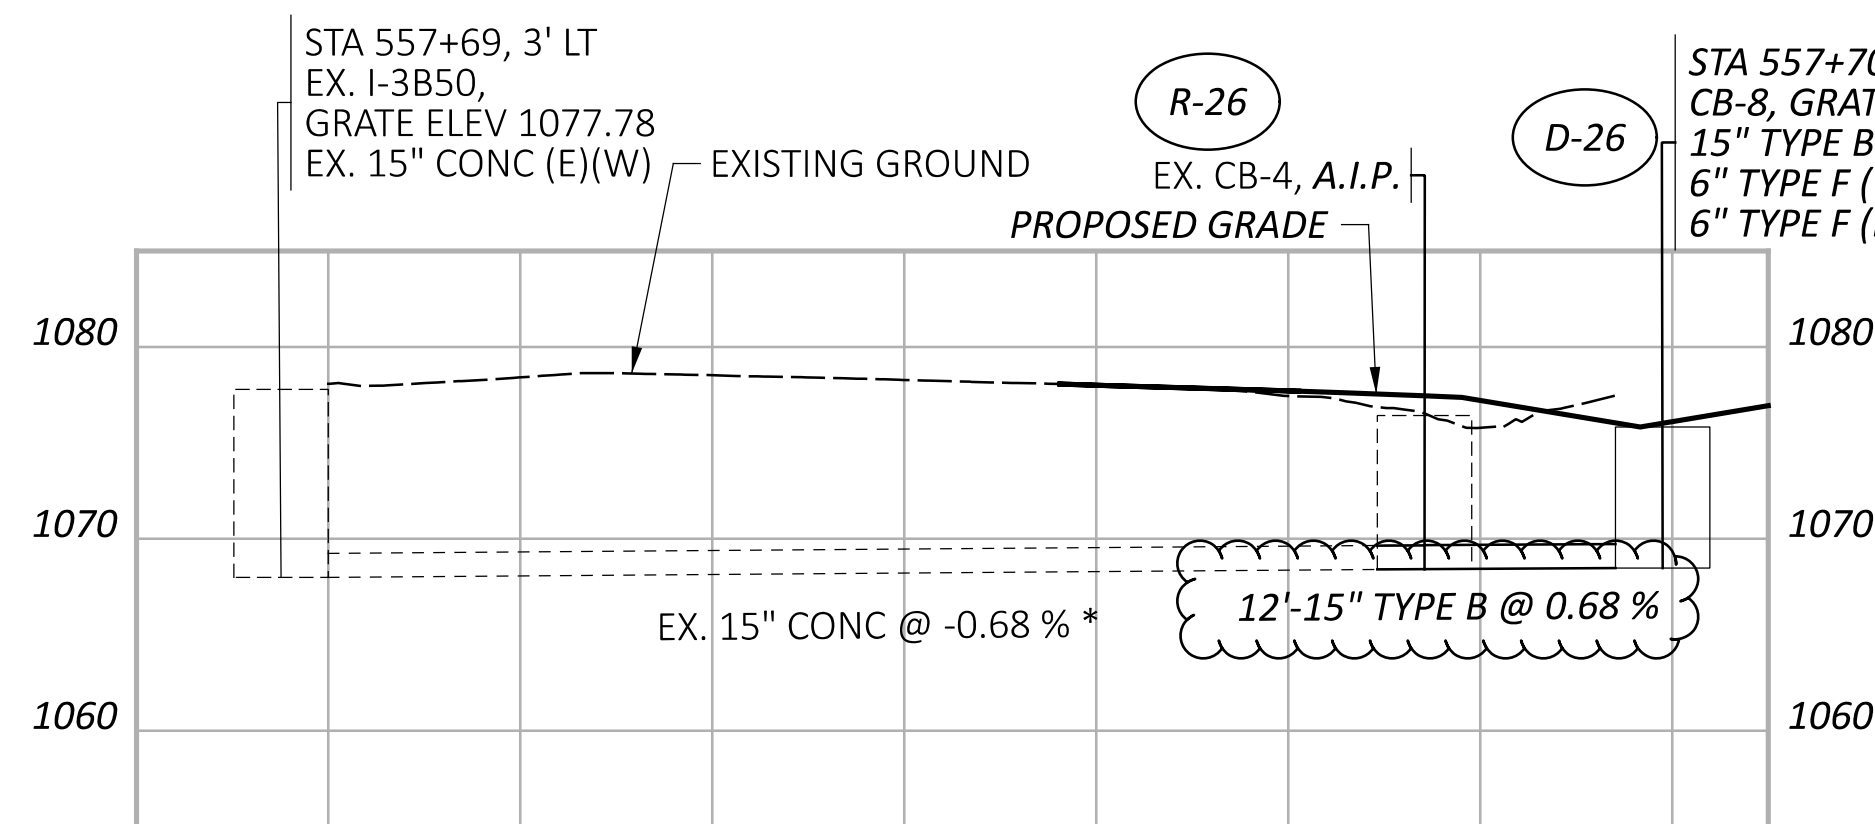

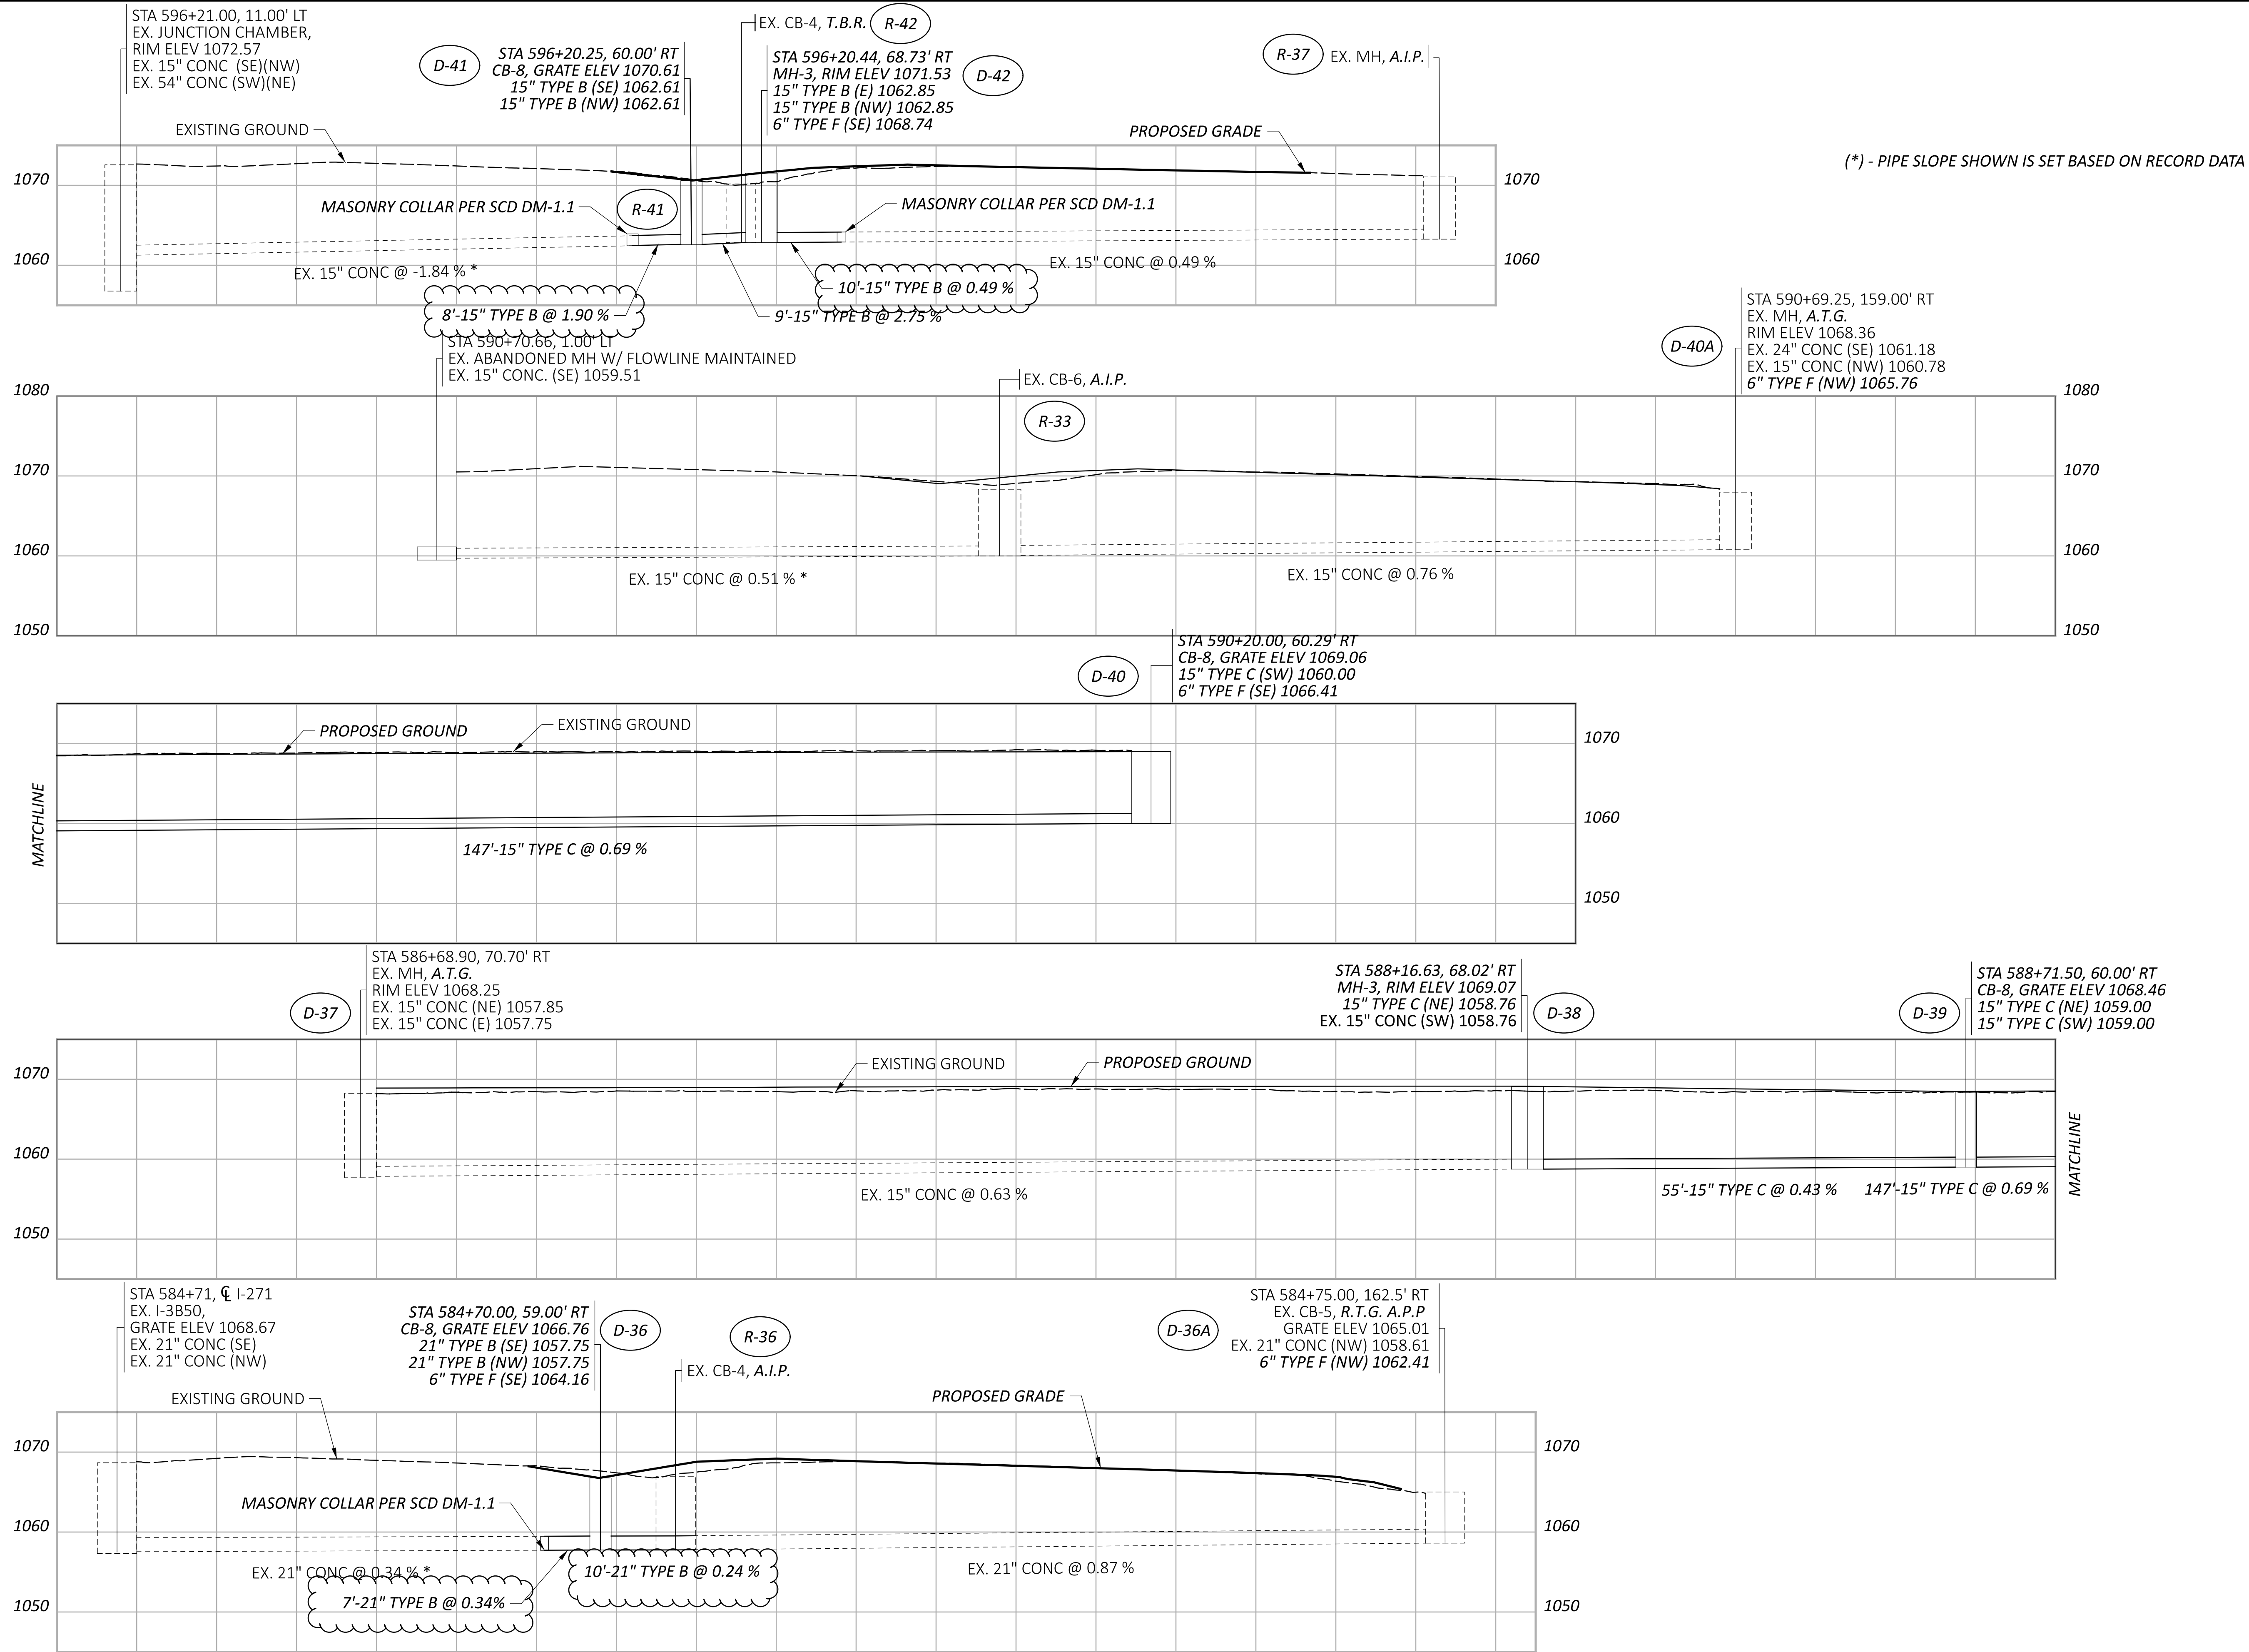

(*) - PIPE SLOPE SHOWN IS SET BASED ON RECORD DATA

STORM SEWER PROFILES
I.R. 271

DESIGN AGENCY	
HNTB	
DESIGNER	KKP
REVIEWER	
PROJECT ID	113156
SHEET	199
TOTAL	233

(*) - PIPE SLOPE SHOWN IS SET BASED ON RECORD DATA

