LOCATION MAP LATITUDE: 41 °24'28.48"N LONGITUDE: 81°38'13.19"W

INTERSTATE HIGHWAY ______

FEDERAL ROUTES ._____

COUNTY & TOWNSHIP ROADS ______

OTHER ROADS ______

CURRENT ADT (2026)______ 120,000

DESIGN HOURLY VOLUME (2046)______ 15,033

DIRECTIONAL DISTRIBUTION _____ 0.64

TRUCKS (24 HOUR B&C) ______ 0.05

DESIGN SPEED _____ 65

LEGAL SPEED ______ 60

NHS PROJECT ______ YES

DESIGN FUNCTIONAL CLASSIFICATION: _____ PRINCIPAL ARTERIAL

IR-480 LOCAL LANES

IR-480 EXPRESS LANES

PRINCIPAL ARTERIAL

INTERSTATE

52,300

54,600

6,500

0.64

YES

STATE OF OHIO DEPARTMENT OF TRANSPORTATION CUY-480-18.42 DECK SEALING

CUYAHOGA COUNTY

CITIES OF VALLEY VIEW, INDEPENDENCE AND GARFIELD HEIGHTS

INDEX OF SHEETS:

TITLE SHEET	1
GENERAL NOTES	2
MAINTENANCE OF TRAFFIC	3-13
GENERAL SUMMARY	14
TRAFFIC CONTROL	15-17
STRUCTURES OVER 20 FEET	
SFN 1812521	18-19
SFN 1812522	20-24
SFN 1812548	25-27

FEDERAL PROJECT NUMBER

E250868

RAILROAD INVOLVEMENT

CUYAHOGA VALLEY SCENIC RAILWAY

PROJECT DESCRIPTION

DECK SEALING OF THE IR-480 BRIDGES OVER THE CUYAHOGA RIVER VALLEY IN GARFIELD HEIGHTS, VALLEY VIEW AND INDEPENDENCE LOCATED IN CUYAHOGA COUNTY.

EARTH DISTURBED AREAS

PROJECT EARTH DISTURBED AREA: N/A
ESTIMATED CONTRACTOR EARTH DISTURBED AREA: N/A

NOTICE OF INTENT EARTH DISTURBED AREA: N/A (NOI NOT REQUIRED)

LIMITED ACCESS

THIS IMPROVEMENT IS ESPECIALLY DESIGNED FOR THROUGH TRAFFIC AND HAS BEEN DECLARED A LIMITED ACCESS HIGHWAY OR FREEWAY BY ACTION OF THE DIRECTOR IN ACCORDANCE WITH THE PROVISIONS OF SECTION 5511.02 OF THE OHIO REVISED CODE.

2023 SPECIFICATIONS

THE STANDARD SPECIFICATIONS OF THE STATE OF OHIO, DEPARTMENT OF TRANSPORTATION, INCLUDING SUPPLEMENTAL SPECIFICATIONS LISTED IN THE PLANS, CHANGES LISTED IN THE PROPOSAL, AND THE SUPPLEMENTAL SPECIFICATION 800 VERSION INDICATED ON THE PROPOSAL SHALL GOVERN THIS IMPROVEMENT.

John Picuri, P.E., P.S. District 12 Deputy Director

Pamela Boratyn
Director, Department of Transportation

DESIGN EXCEPTIONS

DESIGN DESIGNATION

DESIGN YEAR ADT (2046)_

NON

ADA DESIGN WAIVERS

NON

UNDERGROUND UTILITIES Contact Two Working Days Before You Dig OHIO811, 8-1-1, or 1-800-362-2764

(Non members must be called directly)

PLAN PREPARED BY:


ODOT DISTRICT 12

PLANNING AND ENGINEERING

5500 TRANSPORTATION BLVD

GARFIELD HEIGHTS, OHIO 44125

MT-95.30 7/18/25 MT-95.45 7/21/23 MT-98.11 1/17/20	
MT-98.11 1/17/20	
W11-38.11 1/17/20	
MT-98.20 4/19/19 FN	NGINEER'S SEAL
MT-98.22 1/17/20	
MT-98.29 1/17/20	BRIDGE
MT-99.20 4/19/19 Significant S	111111111111111111111111111111111111111
	TEOFO
MT-102.20 4/19/19	5
MT-104.10 1/19/24	Δ =
MT-105.10 1/17/20	TOMAN TO
	E-6/624
	SSONAL ENGIN
	77771111111

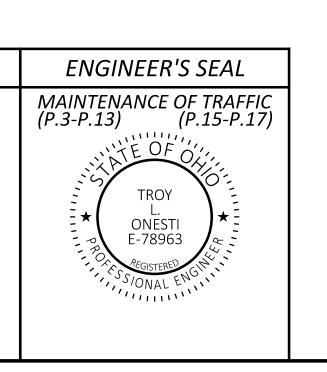

DESIGN AGENCY

SHEET



TSR

REVIEWER

PAT 08/01/25
PROJECT ID

120625