


LOCATION MAP

LATITUDE: 41°29'12" LONGITUDE: 81°41'28"

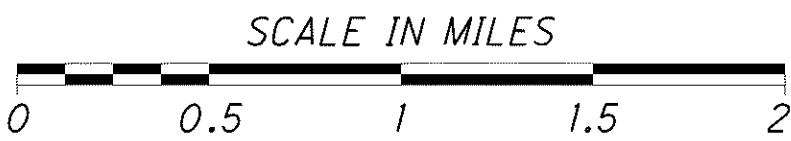

PORTION TO BE IMPROVED	
INTERSTATE HIGHWAY	
STATE & FEDERAL ROUTES	
COUNTY & TOWNSHIP ROADS	
OTHER ROADS	

DESIGN DESIGNATION

SEE DWG. NO. DD-002 INCLUDED IN SURVEY CONTROL

UNDERGROUND UTILITIES

CONTACT BOTH SERVICES
CALL TWO WORKING DAYS
BEFORE YOU DIG

CALL
1-800-362-2764
(TOLL FREE)

OHIO UTILITIES PROTECTION SERVICE
NON-MEMBERS
MUST BE CALLED DIRECTLY

OIL & GAS PRODUCERS PROTECTIVE
SERVICE CALL: 1-800-925-0988

WALSH

WALSH CONSTRUCTION
929 WEST ADAMS STREET
CHICAGO, IL 60607

HNTB

1100 Superior Ave. Ste 1701
Cleveland, OH 44114

STATE OF OHIO
DEPARTMENT OF TRANSPORTATION
CUY-90-14.90
CITY OF CLEVELAND
CUYAHOGA COUNTY

BRIDGE NUMBERS:

**CUY-77-1597L &
CUY-90-1651L**

STRUCTURE FILE NUMBERS:

1807919 & 1807900

STRUCTURE LOCATION NUMBERS:

10 & 11

NOTE: SEAL AND SIGNATURE ARE AN IMAGE
TAKEN FROM THE ORIGINAL AFC DRAWINGS
ISSUED ON 03/14/2011.

ENGINEERS SEAL:	ENGINEERS SEAL:
SIGNED:	SIGNED:
DATE:	DATE:

APPROVED _____
DATE _____ DISTRICT DEPUTY DIRECTOR

APPROVED _____
DATE _____ DIRECTOR, DEPARTMENT OF
TRANSPORTATION

PROJECT DESCRIPTION

THIS PACKAGE CONSISTS OF THE STRUCTURAL ELEMENTS
NEEDED FOR THE DECK REPLACEMENT FOR STRUCTURES
I-90 WESTBOUND AND I-77 SOUTHBOUND RAMP OVER
E. 14TH STREET.

LIMITED ACCESS

THIS IMPROVEMENT IS ESPECIALLY DESIGNED FOR
THROUGH TRAFFIC AND HAS BEEN DECLARED A LIMITED
ACCESS HIGHWAY OR FREEWAY BY ACTION OF THE
DIRECTOR IN ACCORDANCE WITH THE PROVISIONS OF
SECTION 5511.02 OF THE OHIO REVISED CODE.

2010 SPECIFICATIONS

THE STANDARD SPECIFICATIONS OF THE STATE OF
OHIO, DEPARTMENT OF TRANSPORTATION, INCLUDING
CHANGES AND SUPPLEMENTAL SPECIFICATIONS AS LISTED
IN THE WALSH CONTRACT SHALL GOVERN THIS IMPROVEMENT.

DATE	08-09-13	REVISIONS	NO.	RECORD DRAWINGS	DESIGN AGENCY	CONSTRUCTION PROJECT NO.	DWG. NO.
					WALSH HNTB	10-3000	CUY-90-14.90




SUMMARY OF QUANTITIES			
ITEM	DESCRIPTION	TOTAL QUANTITY	UNIT COST
509E10000	EPOXY COATED REINFORCING STEEL	239,161	POUND
898E10200	QC/QA CONCRETE, CLASS QSC2, SUPERSTRUCTURE (DECK)	784	CU YD
898E11000	QC/QA CONCRETE CLASS QSC2, SUPERSTRUCTURE (PARAPET)	173	CU YD
898E20000	QC/QA CONCRETE, CLASS QSC1, SUBSTRUCTURE	11	CU YD
898E10702	QC/QA CONCRETE, CLASS QSC2, SUPERSTRUCTURE (APPROACH SLAB - 25'-0")	481	SQ YD
513E10200	STRUCTURAL STEEL MEMBERS, LEVEL UF	1,675	POUND
514E00100	SURFACE PREPARATION OF EXISTING STRUCTURAL STEEL	LUMP	LUMP
514E00200	FIELD PAINTING OF EXISTING STRUCTURAL STEEL, PRIME COAT	LUMP	LUMP
514E00060	FIELD PAINTING OF STRUCTURAL STEEL, INTERMEDIATE COAT	LUMP	LUMP
514E00300	FIELD PAINTING OF STRUCTURAL STEEL, FINISH COAT	LUMP	LUMP
519E11100	PATCHING CONCRETE STRUCTURES	225	SQ FT
516E11210	STRUCTURAL EXPANSION JOINT INCLUDING ELASTOMERIC STRIP SEAL	176	FT


INDEX OF SHEETS

REV.	DATE	SHEET	TITLE
3	08/09/13	1	TITLE SHEET
5	08/09/13	2	SHEET INDEX
2	08/09/13	2A	STRUCTURE GENERAL NOTES - 1
3	08/09/13	2B	STRUCTURE GENERAL NOTES - 2
3	08/09/13	2C	STRUCTURE GENERAL NOTES - 3
1	03/04/11	3	SITE PLAN - 1
2	04/04/11	4	SITE PLAN - 2
1	03/04/11	5	GENERAL PLAN
1	03/04/11	6	PHASE CONSTRUCTION DETAILS - 1
2	08/09/13	7	PHASE CONSTRUCTION DETAILS - 2
1	03/14/11	8	PHASE CONSTRUCTION DETAILS - 3
2	01/29/13	9	PHASE CONSTRUCTION DETAILS - 4
2	01/29/13	10	PHASE CONSTRUCTION DETAILS - 5 (REAR ABUTMENT)
1	01/29/13	10A	PHASE CONSTRUCTION DETAILS - 5 (FORWARD ABUTMENT)
1	03/14/11	11	PHASE CONSTRUCTION DETAILS - 6
1	03/14/11	12	REMOVAL DETAILS - 1
1	03/14/11	13	REMOVAL DETAILS - 2
1	03/14/11	14	REMOVAL DETAILS - 3
1	03/14/11	15	REMOVAL DETAILS - 4
1	03/14/11	16	REMOVAL DETAILS - 5
1	03/14/11	17	REMOVAL DETAILS - 6
1	03/14/11	18	REAR ABUTMENT DETAILS
1	03/14/11	19	FORWARD ABUTMENT AND PIER DETAILS
1	01/29/13	19A	RECORD OF PIER 1 PATCHING
1	01/29/13	19B	RECORD OF PIER 3 PATCHING
2	01/29/13	20	FRAMING PLAN
3	08/09/13	21	GIRDER ELEVATION - 1
3	08/09/13	22	GIRDER ELEVATION - 2
1	03/14/11	23	SUPERSTRUCTURE DETAILS
2	01/29/13	24	DRAINAGE DETAILS
1	03/14/11	25	SLAB PLAN
3	08/09/13	26	PARAPET PLAN
3	08/09/13	27	SLAB AND PARAPET DETAILS
4	08/09/13	28	TRANSVERSE SECTION - 1
2	01/29/13	29	TRANSVERSE SECTION - 2
1	03/14/11	30	SCREED ELEVATIONS - 1
1	03/14/11	31	SCREED ELEVATIONS - 2
1	03/14/11	32	SCREED ELEVATIONS - 3
1	03/14/11	33	SCREED ELEVATIONS - 4
1	03/14/11	34	SCREED ELEVATIONS - 5
1	03/14/11	35	STRIP SEAL EXPANSION JOINT DETAILS - 1
1	03/14/11	36	STRIP SEAL EXPANSION JOINT DETAILS - 2
3	08/09/13	37	APPROACH SLAB DETAILS - 1
3	08/09/13	38	APPROACH SLAB DETAILS - 2

REVISIONS

- 04/04/11 - REVISED PROFILE GRADE FOR RAMP E10.
- REVISED REBAR IN BRIDGE PARAPET.
- REVISED CONCRETE SEALING COLOR.
- REVISED DECK CONCRETE SEALING LIMITS.
- 04/26/11 - REVISED FASCIA PARAPET CROSS SECTION.
- 01/29/13 - RECORD DRAWINGS - SHOW PATCHING
RECORD DRAWINGS - RFI 00010,RFI 00028, RFI 00040, RFI 00065,
RFI 00128, RFI 00306, NDC 007
- 08/09/13 - RECORD DRAWINGS - RFI 00013, RFI 00016, NCR 004, CHANGE ORDER #15
RECORD DRAWINGS - ADDED RECORD CHANGE TABLE

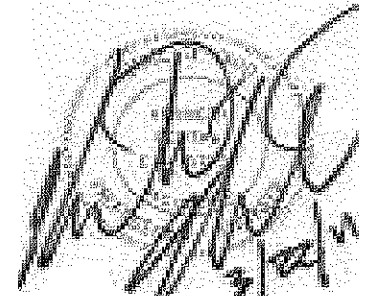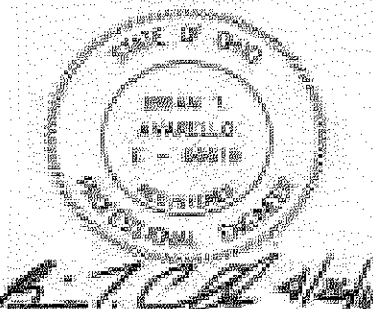DRAWING ISSUE	IMPACT TO DESIGN	ENGINEER OF RECORD	DATE OF CHANGE OR IMAGE OF SEAL/DATE FROM ORIGINAL DOCUMENT	SHEET NO.
APPROVED FOR CONSTRUCTION	NA	Brian T. Avarello #66619	Image of Seal from RFC Plans on Title Sheet	1/38
NDC 0003 - BL 10 Vertical Curve	Yes	Kenneth Fertal # 67122		4, 26, 28, 37, 38/38
NDC 0004 - BL 10-11 parapets	No	NA	NA	4, 26, 28, 37, 38/38
NDC 0005 - BL 9 10 11 12 Concrete Seal Limits	No	NA	NA	4, 26, 28, 37, 38/38
NDC 0006 - BL 9 10 11 12 Deck Slab Chamfer	Yes	Brian T. Avarello #66619		27/38
As-built NDC 0007 - BL 9 10 11 12 Crossframe Repair Details	No	NA	NA	20/38
As-built RFI 00010 - BL 10 and 11 Shear Connector	No	NA	NA	21, 22/38
As-built RFI 00013 - All Bridges Parapet Bars	No	NA	NA	26, 27, 28, 37, 38/38
As-built RFI 00016 - BL 10 heat straightening per NCR 004	No	NA	NA	7/38
As-built RFI 00028 - BL 10 11 Bottom Mat Deck Rebar	No	NA	NA	28, 29/38
As-built RFI 00040 - BL 7 8 9 10 11 12 Welding SIP Formwork	Yes	Brian T. Avarello #66619		2B/38
As-built RFI 00065 - BL 9 10 11 12 Anchored PCB	No	NA	NA	9, 10, 10A/38
As-built RFI 00128 - Pier Downspout Bracket	No	NA	NA	24/38
As-built RFI 00306 - Epoxy-Urethane Conc Sealant BL-7-12	No	NA	NA	2B/38
Changed sheet numbers	No	NA	NA	2A, 2B, 2C/38
Change Order #15	No	NA	NA	21, 22/38

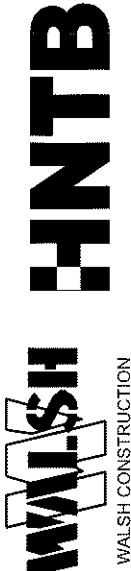DESIGNED RSB		DRAWN RSB		REVIEWED RSB	DATE 03-11-11	BRIDGES 10 & 11		DESIGN AGENCY  Walsh Construction		NO.		REVISIONS		DATE			
CHECKED JTW	CHECKED JTW				STRUCTURE FILE NUMBER 1807919/1807900		BRIDGES 10 & 11		Walsh Construction		RECORD DRAWINGS		08-09-13				
2 / 38						SHEET INDEX											
CUY-90-14.90						BRIDGE NO. CUY-77-1597 L AND CUY-90-1651 L											
PID No. 77332 / 85531						I-90WB AND I-77SB RAMP OVER E 14TH STREET											

090_1651LGN002.dgn 1/8/2016 11:30:11 AM rstriegel

STRUCTURE GENERAL NOTES

PILE DESIGN LOADS (ULTIMATE BEARING VALUE):

CUY-90-1651R

THE ULTIMATE BEARING VALUE IS 75 TONS PER PILE FOR THE 12" C.I.P. REINFORCED CONCRETE REAR AND FORWARD ABUTMENT PILES. THE ULTIMATE BEARING VALUE IS 109 TONS PER PILE FOR THE 14" C.I.P. REINFORCED CONCRETE PIER PILES.

ABUTMENT AND PIER PILES:

- 5 PILES 45 FEET LONG, ORDER LENGTH (REAR)
- 4 PILES 75 FEET LONG, ORDER LENGTH (PIER 1)
- 4 PILES 90 FEET LONG, ORDER LENGTH (PIER 2)
- 4 PILES 90 FEET LONG, ORDER LENGTH (PIER 3)
- 5 PILES 55 FEET LONG, ORDER LENGTH (FORWARD)
- 2 DYNAMIC LOAD TESTING ITEMS

BATTERED PILES:

THE BLOW COUNT FOR BATTERED PILES SHALL BE THE BLOW COUNT DETERMINED FOR VERTICAL PILES OF THE SAME ULTIMATE BEARING VALUE DIVIDED AN EFFICIENCY FACTOR (D). COMPUTE THE EFFICIENCY FACTOR (D) AS FOLLOWS:

D = $\frac{1-UG}{\sqrt{1+G^2}}$

U = COEFFICIENT OF FRICTION, WHICH IS ESTIMATED AT 0.05 FOR DOUBLE-ACTING AIR OPERATED OR DIESEL HAMMERS; 0.1 FOR SINGLE-ACTING AIR OPERATED OR DIESEL HAMMERS; AND 0.2 FOR DROP HAMMERS.

G = RATE OF BATTER (1/3, 1/4, ETC.)

EXISTING STRUCTURE VERIFICATION:

DETAILS AND DIMENSIONS SHOWN ON THESE PLANS PERTAINING TO THE EXISTING STRUCTURES HAVE BEEN OBTAINED FROM PLANS OF THE EXISTING STRUCTURES AND FROM FIELD OBSERVATIONS AND MEASUREMENTS. CONSEQUENTLY, THEY ARE INDICATIVE OF THE EXISTING STRUCTURES AND THE PROPOSED WORK BUT THEY SHALL BE CONSIDERED TENTATIVE AND APPROXIMATE. THE CONTRACTOR IS REFERRED TO CMS SECTIONS 102.05, 105.02 AND 513.04.

ITEM 512 - SEALING OF CONCRETE SURFACES (EPOXY-URETHANE), AS PER PLAN:

AFTER INSTALLATION OF SUPERSTRUCTURE UNITS AND PATCHING OF CONCRETE STRUCTURES PER ITEM 519, SEAL EXPOSED CONCRETE SURFACES OF ALL SUBSTRUCTURES UNITS. THE LIMITS OF SEALING SHALL INCLUDE:

- A) THE FRONT FACE OF ABUTMENT BACKWALLS, FROM TOP TO BRIDGE SEAT, THE BRIDGE SEAT AND THE BREASTWALL DOWN TO THE GROUND LINE.
- B) THE EXPOSED SURFACES OF ALL WINGWALLS AND RETAINING WALLS.
- C) THE EXPOSED SURFACE OF PIERS EXCEPT FOR THE TOP OF PIER CAPS.

CONCRETE SEALER COLOR FOR PARAPETS AND ALL SUBSTRUCTURE ELEMENTS TO BE SW 7022 ALPACA ON BRIDGES 7,8,9,10,11, AND 12.

DOWELS:

UNLESS NOTED OTHERWISE IN THE PLANS, ALL DOWELS SHALL BE SET WITH A NONSHRINK, NONMETALLIC ENCAPSULATED ADHESIVE ANCHORAGE SYSTEM AS MANUFACTURED BY HILTI, INC OR AN APPROVED EQUAL. AT A MINIMUM, DOWEL HOLES DEPTHS AND SIZES SHALL BE AS PER MANUFACTURER'S RECOMMENDATIONS. ANCHORAGE SYSTEM SHALL MEET REQUIREMENTS SPECIFIED IN CMS SECTION 705.20.

APPROACH SLABS

FURNISH APPROACH SLABS CONFORMING TO CMS 526 EXCEPT CONCRETE SHALL BE IN ACCORDANCE WITH SUPPLEMENTAL SPECIFICATION ST-01 STRUCTURES PROJECT PROVISIONS, QC/OA CONCRETE, CLASS QSC2.

STAY-IN-PLACE FORMS

AT THE CONTRACTOR'S OPTION GALVANIZED STEEL STAY-IN-PLACE (SIP) FORMS MAY BE USED AS FALSEWORK FOR THE CONSTRUCTION OF THE CONCRETE DECK.

THE FOLLOWING IS A LISTING OF THE REQUIREMENTS FOR USE OF SIP FORMS:

DESIGN, FURNISH AND INSTALL PERMANENT GALVANIZED STEEL STAY-IN-PLACE (SIP) FABRICATED METAL FORMS FOR CONCRETE DECK SLABS OF ALL INTERIOR BAYS OF BEAMS ACCORDING TO CMS SECTIONS 508.01 AND 508.02 EXCEPT AS MODIFIED BY THESE NOTES. SIP FORMS SHALL NOT BE USED AT OVERHANGS AND WITHIN FIVE FEET OF ALL EXPANSION JOINTS AND SCUPPERS. THE CONTRACTOR MAY ELECT TO FURNISH, INSTALL AND REMOVE, REMOVABLE FORMS TO ACCOMMODATE SKEWED ENDS OF A DECK.

DESIGN SIP FORMS TO SUPPORT THE DEAD WEIGHT OF SIP FORMS, REINFORCEMENT, WET CONCRETE PLUS 50 PSF FOR CONSTRUCTION LIVE LOADS AND MEET THE DEFLECTION SPECIFICATIONS OF 508.01. ALL FLUTES SHALL BE FILLED WITH THE SAME CONCRETE MIX BEING POURED WITH THE DECK.

FABRICATE THE SIP FORMING SYSTEM ACCORDING TO ITEM 513 EXCEPT THAT FABRICATOR PRE-QUALIFICATION IS NOT REQUIRED. SUBMIT MILL TEST REPORTS FOR THE SIP FORMS ACCORDING TO 513.08. SUBMIT SHOP DRAWINGS AND DESIGN CALCULATIONS FOR THE SIP FORMS ACCORDING TO 513.06. FURNISH FORM MATERIALS CONFORMING TO ASTM A653 WITH G235 COATING WEIGHT WITH A MINIMUM THICKNESS OF 20 GAGE. HOT DIP GALVANIZE ALL HARDWARE, HANGERS, AND INCIDENTALS.

DO NOT WELD SIP FORMS OR THEIR SUPPORTS TO THE STEEL BRIDGE MEMBERS WITHIN THE LIMITS MARKED AS TENSION ZONES SHOWN IN THE PLANS.

ACHIEVE A ONE-INCH MINIMUM BEARING LENGTH ON ALL SUPPORTS OF A FLUTE.

PLACE CONCRETE ACCORDING TO THE CONTRACT SPECIFICATIONS:

- FILL THE ENTIRE FORM WITH DECK CONCRETE.
- UTILIZE PROPER CONSTRUCTION TECHNIQUES TO PREVENT VOIDS AND HONEYCOMBS ESPECIALLY AT CONSTRUCTION JOINTS, EXPANSION JOINTS, FLUTES, AND ENDS OF SIP FORM SHEETS.

INSTALL SIP FORMS ACCORDING TO THESE NOTES:

1. PROVIDE THE ENGINEER WITH A WRITTEN INSTALLATION AND INSPECTION PROCEDURE. INCLUDE METHODS FOR ADJUSTING SUPPORT HEIGHTS, SIP ATTACHMENT SEQUENCE, PLACEMENT METHODS USED TO MINIMIZE COATING DAMAGE, COATING REPAIR METHODS, ACCEPTABLE TOLERANCES AND INSPECTION CRITERIA
2. FIELD CUT SIP FORMS USING MECHANICAL CUTTING METHODS. THERMAL CUTTING IS NOT PERMITTED.
3. PLACE FORM SUPPORTS IN DIRECT CONTACT WITH THE TOP OF THE BRIDGE'S STRUCTURAL MEMBERS.
4. SET THE HEIGHT OF THE FORM SUPPORTS SO SIP FORMS DO NOT REST DIRECTLY ON THE BRIDGE'S STRUCTURAL MEMBERS AND TO DEVELOP THE SPECIFIED DECK THICKNESS.
5. PLACE SIP FORMS DIRECTLY ON THE SUPPORTS
6. CONNECT SIP FORMS TO SUPPORTS BEFORE USING THE SIP AS A WORKING SURFACE AND BEFORE THE END OF EACH WORK SHIFT.
7. PROVIDE SAFETY STOPS TO ELIMINATE HAZARDS FROM SUDDEN UPLIFT AND LATERAL MOVEMENT.

IN ADDITION TO THE REQUIREMENTS OF 105.111 FURNISH, ERECT, AND MOVE APPROPRIATE EQUIPMENT OF SCAFFOLDING TO ALLOW THE FOLLOWING INSPECTION ACCESS. ACCESS AND THE SPECIFIED INSPECTIONS ARE NOT ELIGIBLE FOR EXTRA PAYMENT. PROVIDE COMPLETED INSPECTION CHECK LISTS TO DOCUMENT THE FOLLOWING INSPECTIONS:

1. PRIOR TO PLACING CONCRETE VISUALLY INSPECT SIP FORMS FOR DAMAGE.
2. TWO DAYS AFTER CONCRETE PLACEMENT, TEST DECK FOR SOUNDNESS OR BONDING OF THE FORMS BY SOUNDING ON THE FORMS WITH A HAMMER. SOUND ALL SURFACES OF AT LEAST 10% OF THE PANELS WITH THE ENGINEER.
3. REMOVE SIP FORMS IN AREAS WITH DOUBTFUL SOUNDNESS OR BONDING FOR THE ENGINEER'S VISUAL INSPECTION. DO NOT REPLACE SIP FORMS REMOVED FOR INSPECTION. REMOVE FORMS SO THAT ADJACENT FORMS OR WORK IS NOT DEBONDED OR OTHERWISE DAMAGED.
4. IF DEFECTS ARE DISCOVERED DURING THE SPECIFIED INSPECTIONS, TEST THE COMPLETE DECK AND PROPOSE REPAIR OR REMOVAL METHODS ACCEPTABLE TO THE DEPARTMENT. THE DEPARTMENT MAY REQUIRE ADVANCED NON-DESTRUCTIVE TESTING METHODS SUCH AS GROUND PENETRATING RADAR TO VERIFY THE DECK CONDITION ACCORDING TO CMS 105.11.

CONCRETE PARAPETS:

AS SOON AS A CONCRETE SAW CAN BE OPERATED WITHOUT DAMAGING THE FRESHLY PLACED CONCRETE, SAWCUT 1/4" DEEP CONTROL JOINTS INTO THE PERIMETER OF THE CONCRETE PARAPET STARTING AND ENDING AT THE ELEVATION OF THE CONCRETE DECK. PLACE THE SAWCUTS AT A MINIMUM OF 6 FEET AND A MAXIMUM OF 10 FEET CENTERS. USE AN EDGE GUIDE, FENCE, OR JIG TO ENSURE THAT THE CUT JOINT IS STRAIGHT, TRUE, AND ALIGNED ON ALL FACES OF THE PARAPET. THE JOINT WIDTH SHALL BE THE WIDTH OF THE SAW BLADE, A NOMINAL WIDTH OF 1/4 INCH. SEAL THE PERIMETER OF THE DEFLECTION CONTROL JOINT TO A MINIMUM DEPTH OF 1 INCH WITH A POLYURETHANE OR POLYMERIC MATERIAL CONFORMING TO ASTM C920, TYPE S. LEAVE THE BOTTOM 1/2 INCH OF THE INSIDE AND OUTSIDE FACE UNSEALED TO ALLOW WATER TO ESCAPE.


INSPECTION OF EXISTING STRUCTURAL STEEL:

THE ENGINEER WILL VISUALLY INSPECT ALL EXISTING BUTT-WELDED SPLICES AND/OR TOP FLANGE COVER PLATE FILLET WELDS TO ENSURE THE WELDS, PLATES AND BEAMS OR GIRDERS ARE FREE OF DEFECTS AND CRACKS. IF NECESSARY, REMOVE ALL DECK SLAB HAUNCH FORMS IMMEDIATELY ADJACENT TO SUCH WELDS THAT MAY INTERFERE WITH THE ENGINEER'S INSPECTION. THE INSPECTION WILL NOT TAKE PLACE UNTIL THE TOP FLANGES ARE CLEANED ACCORDING TO 511.10, BUT IT WILL BE DONE BEFORE THE DECK SLAB REINFORCEMENT IS INSTALLED. THE ENGINEER WILL REPORT ALL CRACKS FOUND TO THE OFFICE OF CONSTRUCTION ADMINISTRATION, BRIDGE CONSTRUCTION SPECIALIST, ALONG WITH SPECIFIC INFORMATION ON LOCATION OF THE CRACKS, LENGTH, AND DEPTH SO AN EVALUATION AND REPAIR OR REPLACEMENT RECOMMENDATION CAN BE MADE.

ITEM 513 - STRUCTURAL STEEL, MISC.: BEAM RETROFIT PLATES

THE EXISTING BEAMS SHALL HAVE RETROFIT PLATES INSTALLED AS INDICATED IN THE PLANS. STEEL SHALL BE ASTM A709, GRADE 50 (MINIMUM YIELD 50,000 PSI) AND BOLTS SHALL BE ASTM 325. BOLT HOLES IN THE RETROFIT PLATES SHALL BE DRILLED IN THE SHOP. TEMPLATES SHALL BE USED FOR THE DRILLING OF THE HOLES IN THE EXISTING BEAMS. THE WELDS IN THE EXISTING BEAM OR PROTRUSIONS IN THE FLANGE AREA SHALL BE GROUND FLUSH WHERE NECESSARY TO ENSURE PROPER CONTACT FIT. THE GRINDING SHALL BE IN THE DIRECTION OF THE LONGITUDINAL AXIS. RETROFIT PLATES SHALL FIT FLAT AGAINST THE EXISTING BEAM AND FILL PLATES SHALL BE USED TO COMPENSATE FOR ANY MISALIGNMENT OF MORE THAN 1/16". AFTER HOLES ARE DRILLED IN THE BEAM BUT BEFORE FINAL ASSEMBLY, THE CONTACT SURFACES OF THE EXISTING BEAM AND THE ENTIRE SURFACE OF THE RETROFIT PLATES AND FILLER PLATES SHALL BE PREPARED AND GIVEN A PRIME COAT AS PER 514. ALL BURS AND FINIS PRODUCED BY DRILLING OF HOLES SHALL BE REMOVED. PAINT SHALL BE REMOVED NEAR WHITE METAL (Sa 2 1/2). BOLTS SHALL BE INSTALLED AND TIGHTENED, BOLTS FOR THE LOWER FLANGES SHALL BE INSTALLED WITH HEADS DOWN.

DESIGNED		BTA		CHECKED		NJ		CUY - 90-14.90		2B 38	
REVIEWED		JUL		DATE		01-18-11		PID No. 77332 / 85531		2B 38	
DRAWN		BTA		STRUCTURE FILE NUMBER		1807498 / 1807714		BRIDGES 7 8		BRIDGES 10 11 12	
CHECKED		NJ		DATE		08/09/13		DESIGN AGENCY		WALSH HNTB	
REVISIONS		NO.		RECORD DRAWINGS		NO.		DESIGN AGENCY		WALSH HNTB	
NO.		NO.		RECORD DRAWINGS		NO.		DESIGN AGENCY		WALSH HNTB	
NO.		NO.		RECORD DRAWINGS		NO.		DESIGN AGENCY		WALSH HNTB	
NO.		NO.		RECORD DRAW							

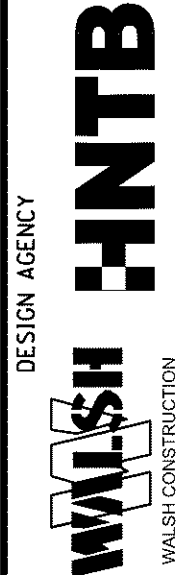

BRIDGES 7 8
BRIDGE 9
BRIDGES 10 11 12

STRUCTURE GENERAL NOTES - 2

CUY-90-1628 L/R; CUY-90-1640; CUY-90-1651 L/R; CUY-77-1597 L
1-90 EASTBOUND AND WESTBOUND OVER E 9TH STREET

090_1651LGN003.dgn 1/8/2016 11:30:17 AM rstriegel

STRUCTURE GENERAL NOTES

DECK PLACEMENT DESIGN ASSUMPTIONS:

THE FOLLOWING ASSUMPTIONS OF CONSTRUCTION MEANS AND METHODS WERE MADE FOR THE ANALYSIS AND DESIGN OF THE SUPERSTRUCTURE. THE CONTRACTOR IS RESPONSIBLE FOR THE DESIGN OF THE FALSEWORK SUPPORT SYSTEM WITHIN THESE PARAMETERS AND WILL ASSUME RESPONSIBILITY FOR SUPERSTRUCTURE ANALYSIS FOR DEVIATION FROM THESE DESIGN ASSUMPTIONS.

AN EIGHT WHEEL FINISHING MACHINE WITH A MAXIMUM WHEEL LOAD OF "A" KIPS FOR A TOTAL MACHINE LOAD OF "B" KIPS.

BRIDGE	"A" (KIPS)	"B" (KIPS)
CUY-90-1628L	1.16	9.28
CUY-90-1628R	1.16	9.28
CUY-90-1640	1.14	9.12
CUY-77-1597L	0.95	7.6
CUY-90-1651L	0.95	7.6
CUY-90-1651R (GIRDER N AND U)	1.14	9.12
CUY-90-1651R (GIRDER W AND BEAM AA)	0.95	7.6

**

**

**

A MINIMUM OUT-TO-OUT WHEEL SPACING AT EACH END OF THE MACHINE OF 103".

A MAXIMUM SPACING OF OVERHANG FALSEWORK BRACKETS OF 48 IN.

A MAXIMUM DISTANCE FROM THE CENTERLINE OF THE FASCIA GIRDER TO THE FACE OF THE SAFETY HANDRAIL OF 65".

** - LOADS PROVIDED ARE BASED ON A MAXIMUM DECK OVERHANG OF 3'-0" FROM THE CENTERLINE OF FASCIA BEAM TO THE EDGE OF SLAB. CONTRACTOR TO PROVIDE TEMPORARY BRACING FOR OVERHANGS LARGER THAN 3'-0" AT BRACKET LOCATIONS TO PREVENT GIRDER WARPING AND EXCESSIVE THINNING OF THE DECK SLAB.

ITEM 513 - STRUCTURAL STEEL MEMBERS, LEVEL UF , AS PER PLAN:

ALL REQUIREMENTS OF 513 APPLY TO SHOP FABRICATED MEMBERS. PERFORM WORK FOR FIELD FABRICATED MEMBERS ACCORDING TO ITEM 513, EXCEPT AS MODIFIED HEREIN. THE DEPARTMENT WILL NOT REQUIRE THE CONTRACTOR PERFORMING FIELD FABRICATION TO BE PRE-QUALIFIED AS SPECIFIED IN SUPPLEMENT 1078. SUBMIT A WRITTEN LETTER OF MATERIAL ACCEPTANCE, 501.06, TO THE INDEPENDENT QUALITY FIRM (IQF). PROVIDE SHOP DRAWINGS ACCORDING TO 513.04 OR SUPPLY THE IQF WITH "AS-BUILT" DRAWINGS MEETING 513.04 AFTER COMPLETION OF FIELD FABRICATION. THE IQF WILL REVIEW THE SUBMITTED DRAWINGS FOR CONCURRENCE WITH THE FINAL AS-BUILT CONDITION. IF THE IQF IS SATISFIED WITH THE "AS-BUILT" DRAWINGS AND THE DELIVERED MATERIALS, SUPPLY A COPY OF THE DRAWINGS, STAMPED AND DATED, ALONG WITH MICROFILM, TO THE STRUCTURAL, WELDING AND METALS SECTION OF THE OFFICE OF MATERIAL MANAGEMENT FOR RECORD PURPOSES.

ITEM 519 - PATCHING CONCRETE STRUCTURES, AS PER PLAN:

PRIOR TO THE SURFACE CLEANING SPECIFIED IN 519.04 AND WITHIN 24 HOURS OF PLACING PATCHING MATERIAL, BLAST CLEAN ALL SURFACES TO BE PATCHED INCLUDING THE EXPOSED REINFORCING STEEL. ACCEPTABLE METHODS INCLUDE HIGH-PRESSURE WATER BLASTING WITH OR WITHOUT ABRASIVES IN THE WATER, ABRASIVE BLASTING WITH CONTAINMENT, OR VACUUM ABRASIVE BLASTING.

CONTRACTOR SHALL DETERMINE AREAS REQUIRING PATCHING USING NON-DESTRUCTIVE METHODS (SOUNDING) ON ALL SUBSTRUCTURE UNITS REQUIRED BY PROJECT SCOPE. CONCRETE REPAIRS SHALL BE INCORDANCE WITH SECTION 519 OF THE CMS.

TABLES OF AREAS ESTIMATED PER SCOPE VS. ACTUAL AREAS DETERMINED

CUY-90-1628L/1628R (BRIDGE 7/8)

SUBSTRUCTURE UNIT	BL 7/BL 8 ESTIMATED (SQ. FT.)	ACTUAL (SQ. FT.)
REAR ABUTMENT	200/100	121.8
PIER 1	30/NOT REQUIRED	64.3
PIER 2	75/NOT REQUIRED	44.2
FORWARD ABUTMENT	50/150	79.3

CUY-90-1640 (BRIDGE 9)

SUBSTRUCTURE UNIT	ESTIMATED (SQ. FT.)	ACTUAL (SQ. FT.)
REAR ABUTMENT	100	84.8
PIER 1	150	33.9
PIER 2	25	53.9
FORWARD ABUTMENT	100	24.9

CUY-77-1597L (BRIDGE 10)

SUBSTRUCTURE UNIT	ESTIMATED (SQ. FT.)	ACTUAL (SQ. FT.)
REAR ABUTMENT	70	42.3
PIER 1	NOT REQUIRED	2.3
PIER 2	NOT REQUIRED	NOT REQUIRED
PIER 3	NOT REQUIRED	19.7
FORWARD ABUTMENT	50	17.6

CUY-77-1651L (BRIDGE 11)

SUBSTRUCTURE UNIT	ESTIMATED (SQ. FT.)	ACTUAL (SQ. FT.)
REAR ABUTMENT	50	23.2
PIER 1	25	37.0
PIER 2	20	NOT REQUIRED
PIER 3	NOT REQUIRED	36.0
FORWARD ABUTMENT	50	26.4

CUY-77-1651R (BRIDGE 12)

SUBSTRUCTURE UNIT	ESTIMATED (SQ. FT.)	ACTUAL (SQ. FT.)
REAR ABUTMENT	50	144.0
PIER 1	25	50.5
PIER 2	20	NOT REQUIRED
PIER 3	NOT REQUIRED	16.5
FORWARD ABUTMENT	50	14.5

DESIGNED
BTA
CHECKED
NJ

DRAWN
BTA
CHECKED
NJ

REVIEWED
JOL
STRUCTURE FILE NUMBER
1807498 / 1807714

DATE
01-18-11

BRIDGES 7 8
BRIDGE 9
BRIDGES 10 11 12

DESIGN AGENCY
WALSH HNTB
WALSH CONSTRUCTION

DATE
08/09/13

REVISIONS
RECORD DRAWINGS

NO.

CUY-90-14.90
PID No. 77332 / 85531

2C/38

2C/38

STRUCTURE GENERAL NOTES - 3
CUY-90-1628 L/R; CUY-90-1640; CUY-90-1651 L/R; CUY-77-1597 L
1-90 EASTBOUND AND WESTBOUND OVER E 9TH STREET

DESIGN TRAFFIC

CUY-90-1651 L
(I.R. 90 WB)

2015 ADT = 48,000
2015 ADTT = 5,200
2035 ADT = 47,000
2035 ADTT = 5,500

CUY-90-1651 R
(I.R. 90 EB)

2015 ADT = 45,000
2015 ADTT = 4,050
2035 ADT = 48,000
2035 ADTT = 4,320

CUY-77-1597 L
(RAMP E10)

2015 ADT = 22,200
2015 ADTT = 3,250
2035 ADT = 23,500
2035 ADTT = 3,500

UY-90-1651 P
(RAMP E9)

2015 ADT = 18,300
2015 ADTT = 2,380
2035 ADT = 19,200
2035 ADTT = 2,500

HORIZONTAL CURVE DATA

EXISTING I.R. 90 CURVE DATA

$$\begin{aligned} P.I. &= STA. 67+01.0 \\ \Delta &= 12^\circ 01' 44'' \text{ (LT.)} \\ D_c &= 01^\circ 30' 00'' \\ R &= 3819.72' \\ T &= 402.44' \\ L &= 801.92' \\ E &= 21.14' \end{aligned}$$

CONST. RAMP EIC

$$\begin{aligned} P.I. &= STA. 0+81.63 \\ \Delta &= 9^\circ 46' 18'' (RT.) \\ D_C &= 6^\circ 00' 00'' \\ R &= 954.93' \\ T &= 81.63' \\ L &= 162.86' \\ E &= 3.48' \end{aligned}$$

CONST. RAMP ES

$P.I. = STA. 5+68.49$
 $\Delta = 22^\circ 06' 18'' (RT.)$
 $DC = 6^\circ 00' 00''$
 $R = 954.93'$
 $T = 186.53$
 $L = 368.42$
 $E = 18.05$

ROADWAY INTERSECTION POINTS

CONST. RAMP E9 STA. 5+68.68
S.B. E14TH STA. 228+25.12


C EXISTING I.R. 90 STA. 71+93.39 =
 D S.B. E14TH STA. 228+96.15

CONST. RAMP E10 STA. 2+93.48 :
S.B. E14TH STA. 229+89.26


CONST. RAMP E10 STA. 2+42.13
N.B. E14TH STA. 130+54.95

EXISTING I.R. 90 STA. 72+59.16
N.B. E14TH STA. 129+62.65

CONST. RAMP E9 STA. 6+45.88
N.B. E14TH STA. 129+03.93

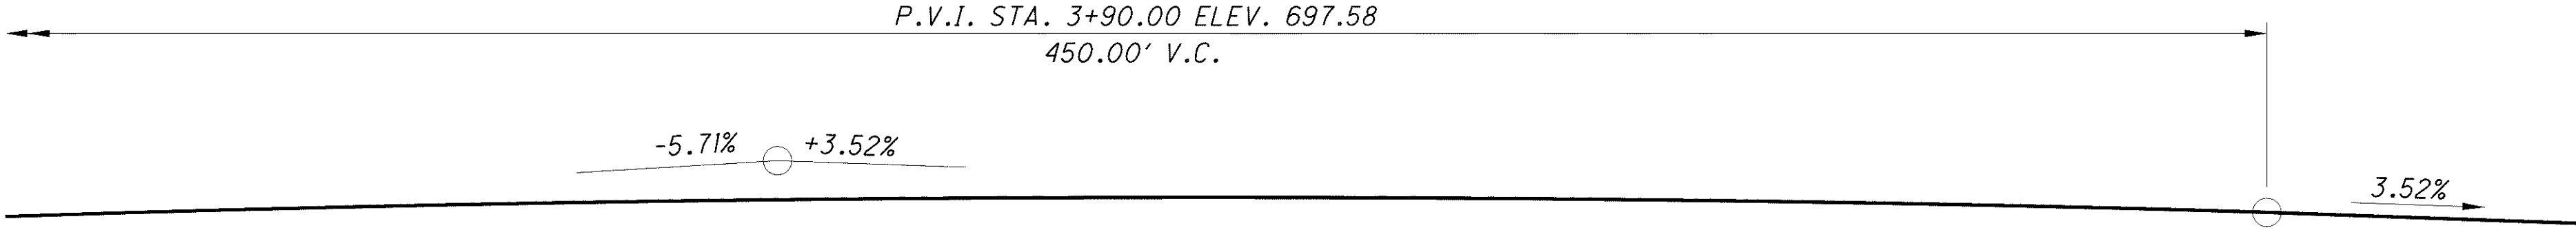

PROFILE ALONG B CONST. RAMP E10

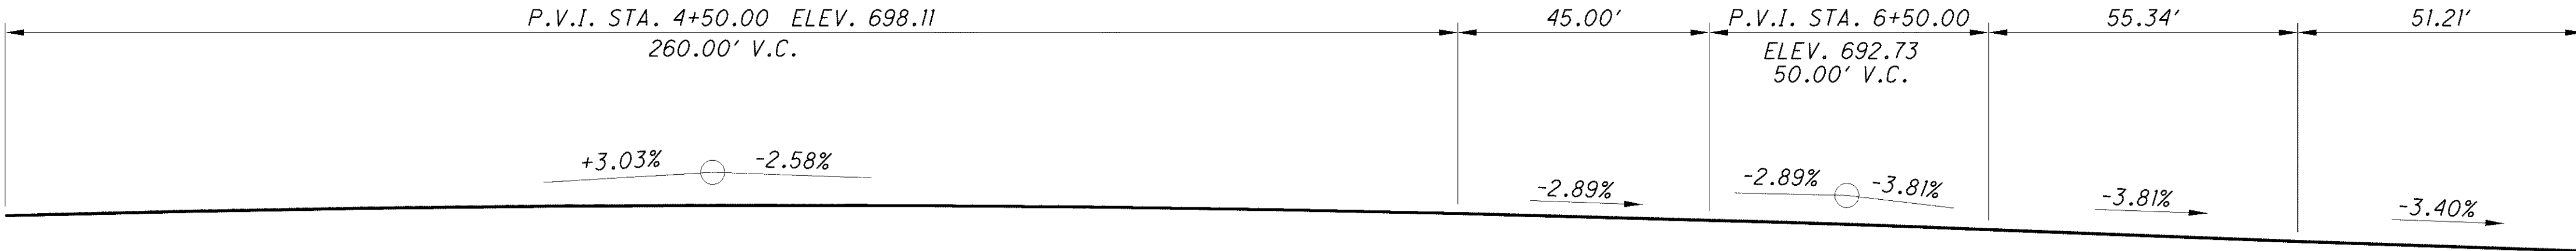

PROFILE ALONG B CONST. RAMP ES

BORING LOCATIONS			
<i>BORING</i>	<i>STATION</i>	<i>OFFSET</i>	<i>TOP OF ROCK</i>
<i>B-069-1-10</i>	<i>72+48.47</i>	<i>86.0' RT.</i>	<i>NOT ENCOUNTERED</i>
<i>B-069-2-10</i>	<i>72+98.97</i>	<i>99.7' RT.</i>	
<i>B-069-3-10</i>	<i>71+41.48</i>	<i>96.1' RT.</i>	

FOUNDATION DATA

REAR AND FORWARD ABUTMENT PILES SHALL BE 12" Ø CAST IN PLACE REINFORCED CONCRETE PILES AND HAVE AN ULTIMATE BEARING VALUE OF 75 TONS PER PILE WITH AN ESTIMATED LENGTH OF 45' FOR THE REAR ABUTMENT AND 55' FOR THE FORWARD ABUTMENT. PIER PILES SHALL BE 14" Ø CAST IN PLACE REINFORCED CONCRETE PILES AND HAVE AN ULTIMATE BEARING VALUE OF 109 TONS PER PILE WITH AN ESTIMATED LENGTH OF 75' AT PIER 1 AND 90' AT PIER 2 AND PIER 3.

PROPOSED WORK



REMOVE EXISTING NON-COMPOSITE BRIDGE DECK IN STAGES;
REMOVE PORTIONS OF EXISTING ABUTMENTS; MODIFY ABUTMENTS
AND WIDEN EXISTING PIERS AND ABUTMENTS IN STAGES; INSTALL
NEW BEARINGS AND ROLLED BEAMS; CONSTRUCT NEW COMPOSITE
BRIDGE DECK IN STAGES; REMOVE AND REPLACE EXISTING
APPROACH SLABS IN STAGES.

BENCHMARK DATA

BM #4 STA. 72+34.4 (C EXISTING I.R. 90), ELEV. 669.18,
OFFSET 129.3 LT.
CHIASED "X" ON N BOLT OF LIGHT POLE AT E. 14TH AND I-90
BM #5 STA. 66+28.4 (C EXISTING I.R. 90), ELEV. 664.68,
OFFSET 198.2 LT.
CHIASED SQUARE AT SE CORNER OF CONCRETE AROUND A SQUARE
CATCH BASIN BETWEEN I-90 W AND I-77 S RAMPS

[illegible]



DESIGNED RSB/KG		CHECKED JRS	STRUCTURE FILE NUMBER 1807919/1807900/1807803		BRIDGE 10				NO.	REVISIONS	DATE
DRAWN RSB		CHECKED NJ	REVIEWED JOL		BRIDGE 11						
					BRIDGE 12						
5		3		8		GENERAL PLAN					
5		1		8		BRIDGE NO. CUY-77-1597 L AND CUY-90-1651 L/R					
3		8		I-90 EB, I-90WB AND I-77SB RAMP OVER E 14TH STREET							
CUY-90-14.90		PID No. 77332 / 85531									

090_1651LPC001.dgn 1/8/2016 11:30:59 AM rstriegel

SUGGESTED CONSTRUCTION SEQUENCE

PHASE 1, STEP 1

1. WIDEN ABUTMENTS, WIDEN PIERS, ERECT BEAM AA AND HAND TIGHTEN ERECTION BOLTS FOR CROSSFRAMES (EXCEPT FIELD SPLICES 2 AND 3) BETWEEN EXISTING GIRDER Z AND BEAM AA TO THE LIMITS SHOWN ON THE PLANS. (CUY-90-1651R ONLY)
2. INSTALL PORTABLE CONCRETE BARRIERS AS SHOWN IN THE PLANS.
3. DIRECT TRAFFIC AS SHOWN ON THE MAINTENANCE OF TRAFFIC PLANS.
4. CUT EXISTING CROSSFRAMES TO THE LIMITS SHOWN IN THE PLANS.
5. REMOVE EXISTING DECK, BARRIER CURB, APPROACH SLABS, TOP OF BACKWALLS AND WINGWALLS TO THE LIMITS SHOWN IN THE PLANS.
6. INSTALL SHEAR CONNECTORS.
7. INSTALL BENT PLATES FOR CROSSFRAMES BETWEEN EXISTING GIRDER Z AND BEAM AA AT FIELD SPLICES 2 AND 3 AND HAND TIGHTEN ERECTION BOLTS FOR CROSSFRAMES. (CUY-90-1651R ONLY)
8. CONSTRUCT DECK AND PARAPET AS SHOWN IN THE PLANS.
9. PERMANENTLY ATTACH CROSSFRAMES BETWEEN EXISTING GIRDER Z AND BEAM AA. (CUY-90-1651R ONLY)
10. REPAIR CUT CROSSFRAMES.
11. CONSTRUCT TOP OF BACKWALLS, APPROACH SLABS AND INSTALL EXPANSION JOINTS AS SHOWN IN THE PLANS.
12. SEAL CONCRETE SURFACES TO THE LIMIT SHOWN ON THE PLANS.

PHASE 1, STEP 2

1. INSTALL PORTABLE CONCRETE BARRIERS AS SHOWN IN THE PLANS.
2. DIRECT TRAFFIC AS SHOWN ON THE MAINTENANCE OF TRAFFIC PLANS.
3. CUT EXISTING CROSSFRAMES TO THE LIMITS SHOWN IN THE PLANS.
4. PROVIDE TEMPORARY BRACINGS FOR EXISTING GIRDER U IN SPAN 3. (CUY-90-1651R ONLY)
5. REMOVE EXISTING DECK, BARRIER CURB, APPROACH SLABS, TOP OF BACKWALLS AND WINGWALLS TO THE LIMITS SHOWN IN THE PLANS.
6. INSTALL SHEAR CONNECTORS.
7. CONSTRUCT DECK AND PARAPET AS SHOWN IN THE PLANS.
8. REPAIR CUT CROSSFRAMES.
9. CONSTRUCT TOP OF BACKWALLS, APPROACH SLABS AND INSTALL EXPANSION JOINTS AS SHOWN IN THE PLANS.
10. SEAL LONGITUDINAL JOINTS WITH HIGH MOLECULAR WEIGHT METHACRYLATE (HMWM).
11. SEAL CONCRETE SURFACES TO THE LIMITS SHOWN ON THE PLANS.

PHASE 1, STEP 3

1. INSTALL PORTABLE CONCRETE BARRIERS AS SHOWN IN THE PLANS.
2. DIRECT TRAFFIC AS SHOWN ON THE MAINTENANCE OF TRAFFIC PLANS.
3. CUT EXISTING CROSSFRAMES TO THE LIMITS SHOWN IN THE PLANS.
4. REMOVE EXISTING DECK, BARRIER CURB, APPROACH SLABS, TOP OF BACKWALLS AND WINGWALLS TO THE LIMITS SHOWN IN THE PLANS.
5. INSTALL SHEAR CONNECTORS.
6. CONSTRUCT DECK AND PARAPET AS SHOWN IN THE PLANS.
7. CONSTRUCT TOP OF BACKWALLS, APPROACH SLABS AND INSTALL EXPANSION JOINTS AS SHOWN IN THE PLANS.
8. SEAL CONCRETE SURFACES TO THE LIMITS SHOWN ON THE PLANS.

PHASE 1, STEP 4

1. INSTALL PORTABLE CONCRETE BARRIERS ON THE NEWLY CONSTRUCTED WORK AS SHOWN IN THE PLANS.
2. DIRECT TRAFFIC AS SHOWN ON THE MAINTENANCE OF TRAFFIC PLANS.
3. REMOVE EXISTING DECK, BARRIER CURB, APPROACH SLABS, TOP OF BACKWALLS AND WINGWALLS TO THE LIMITS SHOWN IN THE PLANS.
4. INSTALL SHEAR CONNECTORS.
5. CONSTRUCT DECK AND PARAPET AS SHOWN IN THE PLANS.
6. REPAIR CUT CROSSFRAMES.
7. CONSTRUCT CLOSURE POUR.
8. CONSTRUCT TOP OF BACKWALLS, APPROACH SLABS AND INSTALL EXPANSION JOINTS AS SHOWN IN THE PLANS.
9. SEAL LONGITUDINAL JOINTS WITH HIGH MOLECULAR WEIGHT METHACRYLATE (HMWM).
10. SEAL CONCRETE SURFACES TO THE LIMITS SHOWN ON THE PLANS.


PHASE 1, STEP 5









1. DIRECT TRAFFIC AS SHOWN ON THE MAINTENANCE OF TRAFFIC PLANS.
2. REMOVE PORTABLE CONCRETE BARRIERS AS SHOWN IN THE PLANS.
3. CUT EXISTING CROSSFRAMES TO THE LIMITS SHOWN IN THE PLANS.
4. REMOVE EXISTING DECK, BARRIER CURB, APPROACH SLABS, TOP OF BACKWALLS AND WINGWALLS TO THE LIMITS SHOWN IN THE PLANS.
5. INSTALL SHEAR CONNECTORS.
6. CONSTRUCT DECK AND PARAPET AS SHOWN IN THE PLANS.
7. REPAIR CUT CROSSFRAMES.
8. CONSTRUCT TOP OF BACKWALLS, APPROACH SLABS AND INSTALL EXPANSION JOINTS AS SHOWN IN THE PLANS.
9. SEAL LONGITUDINAL JOINTS WITH HIGH MOLECULAR WEIGHT METHACRYLATE (HMWM).
10. SEAL CONCRETE SURFACES TO THE LIMITS SHOWN ON THE PLANS.

NOTE:

1. FOR PHASE CONSTRUCTION DETAILS, SEE SHEETS 7/38 THRU 11/38.
2. FOR ADDITIONAL PORTABLE CONCRETE BARRIER DETAILS, SEE ODOT STANDARD DRAWING PCB-91.

DESIGNED RSB CHECKED NJ		DRAWN RSB CHECKED NJ		REVIEWED JOL	DATE 03-11-11	BRIDGE 10 BRIDGE 11 BRIDGE 12		DESIGN AGENCY WALSH HNTB WALSH CONSTRUCTION		NO.		REVISIONS RECORD DRAWINGS		DATE 03-14-11
6/38		6/38		CUY-90-14.90 PID No. 77332 / 85531		PHASE CONSTRUCTION DETAILS - 1 BRIDGE NO. CUY-77-1597 L AND CUY-90-1651 L/R I-90 EB, I-90WB AND I-77SB RAMP OVER E 14TH STREET								

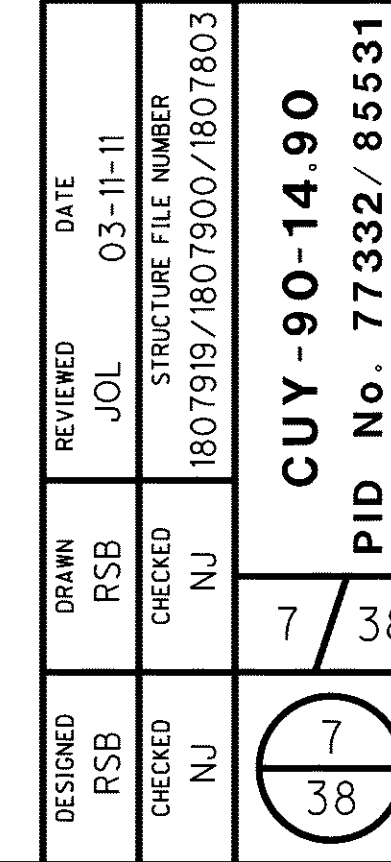

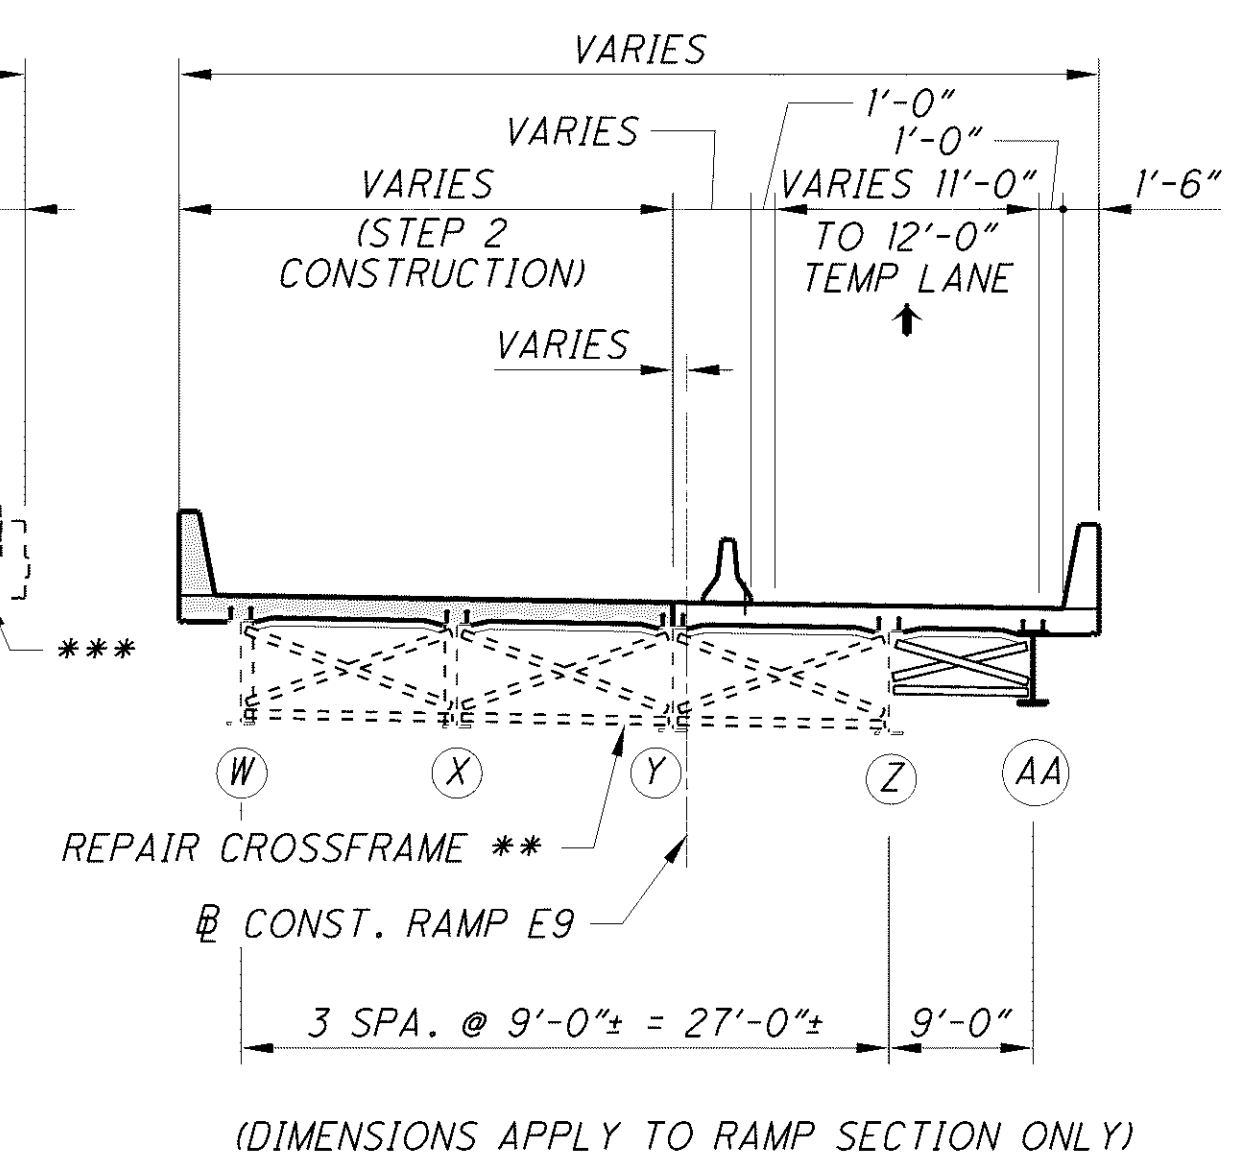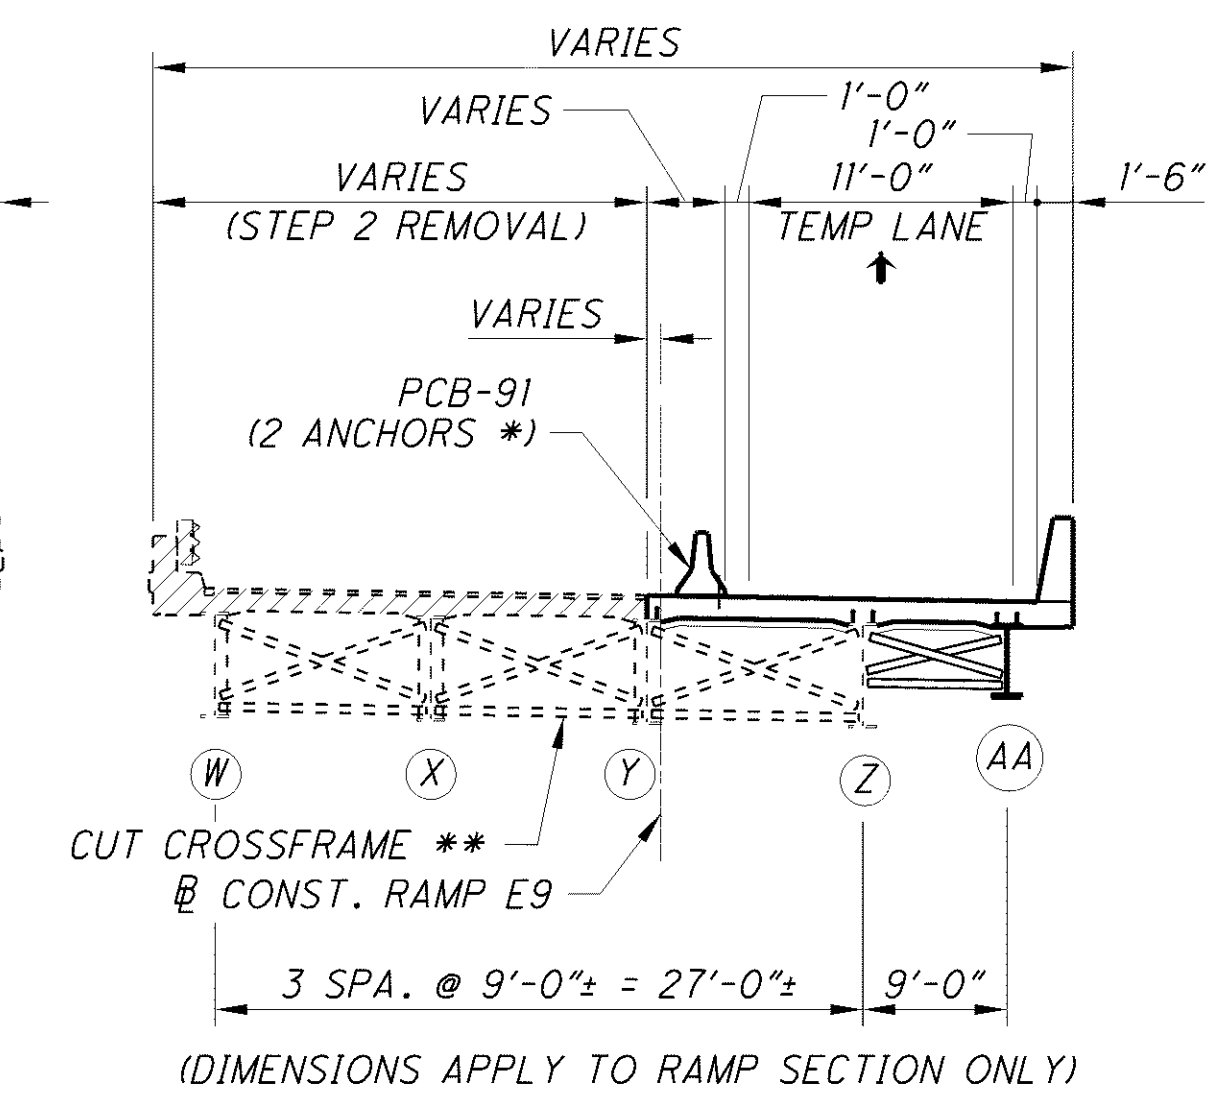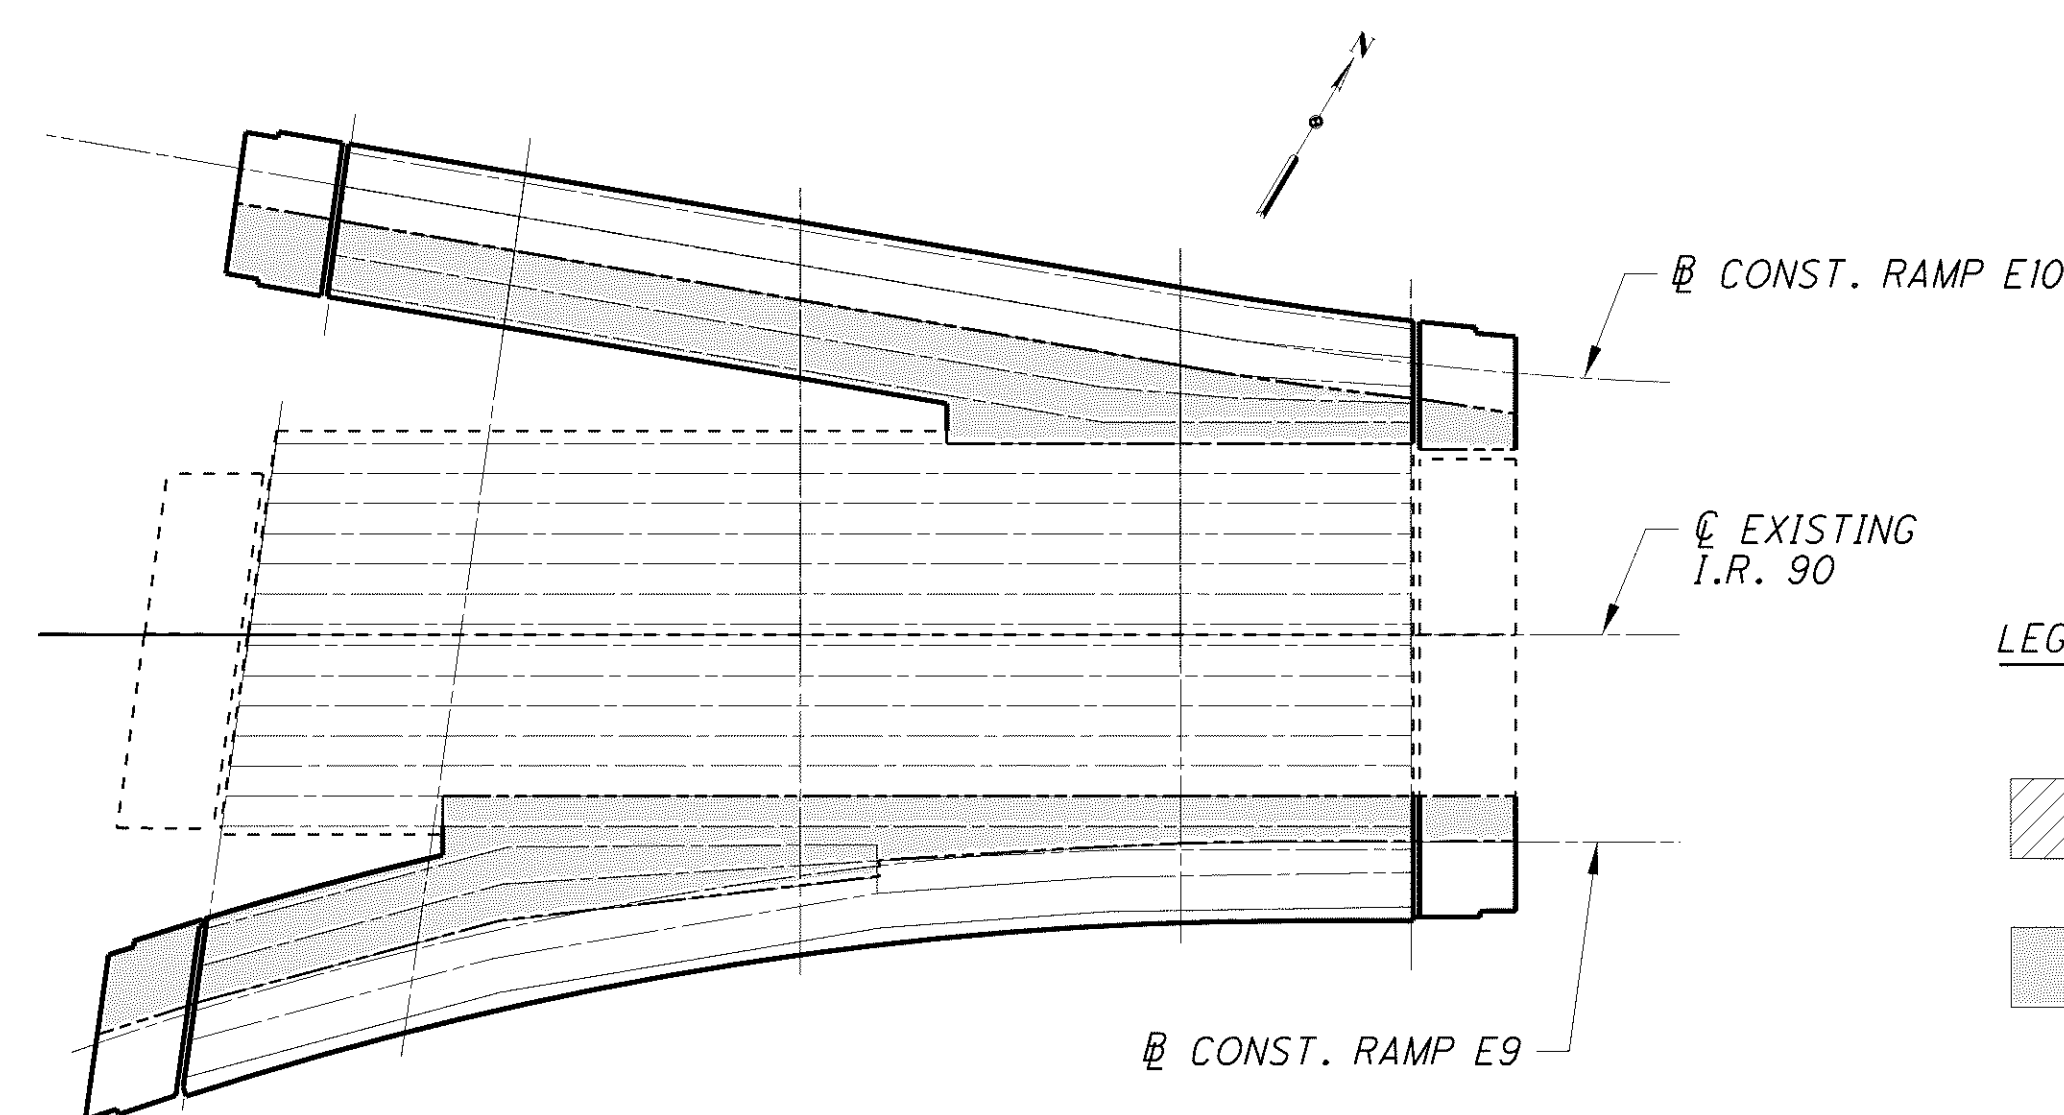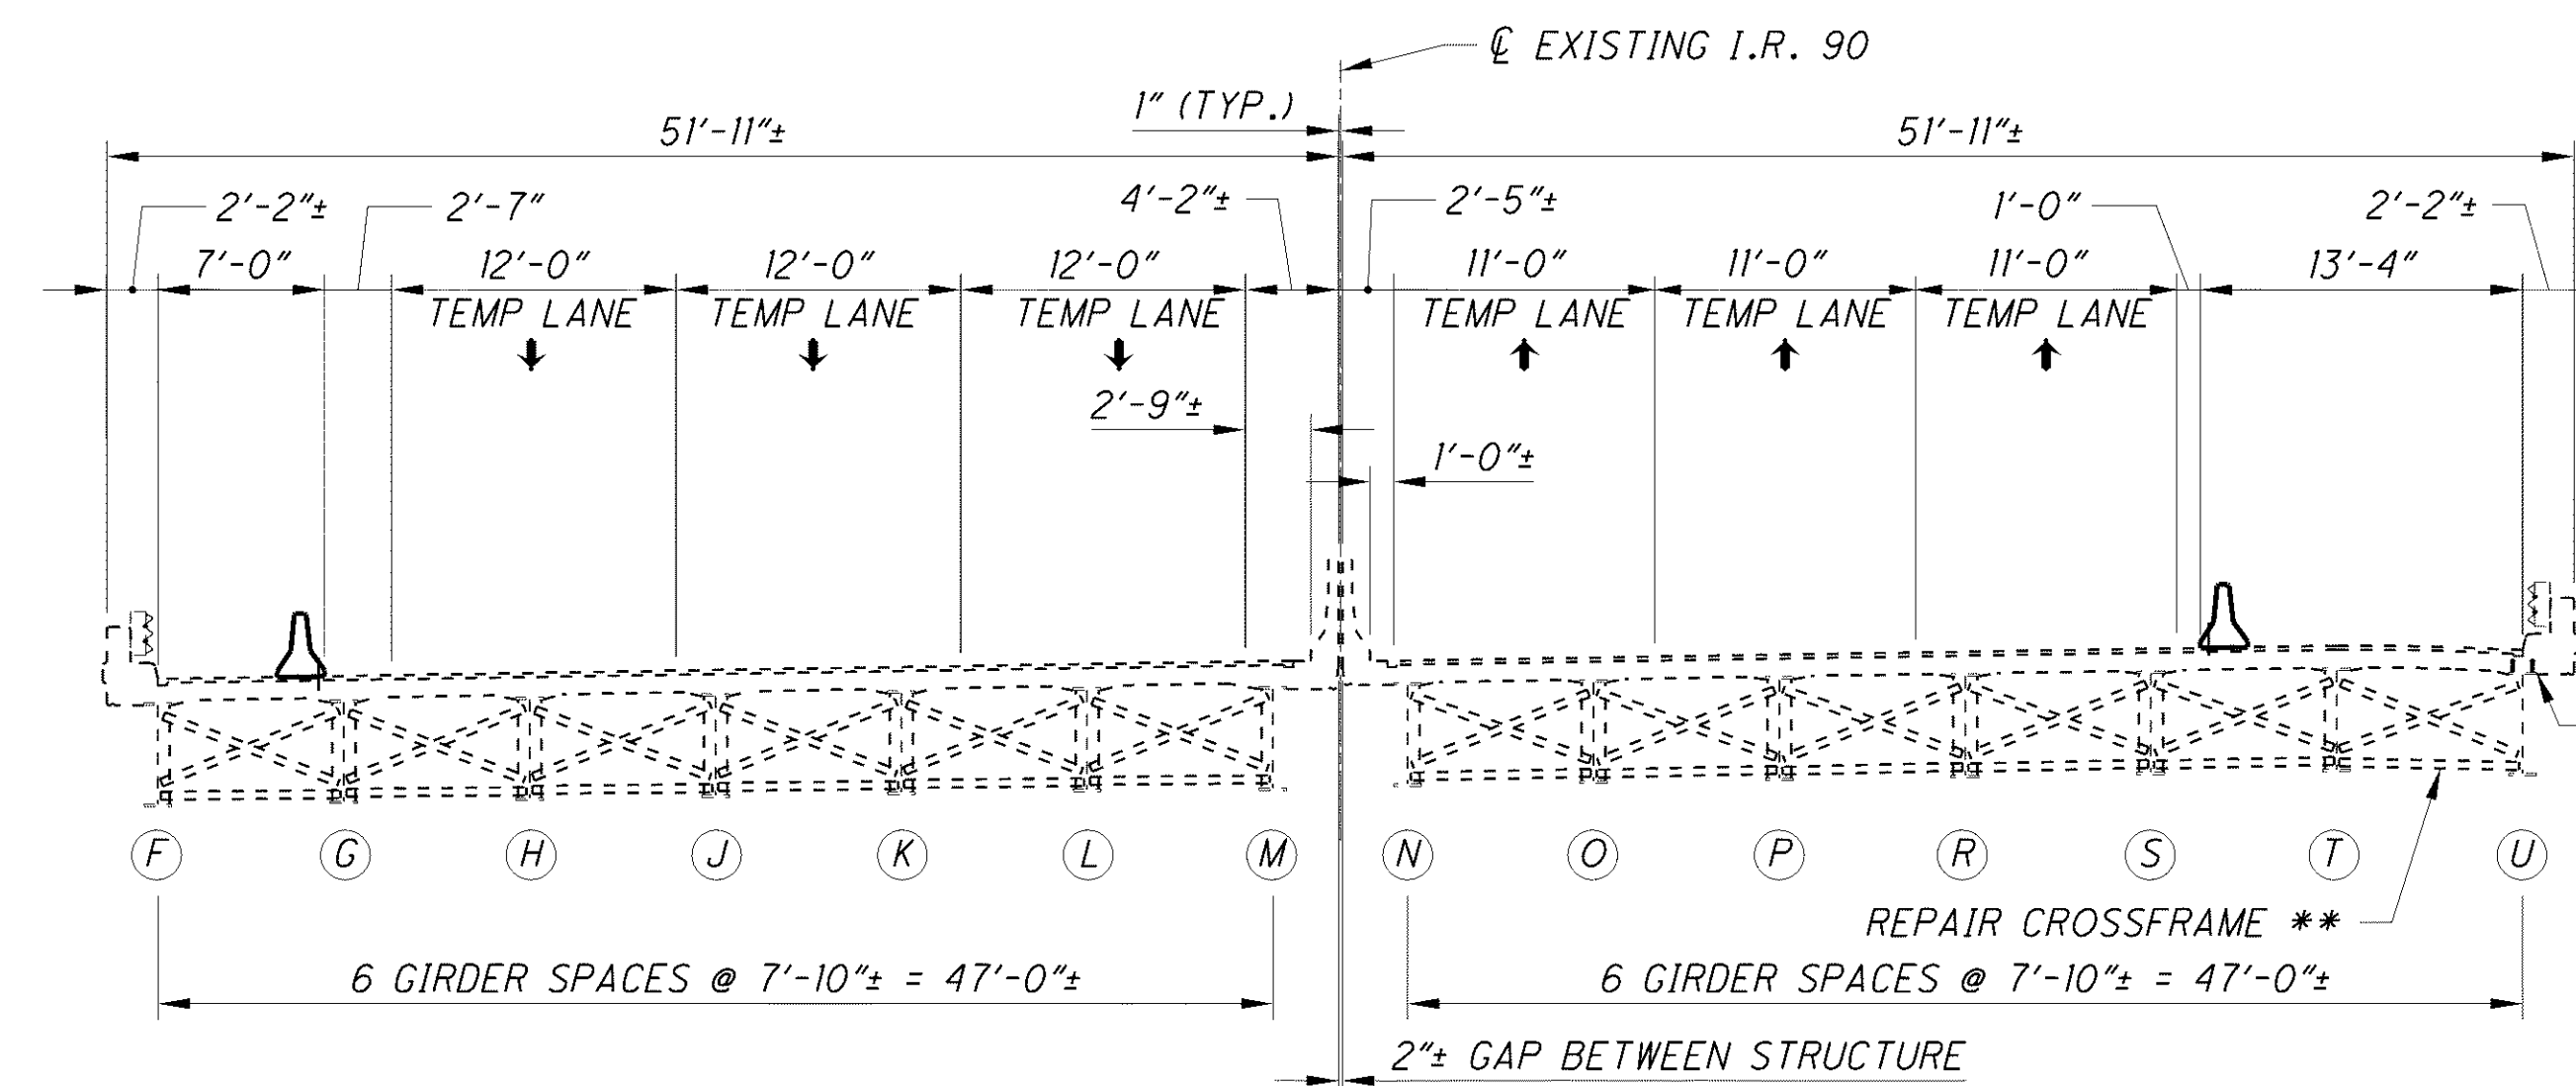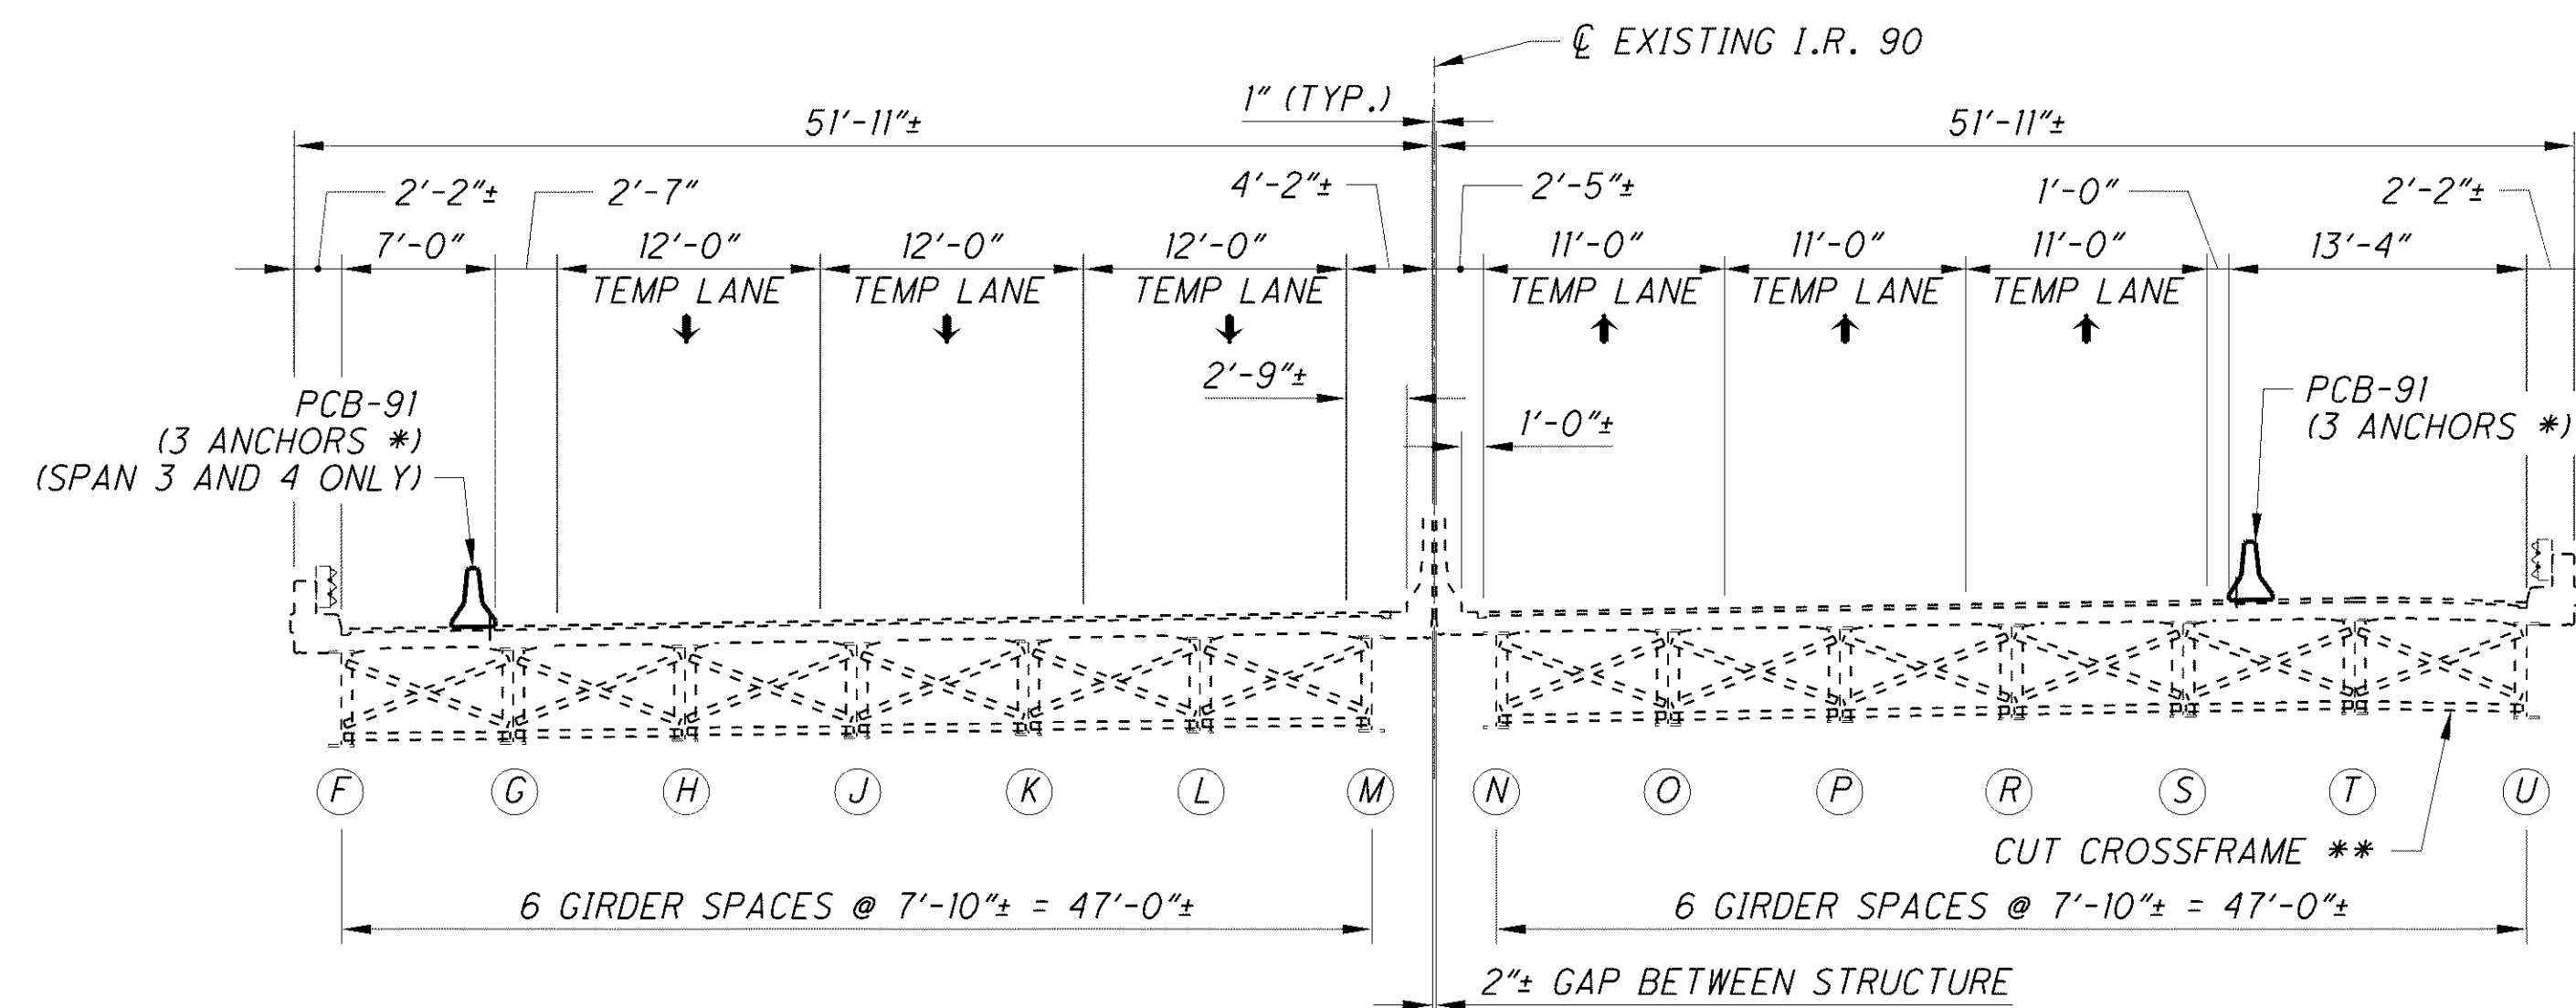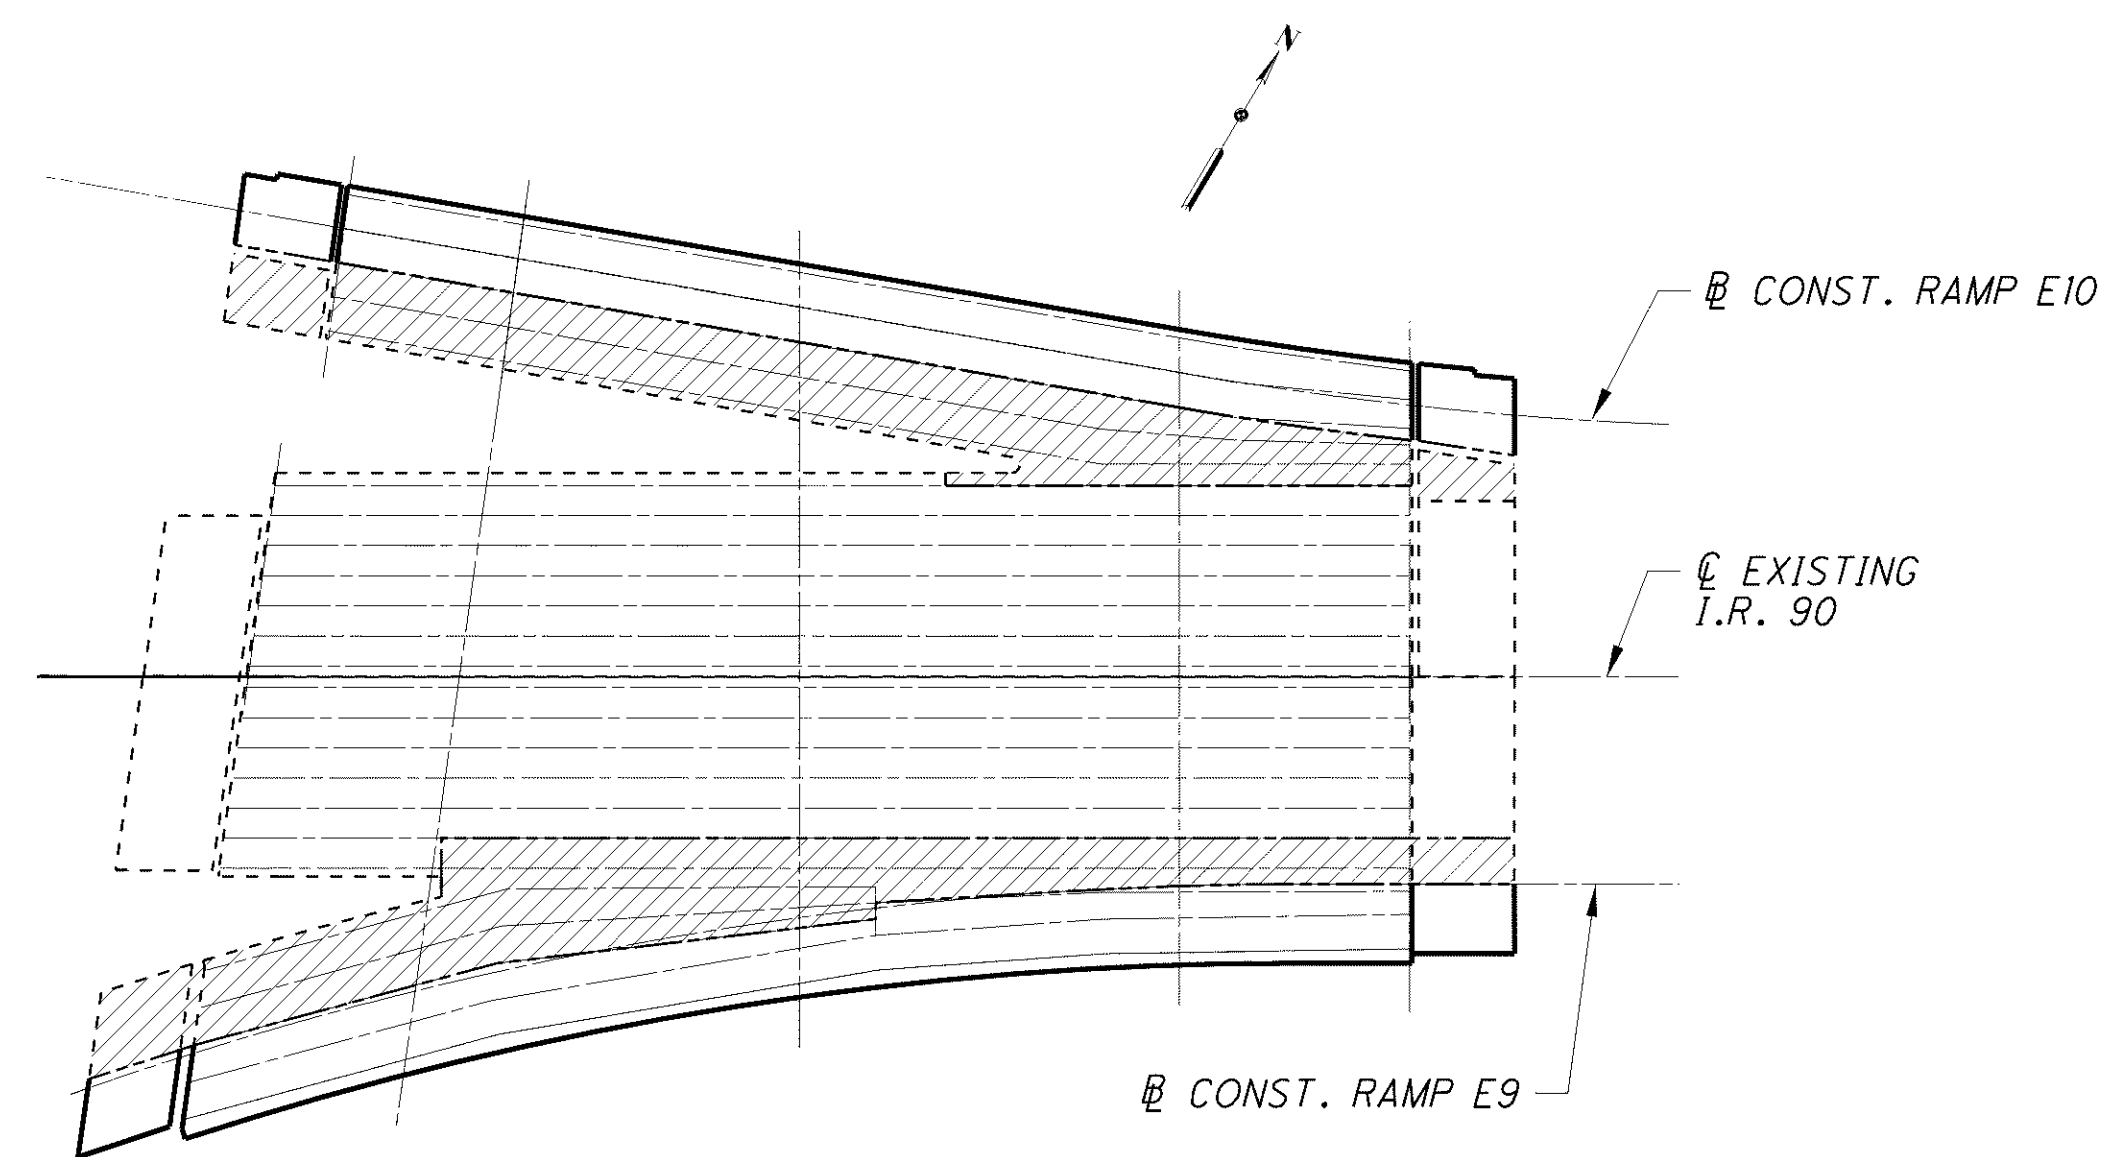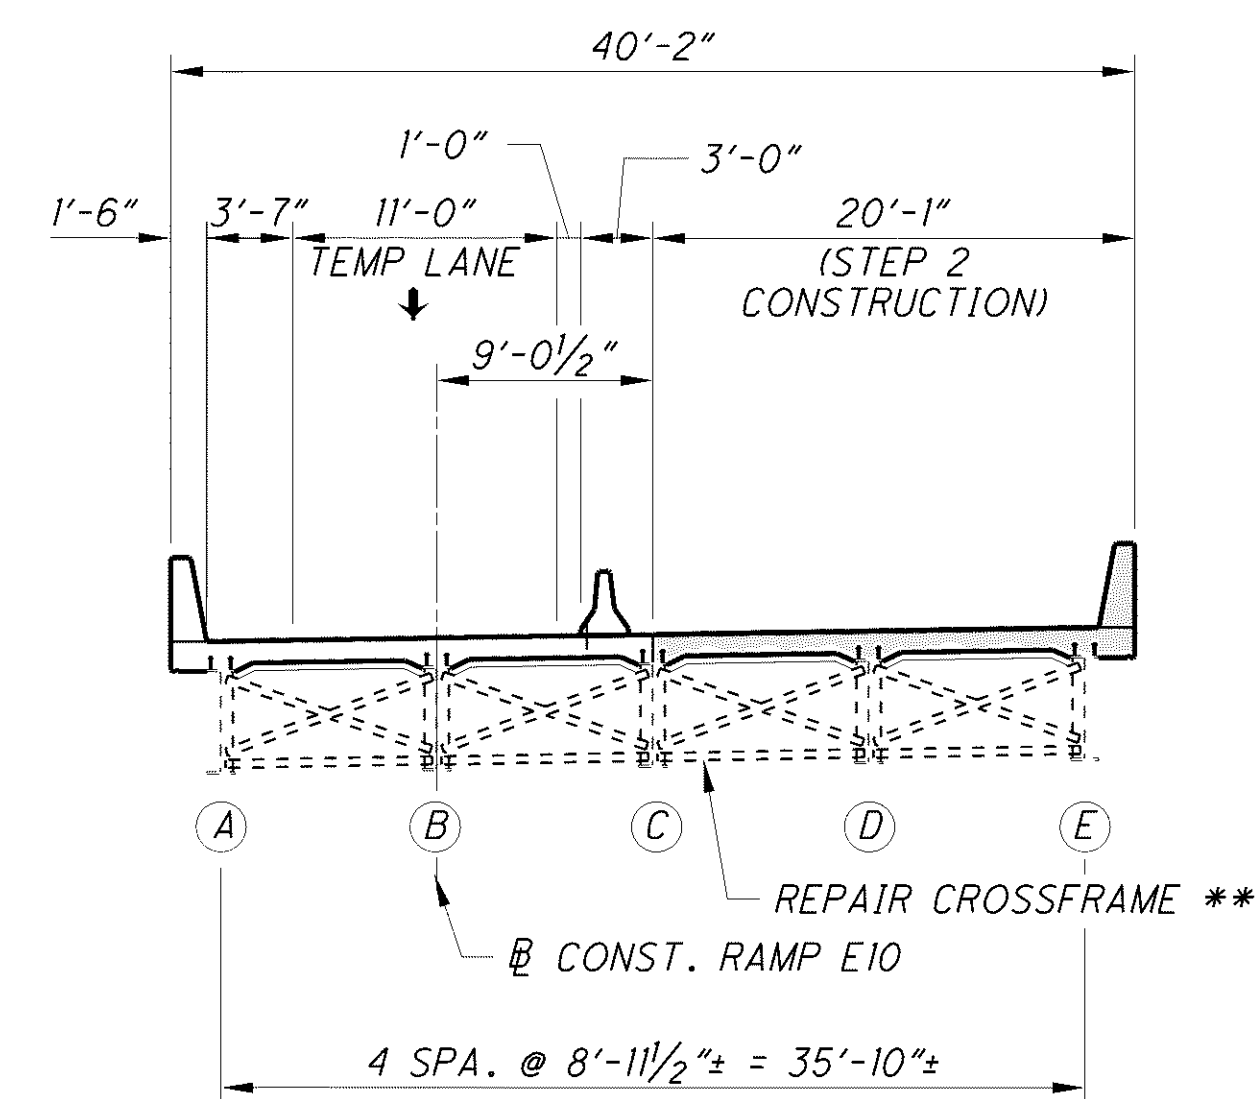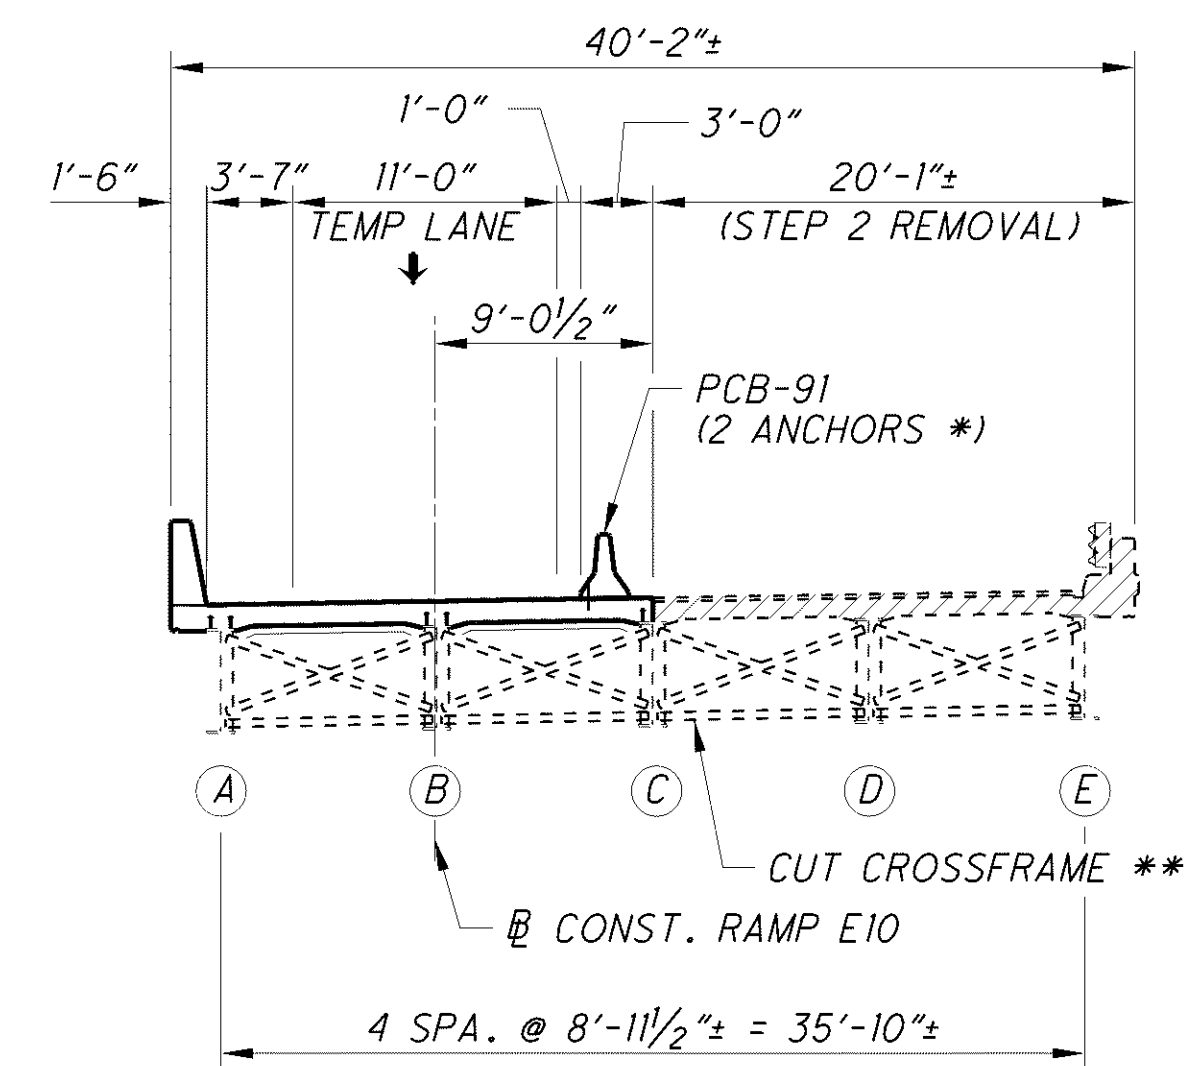


* NUMBER OF PARTIAL DEPTH ANCHOR BOLTS PER SEGMENT (INCLUDES PCB-91 ON APPROACH SLABS)

**** SPANS 2 AND 3 ONLY (CROSSFRAMES)**

*** WITHIN REMOVAL LIMITS
(SHEAR CONNECTORS)

LEGEND:

 INDICATES AREA TO BE REMOVED PER ITEM 202,
PORTIONS OF STRUCTURE REMOVED, OVER 20
FOOT SPAN, AS PER PLAN.



















































 INDICATES AREA TO BE CONSTRUCTED.




NOTE:

1. FOR ADDITIONAL NOTES, SEE SHEET 7/38.


2. AFTER REMOVAL OF THE PORTABLE CONCRETE BARRIER FROM THE NEW DECK, REMOVE THE PARTIAL DEPTH ANCHORS AND GROUT ANY VOIDS LEFT IN THE NEW DECK.

090_1651PC003.dgn 1/8/2016 11:31:14 AM rstriegel


DESIGNED RSB		CHECKED NJ		DRAWN RSB		REVIEWED JOL		DATE 03-11-11		BRIDGE 10				NO. RECORD DRAWINGS REVISIONS DATE
										BRIDGE 11				
										BRIDGE 12				
PHASE CONSTRUCTION DETAILS - 3														
BRIDGE NO. CUY-77-1597 L AND CUY-90-1651 L/R														
I-90 EB, I-90WB AND I-77SB RAMP OVER E 14TH STREET														
DESIGNED RSB		CHECKED NJ		DRAWN RSB		REVIEWED JOL		DATE 03-11-11		BRIDGE 10				NO. RECORD DRAWINGS REVISIONS DATE
										BRIDGE 11				
										BRIDGE 12				
PHASE CONSTRUCTION DETAILS - 3														
BRIDGE NO. CUY-77-1597 L AND CUY-90-1651 L/R														
I-90 EB, I-90WB AND I-77SB RAMP OVER E 14TH STREET														
DESIGNED RSB		CHECKED NJ		DRAWN RSB		REVIEWED JOL		DATE 03-11-11		BRIDGE 10				NO. RECORD DRAWINGS REVISIONS DATE
										BRIDGE 11				
										BRIDGE 12				

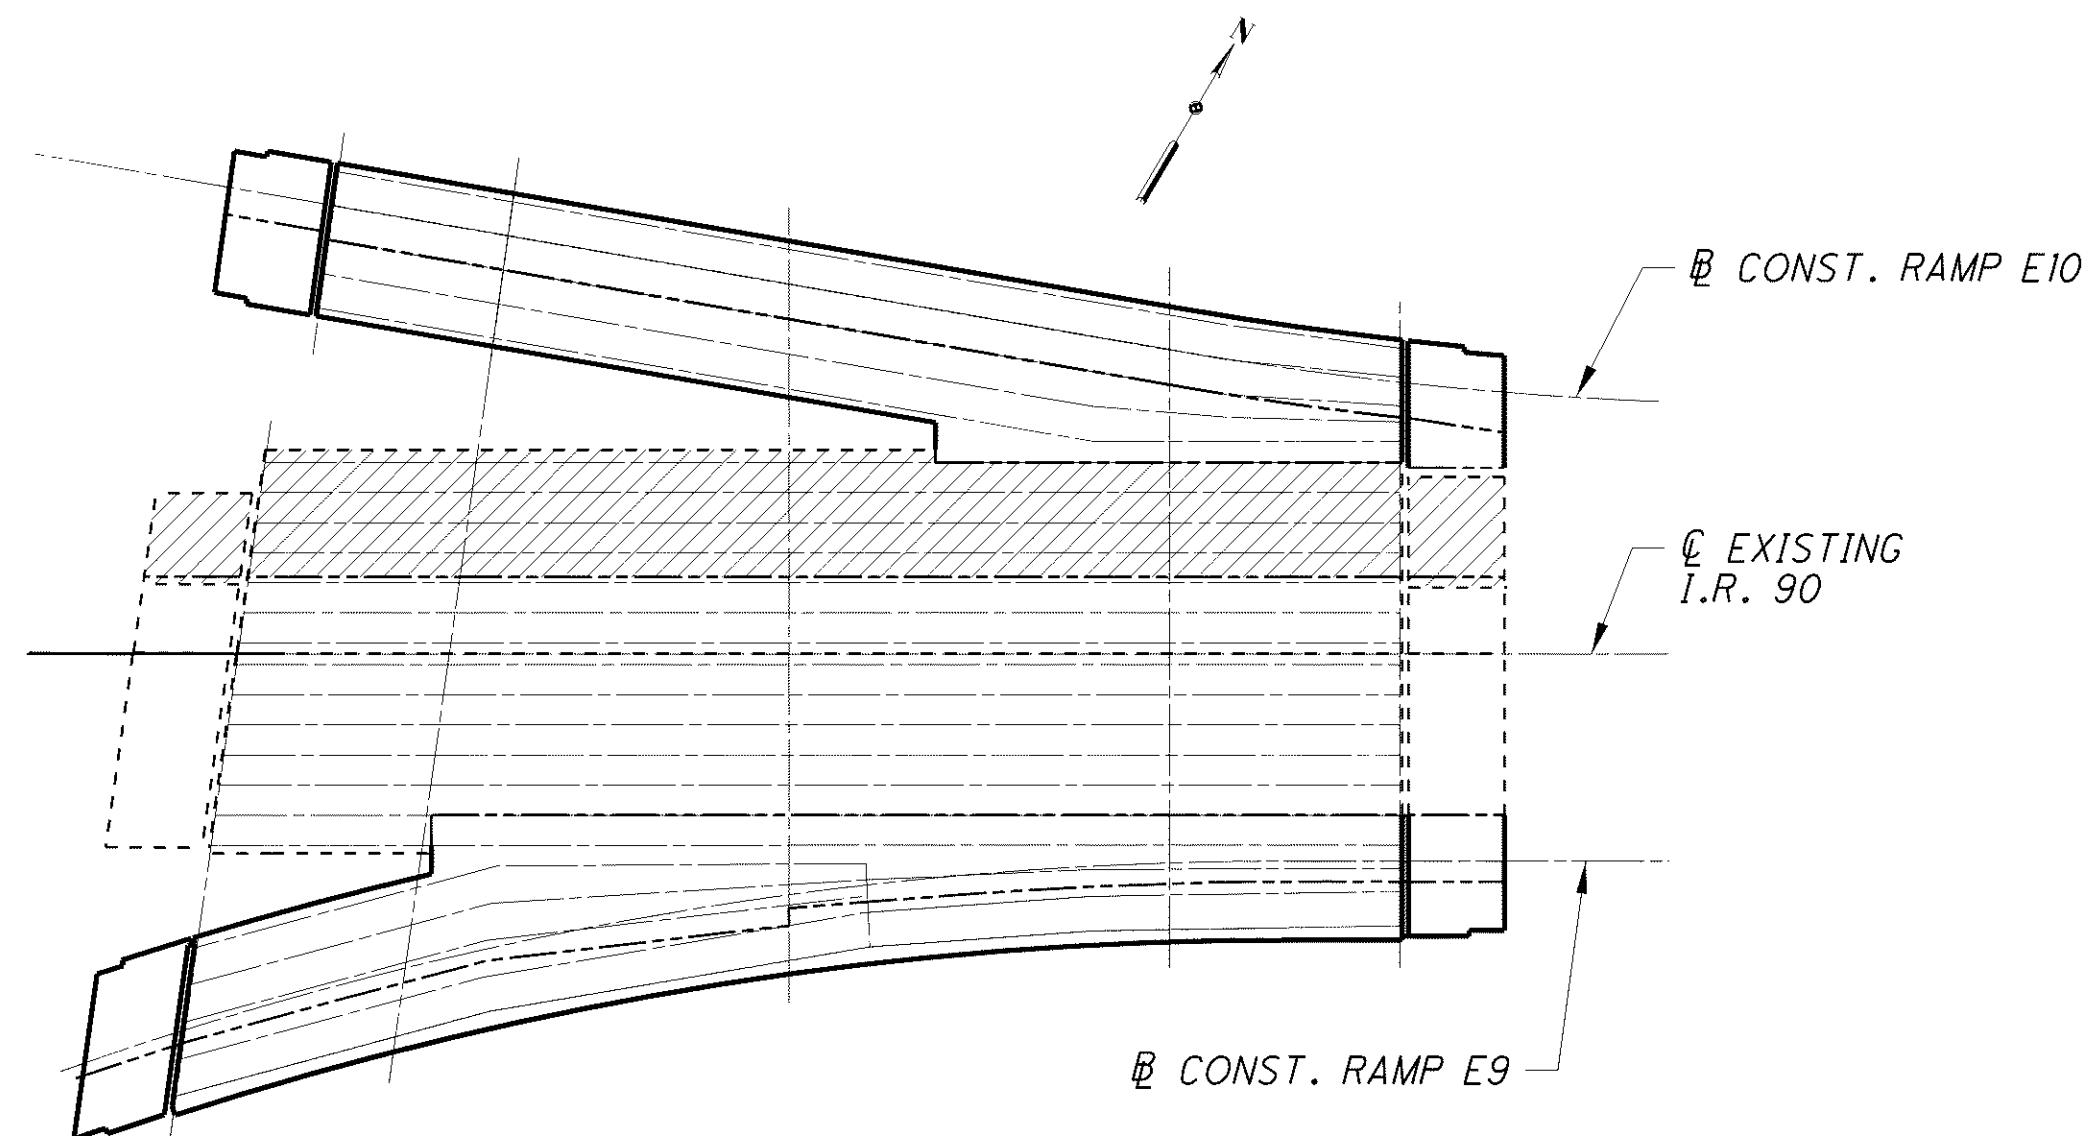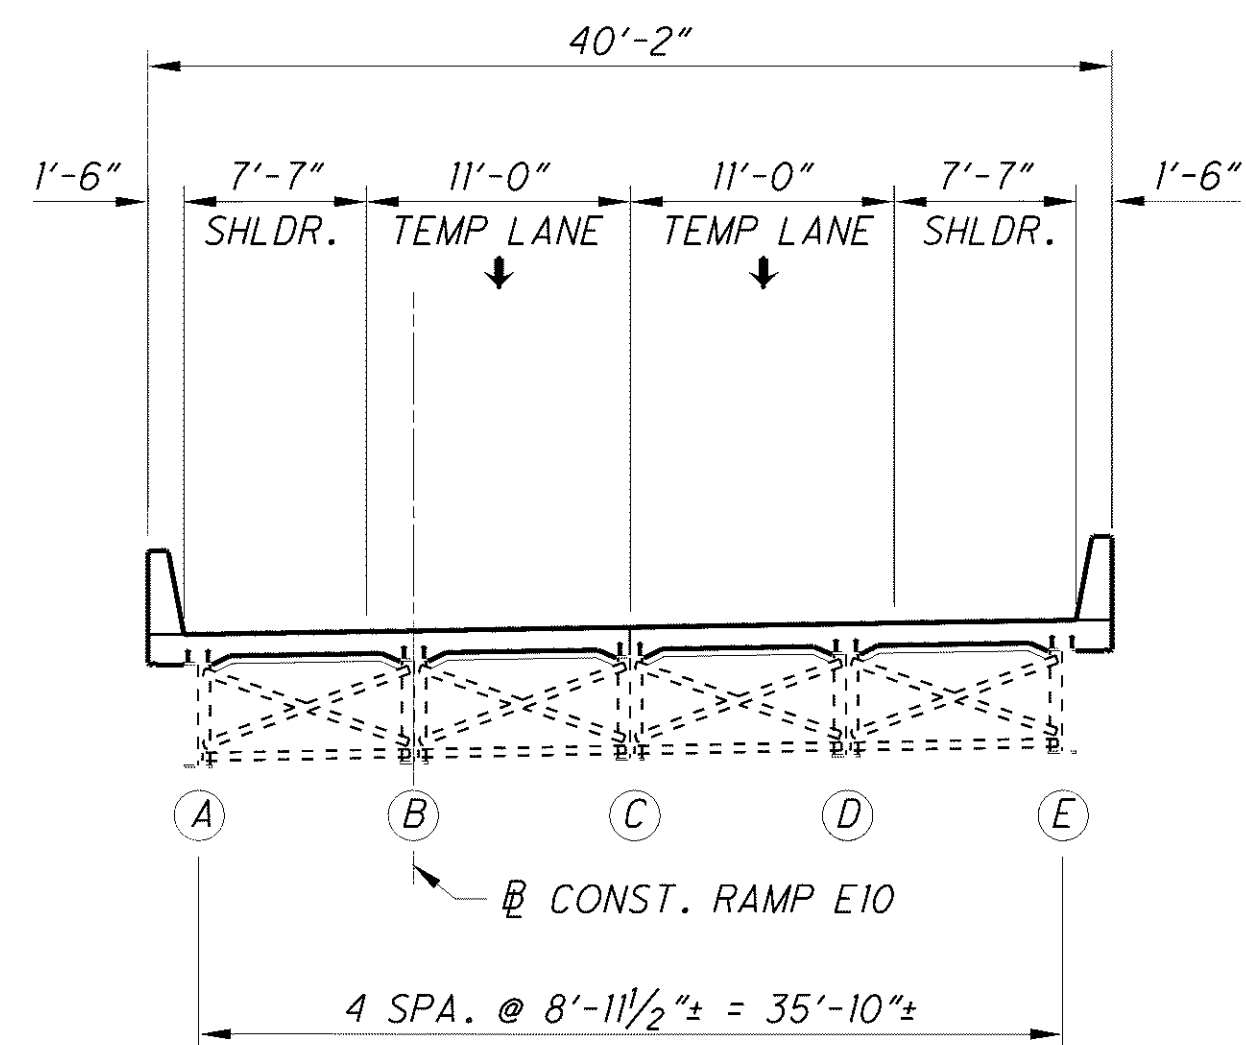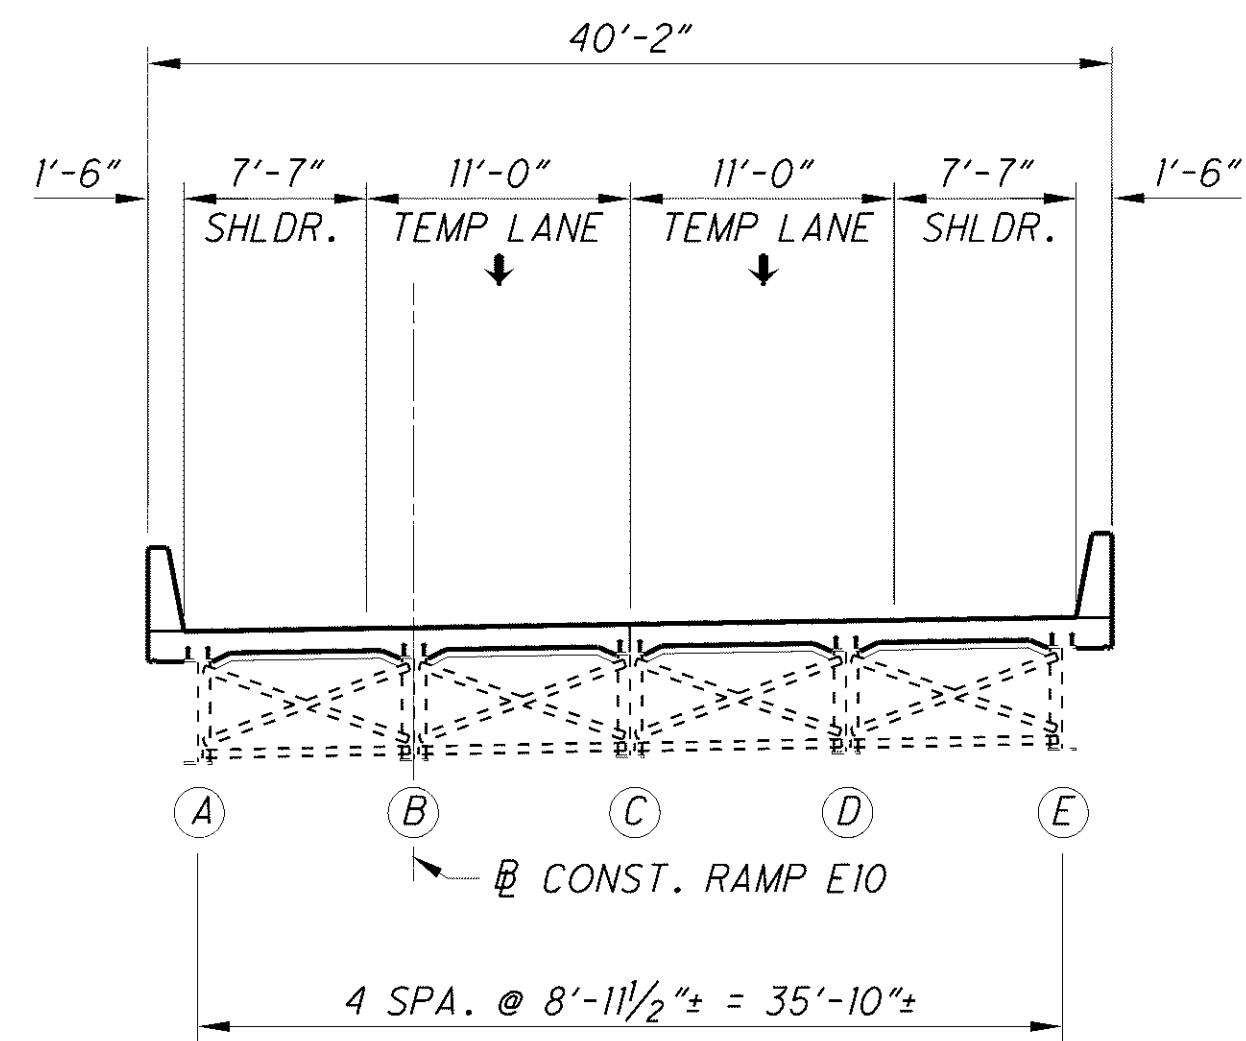


PHASE 1, STEP 3 REMOVAL

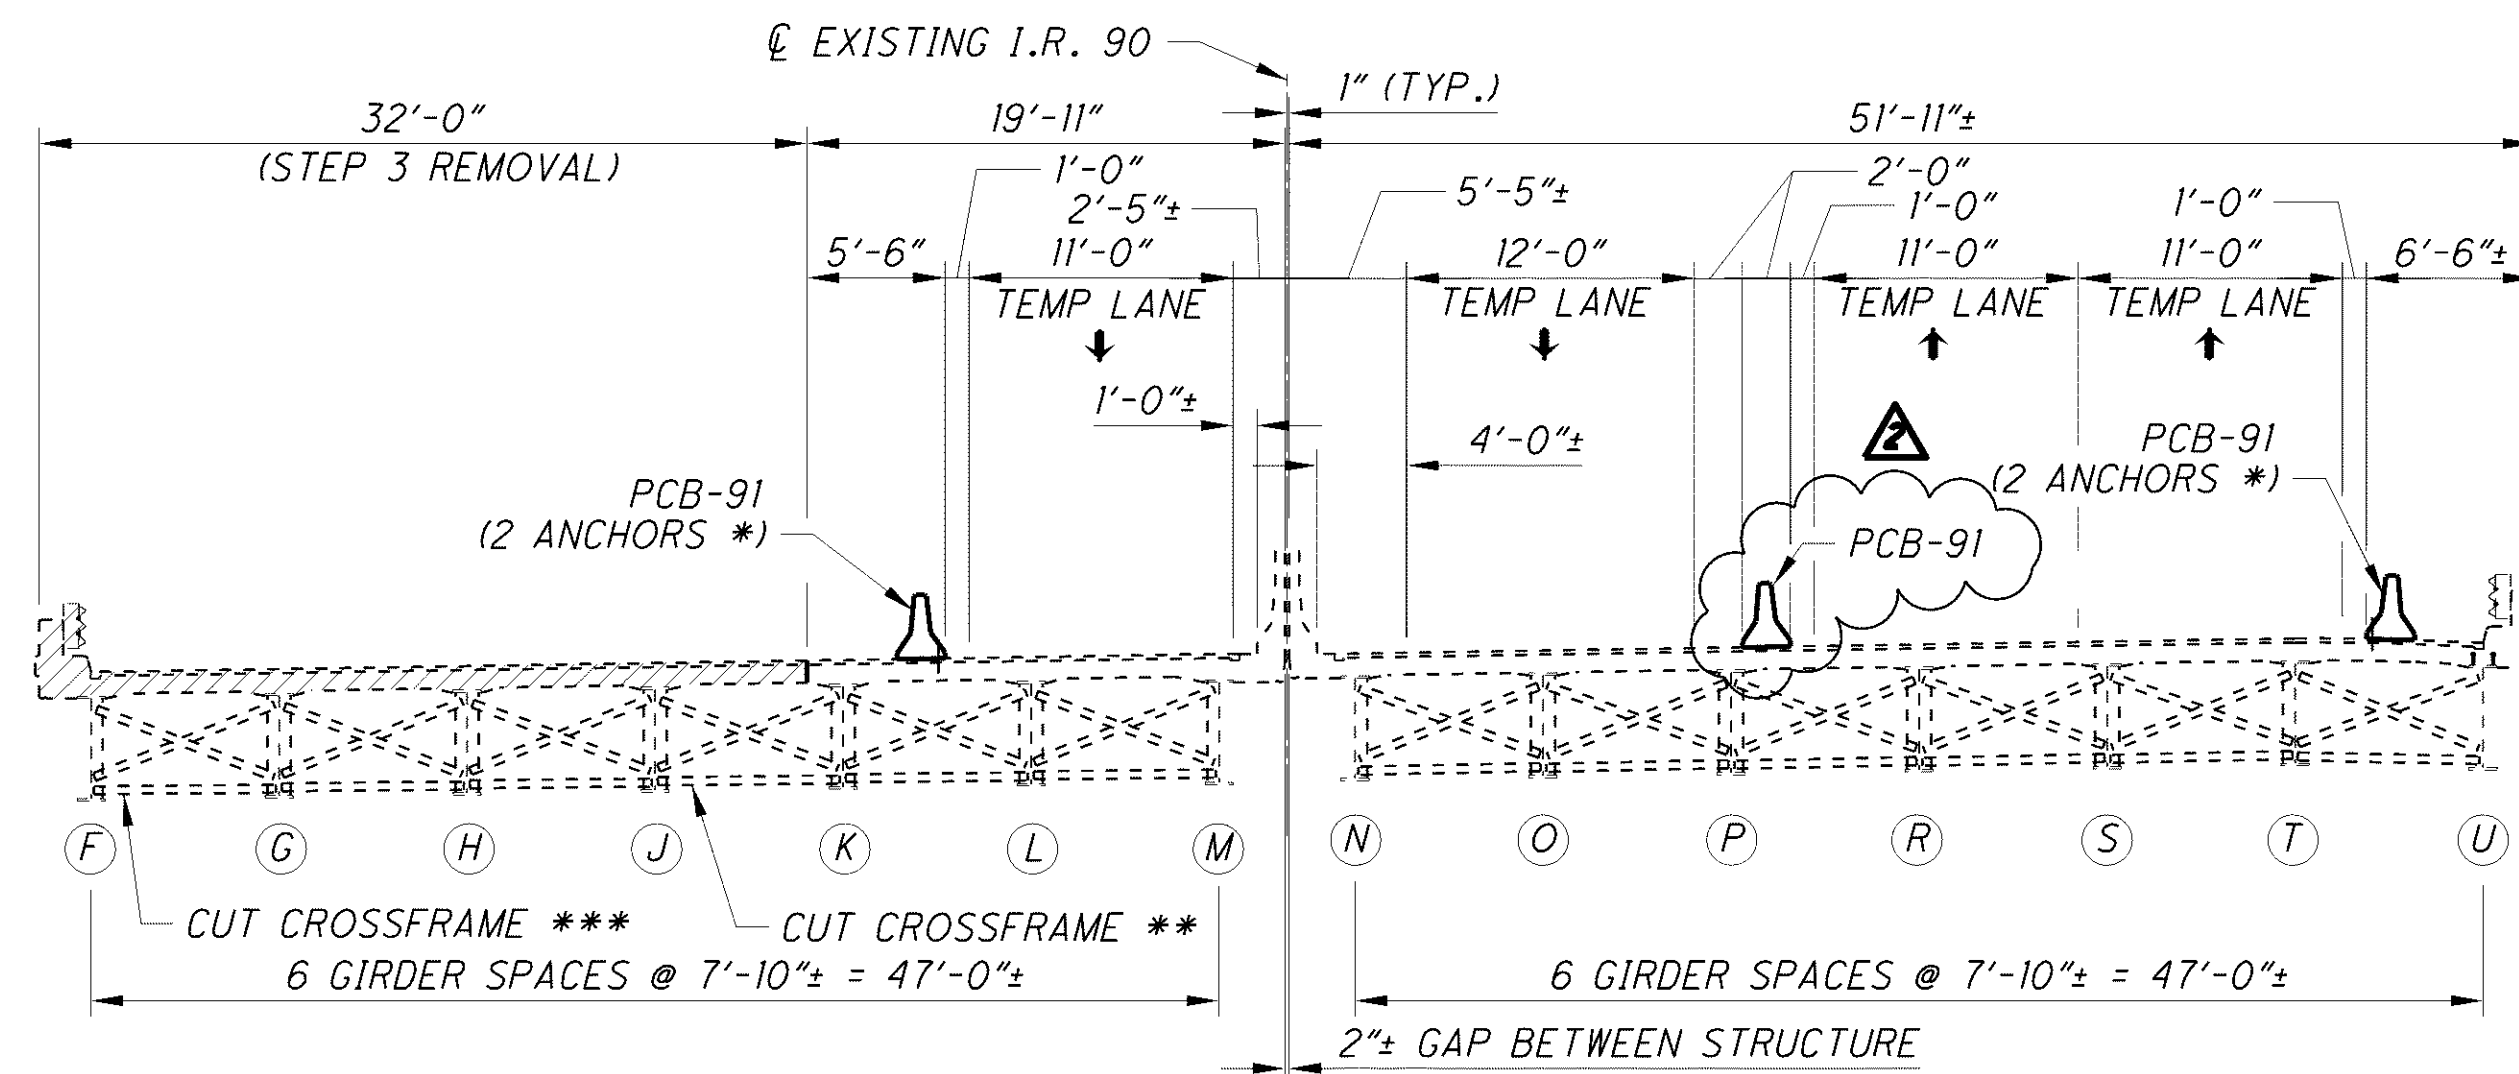



PHASE 1, STEP 3 REMOVAL

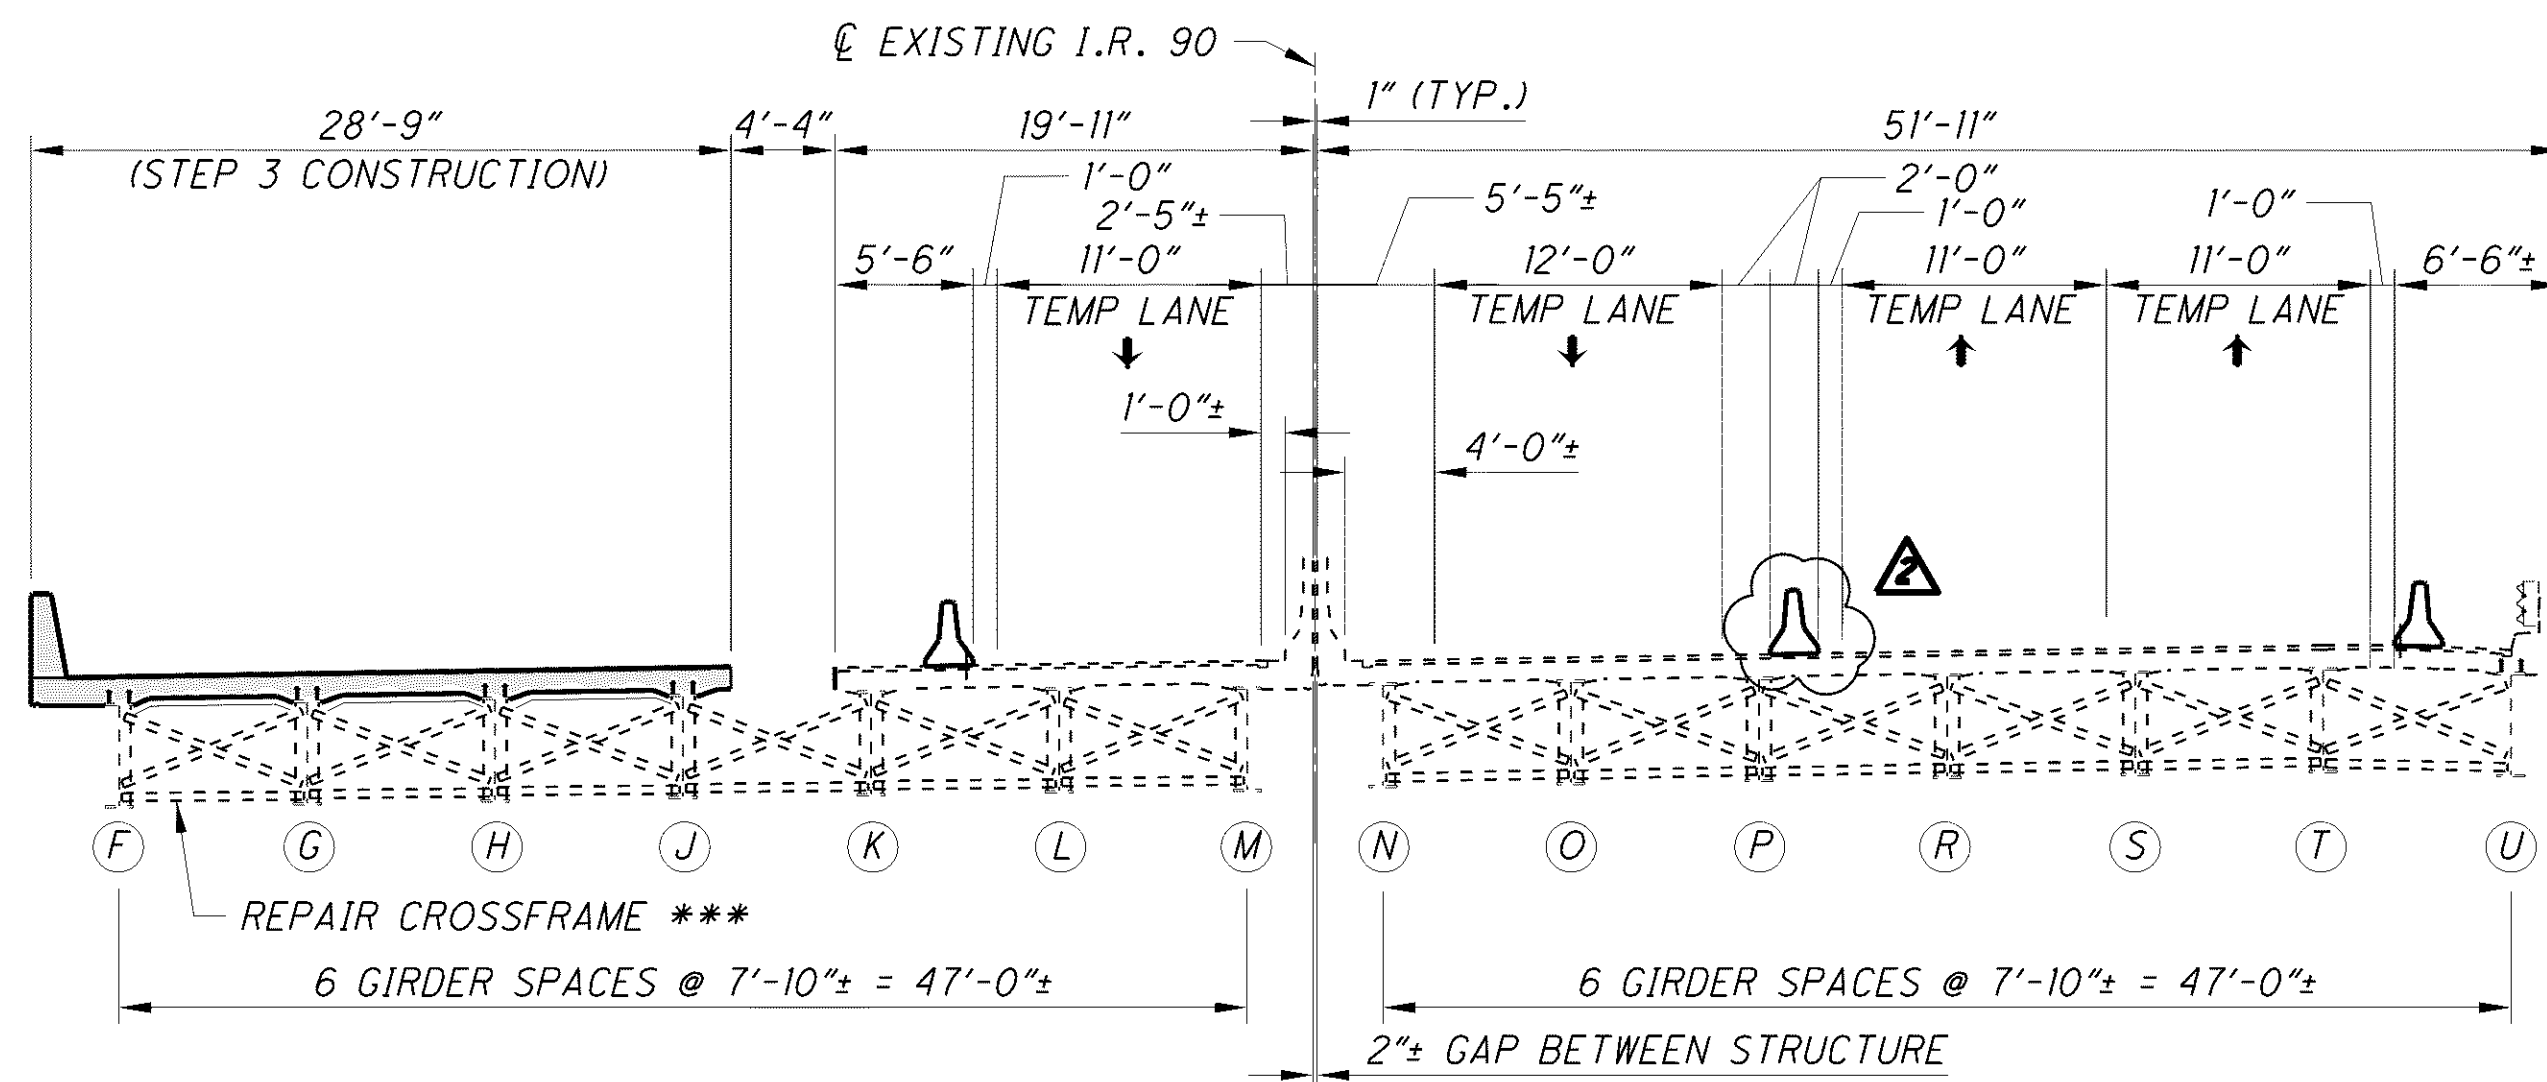

PHASE 1, STEP 3 CONSTRUCTION

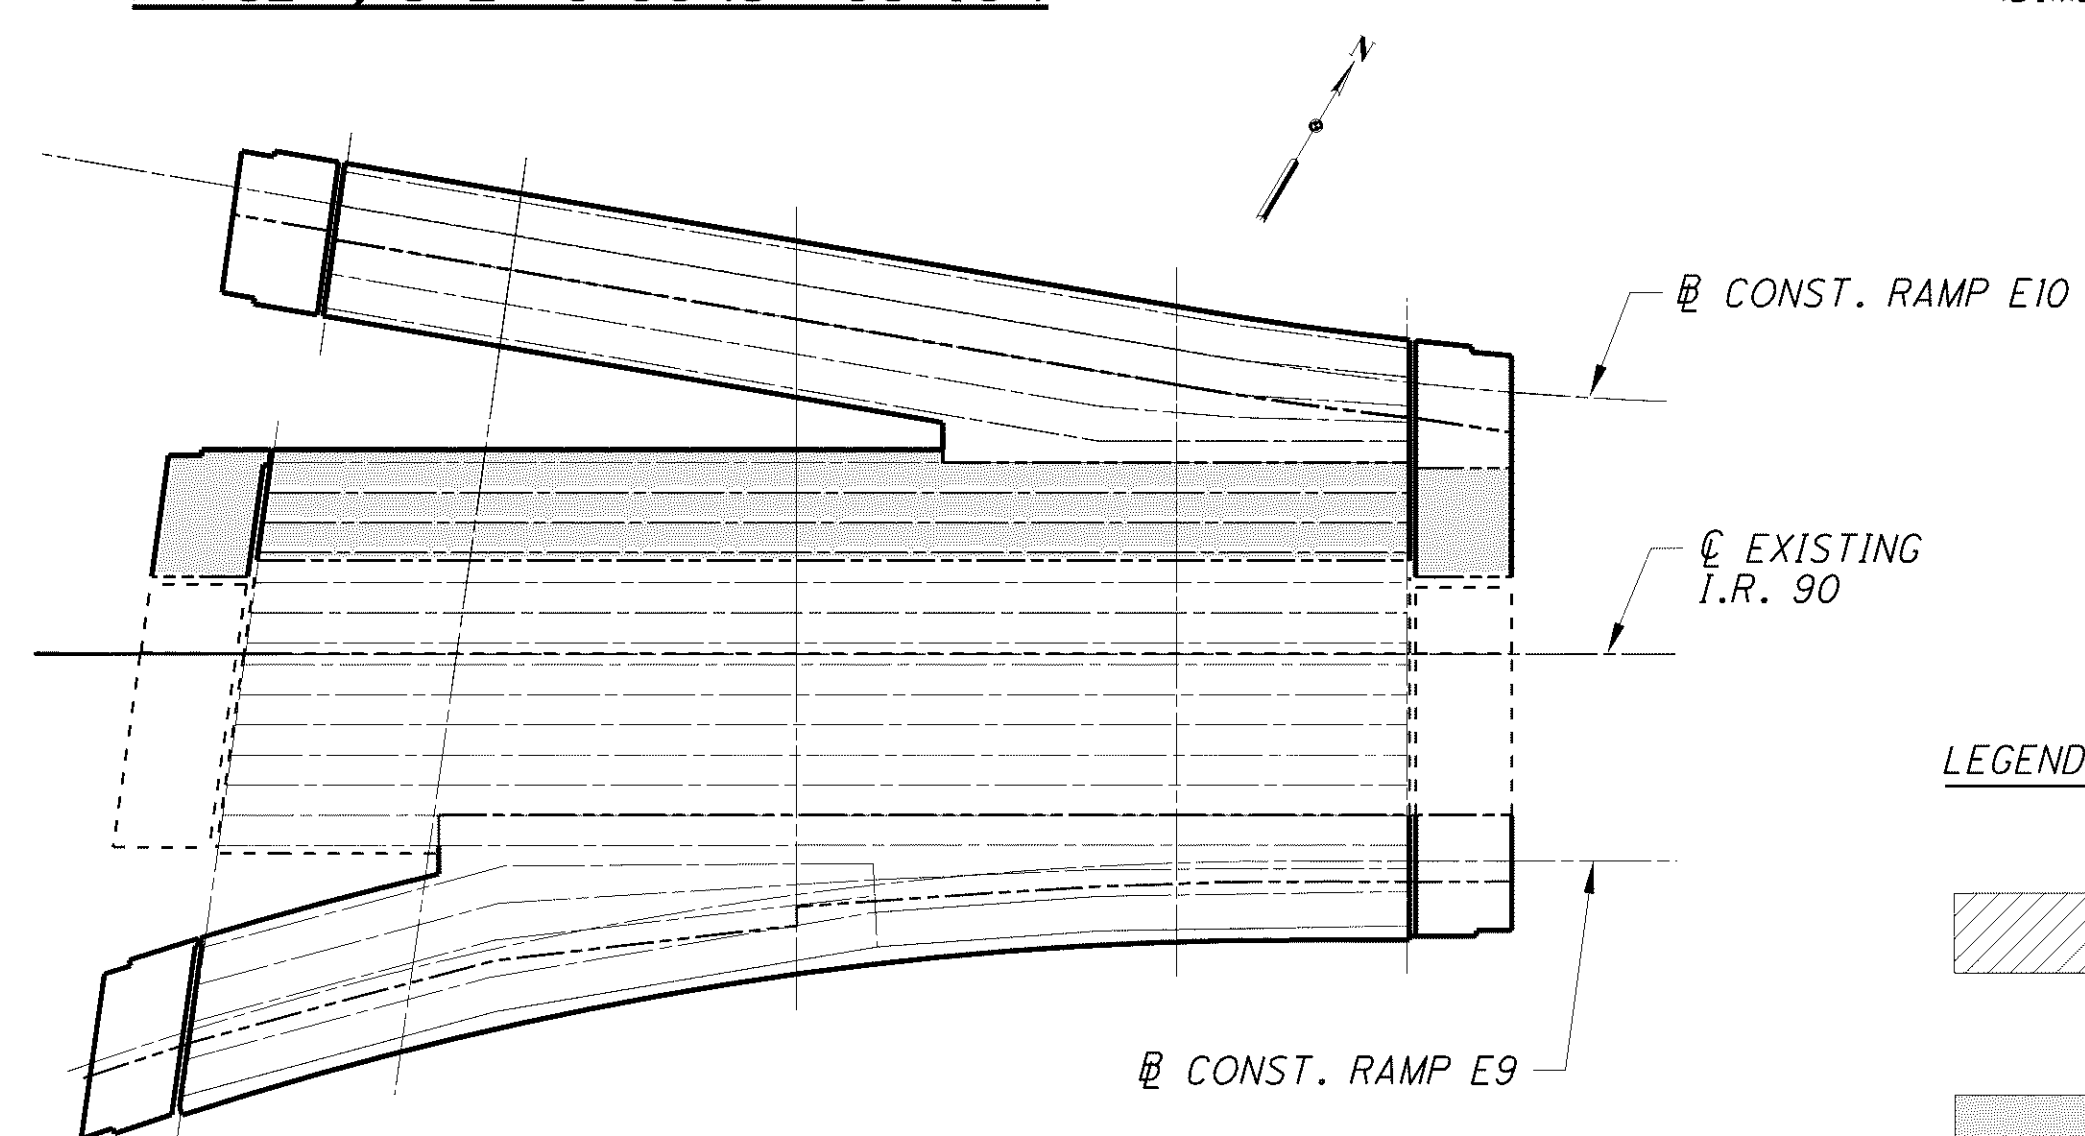


PHASE 1, STEP 3 CONSTRUCTION

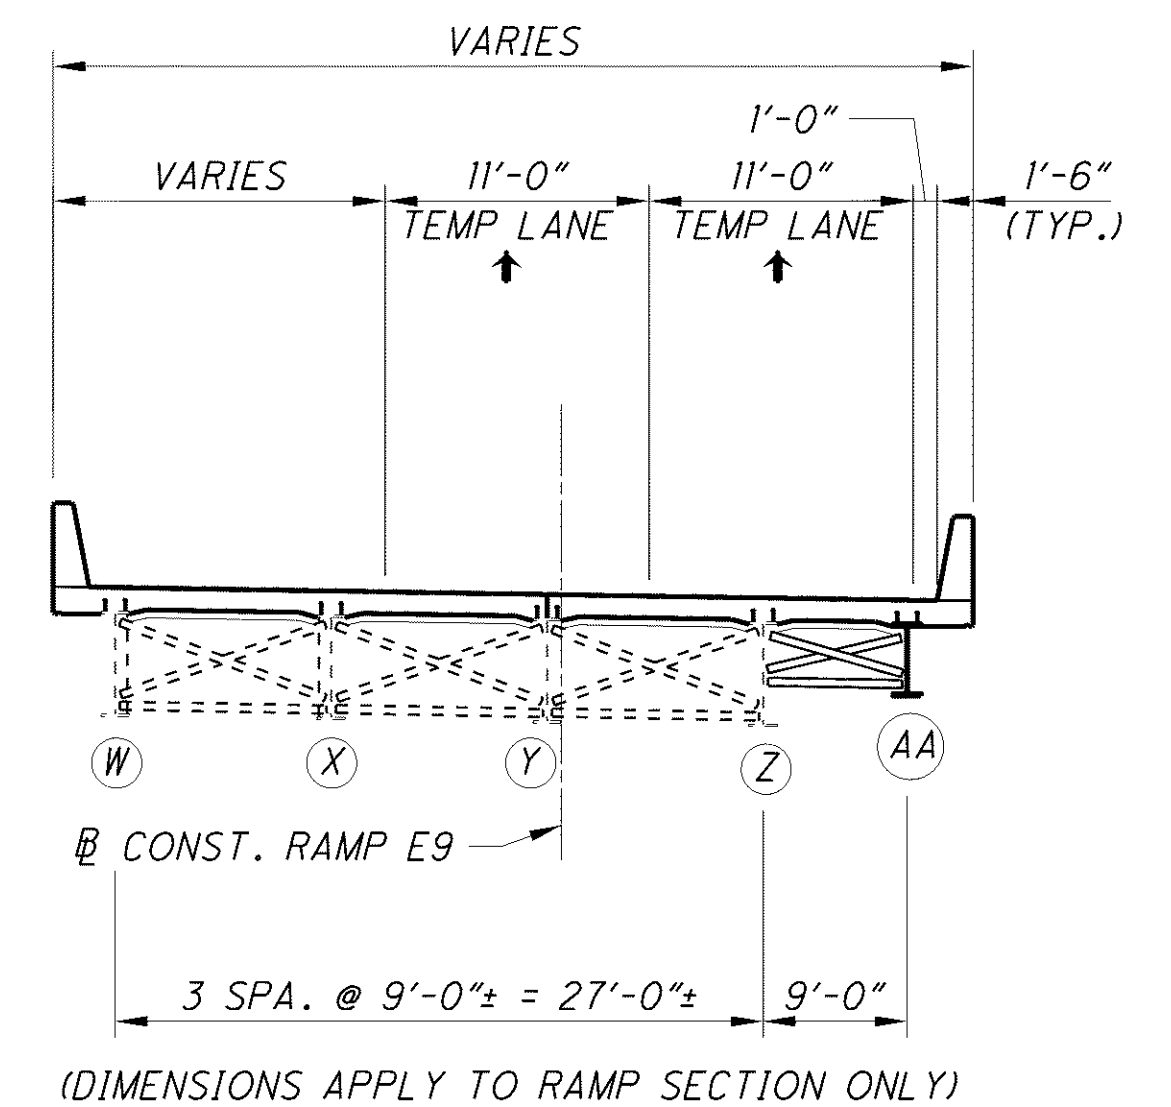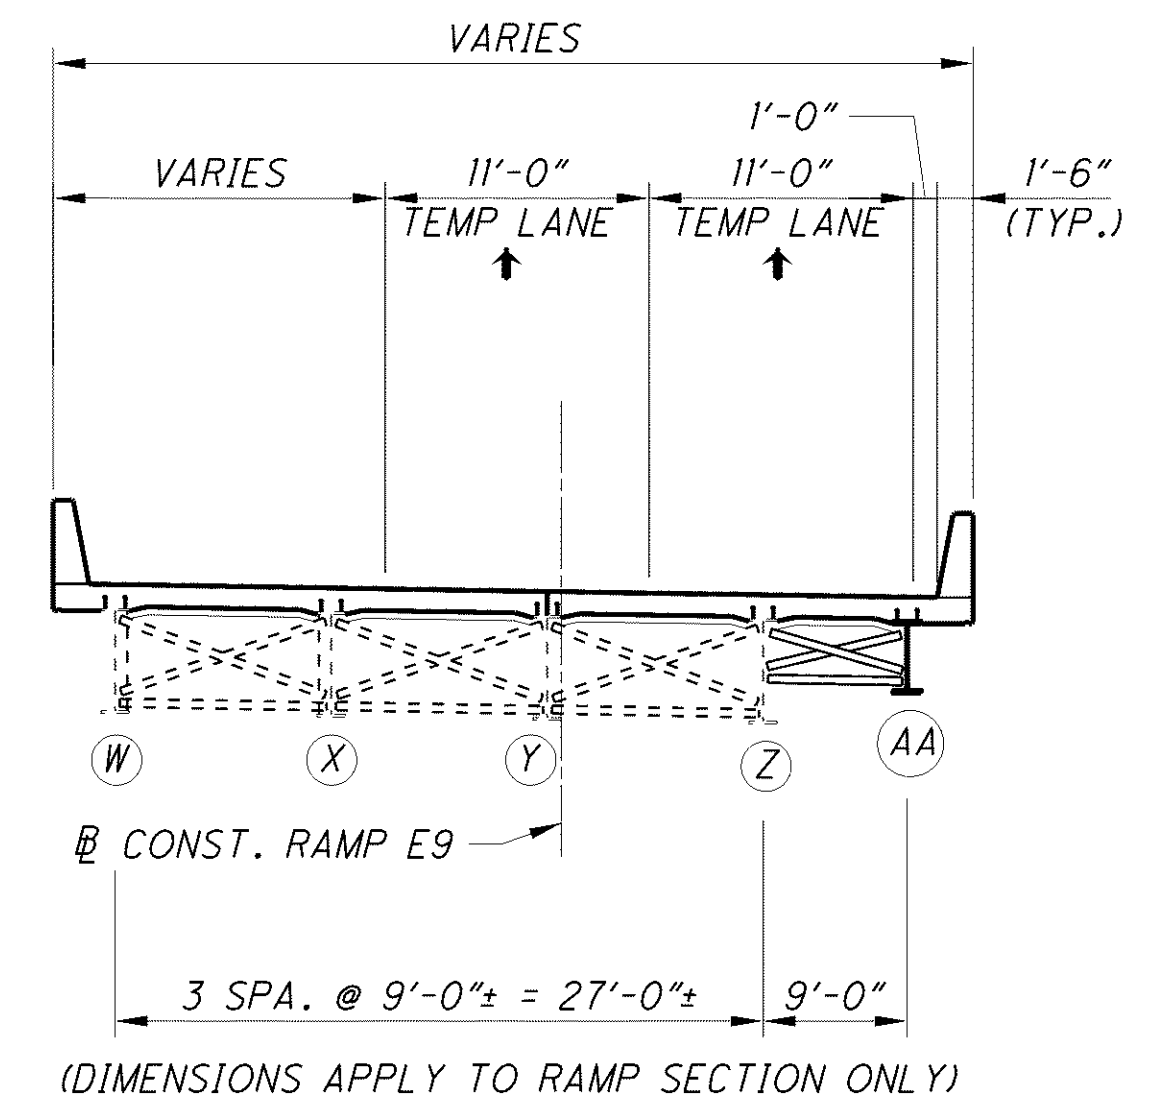

- * NUMBER OF PARTIAL DEPTH ANCHOR BOLTS PER SEGMENT (INCLUDES PCB-91 ON APPROACH SLABS)
- ** SPANS 2 AND 3 ONLY (CROSSFRAMES)
- *** PORTIONS OF SPAN 3 ONLY (SHEAR CONNECTORS)

LEGEND:

 INDICATES AREA TO BE REMOVED PER ITEM 202, PORTIONS OF STRUCTURE REMOVED, OVER 20 FOOT SPAN, AS PER PLAN.

 INDICATES AREA TO BE CONSTRUCTED.

NOTE:

1. FOR ADDITIONAL NOTES, SEE SHEET 7/38.

DESIGNED/	DATE	REVISIONS	NO.	RECORD DRAWINGS	DATE
DRWN/	JUL 03-11-11				01-29-13
RSB	STRUCTURE FILE NUMBER				
CHECKED	1807919/1807900/1807803				
NJ					
DESIGNED/	DATE	REVISIONS	NO.	RECORD DRAWINGS	DATE
DRWN/	JUL 03-11-11				01-29-13
RSB	STRUCTURE FILE NUMBER				
CHECKED	1807919/1807900/1807803				
NJ					

BRIDGE 10

BRIDGE 11

BRIDGE 12

PHASE CONSTRUCTION DETAILS - 4

BRIDGE NO. CUY-77-1597 L AND CUY-90-1651 L/R







I-90 EB, I-90WB AND I-77SB RAMP OVER E 14TH STREET

CUY-90-14.90

PID No. 77332 / 85531

90


38

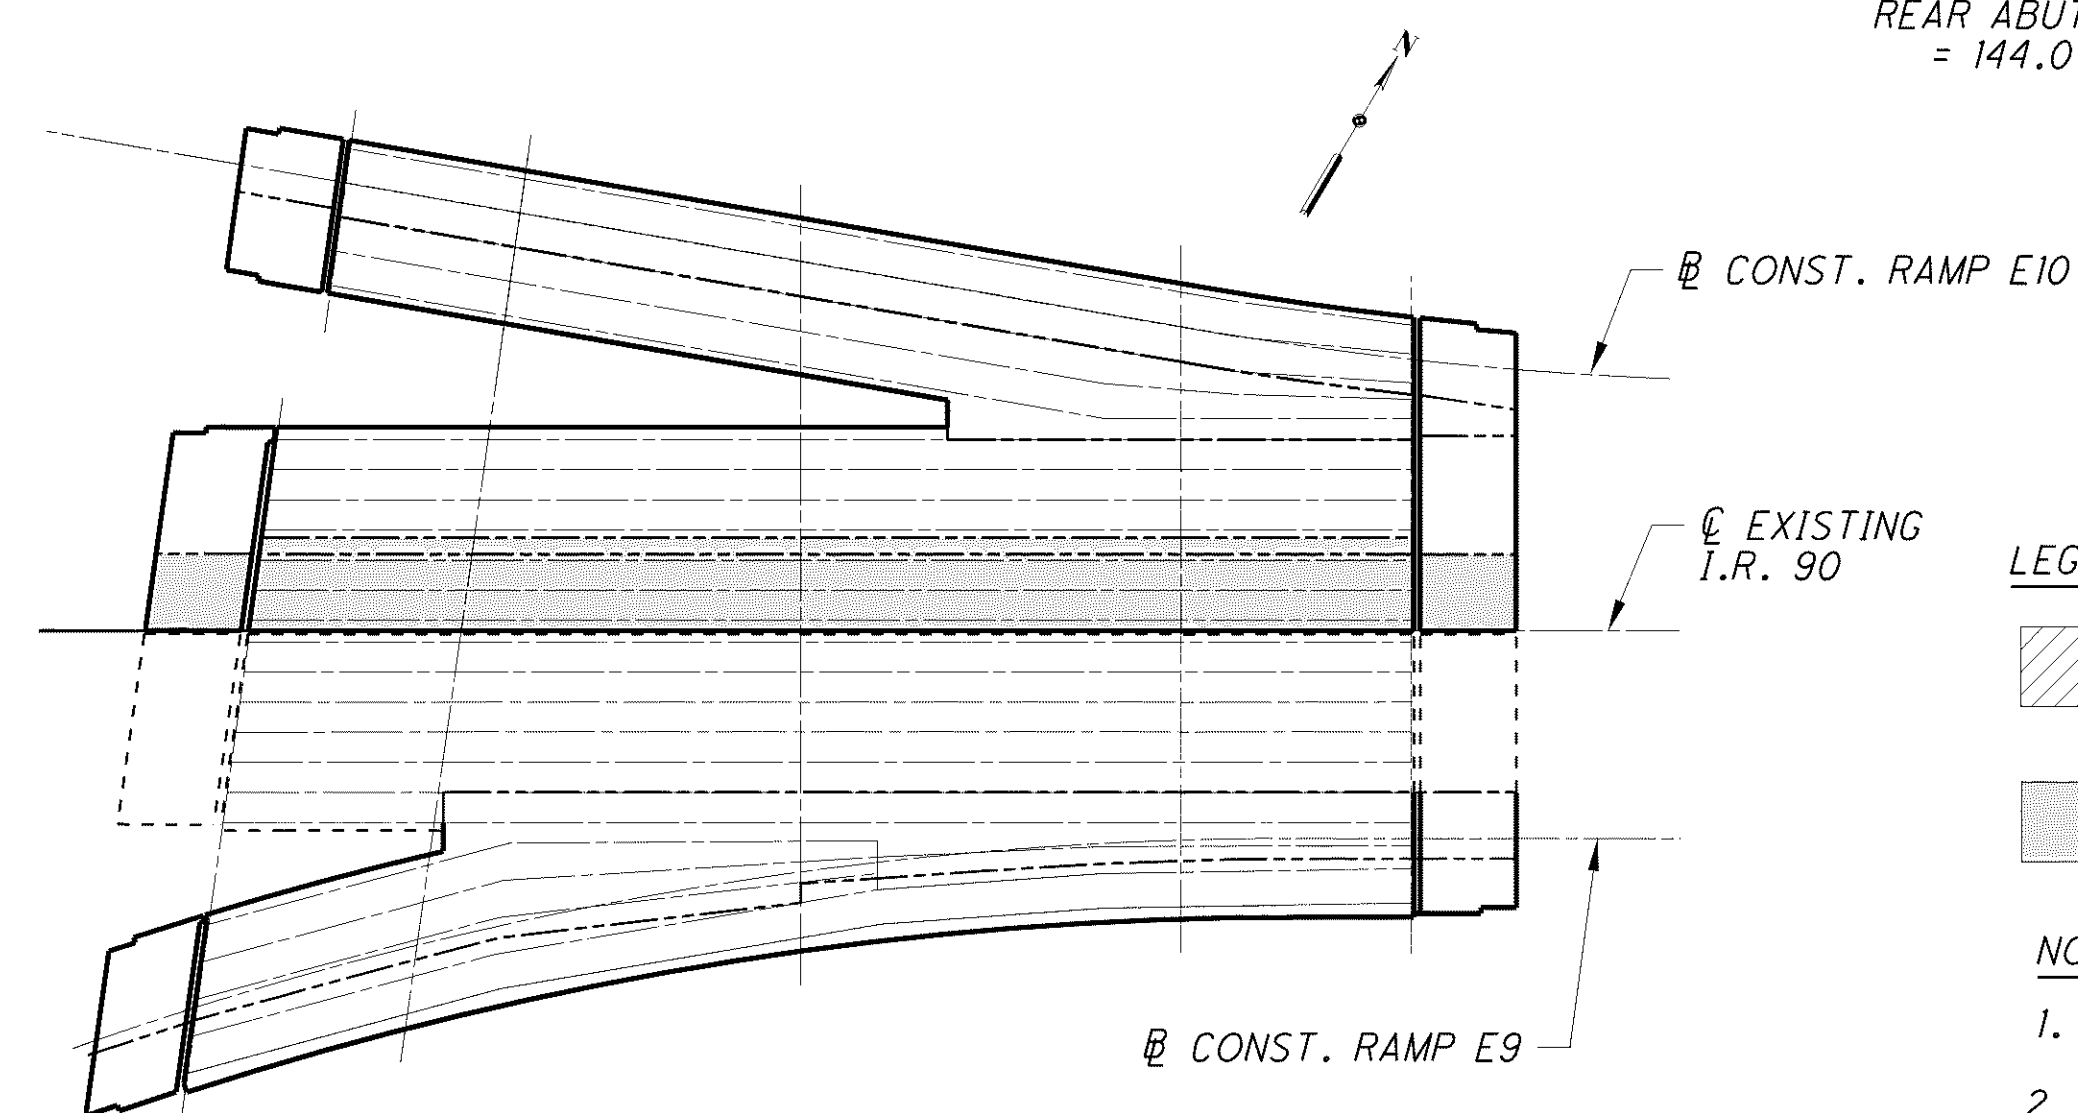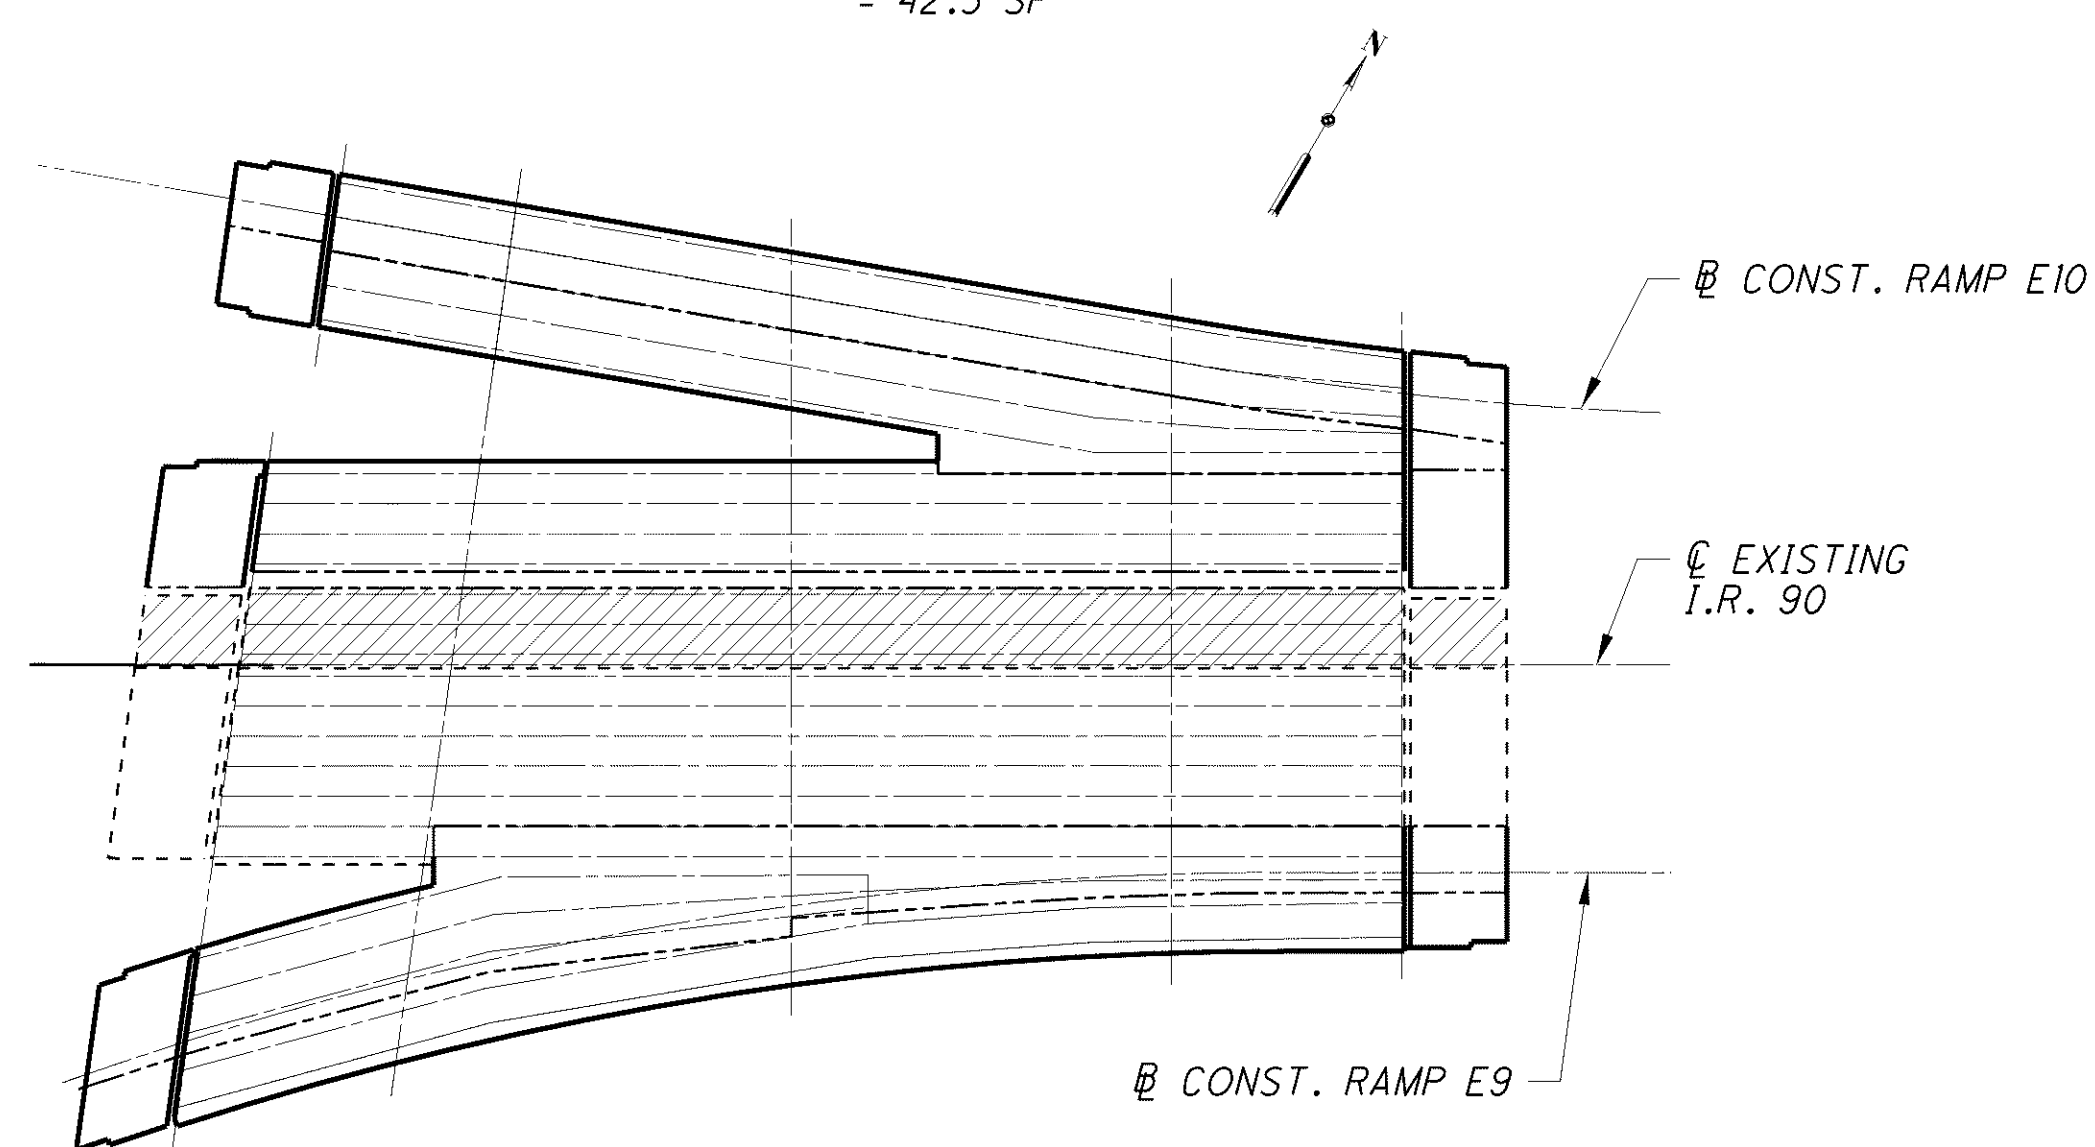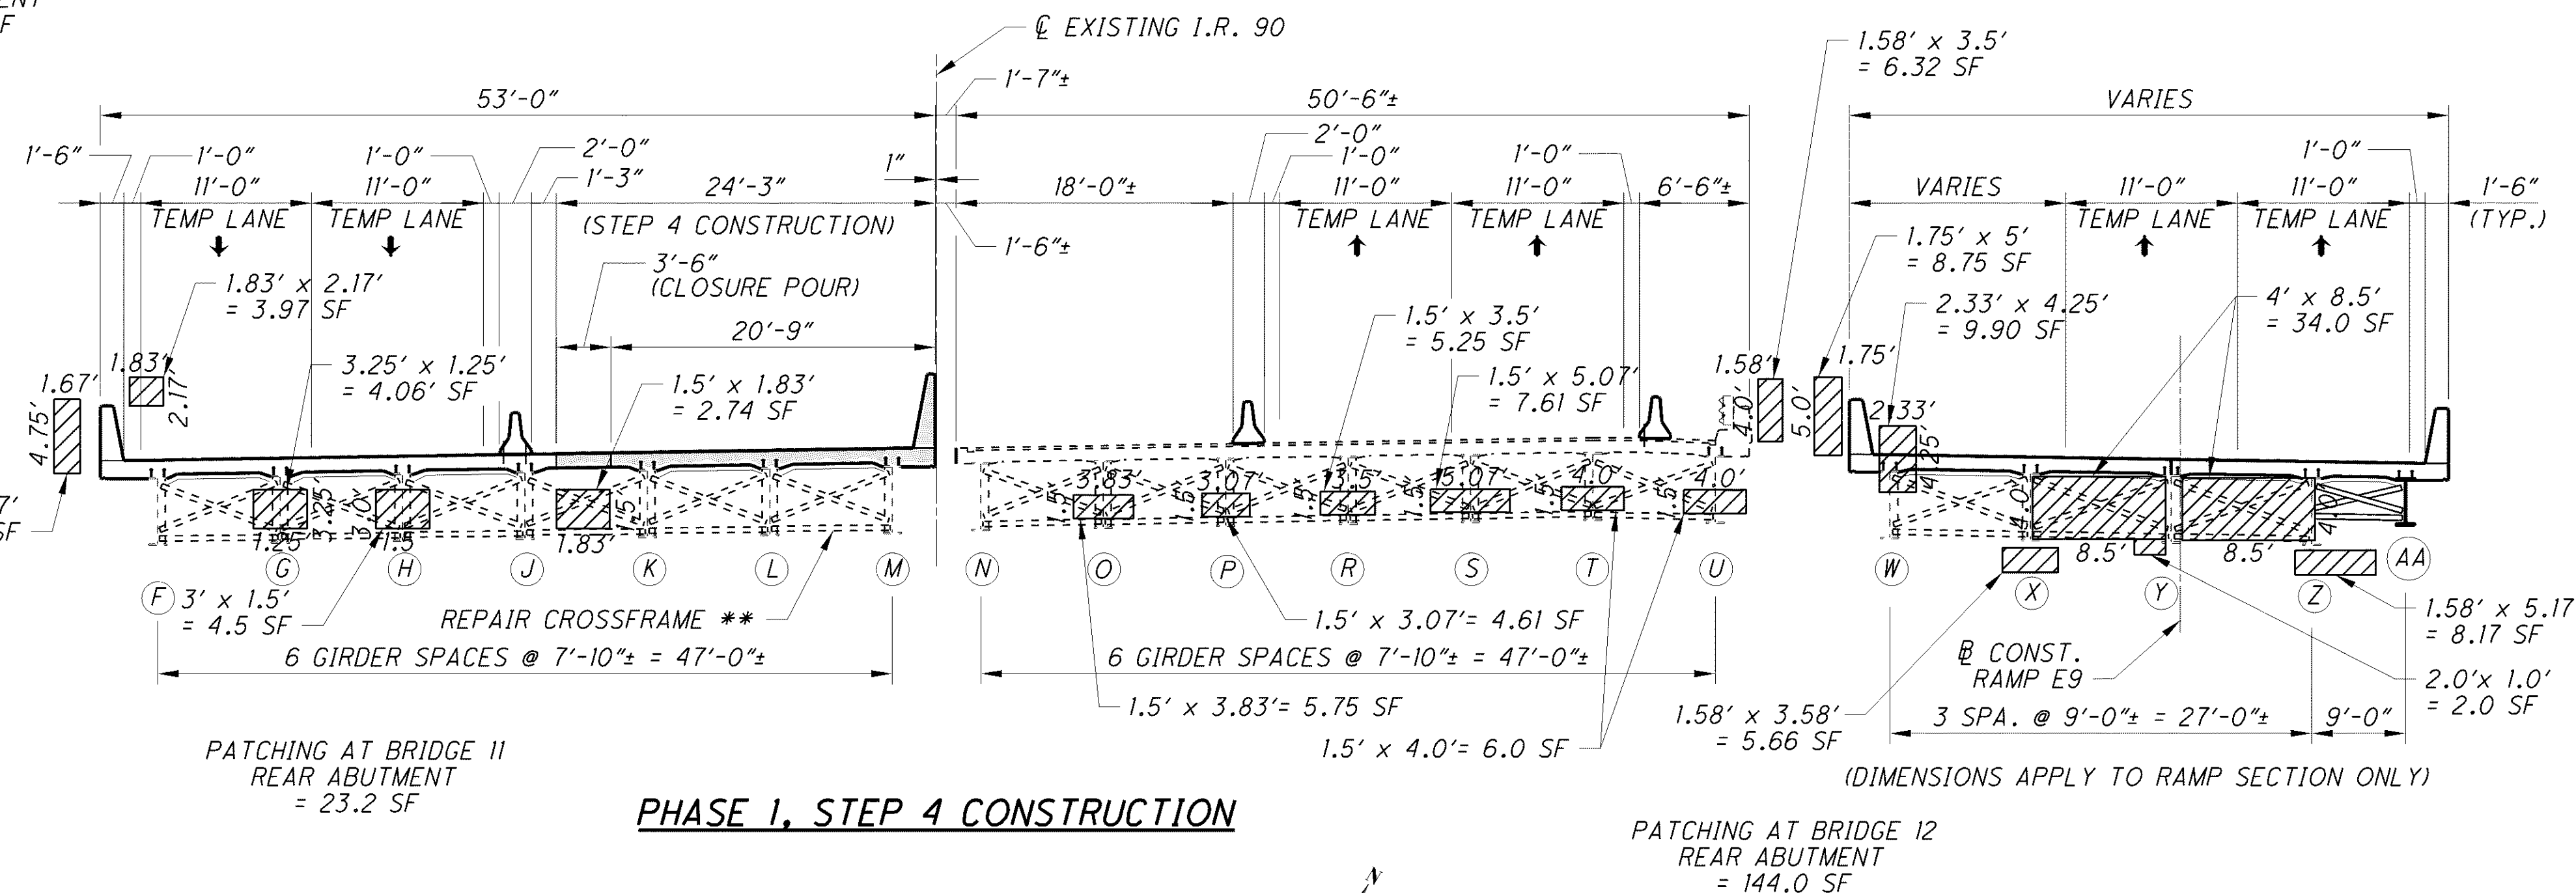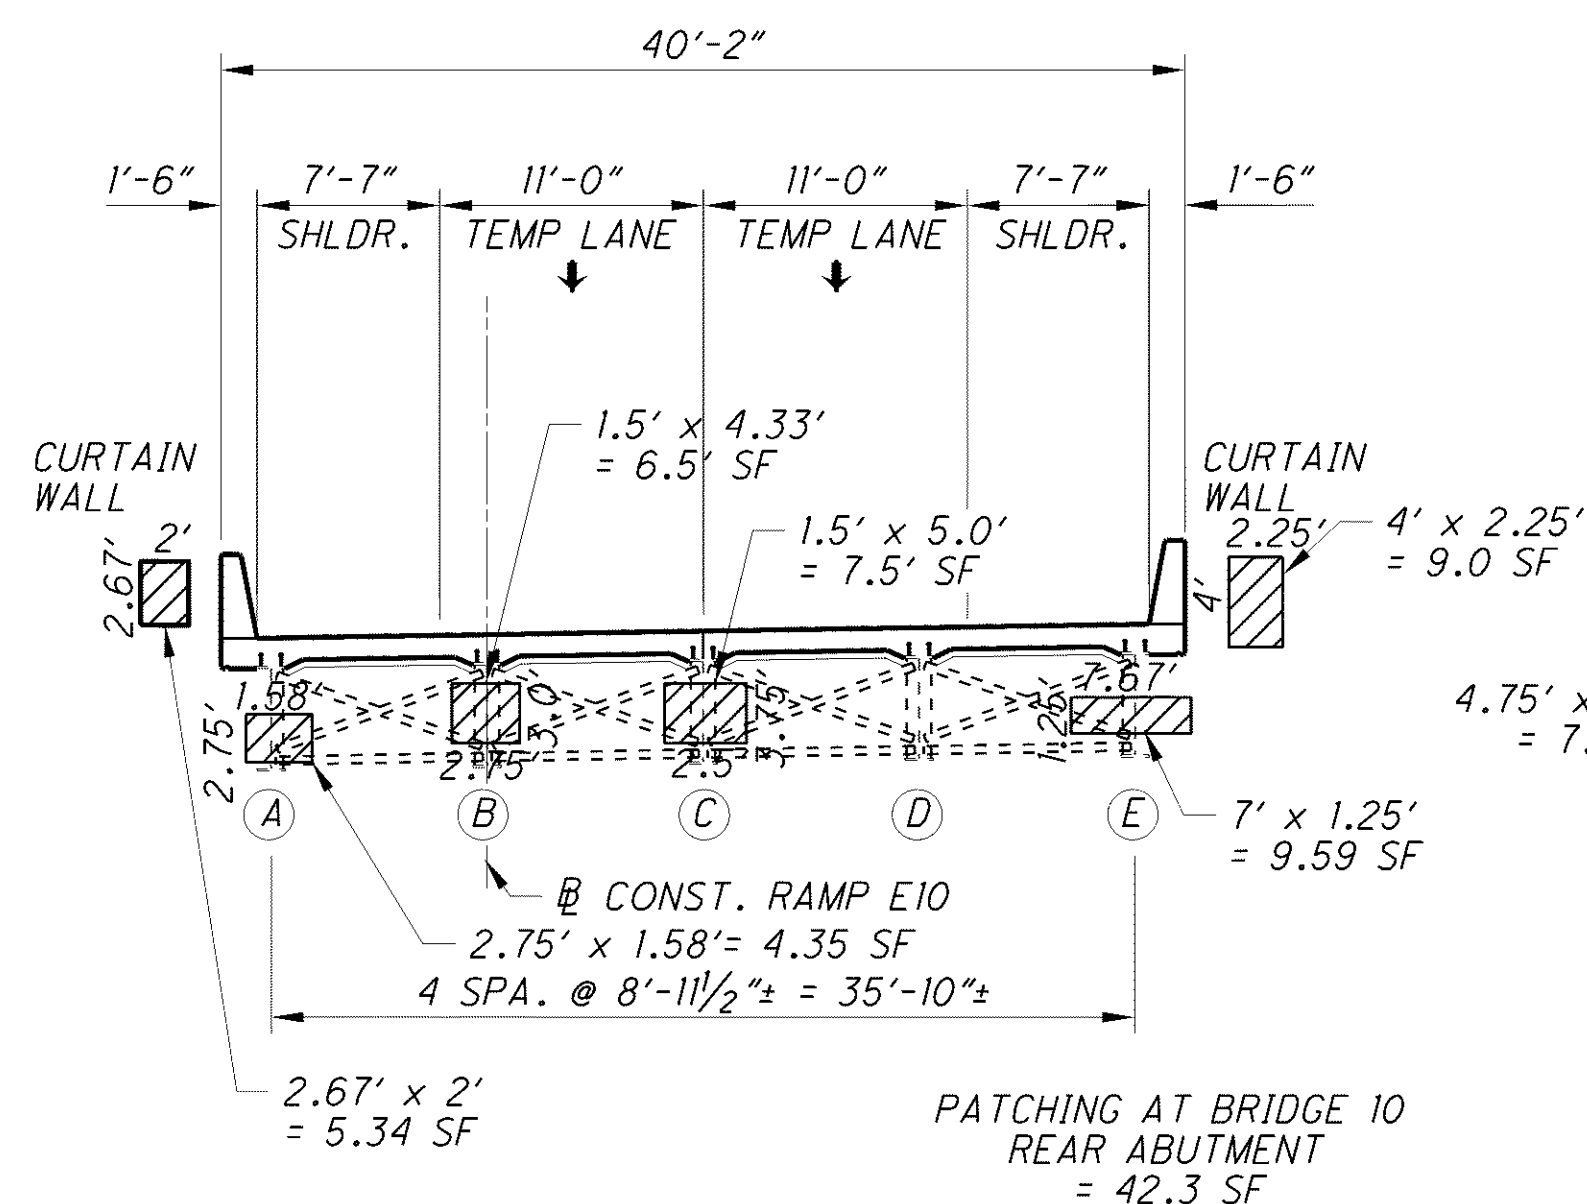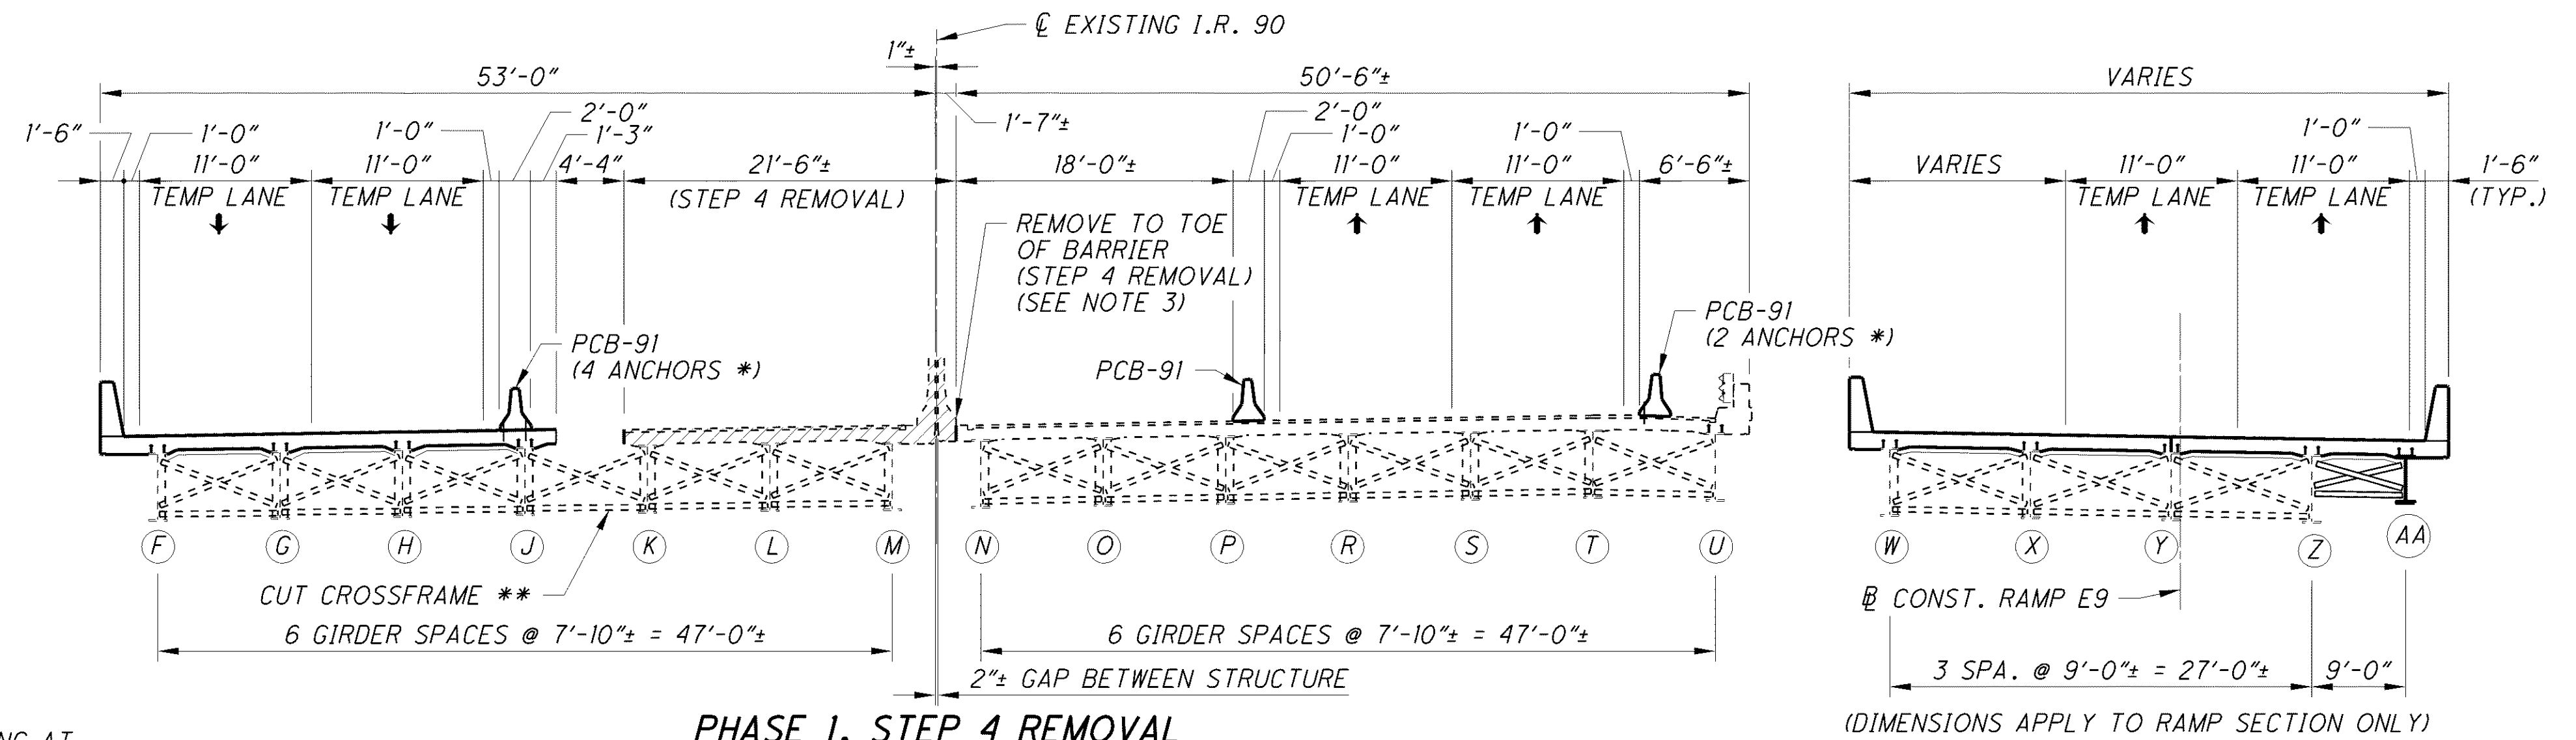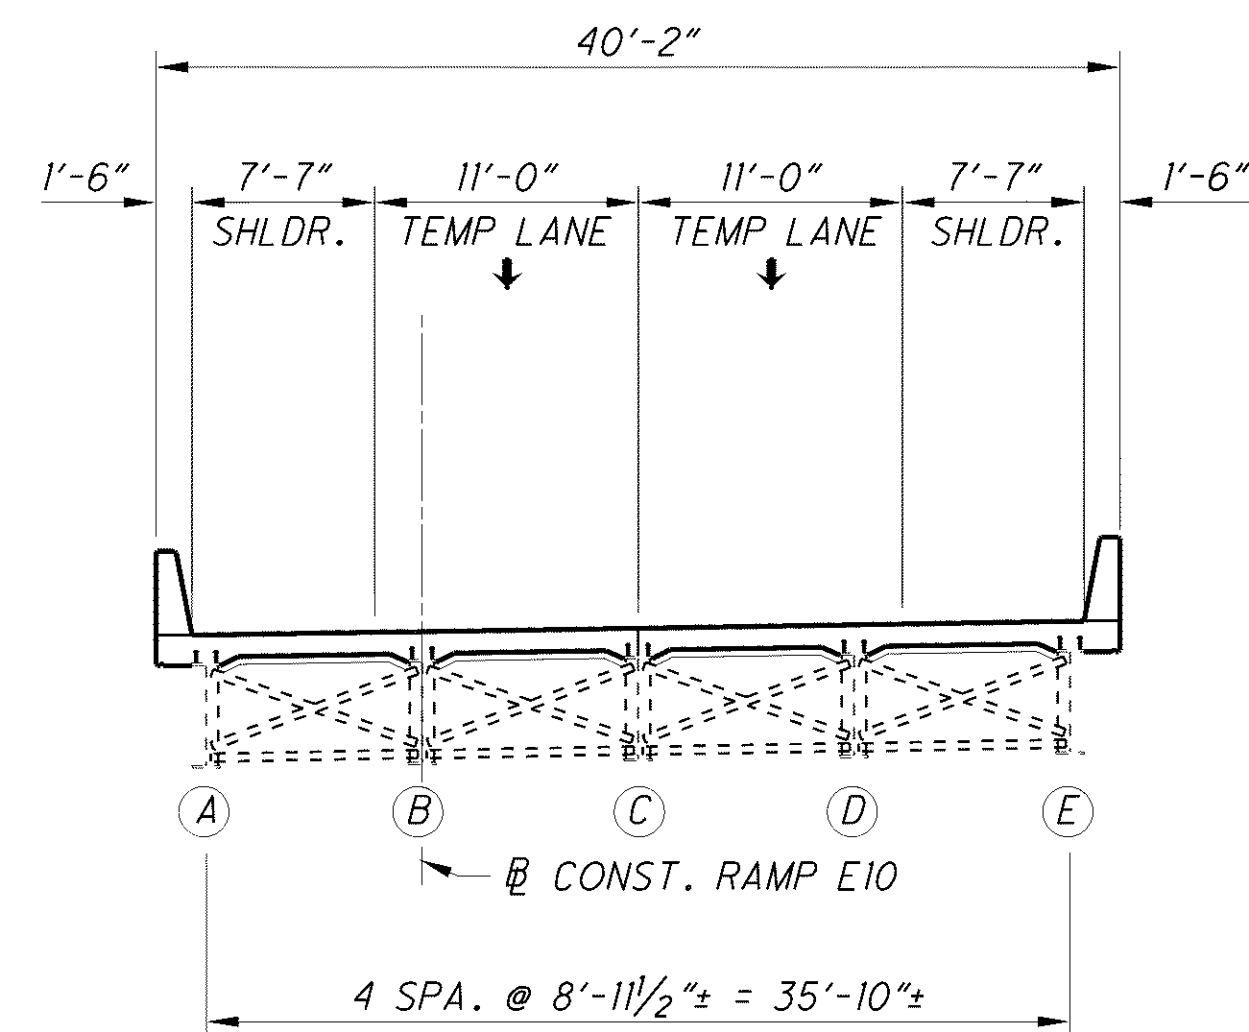

* NUMBER OF PARTIAL DEPTH ANCHOR BOLTS PER SEGMENT (INCLUDES PCB-91 ON APPROACH SLABS)

** SPANS 2 AND 3 ONLY (CROSSFRAMES)

LEGEND:

 INDICATES AREA TO BE REMOVED PER ITEM 202, PORTIONS OF STRUCTURE REMOVED, OVER 20 FOOT SPAN, AS PER PLAN.




 INDICATES AREA TO BE CONSTRUCTED.


NOTE:

1. FOR ADDITIONAL NOTES, SEE SHEET 7/38.


2. AFTER REMOVAL OF THE PORTABLE CONCRETE BARRIER FROM THE NEW DECK, REMOVE THE PARTIAL DEPTH ANCHORS AND GROUT ANY VOIDS LEFT IN THE NEW DECK.

3. VERIFY LOCATION OF GIRDER FLANGE PRIOR TO SAWCUT OF EXISTING DECK.


DESIGNED RSB	REVIEWED JOL	DATE 03-11-11	  	WALSH DESIGN AGENCY HNTB WALSH CONSTRUCTION	NO. _____ REVISIONS _____ RECORD DRAWINGS _____ DATE 01-29-13
DRAWN RSB	CHECKED	STRUCTURE FILE NUMBER 1807919/1807900/1807803			
CHECKED	NJ	10/38			
CHECKED	NJ	10/38			
BRIDGE 10 BRIDGE 11 BRIDGE 12			PHASE CONSTRUCTION DETAILS - 5 - (REAR ABUTMENT) BRIDGE NO. CUY-77-1597 L AND CUY-90-1651 L/R I-90 EB, I-90WB AND I-77SB RAMP OVER E 14TH STREET		
CUY-90-14.90 PID No. 77332/85531					

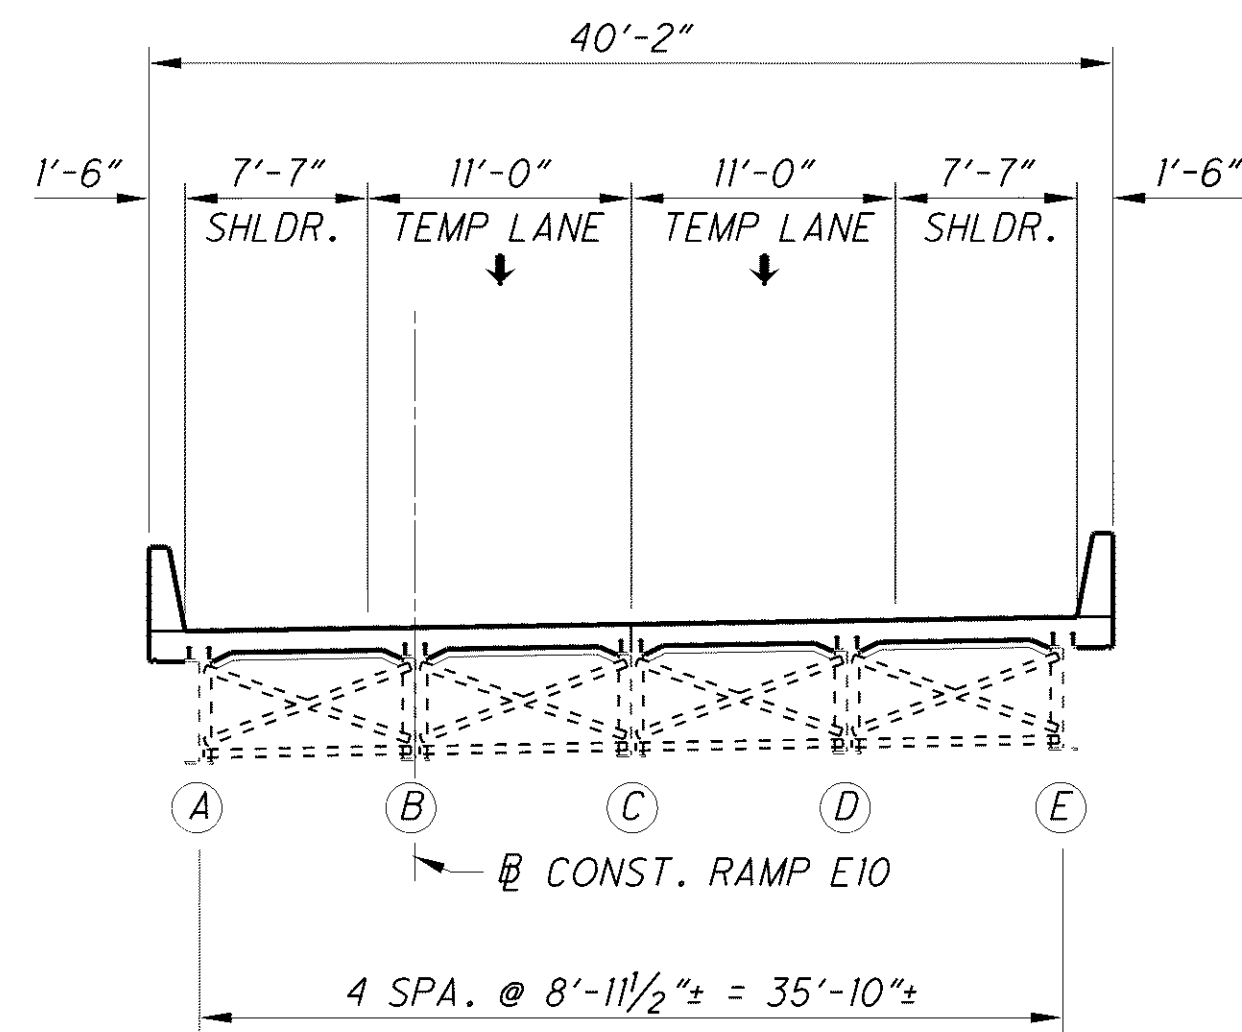


TOTAL PATCHING AT
FORWARD ABUTMENT
= 58.54 SF

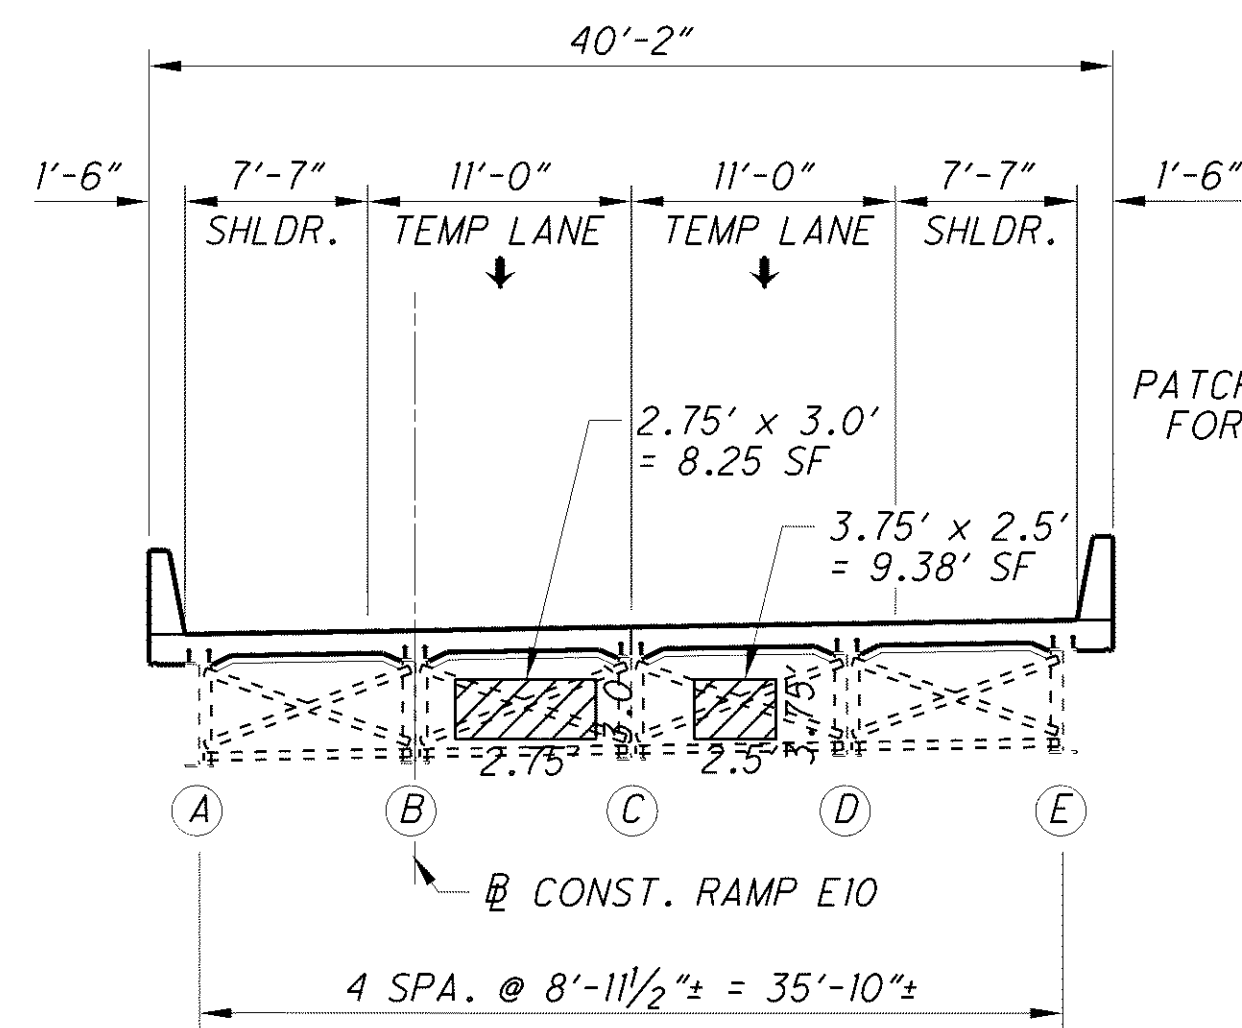


PATCHING AT BRIDGE 10
FORWARD ABUTMENT
= 17.63 SF

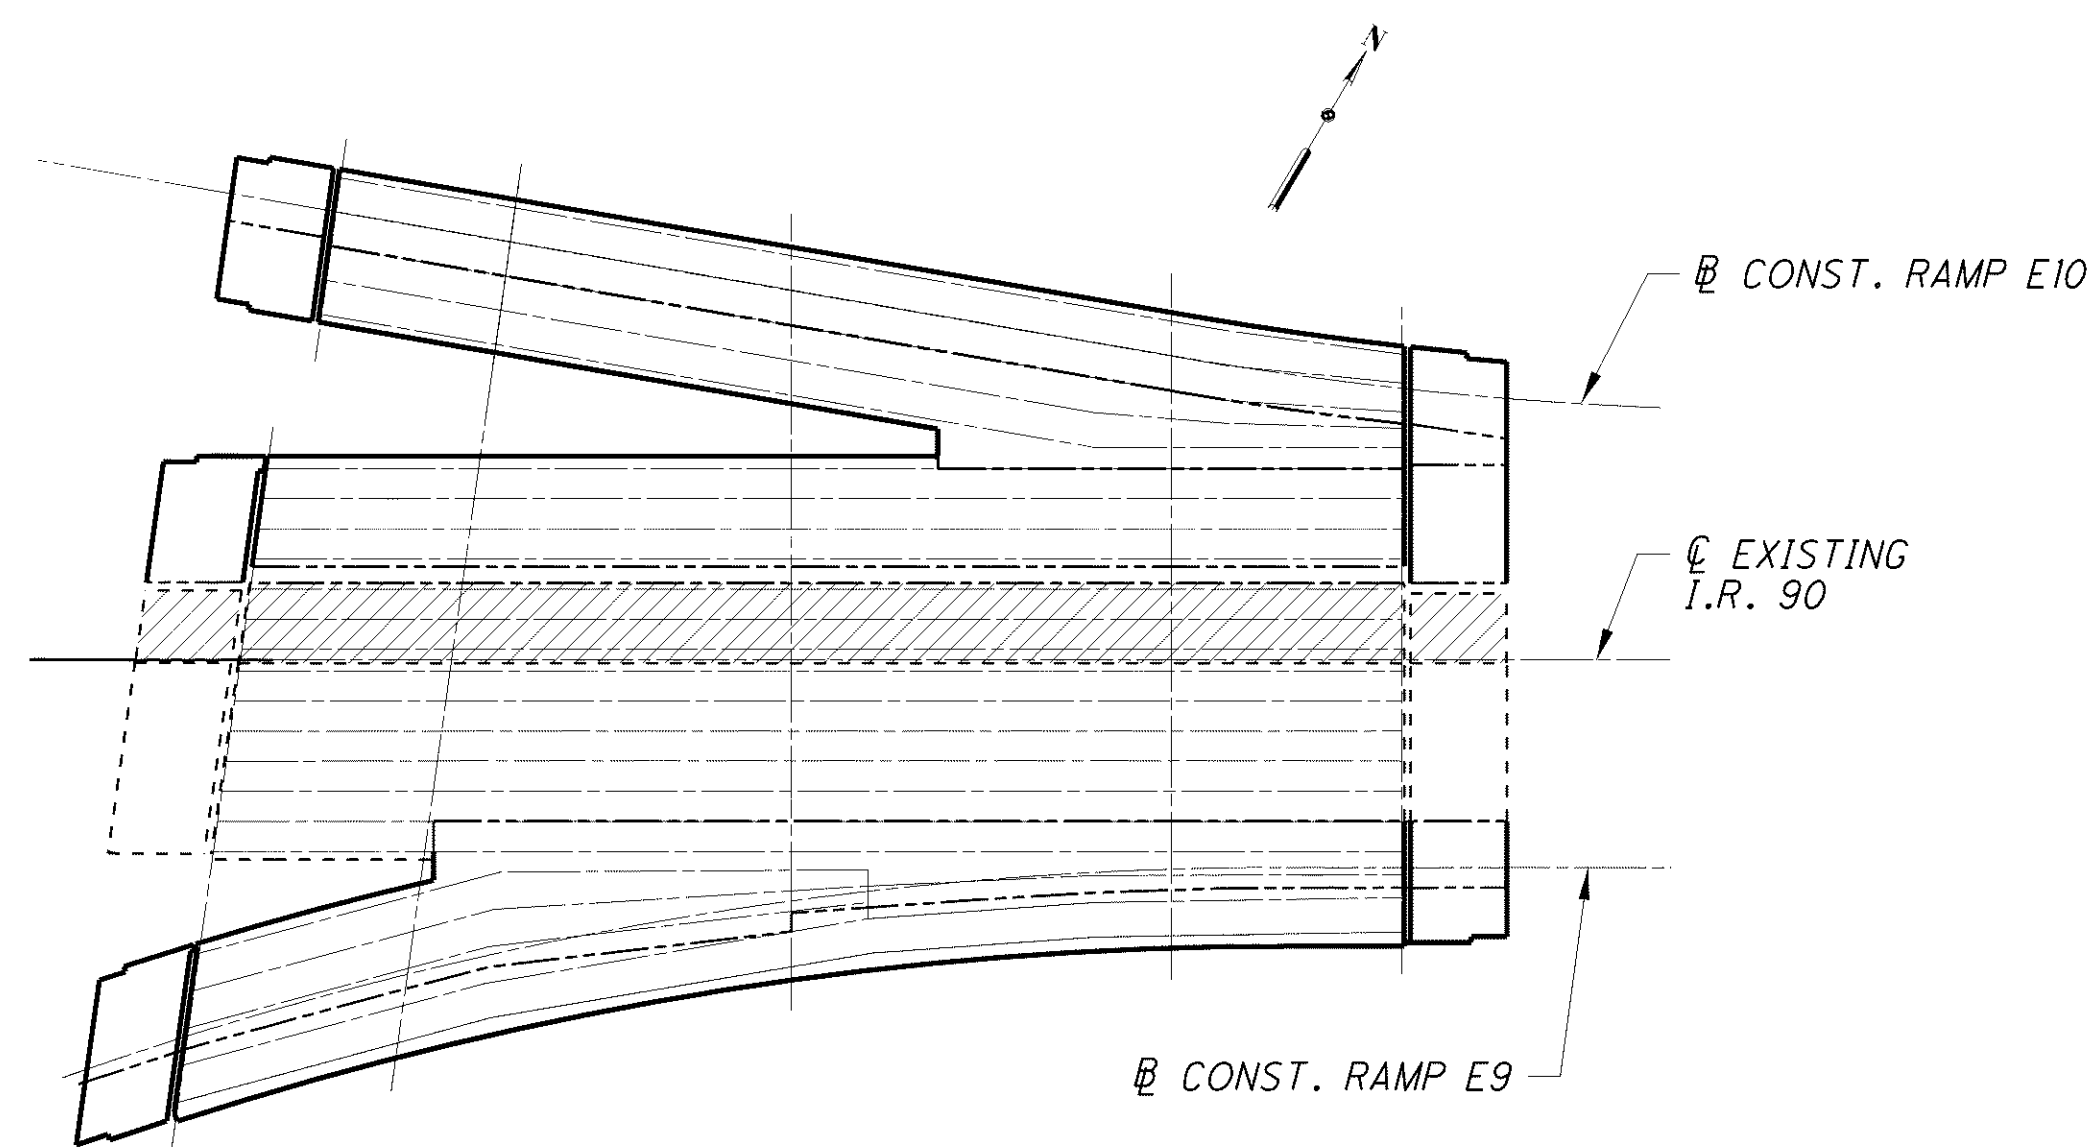

PHASE 1, STEP 4 REMOVAL

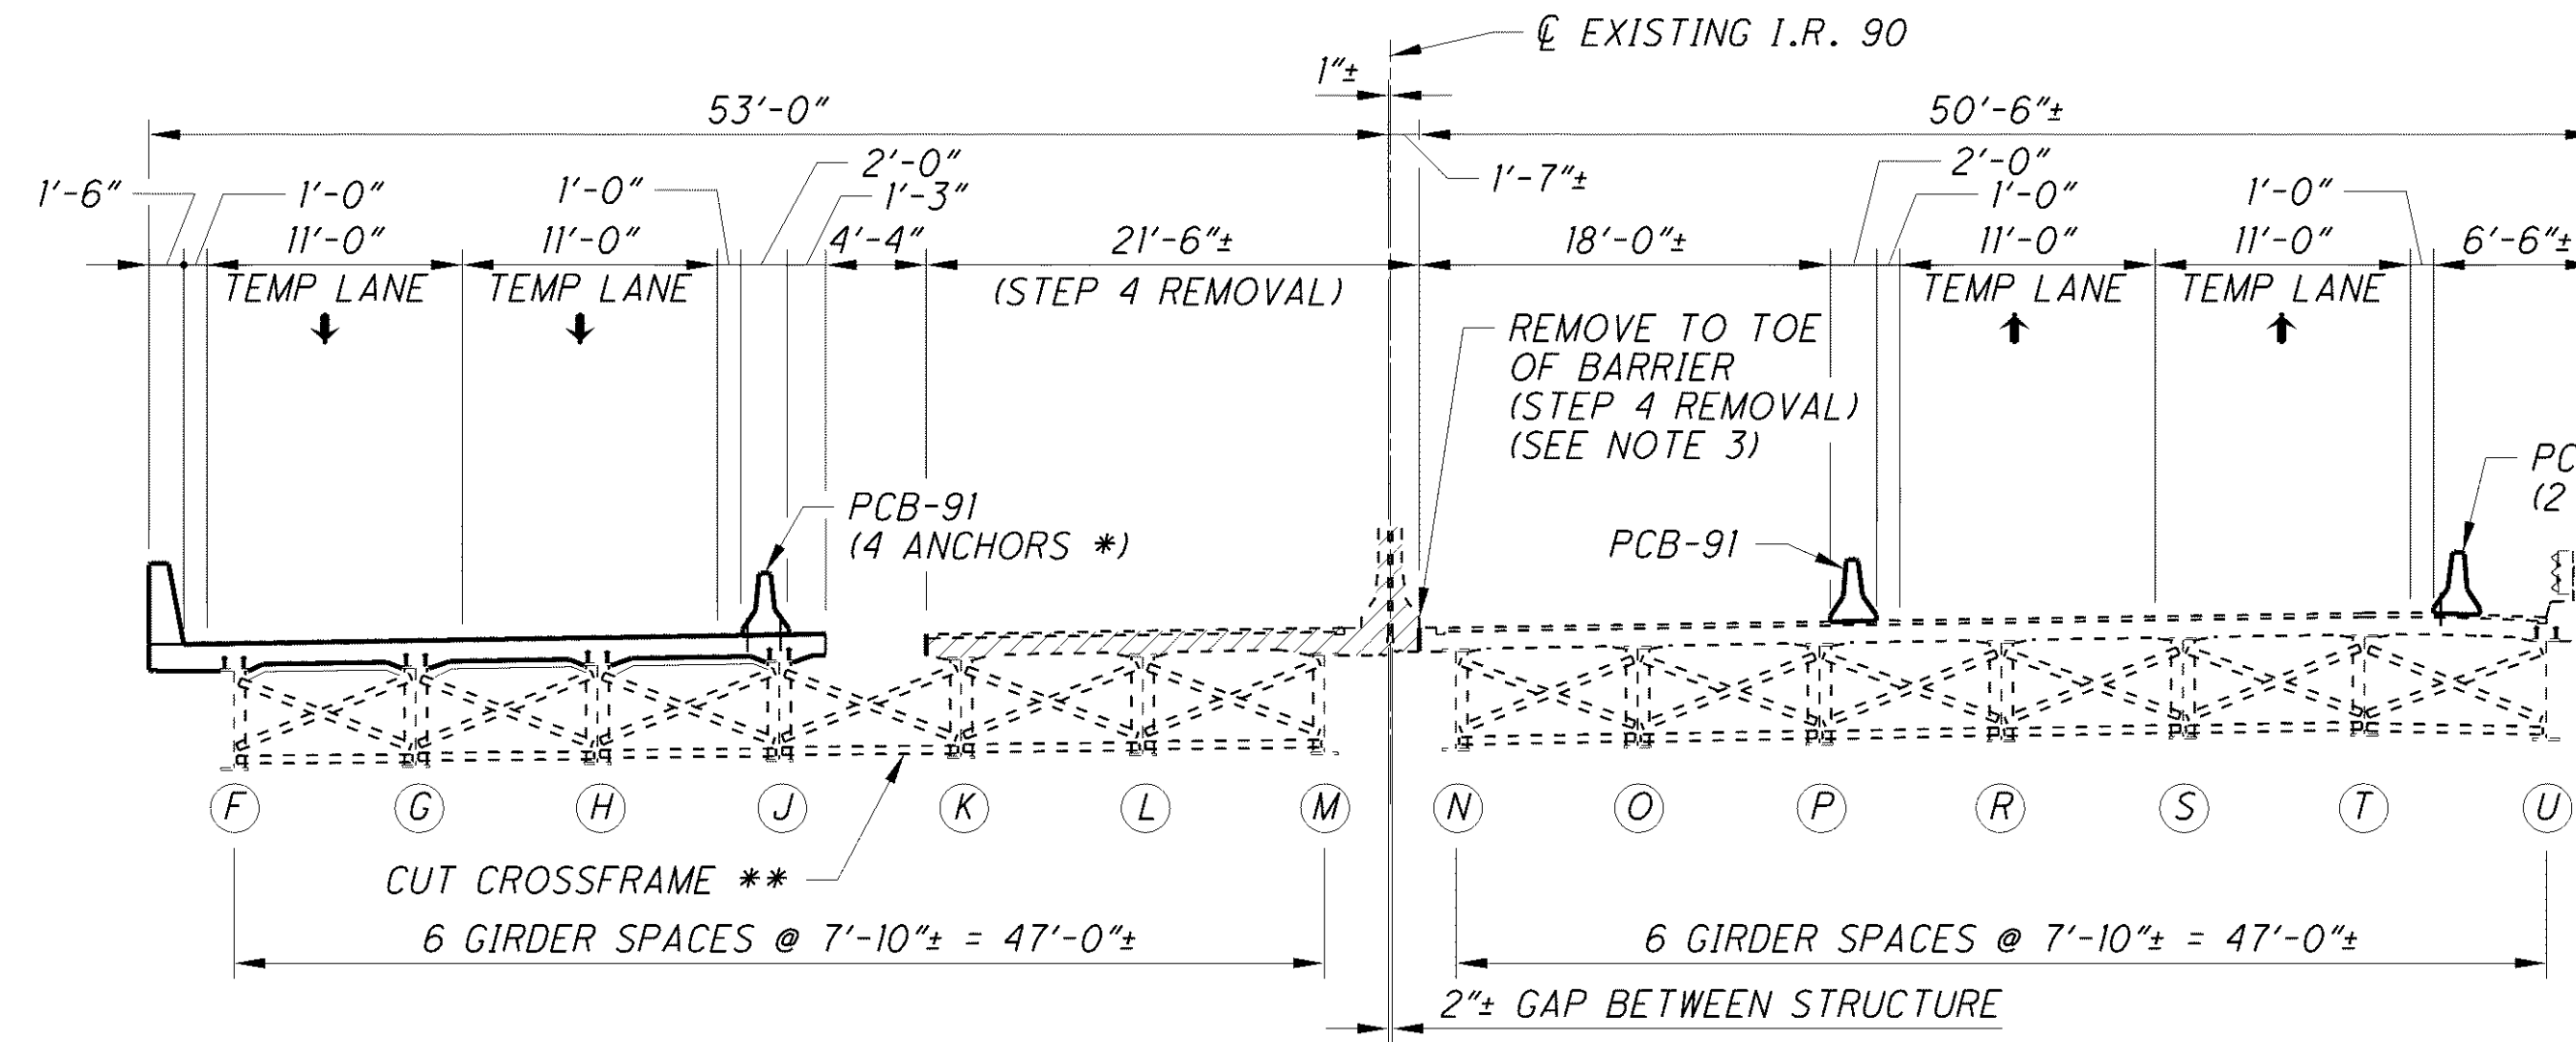


PHASE 1, STEP 4 REMOVAL


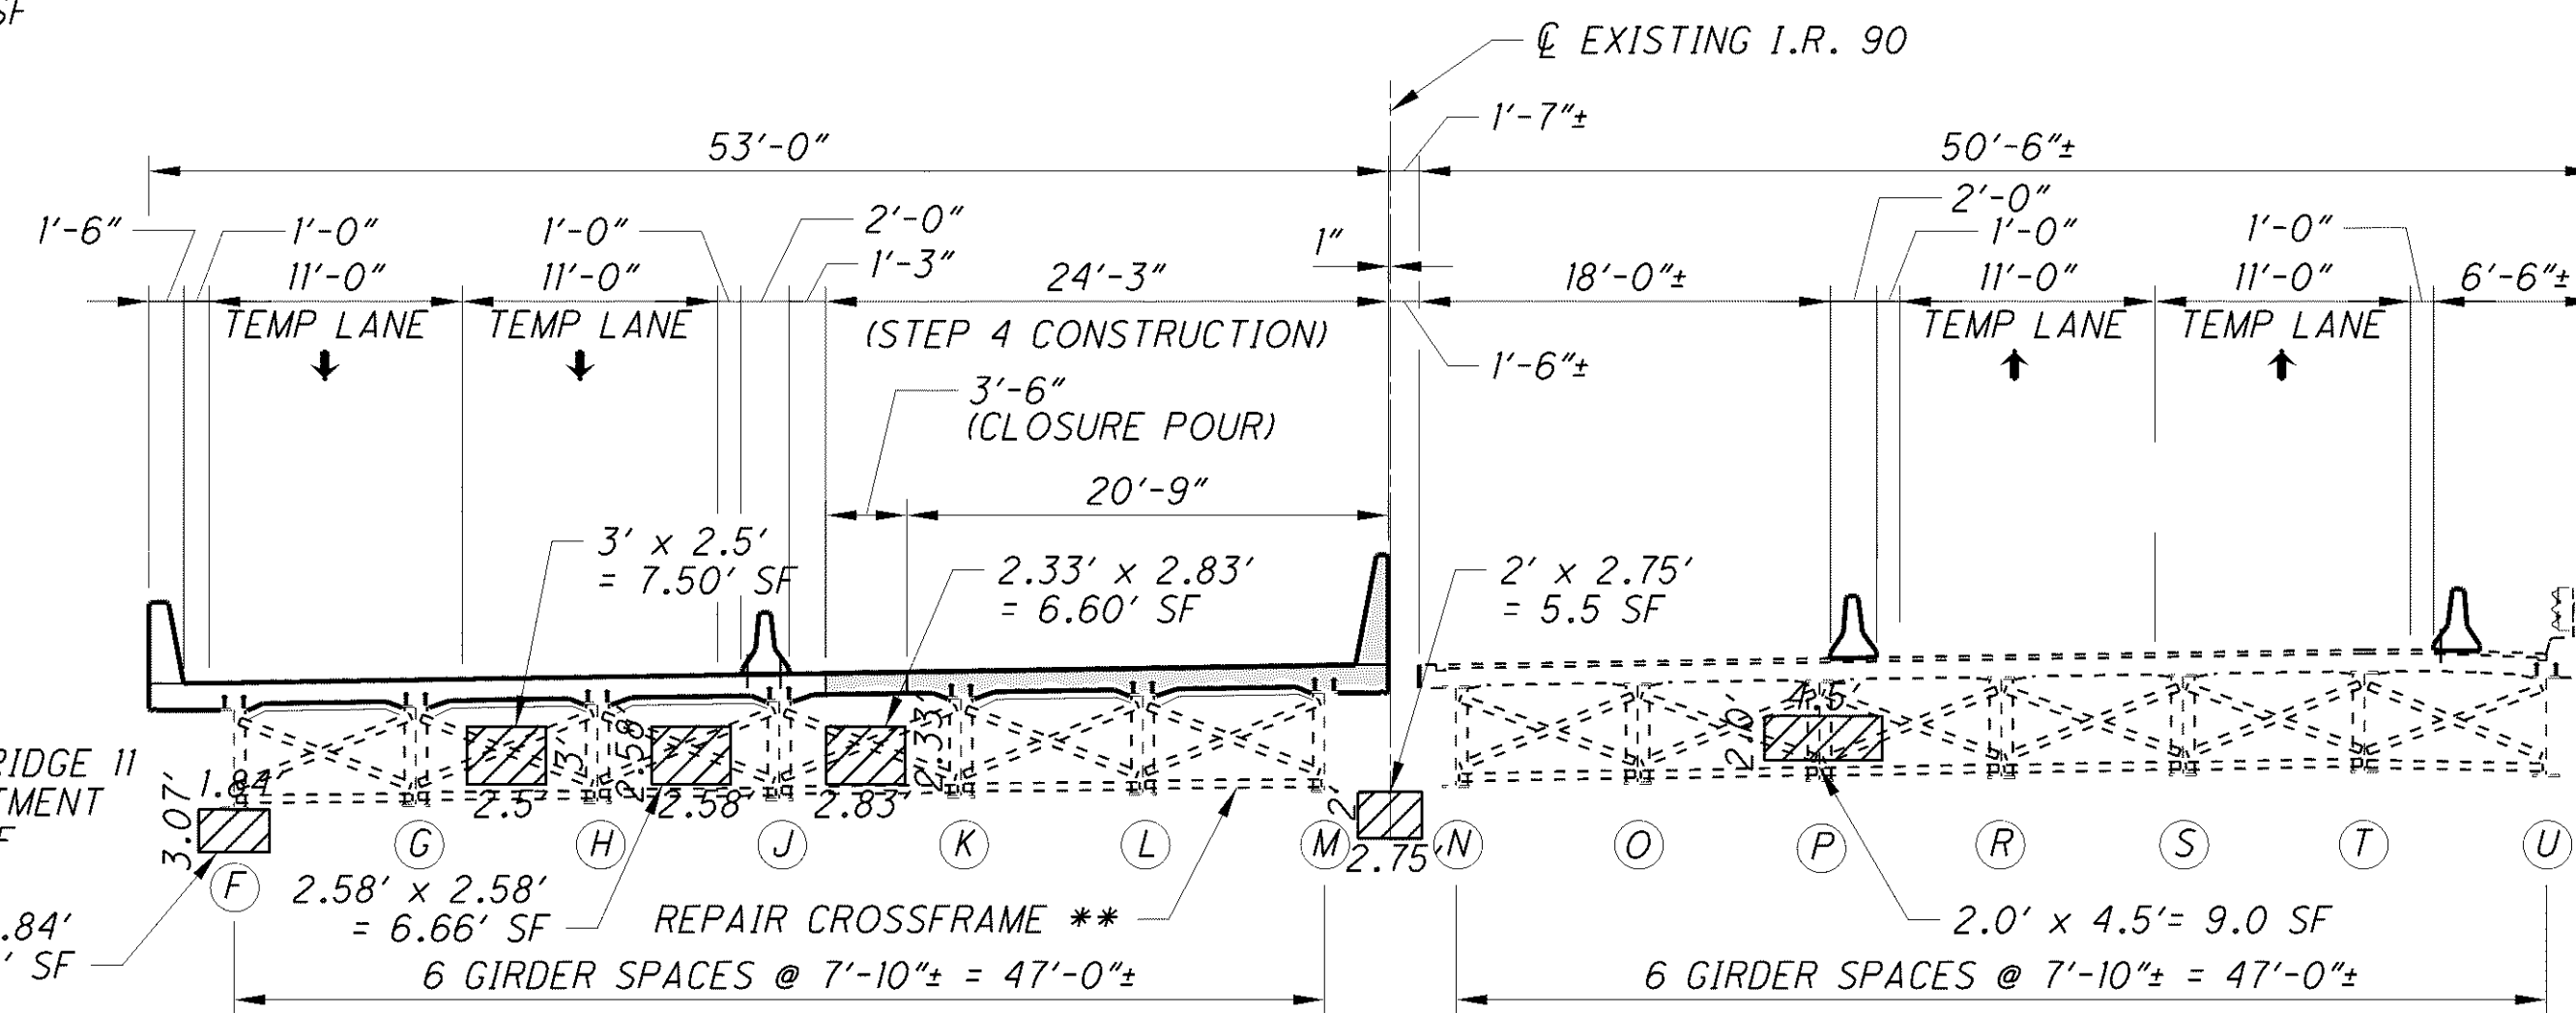


PATCHING AT BRIDGE 12
FORWARD ABUTMENT
= 14.50 SF

PHASE 1, STEP 4 CONSTRUCTION

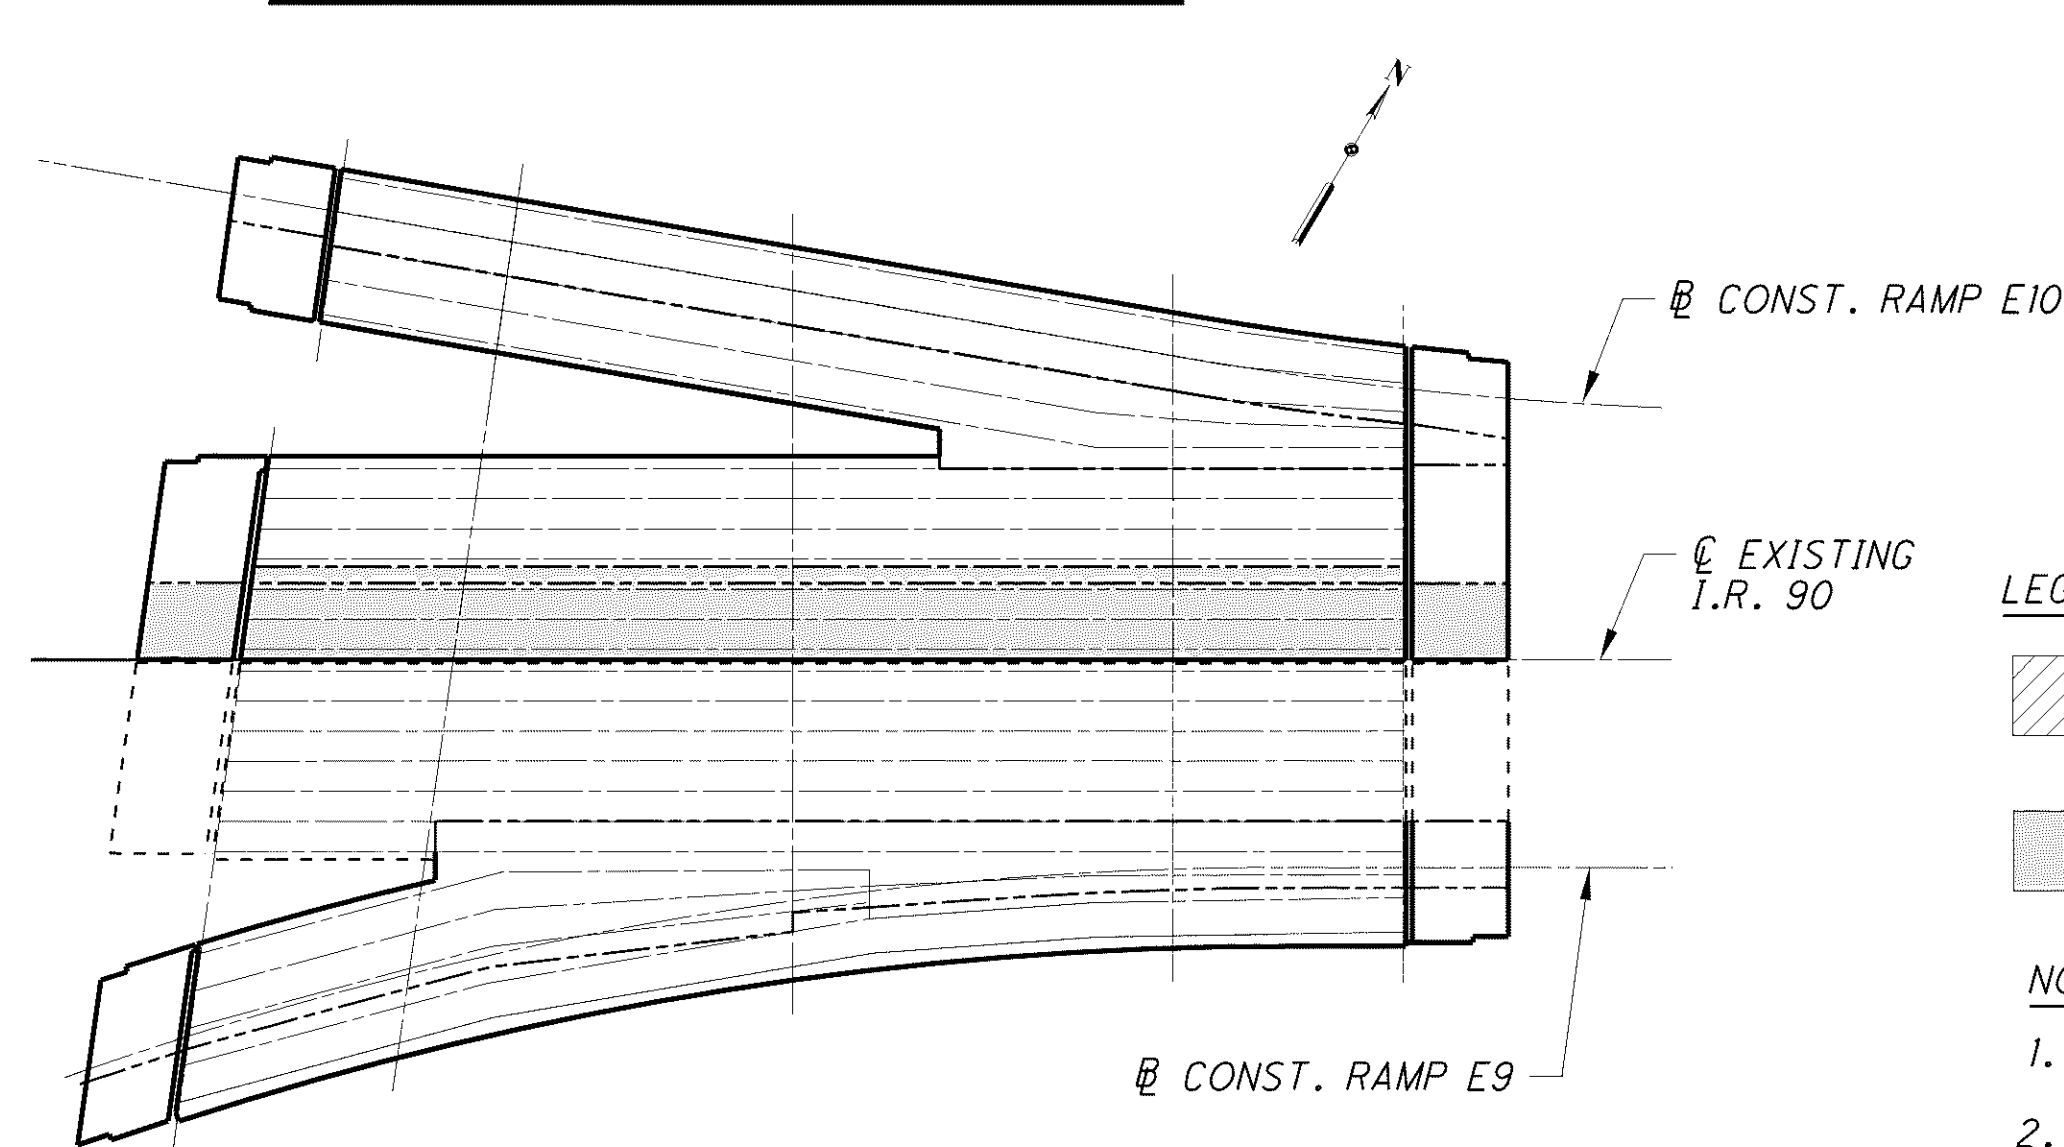

PHASE 1, STEP 4 CONSTRUCTION

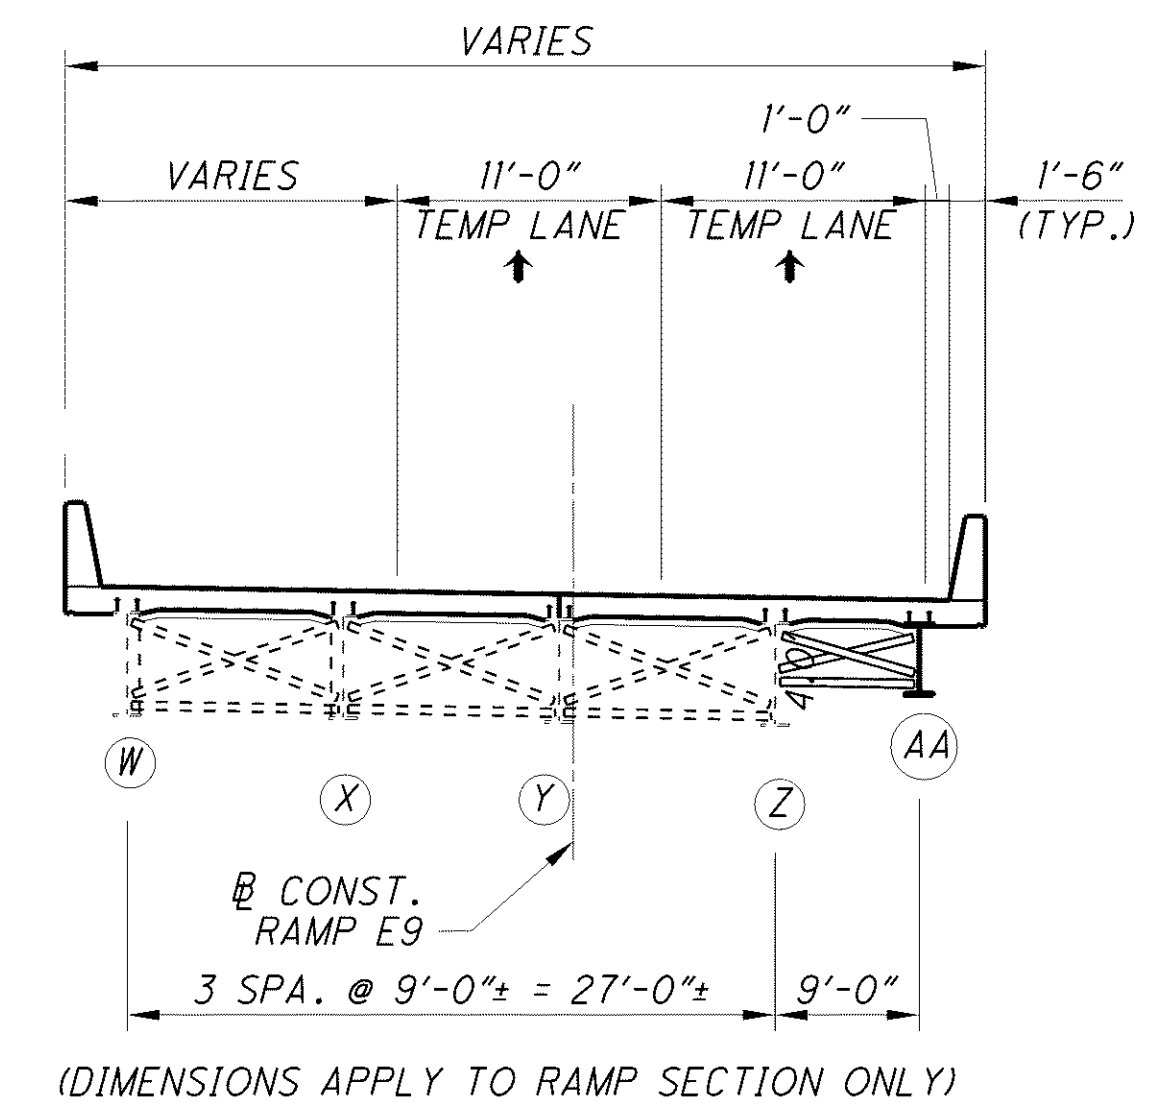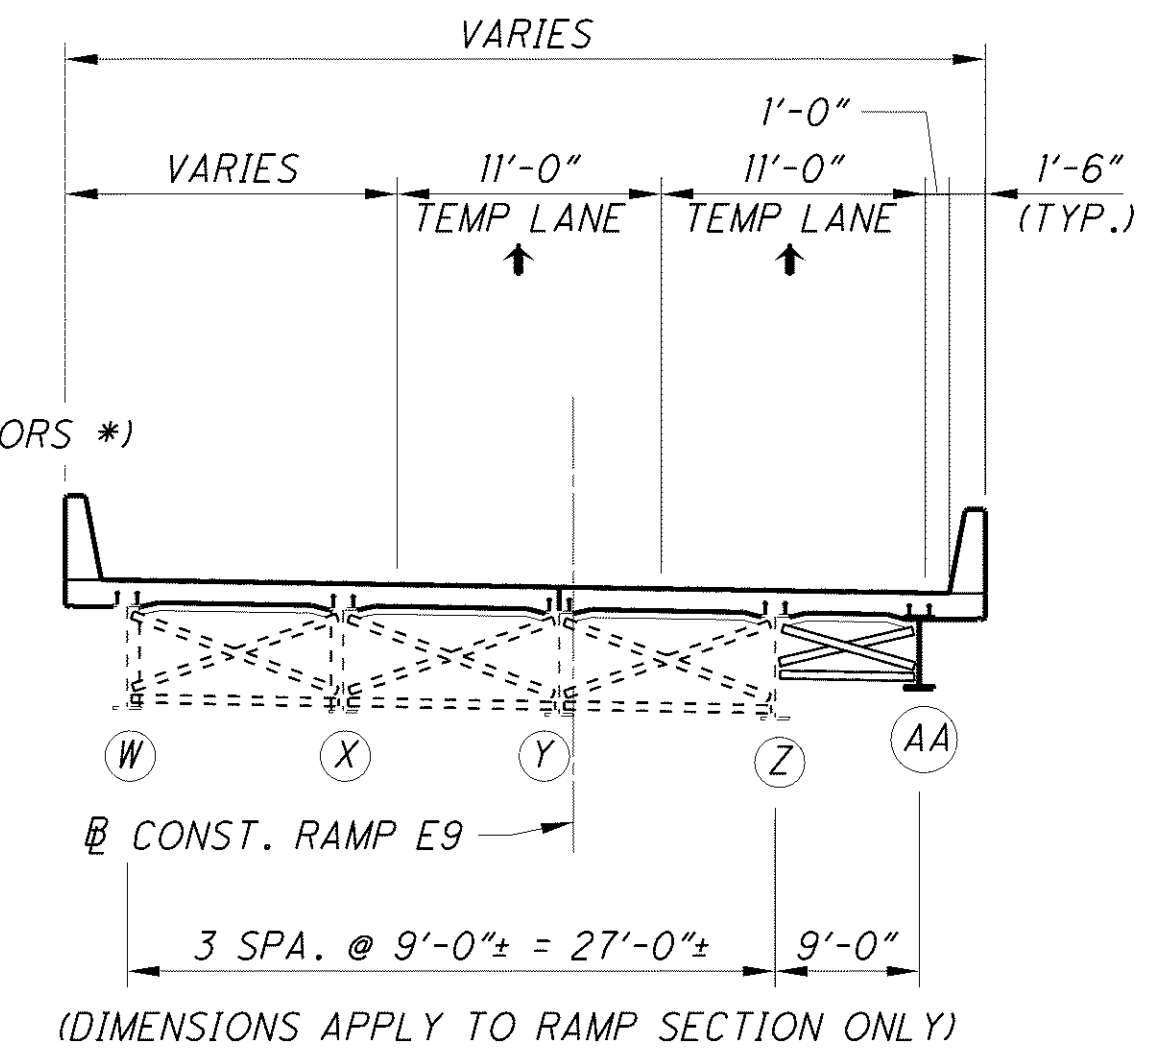

* NUMBER OF PARTIAL DEPTH ANCHOR
BOLTS PER SEGMENT (INCLUDES PCB-91
ON APPROACH SLABS)

** SPANS 2 AND 3 ONLY (CROSSFRAMES)

LEGEND:


INDICATES AREA TO BE REMOVED PER ITEM 202,
PORTIONS OF STRUCTURE REMOVED, OVER 20
FOOT SPAN, AS PER PLAN.

INDICATES AREA TO BE CONSTRUCTED.




NOTE:

- FOR ADDITIONAL NOTES, SEE SHEET 7/38.
- AFTER REMOVAL OF THE PORTABLE CONCRETE BARRIER
FROM THE NEW DECK, REMOVE THE PARTIAL DEPTH
ANCHORS AND GROUT ANY VOIDS LEFT IN THE NEW DECK.
- VERIFY LOCATION OF GIRDER FLANGE PRIOR TO SAWCUT
OF EXISTING DECK.




DESIGNED	DRAWN	REVIEWED	DATE	BRIDGE	PHASE	CONSTRUCTION	DETAILS	NO.	REVISIONS	DATE
PSB	PSB	JOL	03-11-11	10	11	12	5 - (FORWARD ABUTMENT)	01-29-13		
CHECKED	CHECKED	CHECKED	STRUCTURE FILE NUMBER							
NJ	NJ	NJ	1807919/1807900/1807803							
			CUY-90-14.90							
			PID No. 77332 / 85531							
			10A/38							
			10A/38							

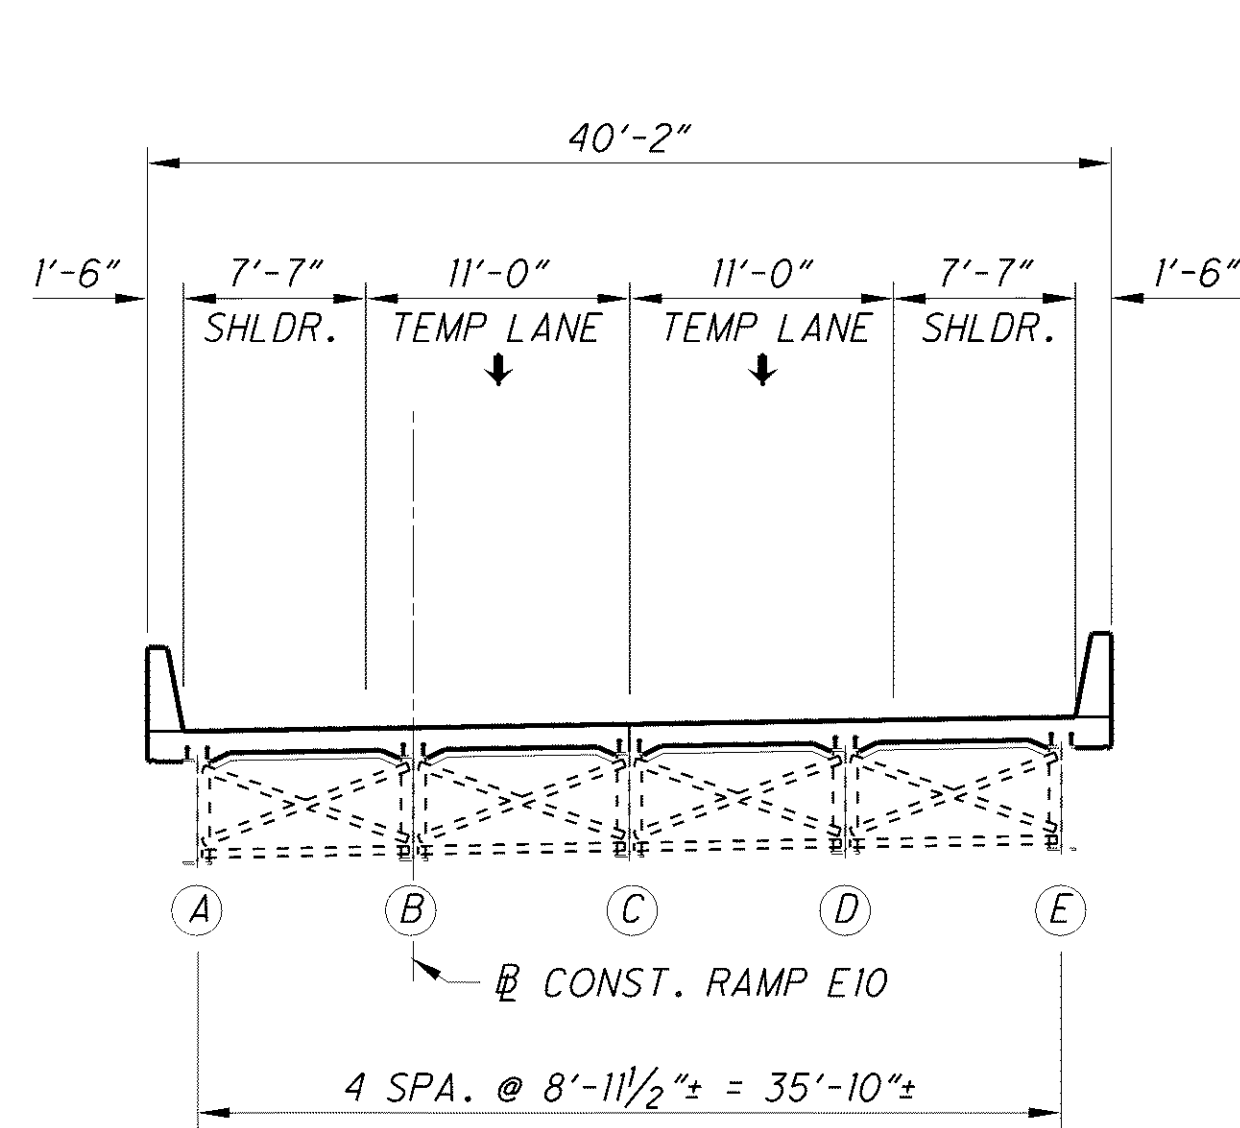


PHASE 1, STEP 5 REMOVAL

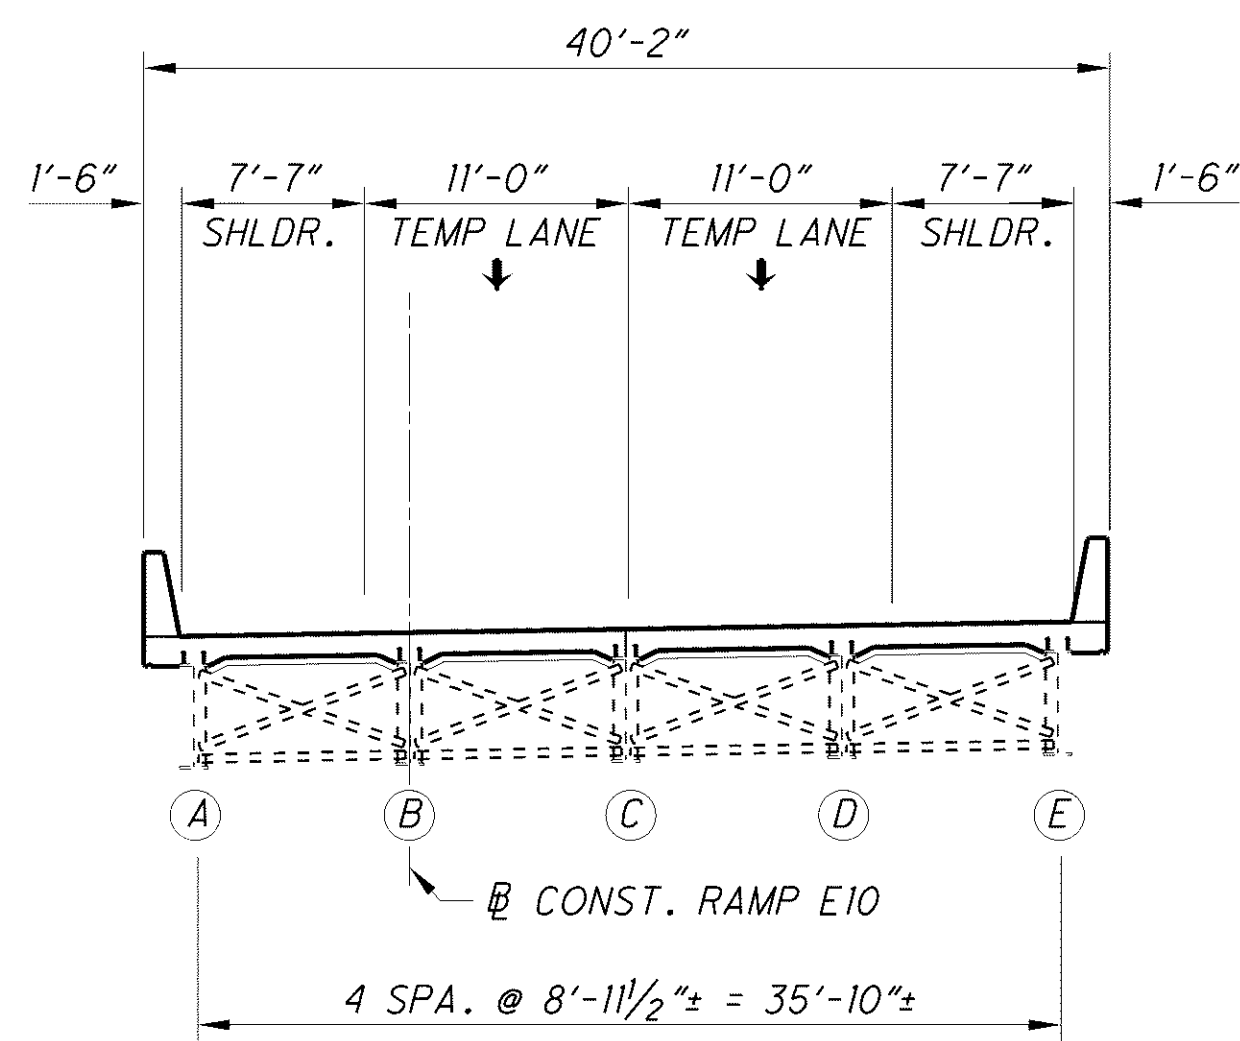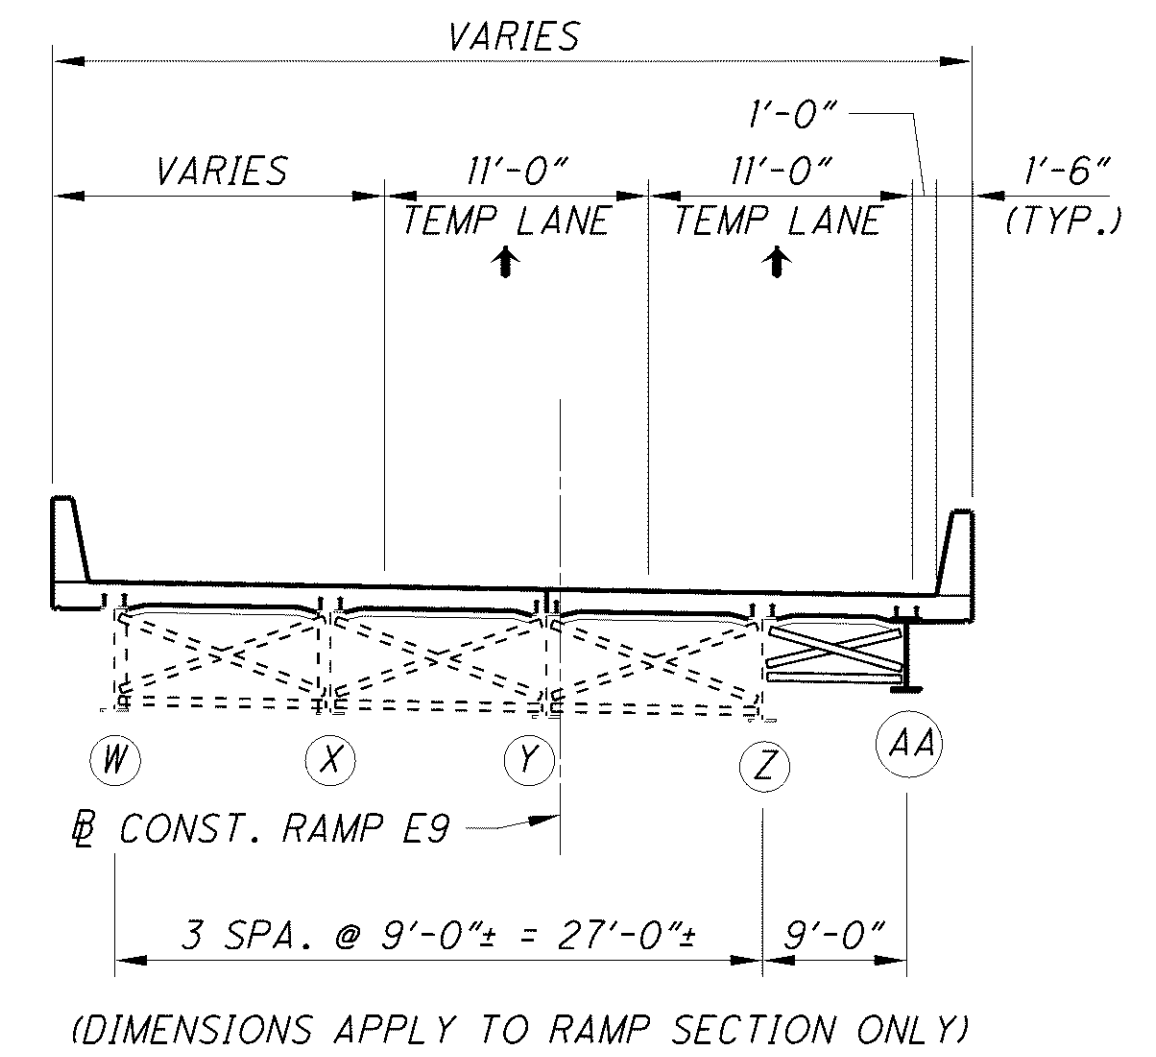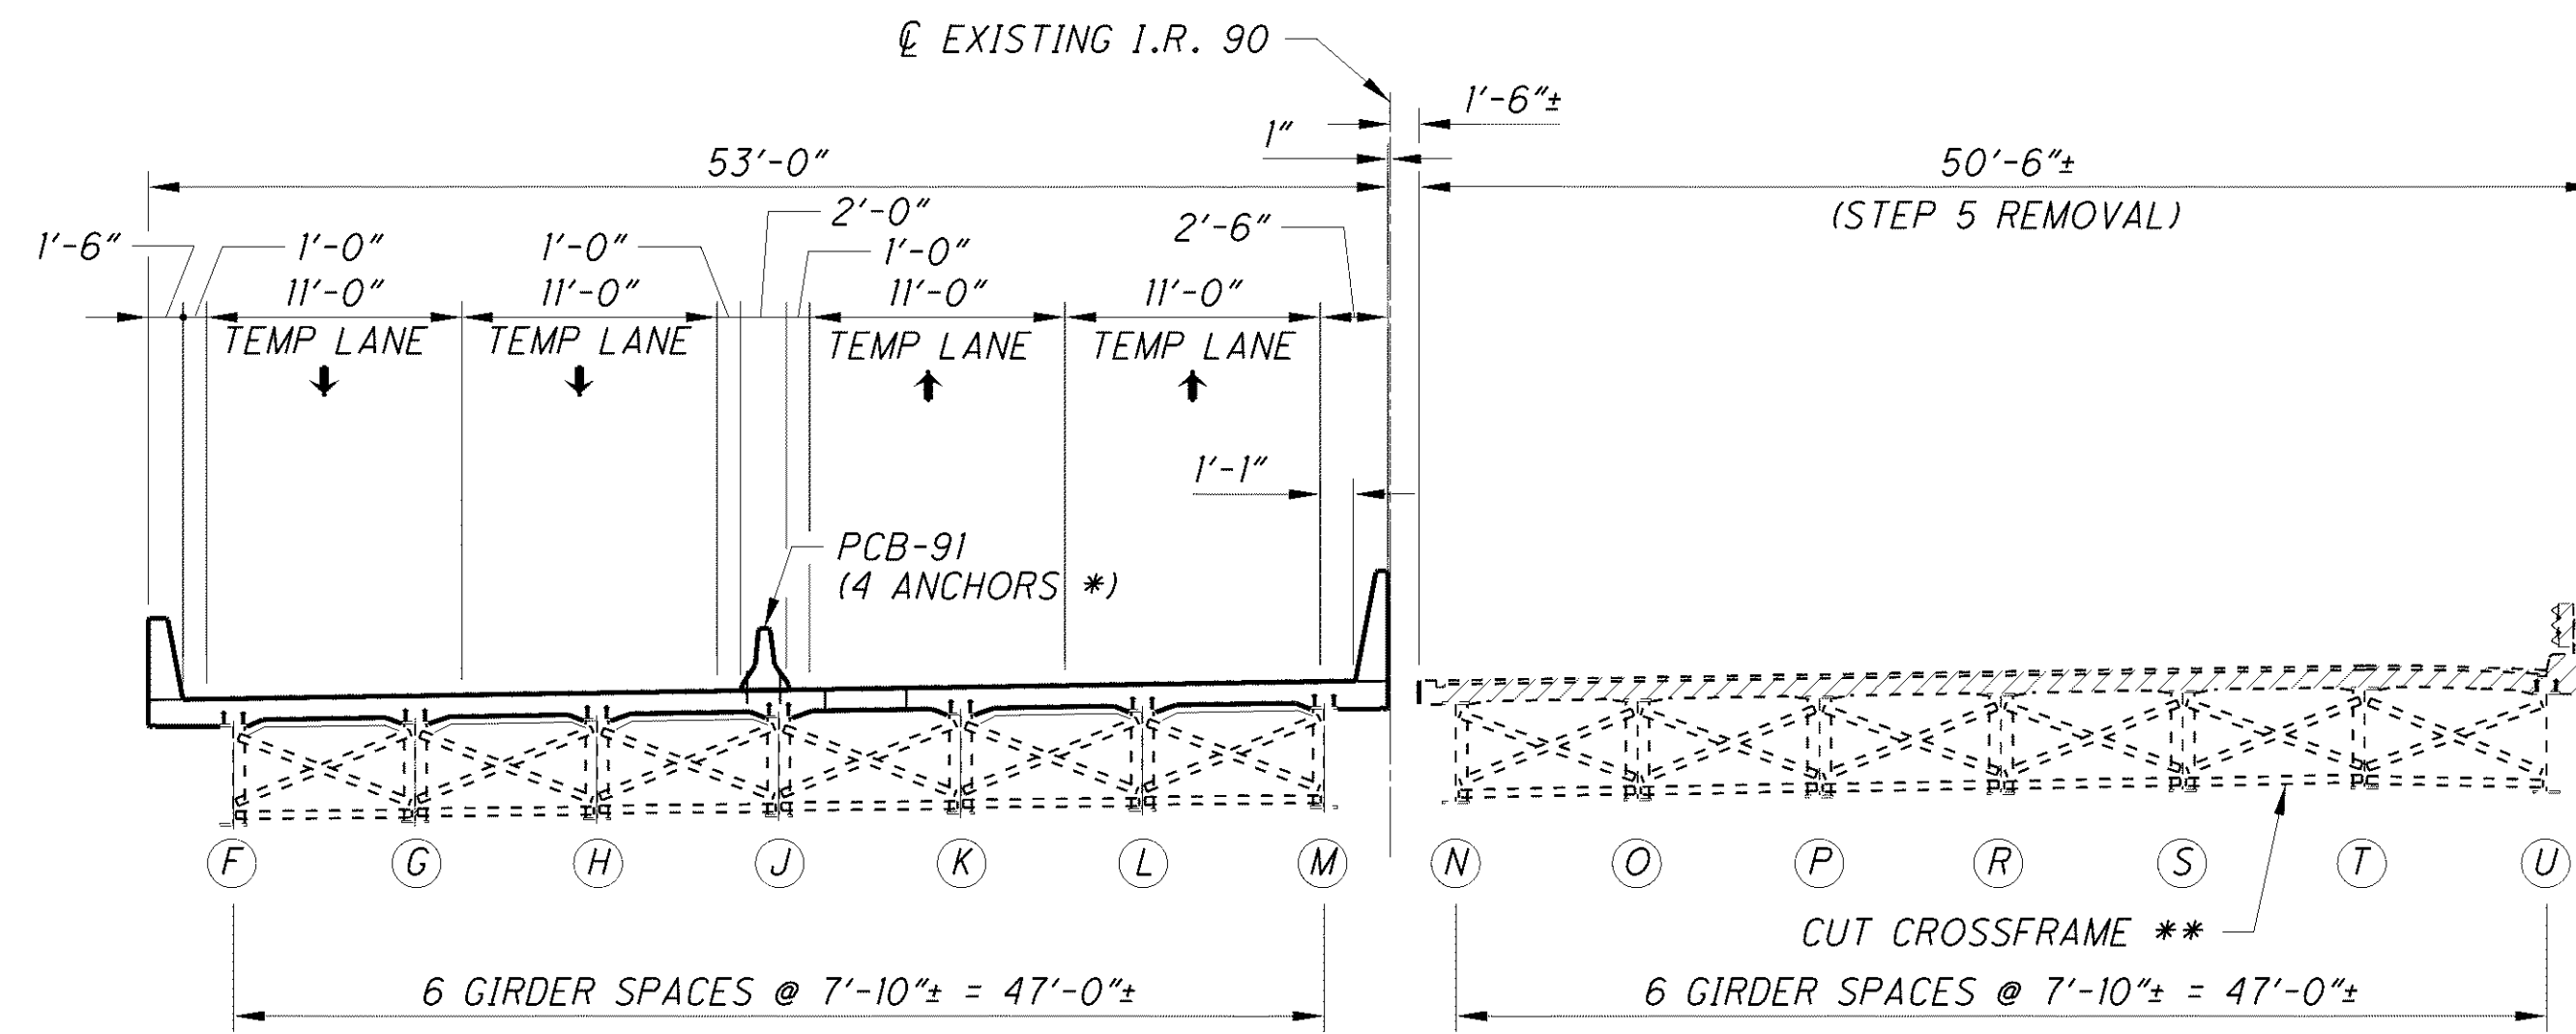

PHASE 1, STEP 5 CONSTRUCTION

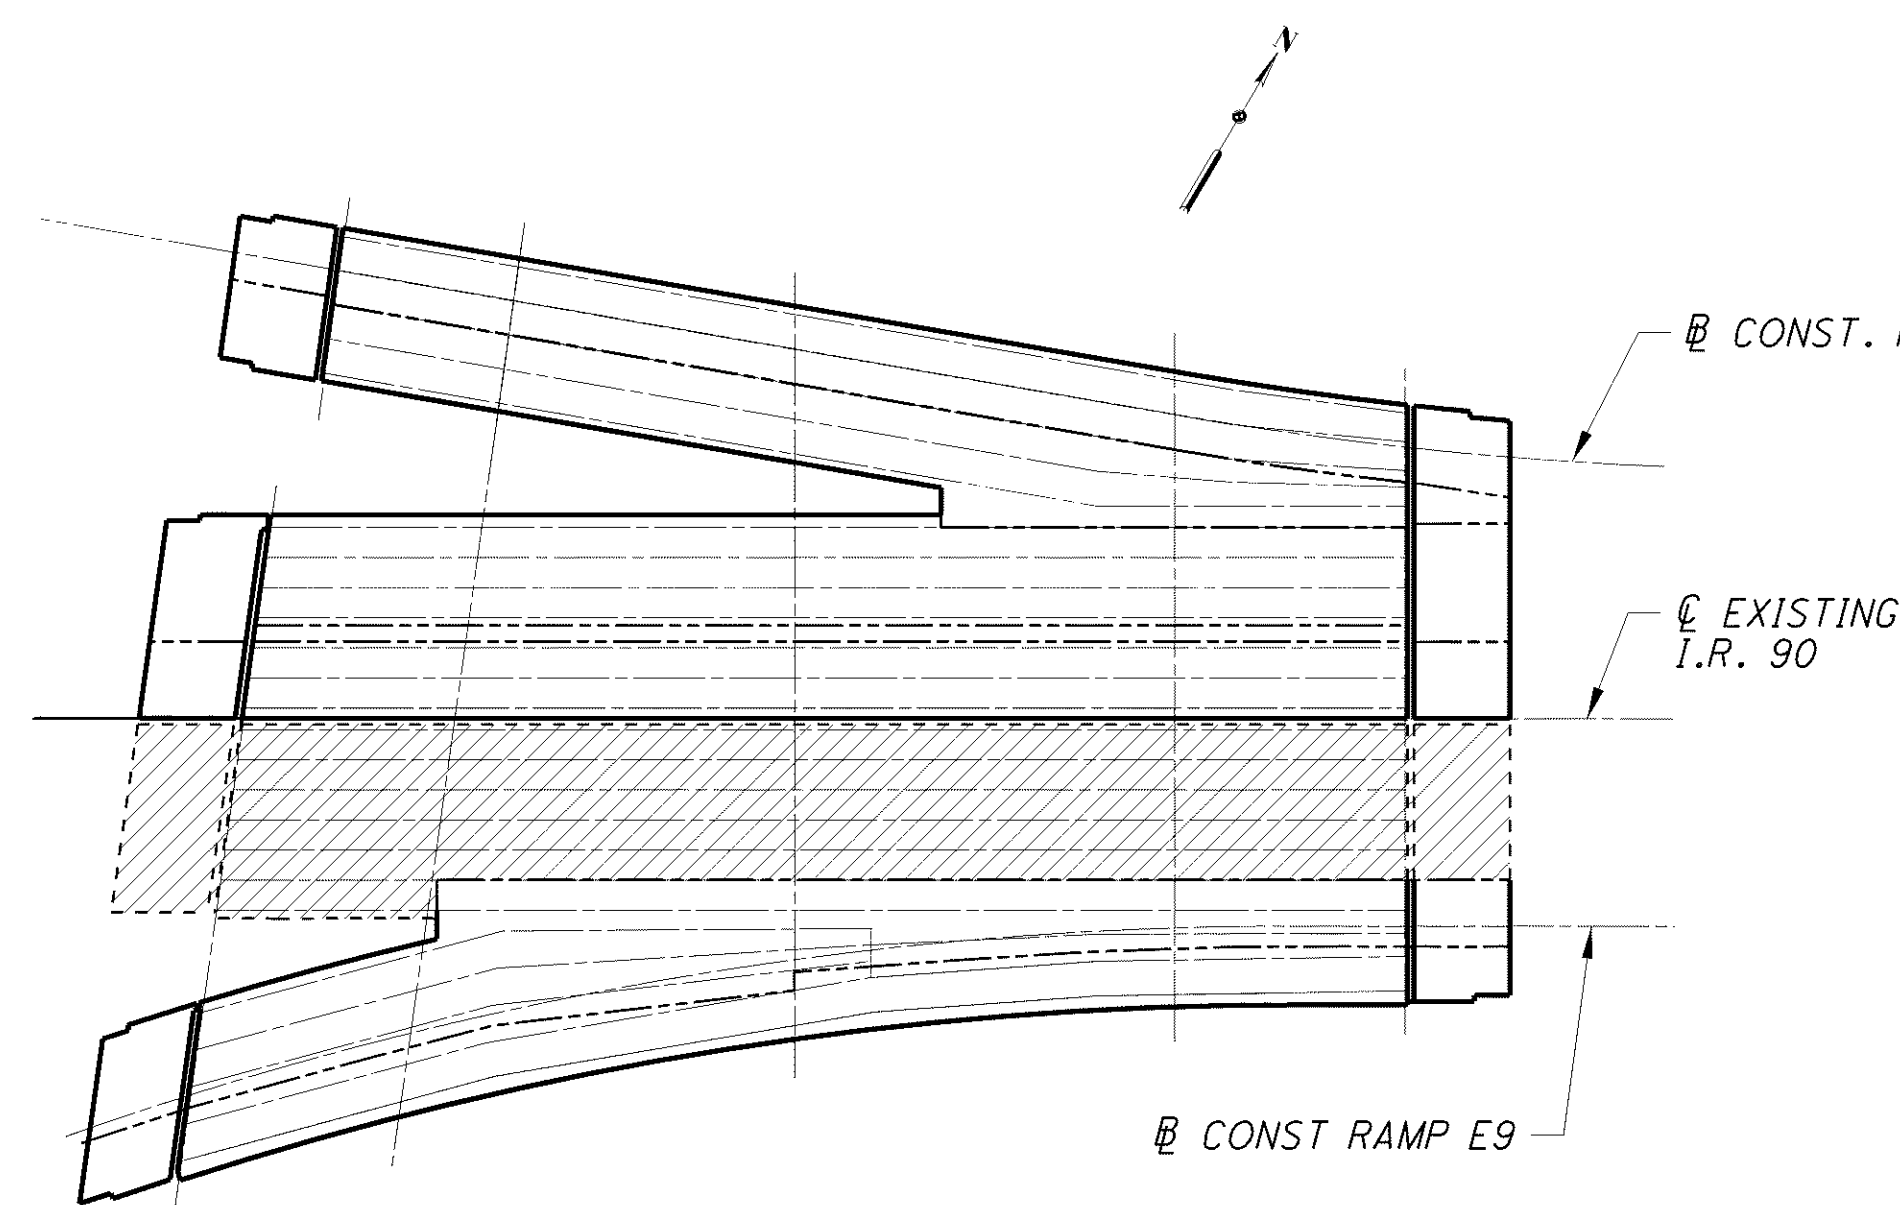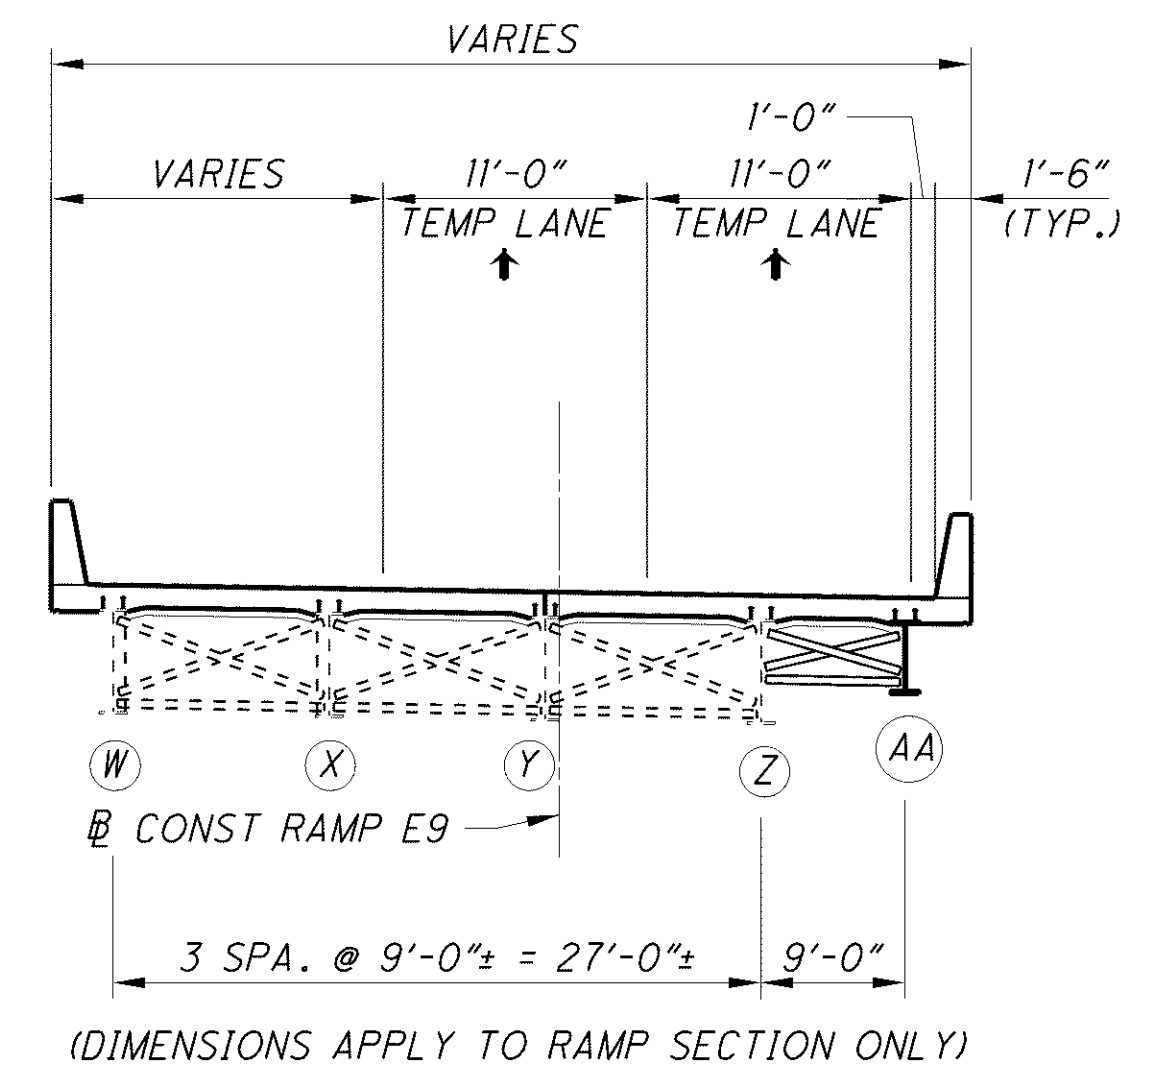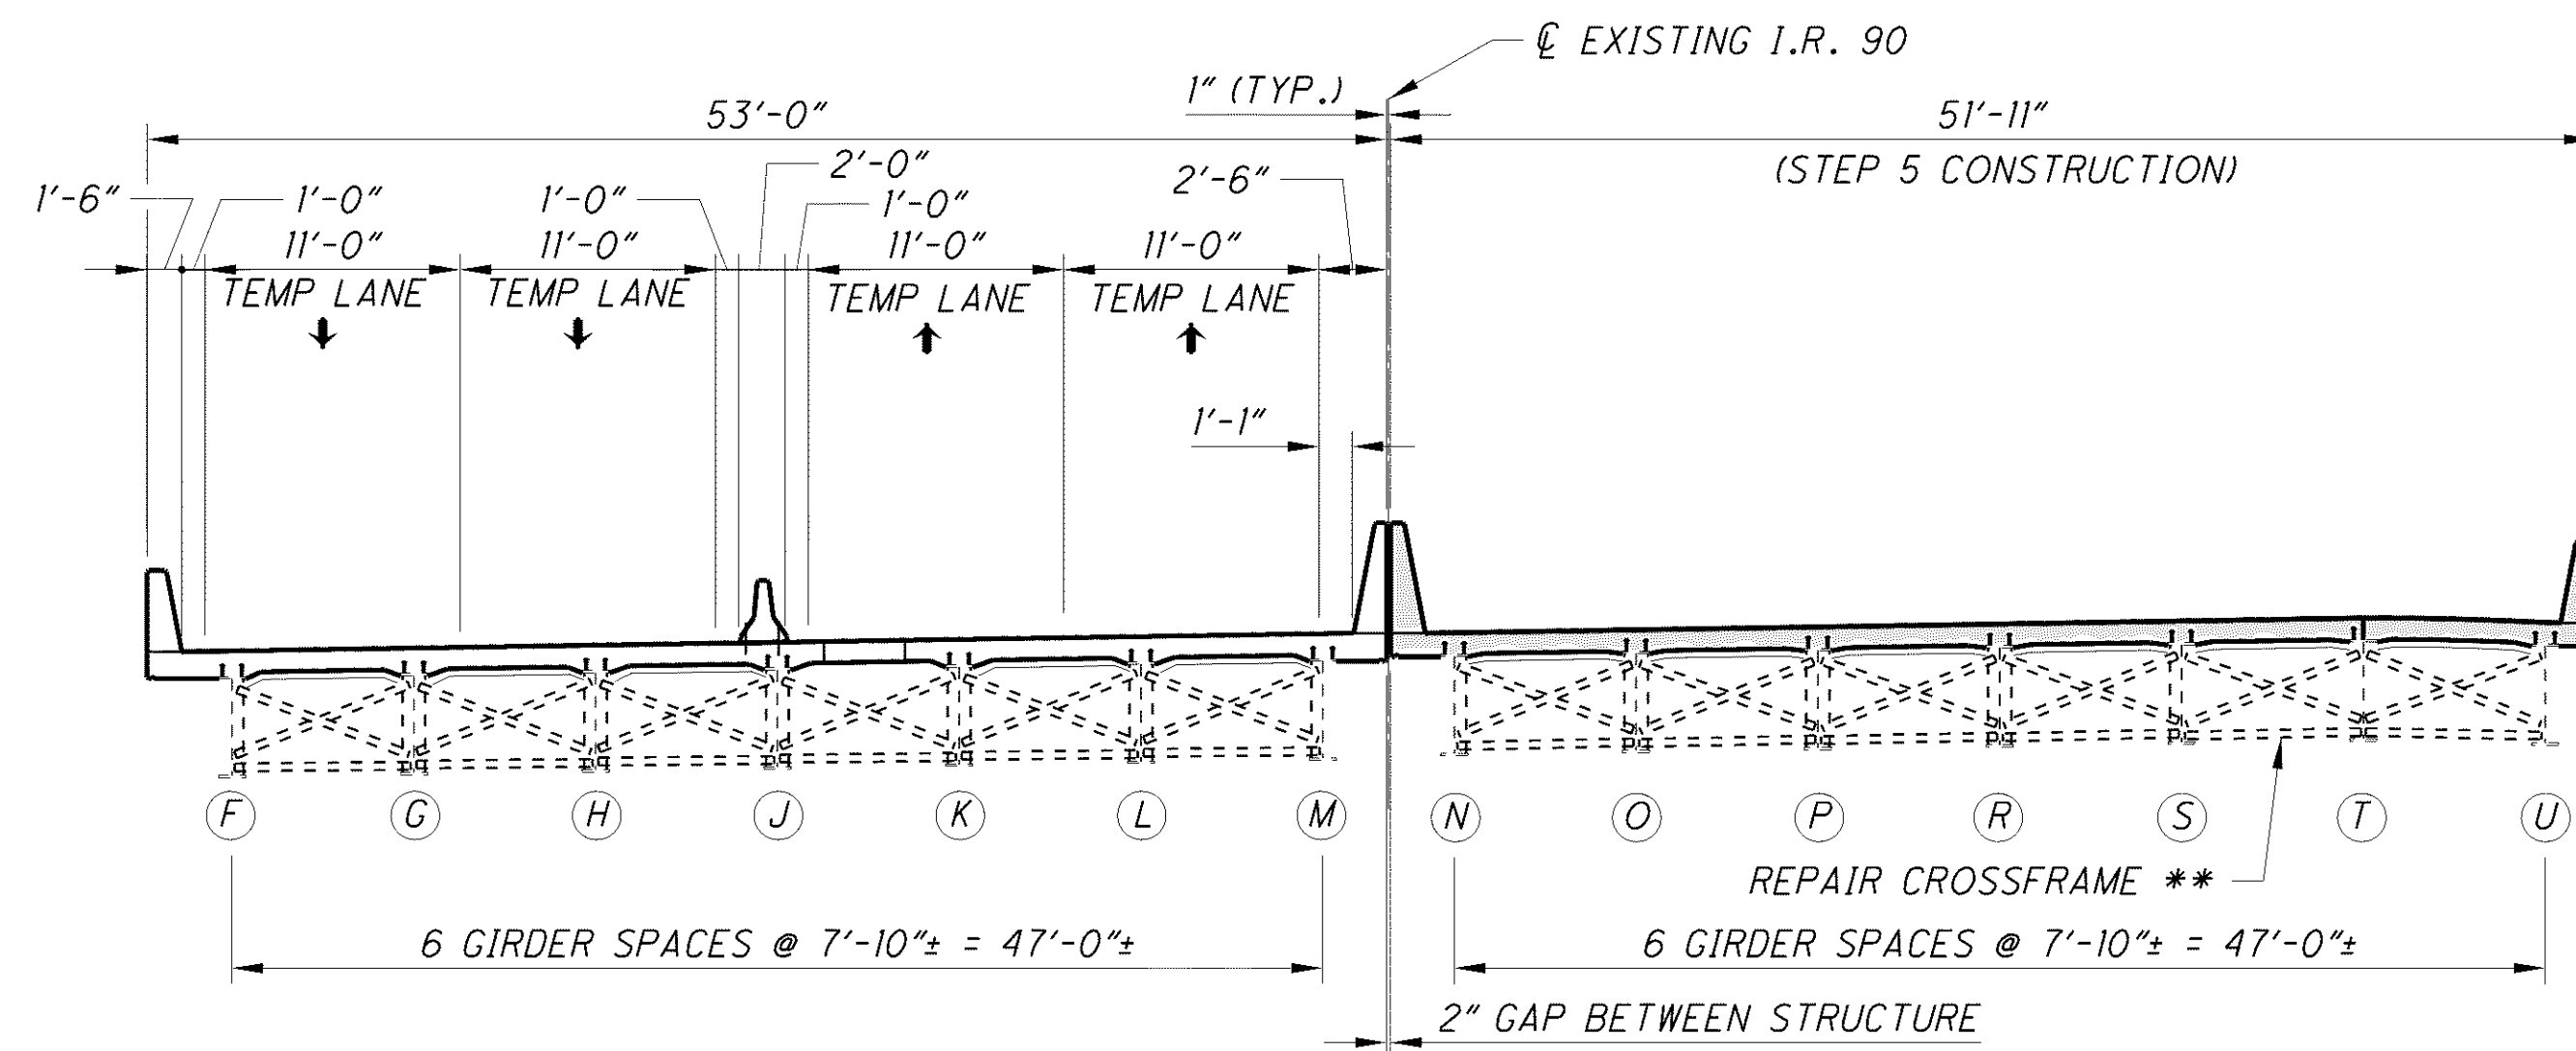

PHASE 1, STEP 5 REMOVAL

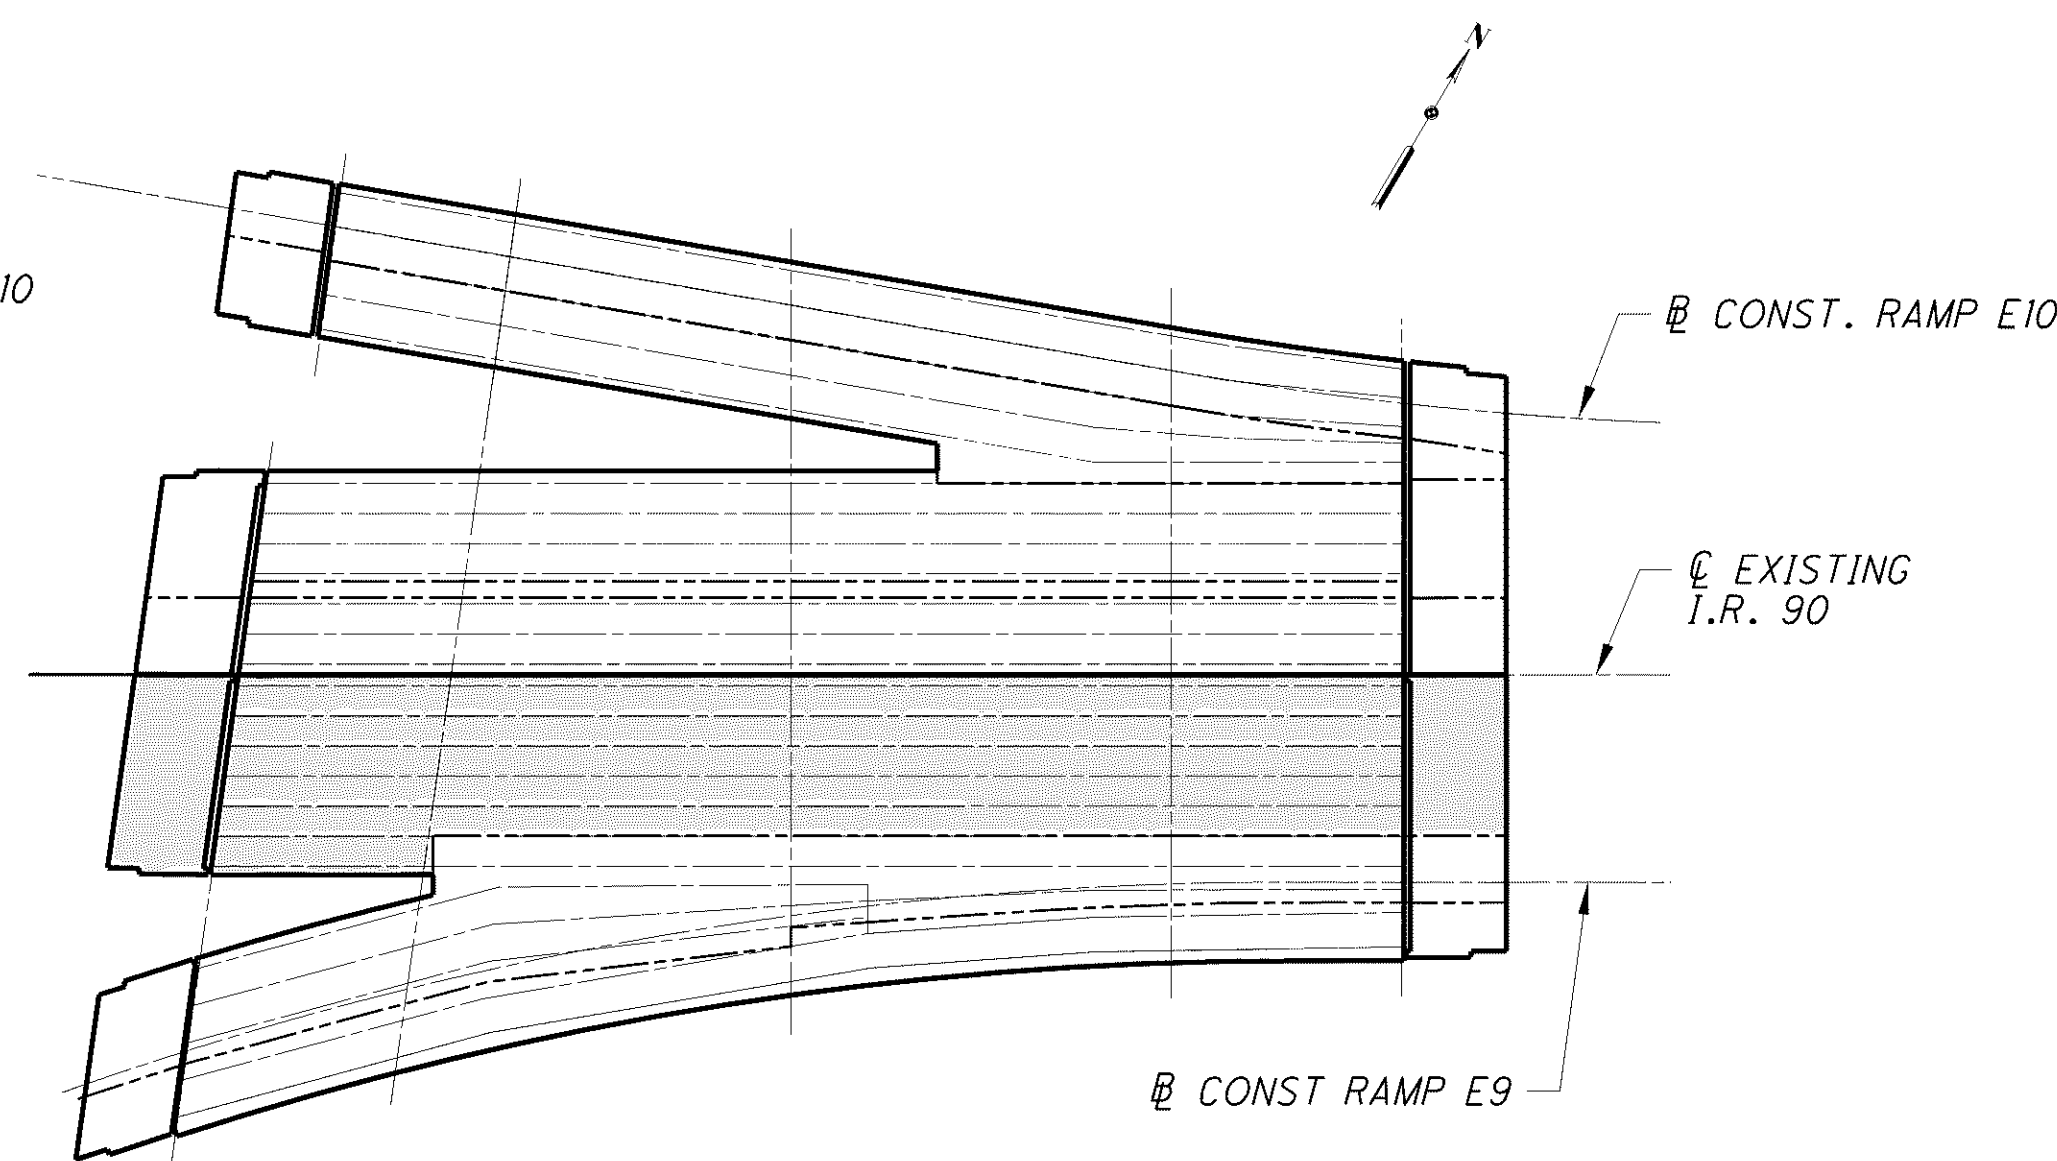

PHASE 1, STEP 5 CONSTRUCTION

* NUMBER OF PARTIAL DEPTH ANCHOR BOLTS PER SEGMENT (INCLUDES PCB-91 ON APPROACH SLABS)

** SPANS 2 AND 3 ONLY (CROSSFRAMES)

LEGEND:

 INDICATES AREA TO BE REMOVED PER ITEM 202, PORTIONS OF STRUCTURE REMOVED, OVER 20 FOOT SPAN, AS PER PLAN.

 INDICATES AREA TO BE CONSTRUCTED.

NOTE:

1. FOR ADDITIONAL NOTES, SEE SHEET 7/38.

2. AFTER REMOVAL OF THE PORTABLE CONCRETE BARRIER FROM THE NEW DECK, REMOVE THE PARTIAL DEPTH ANCHORS AND GROUT ANY VOIDS LEFT IN THE NEW DECK.

[illegible]



- INDICATES AREA TO BE REMOVED PER ITEM 202 APPROACH
SLAB REMOVED

*** - PHASE 1, STEP 1 REMOVAL**
**** - PHASE 1, STEP 2 REMOVAL**
***** - PHASE 1, STEP 3 REMOVAL**
****** - PHASE 1, STEP 4 REMOVAL**

1. EXISTING ELEVATIONS SHOWN ON THE ORIGINAL BRIDGE PLANS HAVE NOT BEEN ADJUSTED TO THE CURRENT PROJECT SURVEY ELEVATIONS. ELEVATIONS NEED TO BE ADJUSTED TO THE CURRENT PROJECT SURVEY ELEVATIONS. FOR REAR ABUTMENT, PIER1, PIER2, PIER3 AND FORWARD ABUTMENT THE ELEVATION ADJUSTMENT IS APPROXIMATELY 0.94, 0.76, 0.70, 0.66 AND 0.64 FEET LOWER RESPECTIVELY THAN EXISTING ELEVATIONS SHOWN ON THE ORIGINAL BRIDGE PLANS.

All piles to be C.I.P. Reinforced Concrete.

Note
Piers for Br. No. 4
E. 14th St. Retaining Walls, are included in
Part 6.

PROPOSED	STRUCTURE
<p>TYPE : Continuous welded steel girder with reinforced concrete deck and substructure.</p> <p>SPANS : 55'-0", 88'-6", 99'-0", & 60'-0" along E. I. B.</p> <p>ROADWAY : Varies</p> <p>LOADING : CF - 2000 - Adequate for A. A. S. H. O. alternate loading.</p> <p>SKUEW : Varies</p> <p>SURFACE COURSE : 1" Monolithic Concrete</p> <p>ALIGNMENT : 1° 30' Lt. Tangent</p> <p>APPROACH SLABS : A S-1-34 (25' long)</p> <p>SUPERELEVATION : Varies</p>	

H.N.T.B. BR. NO. 4 PART 7A



HOWARD, NEEDLES, TAMMEN & BERGENDOFF
CONSULTING ENGINEERS
KANSAS CITY CLEVELAND NEW YORK


SITE PLAN

INNER BELT FREEWAY OVER EAST 14th ST.

BR. NO. CUY-42-1854	STA. 70+89.23
Scale: 1" = 30'	STA. 73+96.25

WILLOW-INNER BELT FREEWAY				
CLEVELAND		CUYAHOGA COUNTY		OHIO
DRAWN <i>P.A.</i>	TRACED <i>J.A.G.</i>	CHECKED <i>A.J.S.</i>	REVIEWED <i>J.C.T.</i>	REVISED
DATE <i>11-4-58</i>	DATE <i>12-18-58</i>	DATE <i>10-21-58</i>	DATE <i>11-13-59</i>	SHEET <i>14</i>

DESIGNED RSB	DRAWN JTW	REVIEWED JOL	DATE 03-11-11	BRIDGES 10 & 11			DESIGN AGENCY	NO.	REVISIONS	DATE
		CHECKED NJ	STRUCTURE FILE NUMBER 1807919/1807900							
<div><div>12</div><div>38</div></div>	12 / 38		CUY -90-14.90 PID No. 77332/ 85531		REMOVAL DETAILS - 1 BRIDGE NO. CUY-77-1597 L AND CUY-90-1651 L I-90WB AND I-77SB RAMP OVER E 14TH STREET					

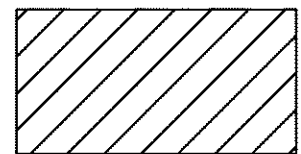

- INDICATES AREA TO BE REMOVED PER ITEM 202 PORTIONS OF STRUCTURE REMOVED, OVER 20 FOOT SPAN, AS PER PLAN

NOTE:

1. EXISTING ELEVATIONS SHOWN ON THE ORIGINAL BRIDGE PLANS HAVE NOT BEEN ADJUSTED TO THE CURRENT PROJECT SURVEY ELEVATIONS. ELEVATIONS NEED TO BE ADJUSTED TO THE CURRENT PROJECT SURVEY ELEVATIONS. FOR REAR ABUTMENT, PIER1, PIER2, PIER3 AND FORWARD ABUTMENT THE ELEVATION ADJUSTMENT IS APPROXIMATELY 0.94, 0.76, 0.70, 0.66 AND 0.64 FEET LOWER RESPECTIVELY THAN EXISTING ELEVATIONS SHOWN ON THE ORIGINAL BRIDGE PLANS.

Note:
End of railing parapet to be normal to top of safety curb.

Note: Prefix "AA" shall be assigned to all bar marks.

CUYAHOGA COUNTY
CITY OF CLEVELAND
CUY-21-1532
CUY-42-1842

REINFORCEMENT SCHEDULE									
MARK	NO.	LENGTH	TYPE	DIMENSIONS				SERIES INCRE- MENT	WEIGHT
				A	B	C	D		
401	1-Ser of 6	4'-6" to 6'-0"	109	8" to 1'-5"	1'-5"			3"	21
402	1-Ser of 6	6'-2" to 6'-6"	109	1'-6" to 1'-8"	1'-5"			3"	25
403	25	6'-6"	109	1'-8"	1'-5"				109
404	34	5'-7"	105	8"	2'-7"				127
406	14	6'-10"	144	2'-6"	1'-10"	7"			64
501	35	4'-5"	105	1'-8"	1'-6"				162
601	12	16'-3"	Str.						421
602	16	17'-6"	Str.						117
603	4	19'-6"	Str.						101
604	9	7'-6"	Str.						41
605	2	13'-6"	Str.						33
606	2	11'-0"	Str.						35
607	2	11'-9"	Str.						29
608	2	9'-9"	Str.						74
609	6	8'-3"	Str.						52
610	6	5'-9"	126	1'-8"	1'-2"	3'-3"			25
611	2	8'-4"	105	1'-2"	3'-9"				33
612	2	10'-10"	105	1'-2"	5'-0"				333
613	24	9'-3"	Str.						285
614	30	6'-4"	104	5'-8"	10"				52
615	4	8'-8"	108	6'-9"	1'-6"	1'-3"			264
616	26	6'-9"	100	5'-5"					120
617	6	13'-4"	104	11'-6"	2'-0"				16
618	1	10'-6"	Str.						48
619	8	4'-0"	Str.						1009
620	17	39'-6"	Str.						108
621	12	6'-0"	Str.						808
622	27	19'-11"	112	10"	7'-8"	6'-4"	0"		279
623	10	18'-7"	109	7'-8"	1'-4"				386
624	2-Ser of 20	6'-2" to 6'-8"	104	5'-6" to 6'-0"	10"				212
625	20	7'-1"	105	3'-5"	2'-0"				261
626	8	21'-9"	Str.						11
627	1	7'-3"	Str.						45
628	2-Ser of 6	4'-7" to 5'-4"	100	3'-3" to 4'-0"					226
629	10	15'-1"	100	13'-9"					
Total									5932

NOTES:
All piles shall be 12" C.I.P. reinforced concrete.
All battered piles shall be battered 3 in 12 in the direction shown.
Pile spacings are given along bottom of footing.
For details of end dam see sheet 173-7A.
For masonry plate detail see sheet 173-7A.
Reinforcement bars shall be 3' clear from bottom of footing, 2' elsewhere.
For Reinforcement Bending Diagram see sheet 117-7A.
For location of lighting conduit see sheet 176-7A.
For guard rail connection and railing details see sheet 175-7A.
H.N.T.B. BR. NO. 4

PART 7A








HOWARD, NEEDLES, TAMMEN & BERGENDOFF
CONSULTING ENGINEERS
KANSAS CITY CLEVELAND NEW YORK

ABUTMENT E-10

INNER BELT FREEWAY OVER EAST 14th ST.
BR. NO. CUY-42-1854 STA. 70+89.23
Scale: 1/4" = 1'-0" STA. 73+96.25
Except as noted

WILLOW-INNER BELT FREEWAY
CLEVELAND CUYAHOGA COUNTY OHIO


DRAWN: C.A.B. TRACED: L.M. CHECKED: J.C.T. REVISION: J.C.T.
DATE: 1/3/99 DATE: 2/26/99 DATE: 4/13/99 SHEET 115

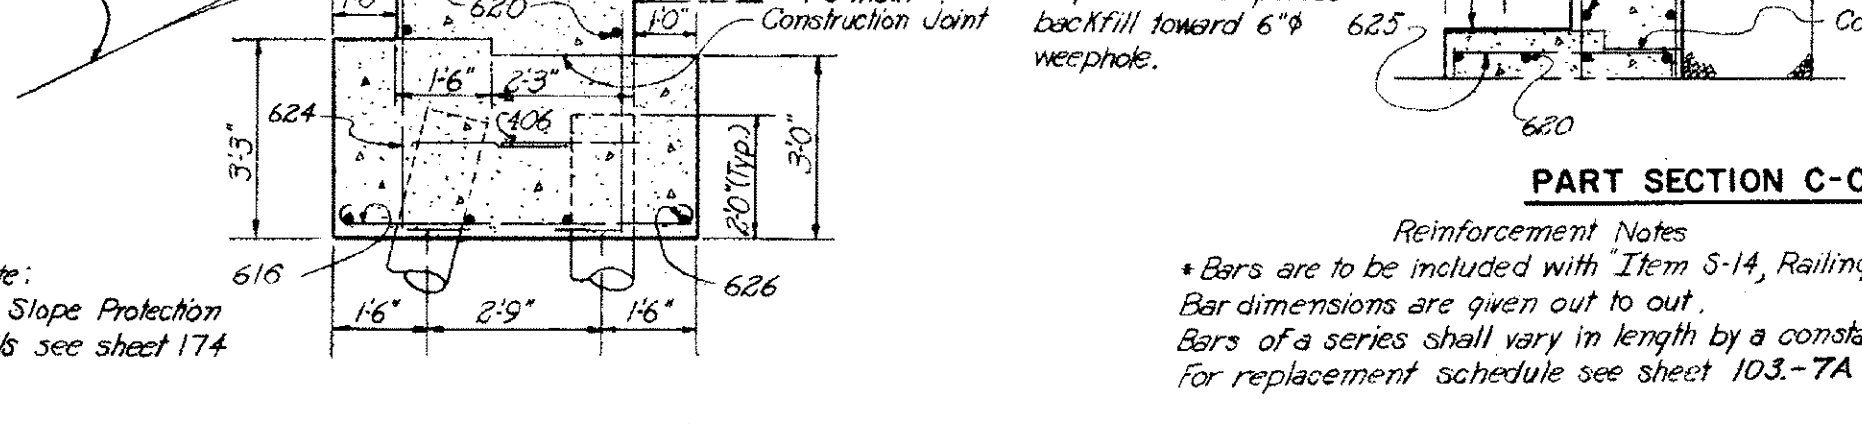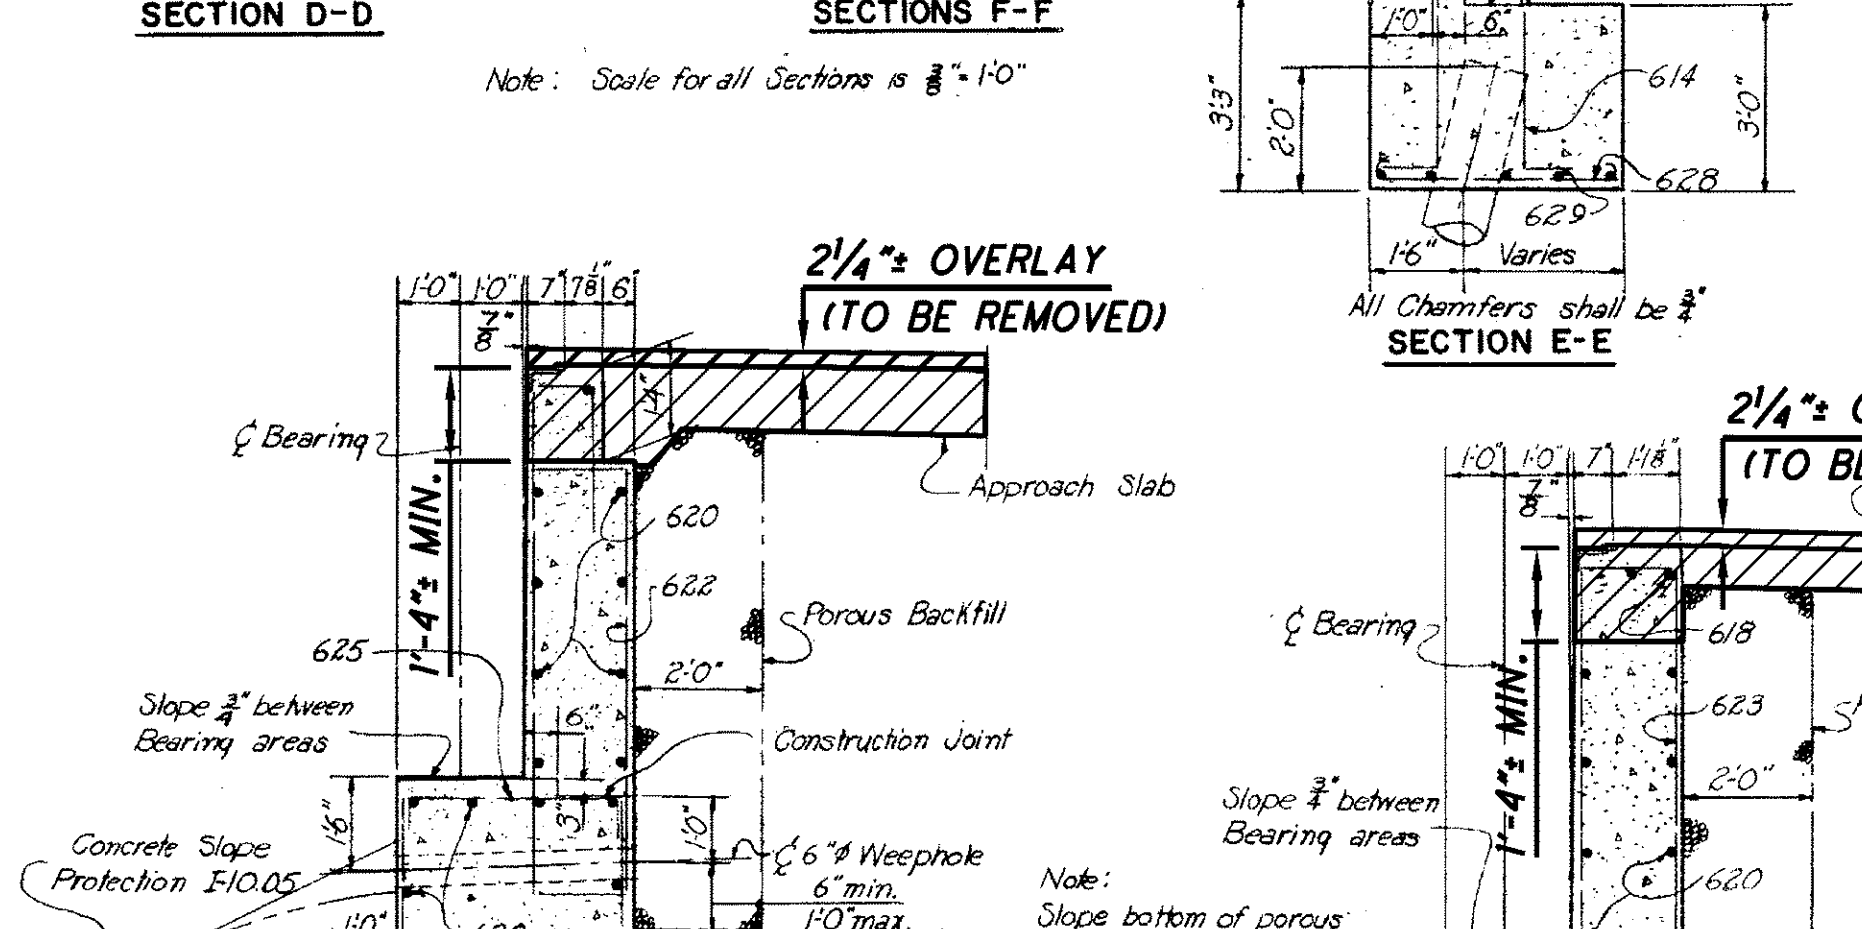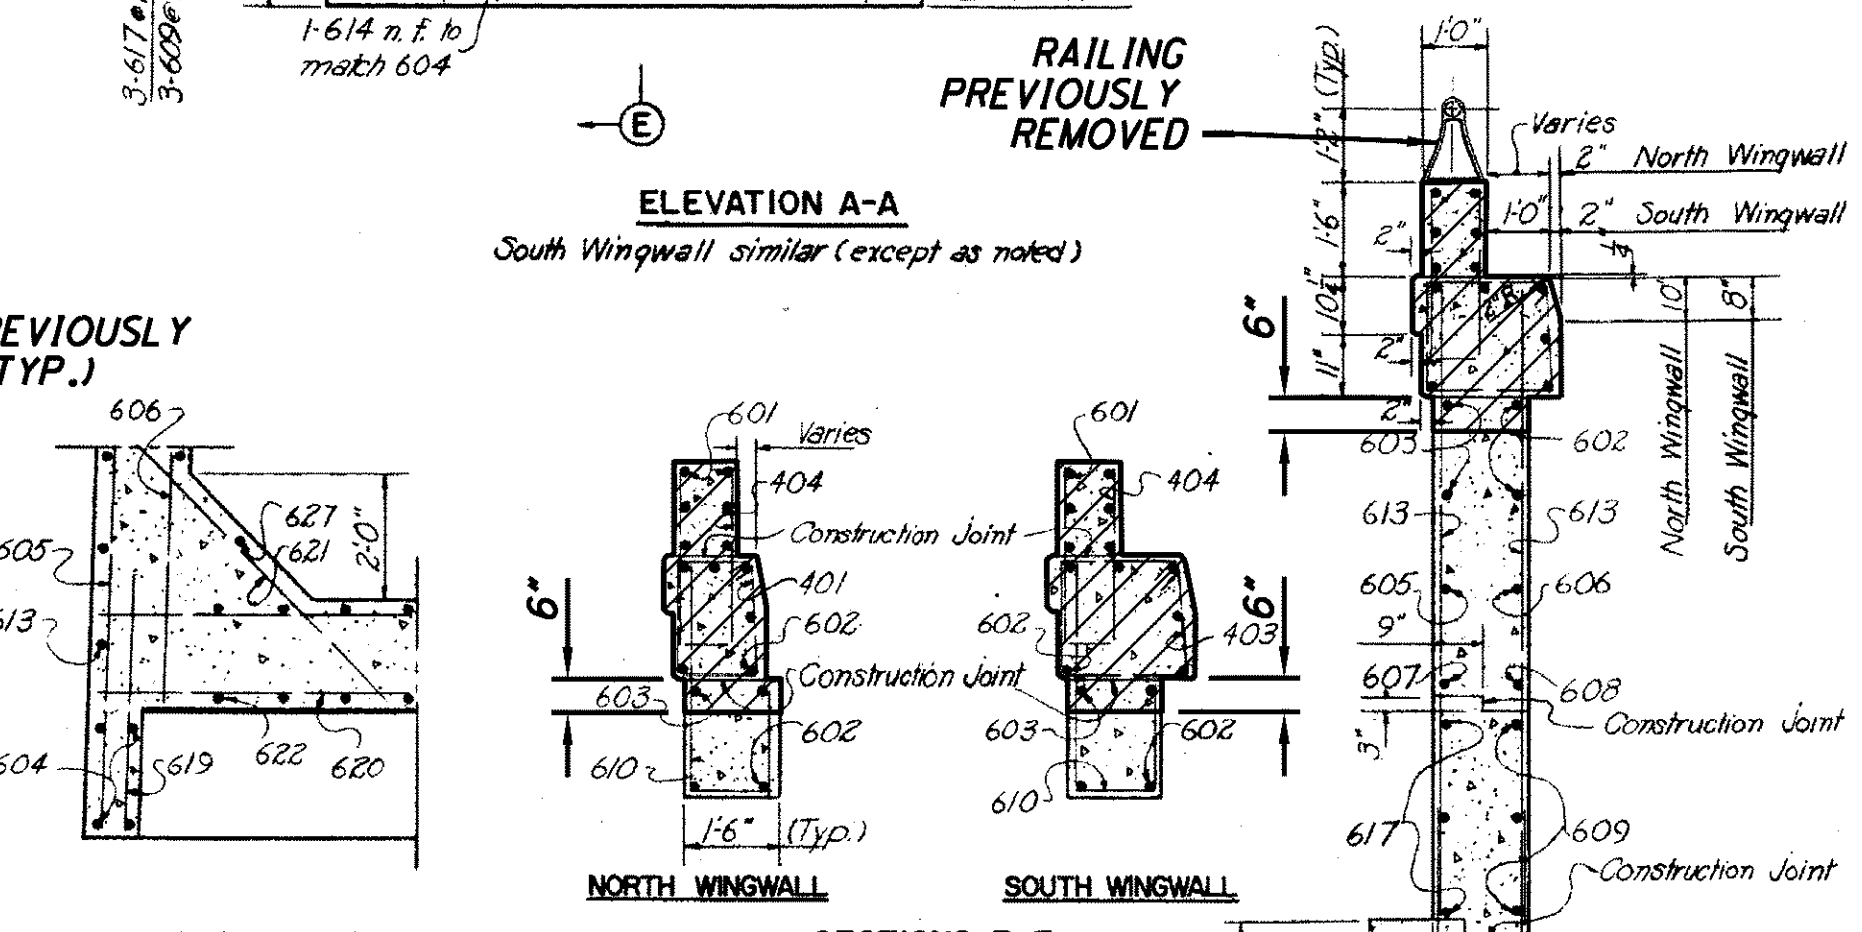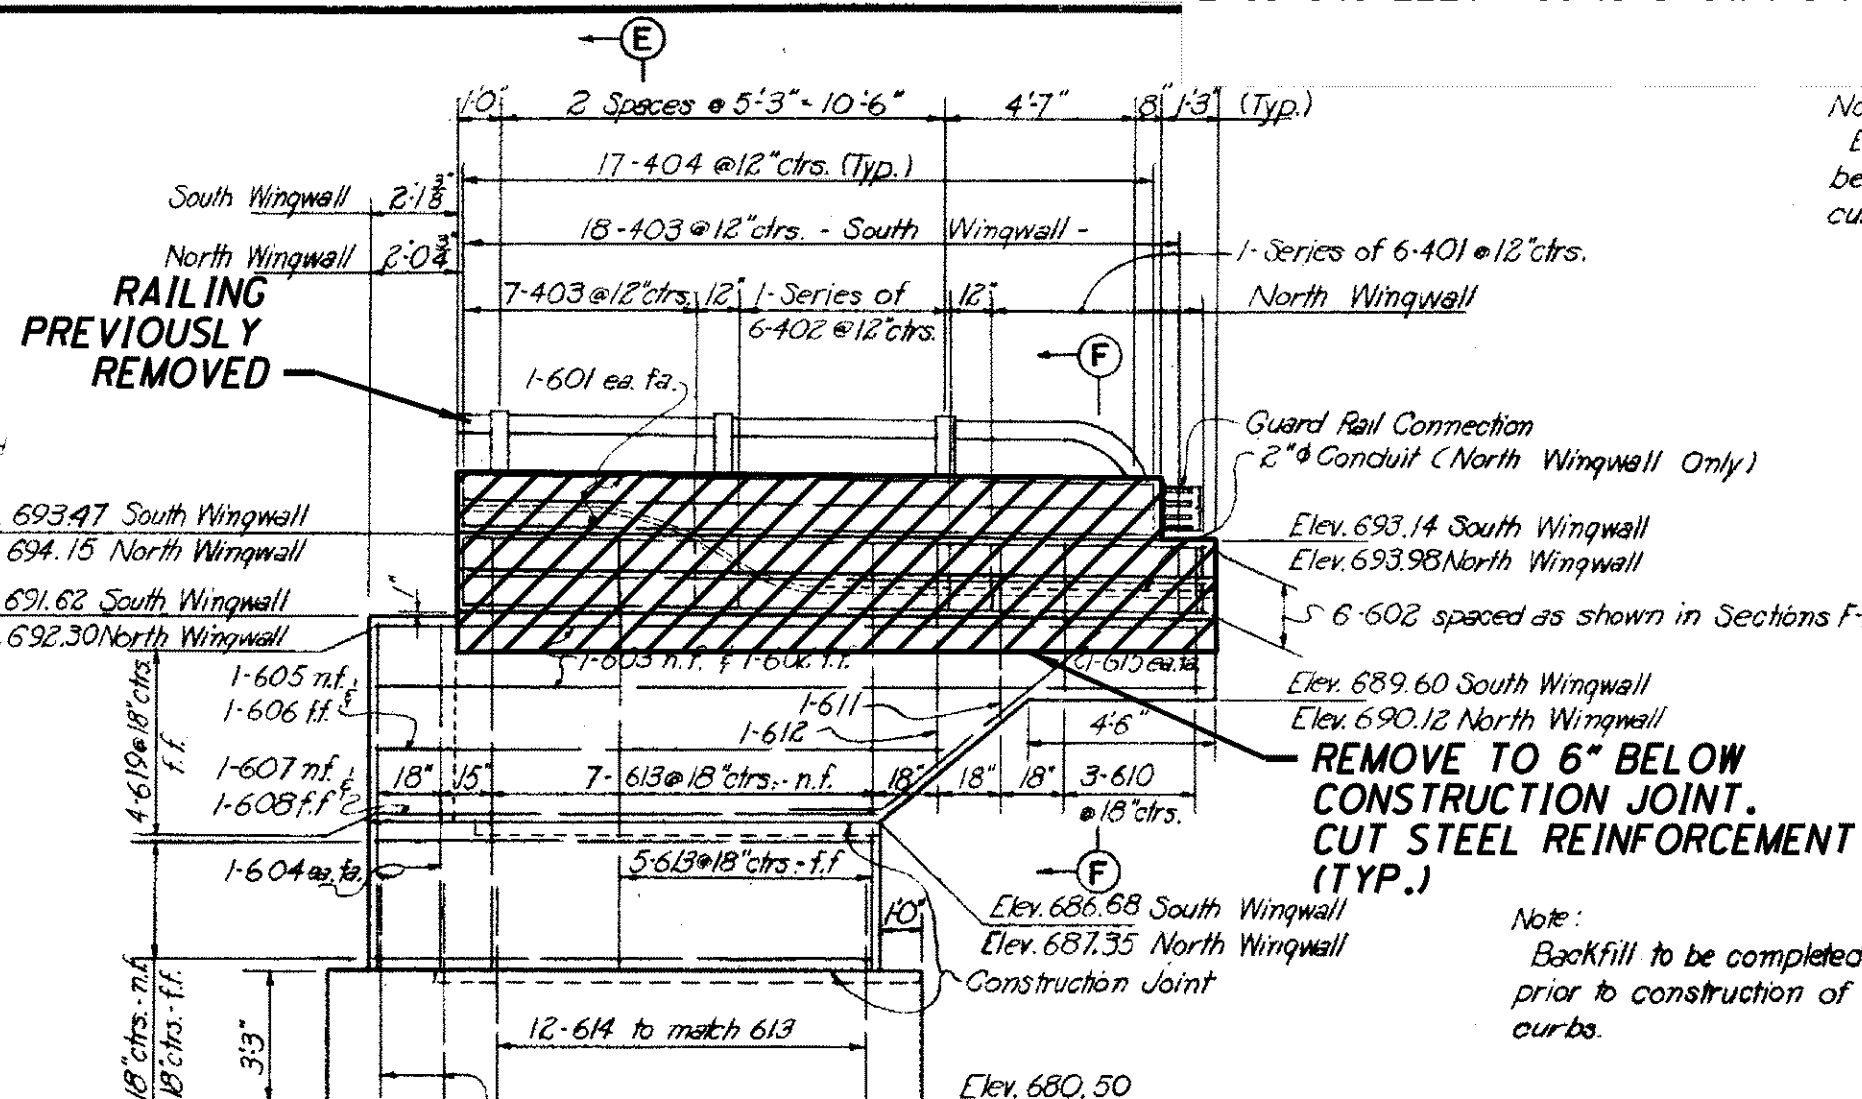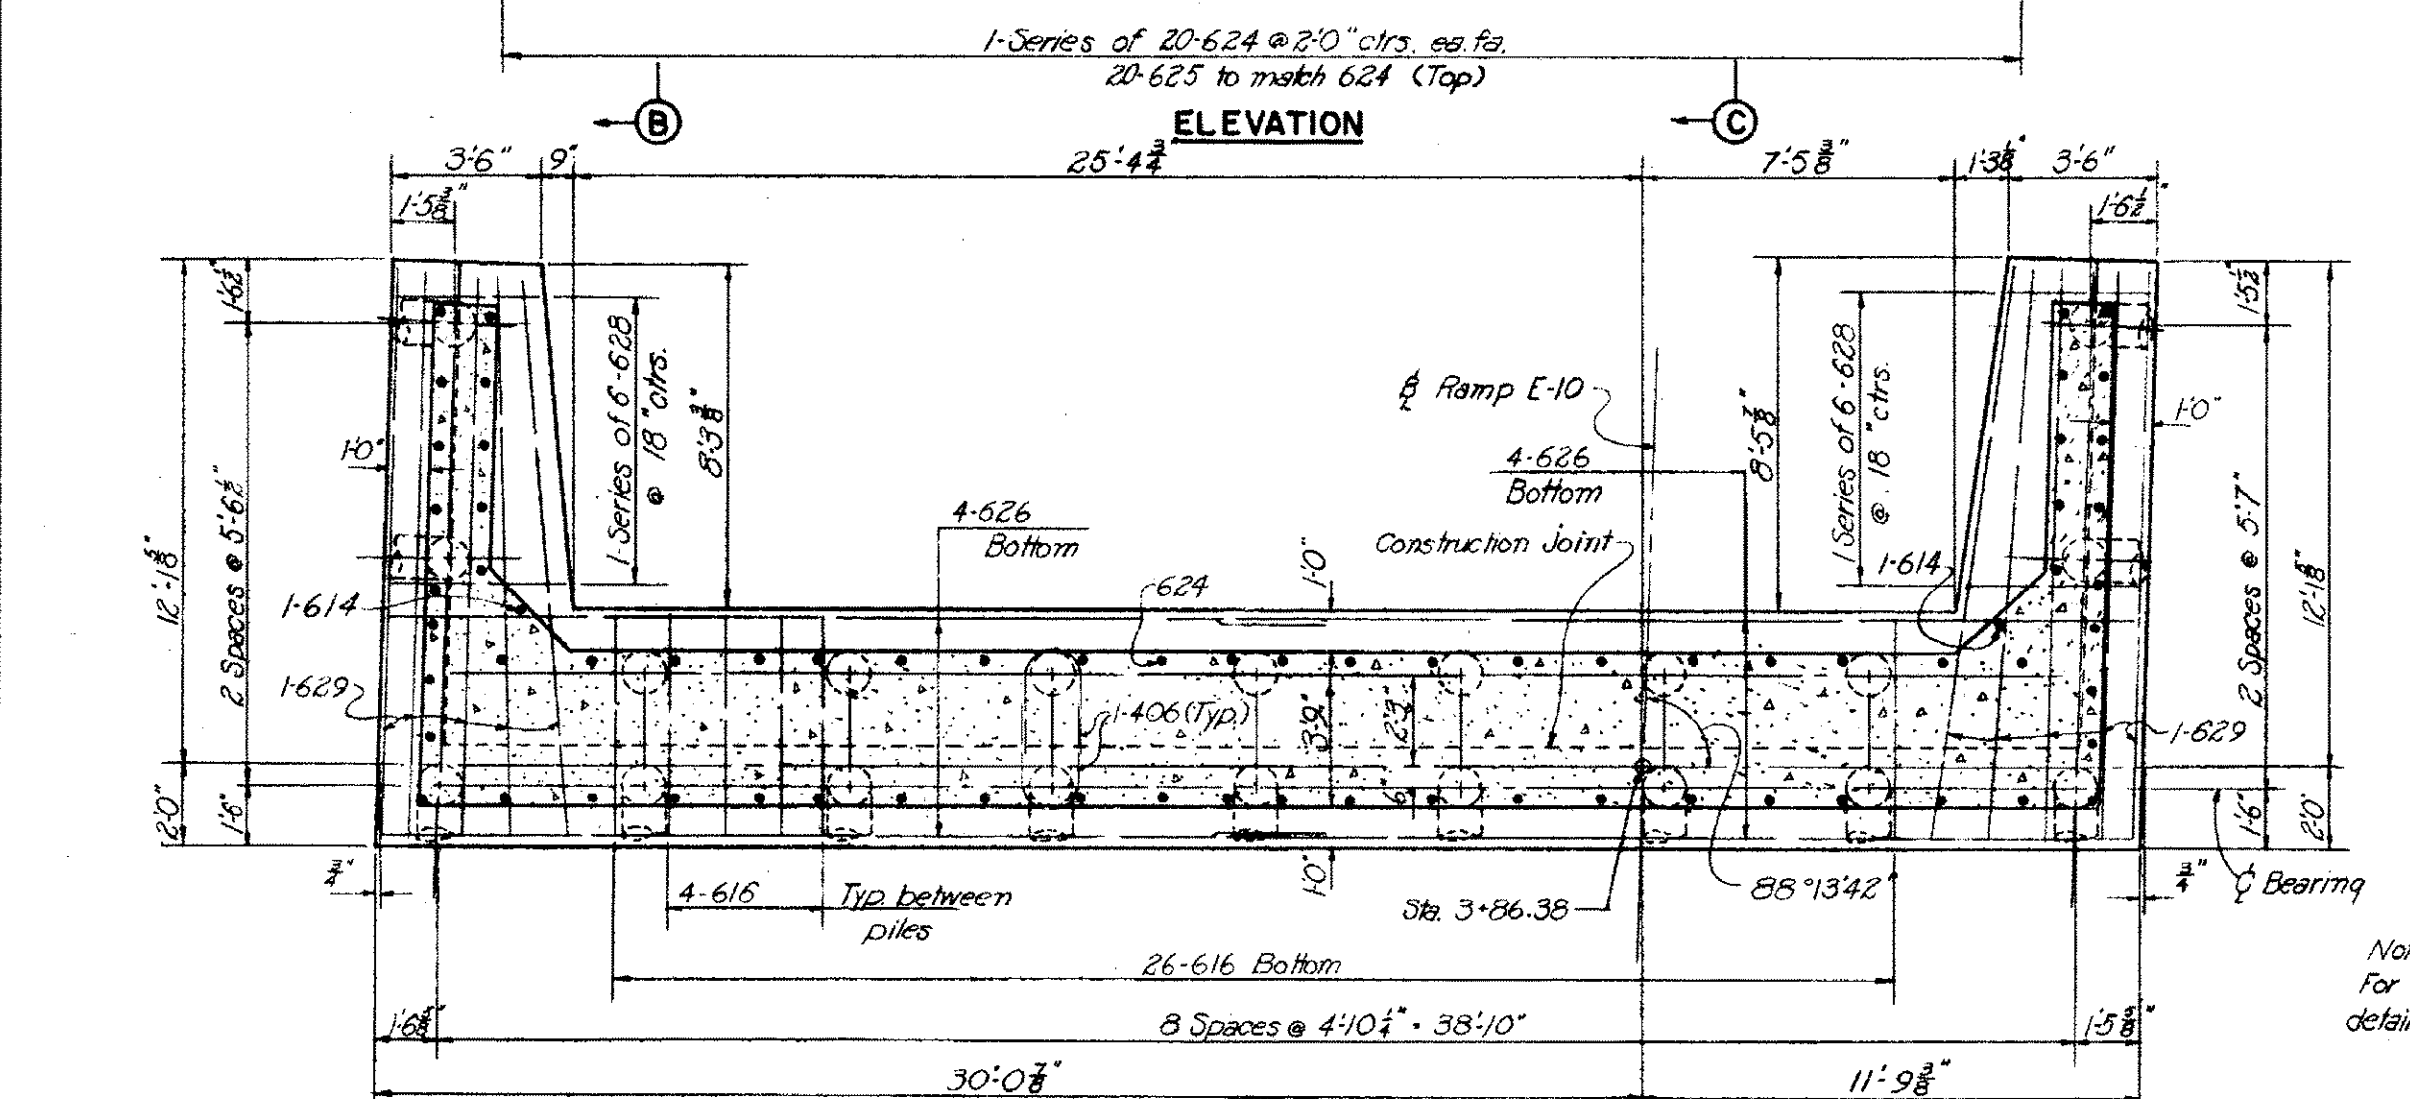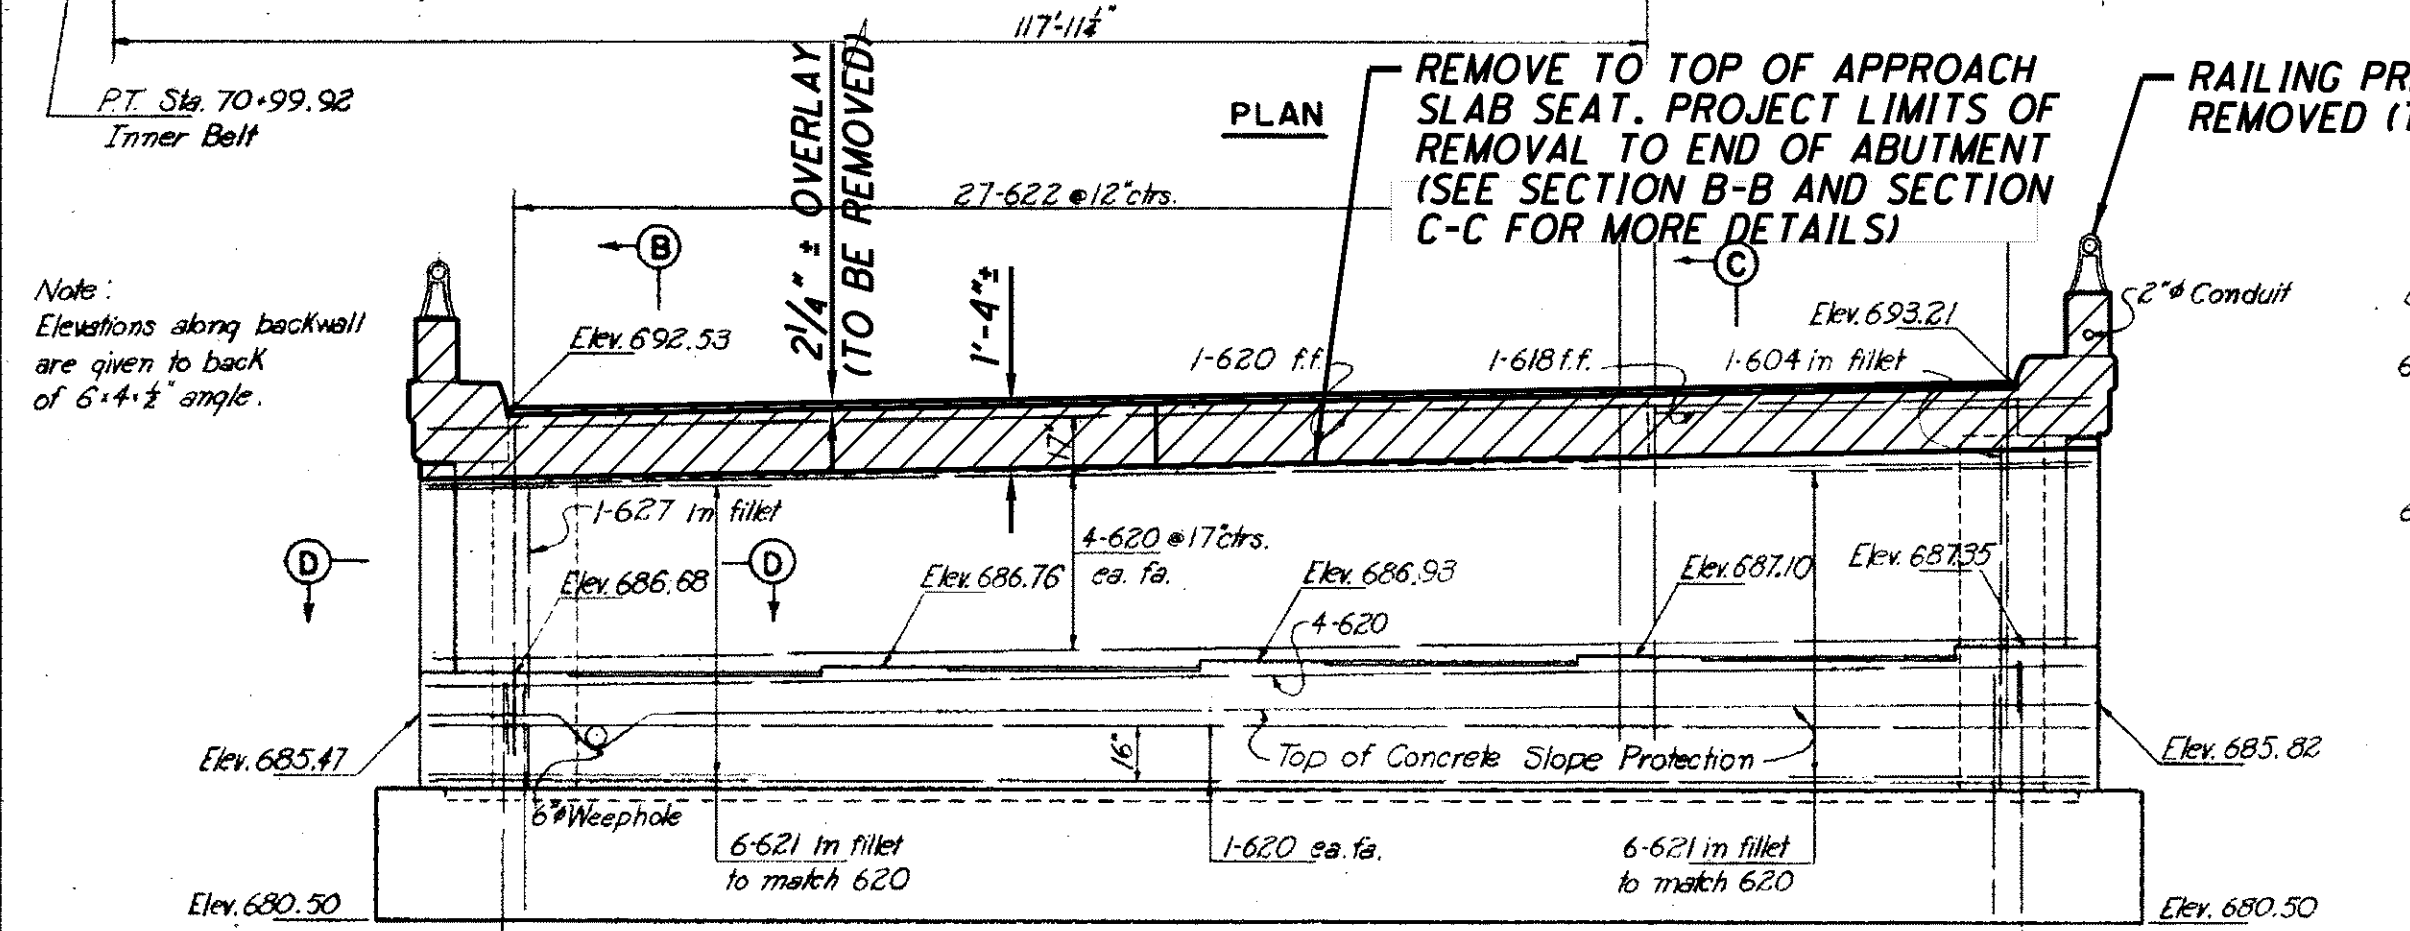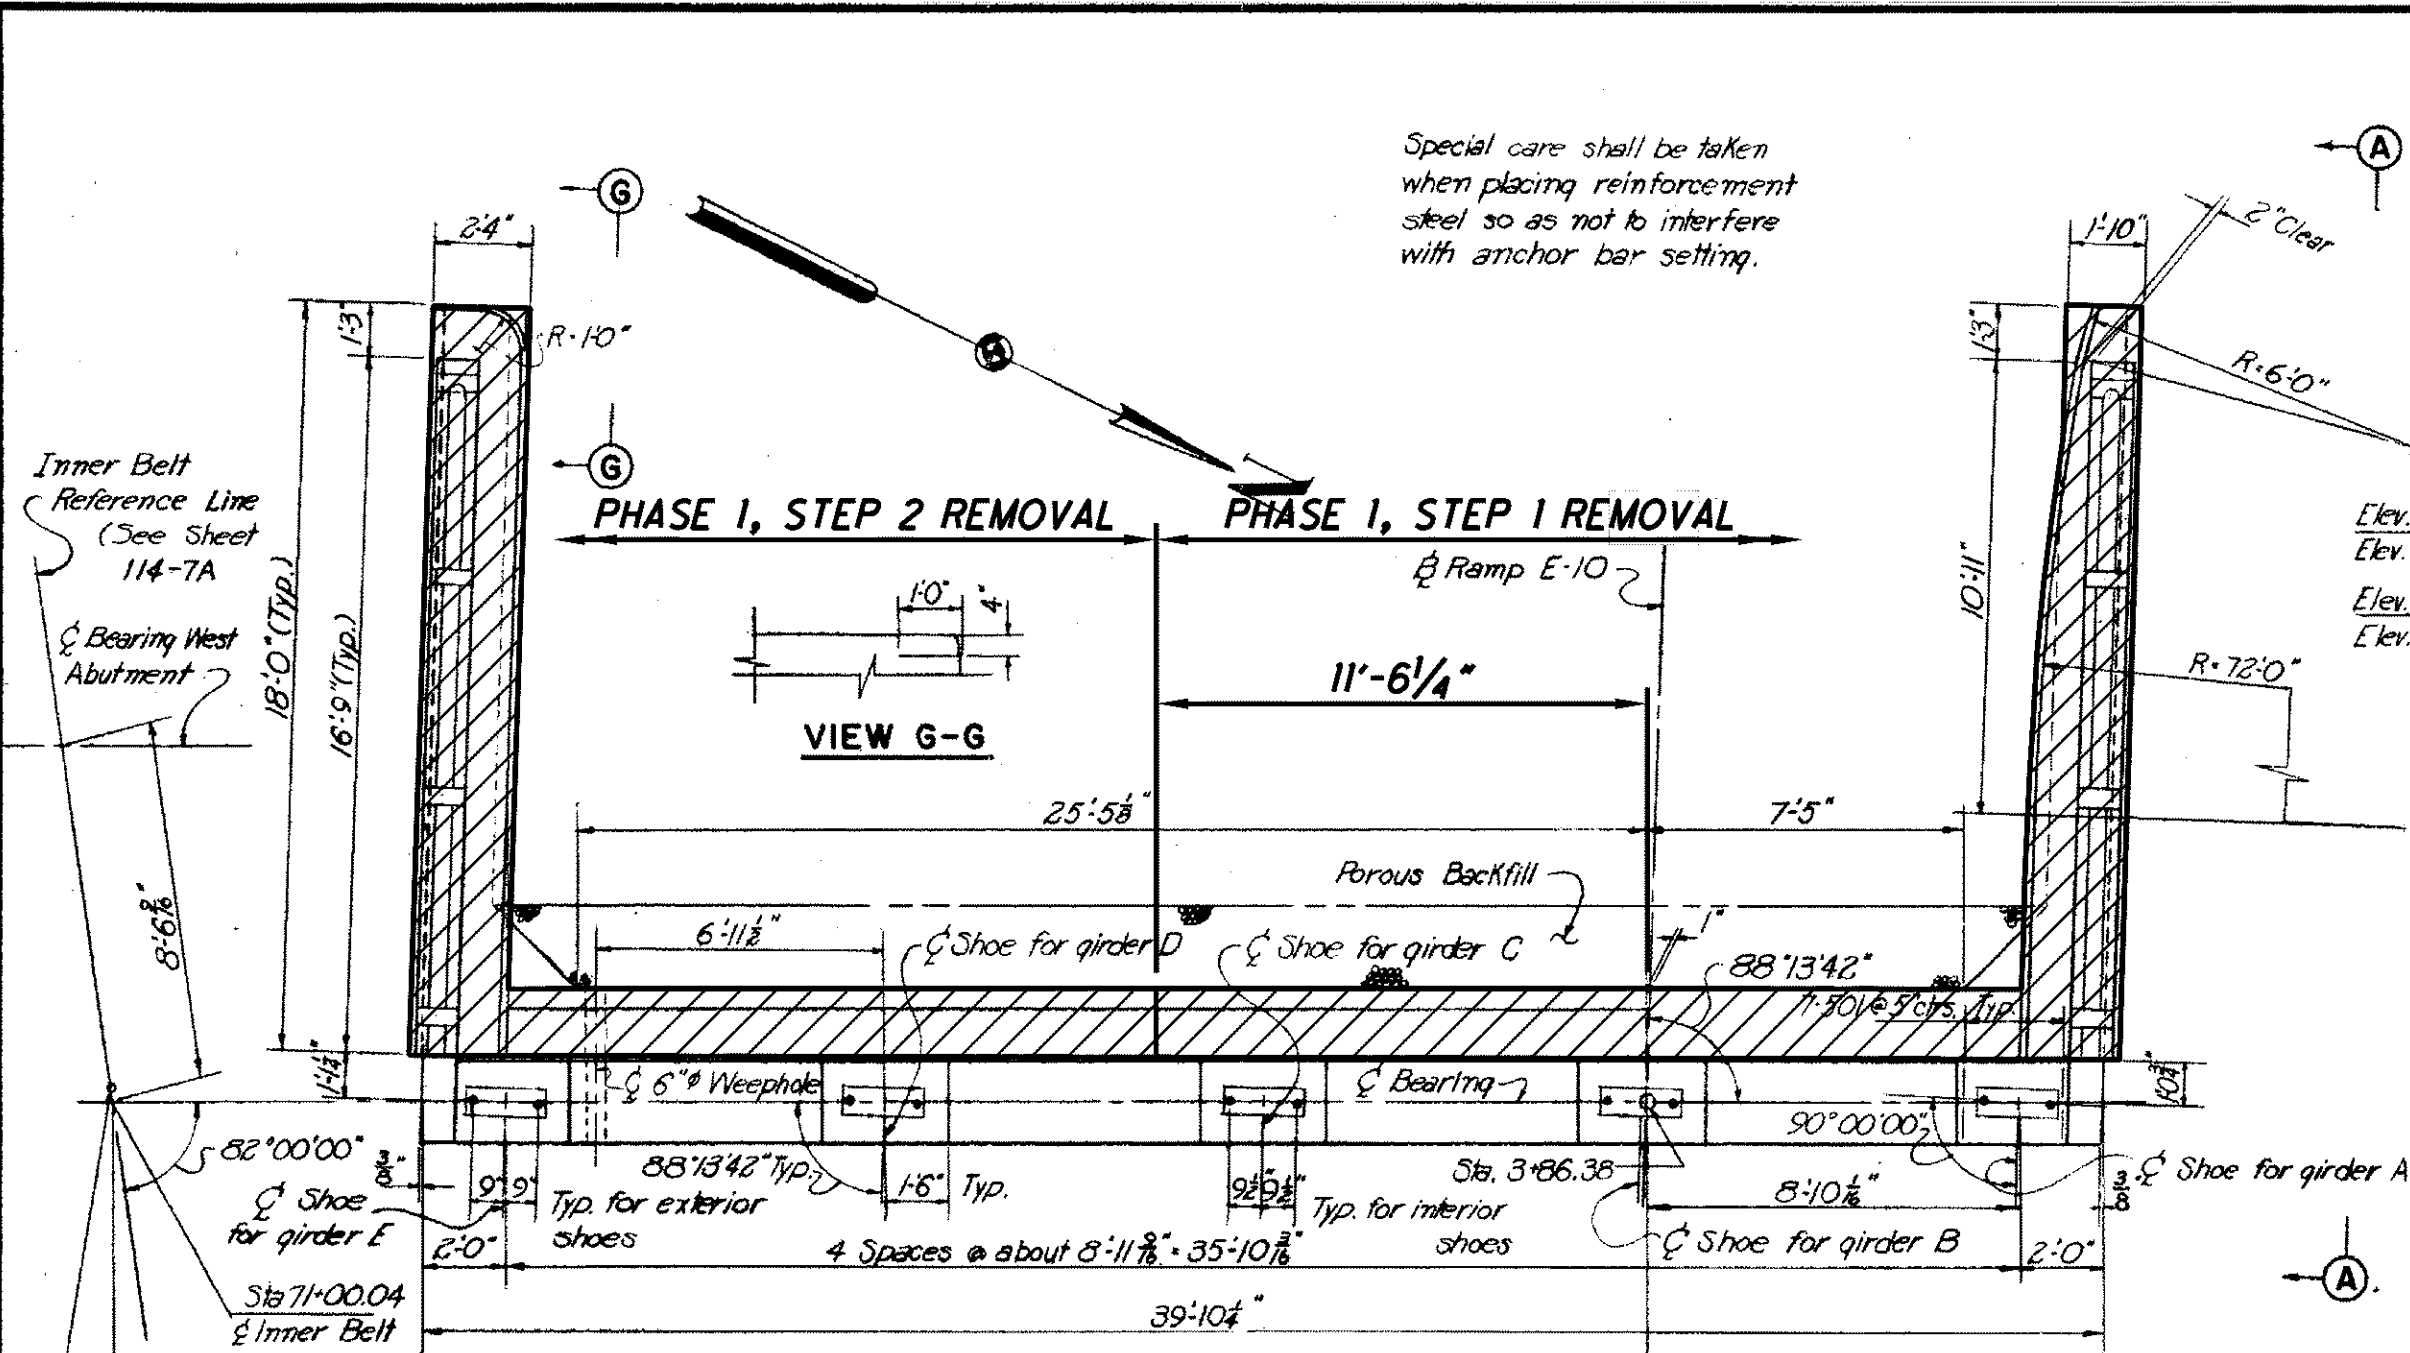

FOOTING PLAN

SECTION B-B

CUY-77-1597L - REAR ABUTMENT

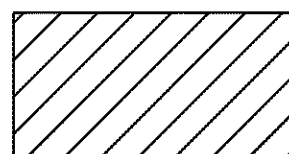

- INDICATES AREA TO BE REMOVED PER ITEM 202 PORTIONS OF STRUCTURE REMOVED, OVER 20 FOOT SPAN, AS PER PLAN

Note: Prefix "AB" shall be assigned to all bar marks.

FED. ROADS DIV. NO.	STATE	FED. AID PROJ. NO.
2	OHIO	

CUYAHOGA COUNTY
CITY OF CLEVELAND
CUY-21-1532
CUY-42-1842

116
181

DATE
03-14-11

REVISIONS
RECORD DRAWINGS

NO.

DESIGN AGENCY

WALSH HNTB

CLEVELAND'S INNER BELT BRIDGE

BRIDGES
10 & 11


REMOVAL DETAILS - 3

BRIDGE NO. CUY-77-1597 L AND CUY-90-1651 L
I-90WB AND I-77SB RAMP OVER E 14TH STREET

CUY-90-14.90
PID No. 77332 / 85531

14 / 38


14
38

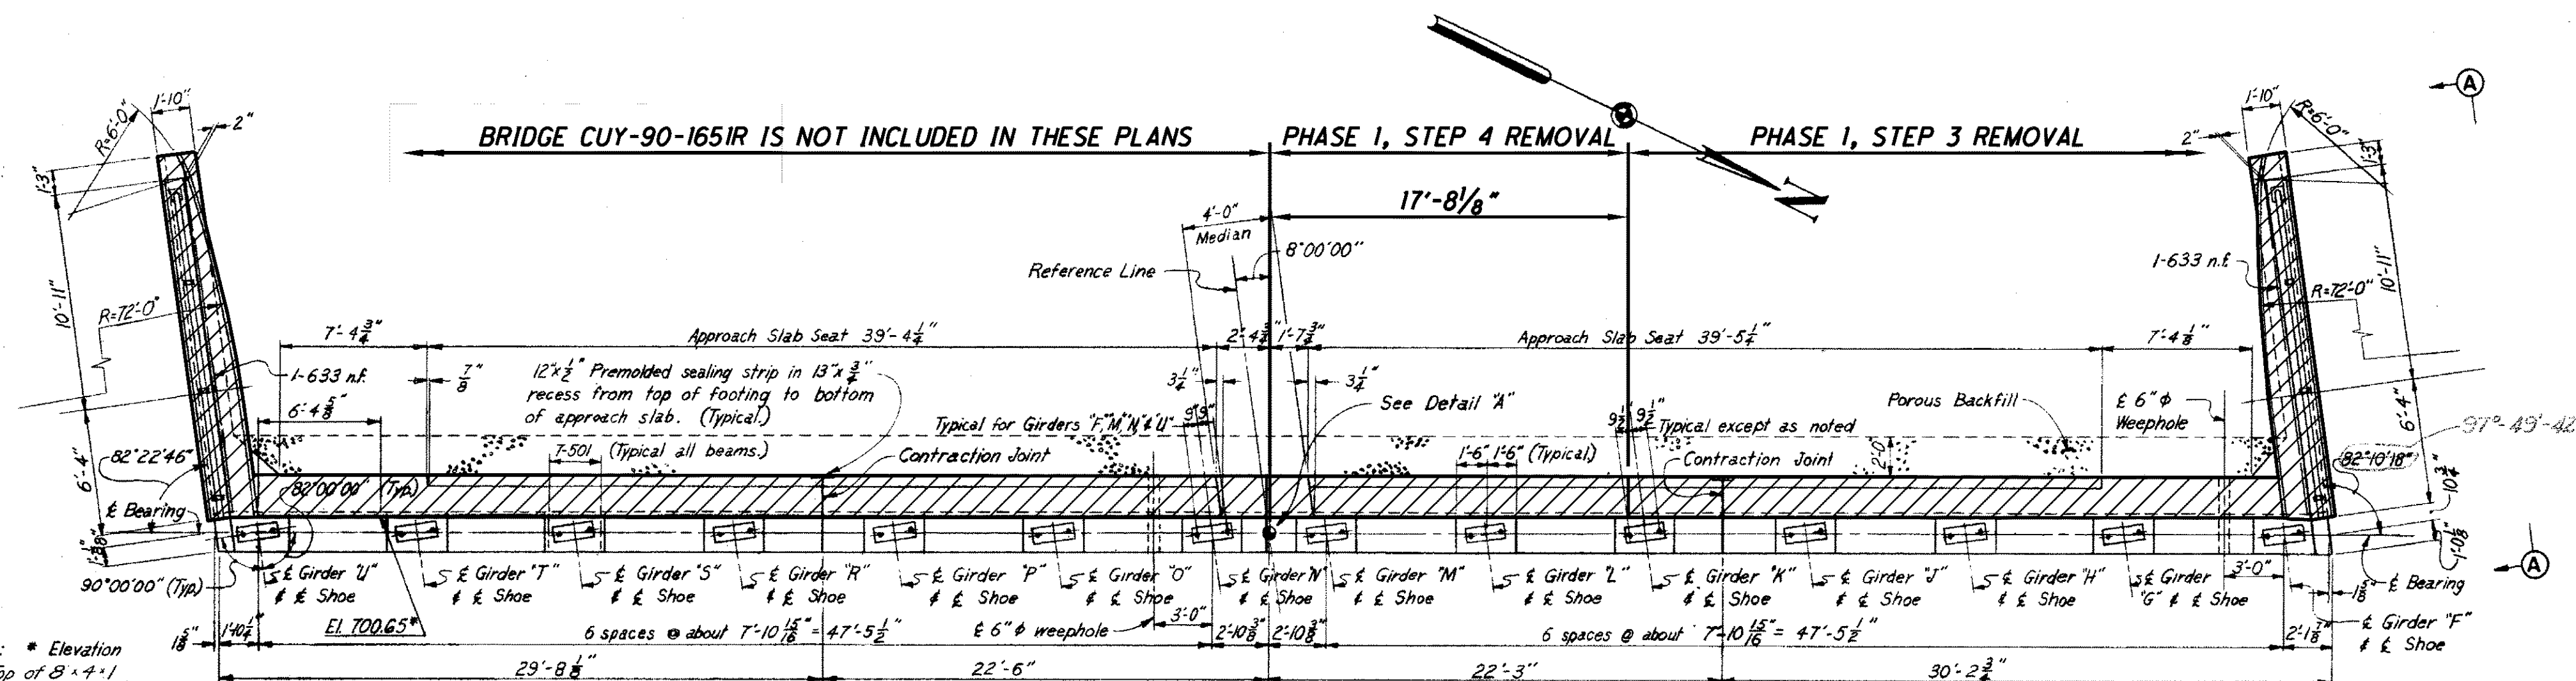


PLAN

REMOVE TO TOP OF APPROACH
SLAB SEAT. PROJECT LIMITS OF
REMOVAL TO END OF ABUTMENT
SEE SECTION B-B AND C-C FOR
MORE DETAILS (TYP.)

2 1/4" OVERLAY
TO BE REMOVED

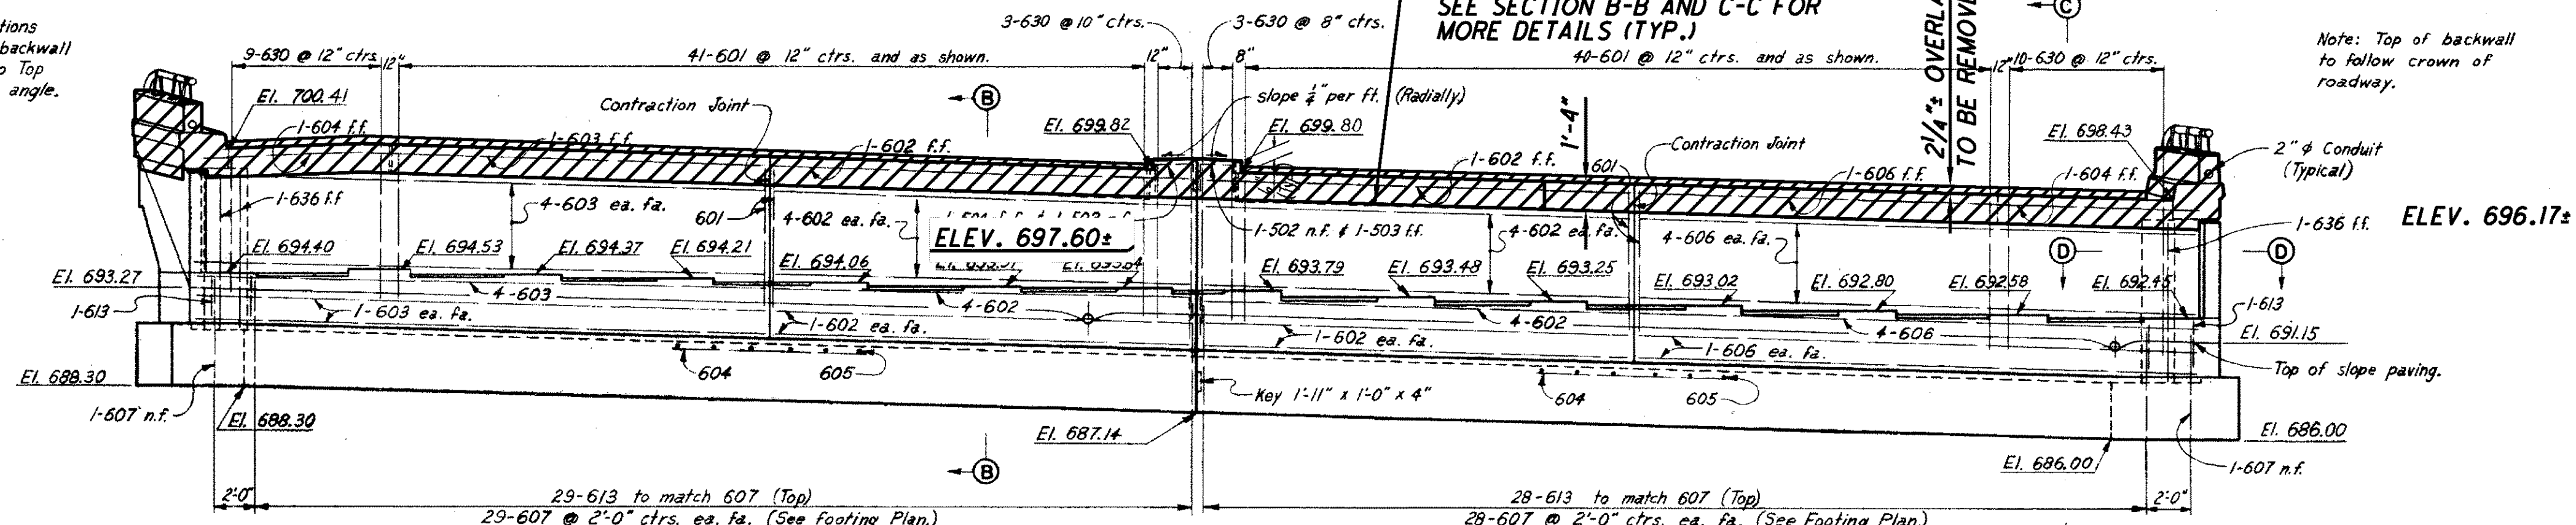

ELEVATION

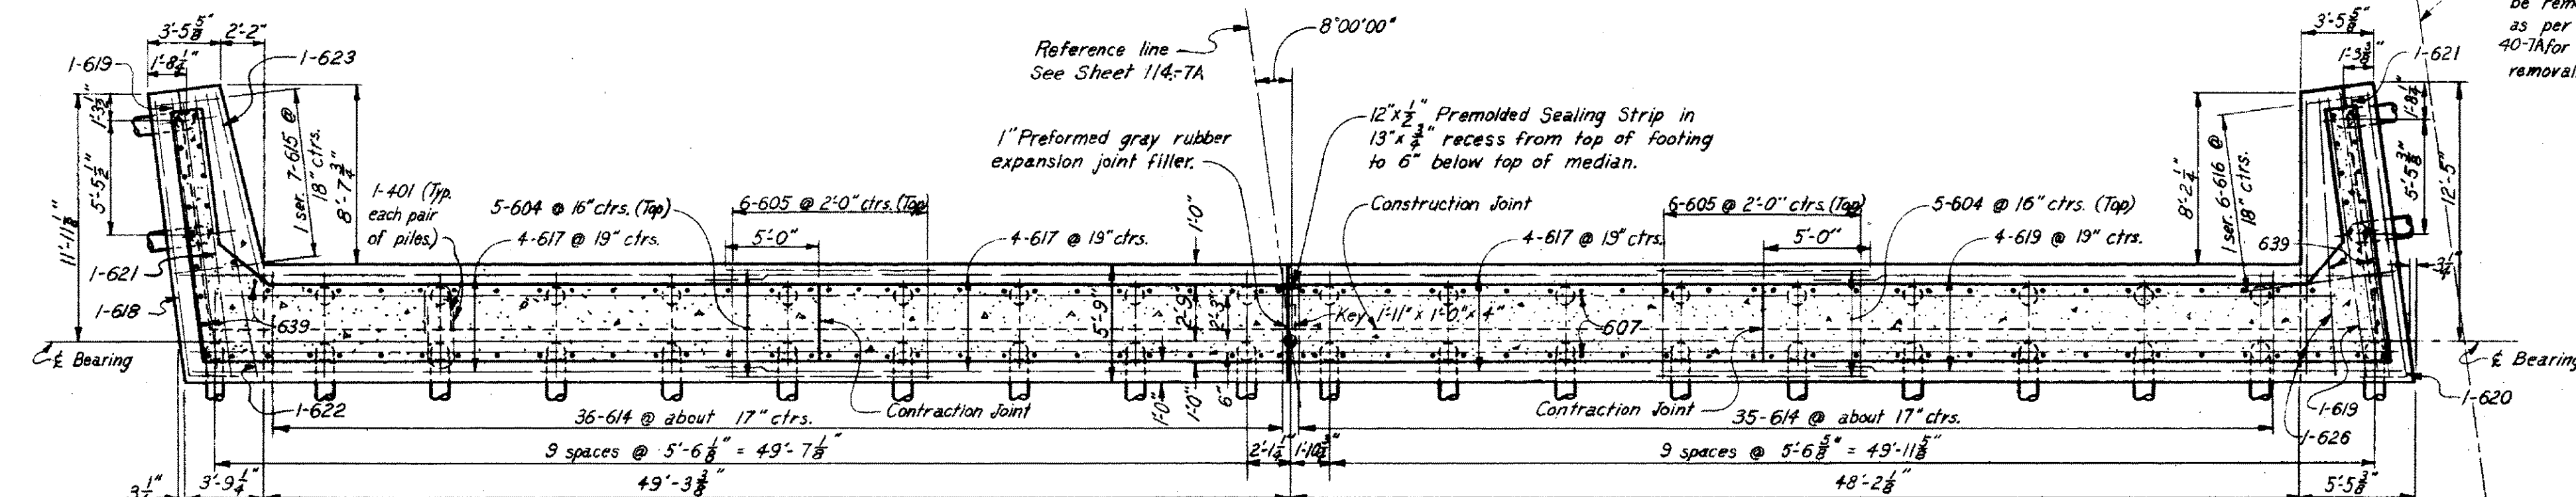


FOOTING PLAN

NOTES:

1. EXISTING ELEVATIONS SHOWN ON THE ORIGINAL BRIDGE PLANS HAVE NOT BEEN ADJUSTED TO THE CURRENT PROJECT SURVEY ELEVATIONS. ELEVATIONS NEED TO BE ADJUSTED TO THE CURRENT PROJECT SURVEY ELEVATIONS. FOR REAR ABUTMENT, PIER1, PIER2, PIER3 AND FORWARD ABUTMENT THE ELEVATION ADJUSTMENT IS APPROXIMATELY 0.94, 0.76, 0.70, 0.66 AND 0.64 FEET LOWER RESPECTIVELY THAN EXISTING ELEVATIONS SHOWN ON THE ORIGINAL BRIDGE PLANS.

2. FOR SECTION B-B AND C-C SEE SHEET 15/38.

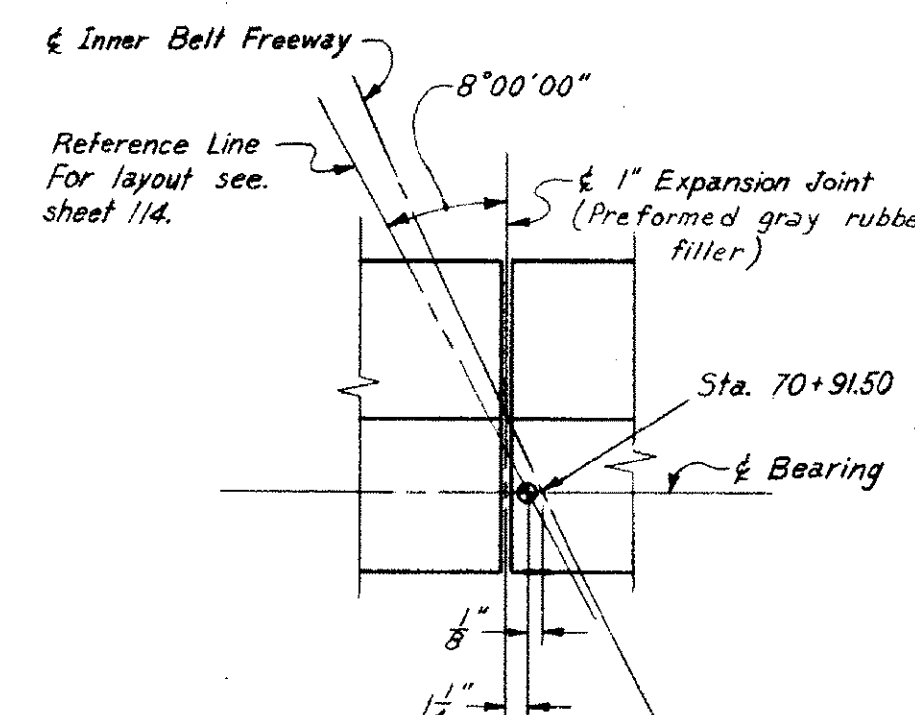

DETAIL "A"
Scale: 1/2" = 1'-0"

NOTES:

All piles shall be 12" ϕ Cast-in-Place reinforced Concrete.
All battered piles shall be battered 3 in 12 in direction shown.
Pile spacings are given along bottom of footing.
For details of end dam, see Sheet 173-7A
For Slope Protection details, see Sheet 174-7A
For location of lighting conduit, see Sheet 176-7A
For Railing details and Guard Rail connection details, see Sheet 175-7A
For sections, see Sheet 117-7A
n.f. = near face; f.f. = far face; ea. fa. = each face.

Backfill shall be placed prior to placing of curb.

H.N.T.B. BR. NO. 4		PART 7A	
HOWARD, NEEDLES, TAMMEN & BERGENDOFF CONSULTING ENGINEERS KANSAS CITY CLEVELAND NEW YORK			
WEST ABUTMENT			
INNER BELT FREEWAY OVER EAST 14th ST.			
BR. NO. CUY-42-1854		STA. 70+89.23	
Scale: 3/16" = 1'-0"		STA. 73+96.25	
Except as noted			
WILLOW-INNER BELT FREEWAY			
CLEVELAND		CUYAHOGA COUNTY OHIO	
DRAWN C.M. TRACED	CHECKED H.R.L.	REVIEWED J.C.T.	REVISED 6-17-62
DATE 1-14-59	DATE 1-22-59	DATE 11-13-57	SHEET 116

CUY-90-1651L/R - REAR ABUTMENT




1. EXISTING ELEVATIONS SHOWN ON THE ORIGINAL BRIDGE PLANS HAVE NOT BEEN ADJUSTED TO THE CURRENT PROJECT SURVEY ELEVATIONS. ELEVATIONS NEED TO BE ADJUSTED TO THE CURRENT PROJECT SURVEY ELEVATIONS. FOR REAR ABUTMENT, PIER1, PIER2, PIER3 AND FORWARD ABUTMENT THE ELEVATION ADJUSTMENT IS APPROXIMATELY 0.94, 0.76, 0.70, 0.66 AND 0.64 FEET LOWER RESPECTIVELY THAN EXISTING ELEVATIONS SHOWN ON THE ORIGINAL BRIDGE PLANS.

Note: Prefix "AD" shall be assigned to all bar marks.

119
181

CUYAHOGA COUNTY
CITY OF CLEVELAND
CUY-21-15.32
CUY-42-18.42

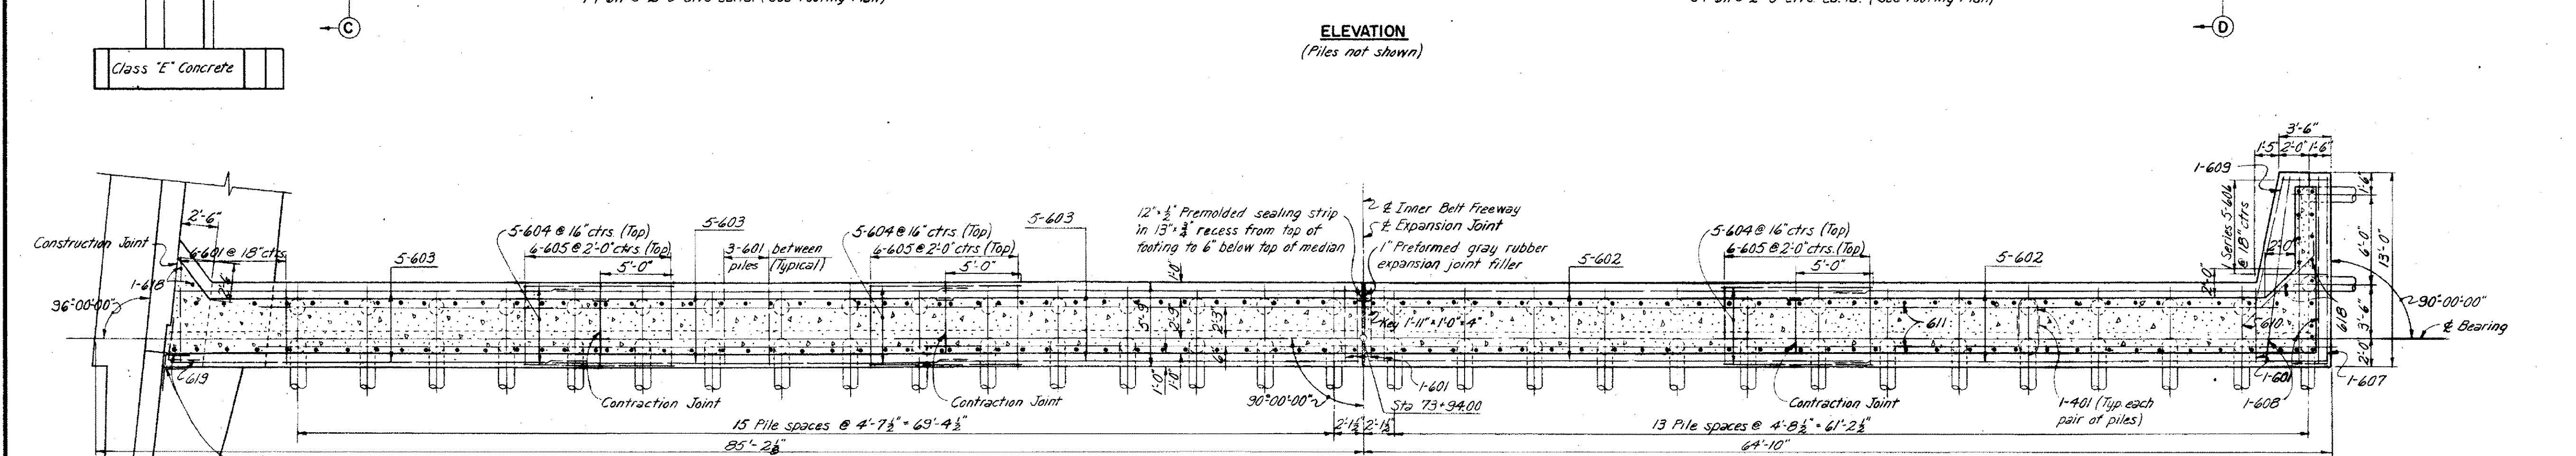

NOTES:

NOTES:
All piles shall be 12" Cast-in-place reinforced concrete.
All battered piles shall be battered 3 in 12 in direction shown.
Pile spacings are given along bottom of footing.
for details of end dam, see sheet 173-7A;
for details of masonry piers, see sheet 173-7A.
Reinforcement bars shall be 3 inches clear from bottom of footing and 2 inches elsewhere.
For Reinforcement Schedule, see sheet 120-7A.
For location of lighting conduit, see sheet 176-7A.
For Railing details, Railing Post spacing and Guard Rail connection details, see sheet 175-7A.

For Slope Protection details, abutment details, and additional notes, see sheet 120-7A
n.f. = near face, f.f. = far face, ea. fa. = each face

HOWARD, NEEDLES, TAMMEN & BERGENDOFF
CONSULTING ENGINEERS
KANSAS CITY CLEVELAND NEW YORK

EAST ABUTMENT

INNER BELT FREEWAY OVER EAST 14th ST.

BR. NO. CUY - 42-1854 STA. 70 + 89.23

Scale: 3/16" = 1'-0" STA. 73+96.25

WILL LOW-INNER BELT FREEWAY

WILLOW-INNER BELT FREEWAY
CLEVELAND CUYAHOGA COUNTY 0

DRAWN <i>CXB</i>	TRACED	CHECKED <i>FST</i>	REVIEWED <i>JCT</i>	REVISED
---------------------	--------	-----------------------	------------------------	---------

DATE 10-28-59	DATE	DATE 11-4-59	DATE 11-13-59	SHEET 11
---------------	------	--------------	---------------	----------

MENT

MILITARY

DATE _____

REVISIONS

No.

DESIGN AGENCY

BRIDGES

DATE _____

VIEWED

AWN
T W

NED

--	--

REMOVAL DETAILS - 5

BRIDGE NO. CUY-77-1597 L AND CUY-90-1651 L
L-90WB AND I-77SB RAMP OVER E 14TH STREET

CIV-00-1400

CUL-90-14:90
IPID No. 77332/85531

16


38



16

--	--

1

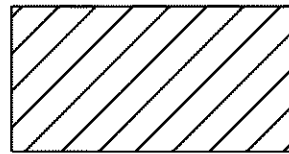




- INDICATES AREA TO BE REMOVED PER ITEM 202 PORTIONS OF STRUCTURE REMOVED, OVER 20 FOOT SPAN, AS PER PLAN

BRIDGE CUY-90-1651R IS NOT INCLUDED IN THESE PLANS








BRIDGE CUY-90-1651R IS NOT INCLUDED IN THESE PLANS

NOTE:

1. EXISTING ELEVATIONS SHOWN ON THE ORIGINAL BRIDGE PLANS HAVE NOT BEEN ADJUSTED TO THE CURRENT PROJECT SURVEY ELEVATIONS. ELEVATIONS NEED TO BE ADJUSTED TO THE CURRENT PROJECT SURVEY ELEVATIONS. FOR REAR ABUTMENT, PIER1, PIER2, PIER3 AND FORWARD ABUTMENT THE ELEVATION ADJUSTMENT IS APPROXIMATELY 0.94, 0.76, 0.70, 0.66 AND 0.64 FEET LOWER RESPECTIVELY THAN EXISTING ELEVATIONS SHOWN ON THE ORIGINAL BRIDGE PLANS.

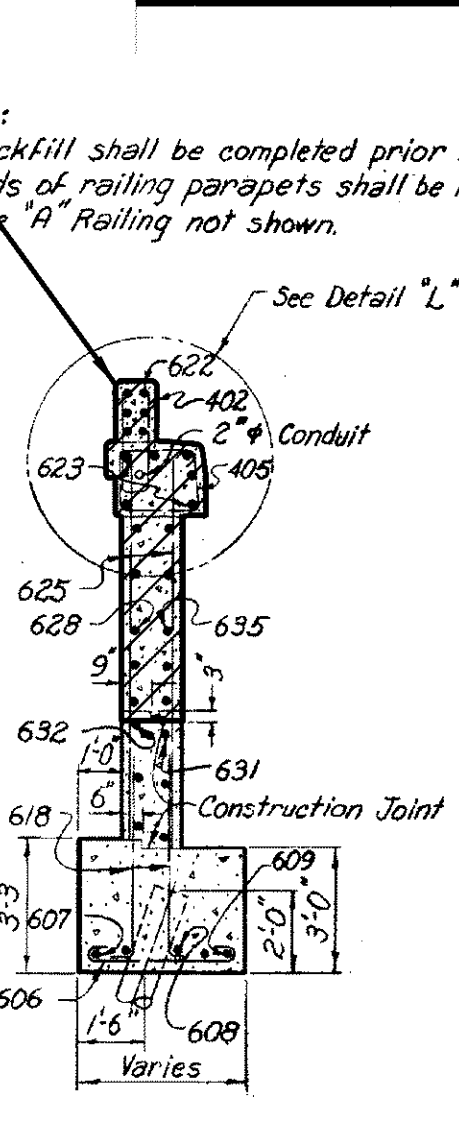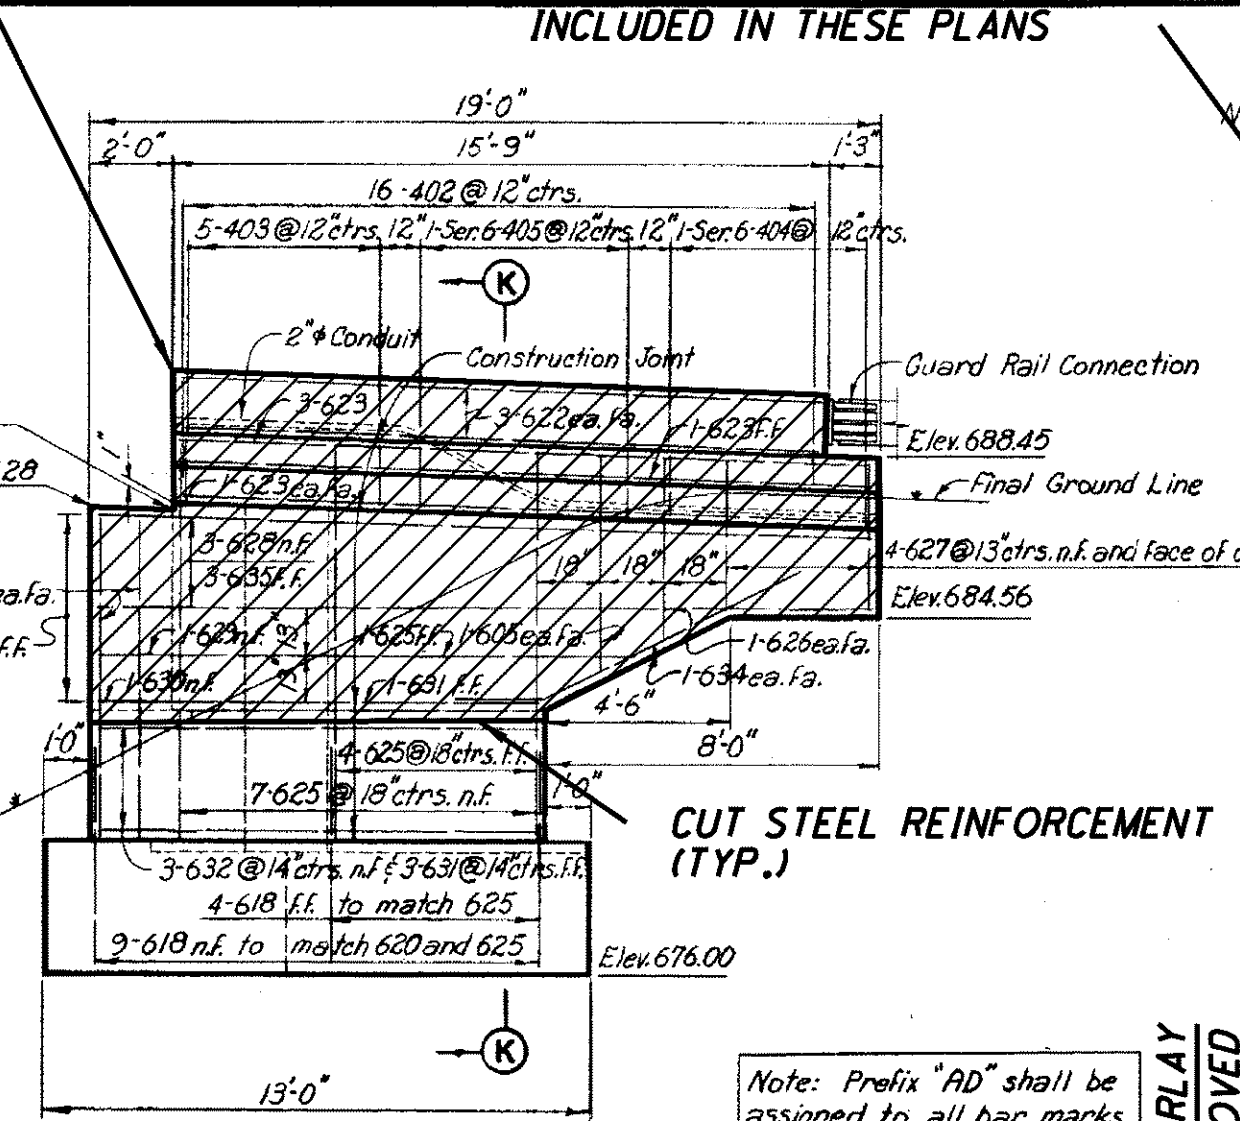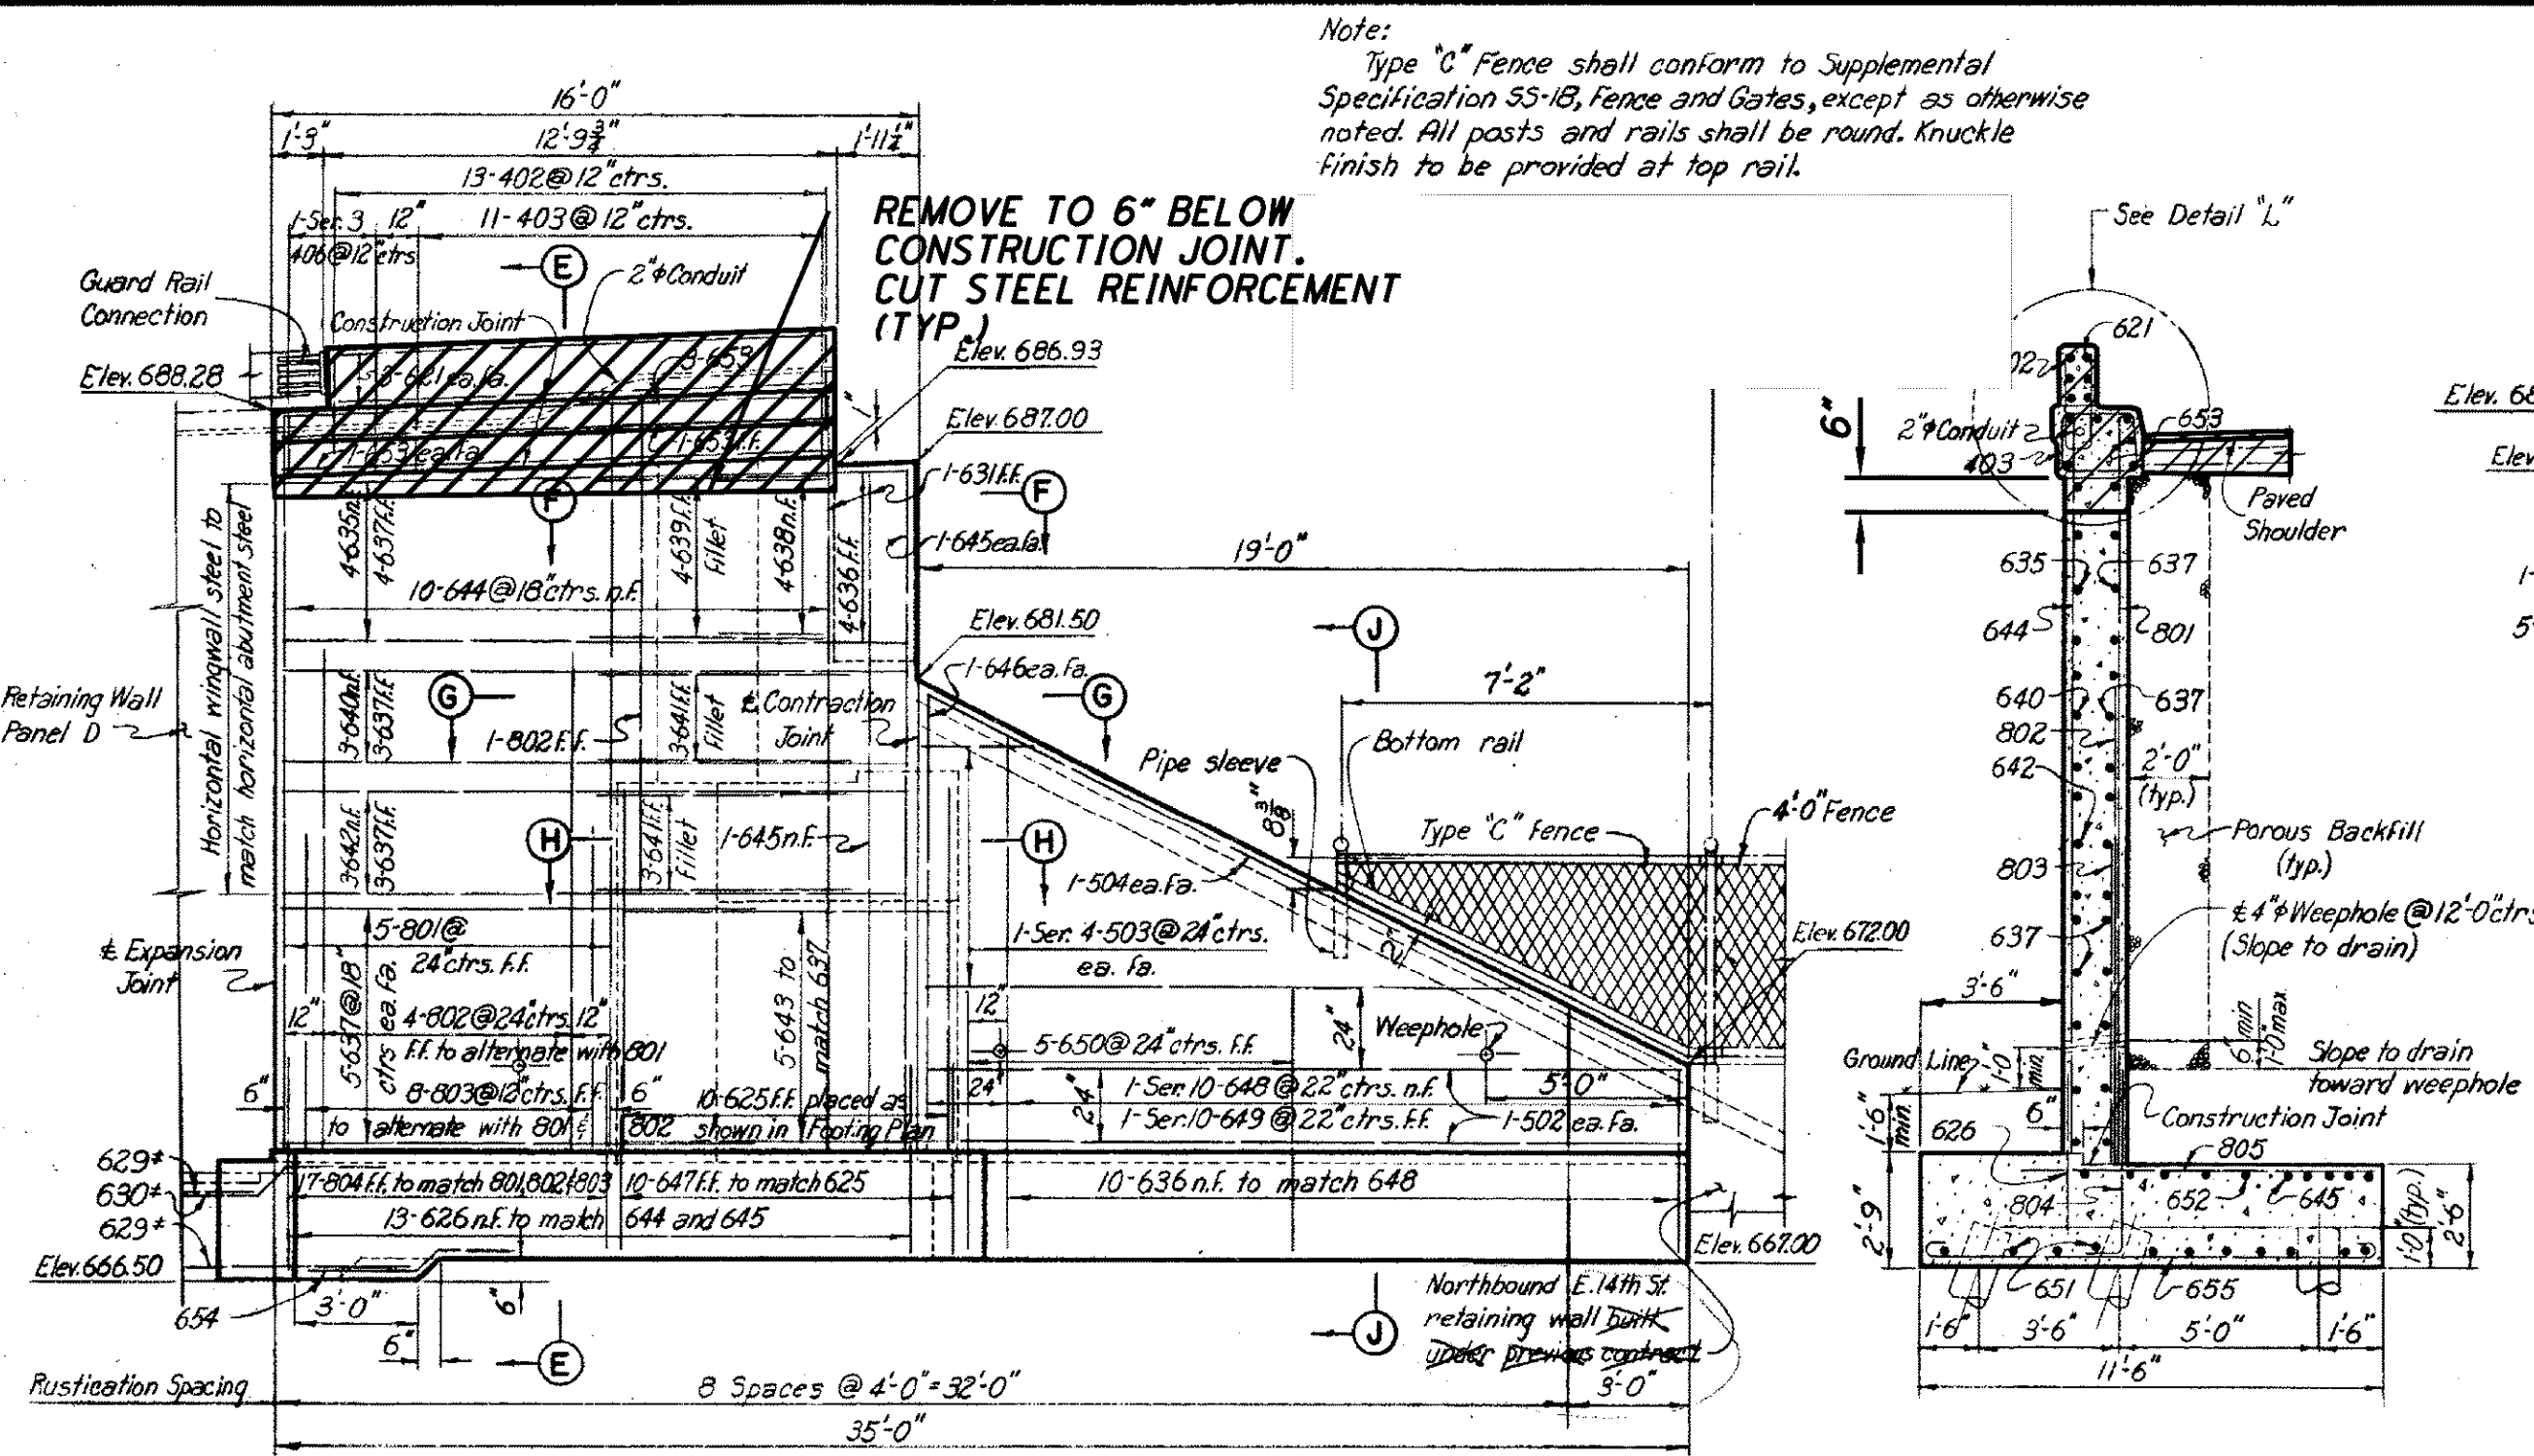

REINFORCEMENT SCHEDULE									
Mark	Number	Length	Type	Dimensions				Series	Weight
				A	B	C	D	Increment	(lbs.)
401	58	5'-10"	144	2'-0"	1'-10"				236
402	29	5'-9"	105	8"	2'-8"				111
403	10	6'-7"	109	1'-8"	1'-5"				17
404	1-Ser. 6	4'-7" to 5'-11"	109	8" to 4"	1'-5"			3 3/4"	21
405	1-Ser. 6	6'-1" to 6'-7"	109	15" to 18"	1'-5"			1 3/4"	25
406	1-Ser. 3	5'-3" to 6'-7"	109	10" to 18"	1'-5"			8"	12
501	151	4'-7"	105	1'-8"	1'-7"				122
502	4	18'-9"	Str.						78
503	1-Ser. 4	2'-9" to 14'-9"	Str.					4'-0"	73
504	2	20'-9"	Str.						43
601	32	6'-9"	100	5'-5"					933
602	10	33'-3"	Str.						439
603	48	27'-9"	Str.						2,201
604	19	10'-0"	Str.						255
605	20	5'-3"	Str.						158
606	1-Ser. 5	4'-6" to 5'-10"	100	3 3/4" to 4"				4"	39
607	1	14'-6"	104	18'-8"	2'-0"				22
608	3	12'-6"	Str.						56
609	1	9'-6"	Str.						14
610	8	7'-5"	108	6'-8"	10"	12			89
611	158	6'-2"	104	5'-6"	10"				1,463
612	20	8'-7"	105	3'-5"	2'-6"				977
613	10	28'-9"	Str.						891
614	17	34'-3"	Str.						594
615	120	19'-9"	112	11"	7'-6"	6'-2"	1'-5"		3,550
617	24	18'-7"	109	7'-6"	1'-5"				670
618	16	5'-8"	104	5'-0"	10"				136
619	3	5'-2"	128	3'-0"	2'-6"	1			24
620	7	7'-9"	Str.						81
621	6	12'-6"	Str.						-
622	6	15'-6"	Str.						151
623	6	18'-9"	Str.						181
624	15	20'-9"	Str.						467
625	22	9'-3"	Str.						306
626	13	9'-6"	Str.						101
627	8	9'-8"	Str.						42
628	3	18'-9"	Str.						84
629	1	12'-9"	Str.						19
630	1	10'-9"	Str.						16
631	6	7'-0"	Str.						63
632	3	12'-6"	104	1'-11"	10'-9"				56
633	1-Ser. 10	4'-9" to 6'-9"	Str.					1'-1/4"	133
634	2	8'-0"	108	1'-11"	7'-0"	6			27
635	7	15'-9"	Str.						166
636	19	4'-0"	Str.						114
637	20	11'-9"	Str.						353
638	4	5'-9"	128	4'-0"	1'-11"	1			35
639	4	8'-0"	141	6'-6"	10"				48
640	3	19'-6"	148	18'-8"	4'-0"	1			88
641	6	8'-2"	108	7'-6"	10"	12			74
642	3	18'-7"	104	15'-8"	3'-11"				64
643	5	24'-7"	125	7'-0"	3'-0"	2'-9"	1'-4"		165
644	10	18'-3"	Str.						274
645	8	17'-0"	Str.						204
646	2	11'-8"	Str.						35
647	10	5'-8"	104	4'-6"	10"				78
648	1-Ser. 10	2'-0" to 10'-6"	Str.					11'-1/4"	94
649	1-Ser. 10	5'-2" to 13'-8"	104	46" to 18"	10"			11'-3/4"	141
650	5	7'-2"	104	6'-6"	10"				54
651	17	14'-0"	Str.						231
652	5	18'-9"	Str.						126
653	6	13'-9"	Str.						124
654	11	13'-5"	118	2'-10"	6"	6"			89
655	16	12'-8"	100	11'-2"					300
656	1-Ser. 18	6'-0" to 9'-8"	100	48" to 64"				2'-1/4"	212
801	5	18'-6"	Str.						247
802	5	12'-0"	Str.						160
803	8	8'-0"	Str.						171
804	17	5'-8"	104	4'-9"	1'-1"				433
805	18	9'-0"	Str.						257
Total									20,468

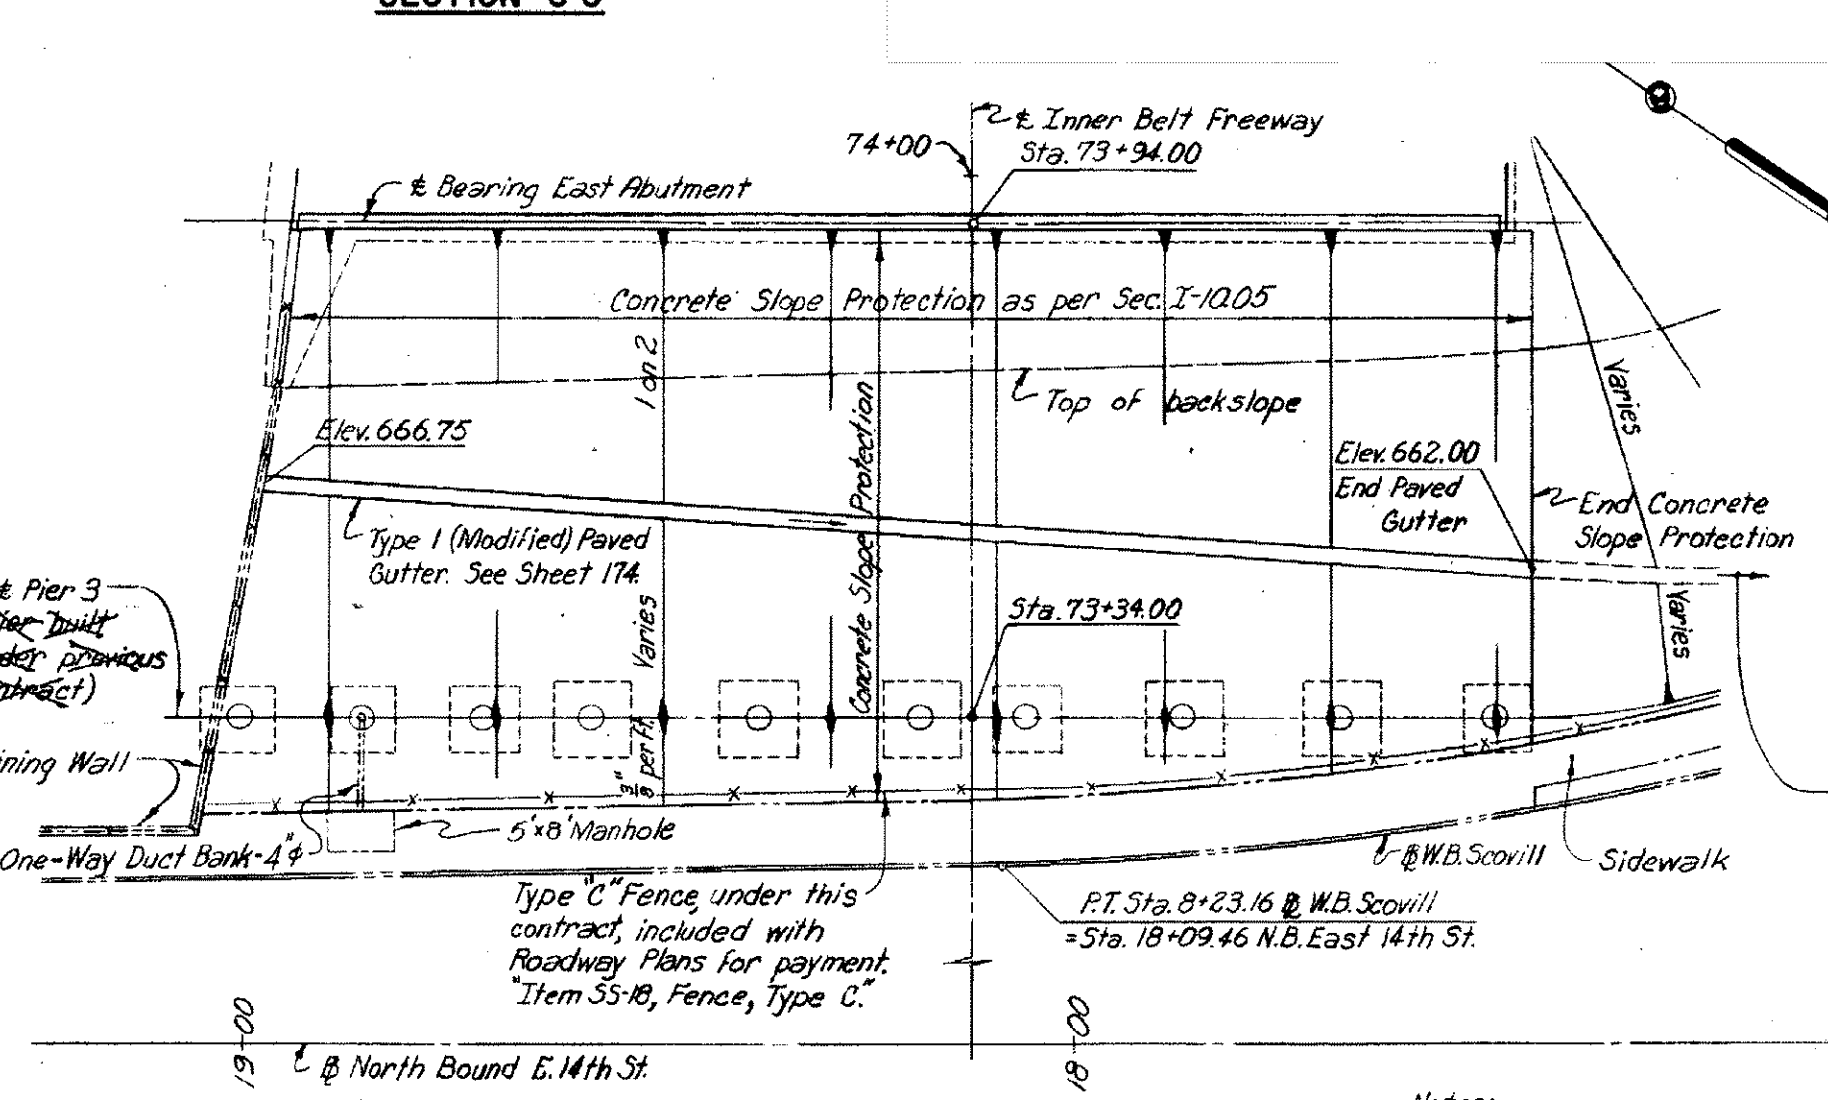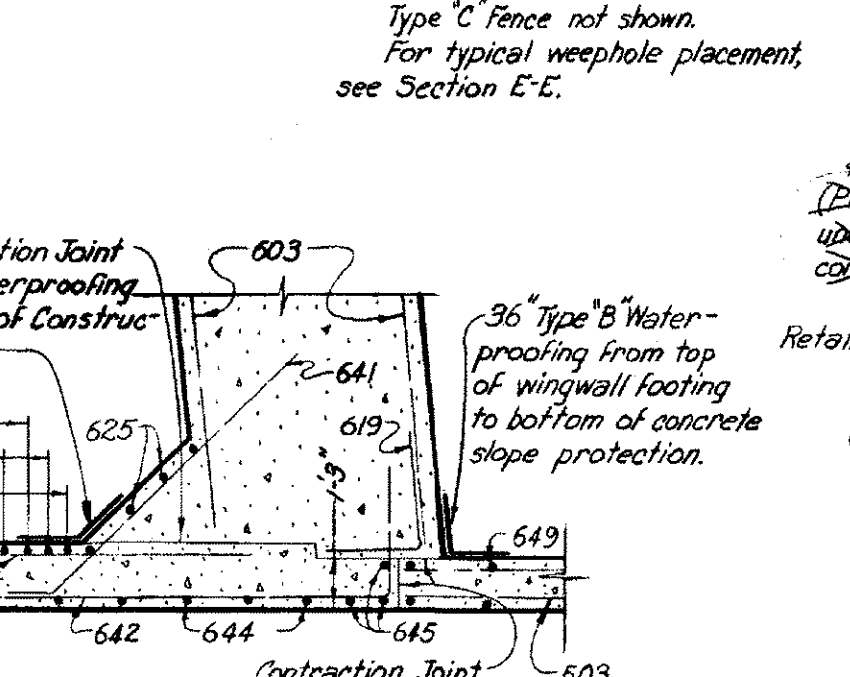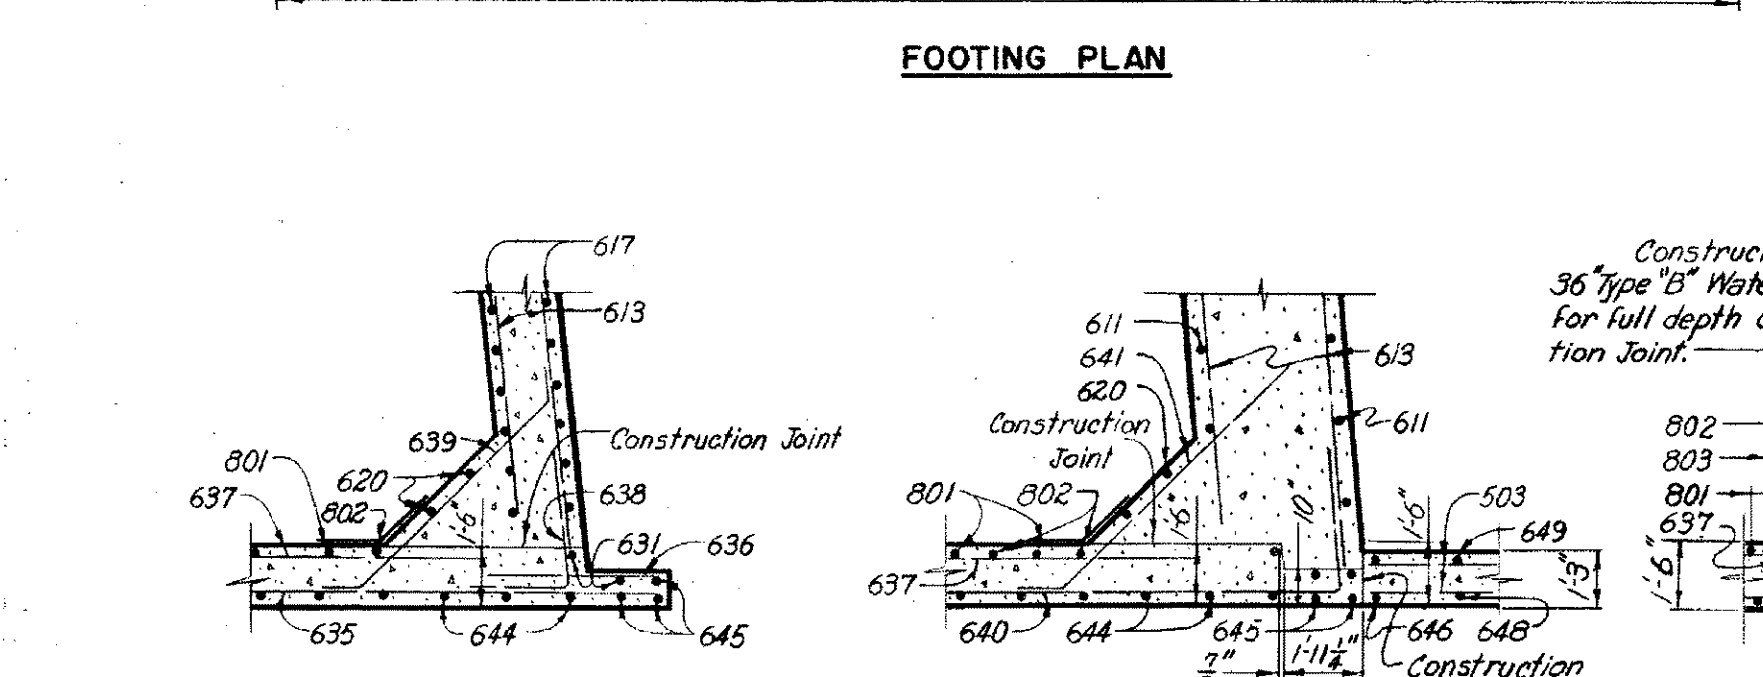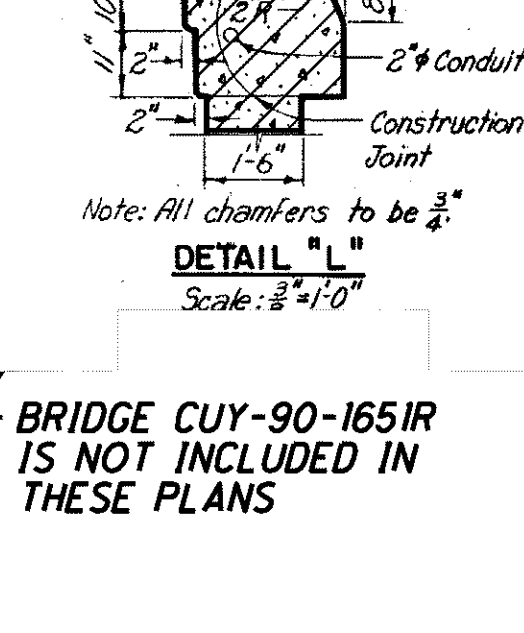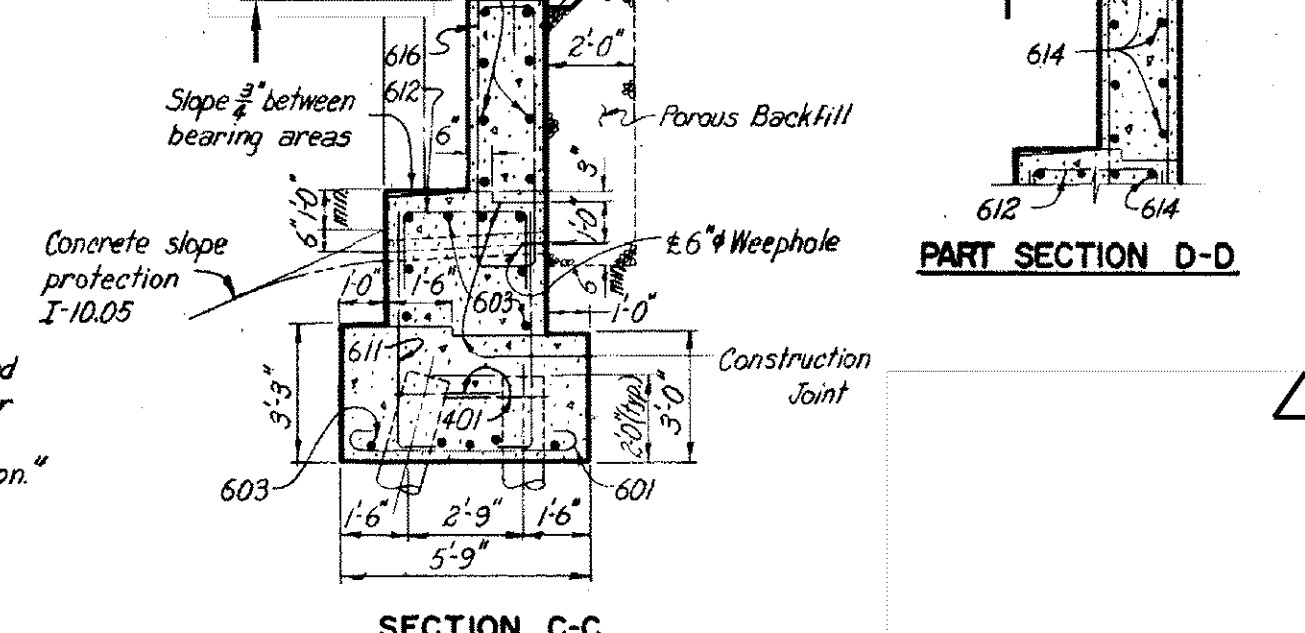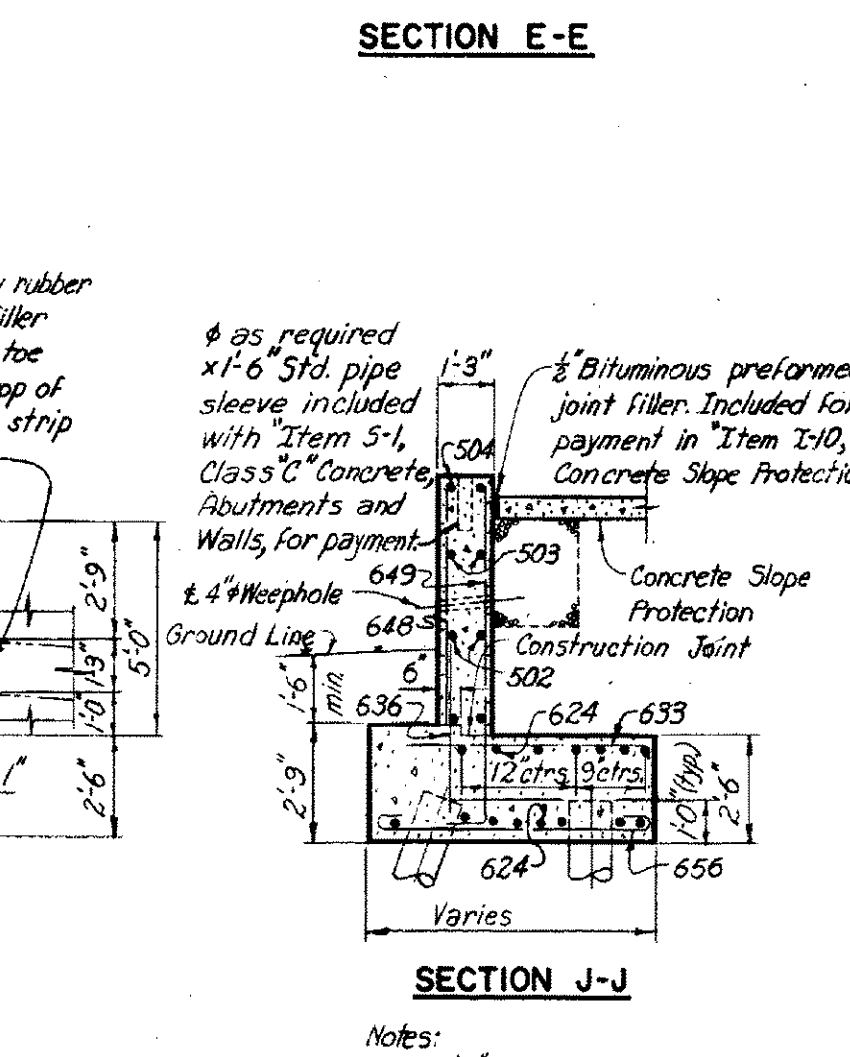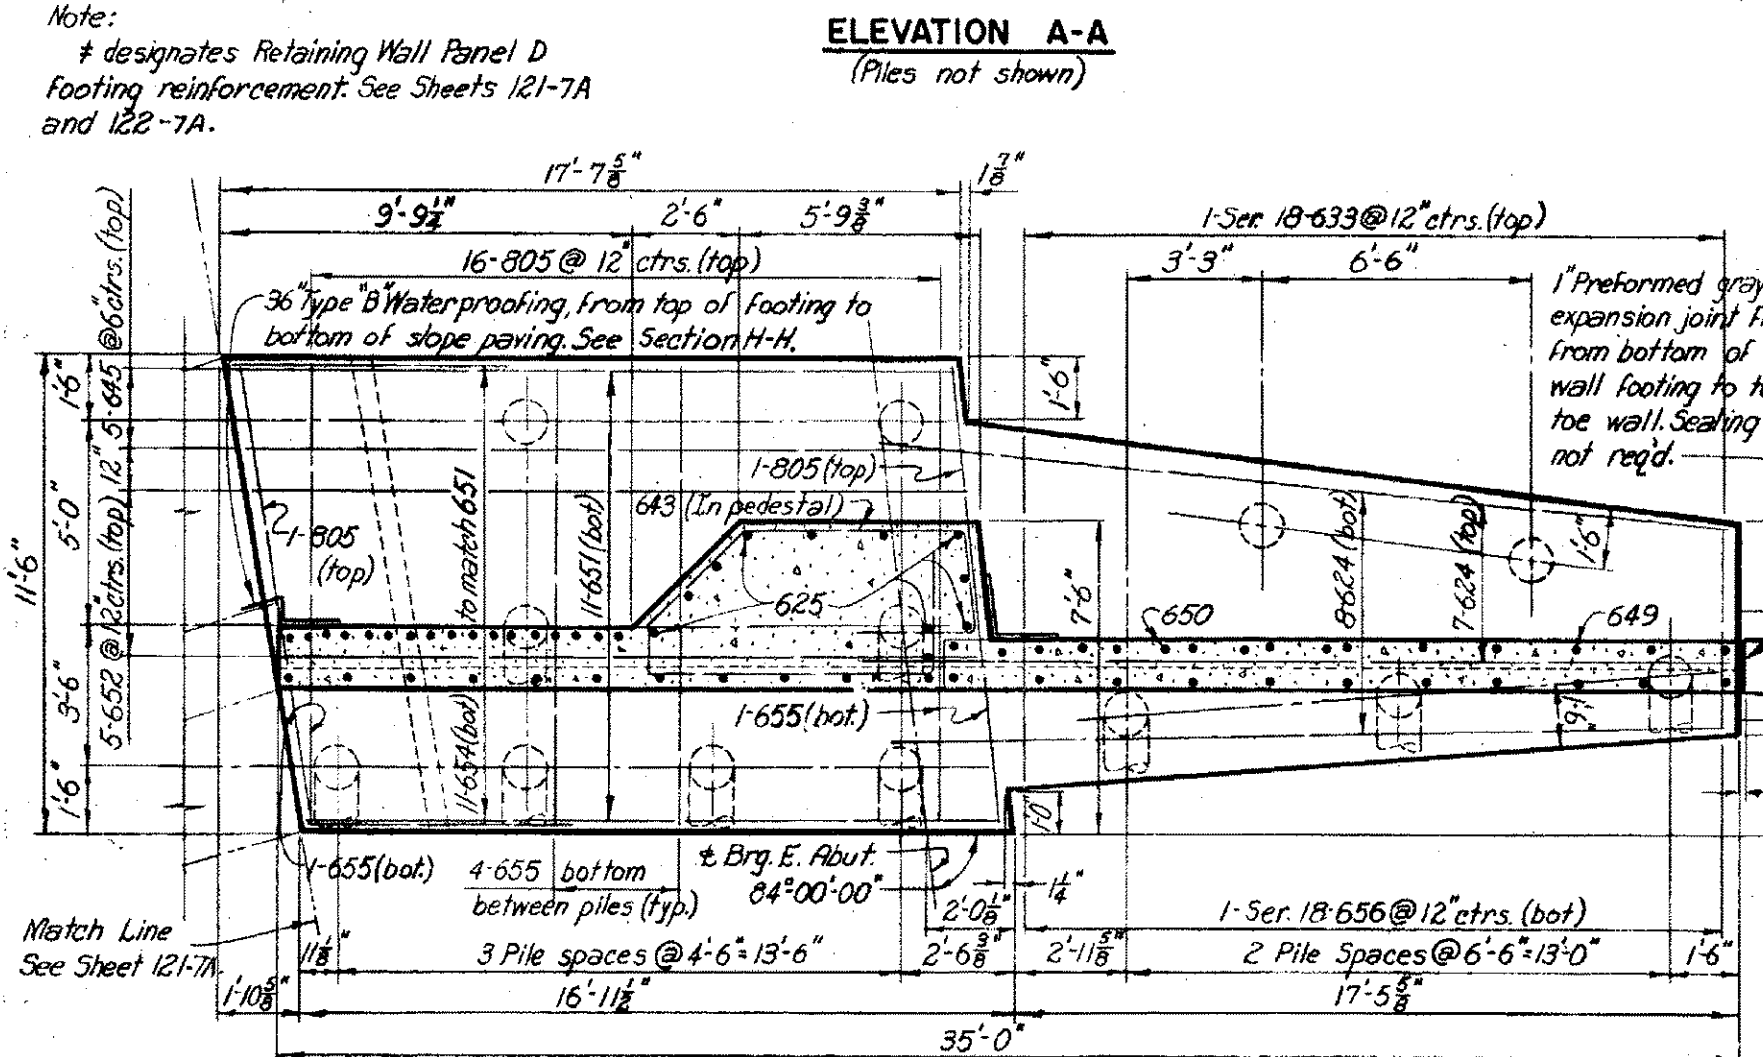

H.N.T.B. BR. NO. 4 PART 7A									
HOWARD, NEEDLES, TAMMEN & BERGENDOFF CONSULTING ENGINEERS KANSAS CITY CLEVELAND NEW YORK									
EAST ABUTMENT DETAILS									
INNER BELT FREEWAY OVER EAST 14th ST.									
BR. NO. CUY-42-1854 STA. 70+89.23									
Scale: 1/4"=1'-0" Except as noted STA. 73+96.25									
WILLOW-INNER BELT FREEWAY									
CLEVELAND CUYAHOGA COUNTY OHIO									
DRAWN/F.S.J. TRACED	CHECKED C.K.B.	REVIEWED J.C.T.	REVISED/F.S.J. 11-24-99						
DATE/12-29-93	DATE	DATE/11-13-97	SHEET 120						

DESIGNED PSB
CHECKED NJ
DATE 03-14-11

REVISIONS
NO. 1
RECORD DRAWINGS

DESIGN AGENCY
WALSH
HNTB
WALSH CONSTRUCTION

REMOVAL DETAILS - 6
BRIDGE NO. CUY-77-1597 L AND CUY-90-1651 L
I-90WB AND I-77SB RAMP OVER E 14TH STREET

BRIDGES
10 & 11


DATE
JUL 3 1985

FILE NUMBER
1807919/1807900


CUY-90-14.90
PID No. 77332 / 85631

17/38
17/38


090_1651LAR001.dgn 1/8/2016 11:32:52 AM rstriegel

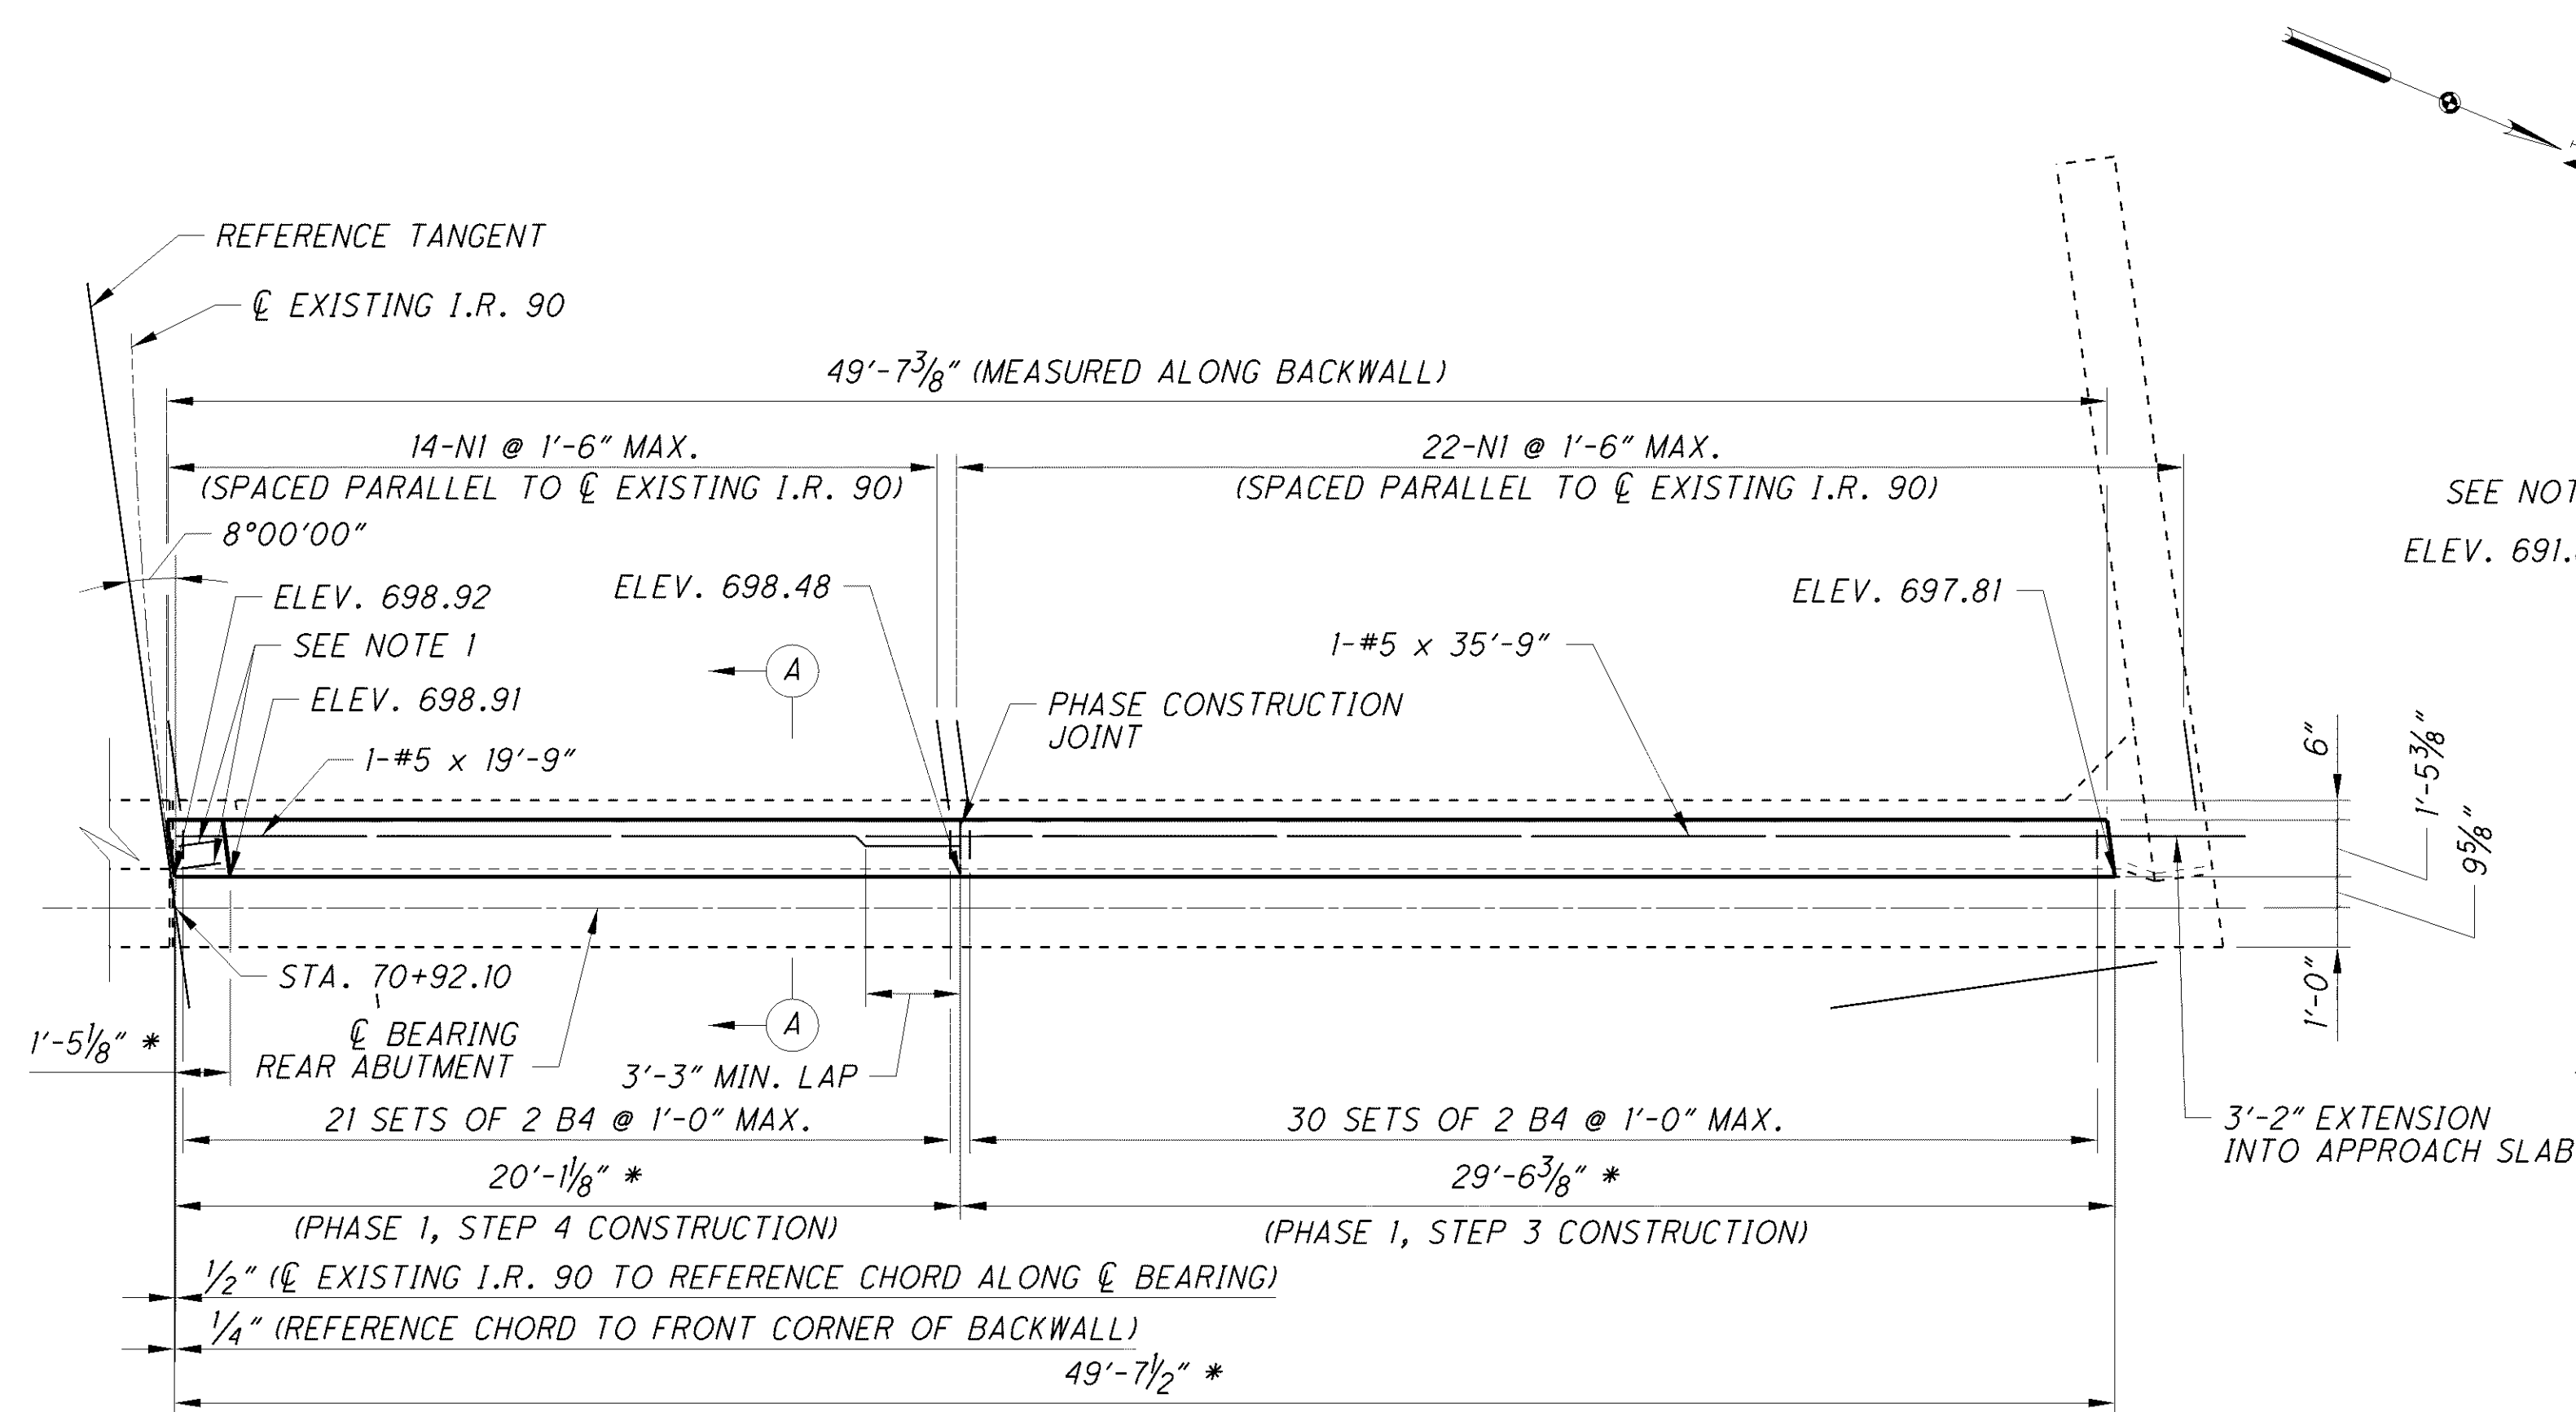


PLAN
(REAR ABUTMENT I.R. 90 WESTBOUND)
(FOOTING NOT SHOWN FOR CLARITY)

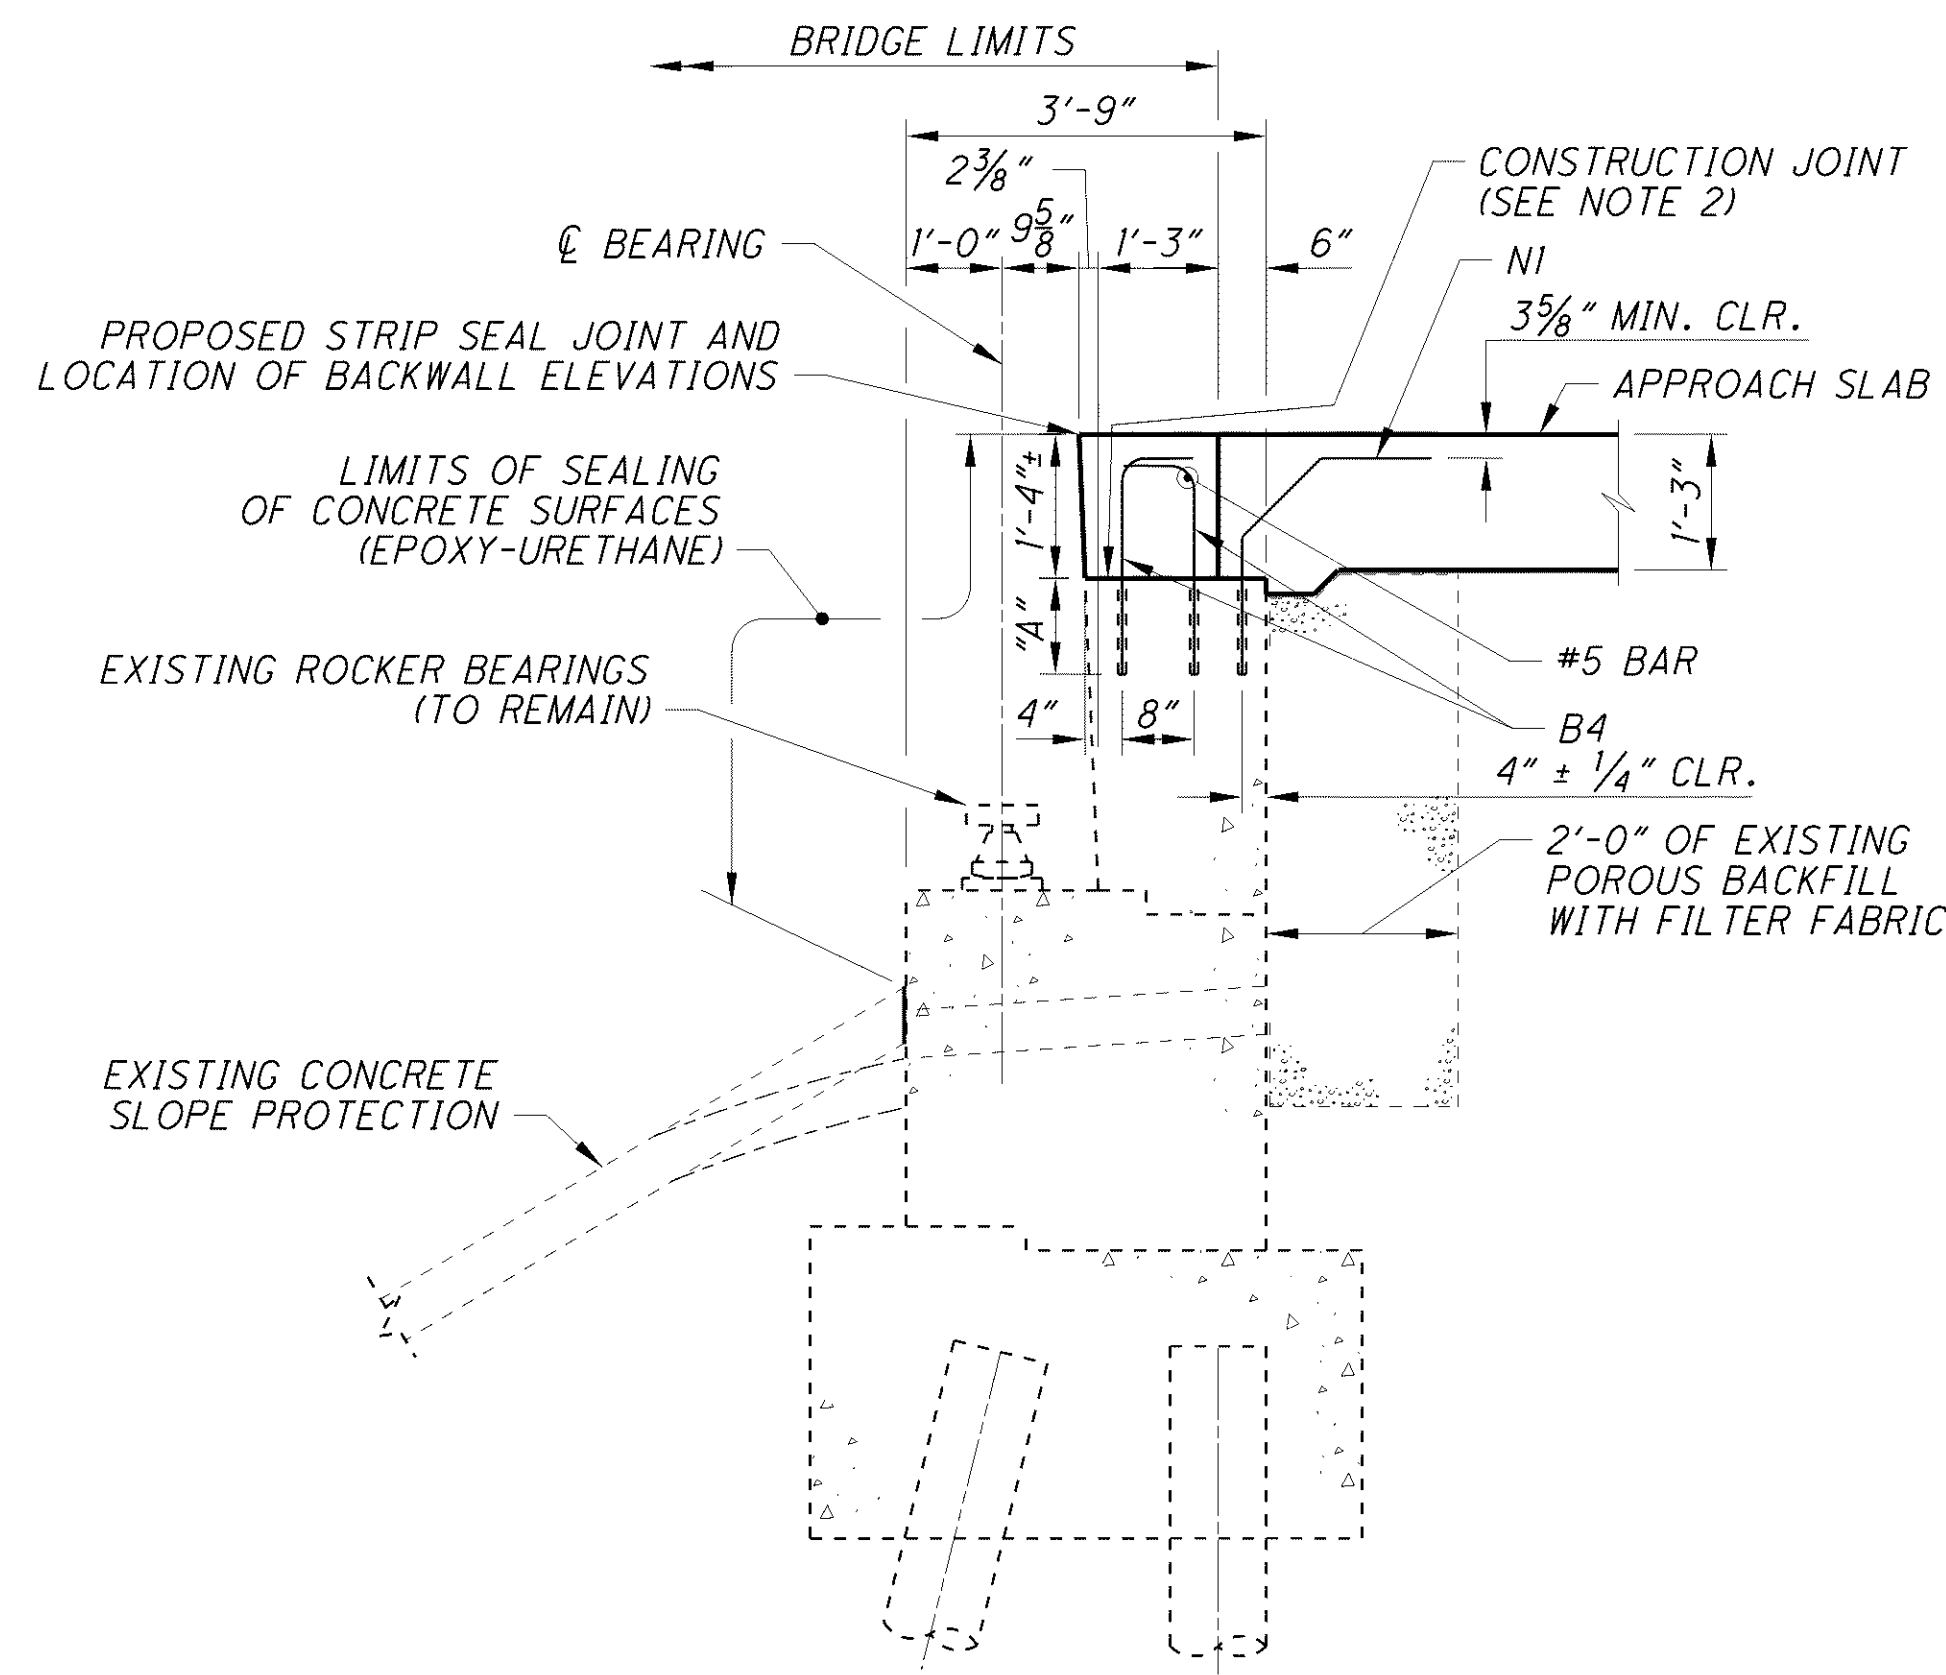


SECTION A-A

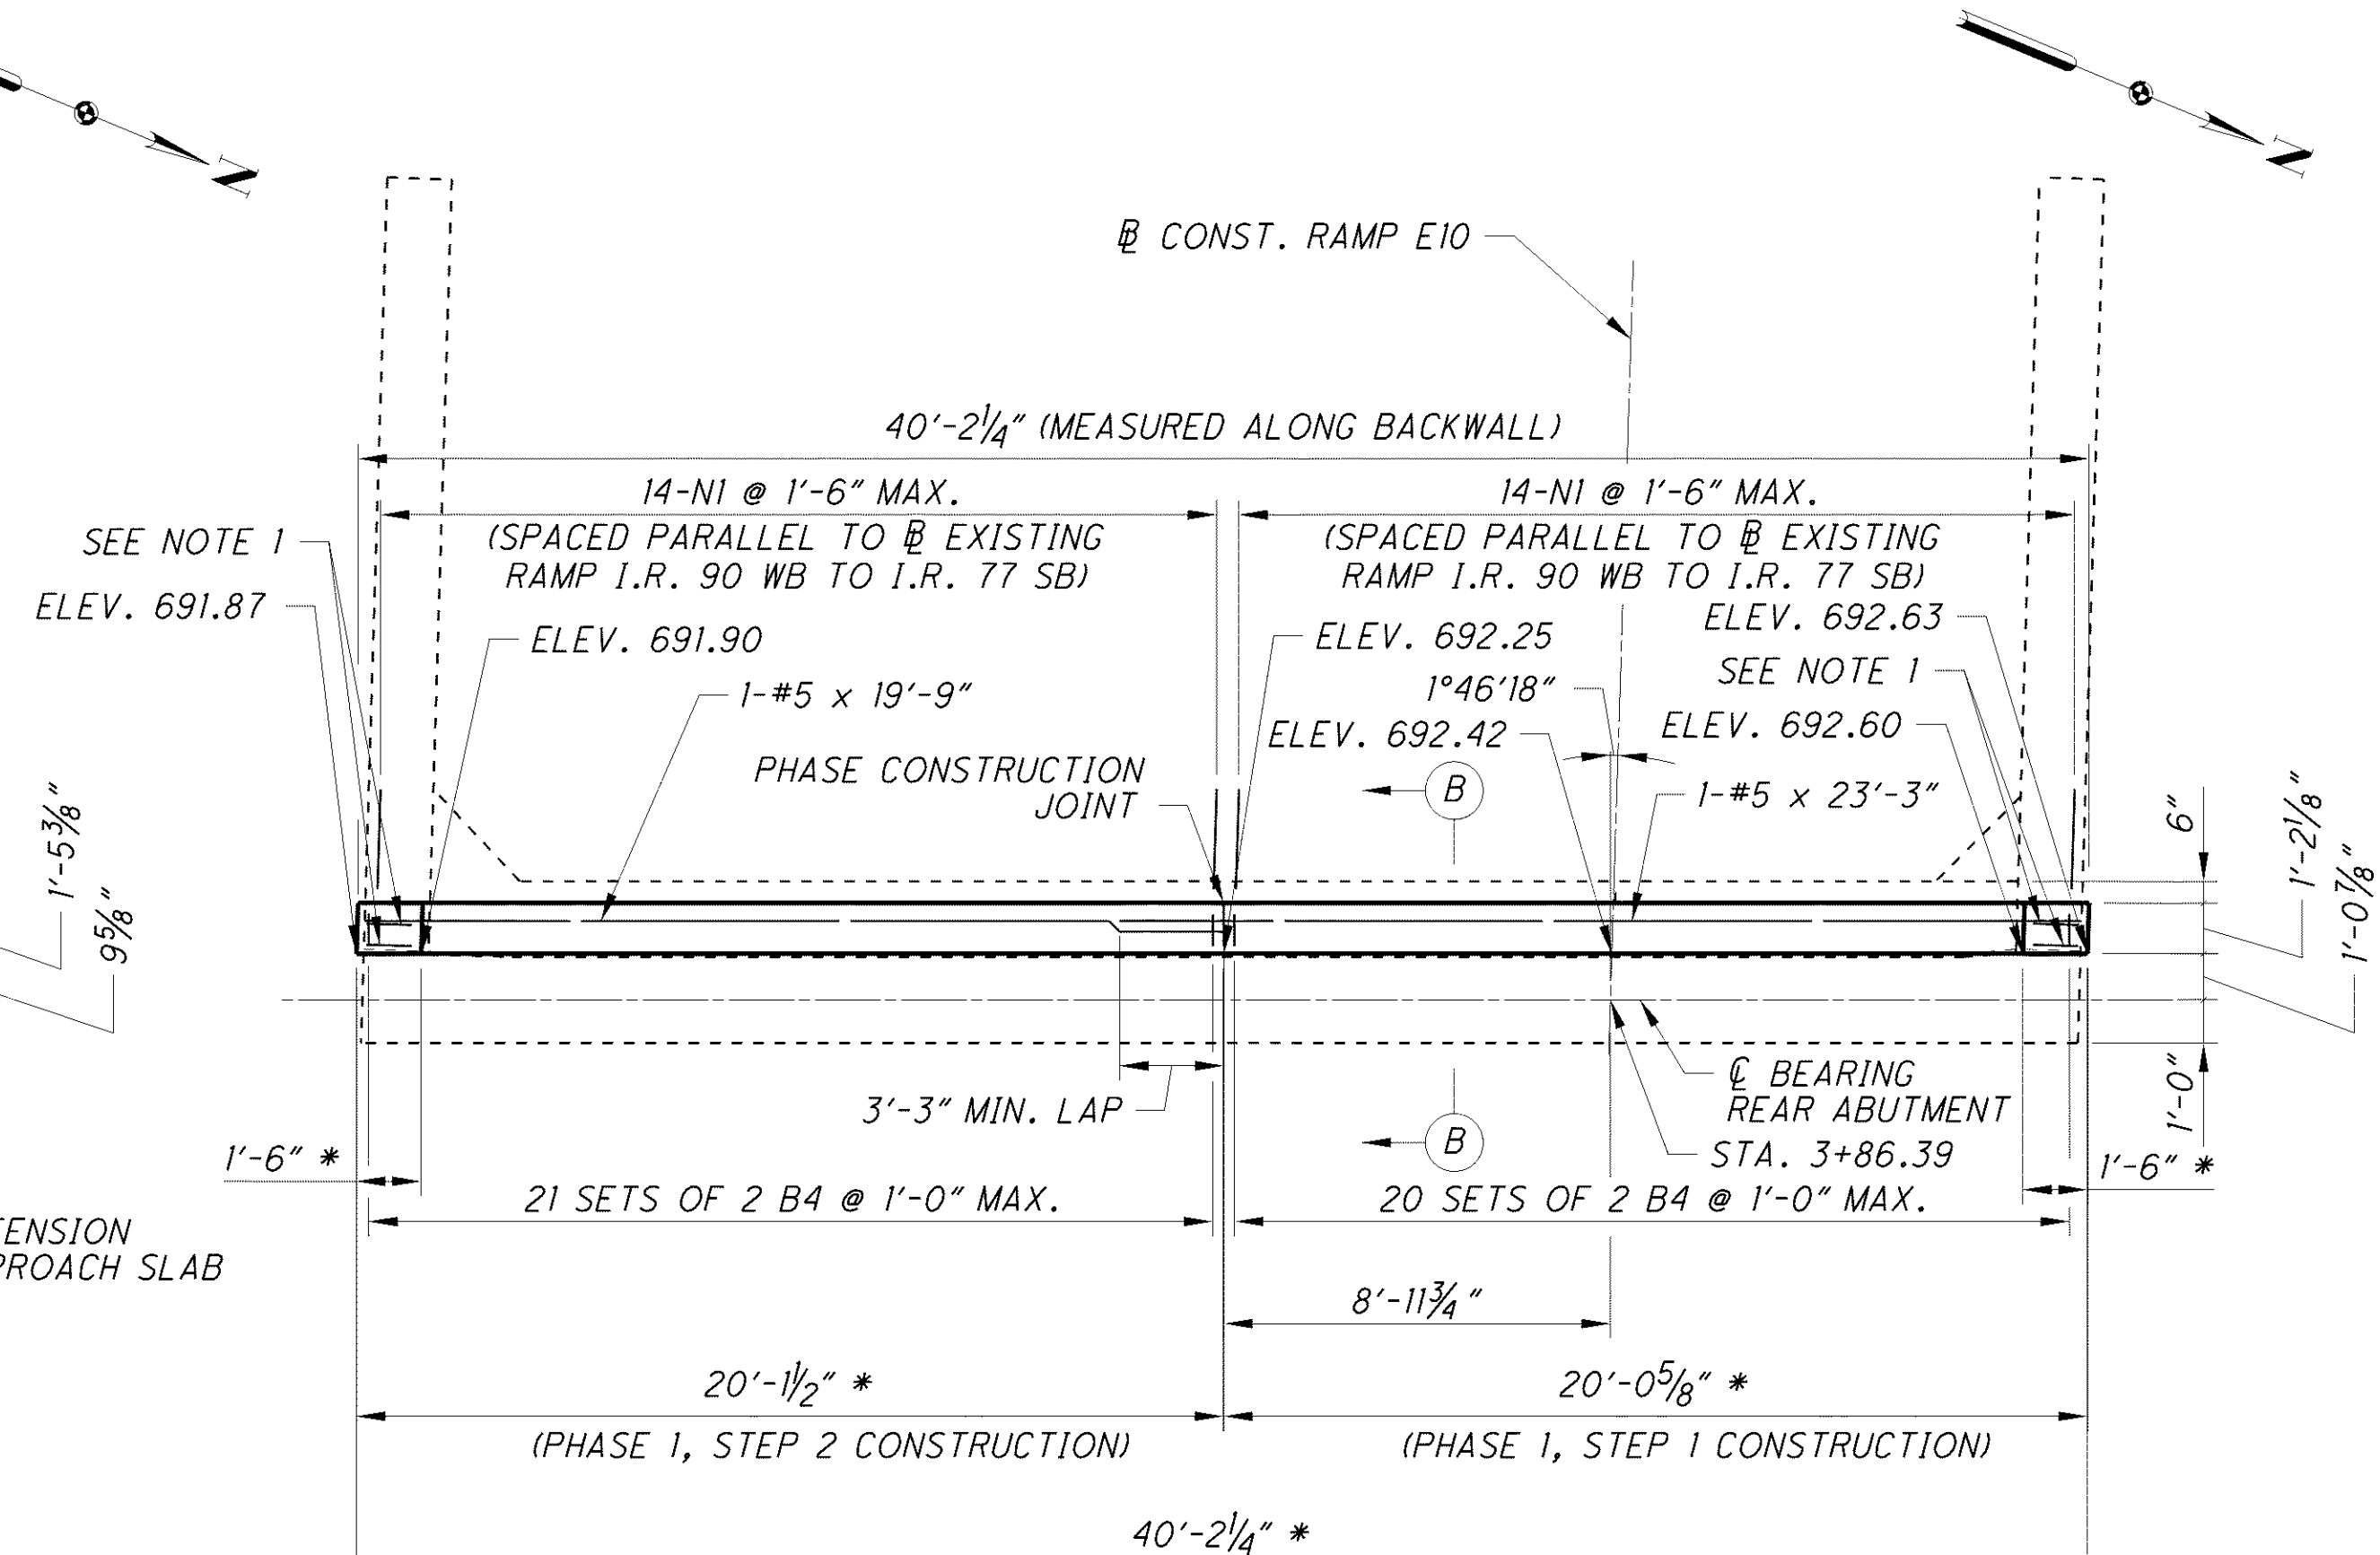

PLAN
(REAR ABUTMENT CONST. RAMP E10)
(FOOTING NOT SHOWN FOR CLARITY)

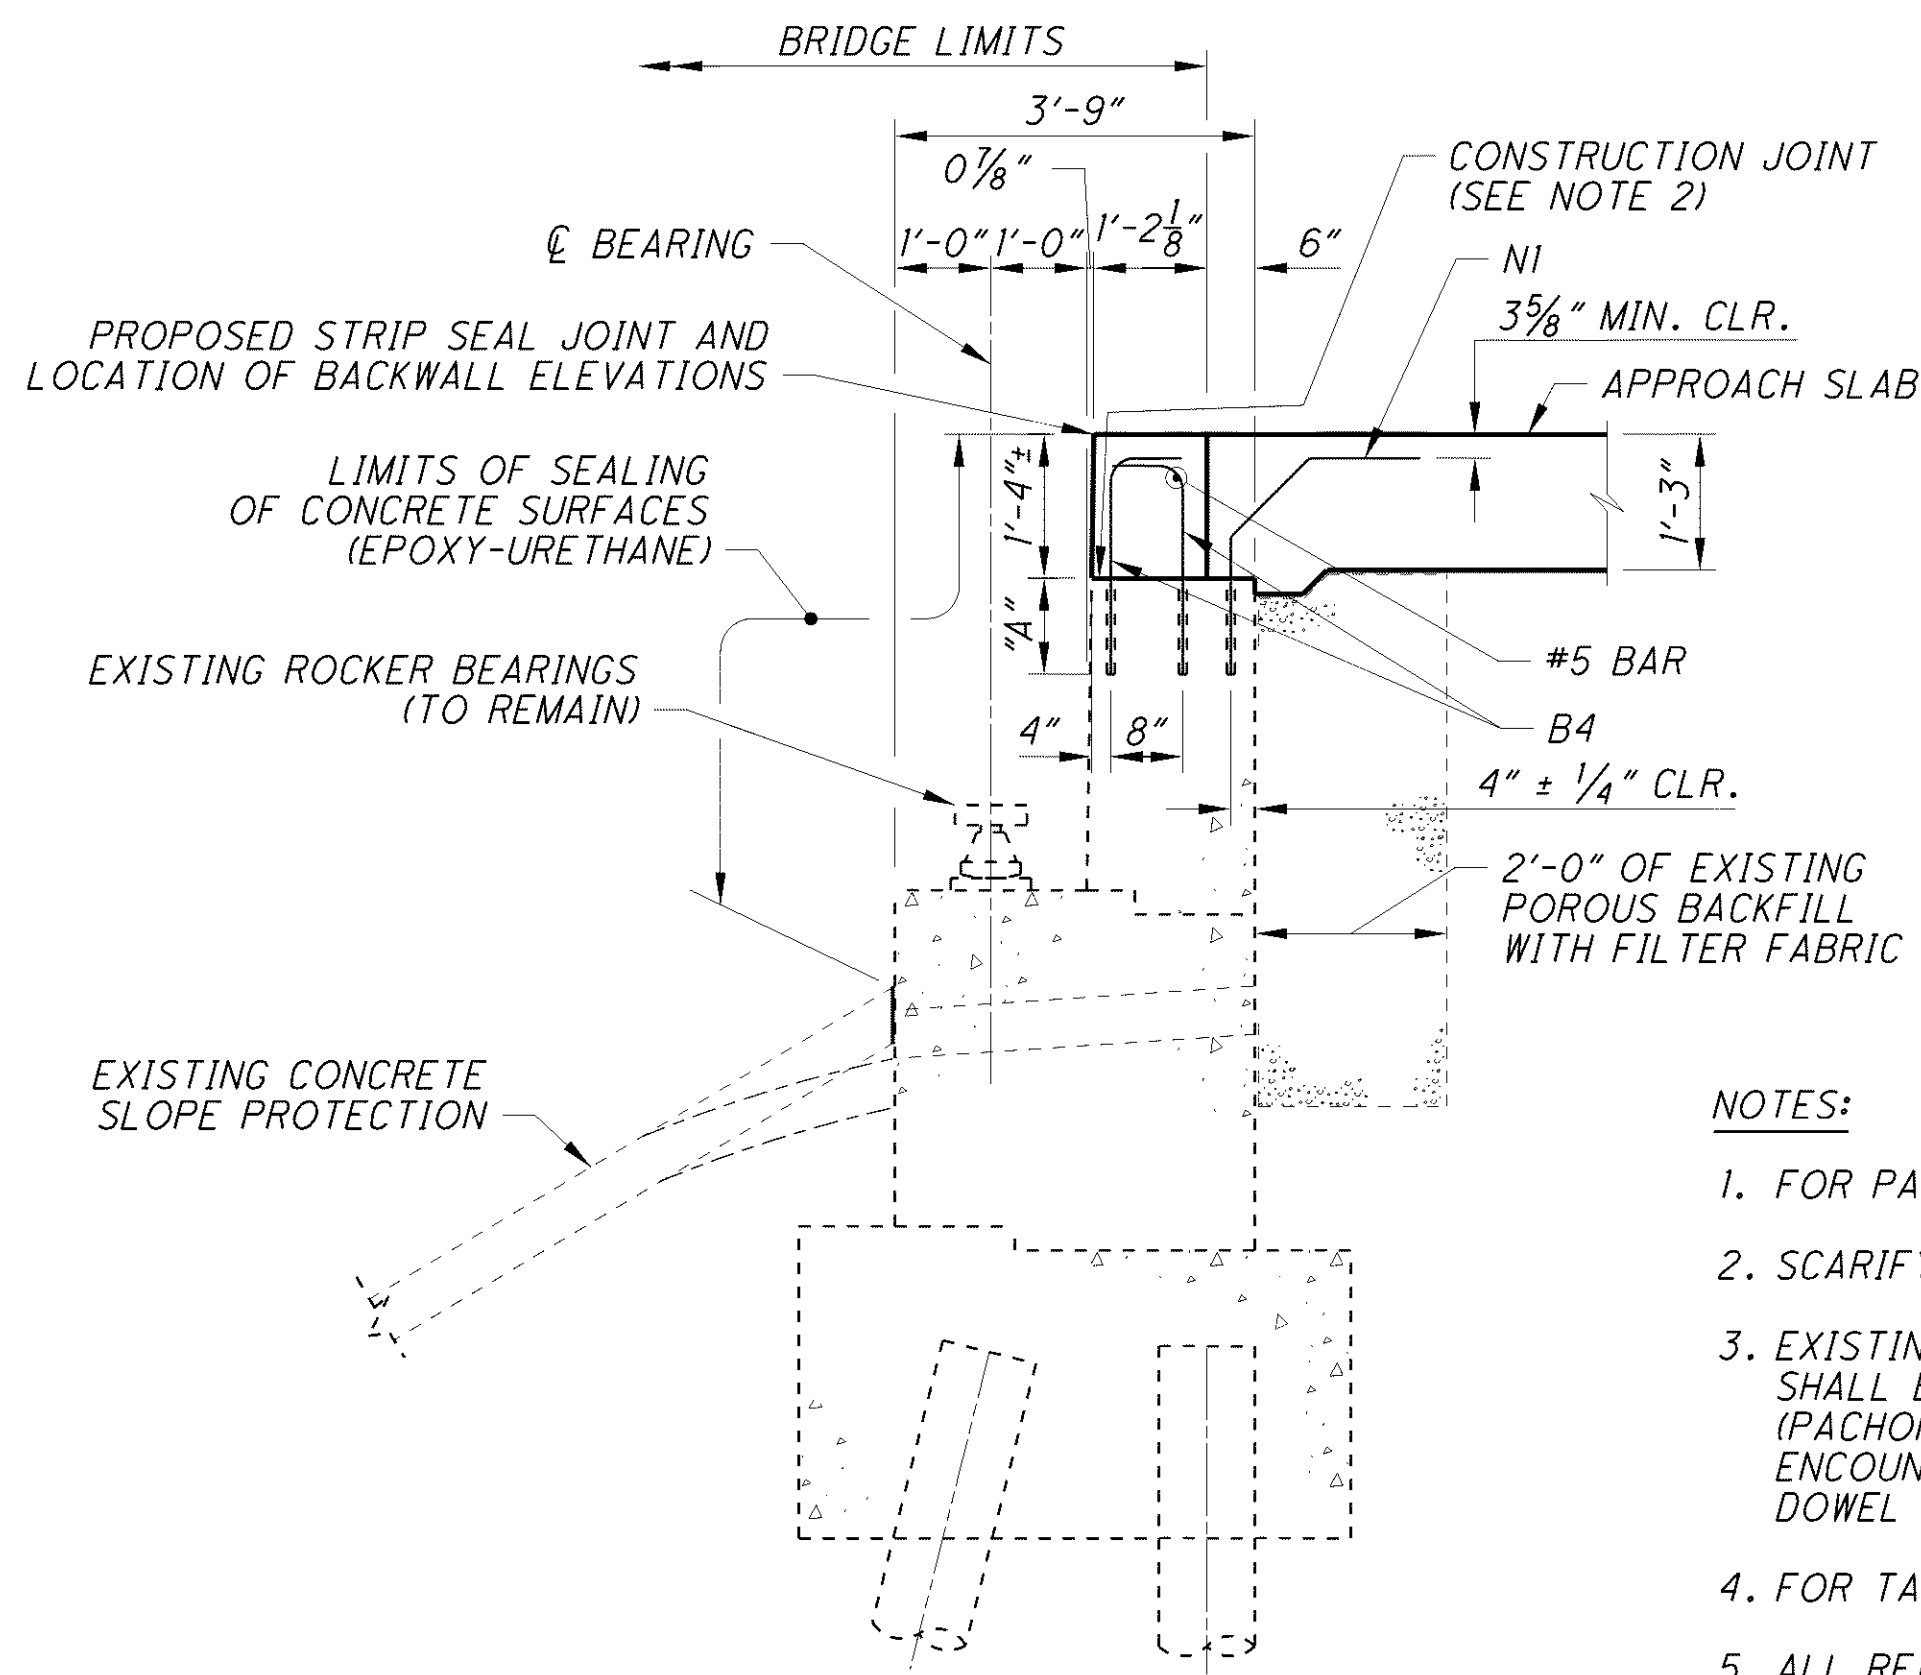

SECTION B-B

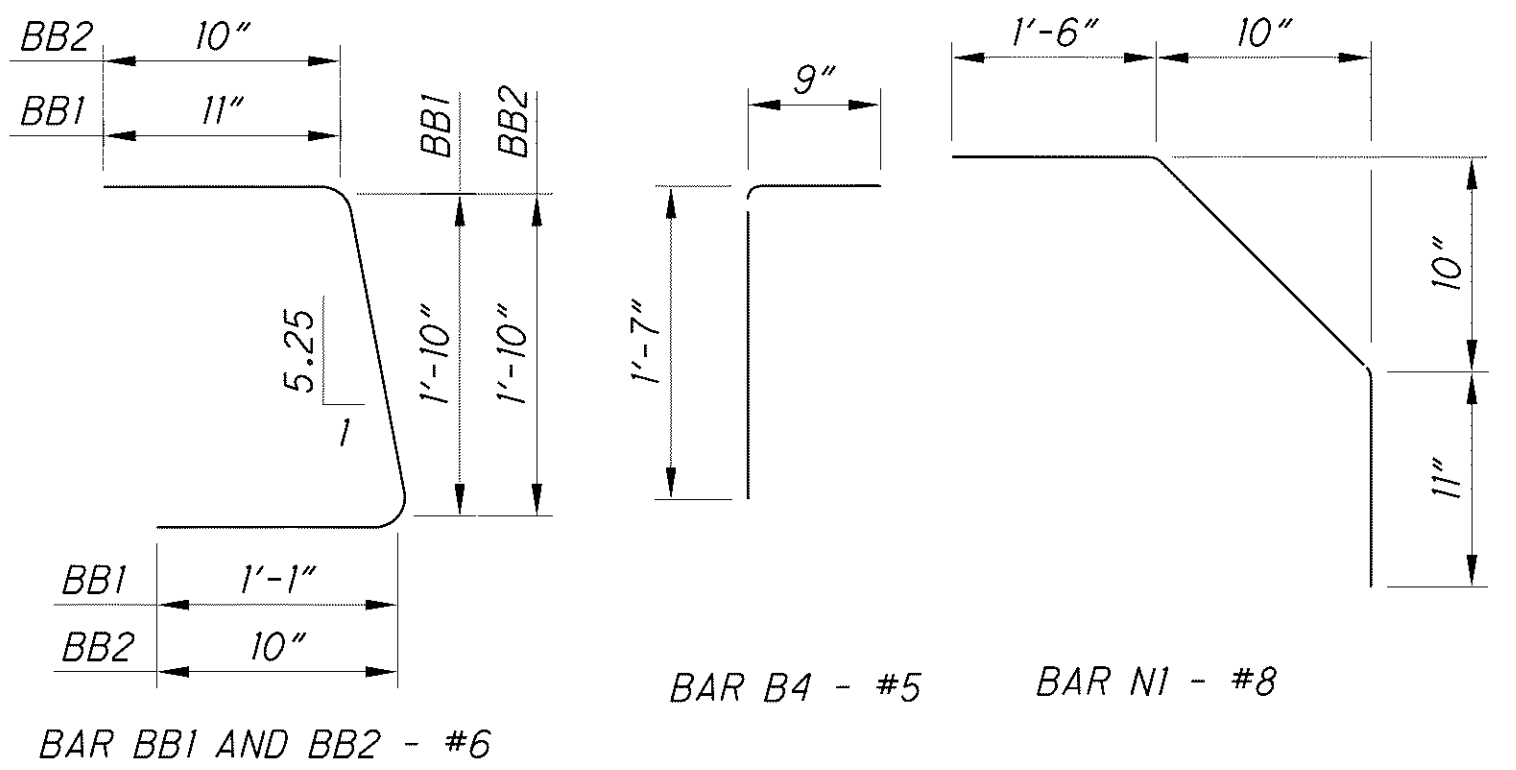

NOTES:

1. FOR PARAPET REINFORCING DETAILS, SEE SHEET 37/38 .
2. SCARIFY THE TOP OF EXISTING SURFACES TO A DEPTH OF 1/4".
3. EXISTING REINFORCING STEEL BARS IN THE AREA OF THE DOWEL HOLES SHALL BE LOCATED WITH THE AID OF A REINFORCING STEEL BAR LOCATOR (PACHOMETER) PRIOR TO DRILLING THE HOLES. IF AN EXISTING BAR IS ENCOUNTERED AT THE SAME LOCATION AS A PROPOSED DOWEL HOLE, THE DOWEL HOLE SHALL BE MOVED TO EITHER SIDE OF THE EXISTING BAR.
4. FOR TABLE OF DIMENSION "A", SEE SHEET 19/38 .
5. ALL REINFORCING STEEL SHALL BE EPOXY COATED AND PER CMS 509.
6. BACKWALL CONCRETE: IN ADDITION TO 511.10, DO NOT PLACE BACKWALL CONCRETE ABOVE THE CONSTRUCTION JOINT AT THE APPROACH SLAB SEAT UNTIL AFTER THE DECK CONCRETE IN THE SPAN ADJACENT TO THE ABUTMENT HAS BEEN PLACED.

DESIGNED		REVIEWED		DATE		BRIDGES		REAR ABUTMENT DETAILS	
PSB	CHECKED	PSB	CHECKED	JOL	03-11-11	10	11	CUY-90-14.90	PID No. 77332 / 85531
NJ		NJ							
18		38		18		38		18	
38		38		38		38		38	

DATE
03-14-11





REVISIONS
RECORD DRAWINGS

NO.

DESIGN AGENCY
WALSH HNTB
WALSH CONSTRUCTION

BRIDGE NO. CUY-77-1597 L AND CUY-90-1651 L
I-90WB AND I-77SB RAMP OVER E 14TH STREET

090_16514AF001.dgn 1/8/2016 11:32:59 AM rstriegel

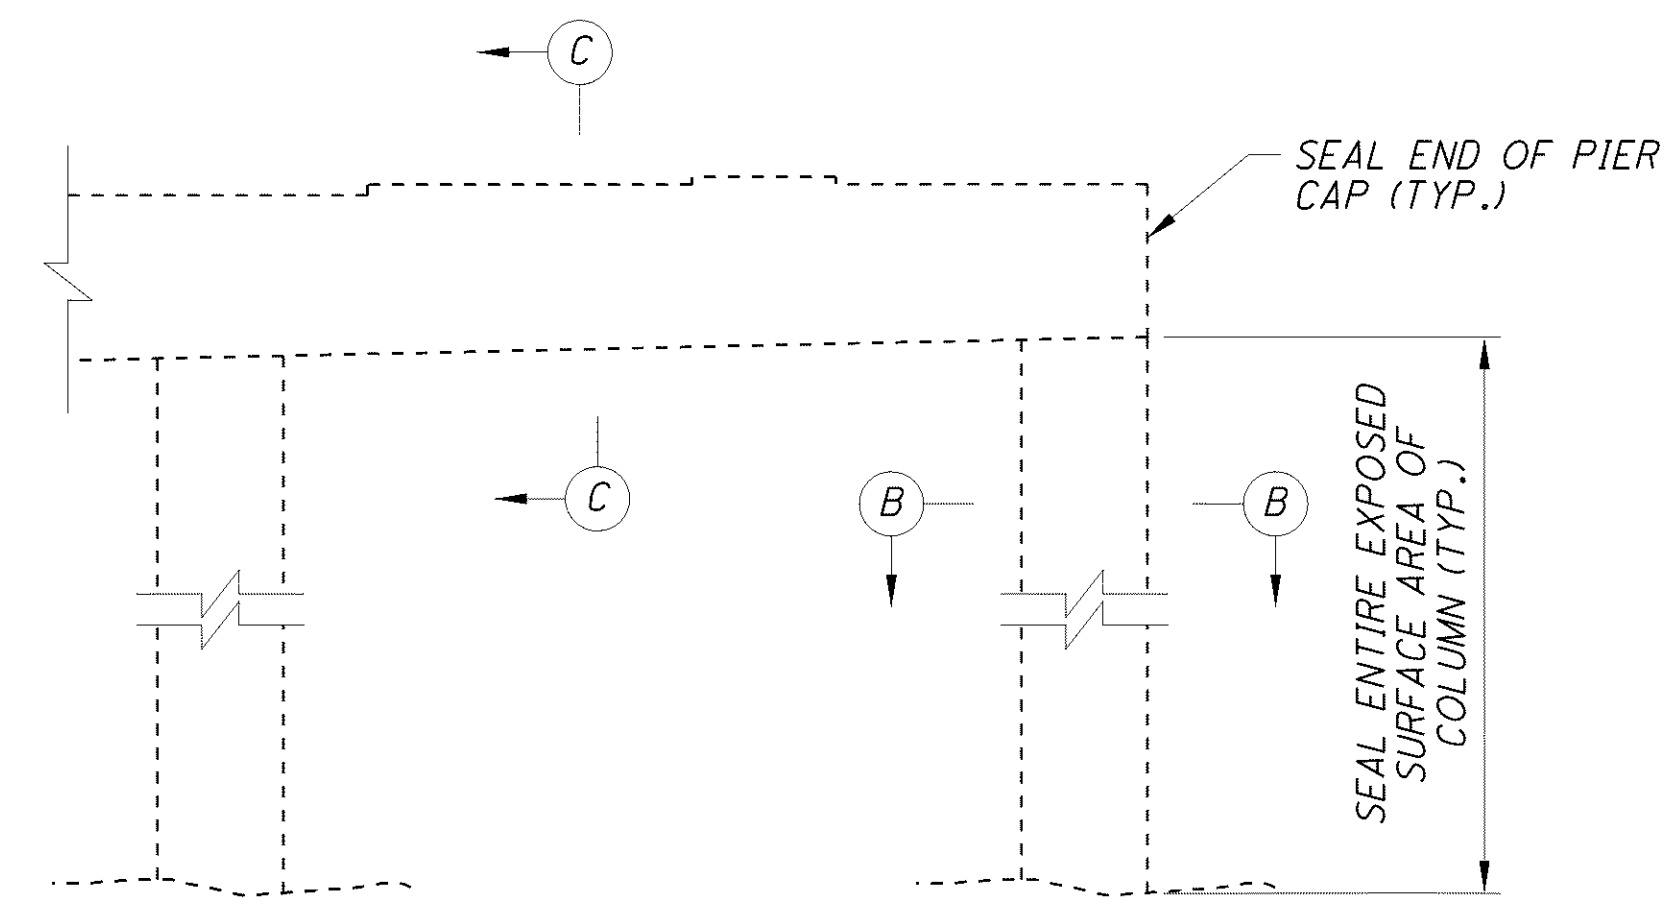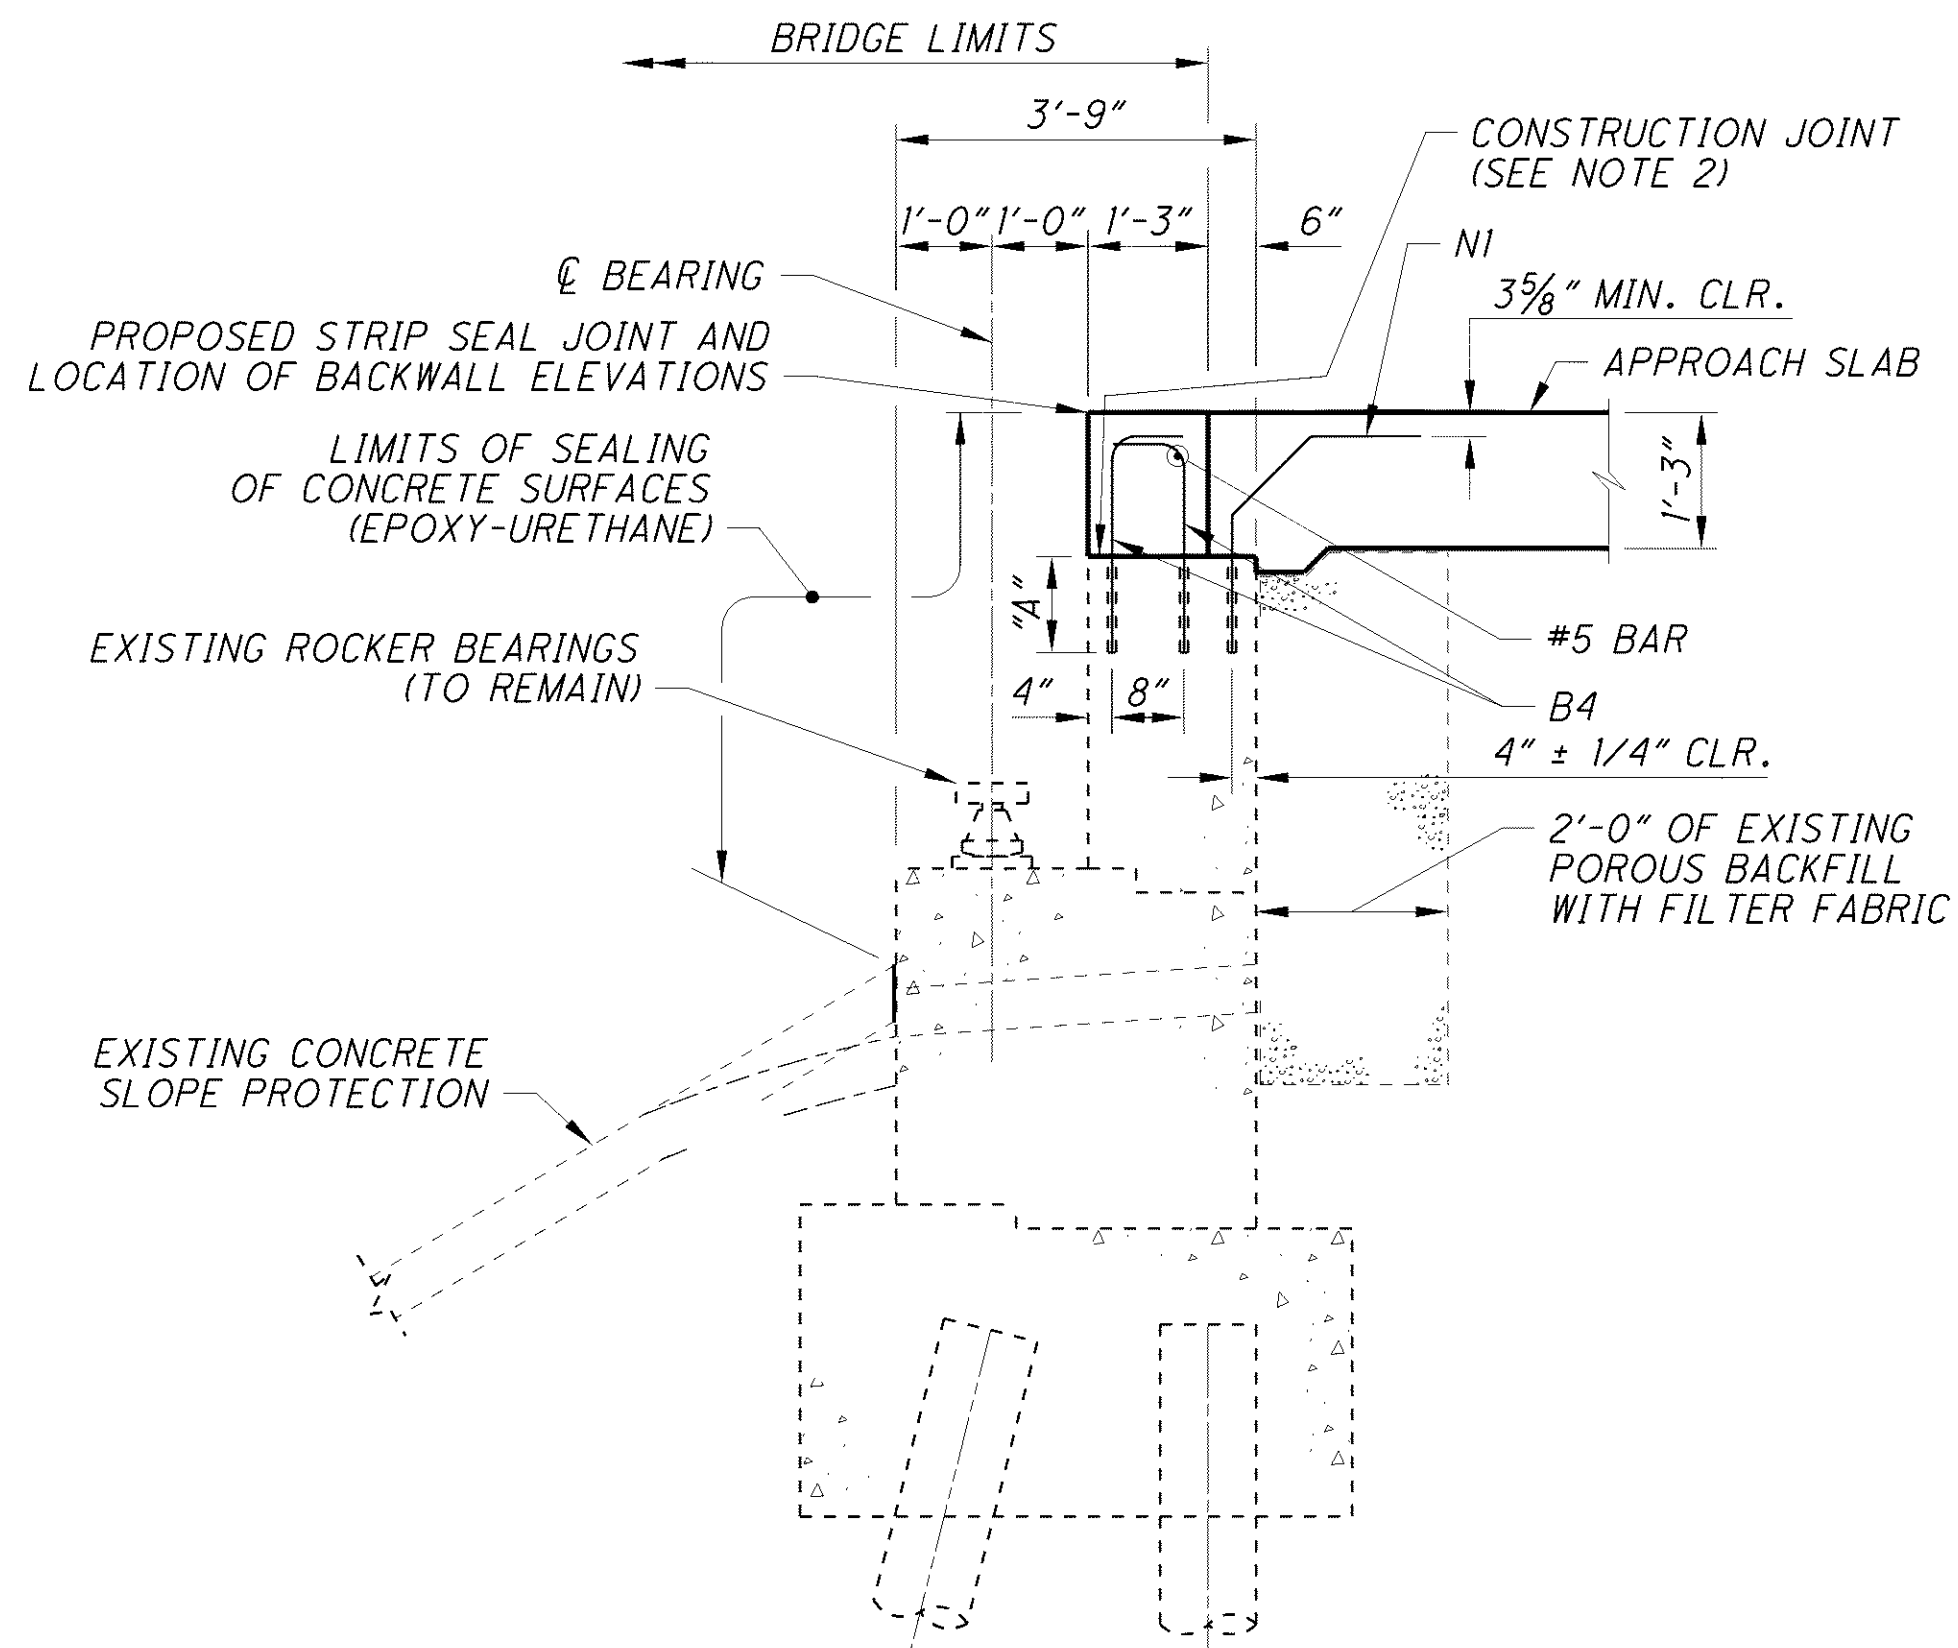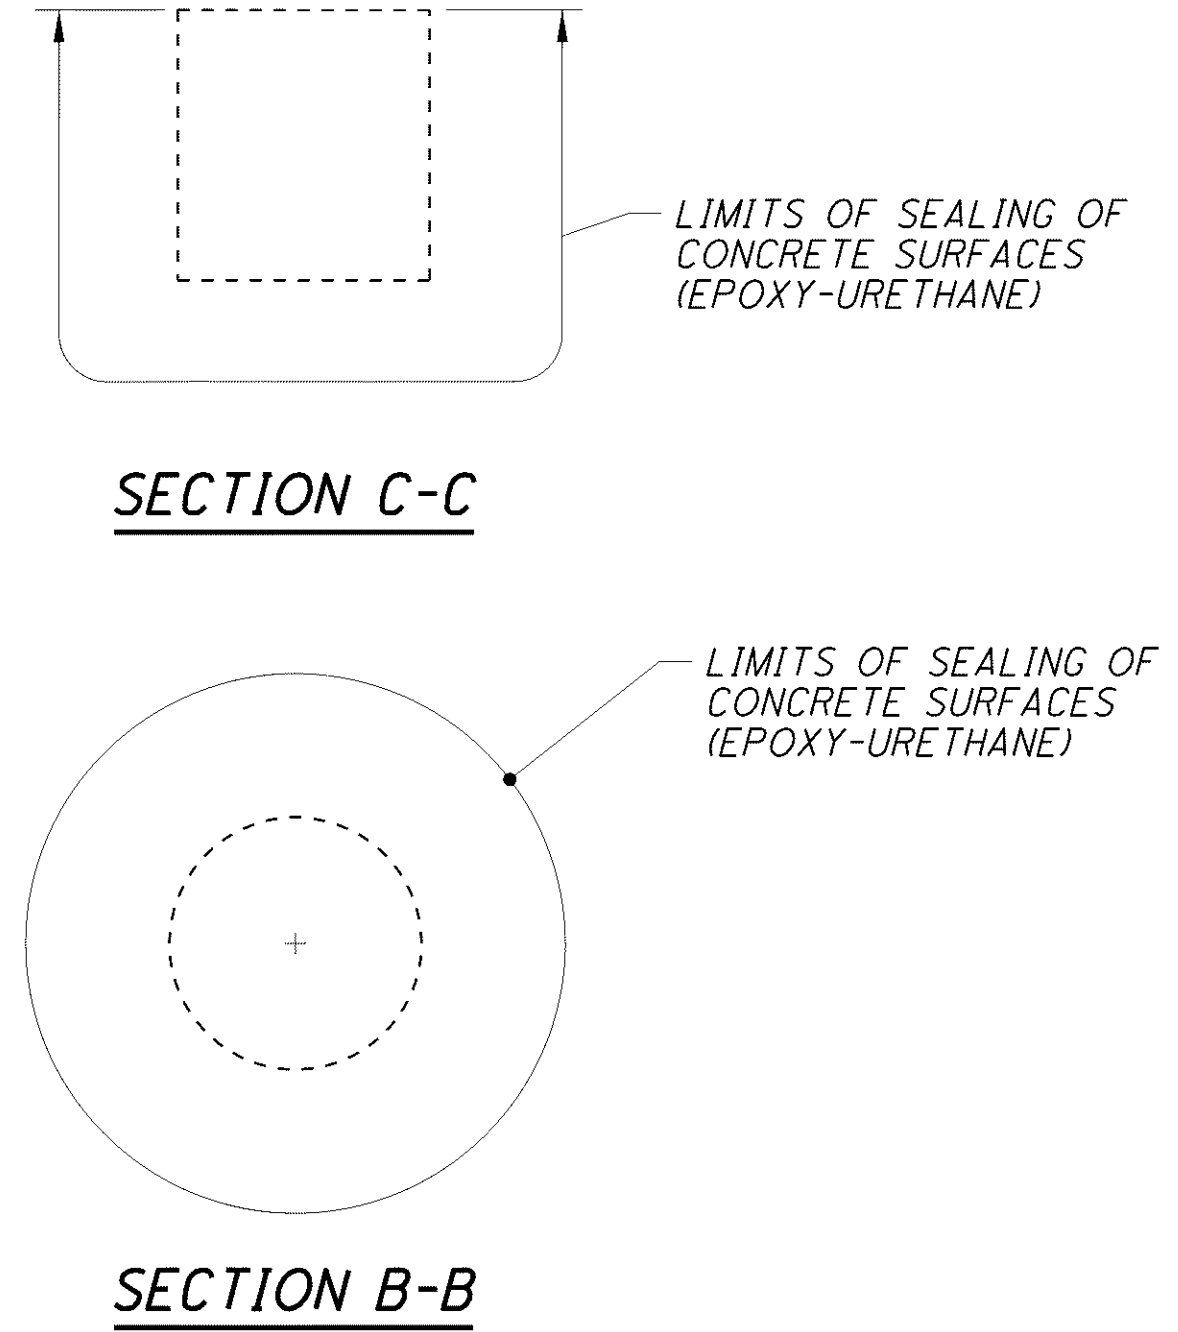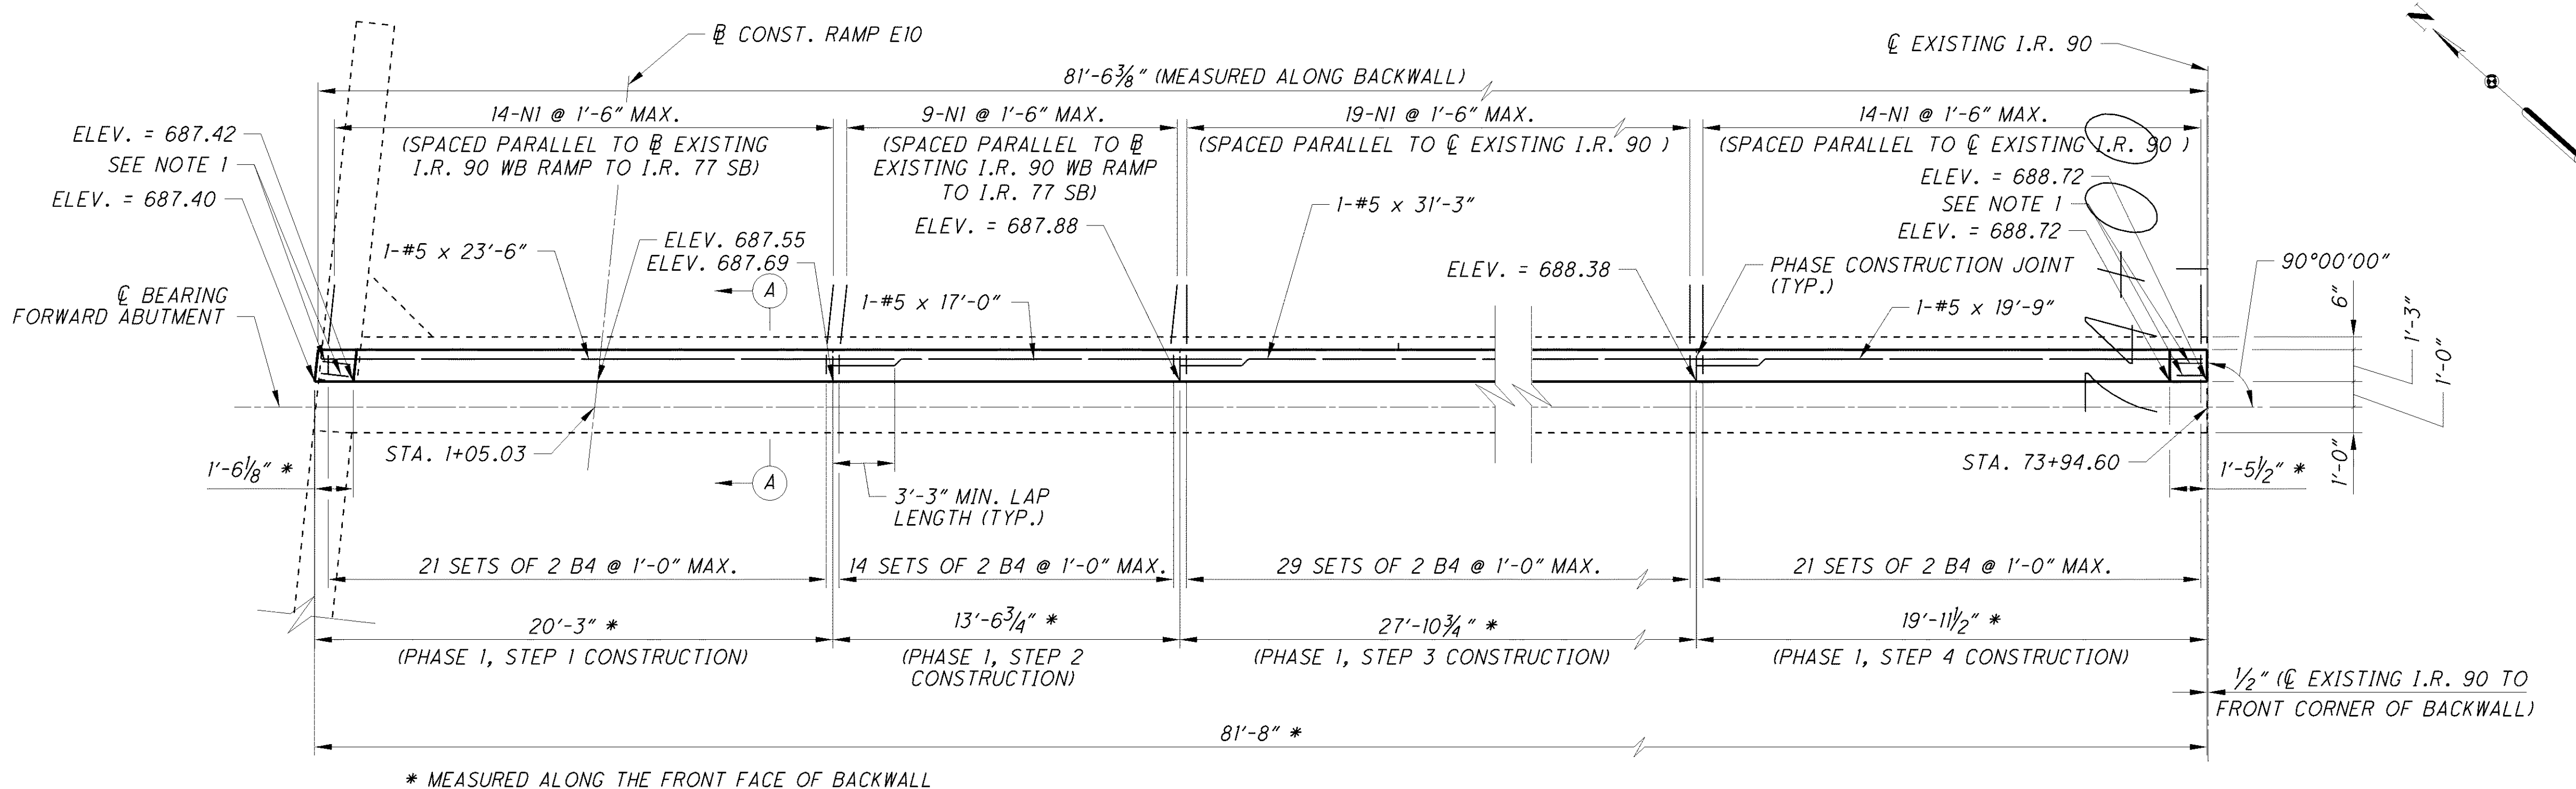


MIN. EPOXY DOWEL DEPTHS *	
REBAR SIZE	DIMENSION "A"
#5	5"
#8	9"

* DOWEL DEPTHS SHALL BE ADJUSTED PER MANUFACTURERS SPECIFICATIONS

MINIMUM LAP LENGTH TABLE	
#5	3'-3"

- NOTES:
- FOR REBAR DETAILS AND BAR BENDING DIAGRAM, SEE SHEET 18/38.
 - SCARIFY THE TOP OF EXISTING SURFACES TO A DEPTH OF 1/4".
 - FOR ADDITIONAL NOTES, SEE SHEET 18/38.

DESIGNED		DATE	REVIEWED		DATE
RSB	RSB	03-11-11	JOL	JOL	03-14-11
CHECKED	CHECKED	FILE NUMBER	CHECKED	CHECKED	RECORD DRAWINGS
NJ	NJ	1807919/1807900	NJ	NJ	
BRIDGES 10 & 11		DESIGN AGENCY		NO.	
		WALSH HNTB			
		CLEVELAND'S PREMIER BRIDGE ENGINEERS			
		FORWARD ABUTMENT AND PIER DETAILS			
		BRIDGE NO. CUY-77-1597 L AND CUY-90-1651 L			
		I-90WB AND I-77SB RAMP OVER E 14TH STREET			
		CUY-90-14.90			
		PID No. 77332 / 85531			
		19/38			
		19/38			

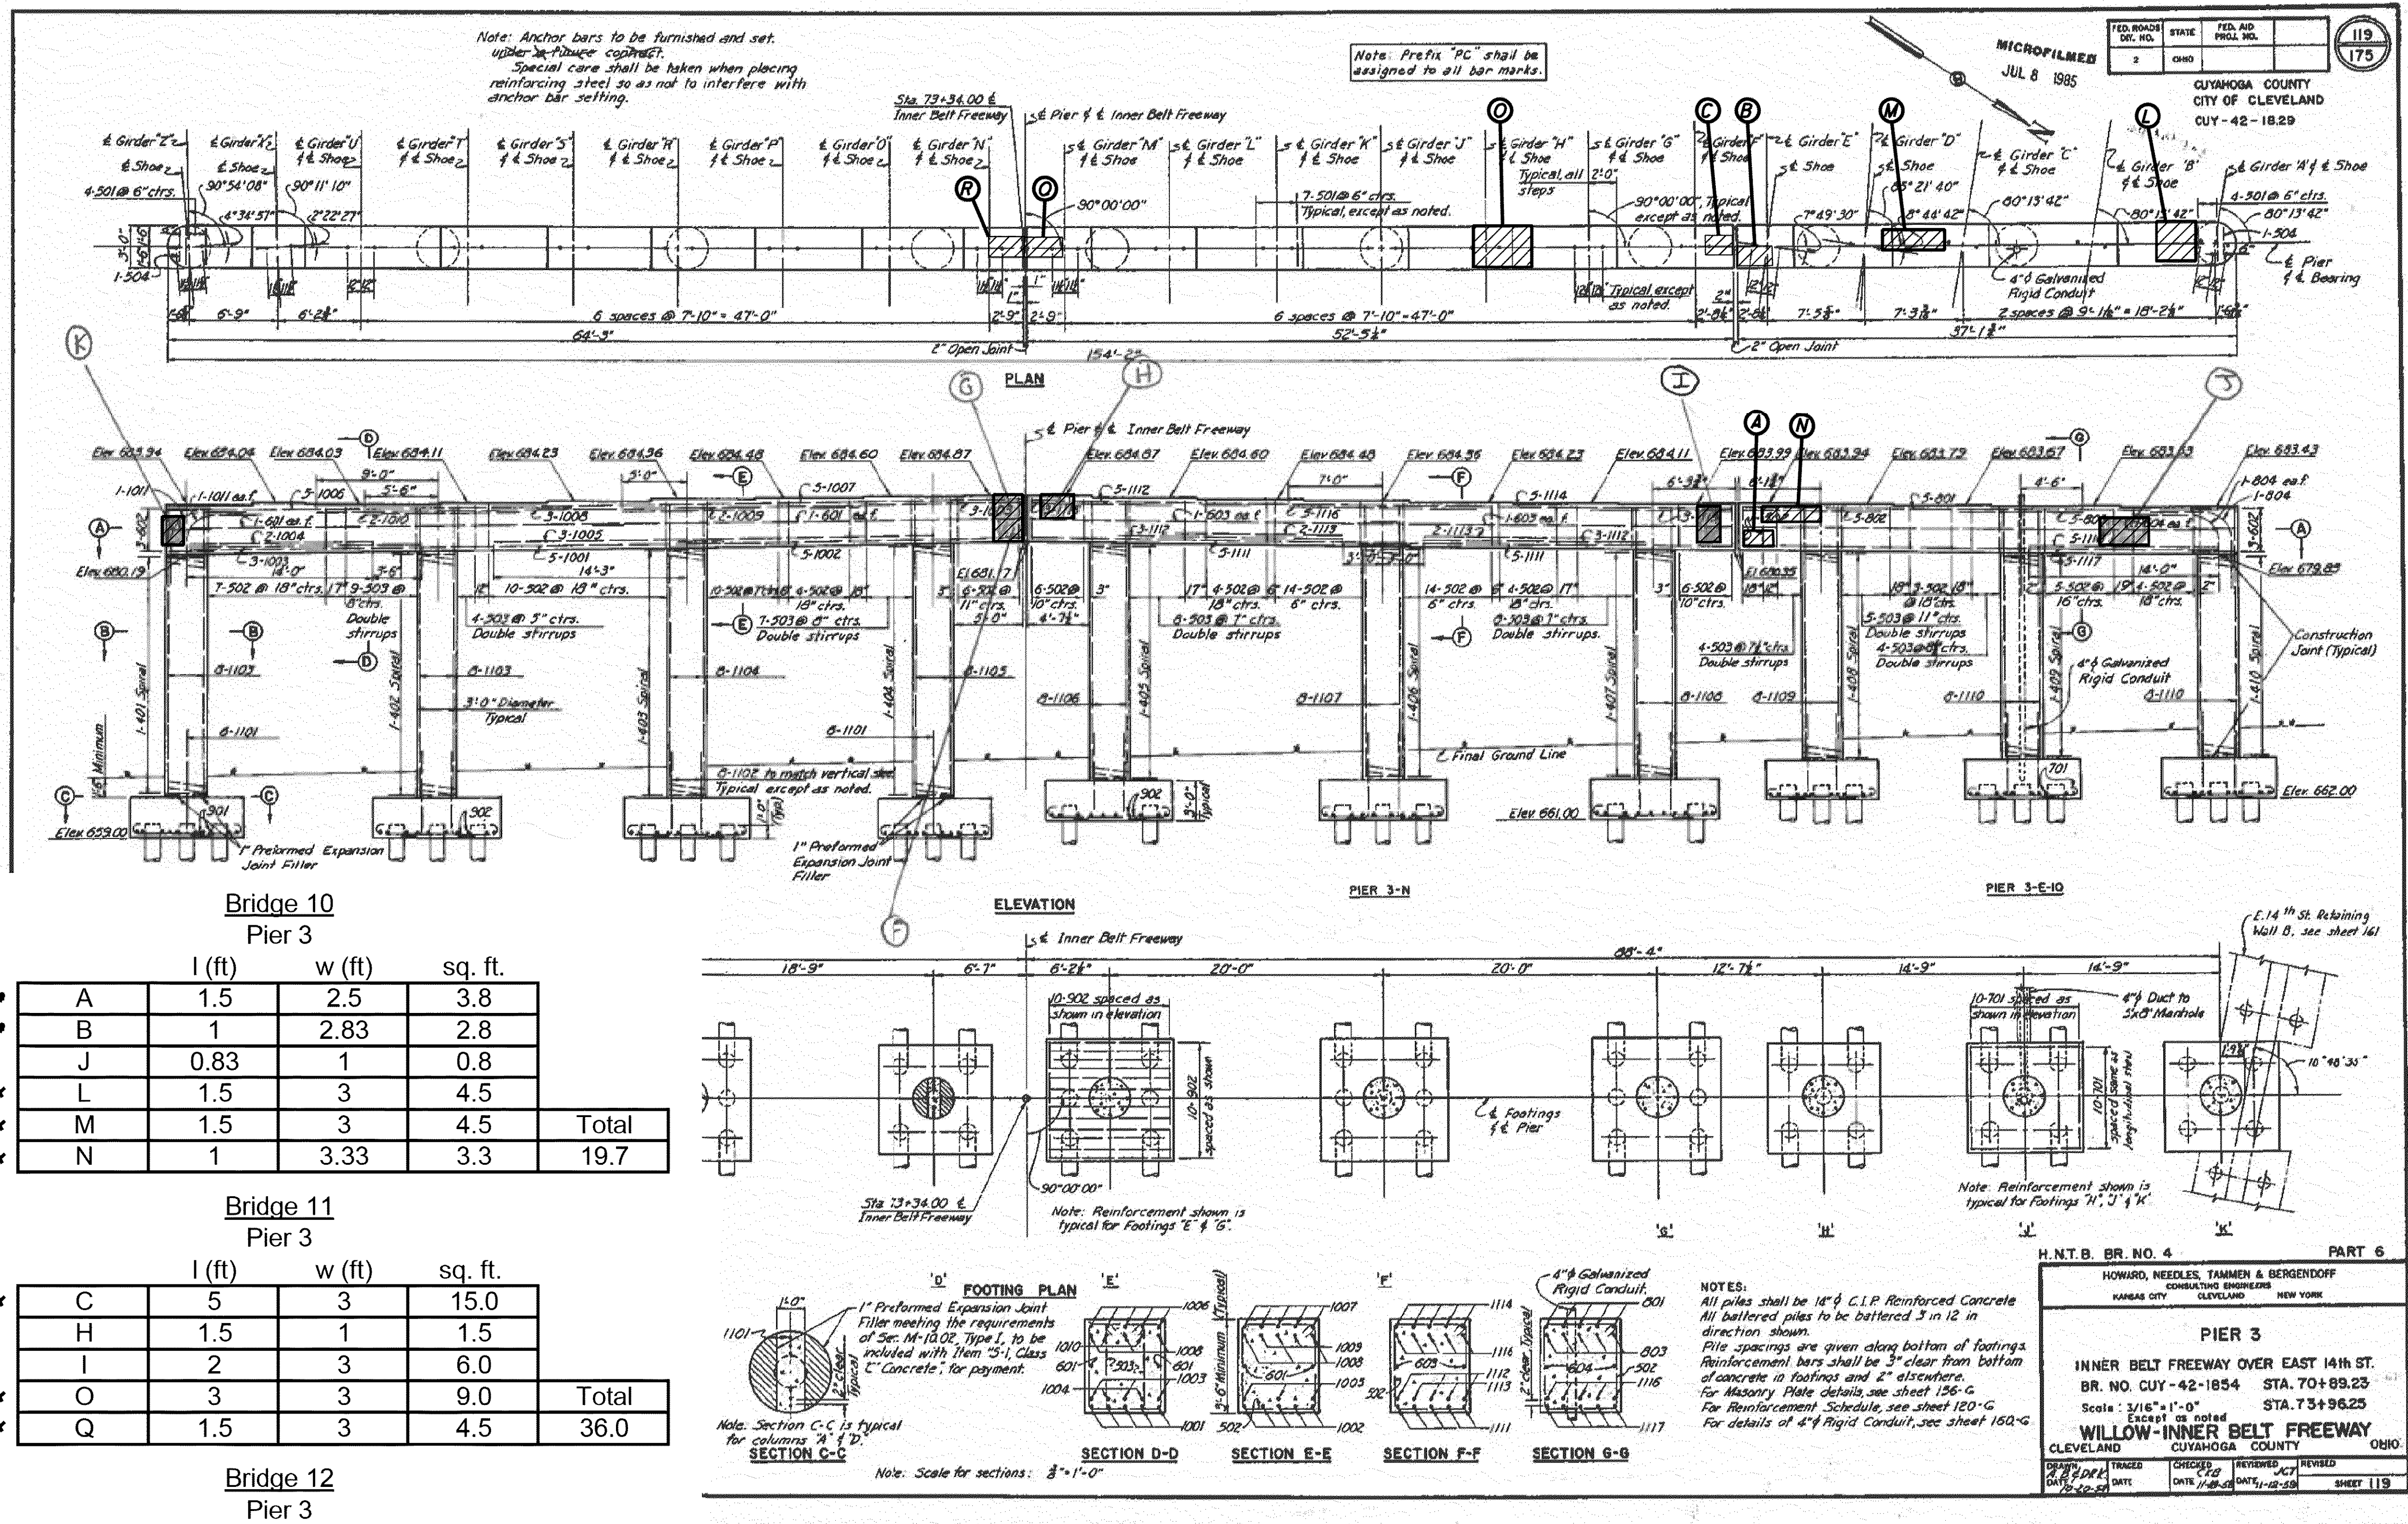

Bridge 10
Pier 3

	I (ft)	w (ft)	sq. ft.	
•	A	1.5	2.5	3.8
•	B	1	2.83	2.8
	J	0.83	1	0.8
x	L	1.5	3	4.5
x	M	1.5	3	4.5
x	N	1	3.33	3.3
				Total
				19.7

Bridge 11
Pier 3

	I (ft)	w (ft)	sq. ft.	
x	C	5	3	15.0
	H	1.5	1	1.5
	I	2	3	6.0
x	O	3	3	9.0
x	Q	1.5	3	4.5
				Total
				36.0

Bridge 12
Pier 3

	I (ft)	w (ft)	sq. ft.	
	G	1.5	2	3.0
	K	3	1.5	4.5
x	R	3	3	9.0
				Total
				16.5

x - INDICATES PATCHING IS ON BOTTOM SIDE
• - INDICATES PATCHING IS ON BACKSIDE

△ -- ADDED PATCHED LOCATIONS

DATE

REVISIONS

NO.

DESIGN AGENCY

WALSH HNTB

CLEVELAND'S INNERBELT BRIDGE

BRIDGE 10
BRIDGE 11
BRIDGE 12

DATE

REVIEWED

DRAWN

CHECKED

STRUCTURE FILE NUMBER

RECORD OF PIER 3 PATCHING

BRIDGE NO. CUY-90-1651L


I-90EB, I-90WB AND IR-77 RAMP OVER EAST 14TH

CUY-90-14.9.0
PID No. 77332 / 85531

19B / 38

19B / 38


090_1651LSD002.dgn 1/8/2016 11:33:35 AM rstriegel

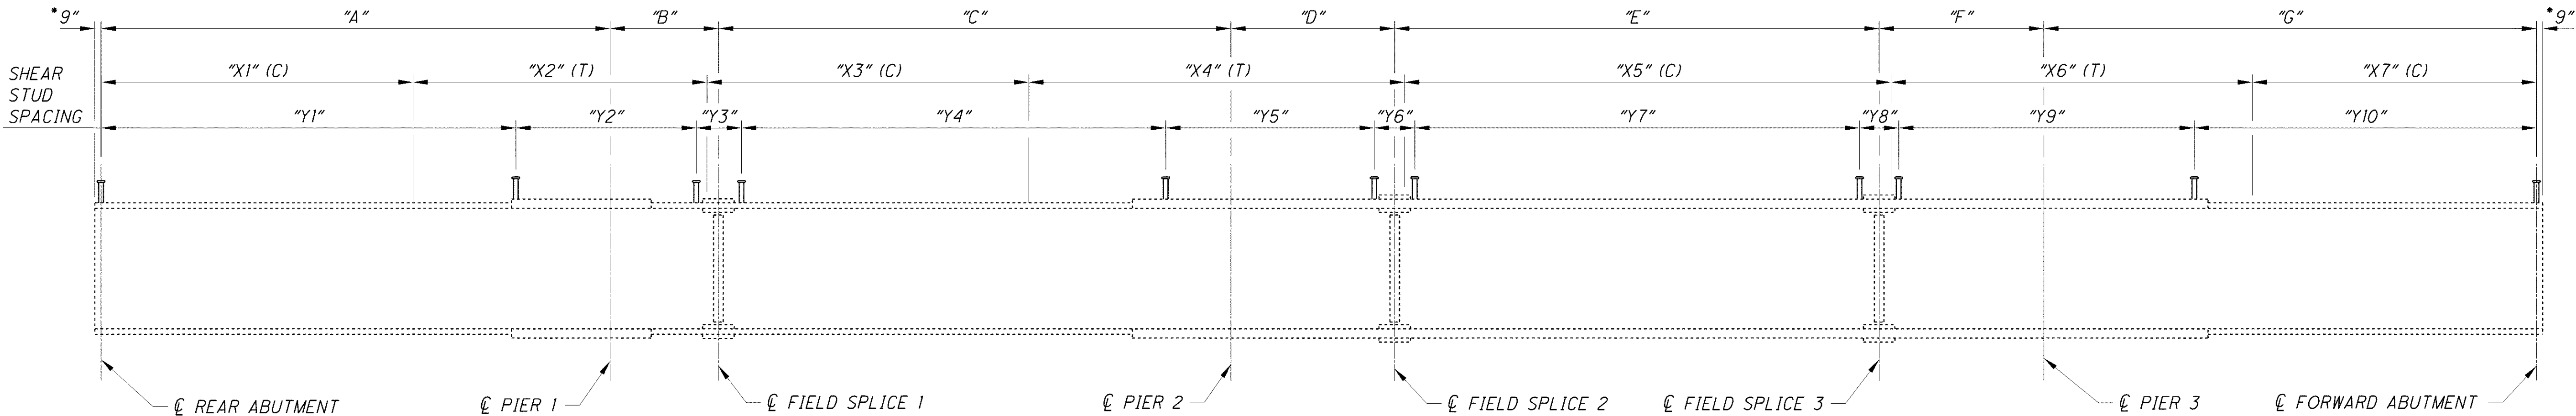

GIRDER ELEVATION
(CUY-90-1651L)

TABLE OF DIMENSIONS														
	"A"	"B"	"C"	"D"	"E"	"F"	"G"	"X1"	"X2"	"X3"	"X4"	"X5"	"X6"	"X7"
GIRDER F	55'-0"±	20'-2 ³ / ₈ "±	61'-3 ⁹ / ₁₆ "±	20'-0"±	59'-0"±	20'-0"±	60'-0"±	38'-0"	33'-0"	40'-9 ¹ / ₄ "	45'-0"	60'-0"	44'-0"	34'-8 ⁵ / ₈ "
GIRDER G	55'-0"±	20'-2 ³ / ₈ " ±	62'-4 ¹³ / ₁₆ "±	20'-0"±	59'-0"±	20'-0"±	60'-0"±	38'-0"	33'-0"	41'-10 ⁹ / ₁₆ "	45'-0"	60'-0"	44'-0"	34'-8 ⁵ / ₈ "
GIRDER H	55'-0"±	20'-2 ³ / ₈ "±	63'-6"±	20'-0"±	59'-0"±	20'-0"±	60'-0"±	38'-0"	33'-0"	41'-11 ³ / ₄ "	46'-0"	60'-0"	44'-0"	34'-8 ⁵ / ₈ "
GIRDER J	55'-0"±	20'-2 ³ / ₈ "±	64'-7 ³ / ₁₆ "±	20'-0"±	59'-0"±	20'-0"±	60'-0"±	38'-0"	33'-0"	42'-0 ⁵ / ₁₆ "	47'-0"	60'-0"	44'-0"	34'-8 ⁵ / ₈ "
GIRDER K	55'-0"±	20'-2 ³ / ₈ "±	65'-8 ¹ / ₁₆ "±	20'-0"±	59'-0"±	20'-0"±	60'-0"±	38'-0"	33'-0"	43'-2 ³ / ₁₆ "	47'-0"	60'-0"	44'-0"	34'-8 ⁵ / ₈ "
GIRDER L	55'-0"±	20'-2 ³ / ₈ "±	66'-9 ⁵ / ₈ "±	20'-0"±	59'-0"±	20'-0"±	60'-0"±	38'-0"	33'-0"	43'-3 ³ / ₈ "	48'-0"	60'-0"	44'-0"	34'-8 ⁵ / ₈ "
GIRDER M	55'-0"±	20'-2 ³ / ₈ "±	67'-10 ¹³ / ₁₆ "±	20'-0"±	59'-0"±	20'-0"±	60'-0"±	38'-0"	33'-0"	44'-4 ⁹ / ₁₆ "	48'-0"	60'-0"	44'-0"	34'-8 ⁵ / ₈ "

SHEAR STUD SPACING											
	"Y1"	"Y2"	"Y3"	"Y4"	"Y5"	"Y6"	"Y7"	"Y8"	"Y9"	"Y10"	
GIRDER F	61 SPA. @ 10" = 50'-10"	15 SPA. @ 1'-6" = 22'-6"	3'-10"	61 SPA. @ 10" = 50'-10"	13 SPA. @ 2'-0" = 26'-0"	4'-4 1/8"	65 SPA. @ 10" = 54'-2"	5'-4"	18 SPA. @ 2'-0" = 36'-0"	50 SPA. @ 10" = 41'-8"	
GIRDER G	61 SPA. @ 10" = 50'-10"	15 SPA. @ 1'-6" = 22'-6"	3'-10"	63 SPA. @ 10" = 52'-6"	13 SPA. @ 2'-0" = 26'-0"	4'-4 1/8"	65 SPA. @ 10" = 54'-2"	4'-9 ¹ / ₄ "	18 SPA. @ 2'-0" = 36'-0"	50 SPA. @ 10" = 41'-8"	
GIRDER H	61 SPA. @ 10" = 50'-10"	15 SPA. @ 1'-6" = 22'-6"	3'-10"	64 SPA. @ 10" = 53'-4"	13 SPA. @ 2'-0" = 26'-0"	4'-4 1/8"	65 SPA. @ 10" = 54'-2"	5'-0 ¹ / ₂ "	18 SPA. @ 2'-0" = 36'-0"	50 SPA. @ 10" = 41'-8"	
GIRDER J	61 SPA. @ 10" = 50'-10"	15 SPA. @ 1'-6" = 22'-6"	3'-10"	65 SPA. @ 10" = 54'-2"	13 SPA. @ 2'-0" = 26'-0"	4'-4 1/8"	65 SPA. @ 10" = 54'-2"	5'-3 ³ / ₄ "	18 SPA. @ 2'-0" = 36'-0"	50 SPA. @ 10" = 41'-8"	
GIRDER K	61 SPA. @ 10" = 50'-10"	15 SPA. @ 1'-6" = 22'-6"	3'-10"	66 SPA. @ 10" = 55'-0"	13 SPA. @ 2'-0" = 26'-0"	4'-4 1/8"	65 SPA. @ 10" = 54'-2"	5'-6 ⁷ / ₈ "	18 SPA. @ 2'-0" = 36'-0"	50 SPA. @ 10" = 41'-8"	
GIRDER L	61 SPA. @ 10" = 50'-10"	15 SPA. @ 1'-6" = 22'-6"	3'-10"	68 SPA. @ 10" = 56'-8"	13 SPA. @ 2'-0" = 26'-0"	4'-4 1/8"	65 SPA. @ 10" = 54'-2"	5'-0"	18 SPA. @ 2'-0" = 36'-0"	50 SPA. @ 10" = 41'-8"	
GIRDER M	61 SPA. @ 10" = 50'-10"	15 SPA. @ 1'-6" = 22'-6"	3'-10"	69 SPA. @ 10" = 57'-6"	13 SPA. @ 2'-0" = 26'-0"	4'-4 1/8"	65 SPA. @ 10" = 54'-2"	5'-3 ³ / ₈ "	18 SPA. @ 2'-0" = 36'-0"	50 SPA. @ 10" = 41'-8"	

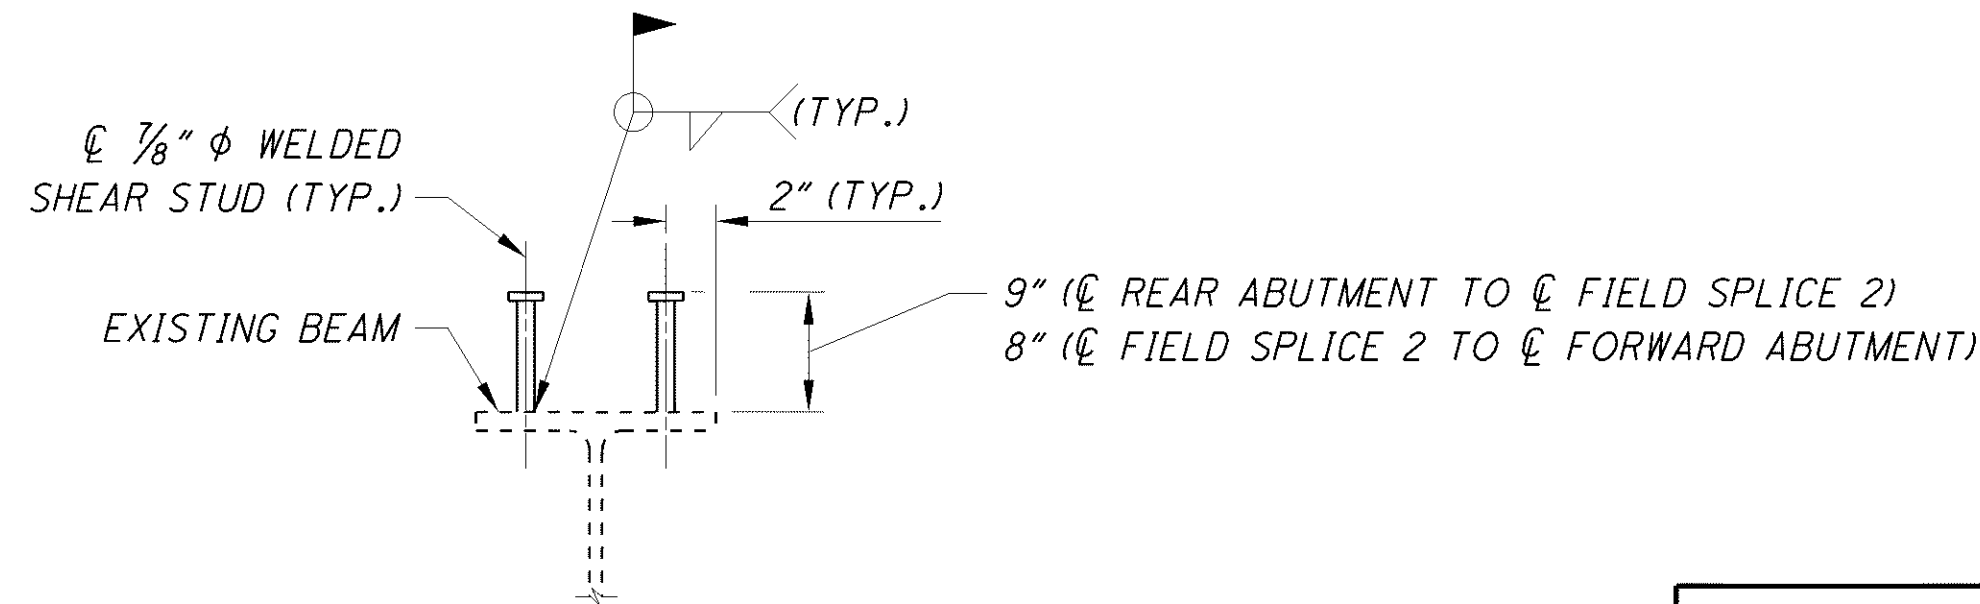

SHEAR STUD DETAIL

(SHEAR STUD PLACEMENT ON BOLTED FLANGE PLATES IS NOT PERMITTED. ADJUST SPACING AS NECESSARY TO AVOID INTERFERENCE.)

GIRDER REMOVAL LENGTH						
GIRDER LINE	F	G	H	J	K	L
FORWARD ABUTMENT	3"	3"	3"	3 ¹ / ₄ "	3 ¹ / ₂ "	2 ¹ / ₂ "
REAR ABUTMENT	1 ¹ / ₄ "	1"	1 ¹ / ₄ "	3 ³ / ₄ "	7 ¹ / ₈ "	1"
SEE NOTE 2						

LEGEND:

(T) DENOTES AREA OF TENSION IN THE TOP FLANGE. THE BOTTOM FLANGE IN THESE AREAS IS IN COMPRESSION.

(C) DENOTES AREA OF COMPRESSION IN THE TOP FLANGE. THE BOTTOM FLANGE IN THESE AREAS IS IN TENSION.

* DIMENSION SHOWN IS THE PRECUT LENGTH. SEE NOTE 2.

NOTES:

- WELD ATTACHMENT OF SUPPORTS FOR CONCRETE DECK FINISHING MACHINE TO AREAS OF THE FASCIA STRINGER FLANGES DESIGNATED "COMPRESSION". DO NOT WELD ATTACHMENTS TO AREAS DESIGNATED "TENSION". FILLET WELDS TO COMPRESSION FLANGES SHALL BE AT LEAST 1" FROM EDGE OF FLANGE, BE NO MORE THAN 2" LONG, AND BE AT LEAST 1/4" FOR THICKNESS UP TO 3/4" OR 5/8" FOR GREATER THAN 3/4" THICK.
- EXISTING BACKWALLS ARE BOWED. BEAM ENDS TO BE TRIMMED TO PROVIDE A GAP FOR EXPANSION AND CONTRACTION TO ALLOW FOR PROPER OPERATION BY TORCH METHOD. THE EXISTING PAINT SYSTEM SHALL BE REPAIRED USING COLD GALVANIZED PAINT. A FUTURE PROJECT WILL REPAIR OR REPLACE THE STRUCTURAL STEEL.

DESIGNED	DRAWN	REVIEWED	DATE	BRIDGES		GIRDER ELEVATION - 1	
JTW	JTW	JOL	03-11-11	10 & 11		BRIDGE NO. CUY-77-1597 L AND CUY-90-1651 L	
CHECKED	CHECKED	CHECKED	STRUCTURE FILE NUMBER	1807919/1807900		I-90WB AND I-77SB RAMP OVER E 14TH STREET	
NJ	NJ	NJ	1807919/1807900	CUY-90-14.90		PID No. 77332 / 85531	
21		38		21		38	



SHEAR STUD SPACING									
	"Y1"	"Y2"	"Y3"	"Y4"	"Y5"	"Y6"	"Y7"	"Y8"	"Y9"
GIRDER A	86 SPA. @ 9" = 64'-6"	3'-0"	44 SPA. @ 9" = 33'-0"	18 SPA. @ 24" = 36'-0"	4'-6"	75 SPA. @ 9" = 56'-3"	4'-4½"	16 SPA. @ 24" = 32'-0"	62 SPA. @ 9" = 46'-6"
GIRDER B	85 SPA. @ 9" = 63'-9"	4'-6"	45 SPA. @ 9" = 33'-9"	18 SPA. @ 24" = 36'-0"	4'-9"	74 SPA. @ 9" = 55'-6"	5'-2¾"	16 SPA. @ 24" = 32'-0"	61 SPA. @ 9" = 45'-9"
GIRDER C	85 SPA. @ 9" = 63'-9"	4'-3"	47 SPA. @ 9" = 35'-3"	18 SPA. @ 24" = 36'-0"	4'-9"	74 SPA. @ 9" = 55'-6"	5'-0⅞"	16 SPA. @ 24" = 32'-0"	61 SPA. @ 9" = 45'-9"
GIRDER D	85 SPA. @ 9" = 63'-9"	4'-3"	49 SPA. @ 9" = 36'-9"	18 SPA. @ 24" = 36'-0"	4'-9"	73 SPA. @ 9" = 54'-9"	5'-4¼"	16 SPA. @ 24" = 32'-0"	61 SPA. @ 9" = 45'-9"
GIRDER E	86 SPA. @ 9" = 64'-6"	3'-0"	49 SPA. @ 9" = 36'-9"	19 SPA. @ 24" = 38'-0"	4'-0"	75 SPA. @ 9" = 56'-3"	4'-0⅞"	16 SPA. @ 24" = 32'-0"	61 SPA. @ 9" = 45'-9"



GIRDER REMOVAL LENGTH					
GIRDER LINE	A	B	C	D	E
FORWARD ABUTMENT	2½"	3"	2¼"	3"	2"
REAR ABUTMENT	3½"	3½"	3½"	2"	2"
SEE NOTE 2					

2. EXISTING BACKWALLS ARE BOWED. BEAM ENDS TO BE TRIMMED TO PROVIDE A GAP FOR EXPANSION AND CONTRACTION TO ALLOW FOR PROPER OPERATION BY TORCH METHOD. THE EXISTING PAINT SYSTEM SHALL BE REPAIRED USING COLD GALVANIZED PAINT. A FUTURE PROJECT WILL REPAIR OR REPLACE THE STRUCTURAL STEEL.

WALSH
DESIGN AGENCY

WALSH CONSTRUCTION

90-1651 L
STREET

BRIDGES
10 & 11

CLEVELAND'S
WINNERBEITBRIDGE




90
THE JOURNAL OF TRANSPORTATION

GIRDER ELEVATION - 2


BRIDGE NO. CUY-77-1597 L AND CUY-
 I-90WB AND I-77SB RAMP OVER E 141

<div><div>22</div><div>38</div></div>	<div><div>22</div><div>38</div></div>	DTW	DTW	DATE
		CHECKED	CHECKED	REVIEWED
	NJ	NJ	JUL	03-11-11
			STRUCTURE FILE NUMBER	
			1807919/1807900	
CUY -90-14.90				
PID No. 77332 / 85531				

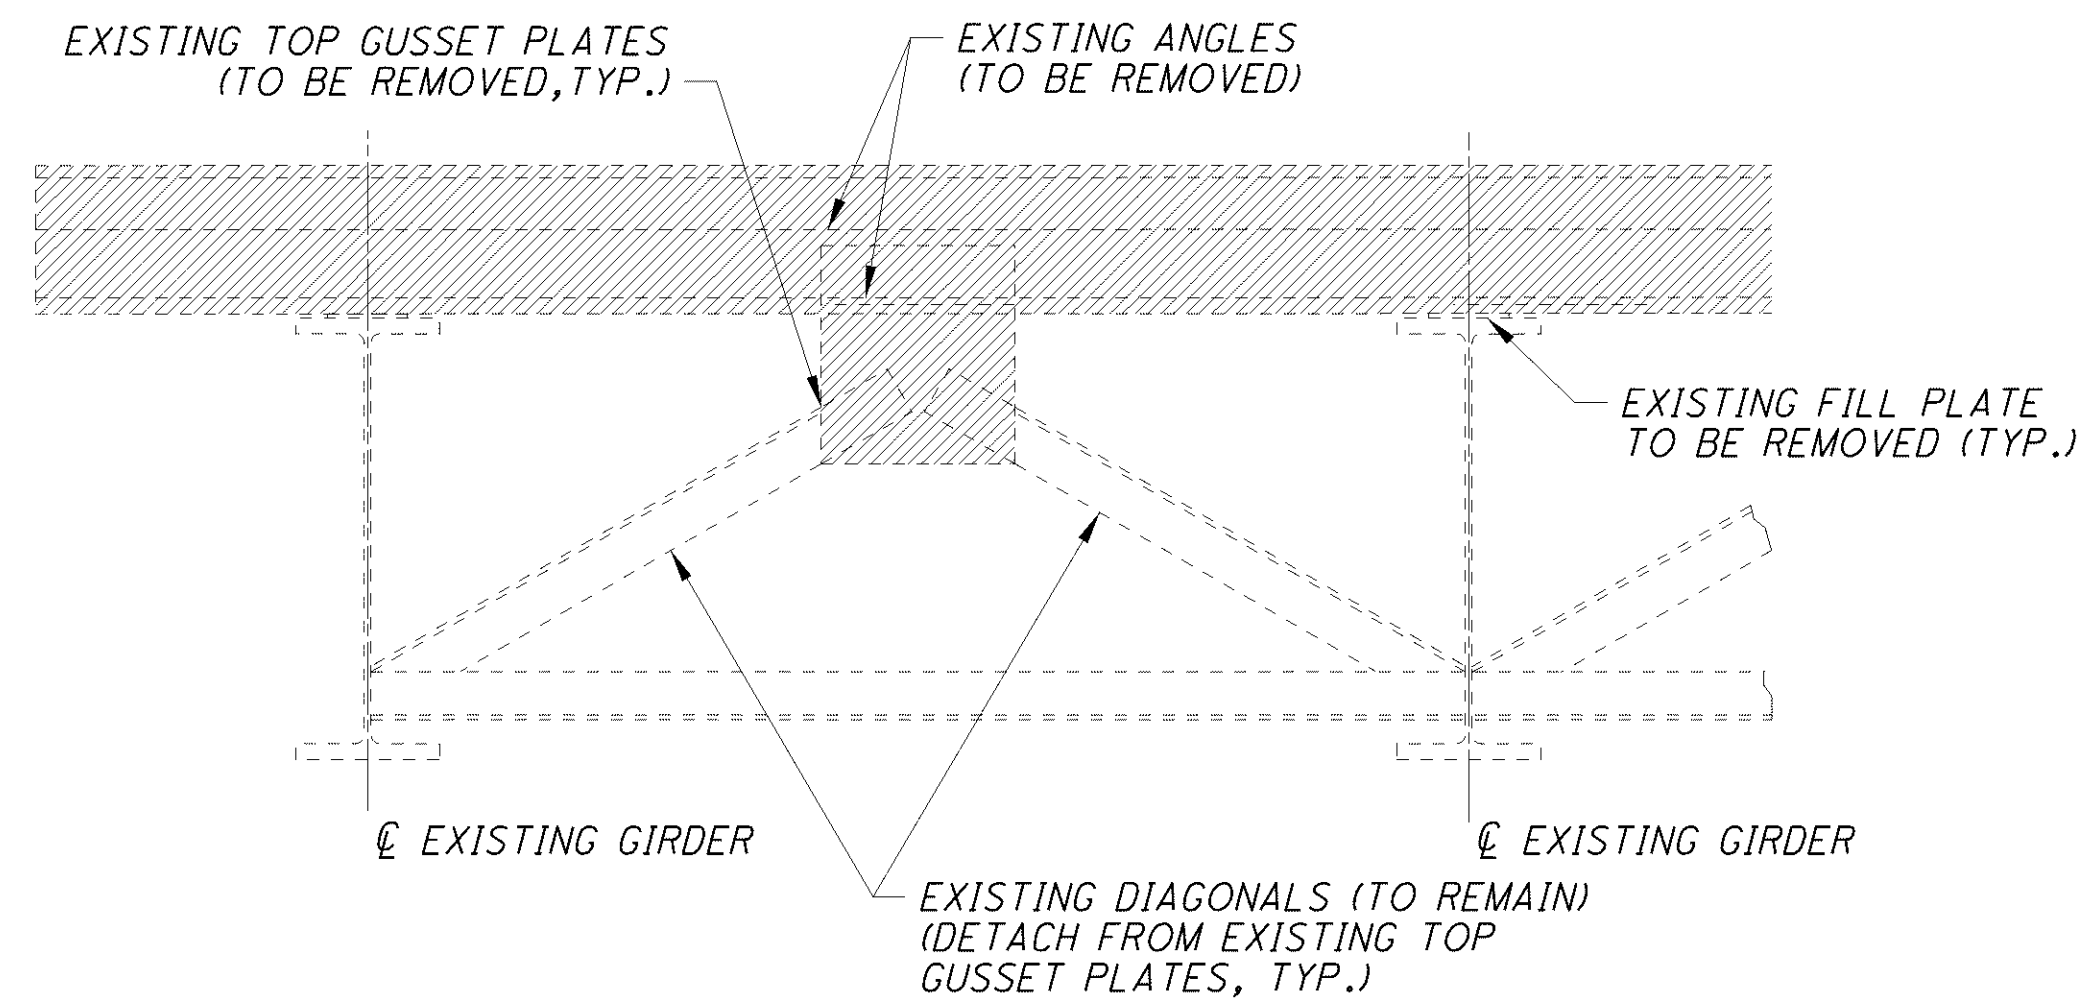


END CROSSFRAME REMOVAL @
CUY-77-1597L FORWARD ABUTMENT,
CUY-90-1651L REAR AND FORWARD ABUTMENT

(SEE NOTE 1)
(NOT TO SCALE)
(SHOWN LOOKING AT DECK)

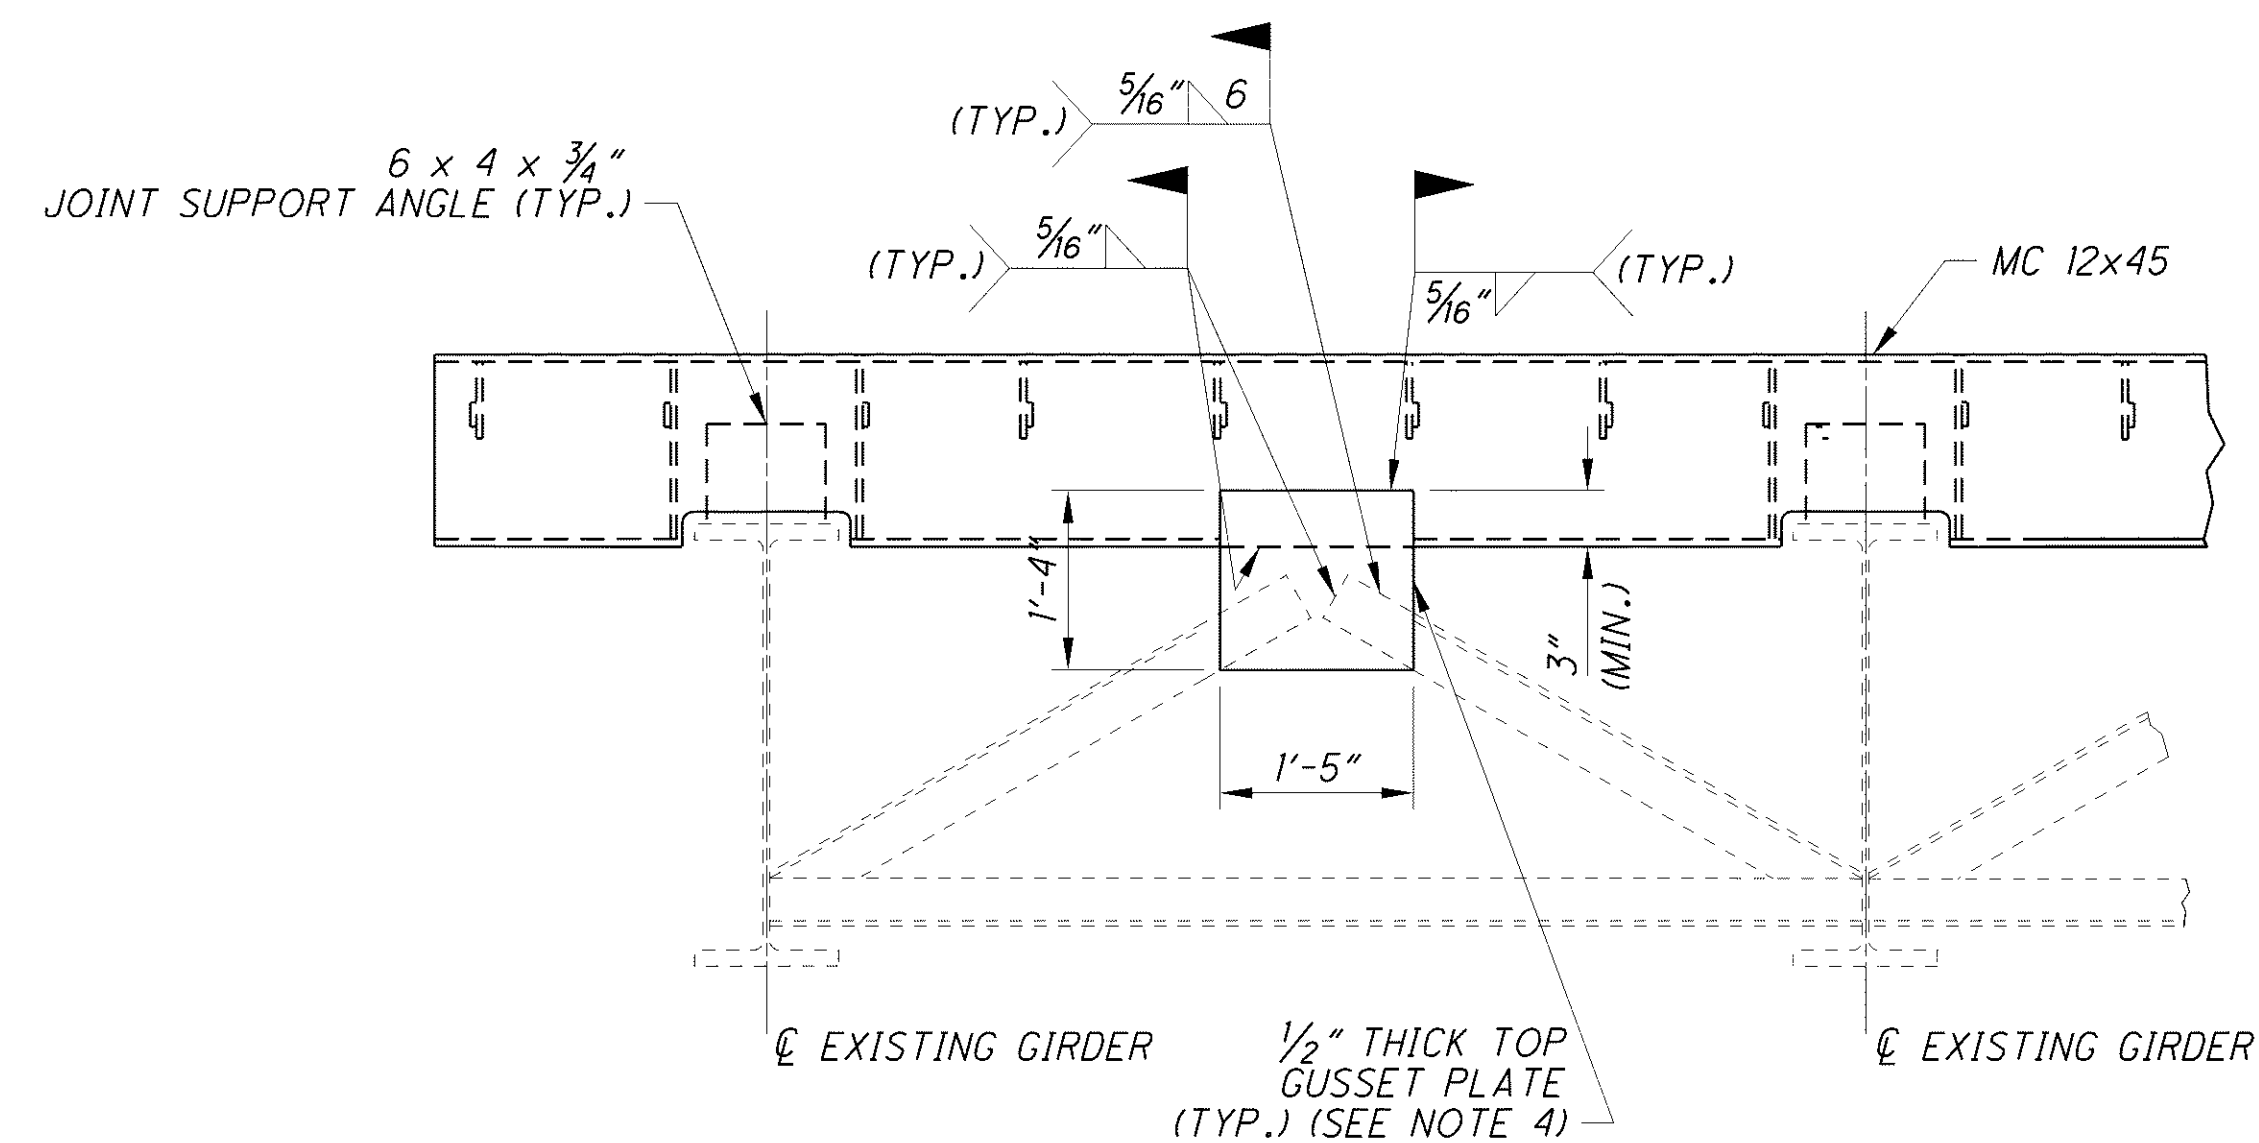


END CROSSFRAME RETROFIT @
CUY-77-1597L FORWARD ABUTMENT,
CUY-90-1651L REAR AND FORWARD ABUTMENT

(SEE NOTE 1)
(NOT TO SCALE)
(SHOWN LOOKING AT DECK)

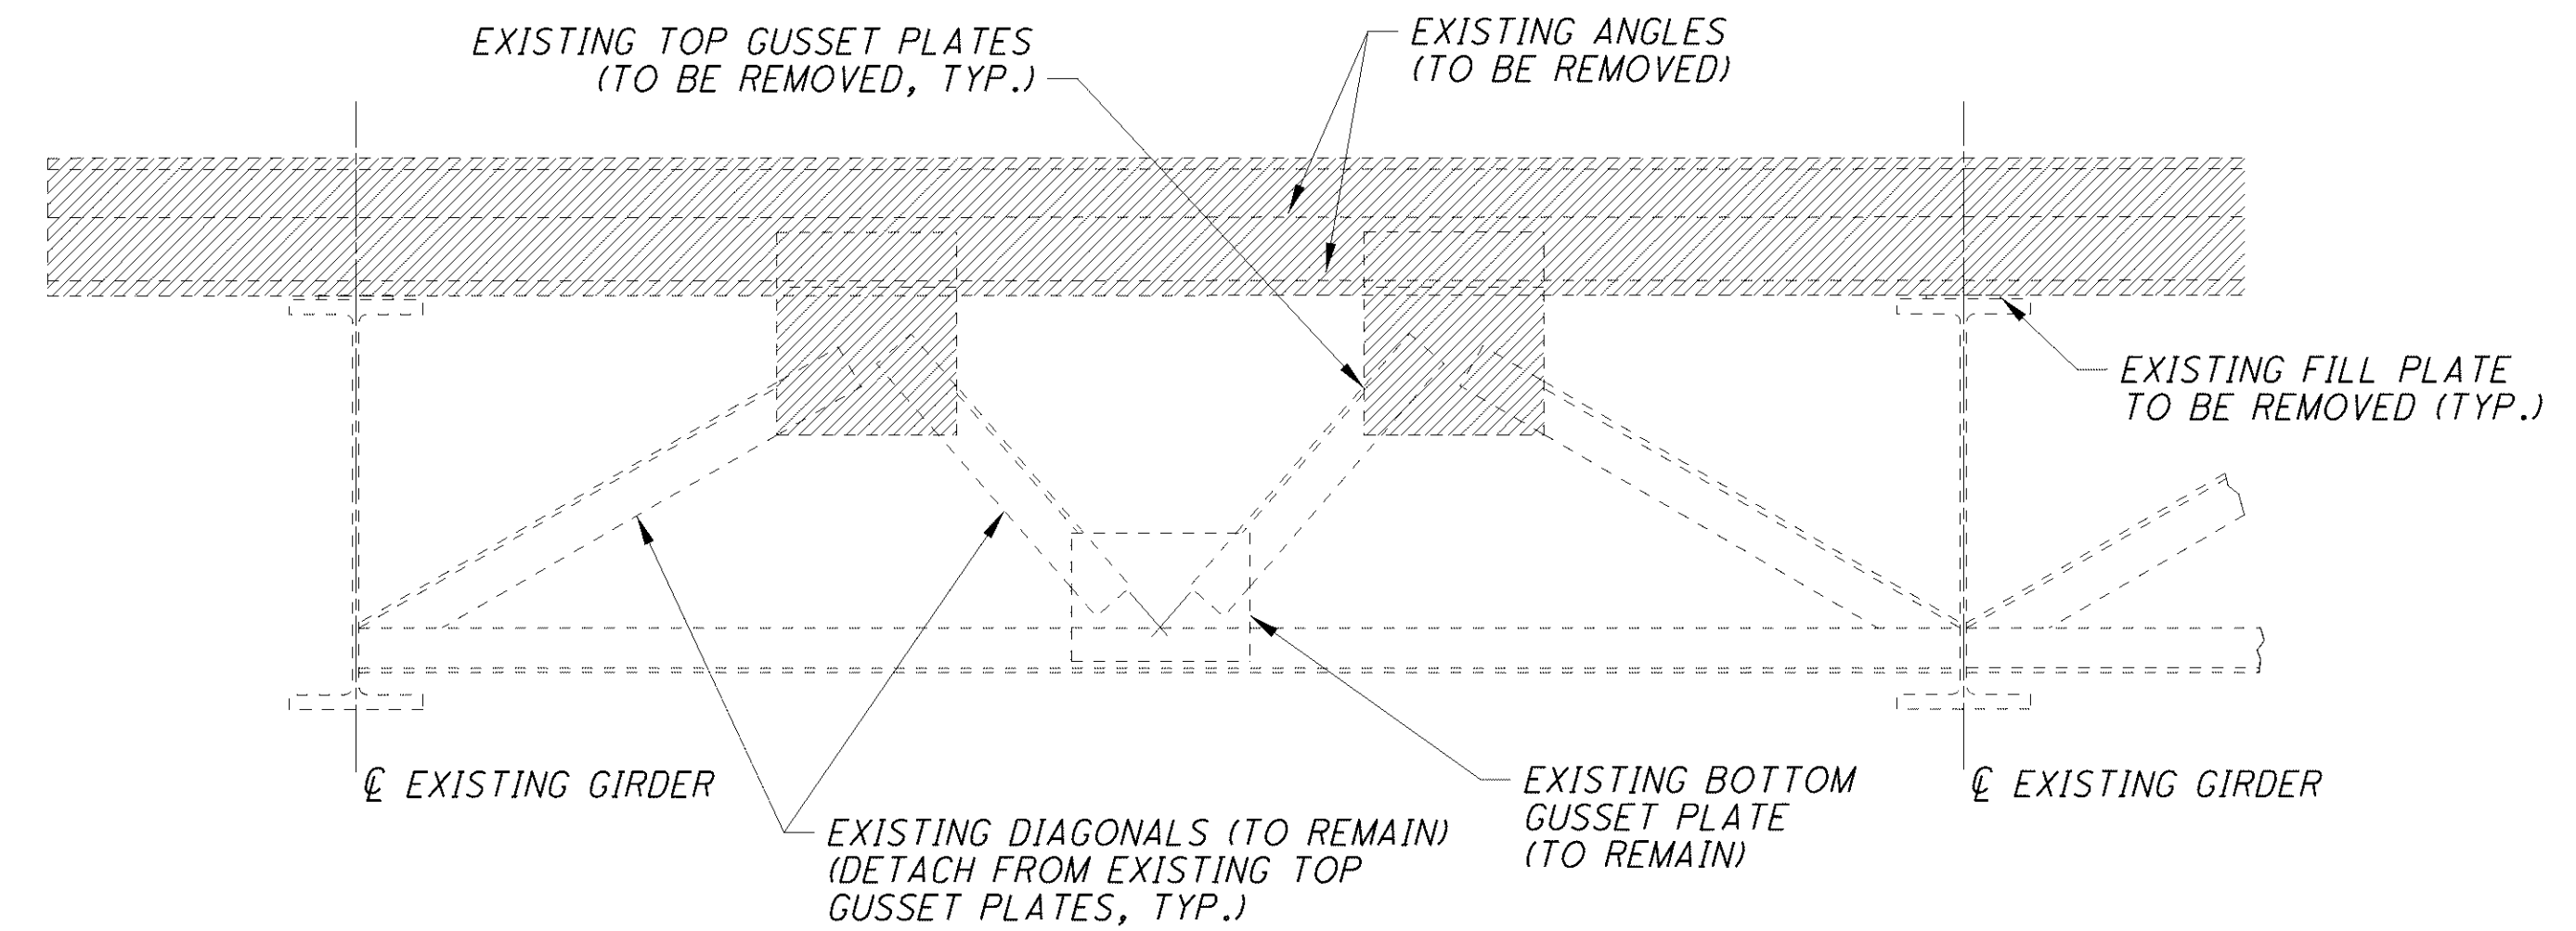

END CROSSFRAME REMOVAL @
CUY-77-1597L REAR ABUTMENT

(SEE NOTE 1)
(NOT TO SCALE)
(SHOWN LOOKING AT DECK)

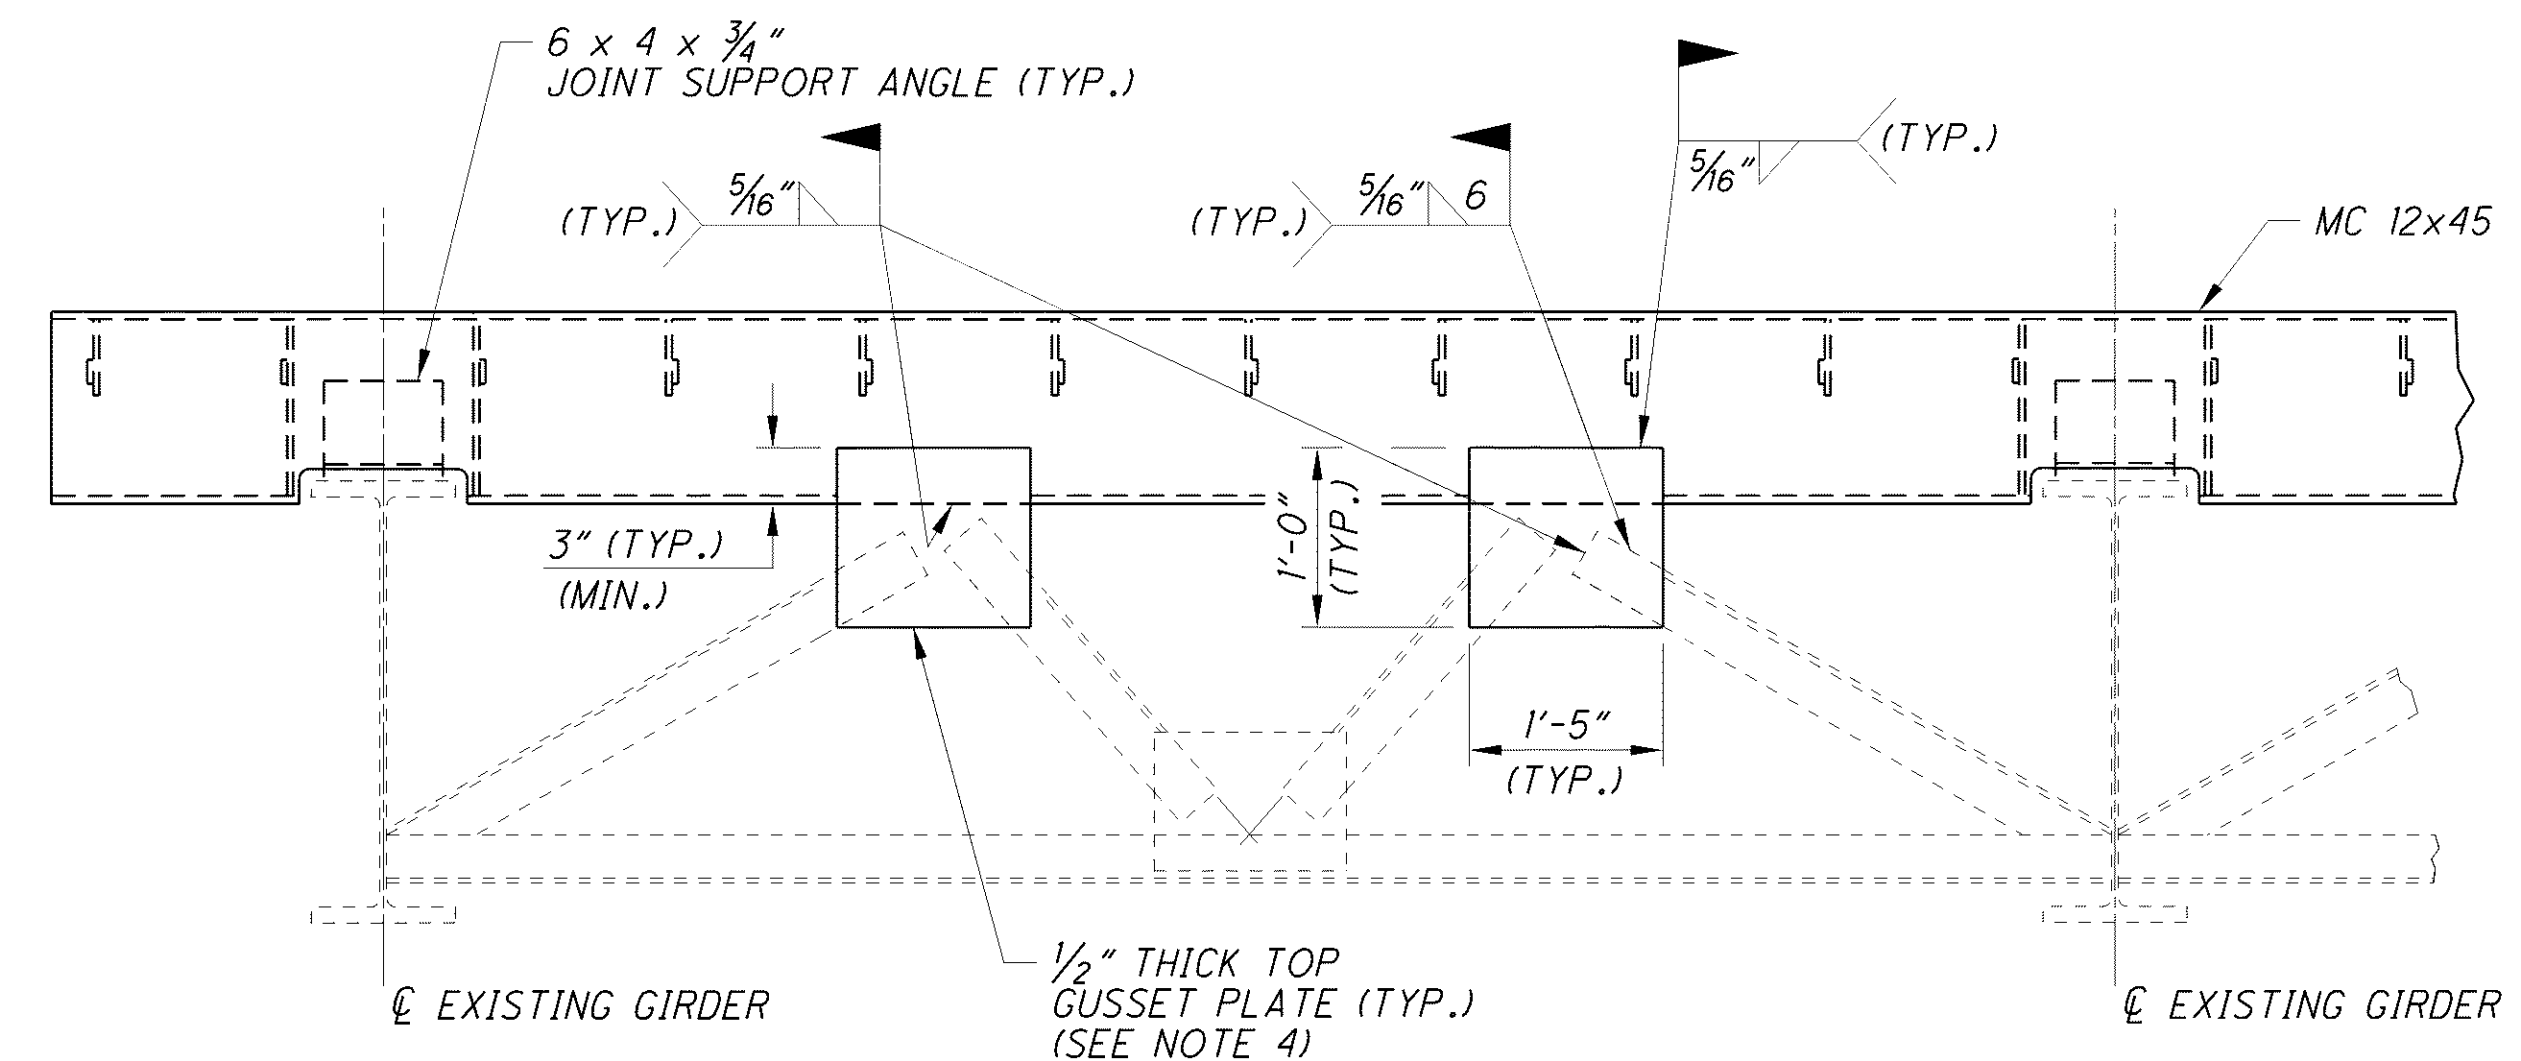


END CROSSFRAME RETROFIT @
CUY-77-1597L REAR ABUTMENT

(SEE NOTE 1)
(NOT TO SCALE)
(SHOWN LOOKING AT DECK)

NOTE:


1. DEPICTION OF THE EXISTING END CROSSFRAMES SHALL BE CONSIDERED REPRESENTATIVE OF THE ACTUAL END CROSSFRAMES.
2. FOR JOINT SUPPORT ANGLE, MC12x45, PLATE CONNECTION DETAILS AND ADDITIONAL DETAILS FOR PROPOSED END CROSSFRAME RETROFIT, REFER TO ODOT STANDARD DRAWING EXJ-4-87.
3. FOR ADDITIONAL EXPANSION JOINT DETAILS, SEE SHEETS 35/38 AND 36/38.
4. IF PROPOSED PHASE CONSTRUCTION SPLICE IN THE MC 12x45 JOINT ARMOR COINCIDES WITH A PROPOSED GUSSET PLATE ATTACHMENT LOCATION, COMPLETE WELDED SPLICE OF MC 12x45 PRIOR TO WELDING ATTACHMENT OF GUSSET PLATE.
5. SEE ODOT STANDARD DRAWING GSD-I-96 FOR DETAILS OTHERWISE NOT SHOWN.

090_1651LSD005.dgn 1/8/2016 11:33:58 AM rstriegel

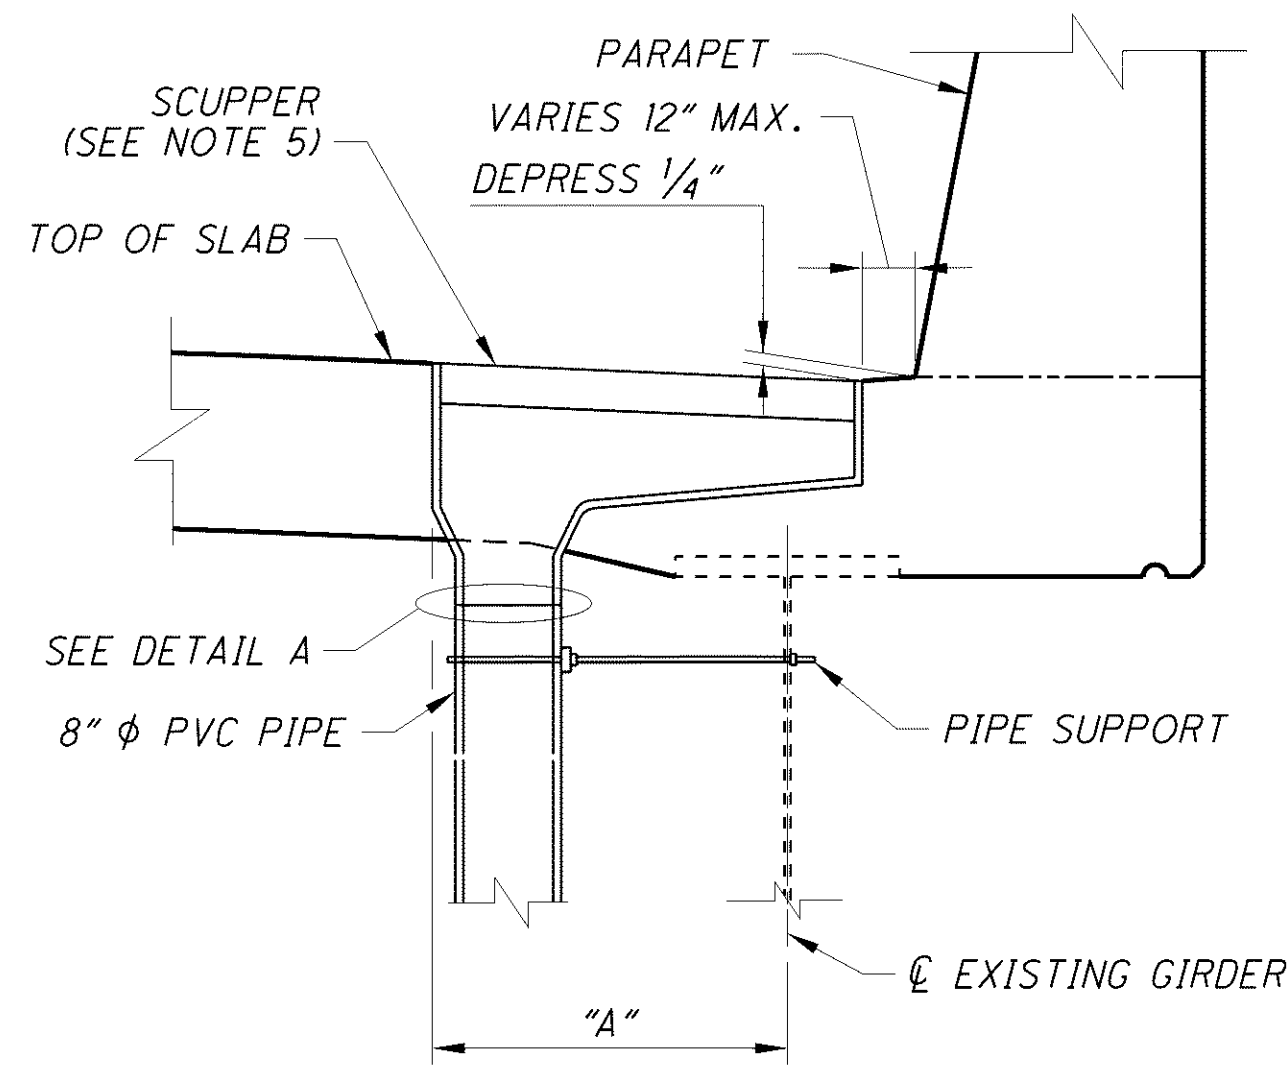


TYPICAL SCUPPER ELEVATION


DIMENSION "A" TABLE	
LOCATION	"A"
GIRDER A	2'-4"
GIRDER E	1'-10"
GIRDER F	1'-6"

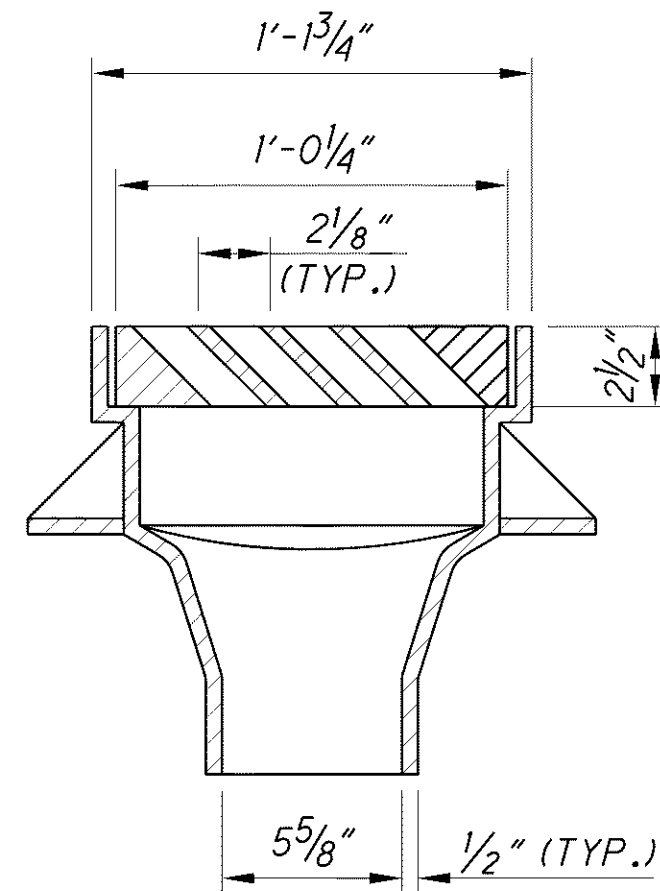


SCUPPER DETAILS
(SEE NOTE 5)

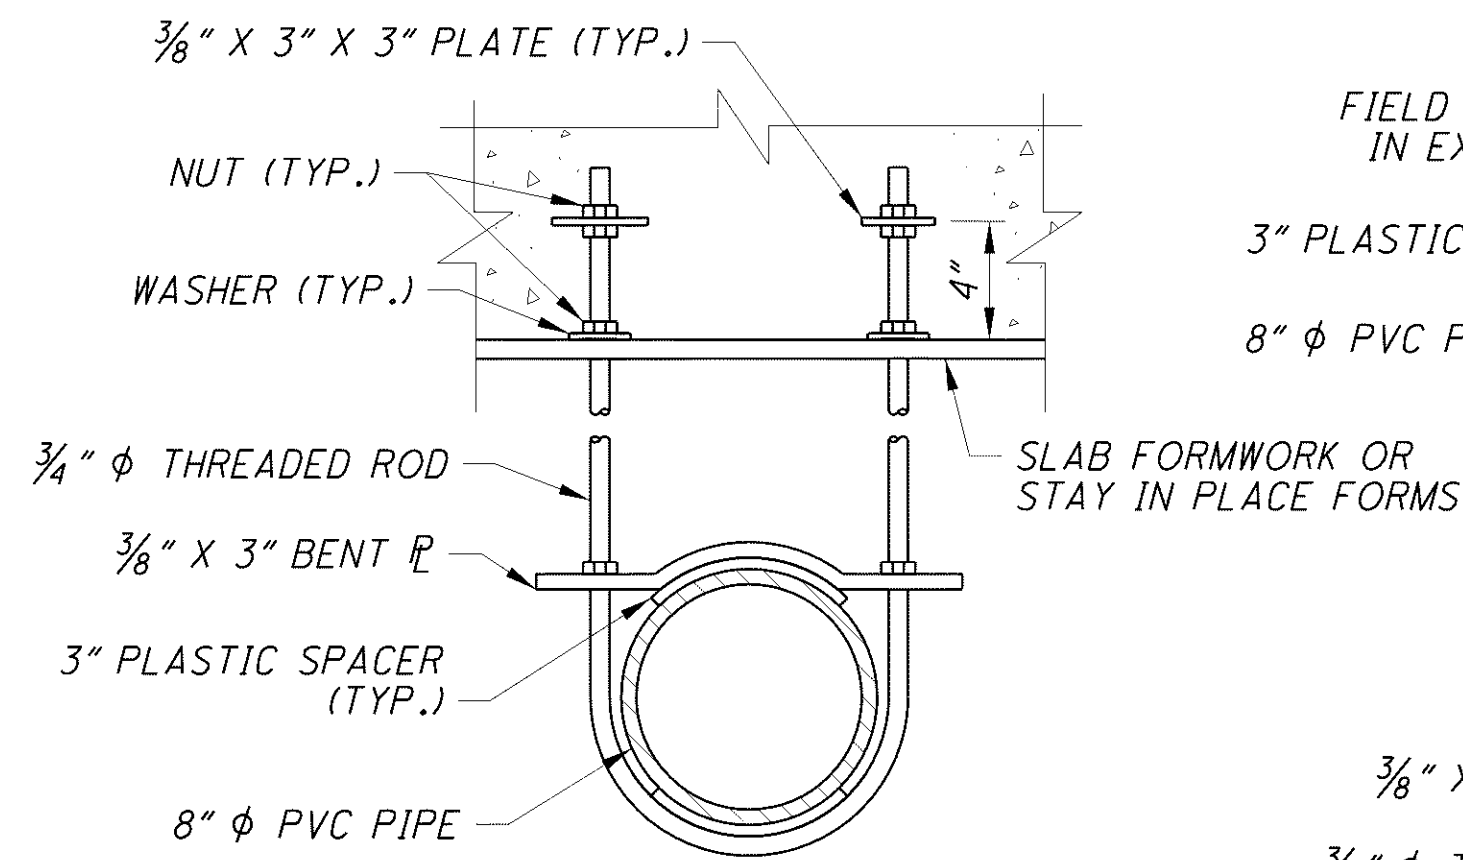


PIPE SUPPORT FROM SLAB

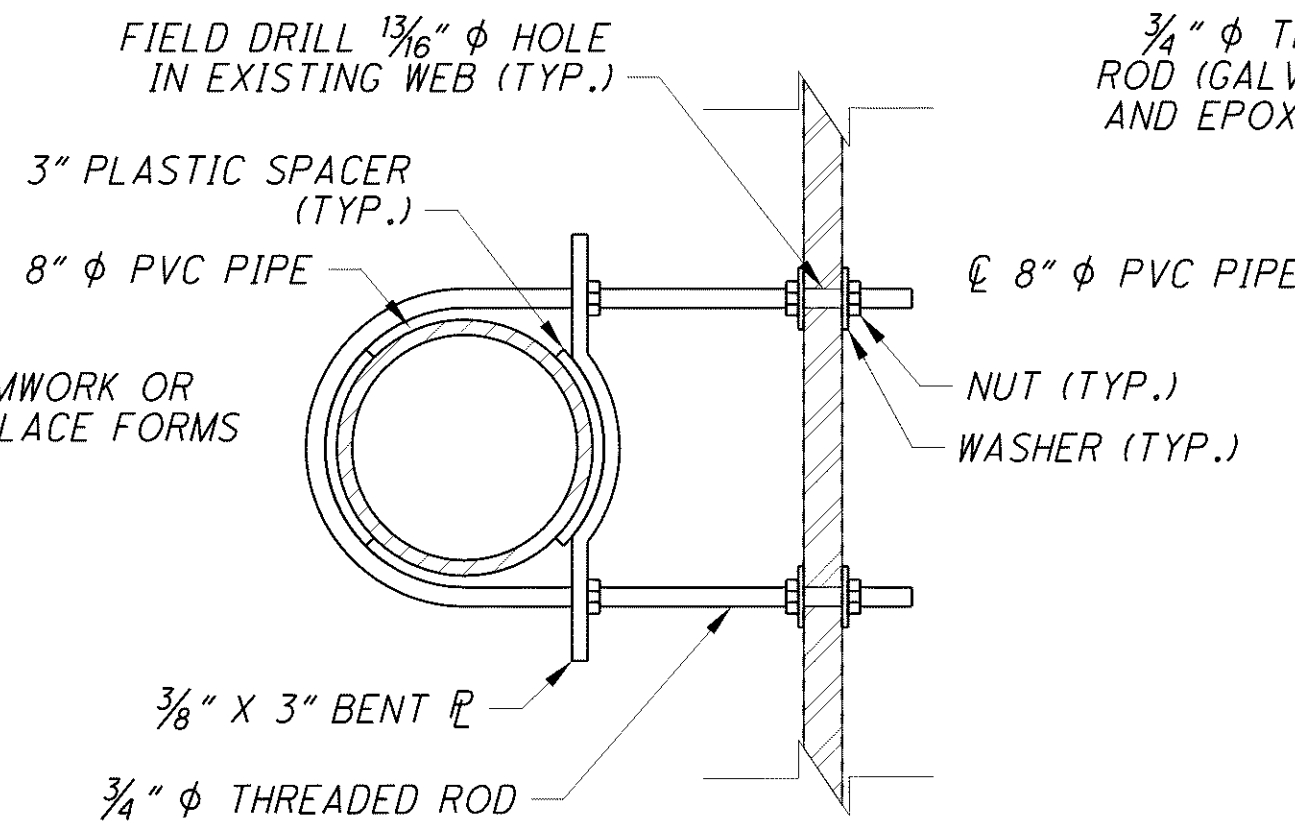


PIPE SUPPORT AT GIRDER

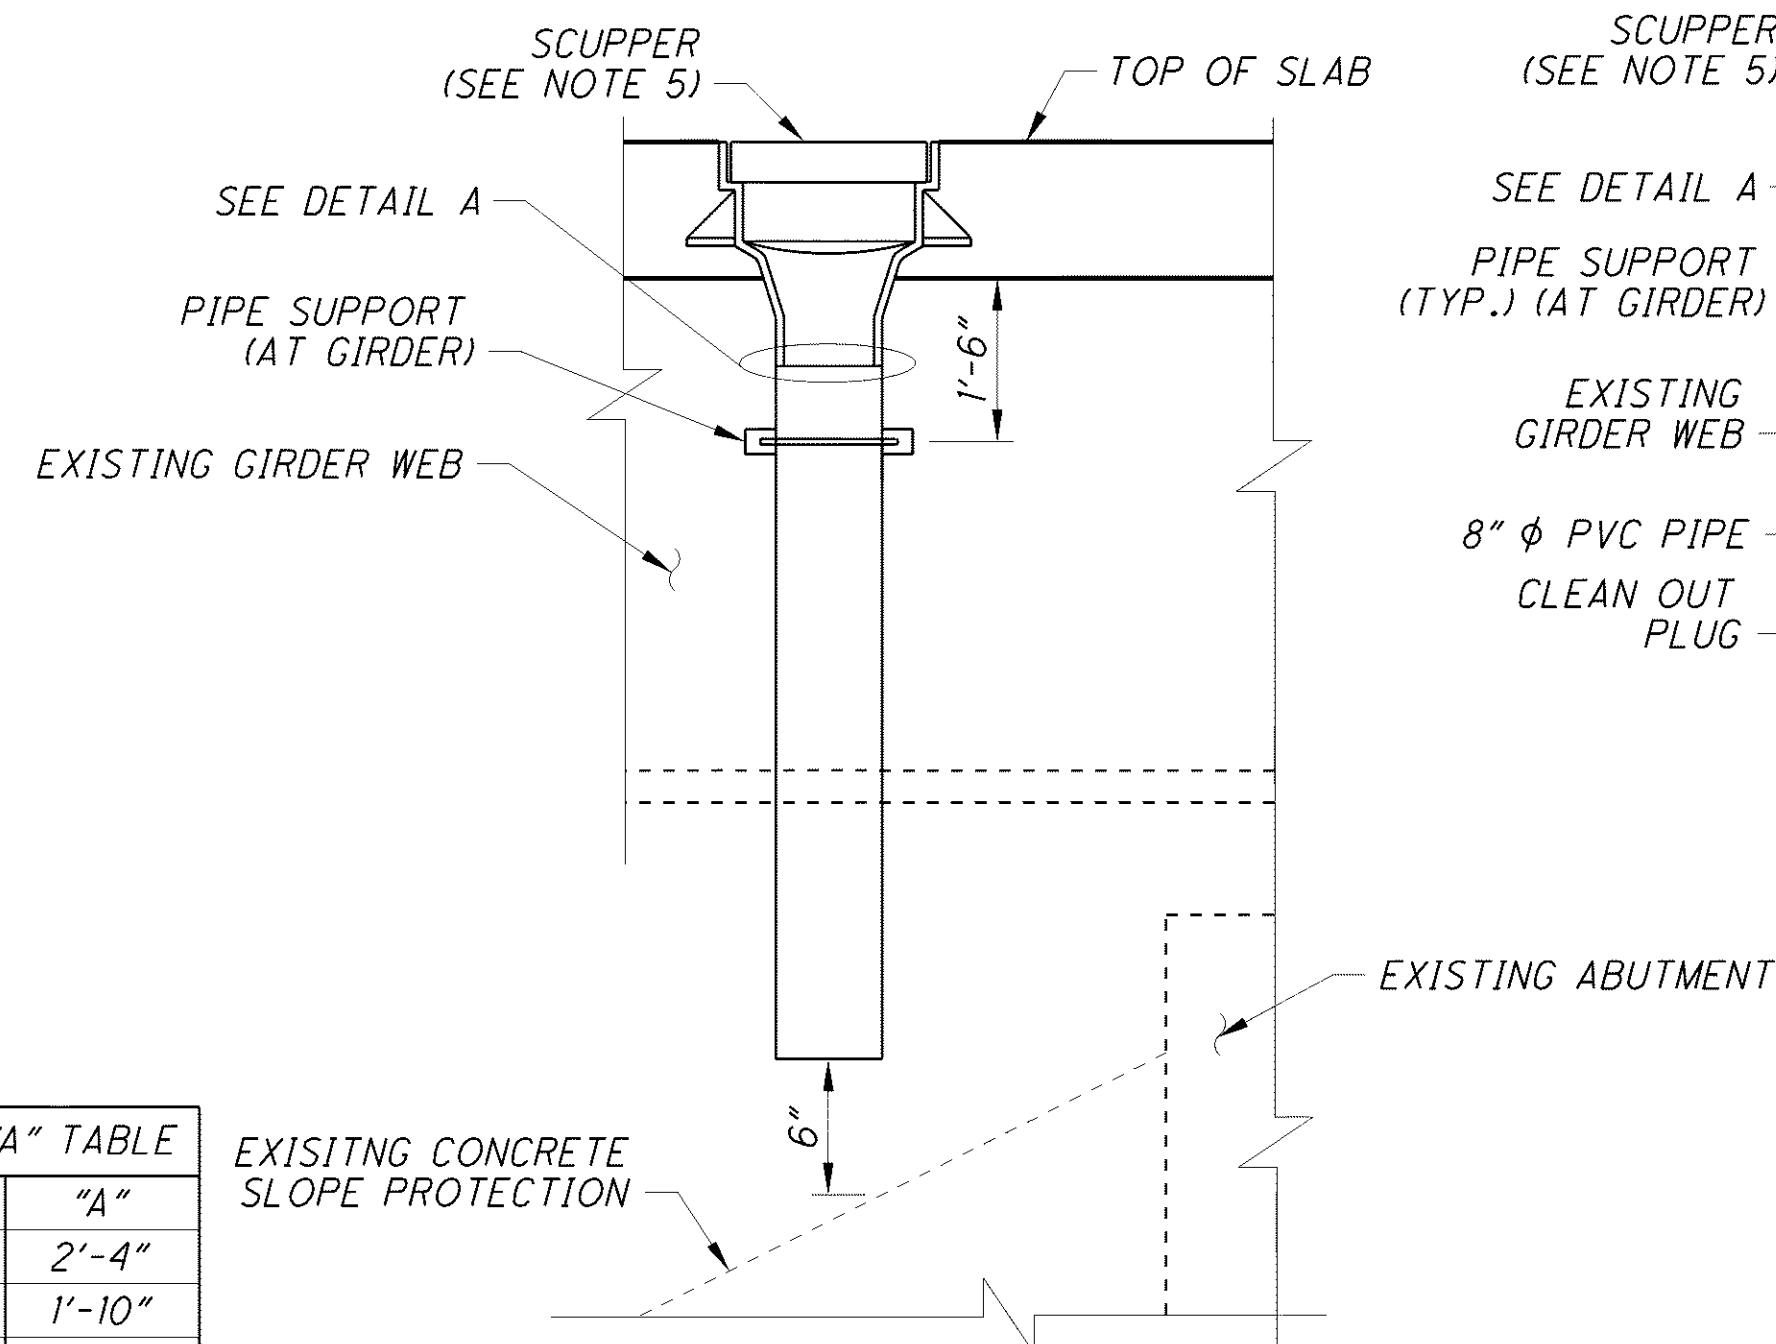

DRAINAGE PIPE AT ABUTMENT DETAIL

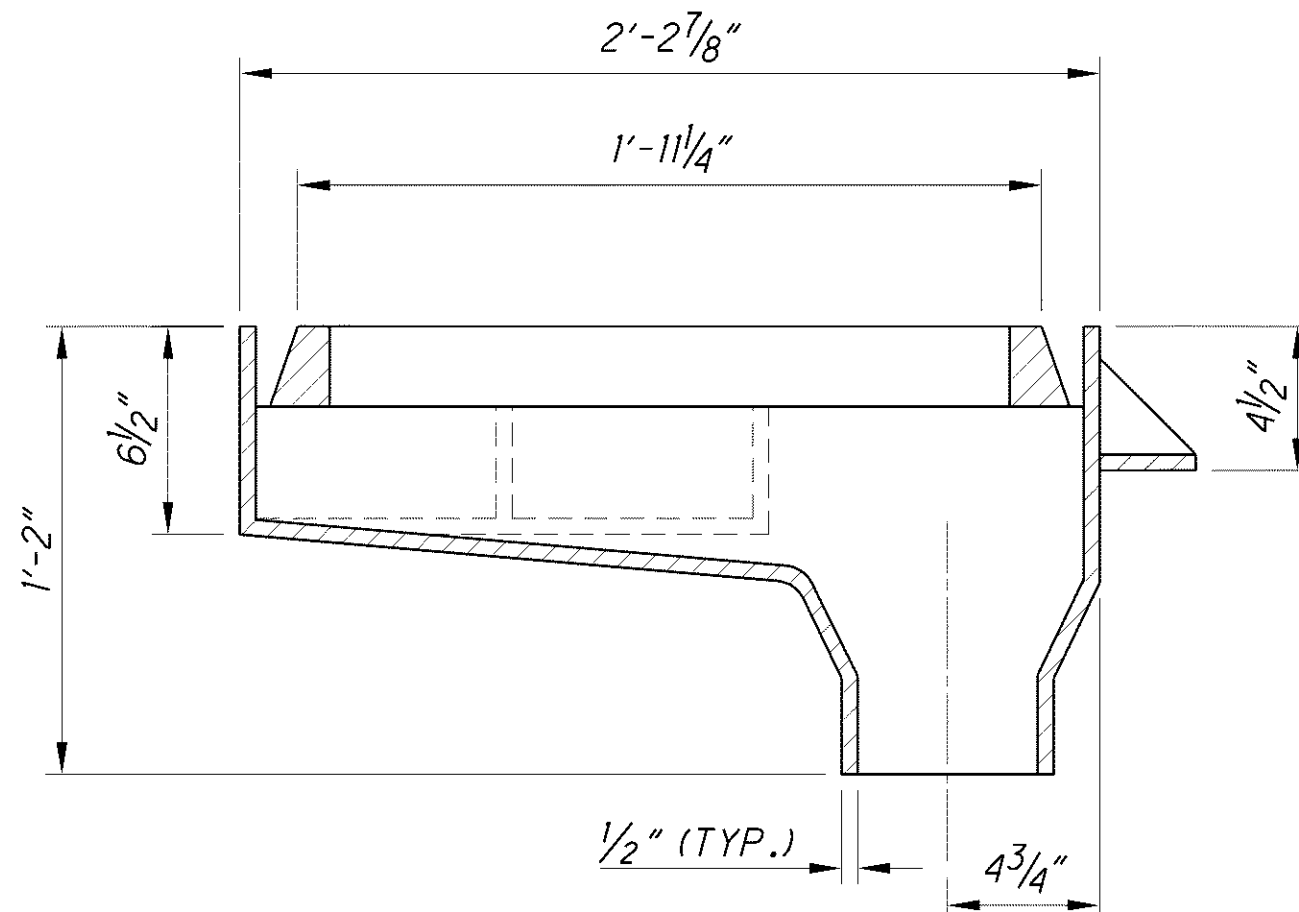

DETAIL A

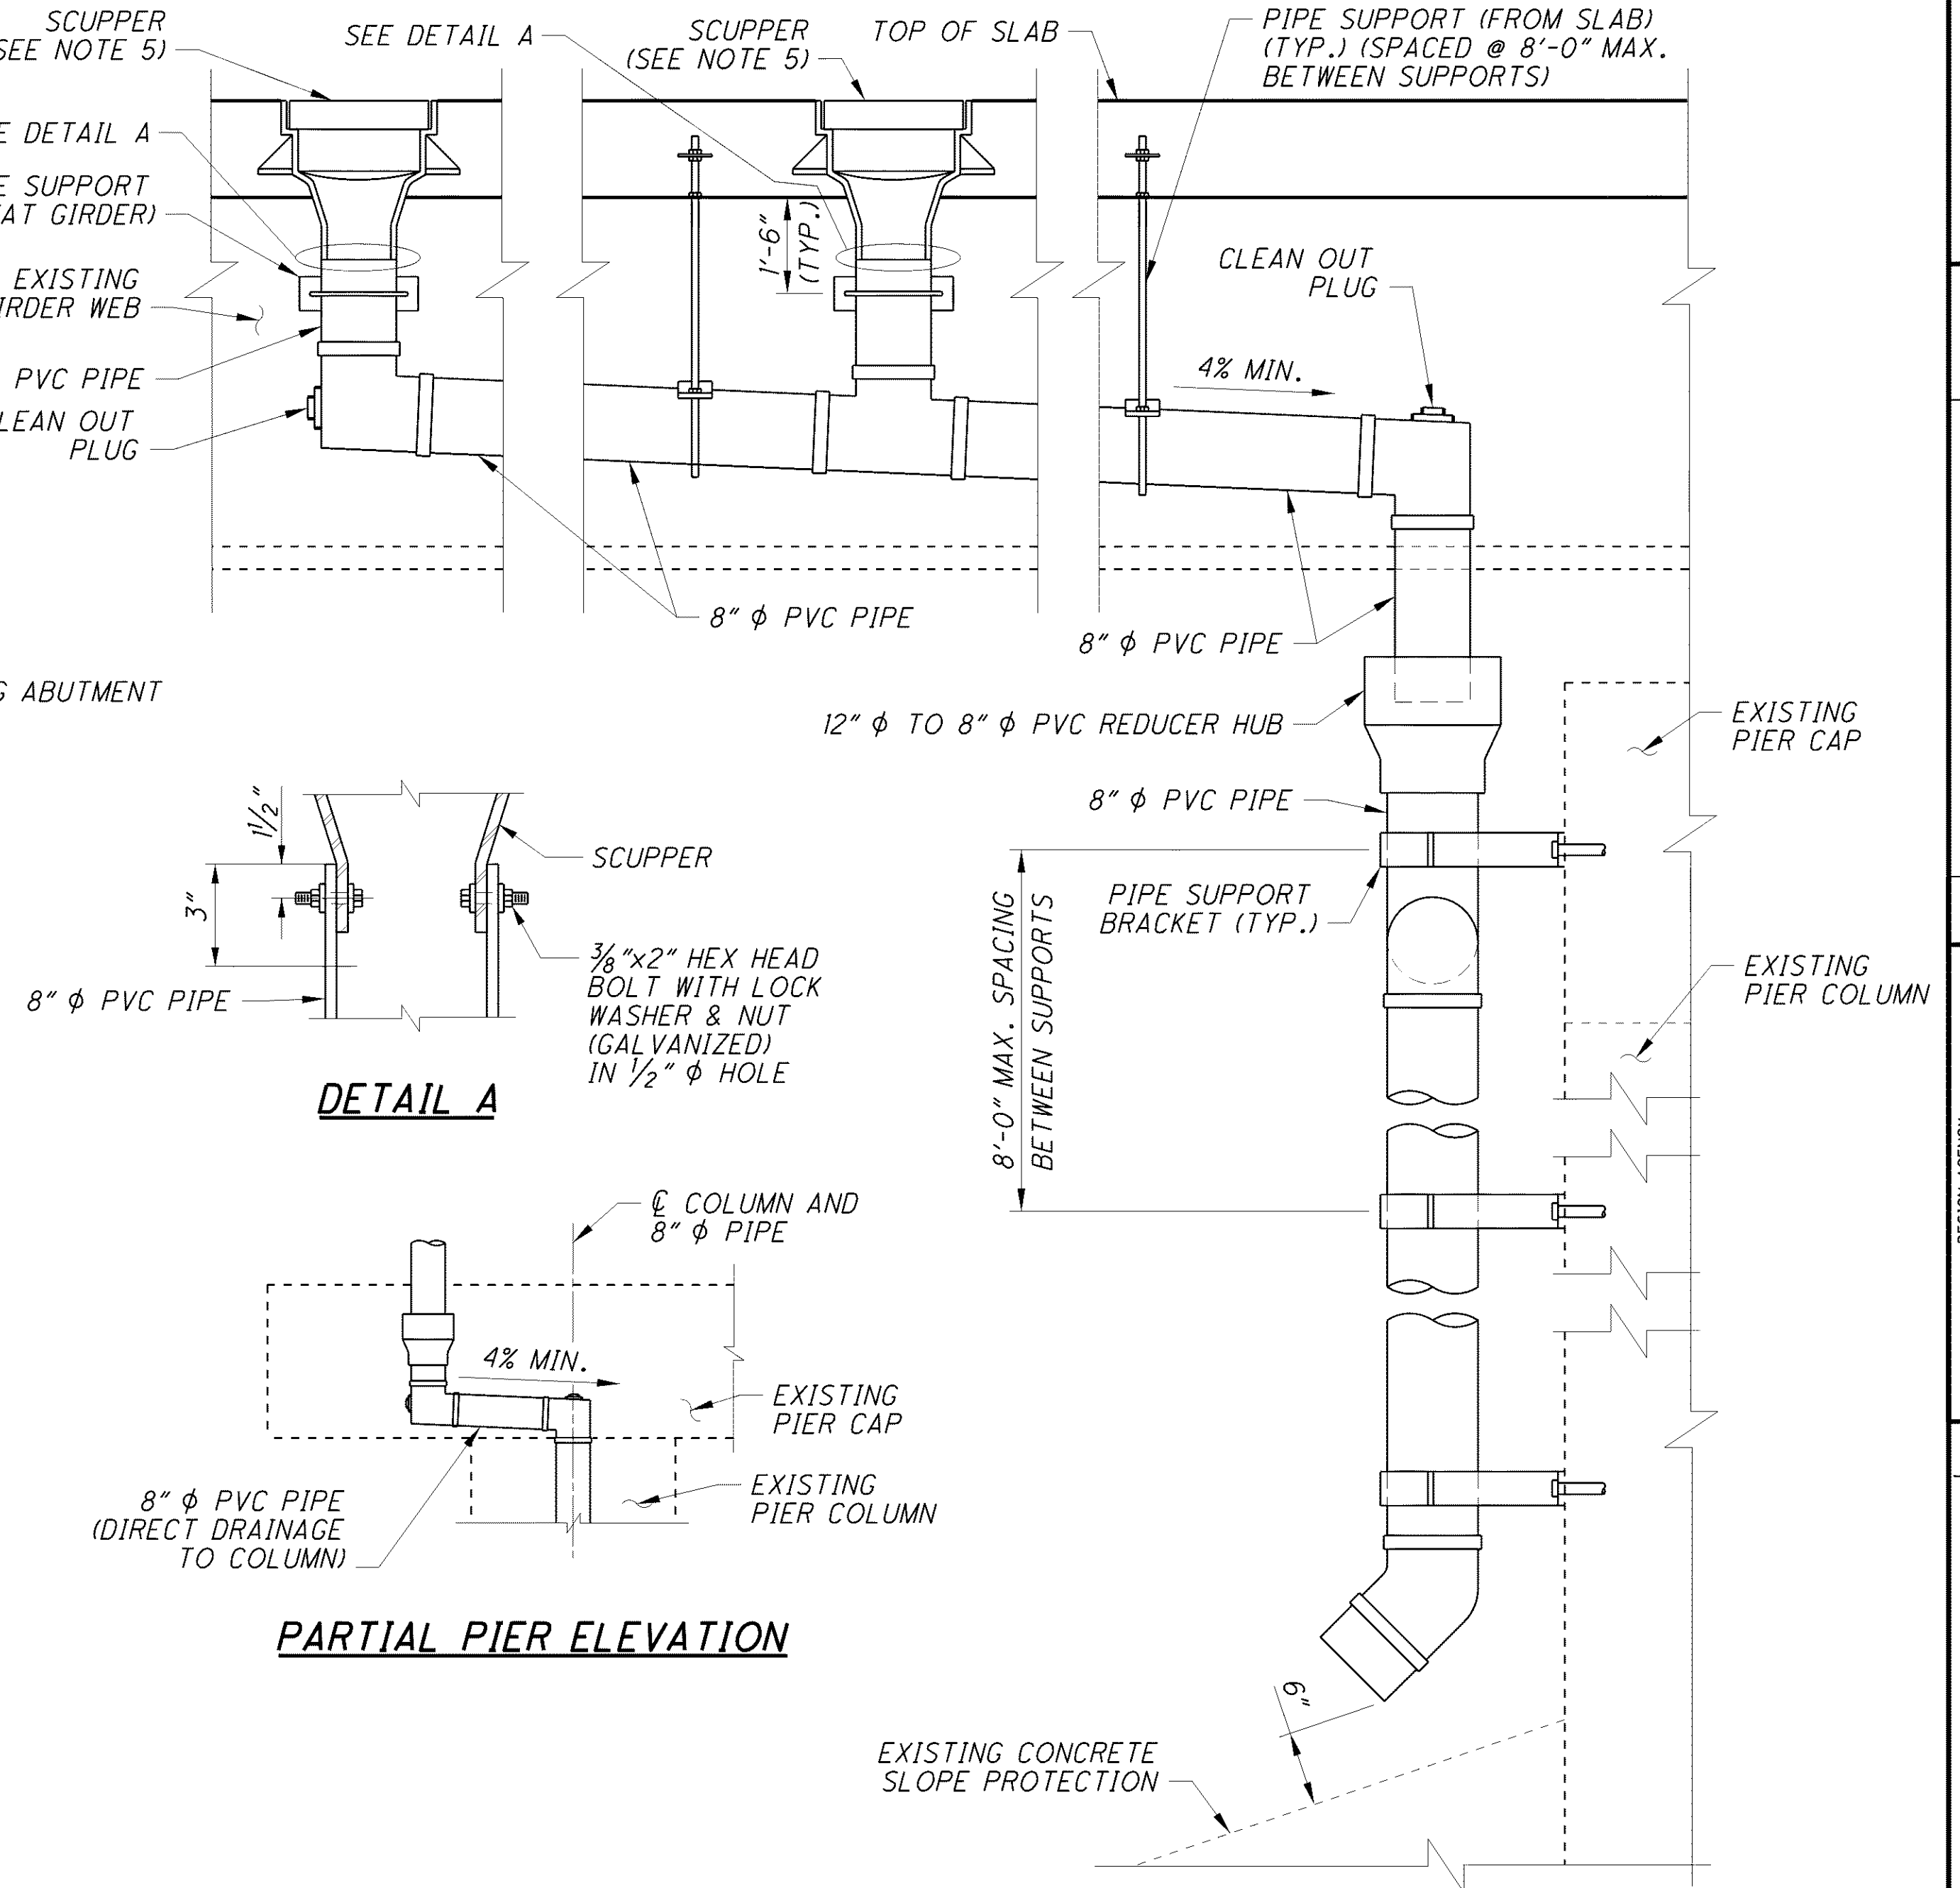


DRAINAGE PIPE AT PIER DETAIL

NOTES:

1. FOR SCUPPER LOCATIONS, SEE SHEET **20/38**.
2. ADJUST THE TOP OF SCUPPER INLET TO MATCH THE CROSS SLOPE OF THE SLAB.
3. ALL MATERIALS FOR THE SUPPORT HANGERS AND BRACKETS SHALL BE ASTM A709 GRADE 36 AND GALVANIZED PER CMS 711.02.
4. POLYVINYL-CHLORIDE (PVC) PIPE USED IN BRIDGE DRAINS SHALL CONFORM TO CMS 707.45.
5. SCUPPER SHALL BE A NEENAH FOUNDRY MODEL NUMBER R-3922. BOLTS FOR SCUPPER GRATE SHALL BE STAINLESS STEEL.

PIPE SUPPORT BRACKET AT PIER
(FIELD BEND BRACKET RADIAL TO FIT CURVE OF PIER COLUMN)

DESIGNED		DRAWN		REVIEWED		DATE		BRIDGES		STRUCTURE FILE NUMBER		DESIGN AGENCY		REVISIONS		DATE	
JTW		JTW		JOL		03-11-11		10 & 11		1807919/1807900		WALSH HNTB		RECORD DRAWINGS		01-29-13	
CHECKED		CHECKED		CHECKED		CHECKED		10 & 11		1807919/1807900		WALSH CONSTRUCTION					
RSB		RSB		RSB		RSB		10 & 11		1807919/1807900		WALSH CONSTRUCTION					
RSB		RSB		RSB		RSB		10 & 11		1807919/1807900		WALSH CONSTRUCTION					
RSB		RSB		RSB		RSB		10 &									

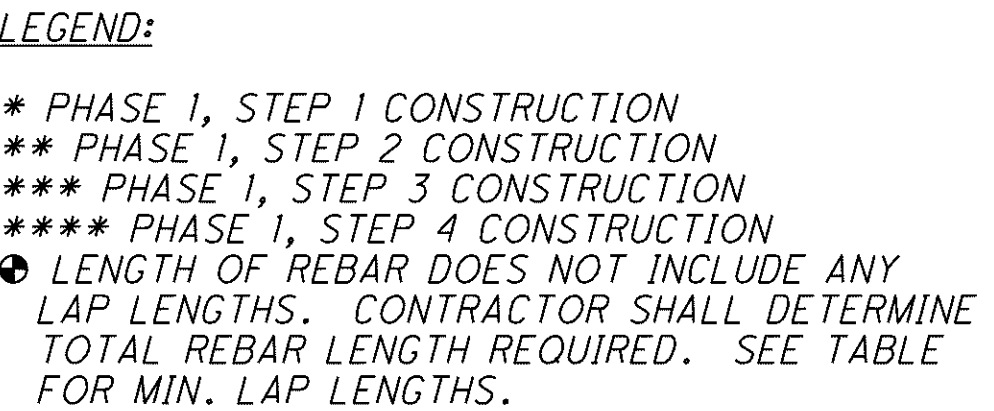


- NOTES:
1. FOR SECTIONS A-A, B-B AND C-C SEE SHEET 27/38.
 2. FOR ADDITIONAL PARAPET DETAILS SEE SHEETS 27/38 AND 38/38 AND ODOT STANDARD SBR-I-99.

MINIMUM LAP LENGTH TABLE	
#5	3'-3"
#6	3'-10"




090_1651\SD007.dgn 1/8/2016 11:34:17 AM rstriegel

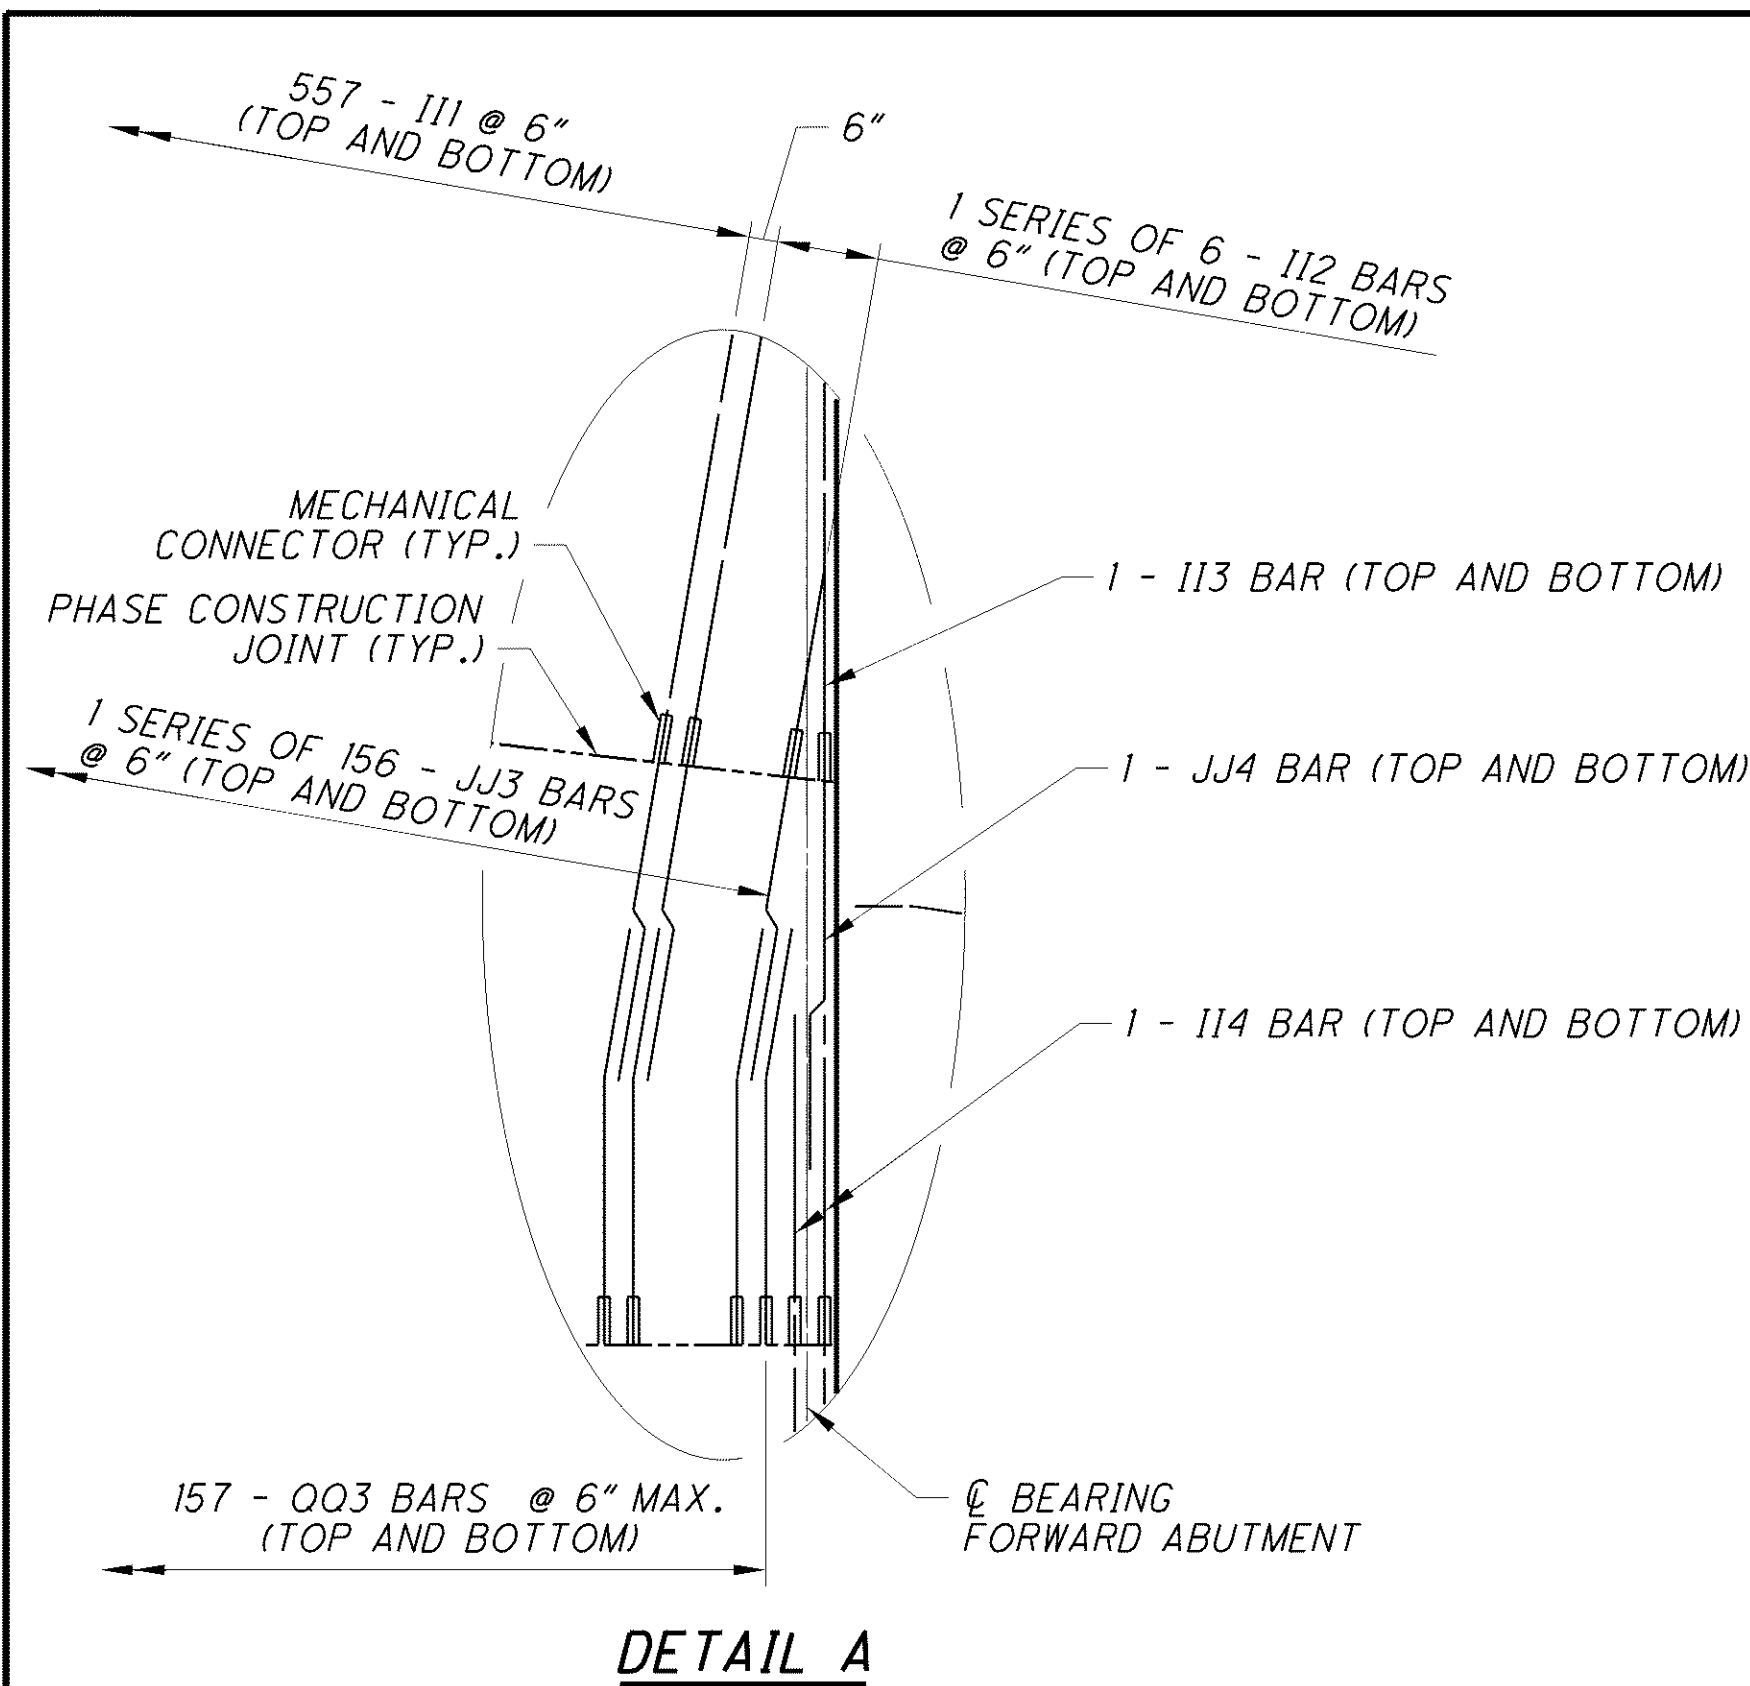


DETAIL A

(LONGITUDINAL BARS NOT SHOWN FOR CLARITY)

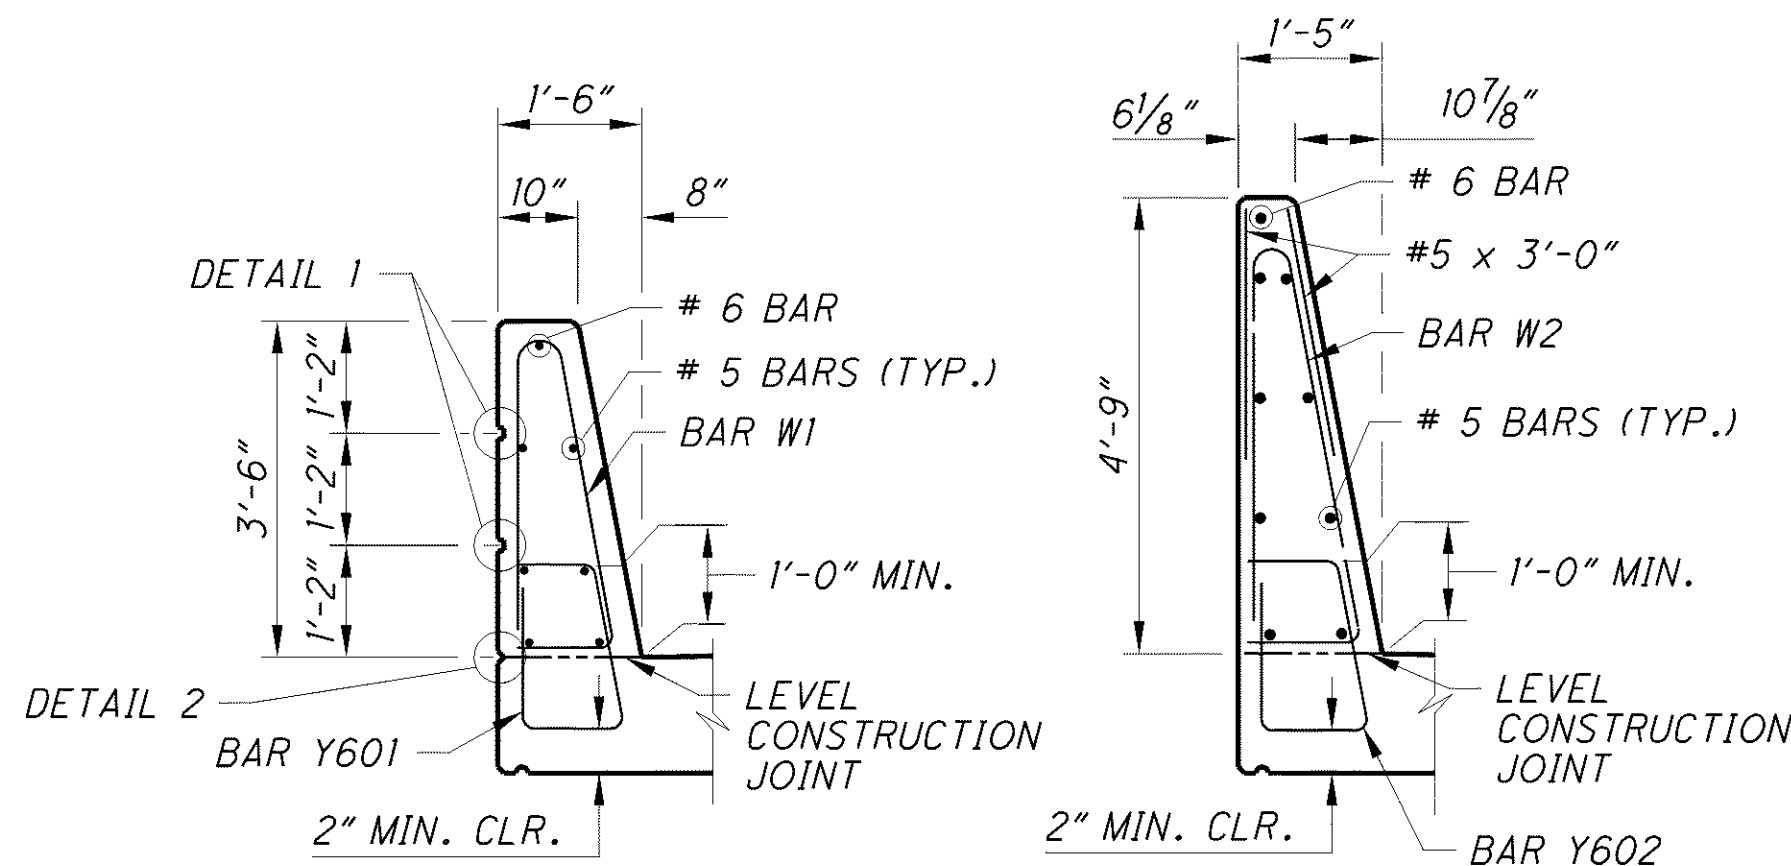


SECTION A-A

SECTION B-B

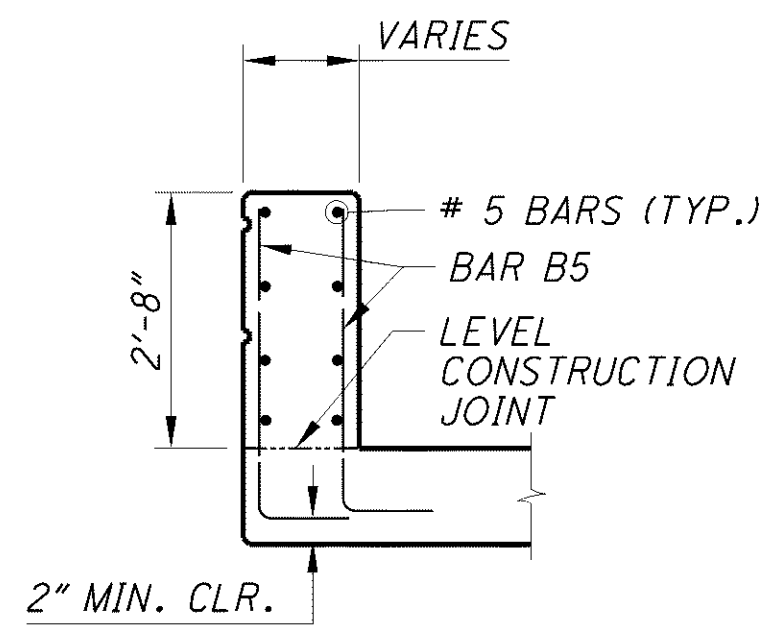


SECTION C-C

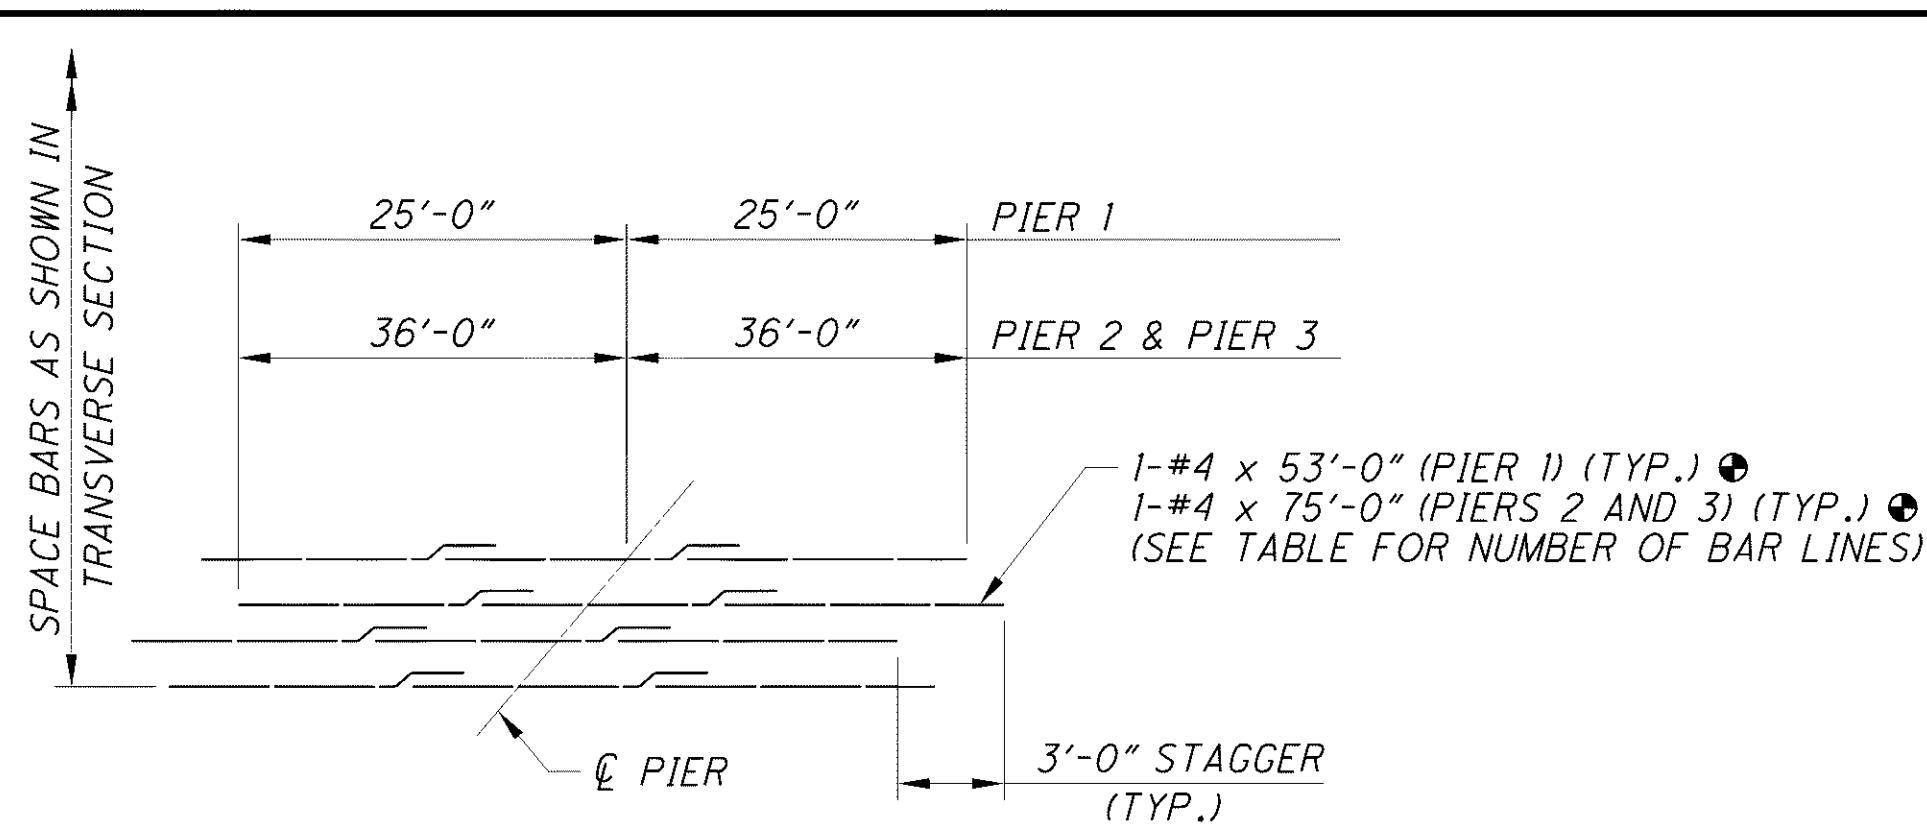


ADDITIONAL REINFORCING OVER THE PIERS

NO. OF ADDITIONAL REINFORCING BARS LINES	PIER		
	1	2	3
PHASE 1, STEP 1	43	43	43
PHASE 1, STEP 2	43	43	46
PHASE 1, STEP 3	66	66	60
PHASE 1, STEP 4	50	50	50

● LENGTH OF REBAR DOES NOT INCLUDE ANY LAP LENGTHS. CONTRACTOR SHALL DETERMINE TOTAL REBAR LENGTH REQUIRED. SEE TABLE FOR MIN. LAP LENGTHS.

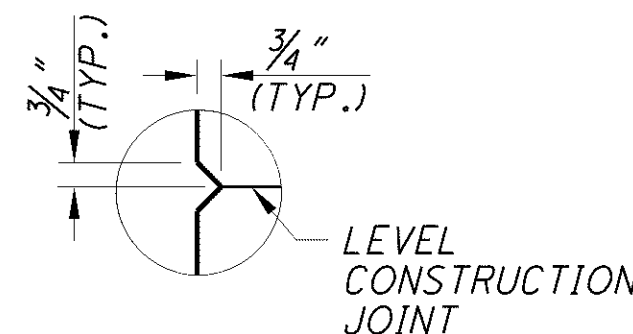

DETAIL 2

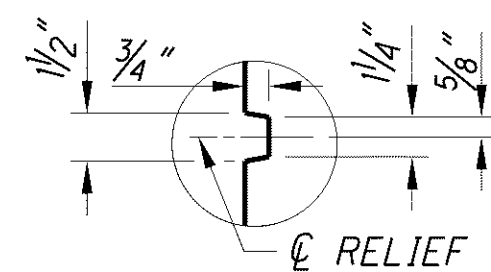

DETAIL 1

BAR G1 - #5


BAR B5- #6

17'-3" TO 2'-6"	A1
17'-3" TO 2'-6"	A2
3'-8" TO 24'-0"	A3
7'-8" TO 29'-0"	A4

BARS A1 - #4
BAR A2, A3 AND A4 - #5

19'-10"	JJ1
18'-0"	JJ2
17'-11" TO 6'-4"	JJ3
8'-4"	JJ4
28'-8"	JJ5


THREADED SECTION
BARS JJ1, JJ2, JJ3, JJ4 AND JJ5 - #5

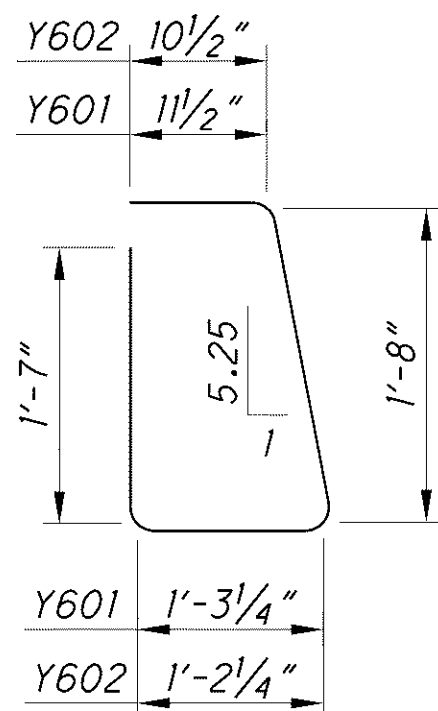


BAR Y601 AND Y602 - #6

19'-10"	I11
17'-5" TO 2'-9"	I12
19'-11"	I13
6'-10"	I14

MECHANICAL CONNECTOR
BARS I11, I12, I13 AND I14 - #5

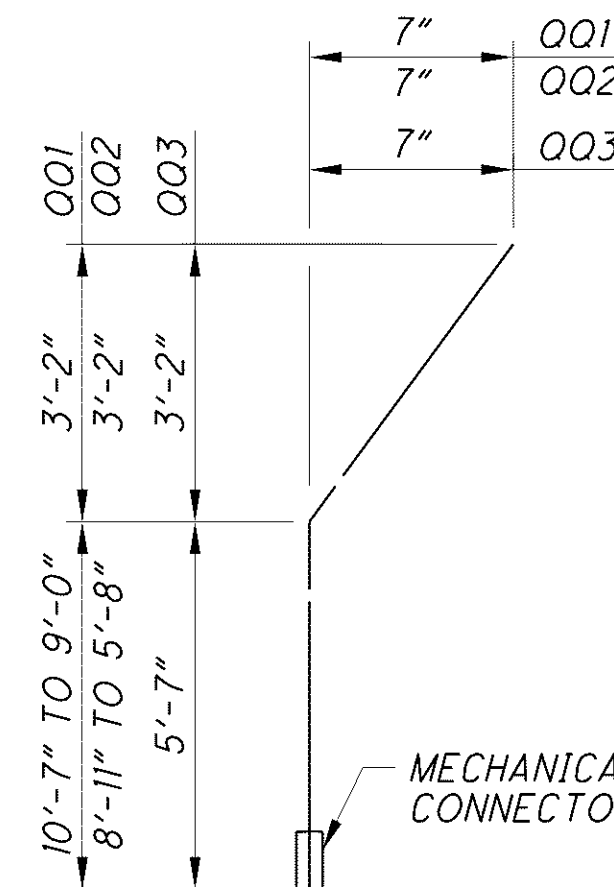

BARS OO1, OO2 AND OO3 - #5

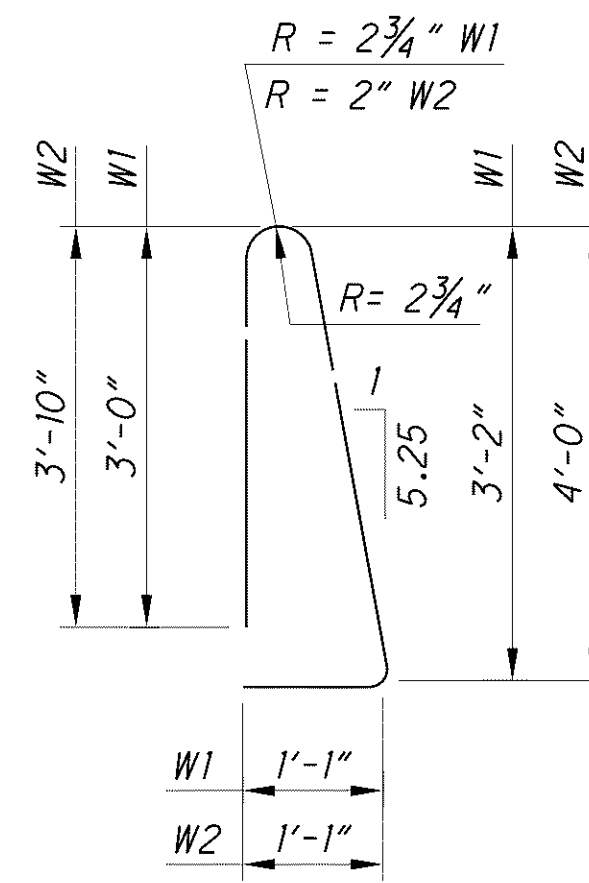

BAR W1 AND W2 - #5

SLAB OVERHANG *																	
	SPAN 1				SPAN 2				SPAN 3				SPAN 4				
	CL BEARING REAR ABUTMENT	0.25	0.5	0.75	CL PIER 1	0.25	0.5	0.75	CL PIER 2	0.25	0.5	0.75	CL PIER 3	0.25	0.5	0.75	CL BEARING FORWARD ABUTMENT
STATION AT CL GIRDER A LEFT SLAB OVERHANG	3+86.67 2'-2"	3+75.16 2'-2"	3+63.65 2'-2"	3+52.15 2'-2"	3+40.64 2'-2"	3+22.38 2'-2"	3+04.13 2'-2"	2+85.88 2'-2"	2+67.62 2'-2"	2+42.51 2'-2"	2+17.39 2'-2"	1+92.28 2'-2"	1+67.17 2'-2"	1+52.01 2'-2¾"	1+36.53 1'-11⅝"	1+21.37 1'-11⅝"	1+06.01 2'-1⅞"
STATION AT CL GIRDER E RIGHT SLAB OVERHANG	3+85.56 2'-2"	3+74.05 2'-2"	3+62.54 2'-2"	3+51.04 2'-2"	3+39.53 2'-2"	3+20.01 2'-2"	3+00.49 2'-2"	2+80.97 2'-2"	2+61.45 2'-2"	2+36.41 2'-2"	———— ————	———— ————	———— ————	———— ————	———— ————	———— ————	———— ————
STATION AT CL GIRDER F LEFT SLAB OVERHANG	70+99.10 3'-3"	71+12.85 3'-3"	71+26.60 3'-3"	71+40.35 3'-3"	71+54.10 3'-3"	71+74.47 3'-3"	71+94.85 3'-3"	72+15.22 3'-3"	72+35.60 3'-3"	72+60.35 3'-3"	———— ————	———— ————	———— ————	———— ————	———— ————	———— ————	———— ————
STATION AT CL GIRDER M RIGHT SLAB OVERHANG	70+92.49 2'-8⅞"	71+06.24 2'-9"	71+19.99 2'-9"	71+33.74 2'-9"	71+47.49 2'-9"	71+69.52 2'-9"	71+91.54 2'-9"	72+13.57 2'-9"	72+35.60 2'-9"	72+60.35 2'-9"	72+85.10 2'-9"	73+09.85 2'-9"	73+34.60 2'-9"	73+49.60 2'-9"	73+64.60 2'-9"	73+79.60 2'-9"	73+94.60 2'-9"




* SLAB OVERHANG DIMENSIONS ARE MEASURED NORMAL TO THE CL GIRDER.

NOTES:

1. FOR ADDITIONAL NOTES SEE SHEET 25/38.
2. FOR LOCATIONS OF SECTION A-A, B-B AND C-C, SEE SHEET 26/38.
3. FOR LOCATION OF DETAIL A, SEE SHEET 25/38.



MINIMUM LAP LENGTH TABLE	
#4	2'-0"
#5	3'-3"

DESIGNED RSB		REVIEWED JOL		DATE 03-11-11	
CHECKED JTW		STRUCTURE FILE NUMBER 1807919/1807900		BRIDGES 10 & 11	
DATE 08-09-13		RECORD DRAWINGS		DESIGN AGENCY WALSH HNTB WALSH CONSTRUCTION	
NO.		REVISIONS		SLAB AND PARAPET DETAILS	
				BRIDGE NO. CUY-77-1597 L AND CUY-90-1651 L	
				I-90WB AND I-77SB RAMP OVER E 14TH STREET	
				CUY-90-14.9.0	
				PID No. 77332 / 85531	
				27/38	

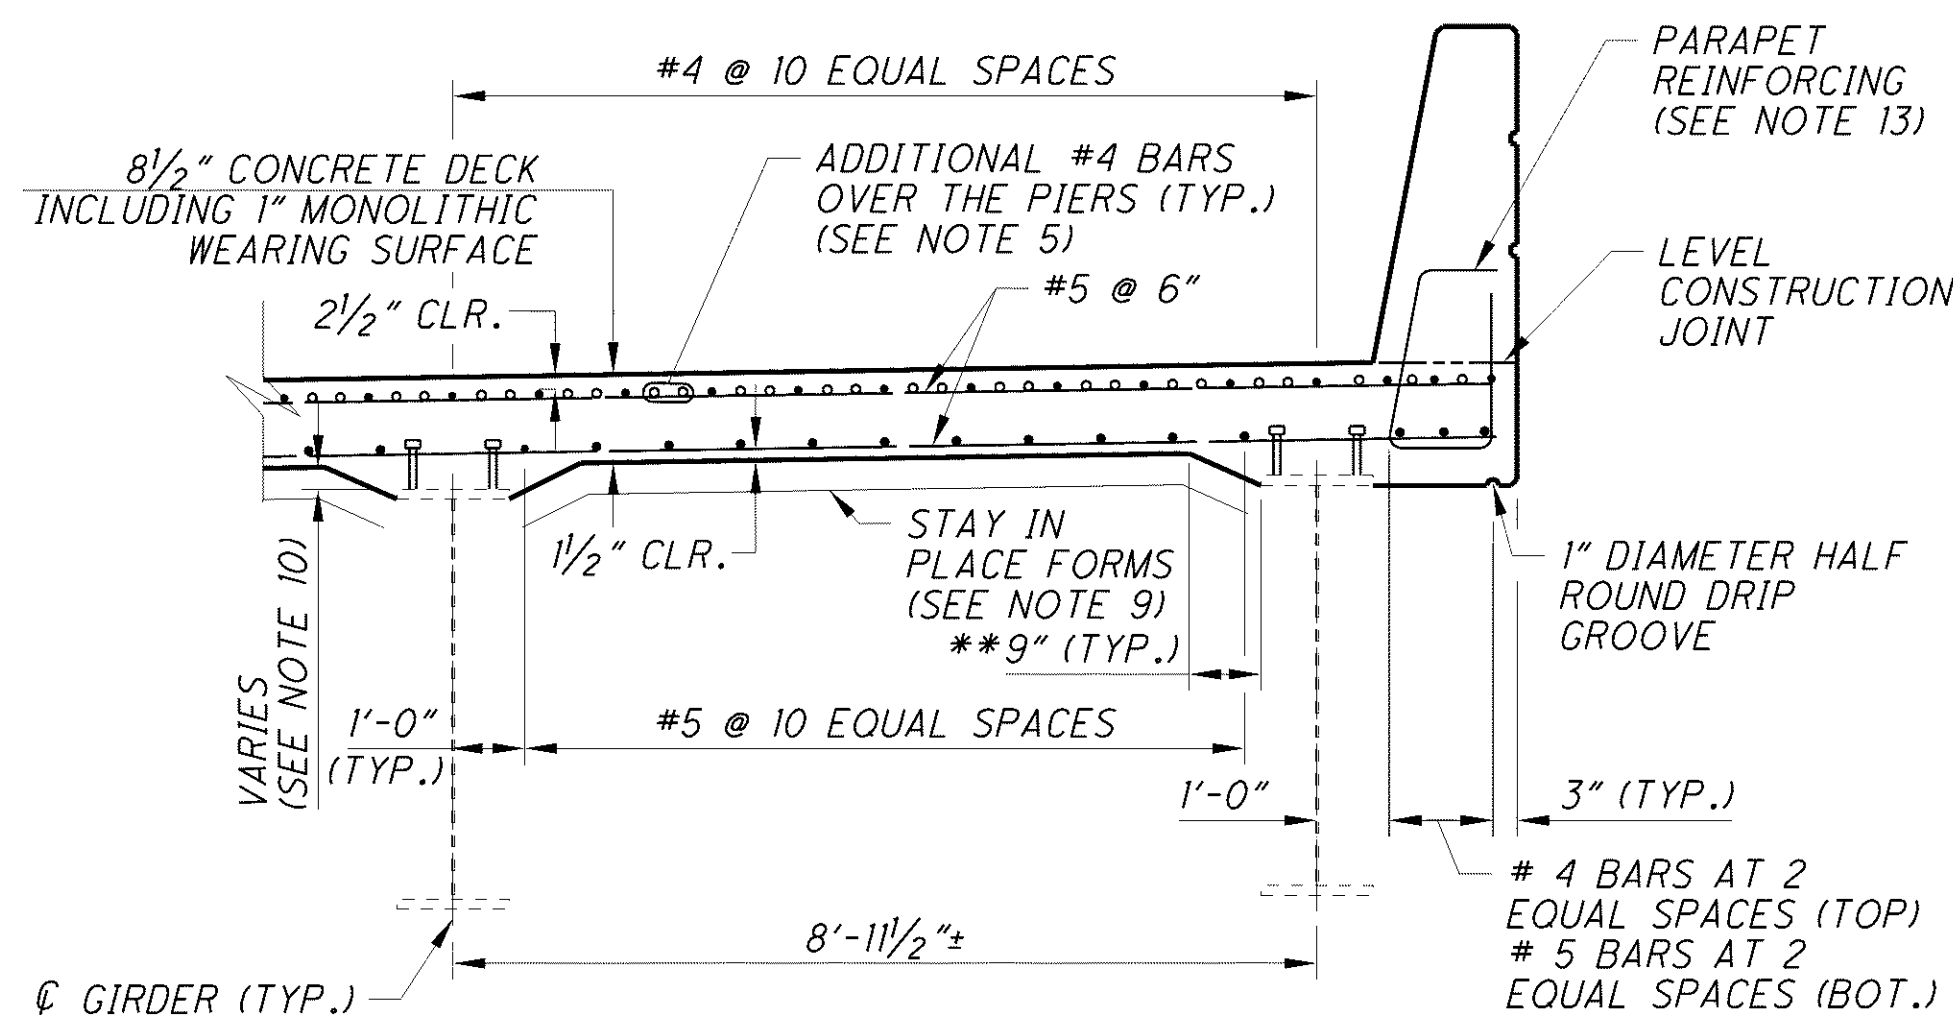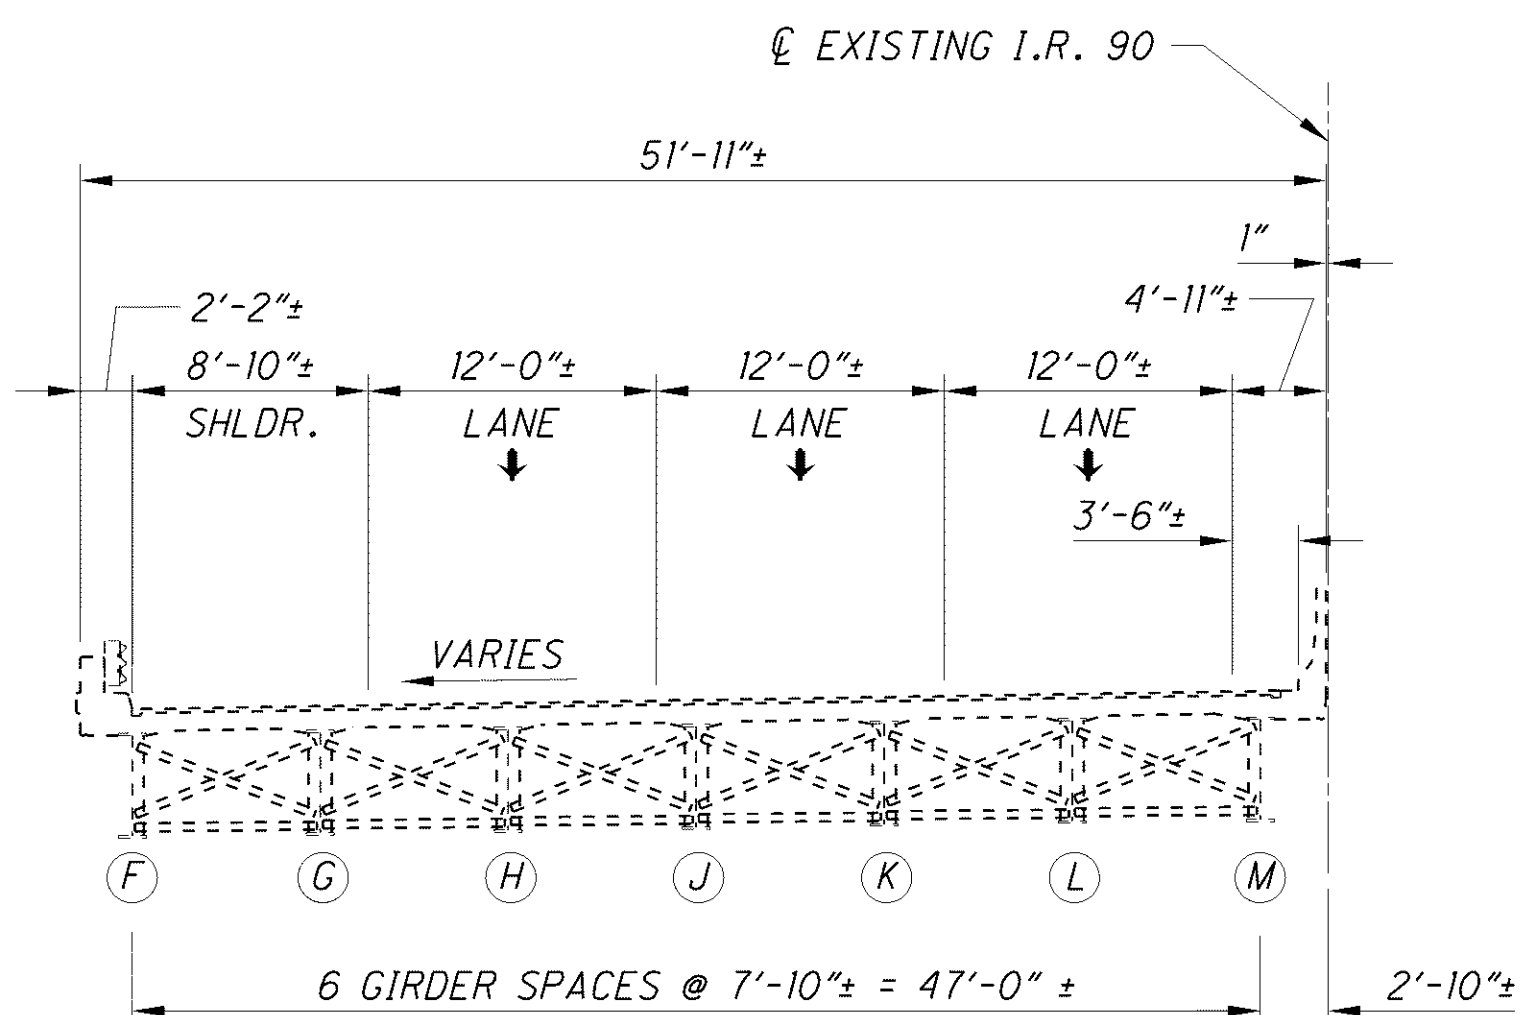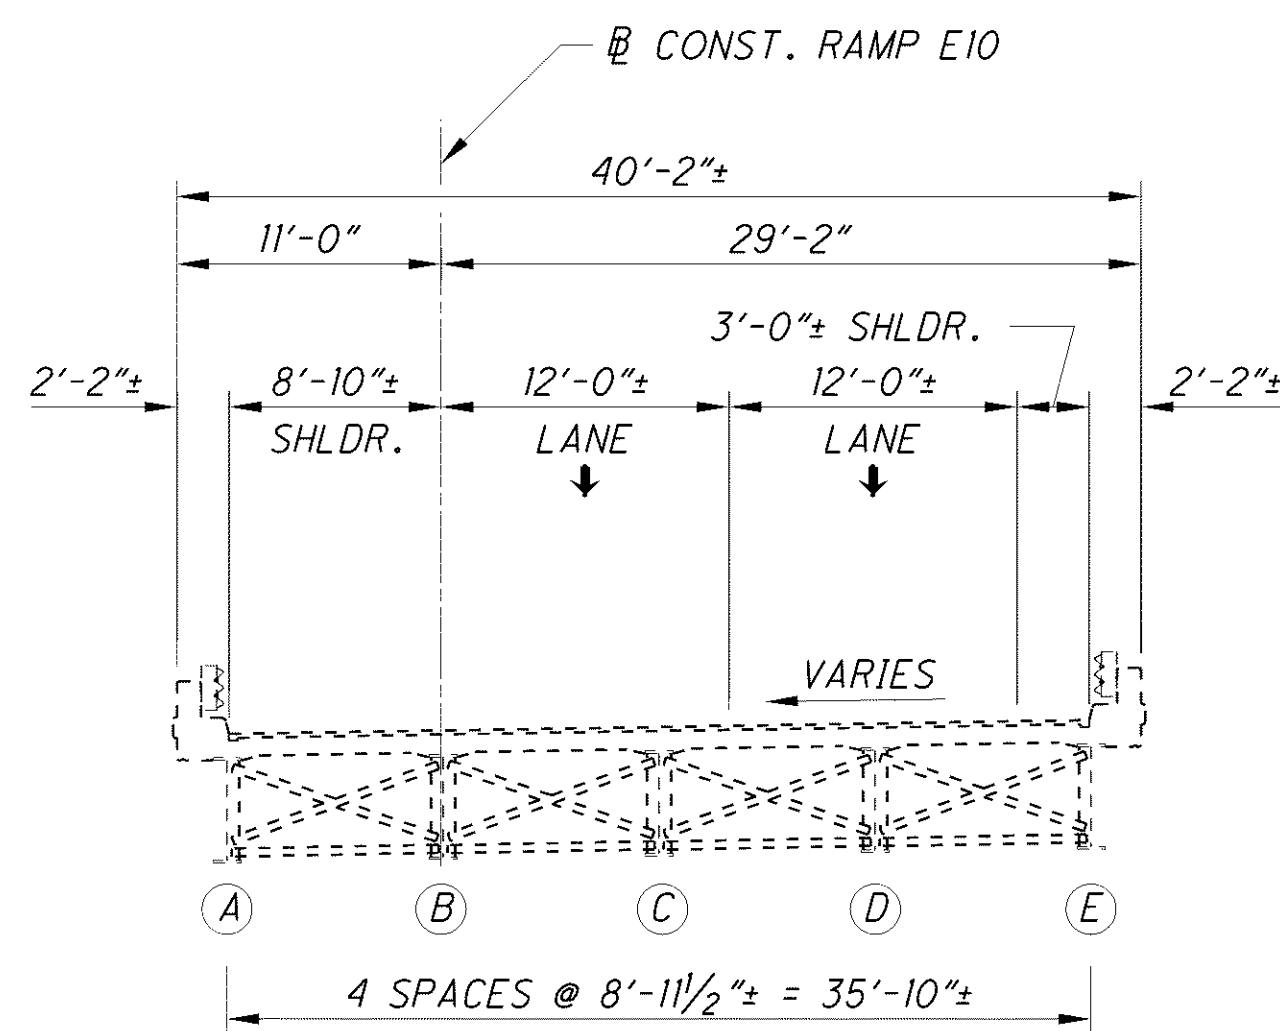

TYPICAL DECK SLAB AND OVERHANG


(CONST. RAMP E10)
(SEE NOTE 11)
(RIGHT OVERHANG SHOWN, LEFT OVERHANG SIMILAR)

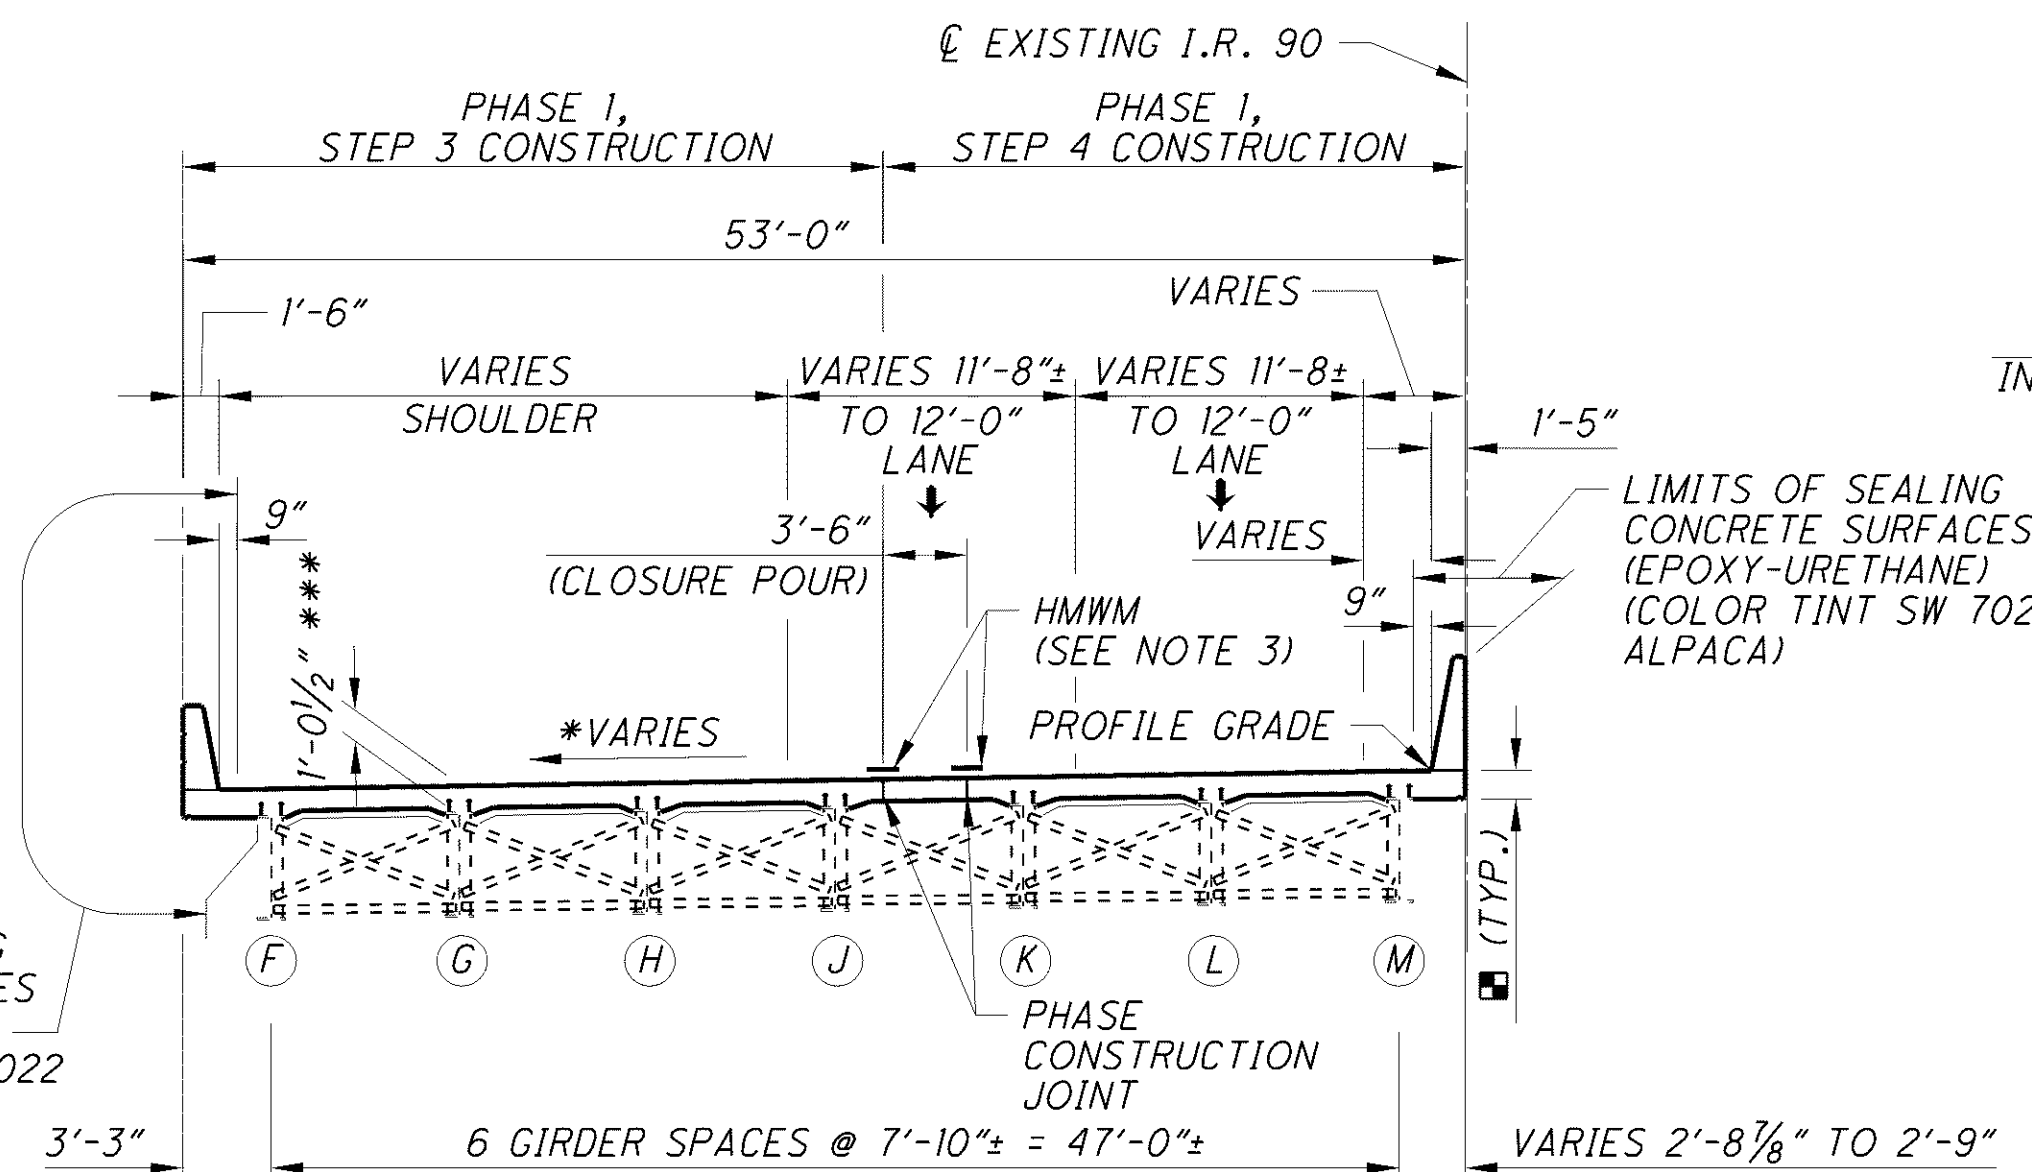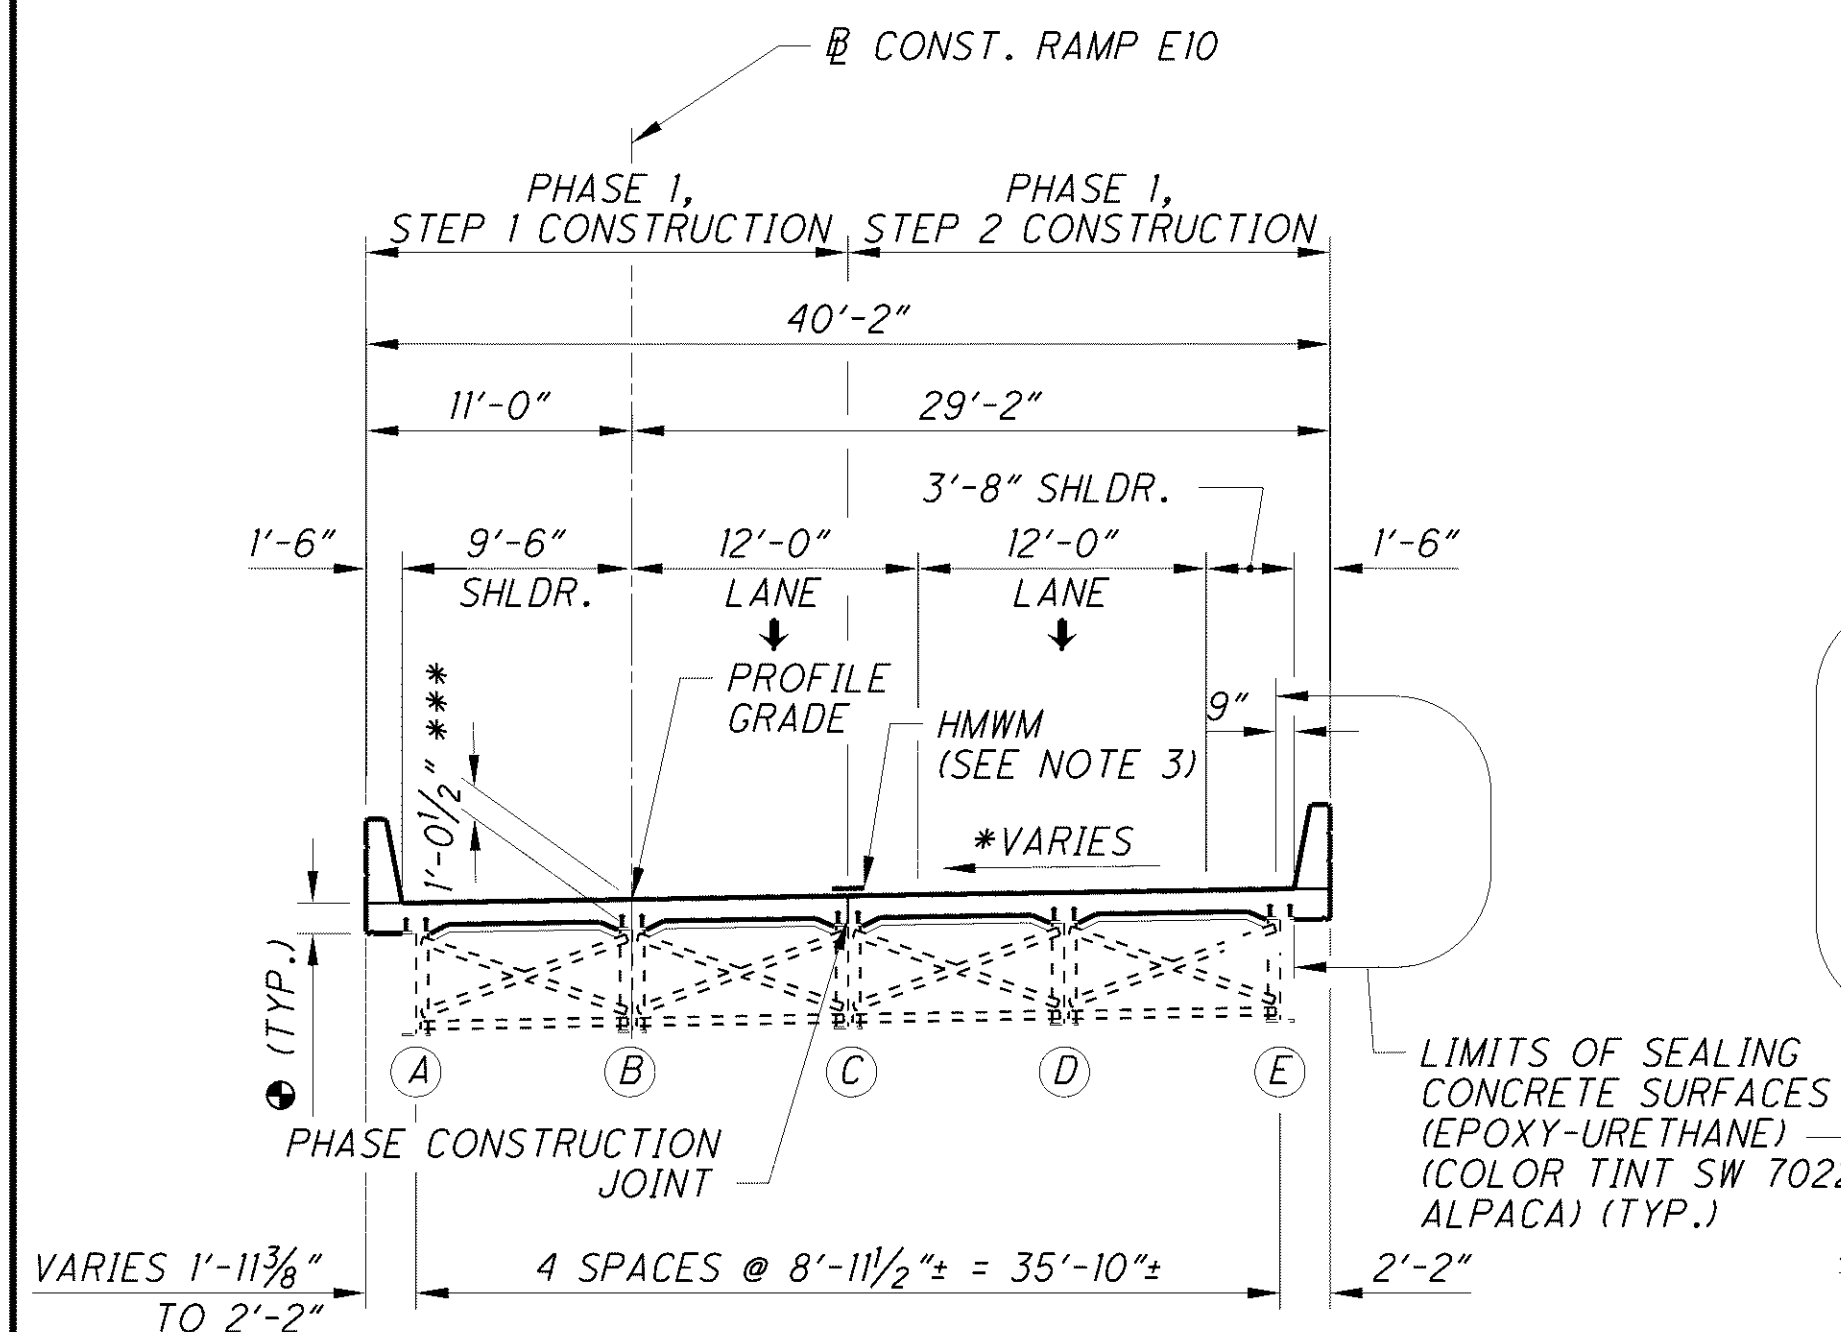

* REFER TO SCREED ELEVATION TABLES AND
SUPER ELEVATION TRANSITION DIAGRAMS
FOR MORE DETAILS. (SEE NOTES 7 & 8)


** ACTUAL HAUNCH DIMENSION VARIES PER
STAY IN PLACE FORM MANUFACTURER

*** MEASURED TO TOP
OF EXISTING WEB,
ACTUAL THICKNESS
WILL VARY

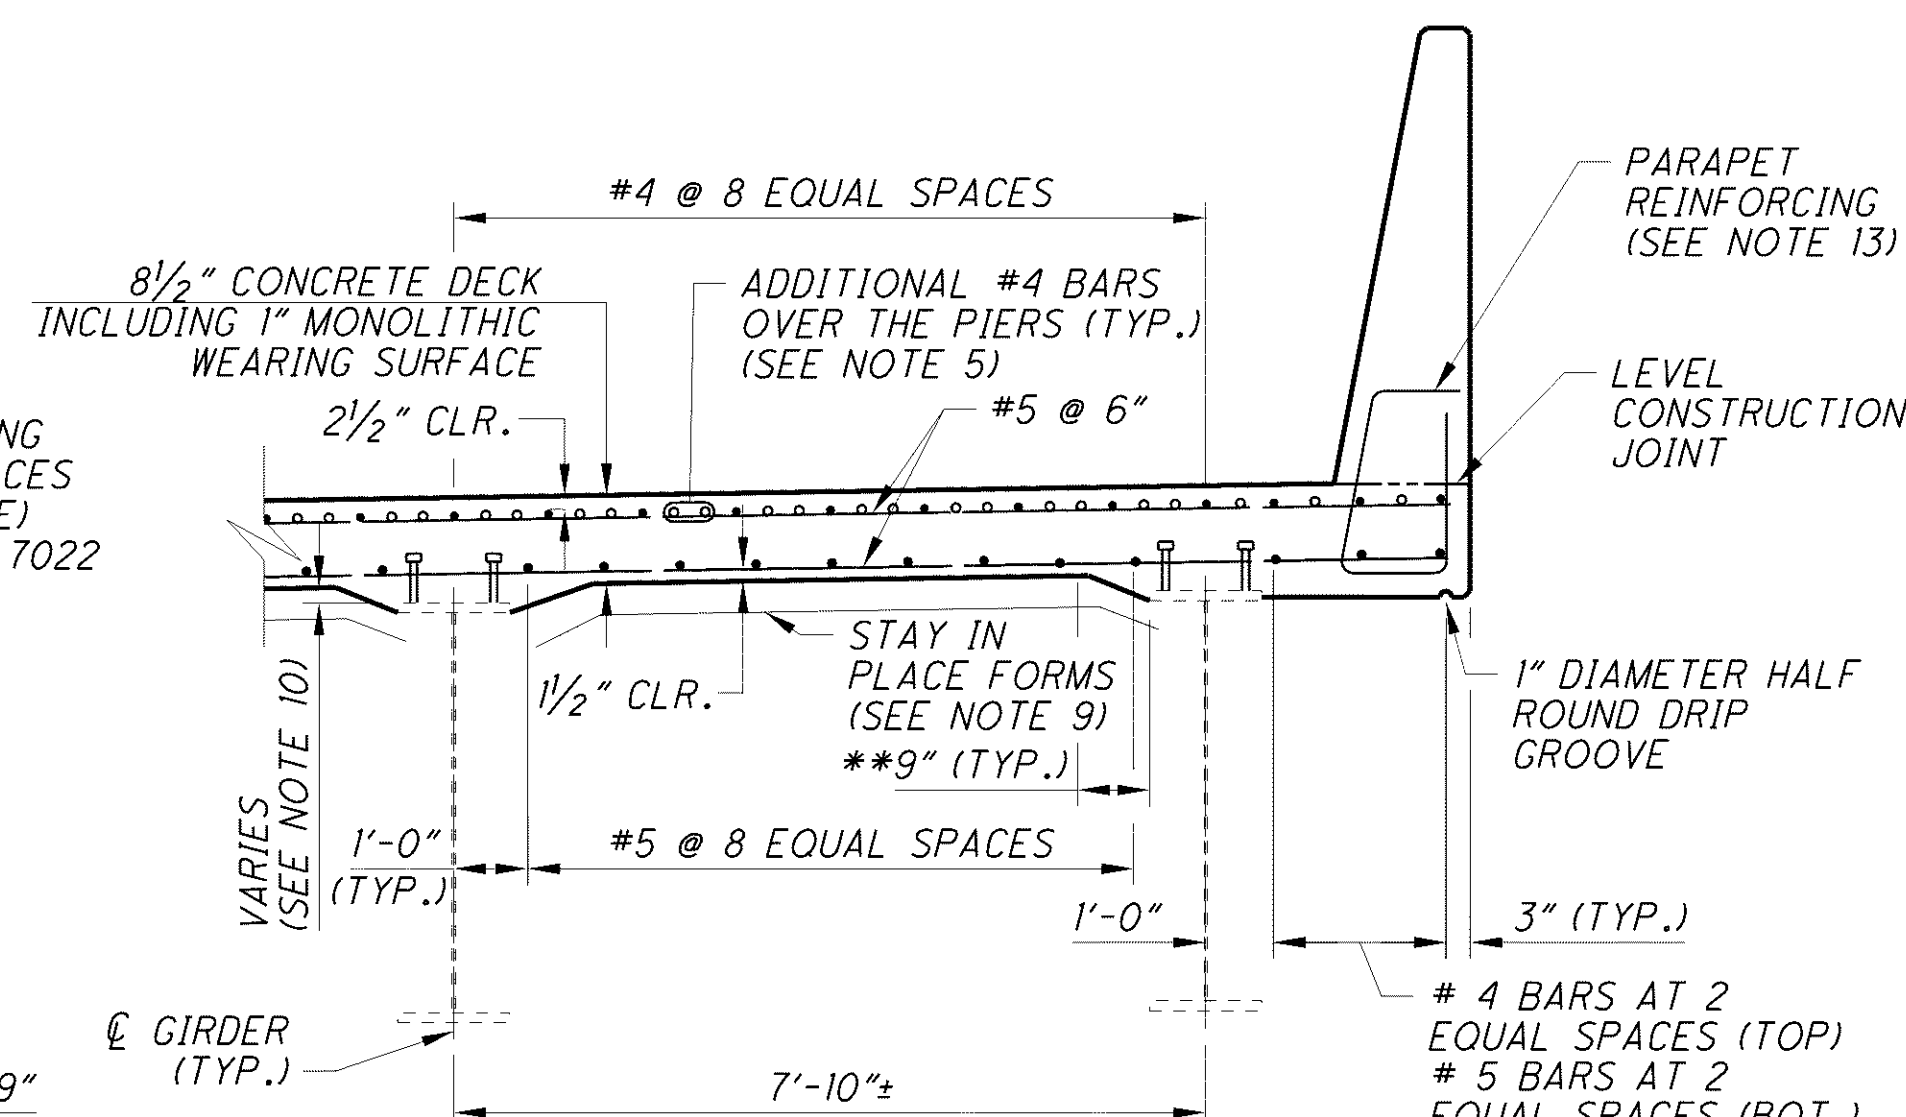

TYPICAL DECK SLAB AND OVERHANG

(I.R. 90 WB)
(SEE NOTE 11)
(RIGHT OVERHANG SHOWN, LEFT OVERHANG SIMILAR)

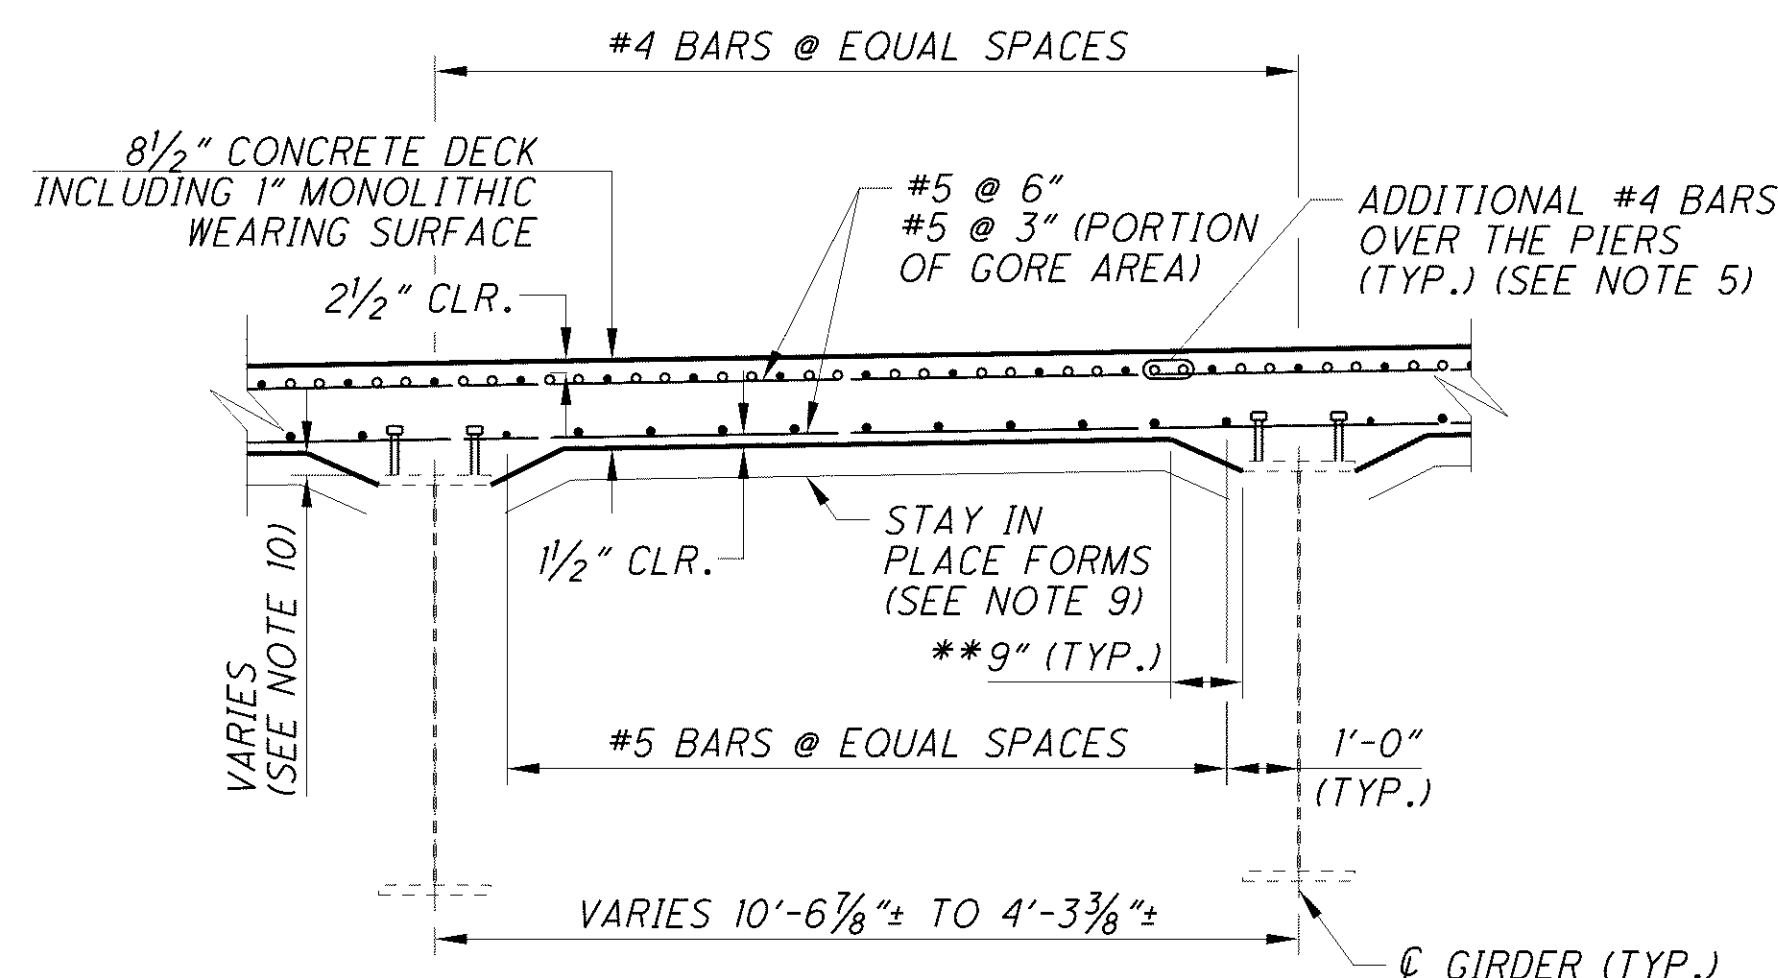

MISCELLANEOUS DECK SLAB

(CONST. RAMP E10)
(SPAN 3 BETWEEN GIRDERS C & E NEAR PIER 3)
(SPAN 3 GORE AREA, NO ADDITIONAL #4 BARS PLACED IN AREA
OF 6" SPACED LONGITUDINAL BARS)
(SPAN 4 BETWEEN ALL GIRDERS)

OVERHANG	MINIMUM	MAXIMUM
LEFT	1 1/8"	1'-2 3/8"
RIGHT	10 5/8"	1'-2 1/4"

OVERHANG	MINIMUM	MAXIMUM
LEFT	11 $\frac{5}{8}$ "	1'-3 $\frac{3}{8}$ "
RIGHT	1'-0 $\frac{1}{2}$ "	1'-1 $\frac{3}{4}$ "

DECK CONCRETE QUANTITY TABLE (CUY-77-1597 L)	
	VOLUME (CU. YD.)
PHASE 1, STEP 1	218
PHASE 1, STEP 2	196


DECK CONCRETE QUANTITY TABLE (CUY-77-1597 L)	
	VOLUME (CU. YD.)
PHASE 1, STEP 3	267
PHASE 1, STEP 4	274

NOTES:






1. FOR PHASE CONSTRUCTION DETAILS, SEE SHEET 6/38 THRU 11/38 .
2. INTERMEDIATE CROSSFRAMES SHALL NOT BE PERMANENTLY ATTACHED IN THE SPECIFIED BAY UNTIL THE CONCRETE POURS ON BOTH SIDES OF THE PHASE CONSTRUCTION JOINT HAVE BEEN COMPLETED AND CURED. FOR ADDITIONAL INTERMEDIATE CROSSFRAME DETAILS, SEE SHEET 20/38 .
3. SEAL CONSTRUCTION JOINT WITH 2'-0" WIDE HIGH MOLECULAR WEIGHT METHACRYLATE (HMMW).
4. THE ESTIMATED QUANTITY OF DECK SLAB CONCRETE IS BASED ON THE CONSTANT DECK SLAB THICKNESS, AS SHOWN, PLUS THE QUANTITY OF CONCRETE THAT FORMS EACH GIRDER HAUNCH. THE ESTIMATE ASSUMES A CONSTANT HAUNCH THICKNESS OF 3 INCHES AND A CONSTANT HAUNCH WIDTH OUTSIDE THE EDGE OF EACH BEAM FLANGE OF 9 INCHES. DEVIATE FROM THIS HAUNCH THICKNESS AS NECESSARY TO PLACE THE DECK SURFACE AT FINISH GRADE. THE ALLOWABLE TOLERANCE FOR HAUNCH WIDTH OUTSIDE EDGE OF EACH BEAM IS 3 INCHES. THE DEPTH SHOWN IN THE TRANSVERSE SECTION WAS MEASURED AT THE CENTERLINE OF GIRDER FROM THE SURFACE OF DECK TO THE BOTTOM OF THE TOP FLANGE. THE AREA OF ALL EMBEDDED STEEL PLATES HAS BEEN DEDUCTED FROM THE HAUNCH QUANTITY IN ACCORDANCE WITH 511.24.

5. FOR DETAILS OF ADDITIONAL REINFORCING OVER THE PIERS, SEE SHEET 27/38 .
6. DRIP GROOVES SHALL TERMINATE 2'-0" FROM THE END OF SLAB NEAR THE ABUTMENTS.
7. FOR SCREED ELEVATION TABLES, SEE SHEETS 30/38 THRU 34/38 .
8. FOR SUPER ELEVATION TRANSITION DIAGRAMS, SEE SHEET 29/38 .
9. REMOVABLE FORMS SHALL BE PROVIDED WITHIN 5'-0" OF BOTH SIDES OF ANY EXPANSION JOINT OR SCUPPER LOCATION. FOR ADDITIONAL STAY IN PLACE FORMS NOTES, SEE SHEET 29/38 .
10. FOR HAUNCH DIMENSIONS, SEE TABLE OF HAUNCHES ON SHEET 29/38 .
11. FOR SLAB OVERHANG DIMENSIONS, SEE SHEET 27/38 .
12. FOR ADDITIONAL TRANSVERSE SECTION DETAILS SEE SHEET 29/38 .
13. FOR ADDITIONAL PARAPET DETAILS, SEE SHEETS 26/38 THRU 27/38 .

[illegible]

	DESIGNED RSB	DRAWN RSB	REVIEWED JOL	DATE 03-11-11	BRIDGES 10 & 11
	CHECKED JTW	CHECKED NJ	STRUCTURE FILE NUMBER 1807919/1807900/1807803		
28 / 38			CUY-90-14.90 PID No. 77332 / 85531		BRIDGE N 1-90 EB, 1-90

090_165\LTIS002.dgn 1/8/2016 11:34:32 AM rstriegel

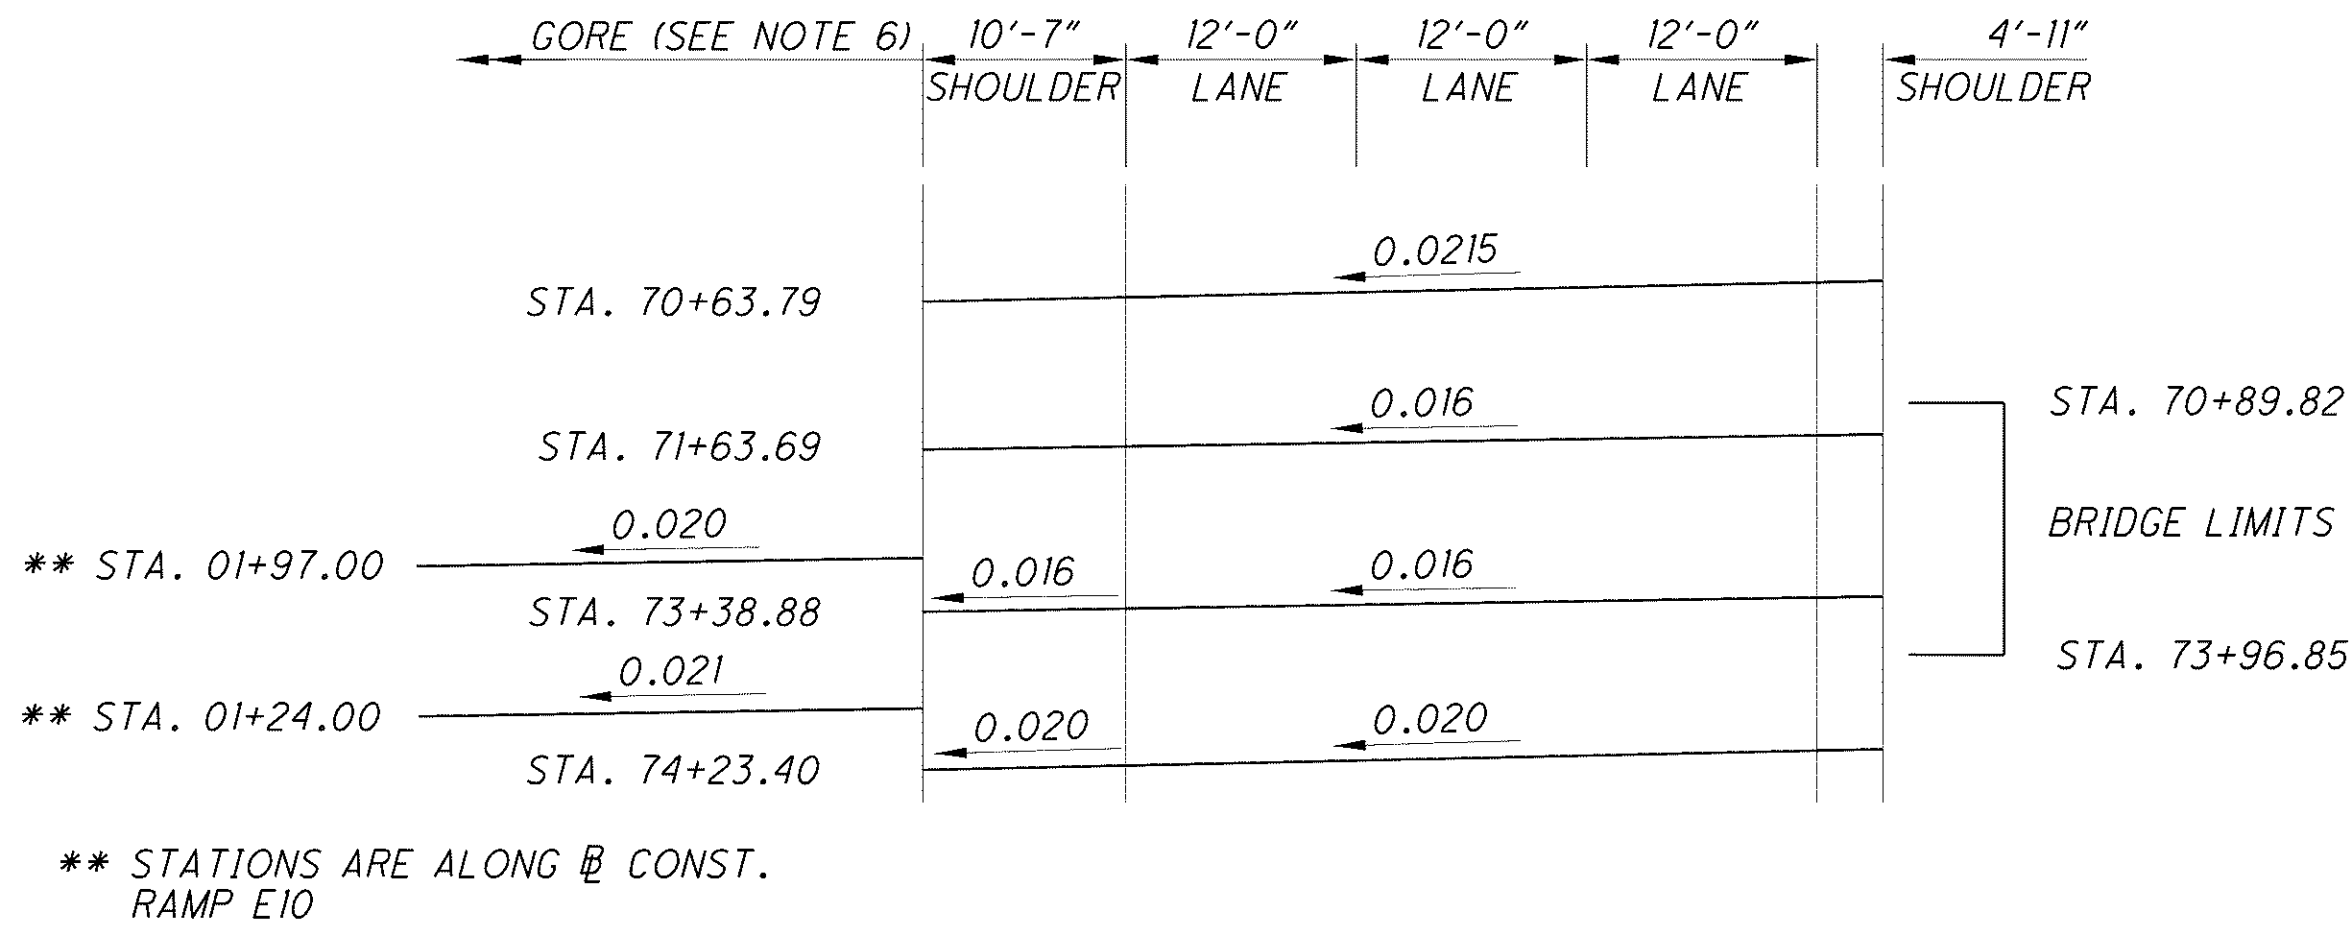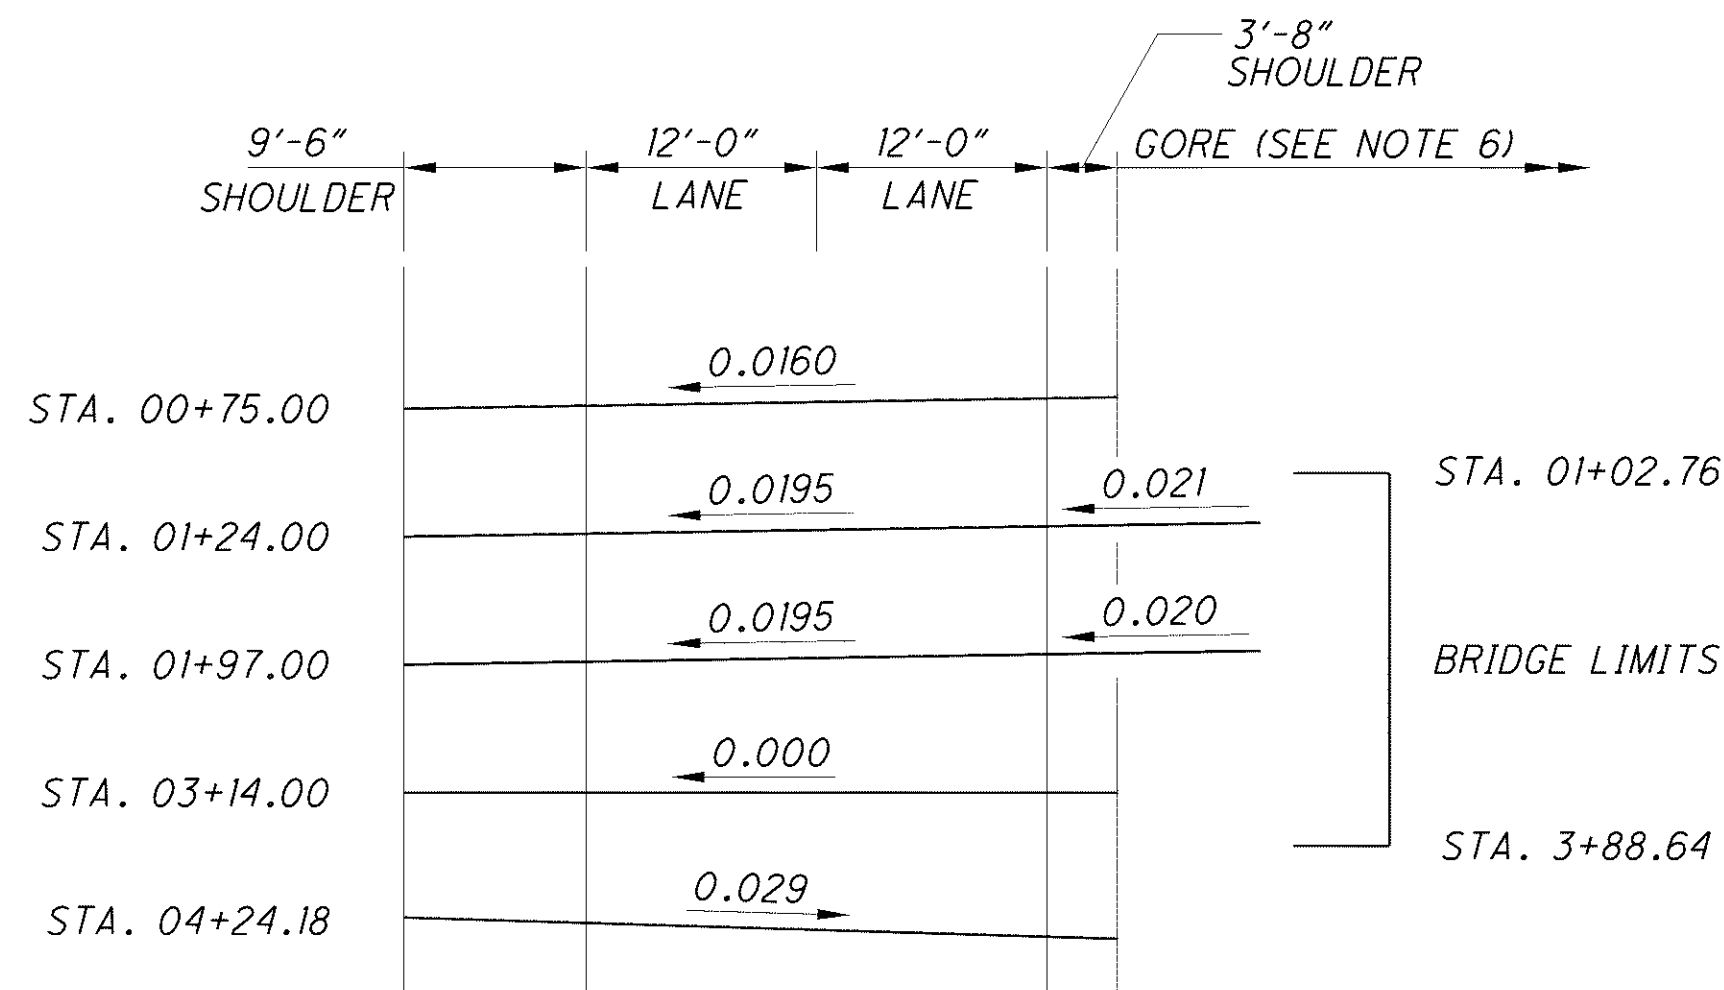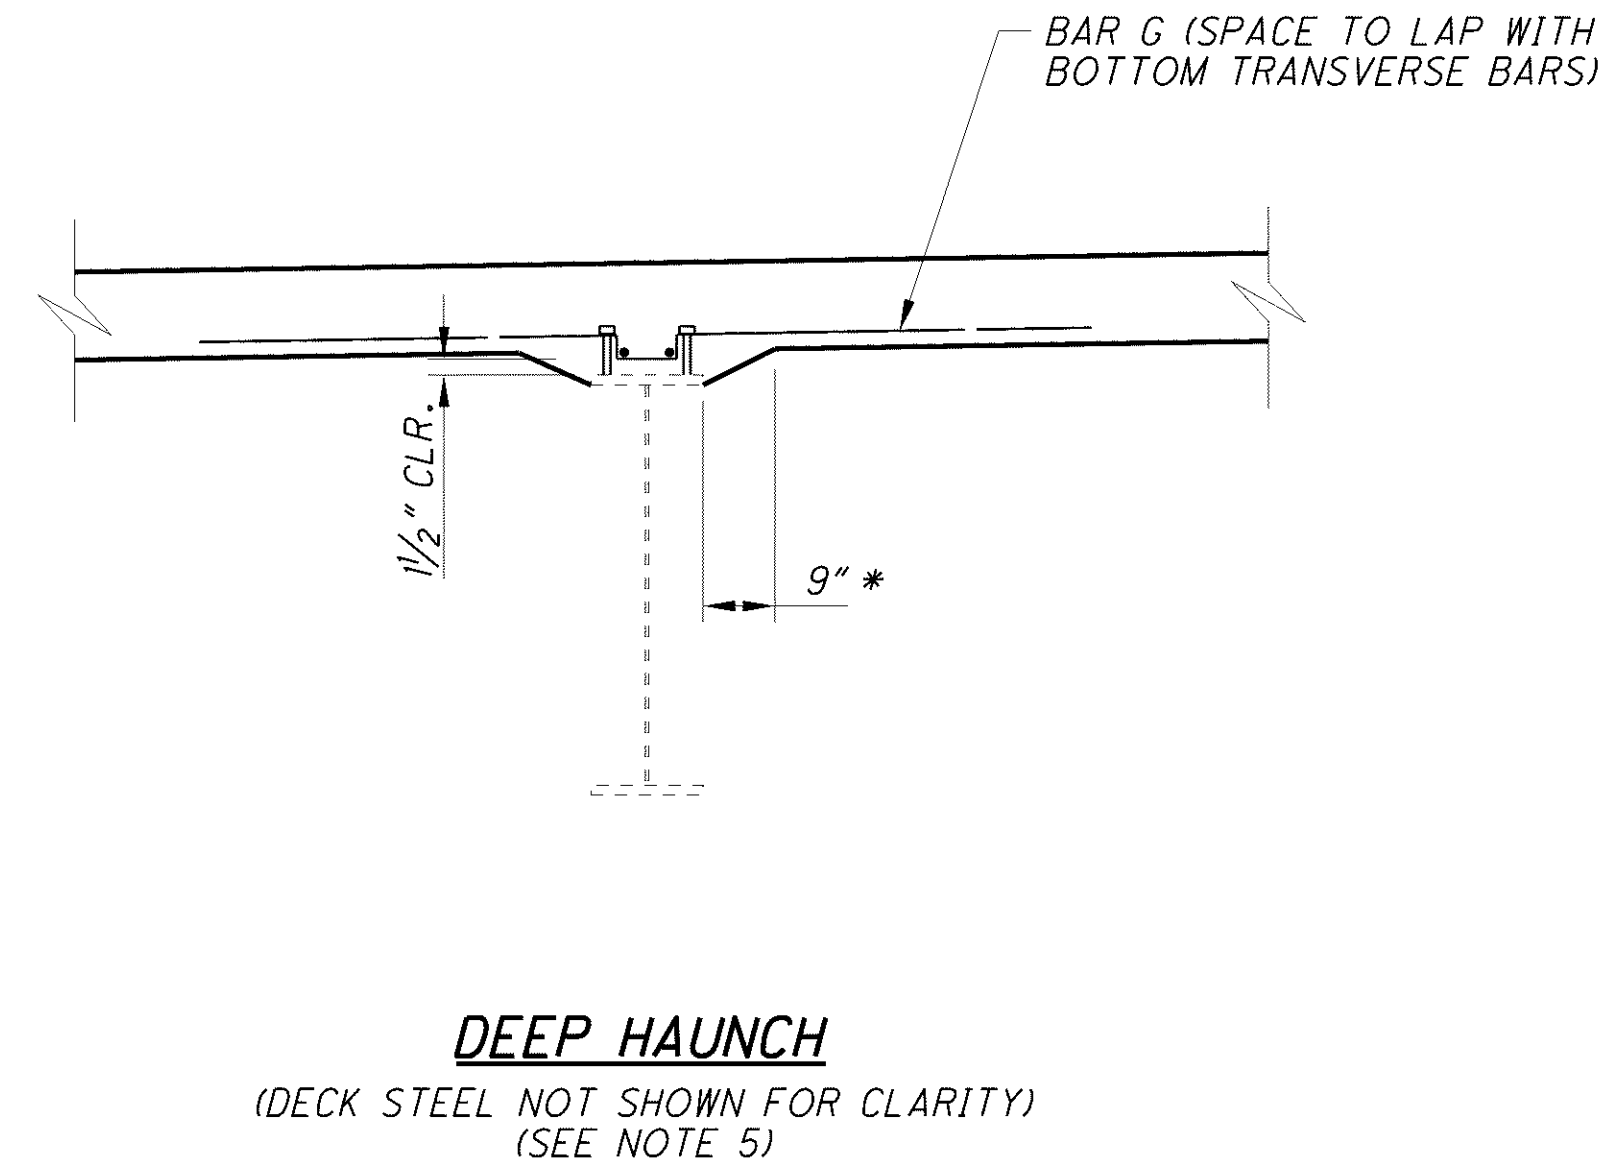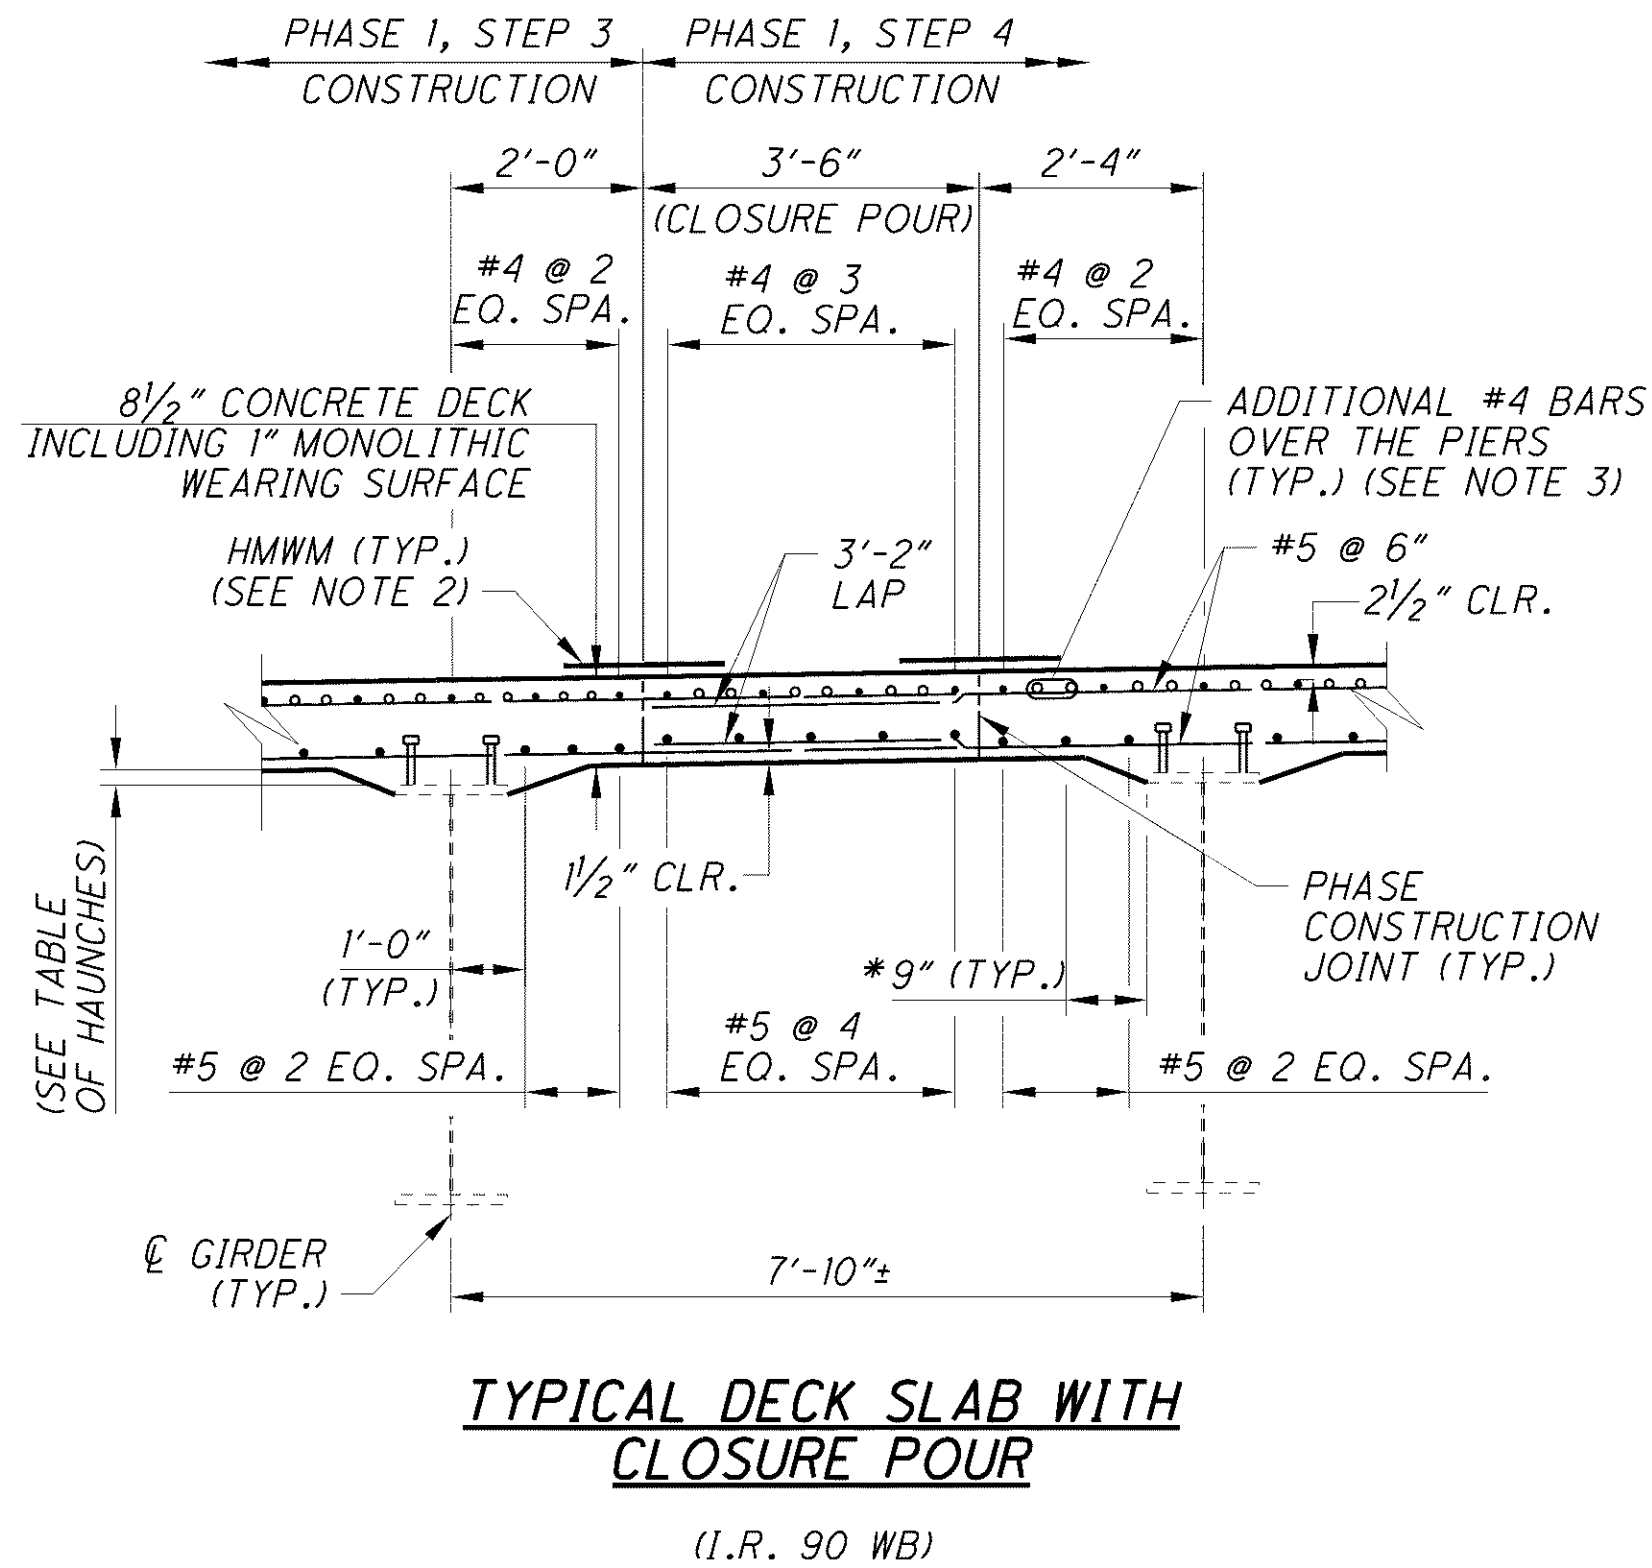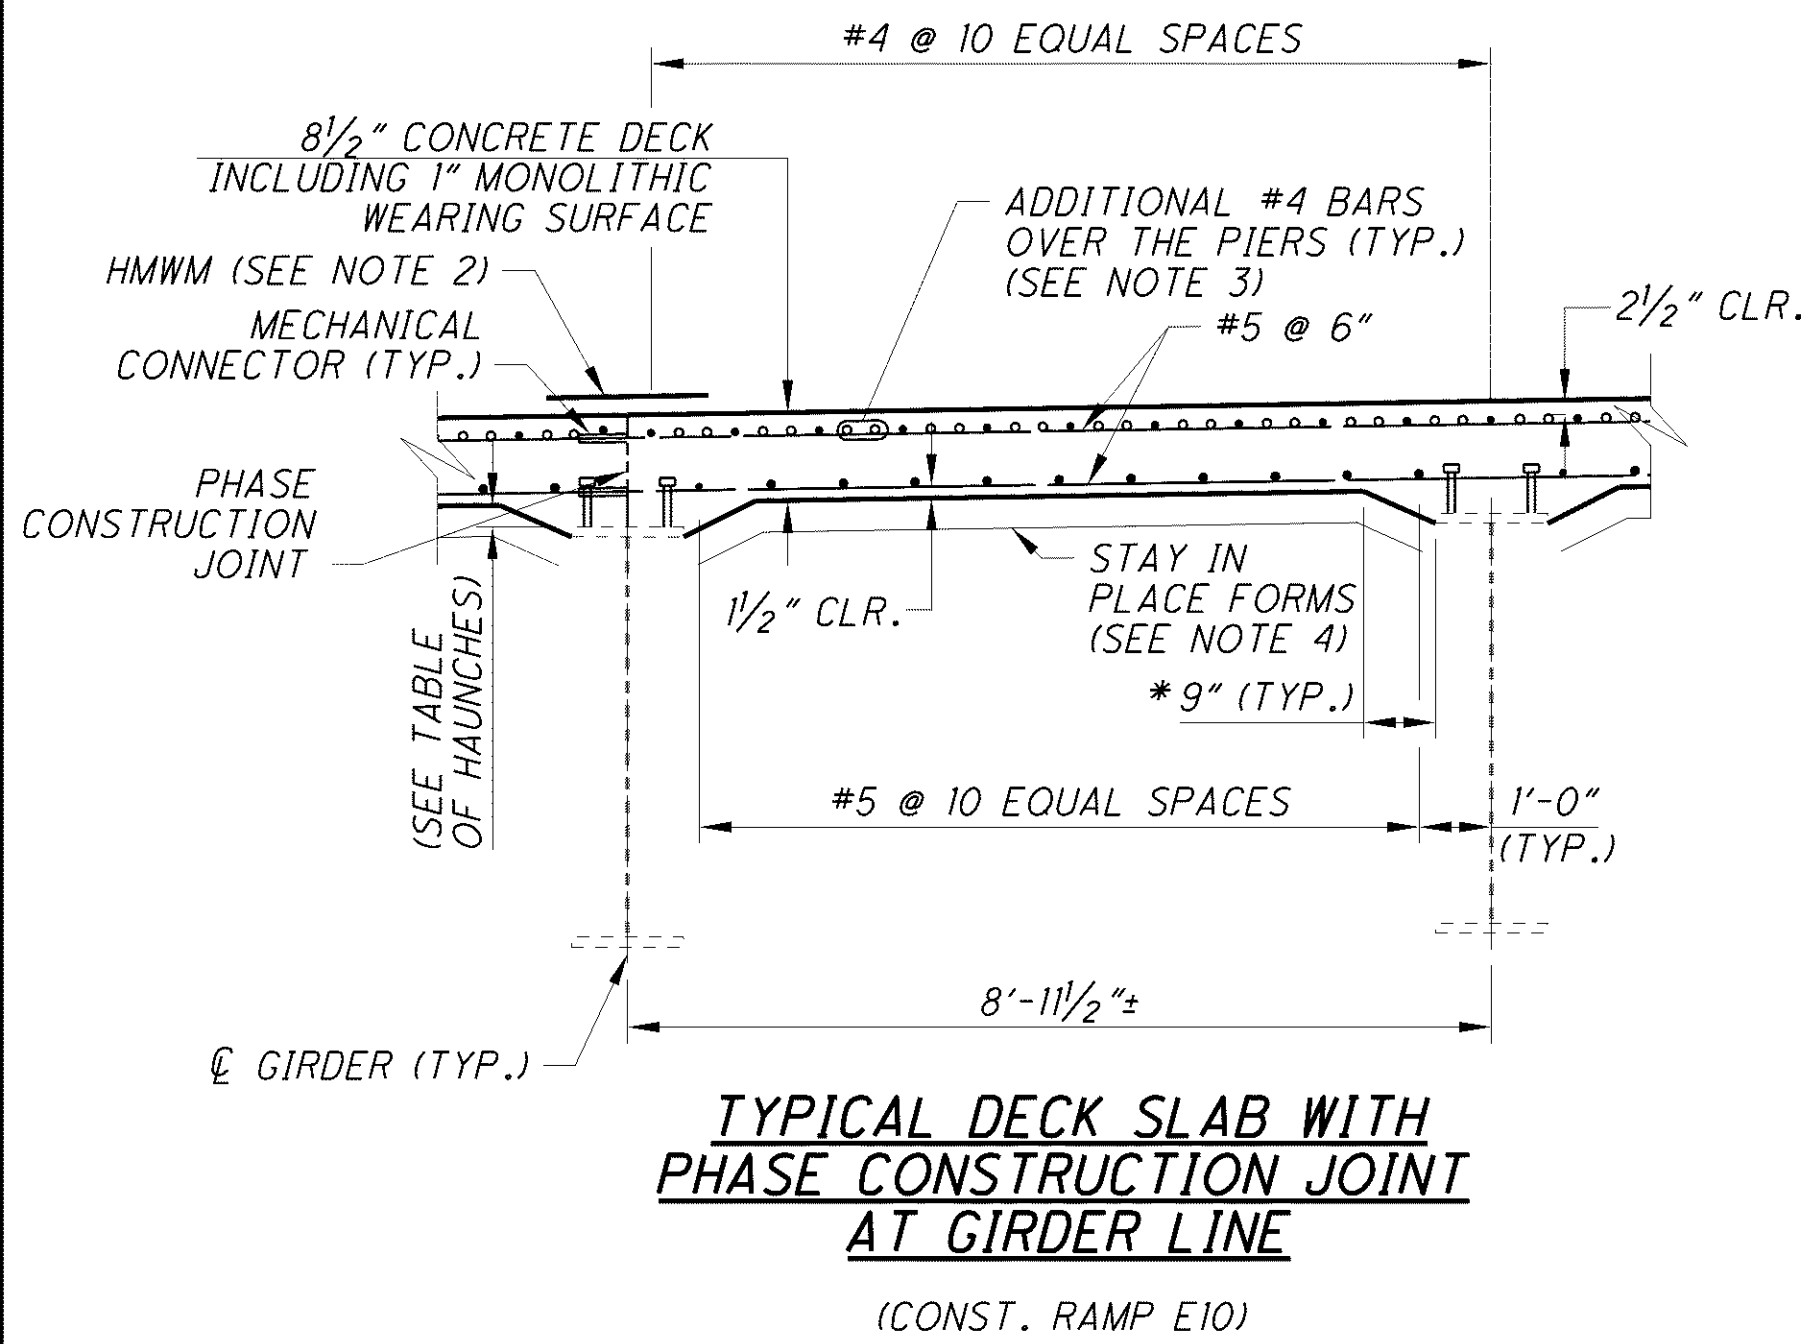

SUPERELEVATION TRANSITION DIAGRAM
(CONST. RAMP E10)
(SHOWN LOOKING DOWNSTATION)

SUPERELEVATION TRANSITION DIAGRAM
(I.R. 90 WB)

TABLE OF HAUNCHES (INCHES) #												
GIRDER LOCATION	A	B	C	D	E	F	G	H	J	K	L	M
REAR ABUTMENT	2 1/4"	2 1/4"	2 1/2"	2 3/4"	3 5/8"	6 1/2"	6"	5 3/8"	4 7/8"	4 3/8"	4"	4"
PIER 1	2"	1 3/4"	2"	2 3/8"	2 5/8"	4"	3 3/4"	3 1/4"	3 1/4"	3 1/8"	3"	3 1/4"
PIER 2	2 1/2"	1 1/2"	1 1/4"	0 3/4"	0 7/8"	2 1/2"	2 5/8"	2 3/4"	2 3/4"	2 1/8"	2 1/8"	2 3/4"
PIER 3	3 7/8"	3 3/8"	3 3/4"	3 3/8"	3 1/4"	3 3/8"	3 1/4"	3 3/8"	3 3/8"	3 5/8"	3 3/4"	3 3/4"
FORWARD ABUTMENT	4"	3 5/8"	3 1/4"	3 1/8"	3 1/4"	3 1/8"	2 7/8"	2 5/8"	2 3/4"	2 3/4"	3 1/8"	3 5/8"

BOTTOM OF DECK TO TOP OF GIRDER TOP FLANGE



- NOTES:
- FOR ADDITIONAL NOTES AND DETAILS, SEE SHEET 28/38.
 - SEAL CONSTRUCTION JOINT WITH 2'-0" WIDE HIGH MOLECULAR WEIGHT METHACRYLATE (HMWM).
 - FOR DETAILS OF ADDITIONAL REINFORCING OVER THE PIERS, SEE SHEET 27/38.
 - REMOVABLE FORMS SHALL BE PROVIDED WITHIN 5'-0" OF BOTH SIDES OF ANY EXPANSION JOINT OR SCUPPER LOCATION. THE MAXIMUM ALLOWABLE WEIGHT FOR THE STAY IN PLACE FORMS FOR GIRDERS A THRU E SHALL BE 15.8 PSF. THE MAXIMUM ALLOWABLE WEIGHT FOR THE STAY IN PLACE FORMS FOR GIRDERS F THRU M SHALL BE 14.6 PSF. THE MAXIMUM ALLOWABLE WEIGHT INCLUDES ADDITIONAL CONCRETE WEIGHT REQUIRED TO FILL FLUTES OF THE STAY IN PLACE FORMS.
 - FOR REBAR DETAILS AND LIMITS OF DEEP HAUNCH REINFORCEMENT, SEE SHEETS 25/38 AND 27/38.
 - THE CROSS SLOPES SHOWN FOR THE GORE AREA ARE REPRESENTATIVE OF THE SLOPE REQUIRED TO CLOSE THE GAP BETWEEN CUY-90-1651L AND CUY-77-1597.

DESIGNED	PSB	CHECKED	JTW	DATE	03-11-11	STRUCTURE FILE NUMBER	1807919/1807900/1807803	BRIDGES	10 & 11	DESIGN AGENCY	WALSH HNTB	NO.	RECORD DRAWINGS	REVISIONS	DATE	01-29-13
TRANSVERSE SECTION - 2										BRIDGE NO. CUY-77-1597 L AND CUY-90-1651 L/R I-90 EB, I-90WB AND I-77SB RAMP OVER E 14TH STREET						
CUY-90-14.90										PID No. 77332 / 85531						
29/38										29/38						

090_1651LSD008.dgn 1/8/2016 11:34:37 AM rstriegel

SCREED ELEVATIONS																	
LOCATION		C BRG. REAR ABUT.	SPAN 1			C BRG. PIER 1	SPAN 2				C BRG. PIER 2	SPAN 3					C BRG. PIER 3
			¼ PT.	½ PT.	¾ PT.		¼ PT.	F.S. 1	½ PT.	¾ PT.		F.S. 2	¼ PT.	½ PT.	¾ PT.	F.S. 3	
LEFT TOE OF PARAPET	STATION	3+86.69	3+75.18	3+63.67	3+52.17	3+40.66	3+22.43		3+04.20	2+85.97	2+67.74		2+42.63	2+17.51	1+92.39		1+67.28
	FINAL TOP OF DECK ELEV.	692.61	692.68	692.73	692.75	692.75	692.68		692.56	692.38	692.12		691.66	691.08	690.37		689.56
	*** ADJUSTED REBOUND	-				-					-						-
	**** DECK SCREED ELEVATION																
GIRDER A	STATION	3+86.67	3+75.16	3+63.65	3+52.14	3+40.64	3+22.38	3+20.63	3+04.13	2+85.88	2+67.62	2+47.33	2+42.51	2+17.39	1+92.28	1+87.46	1+67.17
	* ELEV. AFTER DECK REMOVAL	-				-					-						-
	* ELEV. BEFORE DECK REMOVAL	-				-					-						-
	** SURVEYED REBOUND	-				-					-						-
	*** ADJUSTED REBOUND	-				-					-						-
	FINAL TOP OF DECK ELEV.	692.60	692.67	692.72	692.75	692.74	692.68	692.67	692.56	692.38	692.13	691.77	691.67	691.08	690.38	690.23	689.57
	**** DECK SCREED ELEVATION																
GIRDER B	STATION	3+86.39	3+74.88	3+63.37	3+51.87	3+40.36	3+21.79	3+20.35	3+03.22	2+84.65	2+66.08	2+45.79	2+40.97	2+15.85	1+90.74	1+85.92	1+65.62
	* ELEV. AFTER DECK REMOVAL	-				-					-						-
	* ELEV. BEFORE DECK REMOVAL	-				-					-						-
	** SURVEYED REBOUND	-				-					-						-
	*** ADJUSTED REBOUND	-				-					-						-
	FINAL TOP OF DECK ELEV.	692.43	692.53	692.61	692.66	692.68	692.66	692.66	692.57	692.41	692.17	691.84	691.75	691.19	690.5	690.36	689.69
	**** DECK SCREED ELEVATION																
GIRDER C	STATION	3+86.12	3+74.61	3+63.10	3+51.59	3+40.09	3+21.20	3+20.07	3+02.31	2+83.42	2+64.54	2+44.24	2+39.42	2+14.31	1+89.20	1+84.38	1+64.08
	* ELEV. AFTER DECK REMOVAL	-				-					-						-
	* ELEV. BEFORE DECK REMOVAL	-				-					-						-
	** SURVEYED REBOUND	-				-					-						-
	*** ADJUSTED REBOUND	-				-					-						-
	FINAL TOP OF DECK ELEV.	692.26	692.39	692.50	692.57	692.62	692.63	692.64	692.58	692.44	692.23	691.91	691.83	691.30	690.63	690.49	689.81
	**** DECK SCREED ELEVATION																

SCREED ELEVATIONS						
LOCATION		C BRG. PIER 3	SPAN 4			C BRG. FWD. ABUT.
			1/4 PT.	1/2 PT.	3/4 PT.	
LEFT TOE OF PARAPET	STATION	1+67.28	1+52.02	1+36.71	1+21.40	1+06.09
	FINAL TOP OF DECK ELEV.	689.56	689.02	688.48	687.95	687.45
	*** ADJUSTED REBOUND	-				
	**** DECK SCREED ELEVATION					
GIRDER A	STATION	1+67.17	1+51.91	1+36.61	1+21.31	1+06.01
	* ELEV. AFTER DECK REMOVAL	-				-
	* ELEV. BEFORE DECK REMOVAL	-				-
	** SURVEYED REBOUND	-				-
	*** ADJUSTED REBOUND	-				-
	FINAL TOP OF DECK ELEV.	689.57	689.03	688.49	687.96	687.46
	**** DECK SCREED ELEVATION					
GIRDER B	STATION	1+65.62	1+50.52	1+35.42	1+20.31	1+05.18
	* ELEV. AFTER DECK REMOVAL	-				-
	* ELEV. BEFORE DECK REMOVAL	-				-
	** SURVEYED REBOUND	-				-
	*** ADJUSTED REBOUND	-				-
	FINAL TOP OF DECK ELEV.	689.69	689.16	688.61	688.08	687.57
	**** DECK SCREED ELEVATION					
GIRDER C	STATION	1+64.08	1+49.13	1+34.24	1+19.32	1+04.36
	* ELEV. AFTER DECK REMOVAL	-				-
	* ELEV. BEFORE DECK REMOVAL	-				-
	** SURVEYED REBOUND	-				-
	*** ADJUSTED REBOUND	-				-
	FINAL TOP OF DECK ELEV.	689.81	689.29	688.74	688.20	687.68
	**** DECK SCREED ELEVATION					

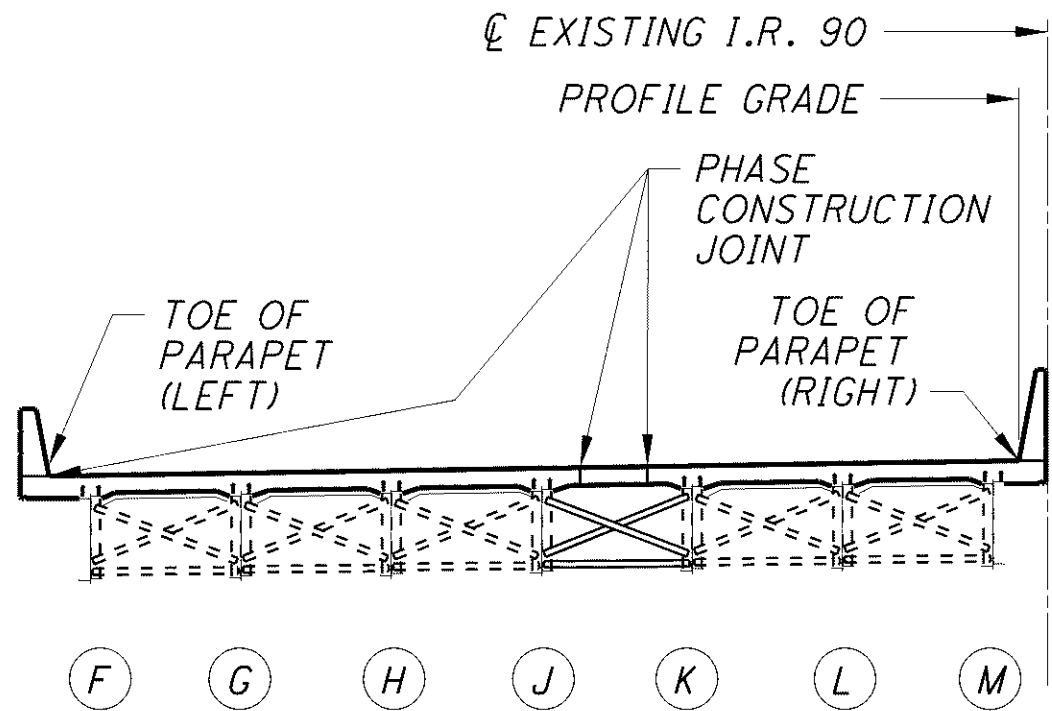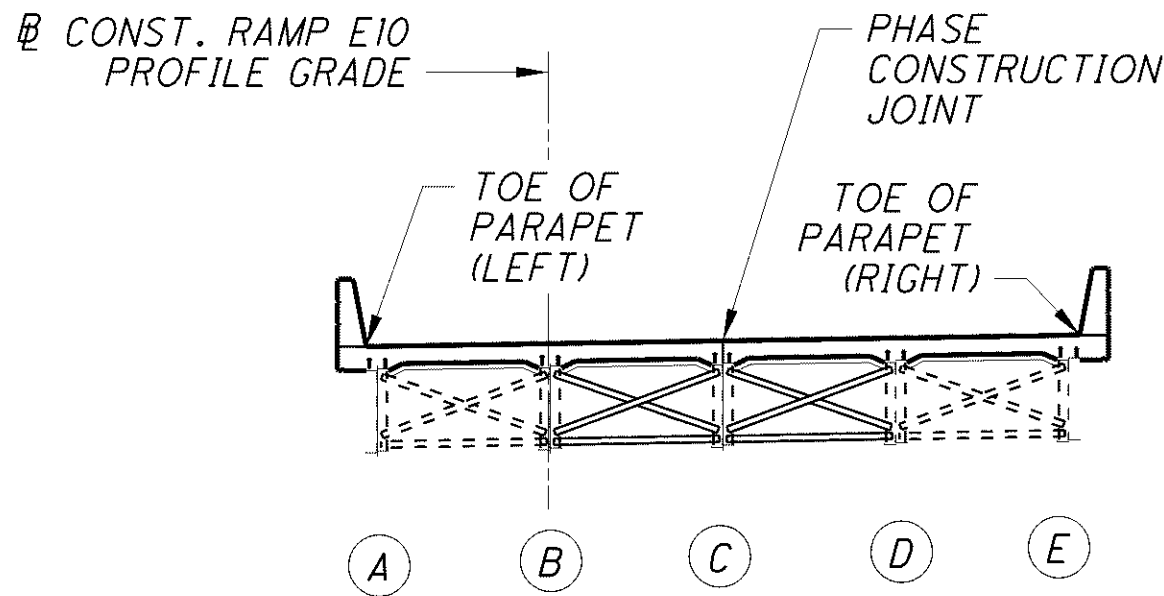

TYPICAL SLAB TRANSVERSE SECTION

(SPAN 1, SPAN 2 AND PART SPAN 3)

SCREED ELEVATIONS:

FIELD PROCEDURES DURING CONSTRUCTION OF DECKS.

1. SURVEY BOTTOM OF EXISTING GIRDERS AT THE LOCATIONS SHOWN IN THE TABLE PRIOR TO DECK REMOVAL AND THEN AFTER DECK REMOVAL.
2. COMPUTE THE AMOUNT OF SURVEYED REBOUND FOR THE GIRDERS BY SUBTRACTING THE ELEVATIONS AFTER REMOVAL FROM THE ELEVATIONS BEFORE REMOVAL.
3. COMPUTE THE ADJUSTED REBOUND FOR THE GIRDERS BY MULTIPLYING THE SURVEYED REBOUND BY THE RATIO OF THE PROPOSED DEAD LOAD TO THE EXISTING DEAD LOAD.
4. ADD THE AMOUNT OF ADJUSTED REBOUND TO THE FINAL TOP OF DECK ELEVATIONS TO OBTAIN THE DECK SCREED ELEVATIONS. USE REBOUND OF THE CLOSEST GIRDER TO DETERMINE TOE OF PARAPET, PHASE CONSTRUCTION JOINT AND CROWN LINE SCREED ELEVATIONS.

LEGEND:

- * - BOTTOM OF BEAM ELEVATION SURVEYED DURING CONSTRUCTION.
- ** - SURVEYED REBOUND - SURVEYED GIRDER ELEVATION BEFORE DECK REMOVAL MINUS SURVEYED GIRDER ELEVATION AFTER DECK REMOVAL.
- *** - ADJUSTED REBOUND - RATIO OF PROPOSED DEAD LOAD TO EXISTING DEAD LOAD (SEE BELOW) MULTIPLIED BY THE SURVEYED REBOUND. FOR TOE OF PARAPETS, PHASE CONSTRUCTION JOINT AND CROWN LINE USE THE CLOSEST GIRDER TO DETERMINE THE ADJUSTED REBOUND.
- **** - DECK SCREED ELEVATION - ADJUSTED REBOUND ADDED TO THE FINAL TOP OF DECK ELEVATION.

$$\frac{\text{PROPOSED DEAD LOAD}}{\text{EXISTING DEAD LOAD}} = 0.97$$

NOTES:


1. FOR TYPICAL SECTION SHOWING PART SPAN 3 AND SPAN 4, SEE SHEET 31/38.

DESIGNED		PSB	CHECKED	MR1	30/38	
DRAWN		RSB	CHECKED	MR1	30/38	
REVIEWED		JOL	DATE	03-11-11	CUY-90-14.90	
BRIDGES		10 & 11		STRUCTURE FILE NUMBER	1807919/1807900	
DESIGN AGENCY		WALSH HNTB		CLASH	PID No. 77332 / 85531	
DATE		03-14-11		RECORD DRAWINGS	BRIDGE NO. CUY-77-1597 L AND CUY-90-1651 L	
REVISED		NO.		NO.	I-90WB AND I-77SB RAMP OVER E 14TH STREET	
SCREED ELEVATIONS - 1		BRIDGES		SCREED ELEVATIONS - 1		

090_1651LSD009.dgn 1/8/2016 11:34:43 AM rstriegel

SCREED ELEVATIONS																	
LOCATION		C BRG. REAR ABUT.	SPAN 1			C BRG. PIER 1	SPAN 2				C BRG. PIER 2	SPAN 3					C BRG. PIER 3
			1/4 PT.	1/2 PT.	3/4 PT.		1/4 PT.	F.S. 1	1/2 PT.	3/4 PT.		F.S. 2	1/4 PT.	1/2 PT.	3/4 PT.	F.S. 3	
PHASE CONST. JOINT	STATION	3+86.12	3+74.61	3+63.10	3+51.59	3+40.09	3+21.20		3+02.31	2+83.42	2+64.54		2+39.42	2+14.31	1+89.20		1+64.08
	* ELEV. AFTER DECK REMOVAL	-					-										
	* ELEV. BEFORE DECK REMOVAL	-					-										
	** SURVEYED REBOUND	-					-										
	*** ADJUSTED REBOUND	-					-										
	FINAL TOP OF DECK ELEV.	692.26	692.39	692.50	692.57	692.62	692.63		692.58	692.44	692.23		691.83	691.3	690.63		689.81
	**** DECK SCREED ELEVATION																
GIRDER D	STATION	3+85.84	3+74.33	3+62.82	3+51.32	3+39.81	3+20.60	3+19.79	3+01.40	2+82.20	2+63.00	2+42.70	2+37.94	2+12.88	1+87.82	1+82.83	1+62.85
	* ELEV. AFTER DECK REMOVAL	-					-										
	* ELEV. BEFORE DECK REMOVAL	-					-										
	** SURVEYED REBOUND	-					-										
	*** ADJUSTED REBOUND	-					-										
	FINAL TOP OF DECK ELEV.	692.09	692.25	692.38	692.48	692.56	692.62	692.63	692.60	692.47	692.28	691.99	691.91	691.42	690.77	690.61	689.91
	**** DECK SCREED ELEVATION																
GIRDER E	STATION	3+85.56	3+74.05	3+62.55	3+51.04	3+39.53	3+20.01	3+19.52	3+00.49	2+80.97	2+61.45	2+41.16	2+36.41	2+11.37	1+86.33	1+81.29	1+61.61
	* ELEV. AFTER DECK REMOVAL	-					-										
	* ELEV. BEFORE DECK REMOVAL	-					-										
	** SURVEYED REBOUND	-					-										
	*** ADJUSTED REBOUND	-					-										
	FINAL TOP OF DECK ELEV.	691.93	692.11	692.27	692.40	692.50	692.61	692.61	692.61	692.51	692.34	692.10	692.03	691.58	690.89	690.74	690.01
	**** DECK SCREED ELEVATION																
RIGHT TOE OF PARAPET	STATION	3+85.54	3+74.04	3+62.53	3+51.02	3+39.51	3+19.97		3+00.43	2+80.88	2+61.34		2+36.30	2+11.26	-	-	-
	FINAL TOP OF DECK ELEV.	691.92	692.10	692.26	692.39	692.50	692.61		692.61	692.52	692.35		692.05	691.59	-	-	-
	*** ADJUSTED REBOUND																
	**** DECK SCREED ELEVATION																

SCREED ELEVATIONS						
LOCATION		C BRG. PIER 3	SPAN 4			C BRG. FWD. ABUT.
			1/4 PT.	1/2 PT.	3/4 PT.	
PHASE CONST. JOINT	STATION	1+64.08	1+49.13	1+34.05	1+19.04	1+04.03
	* ELEV. AFTER DECK REMOVAL	-				
	* ELEV. BEFORE DECK REMOVAL	-				
	** SURVEYED REBOUND	-				
	*** ADJUSTED REBOUND	-				
	FINAL TOP OF DECK ELEV.	689.81	689.29	688.75	688.23	687.72
GIRDER D	STATION	1+62.85	1+48.12	1+33.43	1+18.69	1+03.90
	* ELEV. AFTER DECK REMOVAL	-				
	* ELEV. BEFORE DECK REMOVAL	-				
	** SURVEYED REBOUND	-				
	*** ADJUSTED REBOUND	-				
	FINAL TOP OF DECK ELEV.	689.91	689.36	688.81	688.27	687.74
GIRDER E	STATION	1+61.61	1+47.15	1+32.61	1+18.02	1+03.36
	* ELEV. AFTER DECK REMOVAL	-				
	* ELEV. BEFORE DECK REMOVAL	-				
	** SURVEYED REBOUND	-				
	*** ADJUSTED REBOUND	-				
	FINAL TOP OF DECK ELEV.	690.01	689.45	688.9	688.35	687.81
RIGHT TOE OF PARAPET	STATION	-	-	-	-	-
	FINAL TOP OF DECK ELEV.	-	-	-	-	-
	*** ADJUSTED REBOUND					
	**** DECK SCREED ELEVATION					

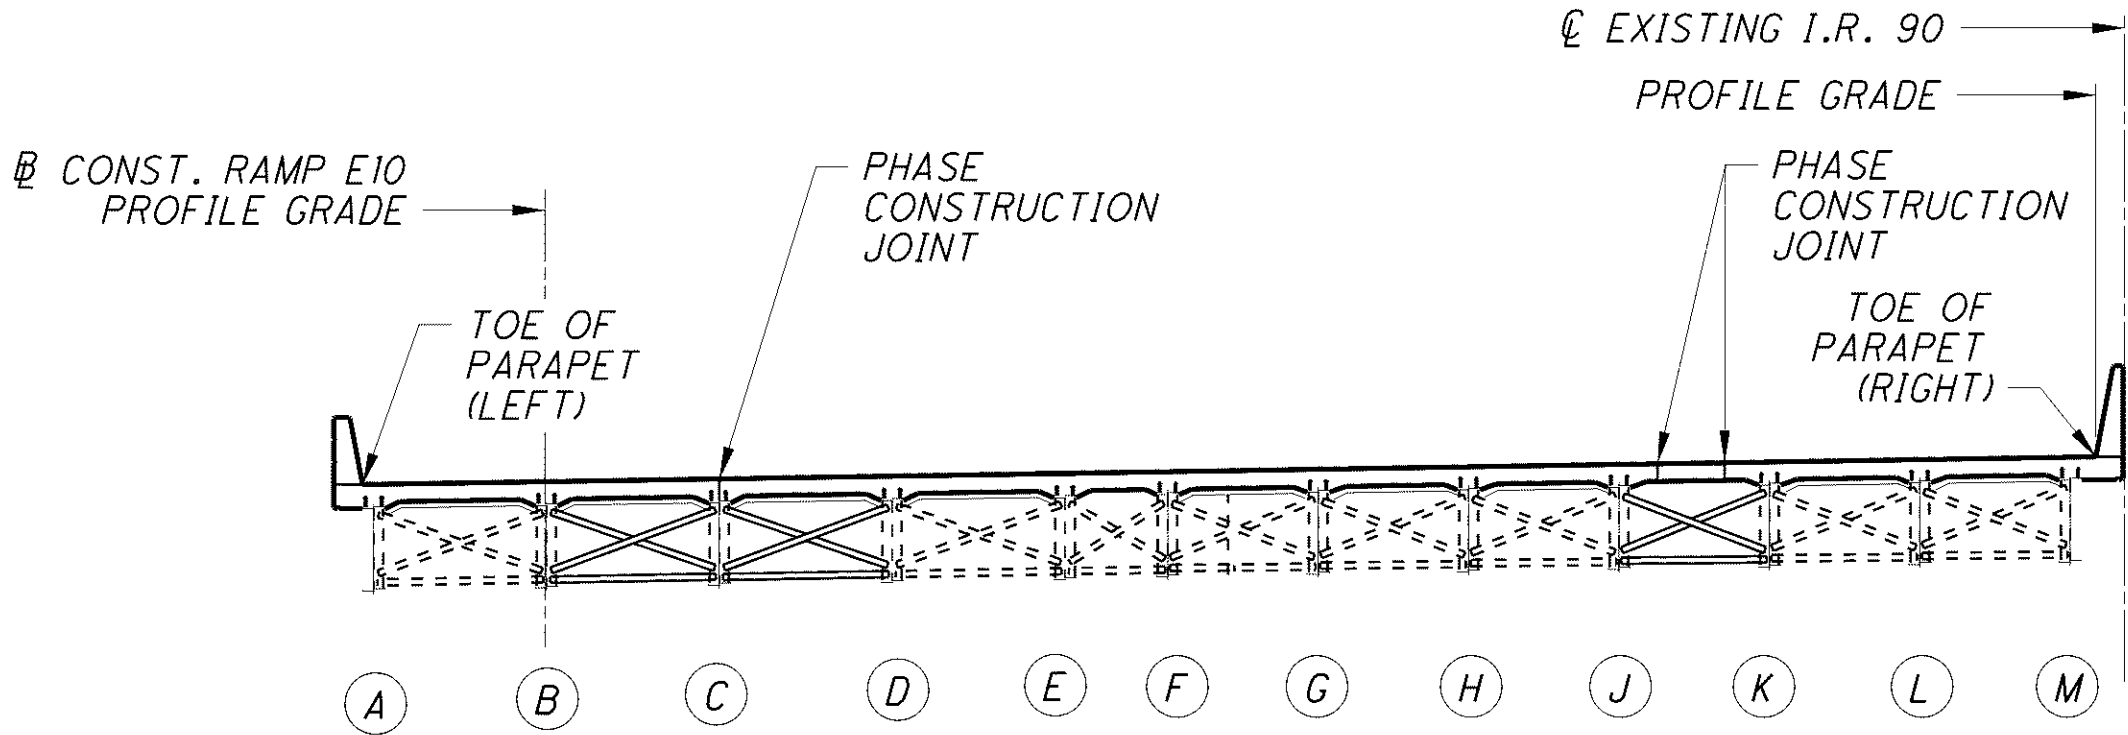

TYPICAL SLAB TRANSVERSE SECTION
(PART SPAN 3 AND SPAN 4)

LEGEND:

- * - BOTTOM OF BEAM ELEVATION SURVEYED DURING CONSTRUCTION.
- ** - SURVEYED REBOUND - SURVEYED GIRDER ELEVATION BEFORE DECK REMOVAL MINUS SURVEYED GIRDER ELEVATION AFTER DECK REMOVAL.
- *** - ADJUSTED REBOUND - RATIO OF PROPOSED DEAD LOAD TO EXISTING DEAD LOAD (SEE BELOW) MULTIPLIED BY THE SURVEYED REBOUND. FOR TOE OF PARAPETS, PHASE CONSTRUCTION JOINT AND CROWN LINE USE THE CLOSEST GIRDER TO DETERMINE THE ADJUSTED REBOUND.
- **** - DECK SCREED ELEVATION - ADJUSTED REBOUND ADDED TO THE FINAL TOP OF DECK ELEVATION.

$$\frac{\text{PROPOSED DEAD LOAD}}{\text{EXISTING DEAD LOAD}} = 0.97$$

NOTES:

1. FOR ADDITIONAL NOTES, SEE SHEET 30/38.
2. FOR TYPICAL SECTION SHOWING SPAN 1, SPAN 2 AND PART SPAN 3, SEE SHEET 30/38.

DESIGNED
RSB
CHECKED
MRJ

DRAWN
RSB
CHECKED
MRJ

REVIEWED
JOL

DATE
03-11-11

STRUCTURE FILE NUMBER
1807919/1807900

BRIDGES
10 & 11

DESIGN AGENCY
WALSH
HNTB
CLEVELAND'S
COLUMBIAN BRIDGE
90th PERCENTILE
WALSH CONSTRUCTION

NO.

REVISIONS
RECORD DRAWINGS

DATE
03-14-11

SCREED ELEVATIONS - 2
BRIDGE NO. CUY-77-1597 L AND CUY-90-1651 L
I-90WB AND I-77SB RAMP OVER E 14TH STREET

CUY-90-14.90
PID No. 77332 / 85531
31/38
31/38

090_1651LSD010.dgn 1/8/2016 11:34:53 AM rstriegel

SCREED ELEVATIONS																	
LOCATION		C BRG. REAR ABUT.	SPAN 1			C BRG. PIER 1	SPAN 2				C BRG. PIER 2	SPAN 3					C BRG. PIER 3
			1/4 PT.	1/2 PT.	3/4 PT.		F.S. 1	1/4 PT.	1/2 PT.	3/4 PT.		F.S. 2	1/4 PT.	1/2 PT.	3/4 PT.	F.S. 3	
LEFT TOE OF PARAPET	STATION	70+99.33	71+13.09	71+26.84	71+40.59	71+54.34	-	71+74.66	71+94.97	72+15.28	72+35.60	-	72+60.35	72+85.10	-	-	-
	FINAL TOP OF DECK ELEV.	697.74	697.42	697.09	696.73	696.35	-	695.72	695.02	694.29	693.56	-	692.68	691.75	-	-	-
	*** ADJUSTED REBOUND	-					-										
	**** DECK SCREED ELEVATION																
GIRDER F	STATION	70+99.08	71+12.85	71+26.60	71+40.35	71+54.10	71+74.30	71+74.47	71+94.85	72+15.22	72+35.60	72+55.60	72+60.35	72+85.10	73+09.85	73+14.60	73+34.60
	* ELEV. AFTER DECK REMOVAL	-					-										
	* ELEV. BEFORE DECK REMOVAL	-					-										
	** SURVEYED REBOUND	-					-										
	*** ADJUSTED REBOUND	-					-										
	FINAL TOP OF DECK ELEV.	697.78	697.46	697.12	696.77	696.39	695.76	695.76	695.06	694.32	693.59	692.88	692.71	691.79	690.97	690.81	690.09
	**** DECK SCREED ELEVATION																
GIRDER G	STATION	70+97.97	71+11.75	71+25.50	71+39.25	71+53.00	71+73.20	71+73.65	71+94.30	72+14.95	72+35.60	72+55.60	72+60.35	72+85.10	73+09.85	73+14.60	73+34.60
	* ELEV. AFTER DECK REMOVAL	-					-										
	* ELEV. BEFORE DECK REMOVAL	-					-										
	** SURVEYED REBOUND	-					-										
	*** ADJUSTED REBOUND	-					-										
	FINAL TOP OF DECK ELEV.	697.96	697.64	697.29	696.93	696.55	695.92	695.91	695.20	694.46	693.72	693.00	692.83	691.94	691.08	690.91	690.2
	**** DECK SCREED ELEVATION																
GIRDER H	STATION	70+96.86	71+10.65	71+24.40	71+38.15	71+51.90	71+72.10	71+72.82	71+93.75	72+14.67	72+35.60	72+55.60	72+60.35	72+85.10	73+09.85	73+14.60	73+34.60
	* ELEV. AFTER DECK REMOVAL	-					-										
	* ELEV. BEFORE DECK REMOVAL	-					-										
	** SURVEYED REBOUND	-					-										
	*** ADJUSTED REBOUND	-					-										
	FINAL TOP OF DECK ELEV.	698.14	697.81	697.46	697.10	696.71	696.09	696.06	695.35	694.60	693.84	693.13	692.96	692.08	691.20	691.03	690.33
	**** DECK SCREED ELEVATION																

SCREED ELEVATIONS						
LOCATION		C BRG. PIER 3	SPAN 4			C BRG. FWD. ABUT.
			1/4 PT.	1/2 PT.	3/4 PT.	
LEFT TOE OF PARAPET	STATION	-	-	-	-	-
	FINAL TOP OF DECK ELEV.	-	-	-	-	-
	*** ADJUSTED REBOUND	-				
	**** DECK SCREED ELEVATION					
GIRDER F	STATION	73+34.60	73+49.60	73+64.60	73+79.60	73+94.60
	* ELEV. AFTER DECK REMOVAL	-				
	* ELEV. BEFORE DECK REMOVAL	-				
	** SURVEYED REBOUND	-				
	*** ADJUSTED REBOUND	-				
	FINAL TOP OF DECK ELEV.	690.09	689.53	688.98	688.43	687.89
	**** DECK SCREED ELEVATION					
GIRDER G	STATION	73+34.60	73+49.60	73+64.60	73+79.60	73+94.60
	* ELEV. AFTER DECK REMOVAL	-				
	* ELEV. BEFORE DECK REMOVAL	-				
	** SURVEYED REBOUND	-				
	*** ADJUSTED REBOUND	-				
	FINAL TOP OF DECK ELEV.	690.20	689.66	689.11	688.56	688.01
GIRDER H	STATION	73+34.60	73+49.60	73+64.60	73+79.60	73+94.60
	* ELEV. AFTER DECK REMOVAL	-				
	* ELEV. BEFORE DECK REMOVAL	-				
	** SURVEYED REBOUND	-				
	*** ADJUSTED REBOUND	-				
	FINAL TOP OF DECK ELEV.	690.33	689.79	689.24	688.69	688.15
	**** DECK SCREED ELEVATION					

LEGEND:

- * - BOTTOM OF BEAM ELEVATION SURVEYED DURING CONSTRUCTION.
- ** - SURVEYED REBOUND - SURVEYED GIRDER ELEVATION BEFORE DECK REMOVAL MINUS SURVEYED GIRDER ELEVATION AFTER DECK REMOVAL.
- *** - ADJUSTED REBOUND - RATIO OF PROPOSED DEAD LOAD TO EXISTING DEAD LOAD (SEE BELOW) MULTIPLIED BY THE SURVEYED REBOUND. FOR TOE OF PARAPETS, PHASE CONSTRUCTION JOINT AND CROWN LINE USE THE CLOSEST GIRDER TO DETERMINE THE ADJUSTED REBOUND.
- **** - DECK SCREED ELEVATION - ADJUSTED REBOUND ADDED TO THE FINAL TOP OF DECK ELEVATION.

$$\frac{\text{PROPOSED DEAD LOAD}}{\text{EXISTING DEAD LOAD}} = 0.96$$

NOTES:

1. FOR ADDITIONAL NOTES, SEE SHEET 30/38.
2. FOR TYPICAL SECTION SHOWING SPAN 1, SPAN 2 AND PART SPAN 3, SEE SHEET 30/38.
3. FOR TYPICAL SECTION SHOWING PART SPAN 3 AND SPAN 4, SEE SHEET 31/38.

DESIGNED
PSB
CHECKED
MRJ

DRAWN
PSB
CHECKED
MRJ

REVIEWED
JOL

DATE
03-11-11

BRIDGES
10 & 11

DESIGN AGENCY
WALSH
HNTB
WALSH CONSTRUCTION

DATE
03-14-11

REVISIONS
RECORD DRAWINGS

NO.

32/38

CUY-90-14.90
PID No. 77332 / 85531

SCREED ELEVATIONS - 3
BRIDGE NO. CUY-77-1597 L AND CUY-90-1651 L
I-90WB AND I-77SB RAMP OVER E 14TH STREET

090_1651\SD011.dgn 1/8/2016 11:34:59 AM rstriegel

SCREED ELEVATIONS																	
LOCATION		C BRG. REAR ABUT.	SPAN 1			C BRG. PIER 1	SPAN 2				C BRG. PIER 2	SPAN 3					C BRG. PIER 3
			1/4 PT.	1/2 PT.	3/4 PT.		F.S. 1	1/4 PT.	1/2 PT.	3/4 PT.		F.S. 2	1/4 PT.	1/2 PT.	3/4 PT.	F.S. 3	
GIRDER J	STATION	70+95.76	71+09.55	71+23.30	71+37.05	71+50.80	71+70.99	71+72.00	71+93.20	72+14.40	72+35.60	72+55.60	72+60.35	72+85.10	73+09.85	73+14.60	73+34.60
	* ELEV. AFTER DECK REMOVAL	-					-										
	* ELEV. BEFORE DECK REMOVAL	-					-										
	** SURVEYED REBOUND	-					-										
	*** ADJUSTED REBOUND	-					-										
	FINAL TOP OF DECK ELEV.	698.32	697.99	697.63	697.26	696.87	696.25	696.21	695.49	694.73	693.97	693.25	693.08	692.20	691.32	691.16	690.45
	**** DECK SCREED ELEVATION																
CONST. JOINT1	STATION	70+95.48	71+09.27	71+23.02	71+36.77	71+50.52		71+71.79	71+93.06	72+14.33	72+35.60		72+60.35	72+85.10	73+09.85		73+34.60
	* ELEV. AFTER DECK REMOVAL	-															
	* ELEV. BEFORE DECK REMOVAL	-															
	** SURVEYED REBOUND	-															
	*** ADJUSTED REBOUND	-															
	FINAL TOP OF DECK ELEV.	698.36	698.03	697.68	697.31	696.91		696.25	695.53	694.76	694.00		693.11	692.23	691.36		690.49
	**** DECK SCREED ELEVATION																
CONST. JOINT2	STATION	70+94.99	71+08.77	71+22.52	71+36.27	71+50.02		71+71.42	71+92.81	72+14.20	72+35.60		72+60.35	72+85.10	73+09.85		73+34.60
	* ELEV. AFTER DECK REMOVAL	-															
	* ELEV. BEFORE DECK REMOVAL	-															
	** SURVEYED REBOUND	-															
	*** ADJUSTED REBOUND	-															
	FINAL TOP OF DECK ELEV.	698.44	698.11	697.76	697.38	696.99		696.32	695.59	694.83	694.06		693.17	692.29	691.41		690.54
	**** DECK SCREED ELEVATION																

SCREED ELEVATIONS						
LOCATION		C BRG. PIER 3	SPAN 4			C BRG. FWD. ABUT.
			1/4 PT.	1/2 PT.	3/4 PT.	
GIRDER J	STATION	73+34.60	73+49.60	73+64.60	73+79.60	73+94.60
	* ELEV. AFTER DECK REMOVAL	-				
	* ELEV. BEFORE DECK REMOVAL	-				
	** SURVEYED REBOUND	-				
	*** ADJUSTED REBOUND	-				
	FINAL TOP OF DECK ELEV.	690.45	689.91	689.37	688.83	688.30
	**** DECK SCREED ELEVATION					
CONST. JOINT1	STATION	73+34.60	73+49.60	73+64.60	73+79.60	73+94.60
	* ELEV. AFTER DECK REMOVAL	-				
	* ELEV. BEFORE DECK REMOVAL	-				
	** SURVEYED REBOUND	-				
	*** ADJUSTED REBOUND	-				
	FINAL TOP OF DECK ELEV.	690.49	689.95	689.41	688.87	688.33
	**** DECK SCREED ELEVATION					
CONST. JOINT2	STATION	73+34.60	73+49.60	73+64.60	73+79.60	73+94.60
	* ELEV. AFTER DECK REMOVAL	-				
	* ELEV. BEFORE DECK REMOVAL	-				
	** SURVEYED REBOUND	-				
	*** ADJUSTED REBOUND	-				
	FINAL TOP OF DECK ELEV.	690.54	690.01	689.47	688.93	688.40
	**** DECK SCREED ELEVATION					

LEGEND:

- * - BOTTOM OF BEAM ELEVATION SURVEYED DURING CONSTRUCTION.
- ** - SURVEYED REBOUND - SURVEYED GIRDER ELEVATION BEFORE DECK REMOVAL MINUS SURVEYED GIRDER ELEVATION AFTER DECK REMOVAL.
- *** - ADJUSTED REBOUND - RATIO OF PROPOSED DEAD LOAD TO EXISTING DEAD LOAD (SEE BELOW) MULTIPLIED BY THE SURVEYED REBOUND. FOR TOE OF PARAPETS, PHASE CONSTRUCTION JOINT AND CROWN LINE USE THE CLOSEST GIRDER TO DETERMINE THE ADJUSTED REBOUND.
- **** - DECK SCREED ELEVATION - ADJUSTED REBOUND ADDED TO THE FINAL TOP OF DECK ELEVATION.

$$\frac{\text{PROPOSED DEAD LOAD}}{\text{EXISTING DEAD LOAD}} = 0.96$$

NOTES:

- FOR ADDITIONAL NOTES, SEE SHEET 30/38.
- FOR TYPICAL SECTION SHOWING SPAN 1, SPAN 2 AND PART SPAN 3, SEE SHEET 30/38.
- FOR TYPICAL SECTION SHOWING PART SPAN 3 AND SPAN 4, SEE SHEET 31/38.

DESIGNED
RSB
MRJ

CHECKED
MRJ

BRIDGES
10 & 11

DESIGN AGENCY
WMH
HNTB
WALSH CONSTRUCTION

REVIEWED
JOL

DATE
03-11-11

STRUCTURE FILE NUMBER
1807919/1807900

NO.

DATE
03-14-11

REVISIONS

RECORD DRAWINGS

NO.

NO.

CUY-90-14.90
PID No. 77332 / 85531

33/38

33/38

SCREED ELEVATIONS - 4

BRIDGE NO. CUY-77-1597 L AND CUY-90-1651 L
I-90WB AND I-77SB RAMP OVER E 14TH STREET

090_1651LSD012.dgn 1/8/2016 11:35:04 AM rstriegel

SCREED ELEVATIONS																	
LOCATION		C BRG. REAR ABUT.	SPAN 1			C BRG. PIER 1	SPAN 2				C BRG. PIER 2	SPAN 3					C BRG. PIER 3
			1/4 PT.	1/2 PT.	3/4 PT.		F.S. 1	1/4 PT.	1/2 PT.	3/4 PT.		F.S. 2	1/4 PT.	1/2 PT.	3/4 PT.	F.S. 3	
GIRDER K	STATION	70+94.67	71+08.45	71+22.20	71+35.95	71+49.70	71+69.89	71+71.17	71+92.65	72+14.12	72+35.60	72+55.60	72+60.35	72+85.10	73+09.85	73+14.60	73+34.60
	* ELEV. AFTER DECK REMOVAL	-					-										
	* ELEV. BEFORE DECK REMOVAL	-					-										
	** SURVEYED REBOUND	-					-										
	*** ADJUSTED REBOUND	-					-										
	FINAL TOP OF DECK ELEV.	698.50	698.16	697.81	697.43	697.04	696.41	696.37	695.64	694.87	694.09	693.38	693.21	692.33	691.45	691.28	690.58
	**** DECK SCREED ELEVATION																
GIRDER L	STATION	70+93.58	71+07.34	71+21.09	71+34.84	71+48.59	71+68.79	71+70.34	71+92.09	72+13.85	72+35.60	72+55.60	72+60.35	72+85.10	73+09.85	73+14.60	73+34.60
	* ELEV. AFTER DECK REMOVAL	-					-										
	* ELEV. BEFORE DECK REMOVAL	-					-										
	** SURVEYED REBOUND	-					-										
	*** ADJUSTED REBOUND	-					-										
	FINAL TOP OF DECK ELEV.	698.68	698.34	697.98	697.60	697.20	696.57	696.52	695.78	695.00	694.22	693.50	693.33	692.45	691.58	691.41	690.70
	**** DECK SCREED ELEVATION																
GIRDER M	STATION	70+92.49	71+06.24	71+19.99	71+33.74	71+47.49	71+67.69	71+69.52	71+91.54	72+13.57	72+35.60	72+55.60	72+60.35	72+85.10	73+09.85	73+14.60	73+34.60
	* ELEV. AFTER DECK REMOVAL	-					-										
	* ELEV. BEFORE DECK REMOVAL	-					-										
	** SURVEYED REBOUND	-					-										
	*** ADJUSTED REBOUND	-					-										
	FINAL TOP OF DECK ELEV.	698.86	698.52	698.15	697.77	697.36	696.73	696.67	695.93	695.14	694.34	693.63	693.46	692.58	691.70	691.53	690.83
	**** DECK SCREED ELEVATION																
RIGHT TOE OF PARAPET	STATION	70+92.30	71+06.06	71+19.81	71+33.56	71+47.31		71+69.38	71+91.45	72+13.52	72+35.60		72+60.35	72+85.10	73+09.85		73+34.60
	FINAL TOP OF DECK ELEV.	698.89	698.55	698.18	697.80	697.39		696.70	695.95	695.16	694.37		693.48	692.60	691.72		690.85
	*** ADJUSTED REBOUND																
	**** DECK SCREED ELEVATION																

SCREED ELEVATIONS						
LOCATION		C BRG. PIER 3	SPAN 4			C BRG. FWD. ABUT.
			1/4 PT.	1/2 PT.	3/4 PT.	
GIRDER K	STATION	73+34.60	73+49.60	73+64.60	73+79.60	73+94.60
	* ELEV. AFTER DECK REMOVAL	-				
	* ELEV. BEFORE DECK REMOVAL	-				
	** SURVEYED REBOUND	-				
	*** ADJUSTED REBOUND	-				
	FINAL TOP OF DECK ELEV.	690.58	690.04	689.51	688.97	688.44
	**** DECK SCREED ELEVATION					
GIRDER L	STATION	73+34.60	73+49.60	73+64.60	73+79.60	73+94.60
	* ELEV. AFTER DECK REMOVAL	-				
	* ELEV. BEFORE DECK REMOVAL	-				
	** SURVEYED REBOUND	-				
	*** ADJUSTED REBOUND	-				
	FINAL TOP OF DECK ELEV.	690.70	690.17	689.64	689.11	688.59
	**** DECK SCREED ELEVATION					
GIRDER M	STATION	73+34.60	73+49.60	73+64.60	73+79.60	73+94.60
	* ELEV. AFTER DECK REMOVAL	-				
	* ELEV. BEFORE DECK REMOVAL	-				
	** SURVEYED REBOUND	-				
	*** ADJUSTED REBOUND	-				
	FINAL TOP OF DECK ELEV.	690.83	690.30	689.78	689.26	688.73
	**** DECK SCREED ELEVATION					
RIGHT TOE OF PARAPET	STATION	73+34.60	73+49.60	73+64.60	73+79.60	73+94.60
	FINAL TOP OF DECK ELEV.	690.85	690.33	689.80	689.28	688.76
	*** ADJUSTED REBOUND	-				-
	**** DECK SCREED ELEVATION	-				-

LEGEND:

- * - BOTTOM OF BEAM ELEVATION SURVEYED DURING CONSTRUCTION.
- ** - SURVEYED REBOUND - SURVEYED GIRDER ELEVATION BEFORE DECK REMOVAL MINUS SURVEYED GIRDER ELEVATION AFTER DECK REMOVAL.
- *** - ADJUSTED REBOUND - RATIO OF PROPOSED DEAD LOAD TO EXISTING DEAD LOAD (SEE BELOW) MULTIPLIED BY THE SURVEYED REBOUND. FOR TOE OF PARAPETS, PHASE CONSTRUCTION JOINT AND CROWN LINE USE THE CLOSEST GIRDER TO DETERMINE THE ADJUSTED REBOUND.
- **** - DECK SCREED ELEVATION - ADJUSTED REBOUND ADDED TO THE FINAL TOP OF DECK ELEVATION.

$$\frac{\text{PROPOSED DEAD LOAD}}{\text{EXISTING DEAD LOAD}} = 0.96$$

NOTES:

1. FOR ADDITIONAL NOTES, SEE SHEET 30/38.
2. FOR TYPICAL SECTION SHOWING SPAN 1, SPAN 2 AND PART SPAN 3, SEE SHEET 30/38.
3. FOR TYPICAL SECTION SHOWING PART SPAN 3 AND SPAN 4, SEE SHEET 31/38.

DESIGNED
PSB
MRJ

CHECKED
MRJ

DRAWN
PSB

CHECKED
MRJ

REVIEWED
JOL

DATE
03-11-11

STRUCTURE FILE NUMBER
1807919/1807900

BRIDGES
10 & 11

DESIGN AGENCY
WALSH
CONSTRUCTION

DATE
03-14-11

RECORD DRAWINGS

REVISIONS

NO.


CUY-90-14.90
PID No. 77332 / 85531

34/38


34/38

SCREED ELEVATIONS - 5

BRIDGE NO. CUY-77-1597 L AND CUY-90-1651 L
I-90WB AND I-77SB RAMP OVER E 14TH STREET

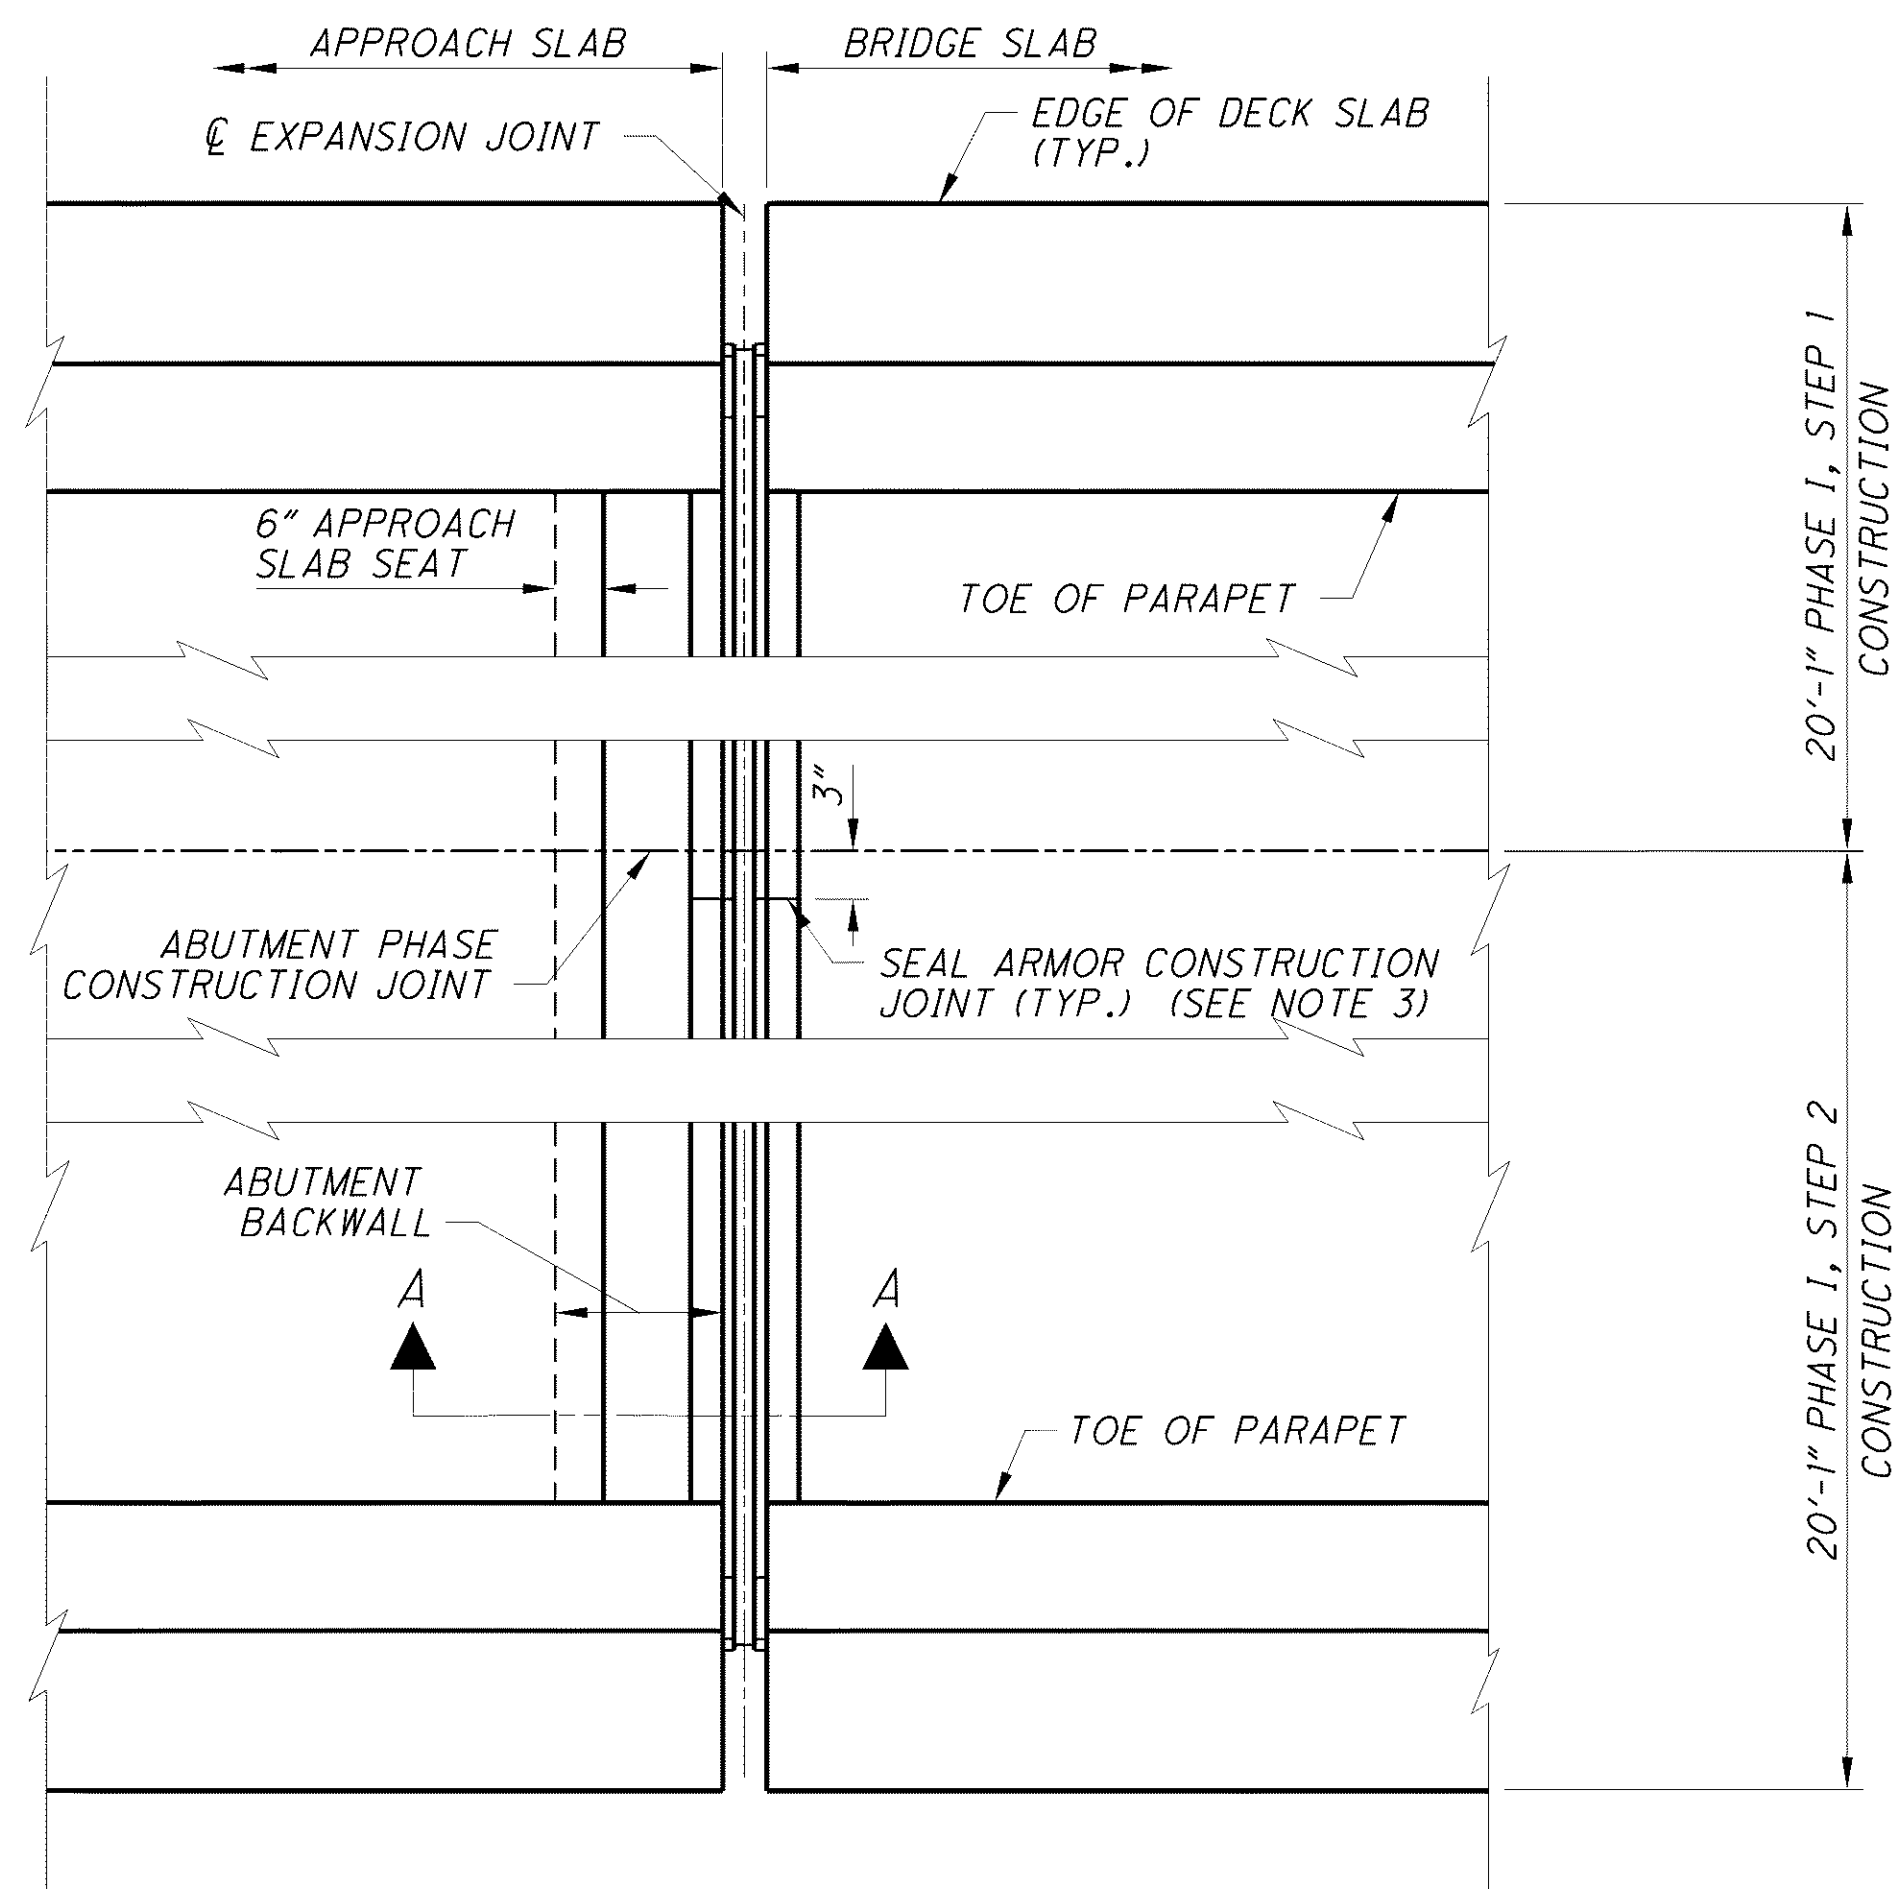


PART PLAN AT REAR ABUTMENT BRIDGE CUY-77-1597L

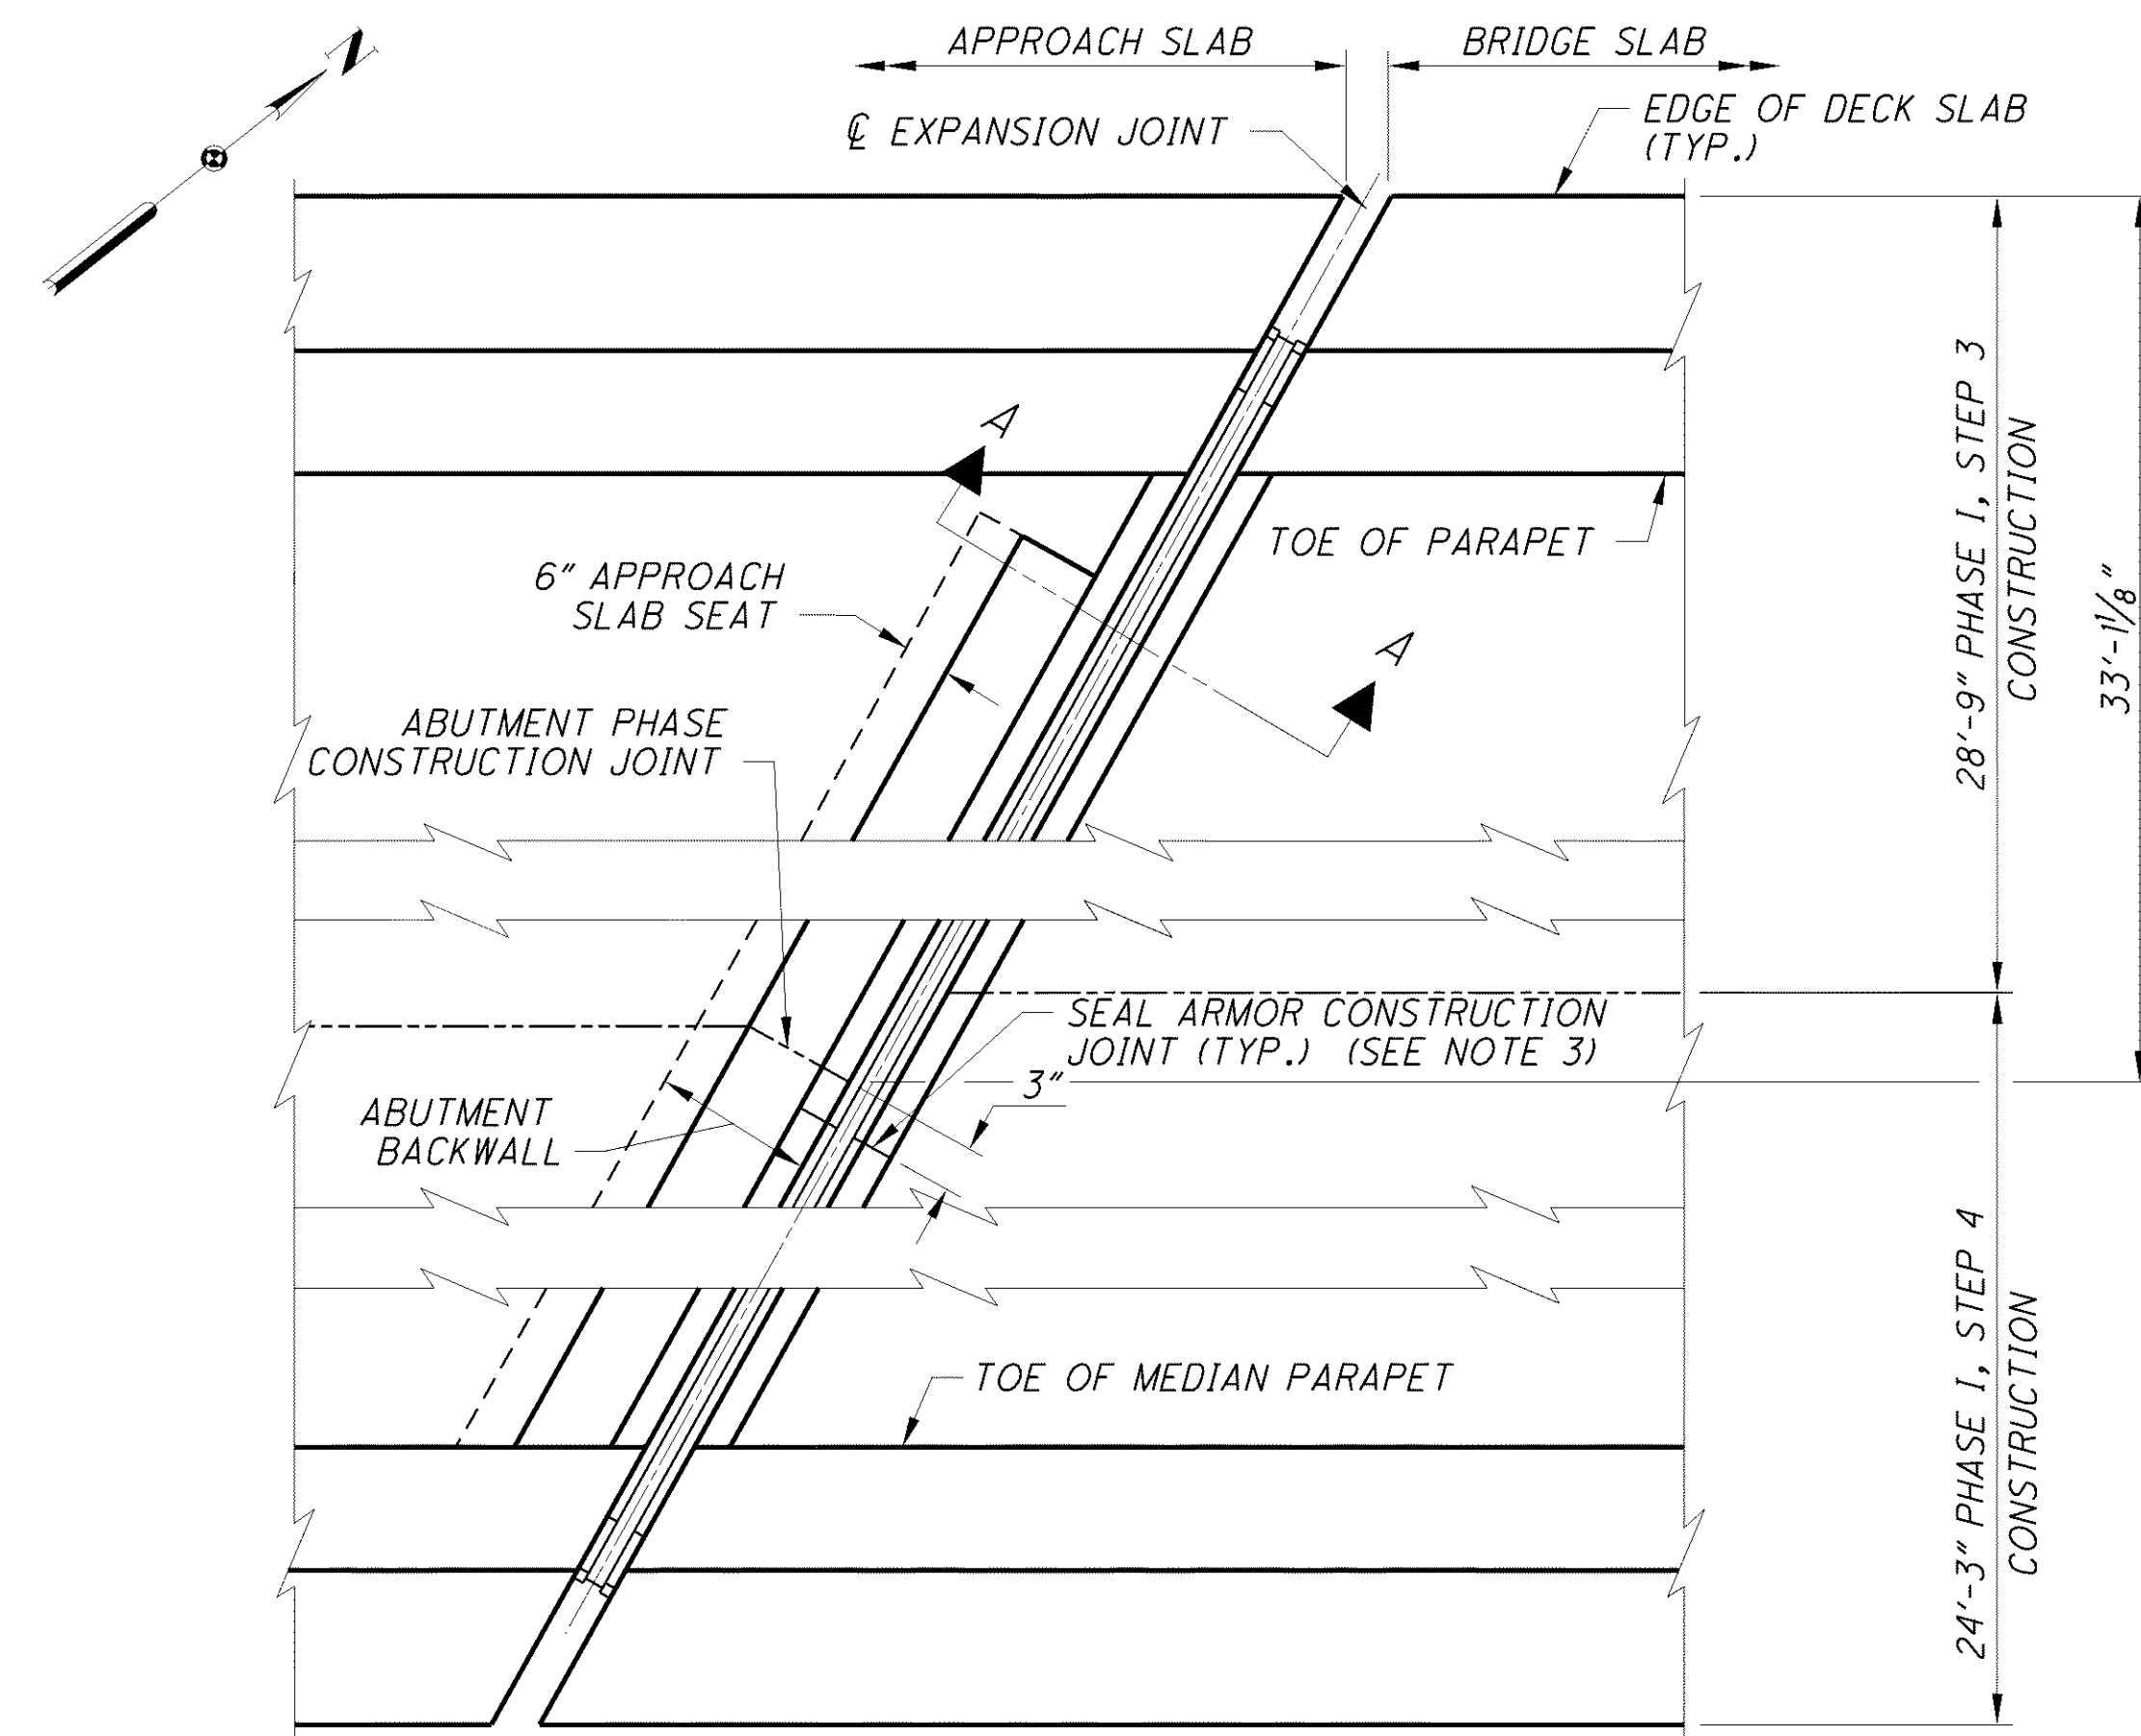

PART PLAN AT REAR ABUTMENT BRIDGE CUY-90-1651L



CUY-77-1597L STRIP SEAL JOINT WIDTH	
AMBIENT TEMPERATURE	DIMENSION "A"
	3" SEAL
90° F	1.32"
80° F	1.41"
70° F	1.51"
60° F	1.60"
50° F	1.69"
40° F	1.79"
30° F	1.88"

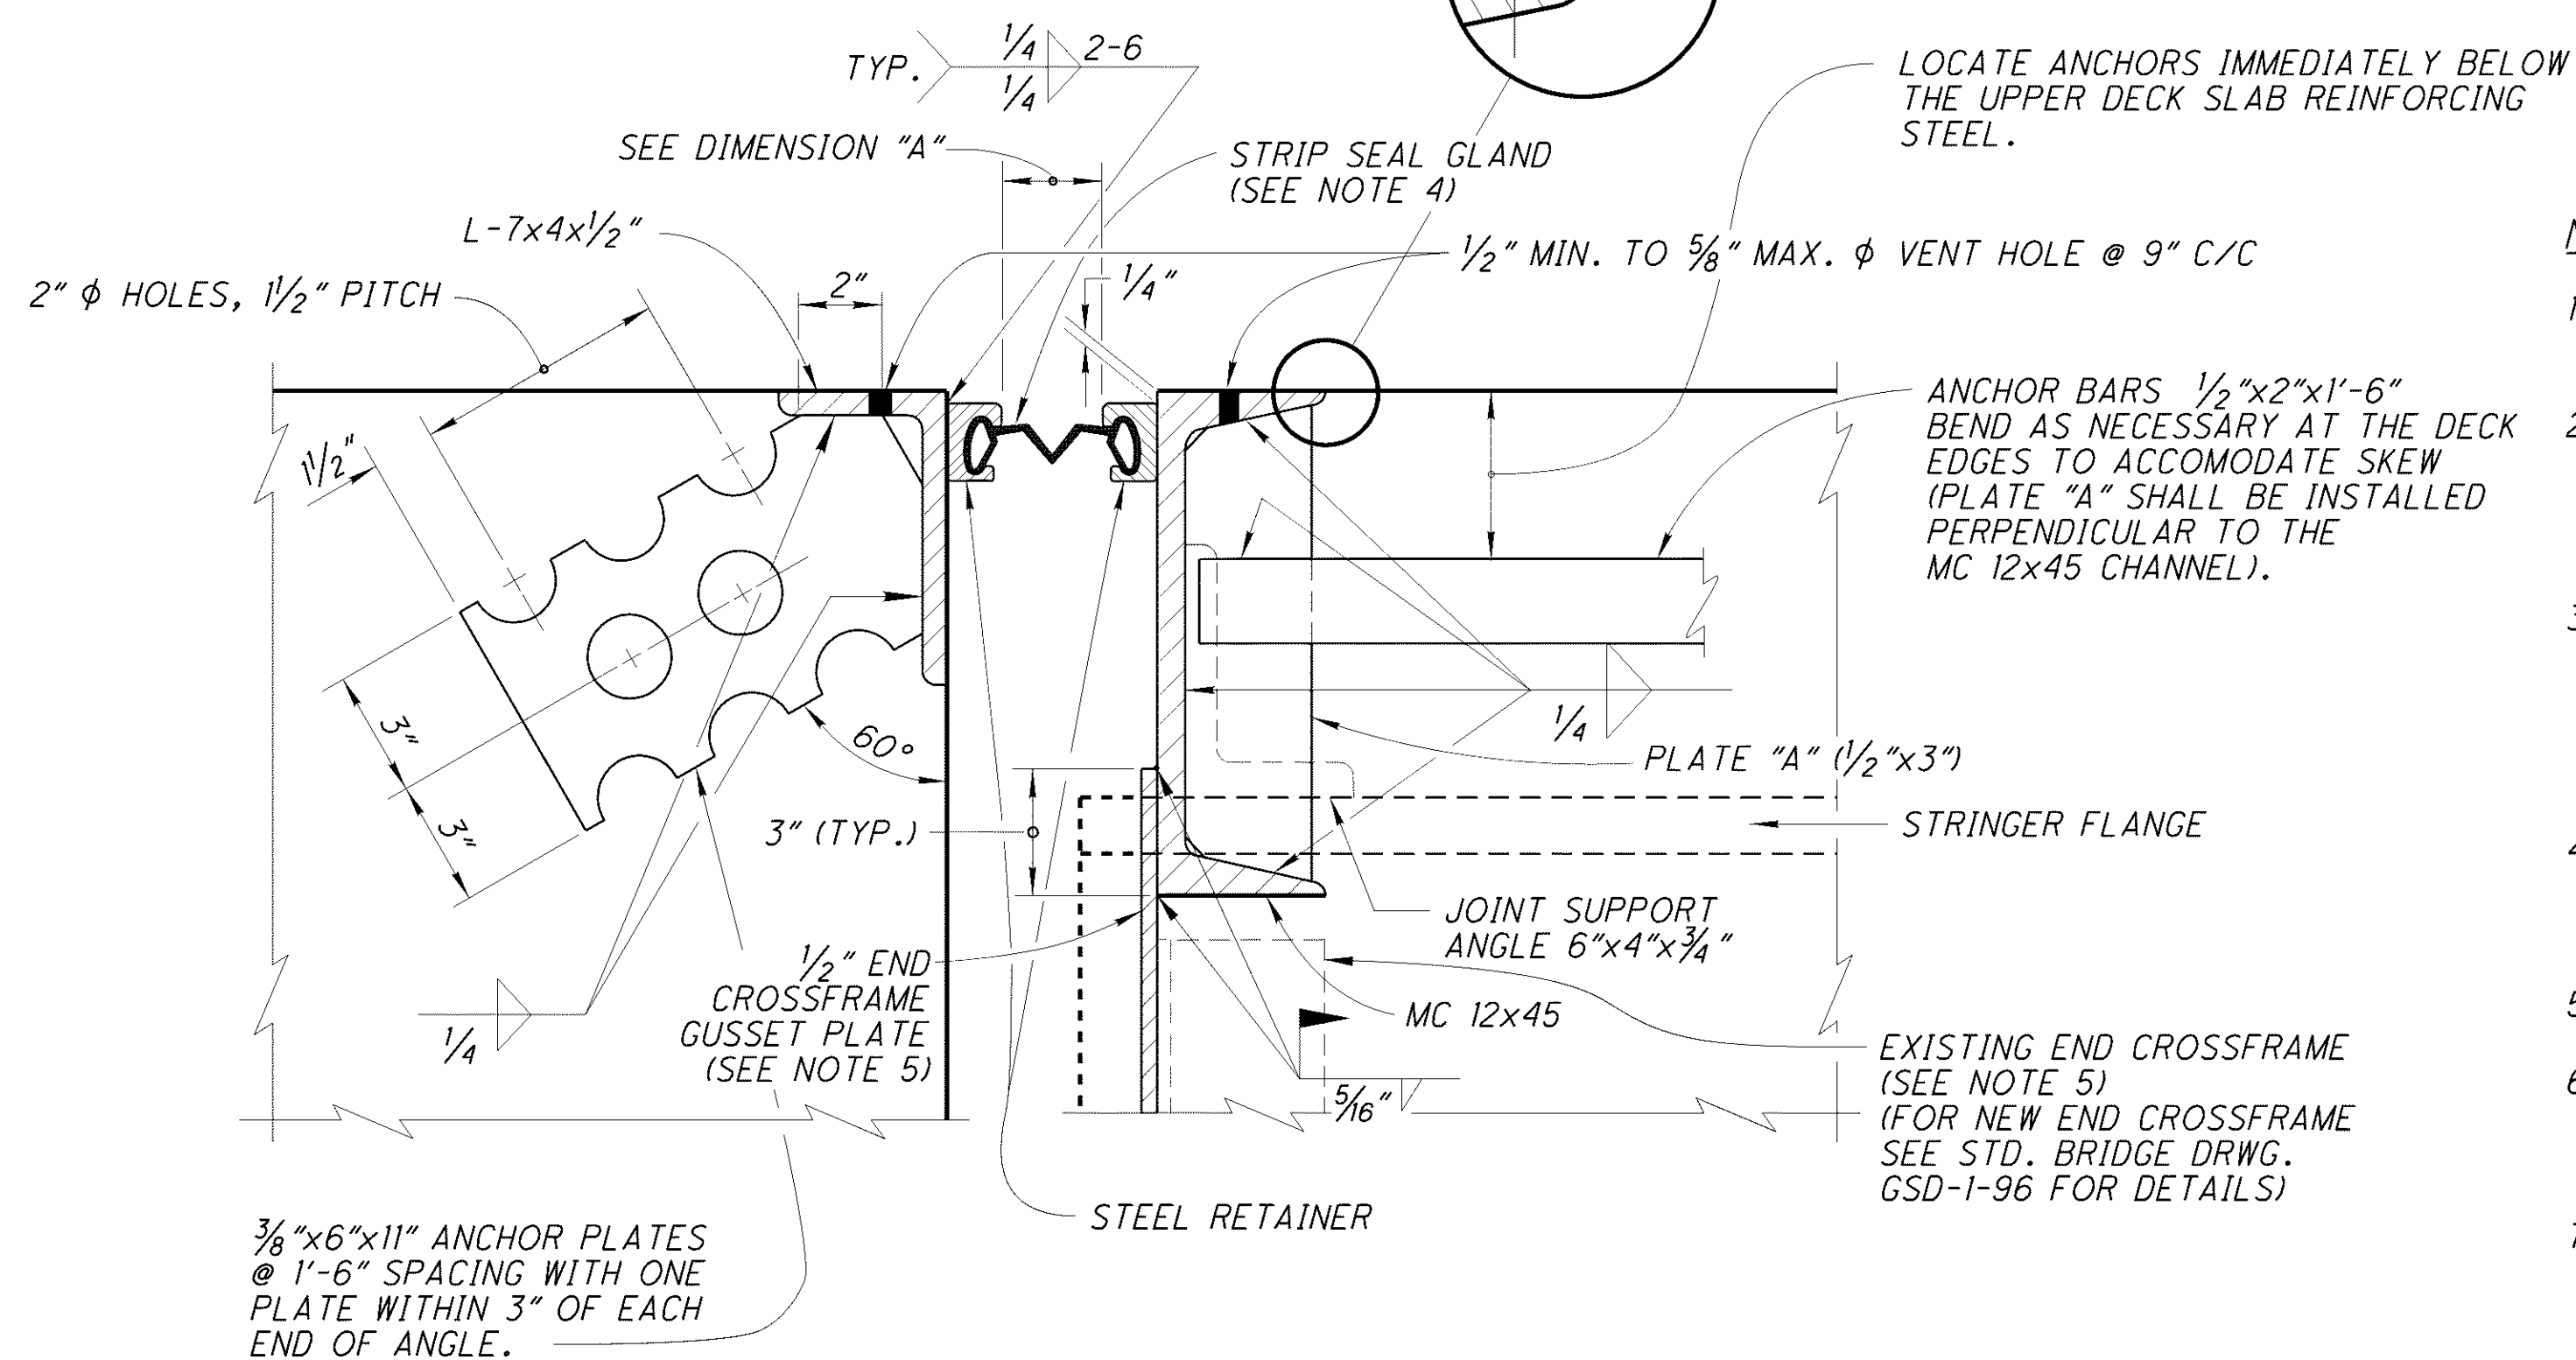
CUY-90-1651L STRIP SEAL JOINT WIDTH	
AMBIENT TEMPERATURE	DIMENSION "A"
	3" SEAL
90° F	1.27"
80° F	1.38"
70° F	1.49"
60° F	1.60"
50° F	1.71"
40° F	1.82"
30° F	1.93"



NOTES:

- FOR ADDITIONAL DETAILS AND NOTES, REFER TO ODOT STANDARD DRAWING EXJ-4-87 SHEETS 1 THRU 5.
- MINIMUM JOINT OPENING (DIMENSION "A") AT THE TIME OF SEAL GLAND INSTALLATION SHALL NOT BE LESS THAN 1 1/2". IF THE JOINT OPENING IS LESS, INSTALLATION SHALL BE POSTPONED UNTIL THE TEMPERATURE DROPS SUFFICIENT AMOUNT TO ALLOW THE MINIMUM 1 1/2" OPENING.
- EXPANSION DEVICE REQUIRES COMPLETE PENETRATION WELDED BUTT JOINTS. BUTT WELDS IN CONTACT WITH THE SEALING GLAND SHALL BE GROUND FLUSH AT THE CONTACT AREA. THE CONSTRUCTION JOINT FOR THE MC 12x45 SHALL NOT BE LOCATED WITHIN THE LIMITS OF THE END CROSSFRAME GUSSET PLATE. RELOCATE THE MC 12x45 CONSTRUCTION JOINT AS NEEDED TO CLEAR THE GUSSET PLATE.
- THE INSTALLATION SEQUENCE OF THE EXPANSION JOINT SHALL FOLLOW THE PHASE CONSTRUCTION DETAIL SEQUENCE. STRIP SEAL GLAND MUST BE INSTALLED IN ONE CONTINUOUS PIECE.
- FOR ADDITIONAL RETROFIT INFORMATION, SEE SHEET 23/38.
- INSTALLATION OF SEAL: DURING INSTALLATION OF THE SUPPORT/ARMOR FOR THE SUPERSTRUCTURE SIDE OF THE EXPANSION JOINT SEAL, OBSERVE THE SEATING OF GIRDERS ON BEARINGS TO ASSURE THAT POSITIVE BEARING IS MAINTAINED.
- FOR ADDITIONAL SEAL ARMOR DIMENSIONS AND ELEVATIONS, SEE ABUTMENTS SHEETS 18/38 AND 19/38.

DESIGNED	RSB	DRAWN	JTW	REVIEWED	JOL	DATE	03-11-11							
	CHECKED		JTW		STRUCTURE FILE NUMBER 1807919/1807900									
CUY-90-14.90		35		BRIDGES				 CLEVELAND AREA RAPID TRANSIT 90	 WALSH CONSTRUCTION	DESIGN AGENCY	HNTB	NO.	REVISIONS	DATE
PID No. 77332 / 85531		38		STRIP SEAL EXPANSION JOINT DETAILS - 1		BRIDGE NO. CUY-77-1597 L AND CUY-90-1651 L I-90WB AND I-77SB RAMP OVER E 14TH STREET								

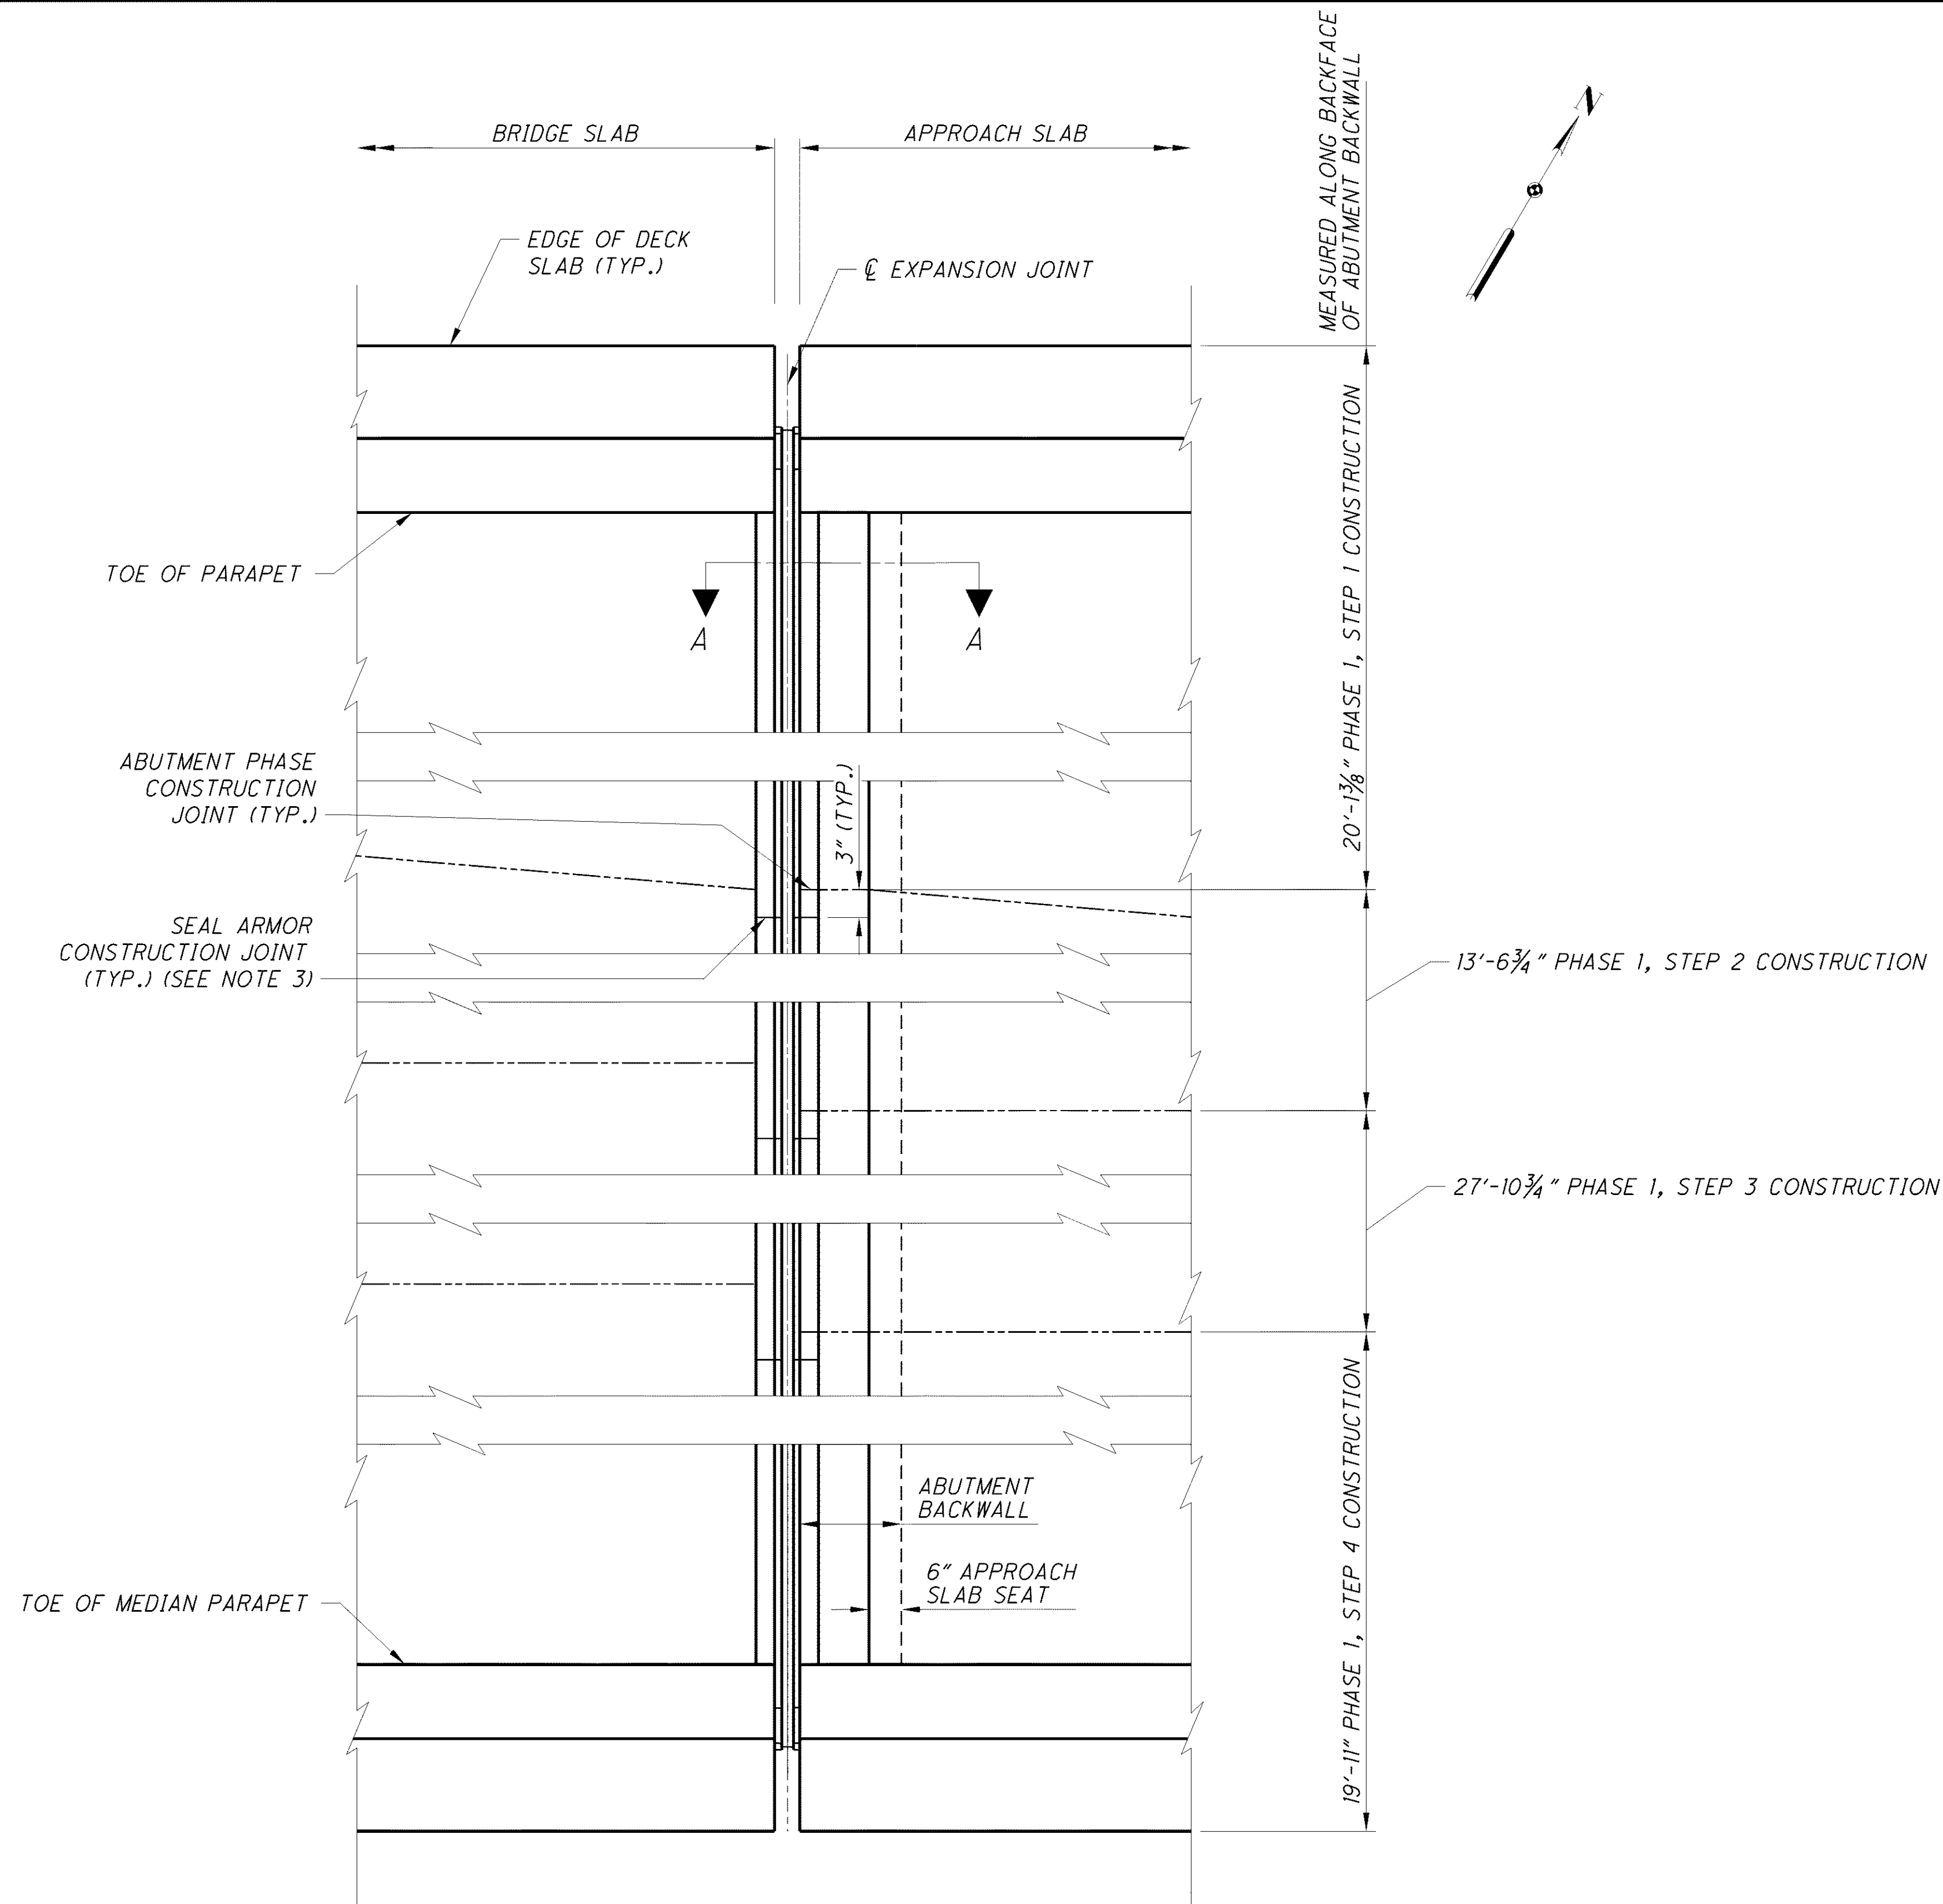














PART PLAN AT FORWARD ABUTMENT BRIDGE CUY-77-1527L AND CUY-90-1651L

STRIP SEAL JOINT WIDTH	
AMBIENT TEMPERATURE	DIMENSION "A"
	3" SEAL
90° F	1.23"
80° F	1.35"
70° F	1.48"
60° F	1.60"
50° F	1.72"
40° F	1.85"
30° F	1.97"

NOTES:

- FOR ADDITIONAL DETAILS AND NOTES, REFER TO ODOT STANDARD DRAWING EXJ-4-87 SHEETS 1 THRU 5.
- MINIMUM JOINT OPENING (DIMENSION "A") AT THE TIME OF SEAL GLAND INSTALLATION SHALL NOT BE LESS THAN 1/2". IF THE JOINT OPENING IS LESS, INSTALLATION SHALL BE POSTPONED UNTIL THE TEMPERATURE DROPS SUFFICIENT AMOUNT TO ALLOW THE MINIMUM 1/2" OPENING.
- EXPANSION DEVICE REQUIRES COMPLETE PENETRATION WELDED BUTT JOINTS. BUTT WELDS IN CONTACT WITH THE SEALING GLAND SHALL BE GROUND FLUSH AT THE CONTACT AREA. THE CONSTRUCTION JOINT FOR THE MC 12x45 SHALL NOT BE LOCATED WITHIN THE LIMITS OF THE END CROSSFRAME GUSSET PLATE. RELOCATE THE MC 12x45 CONSTRUCTION JOINT AS NEEDED TO CLEAR THE GUSSET PLATE.
- THE INSTALLATION SEQUENCE OF THE EXPANSION JOINT SHALL FOLLOW THE PHASE CONSTRUCTION DETAIL SEQUENCE. STRIP SEAL GLAND MUST BE INSTALLED IN ONE CONTINUOUS PIECE.
- FOR SECTION A-A, SEE SHEET 35/38 .
- INSTALLATION OF SEAL: DURING INSTALLATION OF THE SUPPORT/ARMOR FOR THE SUPERSTRUCTURE SIDE OF THE EXPANSION JOINT SEAL, OBSERVE THE SEATING OF GIRDERS ON BEARINGS TO ASSURE THAT POSITIVE BEARING IS MAINTAINED.
- FOR ADDITIONAL SEAL ARMOR DIMENSIONS AND ELEVATIONS, SEE ABUTMENT SHEETS 18/38 AND 19/38 .

DESIGNED PSB	DRAWN JTW	REVIEWED JOL	DATE 03-11-11	BRIDGES 10 & 11	DESIGN AGENCY WALSH HNTB WALSH CONSTRUCTION	NO.	REVISIONS RECORD DRAWINGS	DATE 03-14-11
CHECKED JTW	CHECKED NJ	STRUCTURE FILE NUMBER 1807919/1807900						
CUY-90-14.90 PID No. 77332 / 85531				STRIP SEAL EXPANSION JOINT DETAILS - 2 BRIDGE NO. CUY-77-1597 L AND CUY-90-1651 L I-90WB AND I-77SB RAMP OVER E 14TH STREET				
36/38								

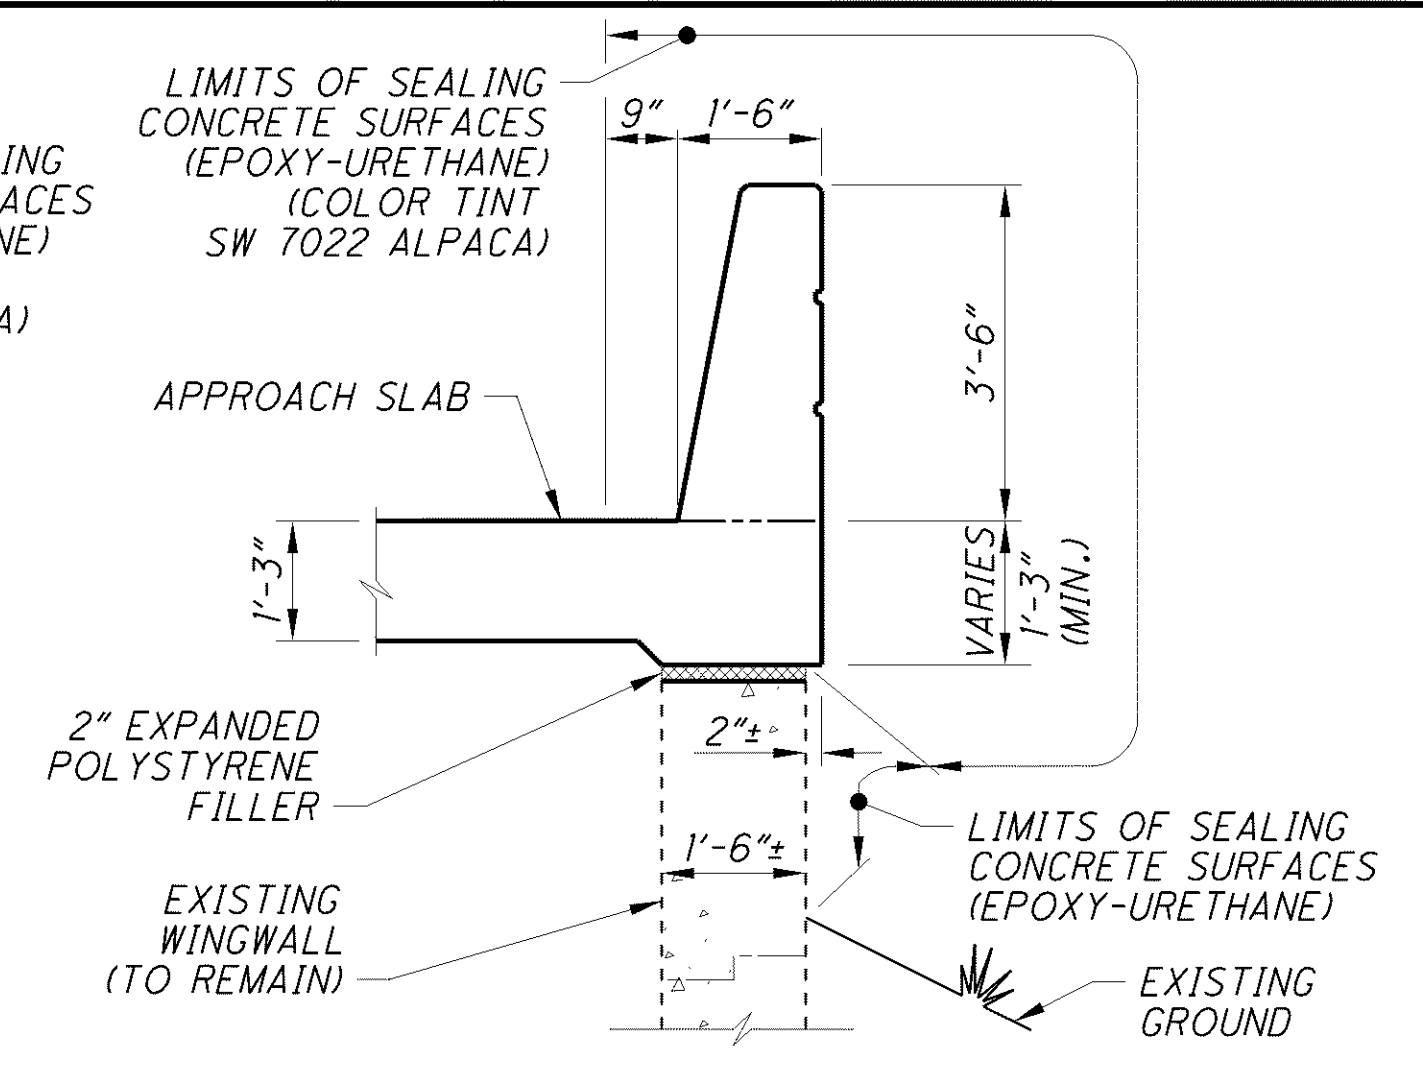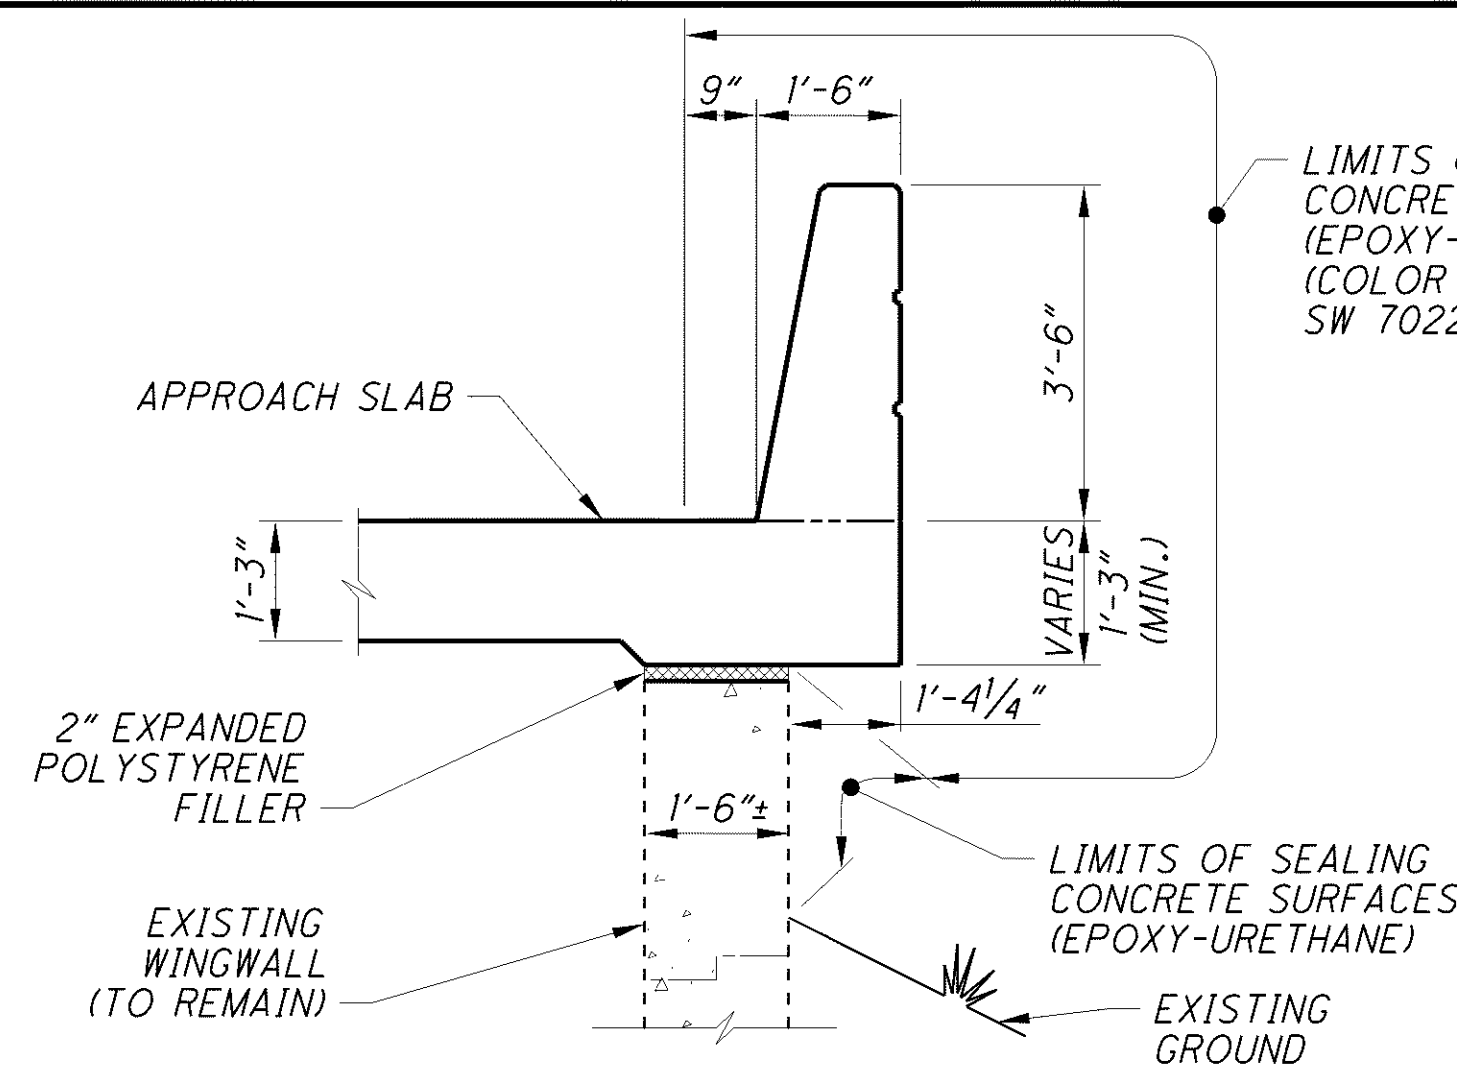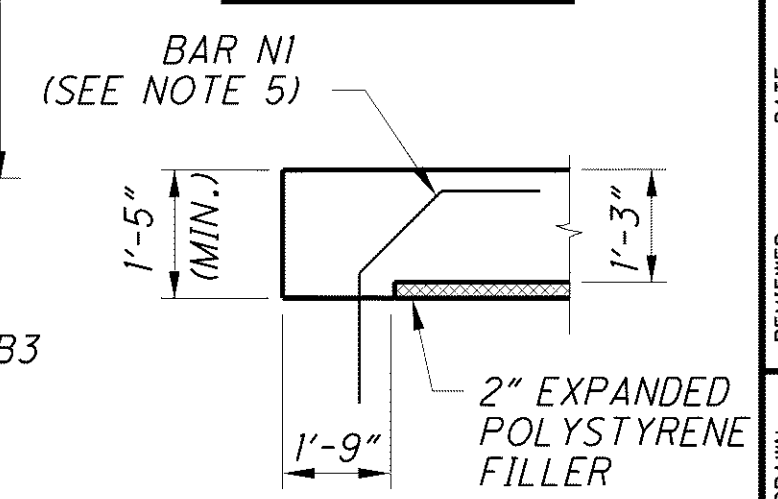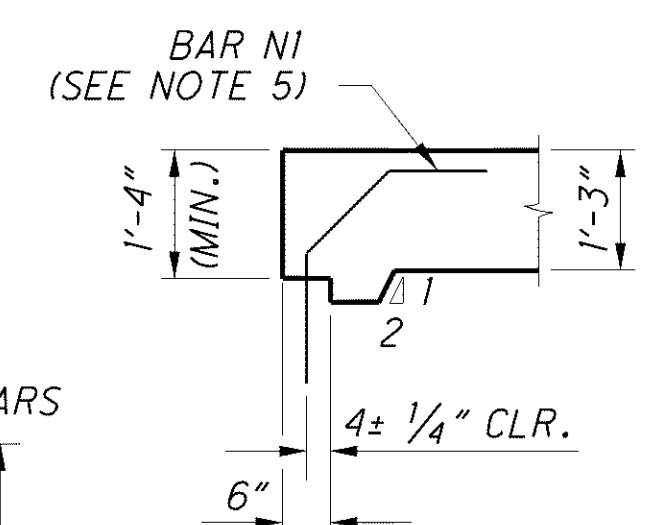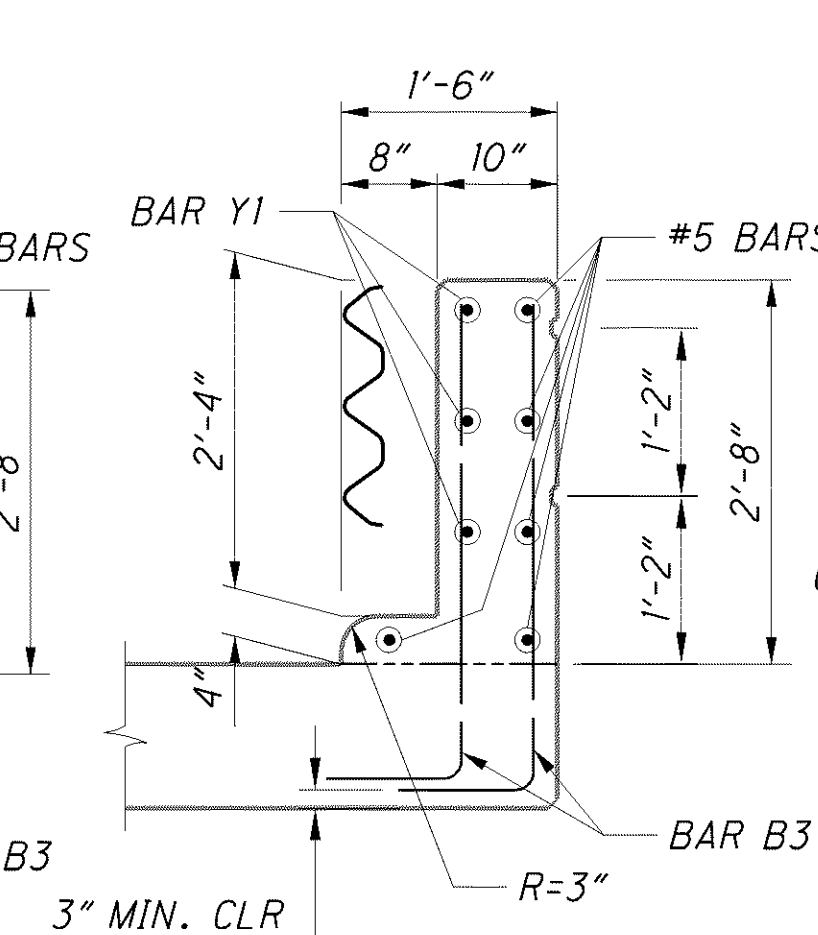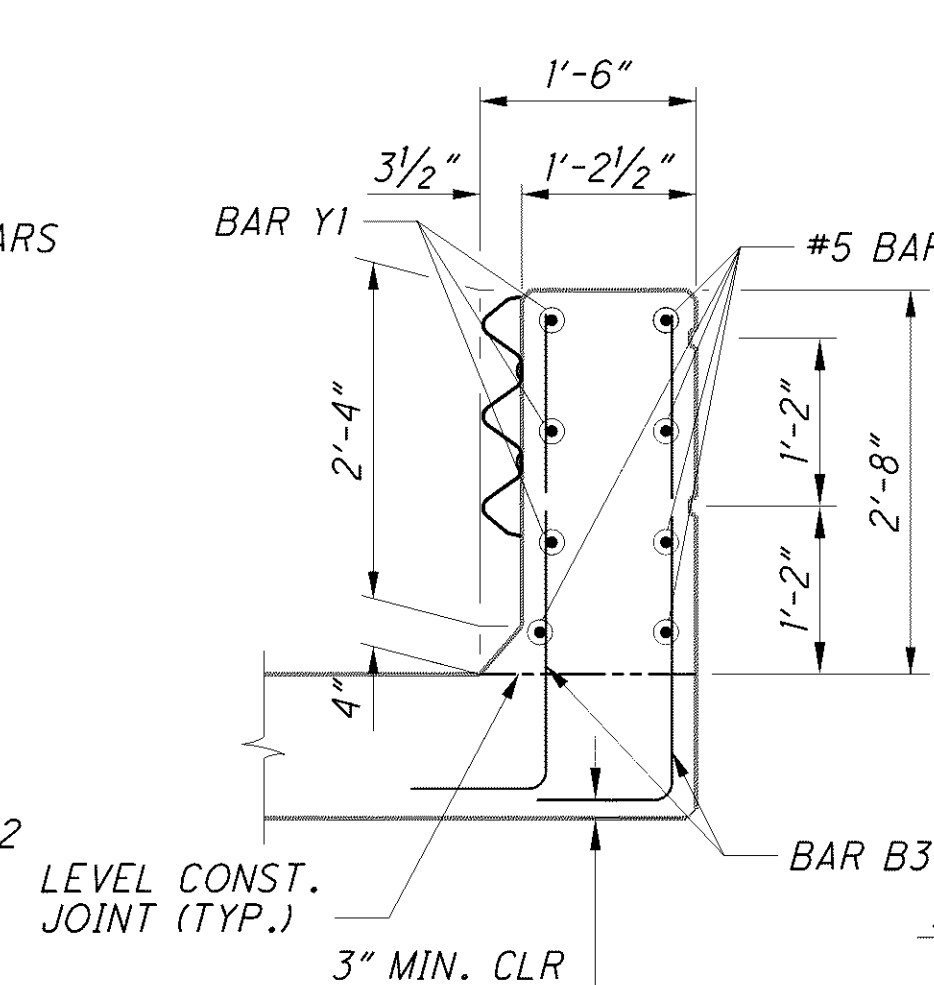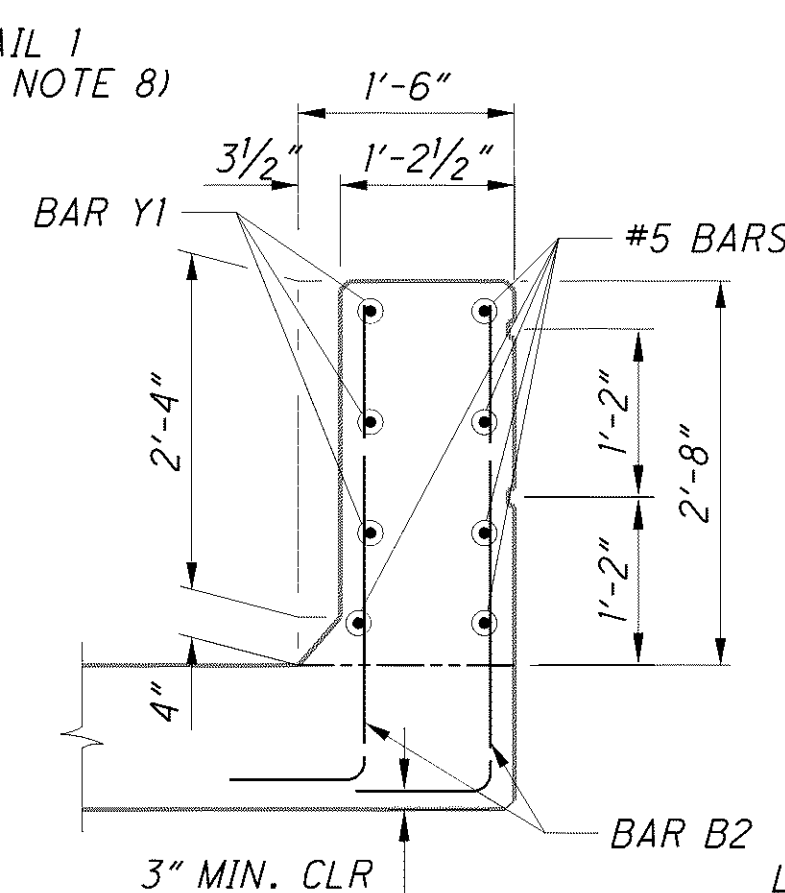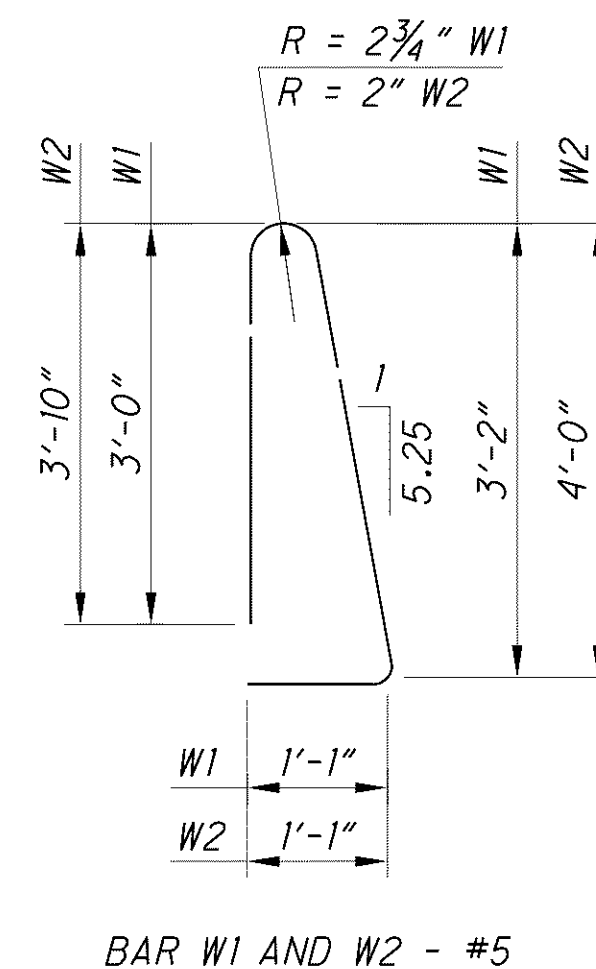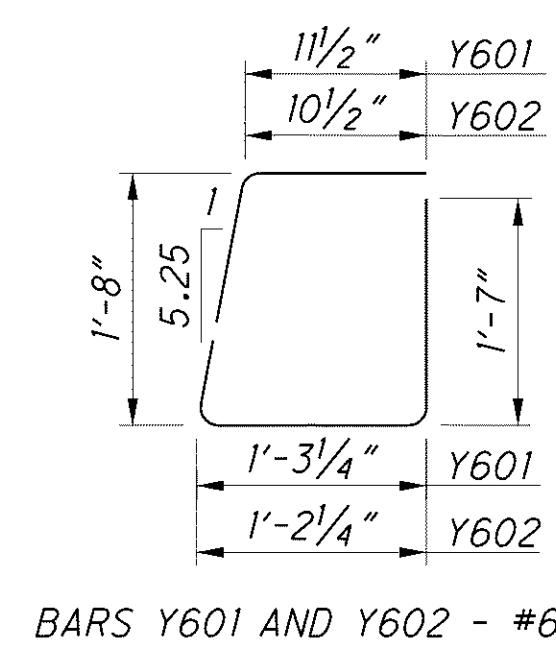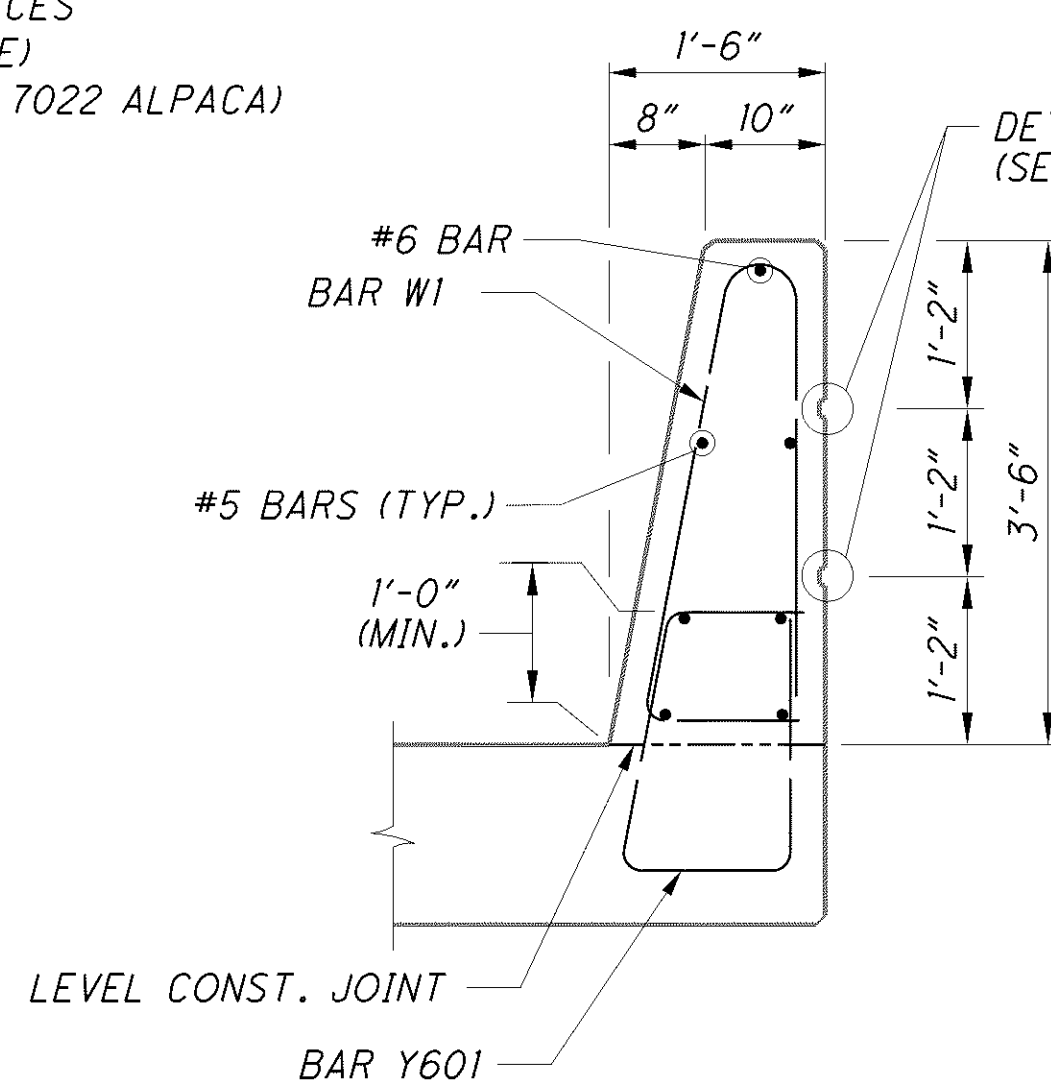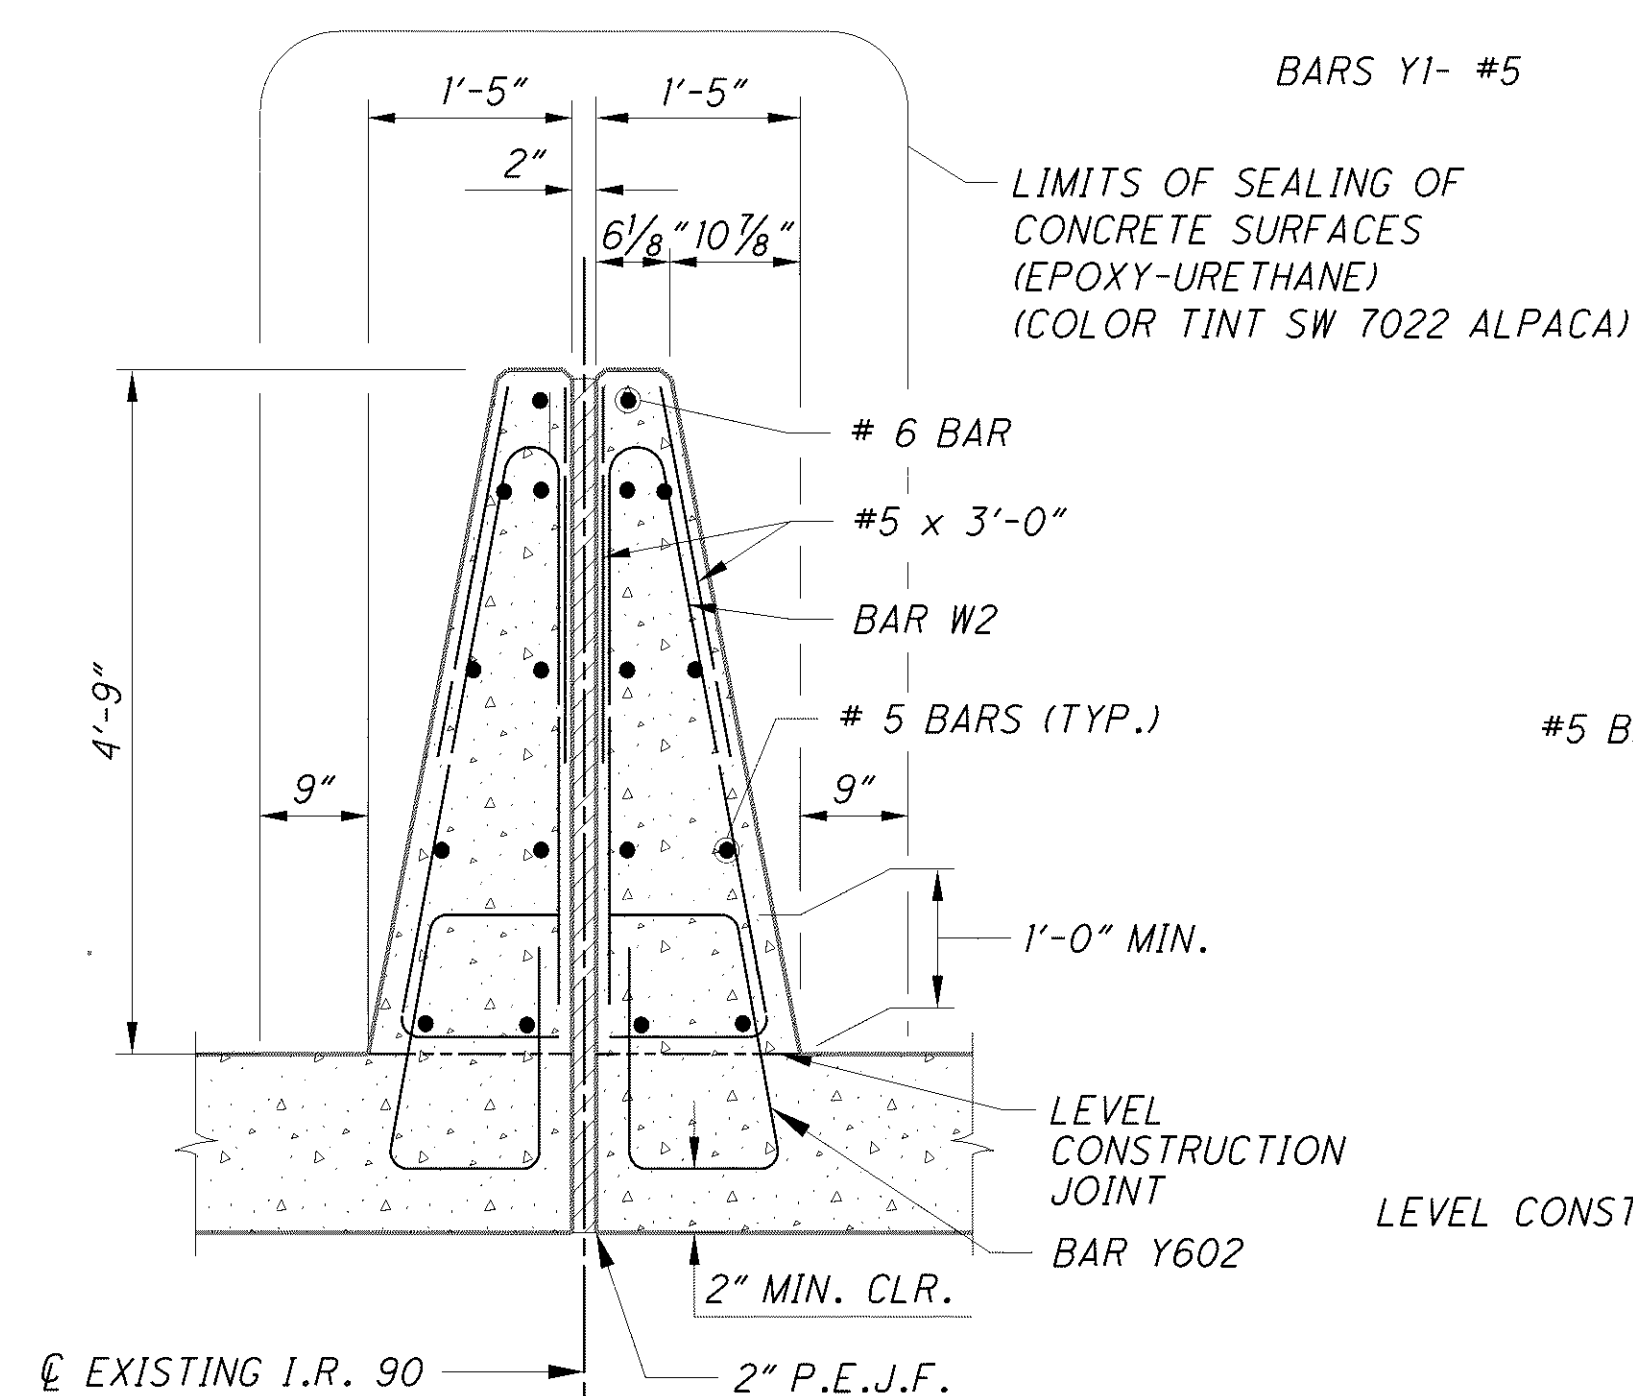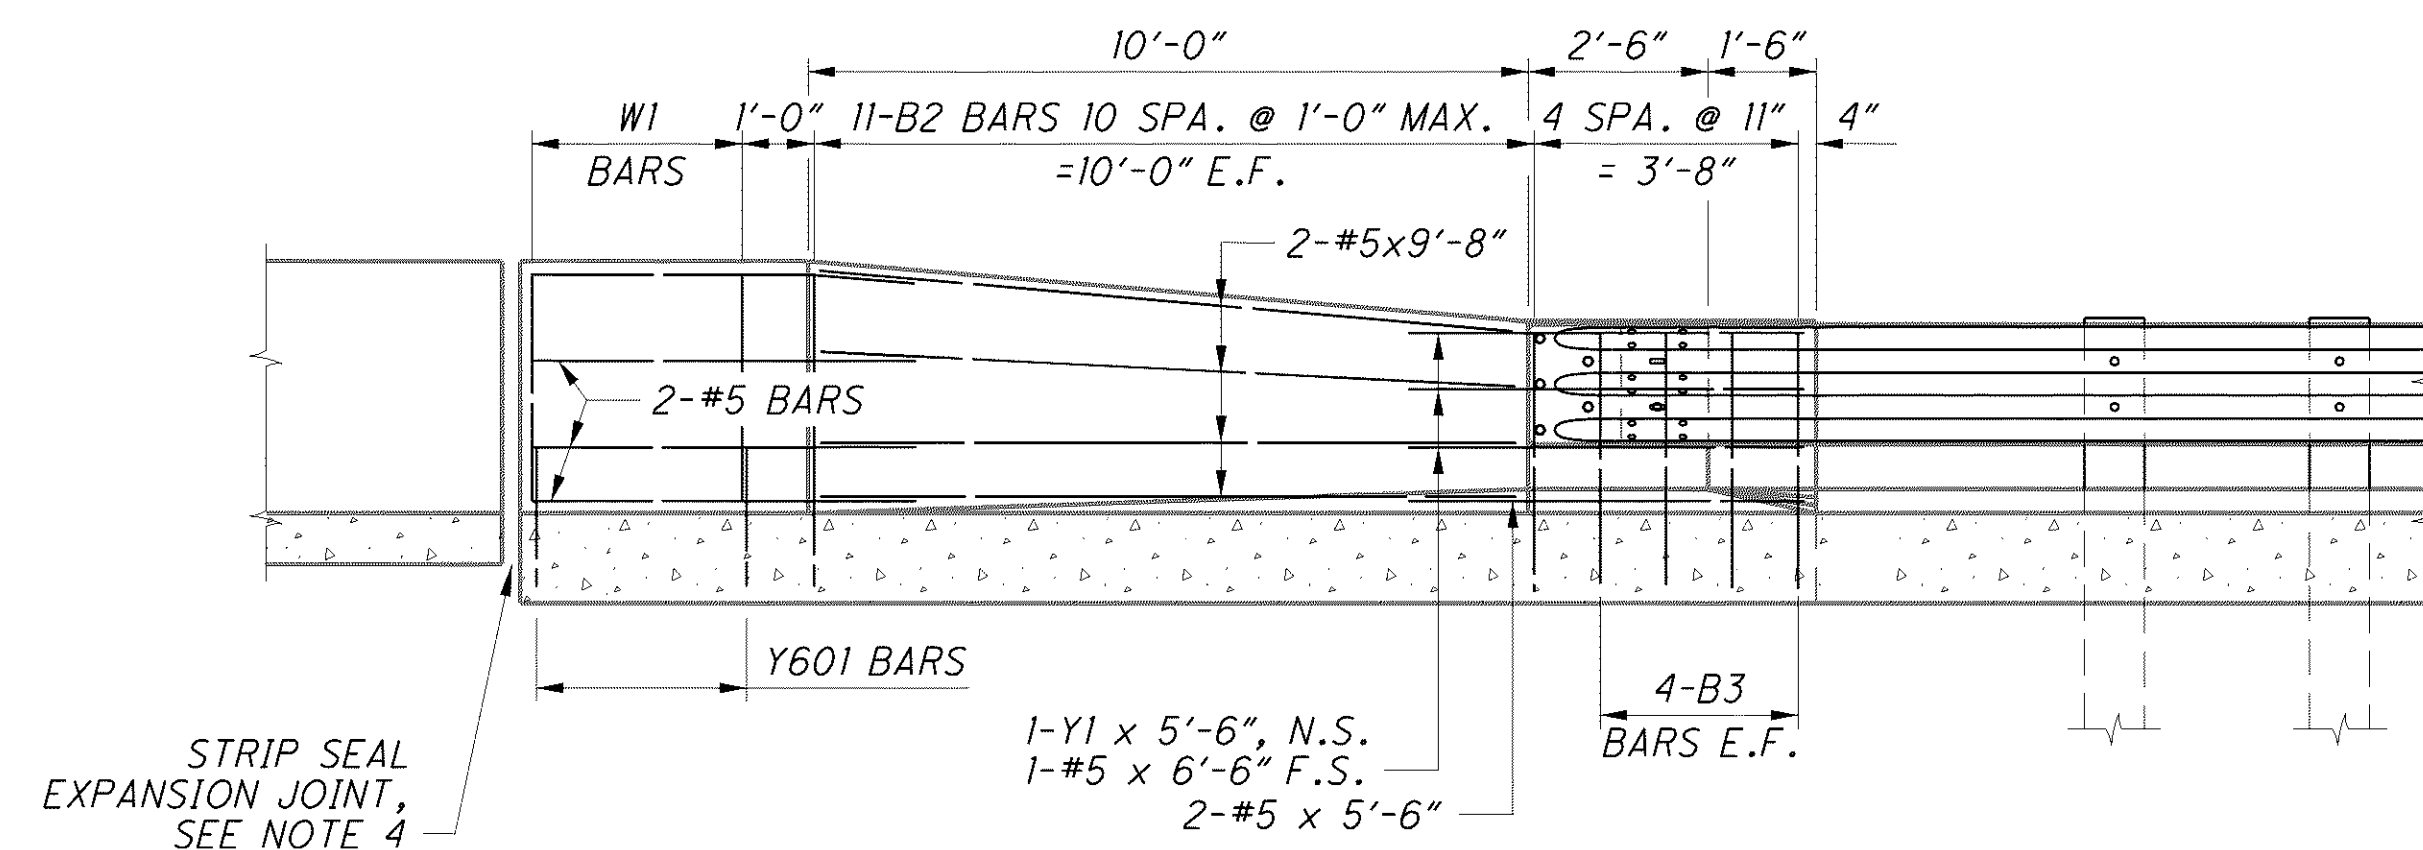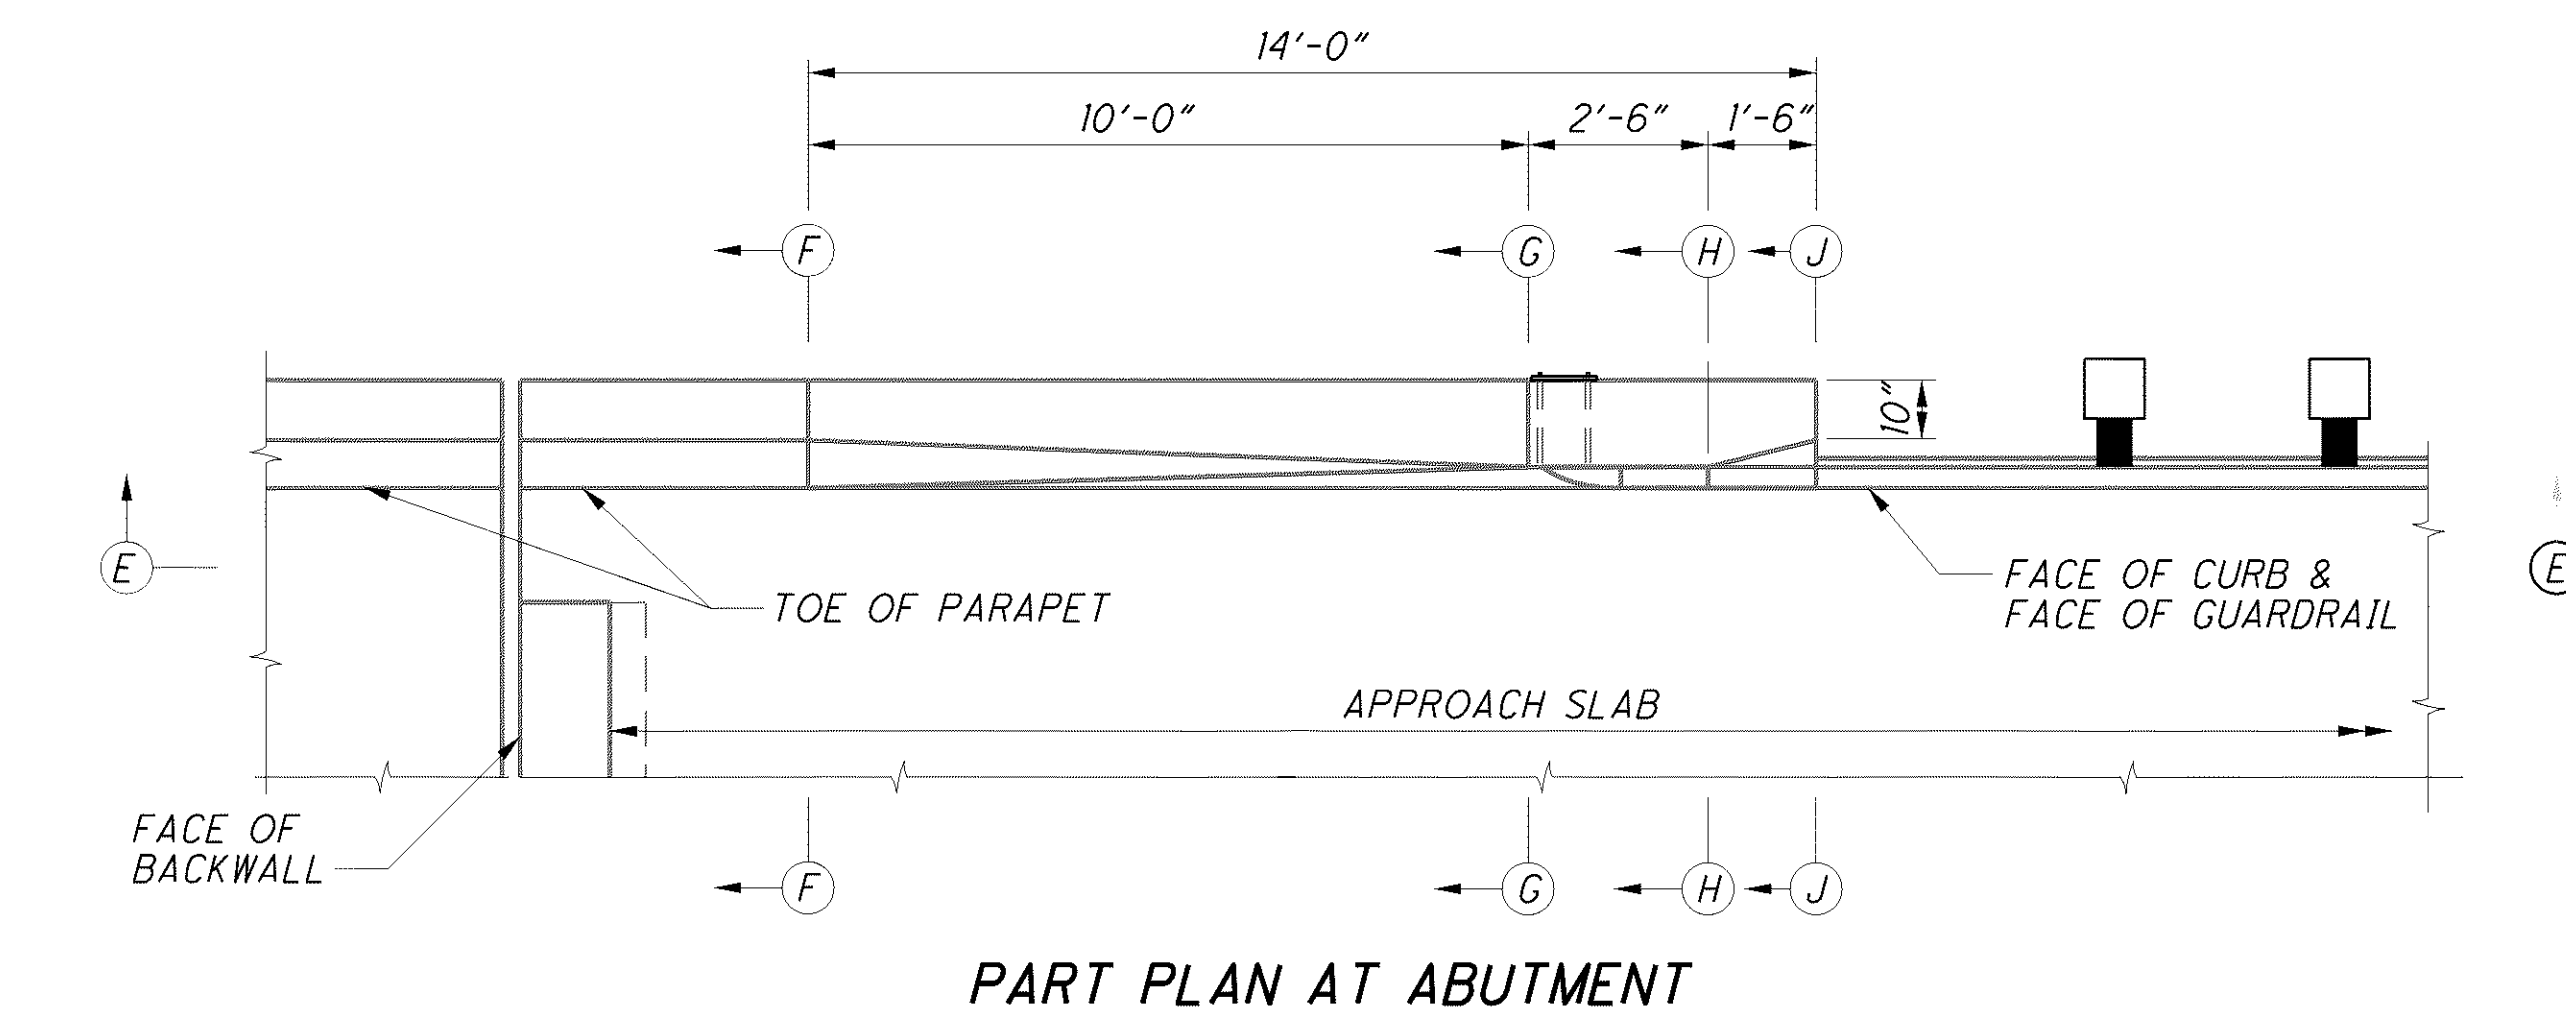

- NOTES:

1. FOR ADDITIONAL APPROACH SLAB DETAILS, SEE ODOT STD. DRAWING AS-1-81.
2. FOR ADDITIONAL PARAPET DETAILS, SEE ODOT STD. DRAWING SBR-1-99.
3. FOR LOCATIONS OF SECTIONS A-A THRU D-D, SEE SHEET 37/38.
4. FOR ADDITIONAL STRIP SEAL EXPANSION JOINT DETAILS, SEE SHEET 35/38 AND 36/38.
5. FOR SPACING AND PLACEMENT OF NI BARS, SEE SHEETS 18/38 THRU 19/38.
6. ALL REINFORCING STEEL SHALL BE EPOXY COATED AND PER CMS 509.
7. FOR ADDITIONAL GUARDRAIL TERMINAL ASSEMBLY DETAILS, SEE ODOT STANDARD DRAWING GR-3.1 AND GR-3.2.
8. FOR DETAIL 1, SEE SHEET 27/38.