STATE OF OHIO DEPARTMENT OF TRANSPORTATION D01-BM-FY22

ALLEN, HANCOCK, PAULDING, PUTNAM, VAN WERT AND WYANDOT COUNTIES

BOWLING GREEN 2 He 2 49 613 LEIPSIC 613 613 634 587 FINDLAY. 694 114 224 BLUFFTON 103 117

INDEX OF SHEETS:

| TITLE SHEET | 1 |
|---------------------------------|--------------------|
| GENERAL NOTES | 2 |
| MAINTENANCE OF TRAFFIC NOTES | 3-5 |
| GENERAL SUMMARY | 6-7 |
| STRUCTURE GENERAL NOTES | 8,8A_ |
| STRUCTURE ESTIMATED QUANTITIES | 9 |
| STRUCTURE MISCELLANEOUS DETAILS | 10-13,13A |
| | - e - (- <u>v</u> |

PROJECT LOCATIONS:

| 1 | ALL-30-2.42 L&R | OVER AUGLIZE RIVER |
|-----------|------------------|---------------------------------|
| 2 | ALL-30-7.03 L&R | OVER OTTAWA RIVER |
| 3 | VAN-30-19.96 R | US 30 OVER CR 173 |
| 4 | PAU-637-0.22 | OVER MADDOX CREEK |
| 5 | WYA-23-7.67 L&R | OVER SANDUSKY RIVER |
| 6 | WYA-23-10.17 L&R | OVER CF&E/CSX RR |
| 7 | HAN-75-6.33 | CR 12 OVER IR 75 |
| 8 | PUT-12-3.70 | OVER PLUM CREEK |
| 9 | PUT-634-10.27 | OVER AUGLAIZE RIVER |
| 10 | VAN-30-15.81 | TR 127/GILLILAND RD. OVER US 30 |
| Y1 | VXN-30-12.X6 RX | OVER YOWN CREEK & CPE RRY |
| 12 | VAN-33-1.64 | OVER CLOUSE DITCH |

DESIGN EXCEPTIONS

NONE REQUIRED

ADA DESIGN WAIVERS

NONE REQUIRED

FEDERAL PROJECT NUMBER

NON-FEDERAL

RAILROAD INVOLVEMENT

NONE

PROJECT DESCRIPTION

PERFORM MISCELLANEOUS BRIDGE MAINTENANCE ACTIVITIES (APPROACH SLAB REPLACEMENTS, JOINT REPLACEMENTS, PATCHING & ETC.) ON VARIOUS BRIDGES IN DISTRICT 1.

EARTH DISTURBED AREAS

PROJECT EARTH DISTURBED AREA: 0.5 ACRES
ESTIMATED CONTRACTOR EARTH DISTURBED AREA: 0.2 ACRES
NOTICE OF INTENT EARTH DISTUR 3ED AREA: N/A (NOI NOT REQUIRED)*
*ROUTINE MAINTENANCE PROJECT

2019 SPECIFICATIONS

THE STANDARD SPECIFICATIONS OF THE STATE OF OHIO, DEPARTMENT OF TRANSPORTATION, INCLUDING SUPPLEMENTAL SPECIFICATIONS LISTED IN THE PLANS AND CHANGES LISTED IN THE PROPOSAL SHALL GOVERN THIS IMPROVEMENT.

LIMITED ACCESS

THIS IMPROVEMENT IS ESPECIALLY DESIGNED FOR THROUGH TRAFFIC AND HAS BEEN DECLARED A LIMITED ACCESS HIGHWAY, OR FREEWAY, BY ACTION OF THE DIRECTOR IN ACCORDANCE WITH THE PROVISIONS OF SECTION 5511.02 OF THE OHIO REVISED CODE.

I HEREBY APPROVE THESE PLAND AND DECLARE THAT THE MAKING OF THIS IMPROVEMENT WILL NOT REQUIRE THE CLOSING TO TRAFFIC OF THE HIGHWAY AND THAT PROVISIONS FOR THE MAINTENANCE AND SAFETY OF TRAFFIC WILL BE AS SET FORTH ON THE PLANS AND ESTIMATES.

PROJECT LOCATIONS

| UNDERG | ROU | ND L | JTI | LIT | IES |
|---------|--------------|---------------------------|-----|-----|-----|
| Contact | Two | | ing | | |
| | OHIO OHIO | 0 8 11 fore You | "Or | g | |

LOCATION MAP LATITUDE: 40°46'18.00" LONGITUDE: 84°05'34.00"

OHIO811, 8-1-1, or 1-800-362-2764 (Non members must be called directly)

PLAN PREPARED BY:
OHIO DEPT. OF TRANSPORTATION, DISTRICT 1
1885 N. MCCULLOUGH ST.
LIMA, OHIO 45801

| | | Ċ. | STA | ANDARD | CONST | RUCTION | DRAWINGS | | SUPPLEMENTAL SPECIFICATIONS | |
|--------------------------------------------------------------------------------------------------------------------------------------------------------------------------------------------------------------------------------------------------------------------------------------------------------------------------------------------------------------------------------------------------------------------------------------------------------------------------------------------------------------------------------------------------------------------------------------------------------------------------------------------------------------------------------------------------------------------------------------------------------------------------------------------------------------------------------------------------------------------------------------------------------------------------------------------------------------------------------------------------------------------------------------------------------------------------------------------------------------------------------------------------------------------------------------------------------------------------------------------------------------------------------------------------------------------------------------------------------------------------------------------------------------------------------------------------------------------------------------------------------------------------------------------------------------------------------------------------------------------------------------------------------------------------------------------------------------------------------------------------------------------------------------------------------------------------------------------------------------------------------------------------------------------------------------------------------------------------------------------------------------------------------------------------------------------------------------------------------------------------------|----------|---------|-----------|----------|----------|---------|------------------------------------------|-------------------------------------------|---------------------------------------|-----------------|
| ENGINEER'S SEAL: | MT-95.30 | 7/19/19 | BP-2.1 | 1/21/22 | DM-4.2 | 7/20/12 | | | 800-2019 1/21/22 | ASBESTOS SURVEY |
| ENGINEER O OE/IE: | MT-95.40 | 1/17/20 | BP-2.3 | 7/18/14 | | | | | 821 4/20/12 | D01-BM-FY 22 |
| | MT-95.45 | 1/17/20 | BP-2.4 | 7/19/13 | AS-1-15 | 7/17/15 | | | 832 10/19/18 | PID 102814 |
| | MT-95.50 | 7/21/17 | BP-9.1 | 1/18/19 | AS-2-15 | 1/18/19 | | | 843 10/18/1 | DATED: 7/13/21 |
| (SEOFO) | | | A. * | | EXJ-4-87 | 1/19/18 | | x 1 12 12 12 12 12 12 12 12 12 12 12 12 1 | 846 4/17/15 | 6 X 1 1 |
| A Principal of the Control of the Co | MT-96.11 | 4/16/21 | DM-4.3 | 1/15/16 | PCB-91 | 7/17/20 | | | 856 1/21/22 | |
| /0)/ J. \O\ | MT-96.20 | 7/15/16 | DM-4.4 | 1/15/16 | DS-1-92 | 7/18/03 | | | 921 4/20/12 | |
| Scheckelhoff Scheckelhoff E-63356 Q Q | MT-96.26 | 1/18/19 | | 5 5 5 | | | ** * * * * * * * * * * * * * * * * * * * | | 961 4/17/20 | 8 2 X C 2 |
| DA E-63356 O | MT-97.10 | 4/19/19 | MT-101.90 | 7/17/20 | | | | , 0 | , , , , , , , , , , , , , , , , , , , | |
| OR O'STER HE | | | MT-105.10 | 1/17/20 | | | | | | |
| | MT-98.10 | 1/17/20 | TC-41.20 | 10/18/13 | | | * . * . | | | |
| 11111111 | MT-98.11 | 1/17/20 | TC-42.20 | 10/18/13 | | | | | | |
| 0 111 1111 | MT-98.20 | 4/19/19 | TC-52.10 | 10/18/13 | | | | | | |
| SIGNED: Ein / Adusbelloff | MT-98.22 | 1/17/20 | TC-52.20 | 1/15/21 | | | | | | |
| DATE: 4/7/2022 | MT-98.28 | 1/17/20 | TC-64.10 | 7/16/21 | | | | | | |

APPROVED Christisher Of Hugher

DATE 04/07/2022 DISTRICT DEPUTY DIRECTOR

APPROVED _____

___ DIRECTOR, DEPARTMENT OF TRANSPORTATION

DESIGNER EJS REVIEWER

ROJECT ID 102814

MJM

7x11 (in.) DATE: 4/6/2022 TIME: 3:09:59 PN liodot-pw-02\Documents\01 Active Projects\Dis

D01-BM-FY22

UTILITIES

THERE ARE NO UNDERGROUND UTILITIES SHOWN ON THIS PLAN.
THE NATURE OF THE WORK REQUIRED BY THIS PROJECT WILL
NOT AFFECT ANY KNOWN UNDERGROUND UTILITIES THAT EXIST
UNDER, OR ADJACENT TO, THE WORK AREA.

EXISTING PLANS

EXISTING PLANS FOR THE VARIOUS LOCATIONS MAY BE INSPECTED IN THE ODOT DISTRICT ONE OFFICE IN LIMA. OHIO.

CLEARING AND GRUBBING

ALTHOUGH THERE ARE NO TREES OR STUMPS SPECIFICALLY MARKED FOR REMOVAL WITHIN THE LIMITS OF THE PROJECT, A LUMP SUM QUANTITY IS INCLUDED IN THE GENERAL SUMMARY FOR ITEM 201, CLEARING AND GRUBBING. ALL PROVISIONS AS SET FORTH IN THE SPECIFICATIONS UNDER THIS ITEM ARE INCLUDED IN THE LUMP SUM PRICE BID FOR ITEM 201, CLEARING AND GRUBBING.

ITEM 251 - PARTIAL DEPTH PAVEMENT REPAIR (442)

A QUANTITY OF THIS ITEM SHALL BE PROVIDED FOR USE AS DIRECTED BY THE ENGINEER. THE ITEM SHALL CONSIST OF RE-PAIRING EXISTING LOCATIONS EXHIBITING SURFACE DETERIORATION ADJACENT TO THE APPROACH SLABS BEING REPLACED AND PLACING ITEM 442 ASPHALT CONCRETE SURFACE COURSE, 12.5 mm, TYPE A or B, (448). IN ADDITION, THIS ITEM SHALL BE USED TO PROVIDE A SMOOTH TRANSITION INTO THE NEW APPROACH SLABS AS DIRECTED BY THE ENGINEER. FOR PLACEMENT OF ITEM 442. A PG64-22 BINDER IS REQUIRED. AND IT SHALL BE PLACED IN TWO ONE AND HALF INCH LIFT THICKNESS. IT IS NOT THE INTENT TO REPAIR EVERY DETERIORATED AREA WITHIN THE PROJECT. THE ENGINEER SHALL DETERMINE WHICH AREAS ARE TO BE REPAIRED. UNLESS OTHERWISE DIRECTED BY THE ENGINEER, THIS ITEM SHALL BE PERFORMED AFTER THE COMPLETION OF THE ABUTTING APPROACH SLAB REPLACEMENT WORK, AND THIS ITEM SHALL COMMENCE WITHIN 7 DAYS OF THE COMPLETION OF THE APPROACH SLABS. PAYMENT SHALL BE BASED ON THE ACTUAL NUMBER OF SQUARE YARDS OF SURFACE PAVEMENT REPAIR. THE FOLLOWING ESTIMATED QUANTITY HAS BEEN CARRIED TO THE GENERAL SUMMARY:

ITEM 251, PARTIAL DEPTH PAVEMENT REPAIR (442), 2,8000 SQ. YD.

EROSION CONTROL

THE QUANTITY BELOW HAS BEEN CARRIED TO THE GENERAL SUMMARY FOR EROSION CONTROL.

ITEM 832 EROSION CONTROL 2,000 EACH

ITEM 642 - EDGE LINE, 6", TYPE 1 & ITEM 642 - LANE LINE, 6", TYE 1

THE QUANTITIES BELOW HAVE BEEN CARRIED TO THE GENERAL SUM-MARY FOR PLACEMENT OF LANE AND EDGE LINES ON THE RECON-STRUCTED APPROACH SLABS AT VARIOUS BRIDGES.

ITEM 642, EDGE LINE, 6", TYPE 1 0.14 MILE ITEM 642, LANE LINE, 6", TYPE 1 0.94 MILE

ITEM 253 - PAVEMENT REPAIR

A QUANTITY OF THIS ITEM SHALL BE PROVIDED FOR USE AS DIRECTED BY THE ENGINEER. THIS ITEM SHALL CONSIST OF CUTTING AND REMOVING DETERIORATED PAVEMENT FULL DEPTH ADJACENT TO THE APPROACH SLABS BEING REPLACED AT VARIOUS BRIDGES AND PLACING 12" 301 ASPHALT CONCRETE BASE, PG64-22. THE MAXIMUM COMPACTED DEPTH OF ANY ONE LAYER SHALL BE 6 INCHES. THE FULL DEPTH PAVEMENT REPAIRS SHALL HAVE A SURFACE COURSE APPLIED PER THE NOTE AND REQUIREMENTS FOR ITEM 251, PARTIAL DEPTH PAVEMENT REPAIR (442). PAYMENT FOR THE SURFACE COURSE SHALL BE INCLUDED WITH ITEM 251. UNLESS OTHERWISE DIRECTED BY THE ENGINEER, THIS ITEM SHALL BE PERFORMED AFTER THE COMPLETION OF THE ABUTTING APPROACH SLABS REPLACEMENT WORK, AND THIS ITEM SHALL COMMENCE WITHIN 7 DAYS OF THE COMPLETION OF THE APPROACH SLABS.

IT IS NOT THE INTENT TO REPAIR EVERY DETERIORATED AREA WITHIN THE PROJECT. THE ENGINEER SHALL DETERMINE WHICH AREAS ARE TO BE REPAIRED.

PAYMENT SHALL BE BASED ON THE ACTUAL NUMBER OF SQUARE YARDS OF SURFACE PAVEMENT REPAIR. THE FOLLOWING ESTIMATED QUANTITY HAS BEEN CARRIED TO THE GENERAL SUMMARY.

ITEM 253, PAVEMENT REPAIR, 1,300 SQ. YD.

CONTACT INFORMATION

THE CONTRACTOR SHALL NOT PERFORM CONTRACT WORK IN ANY COUNTY LINTIL AFTER CONTACTING THE COUNTY MANAGER AND PROJECT ENGINEER. BELOW IS A CONTACT LIST FOR COUNTY MANAGERS

| | ALLEN | | |
|---------------|----------------------|----------------|----------------|
| Contact | Title | Office # | Cell # |
| Jason Hoschak | Trans. Administrator | (419) 999-6711 | (419) 438-4615 |
| Andrew Wita | Trans. Manager | (419) 999-6712 | (419) 234-5377 |
| Brian Rader | Trans. Manager | (419) 999-6717 | (567) 204-3683 |

| <u>HANCOCK</u> | | | | | |
|----------------|----------------------|----------------|----------------|--|--|
| Contact | Title | Office # | Cell # | | |
| Deidra Noel | Trans. Administrator | (419) 999-6731 | (419) 772-4420 | | |
| James Heacock | Trans. Manager | (419) 999-6738 | (419) 306-1428 | | |
| Matthew Clay | Trans. Manager | (419) 999-6732 | (419) 306-5199 | | |

| <u>PAULDING</u> | | | | |
|-----------------|----------------------|----------------|----------------|--|
| Contact | Title | Office # | Cell # | |
| Ross Laukhuf | Trans. Administrator | (419) 999-6751 | (419) 769-0132 | |
| Sam Gonzales | Trans. Manager | (419) 999-6754 | (419) 796-9526 | |
| Alexandra Brown | Trans, Manager | (419) 999-6752 | (419) 203-3520 | |

| | <u>PUTNAN</u> | <u>/</u> | |
|--------------------|----------------------|----------------|----------------|
| Contact | Title | Office # | Cell # |
| Paul Lehman | Trans. Administrator | (419) 999-6761 | (419) 615-3449 |
| Larry Schroeder | Trans. Manager | (419) 999-6762 | (419) 957-4999 |
| Kenneth Williamson | Trans, Manager | (419) 999-6768 | (419) 796-0127 |

| <u>VAN WERI</u> | | | | | |
|-----------------|----------------------|----------------|----------------|--|--|
| Contact | Title | Office # | Cell # | | |
| Ron Leffel | Trans. Administrator | (419) 999-6771 | (419) 302-7617 | | |
| Patrick McConn | Trans. Manager | (419) 999-6772 | (419) 605-8508 | | |
| Bryan Hoersten | Trans. Manager | (419) 999-6778 | | | |

| <u>WYANDOT</u> | | | | | |
|----------------|----------------------|----------------|----------------|--|--|
| Contact | Title | Office # | Cell # | | |
| Kevin Kliesch | Trans. Administrator | (419) 999-6781 | (419) 348-5224 | | |
| Geena Snow | Trans. Manager | (419) 999-6782 | (419) 294-7654 | | |
| April Noel | Trans. Manager | (419) 999-6788 | (419) 619-2745 | | |

ENVIRONMENTAL COMMITMENTS

1. ASBESTOS SURVEYS OF THE STRUCTURES SCHEDULED FOR RENOVATION, WERE CONDUCTED BY A CERTIFIED ASBESTOS HAZARD EVALUATION SPECIALIST. THE SURVEYS DID NOT DETECT REGULATED ASBESTOS-CONTAINING MATERIALS ON THE STRUCTURES. THE ASBESTOS SURVEY REPORT IS FOUND IN THE SPECIAL PROVISIONS ATTACHED TO THE PLANS.

2. THIS PROJECT WAS DEVELOPED TO BE CONSTRUCTED WITHOUT EQUIPMENT OR MATERIALS PLACED (PERMANENTLY OR TEMPORARILY) BELOW THE ORDINARY HIGHWATER MARK OF PLUM CREEK LOCATED AT THE PUT-SR 12-3.70 STRUCTURE.

ITEM 202, WEARING COURSE REMOVED, AS PER PLAN

THE CONTRACTOR SHALL REMOVE THE EXISTING ASPHALTIC CONCRETE COURSE TO THE ORIGINAL CONCRETE DECK (TOP OF CONCRETE CULVERT) AND ANY WATERPROOFING MATERIAL THAT WAS PART OF THE DECK (TOP OF CONCRETE CULVERT). REMOVAL SHALL COMPLY WITH REQUIREMENTS OF CMS 202 AND SUPPLEMENTAL SPECIFICATION 856.

PAYMENT FOR THE WORK ABOVE SHALL BE INCLUDED IN THE UNIT PRICE BID PER SQUARE YARD FOR ITEM 202, WEARING COURSE REMOVED, AS PER PLAN, WHICH SHALL INCLUDE MATERIAL, EQUIPMENT, LABOR, AND INCIDENTALS TO COMPLETE THE WORK.

PERSONAL PROTECTIVE EQUIPMENT (PPE)

THE CONTRACTOR SHALL FOLOW ALL REQUIREMENTS OF SECTIONS XXIV AND XXXIV OF THE OHIO DEPARTMENT OF TRANSPORTATION SAFETY AND HEALTH STANDARD OPERATING PROCEDURE 220-006(SP) EFFECTIVE: NOVEMBER 1, 2018 (EXCEPT AS AMENDED BELOW) AND ALL SUBSEQUENT UPDATES POSTED AT THE FOLLOWING WEBSITE:

HTTP://WWW.DOT.STATE.OH.US/POLICY/POLICIESANDSOPS/POLICIES/220-006(SP).PDF

XXIV. HEAD PROTECTION (HARD HATS)

ALL PERSONS WITHIN THE RIGHT-OF-WAY OF ANY HIGHWAY OR ANY OTHER TYPE OF ROADWAY OR CONSTRUCTION SITE WHO ARE EXPOSED TO EITHER TRAFFIC (VEHICLES USING THE HIGHWAY FOR PURPOSES OF TRAVEL) OR CONSTRUCTION EQUIPMENT WITHIN THE WORK AREA, REGARDLESS OF JOB TYPE, SHALL WEAR APPROPRIATE HEAD PROTECTION. ALL HARD HATS MUST MEET OR EXCEED ANSI Z89.1-2009 TYPE 1, CLASS E-G REQUIREMENTS.

XXXIV. SAFETY APPAREL AND VEST (HIGH VISIBILITY)
ALL PERSONS WITHIN THE RIGHT-OF-WAY OF ANY HIGHWAY OR
ANY OTHER TYPE OF ROADWAY OR CONSTRUCTION SITE WHO ARE
EXPOSED TO EITHER TRAFFIC (VEHICLES USING THE HIGHWAY FOR
PURPOSES OF TRAVEL) OR CONSTRUCTION EQUIPMENT WITHIN
THE WORK AREA, REGARDLESS OF JOB TYPE, SHALL WEAR A HIGHVISIBILITY SAFETY VEST THAT MEETS THE PERFORMANCE CLASS II
OR CLASS III REQUIREMENTS OF THE ANSI/ISEA 107-2015
PUBLICATION ENTITLED "AMERICAN NATIONAL STANDARD FOR
HIGH-VISIBILITY SAFETY APPAREL AND ACCESSORIES."

WORKERS MAY WEAR AN ANSI CLASS II OR ANSI CLASS III APPROVED RAIN SUIT, JACKET OR OTHER APPAREL WITHOUT A SAFETY VEST OVER IT.

WORKERS MUST WEAR THE REQUIRED PPE AS DESCRIBED IN THE LATEST EDITION OF THE CSXT PUBLIC PROJECTS MANUAL, AT ALL TIMES WHILE WORKING WITHIN THE CSXT RIGHT OF WAY.

WINDOW CONTRACT TABLE

| | DESCRIPTION OF | CALENDAR DAYS | DICINICENTIVE C | WORK WINDOW | | |
|-------------|-----------------------------|---------------|--------------------------------------|-------------------------------|----------|--|
| > | CRITICAL WORK | TO COMPLETE | PER DAY | START | END | |
| <u>></u> | ALL WORK ON VAN-33- 0165 | 45 | \$1500 PER DAY PER C&MS 108.07 | CONTRACT EXECUTION DATE | 9/1/2022 | |



EJS

REVIEWER

XXX MM-DD-YY

PROJECT ID

102814

SHEET TOTAL

P.2 13

ITEM 614, MAINTAINING TRAFFIC (AT ALL TIMES)

A MINIMUM OF ONE TEN FEET WIDE LANE OF TRAFFIC IN EACH DIRECTION SHALL BE MAINTAINED AT ALL TIMES BY USE OF THE EXISTING PAVEMENT, THE COMPLETED PAVEMENT, ITEM 502 STRUCTURE FOR MAINTAINING TRAFFIC, ITEM 615 PAVEMENT FOR MAINTAINING TRAFFIC, ITEM 615 ROADS FOR MAINTAINING TRAFFIC, AND TEMPORARY SURFACES USING ITEMS 410 AND 614.

EQUIPMENT CANNOT BE STORED UNPROTECTED IN THE MEDIAN OR SHOULDER AREA AS PER 614.035. IT MUST BE MOVED TO A PROTECTED AREA, WHENEVER NOT IN USE.

FOR WORK AT THE BRIDGES, MINIMUM OF ONE FEET LATERAL CLEARANCE IS REQUIRED FROM EDGE OF LANE TO BARRIERS AND CHANNELIZING DEVICES.

LENGTH AND DURATION OF LANE CLOSURES AND RESTRICTIONS SHALL BE AT THE APPROVAL OF THE ENGINEER. IT IS THE INTENT TO MINIMIZE THE IMPACT TO THE TRAVELING PUBLIC. LANE CLOSURES OR RESTRICTIONS OVER SEGMENTS OF THE PROJECT IN WHICH NO WORK IS ANTICIPATED WITHIN A REASONABLE TIME FRAME, AS DETERMINED BY THE ENGINEER, SHALL NOT BE PERMITTED. THE LEVEL OF UTILIZATION OF MAINTENANCE OF TRAFFIC DEVICES SHALL BE COMMENSURATE WITH THE WORK IN PROGRESS

ADVISORY SPEED (W13-1P) PLAQUES SHALL BE USED FOR LANE CLOSURES ON THE 4-LANE SECTIONS OF US 23 AND US 30. THE ADVISORY SPEED PLAQUES SHALL NOTE AN ADVISORY SPEED 10 MILES LESS THAN THE LEGAL SPEED, AND THEY SHALL BE PLACED AS PER THE APPLICABLE (MT) STANDARD CONSTRUCTION DRAWING.

ACCESS TO ADJACENT PROPERTY WITHIN THE WORK LIMITS
SHALL BE MAINTAINED BY THE CONTRACTOR AT ALL TIMES, AS
PER 614.02(a).

ALL WORK AND TRAFFIC CONTROL DEVICES SHALL BE IN ACCORDANCE WITH C&MS 614 AND OTHER APPLICABLE PORTIONS OF THE SPECIFICATIONS, AS WELL AS THE OHIO MANUAL OF UNIFORM TRAFFIC CONTROL DEVICES. PAYMENT FOR ALL LABOR, EQUIPMENT AND MATERIALS SHALL BE INCLUDED IN THE LUMP SUM CONTRACT PRICE FOR ITEM 614, MAINTAINING TRAFFIC, UNLESS SEPARATELY ITEMIZED IN THE PLAN.

WORK ZONE MARKINGS AND SIGNS

THE FOLLOWING ESTIMATED QUANTITIES HAVE BEEN CARRIED TO THE GENERAL SUMMARY FOR USE AT LOCATIONS IDENTIFIED BY THE ENGINEER FOR WORK ZONE PAVEMENT MARKINGS AND SIGNS PER THE REQUIREMENTS OF C&MS 614.04 AND 614.11.

ITEM 614 - WORK ZONE MARKING SIGNS = 10 EACH

ITEM 614 - WORK ZONE EDGE LINE, CLASS I, 6", 740.06. TYPE 1 = 4.34 MILES

ITEM 614 - WORK ZONE LANE LINE, CLASS I, 6", 740.06, TYPE 1 = 1.77 MILES

ITEM 614 - WORK ZONE DOTTED LINE, CLASS I, 6", 740.06, TYPE 1 = 9.346 FT

ITEM 614 - WORK ZONE IMPACT ATTENUATOR, 24" WIDE HAZARDS, UNIDIRECTIONAL = 12 EACH

ITEM 622 - PORTABLE BARRIER, UNANCHORED = 5,400 FEET ITEM 622 - PORTABLE BARRIER, ANCHORED = 100 FEET

DELINEATION OF PORTABLE AND PERMANENT BARRIER

BARRIER REFLECTORS AND OBJECT MARKERS SHALL BE INSTALLED ON ALL PORTABLE BARRIER (PB) USED FOR TRAFFIC CONTROL; AND, ON PERMANENT CONCRETE BARRIER (INCLUDING BRIDGE PARAPETS) LOCATED WITHIN 5 FEET OF THE EDGE OF THE ADJACENT TRAVEL LANE.

DELINEATION OF PORTABLE AND PERMANENT BARRIER

BARRIER REFLECTORS SHALL CONFORM TO C&MS 626, EXCEPT THAT THE SPACING SHALL BE AS PER TRAFFIC SCD MT-101.70. OBJECT MARKERS AND THEIR INSTALLATION SHALL CONFORM TO C&MS 614.03 AND SCD MT-101.70. WHEN THE PB CONTAINS GLARE SCREEN, ONE SET OF THREE VERTICAL STRIPES OF SHEETING SHALL BE CONSIDERED EQUIVALENT TO AN OBJECT MARKER. ONE-WAY.

INCREASED BARRIER DELINEATION, AS SPECIFIED HEREIN, SHALL BE INSTALLED ON ALL PB AND PERMANENT CONCRETE BARRIER LOCATED WITHIN 5 FEET OF THE EDGE OF THE TRAVELED LANE UNDER EITHER OF THE FOLLOWING CONDITIONS: ALONG TAPERS AND TRANSITION AREAS; OR ALONG CURVES (OUTSIDE ONLY) WITH DEGREE OF CURVATURE GREATER THAN OR EQUAL TO 3 DEGREES.

THE INCREASED BARRIER DELINEATION SHALL CONSIST OF EITHER DELINEATION PANELS OR THE TRIPLE STACKING OF WORK ZONE BARRIER REFLECTORS.

DELINEATION PANELS SHALL CONSIST OF PANELS OF DELINEATION, APPROXIMATELY 34 INCHES LONG AND 6 INCHES WIDE AND SHALL BE "CRIMPED." PANELS SHALL BE INSTALLED AND SPACED PER TRAFFIC SCD MT-101.70.

TRIPLE-STACKED BARRIER REFLECTORS SHALL CONSIST OF ALIGNING THREE BARRIER REFLECTORS VERTICALLY, AT LOCATIONS WHERE A SINGLE BARRIER REFLECTOR WOULD BE OTHERWISE ATTACHED. THERE SHALL BE NO OPEN SPACE BETWEEN THE ADJACENT BARRIER REFLECTORS. THE TRIPLE-STACKED BARRIER REFLECTORS SHALL CONFORM TO C&MS 626, EXCEPT THAT THEY SHALL BE SPACED AND ALIGNED PER TRAFFIC SCD MT-101.70.

THE FOLLOWING ESTIMATED QUANTITIES HAVE BEEN INCLUDED IN THE PLANS AND CARRIED TO THE GENERAL SUMMARY:

ITEM 614, BARRIER REFLECTOR, TYPE 1 (ONE-WAY) = 126 EACH

ITEM 614, OBJECT MARKER, ONE-WAY = 126 EACH

ITEM 614, INCREASED BARRIER DELINEATION 2200 FEET

PAYMENT SHALL BE FULL COMPENSATION FOR ALL MATERIAL, LABOR, INCIDENTALS AND EQUIPMENT NECESSARY FOR FURNISHING, INSTALLING, MAINTAINING AND REMOVING EACH OF THE ABOVE ITEMS.

ALONG RUNS OF INCREASED BARRIER DELINEATION WHERE
THIS ITEM IS PROVIDED, THE QUANTITY SHALL BE MEASURED
AS THE ENTIRE LENGTH OF THE RUN OF INCREASED BARRIER
DELINEATION, INCLUDING THE SPACES BETWEEN THE INDIVIDUAL
DELINEATION PANELS OR STACKS OF BARRIER REFLECTORS.

NOTIFICATION OF TRAFFIC RESTRICTIONS

THROUGHOUT THE DURATION OF THE PROJECT, THE CONTRACTOR SHALL NOTIFY THE PROJECT ENGINEER IN WRITING OF ALL TRAFFIC RESTRICTIONS AND UPCOMING MAINTENANCE OF TRAFFIC CHANGES. THE CONTRACTOR SHALL ENSURE THE WRITTEN NOTIFICATION IS SUBMITTED IN A TIMELY MANNER TO ALLOW THE PROJECT ENGINEER TO MEET THE REQUIRED TIME FRAMES SET FORTH IN THE TABLE BELOW TO INFORM THE SPECIAL HAULING PERMITS SECTION (HAULING.PERMITS@DOT.OHIO.GOV) AND THE DISTRICT PUBLIC INFORMATION OFFICE (PIO). THIS NOTIFICATION SHALL BE RECEIVED BY THE PROJECT ENGINEER PRIOR TO THE PHYSICAL SETUP OF ANY APPLICABLE SIGNS OR MESSAGE BOARDS.

NOTIFICATION OF TRAFFIC RESTRICTIONS

(CONTINUED)

INFORMATION SHOULD INCLUDE, BUT IS NOT LIMITED TO, ALL CONSTRUCTION ACTIVITIES THAT IMPACT OR INTERFERE WITH TRAFFIC AND SHALL LIST THE SPECIFIC LOCATION, TYPE OF WORK, ROAD STATUS, DATE AND TIME OF RESTRICTION, DURATION OF RESTRICTION, NUMBER OF LANES MAINTAINED, NUMBER OF LANES CLOSED, MINIMUM VERTICAL CLEARANCE, MINIMUM WIDTH OF DRIVABLE PAVEMENT, DETOUR ROUTES, IF APPLICABLE, AND ANY OTHER INFORMATION REQUESTED BY THE PROJECT ENGINEER

NOTIFICATION OF TRAFFIC RESTRICTIONS TIME TABLE
ITEM DURATION OF NOTICE DUE TO
CLOSURE PERMITS & PIO

RAMP & >= 2 WEEKS 21 CALENDAR DAYS ROAD CLOSURES PRIOR TO CLOSURE

> > 12 HOURS 14 CALENDAR DAYS & < 2 WEEKS PRIOR TO CLOSURE

<= 12 HOURS 4 CALENDAR DAYS
PRIOR TO CLOSURE

PRIOR TO CLOSURE

LANE >= 2 WEEKS 14 CALENDAR DAYS
CLOSURES & PRIOR TO CLOSURE
RESTRICTIONS
< 2 WEEKS 5 BUSINESS DAYS

START OF N/A 14 CALENDAR DAYS
CONSTRUCTION & PRIOR TO
TRAFFIC PATTERN IMPLEMENTATION
CHANGES

ANY UNFORESEEN CONDITIONS NOT SPECIFIED IN THE PLANS REQUIRING TRAFFIC RESTRICTIONS SHALL ALSO BE REPORTED TO THE PROJECT ENGINEER USING THE NOTIFICATION TIME TABLE.

ITEM 614, REPLACEMENT SIGN

FLATSHEET SIGNS FURNISHED BY THE CONTRACTOR IN ACCORDANCE WITH THE REQUIREMENTS OF THE PLANS, SPECIFICATIONS AND PROPOSAL WHICH BECOME DAMAGED BY TRAFFIC FOR REASONS BEYOND THE CONTROL OF THE CONTRACTOR SHALL BE REPLACED IN KIND WHEN ORDERED BY THE ENGINEER. REPLACEMENT SIGNS SHALL BE NEW. OTHER MATERIALS MAY BE IN USED, BUT GOOD, CONDITION SUBJECT TO APPROVAL BY THE ENGINEER.

PAYMENT FOR THE NEW SIGNS SHALL BE MADE AT THE CONTRACT PRICE PER EACH FOR ITEM 614, REPLACEMENT SIGN, AND SHALL INCLUDE THE COST OF REMOVING AND DISPOSING OF DAMAGED SIGNS, HARDWARE AND SUPPORTS, AND PROVIDING THE NECESSARY REPLACEMENT HARDWARE, SUPPORTS, ETC.

AN ESTIMATED QUANTITY OF 5 EACH HAS BEEN PROVIDED IN THE GENERAL SUMMARY.

ITEM 614, REPLACEMENT DRUM

DRUMS FURNISHED BY THE CONTRACTOR IN ACCORDANCE WITH THE REQUIREMENTS OF THE PLANS, SPECIFICATIONS AND PROPOSAL WHICH BECOME DAMAGED BY TRAFFIC FOR REASONS BEYOND THE CONTROL OF THE CONTRACTOR SHALL BE REPLACED IN KIND WHEN ORDERED BY THE ENGINEER.

REPLACEMENT DRUMS SHALL BE NEW

PAYMENT FOR THE NEW DRUMS SHALL BE MADE AT THE CONTRACT PRICE PER EACH FOR ITEM 614, REPLACEMENT DRUM, AND SHALL INCLUDE THE COST OF REMOVING AND DISPOSING OF THE DAMAGED DRUM, AND PROVIDING AND MAINTAINING THE REPLACEMENT DRUM IN ACCORDANCE WITH THE CONTRACT REQUIREMENTS FOR THE ORIGINAL DRUM

AN ESTIMATED QUANTITY OF 5 EACH HAS BEEN PROVIDED IN THE GENERAL SUMMARY.

ITEM 614, WORK ZONE IMPACT ATTENUATOR FOR 24" WIDE HAZARDS UNIDIRECTIONAL

THIS ITEM SHALL CONSIST OF FURNISHING AND INSTALLING
A NON-GATING IMPACT ATTENUATOR. FURNISH AN IMPACT
ATTENUATOR FROM THE OFFICE OF ROADWAY ENGINEERING'S
APPROVED LIST FOR WORK ZONE IMPACT ATTENUATORS, FROM
THE ROADWAY STANDARDS APPROVED PRODUCTS WEB PAGE.

INSTALLATION SHALL BE AT THE LOCATIONS SPECIFIED IN THE PLANS IN ACCORDANCE WITH THE MANUFACTURER'S SPECIFICATIONS.

THE CONTRACTOR SHALL REPAIR OR REPLACE A DAMAGED UNIT WITHIN 24 HOURS OF A DAMAGING IMPACT.

WHEN BIDIRECTIONAL DESIGNS ARE SPECIFIED, THE CONTRACTOR SHALL SUPPLY APPROPRIATE TRANSITIONS.

WHEN GATING IMPACT ATTENUATORS ARE DESIRED, THE CONTRACTOR SHALL SUBMIT DOCUMENTATION TO THE ENGINEER FOR ACCEPTANCE.

THE COST FOR THE ADDITIONAL BARRIER REQUIRED FOR A GATING IMPACT ATTENUATOR SHALL BE INCLUDED IN THE COST OF THE GATING IMPACT ATTENUATOR.

PAYMENT FOR THE ABOVE WORK SHALL BE MADE AT THE UNIT PRICE BID AND SHALL INCLUDE ALL LABOR, TOOLS, EQUIPMENT AND MATERIALS NECESSARY TO CONSTRUCT AND MAINTAIN A COMPLETE AND FUNCTIONAL IMPACT ATTENUATOR SYSTEM, INCLUDING ALL RELATED BACKUPS, TRANSITIONS, LEVELING PADS, HARDWARE AND GRADING, NOT SEPARATELY SPECIFIED, AS REQUIRED BY THE MANUFACTURER.

DESIGN AG



EJS
REVIEWER
XXX MM-DD-Y
PROJECT ID
102814

P.3 TOTAL

D01-BM-FY22

ITEM 615 - PAVEMENT FOR MAINTAINING TRAFFIC, CLASS B, AS PER PLAN

FOR THE APPROACH SLAB REPLACEMENT WORK, SOME EXISTING SHOULDERS WILL BE USED DURING VARIOUS PHASES TO MAINTAIN TRAFFIC. THE CONTRACTOR SHALL REPAIR THE SHOULDERS AS DIRECTED BY THE PROJECT ENGINEER VIA MILL AND OVERLAY PRIOR TO SHIFTING TRAFFIC ONTO THE AFFECTED SHOULDERS NEEDED FOR LANE SHIFTS REQUIRED TO MAINTAIN TRAFFIC AS SPECIFIED IN THE PLANS AND STANDARD CONSTRUCTION DRAWINGS. THE REPAIR BUILDUP AND TOTAL AREA OF USE FOR MAINTAINING TRAFFIC ARE PROVIDED BELOW.

ONCE TRAFFIC IS RETURNED TO NORMAL LANE ASSIGNMENTS. THE CONTRACTOR SHALL INSTALL RUMBLE STRIPS ALONG THE REPAIRED SHOULDERS OF U.S.R. 30 AS PER C&MS SECTION 618 AND STANDARD CONSTRUCTION DRAWING BP-9.1.

ALL STANDARD SPECIFICATIONS OF ITEM 615 SHALL OTHERWISE APPLY ALONG WITH RELATED SPECIFICATIONS FOR THE VARIOUS PAY/WORK ITEMS. ALL COSTS FOR THE REPAIR INCLUDING ALL RELATED WORK, EQUIPMENT, SAWCUTTING, MOT, TACK COAT, PAVEMENT PLANING (MILLING), RUMBLE STRIPS, ETC. SHALL BE INCLUDED WITH THE PRICE BID FOR 615, PAVEMENT FOR MAINTAINING TRAFFIC, CLASS B, AS PER PLAN.

REPAIR TYPE 1 - 1 1/2 INCH MILL & OVERLAY (US 30):

OVERLAY WITH ITEM 441, A.C. SURFACE COURSE, TYPE I, PG 64-22 - 1 1/2" THICK

ITEM 615 - PAVEMENT FOR MAINTAINING TRAFFIC, CLASS B, AS PER PLAN

TOTAL SQUARE YARDS = 2.000

ESTIMATED QUANTITY IS BASED ON REPAIRING THE PAVED SHOULDERS FOR 200 FT. EACH DIRECTION FROM LEFT AND RIGHT BRIDGES. THE ESTIMATED QUANTITY HAS BEEN CARRIED TO THE GENERAL SUMMARY FOR USE AS DIRECTED BY THE PROJECT ENGINEER.

CONFLICTING PAVEMENT MARKINGS

PRIOR TO PLACEMENT OF ANY WORK ZONE PAVEMENT MARKINGS, THE CONTRACTOR SHALL COMPLETELY REMOVE. AS PER C&MS 614.11G, ALL EXISTING PAVEMENT MARKINGS THAT WOULD CREATE CONFUSION OR CONFLICT WITH THE WORK ZONE PAVEMENT MARKINGS. PAYMENT FOR THIS COMPLETE REMOVAL SHALL BE INCLUDED IN ITEM 614 MAINTAINING TRAFFIC.

COORDINATION OF CONTRACTORS

SINCE THE MAINTENANCE OF TRAFFIC AND WORK ON THIS PROJECT MAY OVERLAP OTHER PROJECTS, SUCH AS ALL-30-113, PID 88830; PROJECT 210625. IT IS ESSENTIAL THAT PACH CONTRACTOR CONDUCT THEIR WORK AND COOPERATE WITH EACH OTHER IN SUCH A MANNER AS NOT TO HINDER THE PROGRESS OR COMPLETION OF THE WORK BEING, PERFOREMED BY THE OTHER CONTRACTOR.



XXX XXX MM-DD-Y 102814

P.5 13

GENERAL SUMMARY

DESIGN AGENCY



DESIGNER
EJS
REVIEWER
XXX MM-DD-Y

102814
HEET TOTAL
P.7 13

D01-BM-FY

STANDARD DRAWINGS AND SUPPLEMENTAL SPECIFICATIONS

REFER TO THE FOLLOWING STANDARD BRIDGE DRAWING(S):

AS-1-15 DATED (REVISED) 7/17/15 AS-2-15 DATED (REVISED) 1/18/19 EXJ-4-87 DATED (REVISED) 1/19/18 PCB-91 DATED (REVISED) 7/17/20 DS-1-92 DATED (REVISED) 7/18/03

AND TO THE FOLLOWING SUPPLEMENTAL SPECIFICATION(S):

800-2019 DATED 1/21/22 843 DATED 10/18/19 846 DATED 4/17/15 856 DATED 1/21/22

DESIGN DATA

CONCRETE CLASS QC2: COMPRESSIVE STRENGTH 4.5 KSI (SUPERSTRUCTURE)

REINFORCING STEEL MINIMUM YIELD STRENGTH 60 KSI

DESIGN SPECIFICATIONS

THE STRUCTURES' WORK CONFORMS TO THE 2ND EDITION OF THE "LRFD BRIDGE DESIGN SPECIFICATIONS" ADOPTED BY THE AMERICAN ASSOCIATION OF STATE HIGHWAY AND TRANSPOR-TATION OFFICIALS, 2014 AND THE ODOT BRIDGE DESIGN MANUAL, 2020.

EXISTING STRUCTURE VERIFICATION

DETAILS AND DIMENSIONS SHOWN ON THESE PLANS PERTAINING TO THE EXISTING STRUCTURE HAVE BEEN OBTAINED FROM PLANS OF THE EXISTING STRUCTURE AND FROM FIELD OBSERVATIONS AND MEASUREMENTS. CONSEQUENTLY, THEY ARE INDICATIVE OF THE EXIST-ING STRUCTURE AND THE PROPOSED WORK BUT THEY SHALL BE CONSIDERED TENTATIVE AND APPROXIMATE. THE CONTRACTOR IS REFERRED TO C&MS, SECTIONS 102.05, 105.02, AND 513.04*.

BASE CONTRACTBID PRICES UPON A RECOGNITION OF THE UNCERTAINTIES DESCRIBED ABOVE AND UPON A PREBID EXAMINATION OF THE EXISTING STRUCTURE. HOWEVER, THE DEPARTMENT WILL PAY FOR ALL PROJECT WORK BASED UPON ACTUAL DETAILS AND DIMENSIONS THAT HAVE BEEN VERIFIED IN THE FIELD.

COPIES OF THE EXISTING PLANS ARE ON FILE AT THE DISTRICT ONE OFFICE OF THE OHIO DEPARTMENT OF TRANSPORTATION.

ITEM 843 - PATCHING CONCRETE STRUCTURES WITH TROWELABLE MORTAR

A QUANTITY IS INCLUDED IN THE ESTIMATED QUANTITIES TO REPAIR ANY DETERIORATED AREAS ON THE PIERS AND BACKWALLS WITH ITEM 843 - PATCHING CONCRETE STRUCTURES WITH TROWELABLE MORTAR, WHERE THE DEPTH OF A PATCH IS EQUAL TO OR LESS THAN 3 INCHES, AS LOCATED BY AND TO THE SATISFACTION OF THE ENGINEER.

PAYMENT FOR ALL OF THE ABOVE SHALL BE AT THE UNIT PRICE BID PER SQ FT FOR ITEM 843 - PATCHING CONCRETE STRUCTURE WITH TROWELABLE MORTAR WHICH SHALL INCLUDE ALL LABOR, EQUIPMENT, MATERIALS AND INCIDENTALS NECESSARY TO COMPLETE THE ABOVE WORK.

ITEM 512 - SEALING OF CONCRETE SURFACE (EPOXY-URETHANE)

THE CONTRACTOR SHALL SEAL ALL LOCATIONS THAT HAVE BEEN PATCHED AND HAVE QUANTITIES INCLUDED IN THE STRUCTURES SUBSUMMARIES FOR THE AREAS ON BRIDGES NOTED BELOW.

| _ | | |
|---|---------------|-------------------------------------|
| | STRUCTURE | PATCHING & SEALING LOCATIONS |
| | HAN-75-0633 | PIER 1 (REAR) AND PIER 3 (FORWARD) |
| | PAU-637-0022 | REAR & FORWARD ABUTMENT BACKWALLS |
| X | VAN-30-7581 | PIER 1/2 AND S(RRY, MEDIAN & YVVQ.) |
| ۱ | ✓ VAN-33-0165 | WINGWALL AND CULVERT SIDES |
| | | |

PAYMENT FOR ALL OF THE ABOVE SHALL BE AT THE UNIT PRICE BID PER SQ YD FOR ITEM 512 - SEALING OF CONCRETE SURFACES (EPOXY-URETHANE) WHICH SHALL INCLUDE ALL LABOR, EQUIPMENT, MATERIALS AND INCIDENTALS NECESSARY TO COMPLETE THE ABOVE WORK.

ITEM 202, PORTIONS OF STRUCTURE REMOVED, AS PER PLAN

THIS ITEM SHALL INCLUDE THE ELEMENTS INDICATED IN THE PLANS AND GENERAL NOTES AND THAT ARE NOT SEPARATELY LISTED FOR PAYMENT, EXCEPT FOR WEARING COURSE REMOVAL. ITEMS TO BE REMOVED INCLUDE ALL EXISTING MATERIALS BEING REPLACED BY NEW CONSTRUC-TION AND MISCELLANEOUS ITEMS THAT ARE NOT SHOWN TO BE INCORPORATED INTO THE FINAL CONSTRUCTION AND ARE DIRECTED TO BE REMOVED BY THE ENGINEER. THE USE OF EXPLOSIVES, HEADACHE BALLS AND/OR HOE-RAMS WILL NOT BE PERMITTED. THE METHOD OF REMOVAL AND THE WEIGHT OF HAMMER SHALL BE APPROVED BY THE ENGINEER. PERFORM ALL WORK IN A MANNER THAT WILL NOT CUT, ELONGATE OR DAMAGE THE EXISTING REINFORCING STEEL TO BE PRESER-VED. CHIPPING HAMMERS SHALL NOT BE HEAVIER THAN THE NOMINAL 90-POUND CLASS. PNEUMATIC HAMMERS SHALL NOT BE PLACED IN DIRECT CONTACT WITH REINFORCING STEEL THAT IS TO BE RETAINED IN THE REBUILT STRUCTURE. SUBMIT CONSTRUCTION PLANS ACCORDING TO C&MS 501.05.

ITEM 526 - REINFORCED CONCRETE APPROACH SLABS (T=15"), AS PER PLAN

THE APPROACH SLAB CONCRETE FOR THIS ITEM SHALL BE A MS MIX DESIGN THAT WILL PRODUCE 4 KSI BEFORE ALLOWING THE OPENING OF THE LANE TO TRAFFIC. TEST THE CONCRETE USING EITHER BEAMS THAT PRODUCE 0.6 KSI OR CYLINDERS THAT SHOW 4 KSI

PRIOR TO PLACEMENT OF THE CONCRETE, THE APPROACH SLAB SEAT AND BASE SHALL BE LEVEL AND FREE OF ANY DEBRIS. ANY NEEDED EXCAVATED MATERIAL SHALL BE PER CMS SECTION 203 AND ANY NEEDED ADDITIONAL BASE MATERAIL SHALL BE PROVIDED PER CMS SECTION 304.

THE LONGITUDINAL JOINT AT THE CENTERLINE OF PAVEMENT/ APPROACH SLABS SHALL BE SPLICED UTILIZING MECHANICAL CONNECTORS TO SPLICE INTO ALL THE TRANSVERSE REIN-FORCING STEEL.

IN ADDITION TO THE REQUIREMENTS OF ITEM 526 AND STANDARD CONSTRUCTION DRAWING AS-1-15. THIS ITEM SHALL ALSO INCLUDE THE APPLICATION OF JOINT SEALER BETWEEN THE INSTALLED APPROACH SLABS AND THE EXISTING ABUTMENTS & DECKS. THE JOINT SEALER SHALL BE APPLIED PER CMS SECTIONS 516.04 & 516.06. THIS MATERIAL REPLACES THE PREFORMED ELASTOMERIC COMPRESSION JOINT SEAL SHOWN IN DETAIL B OF STANDARD CONSTRUCTION DRAWING AS-1-15. SEE DETAIL B ON STANDARD CONSTUCION DRAWING AS-1-15 FOR FURTHER DETAILS.

PAYMENT FOR THE WORK ABOVE SHALL BE INCLUDED IN THE UNIT PRICE BID PER SY FOR ITEM 526 - REINFORCED CONCRETE APPROACH SLABS (T-15"), AS PER PLAN, WHICH SHALL INCLUDE ALL MATERIAL, EQUIPMENT, LABOR, AND INCIDENTALS NECESSARY TO COMPLETE THE WORK.

ITEM 519 - PATCHING CONCRETE STRUCTURES, AS PER PLAN

PRIOR TO THE SURFACE CLEANING SPECIFIED IN C&MS 519.04 AND WITHIN 24 HOURS OF PLACING PATCHING MATERIAL, BLAST CLEAN ALL SURFACES TO BE PATCHED INCLUDING THE EXPOSED REINFORCING STEEL. ACCEPT-ABLE METHODS INCLUDE: HIGH-PRESSURE WATER BLAST-ING WITH. OR WITHOUT, ABRASIVES IN THE WATER. ABRASIVE BLASTING WITH CONTAINMENT OR VACUUM ABRASIVE BLASTING.

WORK ON STRUCTURES OVER WATERWAYS

UNLESS COVERED BY THE WATERWAY PERMITS, WORK IS NOT PERMITTED IN THE WATERWAYS. HOWEVER, WORK IS PERMITTED AT THE ABUTMENTS AND AT THE TOPS OF THE BANKS OF THE WATERWAYS. ADDITIONALLY, NO WORK, MATERIALS, FOUIPMENT AND/OR INCIDENTALS ARE PERMITTED WITHIN OR BELOW THE ORDINARY HIGH WATER MARK (OHWM).

IF NEEDED, THE OHWM CAN BE STAKED BY ODOT, DISTRICT 1, PLANNING AND ENGINEERING DEPARTMENT PRIOR TO INITIATING WORK AT THE STRUCTURES OVER WATERWAYS. THE CONTRACTOR SHALL CONTACT THE PROJECT ENGINEER AND REQUEST THE OHWM STAKING 14 DAYS PRIOR TO STARTING WORK. THE PROJECT ENGINEER WILL NOTIFY THE DISTRICT ENVIRONMENTAL COORDINATOR AND DISTRICT SURVEY OPERATIONS MANAGER TO REQUEST THE STAKING OF THE OHWM BY ODOT. DISTRICT 1. PLANNING AND ENGINEERING DEPARTMENT.

ALL SPALLING CONCRETE REMOVAL OF MID SPAN, UNDERSIDE DECK SECTIONS SHALL BE DONE IN A MANNOR TO ENSURE THAT NO MATERIALS OR EQUIPMENT ENTER THE WATERWAY.

ITEM 516 - ELASTOMERIC STRIP SEAL WITHOUT STEEL EXTRUSION. AS PER PLAN

IN ADDITION TO THE REQUIREMENTS OF ITEM 516 AND STANDARD CONSTRUCTION DRAWING EXJ-4-87. THIS ITEM SHALL ALSO INCLUDE ALL MATERIAL, EQUIPMENT, AND LABOR REQUIRED TO REMOVE THE EXISTING STRIP SEAL AND CLEAN THE EXISTING STEEL RETAINER FOR INSTALLATION OF THE REPLACEMENT STRIP SEAL.

PAYMENT FOR THE WORK ABOVE SHALL BE INCLUDED IN THE UNIT PRICE BID PER FT FOR ITEM 516 - ELASTOMERIC STRIP SEAL WITHOUT STEEL EXTRUSION, AS PER PLAN, WHICH SHALL INCLUDE ALL MATERIAL. EQUIPMENT, LABOR, AND INCIDENTALS NECESSARY TO COMPLETE THE WORK.

ITEM 202 - REMOVAL, MISC.: POLYMER MODIFIED ASPHALT JOINT SYSTEM REMOVAL

IN ADDITION TO THE REQUIREMENTS OF ITEM 202 AND SUPPLEMENTAL SPECIFICATION 846, THIS ITEM SHALL ALSO INCLUDE ALL MATERIAL, EQUIPMENT, AND LABOR REQUIRED TO REMOVE AND DISPOSE OF THE EXISTING POLYMER MODIFIED ASPHALT JOINT SYSTEM (INCLUDING BRIDGE PLATES, ALIGNMENT NAILS & ETC.) FOR INSTALLATION OF THE REPLACEMENT POLYMER MODIFIED ASPHALT JOINT SYSTEM.

PAYMENT FOR THE WORK ABOVE SHALL BE INCLUDED IN THE UNIT PRICE BID PER CUBIC YARD FOR ITEM 202 - REMOVAL, MISC.: POLYMER MODIFIED ASPHALT JOINT SYSTEM REMOVAL INCLUDE ALL MATERIAL, EQUIPMENT, LABOR, AND INCIDENTALS NECESSARY TO COMPLETE THE REMOVAL WORK.

| COUNTY | ROUTE | SLM | FEATURE INTERSECTED | SFN | ADDITIONAL DESCRIPTION OF WORK AND/OR ADDITIONAL WORK |
|----------|------------|---------|-----------------------------|---------|-----------------------------------------------------------------------------------------------|
| REPLACE | APPROACH | SLABS | | | |
| ALL | US 30 | 0242L | AUGLAIZE RIVER | 0200069 | |
| ALL | US 30 | 0242R | AUGLAIZE RIVER | 0200093 | |
| ALL | US 30 | 0703L | OTTAWA RIVER | 0200182 | |
| ALL | US 30 | 0703R | OTTAWA RIVER | 0200212 | |
| VAN | US 30 | 12.76R | OVER TOWN CREEK & CFE RR | 8100578 | REPLACE SLIDING PLATE EXPANSION JOINT W/ STRIP SEAL EXPANSION JOINT (EXJ-4-87) |
| VAN | US 30 | 19.96R | OVER CR 173 | 8104204 | |
| POLYMER | JOINT REPL | ACEMENT | | | |
| PAU | SR 637 | 0022R | MADDOX CREEK | 6301770 | PATCHING ABUTMENT BACKWALLS AND REFURBISHING ABUTMENT BEARINGS |
| WYA | US 23 | 0767L | SANDUSKY RIVER | 8800332 | |
| WYA | US 23 | 0767R | SANDUSKY RIVER | 8800367 | |
| WYA | US 23 | 1017L | CF&E/CSX RR | 8800421 | |
| WYA | US 23 | 1017R | CF&E/CSX RR | 8800456 | |
| PATCHING | MISC. | | | | |
| HAN | IR 75 | 0633 | CR 12 OVER IR 75 | 3202496 | PATCH PIER COLUMNS AND CAPS |
| PUT | SR 12 | 0370 | PLUM CREEK# | 6900100 | REPLACE ROCK CHANNEL PROTECTION ABOVE ORDINARY HIGH WATER MARK |
| PUT | SR 634 | 1027 | AUGLAIZE RIVER | 6901956 | REPLACE STRIP SEAL GLAND |
| YAY | A8284 | 1581 | TR 127 OVER US 30 | 8103860 | RESET BEARINGS AND PATCH PIER COLUMNS AND CAPS |
| VAN | US 33 | 165 | CLOUSE DITCH | 8100942 | REPAIR DECK EDGE BOTH SIDES, PATCHING WINGWALL AND FILLED PIP PROTRUSIONS ON CULVERT SIDES |



FJS XXX MM-DD-Y

SUBSET SHEET 1 OF 1

P.8 13

102814

D01-BM-FY22

ITEM 512 - SEALING CONCRETE BRIDGE DECKS WITH HMWM RESIN

THE CONTRACTOR SHALL SEAL THE CONSTRUCTION JOINTS IN CONCRETE BRIDGE DECKS AND ABUTMENT BACKWALLS FROM PHASE/PART WIDTH CONSTRUCTION FOR MAINTAINING TRAFFIC.

ITEM 516 - JACKING AND TEMPORARY SUPPORT OF SUPERSTRUCTURE, AS PER PLAN

THIS WORK CONSISTS OF RAISING OR RE-POSITIONING EXISTING STRUCTURES TO THE DIMENSIONS AND REQUIRE-MENTS DEFINED IN THE PROJECT PLANS. SUBMIT CON-STRUCTION PLANS IN ACCORDANCE WITH C&MS 501.05. IF, DURING THE JACKING OPERATIONS, CRACKING OF THE CONCRETE SUPERSTRUCTURE, SEPARATION OF THE CONCRETE DECK FROM THE STEEL STRINGERS, OR OTHER DAMAGE TO THE STRUCTURE IS VISUALLY OBSERVED, IMMEDIATELY CEASE THE JACKING OPERATION AND INSTALL SUPPORTS TO THE SATISFACTION OF THE ENGINEER. ANALYZE THE DAMAGE AND SUBMIT A METHOD OF CORRECTION TO THE ENGINEER FOR APPROVAL. EPOXY INJECT ALL BEAMS THAT SEPARATE FROM THE DECK FOR A DISTANCE OF THE SEPARATION IN ACCORDANCE WITH C&MS 512.07. THE DEPARTMENT WILL NOT PAY FOR THE COST OF THIS EPOXY INJECTION OR OTHER REQUIRED REPAIRS. THE BRIDIGE BEARINGS SHALL BE FULLY SEATED ALL CONTACT AREAS. IF FULL SEATING IS NOT ATTAINED, SUBMIT A REPAIR PLAN TO THE ENGINEER. THE DEPARTMENT WILL NOT PAY FOR THE REPAIR COSTS TO ENSURE FULL SEATING ON BEARINGS. THE DEPARTMENT WILL MEASURE THIS WORK ON A LUMP SUM BASIS. THE DEPARTMENT WILL PAY FOR THE ACCEPTED QUANTITIES AT THE CONTRACT PRICE FOR ITEM 516, JACKING AND TEMPORARY SUPPORT OF SUPERSTRUCTURE, AS PER PLAN.

ITEM 516 - REFURBISHING BEARING DEVICES, AS PER PLAN

THIS ITEM SHALL INCLUDE ALL WORK NECESSARY TO PRO-PERLY ALIGN BRIDGE BEARINGS, AS WELL AS THEIR CLEARNING AND PAINTING. INCLUDED SHALL BE THE DIS-ASSEMBLY OF THE BEARINGS. HAND TOOL CLEANING (GRINDING IF NECESSARY), PAINTING ACCORDING TO ITEM 514, REPLACEMENT OF ANY DAMAGED SHEET LEAD WITH PREFORMED BEARING PADS (C&MS 711.21), IN-STALLATION OF ANY NECESSARY STEEL SHIMS OF THE SAME SIZE AS THE BEARINGS TO PROVIDE A SNUG FIT, REALIGNMENT OFTHE UPPER BEARING PLATE BY RE-MOVING EXISTING WELDS AND REWELDING SO THAT THE BEARINGS ARE VERTICALLY ALIGNED AT 60 DEGREES FARENHEIT, LUBRICATING SLIDING SURFACES, AND REASSEMBLY OF THE BEARINGS. ASSURE ALL BEARINGS ARE SHIMMED ADEQUATELY AND THAT NO BEAMS AND/OR BEARING DEVICES ARE "FLOATING". AT NO ADDITIONAL COST TO THE STATE, THE CONTRACTOR MAY INSTALL NEW BEARINGS OF THE SAME TYPE AS THE EXISTING IN PLACE OF REFURBISHING THE BEARINGS. ALL WORK SHALL BE TO THE SATIFACTION OF THE ENGINEER. PAYMENT FOR ALL OF THE ABOVE DESCRIBED LABOR AND MATERIALS WILL BE MADE AT THE CONTRACT PRICE BID FOR ITEM 516 - REFURBISH BEARING DEVICES, AS PER PLAN.

ITEM 513 - STRUCTURAL STEEL MEMBERS, LEVEL UF, AS PER PLAN

ALL REQUIREMENTS OF C&MS 513 APPLY TO SHOP FABRICATED MEMBERS. PERFORM WORK FOR FIELD FABRICATED MEMBERS ACCORDING TO ITEM 513, EXCEPT AS MODIFIED HEREIN. THE DEPARTMENT WILL NOT REQUIRE THE CONTRACTOR PERFORMING FIELD FABRICATION TO BE PREQUALIFIED AS SPECIFIED IN S1078. SUBMIT A WRITTEN LETTER OF MATERIAL ACCEPTANCE IN ACCORDANCE WITH C&MS 501.06, TO THE ENGINEER. PROVIDE THE ENGINEER "AS-BUILT" DRAWINGS ACCORDING C&MS 513.06, EXCEPT C&MS 501.04 DOES NOT APPLY. UPON RECEIPT OF THE ENGINEER'S ACCEPTANCE, SUPPLY A COPY OF THE DRAWINGS, ACCORDING TO S1002 TO THE OFFICE OF MATERIAL MANAGEMENT FOR RECORD PURPOSES.

THE FOLLOWING MEMBERS ARE INCLUDED IN THIS ITEM: FOR FIELD ADJUSTING END CROSS FRAMES BRIDGE NO. VAN-30-1276R

> VARIOUS DESIGN AGENCY



DESIGNER CHECKER
EJS XXX

REVIEWER
XXX MM-DD-YY
PROJECT ID

102814

SUBSET TOTAL
2 7
SHEET TOTAL
P.8A 13

| MODEL: Sheet PAPERSIZE: 34x22 (in.) | | DATE: 4/21/20; |
|-------------------------------------|----------------|-------------------------------------|
| | DUT-BIM-F Y 22 | MODEL: Sheet PAPERSIZE: 34x22 (in.) |

| ITEM | EXT. | DESCRIPTION | See Sht. | UNIT | TOTAL* |
|----------------------------------|------------------------------------------|------------------------------------------------------------------------------------------------------------------------------------------------------------------------------------------------------------------------------------------------------------------------------------------------------------------------------------------------------------------------------------------------------------|--------------------------------------------|------------------------------|-----------------------------|
| 202 | 98500 | REMOVAL MISC.: POLYMER MODIFIED ASPHALT EXPANSON JOINT SYSTEM REMOVED | 8 | CY | 4 |
| 512 | 10100 | SEALING OF CONCRETE SURFACES (EPOXY-URETHANE) | | SY | 14 |
| 516 | 45305 | REFURBISH BEARING DEVICE, AS PER PLAN | 8A | EACH | 8 |
| 516 | 47001 | JACKING AND TEMPORARY SUPPORT OF SUPERSTRUCTURE, AS PER PLAN | 8A | | LS |
| 519 | 11101 | PATCHING CONCRETE STRUCTURE, AS PER PLAN | 8 | SF | 60 |
| 843 | 50000 | PATCHING CONCRETE STRUCTURES WITH TROWELABLE MORTOR | | SF | 60 |
| 846 | 00110 | POLYMER MODIFIED ASPHALT EXPANSION JOINT SYSTEM | | CF | 36 |
| | | STRUCTURE REPAIR (SFN 8800332) (WYA - 023 - 7.67 L OVER SANDUSK | Y RIVER) | | |
| ITEM | EXT. | DESCRIPTION | See Sht. | UNIT | TOTAL |
| 202 | 98500 | REMOVAL MISC.: POLYMER MODIFIED ASPHALT EXPANSON JOINT SYSTEM REMOVED | 8 | CY | 3 |
| 846 | 00110 | POLYMER MODIFIED ASPHALT EXPANSION JOINT SYSTEM | | CF | 23 |
| | | | | | |
| | | STRUCTURE REPAIR (SFN 8800367) (WYA - 023 - 7.67 R OVER SANDUSK | (Y RIVER) | | |
| ITEM | EXT. | STRUCTURE REPAIR (SFN 8800367) (WYA - 023 - 7.67 R OVER SANDUSK DESCRIPTION | (Y RIVER) See Sht. | UNIT | TOTAL |
| ITEM 202 | EXT. 98500 | | , | UNIT CY | TOTAL |
| | | DESCRIPTION | See Sht. | | |
| 202 | 98500 | DESCRIPTION REMOVAL MISC.: POLYMER MODIFIED ASPHALT EXPANSON JOINT SYSTEM REMOVED | See Sht. | CY | 3 |
| 202 | 98500 | DESCRIPTION REMOVAL MISC.: POLYMER MODIFIED ASPHALT EXPANSON JOINT SYSTEM REMOVED POLYMER MODIFIED ASPHALT EXPANSION JOINT SYSTEM | See Sht. | CY | 3 23 |
| 202 846 | 98500 00110 | DESCRIPTION REMOVAL MISC.: POLYMER MODIFIED ASPHALT EXPANSON JOINT SYSTEM REMOVED POLYMER MODIFIED ASPHALT EXPANSION JOINT SYSTEM STRUCTURE REPAIR (SFN 8800421) (WYA - 023 - 10.17 L OVER CF&E/C | See Sht. 8 CSX RR) | CY CF | 3 23 |
| 202 846 ITEM | 98500 00110 EXT. | DESCRIPTION REMOVAL MISC.: POLYMER MODIFIED ASPHALT EXPANSON JOINT SYSTEM REMOVED POLYMER MODIFIED ASPHALT EXPANSION JOINT SYSTEM STRUCTURE REPAIR (SFN 8800421) (WYA - 023 - 10.17 L OVER CF&E/C DESCRIPTION | See Sht. 8 CSX RR) See Sht. | CY CF UNIT | 3 23 TOTAL |
| 202 846 ITEM 202 | 98500 00110 EXT. 98500 | DESCRIPTION REMOVAL MISC.: POLYMER MODIFIED ASPHALT EXPANSON JOINT SYSTEM REMOVED POLYMER MODIFIED ASPHALT EXPANSION JOINT SYSTEM STRUCTURE REPAIR (SFN 8800421) (WYA - 023 - 10.17 L OVER CF&E/C DESCRIPTION REMOVAL MISC.: POLYMER MODIFIED ASPHALT EXPANSON JOINT SYSTEM REMOVED | See Sht. 8 CSX RR) See Sht. 8 | CY CF UNIT CY | 3 23 TOTAL 4 |
| 202 846 ITEM 202 | 98500 00110 EXT. 98500 | DESCRIPTION REMOVAL MISC.: POLYMER MODIFIED ASPHALT EXPANSON JOINT SYSTEM REMOVED POLYMER MODIFIED ASPHALT EXPANSION JOINT SYSTEM STRUCTURE REPAIR (SFN 8800421) (WYA - 023 - 10.17 L OVER CF&E/C DESCRIPTION REMOVAL MISC.: POLYMER MODIFIED ASPHALT EXPANSON JOINT SYSTEM REMOVED POLYMER MODIFIED ASPHALT EXPANSION JOINT SYSTEM | See Sht. 8 CSX RR) See Sht. 8 | CY CF UNIT CY | 3 23 TOTAL 4 |
| 202 846 ITEM 202 846 | 98500 00110 EXT. 98500 00110 | DESCRIPTION REMOVAL MISC.: POLYMER MODIFIED ASPHALT EXPANSON JOINT SYSTEM REMOVED POLYMER MODIFIED ASPHALT EXPANSION JOINT SYSTEM STRUCTURE REPAIR (SFN 8800421) (WYA - 023 - 10.17 L OVER CF&E/C DESCRIPTION REMOVAL MISC.: POLYMER MODIFIED ASPHALT EXPANSON JOINT SYSTEM REMOVED POLYMER MODIFIED ASPHALT EXPANSION JOINT SYSTEM STRUCTURE REPAIR (SFN 8800456) (WYA - 023 - 10.17 R OVER CF&E/C | See Sht. 8 CSX RR) See Sht. 8 CSX RR) | CY CF UNIT CY CF | 3 23 TOTAL 4 28 |

| ITEM | | STRUCTURE REPAIR (SFN 3202496) (HAN - 75 - 6.33 UNDER CF | ₹ 12) | | |
|----------|-------|------------------------------------------------------------------|-------------|------|--------------------|
| ITEM | | | | | |
| I | EXT. | DESCRIPTION | See Sht. | UNIT | TOTAL* |
| 512 | 10100 | SEALING OF CONCRETE STRUCTURE (EXPOXY-EURETHANE) | | SY | 17 |
| 519 | 11101 | PATCHING CONCRETE STRUCTURE, AS PER PLAN | 8 | SF | 100 |
| 843 | 50000 | PATCHING CONCRETE STRUCTURES WITH TROWELABLE MORTAR | | SF | 50 |
| | | EROSION CONTROL REPAIR ITEM (SFN 6900100) (PUT - 12 - 3.7 OVER F | PLUM CREEK) | | |
| ITEM | EXT. | DESCRIPTION | See Sht. | UNIT | TOTAL* |
| 601 | 32210 | ROCK CHANNEL PROTECTION, TYPE C WITH AGGREGATE FILTER | | CY | 80 |
| 201 | 11000 | CLEARING AND GRUBBING | | | LS ** |
| | لللا | | للللا | لللا | |
| | | STRUCTURE REPAIR (SFN 6901956) (PUT - 634 - 10.27 OVER AUGLAI | , | | |
| ITEM | EXT. | DESCRIPTION | See Sht. | UNIT | TOTAL* |
| 516 | 01301 | ELASTOMERIC STRIP SEAL WITHOUT STEEL EXTRUSIONS, AS PER PLAN | 8 | FT | 85.15 |
| | | STRUCTURE REPAIR (SFN 8103860) (VAN - 30 - 15.81 OVER TR | 127) | | |
| ITEM | EXT. | DESCRIPTION | See Sht. | UNIT | TOTAL [*] |
| 512 | 10100 | SEALING OF CONCRETE STRUCTURE (EXPOXY-EURETHANE) | | SY | 23 |
| 516 | 46700 | RESET BEARING | | EACH | 4 |
| 516 | 47001 | JACK AND TEMPORARY SUPPORT OF SUPERSTRUCTURE, AS PER PLAN | 8A | | LS |
| 519 | 11101 | PATCHING CONCRETE STRUCTURE, AS PER PLAN | 8 | SF | 100 |
| | | PATCHING CONCRETE STRUCTURES WITH TROWELABLE MORTAR | | | 100 |

| | YNOTE: | TOTAL | .SAR | $E \bigcirc A$ | RRIE | D TO |) & | ENE | ERA | LS | UM | MA | RY | Y | Y | Y | Y | Y | Y | Y | Y |
|---|---------|-------|-------|----------------|-------|------|-----|-----|------|------|-----|-----|-----|-------|-----|----|----|----|-----|----|---|
| • | **NOTE: | TOTA | LS AR | RE C | ARRIE | ED T | 0 | SEN | IER/ | AL S | SUN | ЛΜА | ARY | ′ - F | ROA | DW | ΆΥ | SE | СТІ | ON | |
| • | | | | | | | | | | | | | | | | | | | | | |


| ITEM | EXT. | DESCRIPTION | See Sht. | UNIT | TOTAL* |
|------------|----------------------------|----------------------------------------------------------------------------------------------------------------------|-------------|------------|---------------------|
| 202 | 22900 | APPROACH SLAB REMOVED | | SY | 134 |
| 509 | 10000 | EPOXY COATED REINFORCING STEEL | | LB | 348 |
| 510 | 10000 | DOWEL HOLES WITH NONSHRINK, NONMETALLIC GROUT | | EACH | 34 |
| 519 | 11101 | PATCHING CONCRETE STRUCTURE, AS PER PLAN | 8 | SF | 25 |
| 526 | 25001 | REINFORCED CONCRETE APPROACH SLABS (T=15"), AS PER PLAN | 8 | SY | 134 |
| | | STRUCTURE REPAIR (SFN 0200093) (ALL - 30 - 2.42 R OVER AUGL | AIZE RIVER) | | |
| ITEM | EXT. | DESCRIPTION | See Sht. | UNIT | TOTAL* |
| 202 | 22900 | APPROACH SLAB REMOVED | | SY | 134 |
| 509 | 10000 | EPOXY COATED REINFORCING STEEL | | LB | 348 |
| 510 | 10000 | DOWEL HOLES WITH NONSHRINK, NONMETALLIC GROUT | | EACH | 34 |
| 519 | 11101 | PATCHING CONCRETE STRUCTURE, AS PER PLAN | 8 | SF | 25 |
| 526 | 25001 | REINFORCED CONCRETE APPROACH SLABS (T=15"), AS PER PLAN | 8 | SY | 134 |
| | | STRUCTURE REPAIR (SFN 0200182) (ALL - 30 - 7.03 L OVER OTTA | AWA RIVER) | | |
| ITEM | EXT. | DESCRIPTION | See Sht. | UNIT | TOTAL* |
| 202 | 22900 | APPROACH SLAB REMOVED | | SY | 134 |
| 509 | 10000 | EPOXY COATED REINFORCING STEEL | | LB | 348 |
| 510 | 10000 | DOWEL HOLES WITH NONSHRINK, NONMETALLIC GROUT | | EACH | 34 |
| 519 | 11101 | PATCHING CONCRETE STRUCTURE, AS PER PLAN | 8 | SF | 25 |
| 526 | 25001 | REINFORCED CONCRETE APPROACH SLABS (T=15"), AS PER PLAN | 8 | SY | 134 |
| | | STRUCTURE REPAIR (SFN 0200212) (ALL - 30 - 7.03 R OVER OTT | AWA RIVER) | | |
| ITEM | EXT. | DESCRIPTION | See Sht. | UNIT | TOTAL* |
| 202 | 22900 | APPROACH SLAB REMOVED | | SY | 134 |
| 509 | 10000 | EPOXY COATED REINFORCING STEEL | | LB | 348 |
| 510 | 10000 | DOWEL HOLES WITH NONSHRINK, NONMETALLIC GROUT | 0 | EACH | 34 |
| 519 | 11101 | PATCHING CONCRETE STRUCTURE, AS PER PLAN | 8 | SF | 25 |
| 526 | 25001 | REINFORCED CONCRETE APPROACH SLABS (T=15"), AS PER PLAN | 8 | SY | 134 |
| | T | STRUCTURE REPAIR (SFN 8100578) (VAN - 30 - 12.76 R OVER TOWN C | | , | |
| ITEM | EXT. | DESCRIPTION | See Sht. | UNIT | TOTAL* |
| 202 | 11301 | PORTIONS OF STRUCTURE REMOVED, AS PER PLAN | 8 | CY | 4 |
| 202 | 22900 | APPROACH SLAB REMOVED | | SY | 67 |
| 509 510 | 10000 | DOWEL HOLES WITH NONSHRINK, NONMETALLIC GROUT | | LB EACH | 533 17 |
| 510 | 34410 | CLASS QC2 CONCRETE, SUPERSTRUCTURE | | CY | 4 |
| | | | | | |
| 512 | 10300 | SEALING BRIDGE DECKS WITH HMWM RESIN Y Y Y Y Y Y Y Y Y Y Y Y Y Y Y Y Y Y Y | Y Y Y 8Å Y | YSYYY | Y Y ₁₂ Y |
| 513 | 10001 | STRUCTURAL STEEL MEMBERS, LEVEL UF, AS PER PERSON STRUCTURAL EXPANSION JOINT INCLUDING ELASTOMERIC STRIP SEAL X X X | 8A | λ Fλ λ | LS |
| 516 519 | 11210 | PATCHING CONCRETE STRUCTURE, AS PER PLAN | 8 | SF | 30.17 10 |
| 526 | 25001 | REINFORCED CONCRETE APPROACH SLABS (T=15"), AS PER PLAN | 8 | SY | 67 |
| | | STRUCTURE REPAIR (SFN 8104204) (VAN - 30 - 19.96 R OVER | CR 173) | | |
| ITEM | EXT. | DESCRIPTION | See Sht. | UNIT | TOTAL* |
| 202 | 22900 | APPROACH SLAB REMOVED | 2.2.2 | SY | 200 |
| 519 | 11101 | PATCHING CONCRETE STRUCTURE, AS PER PLAN | 8 | SF | 25 |
| 526 | 25001 | REINFORCED CONCRETE APPROACH SLABS (T=15"), AS PER PLAN | 8 | SY | 200 |
| | , , , | STRUCTURE REPAIR (SFN 8100942) (VAN - 33 - 1.65 OVER CLOU | JSE DITCH) | , , , | |
| ITEM | EXT. | DESCRIPTION | See Sht. | UNIT | TOTAL* |
| 202 | 11301 | PORTIONS OF STRUCTURE REMOVED, AS PER PLAN | 8 | CY | 8 |
| 202 | 23501 | WEARING COURSE REMOVED, AS PER PLAN | 2 | SY | 20 ** |
| 407 | 10000 | TACK COAT | | GAL | 3 ** |
| F00 | 10000 | EPOXY COATED REINFORCING STEEL | | LB | 209 |
| 509 | 34410 | CLASS QC2 CONCRETE, SUPERSTRUCTURE | | CY | 8 |
| 511 | T | | | SY | 11 |
| 511 | 10100 | SEALING OF CONCRETE SURFACES (EPOXY - URETHANE) | į į | | |
| 511 512 | 10100 | SEALING OF CONCRETE SURFACES (EPOXY - URETHANE) SEALING CONCRETE BRIDGE DECKS WITH HMWM RESIN | | | 8 |
| 511 | 10100 10300 51823300 | SEALING CONCRETE BRIDGE DECKS WITH HMWM RESIN | 8, 13A | SY FT | |

DESIGN AGENCY

DESIGNER EJS REVIEWER XXX MM-DD-YY PROJECT ID


102814 SHEET TOTAL P.9 13

SUBSET SHEET 3 OF 7

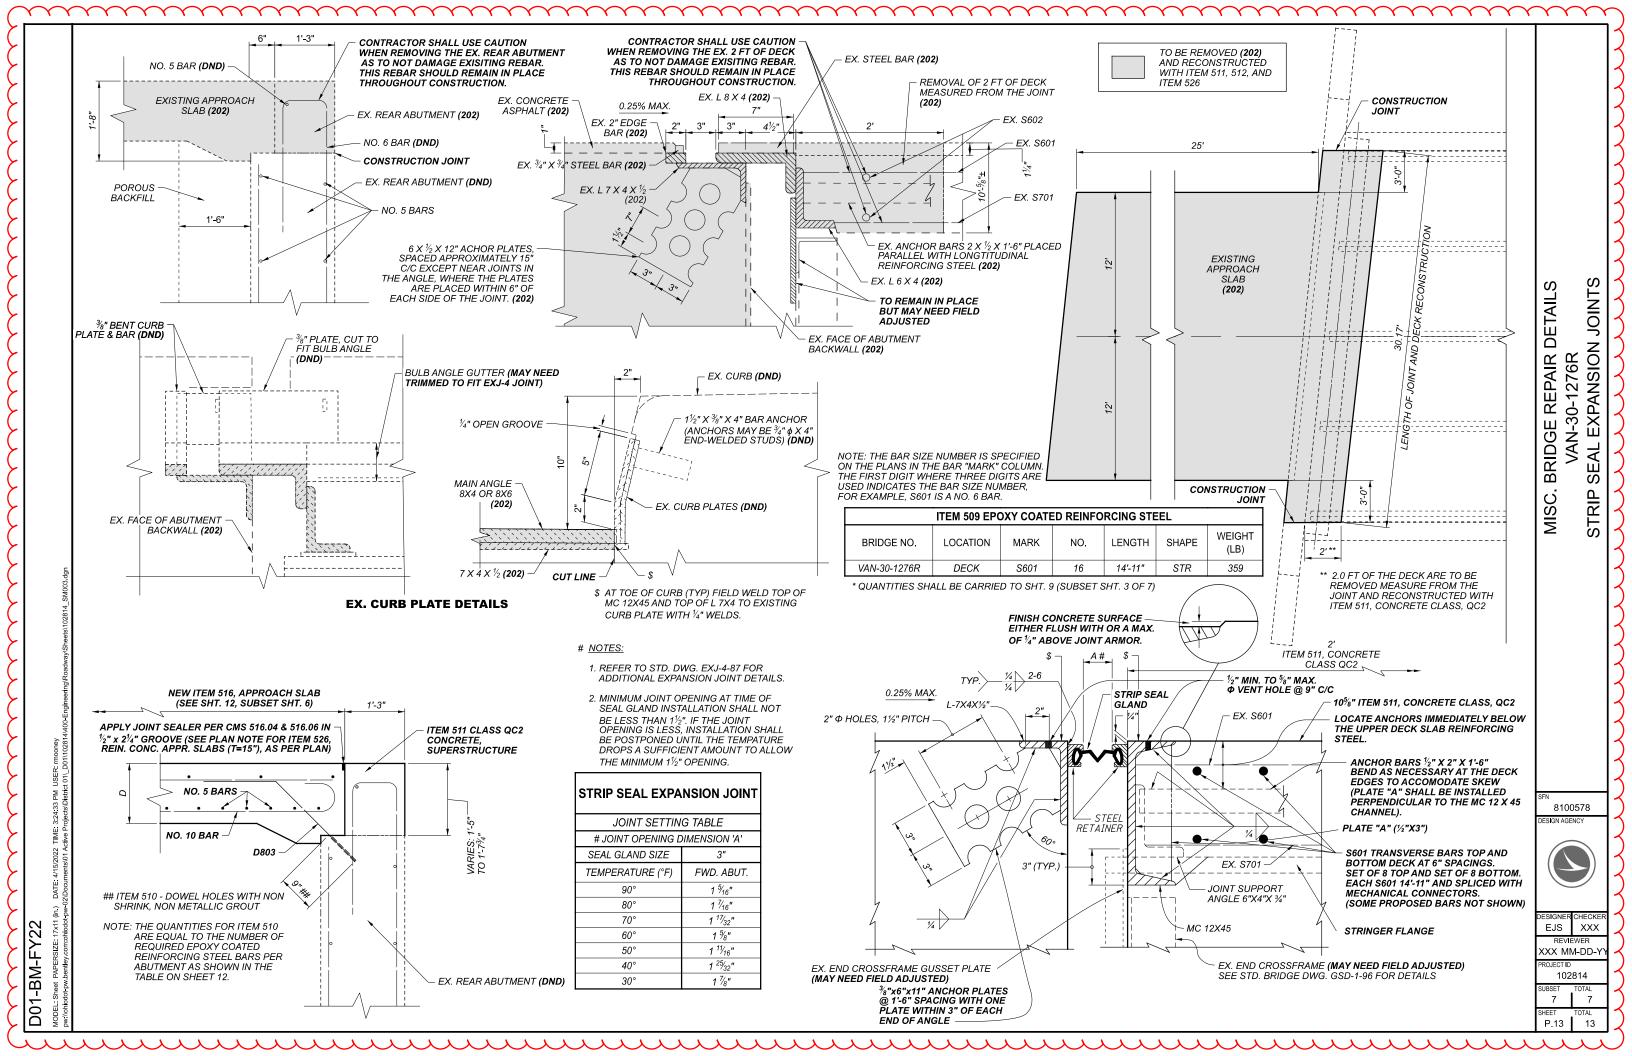



Military Loading

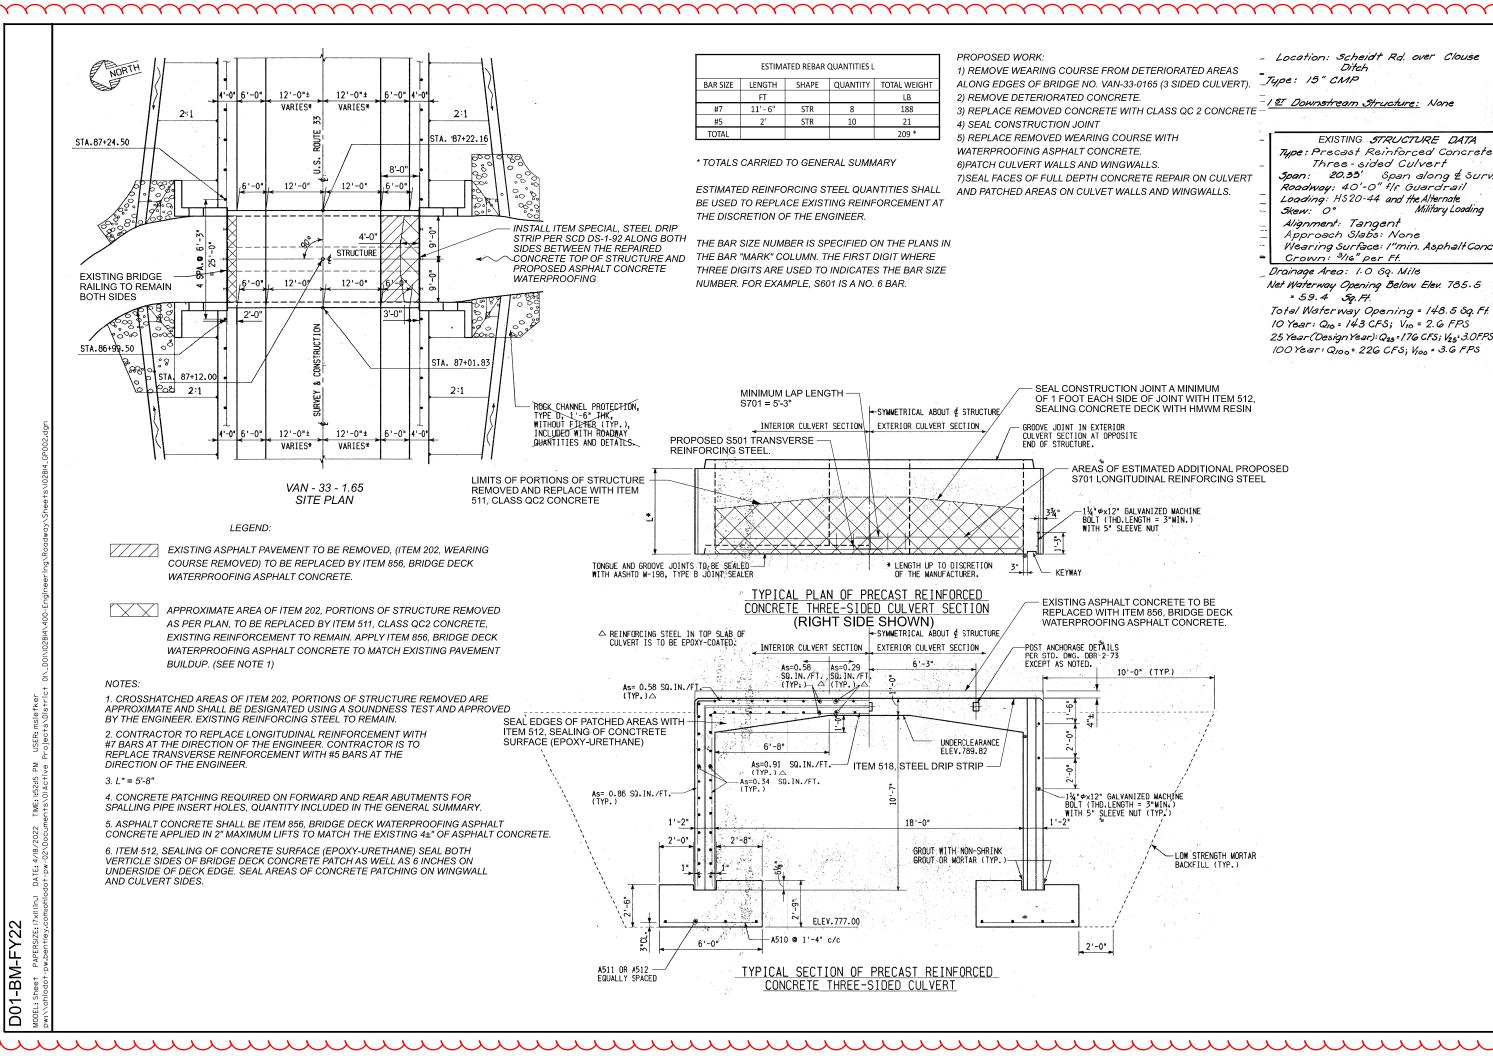



MJS XXX MM-DD-102814 7A

> 13A 13