

STATE OF OHIO DEPARTMENT OF TRANSPORTATION

D01-BP-FY25

BLANCHARD, CRANE, EAGLE, GREENSBURG,
AND UNION TOWNSHIPS

HANCOCK, PUTNAM, AND WYANDOT COUNTIES

FEDERAL PROJECT NUMBER

E240 (089)

RAILROAD INVOLVEMENT

NONE

PROJECT DESCRIPTION

IMPROVEMENT OF STRUCTURES: HAN-75-0775,
HAN-75-0909, HAN-235-1682, PUT-15-1129, AND
WYA-67-2103 BY PAINTING THE STRUCTURAL STEEL.

EARTH DISTURBED AREAS

PROJECT EARTH DISTURBED AREA: 0.0 ACRES
ESTIMATED CONTRACTOR EARTH DISTURBED AREA: 0.0 ACRES
NOTICE OF INTENT EARTH DISTURBED AREA: N/A (NOI NOT REQUIRED)

LIMITED ACCESS

THIS IMPROVEMENT IS ESPECIALLY DESIGNED FOR THROUGH TRAFFIC AND HAS BEEN DECLARED A LIMITED ACCESS HIGHWAY OR FREEWAY BY ACTION OF THE DIRECTOR IN ACCORDANCE WITH THE PROVISIONS OF SECTION 5511.02 OF THE OHIO REVISED CODE.

2023 SPECIFICATIONS

THE STANDARD SPECIFICATIONS OF THE STATE OF OHIO, DEPARTMENT OF TRANSPORTATION, INCLUDING SUPPLEMENTAL SPECIFICATIONS LISTED IN THE PLANS, CHANGES LISTED IN THE PROPOSAL, AND THE SUPPLEMENTAL SPECIFICATION 800 VERSION INDICATED ON THE PROPOSAL SHALL GOVERN THIS IMPROVEMENT.

I HEREBY APPROVE THESE PLANS AND DECLARE THAT THE MAKING OF THIS IMPROVEMENT WILL REQUIRE THE CLOSING TO TRAFFIC OF THE HIGHWAY AND THAT DETOURS WILL BE PROVIDED AS INDICATED ON SHEET 7 & 8.

Christopher A. Hughes

Christopher A. Hughes, P.E.
District 01 Deputy Director

Pamela Boratyn

Pamela Boratyn
Director, Department of Transportation



FOR LOCATION MAPS, LATITUDE AND LONGITUDE
SEE SHEET 2

LOCATION MAP

INDEX OF SHEETS:

TITLE SHEET	1
LOCATION MAPS	2
GENERAL NOTES	3
MAINTENANCE OF TRAFFIC	4-8
GENERAL SUMMARY	9
STRUCTURE - HAN-75-07.76	10-12
STRUCTURE - HAN-75-09.11	13-15
STRUCTURE - HAN-235-16.85	16-18
STRUCTURE - PUT-15-11.36	19-21
STRUCTURE - WYA-67-21.03	22-24

DESIGN EXCEPTIONS

NONE REQUIRED


ADA DESIGN WAIVERS

NONE REQUIRED

UNDERGROUND UTILITIES
Contact Two Working Days Before You Dig
 Before You Dig
OHIO811, 8-1-1, or 1-800-362-2764 (Non members must be called directly)

PLAN PREPARED BY:
OHIO DEPT. OF TRANSPORTATION, DISTRICT 1
1885 N. MCCULLOUGH ST.
LIMA, OHIO 45801

STANDARD CONSTRUCTION DRAWINGS				SUPPLEMENTAL SPECIFICATIONS	SPECIAL PROVISIONS
MT-95.30	7/19/19			800	7/19/24
MT-95.50	7/21/17			821	4/20/22
MT-97.10	4/19/19			832	7/19/24
MT-101.60	4/21/23			921	7/19/24
MT-102.20	4/19/19				
MT-105.10	1/17/20				
TC-41.20	10/18/13				
TC-42.20	10/18/13				
TC-52.10	10/18/13				
TC-52.20	1/15/21				

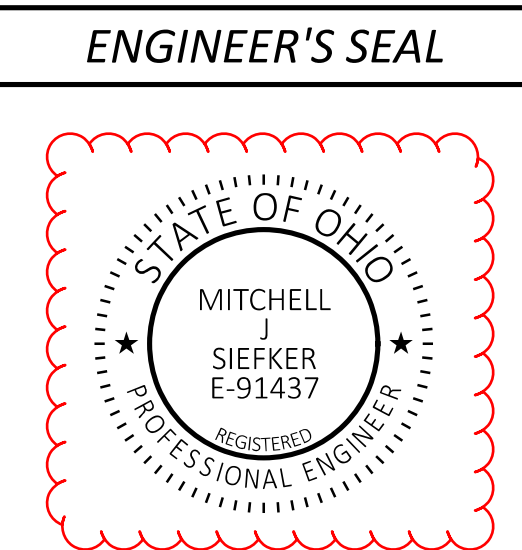

TITLE SHEET

D01-BP-FY25


MODEL: Sheet PAPER:SIZE: 34x22 (in.) DATE: 11/5/2024 TIME: 11:16:54 AM USER: msleiker pvc:\ohio\dot-pw-bentley.com\ohio\dot-pw-02\Documents\01 Active Projects\District 01_D01\110870\400-Engineering\Roadway\Sheets\110870_GT001.dgn

DESIGN AGENCY
DESIGNER
MJS
REVIEWER
RJM 10-18-23
PROJECT ID
110870
SHEET
P.1
TOTAL
24

SHEET NUM.			PART.		ITEM	ITEM EXT	GRAND TOTAL	UNIT	DESCRIPTION	SEE SHEET NO.
5	6	OFFICE CALCS	01/IMS/47	02/STR/47						
									ROADWAY	
			LS	LS	201	11000	LS		CLEARING AND GRUBBING	
									EROSION CONTROL	
		1,200	800	400	832	30000	1,200	EACH	EROSION CONTROL	
									STRUCTURE OVER 20 FOOT SPAN (HAN-75-0776)	
		28,366	28,366		514	00050	28,366	SF	SURFACE PREPARATION OF EXISTING STRUCTURAL STEEL	
		28,366	28,366		514	00056	28,366	SF	FIELD PAINTING OF EXISTING STRUCTURAL STEEL, PRIME COAT	
		28,366	28,366		514	00060	28,366	SF	FIELD PAINTING STRUCTURAL STEEL, INTERMEDIATE COAT	
		28,366	28,366		514	00066	28,366	SF	FIELD PAINTING STRUCTURAL STEEL, FINISH COAT	
		26	26		514	00504	26	MNHR	GRINDING FINS, TEARS, SLIVERS ON EXISTING STRUCTURAL STEEL	
		24	24		514	10000	24	EACH	FINAL INSPECTION REPAIR	
									STRUCTURE OVER 20 FOOT SPAN (HAN-75-0911)	
		37,311	37,311		514	00050	37,311	SF	SURFACE PREPARATION OF EXISTING STRUCTURAL STEEL	
		37,311	37,311		514	00056	37,311	SF	FIELD PAINTING OF EXISTING STRUCTURAL STEEL, PRIME COAT	
		37,311	37,311		514	00060	37,311	SF	FIELD PAINTING STRUCTURAL STEEL, INTERMEDIATE COAT	
		37,311	37,311		514	00066	37,311	SF	FIELD PAINTING STRUCTURAL STEEL, FINISH COAT	
		30	30		514	00504	30	MNHR	GRINDING FINS, TEARS, SLIVERS ON EXISTING STRUCTURAL STEEL	
		32	32		514	10000	32	EACH	FINAL INSPECTION REPAIR	
									STRUCTURE OVER 20 FOOT SPAN (HAN-235-1685)	
		14,456	14,456		514	00050	14,456	SF	SURFACE PREPARATION OF EXISTING STRUCTURAL STEEL	
		14,456	14,456		514	00056	14,456	SF	FIELD PAINTING OF EXISTING STRUCTURAL STEEL, PRIME COAT	
		14,456	14,456		514	00060	14,456	SF	FIELD PAINTING STRUCTURAL STEEL, INTERMEDIATE COAT	
		14,456	14,456		514	00066	14,456	SF	FIELD PAINTING STRUCTURAL STEEL, FINISH COAT	
		22	22		514	00504	22	MNHR	GRINDING FINS, TEARS, SLIVERS ON EXISTING STRUCTURAL STEEL	
		13	13		514	10000	13	EACH	FINAL INSPECTION REPAIR	
									STRUCTURE OVER 20 FOOT SPAN (PUT-15-1136)	
		2,254	2,254		514	00050	2,254	SF	SURFACE PREPARATION OF EXISTING STRUCTURAL STEEL	
		2,254	2,254		514	00056	2,254	SF	FIELD PAINTING OF EXISTING STRUCTURAL STEEL, PRIME COAT	
		2,254	2,254		514	00060	2,254	SF	FIELD PAINTING STRUCTURAL STEEL, INTERMEDIATE COAT	
		2,254	2,254		514	00066	2,254	SF	FIELD PAINTING STRUCTURAL STEEL, FINISH COAT	
		5	5		514	00504	5	MNHR	GRINDING FINS, TEARS, SLIVERS ON EXISTING STRUCTURAL STEEL	
		2	2		514	10000	2	EACH	FINAL INSPECTION REPAIR	
									STRUCTURE OVER 20 FOOT SPAN (WYA-67-2103)	
		6,147	6,147		514	00050	6,147	SF	SURFACE PREPARATION OF EXISTING STRUCTURAL STEEL	
		6,147	6,147		514	00056	6,147	SF	FIELD PAINTING OF EXISTING STRUCTURAL STEEL, PRIME COAT	
		6,147	6,147		514	00060	6,147	SF	FIELD PAINTING STRUCTURAL STEEL, INTERMEDIATE COAT	
		6,147	6,147		514	00066	6,147	SF	FIELD PAINTING STRUCTURAL STEEL, FINISH COAT	
		11	11		514	00504	11	MNHR	GRINDING FINS, TEARS, SLIVERS ON EXISTING STRUCTURAL STEEL	
		6	6		514	10000	6	EACH	FINAL INSPECTION REPAIR	
									MAINTENANCE OF TRAFFIC	
60				60	253	02000	60	CY	PAVEMENT REPAIR	
60				60	407	20000	60	GAL	NON-TRACKING TACK COAT	
30				30	441	70000	30	CY	ASPHALT CONCRETE SURFACE COURSE, TYPE 1, (449), PG64-22	
500			500	614	11110	500	500	HOUR	LAW ENFORCEMENT OFFICER WITH PATROL CAR FOR ASSISTANCE	
	10		5	614	12500	10	10	EACH	REPLACEMENT SIGN	
	20		20	614	12600	20	20	EACH	REPLACEMENT DRUM	
6			6	614	18601	6	6	SNMT	PORTABLE CHANGEABLE MESSAGE SIGN, AS PER PLAN	5
150			150	617	10100	150	150	CY	COMPACTED AGGREGATE	
									INCIDENTALS	
			LS	LS	614	11000	LS		MAINTAINING TRAFFIC	
			LS	LS	624	10000	LS		MOBILIZATION	

GENERAL SUMMARY

DESIGN AGENCY



DESIGNER
RCD

REVIEWER
MJS 10-17-23

PROJECT ID
110870

SHEET TOTAL
P.9 | 24