


STATE OF OHIO DEPARTMENT OF TRANSPORTATION

D02-CS-FY2025

PREVENTATIVE MAINTENANCE CRACK SEAL

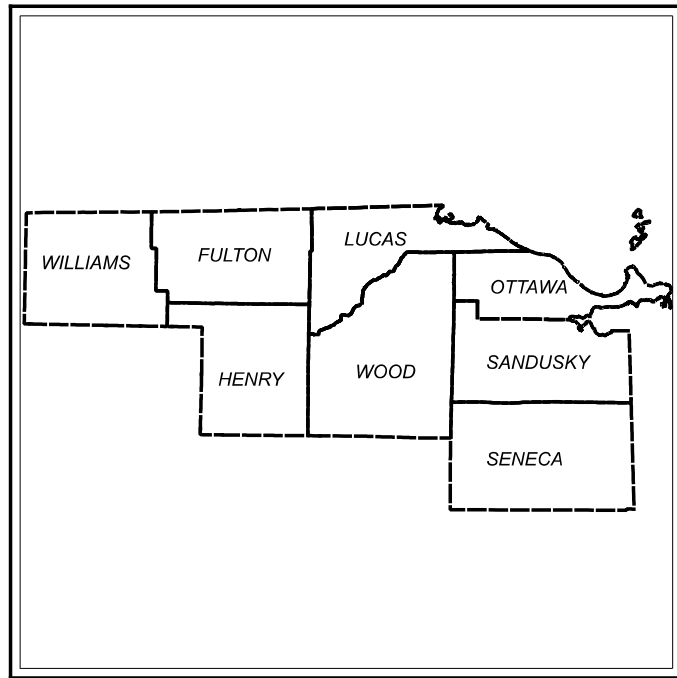

LOCATION MAP

LATITUDE: 41°23'07" LONGITUDE: 83°38'48"



FEDERAL PROJECT NUMBER

NON-FEDERAL

RAILROAD INVOLVEMENT

NONE

PROJECT DESCRIPTION

A DISTRICT WIDE CRACK SEALING PROJECT TO SEAL VARIOUS ROUTES IN THE COUNTIES OF WILLIAM, FULTON, HENRY, LUCAS, WOOD, SANDUSKY, SENECA, AND OTTAWA.

EARTH DISTURBED AREAS

PROJECT EARTH DISTURBED AREA: N/A ACRES
ESTIMATED CONTRACTOR EARTH DISTURBED AREA: N/A ACRES
NOTICE OF INTENT EARTH DISTURBED AREA: N/A ACRES

INDEX OF SHEETS:

TITLE SHEET	1
GENERAL NOTES	2,3
GENERAL SUMMARY	4
SUBSUMMARY	5
LOCATION MAPS	6-13

2023 SPECIFICATIONS

THE STANDARD SPECIFICATIONS OF THE STATE OF OHIO, DEPARTMENT OF TRANSPORTATION, INCLUDING SUPPLEMENTAL SPECIFICATIONS LISTED IN THE PLANS, CHANGES LISTED IN THE PROPOSAL, AND THE SUPPLEMENTAL SPECIFICATION 800 VERSION INDICATED ON THE PROPOSAL SHALL GOVERN THIS IMPROVEMENT.

DESIGN EXCEPTIONS

NONE REQUIRED

ADA DESIGN WAIVERS

NONE REQUIRED

Pat McColley, PE
Pat McColley, P.E., S.I.
District 02 Deputy Director

Jack Marchbanks, PhD
Jack Marchbanks, PhD
Director, Department of Transportation

UNDERGROUND UTILITIES
Contact Two Working Days
Before You Dig

OHIO811.org
Before You Dig

OHIO811, 8-1-1, or 1-800-362-2764
(Non members must be called directly)

PLAN PREPARED BY:
ODOT DISTRICT 2
317 E POE RD.
BOWLING GREEN, OH 43402

ENGINEER'S SEAL



STANDARD CONSTRUCTION DRAWINGS				SUPPLEMENTAL SPECIFICATIONS	SPECIAL PROVISIONS
MT-95.30	7/19/19			890, 2023	7/19/24
MT-95.31	7/19/19			832	7/19/24
MT-95.32	4/19/19				
MT-95.60	4/19/19				
MT-95.61	4/19/19				
MT-98.10	1/17/20				
MT-98.20	4/19/19				
MT-98.22	1/17/20				
MT-98.28	1/17/20				
MT-98.29	1/17/20				
MT-98.30	7/16/21				
MT-99.20	4/19/19				

Added Supplemental Specification

TITLE SHEET

DESIGN AGENCY



DESIGNER

JWZ

REVIEWER

jmf MM-DD-YY

PROJECT ID

114912

SHEET TOTAL

1 13

D02-CS-FY2025

MODEL: Sheet PAPER: 17x11 (in.) DATE: 10/1/2024 TIME: 10:18:11 AM USER: jzlemms pwc:\ohio\dot-pw-bentley.com\shahid-pw-02\Documents\01 Active Projects\District 02_D02\114912\400-Engineering\Roadway\Sheets\114912_GT001.dgn