
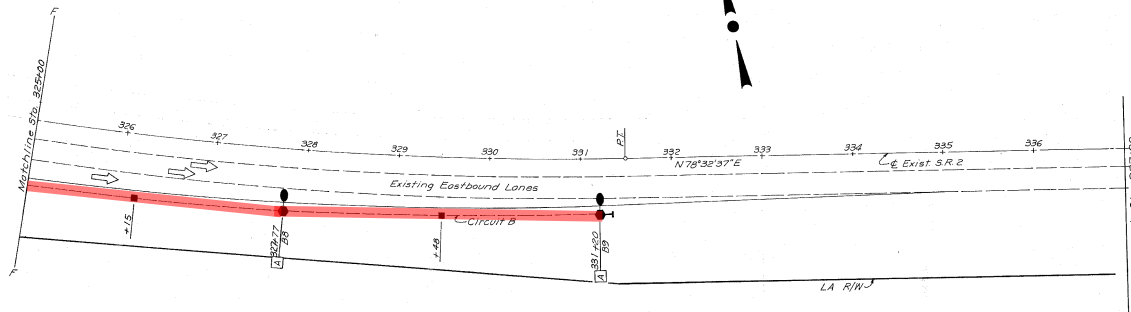


FED. RD. DIST. NO.	STATE	PROJECT	133
2	OHIO		146

LOR-2-5.86

Scale in Feet
0 50 100

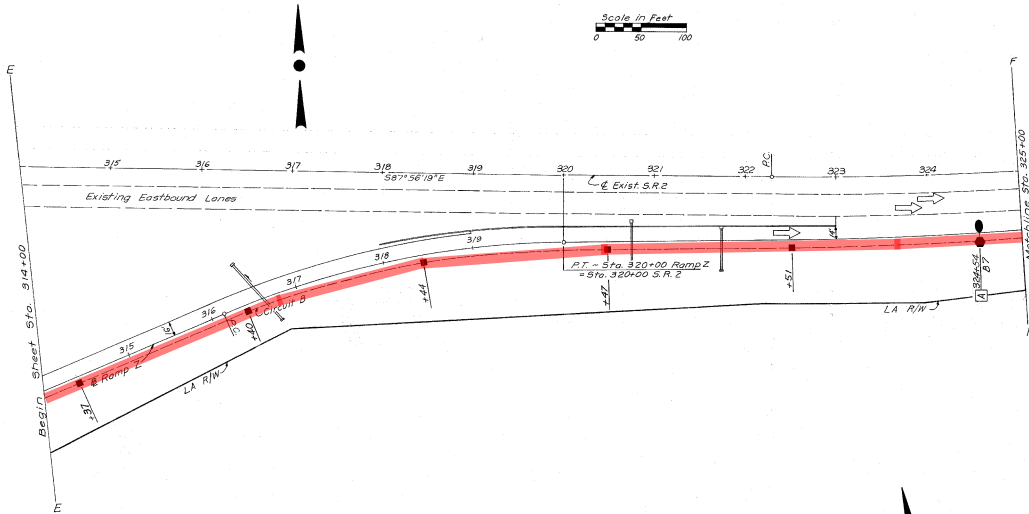

E.B. S.R. 2 - LIGHTING PLAN - STA. 314+00 to STA. 337+00