


LOR-2 & MIDDLE RIDGE RD

D03-LG-FY2010

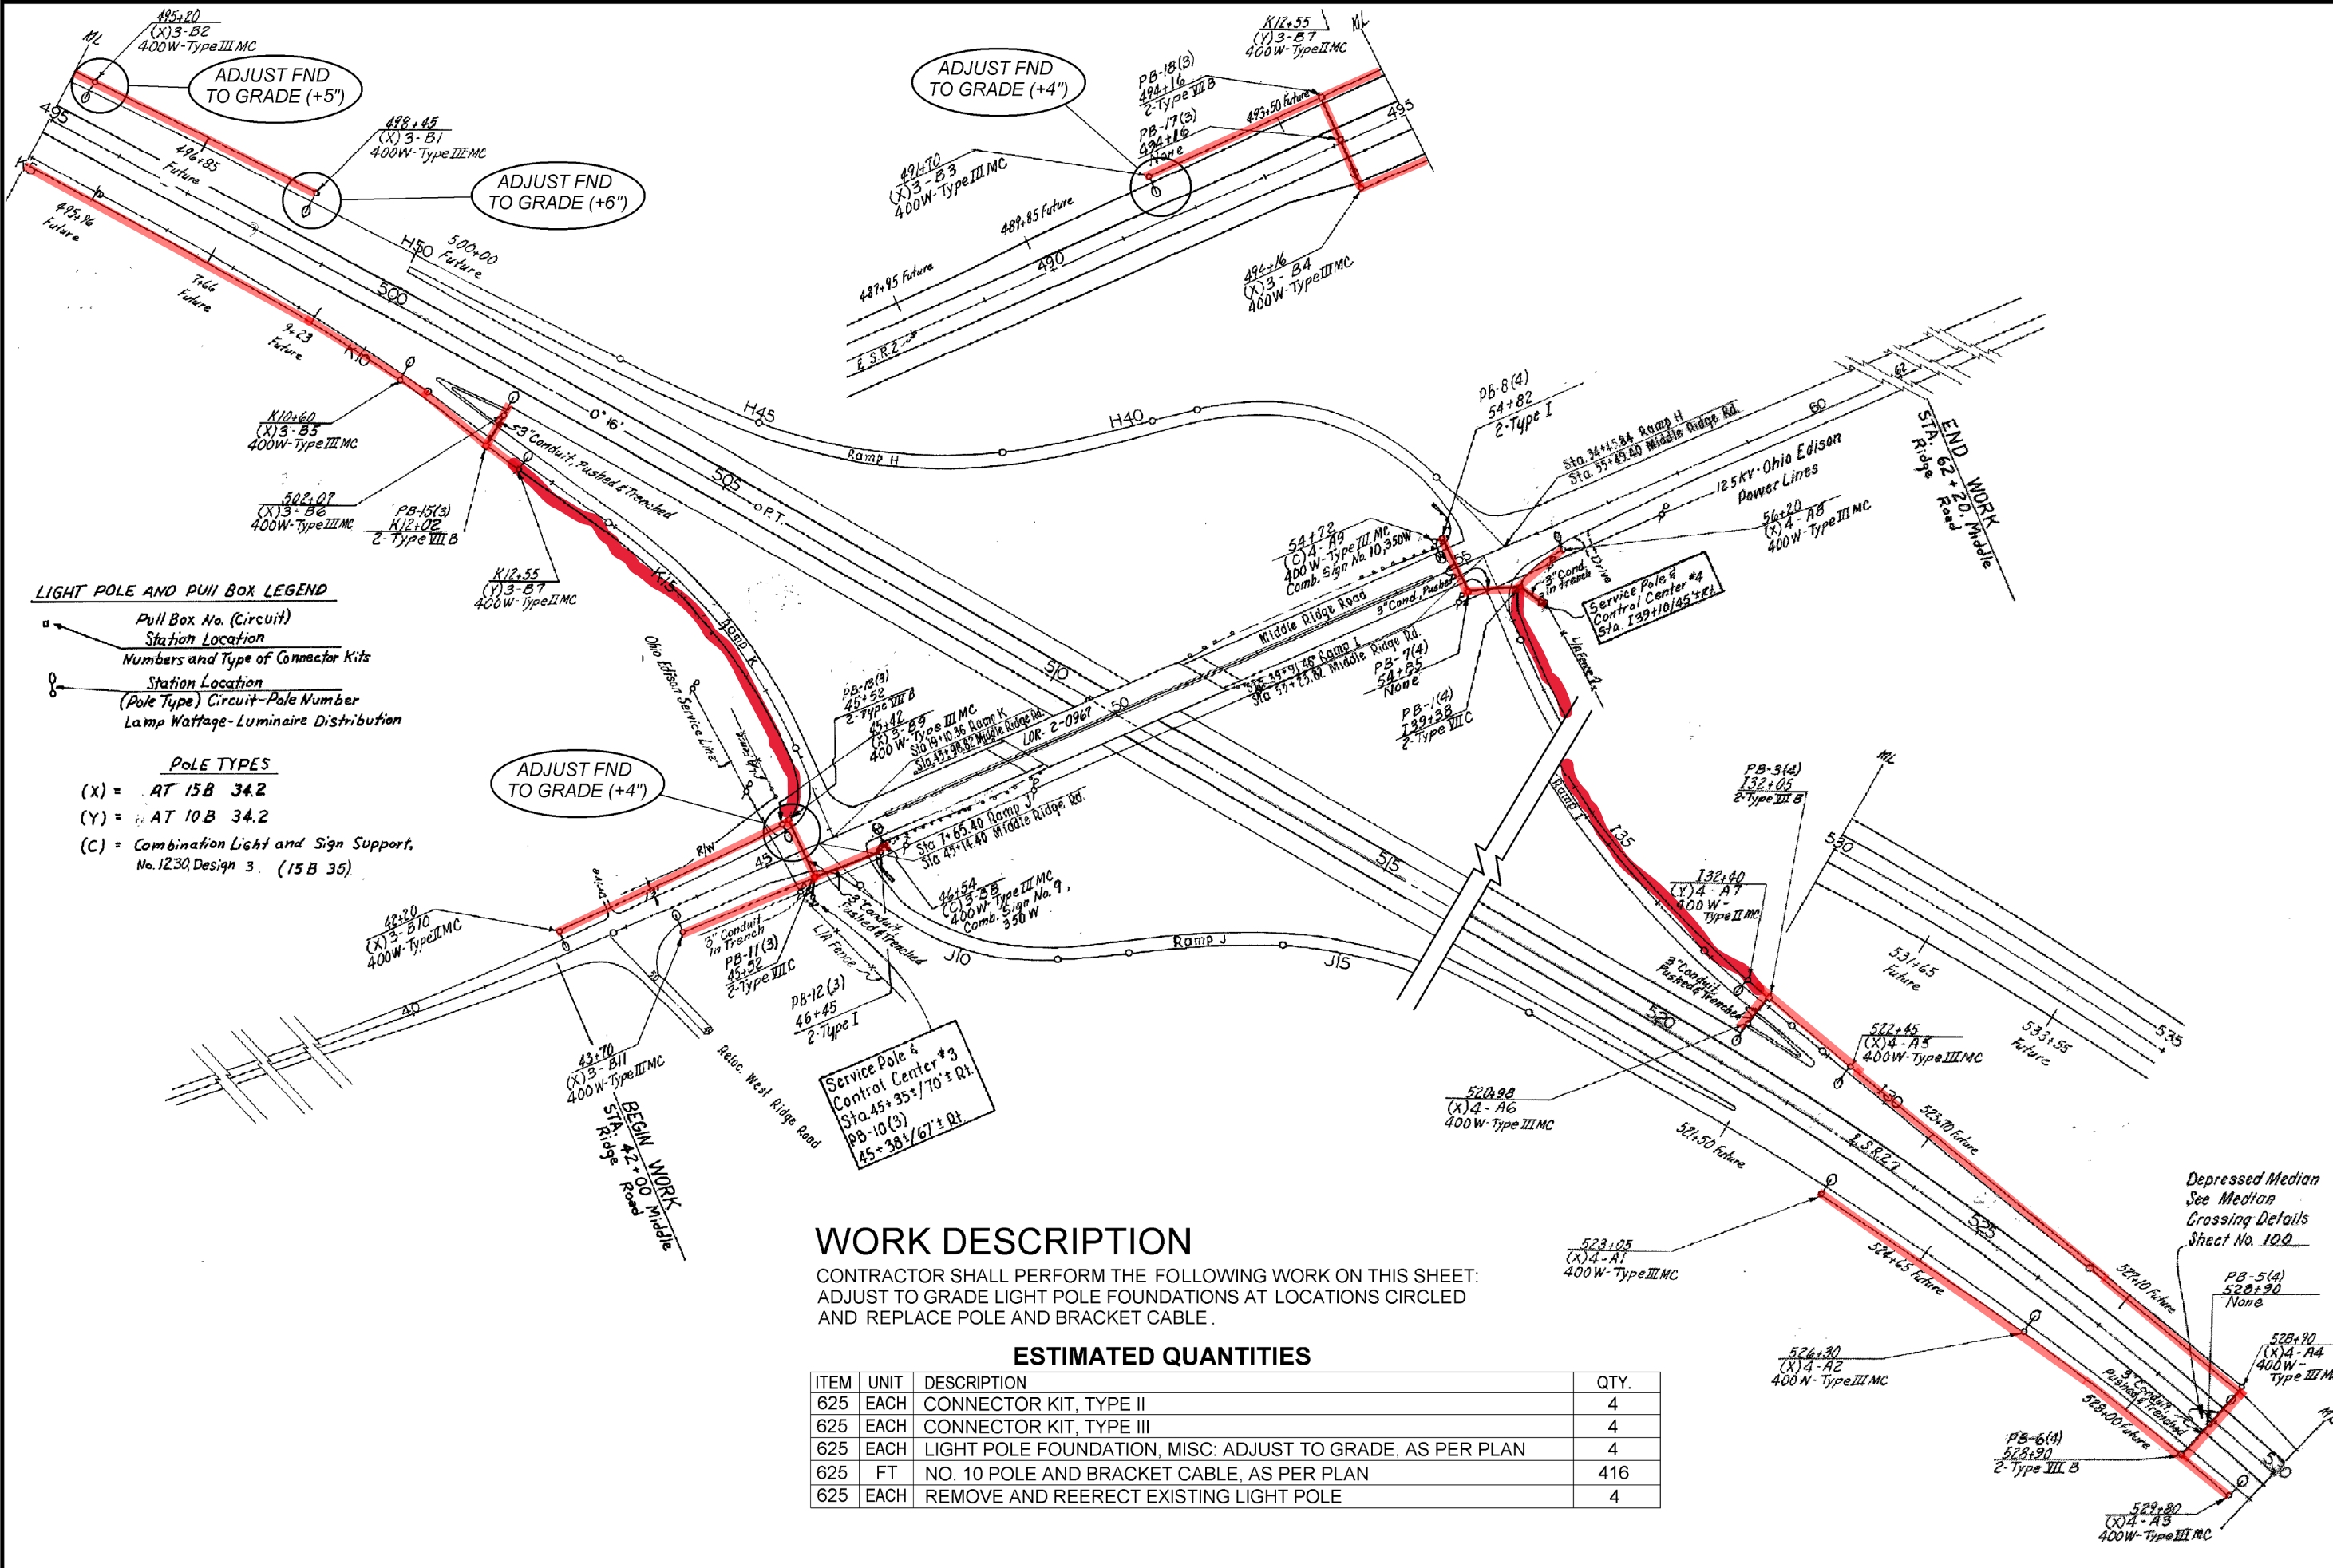

**LIGHT POLE AND PULL BOX LEGEND**

○ Pull Box No. (Circuit)  
Station Location  
Numbers and Type of Connector Kits

○ Station Location  
(Pole Type) Circuit-Pole Number  
Lamp Wattage-Luminaire Distribution

**POLE TYPES**

(X) = AT 15B 34.2  
(Y) = AT 10B 34.2  
(C) = Combination Light and Sign Support,  
No.1230, Design 3. (15B 35)

**WORK DESCRIPTION**

CONTRACTOR SHALL PERFORM THE FOLLOWING WORK ON THIS SHEET:  
ADJUST TO GRADE LIGHT POLE FOUNDATIONS AT LOCATIONS CIRCLED  
AND REPLACE POLE AND BRACKET CABLE.

**ESTIMATED QUANTITIES**

ITEM	UNIT	DESCRIPTION	QTY.
625	EACH	CONNECTOR KIT, TYPE II	4
625	EACH	CONNECTOR KIT, TYPE III	4
625	EACH	LIGHT POLE FOUNDATION, MISC: ADJUST TO GRADE, AS PER PLAN	4
625	FT	NO. 10 POLE AND BRACKET CABLE, AS PER PLAN	416
625	EACH	REMOVE AND REERECT EXISTING LIGHT POLE	4

Depressed Median  
See Median  
Crossing Details  
Sheet No. 100