


LOR-90 @ SR 83

D03-LG-FY2010

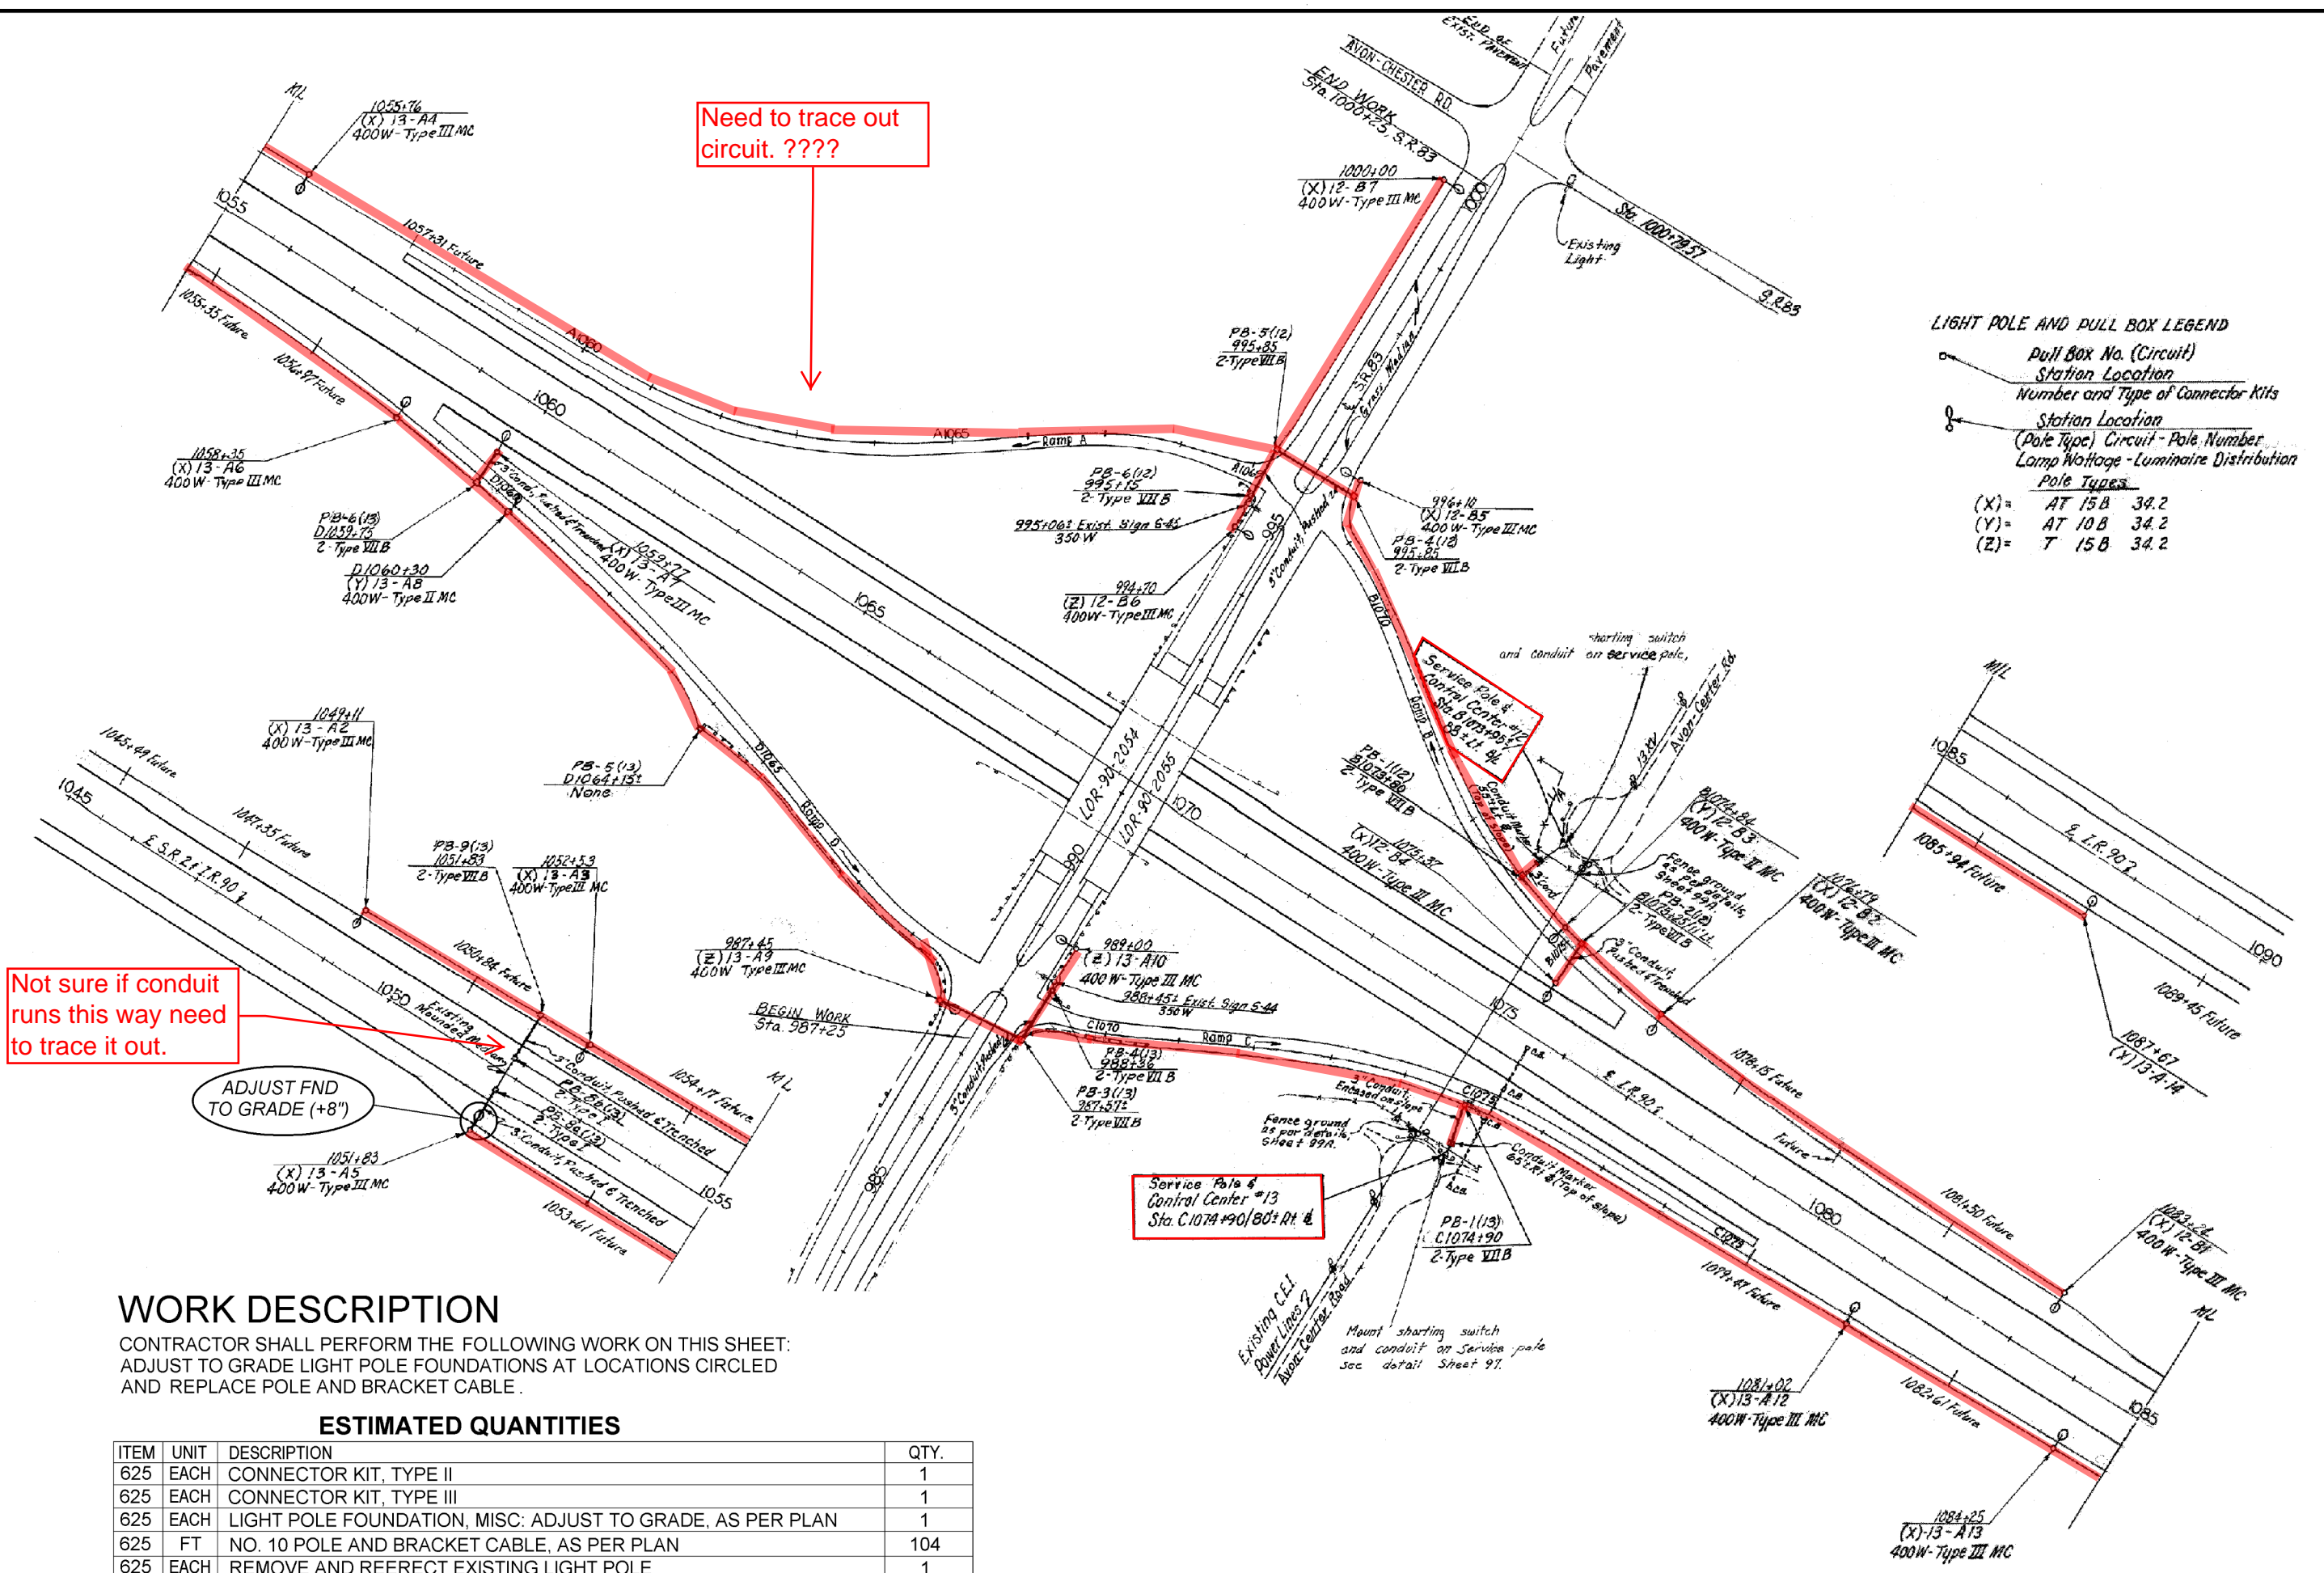

Need to trace out circuit. ????

Not sure if conduit runs this way need to trace it out.

ADJUST FND TO GRADE (+8")

LIGHT POLE AND PULL BOX LEGEND

Pull Box No. (Circuit)
Station Location
Number and Type of Connector Kits

Station Location
(Pole Type) Circuit - Pole Number
Lamp Woltage - Luminaire Distribution

Pole Types

(X) = AT 15 B 34.2
(Y) = AT 10 B 34.2
(Z) = T 15 B 34.2

WORK DESCRIPTION

CONTRACTOR SHALL PERFORM THE FOLLOWING WORK ON THIS SHEET:
ADJUST TO GRADE LIGHT POLE FOUNDATIONS AT LOCATIONS CIRCLED
AND REPLACE POLE AND BRACKET CABLE.

ESTIMATED QUANTITIES

ITEM	UNIT	DESCRIPTION	QTY.
625	EACH	CONNECTOR KIT, TYPE II	1
625	EACH	CONNECTOR KIT, TYPE III	1
625	EACH	LIGHT POLE FOUNDATION, MISC: ADJUST TO GRADE, AS PER PLAN	1
625	FT	NO. 10 POLE AND BRACKET CABLE, AS PER PLAN	104
625	EACH	REMOVE AND REERECT EXISTING LIGHT POLE	1