



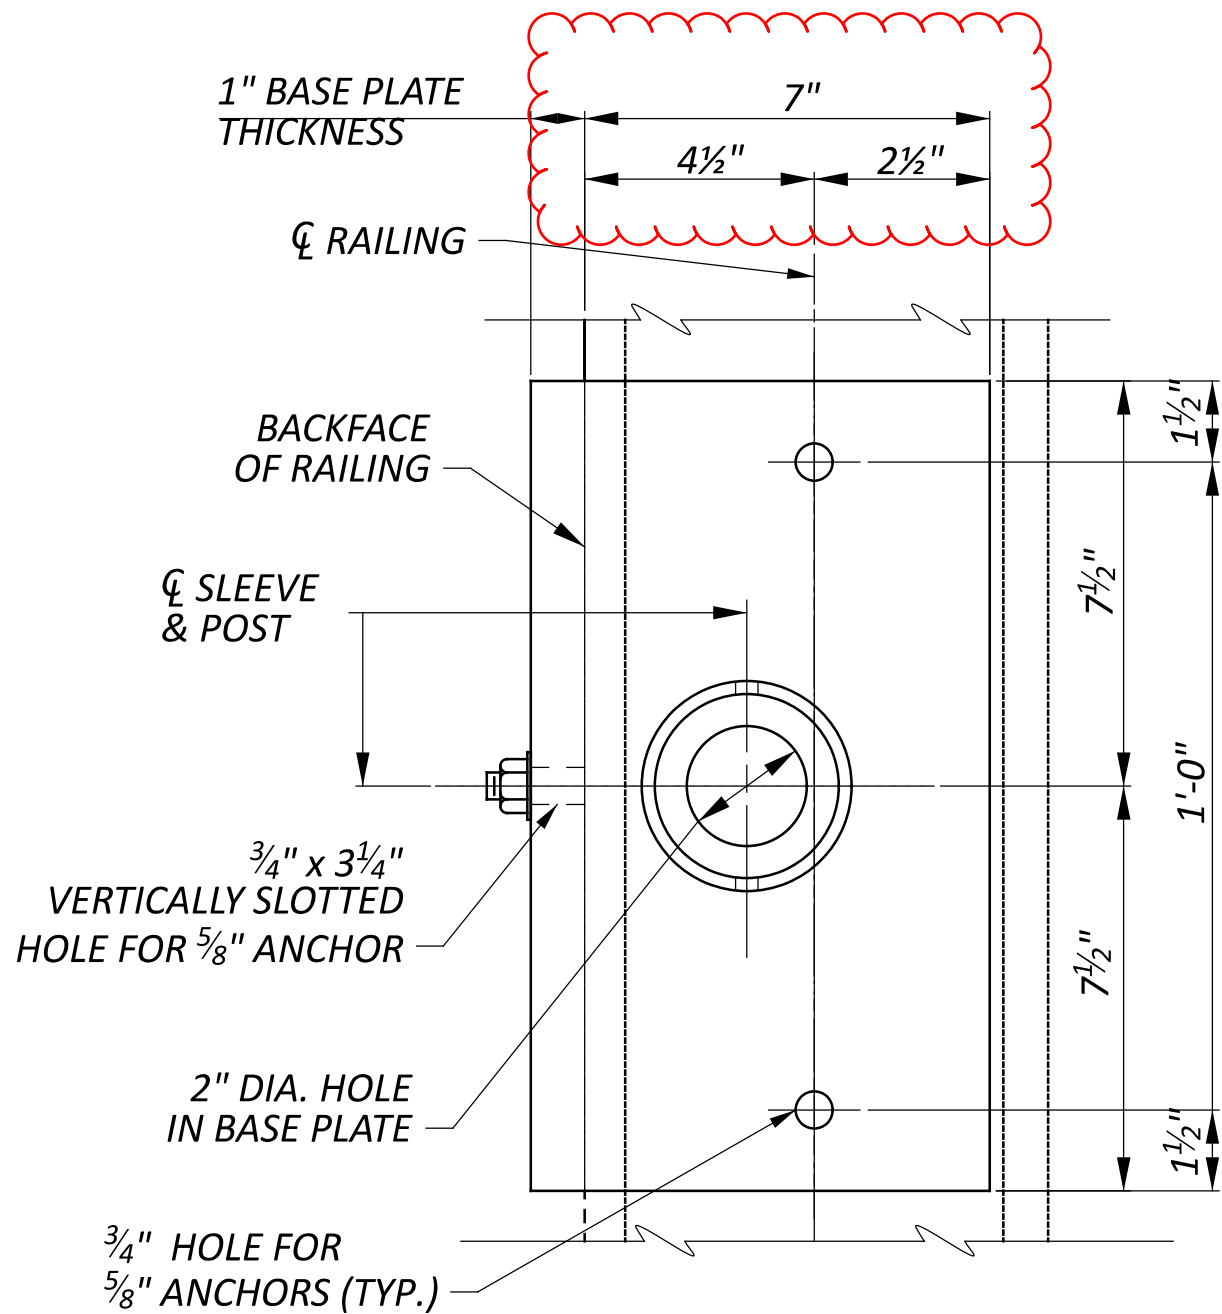


PLAN VIEW BP-2M

SHIM POSITIONS, POST AND SET SCREWS NOT SHOWN
SEE SCD VPF-1-24 FOR ADDITIONAL DETAILS

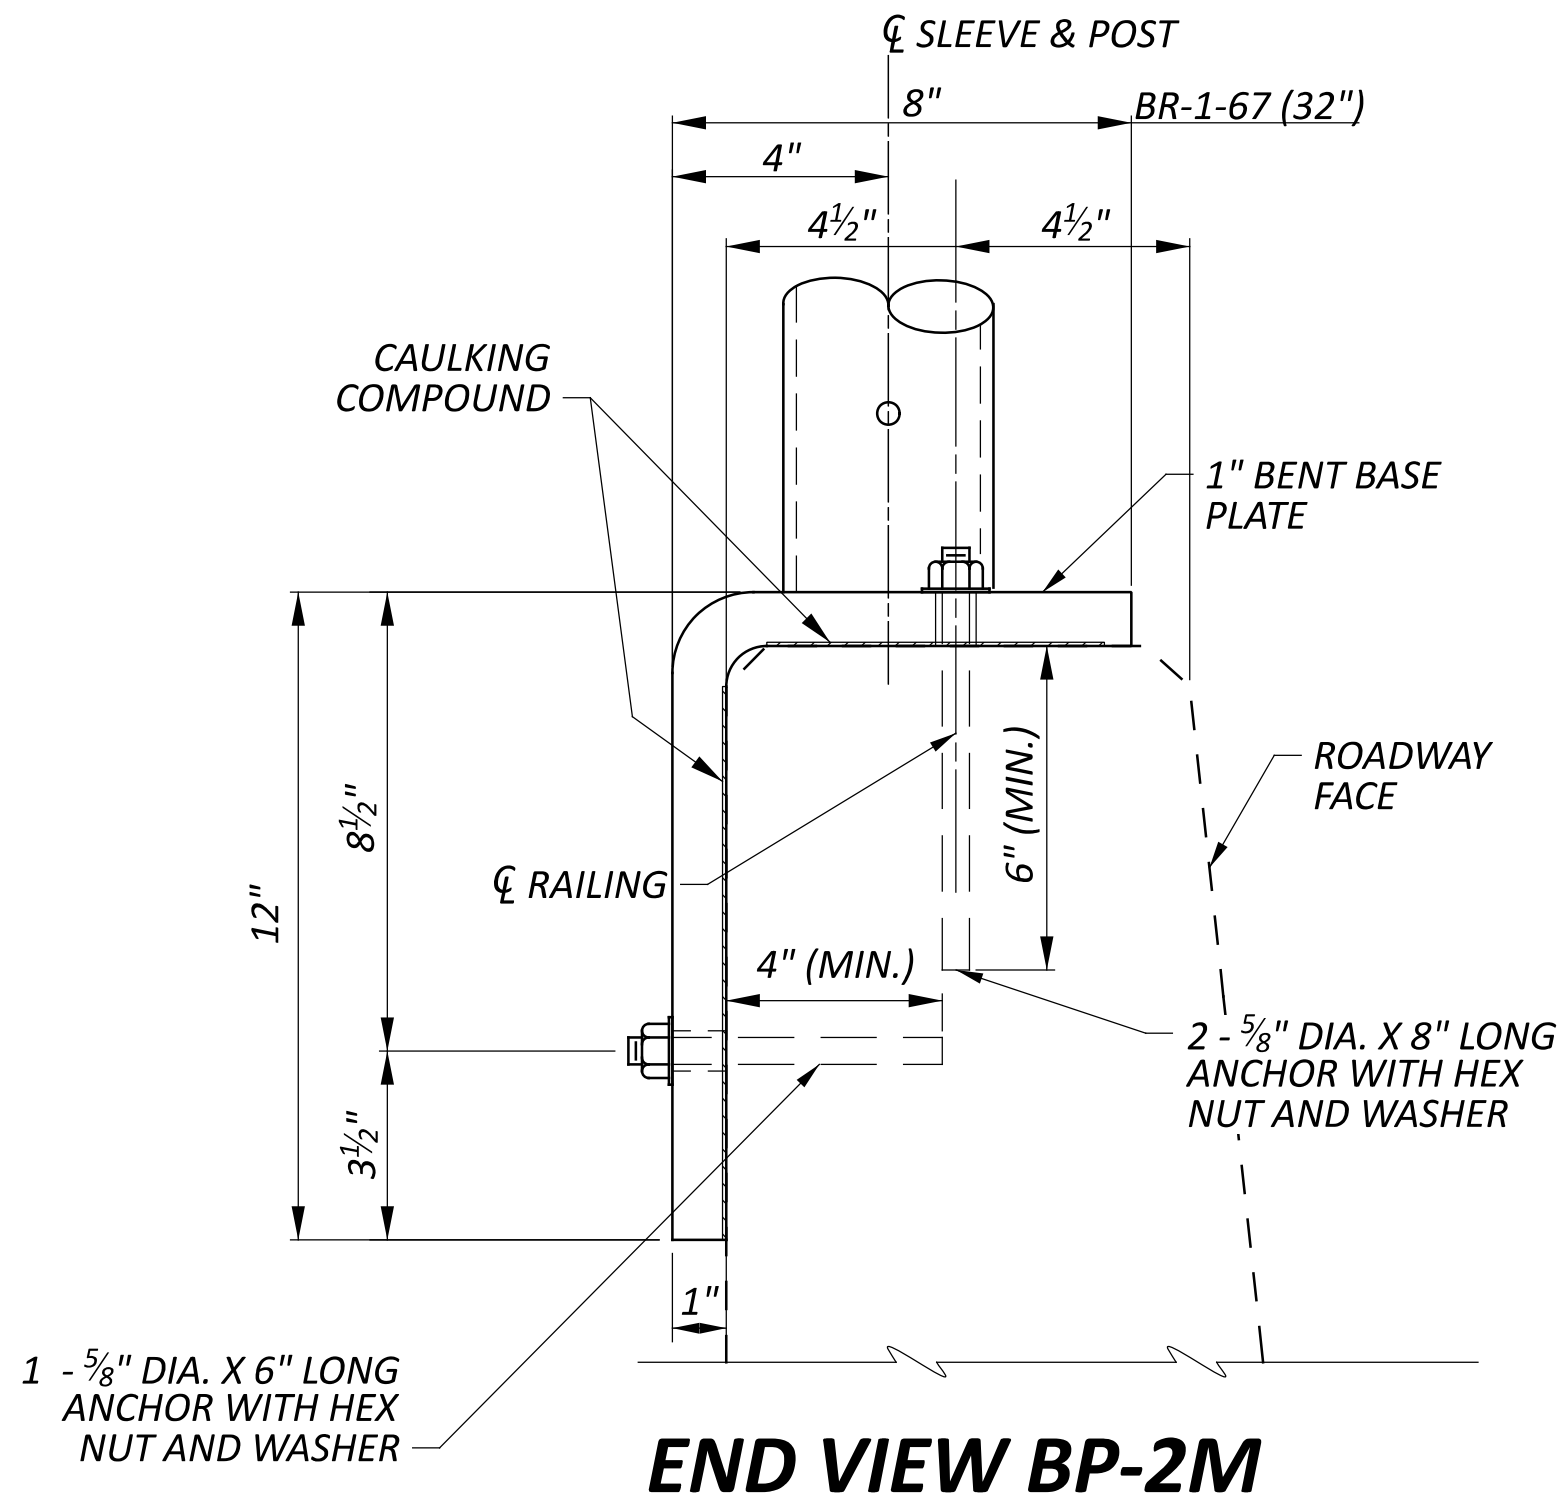

END VIEW BP-2M

BP-2M SHALL BE USED WITH PS-2 POST SECTIONS ON CONCRETE
RAILING SHOWN ON STANDARD BRIDGE DRAWING BR-1-67.
BP-2M REQUIRES A SLEEVE. SEE VPF-1-24 FOR ADDITIONAL
DETAILS.

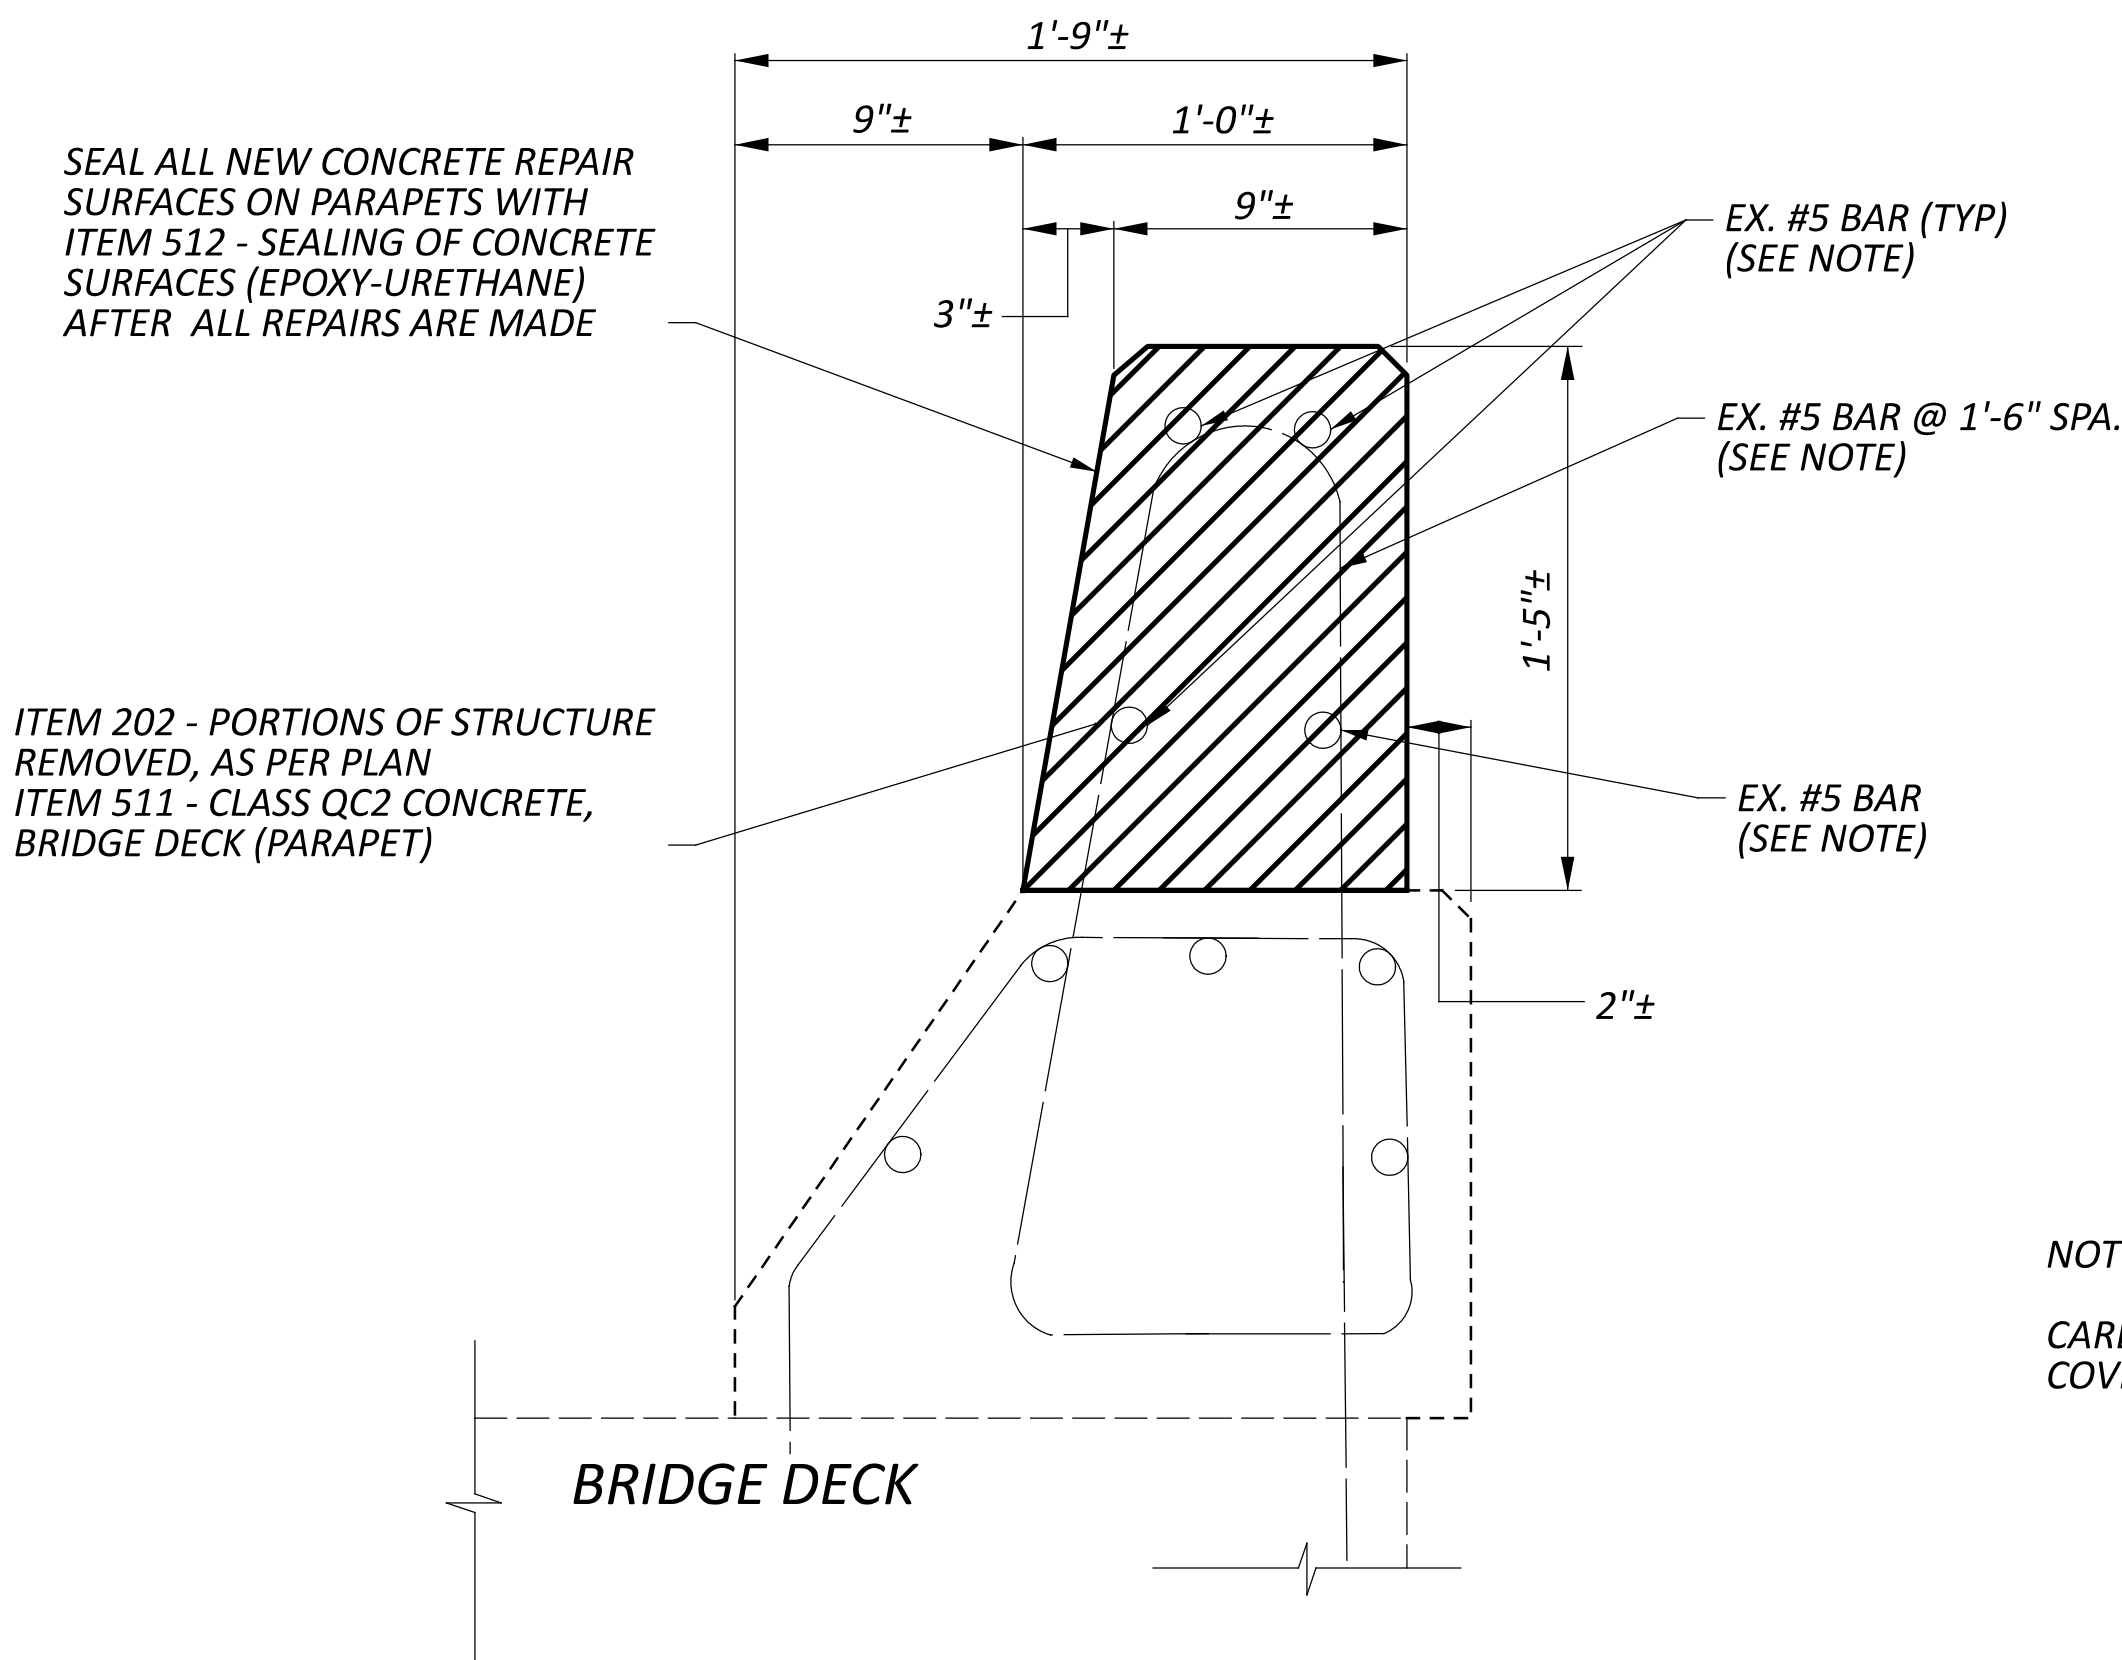


PARAPET REPAIR DETAIL

NOTE:

CAREFULLY DEFORM THE #5 BAR AS NEEDED OR PROVIDE ADDITIONAL CONCRETE
COVER OVER BARS WHERE INSUFFICIENT COVER EXISTS.

LEGEND

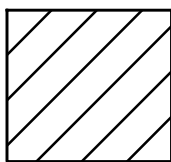

ITEM 202 - PORTIONS OF STRUCTURE REMOVED, AS PER PLAN
ITEM 511 - CLASS QC2 CONCRETE, BRIDGE DECK (PARAPET)
(LOCATION AND QUANTITY TO BE VERIFIED BY THE
ENGINEER PRIOR TO PERFORMING WORK)

STRUCTURE DETAILS

RIC-30-1443

MCELROY RD OVER US-30

SFN	
7001479	
DESIGN AGENCY	
DISTRICT 3	
ENGINEERING TEAM ONE	
DESIGNER	CHECKER
JDW	JNC
REVIEWER	
ACM 06-18-25	
PROJECT ID	
112293	
SUBSET	TOTAL
2	2
SHEET	TOTAL
P.13	P.13