


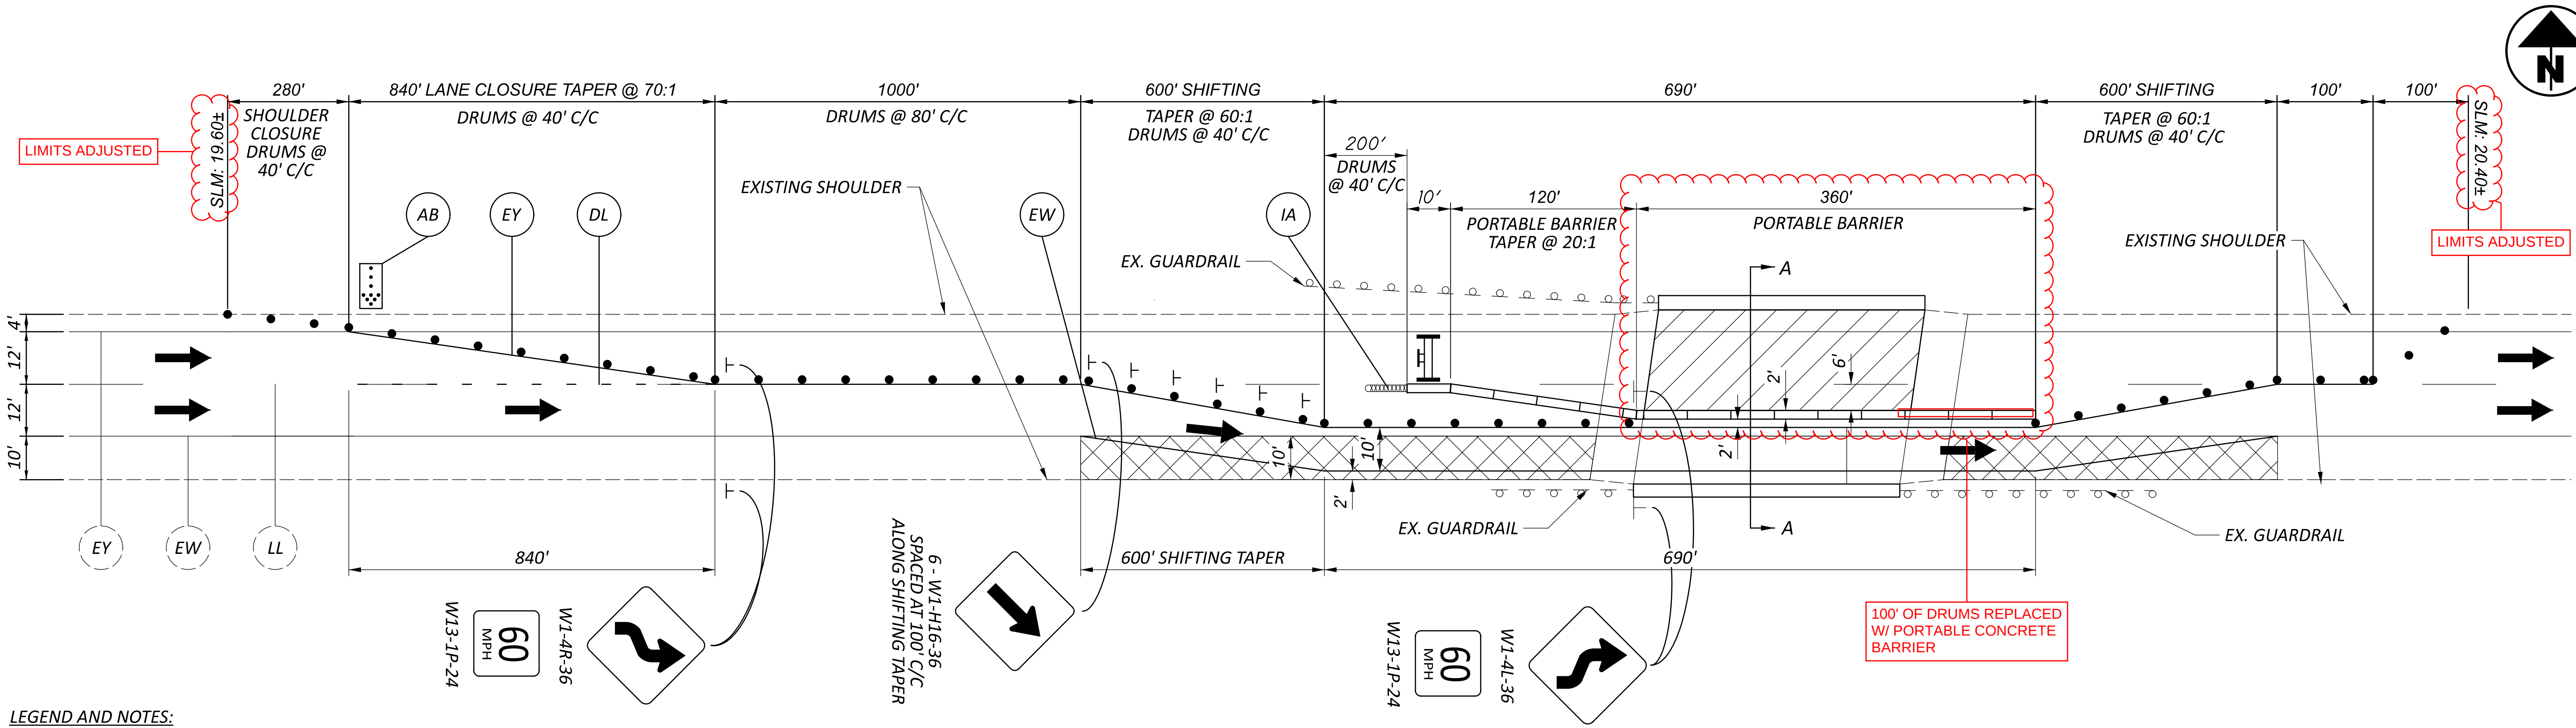


LEGEND AND NOTES:

1. INCLUDE SIGNS PER SCD MT-95.30 AND MT-95.50.

ITEM 202 - PAVEMENT REMOVED AND
ITEM 615 - PAVEMENT FOR MAINTAINING TRAFFIC, CLASS A

WORK ZONE

- EY EXISTING EDGE LINE (YELLOW)
- EW EXISTING EDGE LINE (WHITE)
- LL EXISTING LANE LINE
- EY WORK ZONE EDGE LINE (YELLOW)
- EW WORK ZONE EDGE LINE (WHITE)
- DL WORK ZONE DOTTED LINE
- IA WORK ZONE IMPACT ATTENUATOR
- AB ARROW BOARD

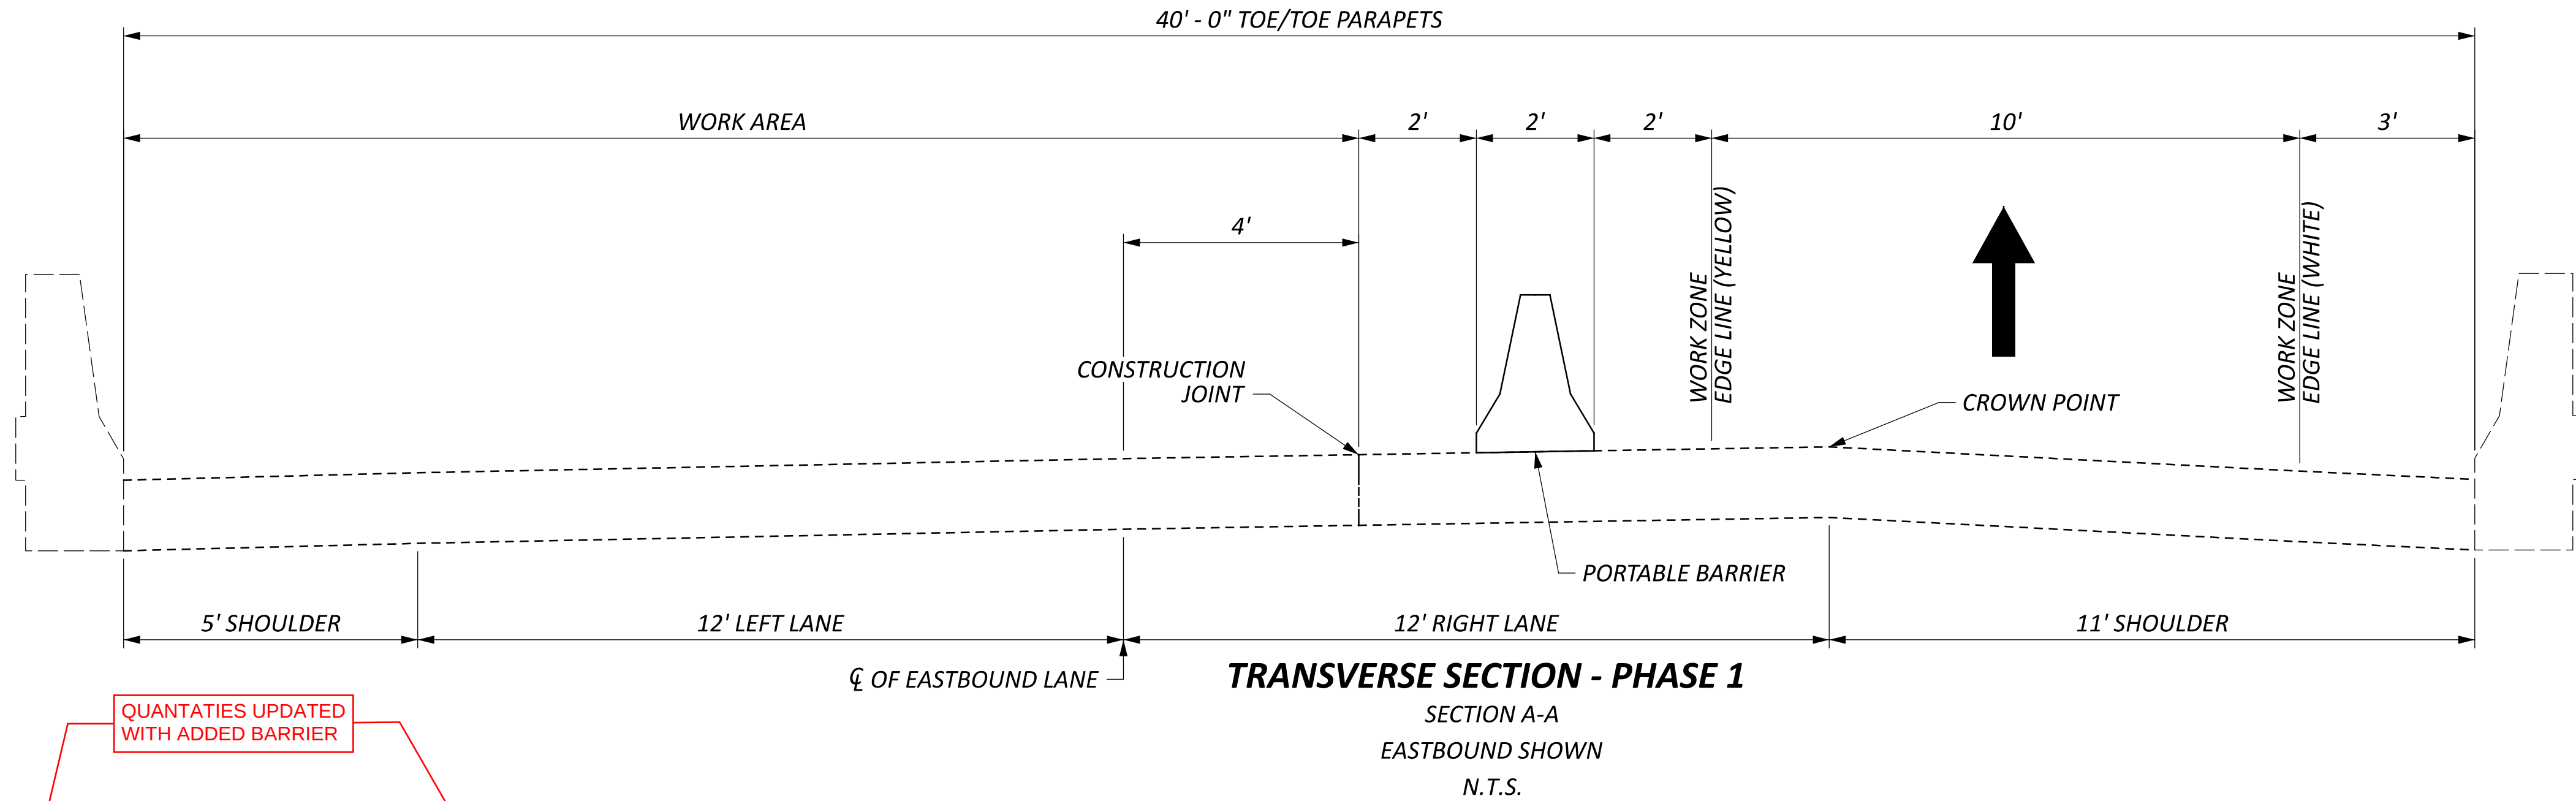

QUANTITIES UPDATED
WITH ADDED BARRIER

MOT SUBSUMMARY

STRUCTURE	202	614	614	614	614	614	615	622	614
	SY	FT	EACH	EACH	MILE	FT	SY	FT	EACH
POR-76-20.081L	1756	60	1	21	1.08	840	1756	490	50
POR-76-20.084R	1756	60	1	21	1.08	840	1756	490	50
TOTALS CARRIED TO GENERAL SUMMARY	3512	120	2	42	2.16	1680	3512	980	100

HORIZONTAL
SCALE IN FEET
0 NOT TO SCALE

MAINTENANCE OF TRAFFIC SCHEMATIC PLAN - PHASE 1
POR-76-20.081L & POR-76-20.084R

DESIGN AGENCY




DESIGNER
CLG

REVIEWER
MJA 04-10-25

PROJECT ID
121533


SHEET TOTAL
P.7C P.16

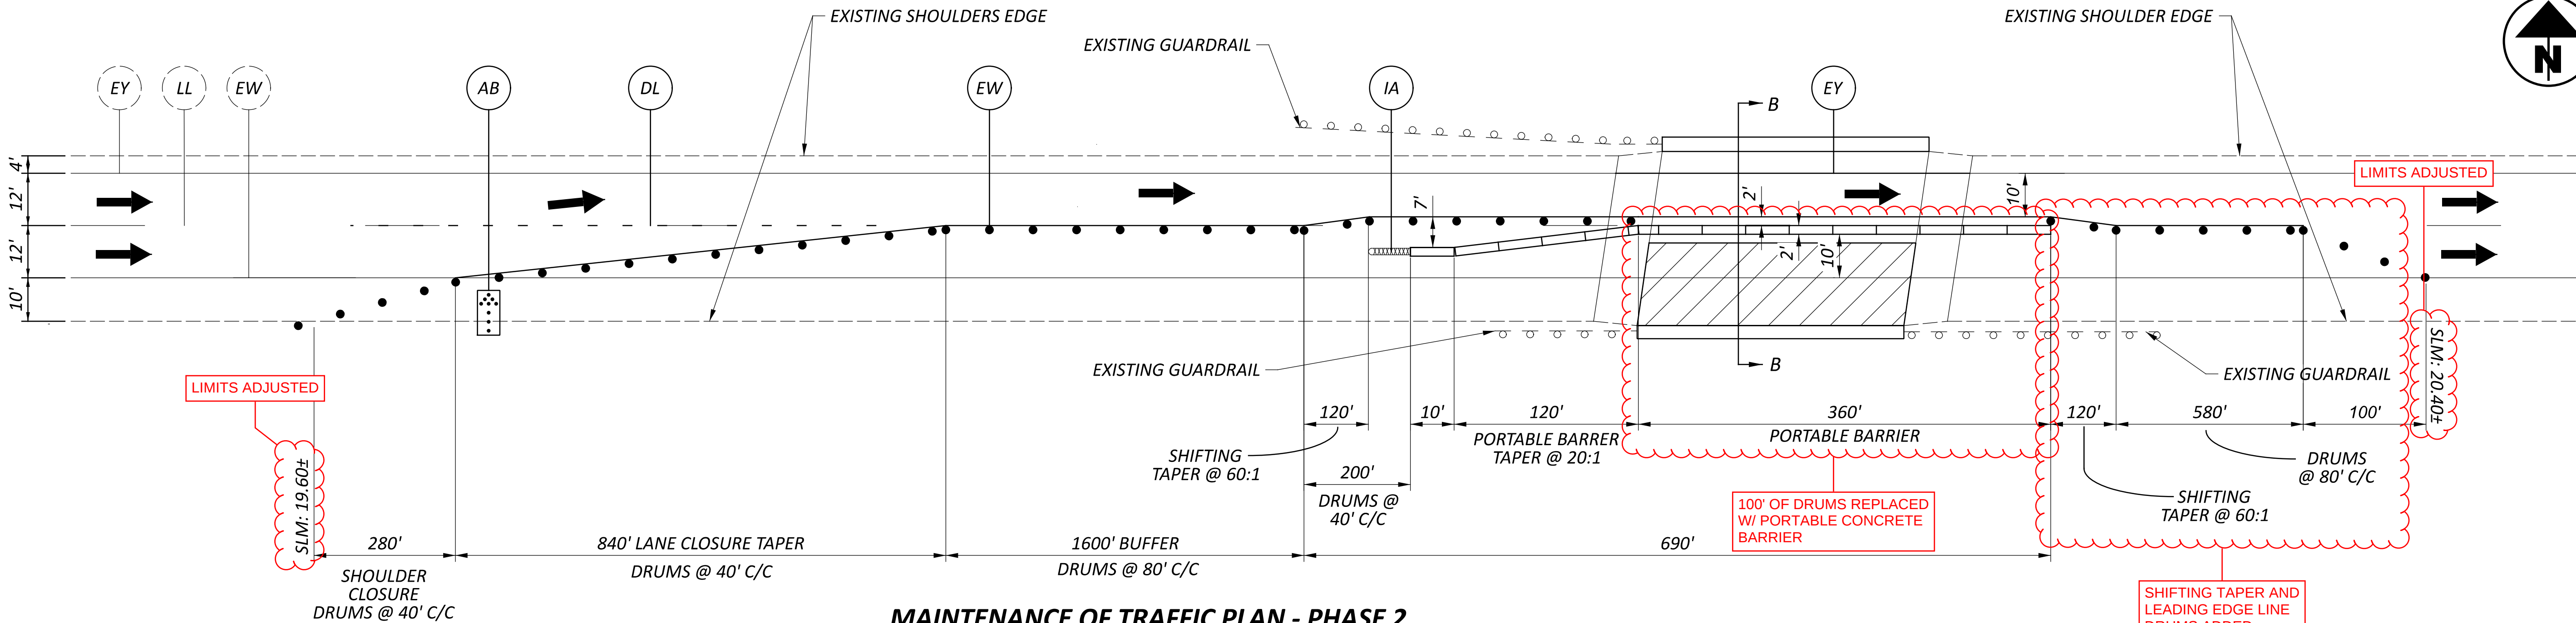

LEGEND AND NOTES:

1. INCLUDE SIGNS PER SCD MT-95.30 AND MT-95.50.
2. WORK ZONE DOTTED LINE TO REMAIN FROM PREVIOUS PHASE.

- WORK ZONE
- EY EXISTING EDGE LINE (YELLOW)
- EW EXISTING EDGE LINE (WHITE)
- LL EXISTING LANE LINE
- EY WORK ZONE EDGE LINE (YELLOW)
- EW WORK ZONE EDGE LINE (WHITE)
- DL WORK ZONE DOTTED LINE
- IA WORK ZONE IMPACT ATTENUATOR
- AB ARROW BOARD

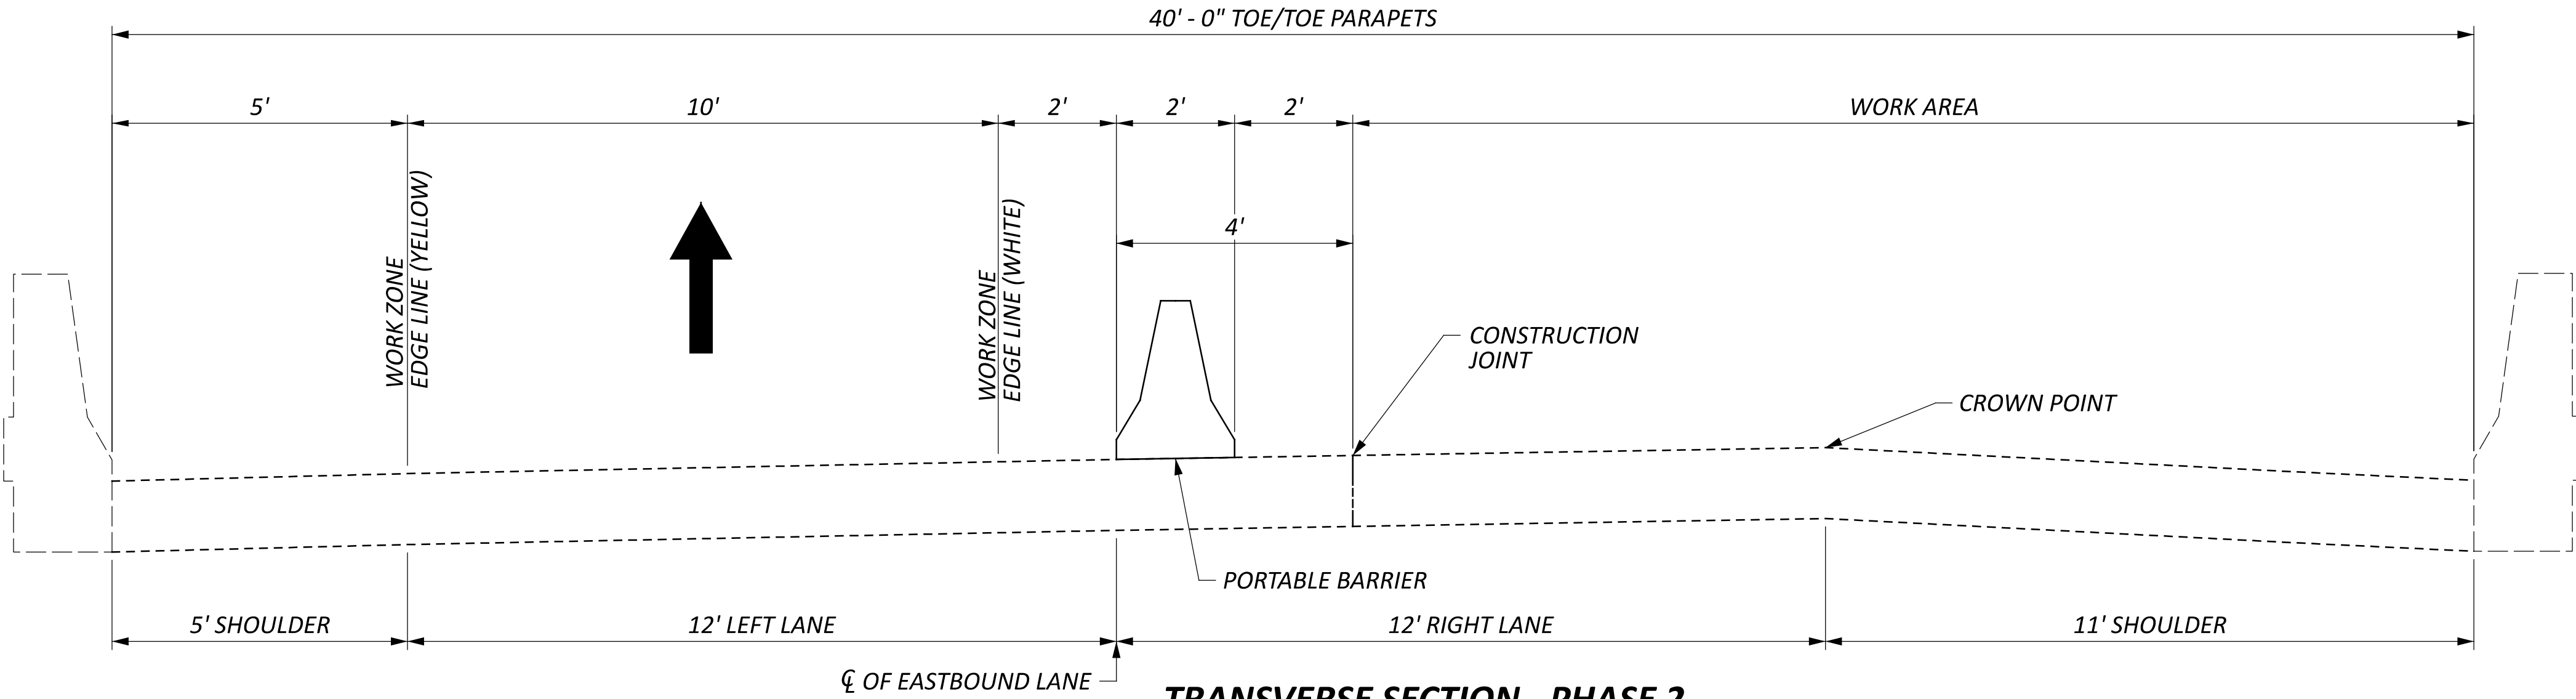

MOT SUBSUMMARY

STRUCTURE	614	614	614	614	622	614
	INCREASED BARRIER DELINEATION	WORK ZONE IMPACT ATTENUATOR, 24" WIDE HAZARDS, (UNIDIRECTIONAL)	OBJECT MARKER, ONE WAY	WORK ZONE EDGE LINE CLASS III, 6", 642 PAINT	PORTABLE BARRIER, UNANCHORED	BARRIER REFLECTOR, TYPE 1, (ONE-WAY)
	FT	EACH	EACH	MILE	FT	EACH
POR-76-20.081L	60	1	21	0.78	490	50
POR-76-20.084R	60	1	21	0.78	490	50
TOTALS CARRIED TO GENERAL SUMMARY	120	2	42	1.56	980	100

QUANTATIES UPDATED WITH ADDED BARRIER + EDGE LINE LENGTH



GENERAL SUMMARY	
DESIGN AGENCY	
	
DESIGNER	
CLG	
REVIEWER	
MJA	04-07-25
PROJECT ID	
121533	
SHEET	TOTAL
P.8	P.16