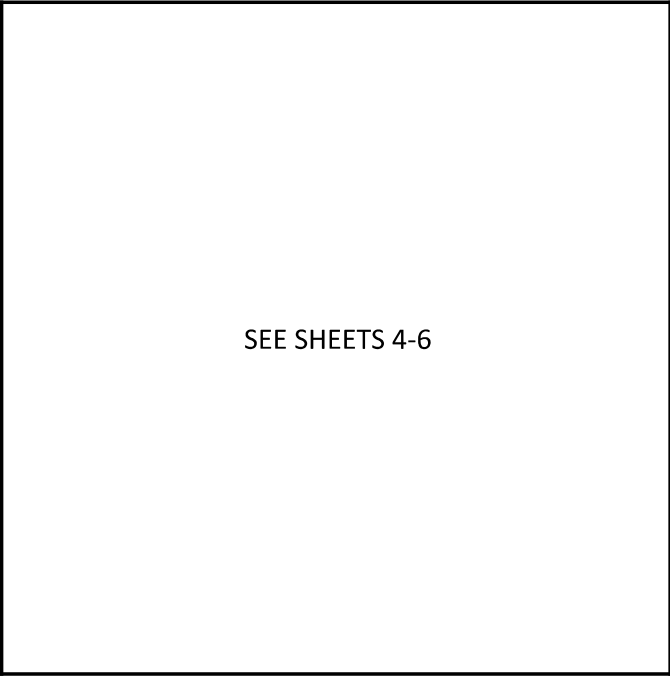




LOCATION MAP

LATITUDE: 39° 57' 06" LONGITUDE: 82° 24' 41"

DESIGN DESIGNATION
N/A

DESIGN EXCEPTIONS
NONE

ADA DESIGN WAIVER
NONE REQUIRED

UNDERGROUND UTILITIES

Contact Two Working Days
Before You Dig


Before You Dig

OHIO811, 8-1-1, or 1-800-362-2764
(Non-members must be called directly)

PLAN PREPARED BY:
OHIO DEPARTMENT OF TRANSPORTATION
DISTRICT 5 ENGINEERING

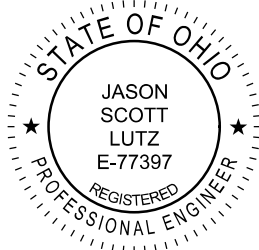
STATE OF OHIO
DEPARTMENT OF TRANSPORTATION

D05-PM-FY2025(A)
FAST DRY EAST

COSHOCTON, GUERNSEY, AND MUSKINGUM COUNTIES

INDEX OF SHEETS

TITLE SHEET	1
GENERAL NOTES	2
MAINTENANCE OF TRAFFIC NOTES	3
LOCATION MAPS	4-6
PAVEMENT MARKING DATA	7-16
GENERAL SUMMARY	17

ENGINEER'S SEAL	STANDARD CONSTRUCTION DRAWINGS					SUPPLEMENTAL SPECIFICATIONS	
	MT-95.30	7/19/19				800	1/17/25
	MT-95.31	7/19/19				821	4/20/12
	MT-95.32	4/19/19				832	7/19/24
	MT-95.60	4/19/19				921	7/19/24
	MT-95.61	4/19/19					
	MT-97.10	4/19/19					
	MT-98.11	1/17/20					
	MT-98.22	1/17/20					
	MT-99.20	4/19/19					SPECIAL PROVISIONS
	MT-105.10	1/17/20					
	TC-71.10	4/21/23					
	TC-72.20	7/21/23					
	TC-73.20	7/19/24					
TC-74.10	7/21/23						

FEDERAL PROJECT NUMBER
NON-FEDERAL

RAILROAD INVOLVEMENT
NONE

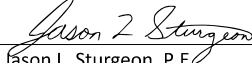
PROJECT DESCRIPTION
DISTRICT WIDE FAST DRY LONG LINE AND AUXILIARY
PAVEMENT MARKING PROJECT AT VARIOUS LOCATIONS
IN COSHOCTON, GUERNSEY, AND MUSKINGUM COUNTIES.

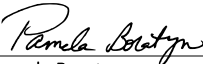
PROJECT EARTH DISTURBED AREA = N/A (MAINTENANCE)
ESTIMATED CONTRACTOR EARTH DISTURBED AREA = N/A
NOTICE OF INTENT EARTH DISTURBED AREA = N/A

2023 SPECIFICATIONS

THE STANDARD SPECIFICATIONS OF THE STATE OF OHIO, DEPARTMENT OF TRANSPORTATION, INCLUDING CHANGES LISTED IN THE PROPOSAL SHALL GOVERN THIS IMPROVEMENT.

I HEREBY APPROVE THESE PLANS AND DECLARE THAT THE MAKING OF THIS IMPROVEMENT WILL NOT REQUIRE THE CLOSING TO TRAFFIC OF THE HIGHWAY AND THAT PROVISIONS FOR THE MAINTENANCE AND SAFETY OF TRAFFIC WILL BE AS SET FORTH ON THE PLANS AND ESTIMATES.

DISTRICT DEPUTY DIRECTOR

Jason L. Sturgeon, P.E.
05

DIRECTOR, DEPARTMENT OF TRANSPORTATION

Pamela Boratyn

TITLE SHEET

DESIGN AGENCY


DESIGNER
RMA

REVIEWER
JSL 12/01/24

PROJECT ID
104996

SHEET 1 | TOTAL 17

ITEM 642 FAST DRY PAVEMENT MARKINGS																								
COUNTY	ROUTE	DESCRIPTION	EDGE LINE 6"		LANE LINE	CENTER LINE	EQUIVALENT SOLID CENTER LINE	CHANNELIZING LINE		STOP LINE 24"	CROSSWALK LINE 12"	RAILROAD MARKING SYMBOL	SCHOOL SYMBOL MARKING 96"	LANE ARROW 96"					LANE REDUCTION ARROW	WRONG WAY ARROW	WORD ON PAVEMENT 96"	DOTTED LINE 6"	YIELD LINE	SPEED MEASUREMENT MARKING, AS PER PLAN
			INFO ONLY	8"			12"	LEFT	RIGHT					THRU/ LEFT	THRU/ RIGHT	THRU	ONLY							
					WHITE	YELLOW				MILE	MILE	MILE	MILE					FT	FT	FT	FT	EACH	EACH	EACH
		TOTAL FROM PREVIOUS SHEET	135.03	75.92	82.00	33.47	51.92	845	28,746	647				43	2					20	2	20,239		14
GUE	I.R. 77	U.S. 22 INTERCHANGE																						
		NE RAMP (NB ON-RAMP)	0.11	0.11					1,600													930		
		NW SLIP	0.03	0.03																				
		NW RAMP (SB OFF-RAMP)	0.31	0.31					640	23									2			510		
		NW LOOP (SB ON-RAMP)	0.23	0.23					1,580										1			1,233		
		SE RAMP (NB OFF-RAMP)	0.13	0.13					600													520		
		SE SLIP	0.02	0.02						30									2					
		11.70-17.70	12.00	12.00	12.00																			
		17.70-23.44	11.48	11.48	11.48																			
		S.R. 541 INTERCHANGE																						
		RAMP A (SB ON-RAMP)	0.18	0.18					948													1,030		
		RAMP B (NB OFF-RAMP)	0.22	0.22					620	52									2			511		
		RAMP C (SB OFF RAMP)	0.15	0.15					686	61									2			490		
		RAMP D (NB ON-RAMP)	0.24	0.24					1,370													1,075		
GUE	S.R. 83	0.71-11.29	21.16			10.58	18.40			25	137													
GUE	S.R. 209	0.00-7.64	15.28			7.64	14.90																	
		SKIP 7.64-10.72 (CAMBRIDGE CORP.)																						
		10.72-11.32	1.10		1.10	1.10	6.25	1,394		158				18	2						8			
		11.32-14.57	5.38		1.72	4.11		1,512		174	261	6	2	14	4		1				8			
		14.57-14.70	0.26		0.08	0.13																		
		14.70-14.75 (VOCATIONAL RD.)	0.09			0.06																		
GUE	S.R. 265	0.00-4.59	9.18			4.59	24.52			25														
		4.59-17.63	26.08			13.04				43	257													
NOB	S.R. 265	0.00-0.32	0.64			0.32	0.62																	
BEL	S.R. 265	0.00-0.41	0.82			0.41	0.31																	
TOTALS CARRIED TO NEXT SHEET			240.12	101.02	108.38	75.45	116.92	3,751	36,790	1,238	655	6	2	75	8		1			29	18	26,538		14

REMOVE EXISTING "SCHOOL" MARKINGS ON GUE-209 AT SLM 12.23 AND 12.63.
THE FOLLOWING QUANTITY IS BEING CARRIED TO THE GENERAL SUMMARY.

ITEM 642, REMOVAL OF PAVEMENT MARKING: 2 EACH

GUERNSEY COUNTY DATA

DESIGN AGENCY



DESIGNER

RMA

REVIEWER

JSL 12/01/24

PROJECT ID

104996

SHEET

11

TOTAL

17

ITEM 642 FAST DRY PAVEMENT MARKINGS																								
COUNTY	ROUTE	DESCRIPTION	EDGE LINE 6"		LANE LINE	CENTER LINE	EQUIVALENT SOLID CENTER LINE	CHANNELIZING LINE		STOP LINE 24"	CROSSWALK LINE 12"	RAILROAD MARKING SYMBOL	SCHOOL SYMBOL MARKING 96"	LANE ARROW 96"					LANE REDUCTION ARROW	WRONG WAY ARROW	WORD ON PAVEMENT 96"	DOTTED LINE 6"	YIELD LINE	SPEED MEASUREMENT MARKING, AS PER PLAN
			WHITE	YELLOW				8"	12"					LEFT	RIGHT	THRU/ LEFT	THRU/ RIGHT	THRU			ONLY			
			MILE	MILE	MILE	MILE	MILE	FT	FT	FT	FT	EACH	EACH	EACH	EACH	EACH	EACH	EACH	EACH	EACH	EACH	EACH	FT	FT
		TOTAL FROM PREVIOUS SHEET	240.12	101.02	108.38	75.45	116.92	3,751	36,790	1,238	655	6	2	75	8		1			29	18	26,538		14
GUE	S.R. 285	0.00-7.91	14.12			7.91	23.73			51	338		2										67	
		7.91-8.35 (U.S. 40 OVERLAP)																						
		8.35-9.47	2.24		1.12				51	150		2											20	
		9.47-13.48	8.02		4.01				16															
GUE	S.R. 313	0.00-1.24	2.48			1.24	2.44			24														
		1.24-2.23 (S.R. 83 OVERLAP)																						
		2.23-9.91	15.34			7.67	33.05			12													21	
		9.91-15.02	10.22		5.11				39	51	2													
		15.02-20.99	11.94		5.97																			
GUE	S.R. 340	0.00-0.86	1.72			0.86	1.53			10														
GUE	S.R. 541	0.00-8.32	16.64			8.32	13.53			17														
		8.32-8.45	0.26		0.13																			
GUE	S.R. 658	0.00-11.07	22.14			11.07	22.08			23														
GUE	S.R. 660	0.00-6.33	12.66			6.33	11.77	172		63				2	2					2				
GUE	S.R. 672	0.00-2.74	5.48			2.74	5.87																	
NOB	S.R. 672	0.00-0.37	0.74		0.37					14														
GUE	S.R. 723	0.00-0.44 (BRIDGE)	SEE GUE I.R. 70/ S.R. 723 INTERCHANGE SW RAMP (SHEET 9)																					
		0.44-0.85	0.53	0.53	0.44			600		28				2	2					2				
GUE	S.R. 800	00.00-2.48	4.96			2.48																		
GUE	S.R. 821	0.00-0.47	0.94			0.47	10.32																	
		S.R. 146 OVERLAP (9.79-9.92)	0.26		0.13																			
		0.60-5.94	10.02		5.34				51	157	2	2												
SUB-TOTALS			380.83	101.55			241.25							79	12		1							
TOTALS CARRIED TO GENERAL SUMMARY			482.38		108.82	146.72		4,523	36,790	1,637	1,351	10	8	92						29	22	26,538	108	14

GUERNSEY COUNTY DATA

DESIGN AGENCY



DESIGNER

RMA

REVIEWER

JSL 12/01/24

PROJECT ID

104996

SHEET

12

TOTAL

17

COUNTY TOTALS				PLAN SPLIT	ITEM	ITEM EXT.	GRAND TOTAL	UNIT	DESCRIPTION	SEE SHEET
NOTES	COS	GUE	MUS	01/NFP/21						
									TRAFFIC CONTROL	
	333.90	482.38	485.89	1,302.17	642	00104	1,302.17	MILE	EDGE LINE, 6", TYPE 1	
	13.78	108.82	100.62	223.22	642	00204	223.22	MILE	LANE LINE, 6", TYPE 1	
	153.44	146.72	185.47	485.63	642	00300	485.63	MILE	CENTER LINE, TYPE 1	
		4,523	13,935	18,458	642	00400	18,458	FT	CHANNELIZING LINE, 8", TYPE 1	
	9,043	36,790	21,534	67,367	642	00404	67,367	FT	CHANNELIZING LINE, 12", TYPE 1	
	900	1,637	2,485	5,022	642	00500	5,022	FT	STOP LINE, TYPE 1	
	915	1,351	1,552	3,818	642	00620	3,818	FT	CROSSWALK LINE, 12", TYPE 1	
	8	10	6	24	642	01000	24	EACH	RAILROAD SYMBOL MARKING, TYPE 1	
	8	8	20	36	642	01110	36	EACH	SCHOOL SYMBOL MARKING, 96", TYPE 1	
	60	92	227	379	642	01300	379	EACH	LANE ARROW, TYPE 1	
			2	2	642	01312	2	EACH	LANE REDUCTION ARROW, TYPE 1	
		29	10	39	642	01322	39	EACH	WRONG WAY ARROW, TYPE 1	
	27	22	59	108	642	01410	108	EACH	WORD ON PAVEMENT, 96", TYPE 1	
		26,538	19,711	46,249	642	01510	46,249	FT	DOTTED LINE, 6", TYPE 1	
			22	22	642	01602	22	EACH	BIKE LANE SYMBOL MARKING, TYPE 1	2
		108		108	642	20802	108	FT	YIELD LINE, TYPE 1	
		2		2	642	30020	2	EACH	REMOVAL OF PAVEMENT MARKING	11
	2	14	6	22	642	40001	22	EACH	SPEED MEASUREMENT MARKING, AS PER PLAN	2
									MAINTENANCE OF TRAFFIC	
150				150	614	11110	150	HOUR	LAW ENFORCEMENT OFFICER WITH PATROL CAR FOR ASSISTANCE	
									INCIDENTALS	
				LS	614	11000		LS	MAINTAINING TRAFFIC	
				LS	624	10000		LS	MOBILIZATION	

GENERAL SUMMARY

DESIGN AGENCY



DESIGNER

RMA

REVIEWER

JSL 12/01/24

PROJECT ID

104996

SHEET

17

TOTAL

17