

EARTHWORK

ITEM 203, EXCAVATION (207 CY)
74 CY (SHEET 24)
+ 29 CY (SHEET 28)
+ 33 CY (SHEET 34)
+ 40 CY (SHEET 43)
+ 31 CY (SHEET 45)

ITEM 203, EMBANKMENT (601 CY)
368 CY (SHEET 24)
+ 33 CY (SHEET 28)
+ 190 CY (SHEET 43)
+ 10 CY (SHEET 45)

SEEDING AND MULCHING

THE FOLLOWING QUANTITIES ARE PROVIDED TO PROMOTE GROWTH AND CARE OF PERMANENT SEEDED AREAS:

ITEM 659 SEEDING AND MULCHING (3242 SY)
LOCATION 1: COS-60-8.18 1285 SY
LOCATION 2: KNO-3-27.87 400 SY
LOCATION 3: LIC-13-6.01 982 SY
LOCATION 3: LIC-13 DRIVES 75 SY
LOCATION 4: MUS-146-6.97* 500 SY
TOTAL 3242 SY
(*CONTINGENCY QUANTITY FOR RE-SEEDING CONTRACTOR'S ACCESS)

ITEM 659 COMMERCIAL FERTILIZER (0.44 TON)
3242 SY X (1 TON PER 7410 SY) = 0.44 TON

ITEM 659 LIME (0.67 ACRE)
3242 SY ÷ (4840 SY PER ACRE) = 0.67 ACRE

ITEM 659 WATER (18 M GAL)
3242 SY X (0.0054 M GAL PER SY) = 18 M GAL

SEEDING AND MULCHING SHALL BE APPLIED TO ALL AREAS OF EXPOSED SOIL BETWEEN THE RIGHT-OF-WAY LINES, AND WITHIN THE CONSTRUCTION LIMITS FOR AREAS OUTSIDE THE RIGHT-OF-WAY LINES COVERED BY WORK AGREEMENT OR SLOPE EASEMENT. QUANTITY CALCULATIONS FOR SEEDING AND MULCHING ARE BASED ON THESE LIMITS.

CLEARING AND GRUBBING

ALTHOUGH THERE ARE NO TREES OR STUMPS SPECIFICALLY MARKED FOR REMOVAL WITHIN THE LIMITS OF THE PROJECT, A LUMP SUM QUANTITY IS INCLUDED IN THE GENERAL SUMMARY FOR ITEM 201, CLEARING AND GRUBBING. ALL PROVISIONS AS SET FORTH IN THE SPECIFICATIONS UNDER THIS ITEM ARE INCLUDED IN THE LUMP SUM PRICE BID FOR ITEM 201, CLEARING AND GRUBBING.

CONDUIT END TREATMENT

IMMEDIATELY AFTER THE PLACEMENT OF ANY CONDUITS, THE CONTRACTOR SHALL CONSTRUCT THE END TREATMENTS AS REQUIRED BY THE PLANS.

ITEM 630 GROUND MOUNTED SUPPORT, NO. 3 POST, AS PER PLAN

SIGN POST SUPPORTS SHALL CONFORM TO **SCD TC-41.20**, EXCEPT ONLY THE TYPE S POSTS WITH ANCHOR BASES SHALL BE FINISHED FOR THIS PROJECT. THE TYPE P AND TYPE F POSTS WILL NOT BE ACCEPTED.

ITEM 623, CONSTRUCTION LAYOUT STAKES AND SURVEYING, AS PER PLAN

IN ADDITION TO THE REQUIREMENTS OF ITEM 623 CONSTRUCTION LAYOUT STAKES AND SURVEYING, THE CONTRACTOR SHALL PROVIDE THE FOLLOWING INFORMATION TO THE DEPARTMENT:

THE CONTRACTOR SHALL PROVIDE AS-BUILT DATA FOR THE SPECIFIED COMPLETED CONSTRUCTION ITEMS IN OHIO STATE PLANE COORDINATES (GRID). THE CONSTRUCTION ITEMS SHALL BE LOCATED AS PER THE SURVEY FEATURE CODE LIST FOUND ON THE OHIO DEPARTMENT OF TRANSPORTATION OFFICE OF CADD & MAPPING SERVICES WEBSITE. AN EMAIL CONTAINING A COMMA DELIMITED ASCII FILE AND A SURVEYOR'S CERTIFICATION SHALL BE DELIVERED TO THE PROJECT ENGINEER AND TO Cody.Gierhart@dot.ohio.gov AFTER ALL INFORMATION HAS BEEN COLLECTED. THE ASCII FILE SHALL INCLUDE A HEADER CONTAINING NAME OF SURVEYOR, DATE(S) OF COLLECTION, HORIZONTAL DATUM (I.E. NAD83 (2011)), OHIO STATE PLANE COORDINATE SYSTEM (NORTH OR SOUTH), VERTICAL DATUM (I.E. NAVD 88, GEOID12A) AND METHOD OF COLLECTION (I.E. OHIO VRS, GPS RTK, TOTAL STATION, ETC.), AND BE IN A TABLE FORMAT AS FOLLOWS: POINT NUMBER, NORTHING, EASTING, ELEVATION, FEATURE CODE, DESCRIPTION.

BELOW IS A LIST OF THE ITEMS THE CONTRACTOR IS REQUIRED TO PROVIDE:
- CULVERT INLET AND OUTLET LOCATION AND ELEVATION
- GUARDRAIL BEGIN AND END OF RUN, END ASSEMBLIES AND TYPE

THE ABOVE ITEMS SHALL BE COLLECTED USING SURVEY GRADE EQUIPMENT MEETING THE REQUIREMENTS OF SECTION 400 IN THE OHIO DEPARTMENT OF TRANSPORTATION SURVEY & MAPPING SPECIFICATIONS MANUAL.

ALL COST ASSOCIATED WITH OBTAINING THE INFORMATION LISTED ABOVE SHALL BE INCLUDED IN THE LUMP SUM BID FOR ITEM 623 CONSTRUCTION LAYOUT STAKES AND SURVEYING, AS PER PLAN.

THE FOLLOWING QUANTITY HAS BEEN INCLUDED IN THE GENERAL SUMMARY TO PERFORM THE WORK AS DESCRIBED ABOVE.

ITEM 623 CONSTRUCTION LAYOUT STAKES AND SURVEYING, AS PER PLAN LUMP SUM

ITEM 408, PRIME COAT, AS PER PLAN

THE CONTRACTOR SHALL APPLY ONE COAT OF MC-70 (AS PER CMS 702) AT A RATE OF 0.40 GAL/SY TO THE COMPLETED AGGREGATE SHOULDER. TO REDUCE AGGREGATE LOSS, THE PRIME COAT SHALL BE APPLIED WITHIN SEVEN (7) DAYS AFTER PLACEMENT OF THE AGGREGATE SHOULDER OR LIQUIDATED DAMAGES PER CMS 108.07 WILL BE ASSESSED. THE CONTRACTOR SHALL PROVIDE A SHIELD TO PREVENT THE SPRAYING OR DRIFTING OF LIQUID BITUMINOUS MATERIAL ONTO THE EDGE OF PAVEMENT OR EDGE LINE. THE ATTENTION OF THE CONTRACTOR IS DIRECTED TO 107.10 OF THE SPECIFICATIONS.

ITEM 606 - ANCHOR ASSEMBLY, MGS TYPE E

THIS ITEM SHALL CONSIST OF FURNISHING AND INSTALLING A MASH 2016 GUARDRAIL END TERMINAL FOR TYPE MGS GUARDRAIL AS LISTED ON ROADWAY ENGINEERING'S WEB PAGE UNDER ROADSIDE SAFETY DEVICES FOR APPROVED GUARDRAIL END TREATMENTS. INSTALLATION SHALL BE AT THE LOCATIONS SPECIFIED IN THE PLANS, IN ACCORDANCE WITH THE MANUFACTURER'S SPECIFICATIONS.

THE FACE OF THE TYPE E IMPACT HEAD SHALL BE COVERED WITH A SHEET OF TYPE G REFLECTIVE SHEETING, PER CMS 730.19.

REFER TO THE MANUFACTURER'S INSTRUCTIONS REGARDING THE INSTALLATION OF, AND THE GRADING AROUND THE FOUNDATION TUBES AND GROUND STRUT. THE TOP OF ANY FOUNDATION TUBE SHOULD BE LESS THAN 4 INCHES ABOVE THE GROUND.


THE PLACEMENT OF THE FOUNDATION TUBES SHOULD BE AN APPROPRIATE DEPTH BELOW THE LEVEL LINE IN ORDER TO MAINTAIN THE FINISHED GUARDRAIL HEIGHT OF 31 INCHES FROM THE EDGE OF THE SHOULDER.

ON-SITE GRADING IS REQUIRED IF THE TOP OF THE FOUNDATION TUBES OR TOP OF THE GROUND STRUT DOES PROJECT MORE THAN 4 INCHES ABOVE THE GROUND LINE.

PAYMENT FOR THE ABOVE WORK SHALL BE MADE AT THE UNIT PRICE BID FOR ITEM 606, ANCHOR ASSEMBLY, MGS TYPE E, EACH, AND SHALL INCLUDE ALL LABOR, TOOLS, EQUIPMENT AND MATERIALS NECESSARY TO CONSTRUCT A COMPLETE AND FUNCTIONAL ANCHOR ASSEMBLY SYSTEM, INCLUDING ALL RELATED TRANSITIONS, REFLECTIVE SHEETING, HARDWARE, GRADING, EMBANKMENT AND EXCAVATION NOT SEPARATELY SPECIFIED, AS REQUIRED BY THE MANUFACTURER.

GRADING FOR MGS TYPE E (MASH 2016) ANCHOR ASSEMBLY

THE GRADING LAYOUT SHOWN HERE SHALL BE USED WITH ITEM 606- ANCHOR ASSEMBLY, MGS TYPE E (MASH 2016), AS DETAILED IN THIS PLAN.

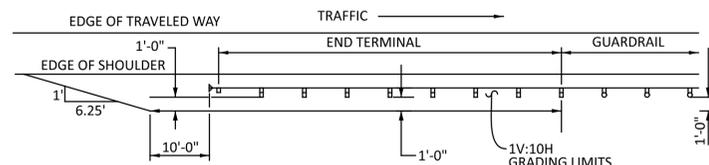

ITEM 690 SPECIAL - MAILBOX SUPPORT

THIS WORK SHALL CONSIST OF FURNISHING AND ERECTING MAILBOX SUPPORTS AND ANY ASSOCIATED MOUNTING HARDWARE IN ACCORDANCE WITH PLAN DETAILS, AND ATTACHING AN OWNER-SUPPLIED MAILBOX AT LOCATIONS SPECIFIED IN THE PLAN, OTHERWISE ESTABLISHED BY THE ENGINEER.

WOOD POSTS SHALL BE NOMINAL 4 INCHES BY 4 INCHES SQUARE OR 4.5 INCHES DIAMETER ROUND, AND CONFORM TO 710.14. STEEL POSTS SHALL BE NOMINAL PIPE SIZE 2 INCHES I.D., AND CONFORM TO AASHTO M 181. ALL HARDWARE INCLUDING BUT NOT LIMITED TO PLATES, SCREWS, BOLTS, AND ETC. SHALL BE COMMERCIAL-GRADE GALVANIZED STEEL. POSTS SHALL BE SET PER THE FIRST PARAGRAPH OF 606.03, AND SHALL IN NO INSTANCE BE ENCASED IN CONCRETE. SUPPORT HARDWARE SHALL ACCOMMODATE EITHER A SINGLE OR A DOUBLE MAILBOX INSTALLATION, AND NO MORE THAN TWO MAY BE MOUNTED ON A SINGLE POST.

THE MAILBOX SHALL BE SECURELY AND NEATLY ATTACHED BY THE CONTRACTOR TO THE NEW SUPPORT. THE CONTRACTOR SHALL FURNISH ALL NECESSARY ATTACHMENT HARDWARE (NUTS, BOLTS, PLATES, SPACERS, AND WASHERS) AS NECESSARY TO ACCOMMODATE THE COMPLETE INSTALLATION.

IN THE ABSENCE OF A NEW BOX SUPPLIED BY THE OWNERR, THE CONTRACTOR SHALL SALVAGE THE EXISTING BOX AND PLACE IT ON THE NEW SUPPORT. DUE CARE SHALL BE EXERCISED IN SUCH AN OPERATION, AND THE CONTRACTOR SHALL BE RESPONSIBLE FOR REPAIRING ANY BOX DAMAGED BY IMPROPER HANDLING ON HIS PART, AS JUDGED AND DIRECTED BY THE ENGINEER.

THE CONTRACTOR SHALL BE RESPONSIBLE FOR COORDINATING WITH THE LOCAL POST MASTER REGARDING THE TIMING OF THE MOVEMENT OF ANY MAILBOX TO A NEW LOCATION.

PAYMENT UNDER THIS ITEM SHALL BE LIMITED TO FINAL PERMANENT INSTALLATIONS, TEMPORARY INSTALLATIONS SHALL BE IN ACCORDANCE WITH 107.10. HOWEVER, THE SAME MATERIAL AND SIZE LIMITATIONS AS FOR PERMANENT INSTALLATIONS SHALL APPLY.

MAILBOX SUPPORTS, COMPLETE IN PLACE, WILL BE PAID FOR AT THE CONTRACT UNIT PRICE PER EACH, FOR ITEM 606 SPECIAL - MAILBOX SUPPORT.

DESIGN AGENCY



DESIGNER
GPM
REVIEWER

PROJECT ID
109614

SHEET TOTAL
P.4 51