

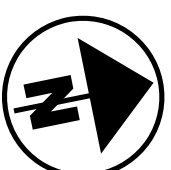


MODEL: Sheet PAPER SIZE: 34x22 (in.) DATE: 4/21/2025 TIME: 9:03:02 AM USER: bharlow
 pw:\vhobiddo-pw.bentley.com:\rhobiddo-pw\02\Documents\01 Active Projects\District 05\ _D05\109614\4400-Engineering\Roadway\Sheets\109614_GG001.dgn

GENERAL SUMMARY	
DESIGN AGENCY	
	
DESIGNER	GPM
REVIEWER	
PROJECT ID	
109614	
SHEET	TOTAL
P.10	51

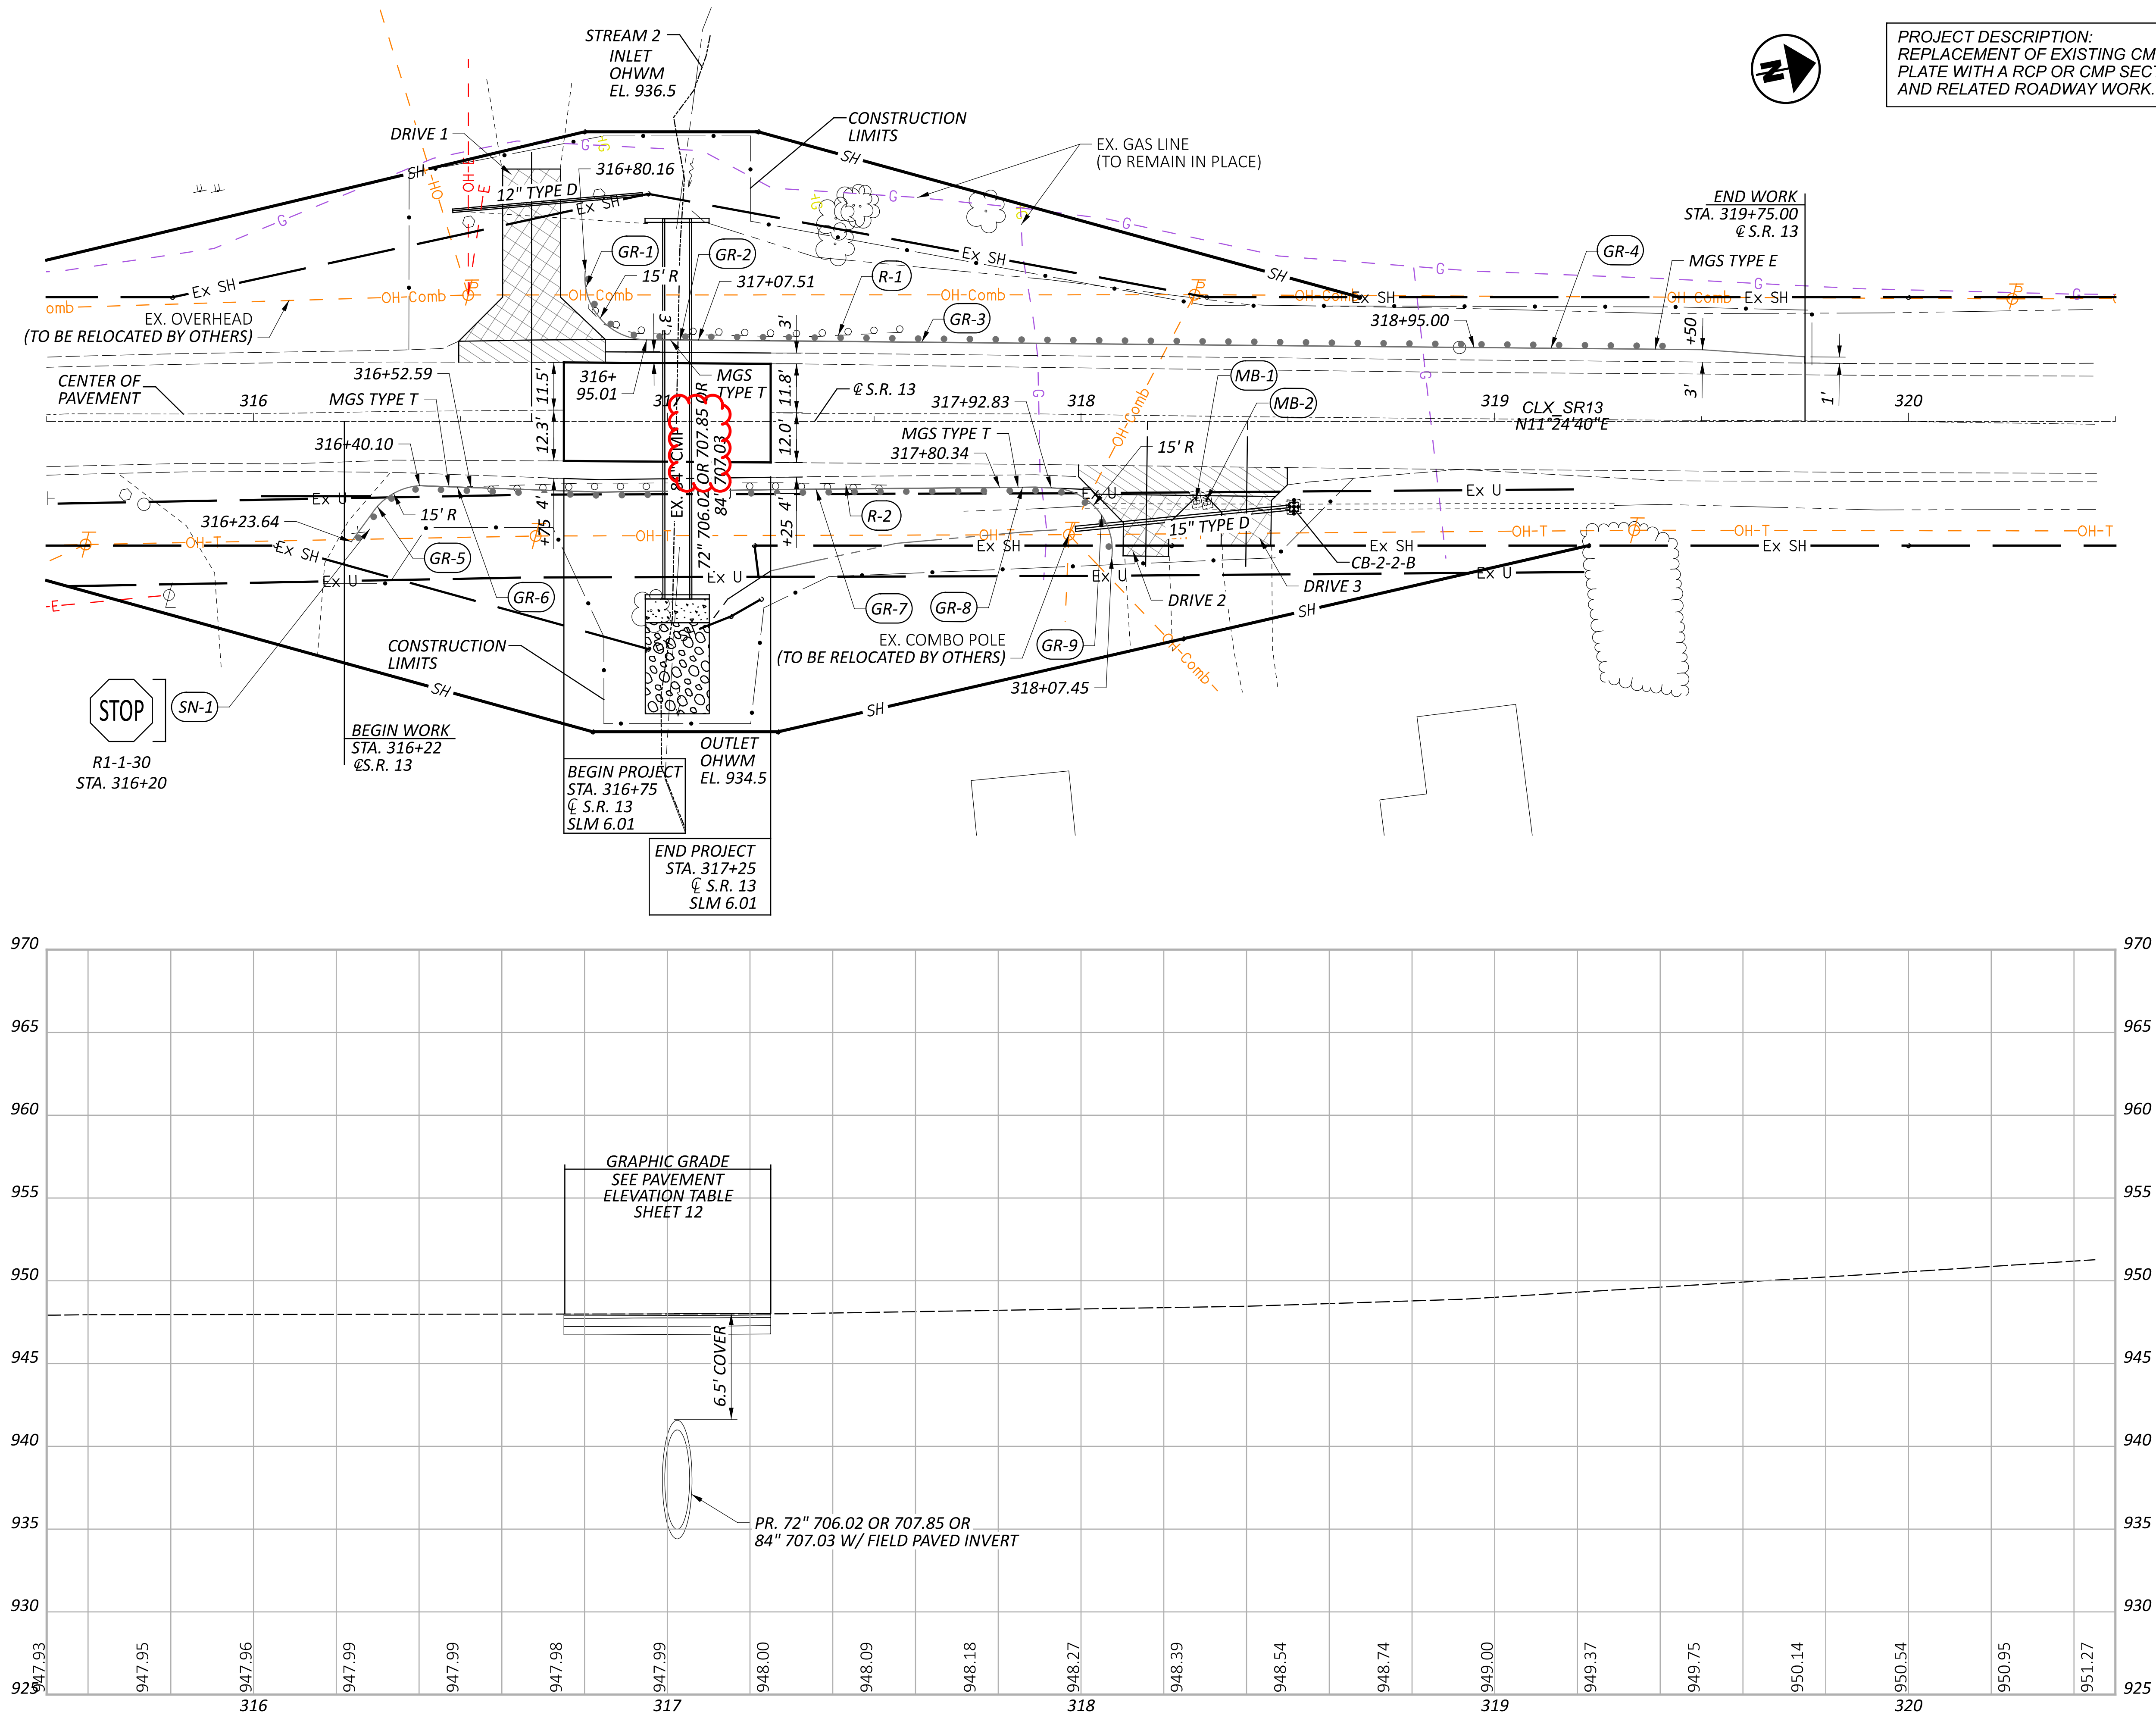

PROJECT DESCRIPTION:
REPLACEMENT OF EXISTING CMP SECTIONAL
PLATE WITH A RCP OR CMP SECTIONAL PLATE
AND RELATED ROADWAY WORK.

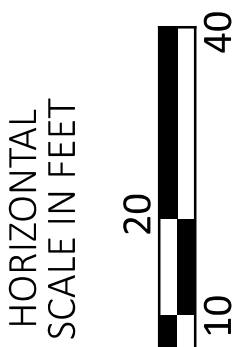

PLAN & PROFILE SHEET
LIC-13-6.01

DESIGN AGENCY



DESIGNER
GPM

REVIEWER

PROJECT ID
109614

SHEET TOTAL
P.36 51

