D05-PM-FY2026(C) R-WR

STATE OF OHIO **DEPARTMENT OF TRANSPORTATION**

D05-PM-FY2026(C)

RECESSED WET-REFLECTIVE

KNOX AND GUERNSEY COUNTIES

INDEX OF SHEETS

TITLE SHEET **GENERAL NOTES** 2-3 MAINTENANCE OF TRAFFIC 4-5 LOCATION MAPS 6-8 PAVEMENT MARKING DATA 9 GENERAL SUMMARY 10

LOCATION MAP

SEE SHEETS 6-8

LATITUDE: 39°57'06" LONGITUDE: 82°24'41"


DESIGN DESIGNATION NONE REQUIRED

DESIGN EXCEPTIONS NONE REQUIRED

ADA DESIGN WAIVER

UNDERGROUND UTILITIES **Before You Dig**

PLAN PREPARED BY: OHIO DEPARTMENT OF TRANSPORTATION **DISTRICT 5 ENGINEERING**

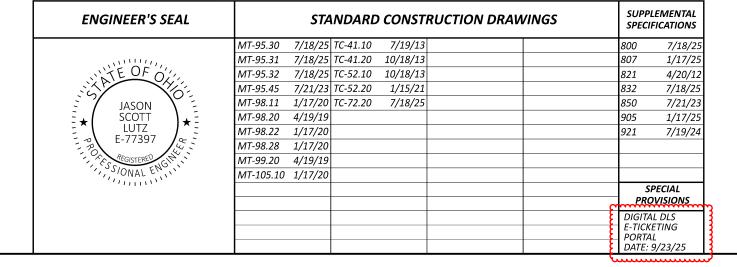

FEDERAL PROJECT NUMBER

NON-FEDERAL

RAILROAD INVOLVEMENT

PROJECT DESCRIPTION

DISTRICT WIDE RECESSED-WET REFLECTIVE THERMOPLASTIC PAVEMENT MARKING PROJECT AT VARIOUS LOCATIONS THROUGHOUT THE DISTRICT.

PROJECT EARTH DISTURBED AREA = N/A (MAINTENANCE) ESTIMATED CONTRACTOR EARTH DISTURBED AREA = N/A NOTICE OF INTENT EARTH DISTURBED AREA = N/A (NOI NOT REQUIRED)

LIMITED ACCESS

THIS IMPROVEMENT IS ESPECIALLY DESIGNED FOR THROUGH TRAFFIC AND HAS BEEN DECLARED A LIMITED ACCESS HIGHWAY OR FREEWAY BY ACTION OF THE DIRECTOR IN ACCORDANCE WITH THE PROVISIONS OF SECTION 5511.02 OF THE OHIO REVISED CODE.

2023 SPECIFICATIONS

THE STANDARD SPECIFICATIONS OF THE STATE OF OHIO, DEPARTMENT OF TRANSPORTATION, INCLUDING CHANGES AND SUPPLEMENTAL SPECIFICATIONS LISTED IN THE PROPOSAL SHALL GOVERN THIS IMPROVEMENT.

I HEREBY APPROVE THESE PLANS AND DECLARE THAT THE MAKING OF THIS IMPROVEMENT WILL NOT REQUIRE THE CLOSING TO TRAFFIC OF THE HIGHWAY AND THAT PROVISIONS FOR THE MAINTENANCE AND SAFETY OF TRAFFIC WILL BE AS SET FORTH ON THE PLANS AND ESTIMATES.

DISTRICT DEPUTY DIRECTOR

DIRECTOR, DEPARTMENT OF TRANSPORTATION

RMA JSL 09/23/2

119926

SHEET

TITLE

NONE REQUIRED