


STATE OF OHIO DEPARTMENT OF TRANSPORTATION

D06-RPM-FY24 FAYETTE, MADISON, MARION, MORROW & PICKAWAY COUNTIES

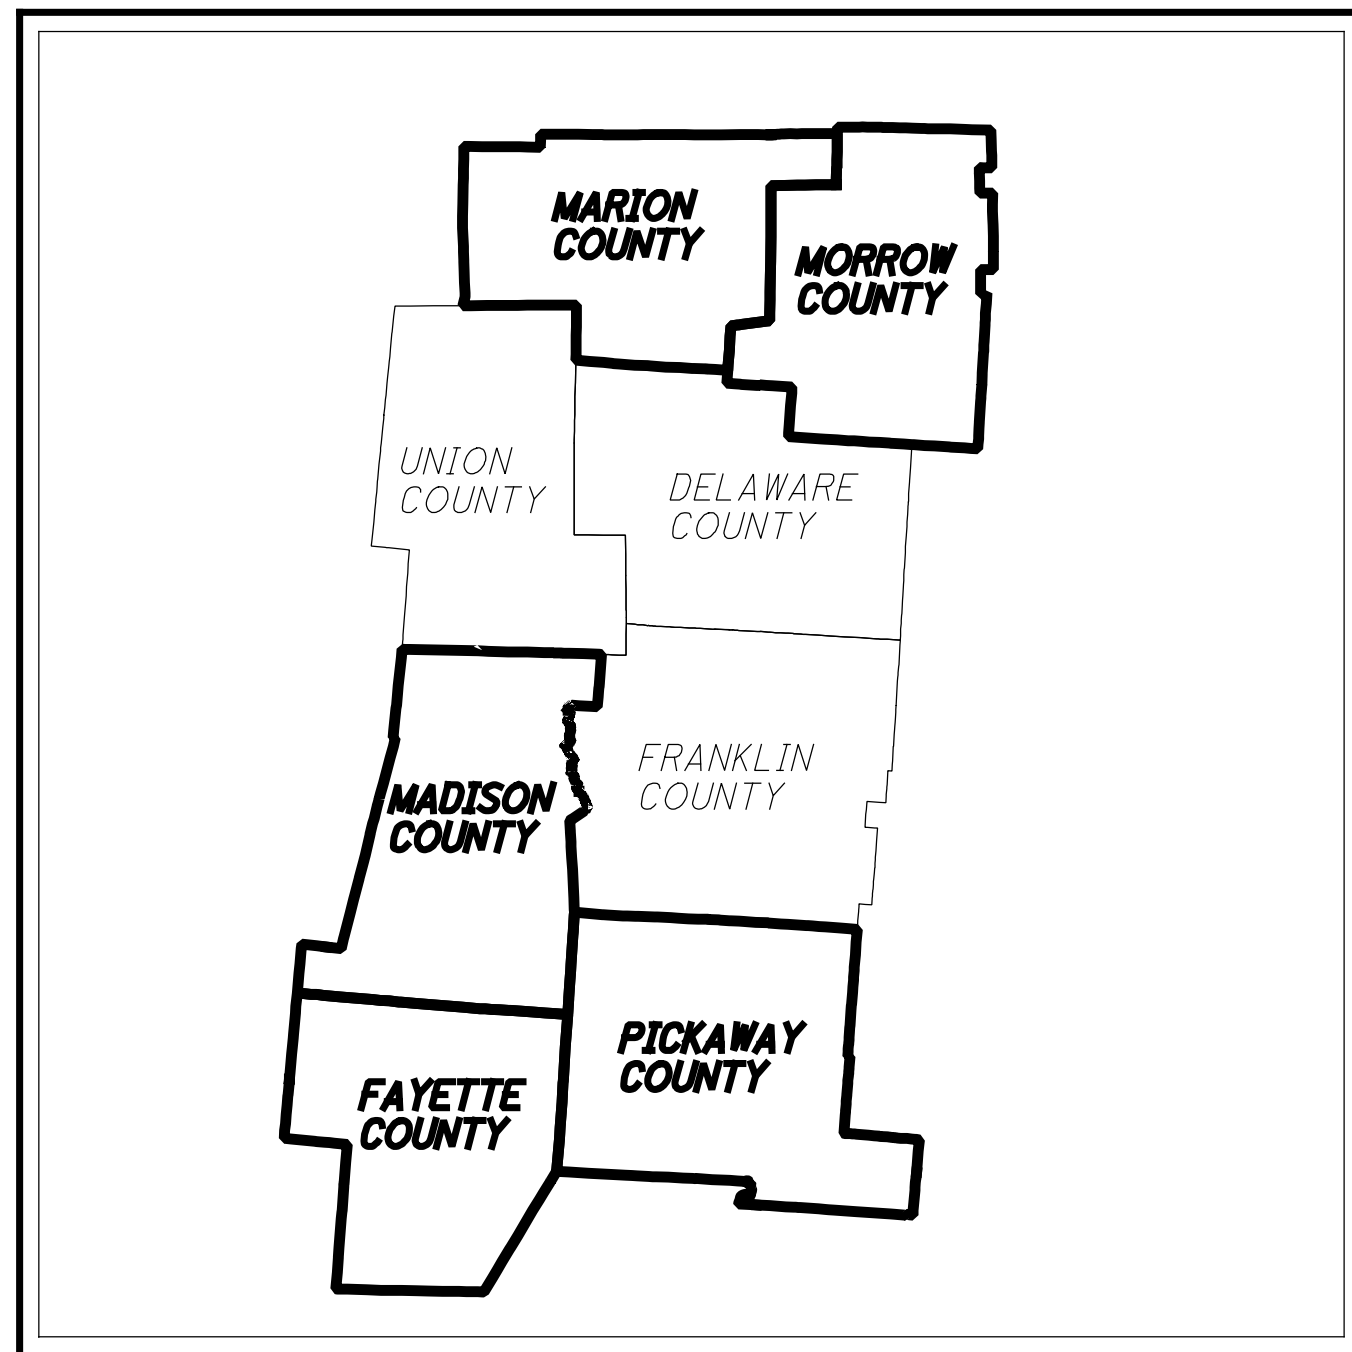

LOCATION MAP

LATITUDE: 40°17'52" LONGITUDE: -83°02'58"



PORTION TO BE IMPROVED	-----	=====
INTERSTATE HIGHWAY	-----	=====
FEDERAL ROUTES	-----	=====
STATE ROUTES	-----	=====
COUNTY & TOWNSHIP ROADS	-----	=====
OTHER ROADS	-----	=====

DESIGN DESIGNATION

CURRENT ADT (2023)	-----	VARIES
DESIGN YEAR ADT (2023)	-----	VARIES
DESIGN HOURLY VOLUME (2023)	-----	VARIES
DIRECTIONAL DISTRIBUTION	-----	VARIES
TRUCKS (24 HOUR B&C)	-----	VARIES
DESIGN SPEED	-----	VARIES
LEGAL SPEED	-----	VARIES
DESIGN FUNCTIONAL CLASSIFICATION:		
VARIES		
NHS PROJECT	-----	VARIES

DESIGN EXCEPTIONS

NONE REQUIRED

ADA DESIGN WAIVERS

NONE REQUIRED

UNDERGROUND UTILITIES
Contact Two Working Days
Before You Dig

OHIO811.org
Before You Dig

OHIO811, 8-1-1, or 1-800-362-2764
(Non members must be called directly)



ENGINEER'S SEAL

STATE OF OHIO
VIMALKUMAR
PATEL
E-87487
REGISTERED
PROFESSIONAL ENGINEER

Digitally signed by vpatel
DN: cn=vpatel, ou=Project,
ou=012, ou=Divisions, DC=oh,
DC=ohio, DC=us
Date: 2024.03.13 15:31:27-0400

INDEX OF SHEETS:

TITLE SHEET	P.1
GENERAL NOTES	P.2
MAINTENANCE OF TRAFFIC NOTES	P.3 - P.4
GENERAL SUMMARY	P.5
TRAFFIC CONTROL SUBSUMMARIES	P.6 - P.7
TRAFFIC CONTROL PLAN QUANTITIES	P.8 - P.27

FEDERAL PROJECT NUMBER

NON-FEDERAL

RAILROAD INVOLVEMENT

NONE

PROJECT DESCRIPTION

REPLACE DAMAGED AND INSTALL NEW
RAISED PAVEMENT MARKERS ON VARIOUS
ROUTES WITHIN FAYETTE, MADISON, MARION,
MORROW, AND PICKAWAY COUNTIES.

EARTH DISTURBED AREAS

PROJECT EARTH DISTURBED AREA:	0.0 ACRES
ESTIMATED CONTRACTOR EARTH DISTURBED AREA:	0.0 ACRES
NOTICE OF INTENT EARTH DISTURBED AREA:	N/A (NOI NOT REQUIRED)*

*ROUTINE MAINTENANCE PROJECT

LIMITED ACCESS

THIS IMPROVEMENT IS ESPECIALLY DESIGNED FOR THROUGH TRAFFIC AND
HAS BEEN DECLARED A LIMITED ACCESS HIGHWAY OR FREEWAY BY ACTION
OF THE DIRECTOR IN ACCORDANCE WITH THE PROVISIONS OF SECTION
5511.02 OF THE OHIO REVISED CODE.

2023 SPECIFICATIONS

THE STANDARD SPECIFICATIONS OF THE STATE OF OHIO, DEPARTMENT OF
TRANSPORTATION, INCLUDING SUPPLEMENTAL SPECIFICATIONS LISTED IN
THE PLANS AND CHANGES LISTED IN THE PROPOSAL SHALL GOVERN THIS
IMPROVEMENT.

I HEREBY APPROVE THESE PLANS AND DECLARE THAT THE
MAKING OF THIS IMPROVEMENT WILL NOT REQUIRE THE
CLOSING TO TRAFFIC OF THE HIGHWAY AND THAT
PROVISIONS FOR THE MAINTENANCE AND SAFETY OF
TRAFFIC WILL BE AS SET FORTH ON THE PLANS AND
ESTIMATES.

Anthony C. Turowski, P.E.
District 06 Deputy Director

Jack Marchbanks, PhD
Director, Department of Transportation

STANDARD CONSTRUCTION DRAWINGS				SUPPLEMENTAL SPECIFICATIONS	SPECIAL PROVISIONS
MT-95.30	7/19/19	TC-73.20	7/21/23	800-2023	10/20/23
MT-95.31	7/19/19			821	4/20/12
MT-95.32	4/19/19			832	7/21/23
MT-95.45	7/21/23			921	4/20/12
MT-95.50	7/21/17				
MT-97.10	4/19/19				
MT-98.10	1/17/20				
MT-98.11	1/17/20				
MT-98.20	4/19/19				
MT-98.22	1/17/20				
MT-98.28	1/17/20				
MT-101.90	7/17/20				
MT-105.10	1/17/20				
TC-65.10	1/17/14				
TC-65.11	7/15/22				

D06-RPM-FY24

MODEL: Sheet_SurvF1 PAPER SIZE: 34x42 (in.) DATE: 3/13/2024 TIME: 3:06:42 PM USER: vpatel
pvc:\ohio\dot-pw-bentley.com\ohio\dot-pw-02\Documents\01 Active Projects\District 06_D06108085\400-Engineering\Roadway\Sheets\108085_GT001.dgn

SHEET TITLE


DESIGN AGENCY



DESIGNER	VHP
REVIEWER	KM 12/11/23
PROJECT ID	108085
SHEET	TOTAL
P.1	P.27

SHEET NUM.										PART.			ITEM	ITEM EXT	GRAND TOTAL	UNIT	DESCRIPTION	SEE SHEET NO.
P.2	P.4	P.6	P.6A	P.7						01/STR/44								
1,000		2,274	1,405							4,679			621	00100	4,679	EACH	TRAFFIC CONTROL	
500		23,248		12,875						36,623			621	00300	36,623	EACH	RPM REFLECTOR	
	150									150			614	11110	150	HOUR	MAINTENANCE OF TRAFFIC LAW ENFORCEMENT OFFICER WITH PATROL CAR FOR ASSISTANCE	
										LS			614	11000	LS		INCIDENTALS MAINTAINING TRAFFIC	
										LS			624	10000	LS		MOBILIZATION	
	4									4			624	15001	4	EACH	MOBILIZATION, AS PER PLAN	P.4

GENERAL SUMMARY

DESIGN AGENCY

 DESIGNER
 VHP
 REVIEWER
 KM 12/11/23
 PROJECT ID
 108085
 SHEET TOTAL
 P.5 P.27

DETAIL	STANDARD DRAWING TC-65.10
1	EDGE LINE
2	CHANNELIZING LINE
3	LANE LINE
4	CENTER LINE

DETAIL	STANDARD DRAWING TC-65.11
5	ENTRANCE RAMP
6	EXIT RAMP
7	4 LANE DIVIDED TO 2 LANE TRANSITION
8	4 LANE UNDIVIDED TO 2 LANE TRANSITION
9	MULTILANE DIVIDED HIGHWAY


DETAIL	STANDARD DRAWING TC-65.11
10	APPROACH W/ LEFT TURN LANE
11	STOP APPROACH
12	TWO WAY LEFT TURN LANE
13	ONE LANE BRIDGE

LOCATION							REFLECTOR TYPE							621	REMARKS
C O U N T Y	R O U T E	B E G I N G P O I N T	E N D P O I N T	L E N G T H F T	D E T A I L	ONE WAY			TWO WAY				RPM		
						WHITE	YELLOW		WHITE RED	YELLOW RED	YELLOW YELLOW				
						RIGHT EDGE LINE	LANE LINE	LEFT EDGE LINE	RIGHT EDGE LINE	CHANNELIZING LINE	LANE LINE	LEFT EDGE LINE	CENTER LINE		
														EACH	
MAR	47*	0.62	2.09		4, 10	16							99	115	SR4 TO VILLAGE OF PROSPECT
MAR	98*	10.96	17.17		4, 11	16							410	426	SR309 TO CRAWFORD CO. LINE
MRW	42*	19.45	25.76		4								425	425	SR19 TO RICHLAND CO. LINE
MRW	314*	19.87	26.02		4, 11	32							407	439	OLD US42 TO RICHLAND CO. LINE
TOTALS CARRIED TO MARION & MORROW COUNTY SUBSUMMARY													1,405		

D06-RPM-FY24

MODEL: 108085_TQ207A PAPER/SCALE: 34x22 (in.) DATE: 3/13/2024 TIME: 3:07:29 PM USER: vpatel
 p:\vohidol-pw-bentley.com\shihodol-pw-02\Documents\01 Active Projects\District 06_D06\108085\400-Engineering\Traffic\Sheets\108085_TQ001.dgn

MARION & MORROW COUNTY PLAN QUANTITIES

DESIGN AGENCY	
DESIGNER	VHP
REVIEWER	DR 12/04/23
PROJECT ID	108085
SHEET	TOTAL
P.20A	P.27