

STATE OF OHIO DEPARTMENT OF TRANSPORTATION

D06 BRIDGE REPAIR FY 23

CITY OF COLUMBUS, ALLEN TOWNSHIP FRANKLIN & UNION COUNTIES

INDEX OF SHEETS:

TITLE SHEET 1-3 GENERAL NOTES MAINTENANCE OF TRAFFIC 5-10 GENERAL SUMMARY STRUCTURES 20' SPAN AND OVER 12-25 FEDERAL PROJECT NUMBER

NON-FEDERAL

RAILROAD INVOLVEMENT

NONE

PROJECT DESCRIPTION

THIS PROJECT CONSISTS OF THE REHABILITATIONS OF FOUR (4) BRIDGES WITH THE FOLLOWING WORK

HEAT STRAIGHTENING AN EXTERIOR STEEL BEAM IN FRANKLIN

LOCATION: FRA-104-1248 ALUM CREEK OVER SR 104

REPAIR OF A PUNCTURE HOLE IN THE WEB OF AN EXTERIOR STEEL BEAM IN UNION COUNTY. LOCATION: UNI-33-0271 HONDA PARKWAY OVER US 33

CONCRETE ENCASEMENT OF EXISTING HP12X53 PILES IN LOCATION: FRA-3-23.83 WESTERVILLE ROAD OVER SR 3

PLACEMENT OF NETTING AROUND THE PARAPETS IN FRANKLIN COUNTY. LOCATION: FRA-70-14.95 PARSONS AVE OVER 170/171

EARTH DISTURBED AREAS

PROJECT EARTH DISTURBED AREA: ESTIMATED CONTRACTOR EARTH DISTURBED AREA: NA NOTICE OF INTENT EARTH DISTURBED AREA: NA

LIMITED ACCESS

THIS IMPROVEMENT IS ESPECIALLY DESIGNED FOR THROUGH TRAFFIC AND HAS BEEN DECLARED A LIMITED ACCESS HIGHWAY OR FREEWAY BY ACTION OF THE DIRECTOR IN ACCORDANCE WITH THE PROVISIONS OF SECTION 5511.02 OF THE OHIO REVISED CODE.

2019 SPECIFICATIONS


THE STANDARD SPECIFICATIONS OF THE STATE OF OHIO, DEPARTMENT OF TRANSPORTATION, INCLUDING SUPPLEMENTAL SPECIFICATIONS LISTED IN THE PLANS AND CHANGES LISTED IN THE PROPOSAL SHALL GOVERN THIS IMPROVEMENT.

I HEREBY APPROVE THESE PLANS AND DECLARE THAT THE MAKING OF THIS IMPROVEMENT WILL NOT REQUIRE THE CLOSING TO TRAFFIC OF THE HIGHWAY EXCEPT AS NOTED ON SHEET 5-10/25, AND THAT PROVISIONS FOR THE MAINTENANCE AND SAFETY OF TRAFFIC WILL BE AS SET FORTH ON THE PLANS AND ESTIMATES.

UNDERGROUND UTILITIES Contact Two Working Days Before You Dig **OHIO811.** org Before You Dig OHIO811, 8-1-1, or 1-800-362-2764

FOR LOCATIONS SEE SHEETS 2-3



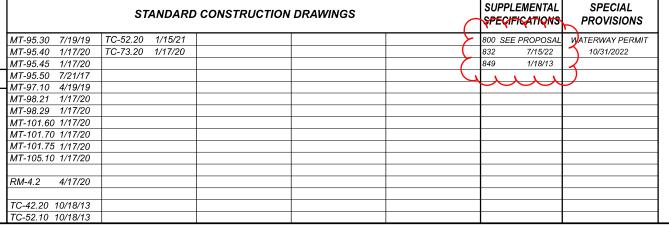

TRANSPORTATION DATE .



CAB

REVIEWER JPH 11-2-22 112664