


Structure Number: LOG-117-0671 (33-1096)
 Structure File Number: 4601890
 (Feature intersected): SR-68 over USR-33
 Project Number: 187-65

Location Map


Plan Reference:
 Date Measured: 3-22-94 *Perry Zivkle*
 Personnel: *Lonnie Coan*

Inventory File Revised _____ Date _____

HORIZONTAL CLEARANCE

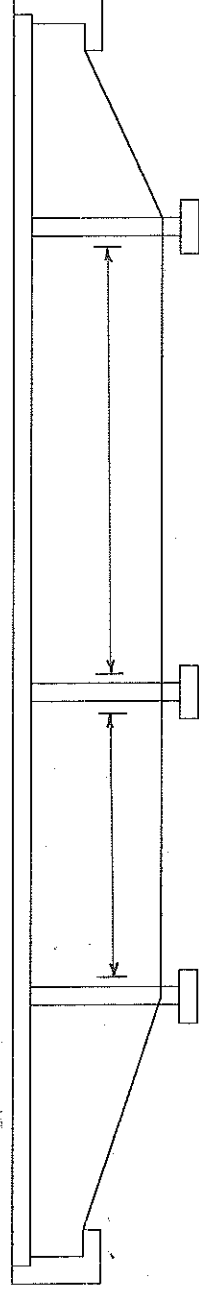

VERTICAL CLEARANCE

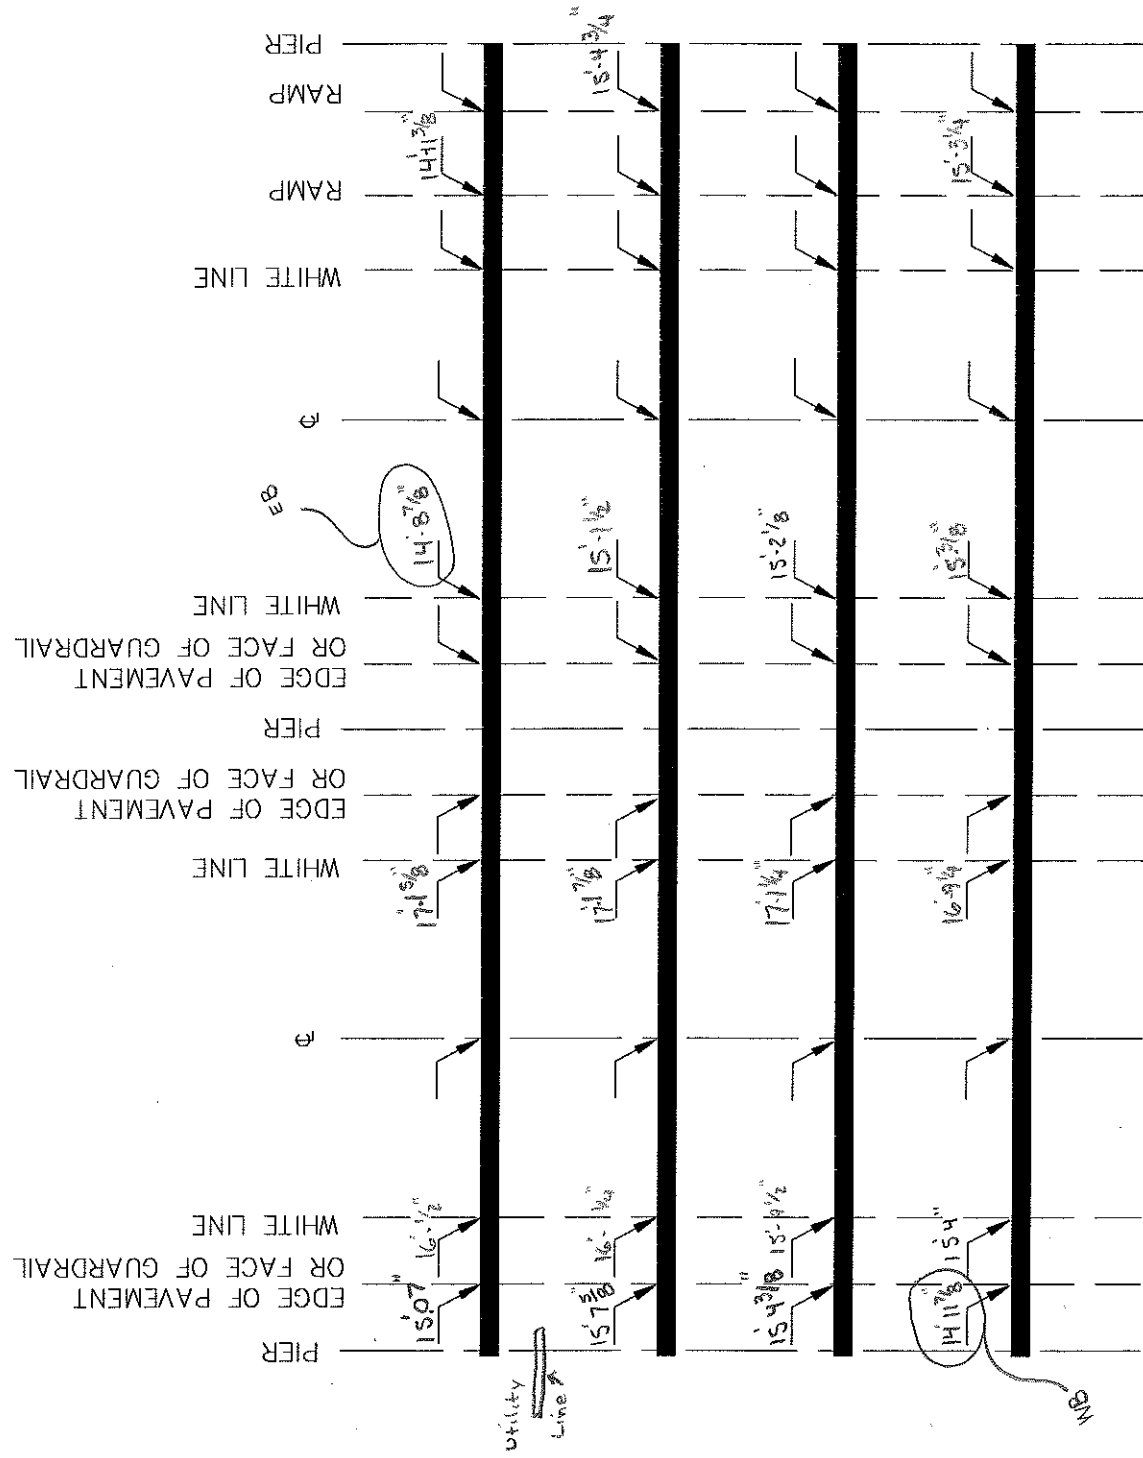

NORTH