ITEM 614, MAINTAINING TRAFFIC

CLA-068-0773R

RAMP F (U.S. 40 WEST TO U.S. 68 NORTH) OVER INDIANA & OHIO RAILWAY (IORY) IS TO BE DETOURED FOR NO MORE THAN 30 DAYS. CLOSE RAMP F PER MT-98.29.

DETOUR ROUTE: U.S. 40 (W NATIONAL ROAD) - S.R. 369 (S TECUMSEH RD) - S.R. 4 - U.S. 40 (W. MAIN ST) - U.S. 68. SEE DETOUR MAP AND SIGNS ON SHEETS 6-7.

INDIANA & OHIO RAILWAY: RAILROAD FLAGGER REQUIRES RAILROAD COORDINATION.

CLA-675-0079

GENERAL

HADDIX RD: TRAFFIC WILL BE MAINTAINED AT ALL TIMES.

I.R. 675: TRAFFIC WILL BE MAINTAINED AT ALL TIMES, EXCEPT AS DESCRIBED BELOW, USING STANDARD DRAWINGS MT-95.30, MT-95.45 AND MT-98.10.

TEMPORARY MINIMUM VERTICAL CLEARANCES: SOUTHBOUND I.R. 675 = 15'-11" NORTHBOUND I.R. 675 = 16'-6"

PHASE 1 CONSTRUCTION

PAINT STRUCTURAL STEEL FROM THE I.R. 675 NORTHBOUND LANE LINE TO THE FORWARD ABUTMENT OVER TRAFFIC. INSTALL AND REMOVE FALSEDECKING AND CONTAINMENT USING MT-95.30 DURING PERMITTED LANE CLOSURE SCHEDULE ONLY.

CLOSE THE I.R. 675 NORTHBOUND OUTSIDE SHOULDER USING MT-95.45.
STAGE ALL EQUIPMENT BEHIND PORTABLE BARRIERS FOR DURATION OF WORK.

PHASE 2 CONSTRUCTION

PAINT STRUCTURAL STEEL FROM THE I.R. 675 SOUTHBOUND LANE LINE TO THE I.R. 675 NORTHBOUND LANE LINE OVER TRAFFIC. INSTALL AND REMOVE FALSEDECKING AND CONTAINMENT USING MT-95.30 DURING PERMITTED LANE CLOSURE SCHEDULE ONLY.

CLOSE THE I.R. 675 INSIDE SHOULDER(S) USING MT-95.45. STAGE ALL EQUIPMENT BEHIND PORTABLE BARRIERS IN THE MEDIAN FOR DURATION OF WORK.

PHASE 3 CONSTRUCTION

PAINT STRUCTURAL STEEL FROM THE REAR ABUTMENT TO THE I.R. 675
SOUTHBOUND LANE LINE OVER TRAFFIC. INSTALL AND REMOVE
FALSEDECKING AND CONTAINMENT USING MT-95.30 AND MT-98.10
DURING PERMITTED LANE CLOSURE SCHEDULE ONLY. MAINTAIN THE I.R. 70
EASTBOUND TO I.R. 675 SOUTHBOUND ENTRANCE RAMP TRAFFIC AT ALL
TIMES PER MT-98.10.

PER MT-95.30, I.R. 675 SOUTHBOUND OUTSIDE SHOULDER AND LANE CLOSURE STARTS AT THE GORE OF I.R. 675 SOUTHBOUND RAMP TO I.R. 70 EASTBOUND.

PER MT-98.10, I.R. 675 SOUTHBOUND ON-RAMP DECISION SIGHT DISTANCE STARTS AT THE GORE OF I.R. 70 EASTBOUND TO I.R. 675 SOUTHBOUND RAMP. MERGING TAPER ENDS AT STRUCTURE CLA-675-0079. MERGING TAPER STARTS AT THE MIDPOINT BETWEEN START OF THE DECISION POINT AND MERGING TAPER END.

CLOSE THE I.R. 675 SOUTHBOUND OUTSIDE SHOULDER USING MT-95.45.

STAGE ALL EQUIPMENT BEHIND PORTABLE BARRIERS FOR DURATION OF WORK.

MOT-075-0259

RAMP U OVER I.R. 75 (I.R. 75 SOUTH TO I.R. 675 NORTH)

RAMP U: TRAFFIC TO BE MAINTAINED AT ALL TIMES. **I.R. 75**: TRAFFIC TO BE MAINTAINED AT ALL TIMES.

PAINT EQUIPMENT STAGING TO BE IN THE MEDIAN BEHIND EXISTING GUARDRAILS.

MOT-675-0296

<u>GENERAL</u>

MCEWEN RD: TRAFFIC WILL BE MAINTAINED AT ALL TIMES.

I.R. 675: TRAFFIC WILL BE MAINTAINED AT ALL TIMES, EXCEPT AS DESCRIBED BELOW, USING STANDARD DRAWING MT-95.30 AND MT-95.45.

TEMPORARY MINIMUM VERTICAL CLEARANCES:

MAINTAIN MINIMUM VERTICAL CLEARANCE AS LISTED ON P.15.

PHASE 1 CONSTRUCTION

PAINT STRUCTURAL STEEL FROM THE REAR ABUTMENT TO THE I.R. 675
NORTHBOUND OUTSIDE LANE LINE OVER TRAFFIC. INSTALL AND REMOVE
FALSEDECKING AND CONTAINMENT USING MT-95.30 DURING PERMITTED
LANE CLOSURE SCHEDULE ONLY. MAINTAIN THE YANKEE ST TO I.R. 675
NORTHBOUND ENTRANCE RAMP TRAFFIC AT ALL TIMES BY REDUCING THE
BUFFER SPACE, STARTING THE MERGE TAPER AT THE END OF THE ENTRANCE
RAMP TAPER.

CLOSE THE I.R. 675 NORTHBOUND OUTSIDE SHOULDER USING MT-95.45. STAGE ALL EQUIPMENT BEHIND PORTABLE BARRIERS FOR DURATION OF WORK.

PHASE 2 CONSTRUCTION

PAINT STRUCTURAL STEEL FROM THE I.R. 675 NORTHBOUND OUTSIDE LANE LINE TO THE I.R. 675 SOUTHBOUND OUTSIDE LANE LINE OVER TRAFFIC.

INSTALL AND REMOVE FALSEDECKING AND CONTAINMENT USING MT-95.30 DURING PERMITTED LANE CLOSURE SCHEDULE ONLY.

CLOSE THE I.R. 675 SOUTHBOUND INSIDE SHOULDER USING MT-95.45.

STAGE ALL EQUIPMENT BEHIND PORTABLE BARRIERS FOR DURATION OF WORK. STAGING IN THE MEDIAN ON THE CABLE RAIL SIDE IS PROHIBITED.

PHASE 3 CONSTRUCTION

PAINT STRUCTURAL STEEL FROM THE I.R. 675 SOUTHBOUND OUTSIDE LANE LINE TO FORWARD ABUTMENT OVER TRAFFIC. INSTALL AND REMOVE FALSEDECKING AND CONTAINMENT USING MT-95.30 DURING PERMITTED LANE CLOSURE SCHEDULE ONLY.

CLOSE THE I.R. 675 SOUTHBOUND OUTSIDE SHOULDER USING MT-95.45. STAGE ALL EQUIPMENT BEHIND PORTABLE BARRIERS FOR DURATION OF WORK.

NO WORK SHALL BE PERFORMED AND ALL EXISTING LANES SHALL BE OPEN TO TRAFFIC DURING THE FOLLOWING DESIGNATED HOLIDAYS OR SPECIAL EVENTS:

NEW YEAR'S (OBSERVED)	GENERAL/REGULAR ELECTION DAY (NOV)
MEMORIAL DAY	CHRISTMAS (OBSERVED)
FOURTH OF JULY (OBSERVED)	
LABOR DAY	
THANKSGIVING	

THE PERIOD OF TIME THAT THE LANES ARE TO BE OPEN DEPENDS ON THE DAY OF THE WEEK ON WHICH THE HOLIDAY OR SPECIAL EVENT FALLS. THE FOLLOWING SCHEDULE SHALL BE USED TO DETERMINE THIS PERIOD:

DAY OF HOLIDAY OR SPECIAL EVENT	TIME ALL LANES MUST BE OPEN TO TRAFFIC
SUNDAY	12:00N FRIDAY THROUGH 6:00 AM MONDAY
MONDAY	12:00N FRIDAY THROUGH 6:00 AM TUESDAY
TUESDAY	12:00N MONDAY THROUGH 6:00 AM WEDNESDAY
TUESDAY (GEN./REG. ELECTION)	5:00 AM TUESDAY THROUGH 12:00 AM WEDNESDAY
WEDNESDAY	12:00N TUESDAY THROUGH 6:00 AM THURSDAY
THURSDAY	12:00N WEDNESDAY THROUGH 6:00 AM FRIDAY
THURSDAY (THANKSGIVING ONLY)	6:00 AM WEDNESDAY THROUGH 6:00 AM MONDAY
FRIDAY	12:00N THURSDAY THROUGH 6:00 AM MONDAY
SATURDAY	12:00N FRIDAY THROUGH 6:00 AM MONDAY

DURING THE SAME PERIODS, MAINTAIN PEDESTRAIN ACCESS IF PEDESTRIAN ACCESS WAS PRESENT PRIOR TO CONSTRUCTION.

SHOULD THE CONTRACTOR FAIL TO MEET ANY OF THESE REQUIREMENTS, THE CONTRACTOR SHALL BE ASSESSED A DISINCENTIVE PER THE LANE VALUE CONTRACT (PN 127).

LA					
DESCRIPTION OF CRITICAL LANE	RESTRICTED TIME PERIOD	TIME UNIT	DISINCENTIVE \$ PER TIME UNIT		
1 LANE OF CLA I.R. 675 UNDERNEATH CLA-675-0079 (HADDIX RD)	PER PLCS	EACH MINUTE	\$100		
2 LANES OF MOT I.R. 675 UNDERNEATH MOT-675-0296 (MCEWEN RD)	PER PLCS	EACH MINUTE	\$100		

SHOULD THE CONSTRUCTION FOR CLA-068-0773R EXCEEDS 30 DAYS, THE CONTRACTOR SHALL BE ASSESSED A DISINCENTIVE PER THE FLEXIBLE START WINDOW CONTRACT (PN 129).

WINDOW CONTRACT TABLE												
DESCRIPTION OF	CALENDAR	DISINCENTIVE	WORK WINDOW									
CRITICAL WORK	DAYS TO COMPLETE	\$ PER DAY	START	END								
RAMP FROM U.S. 40 WEST TO U.S. 68 NORTH (CLA- 068-0773R)	30	\$2,000 PER DAY	04/15/2026	10/15/2026								

LENGTH AND DURATION OF LANE CLOSURES AND RESTRICTIONS SHALL BE AT THE APPROVAL OF THE ENGINEER. IT IS THE INTENT TO MINIMIZE THE IMPACT TO THE TRAVELING PUBLIC. LANE CLOSURES OR RESTRICTIONS OVER SEGMENTS OF THE PROJECT IN WHICH NO WORK IS ANTICIPATED WITHIN A REASONABLE TIME FRAME, AS DETERMINED BY THE ENGINEER, SHALL NOT BE PERMITTED. THE LEVEL OF UTILIZATION OF MAINTENANCE OF TRAFFIC DEVICES SHALL BE COMMENSURATE WITH THE WORK IN PROGRESS.

NOTICE OF CLOSURE SIGNS (W20-H13) SHALL BE ERECTED BY THE CONTRACTOR PRIOR TO THE SCHEDULED ROAD OR RAMP CLOSURE IN ACCORDANCE WITH THE NOTICE OF CLOSURE TIME TABLE BELOW. AT THE APPROVAL OF THE ENGINEER, PORTABLE CHANGEABLE MESSAGE SIGNS MAY BE USED IN LIEU OF THE STANDARD FLATSHEET SIGN FOR CLOSURE DURATIONS OF LESS THAN 1 WEEK.

THE SIGNS SHALL BE ERECTED ON THE RIGHT-HAND SIDE OF THE ROAD/RAMP FACING TRAFFIC. THEY SHALL BE PLACED SO AS NOT TO INTERFERE WITH THE VISIBILITY OF ANY OTHER TRAFFIC CONTROL SIGNS. ON ROADWAYS, THEY SHOULD BE ERECTED AT OR NEAR THE POINT OF CLOSURE. THE SIGNS MAY BE ERECTED ANYWHERE ON RAMPS AS LONG AS THEY ARE VISIBLE TO THE MOTORISTS USING THE RAMP. ON ENTRANCE RAMPS, THE SIGN SHALL BE ERECTED WELL IN ADVANCE OF THE MERGE AREA TO AVOID DISTRACTING MOTORISTS.

	NOTICE OF CLOSURE SIGN TIME TABLE										
	ITEM	DURATION OF CLOSURE	SIGN DISPLAYED TO PUBLIC								
	RAMP & ROAD CLOSURES	>=2 WEEKS	14 CALENDAR DAYS PRIOR TO CLOSURE								
		> 12 HOURS & < 2 WEEKS	7 CALENDAR DAYS PRIOR TO CLOSURE								
		<= 12 HOURS	2 BUSINESS DAYS PRIOR TO CLOSURE								

THE SIGN SHALL DISPLAY THE DATE OF THE CLOSURE IN MMM-DD FORMAT AND THE NUMBER OF DAYS OF THE CLOSURE. THE LAST LINE OF THE W20-H13 SIGN LISTS A PHONE NUMBER WHICH A MOTORIST MAY CALL FOR ADDITIONAL INFORMATION. THIS IS TO BE A SPECIFIC OFFICE WITHIN THE DISTRICT RATHER THAN THE GENERAL SWITCHBOARD NUMBER.

RAMP WILL BE
CLOSED MMM-DD
FOR 60 DAYS
INFO: 1-888-200-9919

W20-H13-60 FOR CLA-068-0773R

THE CONTRACTOR SHALL PROVIDE, ERECT AND MAINTAIN STANDARD 48 X 30 INCH ROAD CLOSED SIGNS, SIGN SUPPORTS, BARRICADES AND LIGHTS, AS DETAILED IN SCD MT-101.60 AT THE FOLLOWING LOCATIONS DURING PERIODS IN WHICH THE AFFECTED ROADS ARE CLOSED TO TRAFFIC.

ON-RAMP FROM U.S. 40 WEST BOUND TO U.S. 68 NORTH BOUND.

THE CONTRACTOR SHALL PROVIDE, ERECT AND MAINTAIN SIGNS AND SIGN SUPPORTS, AS DETAILED IN THE OHIO MANUAL OF UNIFORM TRAFFIC CONTROL DEVICES, AND TYPE III BARRICADES OF THE TYPE AND LOCATION IN THE STD. DRWGS.

ALL WORK AND TRAFFIC CONTROL DEVICES SHALL BE IN ACCORDANCE WITH C&MS 614 AND OTHER APPLICABLE PORTIONS OF THE SPECIFICATIONS, AS WELL AS THE OHIO MANUAL OF UNIFORM TRAFFIC CONTROL DEVICES.

PAYMENT FOR ALL LABOR, EQUIPMENT AND MATERIALS SHALL BE INCLUDED IN THE LUMP SUM CONTRACT PRICE FOR ITEM 614, MAINTAINING TRAFFIC, UNLESS SEPARATELY ITEMIZED IN THE PLAN.

ITEM 614, WORK ZONE IMPACT ATTENUATOR FOR 24" WIDE HAZARDS (UNIDIRECTIONAL)

THIS ITEM SHALL CONSIST OF FURNISHING AND INSTALLING A NON-GATING IMPACT ATTENUATOR. FURNISH AN IMPACT ATTENUATOR FROM THE OFFICE OF ROADWAY ENGINEERING'S APPROVED LIST FOR WORK ZONE IMPACT ATTENUATORS, FROM THE ROADWAY STANDARDS APPROVED PRODUCTS WEB PAGE.

INSTALLATION SHALL BE AT THE LOCATIONS SPECIFIED IN THE PLANS IN ACCORDANCE WITH THE MANUFACTURER'S SPECIFICATIONS.

THE CONTRACTOR SHALL REPAIR OR REPLACE A DAMAGED UNIT WITHIN 24 HOURS OF A DAMAGING IMPACT.

WHEN GATING IMPACT ATTENUATORS ARE DESIRED, THE CONTRACTOR SHALL SUBMIT DOCUMENTATION TO THE ENGINEER FOR ACCEPTANCE.

THE COST FOR THE ADDITIONAL BARRIER REQUIRED FOR A GATING IMPACT ATTENUATOR SHALL BE INCLUDED IN THE COST OF THE GATING IMPACT ATTENUATOR.

PAYMENT FOR THE ABOVE WORK SHALL BE MADE AT THE UNIT PRICE BID AND SHALL INCLUDE ALL LABOR, TOOLS, EQUIPMENT AND MATERIALS NECESSARY TO CONSTRUCT AND MAINTAIN A COMPLETE AND FUNCTIONAL IMPACT ATTENUATOR SYSTEM, INCLUDING ALL RELATED BACKUPS, TRANSITIONS, LEVELING PADS, HARDWARE AND GRADING, NOT SEPARATELY SPECIFIED, AS REQUIRED BY THE MANUFACTURER.

DESIGN AGENCY



2)

0

 \vdash

O

Z

RAFFIC

0

MAINTENANC

designer **JX**

REVIEWER

NKH 02-19-25


PROJECT ID


110152

110152 EET _TOTAL

P.4 TOTAL

			SHI	EET NUM.				PA	ART.	TTEN4	ITEM	GRAND	LINIT	SEE	
					5	CALCS		01/IMS	02/NHS	ITEM	EXT	TOTAL	UNIT	DESCRIPTION SHEET NO.	
														EROSION CONTROL	
						1,556		1,556		659	10000	1,556	SY	SEEDING AND MULCHING	
-						78		78		659	14000	78	SY	REPAIR SEEDING AND MULCHING	
						0.21		0.21		659	20000	0.21	TON	COMMERCIAL FERTILIZER	
-						9		9		659	35000	9	MGAL	WATER	
-						20,000		20,000		832	30000	20,000	EACH	EROSION CONTROL	
														STRUCTURE REPAIR (CLA-068-0773R)	
-						7,381			7,381	514	00050	7,381	SF	SURFACE PREPARATION OF EXISTING STRUCTURAL STEEL	
10					1	7,381			7,381	514	00056	7,381	SF	FIELD PAINTING OF EXISTING STRUCTURAL STEEL, PRIME COAT	
0.20						7,381			7,381	514	00060	7,381	SF	FIELD PAINTING STRUCTURAL STEEL, INTERMEDIATE COAT	
0.00.0						7,381			7,381	514	00066	7,381	SF	FIELD PAINTING STRUCTURAL STEEL, FINISH COAT	
er 24						12			12	514	00504	12	MNHR	GRINDING FINS, TEARS, SLIVERS ON EXISTING STRUCTURAL STEEL	
esign									4	F14	10000		EACU.	FINIAL INCRECTION DEPAIR	
toadsD						4			4	514	10000	4	EACH	FINAL INSPECTION REPAIR	
OpenR						1								STRUCTURE REPAIR (CLA-675-0079)	
CT: (17,576		17,576		514	00050	17,576	SF	SURFACE PREPARATION OF EXISTING STRUCTURAL STEEL	
nao						17,576		17,576		514	00056	17,576	SF	FIELD PAINTING OF EXISTING STRUCTURAL STEEL, PRIME COAT	
A A						17,576		17,576		514	00060	17,576	SF	FIELD PAINTING STRUCTURAL STEEL, INTERMEDIATE COAT	RY
0152						17,576 26		17,576 26		514 514	00066 00504	17,576 26	SF MNHR	FIELD PAINTING STRUCTURAL STEEL, FINISH COAT GRINDING FINS, TEARS, SLIVERS ON EXISTING STRUCTURAL STEEL	AF
ET: 11						20		20		<u> </u>	00304	20	IVIIVIII	GRINDING FINS, TEARS, SEIVERS ON EXISTING STRUCTURAL STEEL	Σ
/ORKS						8		8		514	10000	8	EACH	FINAL INSPECTION REPAIR	Σ
v02 W														STRUCTURE REPAIR (MOT-075-0259)	SL
ŢCĖ						445		445		514	00051	445	SF	SURFACE PREPARATION OF EXISTING STRUCTURAL STEEL, AS PER PLAN 3	7
HDO						445		445		514	00057	445	SF	FIELD PAINTING OF EXISTING STRUCTURAL STEEL, PRIME COAT, AS PER PLAN 3	R/
О ij						445		445		514	00061	445	SF	FIELD PAINTING STRUCTURAL STEEL, INTERMEDIATE COAT, AS PER PLAN 3	ш
SPAC						445		445		514	00067	445	SF	FIELD PAINTING STRUCTURAL STEEL, FINISH COAT, AS PER PLAN 3	EN
ORKS						1		1		514	00504	1	MNHR	GRINDING FINS, TEARS, SLIVERS ON EXISTING STRUCTURAL STEEL	19
» >						1		1		E11	10000	1	EACH	FINIAL INSPECTION DEPAID	
oj.oji						14		14		514 516	10000 25000	14	EACH SE	FINAL INSPECTION REPAIR NYLON REINFORCED NEOPRENE SHEETING	
dot.ok						1 1		1 17		310	23000		<u> </u>	WILOW KENN OKCED NEOF KENE SHEETING	
Xie@ Ign														STRUCTURE REPAIR (MOT-675-0296)	
Jun. 301.d					}	326		326		512	10100	326	SY	SEALING OF CONCRETE SURFACES (EPOXY-URETHANE)	
SER: GG(209	h , ,	209		512	74000	209	SY	REMOVAL OF EXISTING COATINGS FROM CONCRETE SURFACES	
bl U								18,665		514	00050	18,665	SF	SURFACE PREPARATION OF EXISTING STRUCTURAL STEEL	
Pen.t ts\11(18,665		18,665		514	00056	18,665	SF	FIELD PAINTING OF EXISTING STRUCTURAL STEEL, PRIME COAT	
OT_I Sheet						18,665		18,665		514	00060	18,665	SF	FIELD PAINTING STRUCTURAL STEEL, INTERMEDIATE COAT	
OHD way\3						18,665		18,665		514	00066	18,665	SF	FIELD PAINTING STRUCTURAL STEEL, FINISH COAT	
TBL: Road						28		28		514	00504	28	MNHR	GRINDING FINS, TEARS, SLIVERS ON EXISTING STRUCTURAL STEEL	
PEN rring\l						9		9		514	10000	9	EACH	FINAL INSPECTION REPAIR	
ltcfg ginee															
DF.p														MAINTENANCE OF TRAFFIC	
OT_F 52\40					400			400		614	11110	400	HOUR	LAW ENFORCEMENT OFFICER WITH PATROL CAR FOR ASSISTANCE	
2HD(6		6	1.0	614	12380	6	EACH	WORK ZONE IMPACT ATTENUATOR, 24" WIDE HAZARDS, (UNIDIRECTIONAL)	
RV: 0						26		26	LS	614 614	12420 13310	LS	EACH	DETOUR SIGNING PARRIED REFLECTOR TYPE 1 (ONE WAY)	
PLTD t 07_						26		26		614	13350	26 26	EACH EACH	BARRIER REFLECTOR, TYPE 1 (ONE WAY) OBJECT MARKER, ONE WAY	
9 PM Distric															
3:03:0 rojects						1,300		1,300		622	41100	1,300	FT	PORTABLE BARRIER, UNANCHORED	
TIME:														INCIDENTALS	DESIGN AGEN
2025 .01 Ac								LS	LS	614	11000	LS		MAINTAINING TRAFFIC	DESIGN AGEI
)/20/2 ents\								LS	LS	624	10000	LS		MOBILIZATION	
E: 1(_	-			
DA1 02\D(1		-			1	+ +			
(in.) t-pw-					 	1					1	+			DISTRI
4x22 liodot	 					+					+	+			ENGINE
ZE 3					† †		1								DESIGNER
PERSI Itley.cc															REVIE'
et PAI ow.ben							-					+ +			LCG 01
L: Sheet PAI															PROJECT ID 1101
ODEI v:\\oh															SHEET T
Σğ															P.8

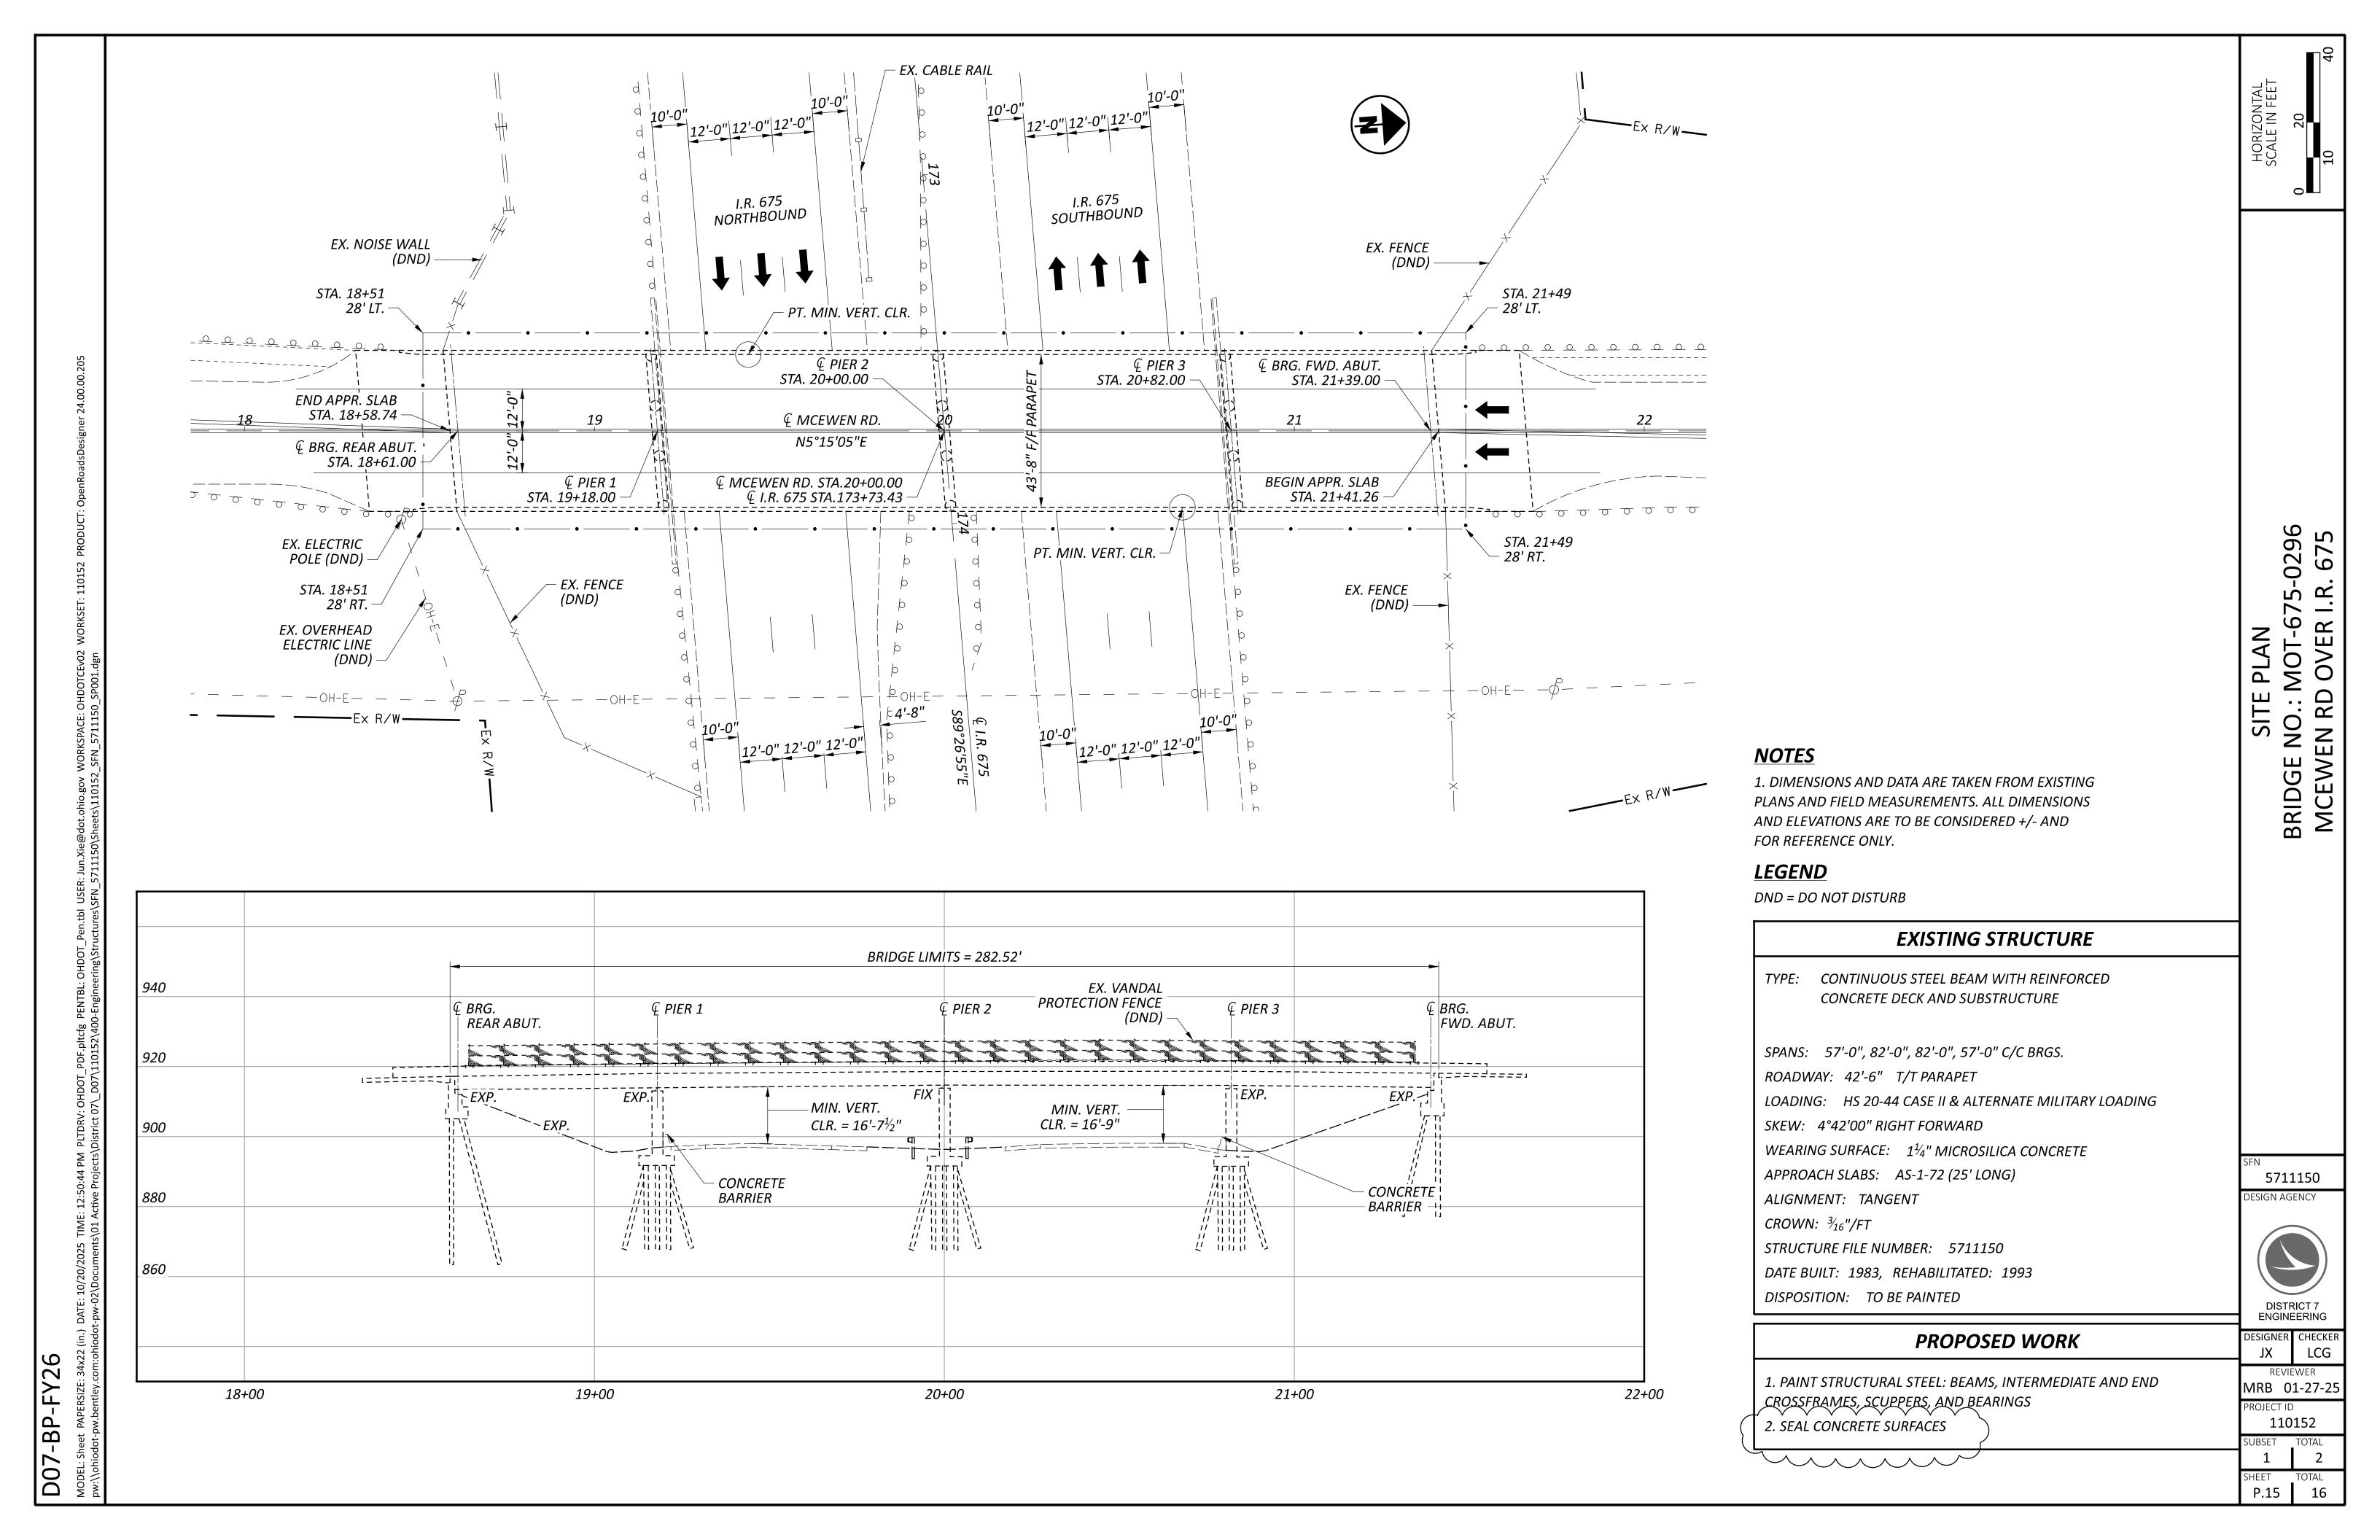

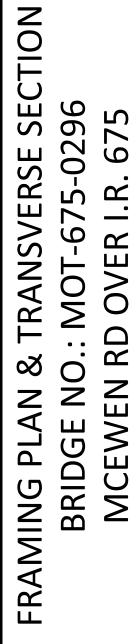



5711150


ESIGN AGENCY

P.16



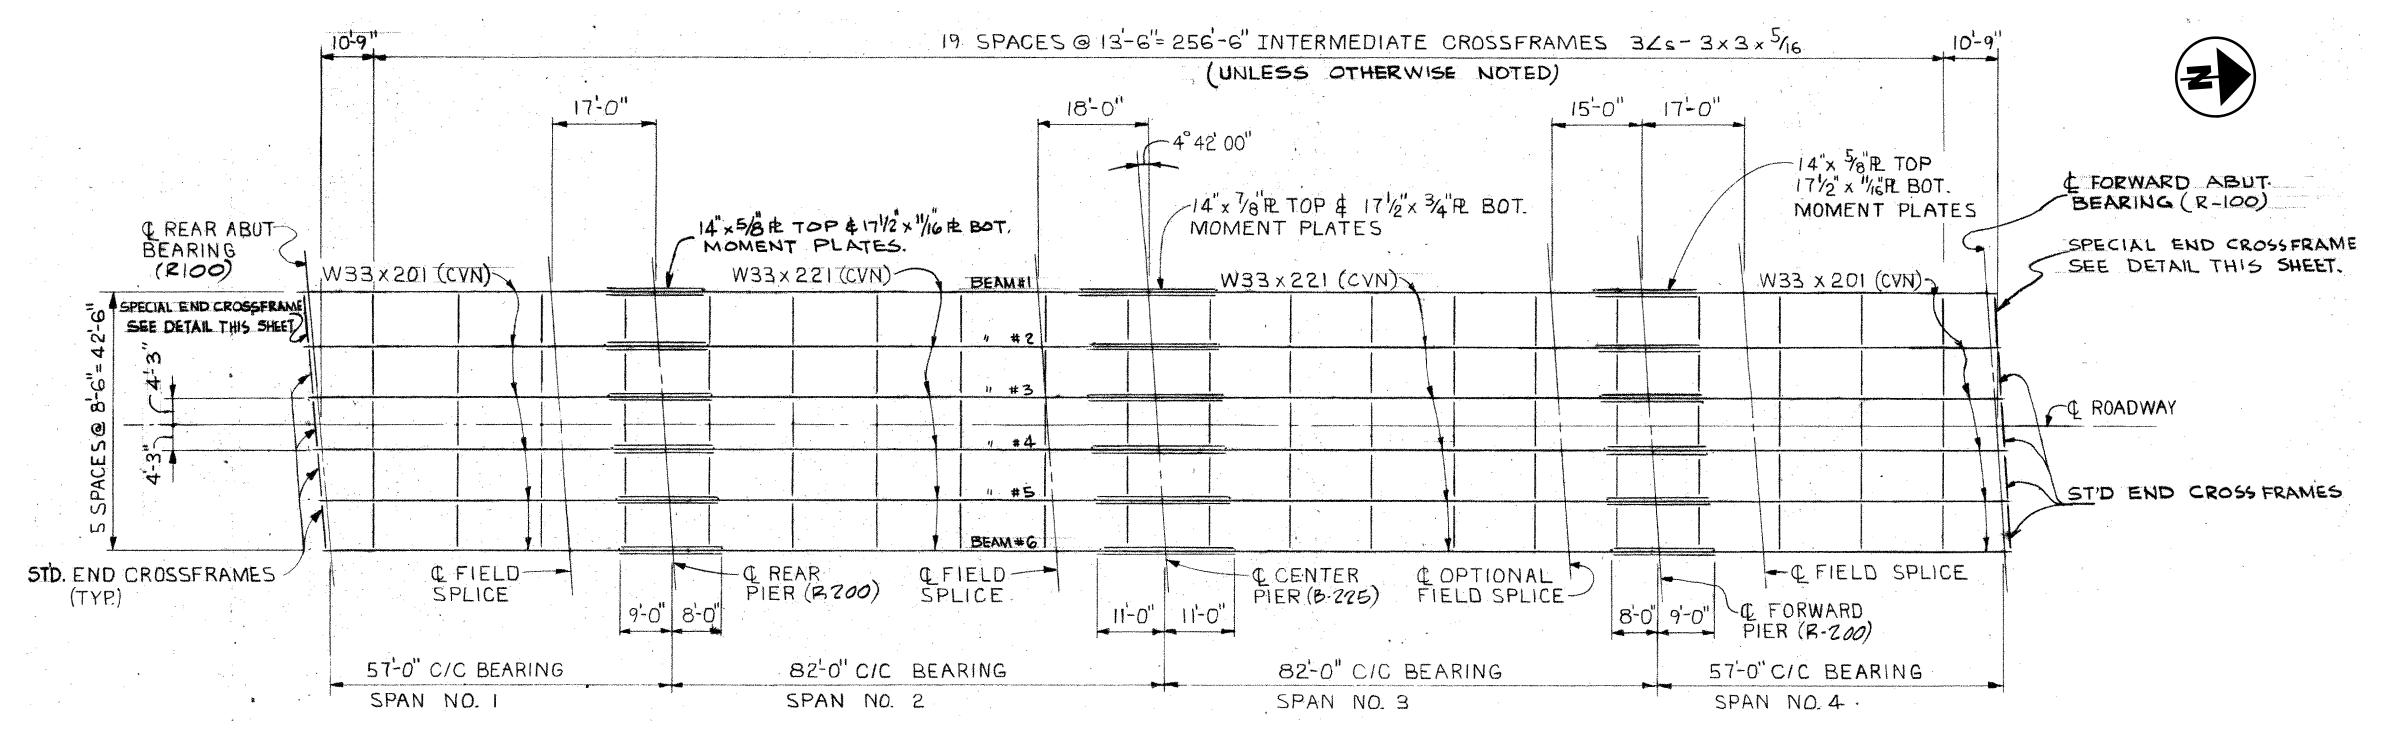


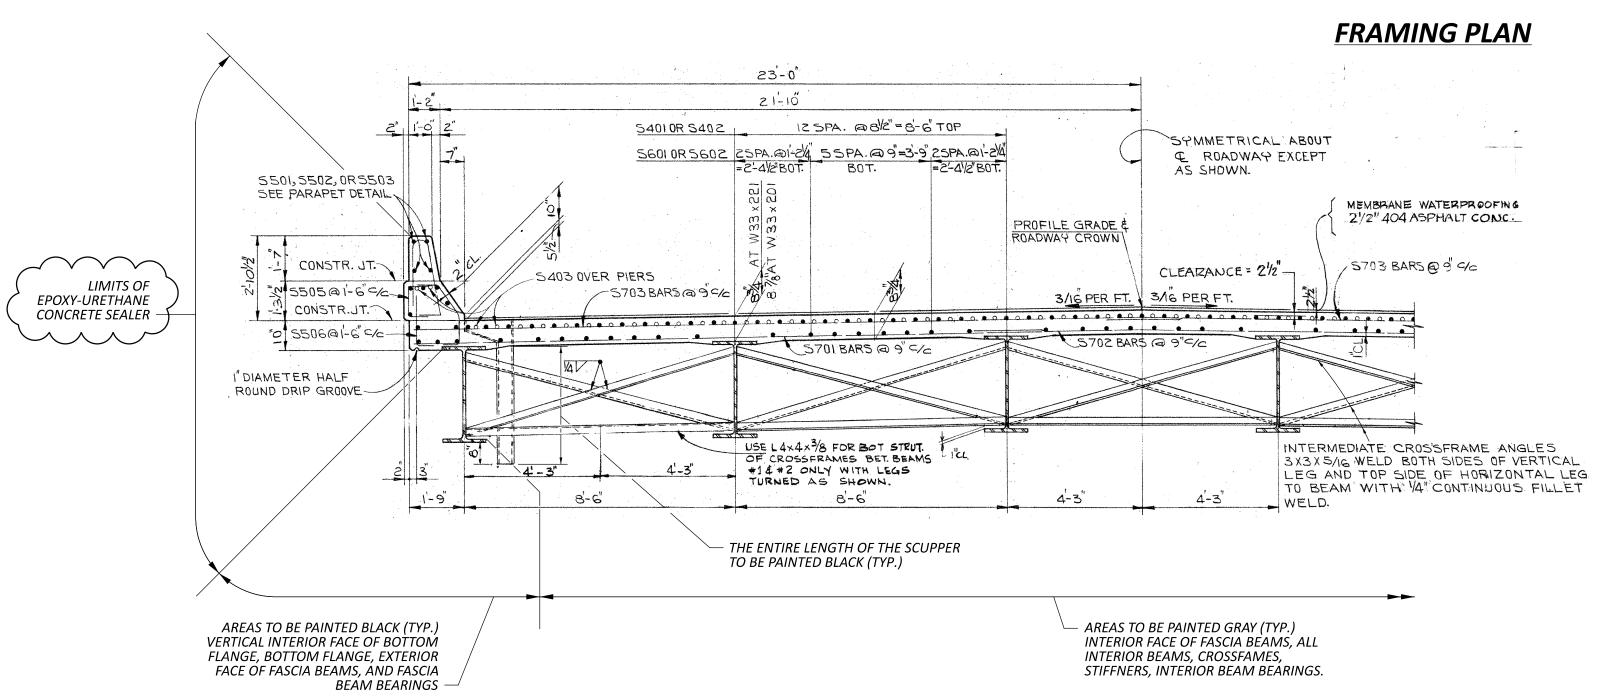

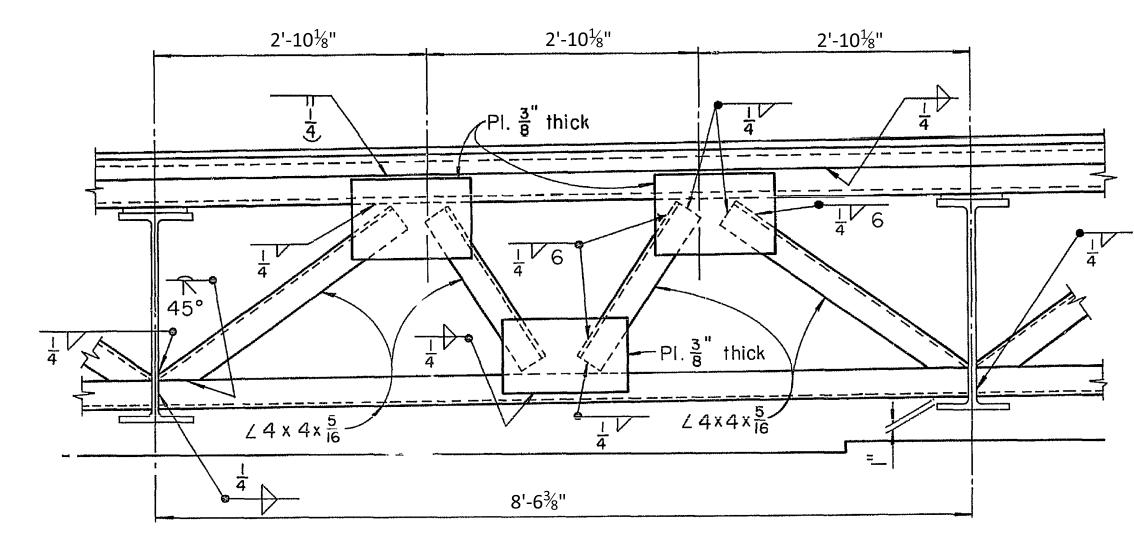

STANDARD END FRAME SECTION

TRANSVERSE SECTION

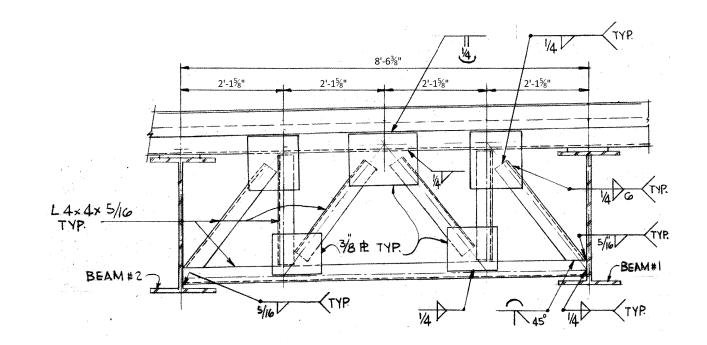

-BP-FY

D07

SPECIAL END FRAME SECTION

NOTES

- 1. DIMENSIC PLANS. ALL AND FOR REFERENCE ONLY.
- 2. THE STRUCTURAL STEEL FINISH COAT COLOR SHALL BE 27040 (BLACK) AND 16440 (GRAY)

		RICT 7 EERING
	DESIGNER JX	CHECK LCC
		EWER) 1-27- :
ONS AND DATA ARE TAKEN FROM EXISTING DIMENSIONS ARE TO BE CONSIDERED +/-	PROJECT II) 152