


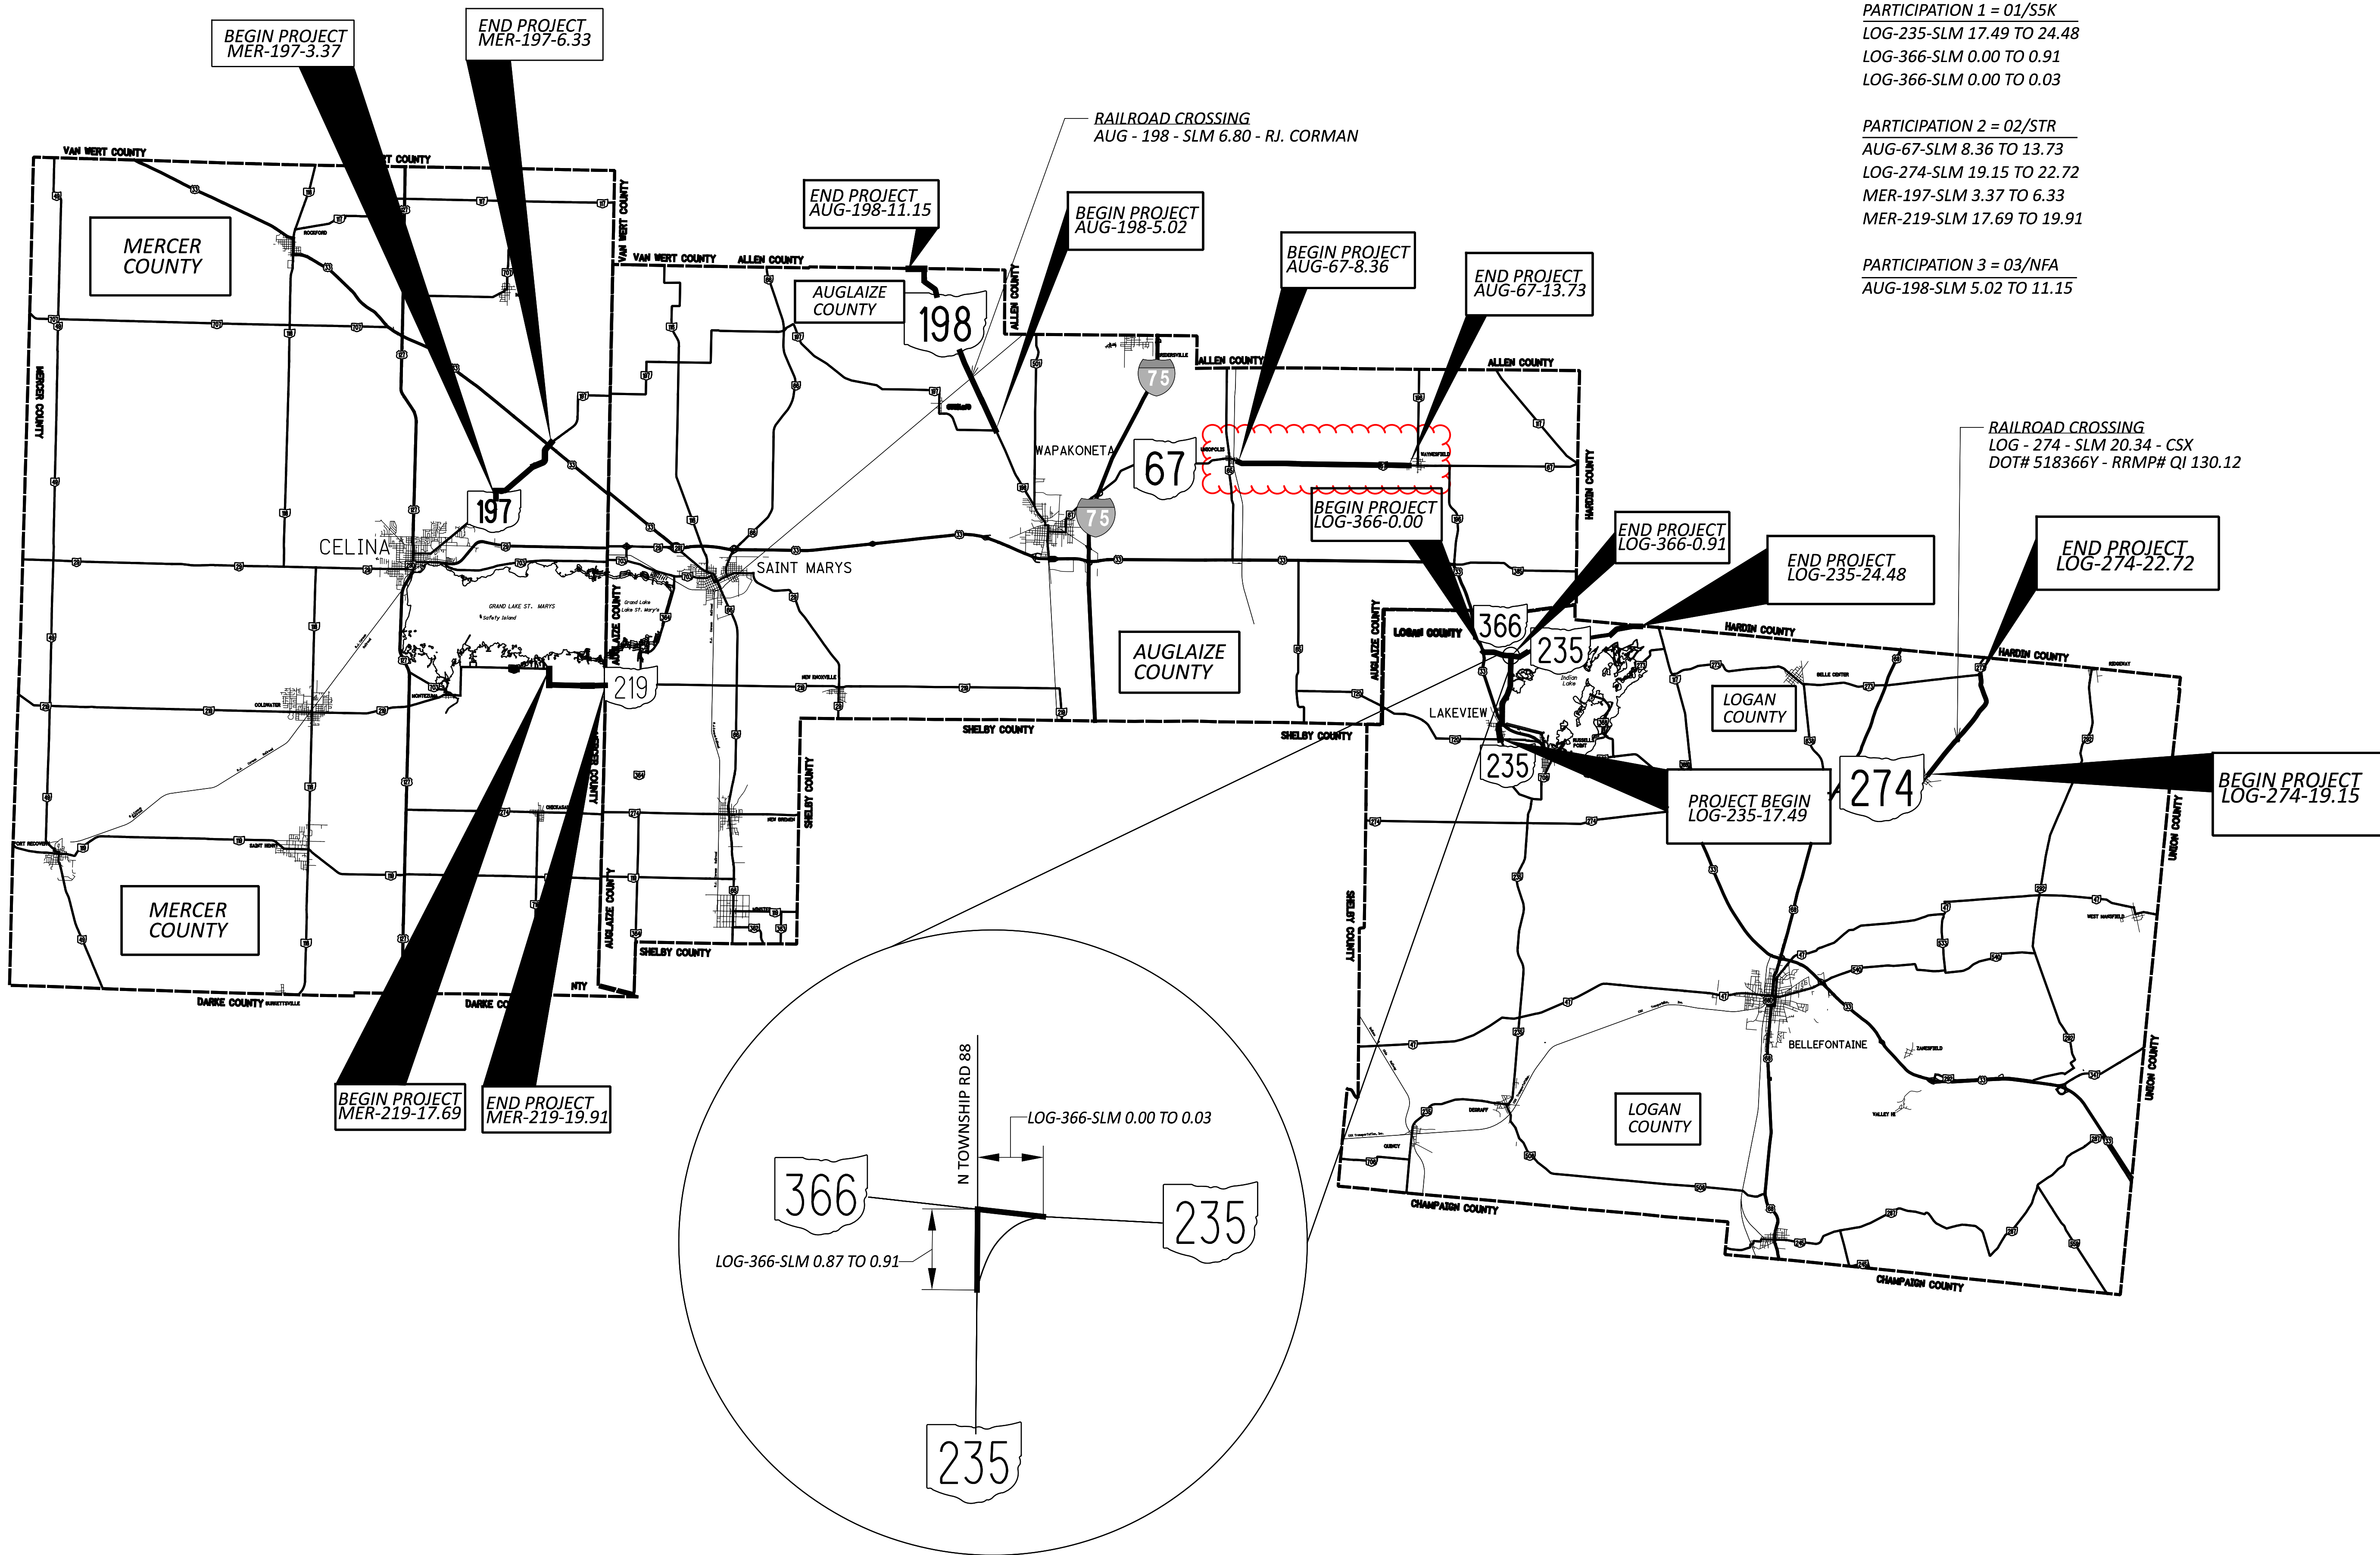


PARTICIPATION 1 = 01/S5K  
LOG-235-SLM 17.49 TO 24.48  
LOG-366-SLM 0.00 TO 0.91  
LOG-366-SLM 0.00 TO 0.03

PARTICIPATION 2 = 02/STR  
AUG-67-SLM 8.36 TO 13.73  
LOG-274-SLM 19.15 TO 22.72  
MER-197-SLM 3.37 TO 6.33  
MER-219-SLM 17.69 TO 19.91

PARTICIPATION 3 = 03/NFA  
AUG-198-SLM 5.02 TO 11.15

ROADWAY LOCATION MAP

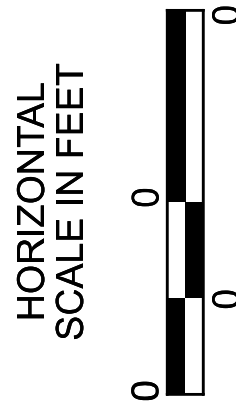

DESIGN AGENCY



DESIGNER

LDB

REVIEWER

BJA 7/18/2025

PROJECT ID

114554

SHEET

P.2

TOTAL

11

| SHEET NUMBER |  |  |  |       |    |         |        |       |       |  | PART.   |         |        | ITEM | ITEM<br>EXT | GRAND<br>TOTAL | UNIT | DESCRIPTION                                                | SEE SHEET<br>NO. |
|--------------|--|--|--|-------|----|---------|--------|-------|-------|--|---------|---------|--------|------|-------------|----------------|------|------------------------------------------------------------|------------------|
|              |  |  |  | 4     | 5  | 7       | 8      | 9     | 10    |  | 01/S5K  | 02/STR  | 03/NFA |      |             |                |      |                                                            |                  |
|              |  |  |  | 1,750 |    |         |        |       |       |  | 500     | 1,000   | 250    | 251  | 01001       | 1,750          | SY   | PAVEMENT                                                   |                  |
|              |  |  |  |       |    | 436,697 |        |       |       |  | 135,969 | 210,845 | 89,883 | 422  | 11000       | 436,697        | SY   | AGGREGATE, SINGLE CHIP SEAL, TYPE A                        |                  |
|              |  |  |  |       |    | 174,677 |        |       |       |  | 54,386  | 84,338  | 35,953 | 422  | 25000       | 174,677        | GAL  | EMULSION, CHIP SEAL, 0.40 GAL/SY                           |                  |
|              |  |  |  |       |    | 16,315  |        |       |       |  | 16,315  |         |        | 886  | 11000       | 16,315         | GAL  | FOG SEAL, 0.12 GAL/SY                                      |                  |
|              |  |  |  |       |    |         |        |       |       |  |         |         |        |      |             |                |      | TRAFFIC CONTROL                                            |                  |
|              |  |  |  |       |    |         |        |       | 2,129 |  | 689     | 1,019   | 421    | 621  | 00100       | 2,129          | EACH | RPM                                                        |                  |
|              |  |  |  |       |    |         |        | 2,129 |       |  | 689     | 1,019   | 421    | 621  | 54000       | 2,129          | EACH | RAISED PAVEMENT MARKER REMOVED                             |                  |
|              |  |  |  |       |    |         | 112.72 |       |       |  | 31.72   | 56.48   | 24.52  | 642  | 00104       | 112.72         | MILE | EDGE LINE, 6", TYPE 1                                      | 4                |
|              |  |  |  |       |    |         | 56.36  |       |       |  | 15.86   | 28.24   | 12.26  | 642  | 00300       | 56.36          | MILE | CENTER LINE, TYPE 1                                        |                  |
|              |  |  |  |       |    |         | 1,000  |       |       |  | 1,000   |         |        | 642  | 00400       | 1,000          | FT   | CHANNELIZING LINE, 8", TYPE 1                              |                  |
|              |  |  |  |       |    |         | 364    |       |       |  | 162     | 132     | 70     | 642  | 00500       | 364            | FT   | STOP LINE, TYPE 1                                          |                  |
|              |  |  |  |       |    |         | 730    |       |       |  | 730     |         |        | 642  | 00620       | 730            | FT   | CROSSWALK LINE, 12", TYPE 1                                |                  |
|              |  |  |  |       |    |         | 8      |       |       |  |         | 4       | 4      | 642  | 01000       | 8              | EACH | RAILROAD SYMBOL MARKING, TYPE 1                            |                  |
|              |  |  |  |       |    |         | 962    |       |       |  | 962     |         |        | 642  | 01200       | 962            | FT   | PARKING LOT STALL MARKING, TYPE 1                          |                  |
|              |  |  |  |       |    |         | 4      |       |       |  | 4       |         |        | 642  | 01702       | 4              | EACH | HANDICAP SYMBOL MARKING, TYPE 1                            |                  |
|              |  |  |  |       |    |         | 500    |       |       |  | 500     |         |        | 642  | 30000       | 500            | FT   | REMOVAL OF PAVEMENT MARKING, CHANNELIZING LINE, 8", TYPE 1 |                  |
|              |  |  |  |       |    |         | 365    |       |       |  | 365     |         |        | 642  | 30000       | 365            | FT   | REMOVAL OF PAVEMENT MARKING, CROSSWALK LINE, 12", TYPE 1   |                  |
|              |  |  |  |       |    |         | 481    |       |       |  | 481     |         |        | 642  | 30000       | 481            | FT   | REMOVAL OF PAVEMENT MARKING, PARKING LOT STALL, TYPE 1     |                  |
|              |  |  |  |       |    |         | 182    |       |       |  | 81      | 66      | 35     | 642  | 30000       | 182            | FT   | REMOVAL OF PAVEMENT MARKING, STOP LINE , TYPE 1            |                  |
|              |  |  |  |       |    |         | 2      |       |       |  | 2       |         |        | 642  | 30020       | 2              | EACH | REMOVAL OF PAVEMENT MARKING, HANDICAP SYMBOL, TYPE 1       |                  |
|              |  |  |  |       |    |         | 4      |       |       |  |         | 2       | 2      | 642  | 30020       | 4              | EACH | REMOVAL OF PAVEMENT MARKING, RAILROAD SYMBOL MARKING       |                  |
|              |  |  |  |       |    |         |        | 28.18 |       |  | 7.93    | 14.12   | 6.13   | 642  | 30030       | 28.18          | MILE | REMOVAL OF PAVEMENT MARKING, CENTERLINE , 6"               |                  |
|              |  |  |  |       |    |         |        | 56.36 |       |  | 15.86   | 28.24   | 12.26  | 642  | 30030       | 56.36          | MILE | REMOVAL OF PAVEMENT MARKING, EDGE LINE , 6"                |                  |
|              |  |  |  |       | 20 |         |        |       |       |  |         |         |        | 614  | 11110       | 20             | hour | MAINTENANCE OF TRAFFIC                                     |                  |
|              |  |  |  |       |    |         |        | 246   |       |  | 20      |         |        | 614  | 11110       | 20             | hour | LAW ENFORCEMENT OFFICER WITH PATROL CAR FOR ASSISTANCE     |                  |
|              |  |  |  |       |    |         | 64.29  |       |       |  | 92      | 119     | 35     | 614  | 12460       | 246            | EACH | WORK ZONE MARKING SIGN                                     | 5                |
|              |  |  |  |       |    |         | 128.58 |       |       |  | 23.79   | 28.24   | 12.26  | 614  | 21100       | 64.29          | MILE | WORK ZONE CENTER LINE, CLASS I, 642 PAINT                  |                  |
|              |  |  |  |       |    |         | 1,500  |       |       |  | 47.58   | 56.48   | 24.52  | 614  | 22110       | 128.58         | MILE | WORK ZONE EDGE LINE, CLASS I, 6", 642 PAINT                |                  |
|              |  |  |  |       |    |         |        |       |       |  | 1,500   |         |        | 614  | 23200       | 1,500          | FT   | WORK ZONE CHANNELIZING LINE, CLASS I, 8", 642 PAINT        |                  |
|              |  |  |  |       |    |         | 445    |       |       |  | 243     | 132     | 70     | 614  | 26200       | 445            | FT   | WORK ZONE STOP LINE, CLASS I, 642 PAINT                    |                  |
|              |  |  |  |       |    |         | 1,095  |       |       |  | 1,095   |         |        | 614  | 27050       | 1,095          | FT   | WORK ZONE CROSSWALK LINE, CLASS I, 12", 642 PAINT          |                  |
|              |  |  |  |       |    |         | 8      |       |       |  |         | 4       | 4      | 614  | 32200       | 8              | EACH | WORK ZONE RAILROAD SYMBOL MARKING, CLASS I, 642 PAINT      |                  |
|              |  |  |  |       |    |         |        |       |       |  |         |         |        |      |             |                |      | INCIDENTALS                                                |                  |
|              |  |  |  |       |    |         |        |       |       |  | LS      | LS      | LS     | 614  | 11000       | LS             |      | MAINTAINING TRAFFIC                                        |                  |
|              |  |  |  |       |    |         |        |       |       |  | LS      | LS      | LS     | 624  | 10000       | LS             |      | MOBILIZATION                                               |                  |

GENERAL SUMMARY

DESIGN AGENCY



DESIGNER

CJP

REVIEWER

BJA 7/18/2025

PROJECT ID

114554

SHEET

P.6

TOTAL

11

|                                                                                       |       |
|---------------------------------------------------------------------------------------|-------|
| PAVEMENT MARKING SUBSUMMARY (2/2)                                                     |       |
| DESIGN AGENCY                                                                         |       |
|  |       |
| DESIGNER                                                                              |       |
| CJP                                                                                   |       |
| REVIEWER                                                                              |       |
| BJA 7/18/2025                                                                         |       |
| PROJECT ID                                                                            |       |
| 114554                                                                                |       |
| SHEET                                                                                 | TOTAL |
| P.9                                                                                   | 11    |