

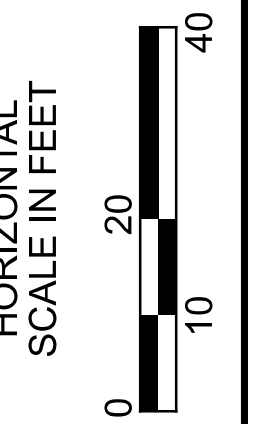
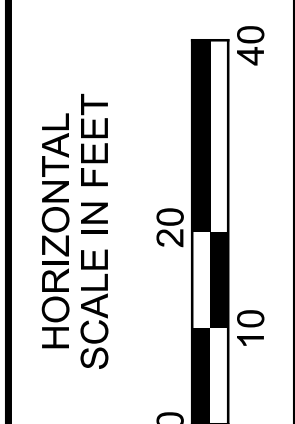


EXISTING STRUCTURE	
TYPE: 42' SPAN x 11.5' RISE CORRUGATED METAL ARCH ON REINFORCED REINFORCED CONCRETE PEDESTAL WALLS	
LENGTH: 242±	
ROADWAY: 10'-0" F/F TUNNEL SAFETY CURB	
LOADING: HS20-44 + EARTH COVER	
SKEW: 17° LT. FWD	
WEARING SURFACE:	
APPROACH SLABS: NONE	
ALIGNMENT: TANGENT	
CROWN:	
STRUCTURE FILE NUMBER: 0903342	
DATE BUILT: 1999	
DISPOSITION: MINOR RUST REPAIRS	
LATITUDE: N 39° 22' 57.01"	
LONGITUDE: W 84° 28' 34.02"	
OFWM: 659.5'	
CULVERT INVERT: 658'	

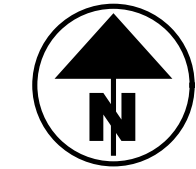

GENERAL PLAN
 BRIDGE No: BUT-129-1958
 SR 129 OVER MILL CREEK

SFN	
0903442	
DESIGN AGENCY	
DESIGNER	CHECKER
GAT	CAH
REVIEWER	
MLB 08/03/22	
PROJECT ID	
100799	
SUBSET	TOTAL
1	2
SHEET	TOTAL
10	13

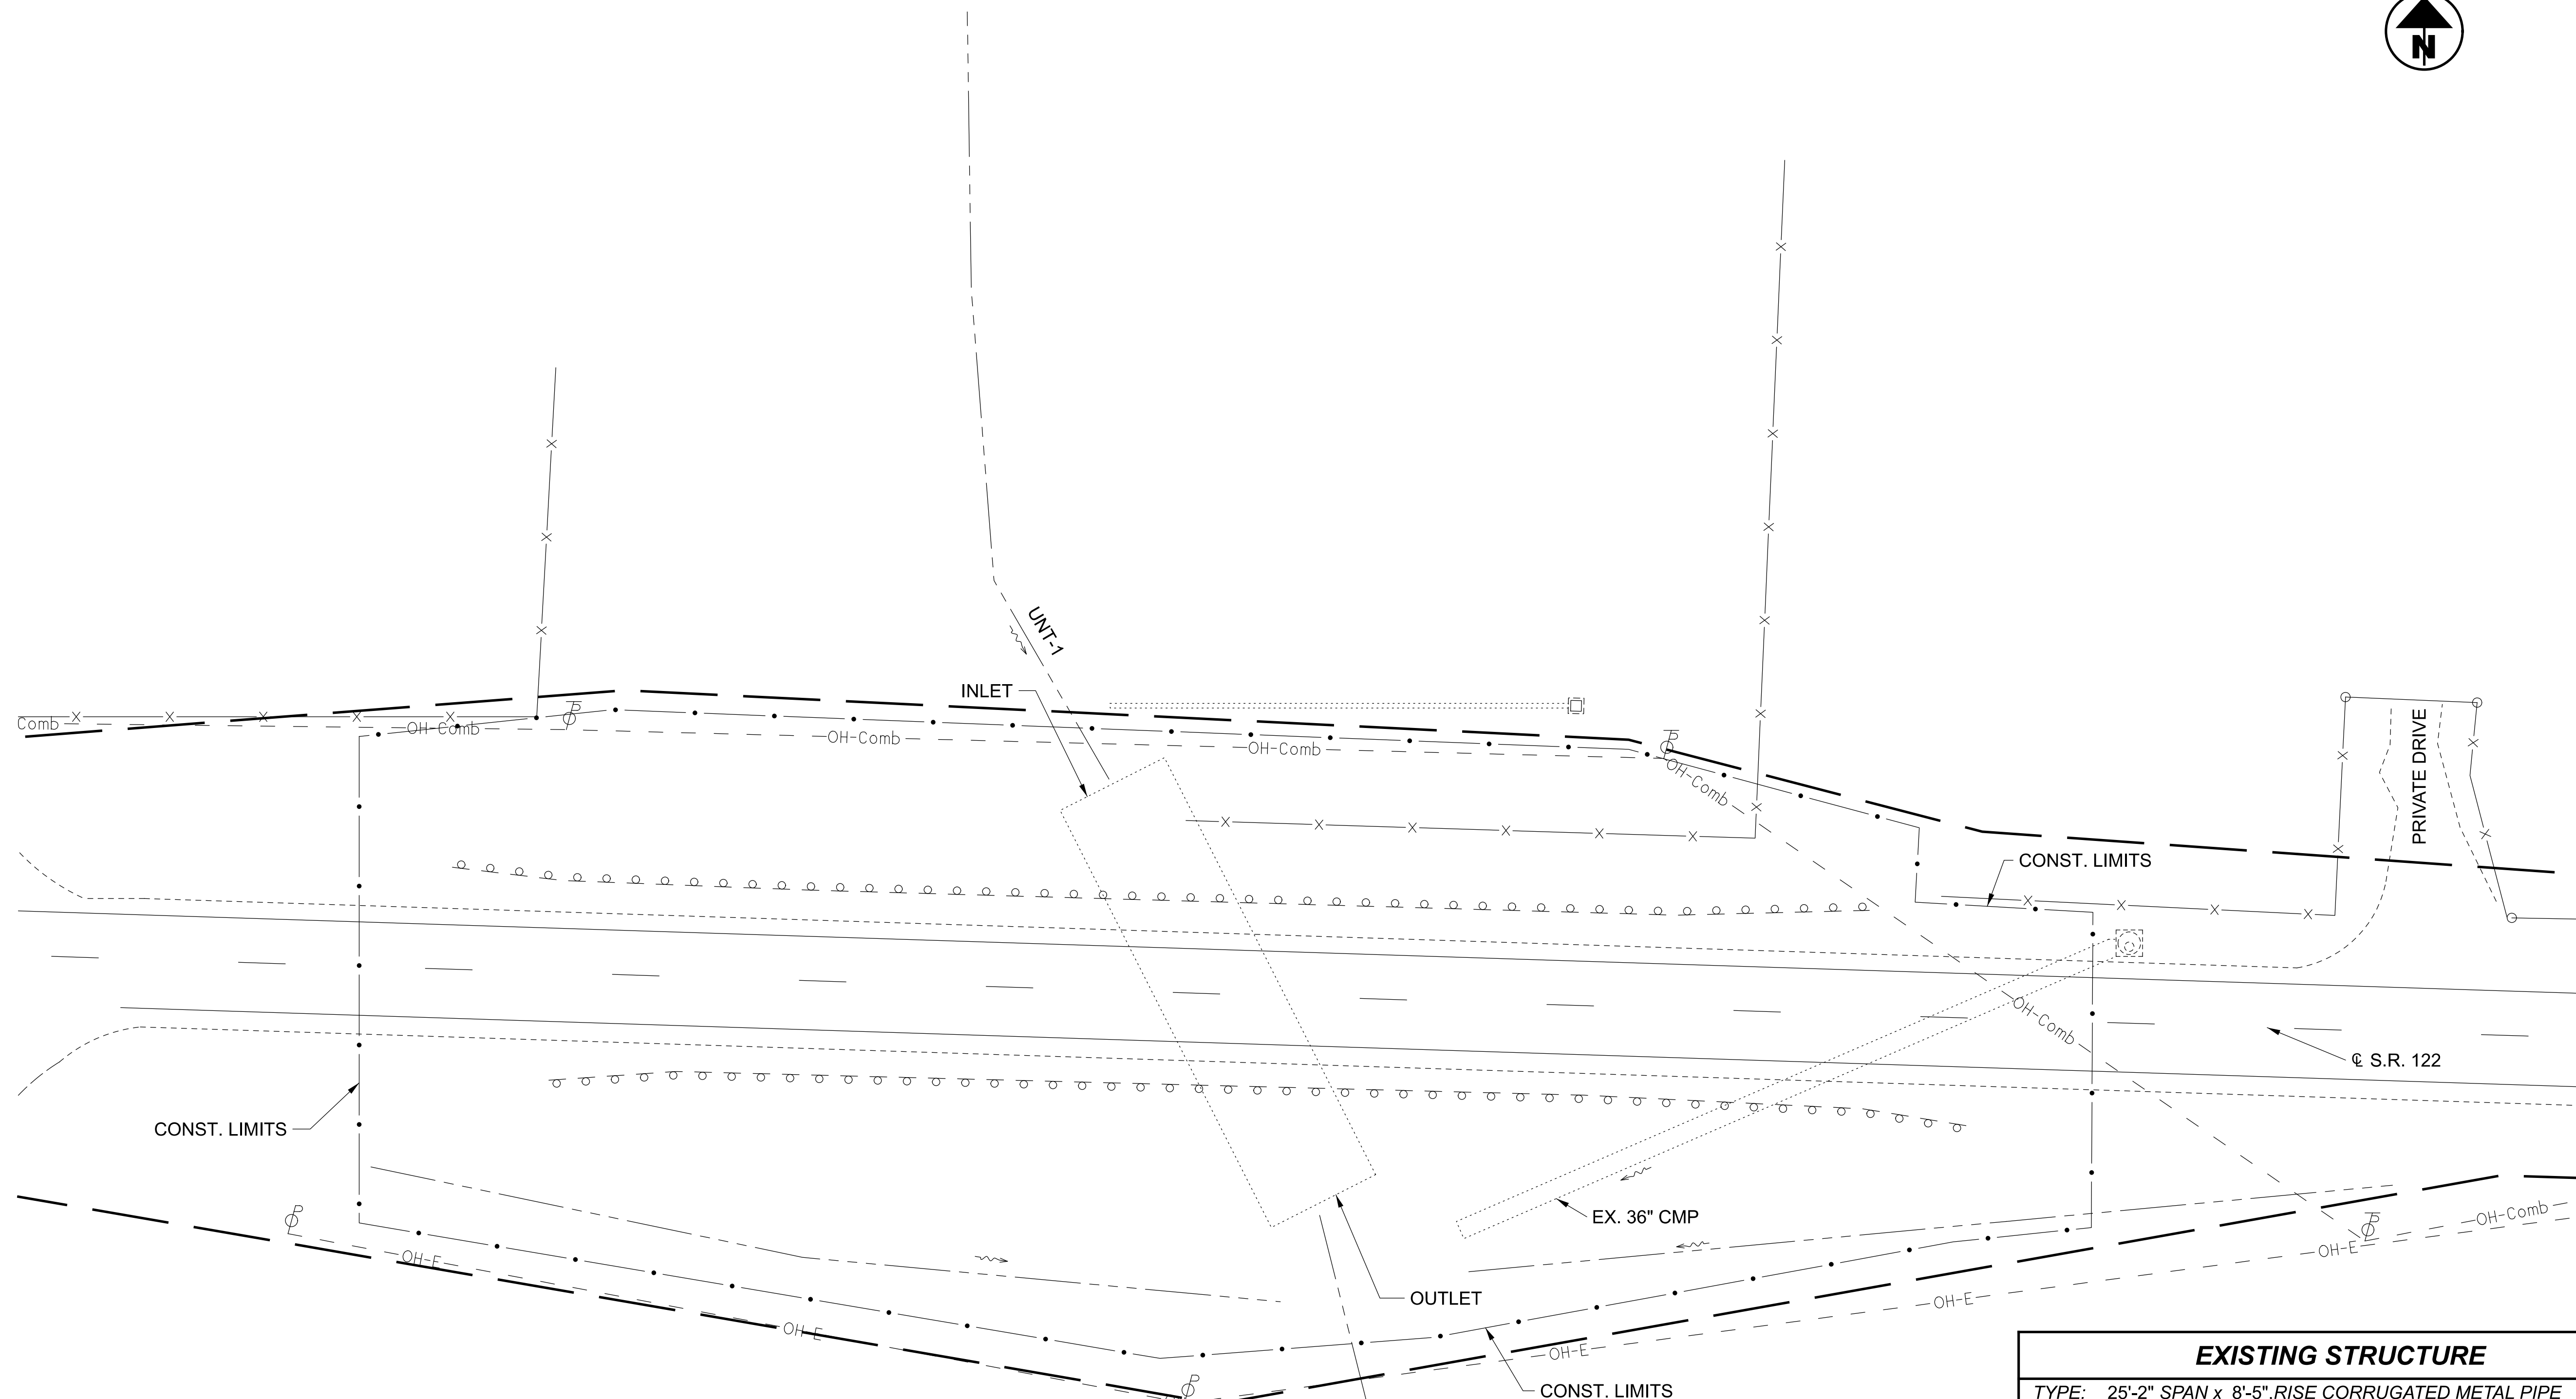

GENERAL PLAN
BRIDGE No. PRE-122-0205
S.R. 122 OVER TRIBUTARY OF FOUR MILE CREEK

EXISTING STRUCTURE	
TYPE:	25'-2" SPAN x 8'-5", RISE CORRUGATED METAL PIPE
LENGTH:	100'
ROADWAY:	28'-0" F/F GUARDRAIL
LOADING:	HS20-44 + 7' OF EARTH COVER
SKREW:	17° RT. FWD
WEARING SURFACE:	
APPROACH SLABS:	NONE
ALIGNMENT:	TANGENT
CROWN:	
STRUCTURE FILE NUMBER:	6801935
DATE BUILT:	1982
DISPOSITION:	MINOR RUST REPAIRS
LATITUDE:	N 39° 44' 36.47"
LONGITUDE:	W 84° 46' 32.56"
OHWM:	1103.5'
CULVERT INVERT:	1100.1'

SFN	6801935
DESIGN AGENCY	
DESIGNER	GAT
CHECKER	CAH
REVIEWER	MLB 08/03/22
PROJECT ID	100799
SUBSET	TOTAL
1	2
SHEET	TOTAL
12	13