FY2026 D08 NOISE

SEE PAGES 2-5

LOCATION MAP

LATITUDE: 39°17'20" LONGITUDE: -84°26'8"

STATE OF OHIO DEPARTMENT OF TRANSPORTATION

D08-N0ISE WALLS-FY2026

GREENE, HAMILTON, AND BUTLER COUNTY

INDEX OF SHEETS:

	TITLE SHEET	1
	LOCATION MAPS	2-5
	GENERAL NOTES	6-8
	MAINTENANCE OF TRAFFIC	8
7	DETOUR MAP	9a 🛂
	GENERALSUMMARY	100
	NOISE WALL SUBSUMMARY	11
	NOISE WALL EXAMPLES	12
	STRUCTURES GENERAL NOTES	13
	STRUCTURES SUBSUMMARY	14
	STRUCTURES OVER 20' SPAN	
	HAM-SR-126 13.199 L	15-22
	HAM-SR-126 13.312 R	23-26
	HAM-RA-31371 0.389 N	27-34

FEDERAL PROJECT NUMBER

E230220

RAILROAD INVOLVEMENT

CSX TRANSPORTATION, NORFOLK SOUTHERN

PROJECT DESCRIPTION

REPLACE AND REHABILITATE NOISE WALL PANELS WHICH HAVE BEEN DAMAGED THROUGHOUT DISTRICT 8. PERFORM MINOR BRIDGE REHABILITATION ON HAM SR 126.

EARTH DISTURBED AREAS

0.8 ACRES PROJECT EARTH DISTURBED AREA: ESTIMATED CONTRACTOR EARTH DISTURBED AREA: 0.2 ACRES NOTICE OF INTENT EARTH DISTURBED AREA: N/A

LIMITED ACCESS

THIS IMPROVEMENT IS ESPECIALLY DESIGNED FOR THROUGH TRAFFIC AND HAS BEEN DECLARED A LIMITED ACCESS HIGHWAY OR FREEWAY BY ACTION OF THE DIRECTOR IN ACCORDANCE WITH THE PROVISIONS OF SECTION 5511.02 OF THE OHIO REVISED CODE.

2023 SPECIFICATIONS

THE STANDARD SPECIFICATIONS OF THE STATE OF OHIO, DEPARTMENT OF TRANSPORTATION, INCLUDING SUPPLEMENTAL SPECIFICATIONS LISTED IN THE PLANS, CHANGES LISTED IN THE PROPOSAL, AND THE SUPPLEMENTAL SPECIFICATION 800 VERSION INDICATED ON THE PROPOSAL SHALL GOVERN THIS IMPROVEMENT.

I HEREBY APPROVE THESE PLANS AND DECLARE THAT THE MAKING OF THIS IMPROVEMENT WILL NOT REQUIRE THE CLOSING TO TRAFFIC OF THE HIGHWAY AND THAT PROVISIONS FOR THE MAINTENANCE AND SAFETY OF TRAFFIC WILL BE AS SET FORTH ON THE PLANS AND ESTIMATES.

Douglas A. Gruver, P.E. District 08 Deputy Director

Director, Department of Transportation

DESIGN EXCEPTIONS


ADA DESIGN WAIVERS

NONE

UNDERGROUND UTILITIES Contact Two Working Days Before You Dig **OHIO811.**org Before You Dig OHIO811, 8-1-1, or 1-800-362-2764 (Non members must be called directly)

PLAN PREPARED BY: **ODOT DISTRICT 8** *505 SOUTH STATE ROUTE 741* LEBANON, OH, 45036

		SUPPLEI SPECIFIC		SPECIAL PROVISIONS		
NBS-1-09	1/17/25			800-2023	7/18/25	
				832	7/18/25	
MT-95.30	7/18/25					
MT-95.45	7/21/23					

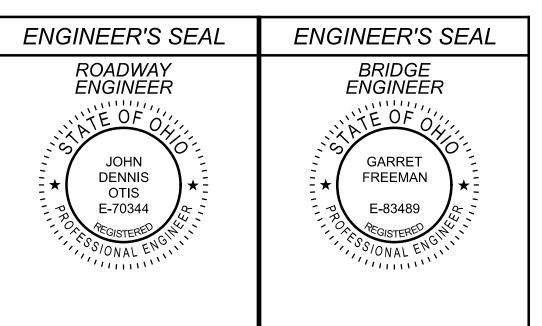

ESIGN AGENCY



ESIGNER NCD REVIEWER JDO 08-07-25 ROJECT ID 112574

REVIEWER JDO 08-07-25 112574

34

SHEET NUMBER								PART.			ITEM	GRAND	SEE			
	9		12		14				01/NHS	02/IMS	03/NHS	ITEM	EXT	TOTAL	UNIT	DESCRIPTION SHEET NO.
																ROADWAY
										LS	LS	201	11000	LS		CLEARING AND GRUBBING
										1,500	1,500	832	30000	3,000	EACH	EROSION CONTROL EROSION CONTROL
																NOISE BARRIERS
			6 26,463							3 19,215	3 7,248	202 202	98100 98400	6 26,463		REMOVAL MISC.:, STEEL POST REMOVAL REMOVAL MISC.:, NOISE BARRIER PANEL REMOVAL AND DISPOSAL 7
			20,403							13,213		202	30400	20,403		REMOVAE MISC., NOISE BARRIER TANCE REMOVAE AND DISTOSAE
			602							302	300	519	11101	602	SF	PATCHING CONCRETE STRUCTURE, AS PER PLAN 6
			24,188 373							17,180 256	7,008 117	SPECIAL SPECIAL	60610210 60610720	24,188 373		NOISE BARRIER (REFLECTIVE), CONCRETE PANEL NOISE BARRIER PANEL REMOVAL AND REUSE 6
			6							3	3	SPECIAL	60610720	6		NOISE BARRIER, STEEL POST 6
			42							42		SPECIAL	60610810	42	EACH	NOISE BARRIER, FIBERGLASS POST COVER 7
			2,400 115							2,160 115	240	SPECIAL SPECIAL	60610920 60610920	2,400 115		NOISE BARRIER(REFLECTIVE), STEEL PANEL7NOISE BARRIER(REFLECTIVE), FIBERGLASS PANEL7
			115							115		SPECIAL	00010920	115		STRUCTURE OVER 20 FOOT SPAN (3118460) SEE SHEET 14
																STRUCTURE OVER 20 FOOT SPAN (3118479)
																SEE SHEET 14
																STRUCTURE OVER 20 FOOT SPAN (3104915) SEE SHEET 14
																MAINTENANCE OF TRAFFIC
	200									<u>~100~</u>						LAW ENFORCEMENT OFFICER WITH PATROL CAR FOR ASSISTANCE
									15,000	(LS XXXXX	614	12420	LS LA 145 ANA A		DETOUR SIGNING 2 PRAILROAD PLAGGING SERVICES
									LS LS LS	LS LS LS	LS LS LS	614 623 624	11000 10000 10000	LS LS LS		INCIDENTALS MAINTAINING TRAFFIC CONSTRUCTION LAYOUT STAKES AND SURVEYING MOBILIZATION
	-															
ı																

D08 NOISE WALLS FY2026

DESIGN AGENCY



DESIGNER
NCD
REVIEWER
JDO 08-07-25
PROJECT ID
112574