


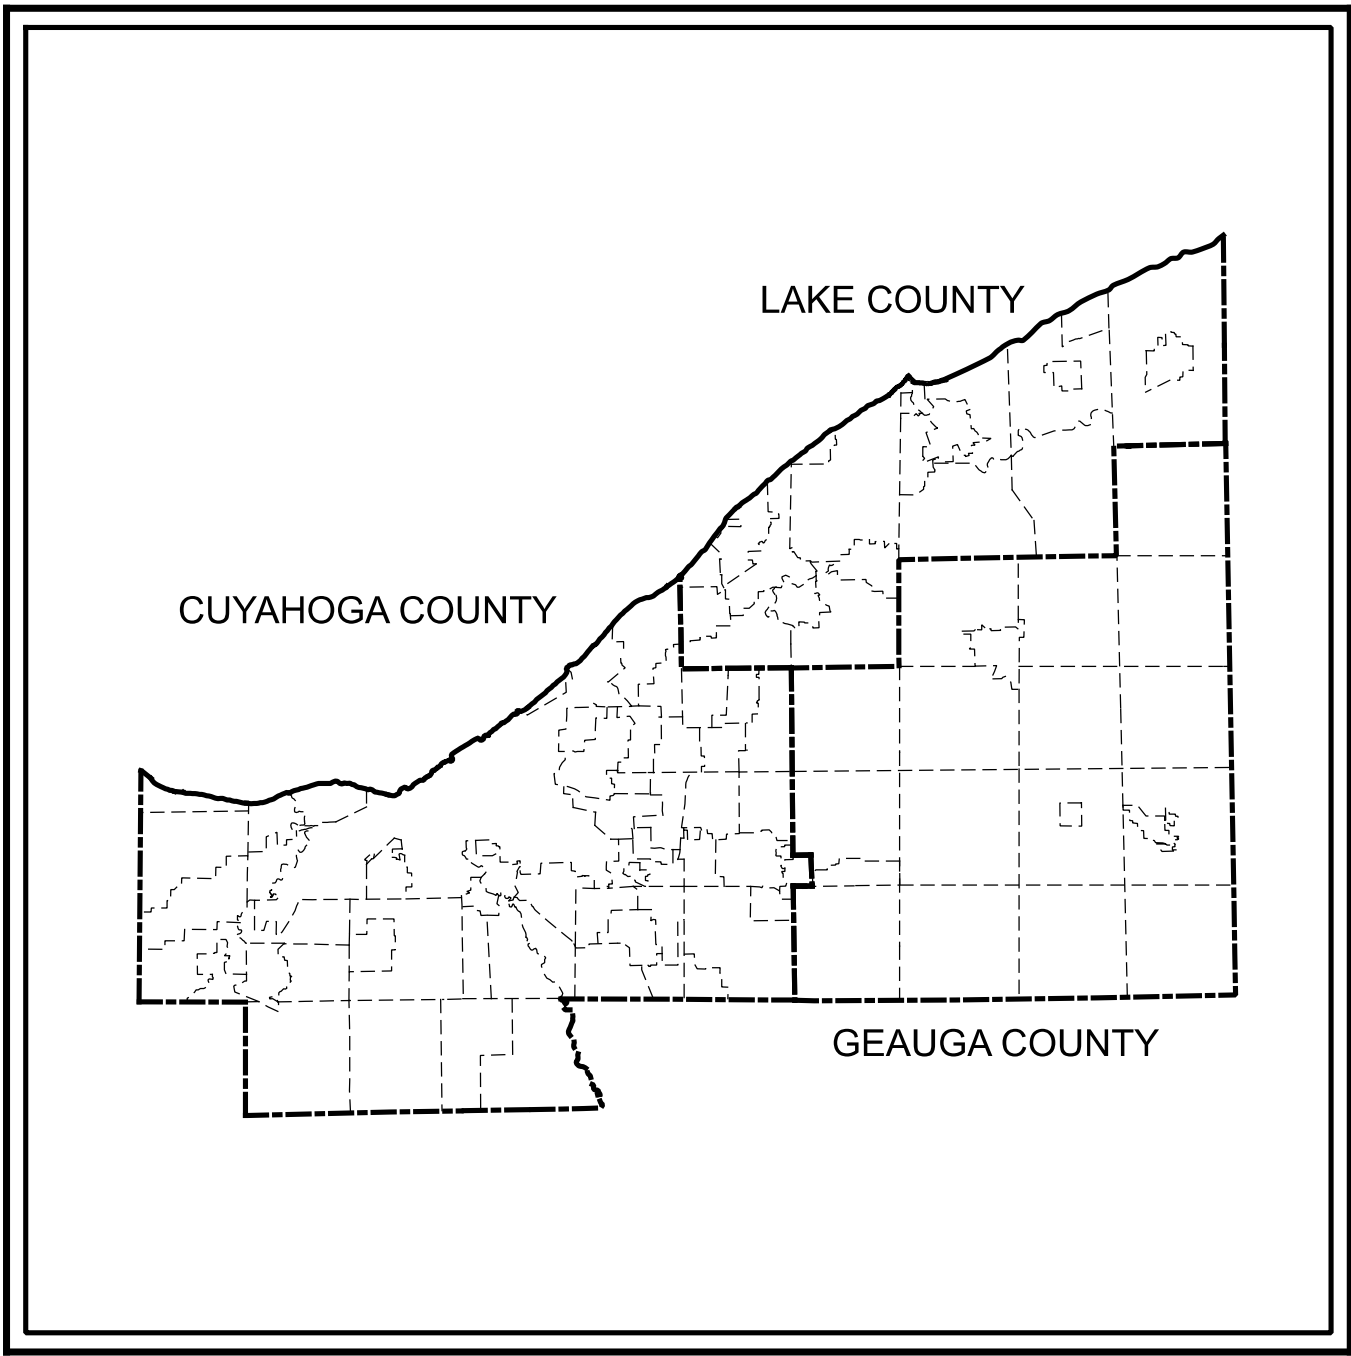

LOCATION MAP

LATITUDE: 41°24'54" LONGITUDE: 81°36'54"



PORTION TO BE IMPROVED	
INTERSTATE HIGHWAY	
FEDERAL ROUTES	
STATE ROUTES	
COUNTY & TOWNSHIP ROADS	
OTHER ROADS	

DESIGN EXCEPTIONS

NONE

ADA DESIGN WAIVERS

NONE

UNDERGROUND UTILITIES

Contact Two Working Days
Before You Dig

OHIO811.org
Before You Dig

OHIO811, 8-1-1, or 1-800-362-2764
(Non members must be called directly)

PLAN PREPARED BY:
OHIO DEPARTMENT OF
TRANSPORTATION
DISTRICT 12
PRODUCTION

ENGINEER'S SEAL

STATE OF OHIO
DEPARTMENT OF TRANSPORTATION

D12-MNT-FY2027
CUYAHOGA, GEAUGA, AND LAKE COUNTIES

INDEX OF SHEETS:

TITLE SHEET	1
LOCATION MAPS	2 - 4
GENERAL NOTES	5 - 6
MOT NOTES	7 - 8
WORK ORDER FORM	9
GENERAL SUMMARY	10
SUBSUMMARIES	11
PLAN SHEETS	12 - 27, 27A, 28-47

STANDARD CONSTRUCTION DRAWINGS							SUPPLEMENTAL SPECIFICATIONS	SPECIAL PROVISIONS
DM-4.3	1/15/16	TC-52.20	1/15/21				800	1/16/26
DM-4.4	1/15/16						821	4/20/12
							832	7/18/25
							921	7/19/24
LA-1.1	10/15/10							
MT-95.30	7/18/25							
MT-98.10	1/17/20							
MT-98.11	1/17/20							
MT-98.20	4/19/19							
MT-98.22	1/17/20							
MT-98.28	1/17/20							
MT-105.10	1/17/20							
TC-41.20	10/18/13							
TC-42.20	10/18/13							
TC-52.10	10/18/13							

FEDERAL PROJECT NUMBER

NON-FEDERAL

RAILROAD INVOLVEMENT

NONE

PROJECT DESCRIPTION

THIS PROJECT CONSISTS OF TREE REMOVAL ALONG VARIOUS INTERSTATE AND STATE ROUTES THROUGHOUT THE DISTRICT.

EARTH DISTURBED AREAS

PROJECT EARTH DISTURBED AREA:	N/A (MAINTENANCE PROJECT)
ESTIMATED CONTRACTOR EARTH DISTURBED AREA:	N/A (MAINTENANCE PROJECT)
NOTICE OF INTENT EARTH DISTURBED AREA:	N/A (MAINTENANCE PROJECT)

LIMITED ACCESS

THIS IMPROVEMENT IS ESPECIALLY DESIGNED FOR THROUGH TRAFFIC AND HAS BEEN DECLARED A LIMITED ACCESS HIGHWAY OR FREEWAY BY ACTION OF THE DIRECTOR IN ACCORDANCE WITH THE PROVISIONS OF SECTION 5511.02 OF THE OHIO REVISED CODE.

2023 SPECIFICATIONS

THE STANDARD SPECIFICATIONS OF THE STATE OF OHIO, DEPARTMENT OF TRANSPORTATION, INCLUDING SUPPLEMENTAL SPECIFICATIONS LISTED IN THE PLANS AND CHANGES LISTED IN THE PROPOSAL SHALL GOVERN THIS IMPROVEMENT.

I HEREBY APPROVE THESE PLANS AND DECLARE THAT THE MAKING OF THIS IMPROVEMENT WILL NOT REQUIRE THE CLOSING TO TRAFFIC OF THE HIGHWAY AND THAT PROVISIONS FOR THE MAINTENANCE AND SAFETY OF TRAFFIC WILL BE AS SET FORTH ON THE PLANS AND ESTIMATES.

John Picuri, P.E., P.S.
District 12 Deputy Director

Pamela Boratyn
Director, Department of Transportation

DESIGN AGENCY

DESIGNER

KHD

REVIEWER

DAB 03/05/26

PROJECT ID

123646

SHEET

P.1

TOTAL

47

CUYAHOGA COUNTY LOCATION MAP

- 1

IR-71 SB
SECTION BETWEEN IR-80 AND SR-82
- 2

IR-71 NB/SB
SLM 13.16 TO 14.05
BETWEEN W 130TH TO RR BRIDGES
- 3

IR-71 SB
SLM 16.56
DENISON AVE OVERPASS
- 4

REMOVED LOCATION
- 5

IR-71 SB
SLM 17.51
PEARL RD OVERPASS
- 6

IR-71 NB/SB
SLM 17.63 TO 18.00
BETWEEN NB AND SB LANES
CLEARING AND GRUBBING
- 7

IR-90 EB
SLM 17.51 TO 17.71
RIGHT SIDE OF SUPERIOR AVE EXIT RAMP
- 8

IR-90 EB
SLM 20.61 TO 21.03
E 72ND ON-RAMP TO MLK BLVD OFF-RAMP
- 9

IR-90 WB
SLM 20.61 TO 21.03
TREES OVERHANGING NOISE BARRIER WALL
FROM LAKESHORE BLVD TO MLK BLVD
- 10

IR-90 EB/WB
SLM 23.48 TO 23.85
AT LAKESHORE BLVD ON AND OFF RAMPS
- 11

IR-90 EB
SLM 23.48 TO 23.85
E 140TH ST OFF-RAMP
- 12

IR-90 EB
SLM 18.18 TO 18.42
MARGINAL RD TO SR-2 WB EXIT RAMP
- 13



IR-271 SB
SLM 12.78 TO 12.96
RAMP FROM US-322 TO IR-271 SB
- 27

IR-71 NB/SB
SLM 0.00 TO 2.59
COUNTY LINE TO SR-82
- 28

IR-77 NB
SLM 14.99 TO 15.19
E. 30TH EXIT RAMP
- 29



IR-77 SB
SLM 15.19 TO 14.99
E. 30TH ENTANCE RAMP TO MM 162.0
- 30

IR-77 SB
SLM 16.07 TO 15.84
E. 14TH ENTANCE RAMP

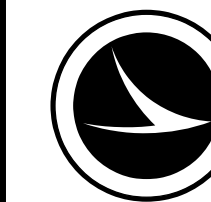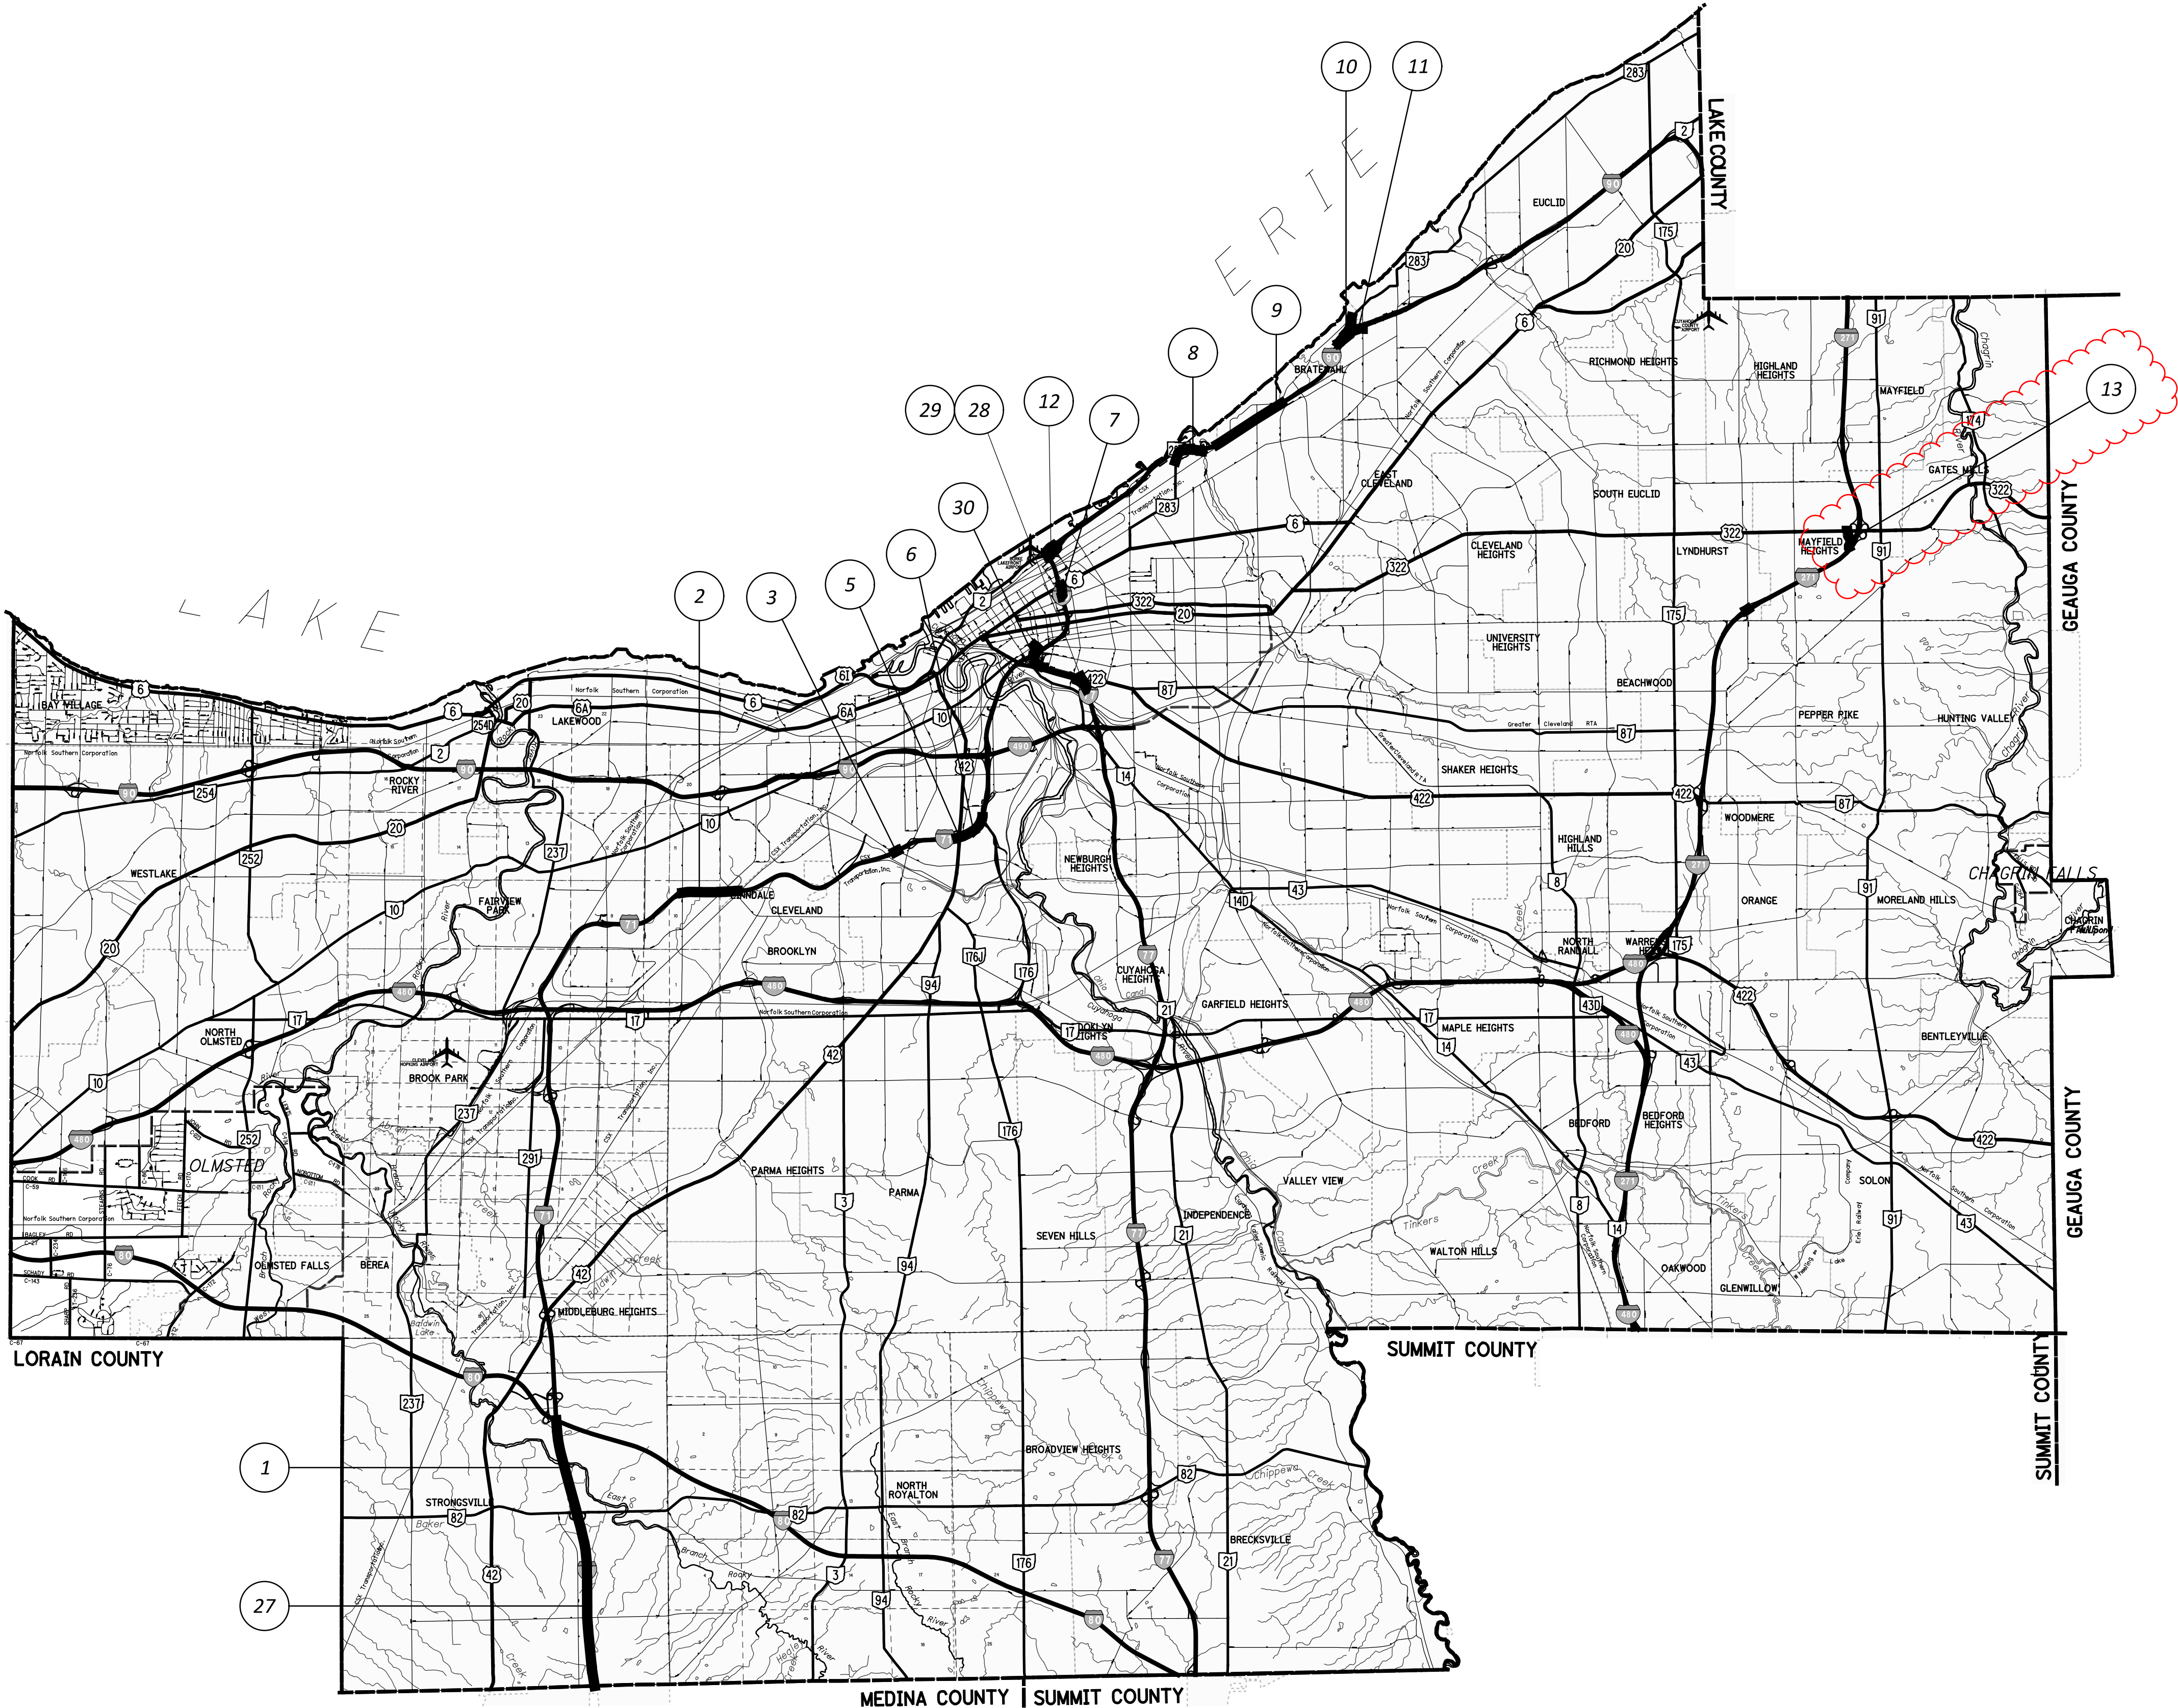

GENERAL SUMMARY	
DESIGN AGENCY	
	
DESIGNER	
KHD	
REVIEWER	
KHD 03/16/26	
PROJECT ID	
123646	
SHEET	TOTAL
P.10	47

[illegible]

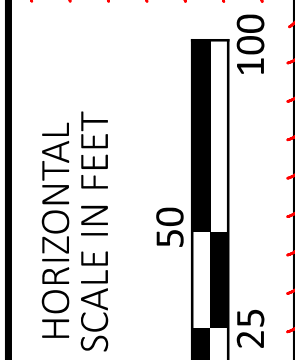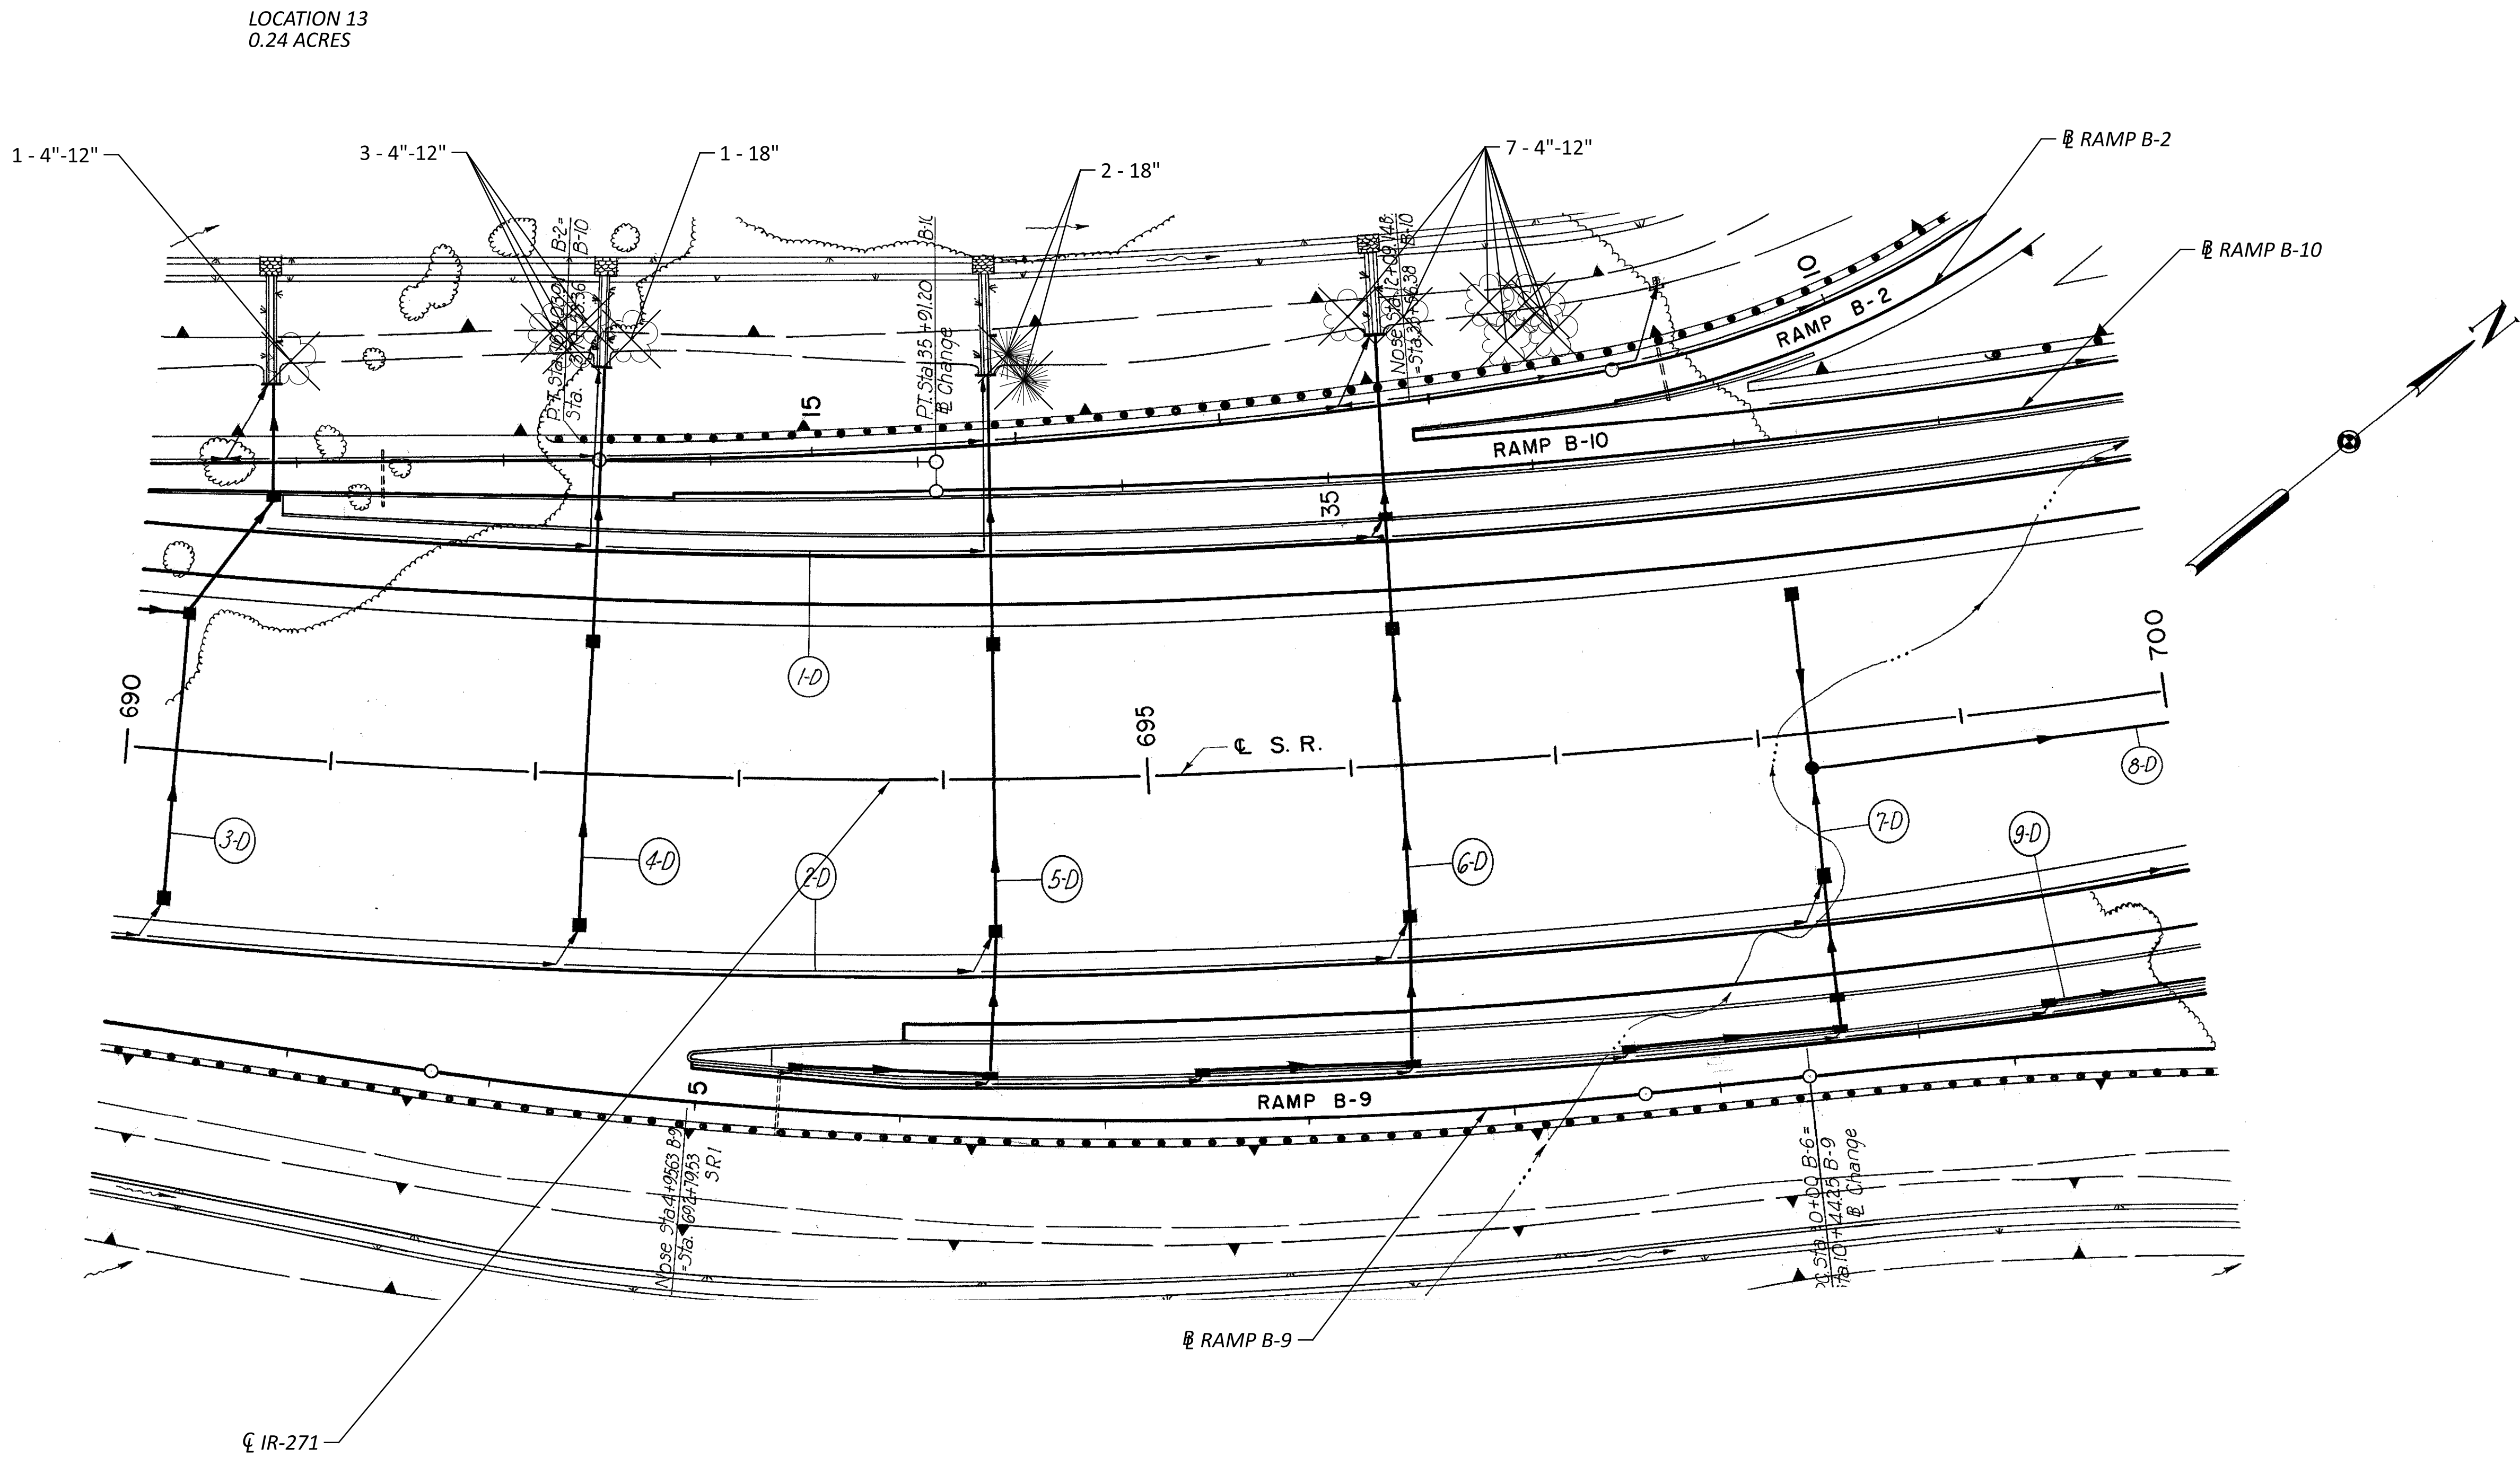

GENERAL PLANS
LOCATION 13

DESIGN AGENCY	
DESIGNER	KJD
REVIEWER	KHD
PROJECT ID	123646
SHEET	P.27A
TOTAL	47