

SCIOTO LAND SURVEYING SERVICE, INC.

173 NORTH SANDUSKY STREET • DELAWARE, OHIO 43015 • 369-7577

PLAT OF SURVEY FOR

VISTA LAND COMPANY LLC

PART OF FARM LOT A, QUARTER-TOWNSHIP 1,
TOWNSHIP 6, RANGE 19, U.S.M.L.
MARLBORO TOWNSHIP, DELAWARE COUNTY, OHIO

LEGEND

- ⊙ P.K. Nail Found
- Iron Pipe Found
- ⊠ Mag Nail Found
- Mag Nail Set
- Iron Bar Set with a plastic cap marked "SLSS RS 6612"


RECORDS USED

Deeds as shown.

BASIS OF BEARINGS

Assumed.

ORIGINAL 34.866 Ac.
O.R.V. 206, PAGE 1344

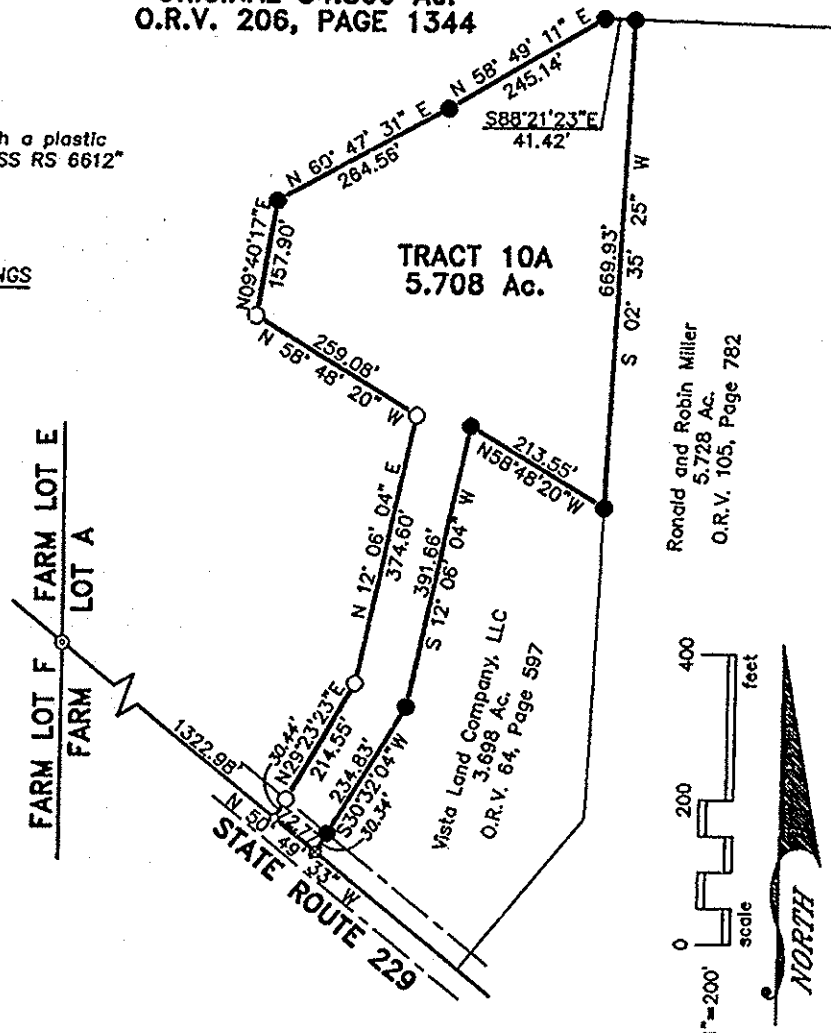

I HEREBY CERTIFY THAT I HAVE SURVEYED THE PROPERTY DESCRIBED IN THE FOREGOING TITLE CAPTION AND THAT SAID SURVEY AND SKETCH ARE ACCURATE AND CORRECT TO THE BEST OF MY KNOWLEDGE AND BELIEF. EASEMENTS, RESTRICTIONS AND RIGHTS-OF-WAY, IF ANY, NOT LOCATED UNLESS NOTED.

KAREN S. COFFMAN, SURVEYOR
Registration No. 7845

APRIL 23, 2002
Date

