


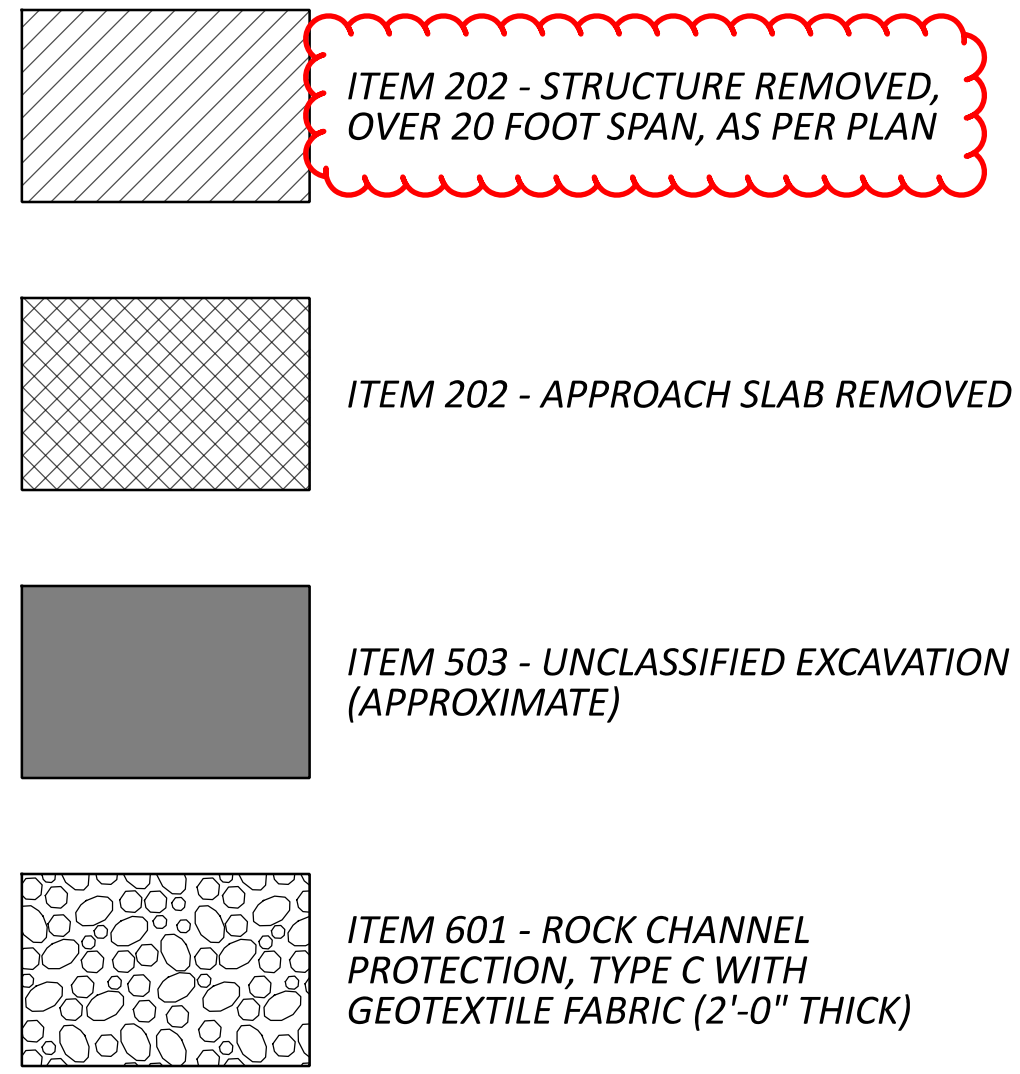
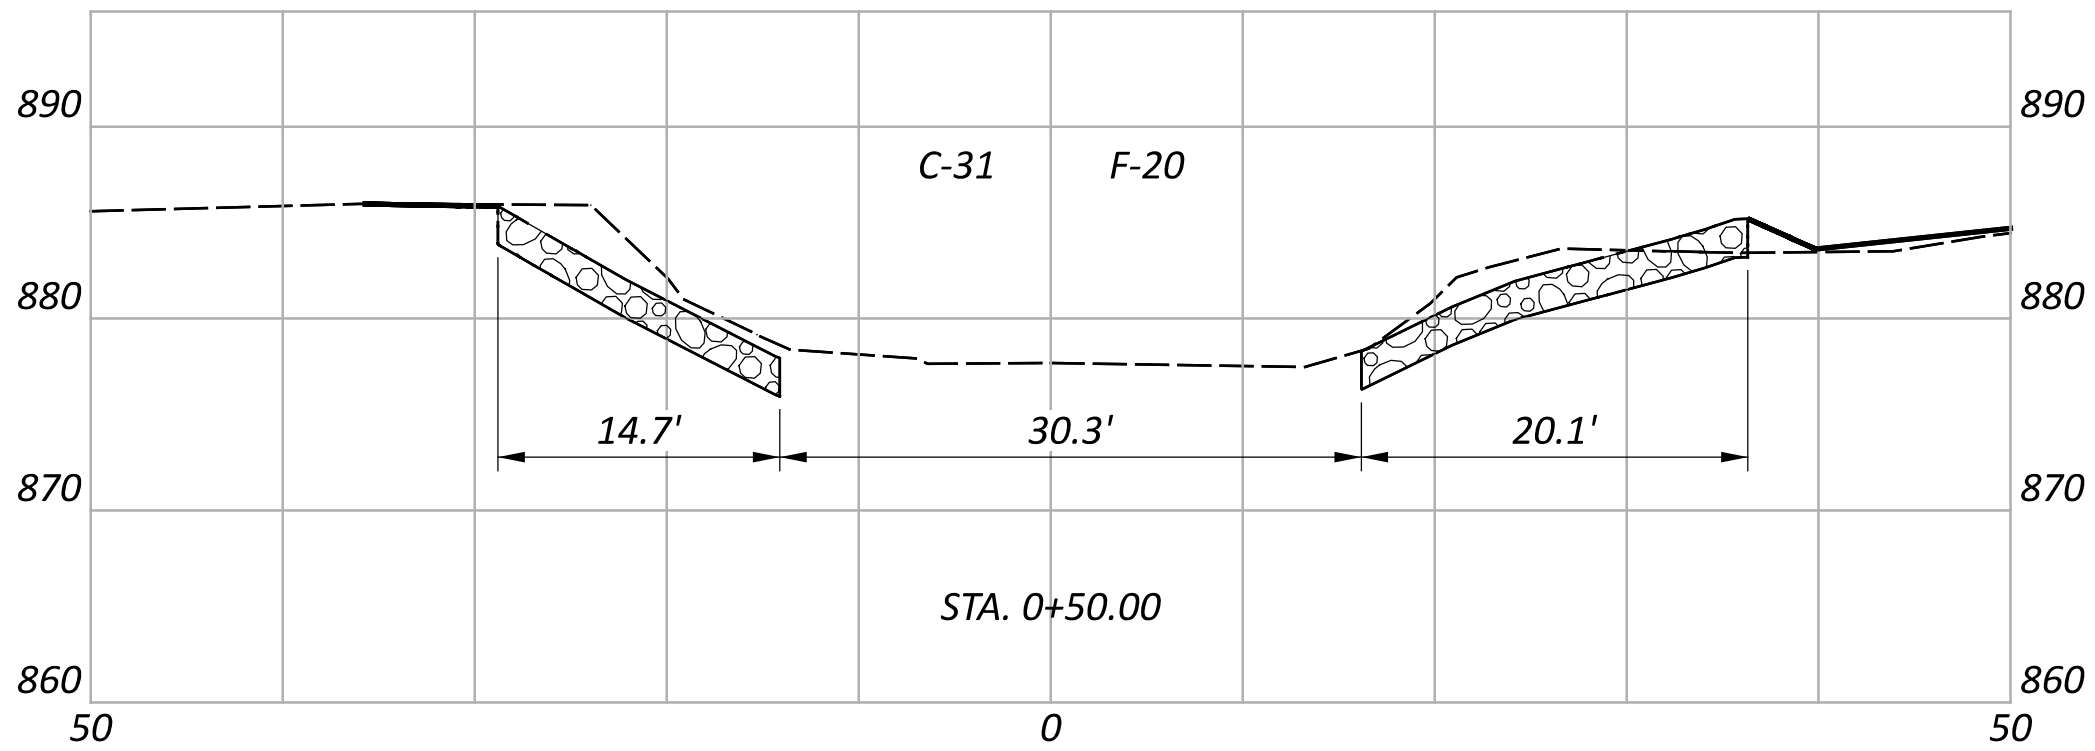
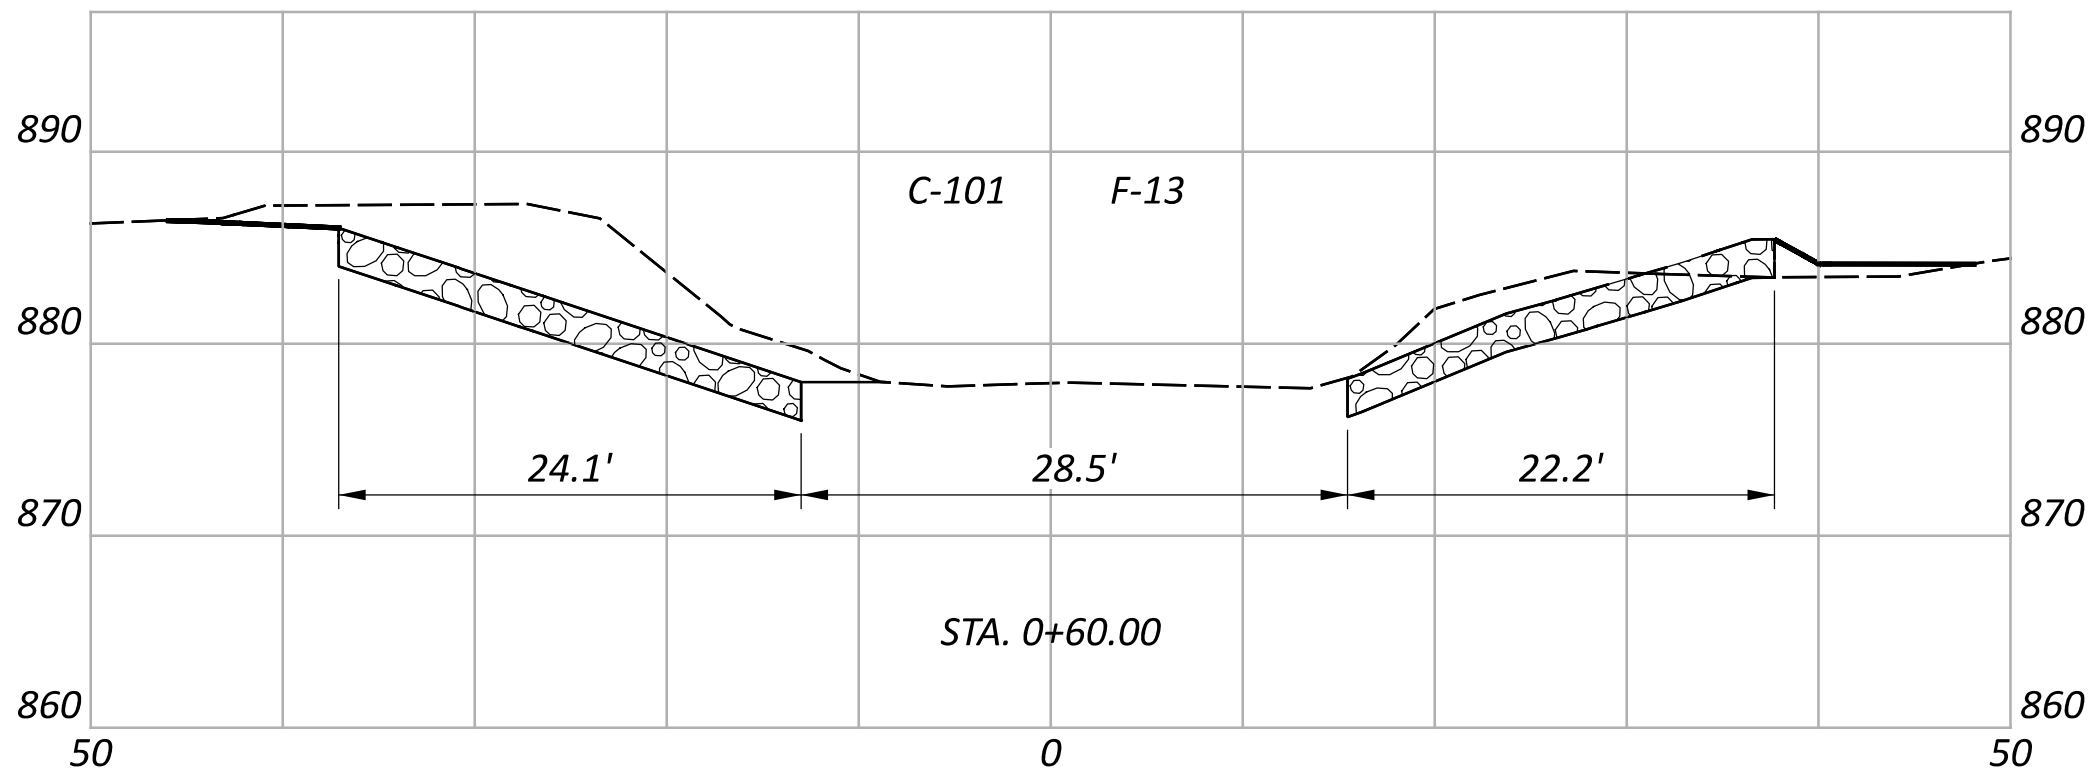
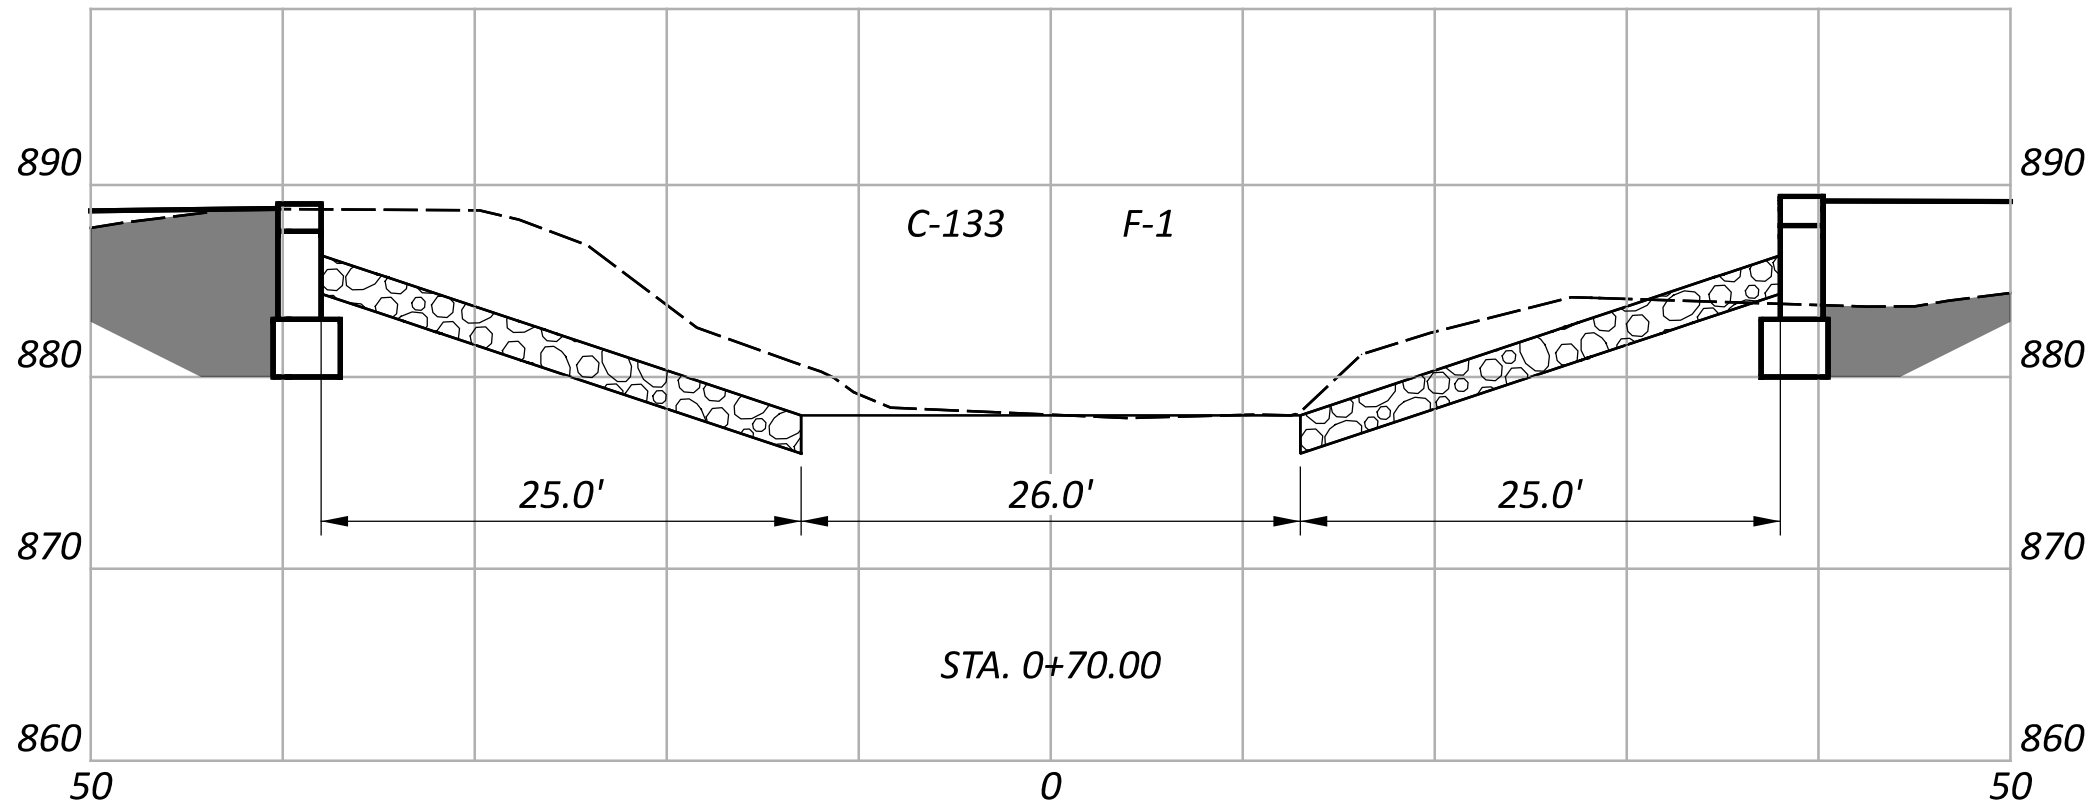
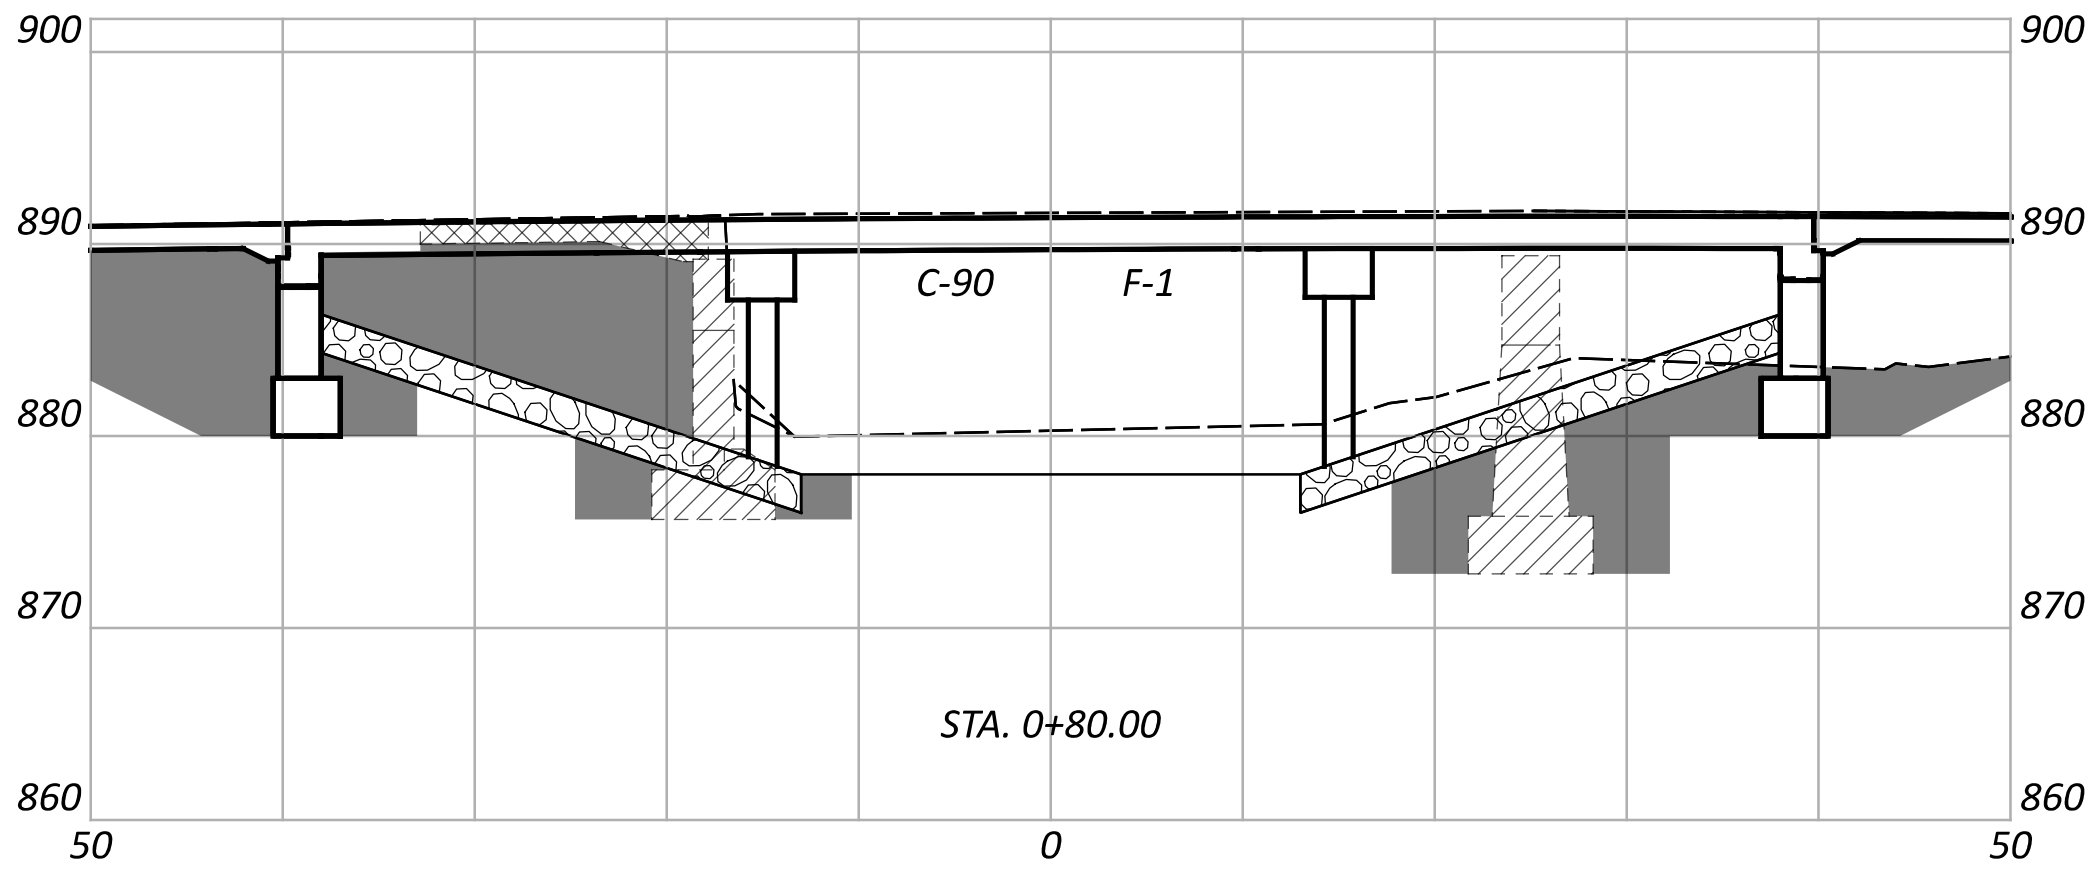
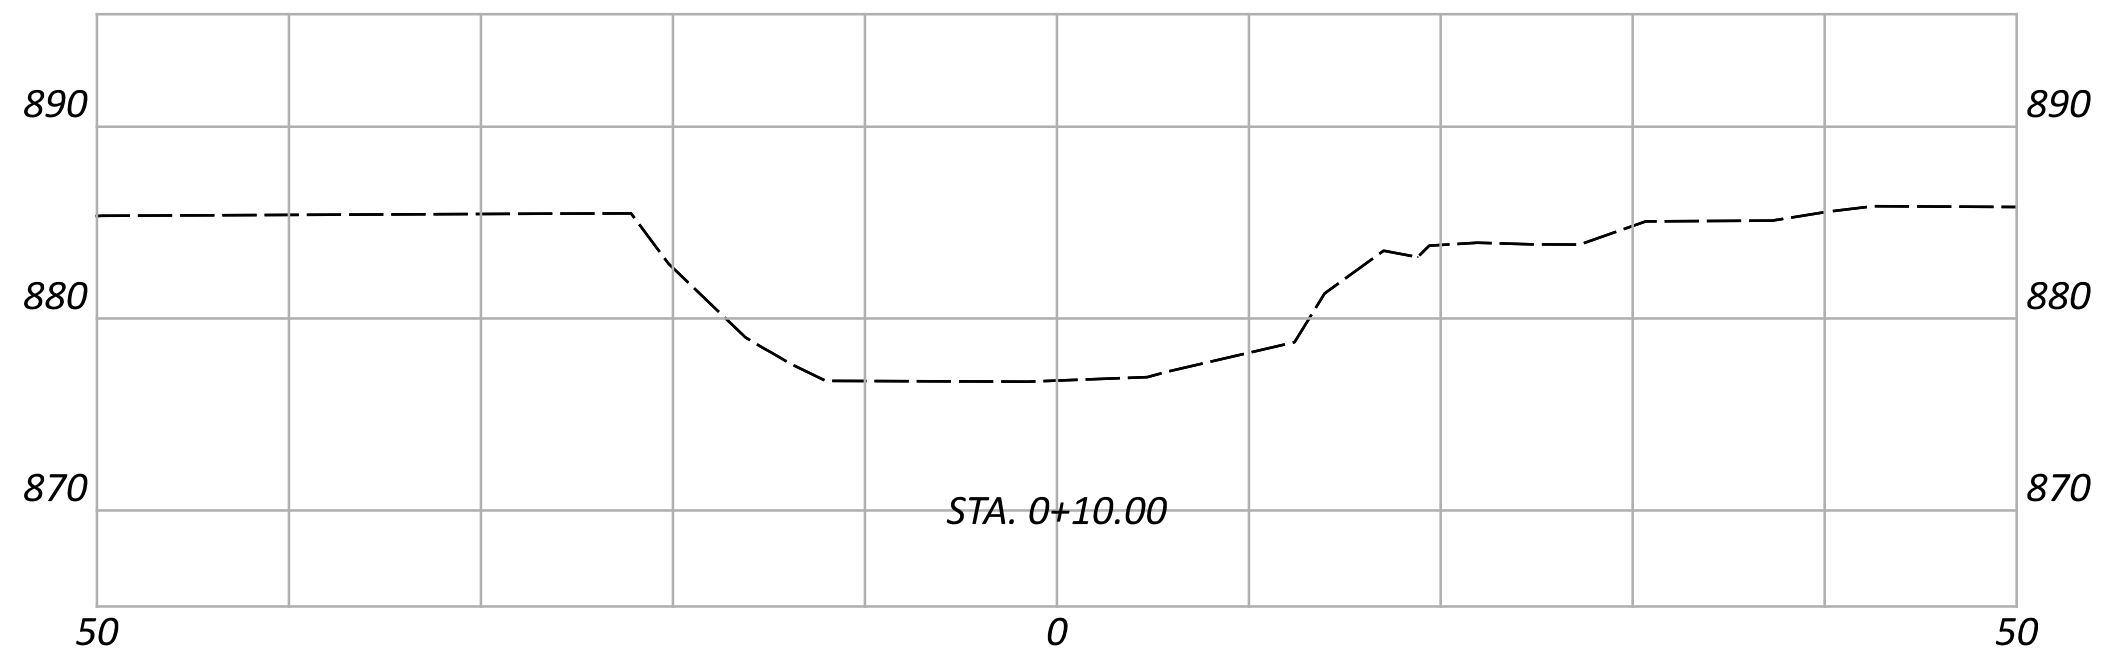
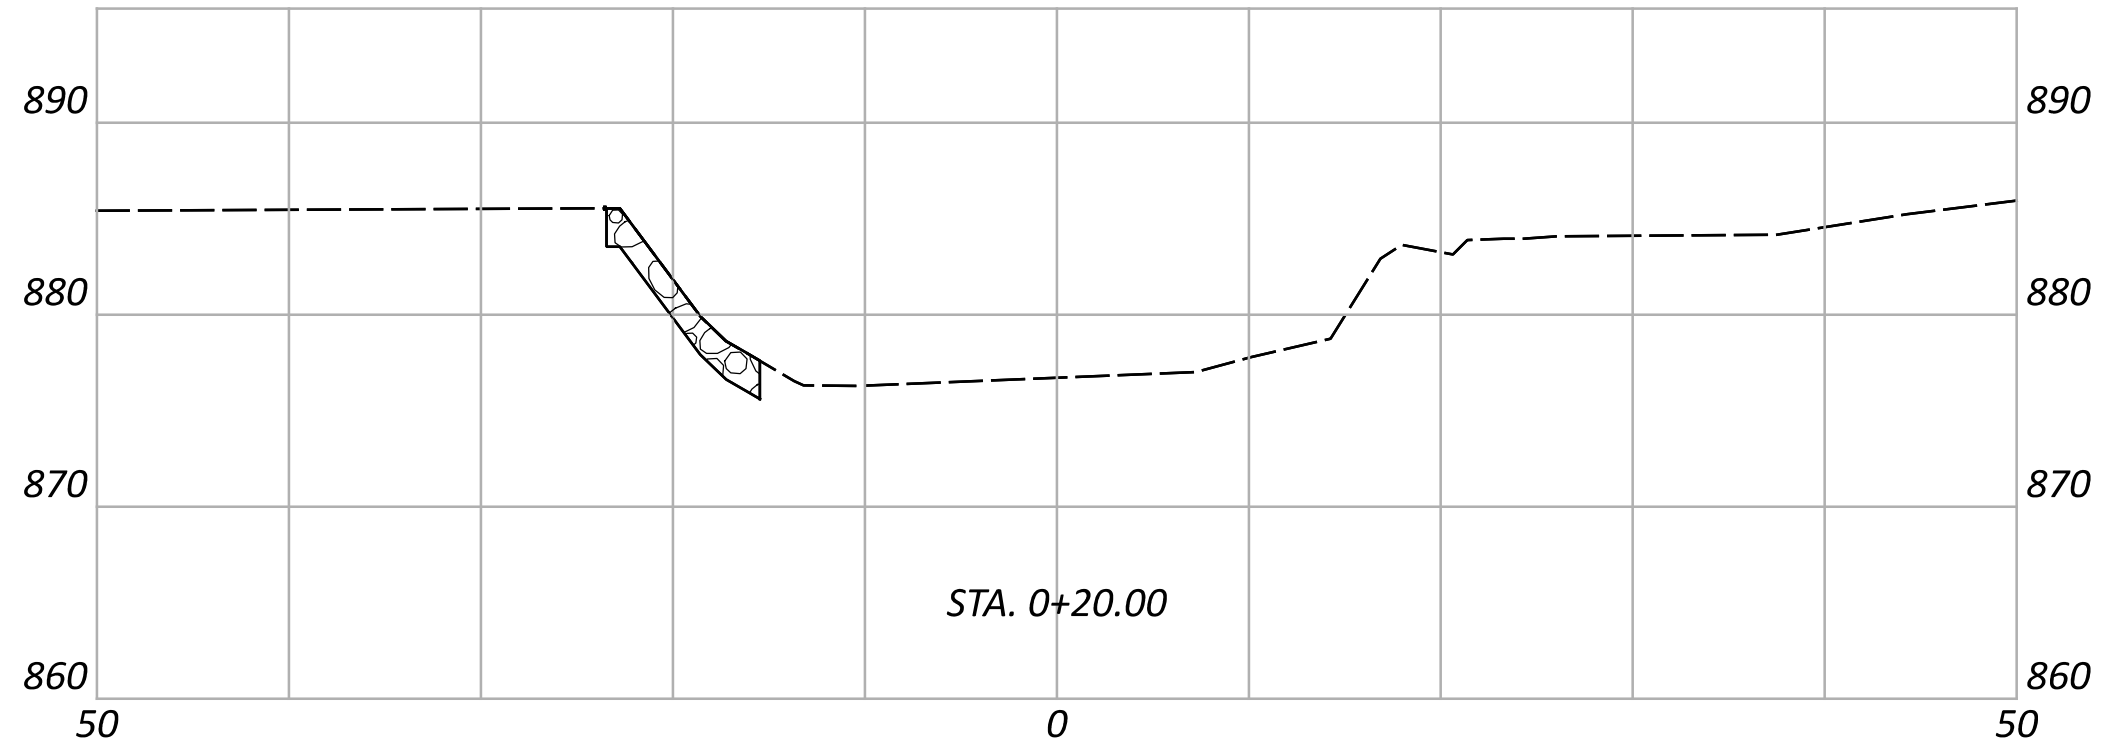
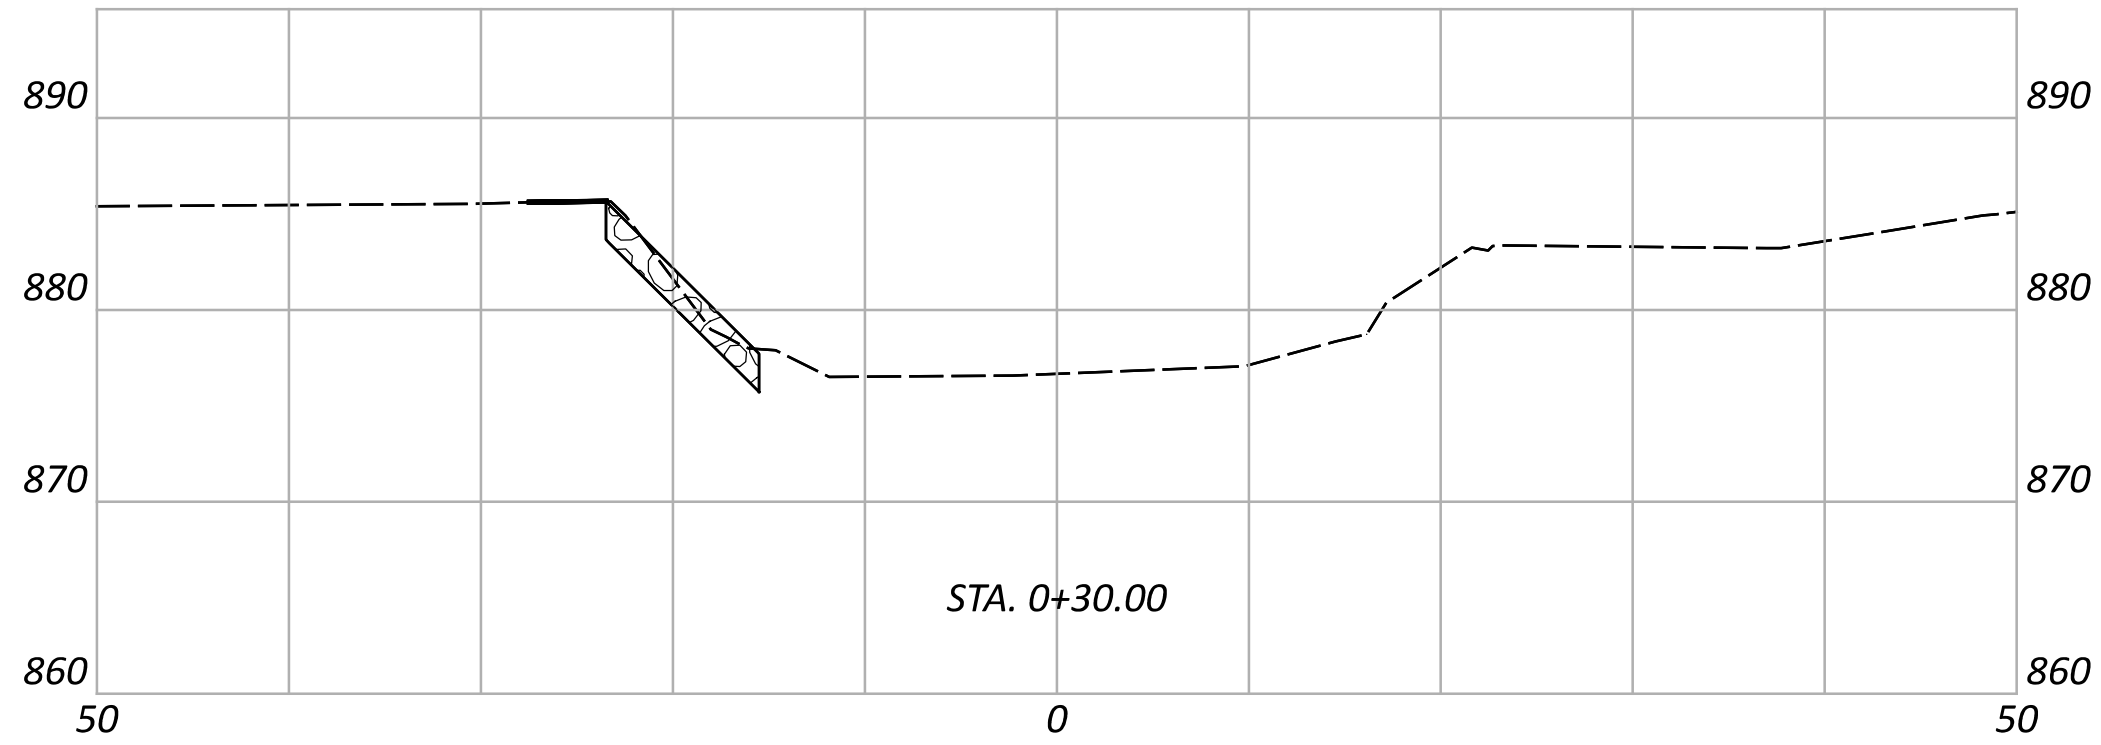
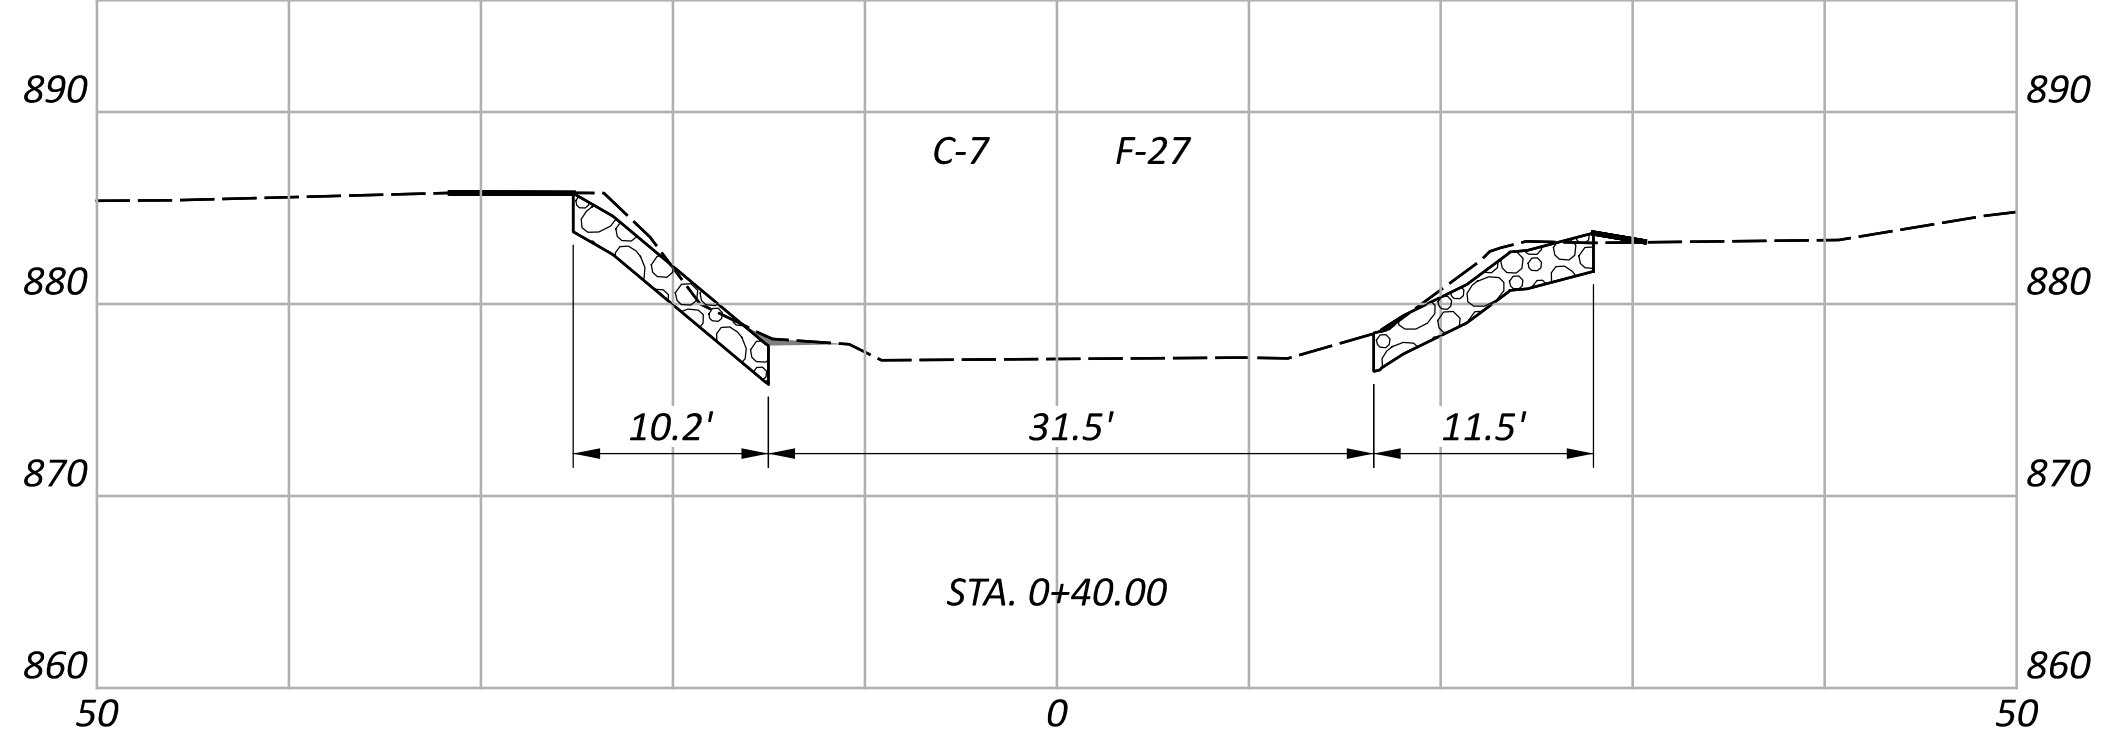
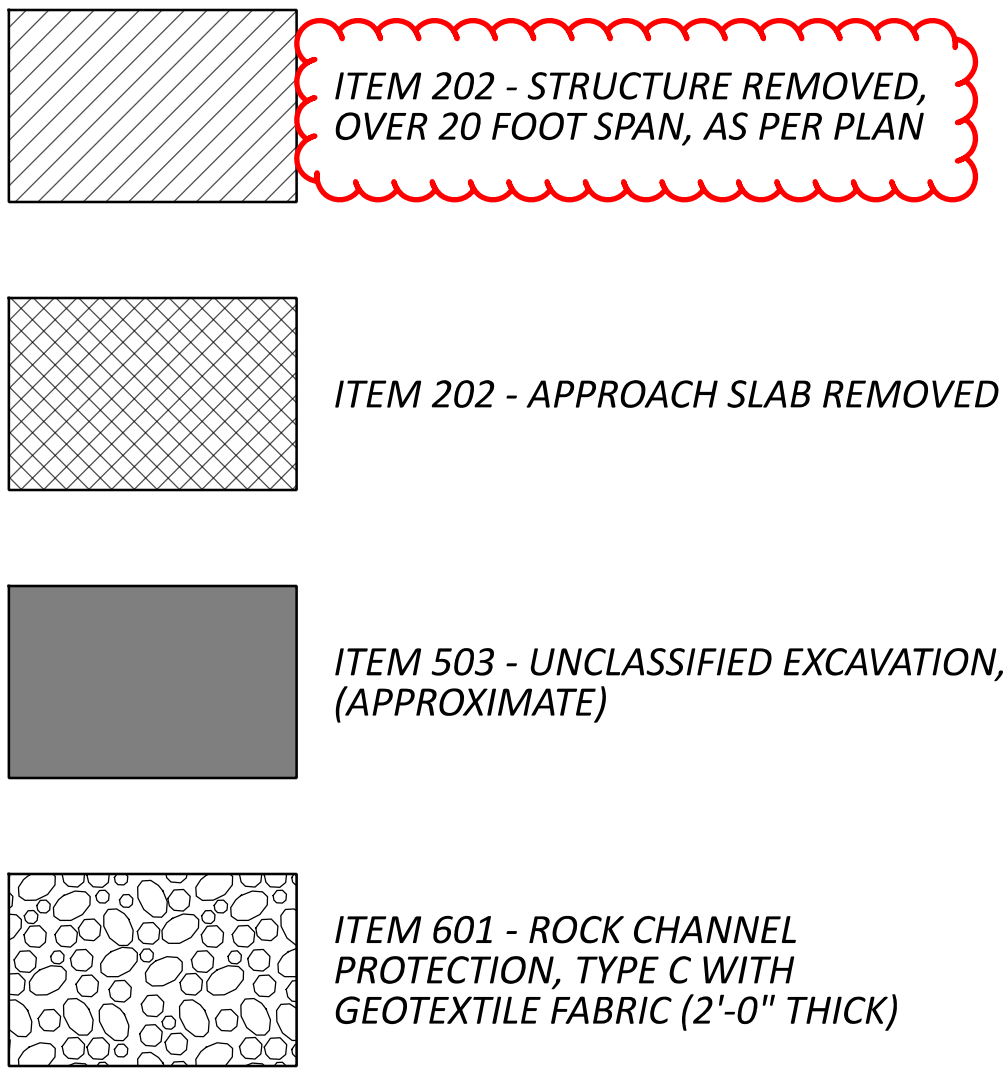
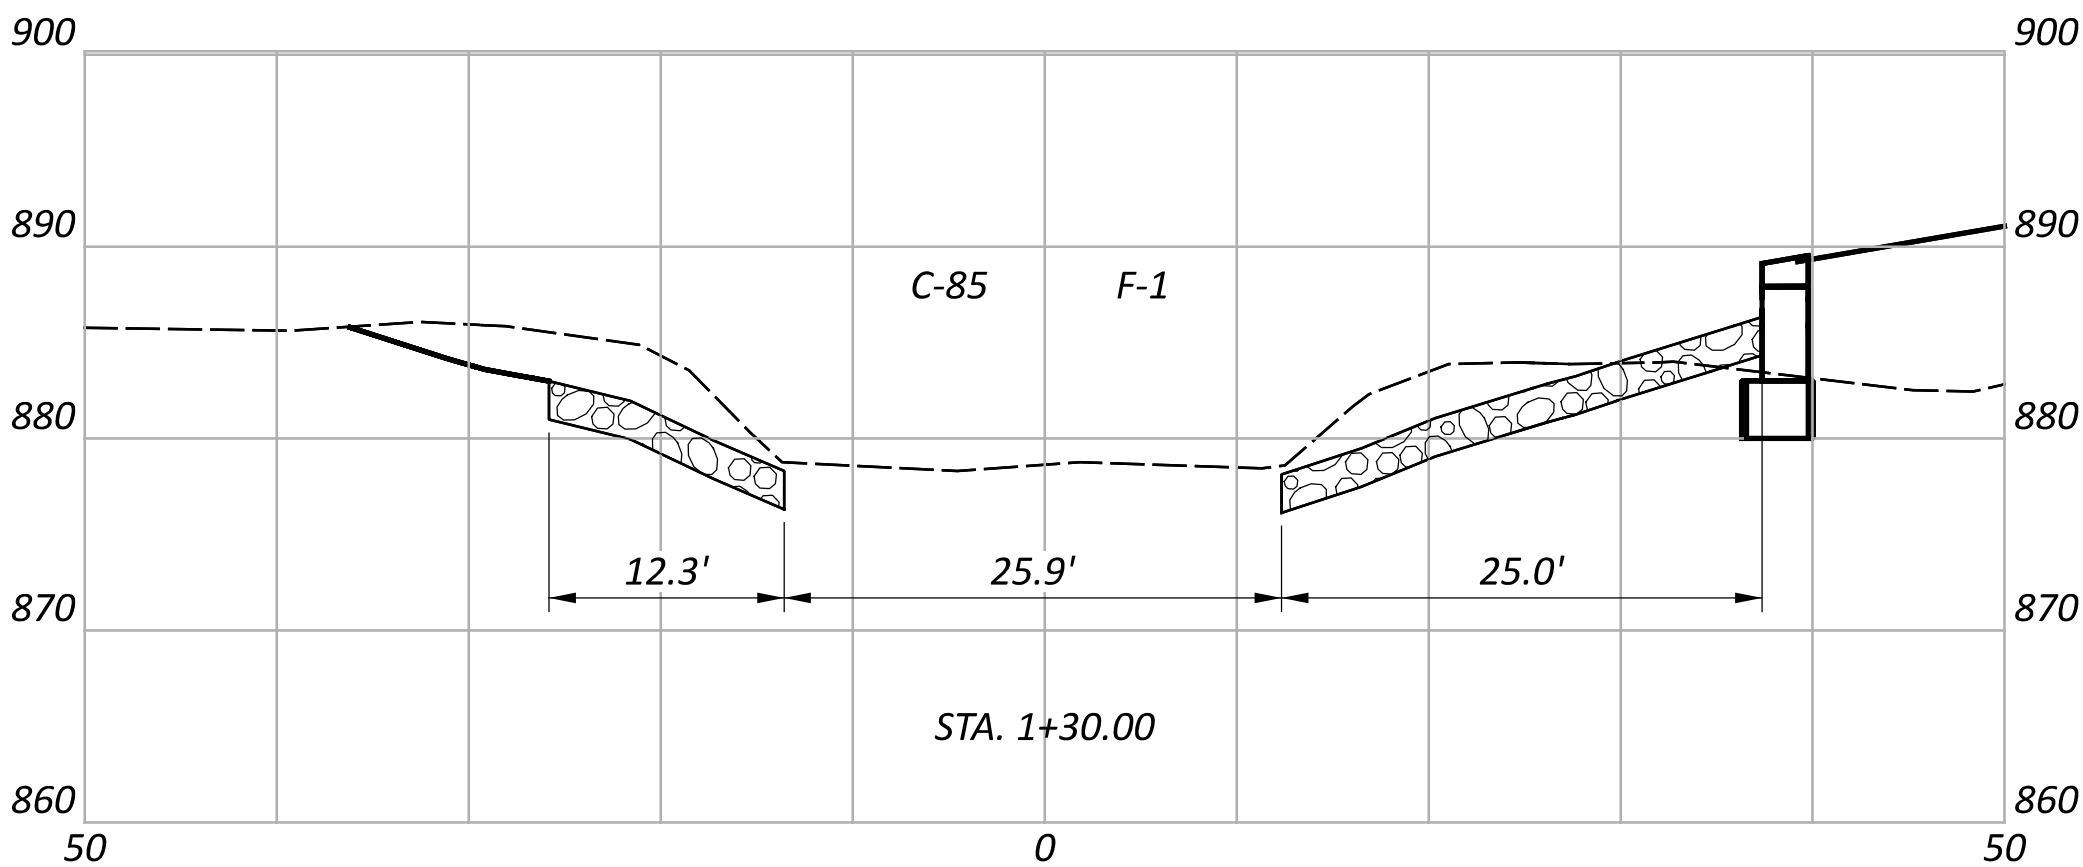
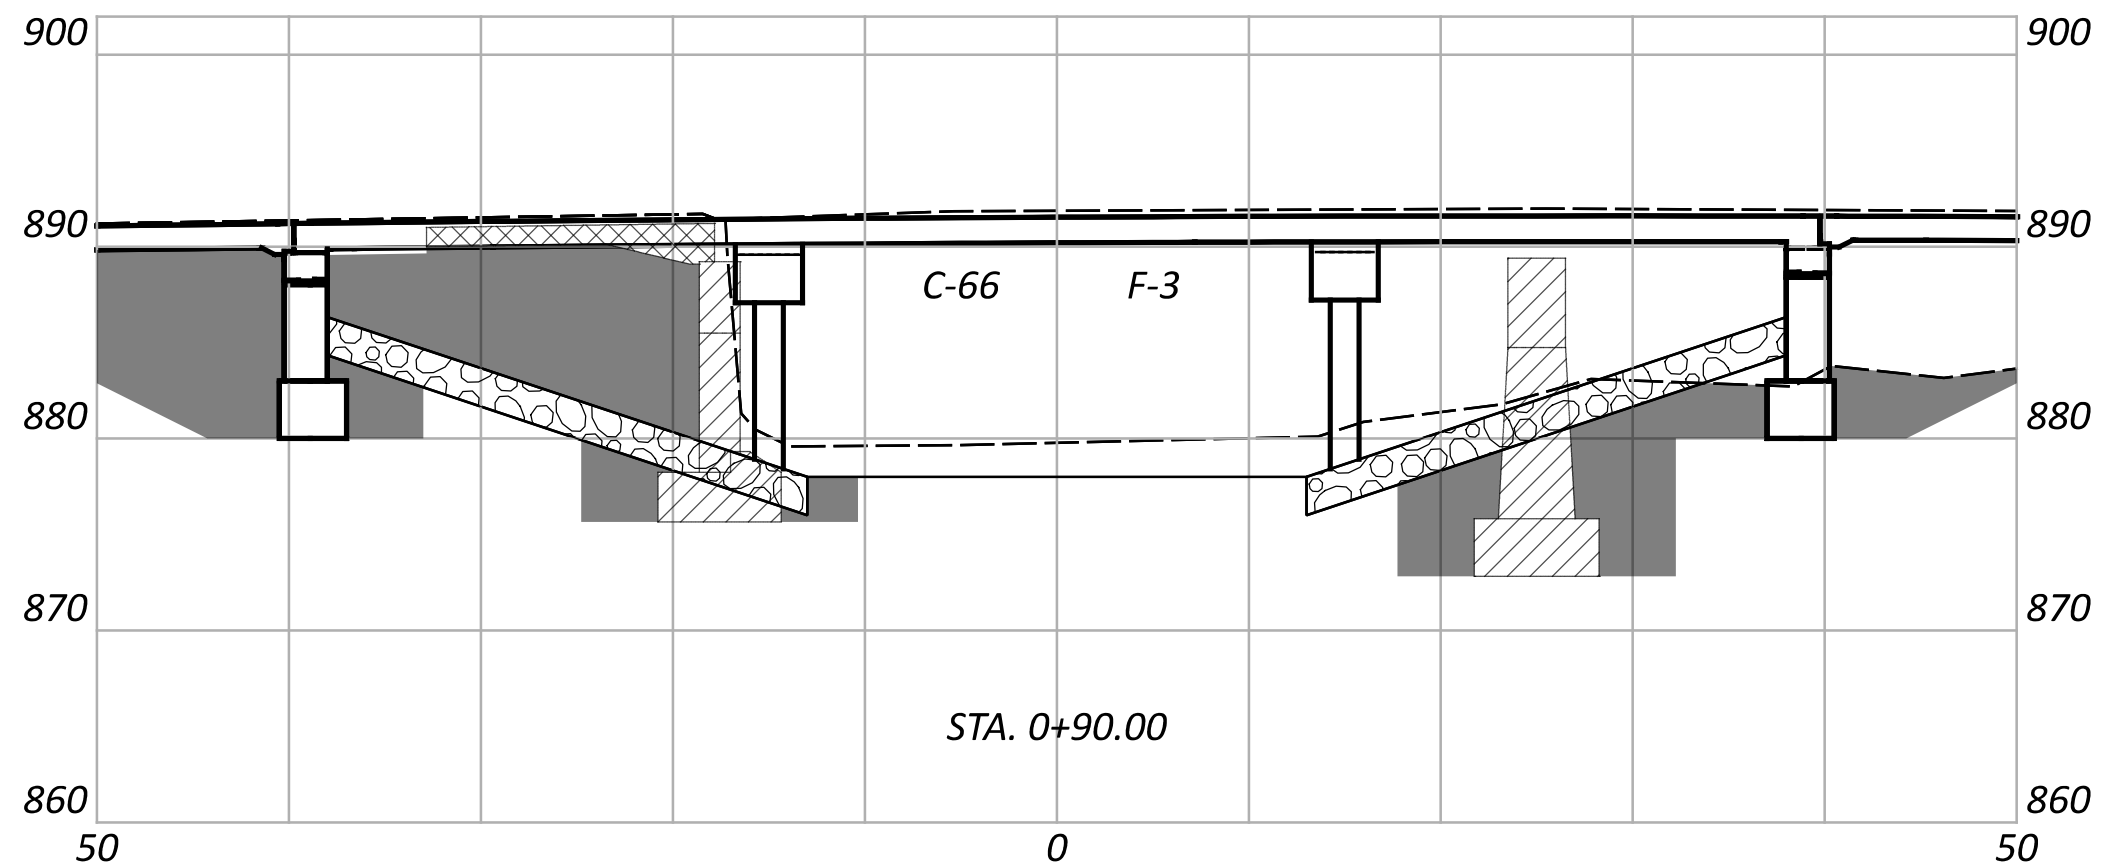
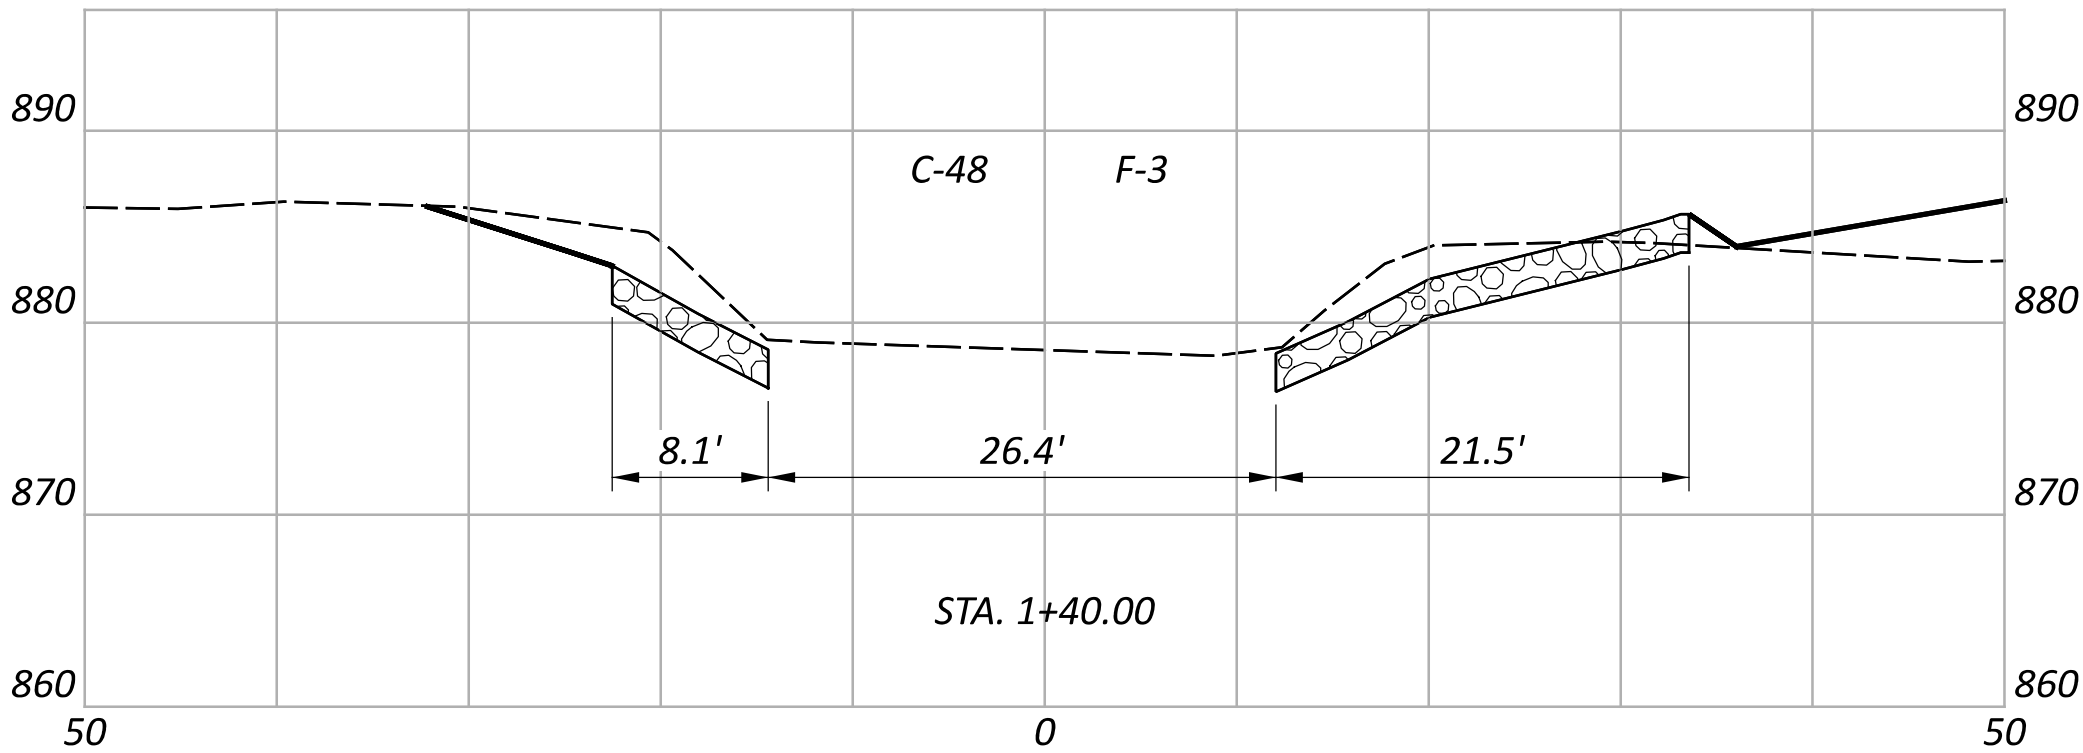
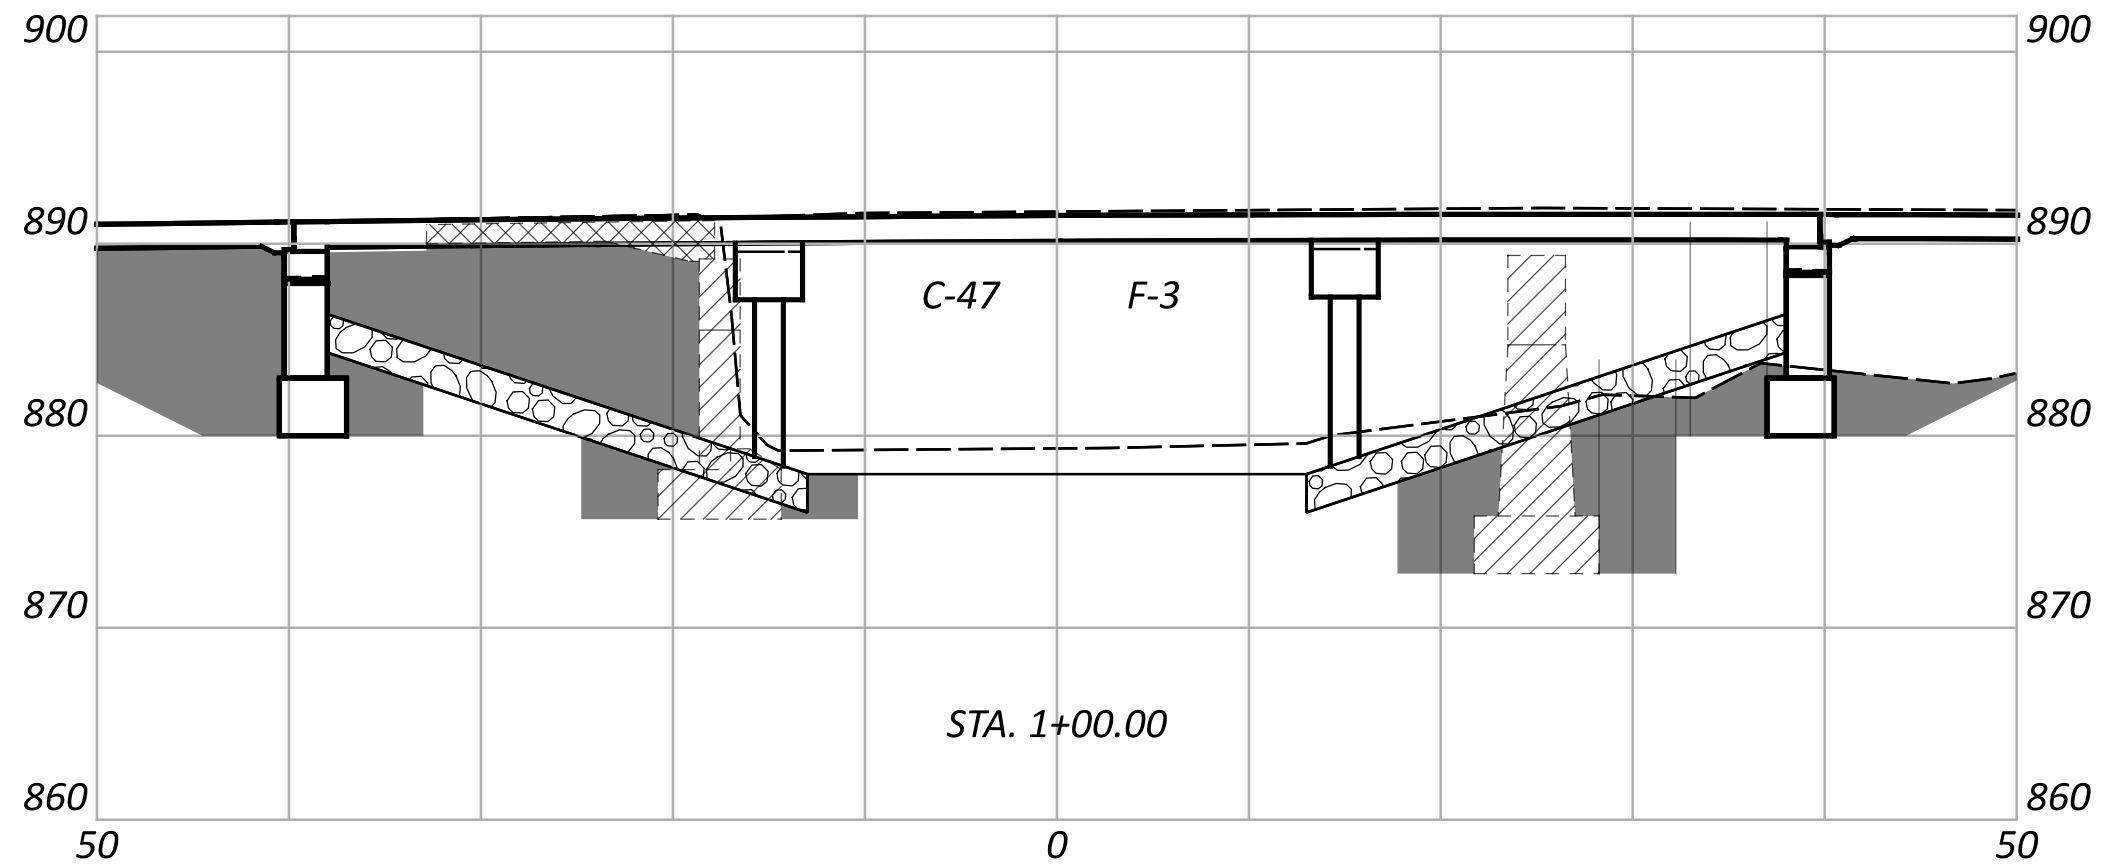
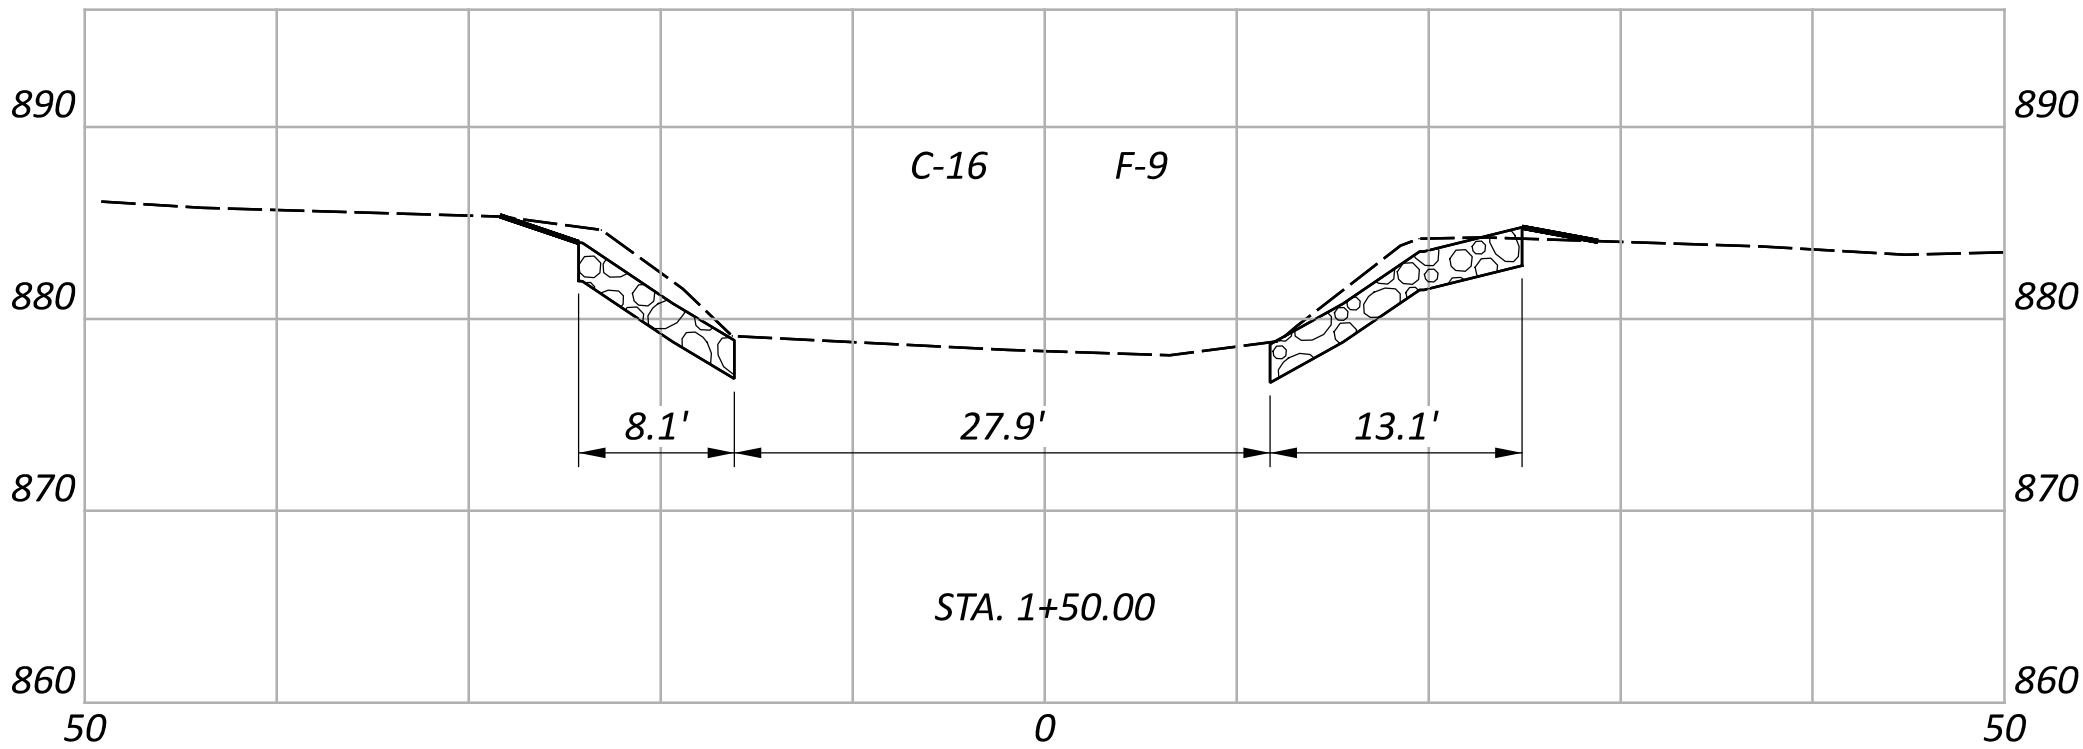
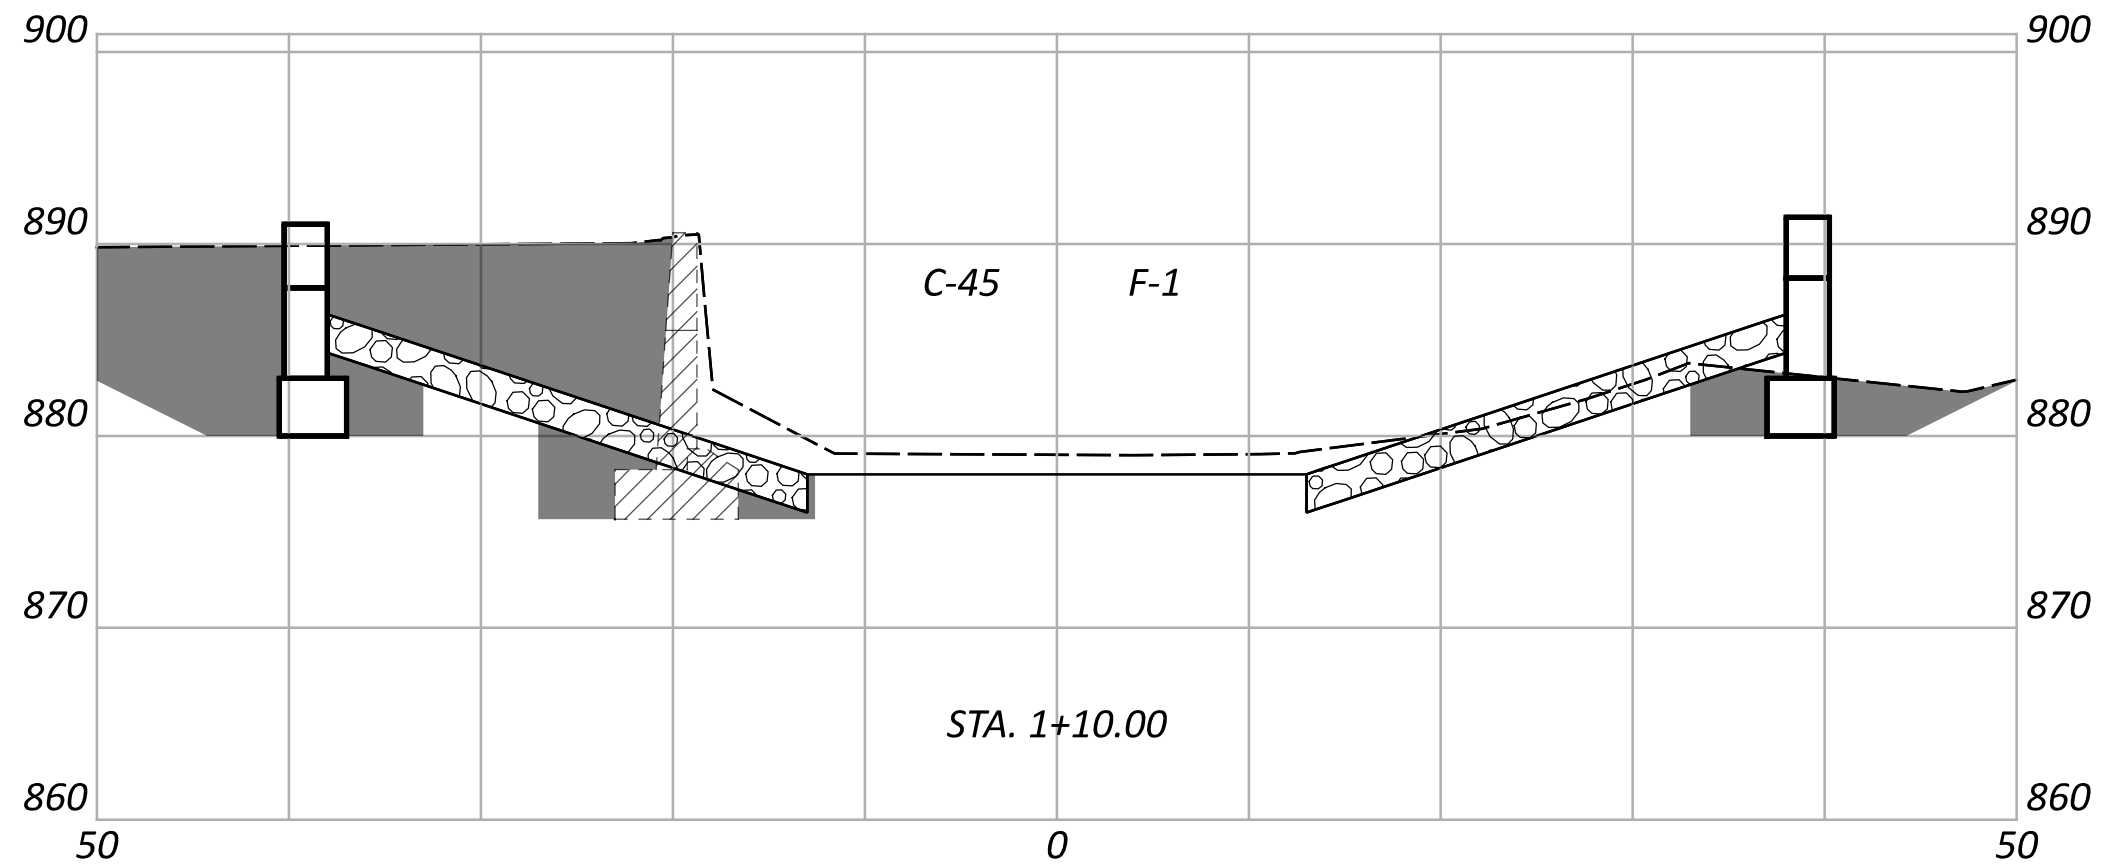


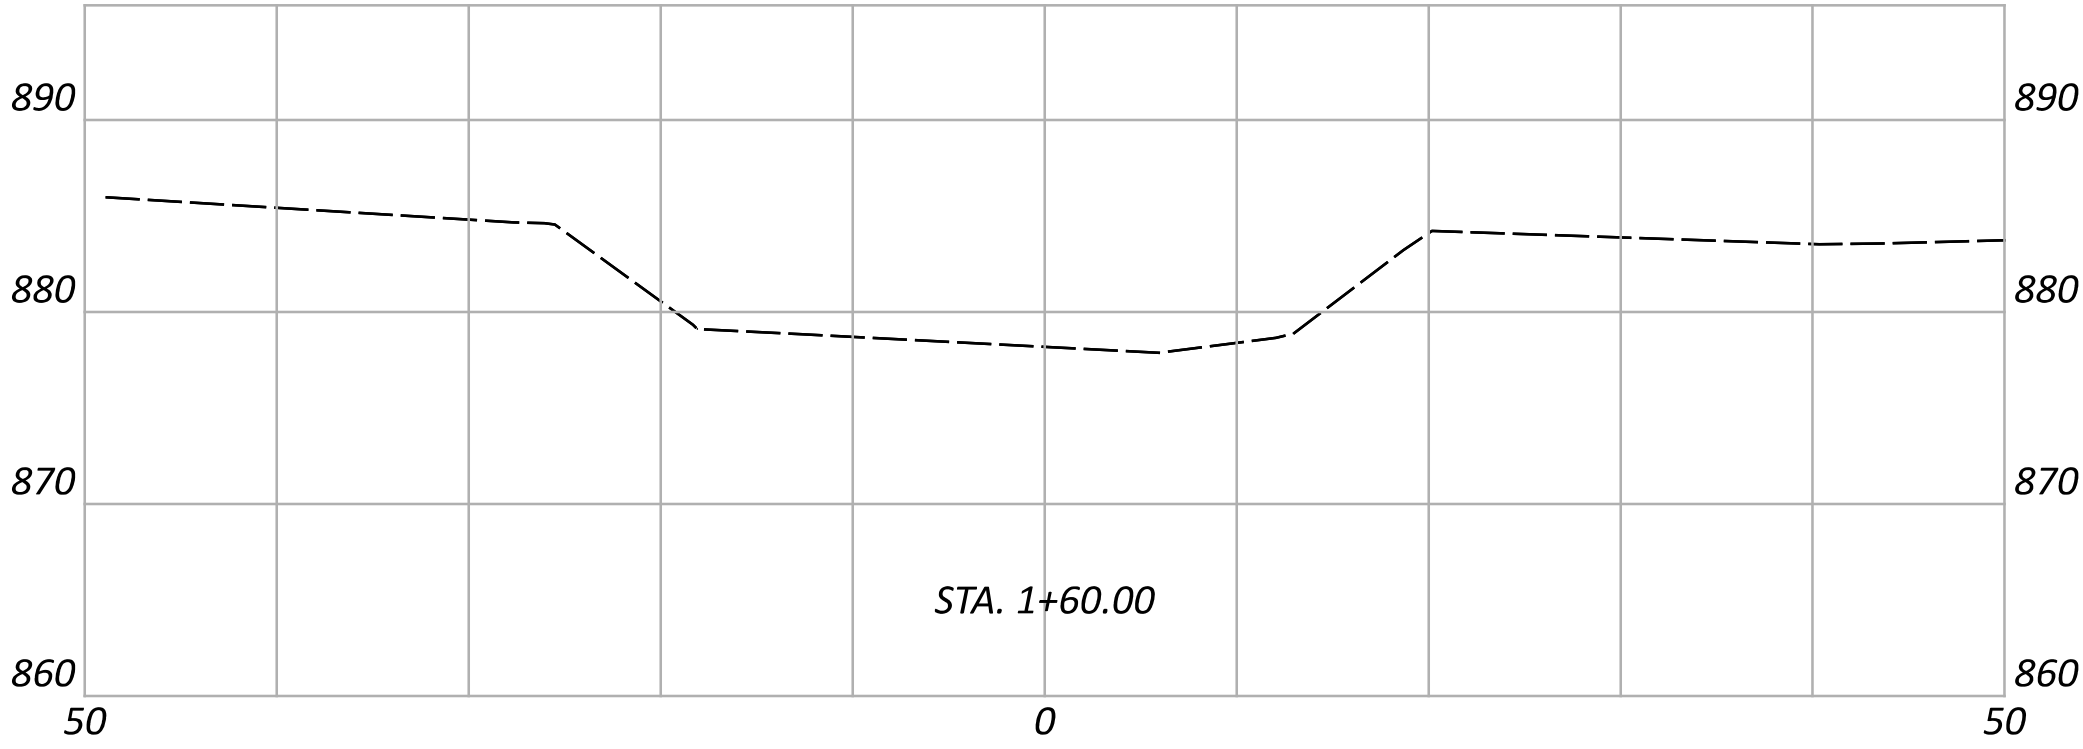


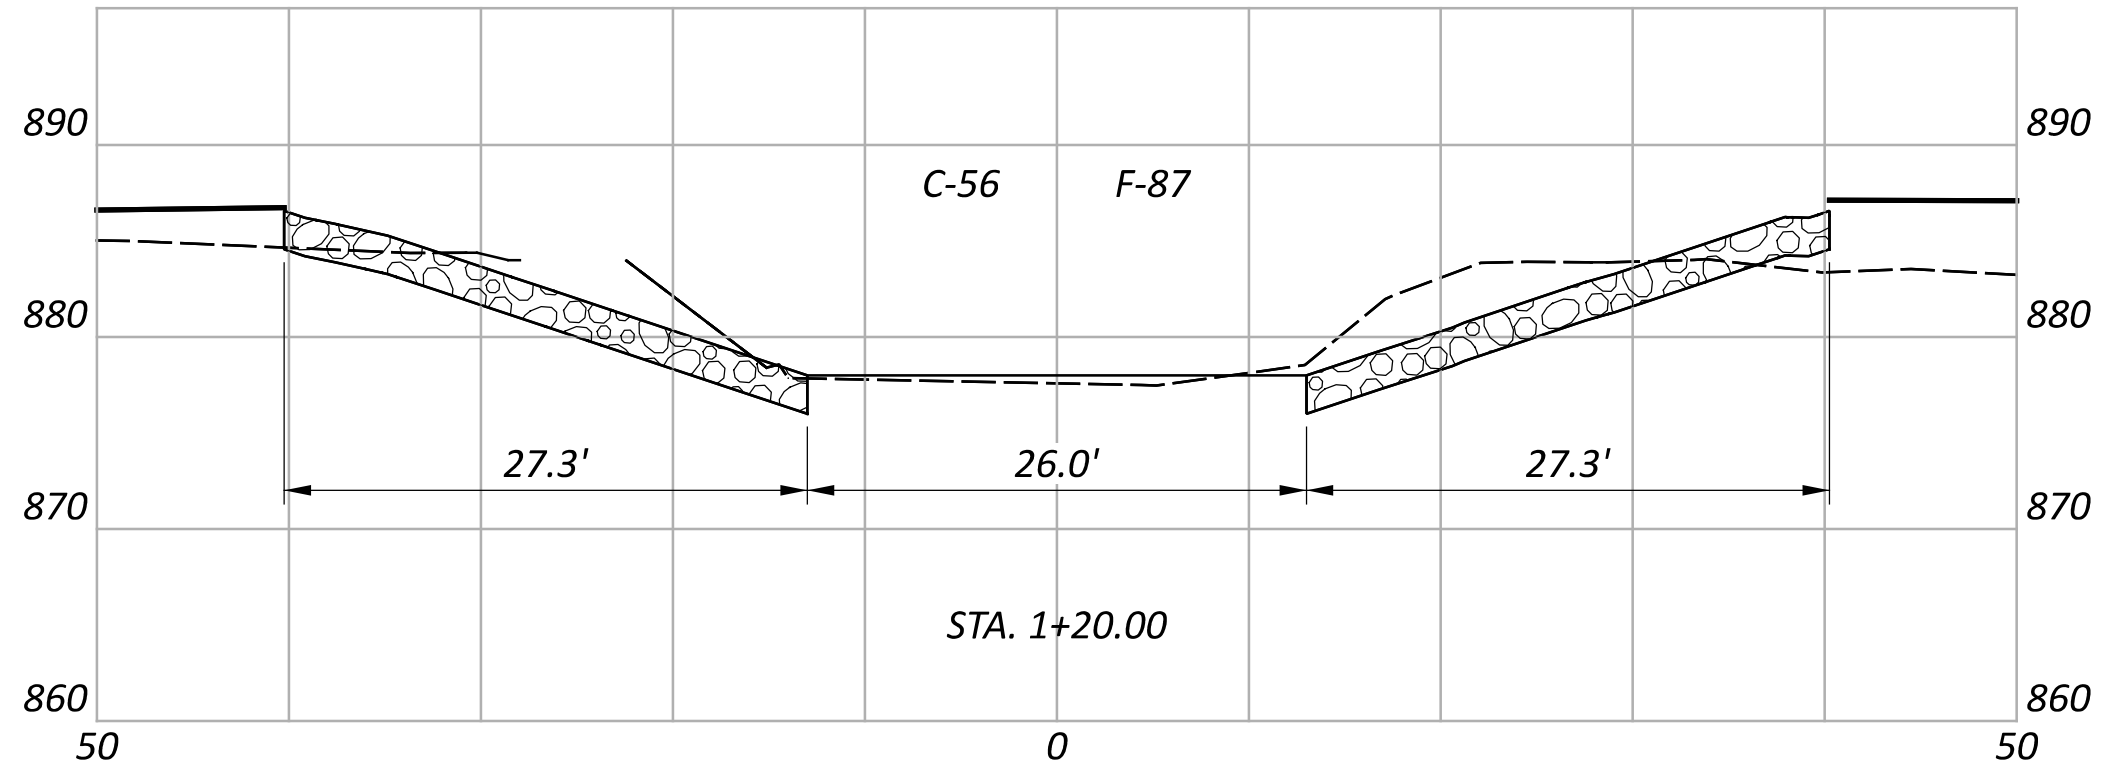


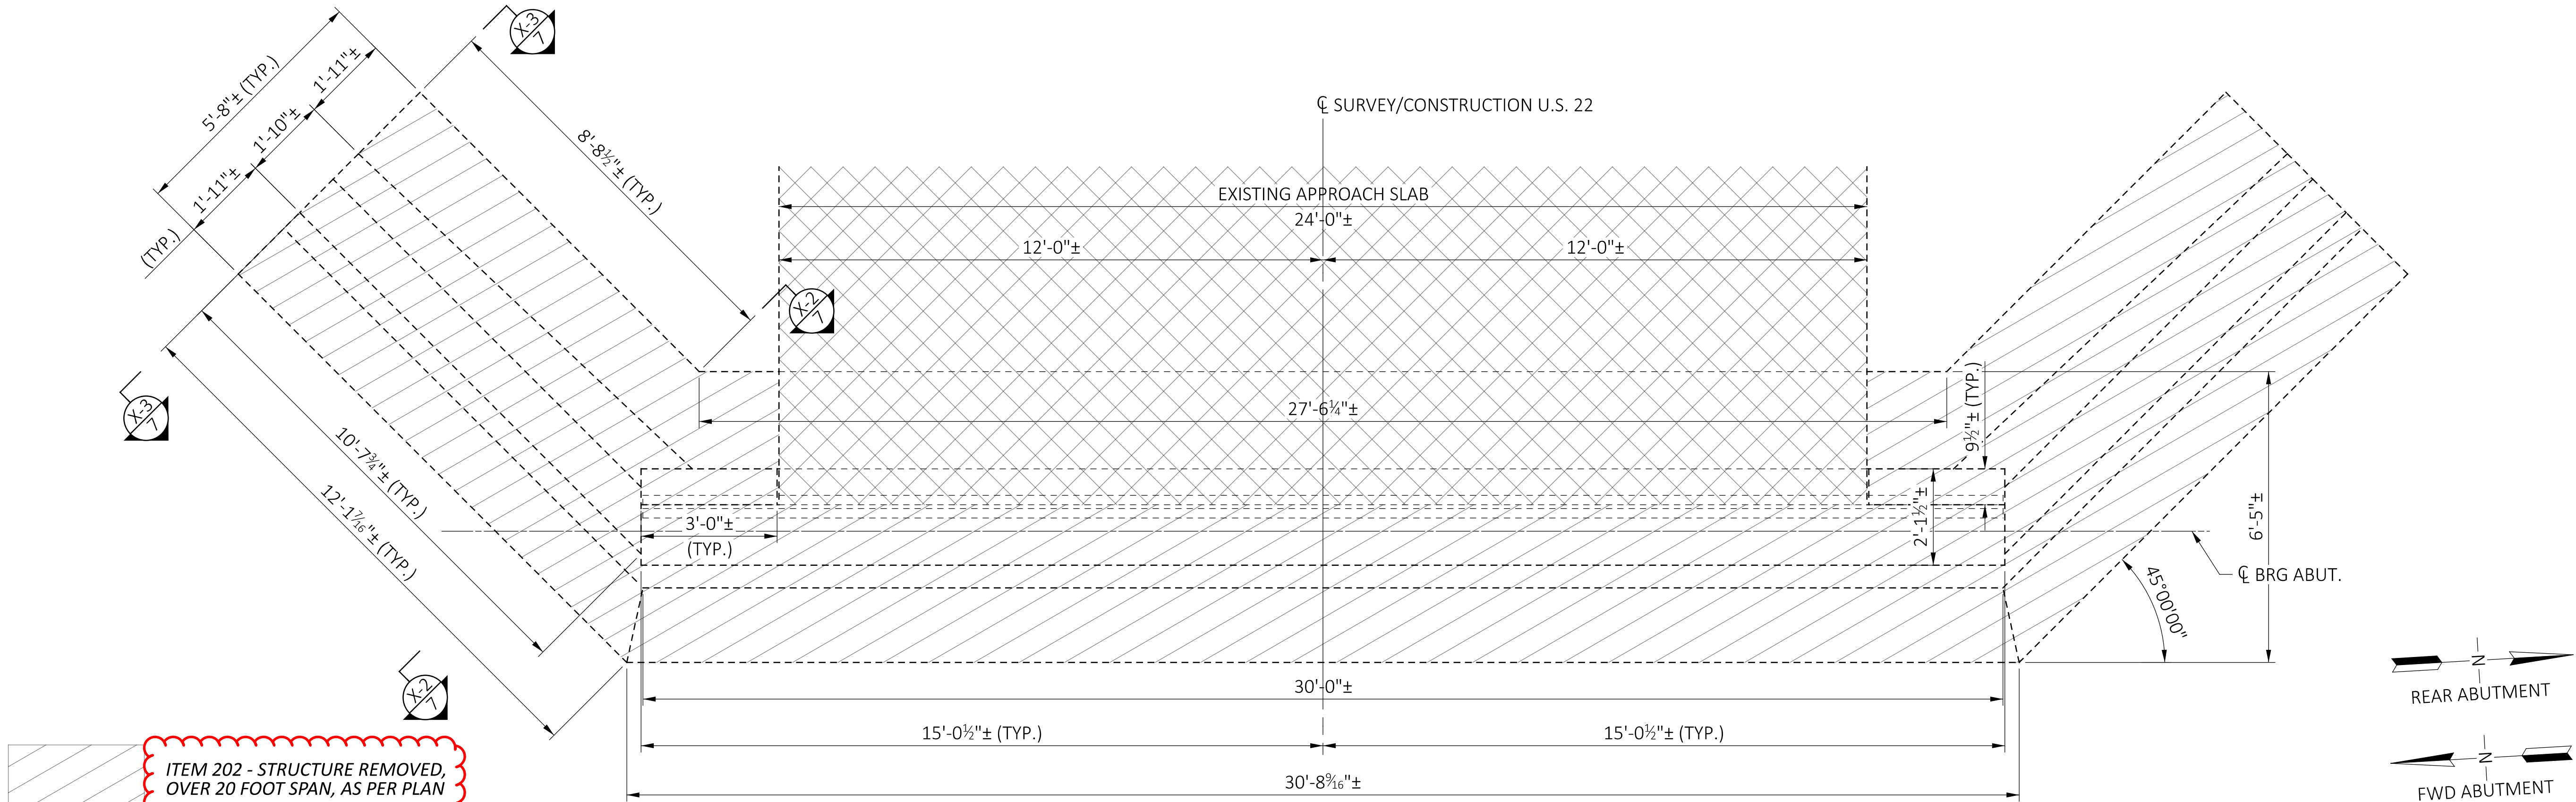


ITEM 202 - STRUCTURE REMOVED,
OVER 20 FOOT SPAN, AS PER PLAN

ITEM 202 - APPROACH SLAB REMOVED

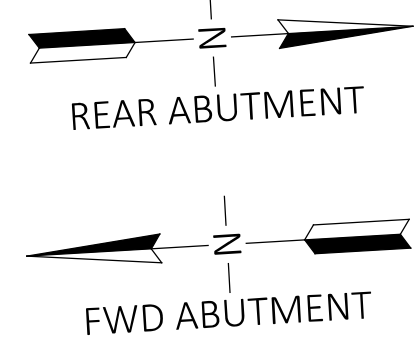


PLAN

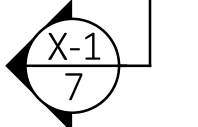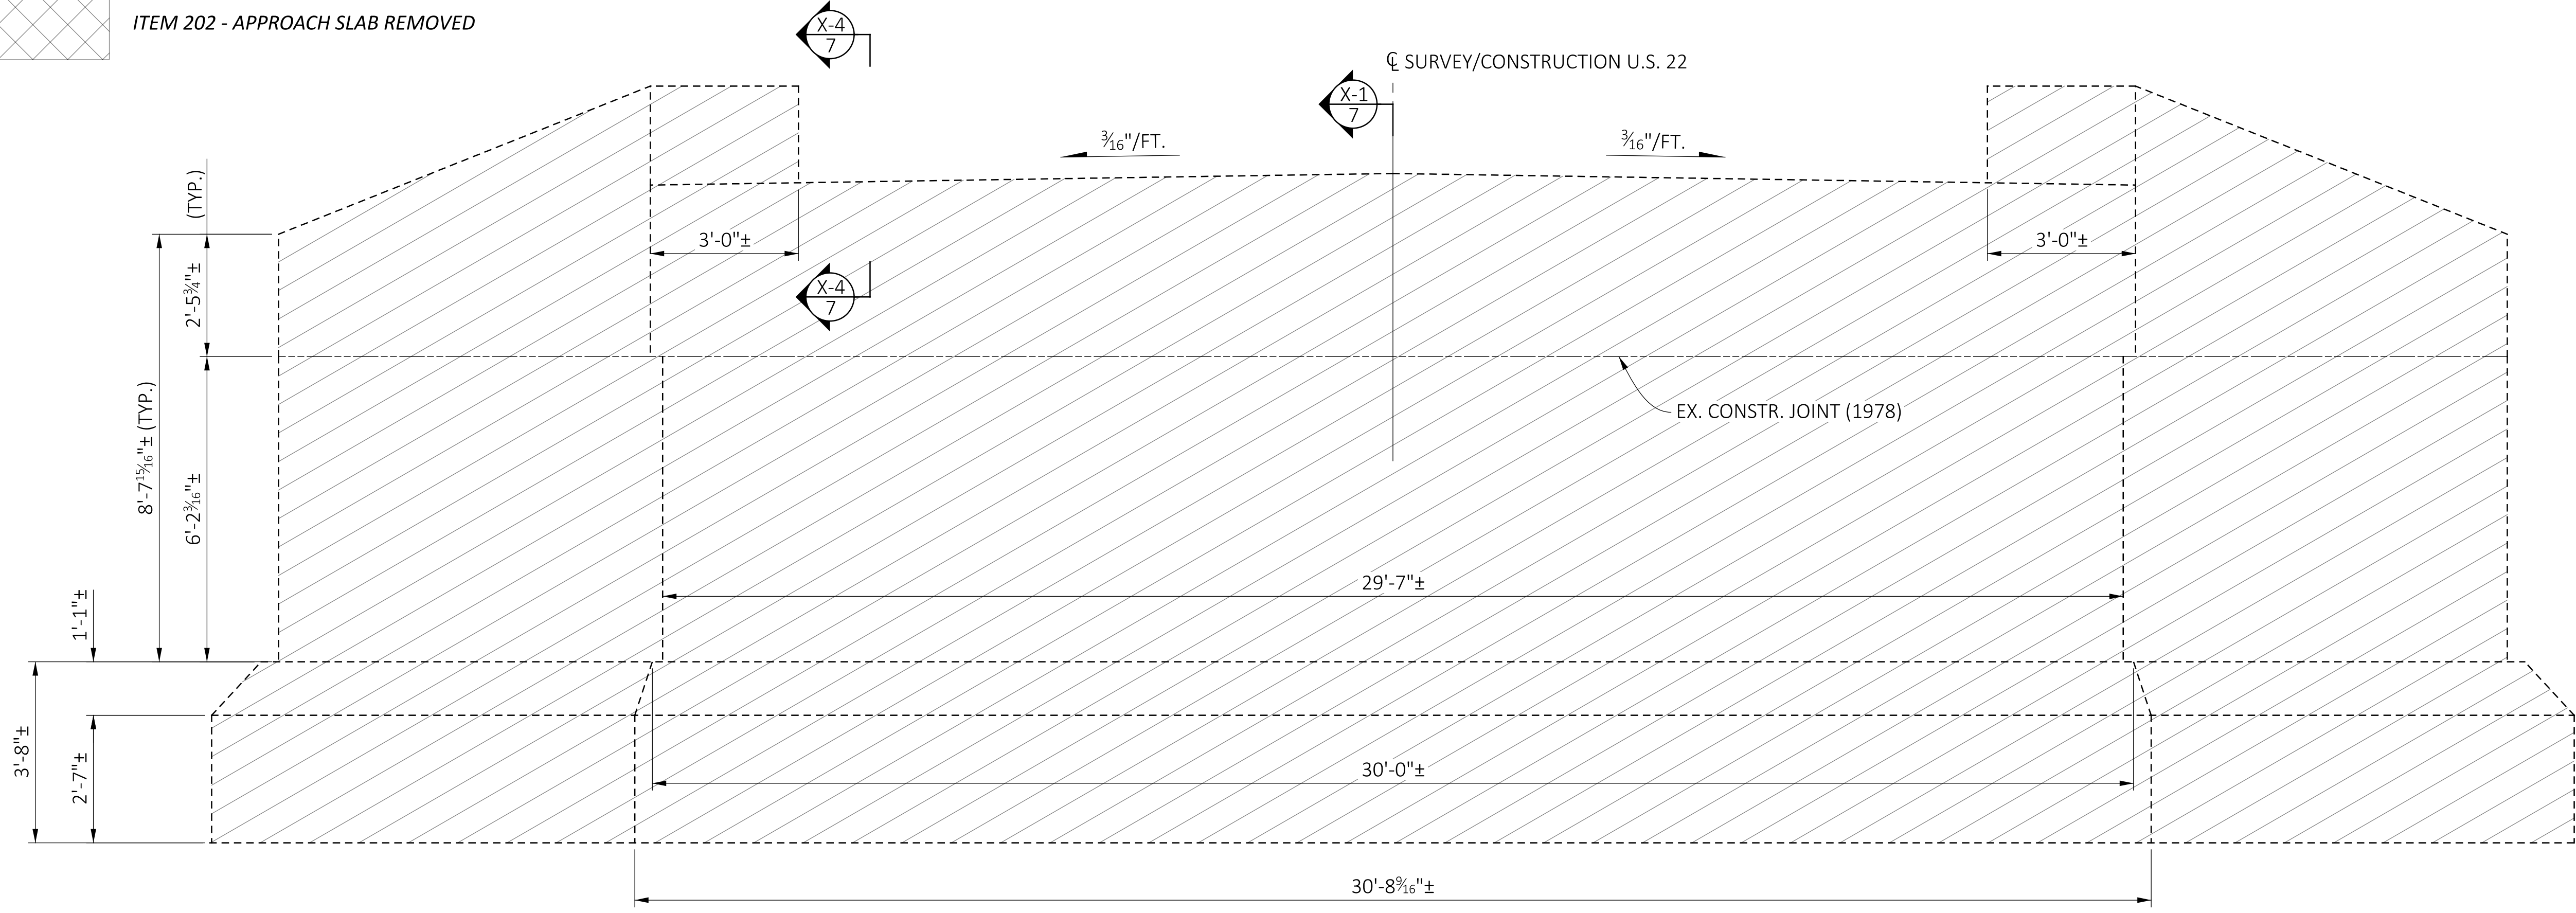


ELEVATION


EXISTING ABUTMENT REMOVAL
BRIDGE NO. FAI-22-03.740
U.S. 22 OVER CLEAR CREEK

SFN 2300095	
DESIGN AGENCY	
DESIGNER TDF	CHECKER MHK
REVIEWER TAG 9-4-25	
PROJECT ID 115691	
SUBSET 6	TOTAL 28
SHEET P.37	TOTAL 75

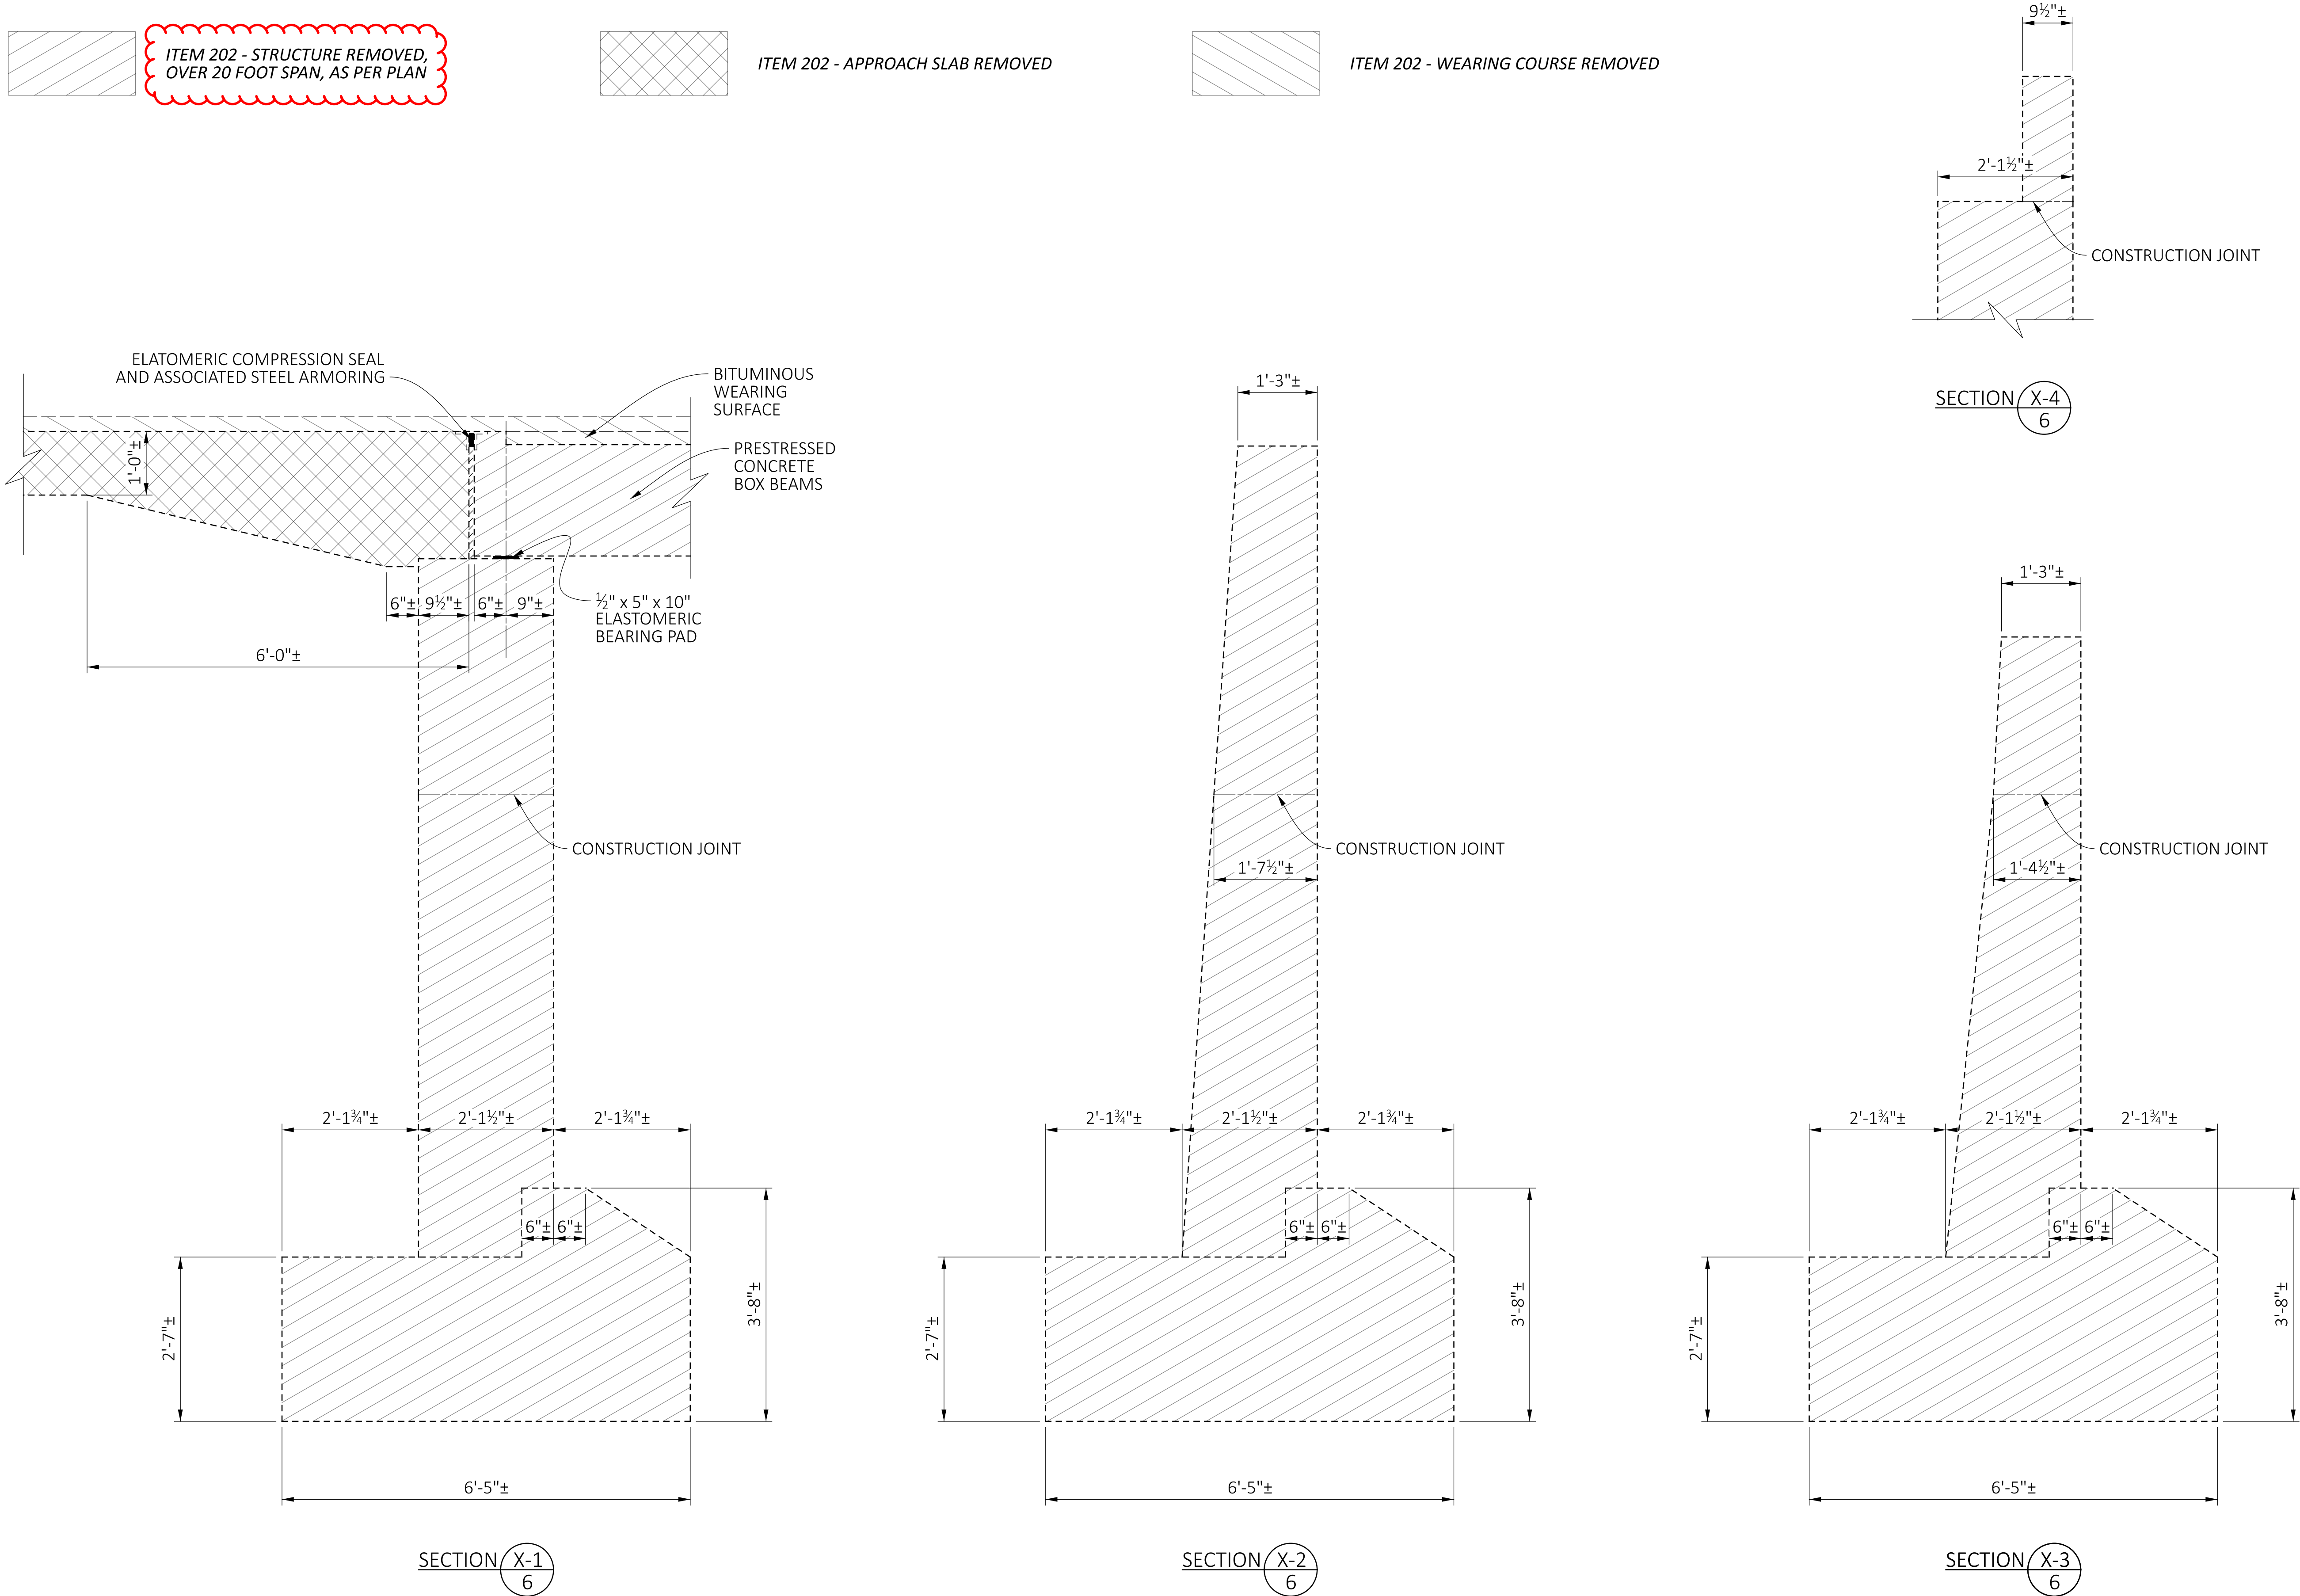


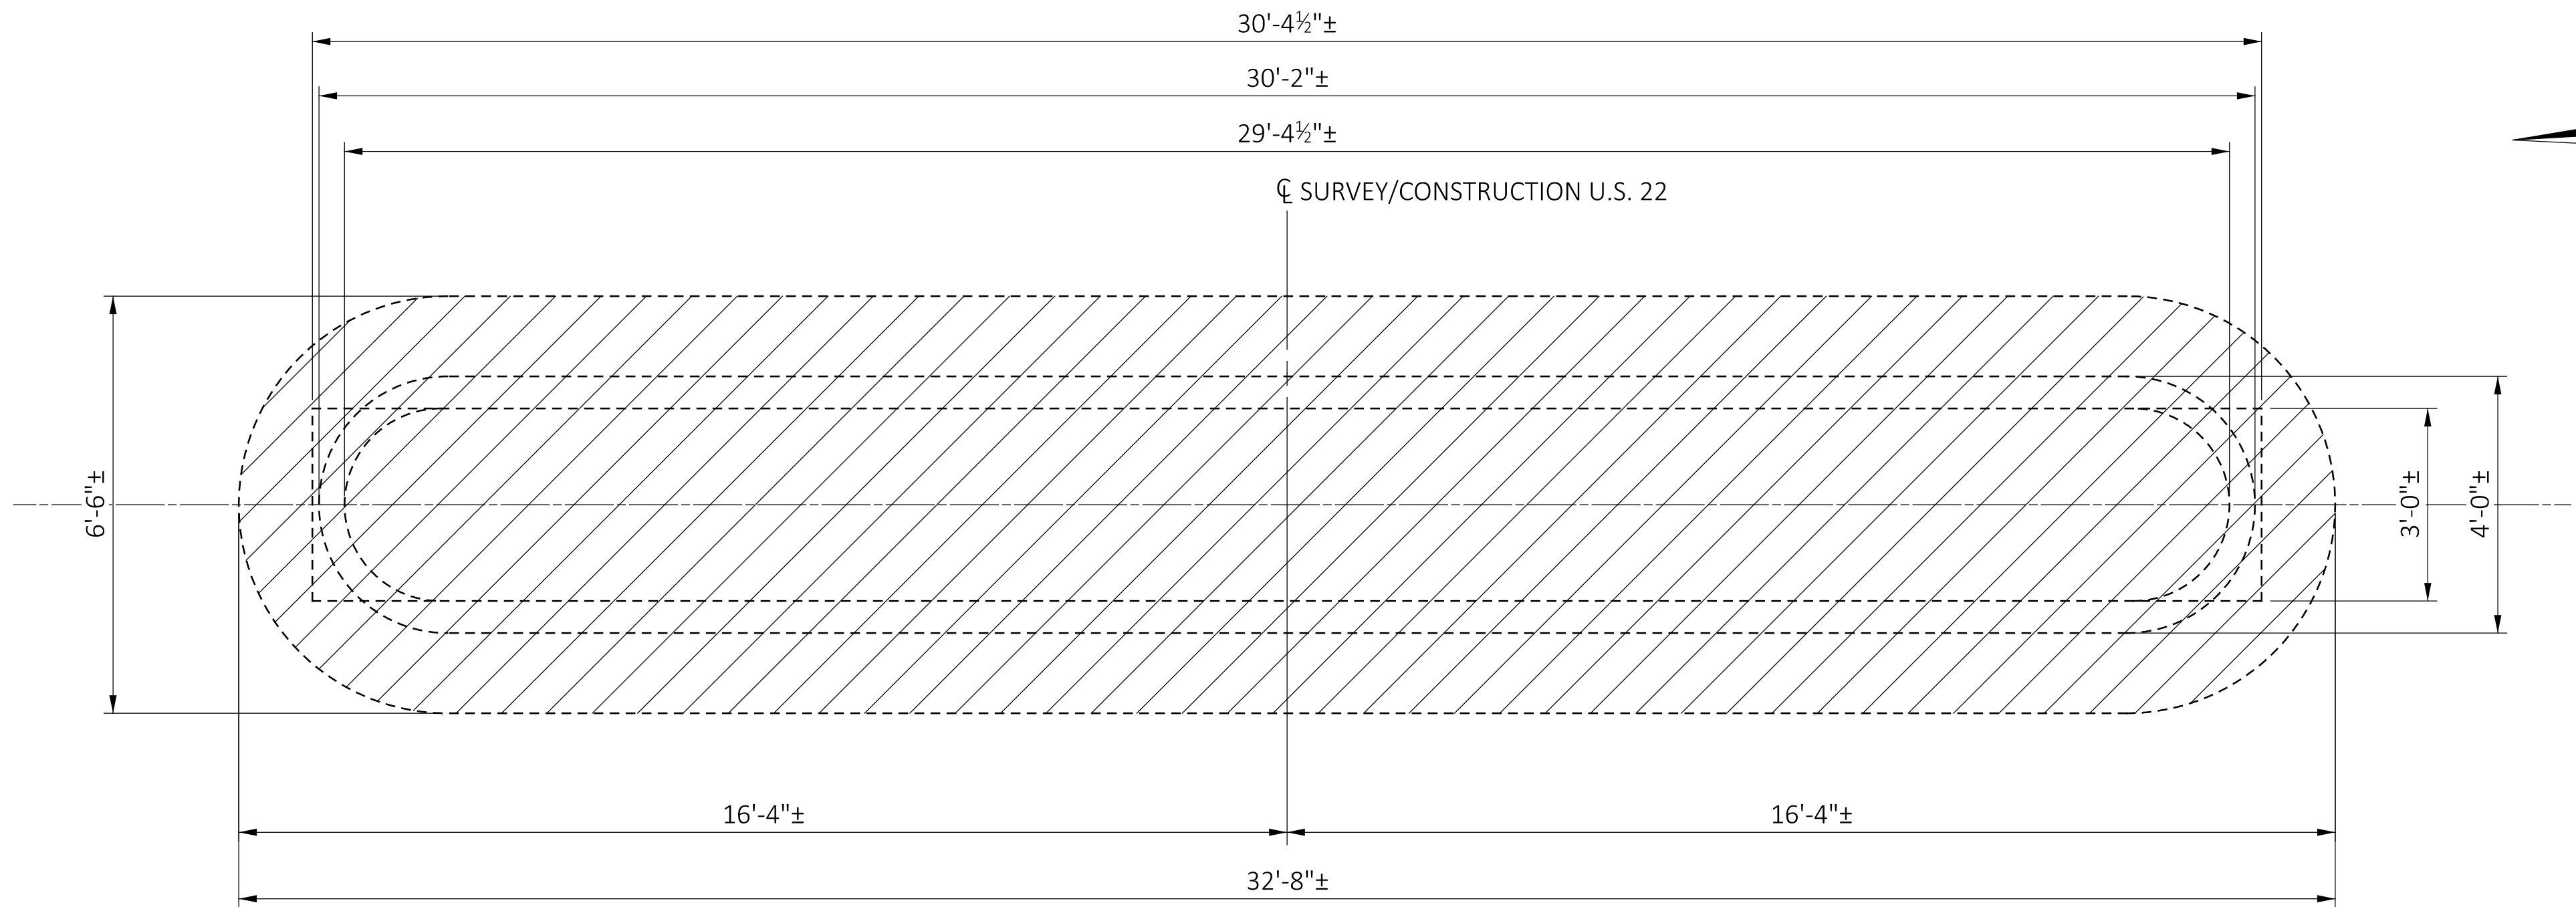


PLAN

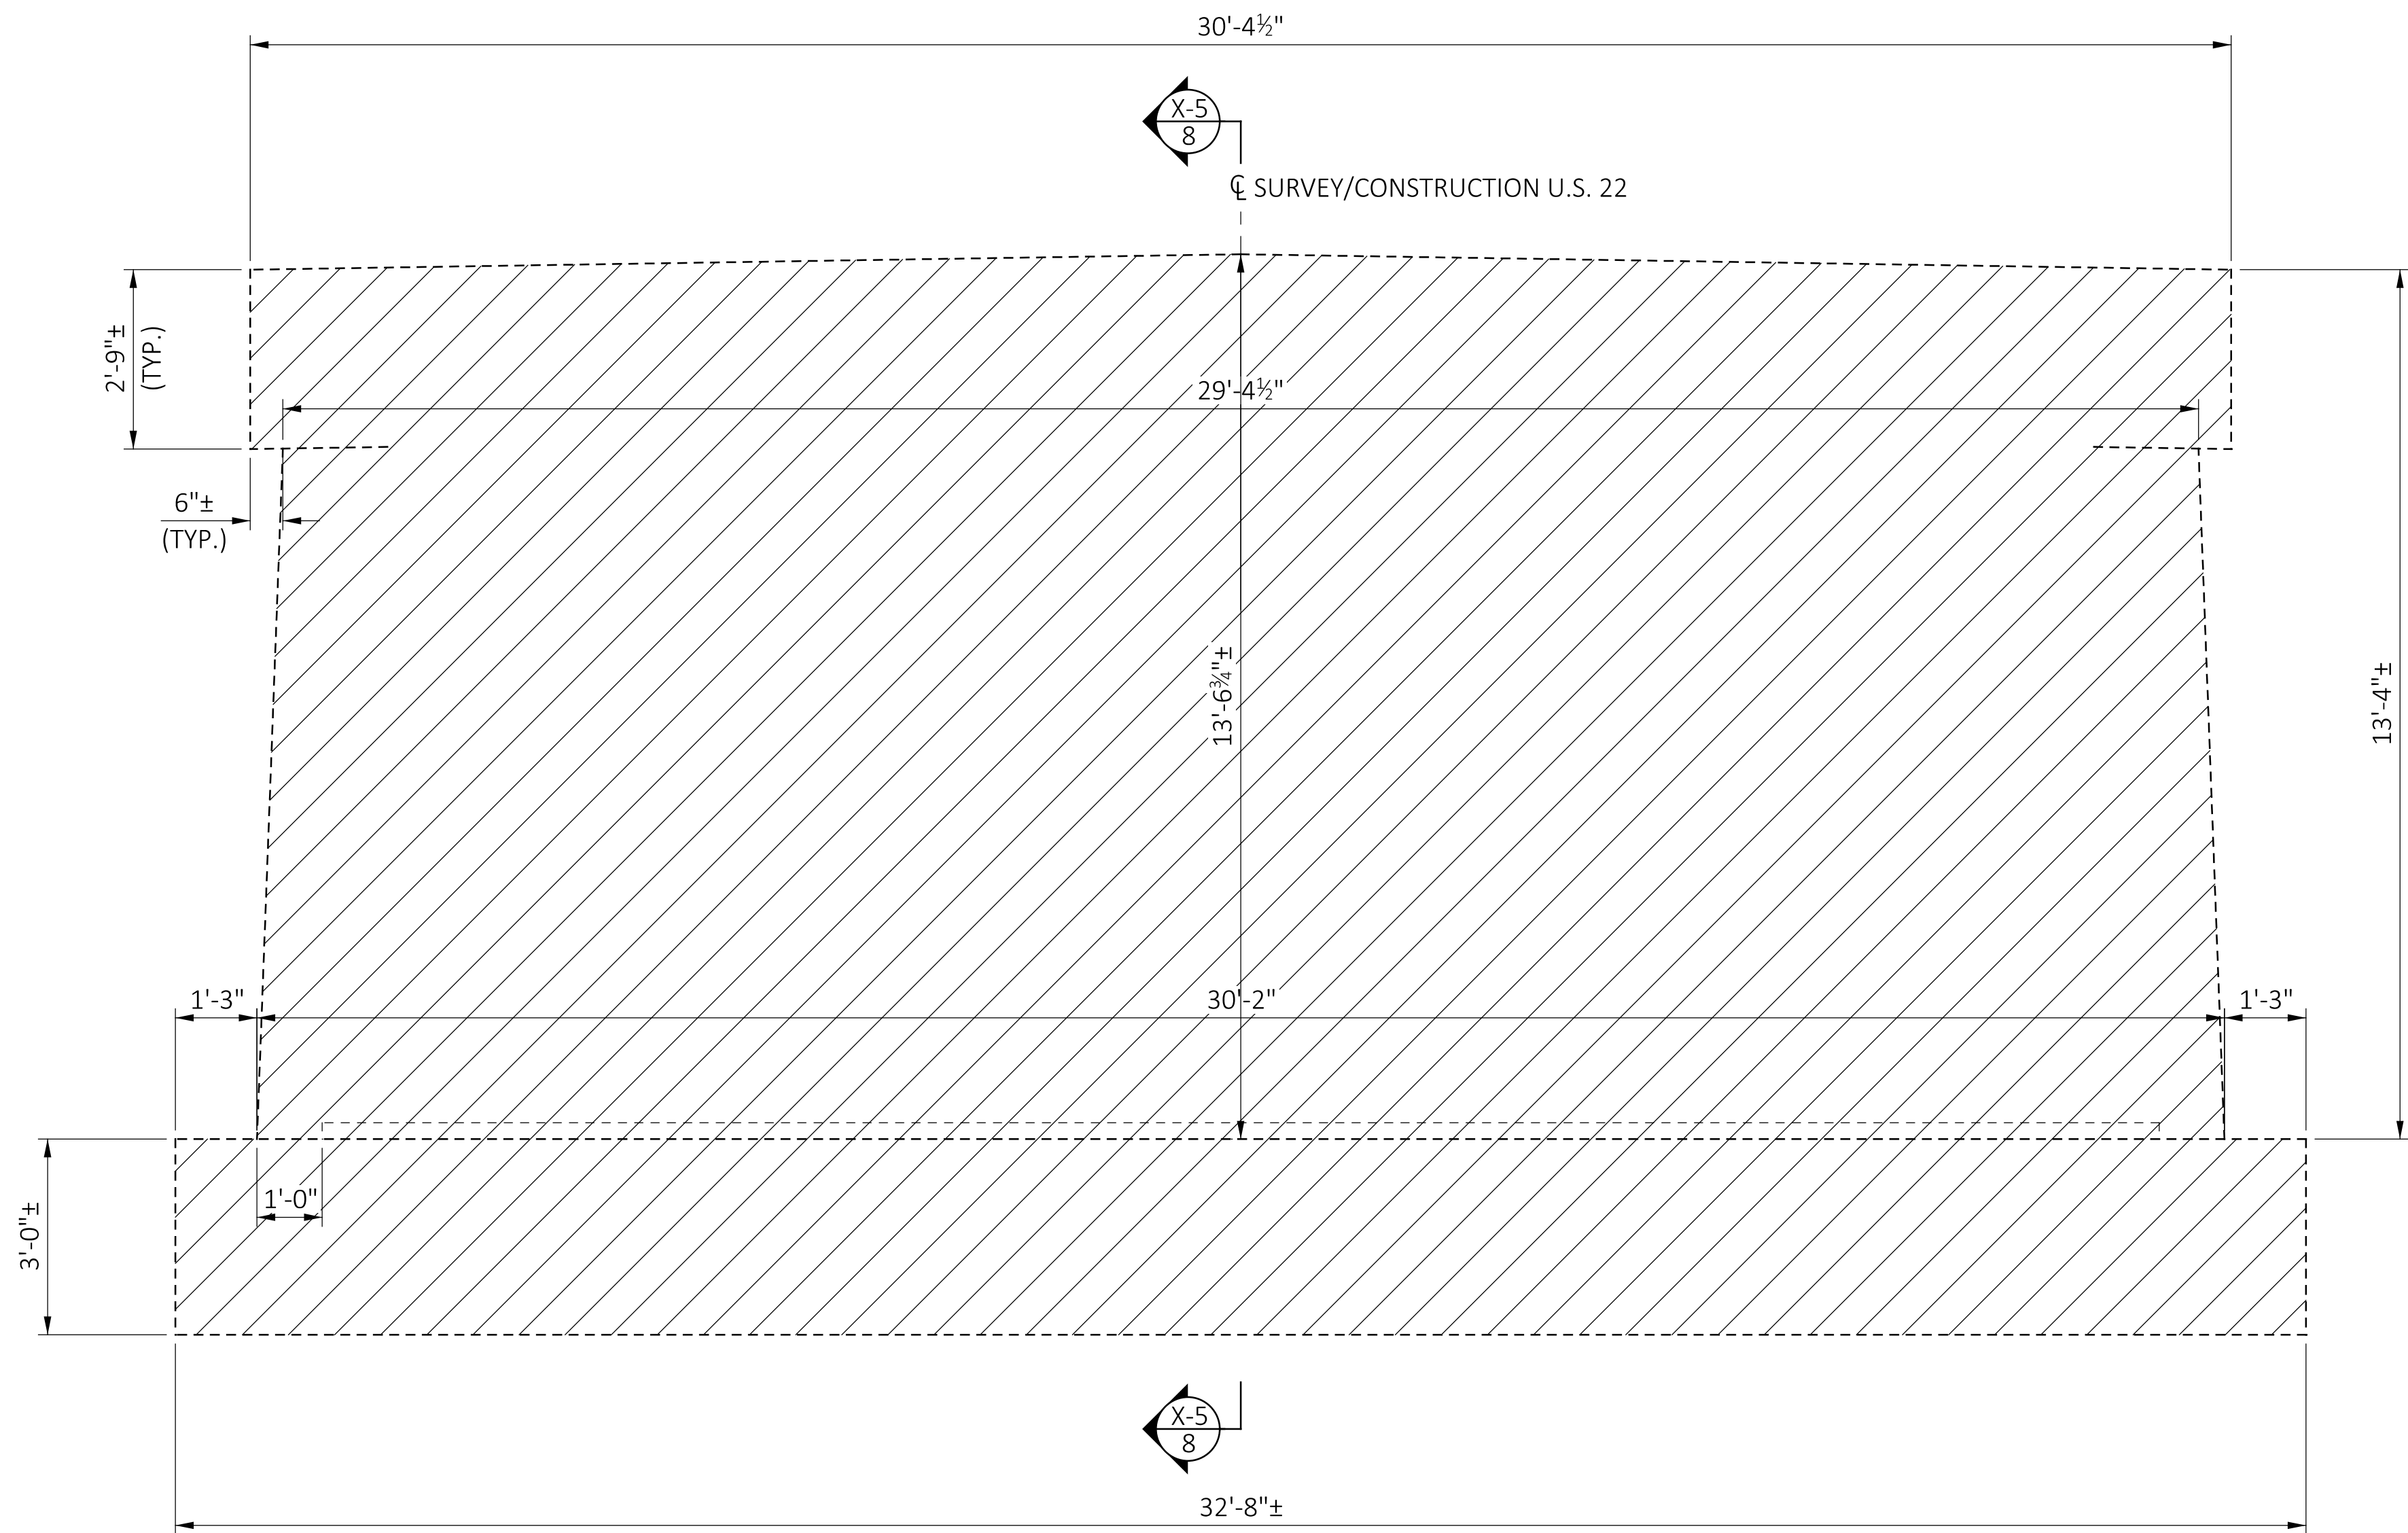

EXISTING

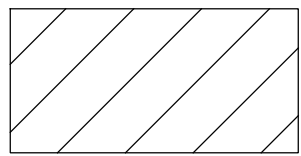

ITEM 202 - STRUCTURE REMOVED,
OVER 20 FOOT SPAN, AS PER PLAN

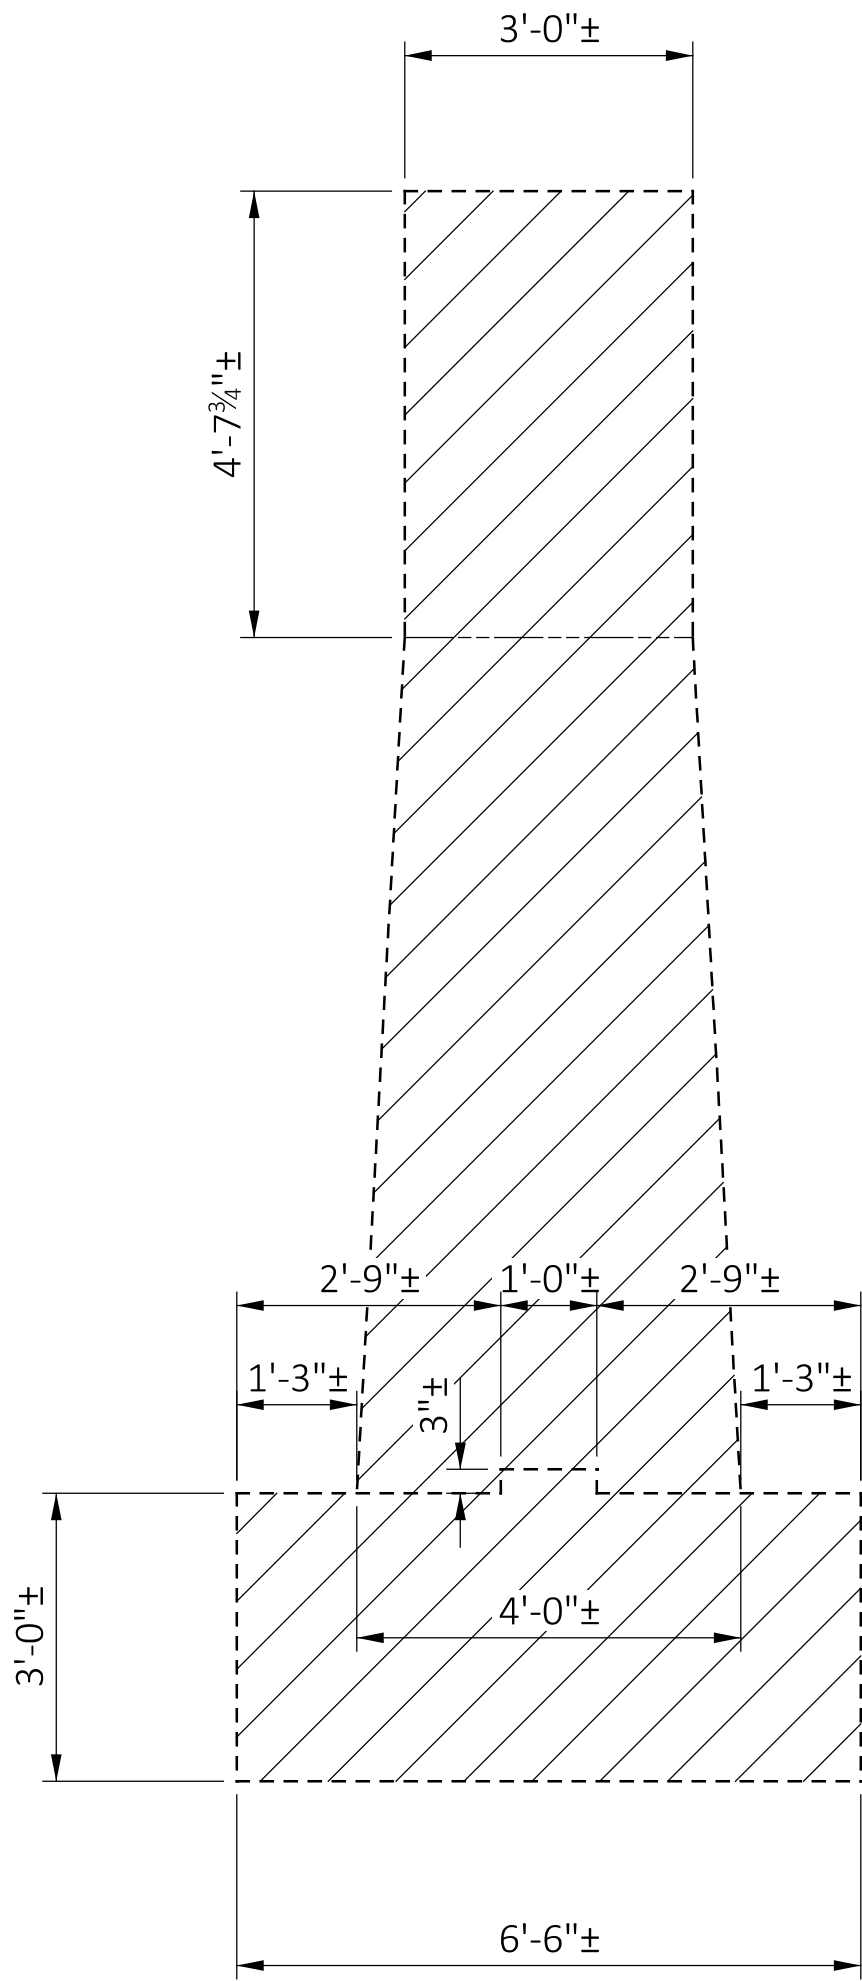

SECTION X-5

PIER REMOVAL DETAILS
BRIDGE NO. FAI-22-03.740
U.S. 22 OVER CLEAR CREEK

SFN	
2300095	
DESIGN AGENCY	
DESIGNER	CHECKER
TDF	MHK
REVIEWER	
TAG 9-4-25	
PROJECT ID	
115691	
SUBSET	TOTAL
8	28
SHEET	TOTAL
P.39	75

