


A02L64W
 AD1104396-02-MDVLOH94-8500 BLUEGRASS BLVD
 MILLEDGEVILLE, OH.
 BORE AND PLACE FIBER, CONTAINED IN 2" IPP,
 AT THE BACK EDGE OF 10' UTILITY EASEMENT FROM
 PEDISTAL TO PROPOSED HAND HOLE NEAR PUMP
 STATION.
 PLACE REMAINING IPP, FIBER AND HAND HOLES AT
 THE BACK EDGE OF RIGHT OF WAY FROM THE
 PUMP STATION TO "TRAILER CITY" ON ST RTE 729,
 ACROSS FROM HEDGE CT.
 BORE AT A MINIMUM 36" DEPTH.


PRIMARY ENGINEER: RODNEY WISSEL
 PHONE:937-212-3054
 EMAIL: RW176J@ATT.COM

BLUEGRASS BLVD

11280
 US-35

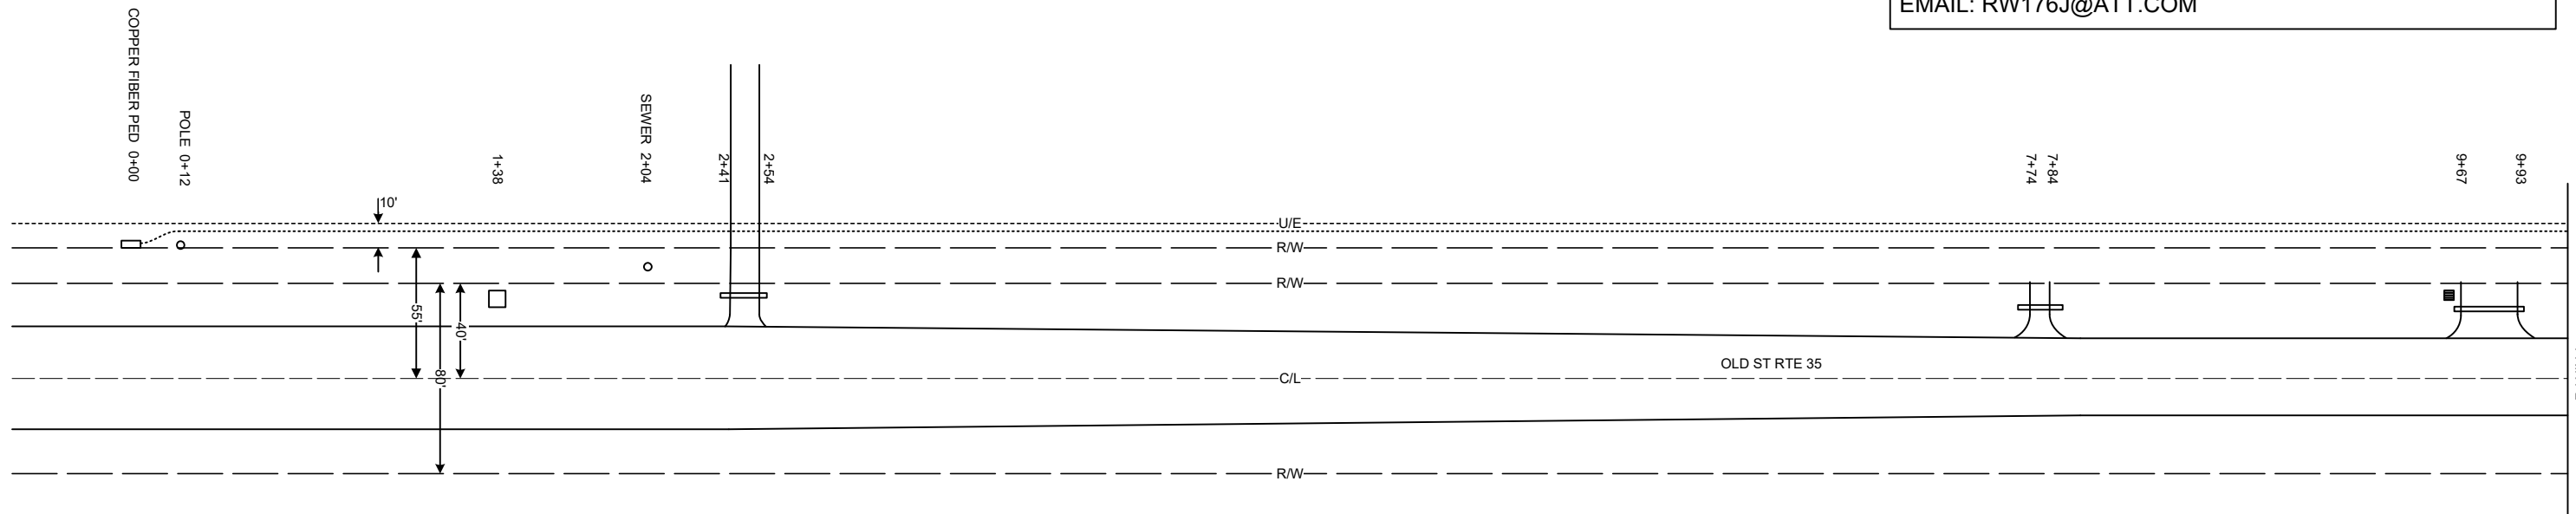

---FIBER CABLE---
 -U/E-
 -R/W-
 -C/L-

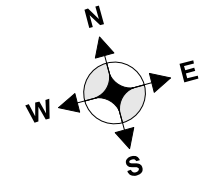

PRINT 1



1" - 70'