ITEM 614, MAINTAINING TRAFFIC

WILSON BRIDGE ROAD SHALL BE CLOSED TO THROUGH TRAFFIC WITHIN THE PROJECT LIMITS SHOWN IN THE PLANS FOR A PERIOD NOT TO EXCEED 90 CONSECUTIVE CALENDAR DAYS. THROUGH TRAFFIC WILL BE DETOURED AND SHALL FOLLOW THE DETOURS SHOWN BELOW. DISINCENTIVES SHALL BE ASSESSED IN THE AMOUNT OF \$7.500 PER DAY FOR EACH CALENDAR DAY THAT THE ROADWAY REMAINS CLOSED TO TRAFFIC BEYOND THE PROPOSAL COMPLETION DATE.

BEFORE THE WORK BEGINS, THE CONTRACTOR SHALL SUBMIT TO THE ENGINEER THE NAMES AND TELEPHONE NUMBERS OF THE PERSON OR PERSONS WHO CAN BE CONTACTED (24) HOURS PER DAY BY THE FRANKLIN COUNTY ENGINEER, ODOT ENGINEER, AND ALL INTERESTED LAW ENFORCEMENT AGENCIES.

THIS PERSON OR PERSONS SHALL BE RESPONSIBLE FOR PLACING OR REPLACING NECESSARY TRAFFIC CONTROL DEVICES IN ACCORDANCE WITH THE OHIO MANUAL OF UNIFORM TRAFFIC CONTROL DEVICES.

THE CONTRACTOR WILL ADVISE ODOT DISTRICT 6 AND THE FRANKLIN COUNTY ENGINEER TWENTY ONE (21) CALENDAR DAYS PRIOR TO THE START OF CONSTRUCTION ACTIVITIES. THE PROJECT ENGINEER WILL PROVIDE ASSISTANCE/CLARIFICATION FOR ANY QUESTIONS.

THE CONTRACTOR SHALL BE RESPONSIBLE FOR CONTACTING THE DISTRICT 6 PUBLIC INFORMATION OFFICE VIA EMAIL AT D06.PIO@DOT.OHIO.GOV TO COORDINATE EFFORTS TO NOTIFY ALL LOCAL COUNTY, STATE AND FEDERAL EMERGENCY SERVICES. SCHOOL DISTRICTS AND ADJACENT RESIDENTS AND BUSINESSES OF THE UPCOMING CLOSURE. ADVANCE NOTIFICATION SHALL OCCUR NO LATER THAN TWENTY-ONE (21) DAYS PRIOR TO CLOSING THE ROAD. IF, SUBSEQUENT TO THE ADVANCE NOTIFICATION, THE START DATE IS CHANGED, THEN A NEW SEVEN (7) DAY NOTIFICATION WILL BE REQUIRED. THE ROAD CANNOT BE CLOSED UNLESS PRIOR NOTIFICATION HAS BEEN ACCOMPLISHED. THE SAME PARTIES SHALL BE NOTIFIED WHEN THE CLOSURE HAS CONCLUDED AND THE ROAD IS BACK OPEN TO TRAFFIC. ALL NOTIFICATIONS SHALL BE MADE UTILIZING THE TEMPLATE PROVIDED BY THE DISTRICT 6 PUBLIC INFORMATION OFFICE.

THE DETOUR ROUTES SHALL BE AS FOLLOWS;

WB DETOUR: SOUTH ON US 23 TO SR 161 WEST, SR 161 TO NORTH ON LINWORTH RD. LINWORTH RD TO WEST ON WILSON BRIDGE RD

EB DETOUR: SOUTH ON LINWORTH RD TO SR 161 EAST, SR 161 TO US 23 NORTH, US 23 TO WEST ON WILSON BRIDGE RD

NOTICE OF CLOSURE SIGNS, W20-H13, SHALL BE ERECTED BY THE CONTRACTOR PRIOR TO THE SCHEDULED ROAD OR RAMP CLOSURE IN ACCORDNACE WITH THE NOTICE OF CLOSURE TIME TABLE BELOW.[AT THE APPROVAL OF THE ENGINEER, PORTABLE CHANGEABLE MESSAGE SIGNS MAY BE USED IN LIEU OF THE STANDARD FLATSHEET SIGN FOR CLOSURE DURATIONS OF LESS THAN 1 WEEK.1

THE SIGNS SHALL BE ERECTED ON THE RIGHT-HAND SIDE OF THE ROAD/RAMP FACING TRAFFIC. THEY SHALL BE PLACED SO AS NOT TO INTERFERE WITH THE VISIBILITY OF ANY OTHER TRAFFIC CONTROL SIGNS. ON ROADWAYS, THEY SHOULD BE ERECTED AT OR NEAR THE POINT OF CLOSURE. THE SIGNS MAY BE ERECTED ANYWHERE ON RAMPS AS LONG AS THEY ARE VISIBLE TO THE MOTORISTS USING THE RAMP. ON ENTRANCE RAMPS, THE SIGN SHALL BE ERECTED WELL IN ADVANCE OF THE MERGE AREA TO AVOID DISTRACTING MOTORISTS.

ITEM 614, MAINTAINING TRAFFIC (CONTINUED)

THE SIGN SHALL DISPLAY THE DATE OF THE CLOSURE IN MMM-DD FORMAT AND THE NUMBER OF DAYS OF THE CLOSURE. THE LAST LINE OF THE W20-H13 SIGN SHALL DISPLAY THE PHONE NUMBER OF THE DISTRICT 6 PUBLIC INFORMATION CONSTRUCTION LINE, (740)833-8268, WHICH A MOTORIST MAY CALL FOR ADDITIONAL INFORMATION.

THE CONTRACTOR SHALL PROVIDE, ERECT AND MAINTAIN STANDARD 48" X 30" "ROAD CLOSED" SIGNS, SIGN SUPPORTS, BARRICADES, GATES, AND LIGHTS, AS DETAILED IN SCD MT-101.60 DURING PERIODS IN WHICH THE AFFECTED ROADS ARE CLOSED TO TRAFFIC.

THE CONTRACTOR SHALL PROVIDE, ERECT AND MAINTAIN SIGNS AND SIGN SUPPORTS, AS DETAILED IN THE OHIO MANUAL OF UNIFORM TRAFFIC CONTROL DEVICE, AND TYPE III BARRICADES OF THE TYPE AND LOCATIONS AS SHOWN IN SHEETS 689/30.

THE CONTRACTOR SHALL MAINTAIN ACCESS TO ALL ADJACENT DRIVEWAYS WITHIN THE PROJECT AREA AT ALL TIMES.

THE CONTRACTOR SHALL PROVIDE ERECT AND MAINTAIN DETOUR SIGNS AND SIGN SUPPORTS AT INTERSECTIONS ALONG DETOUR ROUTES.

THE CONTRACTOR WILL FURNISH, ERECT, AND MAINTAIN, AND SUBSEQUENTLY REMOVE ALL FLAGS, BARRICADES, SIGNS, AND SIGN SUPPORTS AND MAINTAIN ALL FLAGGERS, WATCHERS, AND INCIDENTALS TO PERFORM THE REQUIRED WORK.

PAYMENT FOR ALL ITEMS REQUIRED BY THE OHIO MANUAL OF TRAFFIC CONTROL DEVICES, THE STANDARD CONSTRUCTION DRAWINGS, THE CONSTRUCTION AND MATERIAL SPECIFICATIONS, THE PROPOSAL, AND THIS SCOPE OF SERVICES WILL BE INCLUDED IN THE LUMP SUM PAYMENT FOR ITEM 614, MAINTAINING TRAFFIC AND WILL INCLUDE ALL LABOR, MATERIALS, EQUIPMENT, FUELS, LUBRICATING OILS, SOFTWARE, HARDWARE, AND INCIDENTALS TO PERFORM THE REQUIRED WORK.

A MINIMUM OF ONE LANE OF TRAFFIC IN EACH DIRECTION ON SR 315 SHALL BE MAINTAINED AT ALL TIMES BY USE OF THE EXISTING PAVEMENT.

THE CONTRACTOR SHALL PROVIDE. ERECT AND MAINTAIN STANDARD SIGNS, SIGN SUPPORTS, BARRICADES AND LIGHTS, AS DETAILED IN SCD MT-101.60 AT THE LOCATIONS AS SHOWN IN THE PLANS DURING PERIODS IN WHICH THE AFFECTED ROADS ARE CLOSED TO TRAFFIC.

NO WORK SHALL BE PERFORMED AND THE SAME NUMBER OF LANES ON SR 315 AS WERE AVAILABLE AT THE START OF THE PROJECT SHALL BE OPEN TO TRAFFIC DURING THE FOLLOWING DESIGNATED HOLIDAYS OR EVENTS:

CHRISTMAS FOURTH OF JULY NEW YEARS LABOR DAY MEMORIAL DAY THANKSGIVING OSU HOME GAMES

				Ē	
ITEM	614, MAINTA	AINING TRAFFIC (CONTINUED)	NOTIFICATION OF TRAFFIC RESTRICTIONS (CONTINUED)	WWM CHECKED
MAINTA SHIFTIN UTILIZE SHOULE TRAFFI MINIMIZ SUCH A FOOTB PROTEC TRAIL WORK F	AINED UNDER T NG TRAFFIC ON ED IN THE MOT DERS ALONG SF IC. CONSTRUC ZING IMPACTS AS OHIO STATE ALL GAMES. F CT TRAFFIC AL EDGE/PARAP REQUIRING LAN	D AND FROM I-270/U HE BRIDGE. SHOULDE ITO SHOULDER PAVEM SCHEME. THE PAVE R-315 IS SUITABLE FO TION SCHEDULES WILL DURING HIGH TRAFFIC UNIVERSITY'S MOVE- TALSEWORK UNDER TH ONG SR-315 AND THE ET REMOVAL AND HYD E CLOSURE ALONG SF DRMED UNDER NIGHT 1	R CLOSURES AND ENT MAY BE MENT BUILDUP FOR MAINTAINING BE RESTRICTED, VOLUME EVENTS IN DAY AND HOME E BRIDGE WILL OLENTANGY BIKE RODEMOLITION R-315 OR THE BIKE	INFORMATION SHOULD INCLUDE BUT IS NOT LIMITED TO ALL CONSTRUCTION ACTIVITIES THAT IMPACT OR INTERFERE WITH TRAFFIC AND SHALL LIST THE SPECIFIC LOCATION, TYPE OF WORK, ROAD STATUS, DATE AND TIME OF RESTRICTION, DURATION OF RESTRICTION, NUMBER OF LANES MAINTAINED, NUMBER OF LANES CLOSED, MINIMUM VERTICAL CLEARANCE, MINIMUM WIDTH OF DRIVABLE PAVEMENT, DETOUR ROUTES IF APPLICABLE, AND ANY OTHER INFORMATION REQUESTED BY THE PROJECT ENGINEER. ANY UNFORESEEN CONDITIONS NOT SPECIFIED IN THE PLANS REQUIRING TRAFFIC RESTRICTIONS SHALL ALSO BE REPORTED TO THE PROJECT ENGINEER USING THE NOTIFICATION TIME TABLE.	NOTES
		BE REQUIRED FOR THE NT ALONG WILSON BR		THE PERIOD OF TIME THAT THE LANES ARE TO BE OPEN DEPENDS ON	
DUST	CONTROL			THE DAY OF THE WEEK ON WHICH THE HOLIDAY OR EVENT FALLS. THE FOLLOWING SCHEDULE SHALL BE USED TO DETERMINE THIS PERIOD:	RA
		ALL FURNISH AND APP ED BY THE ENGINEER.	PLY WATER FOR DUST	DAY OF HOLIDAY TIME ALL LANES OR EVENT MUST BE OPEN TO TRAFFIC	U N E
HAUL	ROUTE APP	ROVAL		SUNDAY 12:00N FRIDAY THROUGH 6:00AM MONDAY	G
COUNT ACCEPI WORKIN COMME APPRO	Y ENGINEER'S O T OR REJECT T NG DAYS OF RE NCE UNTIL THE VAL FROM THE	DFFICE FOR APPROVA THE PROPOSED ROUTE CEIPT, CONSTRUCTI CONTRACTOR HAS R COUNTY OF THEIR P	ON SHALL NOT ECEIVED WRITTEN ROPOSED ROUTES	MONDAY12:00N FRIDAY THROUGH 6:00AM TUESDAYTUESDAY12:00N MONDAY THROUGH 6:00AM WEDNESDAYWEDNESDAY12:00N TUESDAY THROUGH 6:00AM THURSDAYTHURSDAY12:00N WEDNESDAY THROUGH 6:00AM FRIDAYTHURSDAY12:00N WEDNESDAY THROUGH 6:00AM MONDAYFRIDAY12:00N THURSDAY THROUGH 6:00AM MONDAYFRIDAY12:00N FRIDAY THROUGH 6:00AM MONDAYSATURDAY12:00N FRIDAY THROUGH 6:00AM MONDAY	TRAFFIC
THROUG CONTRA WRITIN MAINTE ENSURE TIMELY	GHOUT THE DU ACTOR SHALL G OF ALL TRA ENANCE OF TRA THE WRITTEN MANNER TO A	F TRAFFIC RESTR NOTIFY THE PROJECT FFIC RESTRICTIONS A NFFIC CHANGES. THE (NOTIFICATION IS SU LLOW THE PROJECT 1	ECT, THE ENGINEER IN ND UPCOMING CONTRACTOR SHALL BMITTED IN A ENGINEER TO MEET	NO EXTENSIONS OF TIME SHALL BE GRANTED FOR DELAYS IN MATERIAL DELIVERIES, UNLESS SUCH DELAYS ARE INDUSTRY WIDE, OR FOR LABOR STRIKES, UNLESS SUCH STRIKES ARE AREA WIDE. SHOULD THE CONTRACTOR FAIL TO MEET ANY OF THESE REQUIREMENTS, THE CONTRACTOR SHALL BE ASSESSED A DISINCENTIVE PER THE LANE VALUE CONTRACT (PN 127).	NANCE OF
TO INF (HAULIN INFORM NOTIFI PRIOR	ORM SPECIAL NG.PERMITS@D(MATION OFFICE CATION SHALL	FRAMES SET FORTH IN HAULING PERMITS SEC DT.OHIO.GOV) AND TH PIO (D06.PIO@DOT.C BE RECEIVED BY THE CAL SETUP OF ANY A	TION HE DISTRICT PUBLIC DHIO.GOV). THIS PROJECT ENGINEER	615 LUMP SUM ROADS FOR MAINTAINING TRAFFIC AS PER PLAN IN ADDITION TO THE OFFICIAL, SIGNED DETOUR ROUTE, A LOCAL ROUTE HAS BEEN DETERMINED TO BE THE SECONDARY, UNSIGNED DETOUR ROUTE OR DESIGNATED LOCAL DETOUR	MAINTE
	NOTIF	ICATION TIME FRAME	TABLE	COUTE. OLENTANCY RIVER ROAD WILL SERVE AS THE LOCAL	
ITEM	DURATION OF CLOSURE	SIGN DISPLAY TO PUBLIC	NOTIFICATION DUE TO DISTRICT 6 COMMUNICATIONS OFFICE	AND INVENTORY THE SECTION OF ROAD BETWEEN SR-161 (WEST DUBLIN GRANDVILLE ROAD) AND WEST WILSON BRIDGE ROAD. AFTER THE CONSTRUCTION IS COMPLETED, THE ENGINEER WILL REVIEW THE CONDITION AFTER THE AND	
	>= 2 WEEKS	14 CALENDAR DAYS PRIOR TO CLOSURE	21 CALENDAR DAYS PRIOR TO CLOSURE	DETERMINE IF ANY REPAIR IS REQUIRED. THIS ROUTE IS SHOWN ON SHEET NO. 6. DURING THE TIME THAT TRAFFIC IS	
RAMP & ROAD CLOSURES	> 12 HOURS & < 2 WEEKS	7 CALENDAR DAYS PRIOR TO CLOSURE	14 CALENDAR DAYS PRIOR TO CLOSURE	DETOURED, THE CONTRACTOR SHALL MAINTAIN THIS ROUTE IN A CONDITION WHICH IS REASONABLY SMOOTH AND FREE FROM HOLES, RUIS, RIDGES, BUMPS, DUST AND STANDING	9
	<= 12 HOURS	2 BUSINESS DAYS PRIOR TO CLOSURE	4 BUSINESS DAYS PRIOR TO CLOSURE	WATER. ONCE THE DETOUR IS REMOVED AND TRAFFIC RETURNED TO ITS NORMAL PATTERN, THE DESIGNATED LOCAL	1°6
LANE CLOSURES &	>= 2 WEEKS		14 CALENDAR DAYS PRIOR TO CLOSURE	DETOUR ROUTE SHALL BE RESTORED TO A CONDITION THAT IS EQUIVALENT TO THAT WHICH EXISTED PRIOR TO ITS USE FOR THIS PURPOSE. ALL SUCH WORK SHALL BE PERFORMED	15 -1
RESTRIC- TIONS	< 2 WEEKS		5 BUSINESS DAYS PRIOR TO CLOSURE	WHEN AND AS DETERMINED BY THE ENGINEER.	ကို
START OF CONSTRUC- TION & TRAFFIC	NZA		14 CALENDAR DAYS PRIOR TO IMPLEMENTATION		FRA
PATTERN CHANGES				1 1/31/23 REMOVE ITEM 615	7 30

 \bigcirc

 \bigcirc

DESIGNATED LOCAL DETOUR ROUTE

ITEM 614, ASPHALT CONCRETE	
FOR MAINTAINING TRAFFIC	90 CU. YD.
ITEM 642, CENTER LINE	.38 MILE
ITEM 616, WATER	50 M. GAL.
ITEM 617, WATER	1 M. GAL.

 \bigcirc

	$\underline{\vee \vee}$	<u> </u>
DESIGNATED LOCAL DETOUR ROUTE	LCULATED WWM HECKED	-
IN ADDITION TO THE OFFICIAL, SIGNED DETOUR ROUTE, A LOCAL ROUTE HAS BEEN DETERMINED TO BE THE SECONDARY, UNSIGNED DETOUR ROUTE OF "DESIGNATED LOCAL DETOUR ROUTE". THIS ROUTE I SHOWN ON SHEET NO. 6. DURING THE TIME THAT TRAFFIC IS DETOURED, THE CONTRACTOR SHALL MAINTAIN THIS ROUTE IN A CONDITION WHICH IS REASONABLY SMOOTH AND FREE FROM HOLES, RUTS, RIDGES, BUMPS, DUST AND STANDING WATER. ONCE THE DETOUR IS REMOVED AND TRAFFIC RETURNED TO ITS NORMAL PATTERN, THE DESIGNATED LOCAL DETOUR ROUTE SHALL BE RESTORED TO A CONDITION THAT IS EQUIVALENT TO THAT WHICH EXISTED PRIOR TO ITS USE FOR THIS PUPPOSE. ALL SUCH WORK SHALL BE PERFORMED WHEN AND AS DETERMINED BY THE ENGINEER.	NOTES	
THE FOLLOWING ESTIMATED QUANTITIES ARE PROVIDED FOR USE AS DETERMINED BY THE ENGINEER TO MAINTAIN AND SUBSEQUENTLY RESTORE THE DESIGNATED LOCAL DETOUR ROUTE.	NERAL	
ITEM 614, ASPHALT CONCRETE FOR MAINTAINING TRAFFIC 90 CU. YD. ITEM 642, CENTER LINE .38 MILE ITEM 616, WATER 50 M. GAL. ITEM 617, WATER 1 M. GAL.	FIC GE	•
NOTE: 90 CU. YD. IS ENOUGH TO REPAIR ROUGHLY 25% OF A 12″ SECTION OF THE "LOCAL" UNSIGNED ROUTE (OLENTANGY RIVER RD.) FOR 1.5″ DEPTH PAVEMENT REPAIR.	ENANCE OF TRAF	
	MAINT	
	FRA-315-11.66	
DATE DESCRIPTION 1/31/23 ADDED SHEET	(7-A 30	_ }

	UNIT	GRAND	ITEM	ITEM	PART.	 				JM.	EET NU	SH					
		TOTAL	ЕХТ		01/NHS/ PV				8		74		5		4		
CLEARING AND GRUBBING		LS	11000	201	LUMP												
	CY												202				
APPROACH SLAB REMOVED GUARDRAIL REMOVED	SY FT	202 443	22900 38000	202 202	202 443								202 443				
SUBGRADE COMPACTION	SY	202	10000	204	202								202				
GUARDRAIL, TYPE MGS MGS BRIDGE TERMINAL ASSEMBLY, TYPE		343 4	15050 35002	606 606	343 4								343 4				
	2/10/1		00002		,								,				
TIED CONCRETE BLOCK MAT WITH TYPE	SY	181	21060	601	181								181				
SOIL ANALYSIS TEST	EACH	2	00100	659	2										2		
TOPSOIL SEEDING AND MULCHING	CY SY	73 654	00300 10000	659 659	73 654										73 654		
COMMERCIAL FERTILIZER	TON	0.09	20000	659	0.09										0.09		
LIME	ACRE	2	31000	659	2										2		
WATER		4	35000	659	4										4		
EROSION CONTROL	EACH	20,000	30000	832	20,000										20,000		
PAVEMENT PLANING, ASPHALT CONCRET	SY	579	01000	254	579								579				
AGGREGATE BASE	СҮ	34	20000	304	34								34				
NON-TRACKING TACK COAT	GAL	64	20000	407	64								64				
ASPHALT CONCRETE SURFACE COURSE,	CY	21	50000	441	21								21				
CURB, TYPE 4-C	FT	25	24510	609	25								25				
BARRIER REFLECTOR, TYPE 2 (BIDIREC)	EACH	8	00110	626	8								8				
EDGE LINE, 6″ CENTER LINE	MILE MILE	0.3 0.15	10010 10200	646 646	0.3 0.15								0.3 0.15				
LANE ARROW		7	20300	646	7								7				
BIKE LANE SYMBOL MARKING	EACH	6	20600	646	6								6				
STRUCTURE OVER 20																	
STRUCTURE GENERAL SUMMARY																	
MA																	
LAW ENFORCEMENT OFFICER WITH PATR	HOUR	40	11110	614	40				40								
DETOUR SIGNING ASPHALT CONCRETE FOR MAINTAINING	CY		12420 13000	614 614	LUMP 90	 ~~~~~	~~~~~~	~~~~~~~~~~~~~~~~~~~~~~~~~~~~~~~~~~~~~~~	LUMP	~~~~~~	90		~~~~~~~~~~~~~~~~~~~~~~~~~~~~~~~~~~~~~~~	~~~~~			
															•		
WATER WATER	MGAL MGAL	50 1	10000 25000	616 617	50 1						50 1				•		
					,												
CENTER LINE, TYPE 1A	MILE	0.38	00310	642	0.38						0.38						
																2	
MAINTAINING TRAFFIC		LS	11000	614	LUMP												
FIELD OFFICE, TYPE A	MNTH	4	16000	619	4										•		
CONSTRUCTION LAYOUT STAKES AND SU		LS	10000	623	LUMP												
MOBILIZATION		LS	10000	624	LUMP												
					_ = =											1 8	

 \bigcirc

 \bigcirc

 \bigcirc

DESCRIPTION	SEE Sheet No.	CALCULATED KSJ CHECKED BBB
ROADWAY		
ROADWAY E ADWAY E 1 EROSION CONTROL E 2 UNDERLAYMENT E 2 UNDERLAYMENT PAVEMENT TE (1 1/4") TYPE 1, (448), PG64-22 TIONAL)		GENERAL SUMMARY
20 FOOT SPAN (FRA-315-1166, SFN 2515903)	18	
IAINTENANCE OF TRAFFIC		
ROL CAR FOR ASSISTANCE		
TRAFFIC		ဖ
		FRA-315-11.66
		15
		က်
INCIDENTALS		Ā
		FR,
CURVEYING DATE DESCRIPTION 1 1/31/23 ITEM NO. & DESC. CHANGE		(10)
△ 2/3/23 ITEMS ADDED. ROWS SHIFTED		$\left(\begin{array}{c}10\\30\end{array}\right)$
2		

STANDARD DRAWINGS AND SUPPLEMENTAL SPECIFICATIONS:

REFER TO THE FOLLOWING STANDARD BRIDGE DRAWING(S):

A-1-20	REVISED	07-17-20
AS-1-15	REVISED	07-17-15
EXJ-4-87	REVISED	01-19-18
GSD-1-19	REVISED	01-15-21
SBR-1-20	DATED	07-17-20
VPF -1-90	REVISED	07-20-18

AND TO THE FOLLOWING SUPPLEMENTAL SPECIFICATION(S):

848 DATED 01-15-21

DESIGN SPECIFICATIONS:

THIS STRUCTURE CONFORMS TO "STANDARD SPECIFICATIONS FOR HIGHWAY BRIDGES" ADOPTED BY THE AMERICAN ASSOCIATION OF STATE HIGHWAY AND TRANSPORTATION OFFICIALS, 17TH EDITION 2002, AND THE 2020 ODOT BRIDGE DESIGN MANUAL.

DESIGN DATA:

CONCRETE CLASS QC2 - COMPRESSIVE STRENGTH, 4.5 KSI (SUPERSTRUCTURE)

CONCRETE CLASS QC5 - COMPRESSIVE STRENGTH, 4.5 kSI (SUPERSTRUCTURE PATCHING)

STRUCTURAL STEEL - A709, GRADE 50, MINIMUM YIELD STRENGTH 50 kSI

REINFORCING STEEL - ASTM A615 OR A996, GRADE 60, MINIMUM YIELD STRENGTH 60 KSI

DESIGN LOADING:

HI - 9.3

NO FUTURE WEARING SURFACE

DECK PROTECTION METHOD:

2" SUPERPLASTICIZED DENSE CONCRETE OVERLAY

EXISTING STRUCTURE VERIFICATION

DETAILS AND DIMENSIONS SHOWN ON THESE PLANS PERTAINING TO THE EXISTING STRUCTURE HAVE BEEN OBTAINED FROM THE PLANS OF THE EXISTING STRUCTURE AND FROM FIELD OBSERVATIONS AND MEASURMENTS. CONSEQUENTLY, THEY ARE INDICATIVE OF EXISTING STRUCTURE AND THE PROPOSED WORK BUT THEY SHALL BE CONSIDERED TENTATIVE AND APPROXIMATE. THE CONTRACTOR IS REFERRED TO C&MS SECTIONS 102.05 AND 105.03. BASE CONTRACT BID PRICE UPON A RECOGNITION OF THE UNCERTAINTIES DESCRIBED ABOVE AND UPON A PREBID EXAMINATION OF THE EXISTING STRUCTURE. HOWEVER, THE DEPARTMENT WILL PAY FOR ALL PROJECT WORK BASED UPON ACTUAL DETAILS AND DIMENSIONS THAT HAVE BEEN VERIFIED IN THE FIELD.

ITEM 510 - DOWEL HOLES WITH NONSHRINK, NONMETALLIC GROUT, AS PER PLAN

PRIOR TO DRILLING DOWEL HOLES, LOCATE ALL EXISTING REINFORCING STEEL BARS IN THE AREA OF THE HOLE WITH THE AID OF A REINFORCING STEEL DARS IN THE AREA OF THE HOLE WITH THE AID OF A REINFORCING STEEL BAR LOCATOR (PACHOMETER). IF AN EXISTING BAR IS ENCOUNTERED AT THE SAME LOCATIONAS A PROPOSED DOWEL HOLE, MOVE THE DOWEL HOLE TO EITHER SIDE OF THE EXISTING BAR.

PAYMENT FOR ALL LABOR, EQUIPMENT, AND MATERIALS REQUIRED TO PERFORM THE WORK OUTLINED ABOVE SHALL BE INCLUDED IN THE EACH CONTRACT PRICE FOR ITEM 510, DOWEL HOLES WITH NONSHRINK, NONMETALLIC GROUT, AS PER PLAN, UNLESS SEPARATELY ITEMIZED IN THE PLANS.

SEE SHEET 5/17 FOR ESTIMATED QUANTITIES

REINFORCING STEEL, REPLACEMENT OF EXISTING REINFORCING STEEL, AS PER PLAN:

THE BAR SIZE NUMBER IS SPECIFIED ON THE PLANS IN THE BAR MARK COLUMN. THE FIRST DIGIT WHERE THREE DIGITS ARE USED AND THE FIRST TWO DIGITS WHERE FOUR ARE USED, INDICATES THE BAR SIZE NUMBER. FOR EXAMPLE, W601 IS A NO. 6 BAR. BAR DIMENSIONS SHOWN ARE OUT TO OUT UNLESS OTHERWISE INDICATED. R INDICATES INSIDE RADIUS, UNLESS OTHERWISE NOTED. "STD", WRITTEN IN PLACE OF A DIMENSION INDICATES A STANDARD BEND AT THE END OF THE BAR.

ALL REINFORCING STEEL TO BE EPOXY COATED.

ITEM 202 - PORTIONS OF STRUCTURE REMOVED, OVER 20 FOOT SPAN. AS PER PLAN

DESCRIPTION:

THIS WORK CONSISTS OF THE REMOVAL OF PORTIONS OF THE CONCRETE DECK EDGES, DECK ENDS, ABUTMENTS, THE EXISTING SLIDING PLATE JOINTS, END CROSSFRAMES AND SCUPPERS. THE PROVISIONS OF ITEM 202 APPLY EXCEPT AS SPECIFIED BY THE FOLLOWING NOTES. PERFORM WORK CAREFULLY DURING DECK REMOVALS TO PROTECT PORTIONS OF SUCH SYSTEMS THAT ARE TO BE SALVAGED AND INCORPORATED INTO THE PROPOSED STRUCTURE. THE USE OF EXPLOSIVES, HEADACHE BALLS AND/OR HOE RAM TYPE OF EQUIPMENT IS PROHIBITED. SUBMIT CONSTRUCTION PLANS ACCORDING TO C&MS 501.05.

CUT LINE JOINT PREPARATION:

CUI LINE JOINT PREPARATION: SAW CUT BOUNDARIES OF PROPOSED CONCRETE REMOVALS I INCH DEEP. REMOVE CONCRETE TO A ROUGH SURFACE. LEAVE THE EXISTING REINFORCING STELL, IF REQUIRED IN THE PLANS, IN PLACE. INSTALL DOWEL BARS IF SPECIFIED. PRIOR TO CONCRETE PLACEMENT ABRASIVELY CLEAN JOINT SURFACES AND EXISTING EXPOSED REINFORCEMENT TO REMOVE LOOSE AND EXISTING EXPOSED REINFORCEMENT TO REMOVE LOOSE AND DISINTEGRATED CONCRETE AND LOOSE RUST. THROUGHLY CLEAN THE JOINT SURFACE AND EXPOSED REINFORCEMENT OF ALL DIRT, DUST, RUST OR OTHER FOREIGN MATERIAL BY THE USE OF WATER, AIR UNDER PRESSURE, OR OTHER METHODS THAT PRODUCE SATISFACTORY RESULTS. EXISTING REINFORCING STEEL DOES NOT HAVE TO HAVE A BRIGHT STEEL FINISH, BUT REMOVE ALL PACK AND LOOSE RUST. THROUGHLY DRENCH EXISTING CONCRETE SURFACES WITH CLEAN WATER AND ALLOW TO DRY TO A DAMP CONDITION BEFORE PLACING CONCRETE.

REMOVAL METHODS:

THE CONTRACTOR MAY REMOVE CONCRETE BY CUTTING AND BY MEANS OF HAND OPERATED PNEUNATIC HAMMERS EMPLOYING POINTED OR BLUNTED CHISEL TYPE TOOLS. FOR REMOVALS OVER STRUCTURAL MEMBERS, THE CONTRACTOR MAY USE A HAMMER HEAVIER THAN 35 POUNDS BUT NOT TO EXCEED 90 POUNDS UNELSS APPROVED BY THE ENGINEER. REMOVAL METHODS OVER STRUCTURAL MEMBERS SHALL ENSURE ADEQUATE DEPTH CONTROL AND PREVENT NICKING OR GOUGING THE PRIMARY STRUCTURAL MEMBERS.

DECK EDGE REMOVAL ALONG THE EXPANSION JOINT SHALL PRESERVE THE EXISTING REINFORCING STEEL BARS. IF REQUIRED FOR PROPER FIT UP OF THE PROPOSED EXPANSION JOINT THE EXISTING REINFORCING STEEL BARS MAY BE TRIMMED WITH APPROVAL FROM THE ENGINEER.

IF AN EXISTING REINFORCING STEEL BAR IS DAMAGED OR DETERMINED UNUSEABLE BY THE ENGINEER, THEN IT SHALL BE REPLACED BY THE USE OF A MECHANICAL CONNECTOR AND A REINFORCING STEEL BAR OF THE SAME SIZE AND LENGTH THAT WAS DAMAGED AT NO ADDITIONAL COST TO THE DEPARTMENT.

THE EXISTING BEAM ENDS SHALL HAVE A MINIMUM OF 3 INCHES OF CLEARANCE FROM THE EXISTING BACKWALL. IF THERE IS LESS THEN 3 INCHES OF CLEARANCE, THE EXISTING BEAM ENDS SHALL BE TRIMMED TO ALLOW FOR A MINIMUM OF 3 INCHES OF CLEARANCE.

THE EXISTING BRIDGE RAILING AND TERMIAL ASSEMBLY MAY BE REMOVED IF NEEDED TO COMPLETE THE PROPOSED WORK. THE REMOVAL SHALL BE DONE IN MANNER AS NOT TO DAMAGE THE EXISTING RAILING.

MEASURMENT & PAYMENT:

THE DEPARTMENT WILL MEASURE THE QUANTITY OF REMOVALS ON A LUMP SUM BASIS. THE DEPARTMENT WILL PAY FOR THE ACCEPTED QUANTITIES OF REMOVAL AT THE CONTRACT PRICE FOR ITEM 202, PORTIONS OF STRUCTURE REMOVED, AS PER

ITEM 516 - REFURBISHING BEARING DEVICES, AS PER PLAN

THIS ITEM SHALL INCLUDE ALL WORK NECESSARY TO PROPERLY ALIGN BRIDGE BEARINGS AS WELL AS THEIR CLEANING AND PAINTING. INCLUDED SHALL BE THE DISASSEMBLY OF THE BEARINGS, HAND TOOL CLEANING (GRINDING IF NECESSARY), PAINTING ACCORDING TO ITEM 514, REPLACEMENT OF ANY DAMAGED SHEET LEAN WITH PERFORMED BEARING PADS (C&MS 711.211

INSTALLATION OF ANY NECASSARY STEEL SHIMS OF THE SAME OF THE UPPER BEARINGS PLATE BY REMOVING EXISTING WELDS AND REWELDING SO THAT THE BEARING ARE VERTICALLY ALIGNED AT 60°F, LUBRICATING SLIDING SURFACES, AND REASSEMBLY OF BEARINGS. ASSURE ALL BEARINGS ARE SHIMMED ADEQUATELY AND THAT NO BEAMS AND/OR BEARING DEVICES ARE "FLOATING". AT NO ADDITIONAL COST TO THE STATE, THE CONTRICTOR WITH A THE DEADNOS OF THE STATE, THE CONTRACTOR MAY INSTALL NEW BEARINGS OF THE SAME TYPE AS THE EXISTING IN PLACE OF REFURBISHING THE BEARINGS. ALL WORK SHALL BE TO THE SATISFACTION OF THE ENGINEER.

PAYMENT FOR ALL OF THE ABOVE DESCRIBED LABOR AND MATERIALS WILL BE MADE AT THE CONTRACT PRICE BID FOR ITEM 516 - REFUSBISHED BEARING DEVICES, AS PER PLAN EACH.

SEE SHEET 5/17 FOR QUANTITIES.

ITEM 516 - JACKING AND TEMPORARY SUPPORT OF SUPERSTRUCTURE, AS PER PLAN

THIS WORK CONSISTS OF RAISING OR RE-POSITIONING EXISTING STRUCTURES TO THE DIMENSIONS AND REQUIREMENTS DEFINED IN THE PROJECT PLANS.

SUBMIT CONSTRUCTION PLANS IN ACCORDANCE WITH C&MS 501.05. MAXIMUM DIFFERENTIAL JACKING HEIGHT TO $\frac{1}{8}$ INCH BETWEEN ADJACENT BEAM LINES.

IF, DURING THE JACKING OPERATIONS, CRACKING OF THE CONCRETE SUPERSTRUCTURE, SEPARATION OF THE CONCRETE DECK FROM THE STEEL STRINGERS, OR OTHER DAMAGE TO THE STRUCTURE IS VISUALLY OBSERVED, IMMEDIATELY CEASE THE JACKING OPERATION AND INSTALL SUPPORTS TO THE CALIFORMED OF THE DEVELOPMENT OF THE DAMAGE AND SATISFACTION OF THE ENGINEER. ANALYZE THE DAMAGE AND SUBMIT A METHOD OF CORRECTION TO THE ENGINEER FOR APPROVAL. EPOXY INJECT ALL BEAMS THAT SEPARATE FROM THE APPROVAL. EPOXY INJECT ALL BEAMS THAT SEPARATE FROM THE DECK FOR THE DISTANCE OF THE SEPARATION IN ACCORDANCE WITH C&MS 512.07. THE DEPARTMENT WILL NOT PAY FOR THE COST OF THIS EPOXY INJECTION OR OTHER REQUIRED REPAIRS. THE BRIDGE BEARINGS SHALL BE FULLY SEATED AT ALL CONTACT AREAS. IF FULL SEATING IS NOT ATTAINED, SUBMIT A REPAIR PLAN TO THE ENGINEER. THE DEPARTMENT WILL NOT PAY FOR THE REPAIR COSTS TO ENSURE FULL SEATING ON BEARINGS

THE DEPARTMENT WILL MEASURE THIS WORK ON A LUMP SUM BASIS.

THE DEPARTMENT WILL PAY FOR THE ACCEPTED QUANTITIES AT THE CONTRACT PRICE FOR ITEM 516, JACKING AND TEMPORARY SUPPORT OF THE SUPERSTRUCTURE, AS PER PLAN.

ITEM 607 - VANDAL PROTECTION FENCE 6' STRAIGHT, COATED FABRIC, AS PER PLAN

ALL FENCE POSTS, RAILS, BASEPLATE, POST SLEEVES, TENSION BANDS, TRUSS RODS, FABRIC TIES AND ALL OTHER VIABLE PORTIONS OF FENCE NOT LISTED SHALL BE PLACK PVC COATED.

THE MOUNTING BASE PLATE AND SLEEVE SHALL BE BP-5 PER STANDARD DRAWING VPF-1-90. SEE STRUCTURES PLANS FOR POST SPACING ON THE BRIDGE.

ITEM 519 - PATCHING CONCRETE STRUCTURE, AS PER PLAN:

A QUANTITY OF 50 SF WAS ESTIMATED AT EACH ABUTMENT AND A QUANTITY OF 25 SF WAS ESTIMATED AT THE PIERS.

 \bigcirc

 \bigcirc

ITEM 516 - STRUCTURAL EXPANSION JOINT, AS PER PLAN: THIS ITEM SHALL INCLUDE ALL WORK NECESSARY TO PROPERLY PLACE THE STRUCTURAL EXPANSION JOINT (I.E. STEEL RETAINERS, SUPPORT ANGLES, CHANNEL AND ANCHOR BARSJ, GUSSET PLATES AND INSTALL THE ELASTOMERIC STRIP SEAL AS SHOWN ON SHEET 9/16 AND STANDARD BRIDGE DRAWING EXJ-4-87 AND GSD-1-96. ALL STRUCTURAL STEEL MEMBERS SHALL BE LEVEL UF AND ALL REQUIREMENTS OF 513 APPLY TO SHOP FABRICATED MEMBERS. PERFORM WORK FOR FIELD FABRICATED MEMBERS ACCORDING TO ITEM 513, EXCEPT AS MODIFIED HEREIN. THE DEPARTMENT WILL NOT REQUIRE THE CONTRACTOR PERFORMING FIELD FABRICATION TO BE PRE-OUALIFIED AS SPECIFIED IN SUPPLEMENT 1078. SUBMIT A WRITTEN LETTER OF MATERIAL ACCEPTANCE, 501.06, TO THE ENGINEER. PROVIDE SHOP DRAWINGS ACCORDING TO THE ENGINEER REY OWNED SOME THE SUBMITTED DRAWINGS FOR CONCURRENCE WITH THE FINAL AS-BUILT CONDITION. IF NECESSARY, THE ENGINEER MAY CONTACT THE OFFICE OF STRUCTURAL ENGINEER MAY CONTACT THE OFFICE OF STRUCTURAL SUPPLY A COPY OF THE DRAWINGS AND THE DELIVERED MATERIALS, SUPPLY A COPY OF THE DRAWINGS, TO THE STRUCTURAL, WELDING AND METALS SECTIONS OF THE OFFICE OF MATERIAL MANAGEMENT FOR RECORD PURPOSES. PAYMENT FOR ALL EQUIPMENT, MATERIALS, AND LABOR REQUIRED	DESIGNED DRAWN REVIEWED DATE DATE JGM JGM NCK 2/3/23 Base Bescurce International INC. JGM JGM NCK 2/3/23 Base Bescurce International INC. CHECKED REVISED STRUCTURE FILE NUMBER Base Columbus, OHIO 43231 MMS 2515903 2515903 Base Base Base
ASSESSMENT. TREPARE THE DAMAGED MATERIAL FOR WELDING, PROVIDE RUNOFF TABS FOR ALL COMPLETE PENETRATION WELDS. PERFORMING COMPLETE PENETRATION WELDS ACCORDING TO C&MS 513 USING APPROVED ELECTRODES, PROCEDURES AND WELDERS. REMOVE RUNOFF TABS AND GRIND THE COMPLETED EDGES SMOOTH. GRIND THE COMPLETED WELDS SMOOTH AND FLUSH WITH THE ADJACENT SURFACES TO PROVIDE A SURFACE FINISH ACCORDING TO ANSI B46.1 OF 250 MIL. DO NOT OVER GRIND AS TO REDUCE THE MATERIAL THICKNESS OR WIDTH OF THE NEW OR EXISTING MATERIALS. PREPARE ALL REENTRANT CORNERS WITH A ONE INCH RADIUS. REMOVE WELDING, START AND STOP DISCONTINUITIES. RADIOGRAPHIC TEST THE FINISHED WELDS ACCORDING TO C&MS 513.25A AND SUBMIT COPIES OF THE REPORTS TO THE ENGINEER. THE ENGINEER MAY OBTAIN TECHNICAL ASSISTANCE FROM THE OFFICE OF MATERIALS; TOOLS; LABOR; EQUIPMENT; AND INCIDENTALS NECESSARY TO COMPLETE THE ABOVE WORK FOR PAYMENT WITH ITEM 513 - STRUCTURAL STEEL MISC., REPAIR OF DAMAGED MAIN MEMBERS, COMPLETE PENETRATION WELDING. FOOT.	GENERAL NOTES BRIDGE NO. FRA-315-1166C WILSON BRIDGE ROAD OVER SR 315
DATE DESCRIPTION 2/3/23 ADDED NOTE 2/3/23 UPDATED NOTE	215 - 011 210 - 315 - 011 210 No. 104980

ESTIMATED QUANTITIES


DESIGNED BY: JGM CHECKED BY: MMS

		•		1	1				
	ITEM	EXT.	QUANTITY	UNIT	DESCRIPTION	ABUT.	SUPER.	PIERS	GEN
	202	11203	LUMP	LUMP	PORTIONS OF STRUCTURE REMOVED, AS PER PLAN				
	509	10000	71,071	POUND	EPOXY COATED REINFORCING STEEL	3,409	67,662		
	509	20001	711	POUND	REINFORCING STEEL, REPLACEMENT OF EXISTING REINFORCING STEEL, AS PER PLAN		711		
	510	10001	1,804	EACH	DOWEL HOLES WITH NONSHRINK, NONMETALLIC GROUT, AS PER PLAN	1,548	256		
	511	34447	115	CU YD	CLASS OC2 CONCRETE WITH OC/OA, BRIDGE DECK, AS PER PLAN		115		
	511	34448	168		CLASS OC2 CONCRETE. BRIDGE DECK (PARAPET)		168		
	511	43512	15	CU YD	CLASS OCI CONCRETE, WITH OC/QA ABUTMENT INCLUDING FOOTING	15	100		
		15512	10	00 10		10			
	512	10100	1,317	SQ YD	SEALING OF CONCRETE SURFACES (EPOXY-URETHANE)	134	1,183		
	512	33000	44	SQ YD	TYPE 2 WATERPROOFING		44		
、~	\sim	\sim	\sim	\sim		$\uparrow \uparrow \uparrow \uparrow \uparrow$	$\uparrow \uparrow \uparrow \uparrow \uparrow$	\sim	\sim
3	513	10260	1,580	POUND	STRUCTURAL STEEL MEMBERS, LEVEL 3		1,580		
ح.	513	95000	8	FT	STRUCTURAL STEEL, MISC.: REPAIR OF DAMAGED MAIN MEMBER, COMPLETE PENETRATION WELDING		8		
	0.0				A strade to that street, muse to the part the part of				
								\sim	\sim
C	514	21000	LUMP	LUMP	FIELD PAINTING OF DAMAGED STRUCTURAL STEEL		LUMP		
C,	SPECIAL	514E80100	196	SF	SHOP PAINTING OF STRUCTURAL STEEL		196		
									\sim
	516	12201	75	FT	STRUCTURAL STEEL EXPANSION JOINT, AS PER PLAN		75		
	516	45305	8	EACH	REFURBISH BEARING DEVICE, AS PER PLAN		8		
	516	47001	LUMP	LUMP	JACKING AND TEMPORARY SUPPORT OF THE SUPERSTRUCTURE. AS PER PLAN		LUMP		
	518	21200	6	CU YD	POROUS BACKFILL WITH GEOTEXTILE FABRIC	6			
	519	11101	125	SQ FT	PATCHING CONCRETE STRUCTURE, AS PER PLAN	100		25	
	526	25000	201	SQ YD	REINFORCED CONCRETE APPROACH SLABS (T=15")		201		
	SPECIAL	530E01300	17.752	FT	NO. 4 GFRP DEFORMED BARS		17,752		
	SPECIAL	550201500	11,152		NO. 4 GERT DEFORMED BARS		11,152		
	601	20000	310	SQ YD	CRUSHED AGGREGATE SLOPE PROTECTION		310		
		20000	0.0						
	607	39901	580	FT	VANDAL PROTECTION FENCE, 6' STRAIGHT, COATED FABRIC, AS PER PLAN				580
	848	10200	2,132	SQ YD	SUPERPLASTICIZED DENSE CONCRETE OVERLAY USING HYDRODEMOLITION (2" THICK)				2,132
	848	20000	2,132	SQ YD	SURFACE PREPARATION USING HYDRODEMOLITION				2,132
	848	30200	36	CU YD	SUPERPLASTICIZED DENSE CONCRETE OVERLAY (VARIABLE THICKNESS), MATERIAL ONLY				36
	848	50000	64	SQ YD	HAND CHIPPING				64
	848	50100	LUMP	LUMP	TEST SLAB				LUMP
	0.40	50000	15						15
	848	50200	15	CU YD	FULL-DEPTH REPAIR				15
	848	50320	1,977	SQ YD	EXISTING CONCRETE OVERLAY REMOVED (1 1/4" THICK) REMOVAL OF DEBONDED OR DETERIORATED EXISING VARIABLE THICKNESS CONCRETE OVERLAY				1,977
	848	50340	640	SQ YD	TEMOVAL OF DEDONDED OF DETERIORATED EXISING VARIADLE THICKNESS CONCRETE OVERLAT				640
		1		1		1			

0


 \bigcirc


 \bigcirc

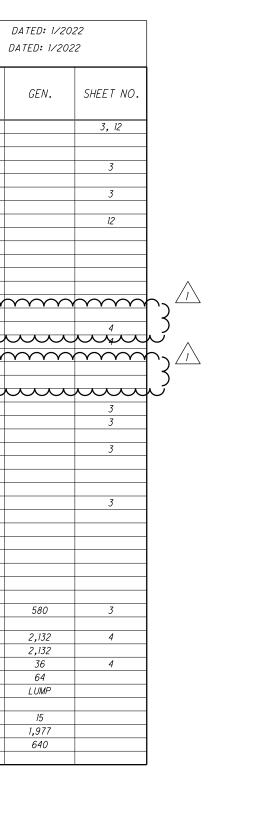

\wedge	DATE	DESCRIPTION
/1	2/3/23	UPDATED QUANTITIES
	2/3/23	ADDED ITEM 513E9500 & 514E21000

		SJILILNUIU UJLVWILSJ	DESIGNED	DRAWN	DRAWN REVIEWED DATE	(
	FRA - 315 - 011		JGM	JGM	NCK 1/18/22	r	RESOURCE INTERNATIONAL INC. 6350 PRESIDENTIAL CATEWAY
7		BKIDGE NO. FKA-315-1166C	CHECKED	REVISED	REVISED STRUCTURE FILE NUMBER		COLUMBUS, OHIO 43231
01 17	PID No. 104980	WILSON BRIDGE ROAD OVER SR 315	MMS		2515903		(614) 823-4949

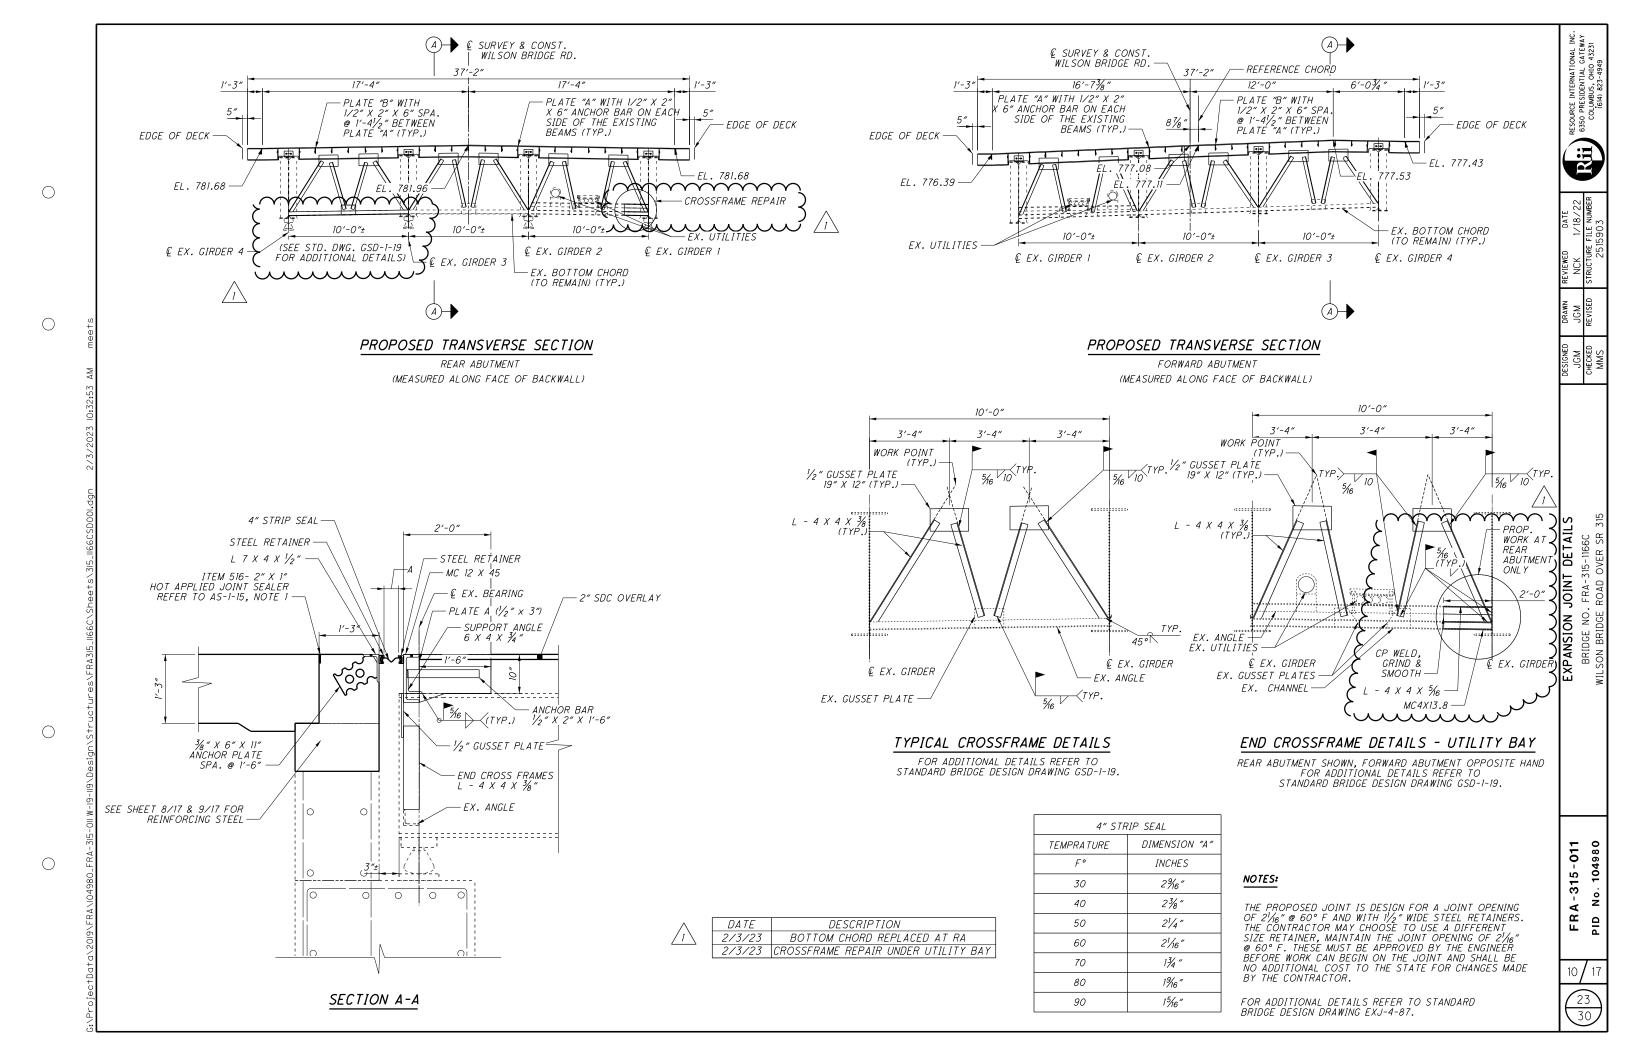

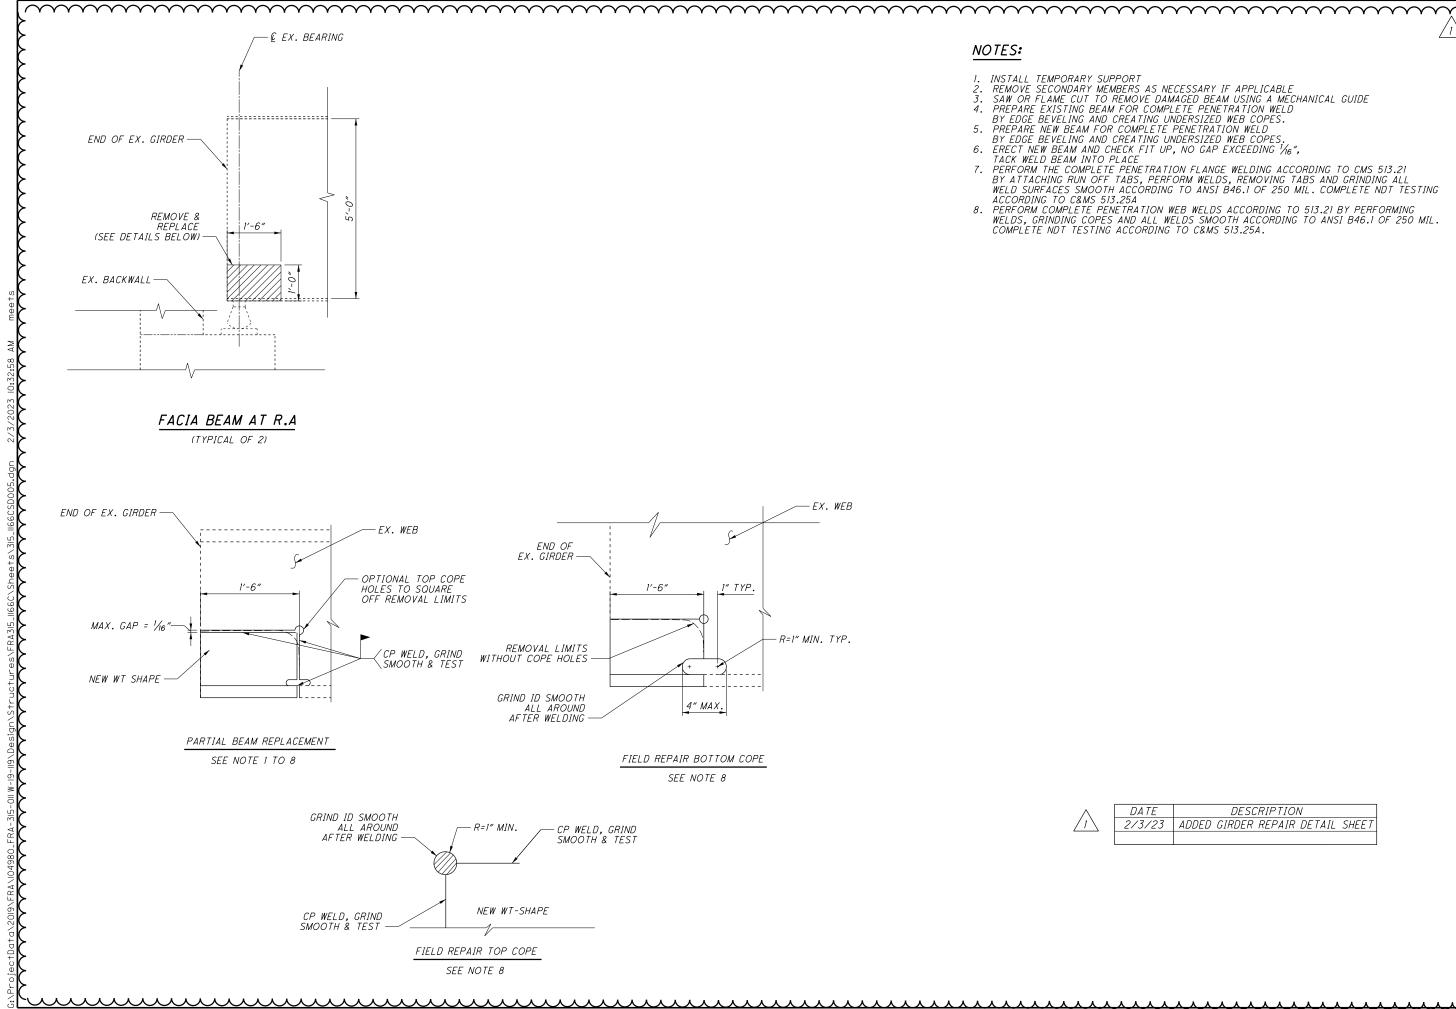

 \bigcirc

 \bigcirc

 \bigcirc

 \bigcirc

INSTALL TEMPORARY SUPPORT
REMOVE SECONDARY MEMBERS AS NECESSARY IF APPLICABLE
SAW OR FLAME CUT TO REMOVE DAMAGED BEAM USING A MECHANICAL GUIDE
PREPARE EXISTING BEAM FOR COMPLETE PENETRATION WELD BY EDGE BEVELING AND CREATING UNDERSIZED WEB COPES.
PREPARE NEW BEAM FOR COMPLETE PENETRATION WELD BY EDGE BEVELING AND CREATING UNDERSIZED WEB COPES.
ERECT NEW BEAM AND CREATING UNDERSIZED WEB COPES.
ERECT NEW BEAM AND CHECK FIT UP, NO GAP EXCEEDING ¹/₁₆", TACK WFID REAM INTO PLACE

DATE	DESCRIPTION	
2/3/23	ADDED GIRDER REPAIR DETAIL SHEET	T
		_

10		GIRDFR REPAIR DETAII S - REAR ABUTMENT	DESIGNED	DRAWN	DESIGNED DRAWN REVIEWED DATE	
23 23	FRA-315-011		MMS	MMS	SSK 1/18/22	RESOURCE INTERNATIONAL INC.
		BRIDGE NO. FRA-SIS-IIBOC	CHECKED	REVISED	CHECKED REVISED STRUCTURE FILE NUMBER	COLUMBUS. OHIO 43231
)	PID No. 104980	WILSON BRIDGE ROAD OVER SR 315	JWE		2515903	(614) 823-4949