

SHEET INDEX

TITLE SHEET	1
SHEET INDEX, ENGINEERS SEALS & CITY OF COLUMBUS SIGNATURES	2
PLAN LEGEND & DESIGN DESIGNATIONS	3
SCHEMATIC PLAN	4 - 7
GEOMETRIC PLAN	8 - 12
CURVE DATA	13 - 16
REFERENCE POINTS AND BENCHMARKS	17
CONTROL POINT KEY MAP	18
INTERSECTION DATA TABLE	19
TYPICAL SECTIONS	20 - 52
GENERAL NOTES	53 - 69, 66A, 67A, 68A, 69A, 69B
SUMMARY OF 4R PART 1 / 6R PART 2	
MOT SEQUENCING	69C
MAINTENANCE OF TRAFFIC	70 - 210, 71A, 71B, 78A, 81A, 102A, 159A-159C, 189A - 189P
GENERAL SUMMARY	211 - 218
SUBSUMMARIES	219 - 229, 225A
ESTIMATED QUANTITIES	230 - 255, 252A, 252B
CALCULATIONS	256 - 260
PROJECT SITE PLAN	261 - 264
PLAN AND PROFILE - I-70 EB	265 - 303
PLAN AND PROFILE - I-71 NB	304 - 315
PLAN AND PROFILE - RAMP A5	316 - 323
PLAN AND PROFILE - FUTURE RAMP B5	324
PLAN AND PROFILE - RAMP C3	325 - 330
PLAN AND PROFILE - RAMP C5	331 - 361
PLAN AND PROFILE - RAMP C6	362 - 367
PLAN AND PROFILE - FRONT STREET	368 - 369
PLAN AND PROFILE - FULTON STREET	370 - 371
PLAN AND PROFILE - MOUND STREET	372 - 373
PLAN AND PROFILE - LIVINGSTON AVENUE	374 - 376
PLAN - SOUDER AVENUE	377
CROSS SECTION LAYOUT SHEET	378 - 383
CROSS SECTIONS - I-70 EB	384 - 423
CROSS SECTIONS - I-70 WB	424 - 429
CROSS SECTIONS - I-71 NB	430 - 444
CROSS SECTIONS - RAMP A5	445 - 455

CROSS SECTIONS - RAMP C3	456 - 462
CROSS SECTIONS - RAMP C5	463 - 500
CROSS SECTIONS - FRONT STREET	501 - 505
CROSS SECTIONS - FULTON STREET	506 - 513
CROSS SECTIONS - LIVINGSTON AVENUE	514 - 522
SUPERELEVATION TABLES	523 - 548
INTERCHANGE DETAILS	549 - 555
INTERSECTION DETAILS	556 - 559
GORE DETAILS	560 - 571
PAVEMENT JOINT DETAILS	572 - 577
PAVER AND CROSSWALK DETAILS	578 - 582
DRIVE DETAILS	583 - 590
PAVEMENT REMOVAL PLANS	626 - 628
RELOCATED BIKE PATH DETAILS	629 - 635
BIKE PATH DETOUR DETAILS	636 - 643, 638A, 643A - 643H, 643J - 643N, 643P, 643R
ROADWAY DETAILS	644 - 664
STORM SEWER PROFILES	665 - 668
DRAINAGE DETAILS	669 - 676, 669A, 669B
UNDERDRAIN DETAILS	677 - 680
TEST HOLE CERTIFICATION FORMS	681 - 691, 691A, 691B
FLOODWALL DETAILS	692 - 697, 694A, 694B
RETAINING WALLS	698 - 711, 703A, 703B
WALL 4W1	712 - 730, 713A, 729A - 729D, 730A
WALL 4W2	731 - 754, 732A, 751A - 751D, 752A, 753A, 754A
WALL 4W4	755 - 763
WALL 4W5 & WALL 4W6	764 - 789, 776A, 776B, 783A, 783B, 786A
WALL 4W7	790 - 803
WALL 4W8	804 - 823
WALL 4W9	824 - 830
WALL 4W10	831 - 834
WALL 4W11	835 - 844
WALL 4W12	845 - 864
WALL 4W20	883 - 888, 883A, 887A
WALLS 4W21A, 4W21B, 4W21C	888A - 888C
TEMPORARY WALLS AND SHORING	889 - 902, 889A, 890A
SANITARY SEWER	903 - 904
WATER WORK	905 - 920
ELECTRICAL/COMMUNICATION	921 - 958, 922A - 922C, 931A, 938A - 938D, 941A, 944A

TRAFFIC CONTROL SIGNALIZATION	959 - 1082, 959A, 960A, 969A, 995A, 1070A, 1082A
ITS PLANS	1083 - 1121, 1096A - 1096H 1122 - 1162, 1143A, 1147A, 1149A, 1154A, 1156A, 1157A, 1161A
LIGHTING	1163 - 1205, 1164A, 1202A, 1203A, 1204A, 1204B, 1205A, 1205B 1206 - 1225
LANDSCAPING	
STRUCTURES (OVER 20' SPAN)	
STRUCTURE DETAILS	1226 - 1227, 1227A - 1227H, 1227J - 1227N
FRA-70-1282R	1228 - 1268
FRA-70-1301A	1269 - 1332
FRA-71-1518A	1333 - 1363, 1361A
FRA-70-1321A	1364 - 1462, 1460A
FRA-70-1343	1462A
FRA-70-1357A	1463 - 1471, 1471A - 1471C
FRA-70-1358A	1472 - 1507, 1473A
FRA-70-1373R	1508 - 1538
FRA-70-1373A	1539 - 1563
FRA-70-1390C	1564 - 1681
FRA-70-1395C	1682 - 1746, 1725A, 1725B
STRUCTURE AESTHETIC DETAILS	1746A - 1746F, 1746H, 1746J - 1746N, 1746P, 1746R
AESTHETIC ENHANCEMENTS	1747 - 1815, 1771A, 1773A - 1773C
SOIL PROFILES	

SHEETS NOT USED: 7, 12, 62, 99, 126, 127, 160, 161, 172, 173, 184, 263, 589, 591-625, 693, 736, 744, 818 - 822, 828, 829, 844, 857-863, 865 - 882, 925, 991, 992, 1747, 1755, 1810

NOTE: RIGHT OF WAY PLANS FOR THIS PROJECT WERE PREPARED AS PART OF PROJECT FRA-70-12.68 PID 77372 / 3084-E AND ARE NOT INCLUDED IN THIS PLAN SET.

NO.	DESCRIPTION	REV. BY	DATE
1	UPDATED SHEETS	CWL	11-5-2021
2	UPDATED SHEETS	CWL	11-12-2021
4	ADDED SHEET	CWL	11-29-2021

CITY OF COLUMBUS:

APPROVED Steven Woods
DATE 5/26/2020 DESIGN SECTION ENGINEER, DIVISION OF DESIGN AND CONSTRUCTION

APPROVED [Signature]
DATE 5/28/2020 ADMINISTRATOR, DIVISION OF POWER

APPROVED [Signature]
DATE 5/28/2020 ADMINISTRATOR, DIVISION OF WATER

APPROVED [Signature]
DATE 5/28/2020 FIRE PREVENTION BUREAU, DIVISION OF FIRE

APPROVED MDT RMV John Newson
DATE 5/28/2020 ADMINISTRATOR, DIVISION OF SEWERAGE AND DRAINAGE

APPROVED Trace Davis by RML
DATE 6/3/2020 DIRECTOR, DEPARTMENT OF PUBLIC UTILITIES

APPROVED Don E. Evans for Paul Rakosky
DATE 5/29/2020 DIRECTOR, DEPARTMENT OF RECREATION AND PARKS





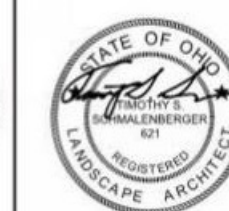

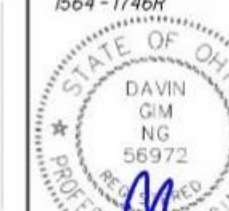
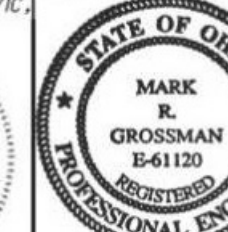
APPROVED James Young
DATE 8/24/2020 CITY ENGINEER/ADMINISTRATOR, DIVISION OF DESIGN AND CONSTRUCTION

APPROVED Jennifer Gallagher
DATE 8/24/2020 DIRECTOR, DEPARTMENT OF PUBLIC SERVICE

APPROVED Brian Midkley
DATE 5/28/2020 ENGINEERING SUPERVISOR, DEPARTMENT OF TECHNOLOGY


CITY OF COLUMBUS APPROVALS

CITY OF COLUMBUS SIGNATURES ON THIS PLAN SIGNIFY ONLY CONCURRENCE WITH THE GENERAL PURPOSES AND GENERAL LOCATION OF THE PROJECT. ALL TECHNICAL DETAILS REMAIN THE RESPONSIBILITY OF THE ENGINEER PREPARING THE PLANS.
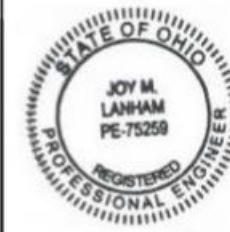
<p>ENGINEERS SEAL:</p> <p>FOR SHEETS 70 - 210</p>  <p>SIGNED: <u>[Signature]</u> DATE: <u>9/6/19</u></p>	<p>ENGINEERS SEAL:</p> <p>FOR SHEETS 804 - 864, 889A - 891, 893 - 900, 905, 922 - 922C, 926 - 930, 938B - 941A</p>  <p>SIGNED: <u>[Signature]</u> DATE: <u>8/16/19</u></p>	<p>ENGINEERS SEAL:</p> <p>FOR SHEETS 1122 - 1162</p>  <p>SIGNED: <u>[Signature]</u> DATE: <u>9/6/19</u></p>	<p>ENGINEERS SEAL:</p> <p>FOR SHEETS 1163 - 1205A</p>  <p>SIGNED: <u>[Signature]</u> DATE: <u>9/6/19</u></p>	<p>ENGINEERS SEAL:</p> <p>FOR SHEETS 1206 - 1225, 1747 - 1815</p>  <p>SIGNED: <u>[Signature]</u> DATE: <u>9/6/19</u></p>	<p>ENGINEERS SEAL:</p> <p>FOR SHEETS 1228 - 1363, 1472 - 1563</p>  <p>SIGNED: <u>[Signature]</u> DATE: <u>9/6/19</u></p>	<p>ENGINEERS SEAL:</p> <p>FOR SHEETS 692 - 803, 865 - 889, 892, 901 - 902, 1364 - 1471C, 1564 - 1746R</p>  <p>SIGNED: <u>[Signature]</u> DATE: <u>9/6/19</u></p>	<p>ENGINEERS SEAL:</p> <p>FOR ENTIRE PLAN EXCEPT SHEETS OTHERWISE NOTED</p>  <p>SIGNED: <u>[Signature]</u> DATE: <u>9/6/19</u></p>
---	--	--	---	---	---	---	---


G:\2012\20120418\FRA\105525\ROADWAY\SHEETS\10552501005.DGN
 7/12/2021
 2:43:06 PM
 DDDTY81STD_USER

CALCULATED ATR CHECKED CWL
SHEET INDEX, ENGINEERS SEALS & COLUMBUS SIGNATURES
 FRA-70/71-12.68/14.86
 2
 1815

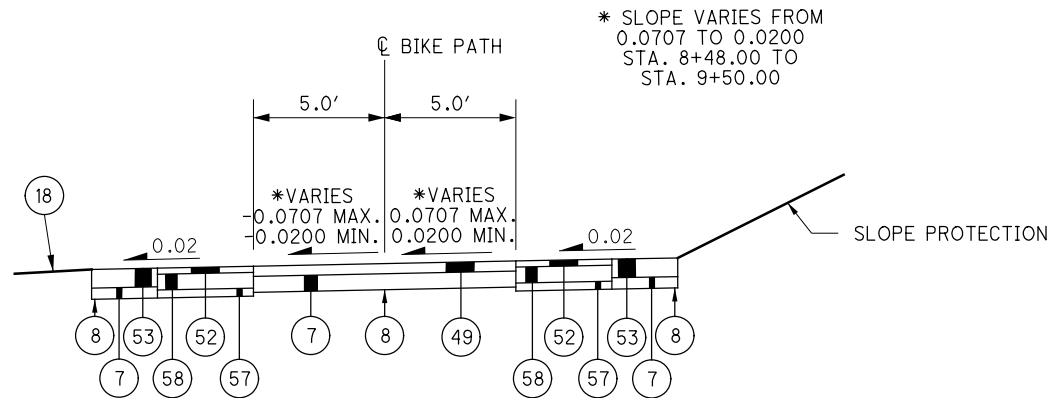

BIKE PATH SECTION

LIMITING STATIONS
STA. 8+48.00 TO STA. 11+53.75

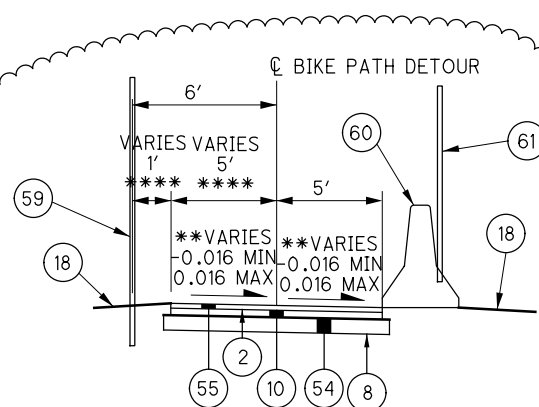

BIKE PATH DETOUR


LIMITING STATIONS
STA. 1+37.10 TO STA. 2+41.62 (SEE NOTE A)
STA. 2+63.67 TO STA. 5+14.72 (SEE NOTE A)
STA. 5+32.66 TO STA. 15+54.32 ***
STA. 19+35.78 TO STA. 22+32.33 ***

** SLOPE:
EXIST. TO -0.016 STA. 1+37.10 TO STA. 1+50.00
-0.016 STA. 1+50.00 TO STA. 2+25.00
-0.016 TO EXIST. STA. 2+25.00 TO 2+41.62
EXIST. TO 0.016 STA. 2+63.67 TO 3+00.00
0.016 STA. 3+00.00 TO STA. 5+00.00
0.016 TO EXIST. STA. 5+00.00 TO STA. 5+14.72
EXIST TO 0.016 STA. 5+32.66 TO 5+50.00
0.016 STA. 5+50.00 TO STA. 13+50.00
0.016 TO -0.016 STA. 13+50.00 TO STA. 14+00.00
-0.016 STA. 14+00.00 TO STA. 15+54.32
-0.016 TO 0.016 STA. 19+35.78 TO STA. 19+50.00
0.016 STA. 19+50.00 TO STA. 22+00.00
0.016 TO EXIST. STA. 22+00.00 TO STA. 22+32.33

*** LIMITS: (59) STA. 13+78.34 TO STA. 15+54.32
STA. 19+35.78 TO STA. 21+46.63
(60) (61) STA. 13+90.50 TO STA. 15+54.32
STA. 19+35.78 TO STA. 21+46.63

NOTE A:
10' ON EACH SIDE OF EXISTING MAIER PLACE
SHALL BE 8" CONCRETE WALK W/ DETECTABLE
WARNING
STA. 2+31.62 TO STA. 2+41.62
STA. 2+63.67 TO STA. 2+73.67

WIDTHS 1' / 5' EXCEPT:
VARIES 1' TO 0' / 5' TO 6'
STA. 13+65.50 TO 13+90.50
0' / 6'
STA. 13+90.50 TO STA. 15+54.32
0' / 6'
STA. 19+35.78 TO STA. 21+46.63
VARIES 0' TO 1' / 6' TO 5'
STA. 21+46.63 TO 21+71.63

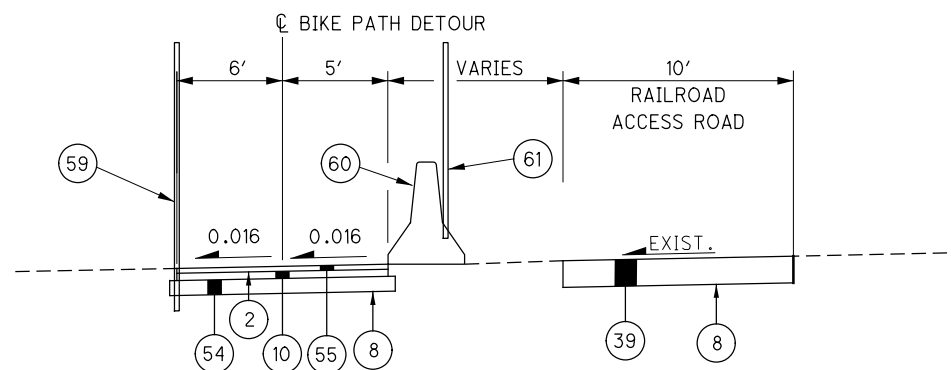

BIKE PATH DETOUR

LIMITING STATIONS
STA. 15+54.32 TO STA. 19+35.78

FOR PROPOSED LEGEND, SEE SHEET 20
FOR CONCRETE PAVER AND RIPRAP DETAILS, SEE SHEET 582
FOR BIKE PATH DETOUR PLANS, SEE SHEET 636 - 643R


NO.	DESCRIPTION	REV. BY	DATE
4	WIDENED BPD	CWL	11-29-2021

G:\2012\2012048\FRA\105523\ROADWAY\SHEETS\105523\300B.DGN
 11/27/2021 1:17:07 PM
 DDDTY81STD_USER

ROADWAY

SUBGRADE STABILIZATION

THIS INVOLVES THE PLACEMENT OF GRANULAR MATERIAL, TYPE B FOR THE LOCATIONS OF UNSUITABLE MATERIALS AS VERIFIED AND DELINEATED BY THE ENGINEER.

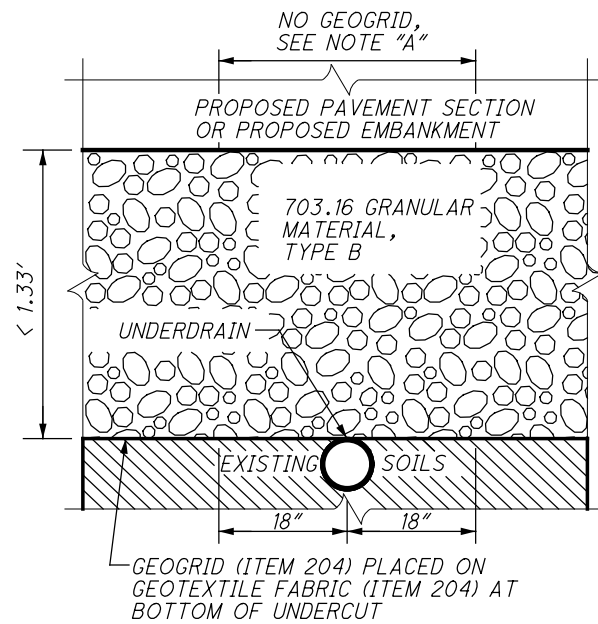

NOTE "A":

THE CONTRACTOR SHALL SUSPEND THE USE OF GEOTEXTILE FABRIC AND GEOGRID WITHIN 18" OF EITHER SIDE OF A CONFLICTING UNDERDRAIN.

DETAIL - UNDERCUT/ REPLACEMENT TREATMENT METHOD
NOT TO SCALE


ITEM 204 - SUBGRADE COMPACTION AND PROOF ROLLING

CONSTRUCT THE SUBGRADE AS FOLLOWS AND IN THE FOLLOWING SEQUENCE:

- SHAPE THE SUBGRADE TO WITHIN 0.2 FEET OF THE PLAN SUBGRADE ELEVATION.
- EXCAVATE AND REPLACE UNSUITABLE SUBGRADE BEFORE COMPACTING THE SUBGRADE WHEN ENCOUNTERED DURING CONSTRUCTION AND AS DIRECTED BY THE ENGINEER. UNSUITABLE SUBGRADE HAS NOT BEEN IDENTIFIED THROUGH THE EXPLORATION PROGRAM. UNSUITABLE SUBGRADE INCLUDES UNSUITABLE SOIL (A-4B, A-2-5, A-5, A-7-5, AND SOIL WITH A LIQUID LIMIT GRATER THAN 65) AND ANY COAL, SHALE, OR ROCK WHICH NEEDS TO BE REMOVED ACCORDING TO 204.05.
- COMPACT THE SUBGRADE ACCORDING TO 204.03.
- APPROXIMATE LIMITS FOR EXCAVATION OF UNSTABLE SUBGRADE ARE SHOWN AND LABELED ON THE CROSS SECTIONS AS UNSTABLE SUBGRADE. THE ENGINEER WILL IDENTIFY THE ACTUAL LIMITS OF EXCAVATION FOR UNSTABLE SUBGRADE BASED ON THE PROOF ROLLING RESULTS AND VISUAL OBSERVATIONS.
- EXCAVATE UNSTABLE SUBGRADE AS DIRECTED BY THE ENGINEER AND STABILIZE BY REPLACING WITH THE SPECIFIED MATERIALS ACCORDING TO 204.07. EXCAVATIONS WILL EXTEND 18 INCHES BEYOND THE EDGE OF THE SURFACE OF THE PAVEMENT, PAVED SHOULDERS, OR PAVED MEDIANS.
- PROOF ROLL THE STABILIZED AREAS ACCORDING TO 204.06 TO VERIFY STABILITY.
- FINE GRADE THE SUBGRADE TO THE SPECIFIED GRADE.

THE QUANTITIES FOR EXCAVATING THE UNSUITABLE SUBGRADE AND UNSTABLE SUBGRADE ARE BOTH PAID UNDER ITEM 204 EXCAVATION OF SUBGRADE.

SEE PAVEMENT SUBGRADE IMPROVEMENT SCHEDULE ON THIS PAGE FOR LOCATIONS AND STATION LIMITS OF EXCAVATE AND REPLACE STABILIZATION.

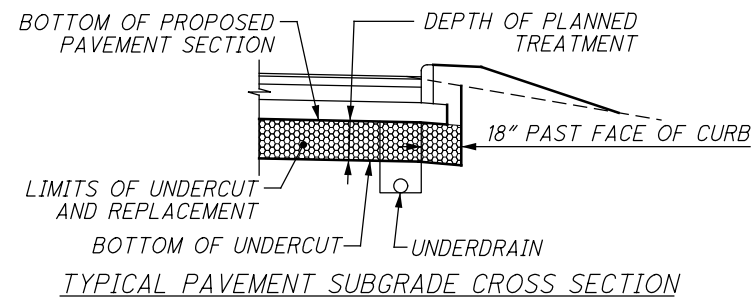

GUARDRAIL/BARRIER WORK AT PROPOSED SIGNS OUTSIDE OF PROJECT LIMITS

THE TRAFFIC CONTROL PLANS ON SHT. NO. 1014 - 1082A INCLUDE THE CONSTRUCTION OF OVERHEAD SIGNS WHICH ARE LOCATED OUTSIDE OF THE ROADWAY PROJECT AREA. THE PROPOSED SIGN CONSTRUCTION REQUIRES THE REMOVAL AND REPLACEMENT OF THE EXISTING MEDIAN BARRIER AS PER ODOT STANDARD DRAWINGS AND DETAILS ON SHEETS 645 - 646.

ESTIMATED QUANTITIES FOR SIGNS OUTSIDE OF PROJECT LIMITS

ITEM	DESCRIPTION	UNIT	SIGN REFERENCE NUMBER			TOTAL
			OSS-201	OSS-203	OSS-204	
202	CONCRETE BARRIER REMOVED	FT	90	90	90	270
622	BARRIER, MISC.: CONCRETE BARRIER, TYPE B	FT	80	80	80	240

PAVEMENT SUBGRADE IMPROVEMENT SCHEDULE

ALIGNMENT	BEGIN STATION	END STATION	SUBGRADE METHOD	DEPTH OF TREATMENT	RECONSTRUCTION SIDE
FUTURE I-70 EB	125+96.00	126+97.69	CEMENT	14"	FULL WIDTH
FUTURE I-70 EB	128+26.12	129+50.00	CEMENT	14"	FULL WIDTH
FUTURE I-70 EB	129+50.00	134+05.00	CEMENT	14"	RIGHT
I-70 EB	4157+88.17	4166+21.70	CEMENT	14"	RIGHT
I-70 EB	4158+50.35	4166+01.56	CEMENT	14"	LEFT
I-70 EB	4169+93.98	4172+00.00	CEMENT	14"	FULL WIDTH
I-70 EB	4180+82.06	4186+25.00	CEMENT	14"	FULL WIDTH
I-70 EB	4186+25.00	4205+28.94	CEMENT	14"	RIGHT
I-70 EB	4186+25.00	4208+14.77	CEMENT	14"	LEFT
I-71 NB	252+86.40	262+00.00	CEMENT	14"	FULL WIDTH
I-71 NB	269+00.00	273+64.54	CEMENT	14"	FULL WIDTH
RAMP A5	5003+23.96	5008+50.00	CEMENT	14"	FULL WIDTH
RAMP C3	3005+50.00	3009+00.00	CEMENT	14"	FULL WIDTH
RAMP C5	5024+38.21	5031+36.49	CEMENT	14"	FULL WIDTH
RAMP C5	5062+13.35	5064+00.00	CEMENT	14"	FULL WIDTH
FRONT ST.	147+75.00	148+61.92	UNDERCUT	12"	FULL WIDTH
FRONT ST.	151+19.35	152+50.00	UNDERCUT	12"	FULL WIDTH
FRONT ST.	155+13.37	156+03.49	UNDERCUT	12"	INTERSECTION
FULTON ST.	19+58.05	23+15.00	UNDERCUT	12"	FULL WIDTH
MOUND ST.	11+49.86	12+53.78	UNDERCUT	12"	INTERSECTION
SOUDER AVE.	5+61.73	6+12.28	UNDERCUT	12"	RIGHT
SOUDER AVE.	5+63.70	6+13.55	UNDERCUT	12"	LEFT
LIVINGSTON AVE.	200+04.62	202+45.02	UNDERCUT	12"	FULL WIDTH
LIVINGSTON AVE.	204+02.13	207+47.00	UNDERCUT	12"	FULL WIDTH

ITEM 203 - GRANULAR EMBANKMENT, AS PER PLAN

PLACE AND COMPACT EMBANKMENT MATERIAL IN 6 INCH LIFTS FOR THE CONSTRUCTION OF THE APPROACH EMBANKMENT AT THE FOLLOWING LOCATIONS:

RAMP C5		
FRA-70-1358A	STA. 5074+10.84 TO STA. 5076+10.84	
FRA-70-1373A	STA. 5079+95.31 TO STA. 5080+45.86	
I-70 EB		
FRA-70-1373R	STA. 4175+43.32 TO STA. 4175+93.32	

ITEM 203 - EMBANKMENT, AS PER PLAN "A"

PLACE AND COMPACT EMBANKMENT MATERIAL IN 6 INCH LIFTS FOR THE CONSTRUCTION OF THE APPROACH EMBANKMENT AT THE FOLLOWING LOCATIONS:

RAMP C5		
FRA-70-1301A	STA. 5039+37.46 TO STA. 5041+87.96	
FRA-70-1358A	STA. 5069+48.10 TO STA. 5071+48.10	
FRA-70-1373A	STA. 5081+38.82 TO STA. 5081+88.82	
RAMP A5		
FRA-71-1518A	STA. 5013+36.09 TO STA. 5015+36.09	
I-70 EB		
FRA-70-1373R	STA. 4176+87.83 TO STA. 4177+37.83	

ITEM 203 - EMBANKMENT, AS PER PLAN "B"

FOR THE VOID CREATED TO EXCAVATE AND CONSTRUCT THE PROPOSED TYPE D BARRIER, AS PER PLAN ALONG THE RIGHT SIDE OF I-71 NB FROM STA. 252+86.40 TO STA. 256+72.79, UTILIZE THE EXISTING EXCAVATED IMPERVIOUS MATERIAL OR OTHER SUITABLE IMPERVIOUS MATERIAL AS BACKFILL AND COMPACT TO FILL THE VOID CREATED BEHIND THE PROPOSED BARRIER WALL. CONTRACTOR TO MINIMIZE IMPACTS TO THE EXISTING LEVEE DURING CONSTRUCTION ACTIVITIES AS SET FORTH IN THE 408 PERMIT AND THE EMERGENCY ACTION PLAN.

EXCAVATION AND BACKFILL COMPACTION SHALL BE PER ODOT CMS 203 AND THE MOST RECENT USACE STANDARD OPERATING PROCEDURE (SOP) FOR EXCAVATION BENCHING AND/OR BACKFILL COMPACTION FOR LEVEE AND FLOODWALL MODIFICATIONS (14 JUNE 2021 LATEST VERSION). USACE PROCEDURES AND GUIDANCE SHALL SUPERCEDE AND SHALL BE FOLLOWED FOR ALL ALL EXCAVATION BENCHING AND BACKFILL WITHIN THE LEVEE EMBANKMENT AND WITHIN 15 FEET OF THE TOE OF THE LEVEE OR FACE OR FLOODWALL. ALL LEVEE EMBANKMENT MATERIAL AND LEVEE FOUNDATION MATERIAL DISTURBED DURING EXCAVATION FOR THE INSTALLATION OF THE TYPE D BARRIER AND THE OVERLAPPING OF THE I-WALL SECTION SHALL BE REPLACED ACCORDING THE USACE SOP.

ALL LABOR, EQUIPMENT AND MATERIALS NECESSARY TO PERFORM THE ABOVE DESCRIBED WORK SHALL BE INCLUDED IN THE UNIT PRICE BID FOR ITEM 203 - EMBANKMENT, AS PER PLAN "B".

QUANTITIES CARRIED TO GENERAL NOTES SUBSUMMARY ON SHEET 69A

NO.	DESCRIPTION	REV. BY	DATE
4 <td>UPDATED 203 NOTES <td>CWL <td>11-29-2021 </td></td></td>	UPDATED 203 NOTES <td>CWL <td>11-29-2021 </td></td>	CWL <td>11-29-2021 </td>	11-29-2021

GENERAL NOTES

FRA - 70 / 71 - 12.68 / 14.86

ENVIRONMENTAL (CONTINUED)

**LOWER SCIOTO BIKEWAY (LSB),
SCIOTO AUDUBON METRO PARK (SAMP)
DODGE PARK**

SEE SHEETS 629- 635 FOR LSB PLANS.
SEE SHEETS 636 - 643 FOR LSB DETOUR PLANS.
SEE SHEET 1049 FOR LSB DETOUR TRAFFIC CONTROL PLANS.

1. THE LSB DETOUR WILL BE CONSTRUCTED AS SHOWN ON SHEETS 636 - 643 AND RECONNECT TO THE EXISTING TRAIL SYSTEM.
2. THE CONTRACTOR WILL KEEP OPEN EITHER THE LSB OR THE LSB DETOUR IN ORDER TO MINIMIZE INTERACTION BETWEEN TRAIL USERS AND CONSTRUCTION ACTIVITIES, EXCEPT FOR THE TWO-WEEK PARK CLOSURE PERIODS. BOTH TRAILS MUST BE CLOSED WHEN THE PARK IS CLOSED TO ENSURE THE SAFETY OF TRAIL USERS.
3. TO ENABLE THE CONTRACTOR TO HAUL MATERIALS TO THE PROJECT SITE, THE SAMP SHALL BE ALLOWED TO BE CLOSED FOR A PERIOD OF TWO (2) WEEKS BETWEEN JANUARY 1, 2022 AND MARCH 15, 2022 AND AGAIN BETWEEN NOVEMBER 1, 2022 AND MARCH 15, 2023. THE CONTRACTOR MUST NOTIFY ODOT AT LEAST 14 DAYS IN ADVANCE OF THE REQUESTED CLOSURE.
4. THE CONTRACTOR SHALL MAINTAIN ACCESS TO THE GRANGE INSURANCE AUDUBON CENTER, PRIVATE BUSINESSES, AND UTILITY COMPANY PROPERTIES DURING THE 2-WEEK CLOSURE PERIODS OF THE SAMP.
5. OUTSIDE THE 2-WEEK CLOSURE PERIODS, TRUCK DELIVERIES WILL BE ALLOWED FROM 9:00 PM THRU 6:00 AM APRIL 1 THRU SEPTEMBER 30 AND 6:00 PM TO 7:00 AM OCTOBER 1 THRU MARCH 31. OUTSIDE OF THOSE DESIGNATED HOURS, ONLY TRUCKS WITH A TOTAL WEIGHT OF LESS THAN 13 TONS WILL BE ALLOWED TO BE WITHIN THE SAMP.
6. ANY CONCRETE POUR THAT IS LARGER THAN 200 CUBIC YARDS IS TO BE PERFORMED OUTSIDE OF SAMP HOURS (6:30 AM TO 8:00 PM). CONCRETE POURS SMALLER THAN 200 CUBIC YARDS MAY BE PERFORMED DURING NORMAL SAMP HOURS. THIS WILL BE THE ONLY EXCEPTION TO THE TONNAGE RESTRICTION ABOVE. THE CONTRACTOR WILL INSTALL SIGNAGE AT THE PARK ENTRANCE TO NOTIFY USERS OF HIGHER THAN USUAL TRUCK TRAFFIC FOR THESE EVENTS.
7. IF ADDITIONAL CLOSURES OF THE LSB OR LSB DETOUR ARE ANTICIPATED, THE CONTRACTOR SHALL NOTIFY THE CITY OF COLUMBUS, FRANKLIN COUNTY METRO PARKS, AND ODOT AT LEAST 7 DAYS BEFORE THE REQUESTED CLOSURE IS TO OCCUR.
8. THE CONTRACTOR SHALL INSTALL TEMPORARY CONSTRUCTION FENCING ALONG THE LSB, LSB DETOUR AND PROPOSED CONSTRUCTION LIMITS TO PROTECT THE SECTION 4(F) PROPERTIES AND THE PUBLIC.
9. 8' TALL FENCING WITH MESH FENCE SCREENING SHALL BE INSTALLED ALONG THE WEST SIDE OF THE LSB DETOUR TO SHIELD TRAIL USERS FROM CONSTRUCTION. PORTABLE BARRIER W/ VANDAL FENCING WILL ALSO BE PROVIDED BETWEEN THE LSB DETOUR AND THE RAILROAD ACCESS ROAD AS SHOWN IN THE PLANS.
10. DURING PERIODS OF NO CONSTRUCTION ACTIVITY, THE EXISTING LSB WILL BE OPEN FOR PUBLIC USE.
11. APPROPRIATE SIGNAGE SHALL BE INSTALLED TO ALERT USERS OF THE SAMP, LSB AND LSB DETOUR OF CONSTRUCTION ACTIVITIES, ACCESS RESTRICTIONS OR CLOSURES, AND TO DIRECT USERS TO SECONDARY ACCESS POINTS. SEE TRAFFIC CONTROL PLANS ON SHEET 1049.
12. VEHICULAR, PEDESTRIAN, AND BICYCLE ACCESS WILL BE MAINTAINED AT ALL TIMES DURING CONSTRUCTION ACTIVITIES EXCEPT FOR THE 2-WEEK CLOSURE PERIODS OF THE SAMP.
13. NO CONSTRUCTION ACTIVITY SHALL OCCUR DURING RED WHITE AND BOOM AND ONE DAY PRECEDING THE EVENT. THE CONSTRUCTION ACTIVITY LIMITATION DATES FOR RED WHITE AND BOOM FOR EACH YEAR WILL BE PROVIDED TO THE CONTRACTOR BY ODOT.
14. THE CONTRACTOR SHALL BE ALLOWED TO STAGE AND STORE WITHIN THE SAMP AS SHOWN ON SHEET 67A. THE AREA WAS PREVIOUSLY OCCUPIED BY A DOG PARK WHICH CONTAINED A SHELTER HOUSE AND WATER FOUNTAIN. THE WATER LINE REMAINS IN PLACE. THE CONTRACTOR WILL PRESERVE THE WATERLINE DURING CONSTRUCTION. ADDITIONALLY, THIS AREA IS PROTECTED BY A 2' SOIL CAP. AT NO TIME WILL THE CONTRACTOR DISTURB THIS CAP.

15. THE STAGING AND/OR STORAGE OF CONSTRUCTION EQUIPMENT SHALL NOT TAKE PLACE OUTSIDE OF THE FENCED CONSTRUCTION LIMITS WITHIN THE DEFINED BOUNDARIES OF THE SAMP.
 16. THE CONTRACTOR SHALL BE REQUIRED TO CLOSELY COORDINATE THE CONSTRUCTION SCHEDULE WITH ODOT DISTRICT 6, COLUMBUS RECREATION AND PARKS, AND FRANKLIN COUNTY METRO PARKS PRIOR TO THE START OF CONSTRUCTION ACTIVITIES.
 17. A REPRESENTATIVE FROM COLUMBUS RECREATION AND PARKS AND FRANKLIN COUNTY METRO PARKS SHALL BE INVITED TO ATTEND ALL CONSTRUCTION RELATED MEETINGS. A SCHEDULE OF CONSTRUCTION ACTIVITIES SHALL BE PROVIDED TO COLUMBUS RECREATION AND PARKS AND SAMP REPRESENTATIVES.
- CONTACT INFORMATION:
- CITY OF COLUMBUS RECREATION AND PARKS:
BRAD WESTALL - (614) 645-2441
BRWestall@Columbus.gov
- FRANKLIN COUNTY METRO PARKS:
DJ WHITE - (614) 445-1076
18. ODOT ADDED A STRUCTURAL PAVEMENT OVERLAY ON MAIER PLACE IN A SEPARATE PROJECT. THE CONTRACTOR WILL BE RESPONSIBLE FOR MAINTENANCE OF MAIER PLACE FOR THE DURATION OF CONSTRUCTION.
 19. CONSTRUCTION CONTRACTOR EMPLOYEE VEHICLES, CONSTRUCTION EQUIPMENT, AND CONSTRUCTION RELATED VEHICLES SHALL UTILIZE MAIER PLACE TO ACCESS THE WORK AREA. CONSTRUCTION CONTRACTOR EMPLOYEES CAN PARK WITHIN THE DESIGNATED CONSTRUCTION AREA OF THE SAMP BUT WILL NOT BE PERMITTED TO PARK IN PARKING LOTS ESTABLISHED FOR PARK USERS.
 20. THE LSB AND LSB DETOUR WILL NOT BE USED FOR ACCESS TO THE WORK AREA, EXCEPT AT THE DESIGNATED CROSSINGS WITHIN EACH PHASE.
 21. LED LIGHTING FIXTURES SHALL BE INSTALLED FOR THE LSB AND LSB DETOUR BENEATH THE I-70/I-71 BRIDGES. THESE LIGHTS WILL BE POWERED FROM AN ODOT CIRCUIT WITH AN ACCESSIBLE DISCONNECT. LIGHTING FIXTURE MAINTENANCE WILL BE THE RESPONSIBILITY OF THE CITY OF COLUMBUS. SEE LIGHTING PLANS ON SHEET 1185.
 22. UPON COMPLETION OF CONSTRUCTION, THE CONTRACTOR SHALL FULLY RESTORE ANY LAND DISTURBED BY CONSTRUCTION ACTIVITIES.

ITEM 607 - FENCE, TYPE CL, AS PER PLAN

TEMPORARY CHAIN LINK CONSTRUCTION FENCING WILL BE INSTALLED ALONG THE CONSTRUCTION LIMITS OF THE CONSTRUCTION AREA ADJACENT TO THE LOWER SCIOTO BIKEWAY, LOWER SCIOTO BIKEWAY DETOUR, SCIOTO AUDUBON METRO PARK AND DODGE PARK. REMOVAL OF THE TEMPORARY FENCE UPON COMPLETION OF CONSTRUCTION ACTIVITY SHALL BE INCLUDED IN THE CONTRACT PRICE BID.

THE FOLLOWING QUANTITY HAS BEEN PROVIDED:

ITEM 607 - FENCE, TYPE CL, AS PER PLAN 2000 FT

METRO PARK/WHITTIER PENINSULA VAP

THE TEMPORARY PARCEL 3 ON WHITTIER PENINSULA HAS BEEN SUBJECT TO AN OEPA VOLUNTARY ACTION PROGRAM (VAP) BY THE OWNER, COLUMBUS AND FRANKLIN COUNTY METRO PARKS AND AS SUCH THE CONTRACTOR'S WORK BELOW SUBGRADE IS GOVERNED BY THE CONDITIONS CONTAINED IN THE NORTHERN TIER COVENANT NOT TO SUE (CNS) (4/22/10, #08NFA308), THE FORMER LAZARUS DISTRIBUTION CNS (6/14/10, #09NFA330) AND THE SOUTHERN TIER CNS (12/30/15, #14NFA592). THE CNS'S CAN BE FOUND WITHIN THE SPECIAL PROVISIONS FOR THE PROJECT.

EQUIPMENT WITHIN FLOODPLAIN

IF THE CONSTRUCTION EQUIPMENT WILL NOT BE IN USE FOR THE FOLLOWING TWO CALENDAR DAYS, THIS SHALL DEFINE IDLE EQUIPMENT, AND THE CONTRACTOR SHALL MOVE THE EQUIPMENT ABOVE ELEVATION 717 FEET. THE ONLY EXCEPTION TO THIS IS FOR LARGE CRANES AND DRILLING RIGS. THE CONTRACTOR WILL MONITOR THE FRANK ROAD USGS/CORPS SCIOTO RIVER GAUGE SOUTH OF SR-104. ADDITIONALLY, THE CONTRACTOR SHALL MONITOR FORECASTED WEATHER PRECIPITATION USING WEATHER.COM AND MYRADAR.COM. PER THE EMERGENCY NOTIFICATION PROCESS WITHIN THE EMERGENCY ACTION PLAN (EAP), ODOT WILL BE NOTIFIED BY THE CITY OF COLUMBUS WHEN THE RIVER LEVEL REACHES THE TRIGGER ELEVATIONS LISTED IN THE EAP. THE CONTRACTOR SHALL MOVE ALL EQUIPMENT ABOVE ELEVATION 717 FEET WHEN THESE CONDITIONS ARE MET, OR WHEN EQUIPMENT IS CONSIDERED IDLE, AS DEFINED IN THIS PARAGRAPH.

PROTECTION OF DOG PARK SOIL CAP

GEOTEXTILE FABRIC SHALL BE PLACED ON TOP OF EXISTING SOIL PRIOR TO PLACING CONSTRUCTION MATERIALS AND/OR EQUIPMENT WITHIN THE SCIOTO AUDUBON METRO PARK DOG PARK LOCATION. THE FOLLOWING QUANTITY HAS BEEN PROVIDED FOR THE PROTECTION OF THE EXISTING SOIL CAP:

ITEM 204 - GEOTEXTILE FABRIC 2000 SY

D:\2012\2012048\FRA\105525\ROADWAY\SHEETS\105525\009.DGN
 11/27/2021 10:06:14 AM
 DDDTY81STD.JESR

QUANTITIES CARRIED TO GENERAL NOTES SUBSUMMARY ON SHEET 69A

NO.	DESCRIPTION	REV. BY	DATE
4	UPDATED NOTE	CWL	11-29-2021

CALCULATED
 ATR
 CHECKED
 CWL

GENERAL NOTES

FRA - 70 / 71 - 12.68 / 14.86

67
 1815

01-2012\2012048\FRA\105525\ROADWAY\SHEETS\105525S025.DGN
 11/21/2021 1:38:50 PM
 CDDTV81STD_USER

SHEET NO.	201		202		202		204		208		251		SPECIAL		SPECIAL		601		607		605		611		611		611		611		
	CLEARING AND GRUBBING, AS PER PLAN		REMOVAL MISC.: TRASH RECEPTACLES		CONCRETE BARRIER REMOVED		GEOTEXTILE FABRIC		VIBRATION CONTROL AND MONITORING, AS PER PLAN		PARTIAL DEPTH PAVEMENT REPAIR (442)		PAVEMENT OVERLAY FABRIC		SAWING AND SEALING CONCRETE JOINTS		TIED CONCRETE BLOCK MAT, TYPE 1		FENCE, TYPE CL, AS PER PLAN		6" UNCLASSIFIED PIPE UNDERDRAINS WITH GEOTEXTILE FABRIC		CONDUIT, MISC.: SEWER VIDEO INSPECTION		6" CONDUIT, TYPE B		6" CONDUIT, TYPE C		CONDUIT, MISC.: BYPASS PUMPING FOR VIDEO INSPECTION AND PIPE REPAIRS		
	LS		EACH		FT		SY		LS		SY		SY		FT		SY		FT		FT		FT		FT		FT		FT	LS	
	01/NHS/PV	01/NHS/PV	01/NHS/PV		01/NHS/PV	01/NHS/PV	01/NHS/PV	01/NHS/PV	01/NHS/PV	01/NHS/PV	01/NHS/PV	01/NHS/PV	01/NHS/PV	01/NHS/PV	01/NHS/PV	05/NHS/OT/COL	01/NHS/PV	01/NHS/PV	01/NHS/PV	01/NHS/PV	01/NHS/PV	01/NHS/PV	01/NHS/PV	01/NHS/PV	01/NHS/PV	01/NHS/PV	01/NHS/PV	01/NHS/PV	01/NHS/PV		
53	LS	LS																													
54			4																												
55											500																				
56					119	151																									
61																															
63																															
66A									LS	LS																					
67								880	1120												880	1120									
69																														LS	
TOTALS CARRIED TO GENERAL SUMMARY																															
	LS	LS	4		119	151		880	1120	LS	LS				500					102	129										
SHEET NO.	611		611		611		611		SPECIAL		622		623		638		SPECIAL		SPECIAL		SPECIAL		SPECIAL		SPECIAL		SPECIAL				
	6" CONDUIT, TYPE E		6" CONDUIT, TYPE F		PRECAST REINFORCED CONCRETE OUTLET		CONDUIT, MISC.: INTERNAL JOINT SEAL		MISCELLANEOUS METAL		BARRIER, MISC.: CONCRETE BARRIER, TYPE B		PROVIDING ELECTRONIC INSTRUMENTATION		WATER WORK, MISC.: SURVEY COORDINATES		SURVEY CONTROL VERIFICATION		WORK INVOLVING NON-REGULATED MATERIALS		WORK INVOLVING HAZARDOUS WASTE		WORK INVOLVING SOLID WASTE		WORK INVOLVING NON-REGULATED WATER		WORK INVOLVING REGULATED WATER				
	FT		FT		EACH		EACH		LB		FT		LS		LS		TON		TON		TON		GAL		GAL						
	01/NHS/PV	01/NHS/PV	54																															
56											106	134																			
58													LS	LS																	
63	22	28	110	140	2	2	26	34	440	560																					
66A																					440	560	44	56	220	280	4840	6160	4840	6160	
68													LS																		
TOTALS CARRIED TO GENERAL SUMMARY																															
	22	28	110	140	2	2	26	34	440	560	106	134	LS	LS	LS					LS	LS	440	560	44	56	220	280	4840	6160	4840	6160

GENERAL NOTES SUBSUMMARY
 CALCULATED CJC CHECKED CWL
FRA-70/71-12.68/14.86
 69A
 1815

SHEET NO.	661	661	661	661	661	661	661	661												
	DECIDUOUS TREE, 2" CALIPER, AS PER PLAN, CERVIS CANADENSIS - RED BUD	DECIDUOUS TREE, 2-1/2" CALIPER, AS PER PLAN, CELTIS OCCIDENTALIS - HACKBERRY	DECIDUOUS TREE, 2-1/2" CALIPER, AS PER PLAN, PLATANUS OCCIDENTALIS - SYCAMORE	DECIDUOUS TREE, 2-1/2" CALIPER, AS PER PLAN, QUERCUS BICOLOR - SWAMP WHITE OAK	PLANTING, MISC.: DECIDUOUS SHRUB, 24" - 36" HEIGHT, VIBURNUM DENTATUM - ARROWWOOD	PLANTING, MISC.: DECIDUOUS SHRUB, 24" - 36" HEIGHT, PHYSOCARPUS OPULIFOLIUS - NINEBARK														
	EACH	EACH	EACH	EACH	EACH	EACH	EACH	EACH												
	01/NHS/P V	01/NHS/P V	01/NHS/P V	01/NHS/P V	01/NHS/P V	01/NHS/P V	01/NHS/P V	01/NHS/P V	01/NHS/P V	01/NHS/ PV	01/NHS/ PV									
66	2	3	4	4	5	7	2	3	9	11	9	11								
TOTALS CARRIED TO GENERAL SUMMARY		2	3	4	4	5	7	2	3	9	11	9	11							
SHEET NO.																				

NO.	DESCRIPTION	REV.	BY	DATE
4	FUNDING CODE CHANGE		CWL	11-29-2021

TOTALS CARRIED TO GENERAL SUMMARY

P:\PR51781\Fra\77372.mot\sheets\Project 4R\105523MS400.dgn \$ddt\$2/2021 \$12:09:59 AM worley

ITEM	EXTENSION	FUNDING SPLIT		TOTAL	UNIT	DESCRIPTION	SEE SHEET
		01/NHS/PV	01/NHS/PV				
410	12000			200	CY	TRAFFIC COMPACTED SURFACE, TYPE A OR B	70
503	11100			LS		COFFERDAMS AND EXCAVATION BRACING	
607	30001	440	560	1000	FT	FENCE, SNOW, AS PER PLAN	
611	05900	2	2	4	FT	15" CONDUIT, TYPE B	
611	07400	55	71	126	FT	18" CONDUIT, TYPE B	
611	98700	0	1	1	EACH	INLET, SIDE DITCH	
611	99114	0	1	1	EACH	INLET, NO. 3 FOR SINGLE SLOPE BARRIER, TYPE D	
611	99500	2	2	4	EACH	INLET, MISC.: LOCAL DEPRESSION REMOVE FROM INLET	
611	99500	0	1	1	EACH	INLET, MISC.: INLET, CAPPED BELOW GRADE	78
611	99574	0	1	1	EACH	MANHOLE, NO. 3	
611	99910	316	402	718	FT	DRAINAGE STRUCTURE, MISC.: LONGITUDINAL TRENCH DRAIN FOR MOT	78
614	11000			LS		MAINTAINING TRAFFIC	70
614	11110	1980	2520	4500	hour	LAW ENFORCEMENT OFFICER WITH PATROL CAR FOR ASSISTANCE	73
614	11630	16786	21364	38150	FT	INCREASED BARRIER DELINEATION	74
614	12380	14	17	31	EACH	WORK ZONE IMPACT ATTENUATOR, 24" WIDE HAZARDS, (UNIDIRECTIONAL)	73
614	12420			LS		DETOUR SIGNING	75
614	12484	2.64	3.36	6	EACH	WORK ZONE INCREASED PENALTIES SIGN	75
614	12500	22	28	50	EACH	REPLACEMENT SIGN	74
614	12600	132	168	300	EACH	REPLACEMENT DRUM	74
614	12801	443	563	1006	EACH	WORK ZONE RAISED PAVEMENT MARKER, AS PER PLAN	70
614	13310	350	446	796	EACH	BARRIER REFLECTOR, TYPE 1, ONE-WAY	74
614	13312	7	9	16	EACH	BARRIER REFLECTOR, TYPE 2, ONE-WAY	76
614	13350	356	454	810	EACH	OBJECT MARKER, ONE WAY	74 / 76
614	18000	66000	84000	150000	EACH	MAINTAINING TRAFFIC, MISC.: BRIDGE DECK AND PAVEMENT PATCHING	77
614	18030	440	560	1000	FT	MAINTAINING TRAFFIC, MISC.: CONSTRUCTION FENCE	77
614	18601	112	142	254	SNMT	PORTABLE CHANGEABLE MESSAGE SIGN, AS PER PLAN	74
614	20011	0.96	1.23	2.19	MILE	WORK ZONE LANE LINE, CLASS I, 6" SPRAY THERMOPLASTIC, AS PER PLAN	74
614	20056	2.55	3.24	5.79	MILE	WORK ZONE LANE LINE, CLASS I, 6", 807 PAINT	
614	21001	0.01	0.02	0.03	MILE	WORK ZONE CENTER LINE, CLASS I SPRAY THERMOPLASTIC, AS PER PLAN	74
614	21050	0.26	0.33	0.59	MILE	WORK ZONE CENTER LINE, CLASS I, 807 PAINT	
614	22010	0.29	0.37	0.66	MILE	WORK ZONE CENTER LINE, CLASS I, 642 PAINT	
614	22011	2.24	2.85	5.09	MILE	WORK ZONE EDGE LINE, CLASS I, 6" SPRAY THERMOPLASTIC, AS PER PLAN	74
614	22056	6.53	8.31	14.84	MILE	WORK ZONE EDGE LINE, CLASS I, 6", 807 PAINT	
614	23011	0.34	0.43		MILE	WORK ZONE EDGE LINE, CLASS I, 6", 642 PAINT	
614	23011	4319	5498	9817	FT	WORK ZONE CHANNELIZING LINE, CLASS I, 12" SPRAY THERMOPLASTIC, AS PER PLAN	74
614	23100	11612	14780	26392	FT	WORK ZONE CHANNELIZING LINE, CLASS I, 12", 807 PAINT	
614	24001	93	119	212	FT	WORK ZONE DOTTED LINE, CLASS I SPRAY THERMOPLASTIC, AS PER PLAN	74
614	24100	3572	4546	8118	FT	WORK ZONE DOTTED LINE, CLASS I, 4", 807 PAINT	
614	24200	474	603	1077	FT	WORK ZONE DOTTED LINE, CLASS I, 642 PAINT	
614	25200	525	669	1194	FT	WORK ZONE TRANSVERSE/DIAGONAL LINE, CLASS I, 642 PAINT	
614	26200	27	34	61	FT	WORK ZONE STOP LINE, CLASS I, 642 PAINT	
614	30200	8	10	18	EACH	WORK ZONE ARROW, CLASS I, 642 PAINT	
614	40000	191	244	435	FT	LONGITUDINAL CHANNELIZER	76
615	10000			LS		ROADS FOR MAINTAINING TRAFFIC	
615	25000	2145	2729	4874	SY	PAVEMENT FOR MAINTAINING TRAFFIC, CLASS B	
615	25001	44	56	100	SY	PAVEMENT FOR MAINTAINING TRAFFIC, CLASS B, AS PER PLAN, TYPE 1	77
615	25001	22	28	50	SY	PAVEMENT FOR MAINTAINING TRAFFIC, CLASS B, AS PER PLAN, TYPE 2	77
615	25001	9	11	20	SY	PAVEMENT FOR MAINTAINING TRAFFIC, CLASS B, AS PER PLAN, TYPE 3	77
615	25001	9	11	20	SY	PAVEMENT FOR MAINTAINING TRAFFIC, CLASS B, AS PER PLAN, TYPE 4	77
615	20001	2958	3765	6723	SY	PAVEMENT FOR MAINTAINING TRAFFIC, CLASS A, AS PER PLAN	70
616	10000	601	764	1365	MGAL	WATER	74
622	41100	14102	17948	32050		PORTABLE BARRIER, UNANCHORED	
622	41110	97	123	220		PORTABLE BARRIER, ANCHORED	
622	41050	1	2	3	EACH	PORTABLE BARRIER, "Y" CONNECTOR	
808	18700	55	69	124	SNMT	DIGITAL SPEED LIMIT (DSL) SIGN ASSEMBLY	75
896	00010	82	104	186	SNMT	PORTABLE NON-INTRUSIVE TRAFFIC SENSOR, CLASS I	77
896	00021	27	35	62	SNMT	PORTABLE CHANGEABLE MESSAGE SIGN, AS PER PLAN	77

NO.	DESCRIPTION	REV. BY	DATE
4	FUNDING SPLIT CHANGE	EMW	11-29-2021

CALCULATED
EMW
CHECKED
RMK

MAINTENANCE OF TRAFFIC GENERAL SUMMARY

FRA-70-12.68

SHEET NUMBER							PARTICIPATION					ITEM	ITEM EXT.	GRAND TOTAL	UNIT	DESCRIPTION	SEE SHEET NO.	
OFFICE CALCS	69A		220				01/NHS/PV	01/NHS/PV	04/MPO/OT	05/NHS/OT/COL	06/ENH/OT/COL							
	2000						880	1120					607	20001	2000	FT	ROADWAY (CONTINUED)	67
			481				212	269					607	23000	481	FT	FENCE, TYPE CL, AS PER PLAN	
			554				244	310					607	23001	554	FT	FENCE, TYPE CLT	53
			736				324	412					607	23001	736	FT	FENCE, TYPE CLT, AS PER PLAN "A"	58
			88				18	23		47			607	35000	88	FT	FENCE, TYPE CLT, AS PER PLAN "B"	
			739				325	414					607	39994	739	FT	FENCE REMOVED AND REBUILT	
			1					1					607	61201	1	EACH	TEMPORARY VANDAL FENCE, TYPE B	
			2				1	1					607	61201	2	EACH	GATE, TYPE CLT, AS PER PLAN "A"	53
			888				391	497					607	70000	888	FT	GATE, TYPE CLT, AS PER PLAN "B"	58
			20627				12922		189	7516			608	10000	20627	SF	FENCELINE SEEDING AND MULCHING	
200			1646				1296	112	69	369			608	15000	1846	SF	4" CONCRETE WALK	
			14				14						608	41001	14	FT	8" CONCRETE WALK	
	5044									5044			608	98000	5044	SF	CONCRETE STEPS, TYPE B, AS PER PLAN	57
			2774						591		2183		608	98000	2774	SF	WALKWAY, MISC.: BRICK PAVER CROSSWALK	579
													608	98000	2774	SF	WALKWAY, MISC.: BRICK PAVER WALK	578
1752							771	981					608	98000	1752	SF	WALKWAY, MISC.: 6" X 6" CONCRETE PAVERS	582
41							18	23					608	98000	41	SF	WALKWAY, MISC.: COLUMBUS DETECTABLE WARNING, TYPE A	58
			16				16						608	98200	16	EACH	WALKWAY, MISC.: COLUMBUS CURB RAMP, TYPE A	57
			1				1						608	98200	1	EACH	WALKWAY, MISC.: COLUMBUS CURB RAMP, TYPE P-7	57
			1				1						608	98200	1	EACH	WALKWAY, MISC.: COLUMBUS CURB RAMP, TYPE P-4 MODIFIED	57
117							70	47					622	10060	117	FT	CONCRETE BARRIER, SINGLE SLOPE, TYPE B	
80							48	32					622	10140	80	FT	CONCRETE BARRIER, SINGLE SLOPE, TYPE C1	
1267							739	528					622	10160	1267	FT	CONCRETE BARRIER, SINGLE SLOPE, TYPE D	
388							194	194					622	10161	388	FT	CONCRETE BARRIER, SINGLE SLOPE, TYPE D, AS PER PLAN	57
2							1	1					622	10200	2	EACH	BARRIER TRANSITION	644
11							5	6					622	25000	11	EACH	CONCRETE BARRIER END SECTION, TYPE D	
1								1					622	25001	1	EACH	CONCRETE BARRIER END SECTION, TYPE D, AS PER PLAN "A"	57
1								1					622	25001	1	EACH	CONCRETE BARRIER END SECTION, TYPE D, AS PER PLAN "B"	57
4							2	2					622	25004	4	EACH	CONCRETE BARRIER, END ANCHORAGE, REINFORCED, TYPE B	
2							1	1					622	25015	2	EACH	CONCRETE BARRIER, END ANCHORAGE, REINFORCED, TYPE C1, AS PER PLAN	58
25							13	12					622	25050	25	EACH	CONCRETE BARRIER, END ANCHORAGE, REINFORCED, TYPE D	
1								1					622	25051	1	EACH	CONCRETE BARRIER, END ANCHORAGE, REINFORCED, TYPE D, AS PER PLAN	58
			1542				839	703					622	41101	1542	FT	PORTABLE BARRIER, UNANCHORED, AS PER PLAN	57
			1811				661	1150					622	41111	1811	FT	PORTABLE BARRIER, ANCHORED, AS PER PLAN	57
	240						106	134					622	90000	240	FT	BARRIER, MISC.: CONCRETE BARRIER, TYPE B	57
80							48	32					622	90000	80	FT	BARRIER, MISC.: CONCRETE BARRIER, TYPE B50	57
	LS						LS	LS					623	11000	LS		PROVIDING ELECTRONIC INSTRUMENTATION	58
	LS						LS	LS					SPECIAL	69098400	LS		SURVEY CONTROL VERIFICATION	54
	LS						LS	LS					878	25000	LS		INSPECTION AND COMPACTION TESTING OF UNBOUND MATERIALS	

GENERAL SUMMARY

FRA - 70 / 71 - 12.68 / 14.86

NO.	DESCRIPTION	REV. BY	DATE
4	FUNDING CODE CHANGE	CWL	11-23-2021

D:\2012\2012048\FRA\105523\ROADWAY\SHEETS\10552365002.DGN
11/21/2021
1:03:25 PM
CDDTV81STD_USER

SHEET NUMBER				PARTICIPATION				ITEM	ITEM EXT.	GRAND TOTAL	UNIT	DESCRIPTION	SEE SHEET NO.
OFFICE CALCS	69A	221	229	01/NHS/PV	01/NHS/PV								
											EROSION CONTROL		
315					139	176		601	12001	315	SY	RIPRAP, WITH GROUT, AS PER PLAN	582
		1127			496	631		601	21000	1127	SY	CONCRETE SLOPE PROTECTION	
	8	223			102	129		601	21050	231	SY	TIED CONCRETE BLOCK MAT WITH TYPE 1 UNDERLAYMENT	
		243			107	136		601	21060	243	SY	TIED CONCRETE BLOCK MAT WITH TYPE 2 UNDERLAYMENT	
		6			3	3		601	32200	6	CY	ROCK CHANNEL PROTECTION, TYPE C WITH FILTER	
		571			251	320		601	37501	571	FT	PAVED GUTTER, TYPE 1-2, AS PER PLAN	65
			2					659	00100	2	EACH	SOIL ANALYSIS TEST	
		6130			2697	3433		659	00300	6130	CY	TOPSOIL	
		55225			24299	30926		659	10000	55225	SY	SEEDING AND MULCHING	
		2761			1215	1546		659	14000	2761	SY	REPAIR SEEDING AND MULCHING	
		2761			1215	1546		659	15000	2761	SY	INTER-SEEDING	
			7.70		3.39	4.31		659	20000	7.70	TON	COMMERCIAL FERTILIZER	
			11.41		5.02	6.39		659	31000	11.41	ACRE	LIME	
			306		135	171		659	35000	306	MGAL	WATER	
		95			42	53		660	30000	95	SY	SODDING UNSTAKED	
		2313			1018	1295		670	00700	2313	SY	DITCH EROSION PROTECTION	
		LS			LS	LS		832	15000	LS		STORM WATER POLLUTION PREVENTION PLAN	
		LS			LS	LS		832	15002	LS		STORM WATER POLLUTION PREVENTION INSPECTIONS	
		LS			LS	LS		832	15010	LS		STORM WATER POLLUTION PREVENTION INSPECTION SOFTWARE	
		1150000			506000	644000		832	30000	1150000	EACH	EROSION CONTROL	
												ENVIRONMENTAL / REMEDIATION	
	1000				440	560		SPECIAL	69065000	1000	TON	WORK INVOLVING NON-REGULATED MATERIALS	66A
	100				44	56		SPECIAL	69065002	100	TON	WORK INVOLVING HAZARDOUS WASTE	66A
	500				220	280		SPECIAL	69065010	500	TON	WORK INVOLVING SOLID WASTE	66A
	11000				4840	6160		SPECIAL	69065022	11000	GAL	WORK INVOLVING NON-REGULATED WATER	66A
	11000				4840	6160		SPECIAL	69065024	11000	GAL	WORK INVOLVING REGULATED WATER	66A

GENERAL SUMMARY

FRA -70/ 71-12.68 / 14.86

NO.	DESCRIPTION	REV. BY	DATE
1	ADDED LIBERTY RMP NOTE	CWL	11-4-2021
4	FUNDING CODE CHANGE / UPDATED EARTHWORK	CWL	11-29-2021

D:\2012\2012048\FRA\105523\ROADWAY\SHEETS\10552365002.DGN
11/29/2021 9:44:24 AM
GDDTV81STD_USER

SHEET NUMBER						PARTICIPATION ^A				ITEM	ITEM EXT.	GRAND TOTAL	UNIT	DESCRIPTION	SEE SHEET NO.	CALCULATED ATR	CHECKED CWL
69A		222	223			01/NHS/PV	01/NHS/PV	05/NHS/OT/COL									
		2.0				0.9	1.1			602	20000	2.0	CY	DRAINAGE CONCRETE MASONRY			
		52				43		9		605	05200	52	FT	4" UNCLASSIFIED PIPE UNDERDRAINS			
		1995				1684		311		605	06000	1995	FT	4" BASE PIPE UNDERDRAINS			
		13967				6146	7821			605	11110	13967	FT	6" SHALLOW PIPE UNDERDRAINS WITH GEOTEXTILE FABRIC			
		12						12		605	13300	12	FT	6" UNCLASSIFIED PIPE UNDERDRAINS			
200		1184				611	773			605	13410	1384	FT	6" UNCLASSIFIED PIPE UNDERDRAINS WITH GEOTEXTILE FABRIC			
		345						345		605	14000	345	FT	6" BASE PIPE UNDERDRAINS			
		25281				11136	14145			605	14020	25281	FT	6" BASE PIPE UNDERDRAINS WITH GEOTEXTILE FABRIC			
		22				22				611	00100	22	FT	4" CONDUIT, TYPE B			
		183				163		20		611	00410	183	FT	4" CONDUIT, TYPE F FOR UNDERDRAIN OUTLET			
		645				285	360			611	00510	645	FT	6" CONDUIT, TYPE F FOR UNDERDRAIN OUTLETS			
50		675				319	406			611	00900	725	FT	6" CONDUIT, TYPE B			
50						22	28			611	01100	50	FT	6" CONDUIT, TYPE C			
50						22	28			611	01400	50	FT	6" CONDUIT, TYPE E			
250						110	140			611	01500	250	FT	6" CONDUIT, TYPE F			
		87				38	49			611	04400	87	FT	12" CONDUIT, TYPE B			
		16				7	9			611	04400	16	FT	12" CONDUIT, TYPE B, 706.02			
		100				44	56			611	04600	100	FT	12" CONDUIT, TYPE C			
		2322				1022	1300			611	05900	2322	FT	15" CONDUIT, TYPE B			
		34				15	19			611	05900	34	FT	15" CONDUIT, TYPE B, 706.02			
		639				281	358			611	05900	639	FT	15" CONDUIT, TYPE B, 706.02 WITH 706.11 JOINTS			
		601				264	337			611	05901	601	FT	15" CONDUIT, TYPE B, AS PER PLAN	64		
		1760				775	985			611	06100	1760	FT	15" CONDUIT, TYPE C			
		284				125	159			611	06100	284	FT	15" CONDUIT, TYPE C, 706.02 WITH 706.11 JOINTS			
		37				17	20			611	06101	37	FT	15" CONDUIT, TYPE C, AS PER PLAN	64		
		992				437	555			611	07400	992	FT	18" CONDUIT, TYPE B			
		12				5	7			611	07401	12	FT	18" CONDUIT, TYPE B, AS PER PLAN, 748.01, CLASS 52	64		
		261				115	146			611	07600	261	FT	18" CONDUIT, TYPE C			
		28				12	16			611	07601	28	FT	18" CONDUIT, TYPE C, AS PER PLAN	64		
		76				33	43			611	08900	76	FT	21" CONDUIT, TYPE B			
		101				44	57			611	08900	101	FT	21" CONDUIT, TYPE B, 706.02 WITH 706.11 JOINTS			
		249				110	139			611	09100	249	FT	21" CONDUIT, TYPE C			
		335				148	187			611	10400	335	FT	24" CONDUIT, TYPE B			
		10				4	6			611	10401	10	FT	24" CONDUIT, TYPE B, AS PER PLAN	64		
		312				138	174			611	10600	312	FT	24" CONDUIT, TYPE C			
		130				57	73			611	11900	130	FT	27" CONDUIT, TYPE B			
		709				312	397			611	12100	709	FT	27" CONDUIT, TYPE C			
		531				233	298			611	13600	531	FT	30" CONDUIT, TYPE C			
		126				55	71			611	16400	126	FT	36" CONDUIT, TYPE B			
		20				8	12			611	16400	20	FT	36" CONDUIT, TYPE B, 706.02			
		126				55	71			611	96600	126	FT	CONDUIT, BORED OR JACKED, 42" TYPE B, 748.06	63		
		292				128	164			611	96601	292	FT	CONDUIT, BORED OR JACKED, AS PER PLAN, 42" CONDUIT, TYPE C, 748.06 (0.625" WALL THICKNESS)	63		
60						26	34			611	97200	60	EACH	CONDUIT, MISC.: INTERNAL JOINT SEAL	63		
		12				5	7			611	98150	12	EACH	CATCH BASIN, NO. 3			
		15				7	8			611	98180	15	EACH	CATCH BASIN, NO. 3A			
		4				1	3			611	98370	4	EACH	CATCH BASIN, NO. 6			
		2				1	1			611	98371	2	EACH	CATCH BASIN, NO. 6, AS PER PLAN	64		
		2				1	1			611	98390	2	EACH	CATCH BASIN, NO. 7			
		10				4	6			611	98410	10	EACH	CATCH BASIN, NO. 8			
		4				1	3			611	98411	4	EACH	CATCH BASIN, NO. 8, AS PER PLAN	64		
		9				3	6			611	98470	9	EACH	CATCH BASIN, NO. 2-2B			
		1					1			611	98510	1	EACH	CATCH BASIN, NO. 2-3			
		1					1			611	98631	1	EACH	CATCH BASIN ADJUSTED TO GRADE, AS PER PLAN	63, 64		

GENERAL SUMMARY

FRA - 70 / 71 - 12.68 / 14.86

NO.	DESCRIPTION	REV. BY	DATE
4	FUNDING CODE CHANGE	CWL	11-29-2021

D:\2021\2012048\FRA\105523\ROADWAY\SHEETS\1055230504.DGN
11/21/2021
2:00:26 PM
C00TV81STD_USER

SHEET NUMBER				PARTICIPATION ^A				ITEM	ITEM EXT.	GRAND TOTAL	UNIT	DESCRIPTION	SEE SHEET NO.	CALCULATED ATR	CHECKED CWL
69A		223		01/NHS/PV	01/NHS/PV	05/NHS/OT/COL									
											DRAINAGE (CONTINUED)				
		1			1		611	99111	1	EACH	INLET, NO. 3 FOR SINGLE SLOPE BARRIER, TYPE C1, AS PER PLAN	64			
		10			4	6	611	99114	10	EACH	INLET, NO. 3 FOR SINGLE SLOPE BARRIER, TYPE D				
		8			4	4	611	99115	8	EACH	INLET, NO. 3 FOR SINGLE SLOPE BARRIER, TYPE D, AS PER PLAN	64			
		2			1	1	611	99151	2	EACH	INLET ADJUSTED TO GRADE, AS PER PLAN	63 , 64			
		26			12	14	611	99574	26	EACH	MANHOLE, NO. 3				
		10			4	6	611	99575	10	EACH	MANHOLE, NO. 3, AS PER PLAN	64			
		4			1	2	611	99655	4	EACH	MANHOLE ADJUSTED TO GRADE, AS PER PLAN	63 , 64			
	4	4			4	4	611	99710	8	EACH	PRECAST REINFORCED CONCRETE OUTLET				
	1000				440	560	SPECIAL	61199820	1000	LB	MISCELLANEOUS METAL	63			
		1				1	611	99900	1	EACH	DRAINAGE STRUCTURE, MISC.: GATEWELL RECONSTRUCTED TO GRADE	669A			
		8			3	3	SPECIAL	69098000	8	EACH	CITY OF COLUMBUS STANDARD CURB AND GUTTER INLET (AA-S125A WITH GRATE AA-S128)	63 , 64			
		1				1	SPECIAL	69098000	1	EACH	CITY OF COLUMBUS RECTANGULAR CATCH BASIN (AA-S135 WITH GRATE AA-S140)	63 , 64			
		4			2	2	SPECIAL	69098000	4	EACH	CITY OF COLUMBUS STANDARD CATCH BASIN (AA-S133A WITH GRATE AA-S141)	63 , 64			
		9			3	5	SPECIAL	69098000	9	EACH	CITY OF COLUMBUS MANHOLE, TYPE C (AA-S102)	63 , 64			
		99			44	55	SPECIAL	69098100	99	FT	CITY OF COLUMBUS 6" PIPE, WITH TYPE 1 BEDDING, WITH 912 COMPACTED GRANULAR MATERIAL	63			
		73			32	41	SPECIAL	69098100	73	FT	CITY OF COLUMBUS 8" PIPE, WITH TYPE 1 BEDDING, WITH 912 COMPACTED GRANULAR MATERIAL	63			
		638			217	278	SPECIAL	69098100	638	FT	CITY OF COLUMBUS 12" PIPE, WITH TYPE 1 BEDDING, WITH 912 COMPACTED GRANULAR MATERIAL	63			
		162			71	91	SPECIAL	69098100	162	FT	CITY OF COLUMBUS 12" PIPE, 706.02 WITH 706.11 JOINTS, WITH TYPE 1 BEDDING, WITH 912 COMPACTED GRANULAR MATERIAL	63			
		56			25	31	SPECIAL	69098100	56	FT	CITY OF COLUMBUS 15" PIPE, 706.02 WITH 706.11 JOINTS, WITH TYPE 1 BEDDING, WITH 912 COMPACTED GRANULAR MATERIAL	63			
		369			162	207		837	10000	369	FT	LINER PIPE, 27" I.D., 707.12			

GENERAL SUMMARY

FRA -70/ 71-12.68 / 14.86

NO.	DESCRIPTION	REV. BY	DATE
4	FUNDING CODE CHANGE	CWL	11-29-2021

215
1815

D:\2012\2012048\FRA\105523\ROADWAY\SHEETS\10552365005.DGN
11/21/2021
2:03:12 PM
GDDTV81STD_USER

01:2012\2012048\FRA\105523\ROADWAY\SHEETS\105523\5001.DGN
 11/21/2021
 2:16:04 PM
 GDDTV81STD_USER

SHEET NO.	202			202			202			202			202			202			202			202			202			202																				
	PAVEMENT REMOVED			PAVEMENT REMOVED, ASPHALT			WALK REMOVED			STEPS REMOVED			CONCRETE BARRIER REMOVED			TRAFFIC ISLAND REMOVED			CURB REMOVED			CURB AND GUTTER REMOVED			GUARDRAIL REMOVED			PIPE REMOVED, 24" AND UNDER			PIPE REMOVED, OVER 24"			REMOVAL MISC.: WOOD POLE														
	01/NHS/PV	01/NHS/PV	05/NHS/OT/COL	01/NHS/PV	01/NHS/PV	05/NHS/OT/COL	01/NHS/PV	05/NHS/OT/COL		01/NHS/PV	01/NHS/PV	01/NHS/PV	01/NHS/PV	01/NHS/PV	01/NHS/PV	01/NHS/PV	01/NHS/PV	05/NHS/OT/COL	01/NHS/PV	01/NHS/PV	01/NHS/PV	01/NHS/PV	01/NHS/PV	01/NHS/PV	01/NHS/PV	01/NHS/PV	01/NHS/PV	01/NHS/PV	01/NHS/PV	01/NHS/PV																		
242																					2812	3579																										
246																										440	559		93	119																		
247																										1034	1317					2																
248																													121																			
254																													794																			
256	4850	5604	62	3781	4261	19	671				122	155	15	19			2995	3760	83	60																												
257	5672	7145		11591	4407	1234	23372	2612		4	752	957	2070	2634			5747	3194	585																													
TOTALS CARRIED TO GENERAL SUMMARY	10522	12749	62	15372	8668	1253	24043	2612		4	874	1112	2085	2653			8742	6954	668	60	2812	3579				1474	1876	915	93	119	2																	
SHEET NO.	202			202			202			202			202			202			202			202			202			202			202																	
	MANHOLE REMOVED			CATCH BASIN REMOVED			INLET REMOVED			CATCH BASIN ABANDONED			INLET ABANDONED			INLET ABANDONED, AS PER PLAN			MANHOLE ABANDONED			MANHOLE ABANDONED, AS PER PLAN "A"			MANHOLE ABANDONED, AS PER PLAN "B"			VALVE BOX REMOVED			REMOVAL MISC.: BENCH REMOVED AND RESET			REMOVAL MISC.: TRAFFIC BOLLARDS REMOVED			REMOVAL MISC.: BOLLARDS			REMOVAL MISC.: ROCK ART MONOLITH			REMOVAL MISC.: BRICK PAVERS REMOVED AND SALVAGED			REMOVAL MISC.: LIGHT POLE		
	01/NHS/PV	01/NHS/PV	01/NHS/PV	01/NHS/PV	01/NHS/PV	05/NHS/OT/COL	01/NHS/PV	01/NHS/PV	05/NHS/OT/COL	01/NHS/PV	01/NHS/PV	05/NHS/OT/COL	01/NHS/PV	05/NHS/OT/COL	01/NHS/PV														
230									1	2	1	1	1	2			1	1	1	2	2																											
234	3	3		5	7		7	8																																								
235	4	6		3	4	1	7	8	1																																							
247																											1		4	2					3													
248			6																																													
254																																																
255																																																
257																																																
TOTALS CARRIED TO GENERAL SUMMARY	7	9	6	8	11	1	14	16	1	1	2	1	1	1	2		1	1	1	2	2	6	1	359	4	2	194	4068					3															

CALCULATED CJC CHECKED CWL
ROADWAY SUBSUMMARY
FRA - 70 / 71-12.68 / 14.86
 219
 1815

NO.	DESCRIPTION	REV. BY	DATE
4	FUNDING CODE CHANGE	CWL	11-29-2021

01:2012/2012048\FRA\105523\ROADWAY\SHEETS\105523S002.DGN
 11/21/2021
 2:21:53 PM
 G00TV81STD_USER

SHEET NO.	606		202			202		607			606		606		606		606		606		607			607		607		607			
	IMPACT ATTENUATOR, TYPE 3 UNIDIRECTIONAL (50 MPH, 48" WIDTH)	IMPACT ATTENUATOR, TYPE 3 UNIDIRECTIONAL (50 MPH, 90" WIDTH)	FENCE REMOVED	GATE REMOVED	TEMPORARY VANDAL FENCE, TYPE B	GUARDRAIL, TYPE MGS	ANCHOR ASSEMBLY, MGS TYPE E (MASH 2016)	ANCHOR ASSEMBLY, MGS TYPE T	MGS BRIDGE TERMINAL ASSEMBLY, TYPE 1	MGS BRIDGE TERMINAL ASSEMBLY, TYPE 2	IMPACT ATTENUATOR, TYPE 3 UNIDIRECTIONAL (60 MPH, 48" WIDTH)	FENCE REMOVED AND REBUILT	FENCE, TYPE CLT	FENCE, TYPE CLT, AS PER PLAN "A"	FENCE, TYPE CLT, AS PER PLAN "B"																
	EACH	EACH	FT	FT	FT	FT	FT	FT	FT	FT	FT	FT	FT	FT	FT	FT	FT	FT	FT	FT	FT	FT	FT	FT	FT	FT	FT				
	01/NHS/PV	01/NHS/PV	01/NHS/PV	01/NHS/PV	05/NHS/OT/COL	01/NHS/PV	01/NHS/PV	01/NHS/PV	01/NHS/PV	01/NHS/PV	01/NHS/PV	01/NHS/PV	01/NHS/PV	01/NHS/PV	01/NHS/PV	01/NHS/PV	01/NHS/PV	01/NHS/PV	01/NHS/PV	01/NHS/PV	01/NHS/PV	05/NHS/OT/COL	01/NHS/PV	01/NHS/PV	01/NHS/PV	01/NHS/PV	01/NHS/PV				
230																															
240			2105	2679	424		1	325	414																						
241	1	1								4164	5299	2	3	2	2	8	11	4	6												
TOTALS CARRIED TO GENERAL SUMMARY	1	1	2105	2679	424		1	325	414	4164	5299	2	3	2	2	8	11	4	6	1	1		18	23	47	212	269	244	310	324	412
SHEET NO.	607		607			608			608			608			608			622		622		626*			626*		607				
	GATE, TYPE CLT, AS PER PLAN "A"	FENCELINE SEEDING AND MULCHING	4" CONCRETE WALK	8" CONCRETE WALK	WALKWAY, MISC.: COLUMBUS CURB RAMP, TYPE A	WALKWAY, MISC.: COLUMBUS CURB RAMP, TYPE P-7	WALKWAY, MISC.: COLUMBUS CURB RAMP, TYPE P-4 MODIFIED	CONCRETE STEPS, TYPE B, AS PER PLAN	WALKWAY, MISC.: BRICK PAVER WALK	PORTABLE BARRIER, UNANCHORED, AS PER PLAN	PORTABLE BARRIER, ANCHORED, AS PER PLAN	BARRIER REFLECTOR, TYPE 1, ONE-WAY	BARRIER REFLECTOR, TYPE 2, ONE-WAY	GATE, TYPE CLT, AS PER PLAN "B"																	
	EACH	FT	SF	SF	EACH	EACH	EACH	FT	SF	FT	FT	FT	FT	FT	FT	FT	FT	FT	FT	FT	FT	FT	FT	FT	FT	FT	FT				
	01/NHS/PV	01/NHS/PV	01/NHS/PV	01/NHS/PV	04/MPO/OT	05/NHS/OT/COL	01/NHS/PV	04/MPO/OT	05/NHS/OT/COL	01/NHS/PV	01/NHS/PV	01/NHS/PV	01/NHS/PV	04/MPO/OT	06/ENH/OT/COL	01/NHS/PV	01/NHS/PV	01/NHS/PV	01/NHS/PV	01/NHS/PV	01/NHS/PV	01/NHS/PV	01/NHS/PV	01/NHS/PV	01/NHS/PV	01/NHS/PV	01/NHS/PV				
230																839	703	661	1150												
240																															
241	1	391	497																												
259					3441	54	7516		541	30	369		6	1	1		233	1703													
260					9481	135			667	39			10			14	358	480													
TOTALS CARRIED TO GENERAL SUMMARY	1	391	497	12922	189	7516		1208	69	369		16	1	1	14	591	2183		839	703	661	1150		106	134	59	76		1	1	

CALCULATED CJC
 CHECKED CWL
ROADWAY SUBSUMMARY
FRA-70/71-12.68/14.86
 220
 1815

* QUANTITY CARRIED TO TRAFFIC CONTROL GENERAL SUMMARY ON SHEET 961																																
	NO.	DESCRIPTION	REV. BY	DATE																												
	4	FUNDING CODE CHANGE	CWL	11-29-2021																												

01\2012\2012048\FRA\105525\ROADWAY\SHEETS\105525\5003.DGN
 11/21/2021
 2:25:15 PM
 G00TV81STD_USER

SHEET NO.	601 TIED CONCRETE BLOCK MAT, TYPE 1		601 TIED CONCRETE BLOCK MAT, TYPE 2		601 ROCK CHANNEL PROTECTION, TYPE C WITH FILTER		601 PAVED GUTTER, TYPE 1-2, AS PER PLAN		601 CONCRETE SLOPE PROTECTION		660 SODDING UNSTAKED		670 DITCH EROSION PROTECTION																											
	SY	01/NHS/P V	01/NHS/P V	SY	01/NHS/P V	01/NHS/P V	SY	01/NHS/P V	01/NHS/P V	SY	01/NHS/P V	01/NHS/P V	SY	01/NHS/P V	01/NHS/P V	SY	01/NHS/P V	01/NHS/P V																						
236	98	125		107	136		3	3		251	320		496	631		42	53		1018	1295																				
TOTALS CARRIED TO GENERAL SUMMARY		98	125		107	136		3	3		251	320		496	631		42	53		1018	1295																			
SHEET NO.	832 STORM WATER POLLUTION PREVENTION PLAN		832 STORM WATER POLLUTION PREVENTION INSPECTIONS		832 STORM WATER POLLUTION PREVENTION INSPECTION SOFTWARE		832 EROSION CONTROL																																	
	LS	01/NHS/P V	01/NHS/P V	LS	01/NHS/P V	01/NHS/P V	LS	01/NHS/P V	01/NHS/P V	EACH	01/NHS/P V	01/NHS/P V																												
236																																								
261	LS	LS	LS	LS	LS	LS	LS	LS	506000	644000																														
TOTALS CARRIED TO GENERAL SUMMARY		LS	LS	LS	LS	LS	LS	LS	506000	644000																														

NO.	DESCRIPTION	REV. BY	DATE
4	FUNDING CODE CHANGE	CWL	11-29-2021

CALCULATED CJC
 CHECKED CWL
EROSION CONTROL SUBSUMMARY
 FRA-70/71-12.68/14.86
 221
 1815

01:2012\2012048\FRA\105523\ROADWAY\SHEETS\105523S004.DGN
 11/21/2021 2:34:06 PM
 CDDTV81STD_USER

SHEET NO.	602		605		605		605		605		605		605		611		611		611		611		611		611		611		611		611		611		611		611		
	CONCRETE MASONRY	01/NHS /PV	01/NHS /PV	05/NHS/ OT/COL	05/NHS/ OT/COL	01/NHS /PV	05/NHS/ OT/COL	01/NHS /PV	05/NHS/ OT/COL	01/NHS /PV	05/NHS/ OT/COL	01/NHS /PV	05/NHS/ OT/COL	01/NHS /PV	05/NHS/ OT/COL	01/NHS /PV	05/NHS/ OT/COL	01/NHS /PV	05/NHS/ OT/COL	01/NHS /PV	05/NHS/ OT/COL	01/NHS /PV	05/NHS/ OT/COL	01/NHS /PV	05/NHS/ OT/COL	01/NHS /PV	05/NHS/ OT/COL	01/NHS /PV	05/NHS/ OT/COL	01/NHS /PV	05/NHS/ OT/COL	01/NHS /PV	05/NHS/ OT/COL	01/NHS /PV	05/NHS/ OT/COL	01/NHS /PV	05/NHS/ OT/COL		
242	0.9	1.1																																					
243																																							
244																																							
245																																							
246																																							
250																																							
251																																							
252																																							
252A																																							
252B																																							
TOTALS CARRIED TO GENERAL SUMMARY	0.9	1.1	12	345	43	9	1684	311	6146	7821	523	661	11136	14145	163	20	285	360	22		297	378	38	49	7	9	44	56	1022	1300	15	19	281	358	264	337	775	985	

SHEET NO.	611		611		611		611		611		611		611		611		611		611		611		611		611		611		611		611		611		611		611		
	15" CONDUIT, TYPE C, 706.02 WITH 706.11 JOINTS	01/NHS /PV	01/NHS /PV	243																																							
244	125	159	10	12	50	63																																	
245			7	8	308	391																																	
246																																							
TOTALS CARRIED TO GENERAL SUMMARY	125	159	17	20	437	555	115	146	33	43	44	57	110	139	148	187	138	174	57	73	312	397	233	298	55	71	8	12	4	6	128	164	5	7	12	16	55	71	

CALCULATED CJC CHECKED CWL

DRAINAGE SUBSUMMARY

FRA-70/71-12.68/14.86

222
1815

NO.	DESCRIPTION	REV BY	DATE
1	FUNDING CODE CHANGE	CWL	11-29-2021

01:2012\2012048\FRA\105525\ROADWAY\SHEETS\105525S005.DGN
 11/21/2021 2:39:21 PM
 CDDTV81STD_USER

SHEET NO.	SPECIAL		SPECIAL		SPECIAL		SPECIAL		837		611		611		611		611		611		611		611		611		611		SPECIAL		
	01/NHS/PV	01/NHS/PV	01/NHS/PV	01/NHS/PV	05/NHS/OT/COL	01/NHS/PV	01/NHS/PV	05/NHS/OT/COL	
230																															
231																															
232																															
233																															
243																															
245																															
246																															
TOTALS CARRIED TO GENERAL SUMMARY	71	91	217	278	143	25	31	44	55	162	207	5	7	7	8	1	3	1	1	1	1	4	6	1	3	3	6	1	3	3	2
SHEET NO.	SPECIAL		SPECIAL		611		SPECIAL		611		611		611		611		SPECIAL		611		611		611		611		611				
	05/NHS/OT/COL	01/NHS/PV	01/NHS/PV	01/NHS/PV	01/NHS/PV	01/NHS/PV	01/NHS/PV	01/NHS/PV	01/NHS/PV	01/NHS/PV	01/NHS/PV	01/NHS/PV	01/NHS/PV	01/NHS/PV	01/NHS/PV	01/NHS/PV	01/NHS/PV	01/NHS/PV	05/NHS/OT/COL	01/NHS/PV	01/NHS/PV	01/NHS/PV	01/NHS/PV	01/NHS/PV	01/NHS/PV	05/NHS/OT/COL	01/NHS/PV	01/NHS/PV			
230																															
231																															
232																															
233																															
234																															
245																															
250																															
251																															
TOTALS CARRIED TO GENERAL SUMMARY	1	2	2	1	32	41	1	4	6	4	4	12	14	4	6	3	5	1	1	1	1	1	1	2	1	2	2	2			

CALCULATED CJC CHECKED CWL
DRAINAGE SUBSUMMARY
FRA-70/71-12.68/14.86
 223
 1815

NO.	DESCRIPTION	REV. BY	DATE
4	FUNDING CODE CHANGE	CWL	11-29-2021

01/20/21 2:04:48 PM FRA\105523\ROADWAY\105523\SS006.DGN
 11/21/2021 2:42:32 PM
 C001V81STD_USER

SHEET NO.	SPECIAL		638	638	638	SPECIAL	638	638	SPECIAL	SPECIAL		SPECIAL	SPECIAL		SPECIAL		638		SPECIAL	SPECIAL	SPECIAL	SPECIAL
	INCREASE OR DECREASE IN EXCAVATION AND BACKFILL (COLUMBUS 811)		WATER WORK, MISC.: 1.5" WATER TAP (COLUMBUS 805)	WATER WORK, MISC.: 3" WATER SERVICE LINE TRANSFER (COLUMBUS 805)	WATER WORK, MISC.: 6" WATER SERVICE LINE TRANSFER (COLUMBUS 805)	6" WATER MAIN DIP AND FITTINGS (COLUMBUS 801)	WATER WORK, MISC.: 20" x 6" TAPPING SLEEVE AND VALVE AND APPURTENANCES	WATER WORK, MISC.: 24" x 6" TAPPING SLEEVE AND VALVE AND APPURTENANCES	8" WATER MAIN DIP AND FITTINGS (COLUMBUS 801)	8" GATE VALVE WITH VALVE BOX (COLUMBUS 802)		12" WATER MAIN DIP AND FITTINGS (COLUMBUS 801)	12" GATE VALVE WITH VALVE BOX (COLUMBUS 802)		20" WATER MAIN DIP AND FITTINGS (COLUMBUS 801)		WATER WORK, MISC.: 1.5" CURB STOP (COLUMBUS 805)		CUT AND PLUG EXISTING 6" WATER LINE (COLUMBUS 808)	CUT AND PLUG EXISTING 8" WATER LINE (COLUMBUS 808)	CUT AND PLUG EXISTING 10" WATER LINE (COLUMBUS 808)	CUT AND PLUG EXISTING 12" WATER LINE (COLUMBUS 808)
	CY		EACH	EACH	EACH	FT	EACH	EACH	FT	EACH		FT	EACH		FT		EACH		EACH	EACH	EACH	EACH
	01/NHS/PV		01/NHS/PV	01/NHS/PV	01/NHS/PV	01/NHS/PV	01/NHS/PV	01/NHS/PV	01/NHS/PV	01/NHS/PV		01/NHS/PV	01/NHS/PV		01/NHS/PV		01/NHS/PV		01/NHS/PV	01/NHS/PV	01/NHS/PV	01/NHS/PV
253			2	1	1	194	1	1	62	1		611	2			2						
254																			1	4	1	2
255						110									4				1			
TOTALS CARRIED TO GENERAL SUMMARY		40	2	1	1	304	1	1	62	1		611	2		4		2		2	4	1	2
SHEET NO.	SPECIAL	SPECIAL	SPECIAL	638	638	SPECIAL	SPECIAL	SPECIAL	SPECIAL	611	638	SPECIAL	638	638			SPECIAL	SPECIAL		611		
	CUT AND PLUG EXISTING 20" WATER LINE (COLUMBUS 808)	20" BUTTERFLY VALVE WITH VALVE BOX (COLUMBUS 802)	6" GATE VALVE WITH VALVE BOX (COLUMBUS 802)	WATER WORK, MISC.: 6" WATER MAIN ABANDONED (COLUMBUS 808)	WATER WORK, MISC.: 8" WATER MAIN ABANDONED (COLUMBUS 808)	CITY OF COLUMBUS MANHOLE, TYPE C (44-S102)	CITY OF COLUMBUS MANHOLE, TYPE C, AS PER PLAN (44-S102)	CITY OF COLUMBUS 18" CONDUIT, C905 PIPE, WITH TYPE 1 BEDDING, WITH ITEM 912 COMPACTED GRANULAR MATERIAL	6" FIRE HYDRANT (COLUMBUS 809)	MANHOLE ADJUSTED TO GRADE, AS PER PLAN (SANITARY)	WATER WORK, MISC.: 20" WATER MAIN ABANDONED (COLUMBUS 808)	FIRE HYDRANT ABANDONED (COLUMBUS 809)	WATER WORK, MISC.: FIRE HYDRANT, RELOCATED (COLUMBUS 809)	FIRE HYDRANT ADJUSTED TO GRADE		VALVE BOX ADJUSTED TO GRADE (COLUMBUS 807)		DUCTILE IRON FITTINGS, INCREASE OR DECREASE (COLUMBUS 801)		MANHOLE ADJUSTED TO GRADE, AS PER PLAN		
	EACH	EACH	EACH	EACH	EACH	EACH	EACH	EACH	EACH	01/NHS/PV	EACH	EACH	EACH	EACH	EACH		LB		EACH			
	01/NHS/PV	01/NHS/PV	01/NHS/PV	01/NHS/PV	01/NHS/PV	01/NHS/PV	01/NHS/PV	01/NHS/PV	01/NHS/PV	01/NHS/PV	01/NHS/PV	01/NHS/PV	01/NHS/PV	01/NHS/PV	05/NHS/OT /COL		01/NHS/PV	05/NHS/OT /COL	01/NHS/PV		01/NHS/PV	
248						3	1	204		2												
253		1	1						3				1									
254				1	2							4		1			11	9				
255	1		1	1					1		1	1		1			9				1	
TOTALS CARRIED TO GENERAL SUMMARY		1	1	2	2	3	1	204	4	2	1	5	1	1	1		20	9	500		1	

NO.	DESCRIPTION	REV. BY	DATE
4	FUNDING CODE CHANGE	CWL	11-29-2021

WATER WORK & SANITARY SEWER SUBSUMMARY
 CALCULATED JMB
 CHECKED CWL
FRA-70/71-12.68/14.86
 224
 1815

01-201212012048\FRA\105523\ROADWAY\SHEETS\105523\5007.DGN
 11/21/2021
 2:45:56 PM
 G00TV81STD_USER

SHEET NO.	SPECIAL	SPECIAL		HANDHOLE	SUBMERSIBLE SEPARABLE CONNECTOR	(3) - 750KCMIL Cu, 15KV, XLP Ins. 133% w/ Cu TAPE SHIELD WITH (1)-350KCMIL Cu, 600V NEUTRAL	2x1 CONCRETE DUCT BANK - 5" PVC (TDMIS-3000)	PADMOUNT SF6 SWITCHGEAR	2x2 CONCRETE DUCT BANK - 5" PVC (TDMIS-3000)	BORE SPACERS FOR 6" SCH 40 PVC CONDUIT	75KVA LOOP FEED SINGLE PHASE PADMOUNT TRANSFORMER (TDMIS-1201)	300KVA LOOP FEED THREE PHASE PADMOUNT TRANSFORMER, 14.4 KV, DELTA/208/120 (TDMIS-1202)	750KVA LOOP FEED THREE PHASE PADMOUNT TRANSFORMER, 14.4KV, DELTA/480/277 (TDMIS-1202)	FIBERGLASS FLAT PAD FOR SINGLE PHASE TRANSFORMERS (TDMIS-1009)	50 1/2 WOOD POLE	THREE PHASE DEADEND ATTACHMENTS (TDMIS-406)	WOOD CROSSARM (TDMIS-10)	PRIMARY DOWN GUY (TDMIS-100)	DISTRIBUTION POLE GROUND (TDMIS-7)	DISTRIBUTION RISER (TDMIS-1001)	11.25° SCH 40 PVC CONDUIT SWEEP	DOP MANHOLE (TDMIS-1015)	4'x 4' x 4' PULLBOX	BRIDGE MOUNTED CONDUIT HANGER	CABLE TRAY RISER	22.5° SCH 40 PVC CONDUIT SWEEP	FIBERGLASS TO PVC CONDUIT COUPLER		
EACH	EACH	FT	FT	EACH	FT	EACH	EACH	EACH	EACH	EACH	EACH	EACH	EACH	EACH	EACH	EACH	EACH	EACH	EACH	EACH	EACH	EACH	EACH			
237			1970				110						1	1	1	2	1	1	12	4		1	65	1	6	6
238	1	1	238		262						1											1				
239	3	6	1245	165	1	721		1	1	1	1								5							
TOTALS CARRIED TO GENERAL SUMMARY			4	7	2208	1245	427	1	721	110	2	1	1	2	1	1	1	12	4	5	2	65	1	6	6	
SHEET NO.	SPECIAL	SPECIAL		WOOD POLE, REMOVAL (TDMIS-1600)	OVERHEAD TRANSFORMER, REMOVAL (TDMIS-1600)	WIRE AND CABLE REMOVAL (TDMIS 1600)	6" FIBERGLASS CONDUIT EXPANSION FITTINGS	ADJUSTING EXISTING GRADE	5" FIBERGLASS 90° SWEEP	EXISTING MANHOLE REMOVAL	MEDIUM VOLTAGE CABLE ACCEPTANCE TESTING	5" SCH 40 PVC CONDUIT	6" SCH 40 PVC CONDUIT	30" DIRECTIONAL BORE AND PIPE, 748.06	5" XHW FIBERGLASS CONDUIT	6" XHW FIBERGLASS CONDUIT	4" SCH 40 PVC CONDUIT	(3)-350KCMIL Cu, 15KV, XLP Ins. 133% w/ Cu TAPE SHIELD WITH (1)-4/0 Cu, 600V NEUTRAL	(3)-#1 AL, 15KV, XLP WITH (1)-#2 AL, 600V NEUTRAL	2x3 CONCRETE DUCT BANK - 6" PVC (TDMIS-3000)	3x3 CONCRETE DUCT BANK - 5" PVC (TDMIS-3000)	PADMOUNT TRANSFORMER RELOCATION	(1)-250KCMIL Cu, 15KV, XLP Ins. 133% w/ Cu TAPE SHIELD WITH (1)-1/0 Cu, 600V NEUTRAL	(3)-500KCMIL Cu, 15KV, XLP Ins. 133% w/ Cu TAPE SHIELD WITH (1)-350KCMIL Cu, 600V NEUTRAL	(3)-#1 Cu, 15KV, XLP Ins. 133% w/ Cu TAPE SHIELD WITH (1)-#1 Cu, 600V NEUTRAL	(2) - #2 AL, 15KV XLP, 133% INS JCN			
EACH	EACH	FT	EACH	EACH	EACH	EACH	EACH	FT	FT	FT	FT	FT	FT	FT	FT	FT	FT	FT	EACH	FT	FT	FT	FT			
237			11		3	12	1			84	5254	551	777	6210	347	1407	420	238	196		2	282				
238	5																									
239	7	11	7400		1			12											475		1245	1317	125			
TOTALS CARRIED TO GENERAL SUMMARY			12	11	7400	11	4	12	84	5254	551	777	6210	347	1407	420	238	196	475	2	282	1245	1317	125		

CALCULATED CJC
 CHECKED ATR
ELECTRICAL SUBSUMMARY
FRA - 70 / 71 - 12.68 / 14.86
 225
 1815

NO.	DESCRIPTION	REV. BY	DATE
2	DOP TDMIS CHANGE	CWL	11-12-2021
4	FUNDING CODE CHANGE	CWL	11-29-2021

SHEET NO.	255	255	SPECIAL	SPECIAL	SPECIAL	SPECIAL	SPECIAL	SPECIAL	SPECIAL																					
	FULL DEPTH PAVEMENT REMOVAL AND RIGID REPLACEMENT, CLASS QC FS	FULL DEPTH PAVEMENT SAWING		4" CONDUIT RISER	CONDUIT ENCASED, 1 - 4"	CONDUIT ENCASED, 2 - 4"	CONDUIT ENCASED, 6 - 4"	CONDUIT ENCASED, 8 - 4"	PRIVATE TELECOM MANHOLE, AS PER PLAN																					
	SY	FT	EACH	FT	FT	FT	FT	FT	EACH																					
239	05/NHS/ OT/COL	05/NHS/ OT/COL	05/NHS/ OT/COL	05/NHS/ OT/COL	05/NHS/ OT/COL	05/NHS/ OT/COL	05/NHS/ OT/COL	05/NHS/ OT/COL	05/NHS/ OT/COL																					
249			4	204	122	26	1117	2																						
TOTALS CARRIED TO GENERAL SUMMARY	181	840	4	204	122	26	1117	2																						
SHEET NO.																														

NO.	DESCRIPTION	REV. BY	DATE
4	FUNDING CODE CHANGE	CWL	11-29-2021

TOTALS CARRIED TO
GENERAL SUMMARY

CALCULATED
 CJC
 CHECKED
 ATR

TELECOM SUBSUMMARY

FRA - 70 / 71 - 12.68 / 14.86

225A
1815

D:\2012\2012048\FRA\105523\ROADWAY\SHEETS\105523\S009.DGN
 11/29/2021
 9:41:06 AM
 GDDTV81STD_USER

SHEET NO.	STATION TO STATION		203	203	203	203	204	204	203	203	659	659	659	659	659	659	659	659
			EXCAVATION CY	EMBANKMENT CY	EMBANKMENT, AS PER PLAN "A" CY	EMBANKMENT, AS PER PLAN "B" CY	GRANULAR MATERIAL, TYPE B CY	EXCAVATION OF SUBGRADE CY	GRANULAR EMBANKMENT CY	GRANULAR EMBANKMENT, AS PER PLAN CY	SEEDING AND MULCHING (SM) SY	SOIL ANALYSIS TEST EACH	TOPSOIL (111*(SM)/1000) CY	REPAIR SEEDING AND MULCHING (0.05*(SM)) SY	INTER-SEEDING (0.05*(SM)) SY	COMM. FERTILIZER [(30*(SM))+ (20*.05*(SM))]*9 /1000*2000 TON	LIME (SM)/(4840) ACRE	WATER [(2*300*(SM)) +(300*.05*(SM))]*9 /1000*1000 MGAL
NB I-71																		
441	269+50.00	270+50.00	1325	830							1870							
442	271+00.00	271+50.00	455	136							1091							
443	272+00.00	272+50.00	276	48							510							
444	273+00.00	273+64.54	115	1							115							
RAMP A5																		
445	5003+23.96	5004+00.00	439	3							0							
446	5004+50.00	5005+50.00	776	139							139							
447	5006+00.00	5007+00.00	1170	44							508							
448	5007+50.00	5008+00.00	1177	242							574							
449	5008+50.00	5009+50.00	62	2737							781							
450	5010+00.00	5011+00.00	66	7602							1191							
451	5011+50.00	5012+18.10	647	7506							1058							
452	5012+50.00	5013+00.00	41	9024	1591						1356							
453	5013+50.00	5014+00.00	44		10620						1467							
454	5014+50.00	5015+00.00	18		4574	18					735							
455	5015+06.59	5015+36.59	13		681						293							
RAMP C3																		
456	3000+16.87	3001+00.00	0	88							0							
457	3001+50.00	3002+50.00	7	100							75							
458	3003+00.00	3004+00.00	3	533							108							
459	3004+50.00	3005+50.00	13	991							627							
460	3006+00.00	3007+00.00	27	179							470							
461	3007+50.00	3008+50.00	111	14							213							
462	3009+00.00	3010+00.00	0	0							0							
RAMP C5																		
463	5024+38.21	5026+00.00	169	4							173							
464	5026+50.00	5028+00.00	196	439							694							
465	5028+50.00	5030+00.00	269	1627							1142							
466	5030+50.00	5031+36.49	156	2087							711							
467	5031+66.55	5032+65.33	58	249							8							
468	5033+00.00	5033+50.00	61	311							72							
469	5034+00.00	5034+83.94	26	455							149							
470	5034+97.48	5035+50.00	2	744							241							
471	5036+00.00	5036+50.00	33	911							197							
472	5037+00.00	5038+00.00	32	799							314							
473	5038+50.00	5039+50.00	18	279	703						686							
474	5040+00.00	5041+17.78	62		6025						1466							
475	5041+50.00	5042+00.00	132	2060	2950						1317							
476	5042+50.00	5047+55.00	1371	86							567							
477	5061+83.35	5047+72.06	2804	0							598							
478	5062+50.00	5063+50.00	5864	670							1092							
479	5064+00.00	5065+00.00	881	3615							997							
480	5065+50.00	5066+50.00	63	6681							1333							
481	5067+00.00	5068+00.00	58	11034							1714							
482	5068+50.00	5069+00.00	27	9070	167						1192							
483	5069+50.00	5070+00.00	13		9977						1112							
484	5070+50.00	5071+00.00	0		6409						696							
485	5071+18.62	5074+10.30	99		1258						267							
486	5074+40.30	5074+50.00	280		0						1612							
487	5075+00.00	5075+50.00	170	2	0						973							
488	5076+00.00	5076+08.84	66	0	0						84							
489	5076+50.00	5077+00.00	93	17					386	103	84							
490	5077+50.00	5078+00.00	68	49					909		253							
491	5078+50.00	5079+00.00	53	24					897		217							
492	5079+12.85	5079+50.00	61	13	0				473		119							
493	5080+00.00	5080+15.86	52	5					555	32	107							
494	5080+45.86	5081+38.82	0	11							97							
495	5081+68.82	5081+98.63	0	9							67							
496	5082+00.00	5082+50.00	0	6							71							
											158							
SUBTOTALS CARRIED TO SHEET 229			20022	71474	44955				3220	3353	31176							

NO.	DESCRIPTION	REV. BY	DATE
4	UPDATED EARTHWORK	CWL	11-29-2021

CALCULATED ATR CHECKED CWL
EARTHWORK SUBSUMMARY AND CALCULATIONS
FRA - 70 / 71-12.68 / 14.86
 227
 1815

01\2012\201204\FRA\05523\ROADWAY\SHEETS\105230501.DWG
11/29/2021
9:28:25 AM
G00TV81STD_USER

SHEET NO.	STATION TO STATION		203	203	203	203	204	204	659	659	659	659	659	659	659
			EXCAVATION CY	EMBANKMENT CY	EMBANKMENT, AS PER PLAN "A" CY	EMBANKMENT, AS PER PLAN "B" CY	GRANULAR MATERIAL, TYPE B CY	EXCAVATION OF SUBGRADE CY	SEEDING AND MULCHING (SM) SY	SOIL ANALYSIS TEST EACH	TOPSOIL (111*(SM))/(1000) CY	REPAIR SEEDING AND MULCHING (0.05*(SM)) SY	INTER-SEEDING (0.05*(SM)) SY	COMM. FERTILIZER [(30*(SM))+ (20*.05*(SM))]*9 /1000*(2000) TON	LIME (SM)/(4840) ACRE
RAMP C5															
497	5083+00.00	5083+50.00	0	4					172						
498	5084+00.00	5084+20.00	0	3					58						
499	5084+50.00	5085+00.00	0	650					50						
500	5085+50.00	5086+00.00	0	310					8						
FRONT ST.															
501	147+50.00	147+91.50	26	3			46	46	0						
502	148+00.00	148+50.00	57	14			144	144	0						
503	148+61.92	150+88.81	139	25			240	240	0						
504	151+19.35	151+50.00	94	55			193	193	0						
505	152+00.00	152+50.00	68	5			112	112	0						
FULTON ST.															
506	19+25.00	19+50.00	0	0					0						
507	19+87.23	20+00.00	123	4			104	104	0						
508	20+20.46	20+50.00	88	2			94	94	0						
509	20+55.92	21+00.00	84	3			98	98	0						
510	21+24.00	21+50.00	83	52			104	104	0						
511	22+00.00		73	108			108	108	0						
512	22+50.00		67	61			107	107	0						
513	23+00.00	23+15.00	18	1			30	30	0						
LIVINGSTON AVE.															
514	200+00.00	200+50.00	50	28			84	84	52						
515	201+00.00	201+94.78	51	57			108	108	98						
516	202+00.00	202+45.02	22	16			44	44	32						
517	204+02.13	204+50.00	78	4			111	111	58						
518	204+61.50	205+00.00	55	31			63	63	22						
519	205+50.00	206+00.00	97	179			140	140	23						
520	206+50.00	206+80.00	41	129			83	83	48						
521	207+00.00	207+47.00	45	65			73	73	31						
522	207+50.00		0	0			0	0	0						
RELOCATED BIKE PATH															
630	8+48.00	8+50.00	54	6					79						
631	9+00.00	9+50.00	1198	1					422						
632	10+00.00	10+50.00	1387	0					53						
633	10+66.95	11+00.00	262	2					0						
634	11+00.40	11+29.28	13	3					0						
635	11+50.00	11+53.75	1	0					0						
BIKE PATH DETOUR															
639	1+50.00	2+50.00	32	3					120						
640	3+00.00	3+50.00	126	15					256						
641	4+00.00	4+50.00	120	1					164						
642	5+00.00	5+50.00	27	3					83						
643	6+00.00	6+50.00	47	8					139						
643A	7+00.00	8+00.00	63	15					206						
643B	8+50.00	9+00.00	31	6					97						
643C	9+50.00	10+00.00	28	6					97						
643D	10+50.00	11+00.00	41	27					208						
643E	11+50.00	12+00.00	35	44					222						
643F	12+50.00	13+00.00	36	25					183						
643G	13+50.00	14+50.00	51	5					123						
643H	15+00.00	16+00.00	56	6					142						
643J	16+50.00	17+50.00	55	4					228						
643K	18+00.00	18+50.00	30	2					113						
643L	19+00.00	19+50.00	24	195					300						
SUBTOTALS CARRIED TO SHEET 229			5076	2186			2086	2086	3887						

NO.	DESCRIPTION	REV.	BY	DATE
4	UPDATED EARTHWORK			11-29-2021

D:\2012\2012048\FRA\105523\ROADWAY\SHEETS\105523\5911.DGN
 11/28/2021 9:36:51 AM
 CDDTV81STD_USER

SHEET NO.	STATION TO STATION		203	203	203	203	204	204	203	203	659	659	659	659	659	659	659	
			EXCAVATION CY	EMBANKMENT CY	EMBANKMENT, AS PER PLAN "A" CY	EMBANKMENT, AS PER PLAN "B" CY	GRANULAR MATERIAL, TYPE B CY	EXCAVATION OF SUBGRADE CY	GRANULAR EMBANKMENT CY	GRANULAR EMBANKMENT, AS PER PLAN CY	SEEDING AND MULCHING (SM) SY	SOIL ANALYSIS TEST EACH	TOPSOIL (111*(SM))/(1000) CY	REPAIR SEEDING AND MULCHING (0.05*(SM)) SY	INTER-SEEDING (0.05*(SM)) SY	COMM. FERTILIZER [(30*(SM))+ (20*.05*(SM))]*9 /1000*2000 TON	LIME (SM)/(4840) ACRE	WATER [(2*300*(SM)) +(300*.05*(SM))]*9 /1000*1000 MGAL
BIKE PATH DETOUR																		
643M	20+00.00	20+50.00	113	168							436							
643N	21+00.00	21+50.00	46	68							262							
643P	22+00.00	22+50.00	38	0							104							
643R	23+00.00		0	0							0							
SUBTOTALS FROM THIS SHEET			197	236							802							
SUBTOTALS FROM SHEET 226			32673	43898		87			35723	5120	19360							
SUBTOTALS FROM SHEET 227			20022	71474	44955				3220	3353	31176							
SUBTOTALS FROM SHEET 228			5076	2186			2086	2086			3887							
SUBTOTALS FOR SEEDING & MULCHING CALCULATIONS TOTALS CARRIED TO THE GENERAL SUMMARY			57771	117794	44955	87	2086	2086	38943	8473	55225	2	6130	2761	2761	7.70	11.41	306
											55225	2	6130	2761	2761	7.70	11.41	306

NO.	DESCRIPTION	REV.	BY	DATE
4	UPDATED EARTHWORK		CWL	11-29-2021

CALCULATED	ATR	CHECKED	CWL
EARTHWORK SUBSUMMARY AND CALCULATIONS			
FRA - 70 / 71-12.68 / 14.86			
			229 1815

01:2012\2012048\FRA\105525\ROADWAY\SHEETS\1055250002.DGN
 11/22/2021 7:26:01 AM
 GDDTV81STD_USER

REF. NO.	SHEET NO.	STATION		SIDE	611		611		611		611		611		611		611		611		611			
		FROM	TO		CATCH BASIN, NO. 2-2B		CATCH BASIN, NO. 3		CATCH BASIN, NO. 3A		CATCH BASIN, NO. 6		CATCH BASIN, NO. 8		CATCH BASIN, NO. 8, AS PER PLAN		MANHOLE, NO. 3		MANHOLE, NO. 3, AS PER PLAN		INLET, NO. 3 FOR SINGLE SLOPE BARRIER, TYPE D		INLET, NO. 3 FOR SINGLE SLOPE BARRIER, TYPE D, AS PER PLAN	
					EACH		EACH		EACH		EACH		EACH		EACH		EACH		EACH		EACH			
					01/NHS/PV	01/NHS/PV	01/NHS/PV	01/NHS/PV	01/NHS/PV	01/NHS/PV	01/NHS/PV	01/NHS/PV	01/NHS/PV	01/NHS/PV	01/NHS/PV	01/NHS/PV	01/NHS/PV	01/NHS/PV	01/NHS/PV	01/NHS/PV	01/NHS/PV	01/NHS/PV		
D-62	312	271+27.21	(I-71 NB)	RT																				
D-63	312	271+89.00	(I-71 NB)	RT																				
D-64	310	265+52.70	(I-71 NB)	LT																				
D-66	281	4157+98.16	(I-70 EB)	RT																				
D-67	350	5068+00.00	(RAMP C5)	RT	1																			
D-68	350	5068+89.91	(RAMP C5)	RT	1																			
D-69	348	5064+56.00	(RAMP C5)	RT																				
D-70	348	5063+92.72	(RAMP C5)	RT																				
D-71	342	58+60.70	(EX SR 315 NB)	RT																				
D-100	352	5071+14.38	(RAMP C5)	RT																				
D-101	350	5068+00.00	(RAMP C5)	RT																				
D-104	281	5062+60.38	(RAMP C5)	LT																				
D-108	279	5061+00.00	(RAMP C5)	LT																				
D-110	281	5064+42.90	(RAMP C5)	LT																				
D-111	283	5067+64.83	(RAMP C5)	LT																				
D-113	281	5063+24.57	(RAMP C5)	LT																				
D-114	348	5061+97.48	(RAMP C5)	RT																				
D-154	294	4187+04.95	(I-70 EB)	LT																				
D-155	294	4187+79.05	(I-70 EB)	LT																				
D-157	292	4185+75.68	(I-70 EB)	LT																				
D-159	354	5078+00.00	(RAMP C5)	RT	1																			
D-160	289	4179+50.87	(I-70 EB)	LT																				
D-161	289	4177+26.22	(I-70 EB)	LT																				
D-162	294	187+68.00	(I-70 WB)	RT																				
D-165	289	4178+41.09	(I-70 EB)	LT																				
D-188	292	4183+00.32	(I-70 EB)	RT																				
D-189	289	4181+00.28	(I-70 EB)	RT																				
D-190	289	4179+15.29	(I-70 EB)	RT																				
D-191	292	4182+50.59	(I-70 EB)	LT																				
D-192	289	4179+50.59	(I-70 EB)	LT																				
D-201	333 - 335	5030+00.00	(RAMP C5)	RT	1																			
D-202	335	5031+07.19	(RAMP C5)	RT																				
D-204	335	5033+20.48	(RAMP C5)	RT																				
D-205	269	128+65.00	(I-70 EB)	LT																				
D-206	269	128+65.00	(I-70 EB)	RT																				
D-207	335	5032+85.51	(RAMP C5)	LT																				
D-208	335	5032+90.46	(RAMP C5)	RT																				
D-209	269	128+35.00	(I-70 EB)	RT																				
D-210	269	128+35.00	(I-70 EB)	LT																				
D-211	269	128+26.90	(I-70 EB)	LT																				
D-212	271	5036+50.00	(RAMP C5)	RT																				
D-213	327	3005+50.00	(RAMP C3)	RT	1																			
D-214	329	3007+12.85	(RAMP C3)	RT																				
D-215	329	3008+40.40	(RAMP C3)	RT																				
D-216	340	5041+41.91	(RAMP C5)	LT																				
D-217	269	5035+30.15	(RAMP C5)	LT																				
D-220	306	254+00.00	(I-71 NB)	RT																				
D-222	306	256+60.40	(I-71 NB)	RT																				
D-223	316	5004+57.60	(RAMP A5)	RT																				
D-224	281	4158+16.00	(I-70 EB)	RT																				
TOTALS CARRIED TO SUBSUMMARY SHEET 223					2	3	3	4	3	3	1	2	1	1	1	2	4	4	2	2	4	4	2	2

ESTIMATED QUANTITIES	NO.	DESCRIPTION	REV. BY	DATE
	4	FUNDING CODE CHANGE	CWL	11-29-2021
231	1815	FRA - 70 / 71 - 12.68 / 14.86		
CALCULATED	JMB	CHECKED	CWL	

0:\2012\2012048\FRA\105523\ROADWAY\SHEETS\1055230004.DGN
 11/22/2021 7:39:31 AM
 GDDTV81STD_USER

REF. NO.	SHEET NO.	STATION		SIDE	611		611		611		611		SPECIAL	611		611		SPECIAL	
		FROM	TO		CATCH BASIN, NO. 2-2B		CATCH BASIN, NO. 3		CATCH BASIN, NO. 3A		CATCH BASIN, NO. 6, AS PER PLAN		CITY OF COLUMBUS STANDARD CURB AND GUTTER INLET (AA-S125A WITH GRATE AA-S128)	MANHOLE, NO. 3		MANHOLE, NO. 3, AS PER PLAN		CITY OF COLUMBUS MANHOLE, TYPE C (AA-S102)	
					EACH		EACH		EACH		EACH		EACH	EACH		EACH		EACH	
					01/NHS/PV	01/NHS/PV	01/NHS/PV	01/NHS/PV	01/NHS/PV	01/NHS/PV	01/NHS/PV	01/NHS/PV	05/NHS/OT/COL	01/NHS/PV	01/NHS/PV	01/NHS/PV	01/NHS/PV	01/NHS/PV	01/NHS/PV
D-326	292	4184+88.80 (I-70 EB)		LT										1					
D-327	292	183+16.03 (I-70 WB)		LT				1											
D-328	292	185+73.90 (I-70 WB)		LT	1														
D-329	298	4200+81.39 (I-70 EB)		RT				1											
D-330	298	4201+50.63 (I-70 EB)		RT			1												
D-331	300	4202+53.27 (I-70 EB)		RT				1											
D-332	289,292	4182+00.61 (I-70 EB)		LT											1				
D-333	306	254+00.00 (I-71 NB)		RT					1										
D-334	316	5004+48.92 (RAMP A5)		RT					1										
D-340	375	206+09.66 (LIVINGSTON AVE.)		RT							1								
D-341	374	200+32.19 (LIVINGSTON AVE.)		RT														1	
D-342	374	201+05.57 (LIVINGSTON AVE.)		RT														1	
D-350	348	5061+19.30 (RAMP C5)		RT										1					
D-351	335	5030+41.57 (RAMP C5)		RT										1					
D-352	271	134+14.52 (I-70 EB)		RT			1												
D-353	292	4182+95.83 (I-70 EB)		LT											1				
D-354	371	21+62.24 (FULTON ST.)		LT														1	
TOTALS CARRIED TO SUBSUMMARY SHEET 223					0	1	1	1	1	2	1	1	1	1	2	1	1	1	2

NO.	DESCRIPTION	REV. BY	DATE
4	FUNDING CODE CHANGE	CWL	11-29-2021

CALCULATED JMB CHECKED CWL
ESTIMATED QUANTITIES
FRA - 70 / 71 - 12.68 / 14.86
 233
 1815

01:2012\2012048\FRA\105525\ROADWAY\SHEETS\1055250005.DGN
 11/22/2021
 7:43:15 AM
 GDDTV81STD_USER

REF. NO.	SHEET NO.	STATION		SIDE	202		202		202		611	611		611		611						
		FROM	TO		INLET REMOVED	MANHOLE REMOVED	CATCH BASIN REMOVED	DRAINAGE STRUCTURE, MISC.; GATEWELL RECONSTRUCTED TO GRADE	CATCH BASIN ADJUSTED TO GRADE, AS PER PLAN	INLET ADJUSTED TO GRADE, AS PER PLAN	MANHOLE ADJUSTED TO GRADE, AS PER PLAN											
					EACH	EACH	EACH	EACH	EACH	EACH	EACH	EACH	EACH	EACH	05/NHS/OT/COL							
					01/NHS/PV	01/NHS/PV	01/NHS/PV	01/NHS/PV	01/NHS/PV	01/NHS/PV	01/NHS/PV	01/NHS/PV	01/NHS/PV	01/NHS/PV	01/NHS/PV	01/NHS/PV	05/NHS/OT/COL					
DJ-12	372	11+70.88 (MOUND ST.)		RT									1									
DJ-13	372	11+95.78 (MOUND ST.)		LT													1					
DJ-14	372	12+05.15 (MOUND ST.)		RT													1					
DJ-15	372	12+32.40 (MOUND ST.)		RT													1					
DJ-16	372	12+34.55 (MOUND ST.)		LT													1					
DJ-17	316	5004+24.33 (RAMP A5)		RT													1					
DJ-300	375	205+82.26 (LIVINGSTON AVE.)		RT													1					
DJ-301	318	5009+96.16 (RAMP A5)		LT							1											
DR-2	287	4176+00.65 (I-70 EB)		RT													1					
DR-3	287	4173+93.28 (I-70 EB)		RT													1					
DR-4	287	4175+67.29 (I-70 EB)		RT													1					
DR-5	287	4175+77.80 (I-70 EB)		RT													1					
DR-6	289	4181+71.99 (I-70 EB)		LT													1					
DR-7	292	4182+71.83 (I-70 EB)		RT													1					
DR-8	292	4186+60.70 (I-70 EB)		RT													1					
DR-10	294	4189+99.14 (I-70 EB)		RT													1					
DR-13	292	4184+20.40 (I-70 EB)		RT													1					
DR-14	292	4185+04.95 (I-70 EB)		RT													1					
DR-15	269	130+96.22 (I-70 EB)		RT													1					
DR-17	269	128+25.44 (I-70 EB)		LT													1					
DR-18	269	128+26.90 (I-70 EB)		LT													1					
DR-19	335	5032+62.86 (RAMP C5)		LT													1					
DR-20	265	121+02.32 (I-70 EB)		RT													1					
DR-21	329	3008+40.40 (RAMP C3)		RT													1					
DR-22	356	5080+31.01 (RAMP C5)		RT													1					
DR-23	318	5006+31.25 (RAMP A5)		RT													1					
DR-24	318	5007+81.37 (RAMP A5)		RT													1					
DR-25	310	264+09.85 (I-71 NB)		LT													1					
DR-26	310	263+94.82 (I-71 NB)		RT													1					
DR-27	320	5014+19.04 (RAMP A5)		LT													1					
DR-28	320	5014+64.48 (RAMP A5)		LT													1					
DR-29	312	270+40.56 (I-71 NB)		RT													1					
DR-30	322	5016+01.77 (RAMP A5)		LT													1					
DR-31	322	5016+08.99 (RAMP A5)		LT													1					
DR-37	306	257+57.31 (I-71 NB)		RT													1					
DR-38	316	258+72.82 (I-71 NB)		RT													1					
DR-40	267	124+01.85 (I-70 EB)		RT													1					
DR-41	287	4176+91.54 (I-70 EB)		RT													1					
DR-42	287	4176+84.91 (I-70 EB)		RT													1					
DR-43	289	4177+91.18 (I-70 EB)		RT													1					
DR-44	289	4178+03.68 (I-70 EB)		RT													1					
TOTALS CARRIED TO SUBSUMMARY SHEET 219.223					7	8	3	3	5	7	1	0	1	1	1	1	2	1				

NO.	DESCRIPTION	REV. BY	DATE
4	FUNDING CODE CHANGE	CWL	11-29-2021

CALCULATED	JMB	CHECKED	CWL
ESTIMATED QUANTITIES			
FRA - 70 / 71 - 12.68 / 14.86			
234			
1815			

0:\2012\2012048\FRA\105525\ROADWAY\SHEETS\1055250006.DGN
 11/22/2021 7:01:15 AM
 G00TV81STD_USER

REF. NO.	SHEET NO.	STATION		SIDE	202		202			202		
		FROM	TO		MANHOLE REMOVED		CATCH BASIN REMOVED			INLET REMOVED		
					EACH		EACH			EACH		
					01/NHS/PV	01/NHS/PV	01/NHS/PV	01/NHS/PV	05/NHS/OT/ COL	01/NHS/PV	01/NHS/PV	05/NHS/OT/ COL
DR-45	294	4187+50.80 (I-70 EB)		LT								
DR-48	348	5062+10.63 (RAMP C5)		RT	1					1		
DR-50	310	264+59.26 (I-71 NB)		LT	1							
DR-51	287	4173+76.75 (I-70 EB)		RT			1					
DR-52	354	5078+05.54 (RAMP C5)		RT			1					
DR-53	287	4175+60.00 (I-70 EB)		RT						1		
DR-54	289	4179+75.54 (I-70 EB)		LT						1		
DR-55	292	4184+35.94 (I-70 EB)		LT						1		
DR-56	292	4184+77.97 (I-70 EB)		RT						1		
DR-57	374	203+29.88 (LIVINGSTON AVE.)		LT	1							
DR-58	374	203+84.62 (LIVINGSTON AVE.)		RT						1		
DR-59	375	204+36.24 (LIVINGSTON AVE.)		LT							1	
DR-60	316	258+45.50 (I-71 NB)		RT			1					
DR-61	340	5041+96.43 (RAMP C5)		RT			1					
DR-62	370	19+24.54 (FULTON ST.)		LT			1					
DR-63	370	19+32.14 (FULTON ST.)		RT	1							
DR-64	370	19+35.51 (FULTON ST.)		RT						1		
DR-65	370	19+57.65 (FULTON ST.)		RT			1					
DR-66	370	20+08.57 (FULTON ST.)		RT	1							
DR-67	368	151+24.52 (FRONT ST.)		LT						1		
DR-72	292	4185+49.08 (I-70 EB)		LT						1		
DR-73	289	4177+39.36 (I-70 EB)		LT						1		
DR-76	298	4200+54.01 (I-70 EB)		RT						1		
DR-77	298	4201+52.67 (I-70 EB)		RT						1		
DR-78	300	4202+53.27 (I-70 EB)		RT						1		
DR-79	374	201+11.75 (LIVINGSTON AVE.)		RT						1		
DR-80	374	201+54.54 (LIVINGSTON AVE.)		RT						1		
DR-300	375	206+09.66 (LIVINGSTON AVE.)		RT					1			
DR-301	370	19+37.90 (FULTON ST.)		LT	1							
D-350	348	5061+19.30 (RAMP C5)		RT	1							
D-351	335	5030+41.57 (RAMP C5)		RT	1							
D-352	271	134+14.52 (I-70 EB)		RT						1		
D-353	292	4182+95.83 (I-70 EB)		LT	1							
D-354	371	21+62.24 (FULTON ST.)		LT	1							
TOTALS CARRIED TO SUBSUMMARY SHEET 219					4	6	3	4	1	7	8	1

NO.	DESCRIPTION	REV. BY	DATE
4	FUNDING CODE CHANGE	CWL	11-29-2021

CALCULATED	JMB	CHECKED	CWL
ESTIMATED QUANTITIES			
FRA - 70 / 71 - 12.68 / 14.86			
235 1815			

REF. NO.	SHEET NO.	STATION		SIDE	601 TIED CONCRETE BLOCK MAT, TYPE 1		601 TIED CONCRETE BLOCK MAT, TYPE 2		601 ROCK CHANNEL PROTECTION, TYPE C WITH FILTER		601 PAVED GUTTER, TYPE 1-2, A.P.P.		601 CONCRETE SLOPE PROTECTION		660 SODDING UNSTAKED		670 DITCH EROSION PROTECTION		
		FROM	TO		SY	SY	CY	FT	SY	SY	SY	SY							
					01/NHS/PV	01/NHS/PV													
E-1	327 - 329	3003+98.70 (RAMP C3)	3007+01.77 (RAMP C3)	RT							128	162			21	27			
E-2	340	5040+50.00 (RAMP C5)	5043+00.18 (RAMP C5)	RT	98	125													
E-3	310	264+05.07 (I-7 INB)	266+00.00 (I-71 NB)	RT													70	89	
E-8	312	269+50.00 (I-71 NB)	270+50.00 (I-71 NB)	LT													41	53	
E-9	271	132+16.97 (I-70 EB)	134+67.11 (I-70 EB)	RT													92	117	
E-10	292	4184+01.09 (I-70 EB)	4186+00.70 (I-70 EB)	LT													74	94	
E-11	279	4155+71.25 (I-70 EB)		RT			1	2	1.1	1.4									
E-12	329	3008+41.83 (RAMP C3)		RT			1	1	0.8	1									
E-14	308 - 310	262+50.00 (I-71 NB)	264+00.00 (I-71 NB)	LT													56	72	
E-15	318 - 320	5010+00.00 (RAMP A5)	5011+50.00 (RAMP A5)	RT													55	70	
E-16	285 - 287	4171+47.04 (I-70 EB)	4173+00.03 (I-70 EB)	RT													55	70	
E-17	287	4173+61.43 (I-70 EB)	4175+14.90 (I-70 EB)	RT													55	70	
E-18	287	4175+14.90 (I-70 EB)	4176+11.60 (I-70 EB)	RT													35	44	
E-19	281 - 283	4158+00.00 (I-70 EB)	4166+24.84 (I-70 EB)	RT													298	379	
E-20	338 - 340	5039+50.00 (RAMP C5)	5040+50.00 (RAMP C5)	LT													37	47	
E-21	308	261+00.00 (I-71 NB)	262+50.00 (I-71 NB)	RT													55	70	
E-22	318	5006+50.00 (RAMP A5)	5008+50.00 (I-71 NB)	RT													73	92	
E-23	320	5013+86.50 (RAMP A5)		RT			30	38											
E-24	312	268+50.00 (I-71 NB)	269+50.00 (I-71 NB)	LT			43	55											
E-25	340	5041+29.47 (RAMP C5)		RT			24	30											
E-26	320	5013+68.02 (RAMP A5)	5015+38.90 (RAMP A5)	LT							89	114			15	19			
E-27	320	5014+81.68 (RAMP A5)	5015+41.55 (RAMP A5)	RT							34	44			6	7			
E-28	312	269+50.00 (I-71 NB)		LT					0.6	0.7									
E-68	350	5068+89.91 (RAMP C5)	5069+50.00 (RAMP C5)	RT													22	28	
E-69	318	5007+77 (RAMP A5)	5008+40 (RAMP A5)	RT									185	235					
E-70	320	5011+16 (RAMP A5)	5012+11 (RAMP A5)	RT									311	396					
E-71	310	265+92.37 (I-71 NB)	266+11.11 (I-71 NB)	RT			8	10											
TOTALS CARRIED TO SUBSUMMARY SHEET 221					98	125	107	136	3	3	251	320	496	631	42	53	1018	1295	

CALCULATED
JMB
CHECKED
CWL

ESTIMATED QUANTITIES

FRA - 70 / 71 - 12.68 / 14.86

236
1815

NO.	DESCRIPTION	REV. BY	DATE
4	FUNDING CODE CHANGE	CWL	11-29-2021

0:\2012\2012048\FRA\105523\ROADWAY\SHEETS\1055230007.DGN
 11/22/2021 7:44:01 AM
 Q00TV81STD_USER

01/20/21/2012/2048\FRA\105523\ROADWAY\SHEETS\1055230020.DGN
 11/22/2021 7:07:53 AM
 CDDT\B15TD_USER

REF. NO.	SHEET NO.	STATION		SIDE	607		202			607			607		607		607		607		607		607				
					GATE, TYPE CLT, AS PER PLAN "B"		FENCE REMOVED			GATE REMOVED			FENCE REMOVED AND REBUILT			FENCE, TYPE CLT		FENCE, TYPE CLT, AS PER PLAN "A"		GATE, TYPE CLT, AS PER PLAN "A"		FENCE, TYPE CLT, AS PER PLAN "B"		TEMPORARY VANDAL FENCE, TYPE B		FENCELINE SEEDING AND MULCHING	
					FROM	TO	EACH	FT			EACH	FT			FT		FT		EACH		FT		FT		FT		
		01/NHS/PV	01/NHS/PV	01/NHS/PV	01/NHS/PV	05/NHS/OT/COL	01/NHS/PV	01/NHS/PV	01/NHS/PV	01/NHS/PV	05/NHS/OT/COL	01/NHS/PV	01/NHS/PV	01/NHS/PV	01/NHS/PV	01/NHS/PV	01/NHS/PV	01/NHS/PV	01/NHS/PV	01/NHS/PV	01/NHS/PV	01/NHS/PV	01/NHS/PV				
F-1	375	207+02.79 (LIVINGSTON)	207+48.53 (LIVINGSTON)	LT							47																
F-2	370, 371	22+84.08 (FULTON)	23+15.00 (FULTON)	RT						18	23																
F-3	333, 335	5028+87.45 (RAMP C5)	5031+21.40 (RAMP C5)	RT								104.3	132.7									104.3	132.7				
F-4	338	5038+16.04 (RAMP C5)	5038+35.66 (RAMP C5)	RT								12.8	16.2									12.8	16.2				
F-5	348	5063+82.00 (RAMP C5)	5064+37.18 (RAMP C5)	RT								29.5	37.5									29.5	37.5				
F-6	350, 352	5066+44.33 (RAMP C5)	5071+86.54 (RAMP C5)	RT										243.5	309.8	1						243.5	309.8				
F-7	636 - 637	5+78.90 (BIKE DETOUR)	6+43.41 (BIKE DETOUR)	LT								33.6	42.8														
F-8	637	7+64.22 (BIKE DETOUR)	7+99.64 (BIKE DETOUR)	LT								14.9	18.9														
F-9	637	9+37.36 (BIKE DETOUR)	9+90.39 (BIKE DETOUR)	LT								16.1	20.5														
F-10	638	13+78.34 (BIKE DETOUR)	14+26.99 (BIKE DETOUR)	LT														22.7	28.9								
F-11	638	14+26.99 (BIKE DETOUR)	14+50.99 (BIKE DETOUR)	LT	1																						
F-12	638	13+90.50 (BIKE DETOUR)	14+29.99 (BIKE DETOUR)	RT																	16.3	20.7					
F-13	638	14+29.99 (BIKE DETOUR)	14+53.99 (BIKE DETOUR)	RT		1																					
F-14	637-638	14+50.99 (BIKE DETOUR)	21+46.63 (BIKE DETOUR)	LT														301.0	383.1								
F-15	637-638	14+53.99 (BIKE DETOUR)	21+46.63 (BIKE DETOUR)	RT																	308.5	392.6					
FR-1	374	4183+57.47 (I-70 EB)	202+62.79 (LIVINGSTON)	LT																							
FR-2	374, 375	203+45.92 (LIVINGSTON)	206+69.37 (LIVINGSTON)	LT			154.4	196.6			424																
FR-3	333, 335	5028+87.45 (RAMP C5)	5031+49.11 (RAMP C5)	RT			115.3	146.7																			
FR-4	335	5032+37.36 (RAMP C5)	5032+62.68 (RAMP C5)	RT			16.3	20.7																			
FR-5	338	5035+49.41 (RAMP C5)	5038+35.66 (RAMP C5)	RT			132.9	169.1																			
FR-6	348, 350	5063+82.00 (RAMP C5)	5068+70.72 (RAMP C5)	RT			288.2	366.8																			
FR-7	354	5078+96.43 (RAMP C5)	5079+22.43 (RAMP C5)	RT																							
FR-8	356, 358	5082+30.80 (RAMP C5)	5086+25.12 (RAMP C5)	RT			261.9	333.3																			
FR-9	360	5086+71.74 (RAMP C5)	5087+84.37 (RAMP C5)	RT			71.1	90.5																			
FR-10	370, 371	19+37.95 (FULTON)	22+84.08 (FULTON)	RT			152.2	193.8																			
FR-11	368	150+74.18 (FRONT)	151+81.97 (FRONT)	LT			47.5	60.5																			
FR-12	304 - 312	252+86.40 (I-71 NB)	273+29.19 (I-71 NB)	RT			842.0	1071.7																			
FR-13	637	9+37.36 (BIKE DETOUR)	9+90.39 (BIKE DETOUR)	LT/RT			22.7	28.9																			

ESTIMATED QUANTITIES

CALCULATED
 JMB
 CHECKED
 CWL

FRA - 70 / 71 - 12.68 / 14.86

NO.	DESCRIPTION	REV. BY	DATE
4	FUNDING CODE CHANGE	CWL	11-29-2021

TOTALS CARRIED TO SUBSUMMARY SHEET 220

1 1 2105 2679 424 0 1 18 23 47 212 269 244 310 0 1 324 412 325 414 391 497

240
 1815

01:2012\2012048\FRA\105523\ROADWAY\SHEETS\10552300009.DGN
 11/22/2021 9:01:28 AM
 GDDTV81STD_USER

REF. NO.	SHEET NO.	STATION		SIDE	606		606		606		606		606		606		626		626		
		FROM	TO		GUARDRAIL, TYPE MGS		MGS BRIDGE TERMINAL ASSEMBLY, TYPE 1		MGS BRIDGE TERMINAL ASSEMBLY, TYPE 2		ANCHOR ASSEMBLY, MGS TYPE E (MASH 2016)		ANCHOR ASSEMBLY, MGS TYPE T		IMPACT ATTENUATOR, TYPE 3 UNIDIRECTIONAL (50 MPH, 90" WIDTH)		IMPACT ATTENUATOR, TYPE 3 UNIDIRECTIONAL (50 MPH, 48" WIDTH)		BARRIER REFLECTOR, TYPE 1, ONE-WAY		BARRIER REFLECTOR, TYPE 2, ONE-WAY
					FT		EACH		EACH		EACH		EACH		EACH		EACH		EACH		
					01/NHS/PV	01/NHS/PV	01/NHS/PV	01/NHS/PV	01/NHS/PV	01/NHS/PV	01/NHS/PV	01/NHS/PV	01/NHS/PV	01/NHS/PV	01/NHS/PV	01/NHS/PV	01/NHS/PV	01/NHS/PV	01/NHS/PV	01/NHS/PV	
G-1	331 - 335	5024+38.21 (RAMP C5)	5031+00.04 (RAMP C5)	RT	291.0	370.4		1													
G-2	327, 329	3004+33.90 (RAMP C3)	3009+00.00 (RAMP C3)	RT	201.6	256.6				1											
G-3	327, 329	3004+34.58 (RAMP C3)	3009+00.00 (RAMP C3)	LT	211.8	269.5															
G-4	281, 283	4157+86.17 (I-70 EB)	4166+36.81 (I-70 EB)	RT	357.3	454.8		1													
G-5	364	6005+64.05 (RAMP C6)	6010+65.38 (RAMP C6)	RT	219.8	279.7		1						1							
G-6	296, 298	4192+70.37 (I-70 EB)	4197+47.14 (I-70 EB)	RT	198.6	252.8		1													
G-7	285	4169+91.76 (I-70 EB)	4170+87.66 (I-70 EB)	RT	30	38.2		1													
G-8	304	251+94.88 (I-71 NB)	252+74.90 (I-71 NB)	RT	0	0		1					1								
G-9	308 - 312	260+73.65 (I-71 NB)	272+03.49 (I-71 NB)	LT	475.1	604.6		1					1								
G-10	310 - 312	265+50.32 (I-71 NB)	270+82.56 (I-71 NB)	RT	192.5	245		1					1								
G-11	318, 320	5008+46.34 (RAMP A5)	5015+10.25 (RAMP A5)	LT	263.9	335.9		1					1								
G-12	318, 320	5009+40.64 (RAMP A5)	5014+34.78 (RAMP A5)	RT	202.7	258		1					1								
G-13	338, 340	5039+05.43 (RAMP C5)	5041+41.61 (RAMP C5)	RT	104	132.4		1								1					
G-14	348 - 352	5062+40.43 (RAMP C5)	5070+83.69 (RAMP C5)	LT	375.6	478		1													
G-15	352, 354	5074+89.33 (RAMP C5)	5079+02.50 (RAMP C5)	LT	170.3	216.7		1													
G-16	292, 294	183+98.23 (I-70 WB)	187+65.80 (I-70 WB)	LT	148.5	189.0		1													
G-17	340	5040+39.70 (RAMP C5)	5041+43.00 (RAMP C5)	LT	22	28		1					1								
G-18	348	5061+71.78 (RAMP C5)	5063+52.40 (RAMP C5)	RT	67.0	85.3		1													
G-19	350, 352	5066+62.10 (RAMP C5)	5071+00.96 (RAMP C5)	RT	191.6	243.9		1													
G-20	342	58+64.62 (SR 315 NB)	59+61.98 (SR 315 NB)	RT	44	56							2								
G-21	340	62+11.25 (SR 315 SB)	62+85.54 (SR 315 SB)	LT	27.5	35							1								
G-22	364	6004+96.45 (RAMP C6)	6006+06.21 (RAMP C6)	RT	37.6	47.8		1													
G-23	292, 294	4183+86.93 (I-70 EB)	4191+59.53 (I-70 EB)	RT	331.1	421.4		1													
REFLECTORS																					
		G-1	G-2	RT														10	15		
		G-3		LT															9		
		124+78.14 (I-70 EB)	128+26.37 (I-70 EB)	LT														4			
		G-17	5051+75.92 (RAMP C5)	LT														10	2		
		G-13	5051+59.23 (RAMP C5)	RT														10	3		
		G-8	5004+50.00 (RAMP A5)	RT														6	1		
		G-11	5017+37.12 (RAMP A5)	LT														5	10		
		G-12	5090+80.78 (RAMP C5)	RT														46	14		
		5017+25.79 (RAMP B5)	B-4	LT														15	10		
		G-15	5081+63.95 (RAMP C5)	LT														3	4		
		5084+20.00 (RAMP C5)	5090+82.09 (RAMP C5)	LT														13			
		G-5	4200+64.05 (I-70 EB)	RT														14	21		
		B-1		RT														11			
		G-9	272+50.00 (I-71 NB)	LT														2	17		
		G-10	B-3	RT														38	21		
		4148+49.95 (I-70 EB)	4167+27.87 (I-70 EB)	LT														19			
		B-2		LT														5			
		4174+06.00 (I-70 EB)	4197+00.00 (I-70 EB)	LT														14			
		G-20		RT															2		
		G-21		RT															2		
		B-5																2	4		
		B-6																6			
		OVERHEAD SIGN REPLACEMENT																7			
TOTALS CARRIED TO SUBSUMMARY SHEET 220					4164	5299	8	11	4	6	2	3	2	2	1	1		106	134	59	76

ESTIMATED QUANTITIES

FRA - 70 / 71 - 12.68 / 14.86

CALCULATED
JMB
CHECKED
CWL

241
1815

01/28/21 2012048 FRA 105523 ROADWAY SHEETS 1055230009.DGN
 11/22/2021
 9:26:52 AM
 CDDTV815TD_USER

REF. NO.	SHEET NO.	STATION		SIDE	202		602		
		FROM	TO		GUARDRAIL REMOVED		CONCRETE MASONRY		
					FT		CU YD		
					01/NHS/PV		01/NHS/PV		
GR-1	265-269	116+19.33 (I-70 EB)	127+29.69 (I-70 EB)	RT	486.89	619.67			
GR-2	269-271,329	127+96.30 (I-70 EB)	3009+00.00 (RAMP C3)	RT	504.97	642.68			
GR-3	327,329	3004+73.16 (RAMP C3)	3009+00.00 (RAMP C3)	RT	197.27	251.08			
GR-5	283	4163+42.26 (I-70 EB)	4166+34.90 (I-70 EB)	RT	127.46	162.23			
GR-6	285,287	4169+95.79 (I-70 EB)	4175+82.50 (I-70 EB)	RT	257.64	327.91			
GR-7	289	4177+06.29 (I-70 EB)	4181+58.12 (I-70 EB)	LT	199.27	253.61			
GR-8	292	4182+27.54 (I-70 EB)	4183+33.43 (I-70 EB)	LT/RT	48.92	62.26			
GR-9	292	4184+58.73 (I-70 EB)	4186+36.11 (I-70 EB)	LT/RT	78.44	99.84			
GR-10	296	4192+77.40 (I-70 EB)	4185+90.36 (I-70 EB)	RT	138.52	176.29			
GR-11	296,298	4196+71.88 (I-70 EB)	4198+00.27 (I-70 EB)	RT	56.56	71.99			
GR-12	306	254+99.31 (I-71 NB)	256+63.94 (I-71 NB)	RT	72.29	92.01			
GR-13	312,314	270+06.97 (I-71 NB)	273+05.40 (I-71 NB)	RT	132.77	168.99			
GR-14	320	5011+28.86 (RAMP A5)	5015+10.28 (RAMP A5)	RT	153.51	195.37			
GR-15	312	269+14.68 (I-71 NB)	268+34.80 (I-71 NB)	LT/RT	148.68	189.24			
GR-16	275,277	44+98.23 (RAMP B5)	148+54.11 (I-70 EB)	LT	154.87	197.11			
GR-20	342	5045+89.37 (RAMP C5)	5046+01.82 (RAMP C5)	LT/RT	53.62	68.25			
HW-3	329	3008+41.83 (RAMP C3)		RT			0.12	0.15	
HW-4	340	5041+42.01 (RAMP C5)		LT			0.12	0.15	
HW-61	312	269+50.00 (I-71 NB)		LT			0.12	0.15	
HW-108	279	5060+60.37 (RAMP C5)		LT			0.26	0.34	
HW-263	320	5011+97.96 (RAMP A5)		LT			0.12	0.15	
HW-266	320	5014+00.00 (RAMP A5)		RT			0.12	0.15	
TOTALS CARRIED TO SUBSUMMARY SHEET 219.222					2812	3579		0.9	1.1

NO.	DESCRIPTION	REV. BY	DATE
4	FUNDING CODE CHANGE	CWL	11-29-2021

CALCULATED
 JMB
 CHECKED
 CWL

ESTIMATED QUANTITIES

FRA - 70 / 71 - 12.68 / 14.86

242
1815

01:\2012\2012048\FRA\105523\ROADWAY\105523\001.dgn
11/22/2021
9:33:52 AM
COWT815D_USER

REF. SHEET NO.	SHEET NO.	STATION		SIDE	611		611		611		611		611		611		611		611		611		611		611		611		837							
					12" CONDUIT, TYPE B		15" CONDUIT, TYPE B		15" CONDUIT, TYPE B, 706.02		15" CONDUIT, TYPE B, 706.02 WITH 706.11 JOINTS		15" CONDUIT, TYPE B, AS PER PLAN		15" CONDUIT, TYPE C		15" CONDUIT, TYPE C, AS PER PLAN		18" CONDUIT, TYPE B		18" CONDUIT, TYPE C, AS PER PLAN		21" CONDUIT, TYPE B, 706.02 WITH 706.11 JOINTS		24" CONDUIT, TYPE B		24" CONDUIT, TYPE C		27" CONDUIT, TYPE C		36" CONDUIT, TYPE B, 706.02		CONDUIT, BORED OR JACKED, AS PER PLAN, 42" CONDUIT, TYPE C, 748.06 (0.625" WALL THICKNESS)		LINER PIPE, 27" I.D., 707.12	
		FROM	TO	FT	FT	FT	FT	FT	FT	FT	FT	FT	FT	FT	FT	FT	FT	FT	FT	FT	FT	FT	FT	FT	FT	FT	FT	FT	FT	FT	FT	FT	FT			
P-30	354	D-30	D-31	LT/RT						37	47																									
P-31	354	D-32	D-31	RT						25.5	32.5																									
P-32	354	D-33	D-32	RT						24.6	31.4																									
P-33	354	D-259	D-33	RT																15	19															
P-35	354	D-35	D-33	LT/RT																21.1	26.9															
P-36	287	D-35	D-36	RT									92.8	118.2																						
P-37	287	D-37	D-36	LT/RT			46.6	59.4																												
P-38	354	D-42	D-38	RT																					87.6	111.4										
P-41	350,352	D-101	D-41	RT																				141.7	180.3											
P-42	352	D-41	D-42	RT																																
P-42A	352	5071+45.14 (RAMP C5) 5074+38.65 (RAMP C5)		RT																													128.5	163.5	162.4	206.6
P-42B	354	D-42	EX-4	RT													4.8	6.2																		
P-43	356	D-43	D-44	LT							69.1	87.9																								
P-44	289	D-190	D-44	RT							5.3	6.7																								
P-45	356	D-43	D-45	LT/RT							16.3	20.7																								
P-50	281	D-50	D-262	RT			14.5	18.5																												
P-50A	281	AB-27	D-50	RT						7	9																									
P-51	283	D-51	D-52	RT									4.8	6.2																						
P-52	310	D-229	263+90.46 (I-71 NB)		RT																				4.4	5.6										
P-53	285	D-53	D-54	RT			13.2	16.8																												
P-54	285	D-54	D-55	LT									3.1	3.9																						
P-55	364	D-55	D-261	LT/RT			23.8	30.2																												
P-56	292	D-157	D-56	LT																		6.6	8.4													
P-56A	292	D-56	4185+91.26 (I-70 EB)		LT				2.2	2.8																										
P-57	292	AB-4	D-57	RT									27.3	34.7																						
P-58	292,294		D-57	RT			39.6	50.4																												
P-59	294	D-58	D-59	RT			23.8	30.2																												
P-60	294	D-60	4189+90.67 (I-70 EB)		RT	4.4	5.6																													
P-61	312	D-61	HW-61	LT/RT															49.7	63.3																
P-62	312	D-61	D-62	RT			44	56																												
P-63	312	D-62	D-63	RT			27.3	34.7																												
P-64	310	D-64	265+52.70 (I-71 NB)		LT											4.8	6.2																			
P-65	310	D-237	D-64	LT																					43.6	55.4										
P-66	281	D-66	D-113	RT			26	33																												
P-67	350	D-101	D-67	RT									3.5	4.5																						
P-68	350	D-67	D-68	RT									38.7	49.3																						
P-69	348	D-70	D-69	RT							27.7	35.3																								
P-70	348	D-113	D-70	LT/RT							43.6	55.4																								
P-71	342	D-71	AB-50	RT															12.3	15.7																

NO.	DESCRIPTION	REV. BY	DATE
4	FUNDING CODE CHANGE	CWL	11-29-2021

TOTALS CARRIED TO SUBSUMMARY SHEET 222, 223

4 6 259 329 2 3 249 317 34 44 143 182 10 12 50 63 12 16 36 46 7 8 44 55 229 292 4 6 128 164 162 207

ESTIMATED QUANTITIES

CALCULATED
JMB
CHECKED
CWL

FRA - 70 / 71-12.68 / 14.86

243
1815

REF. NO.	SHEET NO.	STATION		SIDE	611		611		611		611		611		611		611		611		611		611		611		611		611					
					12" CONDUIT, TYPE C		15" CONDUIT, TYPE B		15" CONDUIT, TYPE B, 706.02		15" CONDUIT, TYPE B, 706.02 WITH 706.11 JOINTS		15" CONDUIT, TYPE B, AS PER PLAN		15" CONDUIT, TYPE C		15" CONDUIT, TYPE C, 706.02 WITH 706.11 JOINTS		15" CONDUIT, TYPE C, AS PER PLAN		18" CONDUIT, TYPE B		24" CONDUIT, TYPE B		27" CONDUIT, TYPE B		27" CONDUIT, TYPE C		30" CONDUIT, TYPE C		36" CONDUIT, TYPE B, 706.02		18" CONDUIT, TYPE B, 748.01 CLASS 52, AS PER PLAN	
					FT	PV	FT	PV	FT	PV	FT	PV	FT	PV	FT	PV	FT	PV	FT	PV	FT	PV	FT	PV	FT	PV	FT	PV	FT	PV	FT	PV	FT	PV
FROM	TO																																	
P-100	352	D-100	D-41	RT								36.1	45.9																					
P-101	350	D-111	D-101	LT/RT																	57.2	72.8												
P-104	281	D-104	D-113	RT			29.5	37.5																										
P-108	279	D-108	HW-108	RT																				18	23									
P-110	281	D-113	D-110	RT																														
P-111	281,283	D-262	D-111	RT																				52.8	67.2									
P-111A	283	AB-3	D-111	RT																														
P-112	283	D-111	D-52	RT										15	19																			
P-113	279,281	D-108	D-113	RT								132.9	169.1																					
P-114	348	D-104	D-114	LT/RT			37	47																			101.6	129.4						
P-154	294	D-154	D-254	LT			3.5	4.5																										
P-155	294	D-155	D-255	LT			3.1	3.9																										
P-157	292	D-302	D-157	LT																														
P-159	354	D-38	D-159	RT	44	56															6.2	7.8												
P-160	289	D-160	D-332	LT																110	140													
P-161	289	D-161	D-165	LT			51	65																										
P-162	292,294	D-162	EX-2	LT										76	96																			
P-165	289	D-165	AB-5	LT										14.5	18.5																			
P-165A	289	D-165	178+39.87 (I-70 EB)	LT			3.5	4.5																										
P-188	292	DJ-11	D-188	LT/RT																			28.2	35.8										
P-189	289,292	D-189	D-188	RT																			88	112										
P-190	289	D-190	D-189	RT																			81.4	103.6										
P-191	292	D-191	DJ-11	LT			21.6	27.4																										
P-192	289	D-192	D-160	LT			2.6	3.4																										
P-201	335	D-201	DJ-6	RT																														
P-202	335	DJ-6	D-202	RT																														
P-204	335	D-208	D-204	RT																														
P-205	269	D-210	D-205	LT																														
P-206	269	D-207	D-206	LT			7.5	9.5																										
P-207	269	D-209	D-207	LT			6.6	8.4																										
P-208	335	D-207	D-208	LT/RT																														
P-209	269	D-210	D-209	LT/RT			26	33																										
P-210	269	D-211	D-210	LT																														
P-211	269	EX-3	D-211	LT																														
P-212	269,271	D-217	D-212	RT																														
P-213	327,329	D-213	D-214	RT																														
P-214	329	D-214	D-215	RT																														
P-215	329	D-215	HW-3	RT																														
P-216	340	D-216	HW-4	LT																														
P-217	269	D-217	130+96.19 (I-70 EB)	RT																														
P-220	306	D-220	D-222	RT																														
P-222	306,308	D-222	D-223	RT																														
P-223	316	D-223	5004+57.16 (RAMP A5)	RT																														
P-223A	316	D-223	258+47.78 (I-71 NB)	RT																														
P-224	281	D-224	D-66	RT																														
P-225	316,318	D-223	D-225	RT																														
P-229	310	D-229	263+92.78 (I-71 NB)	RT																														
TOTALS CARRIED TO SUBSUMMARY SHEET 222					44	56	408	520	6	7	32	41	105	134	324	412	125	159	7	8	308	391	90	115	57	73	83	105	172	220	4	6	5	7

ESTIMATED QUANTITIES

FRA - 70 / 71 - 12.68 / 14.86

244
1815

D:\2012\2012048\FRA\10552\ROADWAY\SHEETS\10552\SUBSUMMARY.DGN
 11/22/2021 9:37:15 AM
 GDDTV1615D_USER

NO.	DESCRIPTION	REV.	BY	DATE
4	FUNDING CODE CHANGE			11-29-2021

CALCULATED
 JMB
 CHECKED
 CWL

01:201212048\FRA\105523\ROADWAY\105523\0013.DGN
 11/22/2021 8:48:56 AM CDDTVB1STD_USER

REF. SHEET NO.	STATION	SIDE	202		202		611		611		611		611		611		611		SPECIAL		SPECIAL		SPECIAL		SPECIAL				
			FROM	TO	PIPE REMOVED, 24" AND UNDER		PIPE REMOVED, OVER 24"		12" CONDUIT, TYPE B		12" CONDUIT, TYPE B, 706.02		15" CONDUIT, TYPE B		15" CONDUIT, TYPE B, 706.02		15" CONDUIT, TYPE B, AS PER PLAN		18" CONDUIT, TYPE B		18" CONDUIT, TYPE C		CITY OF COLUMBUS 12" PIPE, 706.02 WITH 706.11 JOINTS, WITH TYPE 1 BEDDING, WITH 912 COMPACTED GRANULAR MATERIAL		CITY OF COLUMBUS 12" PIPE, WITH TYPE 1 BEDDING, WITH 912 COMPACTED GRANULAR MATERIAL		CITY OF COLUMBUS 15" PIPE, 706.02 WITH 706.11 JOINTS, WITH TYPE 1 BEDDING, WITH 912 COMPACTED GRANULAR MATERIAL		CITY OF COLUMBUS 6" PIPE, WITH TYPE 1 BEDDING, WITH 912 COMPACTED GRANULAR MATERIAL
			01/NHS/PV	01/NHS/PV	01/NHS/PV	01/NHS/PV	01/NHS/PV	01/NHS/PV	01/NHS/PV	01/NHS/PV	01/NHS/PV	01/NHS/PV	01/NHS/PV	01/NHS/PV	01/NHS/PV	01/NHS/PV	01/NHS/PV	01/NHS/PV	01/NHS/PV	01/NHS/PV	01/NHS/PV	01/NHS/PV	05/NHS/OT/COL	01/NHS/PV	01/NHS/PV	01/NHS/PV	01/NHS/PV		
P-318	370	D-319	D-318	RT																29	37								
P-318A	370	D-318	AB-29	LT																3.5	4.5								
P-319	370	D-319	D-320	RT																7.5	9.5								
P-320	368	D-321	D-320	LT/RT																				24.6	31.4				
P-321	292	D-268	D-321	LT													37	47											
P-322	368	D-320	D-322	RT																15	19								
P-323	368	D-321	D-323	LT																16.3	20.7								
P-326	292	D-326	D-302	LT						38.3	48.7																		
P-327	370	D-315	DJ-326	RT																				22.9	29.1				
P-328	292	D-328	185+75.35 (I-70 WB)	LT												1.8	2.2												
P-329	298	D-329	D-330	RT				30.4	38.6																				
P-330	298	D-330	4201+66.63 (I-70 EB)	RT									7	9															
P-331	300	D-331	4202+45.34 (I-70 EB)	RT						3.5	4.5																		
P-332	292	D-332	DJ-11	LT														42.2	53.8										
P-333	306	D-220	D-333	RT								1.8	2.2																
P-334	316	D-334	D-223	RT								4	5																
P-340	375	DJ-300	D-340	RT																									
P-341	374	D-341	D-306	RT																				17.2	21.8				
P-342	374	D-342	D-306	RT																				16.3	20.7				
P-350	289	AB-5	D-160	LT										47.5	60.5														
P-351	289	D-161	177+22.82 (I-70 EB)	LT						3.5	4.5																		
P-360	374	202+58.62 (LIVINGSTON)	D-312	LT/RT																							33.4	42.6	
P-361	374,375	203+94.03 (LIVINGSTON)	D-305	LT/RT																							10.1	12.9	
P-500	287	D-267	EX-6	LT										19.8	25.2														
P-501	287	D-267	174+97.70 (I-70 EB)	LT				3.5	4.5																				
P-502	287	AB-2	D-36	RT										26.8	34.2														
PR-1	283	AB-3	4162+98.68 (I-70 EB)	RT	11	14																							
PR-2	287	DR-53	DR-2	RT	16.3	20.7																							
PR-3	287	DR-3	DR-4	RT	75.7	96.3																							
PR-4	287	DR-4	DR-5	RT	6.6	8.4																							
PR-5	287	DR-5	O.S.I.S.	RT	26.4	33.6																							
PR-6	289,292	DR-6	DJ-11	LT	53.7	68.3																							
PR-7	292	DJ-11	DR-7	LT/RT	19.8	25.2																							
PR-8	292	DR-9	DR-8	RT	22.4	28.6																							
PR-9	292	EX-2	DR-9	LT/RT	33.9	43.1																							
PR-10	287	DR-2	O.S.I.S.	RT	14.1	17.9																							
PR-12	292	DR-13	4184+77.97 (I-70 EB)	RT	24.2	30.8																							
PR-13	269	DR-17	DR-19	LT/RT	30.4	38.6																							
PR-15	269	DR-18	DR-17	LT	4.4	5.6																							
PR-16	269	DJ-1	DR-18	LT	5.3	6.7																							
PR-17	269	DR-15	130+96.19 (I-70 EB)	RT	2.2	2.8																							
PR-18	335	5030+08.06 (RAMP C5)	5032+04.54 (RAMP C5)	RT			86.2	109.8																					
PR-19	316	DR-60	5004+57.16 (RAMP A5)	RT	3.1	3.9																							
PR-20	356	DR-22	5080+50.64 (RAMP C5)	RT	15.4	19.6																							
PR-22	310	DR-25	DR-50	LT	21.6	27.4																							
PR-23	310	DR-25	DR-26	LT/RT	37	47																							
PR-24	310	DR-26	263+90.46 (I-71 NB)	RT			3.5	4.5																					
PR-25	310	DR-26	263+92.78 (I-71 NB)	RT			3.5	4.5																					
PR-26	318	DR-23	5006+26.89 (RAMP A5)	RT	16	21																							

CALCULATED JMB CHECKED CWL
ESTIMATED QUANTITIES
FRA - 70 / 71 - 12.68 / 14.86
 (246)
 1815

TOTALS CARRIED TO SUBSUMMARY SHEET 219, 222, 223		440	559	93	119	34	43	7	9	44	56	7	9	94	120	79	101	2	2	71	91	56	72	29	25	31	44	55
---	--	-----	-----	----	-----	----	----	---	---	----	----	---	---	----	-----	----	-----	---	---	----	----	----	----	----	----	----	----	----

NO.	DESCRIPTION	REV. BY	DATE
4	FUNDING CODE CHANGE	CWL	11-29-2021

0:\2012\2012048\FRA\105523\ROADWAY\SHEETS\1055230014.DGN
 11/22/2021 9:52:37 AM
 GDDTV81STD_USER

REF. NO.	SHEET NO.	STATION		SIDE	202		202		202		202		202		202		202	
		FROM	TO		PIPE REMOVED, 24" AND UNDER	REMOVAL MISC.: BENCH REMOVED AND RESET	REMOVAL MISC.: BOLLARDS	REMOVAL MISC.: ROCK ART MONOLITH	REMOVAL MISC.: LIGHT POLE	REMOVAL MISC.: WOOD POLE								
					FT	FT	EACH	EACH	EACH	EACH	EACH	EACH	EACH					
					01/NHS/PV	01/NHS/PV	05/NHS/OT/COI	01/NHS/PV	01/NHS/PV	01/NHS/PV	01/NHS/PV	01/NHS/PV	01/NHS/PV					
PR-38	316	DR-60	5004+58.16 (RAMP A5)	RT	5.3	6.7												
PR-39	306,308	DR-37	DR-60	RT	38.7	49.3												
PR-40	316	DR-60	DR-40	RT	11	14												
PR-41	318	DR-23	DR-24	RT	64.2	81.8												
PR-42	348	DJ-5	DR-48	RT	44	56												
PR-51	287	DR-51	DR-3	RT	10.1	12.9												
PR-52	354	DR-3	DR-52	LT/RT	28.2	35.8												
PR-53	287	EX-6	DR-53	LT	32.6	41.4												
PR-54	289	AB-5	DR-54	LT	56.3	71.7												
PR-55	292	DJ-11	DR-55	LT	59.8	76.2												
PR-61	340	DR-61	5043+00.18 (RAMP C5)	RT	46.2	58.8												
PR-62	370	DR-62	DR-63	LT/RT	11.4	14.6												
PR-64	370	DR-63	DR-64	RT	4	5												
PR-65	370	DR-64	DR-65	RT	9.7	12.3												
PR-66	370	DR-63	DR-66	RT	31.7	40.3												
PR-67	370	DR-67	DR-63	LT/RT	37.4	47.6												
PR-68	370,371	DR-66	DJ-326	LT/RT	66	84												
PR-70	370	DR-70	DR-63	LT/RT	70.4	89.6												
PR-71	370	AB-29	DR-66	LT/RT	14.5	18.5												
PR-72	289	DR-73	AB-5	LT	44	56												
PR-73	368	DR-57	148+60.41 (FRONT)	RT	5.7	7.3												
PR-74	374	DR-57	DR-58	RT	23.8	30.2												
PR-75	374,375	DR-58	DR-59	RT	26	33												
PR-76	298	DR-76	DR-77	RT	42.2	53.8												
PR-77	375	EX-300	DR-300	RT	11	14												
PR-78	292	DR-72	4185+54.02 (I-70 EB)	LT	5.7	7.3												
PR-90	287	AB-2	DR-53	RT	22.9	29.1												
PR-91	289	4178+36.08 (I-70 EB)	AB-5	LT	18	23												
PR-92	289	4177+18.17 (I-70 EB)	DR-73	LT	22.4	28.6												
PR-93	354	5075+07.72 (RAMP C5)	EX-4	LT/RT	22.0	28.0												
PR-215	329	DR-21	HW-3	RT	30.4	38.6												
PR-267	287	4174+97.74 (I-70 EB)	AB-2	LT/RT	33.9	43.1												
PR-300	292	EX-8	DR-55	LT	34.8	44.2												
PR-306	374	DR-56	200+70.63 (LIVINGSTON)	LT/RT	16	21												
PR-307	374	DR-80	DR-79	RT	16.7	21.3												
PR-308	374	DR-79	DR-14	LT/RT	17.2	21.8												
R-1	374	202+27.26 (LIVINGSTON AVE)		RT				4										
R-2	375	204+07.19 (LIVINGSTON AVE)		RT			1											
R-3	350	5066+83.42 (RAMP C5)		RT								1						
R-4	350	5067+04.15 (RAMP C5)		RT														
R-5	350	5068+06.83 (RAMP C5)		RT								1						
R-6	350	5068+77.48 (RAMP C5)		RT														
R-7	348	5064+84.69 (RAMP C5)		LT														
R-8	352	5073+11.59 (RAMP C5)		LT														
R-9	352	5073+84.39 (RAMP C5)		RT														
TOTALS CARRIED TO SUBSUMMARY SHEET 219					1034	1317	1	4	2	3	2							

NO.	DESCRIPTION	REV. BY	DATE
4	FUNDING CODE CHANGE	CWL	11-29-2021

ESTIMATED QUANTITIES

FRA - 70 / 71 - 12.68 / 14.86

CALCULATED JMB CHECKED CWL

247
1815

D:\2012\2012048\FRA\105523\ROADWAY\SHEETS\1055230015.DGN
 11/22/2021
 9:57:53 AM
 GDDTV81STD_USER

REF. NO.	SHEET NO.	STATION		SIDE	202	202			SPECIAL	SPECIAL	611				SPECIAL						
		FROM	TO		PIPE REMOVED, 24" AND UNDER FT	MANHOLE REMOVED (SANITARY) EACH			CITY OF COLUMBUS MANHOLE, TYPE C (AA-S102) EACH	CITY OF COLUMBUS MANHOLE, TYPE C; AS PER PLAN (AA-S102) EACH	MANHOLE ADJUSTED TO GRADE, AS PER PLAN (SANITARY) EACH			CITY OF COLUMBUS 18" CONDUIT, C905 PIPE, WITH TYPE 1 BEDDING, WITH ITEM 912 COMPACTED GRANULAR MATERIAL FT							
					01/NHS/PV	01/NHS/PV			01/NHS/PV	01/NHS/PV	01/NHS/PV				01/NHS/PV						
SA-1	903	11+31.18 (SHORT ST.)		LT				1													
SA-2	903	10+48.04 (SHORT ST.)		LT				1													
SA-3	904	4176+82.28 (I-70 EB)		RT				1													
SA-4	289	178+37.29 (I-70 EB)		RT						1											
SJ-3	335	5030+33.13 (RAMP C5)		RT						1											
SJ-10	372	12+05.79 (MOUND ST.)		LT						1											
SP-1	903	SA-1	SA-2	LT											84						
SP-2	903	SA-2	10+44.58 (SHORT ST.)	LT											27						
SP-3	904	SA-3	SJ-5	RT											93						
SR-1	903	10+67.93 (SHORT ST.)		LT		1															
SR-2	903	11+02.45 (SHORT ST.)		LT		1															
SR-3	903	11+33.92 (SHORT ST.)		LT		1															
SR-4	903	11+23.77 (SHORT ST.)		LT		1															
SR-5	903	11+31.55 (SHORT ST.)		LT		1															
SR-6	903	10+44.58 (SHORT ST.)	SR-1	LT	21																
SR-7	903	SR-1	SR-2	LT	33																
SR-8	903	SR-2	SR-8	LT	27																
SR-9	903	SR-5	SR-3	LT	7																
SR-10	903	SR-3	SA-1	LT	6																
SR-11	903	SR-4	SR-3	LT	15																
SR-12	903	SR-4	SR-5	LT	12																
SR-13	289	178+37.29 (I-70 EB)		RT		1															
TOTALS CARRIED TO SUBSUMMARY SHEET 219.224					121	6			3	1	2				204						

NO.	DESCRIPTION	REV. BY	DATE
4	FUNDING CODE CHANGE	CWL	11-29-2021

CALCULATED JMB CHECKED CWL
SANITARY SEWER ESTIMATED QUANTITIES
FRA - 70 / 71 - 12.68 / 14.86
 248
 1815

REF. NO.	SHEET NO.	STATION		SIDE	605				611				FOR INFORMATION ONLY								
		FROM	TO		6" SHALLOW PIPE UNDERDRAINS WITH GEOTEXTILE FABRIC		6" UNCLASSIFIED PIPE UNDERDRAINS WITH GEOTEXTILE FABRIC		6" BASE PIPE UNDERDRAINS WITH GEOTEXTILE FABRIC		6" CONDUIT, TYPE F FOR UNDERDRAIN OUTLETS		6" CONDUIT, TYPE B		PRECAST REINFORCED CONCRETE OUTLET		6" PLUG	6" X 6" TEE	6" X 6" CROSS	6" 90° BEND	
					FT	FT	FT	FT	FT	FT	FT	FT	FT	FT	EACH	EACH	EACH	EACH	EACH		
					01/NHS/ PV	01/NHS/ PV	01/NHS/ PV	01/NHS/ PV	01/NHS/ PV	01/NHS/ PV	01/NHS/ PV	01/NHS/ PV	01/NHS/ PV	01/NHS/ PV	01/NHS/ PV	01/NHS/ PV	01/NHS/ PV				
U-1	677	5024+38.21 (RAMP C5)	OUTLET	RT	125.8	160.2						5.7	7.3		4.4	5.6	1		1	1	1
U-2	677	5024+38.21 (RAMP C5)	U-1	RT					125.8	160.2									1		
U-3	677	5031+02.19 (RAMP C5)	U-1	RT					165	211									1		
U-4	677	5031+37.30 (RAMP C5)	U-1	RT	180.8	230.2													1	1	
U-6	677	5031+38.41 (RAMP C5)	D-202	RT					9.2	11.8		4.4	5.6						1		
U-7	677	126+97.68 (I-70 EB)	EXISTING UD	RT	44.9	57.1													1		
U-8	677	126+97.71 (I-70 EB)	EXISTING UD	LT					44.9	57.1									1		
U-9	677	126+97.73 (I-70 EB)	EXISTING UD	LT					44.9	57.1									1		
U-10	677	128+25.37 (I-70 EB)	D-210	LT			4.4	5.6											1		
U-11	677	128+40.00 (I-70 EB)	D-205	LT			6.6	8.4				4.4	5.6						1		
U-12	677	129+50.00 (I-70 EB)	D-205	LT					33.4	42.6		4.4	5.6						1		
U-13	677	129+50.00 (I-70 EB)	D-206	LT/RT					37.4	47.6				15.8	20.2				1	1	
U-14	677	128+26.37 (I-70 EB)	U-13	RT			17.2	21.8											1		
U-15	677	128+28.68 (I-70 EB)	D-209	RT			2.6	3.4											1		
U-16	677	129+50.00 (I-70 EB)	U-13	RT	37.4	47.6													1		1
U-17	677	128+25.87 (I-70 EB)	U-13	LT			17.2	21.8											1		
U-18	677	128+40.00 (I-70 EB)	D-206	RT			6.6	8.4				4.4	5.6						1		
U-19	677	3004+93.21 (RAMP C3)	U-157	BL	268.4	341.6													1	1	
U-20	677	5039+68.62 (RAMP C3)	D-214	LT					105.6	134.4				11.9	15.1						1
U-21	677	5040+28.18 (RAMP C5)	U-300	BL	298.3	379.7													1		
U-22																					
U-23	677	3004+93.21 (RAMP C3)	U-158	RT					267.1	339.9				2.6	3.4				1		2
U-24	677	3007+17.85 (RAMP C3)	EXISTING UD	LT					81.4	103.6									1		
U-25	677	3004+93.21 (RAMP C3)	U-26	LT					26.4	33.6									1		
U-26	677	5041+57.96 (RAMP C5)	U-19	LT					111.3	141.7				11.4	14.6				1		1
U-43	677	266+98.35 (I-71 NB)	D-62	LT/RT					196.7	250.3				17.6	22.4				1	1	1
U-44	677	266+98.47 (I-71 NB)	U-43	RT	187.4	238.6													1		
U-45	677	266+93.38 (I-71 NB)	D-235	RT					125	159		8.4	10.6						1		1
U-46	677	271+83.99 (I-71 NB)	D-62	RT					20.7	26.3		4.4	5.6						1		
U-47	677	5015+07.84 (RAMP A5)	OUTLET	LT					211.2	268.8		11.4	14.6				1		1		1
U-48	677	5015+06.59 (RAMP A5)	D-234	BL	223.1	283.9						9.2	11.8		3.5	4.5			1	1	1
U-49	677	5014+42.61 (RAMP A5)	U-48	RT					193.2	245.8									1		
U-50	677	5010+35.00 (RAMP A5)	U-52	LT					150.9	192.1									1		
U-51	677	5004+53.95 (RAMP A5)	U-193	RT					63.8	81.2									1		
U-52	677	264+00.12 (I-71 NB)	U-55	RT					137.7	175.3				4.8	6.2				1	1	2
U-53	677	5009+95.00 (RAMP A5)	U-332	RT					151.4	192.6									1		
U-54	677	263+95.00 (I-71 NB)	U-332	LT					156.6	199.4									1		
U-55	677	5006+94.28 (RAMP A5)	U-332	LT					19.8	25.2									1		
U-56	677	254+05.00 (I-71 NB)	D-334	RT					184.8	235.2		4.4	5.6						1		
U-57	677	253+53.06 (I-71 NB)	U-330	RT/BL	279.4	355.6													1		
U-58	677	266+93.56 (I-71 NB)	OUTLET	LT					132.4	168.6		4.8	6.2				1		1		1
U-59	678	5062+02.48 (RAMP C5)	D-70	RT					78.8	100.2		4.4	5.6						1		
U-60	678	5062+02.48 (RAMP C5)	U-61	RT	83.6	106.4													1		

NO.	DESCRIPTION	REV. BY	DATE
4	FUNDING CODE CHANGE	CWL	11-29-2021

TOTALS CARRIED TO SUBSUMMARY SHEET 222, 223

1730 2201 55 70 2876 3661 71 90 73 92 1 2

UNDERDRAIN ESTIMATED QUANTITIES
CALCULATED JMB
CHECKED CWL
FRA - 70 / 71-12.68 / 14.86
250
1815

01/28/21 2612848 FRA\105523\ROADWAY\105523\105523\00666.dgn
11/22/2021 9:08:32 AM
C00TV81STD_USER

REF. NO.	SHEET NO.	STATION		SIDE	605		605		605		611		611		611		FOR INFORMATION ONLY			
		FROM	TO		6" SHALLOW PIPE UNDERDRAINS WITH GEOTEXTILE FABRIC		6" UNCLASSIFIED PIPE UNDERDRAINS WITH GEOTEXTILE FABRIC		6" BASE PIPE UNDERDRAINS WITH GEOTEXTILE FABRIC		6" CONDUIT, TYPE F FOR UNDERDRAIN OUTLETS		6" CONDUIT, TYPE B		PRECAST REINFORCED CONCRETE OUTLET		6" PLUG	6" X 6" TEE	6" X 6" CROSS	6" 90° BEND
					FT	FT	FT	FT	FT	FT	FT	FT	FT	FT	EACH	EACH				
					01/NHS/ PV	01/NHS/ PV	01/NHS/ PV	01/NHS/ PV	01/NHS/ PV	01/NHS/ PV	01/NHS/ PV	01/NHS/ PV	01/NHS/ PV	01/NHS/ PV	01/NHS/ PV	01/NHS/ PV				
U-61	678	5062+65.38 (RAMP C5)	D-70	LT					83.6	106.4			15	19			1	1	1	
U-62	678	5062+65.38 (RAMP C5)	OUTLET	LT					56.8	72.2	4.8	6.2			1				1	
U-63	678	5071+09.38 (RAMP C5)	D-69	RT					279.4	355.6	4.4	5.6					1			
U-64	678	5071+18.62 (RAMP C5)	U-66	BL					57.6	73.4							1		1	
U-65	678	6001+86.80 (RAMP C6)	U-61	LT					318.6	405.4							1			
U-66	678	5071+09.38 (RAMP C5)	U-61	RT	314.2	399.8											1	1		
U-67	678	5071+25.49 (RAMP C5)	D-100	RT							4.4	5.6					1			
U-68	678	5071+22.36 (RAMP C5)	D-100	RT					3.5	4.5			4.4	5.6			1		1	
U-69	678	5071+07.85 (RAMP C5)	D-III	LT					152.7	194.3	5.7	7.3					1		1	
U-70	678	5067+59.83 (RAMP C5)	U-62	LT					163.7	208.3							1			
U-71	678	5064+50.96 (RAMP C5)	D-70	RT					21.1	26.9	4.4	5.6					1			
U-72	678	4158+61.63 (I-70 EB)	EX-40	LT					16.7	21.3	3.1	3.9	1.3	1.7			1	1		
U-73	678	4166+17.74 (I-70 EB)	U-76	RT	225.3	286.7											1			
U-74	678	4166+05.79 (I-70 EB)	U-76	RT					219.1	278.9							1			
U-75	678	4166+21.70 (I-70 EB)	D-51	RT							4.4	5.6					1			
U-76	678	4158+01.56 (I-70 EB)	D-50	RT	137.3	174.7							10.6	13.4			1	1	1	
U-77	678	4165+98.74 (I-70 EB)	U-104	LT					222.2	282.8							1			
U-78	678	4158+01.44 (I-70 EB)	D-224	RT					2.2	2.8	4.4	5.6					1			
U-79	678	6007+78.50 (RAMP C6)	U-188	LT					110.0	140.0										
U-80	678	4174+15.31 (I-70 EB)	U-164	LT					158.4	201.6			1.3	1.7			1		2	
U-81	678	4175+54.17 (I-70 EB)	D-37	LT				16.7	21.3								1			
U-82	678	4174+20.30 (I-70 EB)	U-188	RT					41.8	53.2							1			
U-83	678	4173+00.00 (I-70 EB)	D-54	RT					105.2	133.8							1			
U-84	678	4175+15.28 (I-70 EB)	U-164	BL					156.6	199.4							1			
U-85	678	4175+63.91 (I-70 EB)	U-188	BL				21.1	26.9								1			
U-86	678	4175+70.50 (I-70 EB)	U-188	RT				24.2	30.8								1			
U-87	678	4175+75.76 (I-70 EB)	U-188	RT				26.4	33.6								1			
U-88	678	4175+79.47 (I-70 EB)	U-188	RT				29.5	37.5								1			
U-89	678	5077+91.39 (RAMP C5)	U-94	LT				24.2	30.8											
U-90	678	5080+18.54 (RAMP C5)	U-93	RT	99.9	127.1											1			
U-91	678	5080+19.34 (RAMP C5)	U-93	RT					76.1	96.9							1			
U-92	678	5074+46.64 (RAMP C5)	D-259	RT					106.9	136.1	4.4	5.6					1			
U-93	678	5074+45.18 (RAMP C5)	D-32	RT	152.2	193.8							4	5			1	1	1	
U-94	678	5074+89.26 (RAMP C5)	D-35	LT					65.1	82.9	5.3	6.7								
U-95	678	6005+64.47 (RAMP C6)	D-261	RT					16.7	21.3	4.4	5.6					1	1		
U-96	678	4174+20.26 (I-70 EB)	D-37						42.7	54.3							1			
U-97	678	6004+82.50 (RAMP C6)	U-79	LT					131.1	166.9							1			
U-98	678	6005+02.85 (RAMP C6)	U-188	BL	230.6	293.4											1			
U-99	678	4170+03.33 (I-70 EB)	U-164	RT	25.1	31.9											1			
U-100																				
U-101	678	5077+05.00 (RAMP C5)	U-93	RT					37.8	48.2							1			
U-104	678	4161+01.00 (I-70 EB)	U-72	LT					89.8	114.2										
U-105	679	4177+06.19 (I-70 EB)	D-192	LT					103.4	131.6	4.4	5.6					1			

NO.	DESCRIPTION	REV. BY	DATE
4	FUNDING CODE CHANGE	CWL	11-29-2021

TOTALS CARRIED TO SUBSUMMARY SHEET 222, 223

1185	1508	143	181	2839	3614	55	69	37	47	1	0	38	6	3	6
------	------	-----	-----	------	------	----	----	----	----	---	---	----	---	---	---

CALCULATED JMB CHECKED CWL
UNDERDRAIN ESTIMATED QUANTITIES
FRA - 70 / 71 - 12.68 / 14.86
 251 / 1815

01:2012\2012048\FRA\0552\ROADWAY\SHEETS\1056236061.DGN
 11/22/2021 9:03:10 AM
 G001V81STD_USER

REF. NO.	SHEET NO.	STATION		SIDE	605	605	605		605	611	611		611	611	FOR INFORMATION ONLY							
					6" SHALLOW PIPE UNDERDRAINS WITH GEOTEXTILE FABRIC	6" UNCLASSIFIED PIPE UNDERDRAINS WITH GEOTEXTILE FABRIC	4" BASE PIPE UNDERDRAINS		6" BASE PIPE UNDERDRAINS WITH GEOTEXTILE FABRIC	4" CONDUIT, TYPE F FOR UNDERDRAIN OUTLETS	6" CONDUIT, TYPE F FOR UNDERDRAIN OUTLETS		4" CONDUIT, TYPE B	6" CONDUIT, TYPE B		4" 90° BEND	4" PLUG	6" PLUG	6" X 6" TEE	6" X 6" CROSS	6" 90° BEND	
		FROM	TO		FT	FT	FT	FT	FT	FT	FT	FT	FT	FT	FT	FT	EACH	EACH	EACH	EACH	EACH	EACH
		01/NHS/ PV	01/NHS/ PV	01/NHS/ PV	01/NHS/ PV	01/NHS/ PV		01/NHS/ PV	01/NHS/ PV	01/NHS/ PV	01/NHS/ PV	01/NHS/ PV	01/NHS/ PV	01/NHS/ PV								
U-106	679	4177+13.59 (I-70 EB)	U-109	LT	106	135								5.3	6.7				1			2
U-107	679	4177+20.89 (I-70 EB)	D-189	RT				167.2	212.8					17.6	22.4				1	2		1
U-108	679	4179+55.60 (I-70 EB)	D-191	LT				125.4	159.6		4.4	5.6							1			
U-109	679	4179+54.21 (I-70 EB)	D-191	LT	130.2	165.8								4.4	5.6				1			1
U-110	679	4177+30.09 (I-70 EB)	U-107	RT	162.8	207.2													1			
U-111	679	4177+32.31 (I-70 EB)	U-107	RT				161.9	206.1										1			
U-112	679	4208+14.66 (I-70 EB)	U-147	LT	291.7	371.3													1			
U-113	679	5084+57.16 (RAMP C5)	D-43	LT				120.6	153.4										1			
U-114	679	5081+72.76 (RAMP C5)	U-118	RT			8.8	11.2											1			
U-115	679	5081+73.65 (RAMP C5)	U-118	RT			8.8	11.2											1			
U-117	679	5085+53.99 (RAMP C5)	U-118	RT																		
U-118	679	5086+03.90 (RAMP C5)	D-45	RT	183	233		160.6	204.4					4.0	5.0				1	1	1	
U-119	679	5086+29.61 (RAMP C5)	U-117	RT			34.8	44.2						2.6	3.4				1			2
U-120	679	4179+27.31 (I-70 EB)	D-189																1			
U-121	679	4181+05.32 (I-70 EB)	U-123	RT				101.2	128.8										1			2
U-122	679	4181+12.29 (I-70 EB)	D-188	RT				78.3	99.7		4.4	5.6							1			
U-123	679	4183+25.00 (I-70 EB)	D-57	RT				151.4	192.6										1			
U-124	679	4182+65.59 (I-70 EB)	D-157	LT				132.0	168.0		4.4	5.6							1			
U-125	679	4182+55.60 (I-70 EB)	D-254	LT	193.2	245.8					4.4	5.6							1			
U-126	679	4181+05.44 (I-70 EB)	U-155	RT				154.9	197.1					5.3	6.7				1			2
U-127	679	4208+14.66 (I-70 EB)	U-147	LT				291.7	371.3										1			
U-128	679	4185+90.59 (I-70 EB)	D-154	LT				45.3	57.7		4.4	5.6							1			
U-129	680	151+38.35 (FRONT)	U-222	LT/RT															1			
U-132	680	23+15.00 (FULTON)	D-318	LT						10									1			
U-134	680	21+05.59 (FULTON)	D-317	RT						10									1			
U-135	680	21+95.00 (FULTON)	D-315	RT						10									1			
U-136	680	22+90.01 (FULTON)	D-314	RT						10									1			
U-137	677	31+29.34 (SOUDER)	EXISTING UD	LT															1			
U-138	677	31+28.01 (SOUDER)	EXISTING UD	RT															1			
U-139	679	4186+72.94 (I-70 EB)	D-58	RT				33	42		4.4	5.6							1			
U-140	679	4188+05.06 (I-70 EB)	D-58	RT				17.2	21.8		4.4	5.6							1			
U-141	679	4187+10.10 (I-70 EB)	D-255	LT	26.8	34.2					4.4	5.6							1			
U-142	679	4189+94.29 (I-70 EB)	D-59	RT				77.4	98.6		4.4	5.6							1			
U-143	679	4193+97.50 (I-70 EB)	D-255	LT	264.9	337.1					4.4	5.6							1			
U-144	679	4205+28.94 (I-70 EB)	U-149	RT	166.8	212.2													1			
U-145	679	4205+28.94 (I-70 EB)	D-331	RT				117	149		4.4	5.6							1			
U-146	679	4194+02.50 (I-70 EB)	U-147	LT				330	420										1			
U-147	679	4194+02.50 (I-70 EB)	EX-30	LT	330	420								6.2	7.8				1	1	1	
U-148	679	4202+48.27 (I-70 EB)	D-330	RT				38.7	49.3		4.4	5.6							1			
U-149	679	4194+51.41 (I-70 EB)	D-330	RT	308	392								5.7	7.3				1	1		
U-150	679	4194+02.50 (I-70 EB)	D-329	RT				294.8	375.2		4.4	5.6							1			
U-151	679	4200+89.05 (I-70 EB)	D-330	RT				22.9	29.1		4.4	5.6							1			
U-154	680	23+15.00 (FULTON)	D-318	RT			323						22					1	1			
U-155	679	4184+57.04 (I-70 EB)	U-125	BL				73.9	94.1					10.6	13.4							1

UNDERDRAIN ESTIMATED QUANTITIES

FRA - 70 / 71 - 12.68 / 14.86

CALCULATED
JMB
CHECKED
CWL

NO.	DESCRIPTION	REV. BY	DATE
4	FUNDING CODE CHANGE	CWL	11-29-2021

TOTALS CARRIED TO SUBSUMMARY SHEET 222

REF. NO.	SHEET NO.	STATION		SIDE	605		605		605		611		611		FOR INFORMATION ONLY						CALCULATED		
		FROM	TO		6" SHALLOW PIPE UNDERDRAINS WITH GEOTEXTILE FABRIC	6" UNCLASSIFIED PIPE UNDERDRAINS WITH GEOTEXTILE FABRIC	6" BASE PIPE UNDERDRAINS WITH GEOTEXTILE FABRIC	6" CONDUIT, TYPE F FOR UNDERDRAIN OUTLETS	6" CONDUIT, TYPE B	4" PLUG	4" X 4" TEE	4" 90° BEND	6" PLUG	6" X 6" TEE	6" X 6" CROSS	6" 90° BEND	JMB						
					FT	FT	FT	FT	FT	FT	FT	FT	FT	EACH	EACH	EACH	EACH	EACH	EACH	EACH	CHECKED		
					01/NHS/ PV	01/NHS/ PV	01/NHS/ PV	01/NHS/ PV	01/NHS/ PV	01/NHS/ PV	01/NHS/ PV	01/NHS/ PV	01/NHS/ PV								CWL		
U-156	677	5032+65.15 (RAMP C5)	U-304	LT			2.6	3.4															
U-157	677	5032+50.00 (RAMP C5)	U-302	RT			26.4	33.6												1			
U-158	677	5032+50.00 (RAMP C5)	U-302	RT			26.4	33.6															
U-159	677	5032+66.46 (RAMP C5)	U-303	RT			8.4	10.6											1				
U-160	677	5032+66.98 (RAMP C5)	U-303	RT			18	19											1				
U-164	678	4169+79.61 (I-70 EB)	D-54	LT/RT					31.7	40.3			31.7	40.3					1	1	2		
U-165	678	4169+93.98 (I-70 EB)	U-164	BL					29	37									1				
U-166	678	4170+05.70 (I-70 EB)	D-53	RT					6.6	8.4			4.4	5.6					1				
U-167	679	5071+86.95 (RAMP C5)	D-43	LT			8.4	10.6											1				
U-170	677	259+51.96 (I-71 NB)	U-332	LT			40	51															
U-180	678	4157+88.17 (I-70 EB)	D-66	RT									4.4	5.6					1				
U-181	678	4158+21.00 (I-70 EB)	U-76	RT					122.3	155.7									1				
U-182	678	5062+50.38 (RAMP C5)	D-104	LT									4.4	5.6					1				
U-183	678	5061+87.48 (RAMP C5)	D-114	RT									4.4	5.6					1				
U-184	678	4174+15.27 (I-70 EB)	U-164	RT	155.3	197.7													1				
U-185	678	4170+35.04 (I-70 EB)	D-54	RT					6.6	8.4			4.4	5.6					1				
U-186	678	5074+35.45 (RAMP C5)	U-94	LT					241.1	306.9			1.8	2.2					1			2	
U-187	678	6006+17.04 (RAMP C6)	U-188	RT					179.5	228.5									1				
U-188	678	4174+20.30 (I-70 EB)	D-36	BL/RT					41.8	53.2			4.8	6.2	26	33			1				
U-189	677	252+86.40 (I-71 NB)	D-333	RT					104	105			4.4	5.6					1				
U-190	677	252+86.40 (I-71 NB)	U-191	BL	293	373													1				
U-191	677	259+51.96 (I-71 NB)	U-322	BL			39.6	50.4															
U-193	677	5005+99.92 (RAMP A5)	U-322	RT			22	28															
U-194	677	5009+95.00 (RAMP A5)	U-322	BL	151.8	193.2													1				
U-195	677	266+93.44 (I-71 NB)	U-322	RT	286.4	364.6													1				
U-196	677	5015+06.05 (RAMP A5)	D-265	RT					16.3	20.7			4.4	5.6					1				
U-197	677	270+30.35 (I-71 NB)	D-62	RT					37.4	47.6			4.4	5.6					1				
U-198	677	266+98.53 (I-71 NB)	D-61	RT					135.1	171.9			4.4	5.6					1				
U-199	677	258+66.57 (I-71 NB)	U-170	LT					37.8	48.2									1				
U-200	677	273+46.55 (I-71 NB)	D-63	RT					64.7	82.3			4.4	5.6					1				
U-201	677	273+64.54 (I-71 NB)	U-43	BL	104.3	132.7													1				
U-202	677	274+00.40 (I-70 NB)	U-43	LT					123.2	156.8									1				
U-203																							
U-204	677	5031+36.49 (RAMP C5)	U-4	BL					107.4	136.6			5.3	6.7					1			1	
U-206	677	3007+17.85 (RAMP C3)	EXISTING UD	RT					79.6	101.4									1				
U-207	677	3004+98.21 (RAMP C3)	D-214	RT					88.9	113.1			4.4	5.6					1				
U-208	677	5041+36.91 (RAMP C5)	D-207	LT					370.5	471.5			4.4	5.6					1	1			
U-209	677	5041+36.91 (RAMP C5)	U-208	LT	48	61								2.6	3.4				1			1	
U-210	677	5041+57.96 (RAMP C5)	D-216	LT					2.6	3.4			4.4	5.6					1				
U-211	677	5041+57.96 (RAMP C5)	D-216	LT	7	9								2.6	3.4				1			1	
U-212	677	134+05.00 (I-70 EB)	D-206	RT					232.8	296.2			4.4	5.6					1				
U-214	679	4187+19.93 (I-70 EB)	D-155	LT					21.1	26.9			4.4	5.6					1				
U-215	679	4193+97.50 (I-70 EB)	D-60	RT					172.5	219.5			4.4	5.6					1				
NO.	DESCRIPTION	REV. BY	DATE																				
4	FUNDING CODE CHANGE	CWL	11-29-2021																				
TOTALS CARRIED TO SUBSUMMARY SHEET 222					1046	1332	192	241		2253	2840		76	96		70	90			37	2	2	5

UNDERDRAIN ESTIMATED QUANTITIES

FRA - 70 / 71 - 12.68 / 14.86

D:\2021\2012048\FRA\05523\ROADWAY\SHEETS\185230063.DGN
 11/22/2021
 9:36:07 AM
 C00T01815D_USER

01:2012120448\FRA\105523\ROADWAY\SHEETS\10552300051.DGN
 11/22/2021
 10:01:05 AM
 C001V815TD_USER

REF. NO.	SHEET NO.	STATION		SIDE	202	202	638	638	SPECIAL		SPECIAL	SPECIAL	SPECIAL	SPECIAL	SPECIAL	638	
		FROM	TO		PIPE REMOVED, 24" AND UNDER FT	VALVE BOX REMOVED EACH	WATER WORK, MISC.: 6" WATER MAIN ABANDONED (COLUMBUS 808) EACH	WATER WORK, MISC.: 8" WATER MAIN ABANDONED (COLUMBUS 808) EACH	VALVE BOX ADJUSTED TO GRADE (COLUMBUS 807) EACH	CUT AND PLUG EXISTING 6" WATER LINE (COLUMBUS 808) EACH	CUT AND PLUG EXISTING 8" WATER LINE (COLUMBUS 808) EACH	CUT AND PLUG EXISTING 10" WATER LINE (COLUMBUS 808) EACH	CUT AND PLUG EXISTING 12" WATER LINE (COLUMBUS 808) EACH	FIRE HYDRANT ABANDONED (COLUMBUS 809) EACH	FIRE HYDRANT ADJUSTED TO GRADE EACH		
				△	01/NHS/PV	01/NHS/PV	01/NHS/PV	01/NHS/PV	01/NHS/PV	05/NHS/OT/ COL	01/NHS/PV	01/NHS/PV	01/NHS/PV	01/NHS/PV	01/NHS/PV	05/NHS/OT/ COL	
WJ-1	909	5091+16.71 (RAMP C5)		LT					1								
WJ-2	909	5091+28.88 (RAMP C5)		LT					1								
WJ-3	909	19+53.92 (FUL TON)		LT					1								
WJ-4	909	19+15.18 (FUL TON)		LT					1								
WJ-5	909	19+14.97 (FUL TON)		LT					1								
WJ-6	909	20+03.69 (FUL TON)		LT					1								
WJ-7	909	20+05.36 (FUL TON)		LT					1								
WJ-8	909	21+16.11 (FUL TON)		LT					1								
WJ-10	910	22+38.62 (FUL TON)		LT					1								
WJ-11	906	204+89.71 (LIVINGSTON)		RT											1		
WJ-12	906	204+91.74 (LIVINGSTON)		RT						1							
WJ-13	906	205+20.36 (LIVINGSTON)		RT					1								
WJ-14	906	205+55.71 (LIVINGSTON)		RT					1								
WJ-15	906	205+65.17 (LIVINGSTON)		RT					1								
WJ-16	906	205+68.76 (LIVINGSTON)		RT					1								
WJ-17	906	205+77.27 (LIVINGSTON)		RT					1								
WJ-18	906	207+15.35 (LIVINGSTON)		RT					1								
WJ-19	906	207+19.90 (LIVINGSTON)		RT					1								
WJ-20	907	200+64.79 (LIVINGSTON)		RT					1								
WJ-21	909	21+47.96 (FUL TON)		LT						1							
WJ-22	909	151+20.91 (FRONT)		RT					1								
WR-1	907	4182+97.89 (I-70 EB)		RT											1		
WR-2	907	5086+96.17 (RAMP C5)	5087+96.52 (RAMP C5)	RT	160		1			1							
WR-3	909	19+35.09 (FUL TON)		LT													
WR-4	909	19+83.14 (FUL TON)		LT											1		
WR-5	909	21+15.90 (FUL TON)		LT											1		
WR-6	281	4161+65.89 (I-70 EB)		LT				1									
WR-7	281	4157+93.32 (I-70 EB)	4158+14.26 (I-70 EB)	RT	25						2						
WR-8	908	5071+16.06 (RAMP C5)	5071+67.74 (RAMP C5)	LT/RT	134						2						
WR-9	908	5071+67.74 (RAMP C5)		LT				1									
WR-10	908	4166+58.46 (I-70 EB)		RT											1		
WR-11	911	5069+85.12 (RAMP C5)	5071+16.06 (RAMP C5)	RT	147												
WR-12	911	5070+83.82 (RAMP C5)	5071+16.06 (RAMP C5)	RT	66							1		2			
WR-13	908	5071+12.17 (RAMP C5)	4167+06.59 (I-70 EB)	LT/RT	262												
WR-14	910	22+38.73 (FUL TON)		LT											1		
NO. DESCRIPTION REV. BY DATE																	
4 FUNDING CODE CHANGE CWL 11-29-2021																	
TOTALS CARRIED TO SUBSUMMARY SHEETS 219.224					794	4	1	2		11	9	1	4	1	2	4	1

CALCULATED JMB CHECKED CWL
WATER WORK ESTIMATED QUANTITIES
FRA - 70 / 71 - 12.68 / 14.86
 254
 1815

01:\2012\2012048\FRA\105523\ROADWAY\105523\ROADWAY\SHEETS\1055230202.DGN
 11/22/2021
 10:17:06 AM
 G001V815TD_USER

STATION		SIDE	LENGTH	AVERAGE WIDTH W	SURFACE AREA A A=LxW	CADD AREAS	202			202			202			202			202				
							PAVEMENT REMOVED			PAVEMENT REMOVED, ASPHALT			WALK REMOVED	CONCRETE BARRIER REMOVED		TRAFFIC ISLAND REMOVED		CURB REMOVED			CURB AND GUTTER REMOVED		
FROM	TO						SY			SF	FT		SY			FT							
							01/NHS/PV	01/NHS/PV	05/NHS/OT /COL	01/NHS/PV	01/NHS/PV	05/NHS/OT /COL	01/NHS/PV	01/NHS/PV	01/NHS/PV	01/NHS/PV	01/NHS/PV	01/NHS/PV	05/NHS/OT /COL	01/NHS/PV			
DRIVEWAYS																							
DV-1	20+20.46 (FULTON)					570.75	63.42											12.83	16.33				
DV-2	20+55.92 (FULTON)					574.64	63.85											13.00	16.55				
DV-3	21+37.66 (FULTON)					370.84	41.20											6.15	7.83				
DV-4	152+11.68 (FRONT)					864.05	96.01											15.12	19.24				
DV-5	202+00.00 (LIVINGSTON)					479.69	53.30											2.41	3.06				
DV-5	202+00.00 (LIVINGSTON)					521.00			57.89														
DV-6	GATEWELL #4					320.72	35.64											16.41	20.89				
DV-8	204+61.50 (LIVINGSTON)					235.26		26.14														29.24	
DV-8	204+61.50 (LIVINGSTON)					148.37				16.49												14.01	
DV-9	205+69.33 (LIVINGSTON)					320.13		35.57														37.73	
DV-9	205+69.33 (LIVINGSTON)					18.38				2.04												1.54	
DV-11	5009+25.00 (RAMP A5)					843.74	93.75																
DV-11	5009+25.00 (RAMP A5)					47.39			5.27									10.80	13.74				
PARKING LOT																							
	LIVINGSTON & 2ND ST					2895.44			321.72									80.40	102.33				
SOUDER AVE																							
5+63.70	6+13.55	LT				216.20			24.02			327.46						20.48				29.39	
5+61.73	6+12.28	RT				220.85			24.54			343.35						20.07				30.48	
NORTHBOUND I.R. 71																							
252+86.40	258+90.12	LT/RT				16252.93	794.59	1011.29						10.18	12.96			26.00	33.00				
252+86.40	258+90.12	RT				4619.63			225.85	287.44								164.10	208.85				
5004+30.62 (RAMP A5)	5008+68.87 (RAMP A5)	LT				930.35			45.48	57.89								196.06	249.53				
5004+30.62 (RAMP A5)	5008+68.87 (RAMP A5)	LT/RT				7633.28	373.18	474.96															
5004+30.62 (RAMP A5)	5008+68.87 (RAMP A5)	RT				3756.43			183.65	233.73								49.62	63.15				
5011+81.5 (RAMP A5)	5018+60.36 (RAMP A5)	LT				2757.31			134.80	171.57								324.14	412.55				
5011+81.5 (RAMP A5)	5018+60.36 (RAMP A5)	LT/RT				12002.49	586.79	746.82															
5011+81.5 (RAMP A5)	5018+60.36 (RAMP A5)	RT				4001.93			195.65	249.01								250.86	319.28				
93497 TEMP RAMP (N.B. 71)																							
		LT/RT				14797.78			723.45	920.75													
RAMP BC																							
	SHOULDER	LT				3124.23			152.74	194.40								313.60	399.13				
	LANE	LT/RT				15577.76	761.58	969.28															
	SHOULDER	RT				9511.25			464.99	591.81								252.56	321.44				
	PUMP STATION DRIVE	RT				1454.24	71.10	90.49					11.04	14.04				52.20	66.43				
RAMP C3																							
3002+01.52	3009+00.00	LT				3508.11			171.51	218.28				4.11	5.24			273.13	347.61				
3000+16.87	3009+00.00	LT/RT				14766.27	721.91	918.79															
3000+16.87	3009+00.00	RT				8662.39			423.49	538.99								396.19	504.25				
EASTBOUND I.R. 70																							
125+96.00	127+28.39	LT				1246.73			60.95	77.57			110.62	140.78									
119+98.35	127+28.39	LT/RT				13275.88	649.04	826.05															
119+98.35	127+28.39	RT				7498.50			366.59	466.57								320.42	407.81				
127+96.76	129+50.00	LT				1477.33			72.23	91.92								69.09	87.94				
127+96.76	130+51.85	LT/RT				9092.74	444.53	565.77															
127+96.76	130+51.85	RT				2575.00			125.89	160.22								108.96	138.68				
TOTALS CARRIED TO ROADWAY SUBSUMMARY ON SHEET 219						4850	5604	62	3781	4261	19	671	122	155	15	19	2995	3760	83	60			

CALCULATED CJC
CHECKED CWL

PAVEMENT REMOVAL CALCULATIONS

NO.	DESCRIPTION	REV. BY	DATE
4	FUNDING CODE CHANGE		11-29-2021

FRA - 70 / 71 - 12.68 / 14.86

256
1815

STATION	SIDE	LENGTH	AVERAGE WIDTH W	SURFACE AREA A A=LxW	CADD AREAS	202		202		202		202		202		202		202		202			
						PAVEMENT REMOVED SY	PAVEMENT REMOVED, ASPHALT SY	WALK REMOVED SF	STEPS REMOVED FT	CONCRETE BARRIER REMOVED FT	TRAFFIC ISLAND REMOVED SF	CURB REMOVED FT	REMOVAL MISC.: TRAFFIC BOLLARDS REMOVED FT	REMOVAL MISC.: BRICK PAVERS REMOVED AND SALVAGED SF									
FROM	TO					01/NHS/PV	01/NHS/PV	01/NHS/PV	01/NHS/PV	05/NHS/OT /COL	01/NHS/PV	05/NHS/OT /COL	01/NHS/PV	01/NHS/PV	01/NHS/PV	01/NHS/PV	05/NHS/OT /COL	01/NHS/PV	01/NHS/PV	05/NHS/OT /COL			
EASTBOUND I.R. 70 CONT																							
4158+21.33	4166+10.19	LT			7448.29			364.14	463.45														
4158+21.33	4166+10.19	RT			2076.80	101.53	129.22																
4158+21.33	4166+10.19	RT			7158.31			349.96	445.41					62.14	79.08				289.21	368.09			
4169+93.98	4175+63.91	LT			4741.65			231.81	295.04					39.59	50.38								
4169+93.98	4175+63.91	LT/RT			29156.00	1425.4	1814.15																
4169+93.98	4175+63.91	RT			6232.62			304.71	387.81										253.73	322.93			
4177+06.24	4208+14.75	LT			25248.72			1234.38	1571.03														
4177+06.24	4186+25.00	LT/RT			43131.49	2108.65	2683.74																
4186+25.00	4195+78.19	LT			2884.96	141.04	179.51																
4177+06.24	4186+25.00	RT			5838.34			285.43	363.27					1480.80	1884.66	408.74	520.21						
4187+96.15	4189+69.92	RT			4428.18			216.49	275.53					55.12	70.15				518.01	659.28			
WESTBOUND I.R. 70																							
542+50.00	544+03.63	LT			1408.86	68.88	87.66							64.50	82.09				1.52	1.94			
540+94.35	544+58.70	RT			2801.58	136.97	174.32							160.21	203.90								
RAMP FROM I.R. 70 TO FRONT ST																							
4181+61.77	4184+26.27	RT			3846.45	188.05	239.33									197.77	251.7	120.30	153.11				
4181+61.77	4184+26.27	RT			157.88			7.72	9.82									79.53	101.22				
RAMP FROM I.R. 70 TO 3RD ST																							
4186+25.00	4197+04.60	RT			1985.45			97.07	123.54					55.96	71.22	150.03	190.94	275.28	350.35				
4186+25.00	4196+76.51	RT			16310.34	797.39	1014.87																
4186+25.00	4196+51.73	RT			7582.15			370.68	471.78					314.34	400.06			149.48	190.24				
LIVINGSTON AVE																							
200+02.98																							
200+02.98	204+02.12	LT/RT			17164.52			1907.17		6787.41				240.45	306.03	1239.75							
204+02.12	207+47.00	LT/RT			12988.12			1443.12		208.83						521.73				29.69			
					11104.76													1233.86		584.49	4067.04		
2ND ST																							
0+17.25	0+99.48	LT/RT			1816.45			201.83		256.01													
FRONT ST																							
146+75.00	148+25.58	LT/RT			2360.33			262.26		1558.12						102.25					161.43		
148+25.58	148+61.91	LT/RT			2319.33			257.70		804.68						79.87					32.47		
148+93.42	149+19.59	LT/RT			1780.32			197.81		494.78						70.00							
150+60.34	151+19.35	LT/RT			3398.02			377.56		997.18						60.75							
151+19.35	151+40.35	LT/RT			1151.26			127.92		578.38						42.02							
151+40.35	152+50.00	LT/RT			5852.62			650.29		2101.95			3.50			165.90							
148+78.00	150+60.22	RT																		182.21			
150+65.07	152+11.68	LT																		146.61			
FULTON ST																							
19+24.33	23+15.00	LT/RT			17192.18			1910.24		9584.21						694.29							
MOUND ST																							
11+49.85	12+53.78	LT/RT			7132.68			792.52															
WEST MOUND ST																							
23+48.52	25+21.36	LT			525.70	58.41										186.81							
WHITTIER ST																							
9+00.00	EX. A.S.	LT/RT			8591.05	420.01	534.55									270.16	343.84						
EX. A.S.	17+00.00	LT/RT			4608.95	225.33	286.78									143.44	182.56						
TOTALS CARRIED TO ROADWAY SUBSUMMARY ON SHEET 219						5672	7145	11591	4407	1234	23372	2612	4	752	957	2070	2634	5747	3194	585	359	194	4068

CALCULATED CJC	CHECKED CWL	NO.	4	DESCRIPTION	REV. BY	DATE	FUNDING CODE CHANGE	PAVEMENT REMOVAL CALCULATIONS	
								FRA - 70 / 71 - 12.68 / 14.86	257 1815

01:\2012\2012048\FRA\105525\ROADWAY\SHEETS\105525C002.DGN
 11/22/2021
 10:22:56 AM
 G00T015TD_USER

01/20/21 2:28:48 PM FRA\105523\ROADWAY\SHEETS\105523\001.DGN
 11/22/2021
 10:28:59 AM
 G00TV815TD_USER

REF. NO.	SHEET NO.	STATION/LOCATION	ALIGNMENT	SIDE	USAGE	TYPE	EXISTING MATERIAL	SURFACE AREA 1 (CADD AREA)	SURFACE AREA 2 (CADD AREA)	204		304		305		407		407		441		441		452		609	204	609	609	
								SF	SF	SY		CY			SY		SY		GAL		GAL			CY		CY		SY		SY
										01/NHS/ PV	05/NHS/ OT/COL	01/NHS/ PV	01/NHS/ PV	01/NHS/ PV	05/NHS/ OT/COL	01/NHS/ PV	05/NHS/ OT/COL	01/NHS/ PV	05/NHS/ OT/COL	01/NHS/ PV	05/NHS/ OT/COL	01/NHS/ PV	05/NHS/ OT/COL	01/NHS/ PV	05/NHS/ OT/COL	06/ENH/ OT/COL	01/NHS/ PV	01/NHS/ PV	01/NHS/ PV	05/NHS/ OT/COL
DV-1	370,584	20+20.46	FULTON ST.	LT	COMM.	-	CONC.	138.13	75.92	23.78														23.78						
DV-2	370,584	20+55.92	FULTON ST.	LT	COMM.	-	CONC.	144.91	95.50	26.71														26.71						
DV-3	370	21+37.66	FULTON ST.	LT	COMM.	1	CONC.	119.55	77.11	21.85														21.85	15.62					
DV-4	368-369	152+11.68	FRONT ST.	LT	COMM.	1	CONC.	334.59	193.14	58.64														58.64	15.62					
DV-5	585	202+00.00	LIVINGSTON	RT	COMM.	-	ASPHALT	365.51	777.20	126.97			86.36	6.04		4.75		3.6		4.2			40.61							
DV-6	586-587	GATEWELL #4			FIELD	-	GRAVEL	999.98	5109.34	678.81		55.51	70.65										111.11				163.16			
DV-7	588	RAILROAD			FIELD	-	GRAVEL	464.60	6583.59	783.13		71.53	91.03										51.62					43.83		
DV-8	375	204+61.50	LIVINGSTON	RT	COMM.	2A	ASPHALT	146.12	113.04		28.80			12.56		0.88		0.69		0.52		0.61		16.24					23.51	
DV-9	375	205+69.33	LIVINGSTON	RT	COMM.	2B	CONC.	220.93			24.55												24.55						15.42	
DV-10	318-320	GATEWELL #5			ACCESS	-	ASPHALT		22046.87	2449.65		239.52	304.85																	
DV-11	318	5009+25.00	RAMP A5	RT	FIELD	3	ASPHALT	764.49	844.00	178.72				93.78		6.56		5.16		3.91		4.56		84.94						
DV-12	304-323	RIVER ACCESS			FIELD	-	GRAVEL	24694.00	2743.78			268.28	341.45																	
DV-13	350	ELECTRIC			FIELD	-	GRAVEL	2841.98	315.78			30.88	39.30																	
DV-14	638-638A	RAILROAD			FIELD	-	GRAVEL	3829.82	425.54			41.61	52.96																	
DV-15	352-356	RR X-ING ACCESS			FIELD	-	GRAVEL	16477.74	1830.86			179.02	227.84													1830.86				
	590	PARKING LOT	LIVINGSTON	LT/RT		-	ASPHALT		3061.70	340.19				340.19		23.81		18.71		14.17		16.54							249.44	

CALCULATED CJC
 CHECKED CWL
DRIVE CALCULATIONS
FRA-70/71-12.68/14.86
 258
 1815

TOTALS CARRIED TO GENERAL SUMMARY 211, 216

10005 54 887 1129 521 13 37 1 29 1 22 1 26 1 420 41 32 1831 164 294 39

NO.	DESCRIPTION	REV. BY	DATE
4	FUNDING CODE CHANGE	CWL	11-29-2021

STATION	SIDE	LENGTH	AVERAGE WIDTH W	SURFACE AREA A A = L x W	CADD AREAS	608			608			608			608	
						4" CONCRETE WALK			8" CONCRETE WALK			WALKWAY, MISC.: COLUMBUS CURB RAMP, TYPE A	WALKWAY, MISC.: COLUMBUS CURB RAMP, TYPE P-7	WALKWAY, MISC.: COLUMBUS CURB RAMP, TYPE P-4 MODIFIED	WALKWAY, MISC.: BRICK PAVER WALK	
FROM	TO					SF			SF			EACH	EACH	EACH	SF	
LIVINGSTON AVE						01/NHS/PV	04/MPO/OT	05/NHS/OT/COL	01/NHS/PV	04/MPO/OT	05/NHS/OT/COL	01/NHS/PV	01/NHS/PV	01/NHS/PV	04/MPO/OT	06/ENH/OT/COL
203+92.24	203+94.99	LT	2.75	5.00	13.75											
203+94.99	205+51.56	LT	156.57	10.00	1565.70											
205+51.56	205+54.52	LT	2.96	10.20	30.19											
205+54.52	206+01.15	LT	46.63	12.34	575.41											
206+01.15	206+19.39	LT	18.24	15.21	277.43											
206+19.39	207+31.89	LT	112.5	13.50	1518.75											
207+31.89	207+47.00	LT	15.11	19.17	289.66											
200+04.37	200+42.61	RT	38.24	7.00	267.68											
200+42.61	200+46.21	RT			CADD	22.23										
200+46.21	200+59.83	RT			CADD	129.69			10.03							
200+86.31	201+02.97	RT			CADD	133.67										
201+02.97	201+64.67	RT	61.70	7.00	431.90											
201+64.67	201+72.99	RT	8.32	7.00	58.24											
202+24.80	202+31.48	RT			CADD	49.41										
202+31.48	202+43.98	RT			CADD	93.09										
202+43.98	202+54.35	RT	10.37	7.00	72.59											
202+54.35	203+01.10	RT			CADD	984.85			3.48	29.11						
203+01.10	203+79.46	RT			CADD	532.56			37.18							
203+79.46	203+91.30	RT			CADD	101.33										
203+91.30	204+44.27	RT	52.97	9.00	476.73											
204+04.18	204+15.03	RT			CADD	32.24										
204+15.03	204+44.27	RT			CADD	169.87										
204+44.27	204+80.09	RT			CADD	169.87										
204+80.09	205+53.87	RT	73.78	9.00	664.02											
205+53.87	205+95.38	RT			CADD	198.91										
205+95.38	206+33.97	RT	38.59	11.57	446.49											
206+33.97	206+55.18	RT	21.21	11.96	253.67											
206+55.18	207+47.00	RT			CADD	1270.24										
FRONT ST																
147+75.00	147+87.44	LT	12.44	16.87	209.86											
147+87.44	148+19.39	LT	31.95	16.03	512.16											
148+19.39	148+31.07	LT	11.68	15.00	175.20											
148+31.07	148+31.07	LT			CADD	53.91										
151+16.33	151+39.35	LT			CADD	527.07										
151+39.35	151+80.02	LT	40.67	13.50	549.05											
151+80.02	152+42.78	LT			CADD	332.65										
152+42.78	152+50.00	LT	7.22	14.46	104.40											
152+50.00	152+57.34	LT	7.34	14.43	105.92											
147+75.00	147+90.99	RT			CADD	167.37										
147+90.99	148+10.77	RT	19.78	17.50	346.15											
148+10.77	148+20.71	RT			CADD	139.46										

CALCULATED CJC
 CHECKED CWL
WALK CALCULATIONS
FRA - 70 / 71 - 12.68 / 14.86
 259
 1815

01/20/2021 2:04:48 PM FRA-105525-ROADWAY-SHEETS-105525-004.DGN
 11/22/2021
 11:16:35 AM
 G007V815TD_USER

TOTALS CARRIED TO ROADWAY SUBSUMMARY ON SHEET 220

3441 54 7516 541 30 369 6 1 1 233 1703

STATION		SIDE	LENGTH	AVERAGE WIDTH W	SURFACE AREA A A=LxW	CADD AREAS	608		608		608		608		608		CALCULATED CJC	CHECKED CWL	
							4" CONCRETE WALK	8" CONCRETE WALK	CONCRETE STEPS, TYPE B, AS PER PLAN	WALKWAY, MISC.: COLUMBUS CURB RAMP, TYPE A	WALKWAY, MISC.: BRICK PAVER WALK								
FROM	TO						SF	SF	FT	EACH	SF								
FRONT ST																			
151+02.93	151+39.35	RT				CADD												874.94	
151+39.35	151+48.14	RT	8.79	10.71	94.14		94.14												
151+39.35	151+48.14	RT				CADD		37.47										37.47	
151+48.14	151+56.15	RT	8.01	10.64	85.23		85.23												
151+56.15	151+61.40	RT	5.25	9.23	48.46		48.46												
151+61.40	151+86.60	RT	25.20	10.71	269.89		269.89												
151+86.60	151+91.67	RT	5.07	6.51	33.01		33.01												
151+91.67	152+09.97	RT	18.30	7.98	146.03		146.03												
152+09.97	152+18.09	RT	8.12	12.06	97.93		97.93												
FULTON ST																			
19+45.63	19+50.88	LT	5.25	9.05	47.51		47.51												
19+50.88	19+61.79	LT	10.91	10.65	116.19		116.19												
19+45.63	19+61.79	LT				CADD		97.24										97.24	
19+61.79	19+75.72	LT	13.93	10.89	151.70		151.70												
19+75.72	19+80.97	LT	5.25	9.64	50.61		50.61												
19+80.97	20+02.23	LT	21.26	11.32	240.66		240.66												
20+02.23	20+79.35	LT				CADD			472.73										
20+79.35	20+96.22	LT	16.87	13.45	226.90		226.90												
20+96.22	21+00.32	LT	4.10	12.26	50.27		50.27												
21+00.32	21+24.16	LT	23.84	14.07	335.43		335.43												
21+24.16	21+51.09	LT				CADD			194.18										
21+51.09	22+00.00	LT	48.91	15.83	774.25		774.25												
22+00.00	22+40.00	LT	40.00	17.10	684.00		684.00												
22+40.00	23+00.00	LT	60.00	18.47	1108.20		1108.20												
23+00.00	23+15.00	LT	15.00	19.81	297.15		297.15												
19+83.00	20+40.93	RT	57.93	12.50	724.13		724.13												
20+40.93	20+44.79	RT	3.86	14.43	55.70		55.70												
20+44.79	20+48.93	RT	4.14	16.36	67.73		67.73												
20+48.93	20+52.76	RT	3.83	14.43	55.27		55.27												
20+52.76	22+79.08	RT	226.32	12.50	2829.00		2829.00												
22+79.08	22+84.08	RT	5.00	8.68	43.40		43.40												
22+84.08	23+00.00	RT	15.92	4.86	77.37		77.37												
23+00.00	23+15.00	RT	15.00	7.91	118.65		118.65												
SOUDER AVE																			
5+63.70	5+71.08	LT	7.38	7.17	52.91		52.91												
5+71.08	5+95.13	LT	24.05	6.41	154.16		154.16												
5+95.13	6+13.55	LT	18.42	6.33	116.60		116.60												
5+61.73	5+68.73	RT	7.00	7.60	53.20		53.20												
5+68.73	6+12.28	RT	43.55	6.32	275.24		275.24												
FRA-70-13.95																			
CONCRETE STEPS																			
151+43.54	2 TREAD	RT		6.89					13.78										
NO.	DESCRIPTION	REV. BY	DATE																
4	FUNDING CODE CHANGE	CWL	11-29-2021																
TOTALS CARRIED TO ROADWAY SUBSUMMARY ON SHEET 220							9481	135	667	39		14	10		358	480			

WALK CALCULATIONS
FRA - 70 / 71 - 12.68 / 14.86
260
1815

01/20/21 2012048 FRA 105525 ROADWAY SHEETS 105525C005.DGN
 11/22/2021
 11:21:36 AM
 CADDUSER




0 10 20
HORIZONTAL SCALE IN FEET

CALCULATED TMT CHECKED CWL

**PLAN - I-70 EASTBOUND
STA. 4162+00.00 TO STA. 4167+00.00**

FRA-70/71-12.68/14.86

283
1815

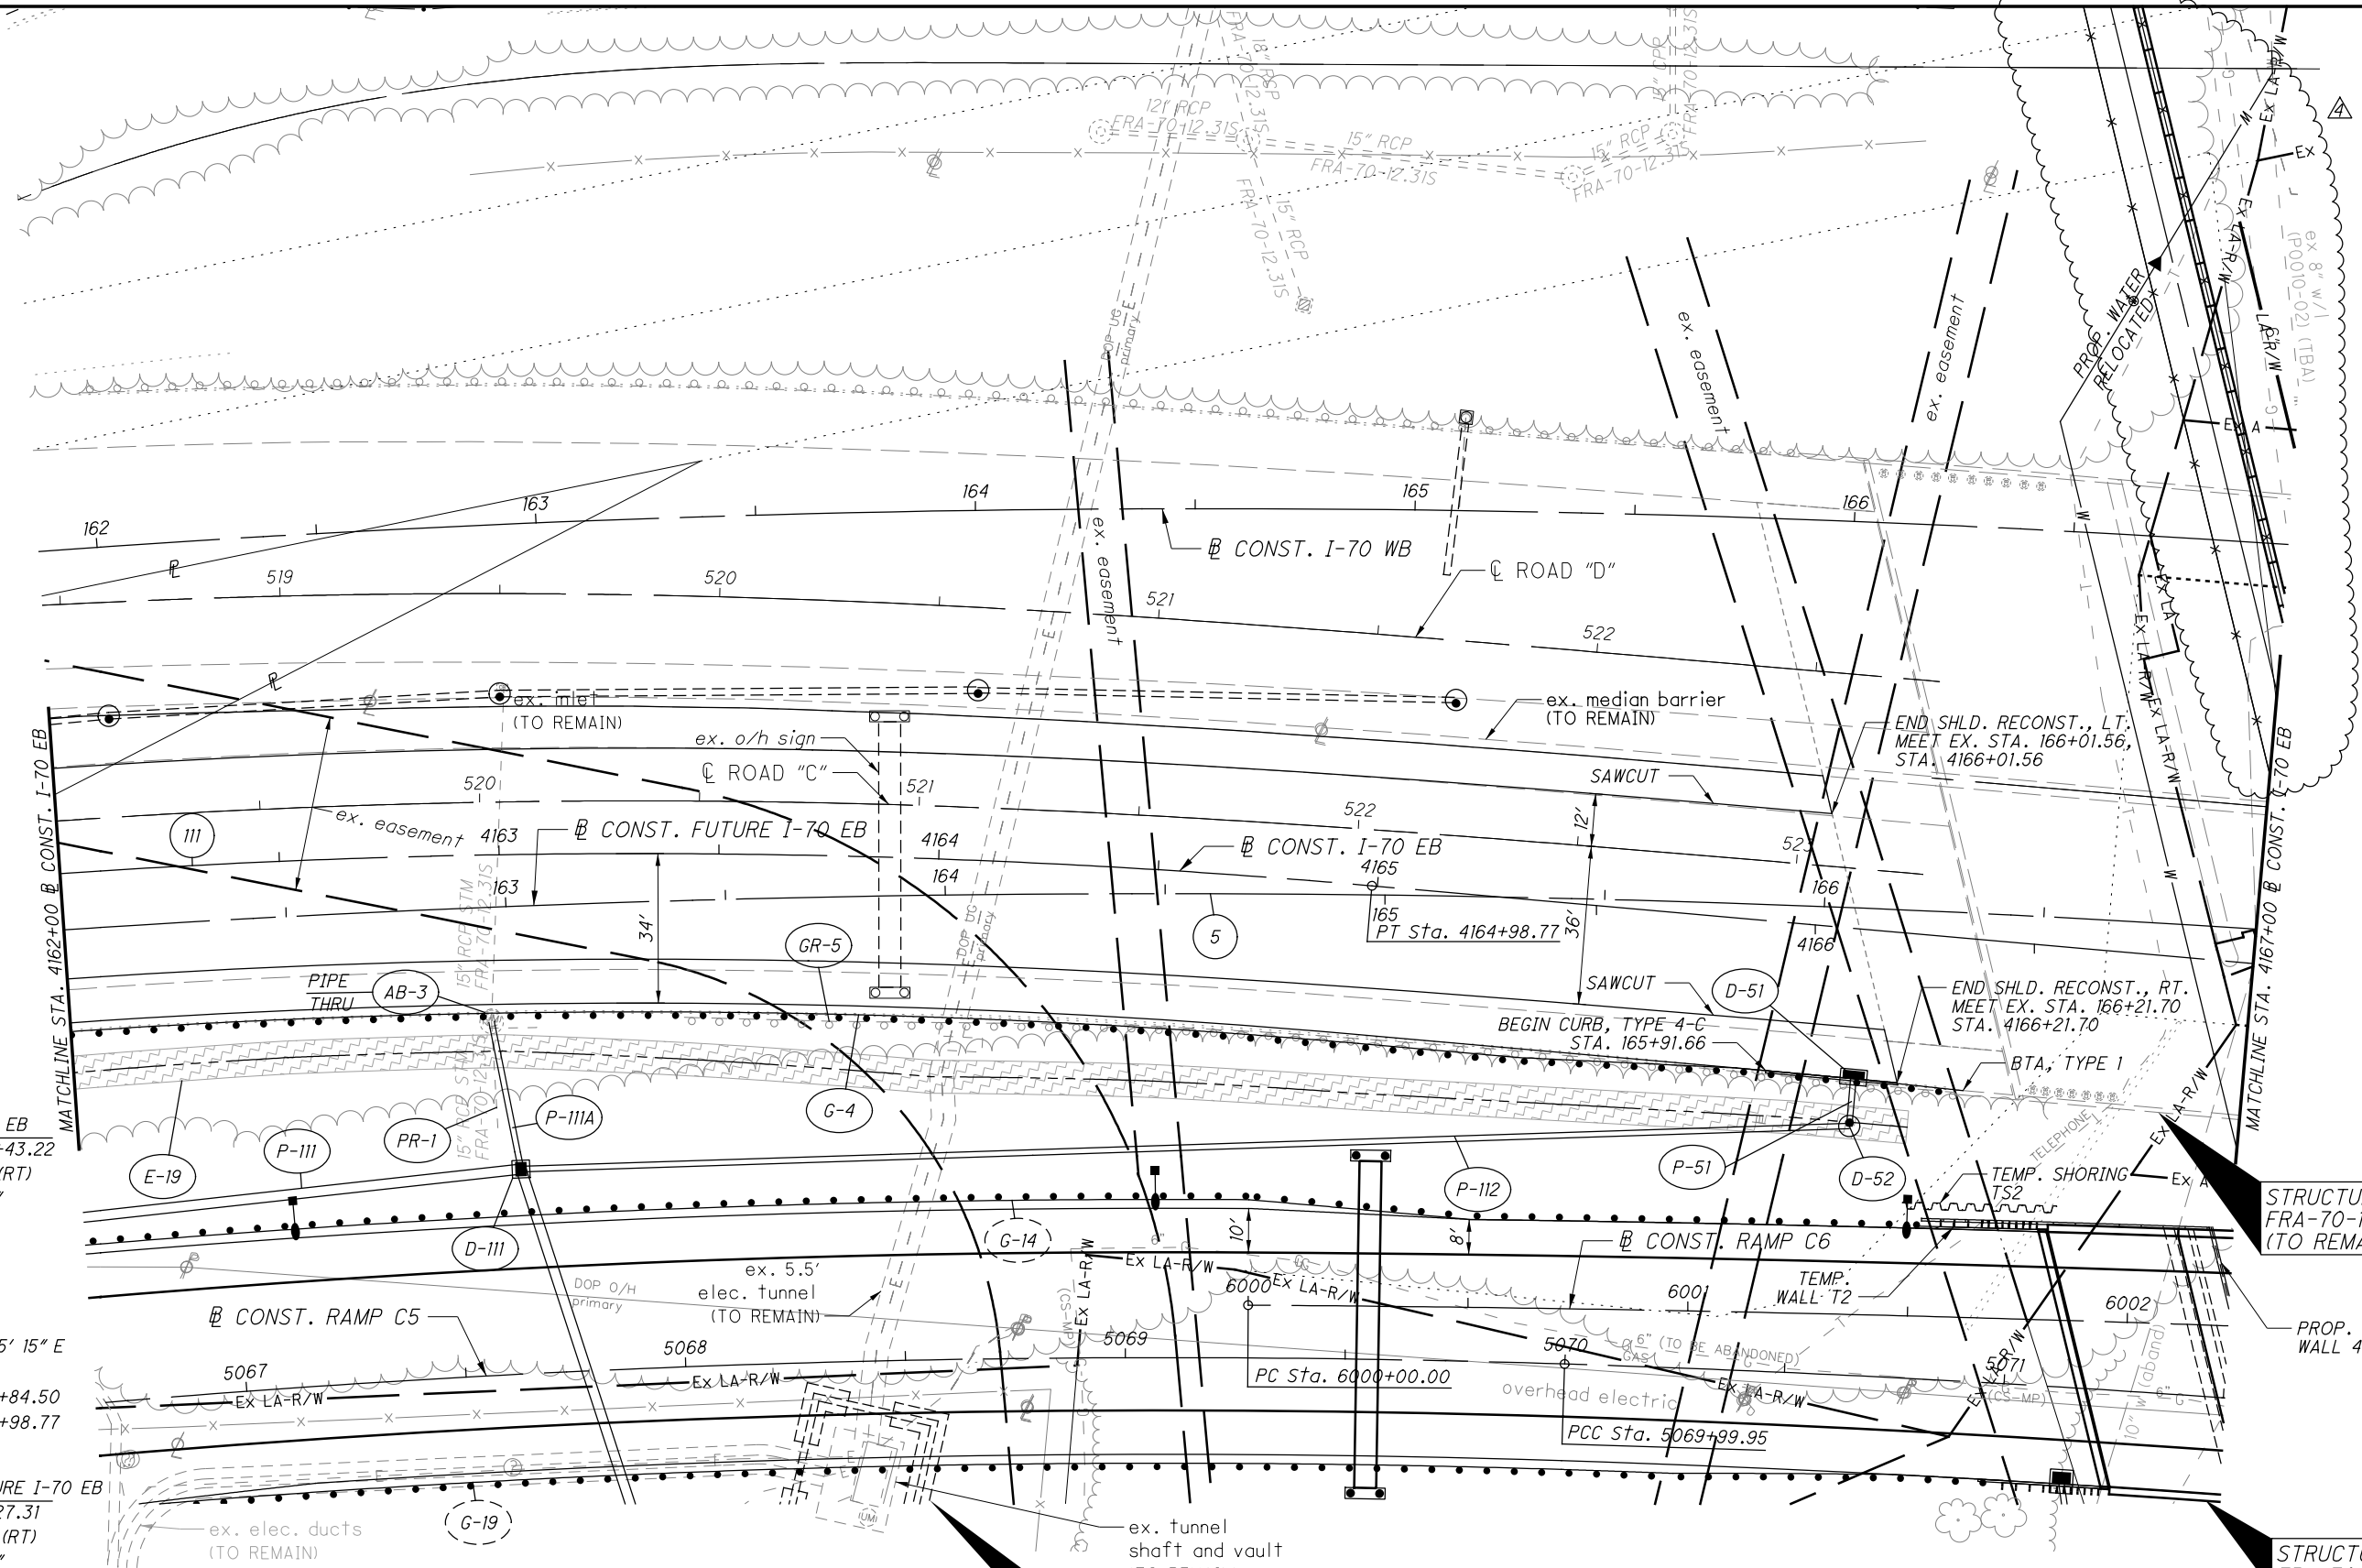

III **CONST. I-70 EB**
 P.I. Sta. 4162+43.22
 $\Delta = 15^\circ 31' 32''$ (RT)
 $D_c = 3^\circ 01' 08''$
 $R = 1,897.86'$
 $T = 258.72'$
 $L = 514.26'$
 $E = 17.55'$
 $C = 512.69'$
 $C.B. = N 74^\circ 45' 15'' E$
 $e_{max} = exist.$
 P.C. Sta. 4159+84.50
 P.T. Sta. 4164+98.77
 D.S. = 60 MPH

5 **CONST. FUTURE I-70 EB**
 P.I. Sta. 167+27.31
 $\Delta = 31^\circ 42' 37''$ (RT)
 $D_c = 1^\circ 30' 00''$
 $R = 3,819.72'$
 $T = 1,084.84'$
 $L = 2,114.01'$
 $E = 151.07'$
 $C = 2,087.14'$
 $C.B. = N 81^\circ 13' 18'' E$
 $e_{max} = 0.037$ (FUTURE)
 P.C.C. Sta. 156+42.47
 P.T. Sta. 177+56.48
 D.S. = 60 MPH

FOR STRUCTURE PLANS, SEE SHEETS 1472-1507
 FOR I-70 EB PROFILE, SEE SHEET 284
 FOR RAMP C5 PLANS, SEE SHEETS 331-361
 FOR RAMP C6 PLANS, SEE SHEETS 362-367
 FOR RETAINING WALL DETAILS, SEE SHEETS 831-834
 FOR PIPE PROFILES, SEE SHEETS 284, 397
 FOR SIGNING PLANS, SEE SHEETS 1014-1049
 FOR UNDERDRAIN DETAILS, SEE SHEETS 677-680
 FOR LIGHTING PLANS, SEE SHEETS 1163-1205A
 FOR ITS PLANS, SEE SHEETS 1122-1162
 FOR TEMP. WALL AND SHORING DETAILS, SEE SHEETS 889-902
 FOR WATER WORK DETAILS, SEE SHEETS 905-920
 FOR UTILITY LEGEND, SEE SHEET 3
 FOR ESTIMATED QUANTITIES, SEE SHEETS 230-255

STRUCTURE NO. FRA-70-1357A

STRUCTURE NO. FRA-70-1358R (TO REMAIN)

STRUCTURE NO. FRA-70-1358A

NO.	DESCRIPTION	REV. BY	DATE
4	WIDENED BPD	CWL	11-29-2021

01:\2012\20120416\FRA\105625\ROADWAY\SHEETS\105625P01.DWG
 11/27/2021 1:22:38 PM
 DDDTY81STD_USER


112 **CONST. I-70 EB**
 P.I. Sta. 4173+02.46
 $\Delta = 14^\circ 20' 13''$ (RT)
 $D_c = 1^\circ 30' 00''$
 $R = 3,819.72'$
 $T = 480.41'$
 $L = 955.79'$
 $E = 30.09'$
 $C = 953.30'$
 $C.B. = N 89^\circ 41' 07'' E$
 $e_{max} = 0.037$
 P.C. Sta. 4168+22.05
 P.T. Sta. 4177+77.84
 D.S. = 60 MPH

5 **CONST. FUTURE I-70 EB**
 P.I. Sta. 167+27.31
 $\Delta = 31^\circ 42' 37''$ (RT)
 $D_c = 1^\circ 30' 00''$
 $R = 3,819.72'$
 $T = 1,084.84'$
 $L = 2,114.01'$
 $E = 151.07'$
 $C = 2,087.14'$
 $C.B. = N 81^\circ 13' 18'' E$
 $e_{max} = 0.037$ (FUTURE)
 P.C.C. Sta. 156+42.47
 P.T. Sta. 177+56.48
 D.S. = 60 MPH

FOR TEMP. WALL AND SHORING DETAILS, SEE SHEETS 889 - 902
 FOR WATER WORK DETAILS, SEE SHEETS 905-920
 FOR I-70 EB PROFILE, SEE SHEET 286
 FOR RAMP C5 PLANS, SEE SHEETS 331-361
 FOR RAMP C6 PLANS, SEE SHEETS 362-367
 FOR GORE DETAILS, SEE SHEETS 560-571
 FOR STRUCTURE PLANS, SEE SHEETS 1472-1507
 FOR RETAINING WALL DETAILS, SEE SHEETS 804-823, 831-834
 FOR SIGNING PLANS, SEE SHEETS 1014-1049
 FOR UNDERDRAIN DETAILS, SEE SHEETS 677-680
 FOR LIGHTING PLANS, SEE SHEETS 1163-1205A
 FOR ITS PLANS, SEE SHEETS 1122-1162
 FOR UTILITY LEGEND, SEE SHEET 3
 FOR ESTIMATED QUANTITIES, SEE SHEETS 230-255

TAPER TABLE								
TAPER CODE	BEGINNING STATION	ENDING STATION	SIDE	DESCRIPTION	BEGIN WIDTH	END WIDTH	TAPER RATE	
DC	4170+05.70	I-70 EB	I-70 EB	RT	SHOULDER	6.03'	9.00'	34:1
DD	4171+61.37	I-70 EB	I-70 EB	RT	PB OFFSET	33.00'	32.00'	102:1

ITEM 670 - DITCH EROSION PROTECTION

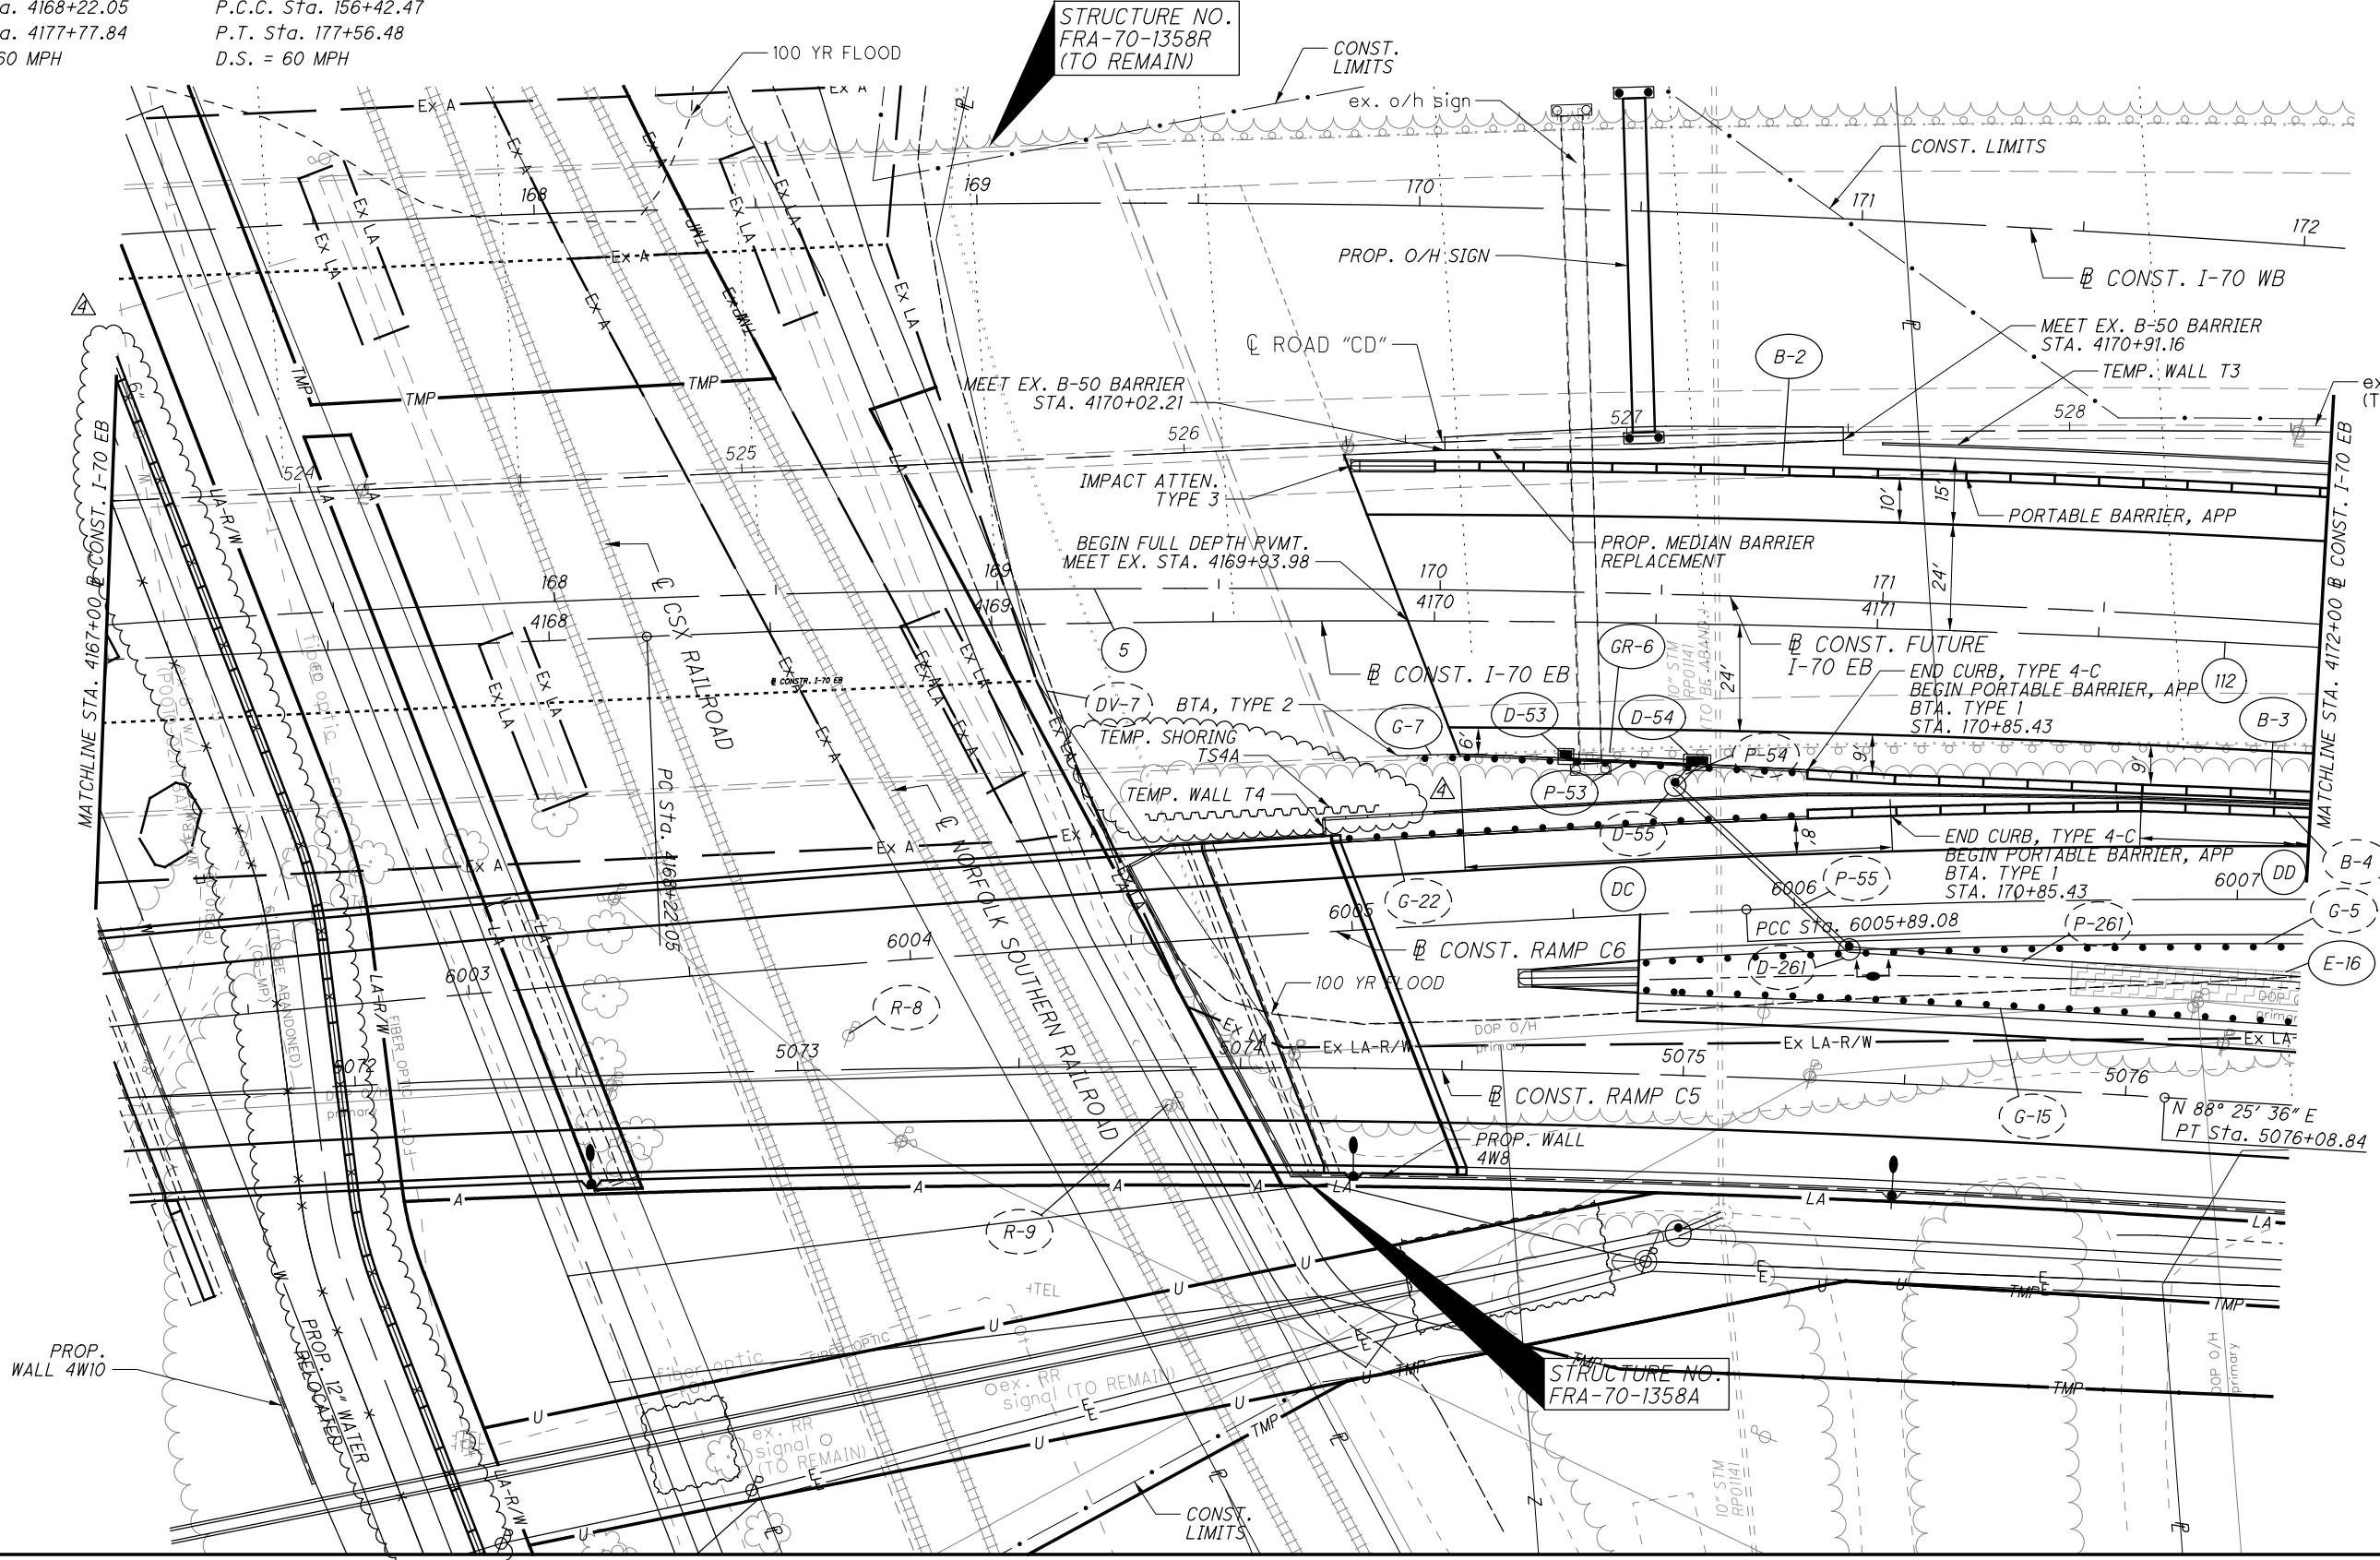

PLAN - I-70 EASTBOUND
STA. 4167+00.00 TO STA. 4172+00.00

NO.	DESCRIPTION	REV. BY	DATE
4	ADDED TEMP. SHORING TS44 / WIDENED BPD	CWL	11-29-2021

FRA-70/71-12.68/14.86

285
1815

G:\2012\20120418\FRA\105525\ROADWAY\SHEETS\105525P011.DGN
 11/27/2021
 11:25:53 PM
 C:\Users\j1std\Documents\105525P011.DGN

FOR PIPE PROFILES, SEE SHEETS 353, 484, 665, 666
 FOR RAMP C5 PROFILE, SEE SHEET 353
 FOR RAMP C6 PLANS, SEE SHEETS 362-367
 FOR I-70 EB PLANS, SEE SHEETS 265-303
 FOR GORE DETAILS, SEE SHEETS 560-571
 FOR STRUCTURE PLANS, SEE SHEETS 1472-1507
 FOR RETAINING WALL DETAILS, SEE SHEETS 804 - 823, 831 - 834
 FOR WATER WORK DETAILS, SEE SHEETS 905 - 920
 FOR UNDERDRAIN DETAILS, SEE SHEETS 677-680
 FOR ITS PLANS, SEE SHEETS 1122-1162
 FOR LIGHTING PLANS, SEE SHEETS 1163-1205A
 FOR SIGNING PLANS, SEE SHEETS 1014-1049
 FOR UTILITY LEGEND, SEE SHEET 3
 FOR ESTIMATED QUANTITIES, SEE SHEETS 230-255
 FOR TEMP. WALL AND SHORING DETAILS, SEE SHEETS 889A-902
 FOR DRIVE DETAILS, SEE SHEETS 583 - 590
 FOR BIKE PATH DETOUR PLANS, SEE SHEETS 636 - 643R



PLAN - RAMP C5
STA. 5070+00.00 TO STA. 5075+00.00


FRA-70/71-12.68/14.86

NO.	DESCRIPTION	REV. BY	DATE
4	ADDED TEMP. SHORING TS4A / WIDENED BPD	CWL	11-29-2021

17 CONST. RAMP C5
 P.I. Sta. 5073+05.04
 $\Delta = 9^\circ 08' 00''$ (RT)
 $D_c = 1^\circ 30' 00''$
 $R = 3,819.72'$
 $T = 305.09'$
 $L = 608.89'$
 $E = 12.16'$
 $C = 608.25'$
 C.B. = N 83° 51' 36" E
 $e_{max} = 0.028$
 P.C.C. Sta. 5069+99.95
 P.T. Sta. 5076+08.84
 D.S. = 50 MPH

ITEM 670 - DITCH EROSION PROTECTION

D:\2012\2012048\FRA\105523\ROADWAY\SHEETS\105523R0661.DGN
 11/27/2021
 11:28:31 PM
 C001V81STD_USER

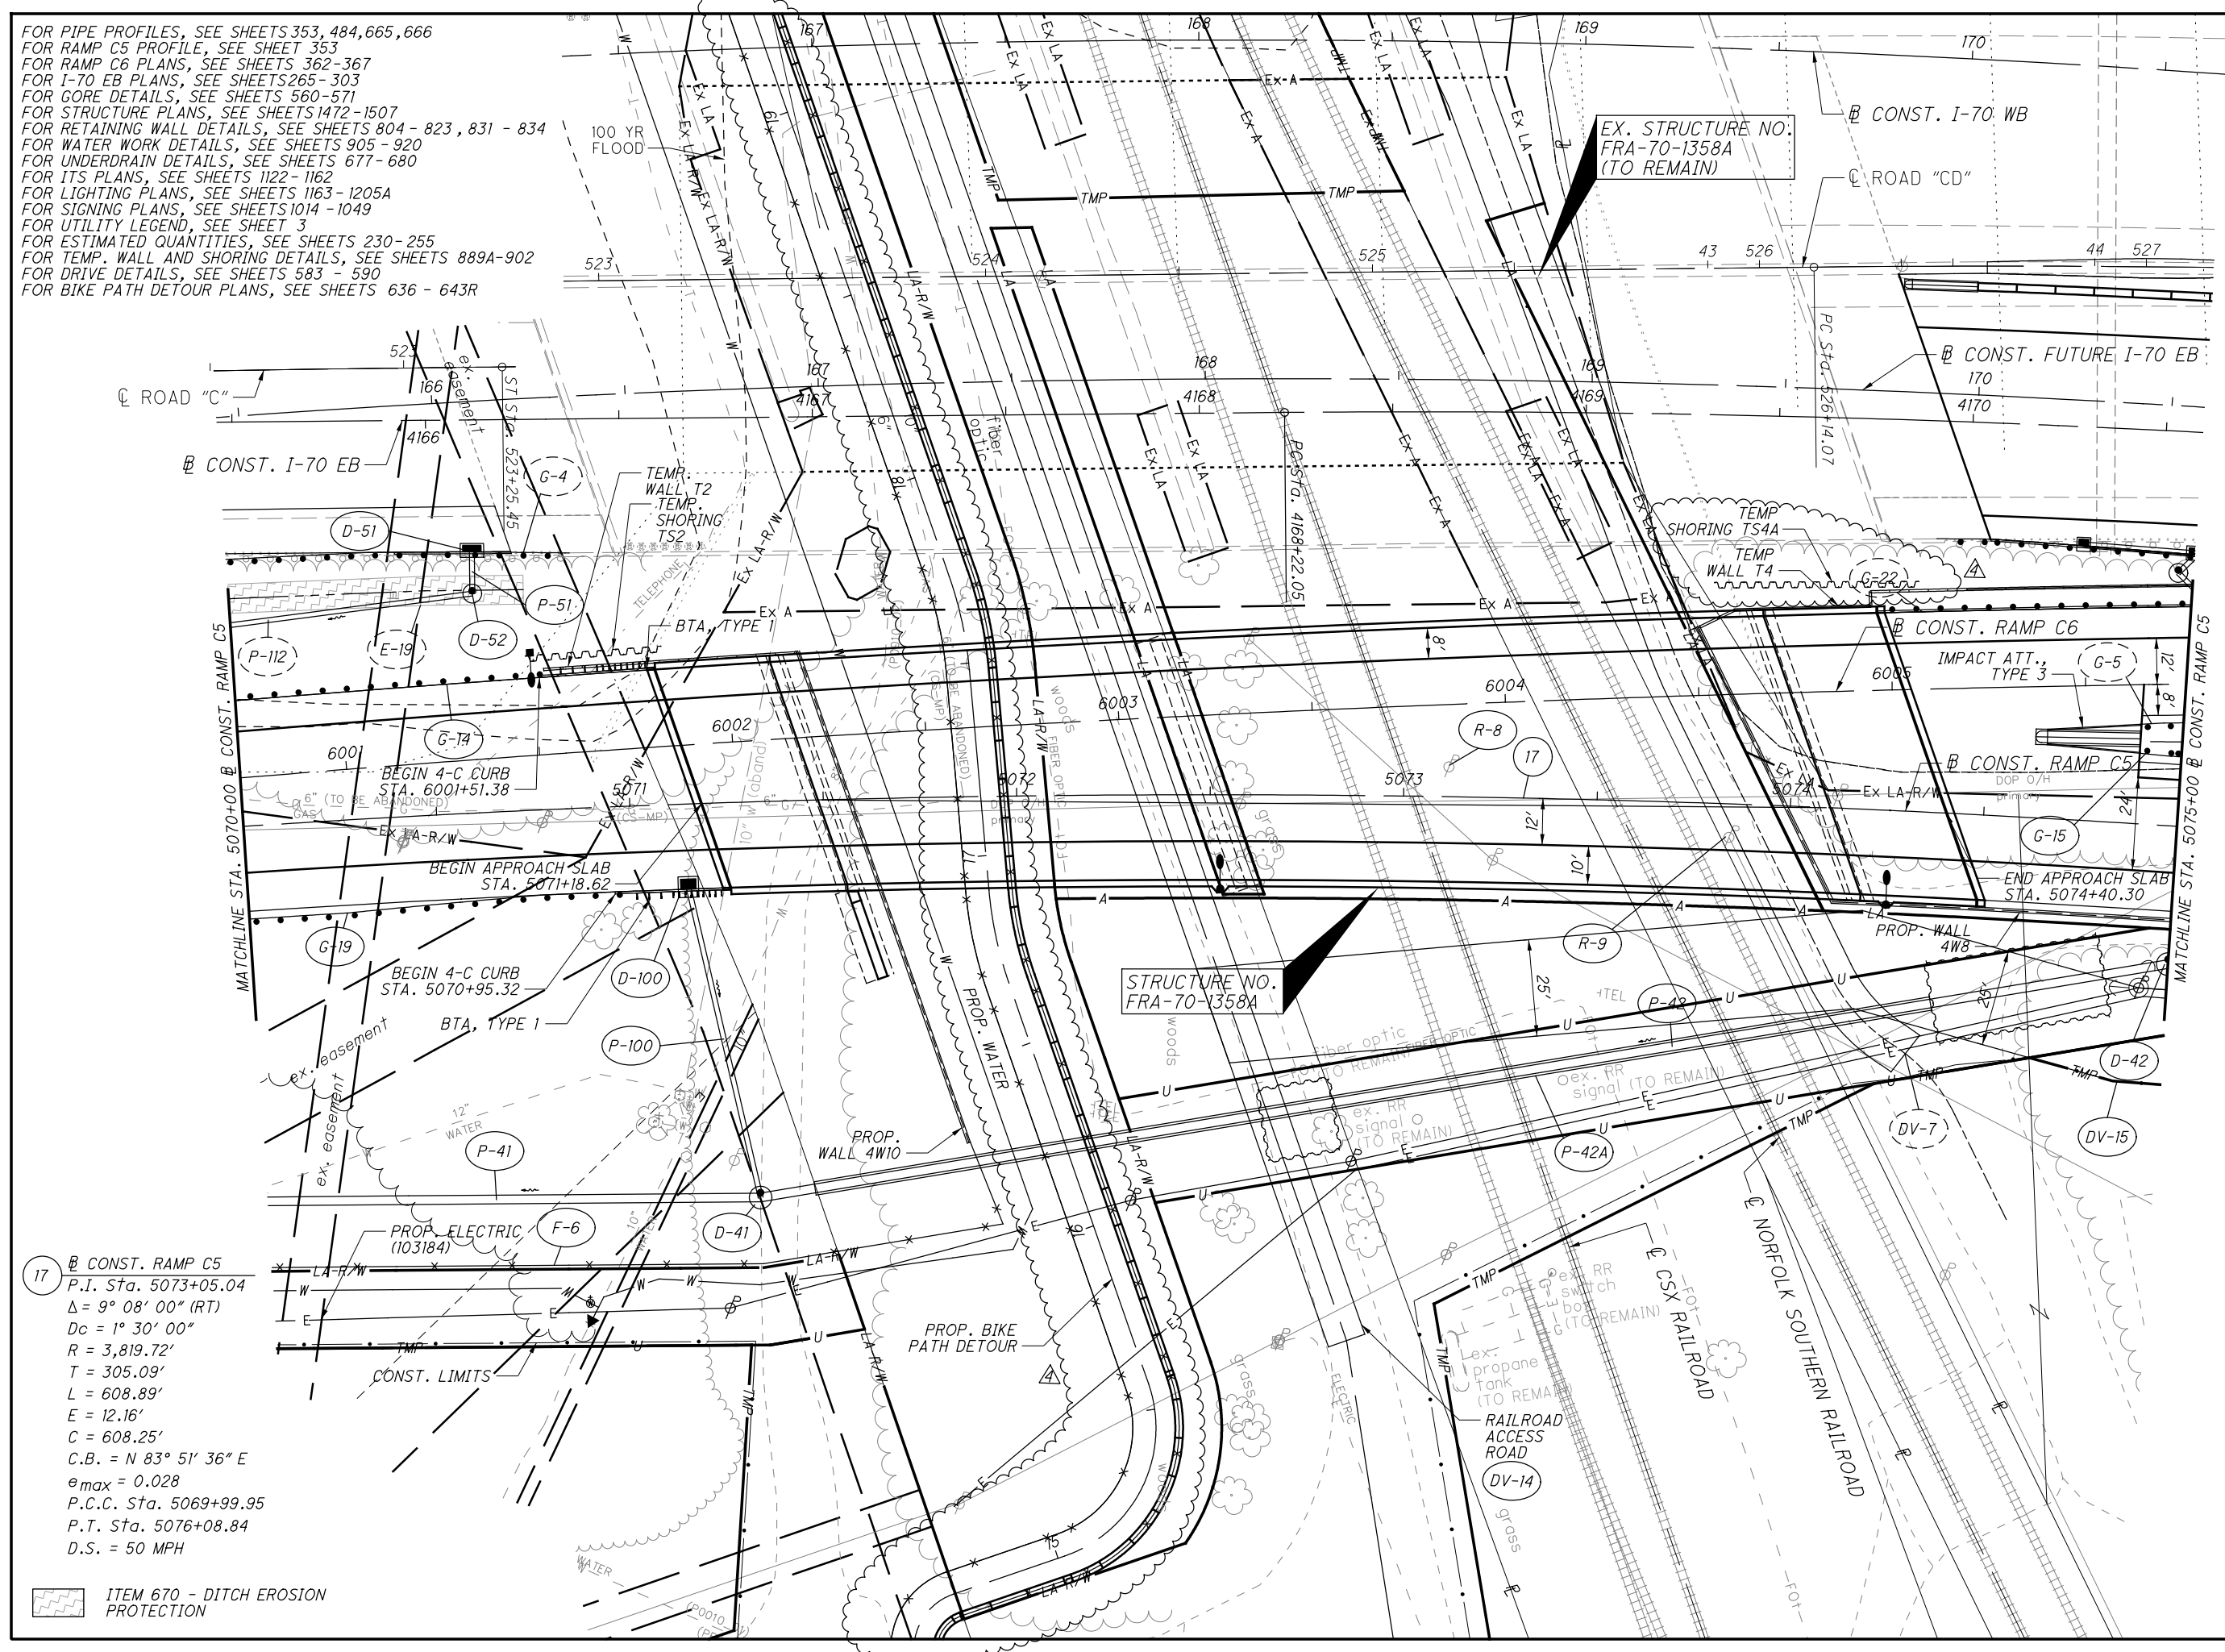



NO.	DESCRIPTION	REV. BY	DATE
4	ADDED TEMP. SHORING TS4A	CWL	11-29-2021


PLAN - RAMP C6
STA. 6002+00.00 TO STA. 6007+00.00

FRA-70/71-12.68/14.86

364
1815

STRUCTURE NO. FRA-70-1358R (TO REMAIN)

STRUCTURE NO. FRA-70-1358A

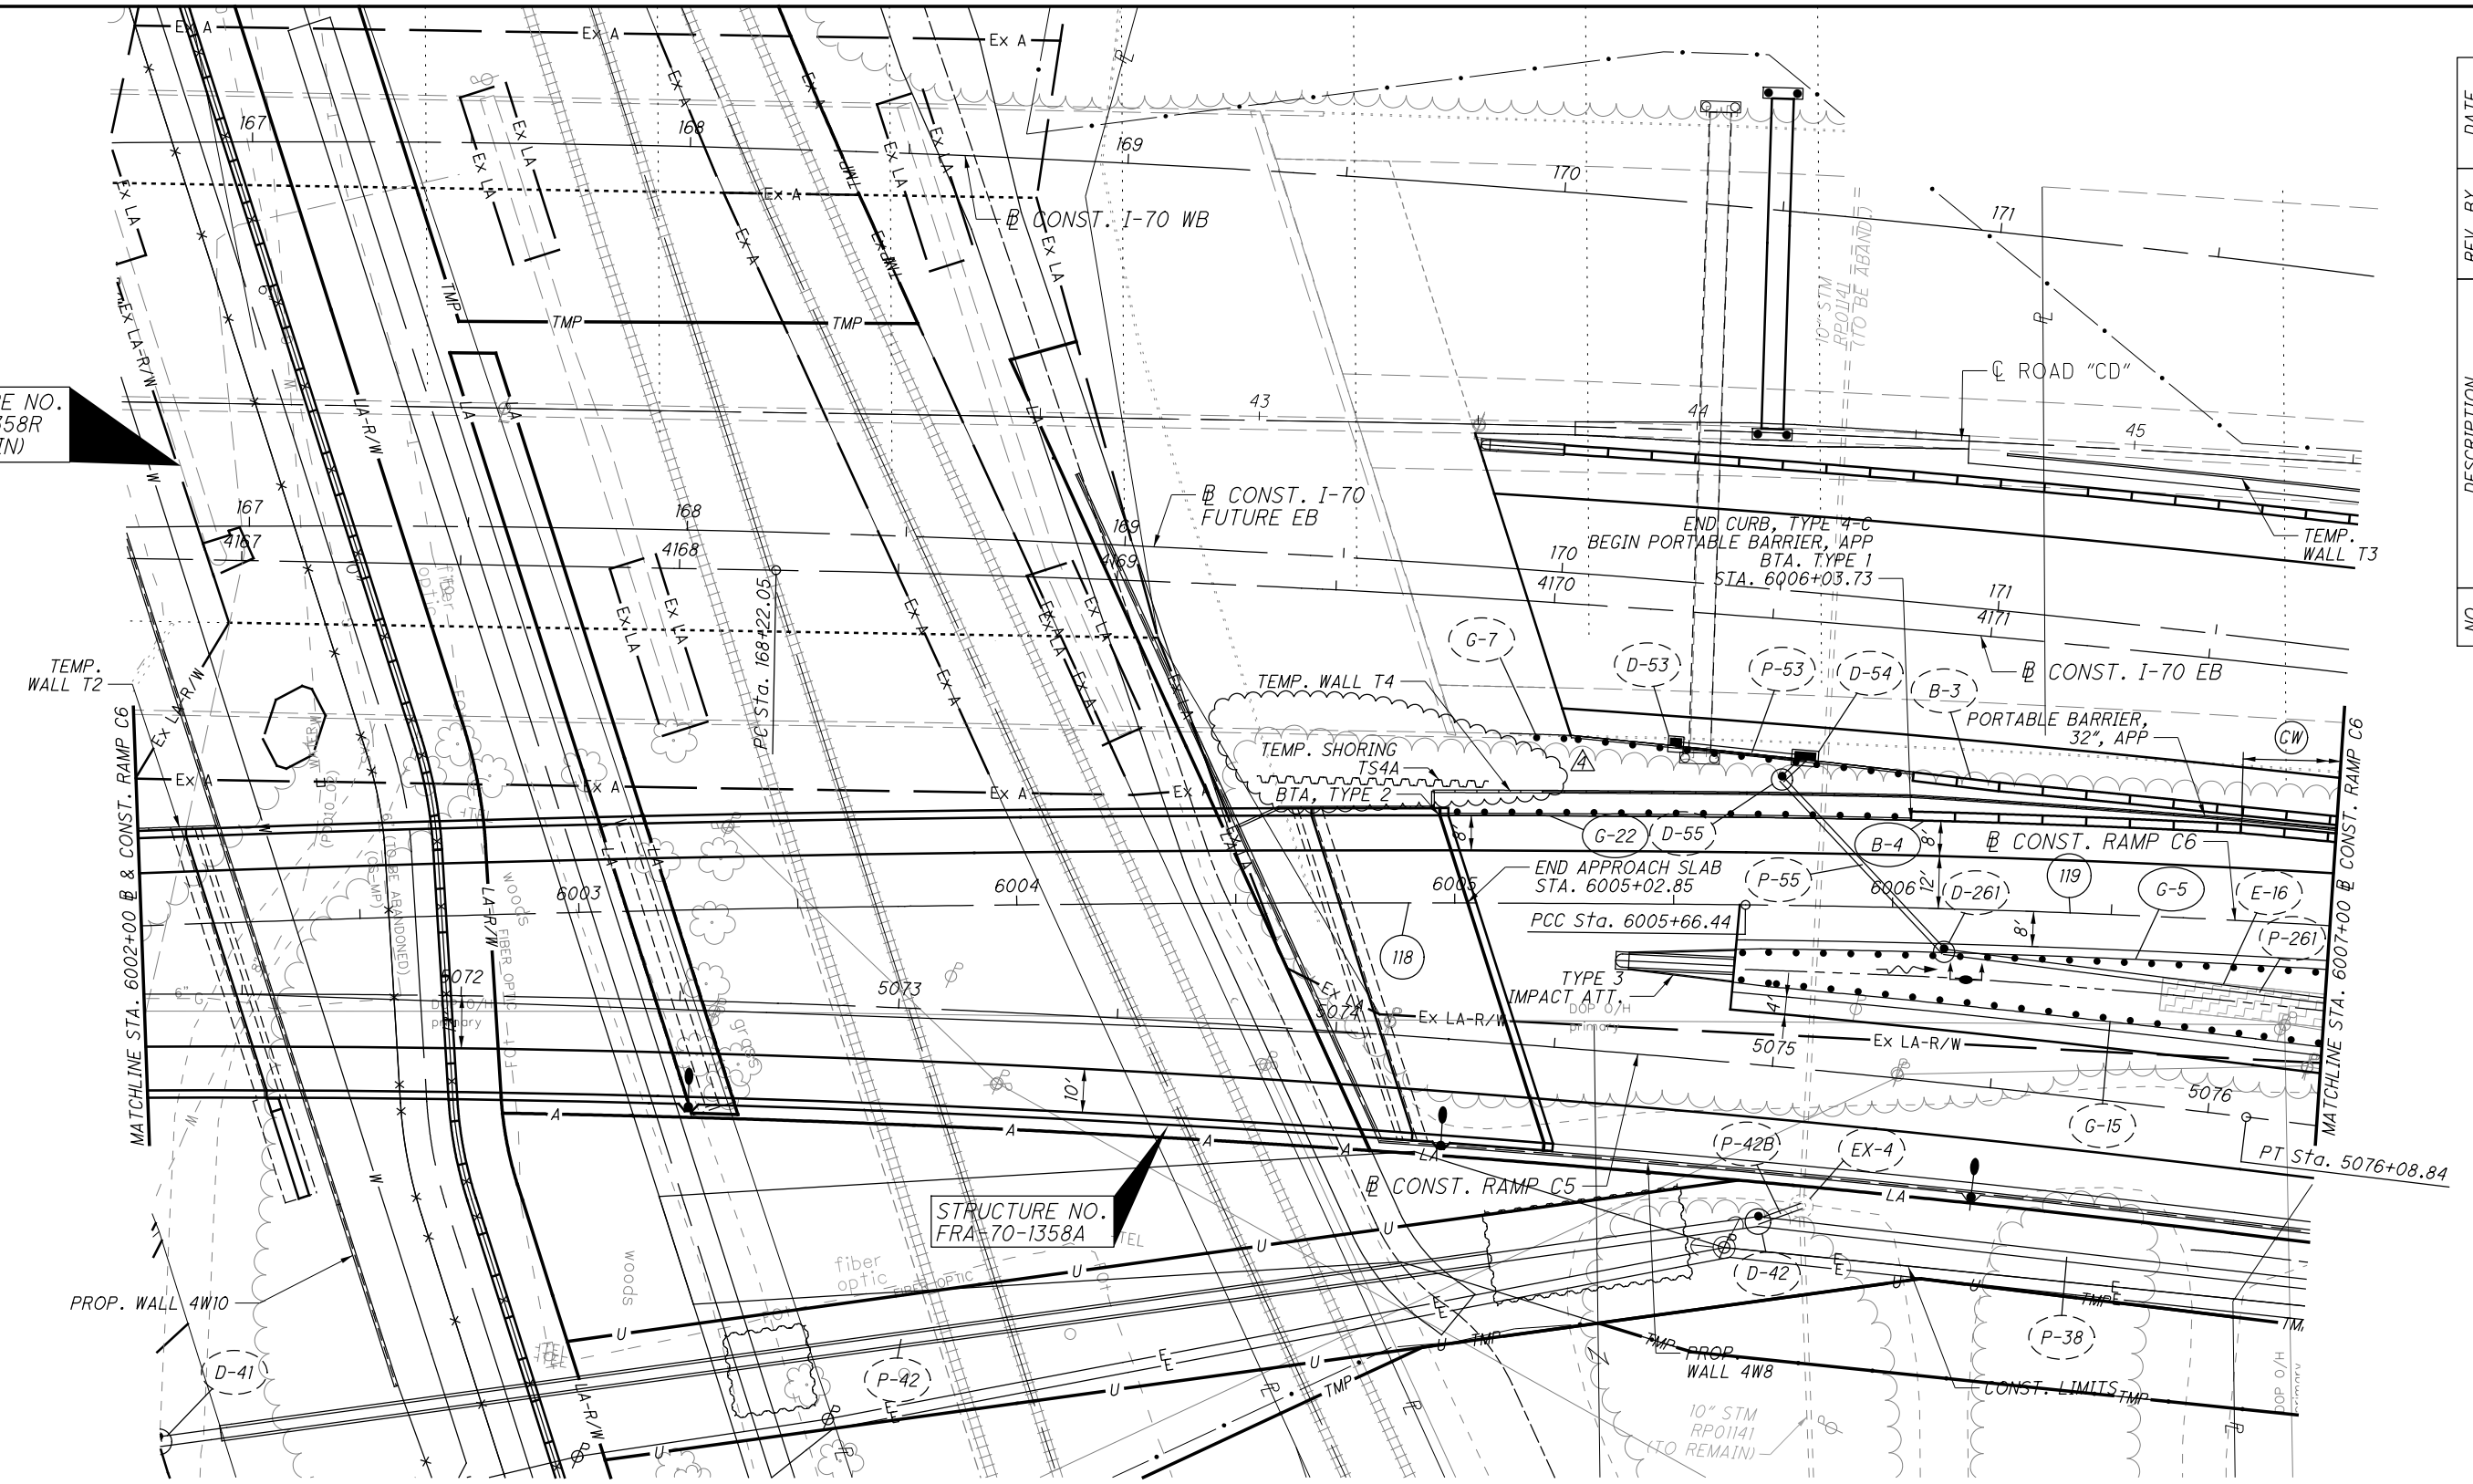

118 **CONST. RAMP C6**
 P.I. Sta. 6002+83.35
 $\Delta = 4^\circ 14' 54''$ (RT)
 $D_c = 0^\circ 45' 00''$
 $R = 7,639.44'$
 $T = 283.35'$
 $L = 566.44'$
 $E = 5.25'$
 $C = 566.31'$
 $C.B. = N 79^\circ 58' 34'' E$
 $e_{max} = 0.028$
 P.C. Sta. 6000+00.00
 P.T. Sta. 6005+66.44
 D.S. = 50 MPH

119 **CONST. RAMP C6**
 P.I. Sta. 6007+89.84
 $\Delta = 9^\circ 26' 10''$ (RT)
 $D_c = 2^\circ 07' 00''$
 $R = 2706.89'$
 $T = 223.41'$
 $L = 445.80'$
 $E = 9.20'$
 $C = 445.30'$
 $C.B. = N 86^\circ 49' 06'' E$
 $e_{max} = 0.037$
 P.C. Sta. 6005+66.44
 P.C.C. Sta. 6010+12.24
 D.S. = 50 MPH

TAPER CODE	BEGINNING STATION	ENDING STATION	SIDE	DESCRIPTION	BEGIN WIDTH	END WIDTH	TAPER RATE
CW	6006+78.47	RAMP C6	6007+78.47	RAMP C6	LT	PORT BARRIER	8.00' 4.00' 25:1

ITEM 670 - DITCH EROSION PROTECTION

FOR RAMP C6 PROFILE, SEE SHEET 365
 FOR RAMP C5 PLANS, SEE SHEETS 331-361
 FOR I-70 EB PLANS, SEE SHEETS 265-303
 FOR STRUCTURE PLANS, SEE SHEETS 1472-1507
 FOR GORE DETAILS, SEE SHEETS 560-571
 FOR RETAINING WALL DETAILS, SEE SHEETS 804-823, 831-834, 898, 899
 FOR PIPE PROFILES, SEE SHEETS 365, 397
 FOR UNDERDRAIN DETAILS, SEE SHEETS 677-680
 FOR LIGHTING PLANS, SEE SHEETS 1163-1205
 FOR ITS PLANS, SEE SHEETS 1122-1162
 FOR UTILITY LEGEND, SEE SHEET 3
 FOR SIGNING PLANS, SEE SHEETS 1014-1049
 FOR ESTIMATED QUANTITIES, SEE SHEETS 230-255

G:\2012\20120418\FRA\105525\ROADWAY\SHEETS\105525P072.DGN
 11/24/2021 11:45:37 PM
 DDDTY81STD_USER

SEEDING		NO.	DESCRIPTION	REV. BY	DATE
END WIDTH	SO. YDS.				
19		4	EARTHWORK REVISED	ATR	11-29-2021


- [#] ITEM 203 - GRANULAR EMBANKMENT
- ITEM 206 - CEMENT STABILIZED SUBGRADE, 14 INCHES DEEP
- ITEM 202 - PAVEMENT REMOVED
- ITEM 202 - PAVEMENT REMOVED, ASPHALT

END AREA	VOLUME	CALCULATED	CHECKED	CWL
91	0			
24	0	[87]		
124	0	[24]		
0	5			
199	1815	[874]		

CROSS SECTIONS I-70 EASTBOUND
 STA. 4166+00.00 TO STA. 4170+00.00

FRA -70/ 71-12.68 / 14.86

396
 1815

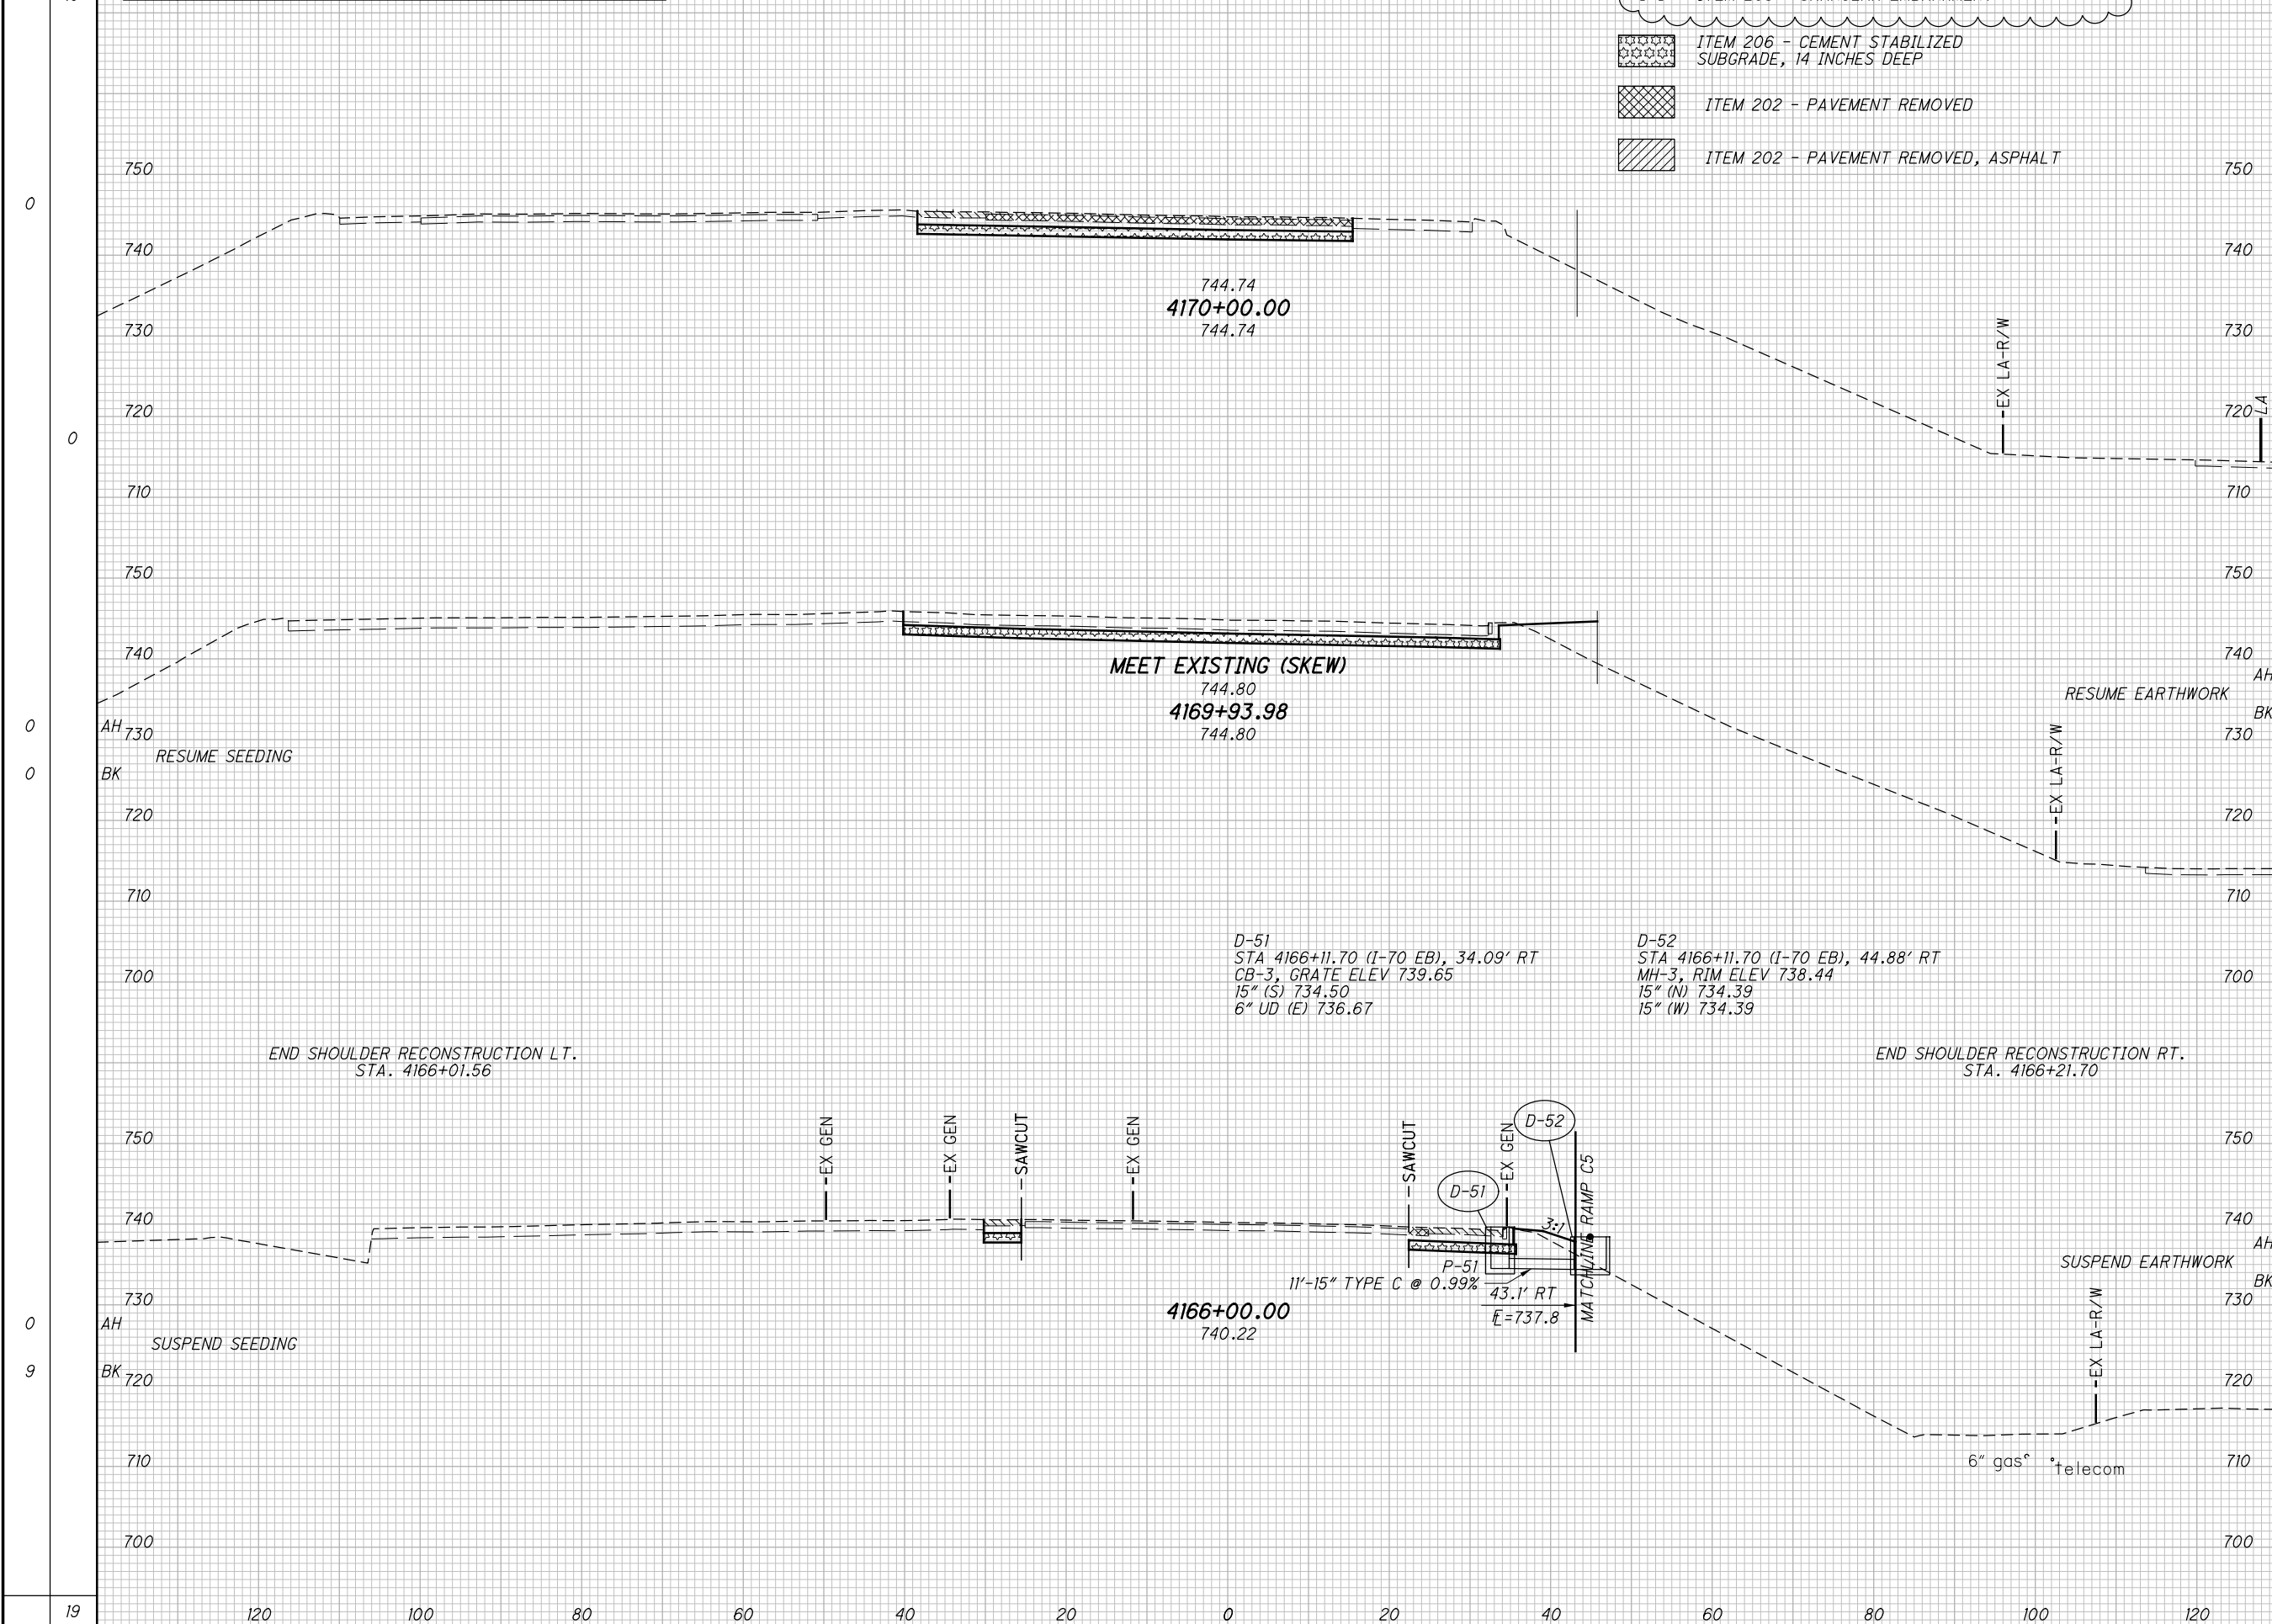

D:\2012\2012048\FRA\105523\ROADWAY\105523\S001.DGN
 11/24/2021
 3:17:48 PM
 D:\105523\STD_USER

SEEDING		NO.	DESCRIPTION	REV. BY	DATE
END WIDTH	SO. YDS.				
72		4	EARTHWORK REVISED	ATR	11-29-2021


[#] ITEM 203 - GRANULAR EMBANKMENT

LOAD TRANSFER PLATFORM
(INCLUDED WITH RETAINING WALL
ITEM 203 - ROADWAY, MISC.: COLUMN
SUPPORTED WALLS)

- [Pattern] ITEM 206 - CEMENT STABILIZED SUBGRADE, 14 INCHES DEEP
- [Pattern] ITEM 202 - PAVEMENT REMOVED
- [Pattern] ITEM 202 - PAVEMENT REMOVED, ASPHALT

D-261
STA 6006+12.03 (C6), 4.00' RT
MH-3, RIM ELEV 749.98
15" (N) 738.08
15" (E) 738.08
6" UD (W) 746.83

END AREA	VOLUME	CALCULATED	CHECKED					
				CUT	FILL	CUT	FILL	ATR
		309	[2278]					
		196	[1117]					
		380	[1906]					
		214	[941]					
		689	[4184]					
CROSS SECTIONS I-70 EASTBOUND STA. 4170+50.00 TO STA. 4171+00.00								
FRA -70/ 71-12.68 / 14.86								
		397	[1815]					

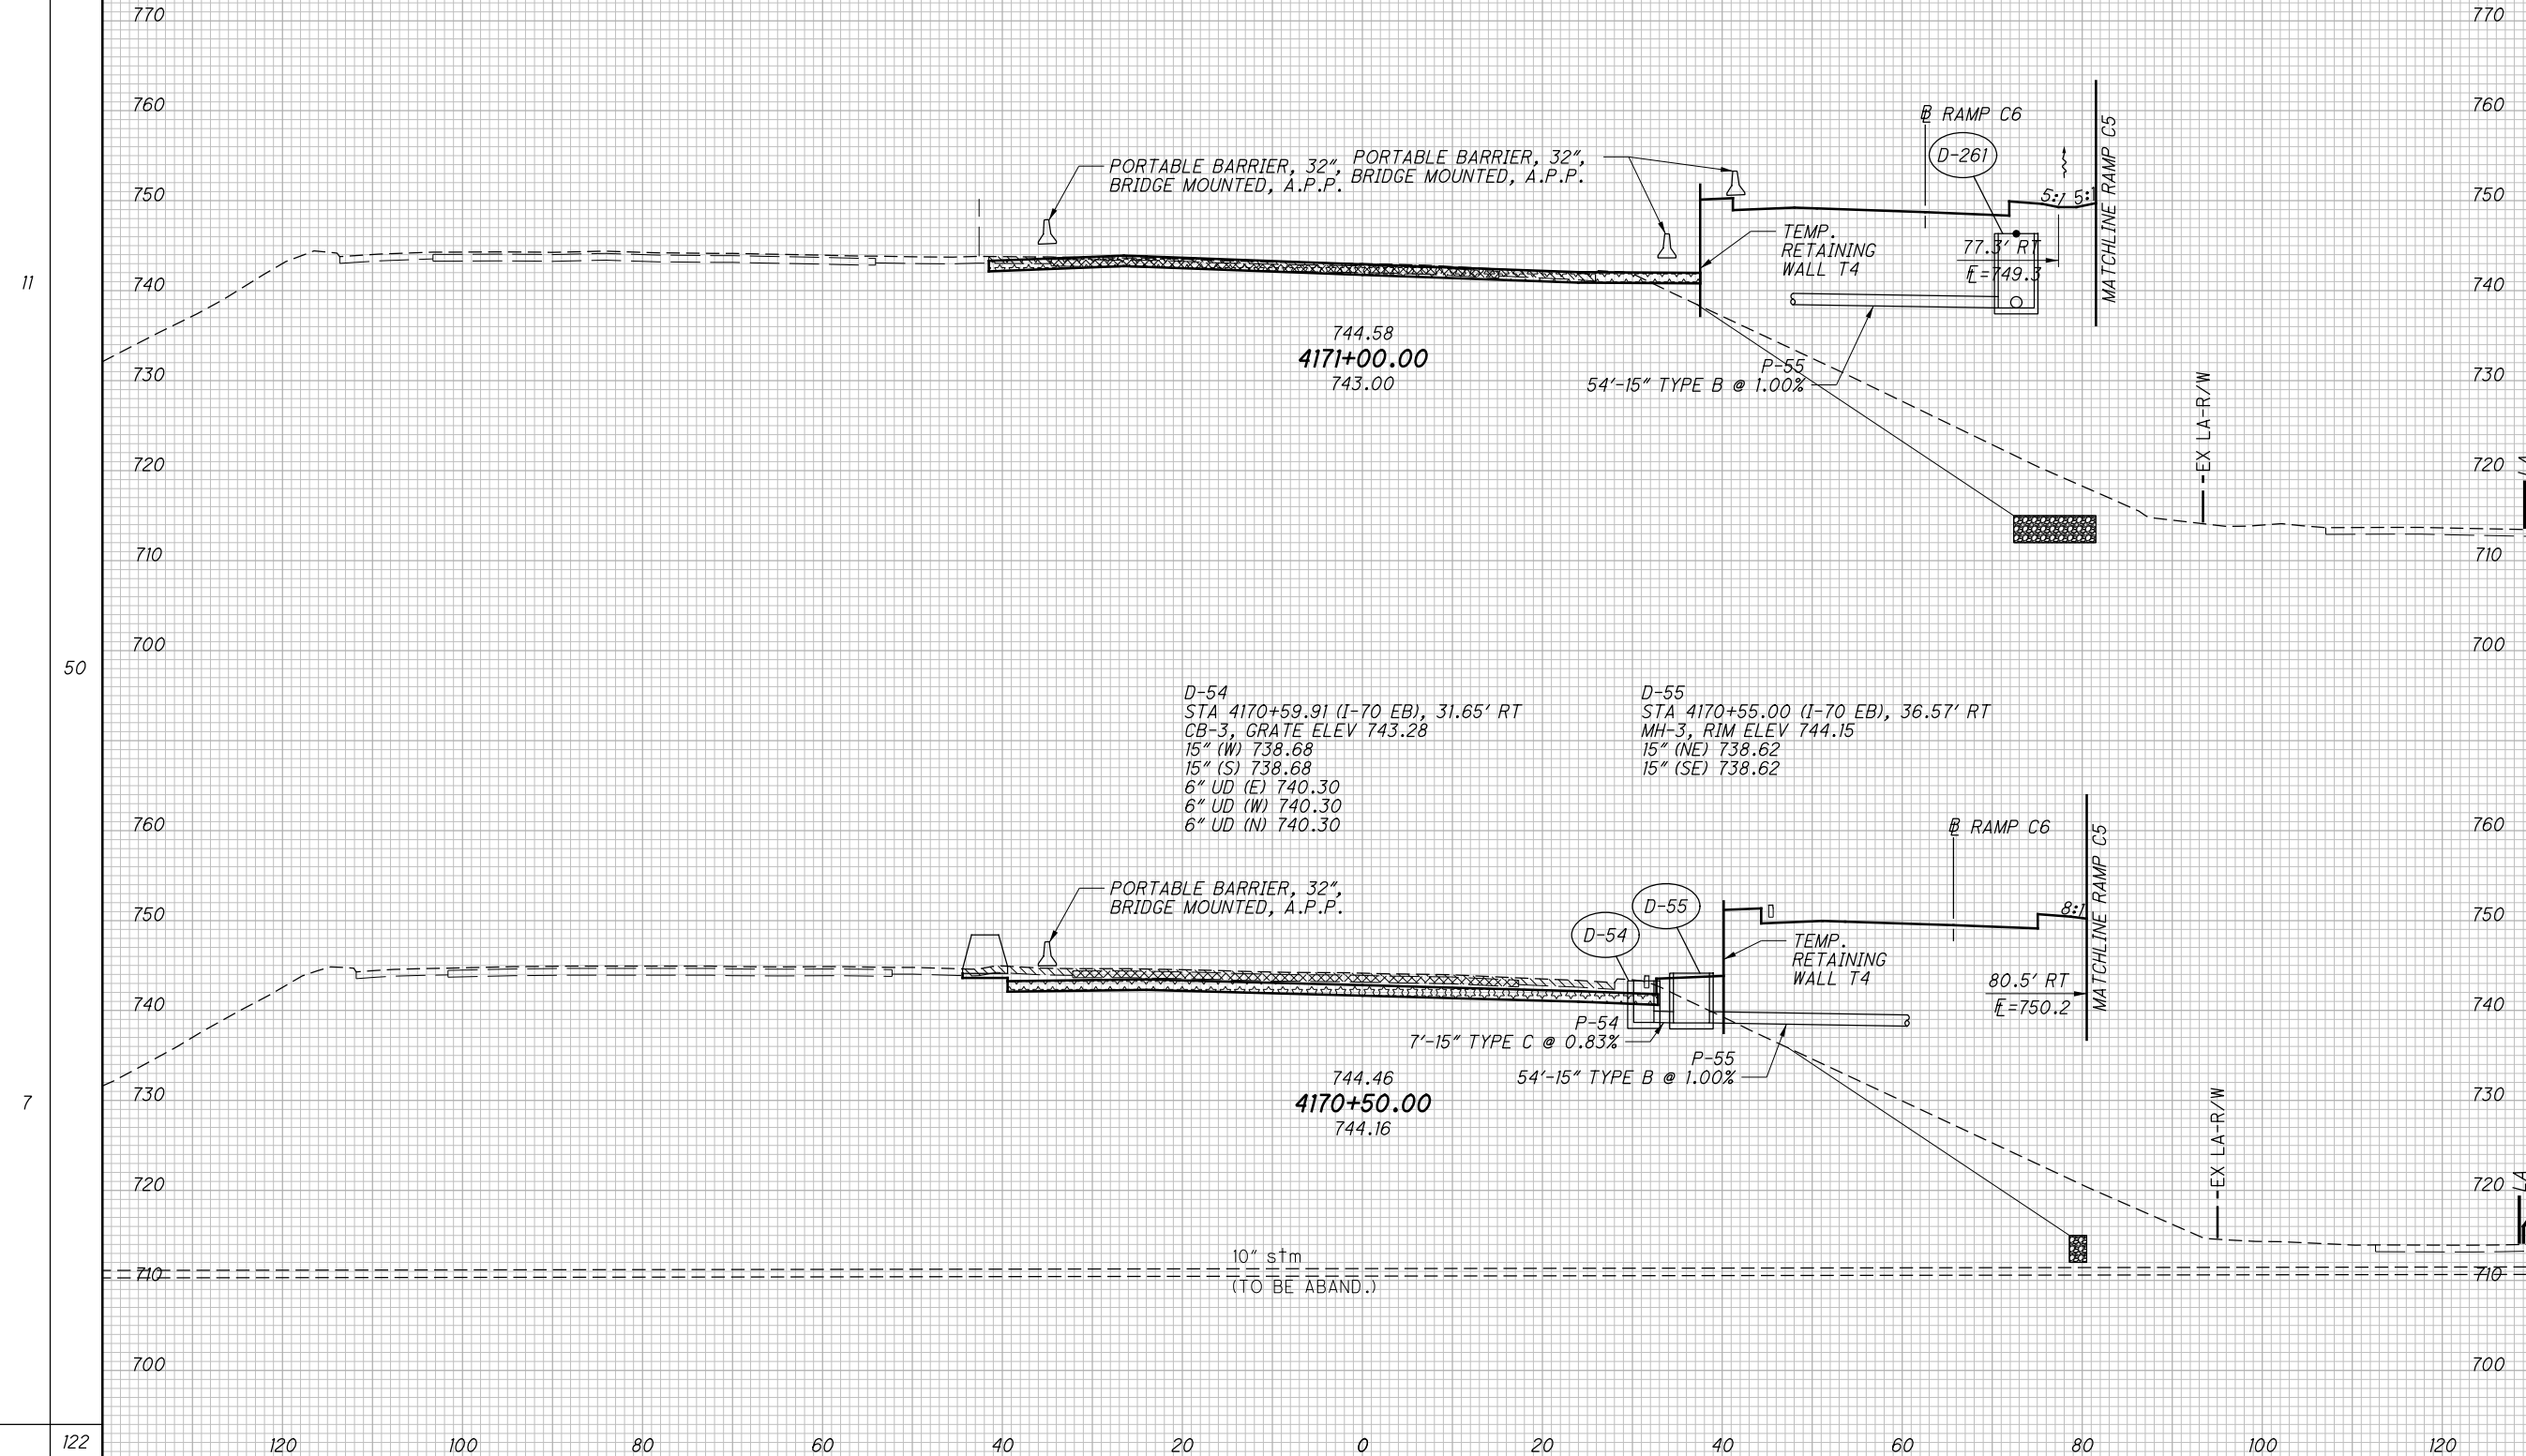

01-2812-2012048 VFR1105523 VROADWAY SHEETS\105523X5001.DGN
 11/24/2021 3:18:37 PM
 000TV81STD_LUSER

SEEDING
END WIDTH SO. YDS.

NO.	DESCRIPTION	REV. BY	DATE
4	EARTHWORK REVISED	ATR	11-29-2021

END AREA		VOLUME		CALCULATED ATR	CHECKED CWL
CUT	FILL	CUT	FILL		
		213	[3090]		


[#] ITEM 203 - GRANULAR EMBANKMENT

LOAD TRANSFER PLATFORM (INCLUDED WITH RETAINING WALL ITEM 203 - ROADWAY, MISC.: COLUMN SUPPORTED WALLS)

ITEM 206 - CEMENT STABILIZED SUBGRADE, 14 INCHES DEEP

ITEM 202 - PAVEMENT REMOVED

ITEM 202 - PAVEMENT REMOVED, ASPHALT

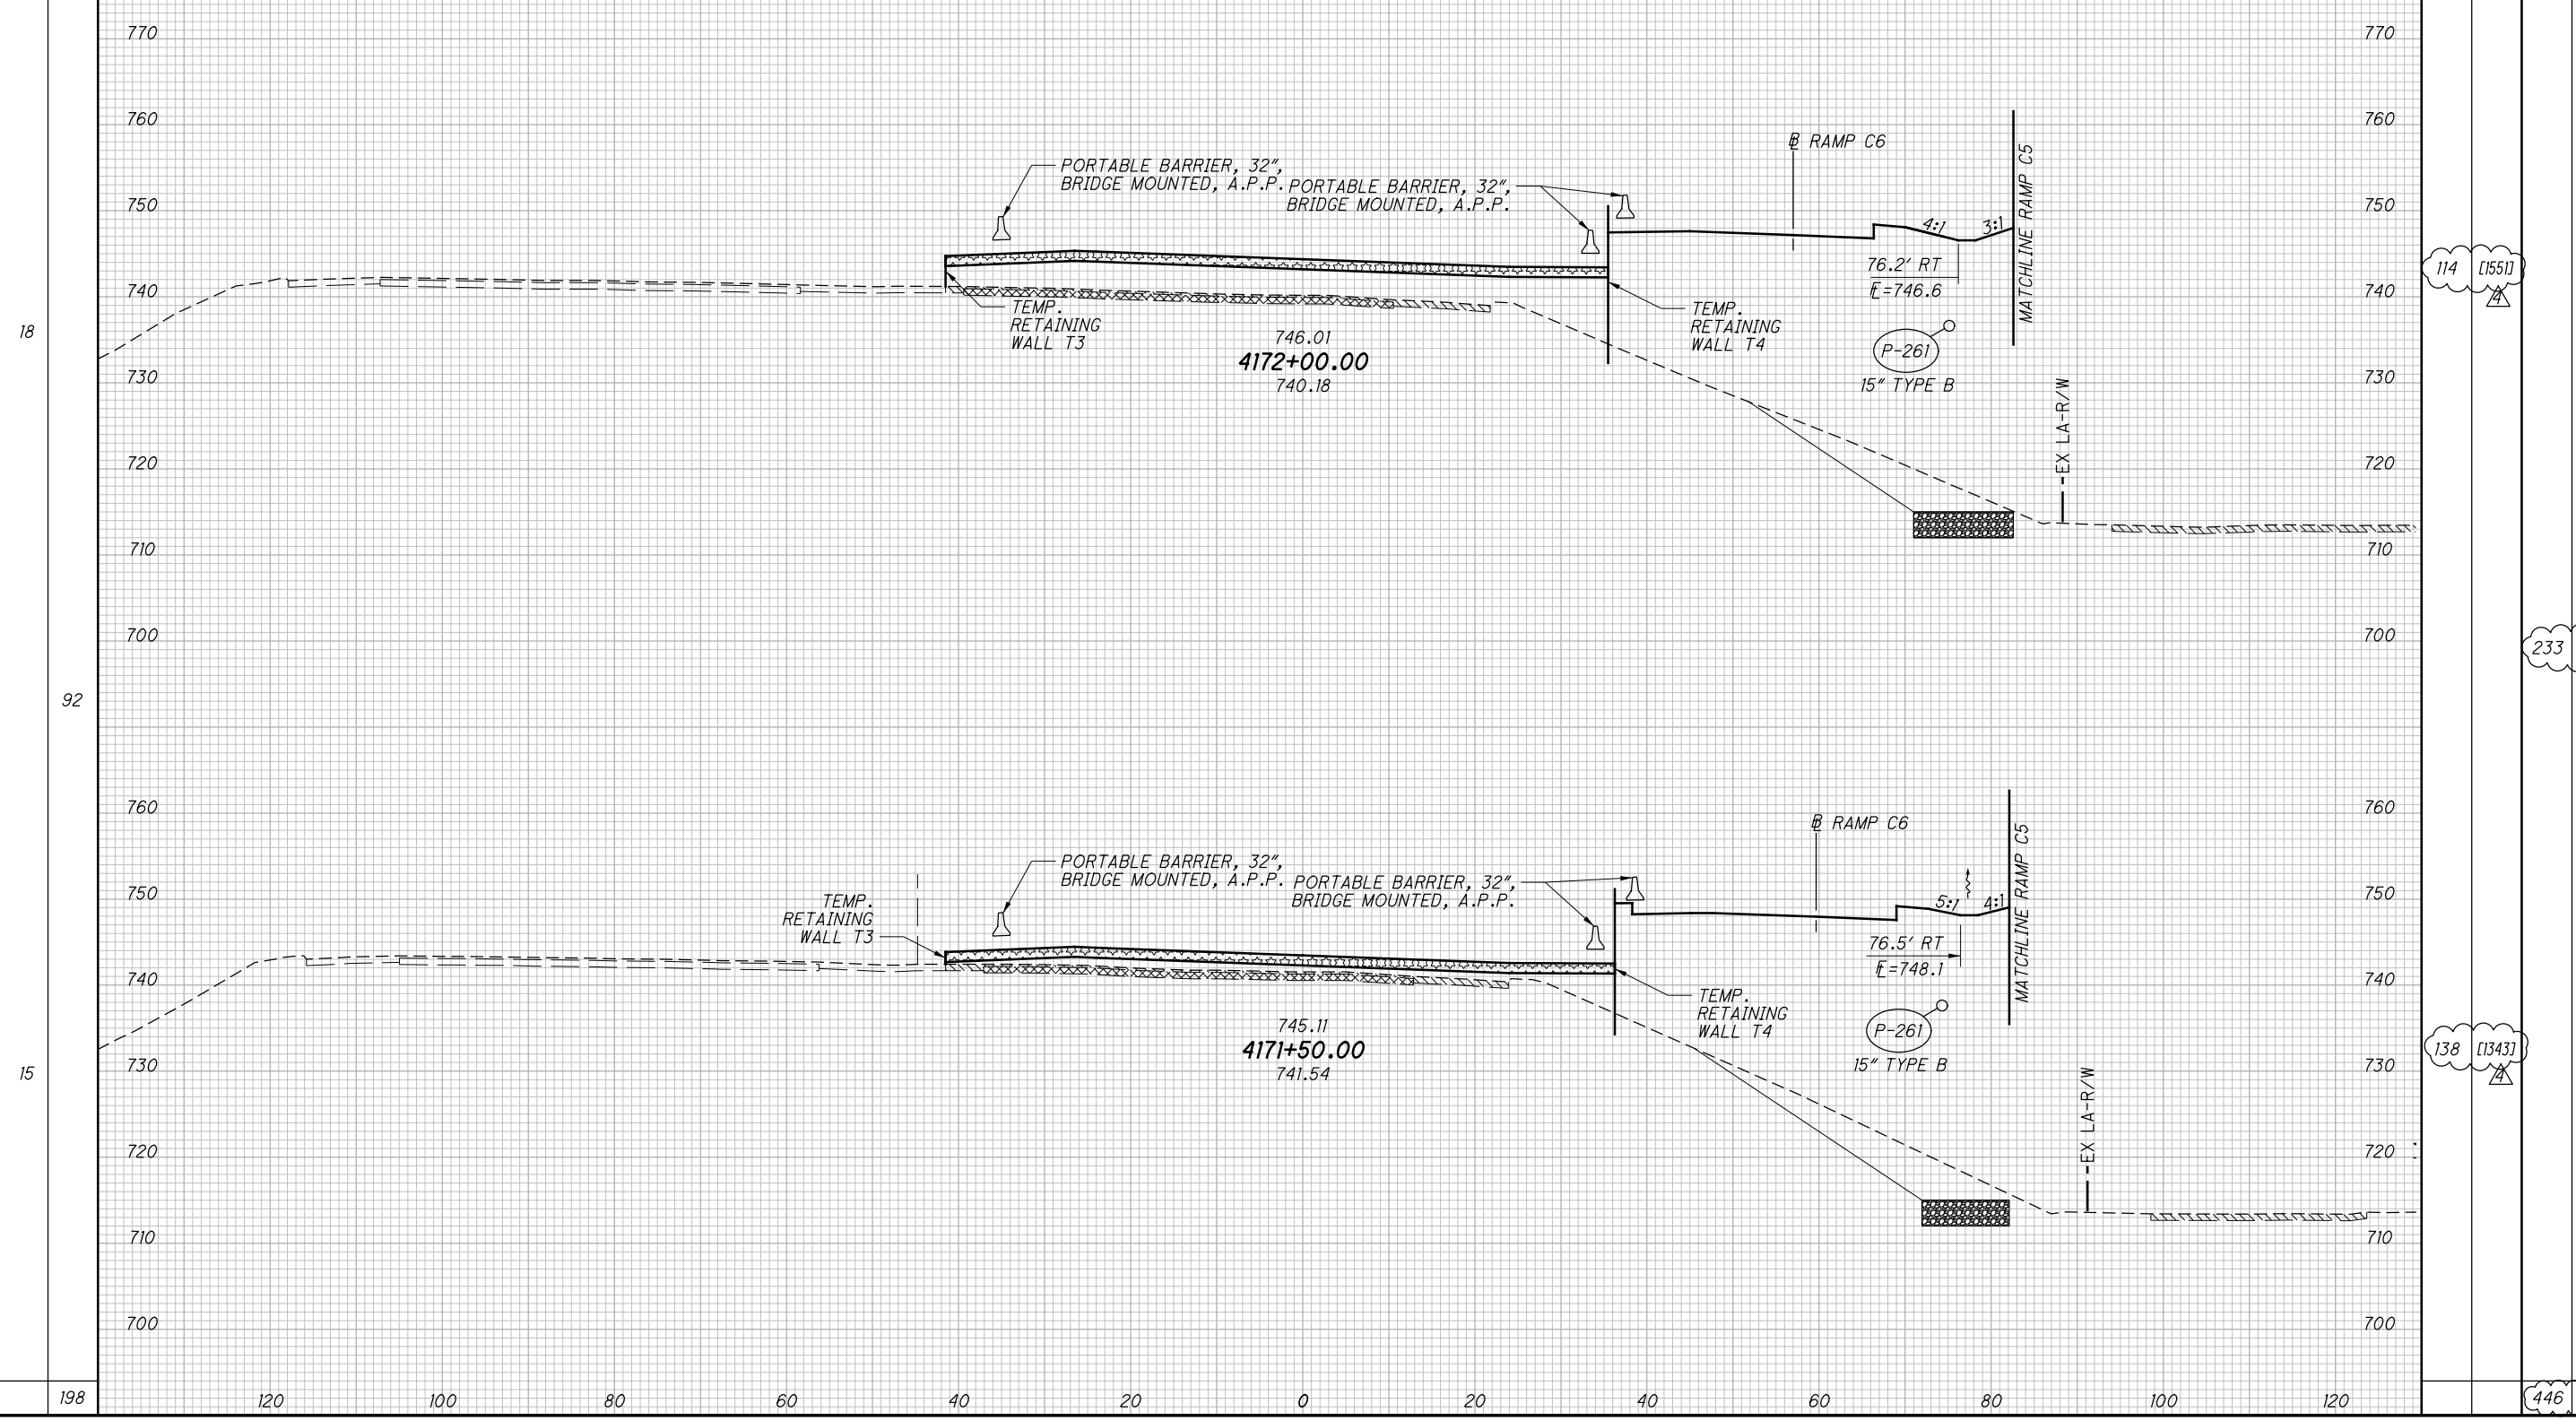

CROSS SECTIONS I-70 EASTBOUND
STA. 4171+50.00 TO STA. 4172+00.00

FRA -70/ 71-12.68 / 14.86

0:\2012\2012048\FRA\105523\ROADWAY\105523\SHEETS\105523X5001.DGN
 11/24/2021 3:19:32 PM
 000TV81STD.LUSER

18

92

15

198

446 [5770]

398
1815

SEEDING	
END WIDTH	SO. YDS.
122	

NO.	DESCRIPTION	REV. BY	DATE
4	EARTHWORK REVISED	ATR	11-29-2021

[#] ITEM 203 - GRANULAR EMBANKMENT


LOAD TRANSFER PLATFORM (INCLUDED WITH RETAINING WALL ITEM 203 - ROADWAY, MISC.: COLUMN SUPPORTED WALLS)

ITEM 202 - PAVEMENT REMOVED

ITEM 202 - PAVEMENT REMOVED, ASPHALT

END AREA		VOLUME		CALCULATED ATR	CHECKED CWL
CUT	FILL	CUT	FILL		
		231	[3921]		

22	117	20	239
----	-----	----	-----

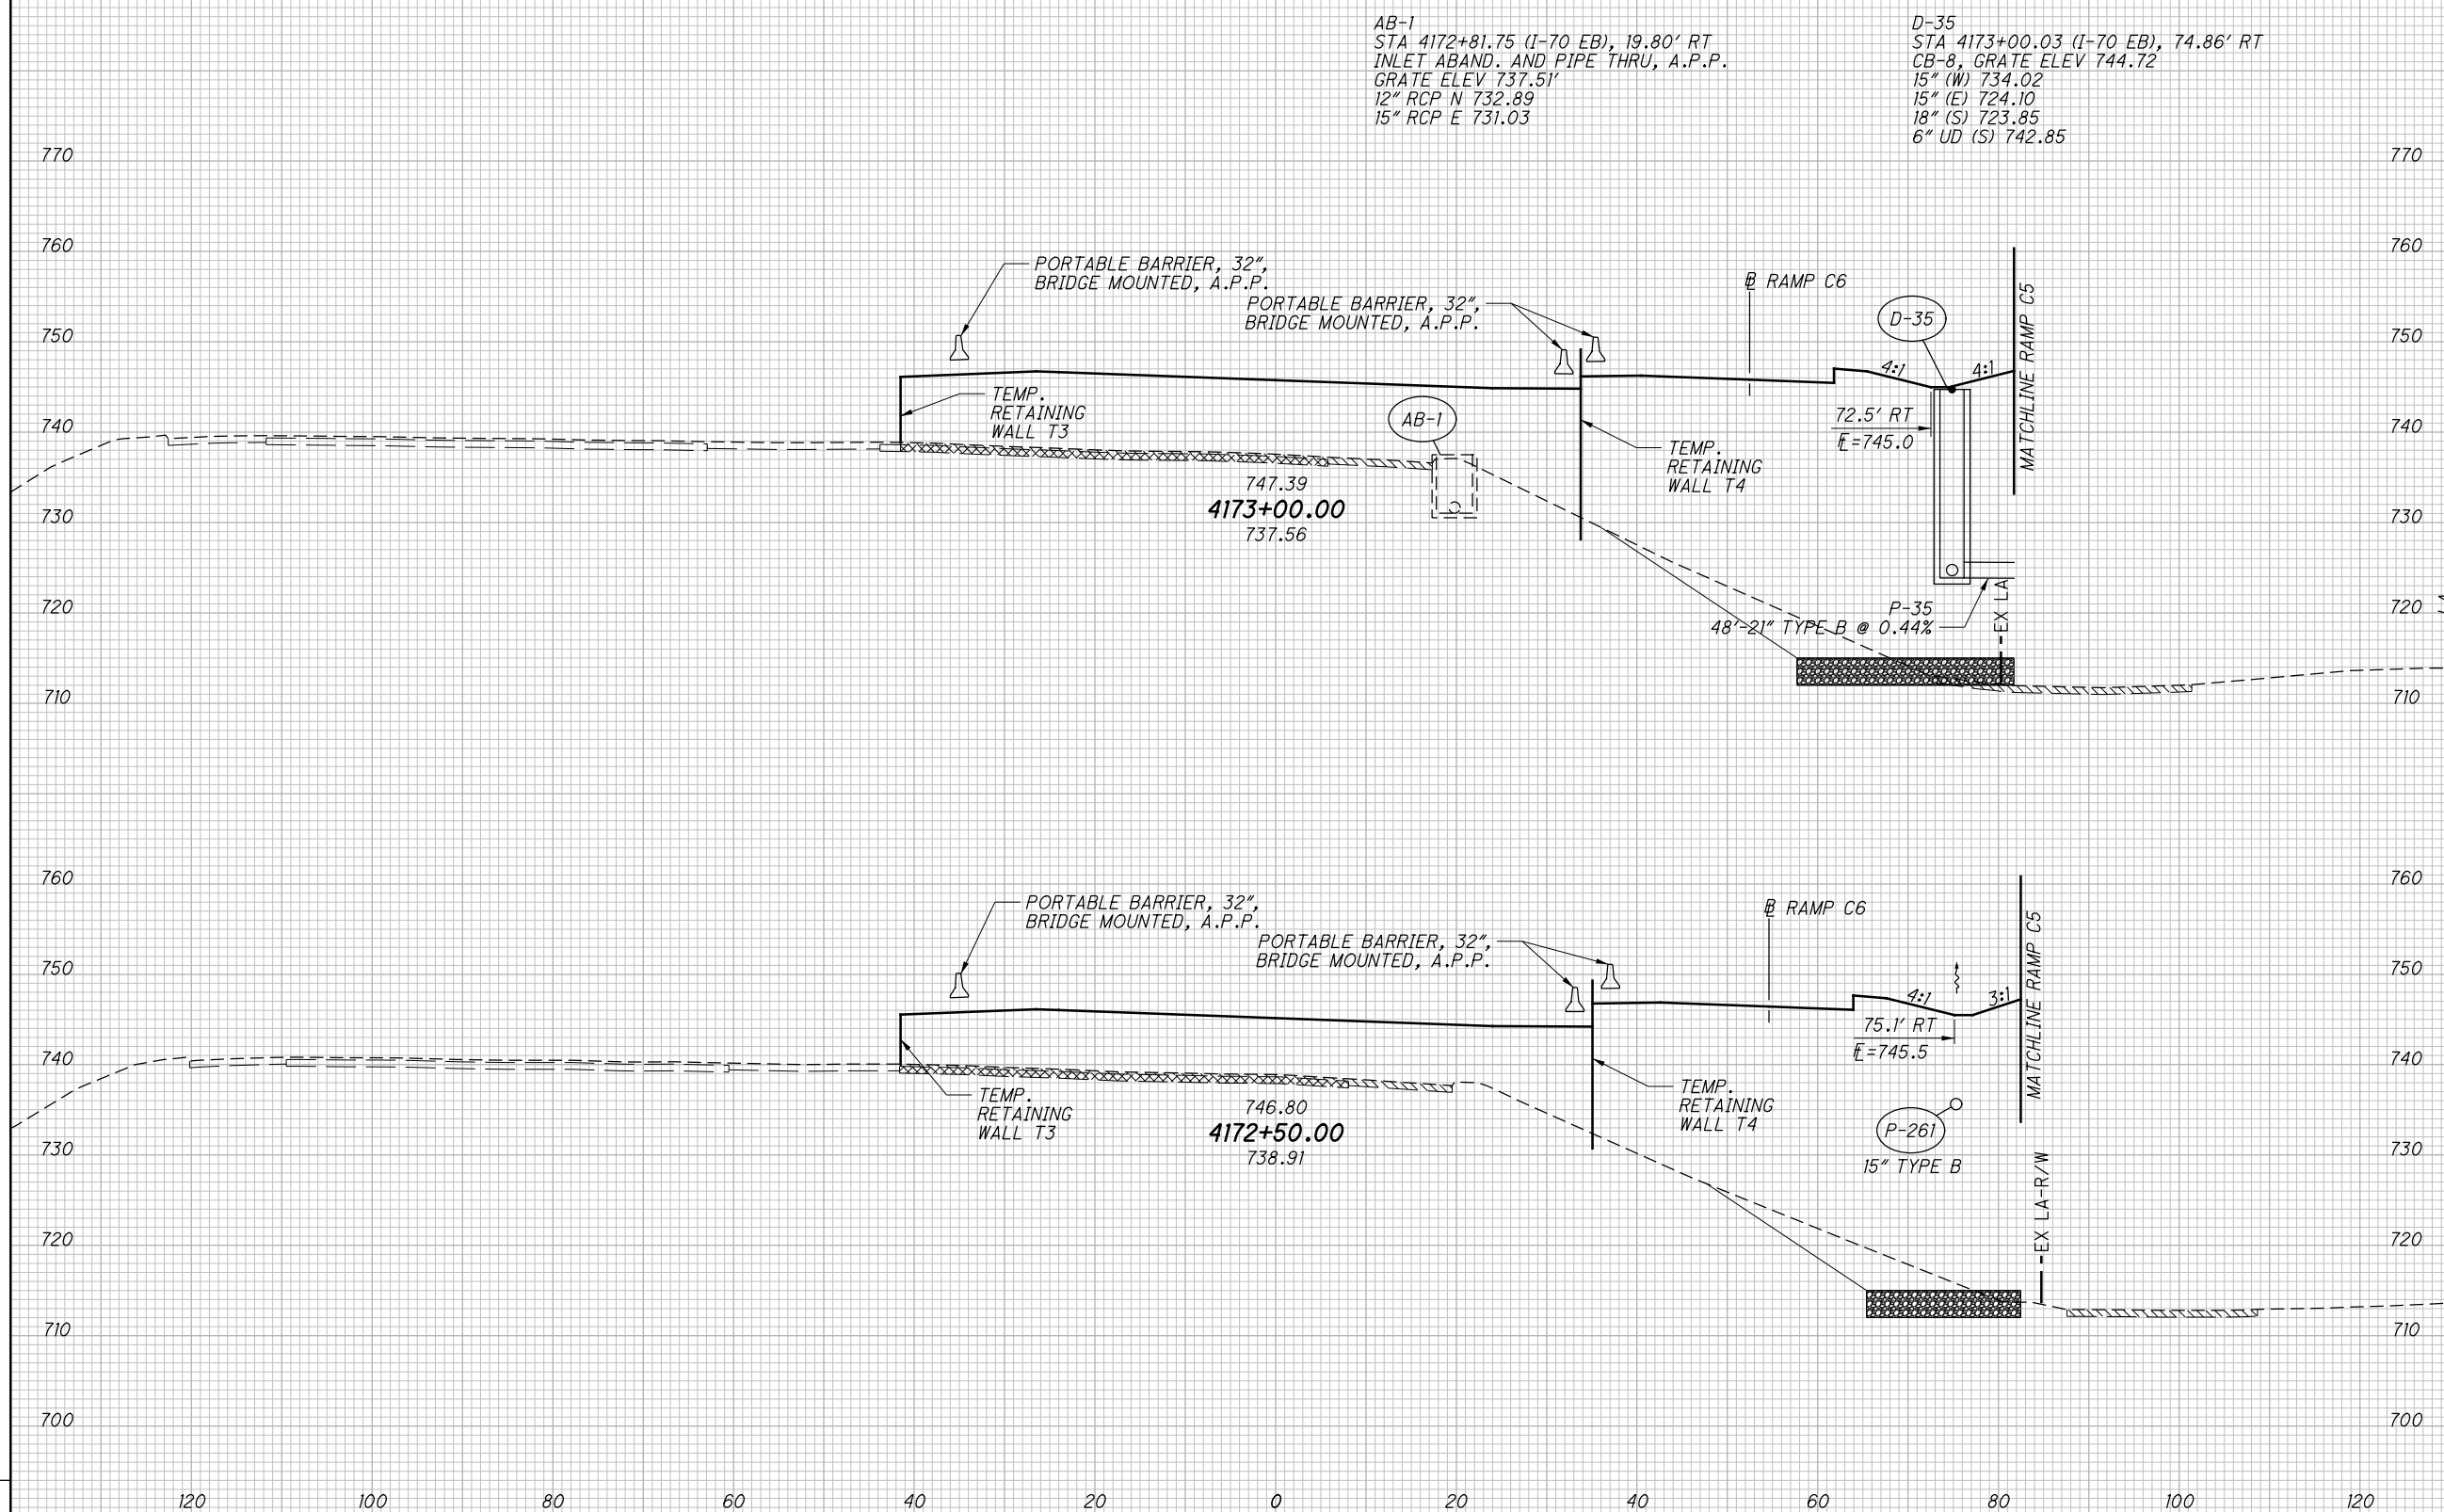

AB-1
STA 4172+81.75 (I-70 EB), 19.80' RT
INLET ABAND. AND PIPE THRU, A.P.P.
GRATE ELEV 737.51'
12" RCP N 732.89
15" RCP E 731.03

D-35
STA 4173+00.03 (I-70 EB), 74.86' RT
CB-8, GRATE ELEV 744.72'
15" (W) 734.02
15" (E) 724.10
18" (S) 723.85
6" UD (S) 742.85

CROSS SECTIONS I-70 EASTBOUND
STA. 4172+50.00 TO STA. 4173+00.00

FRA -70/ 71-12.68 / 14.86

399	1815
-----	------

D:\2012\2012048\FRA\105523\ROADWAY\SHETS\105523X5001.DGN
 11/24/2021 3:20:18 PM
 D:\1\81 STD.LUSER

SEEDING		NO.	DESCRIPTION	REV. BY	DATE
END WIDTH	SO. YDS.				
108		4	EARTHWORK REVISED	ATR	11-29-2021

[#] ITEM 203 - GRANULAR EMBANKMENT

LOAD TRANSFER PLATFORM (INCLUDED WITH RETAINING WALL ITEM 203 - ROADWAY, MISC.: COLUMN SUPPORTED WALLS)

ITEM 202 - PAVEMENT REMOVED


ITEM 202 - PAVEMENT REMOVED, ASPHALT

END AREA		VOLUME		CALCULATED	CHECKED
CUT	FILL	CUT	FILL		
		110	[4422]		

CROSS SECTIONS I-70 EASTBOUND
STA. 4173+50.00 TO STA. 4174+00.00

FRA -70/ 71-12.68 / 14.86


400
1815

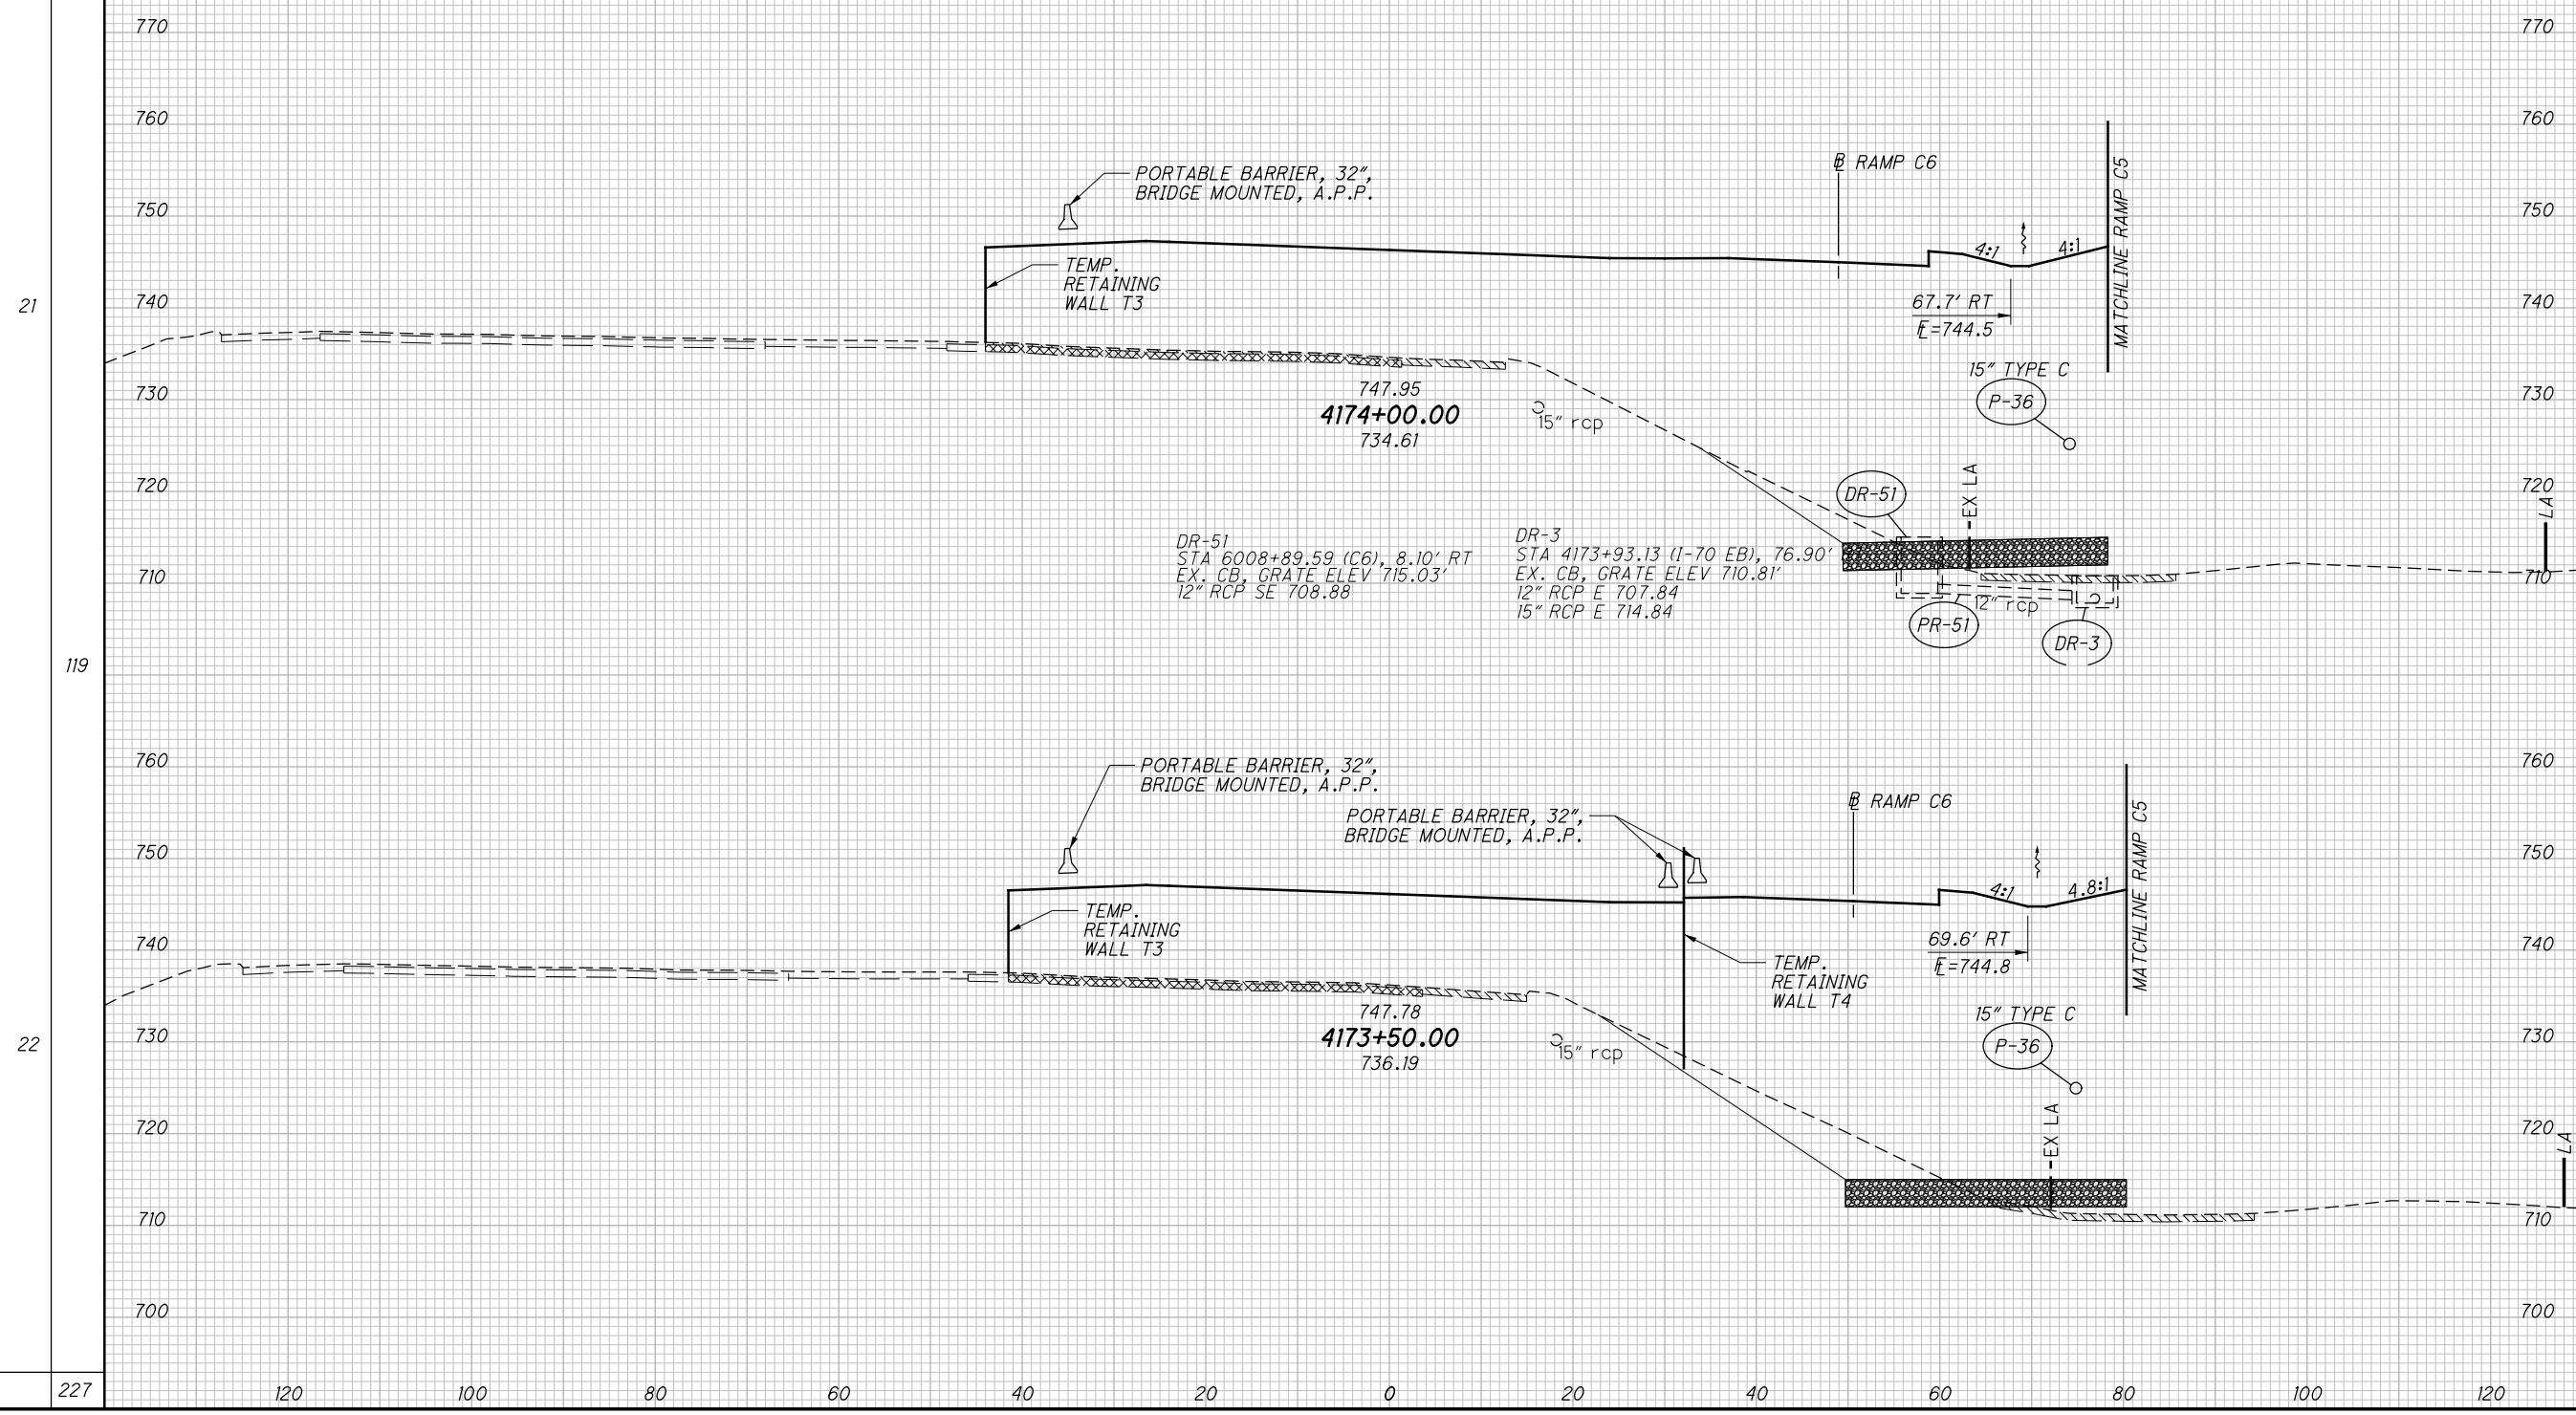

01-2812-2012048 VFR1\05523\ROADWAY\185523X5001.DGN
 11/24/2021 3:21:29 PM
 0001V81STD.LUSER

SEEDING		NO.	DESCRIPTION	REV. BY	DATE
END WIDTH	SO. YDS.				
89		4	EARTHWORK REVISED	ATR	11-29-2021

END AREA		VOLUME		CALCULATED	ATR	CHECKED	CWL
CUT	FILL	CUT	FILL				

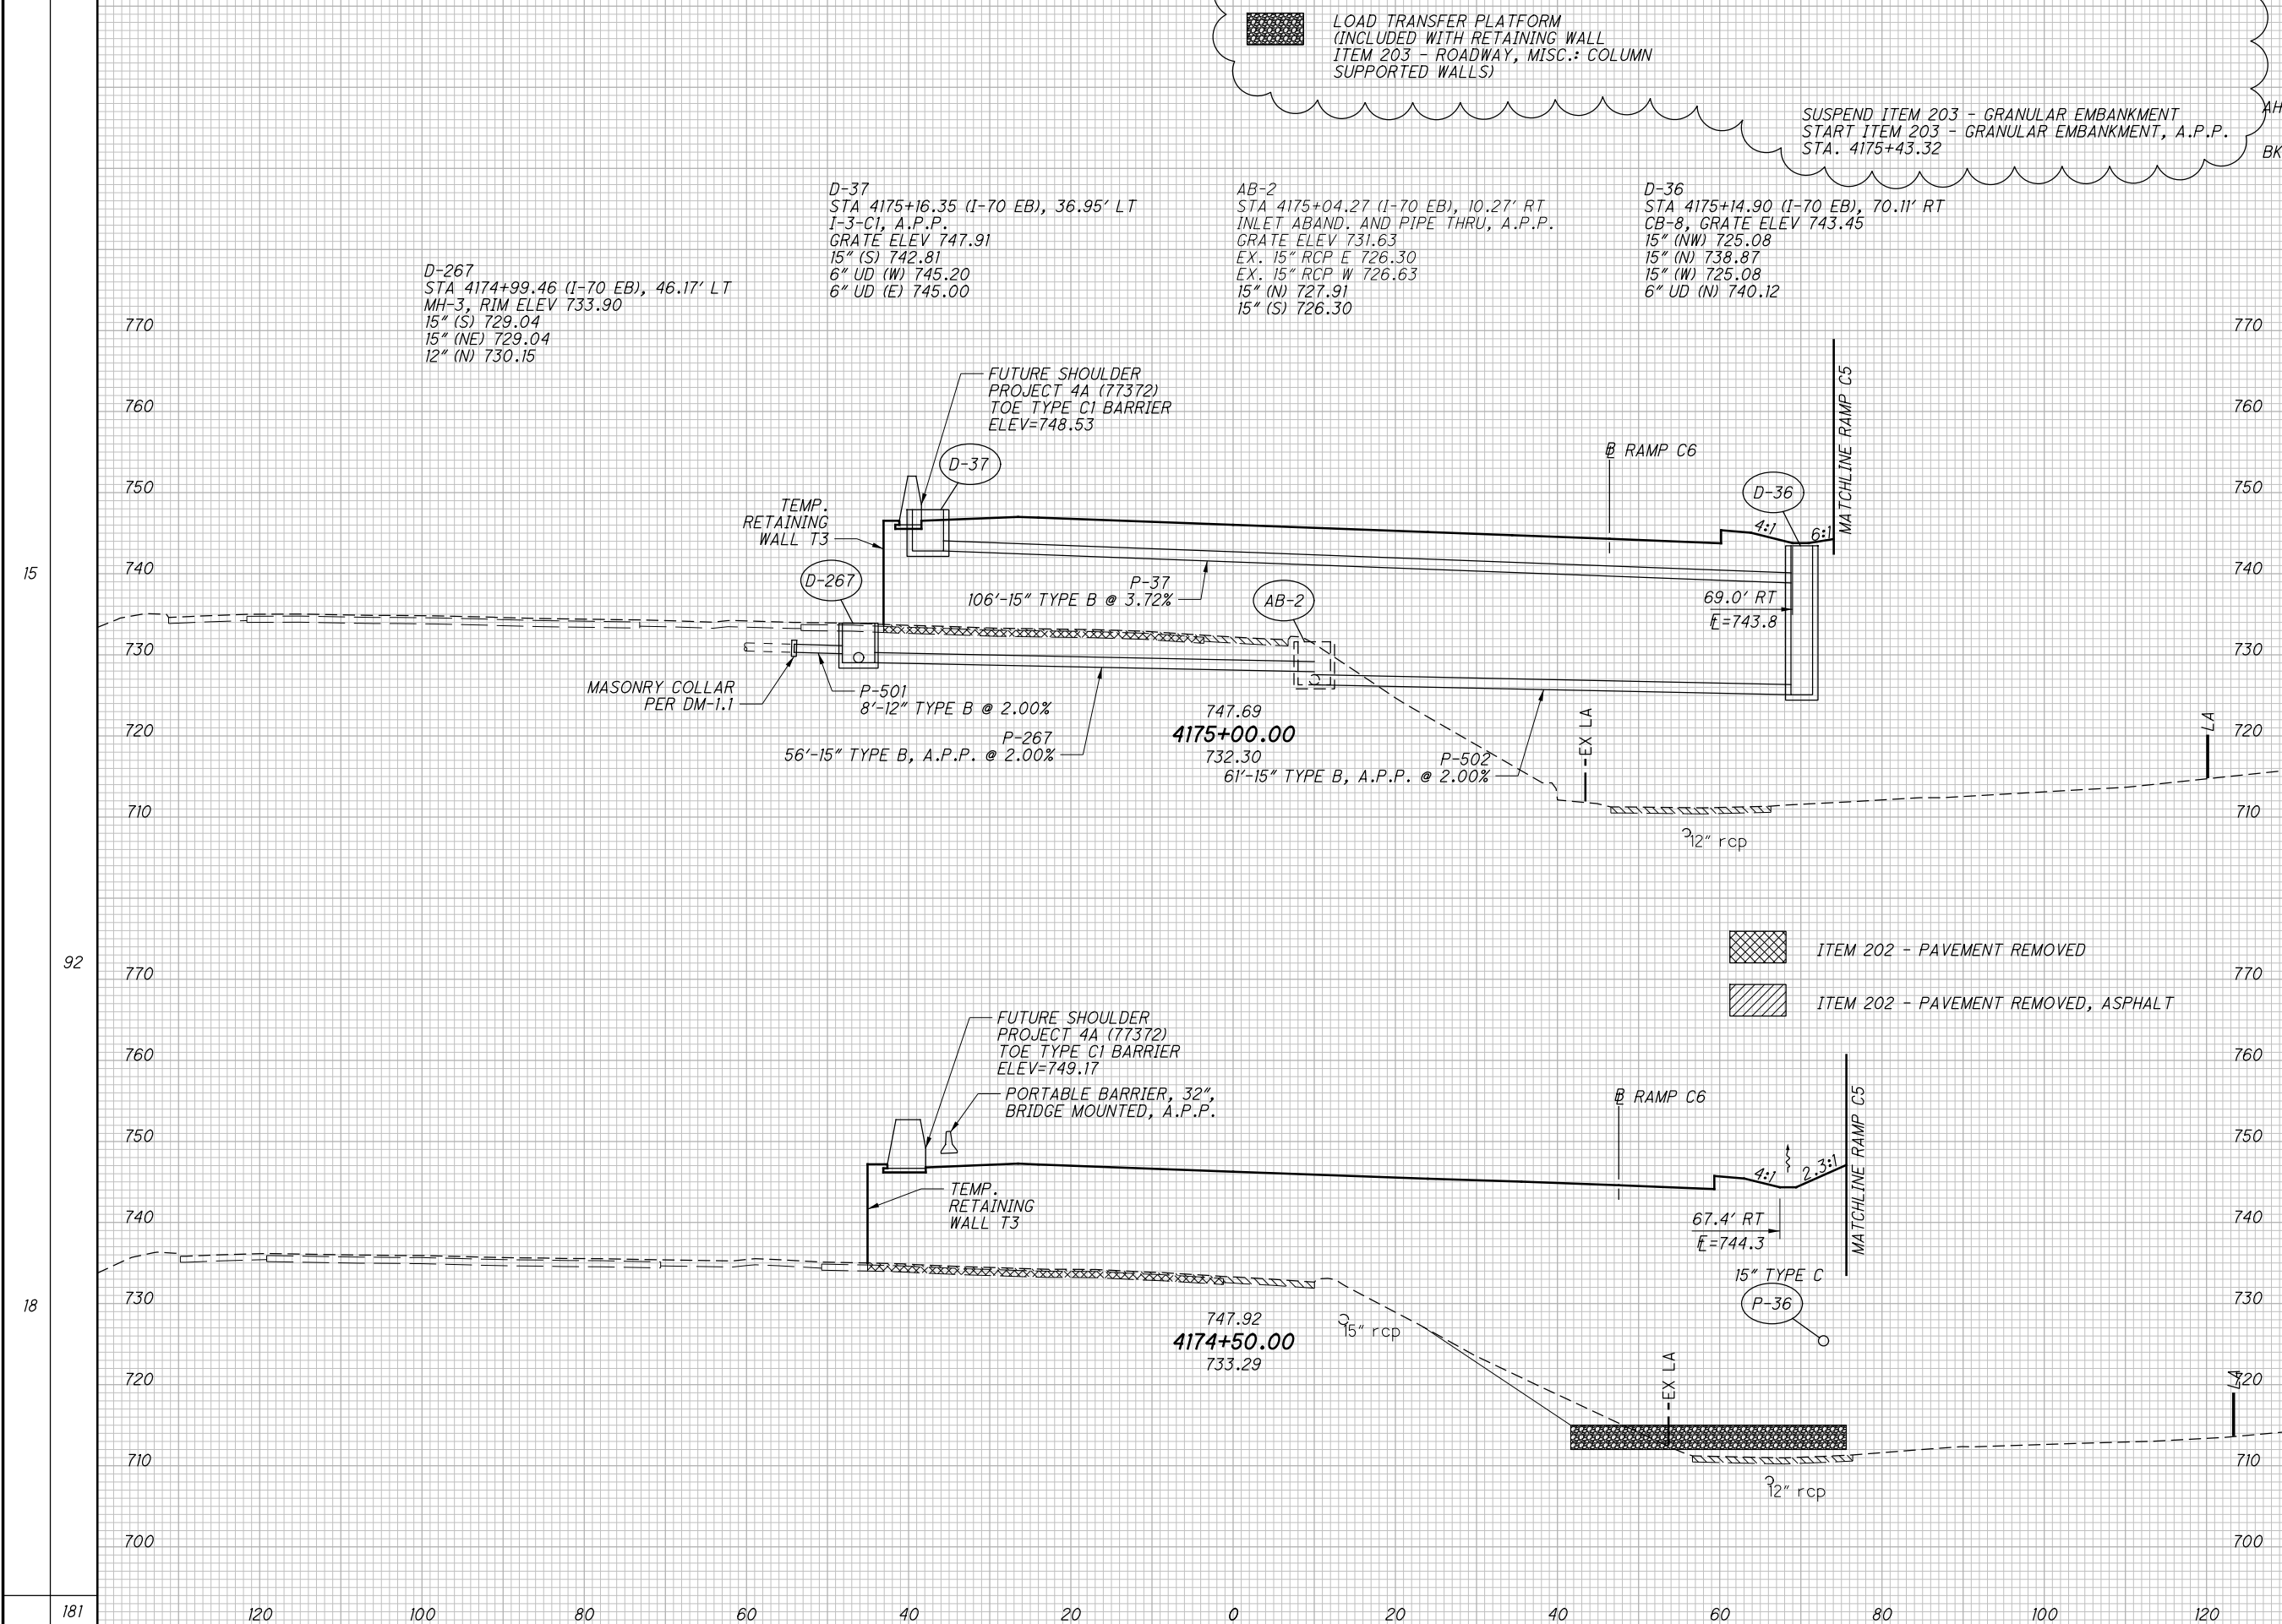

[#] ITEM 203 - GRANULAR EMBANKMENT
 "# ITEM 203 - GRANULAR EMBANKMENT, AS PER PLAN

LOAD TRANSFER PLATFORM
 (INCLUDED WITH RETAINING WALL
 ITEM 203 - ROADWAY, MISC.: COLUMN
 SUPPORTED WALLS)

SUSPEND ITEM 203 - GRANULAR EMBANKMENT
 START ITEM 203 - GRANULAR EMBANKMENT, A.P.P.
 STA. 4175+43.32

CROSS SECTIONS I-70 EASTBOUND
 STA. 4174+50.00 TO STA. 4175+00.00

ITEM 202 - PAVEMENT REMOVED
 ITEM 202 - PAVEMENT REMOVED, ASPHALT

01:2812:2012048\FRA\105523\ROADWAY\105523\105523\S001.DGN
 11/24/2021 4:31:28 PM
 0001\81STD_USER

FRA - 70/ 71-12.68 / 14.86

58	[2436]	401	1815
----	--------	-----	------

SEEDING	SO. YDS.
END WIDTH	120

NO.	DESCRIPTION	REV. BY	DATE
4	EARTHWORK REVISED	ATR	11-29-2021

END AREA	VOLUME	CALCULATED	CHECKED
CUT	CUT	A TR	CWL
FILL	FILL		


120

0 9

32

10

32

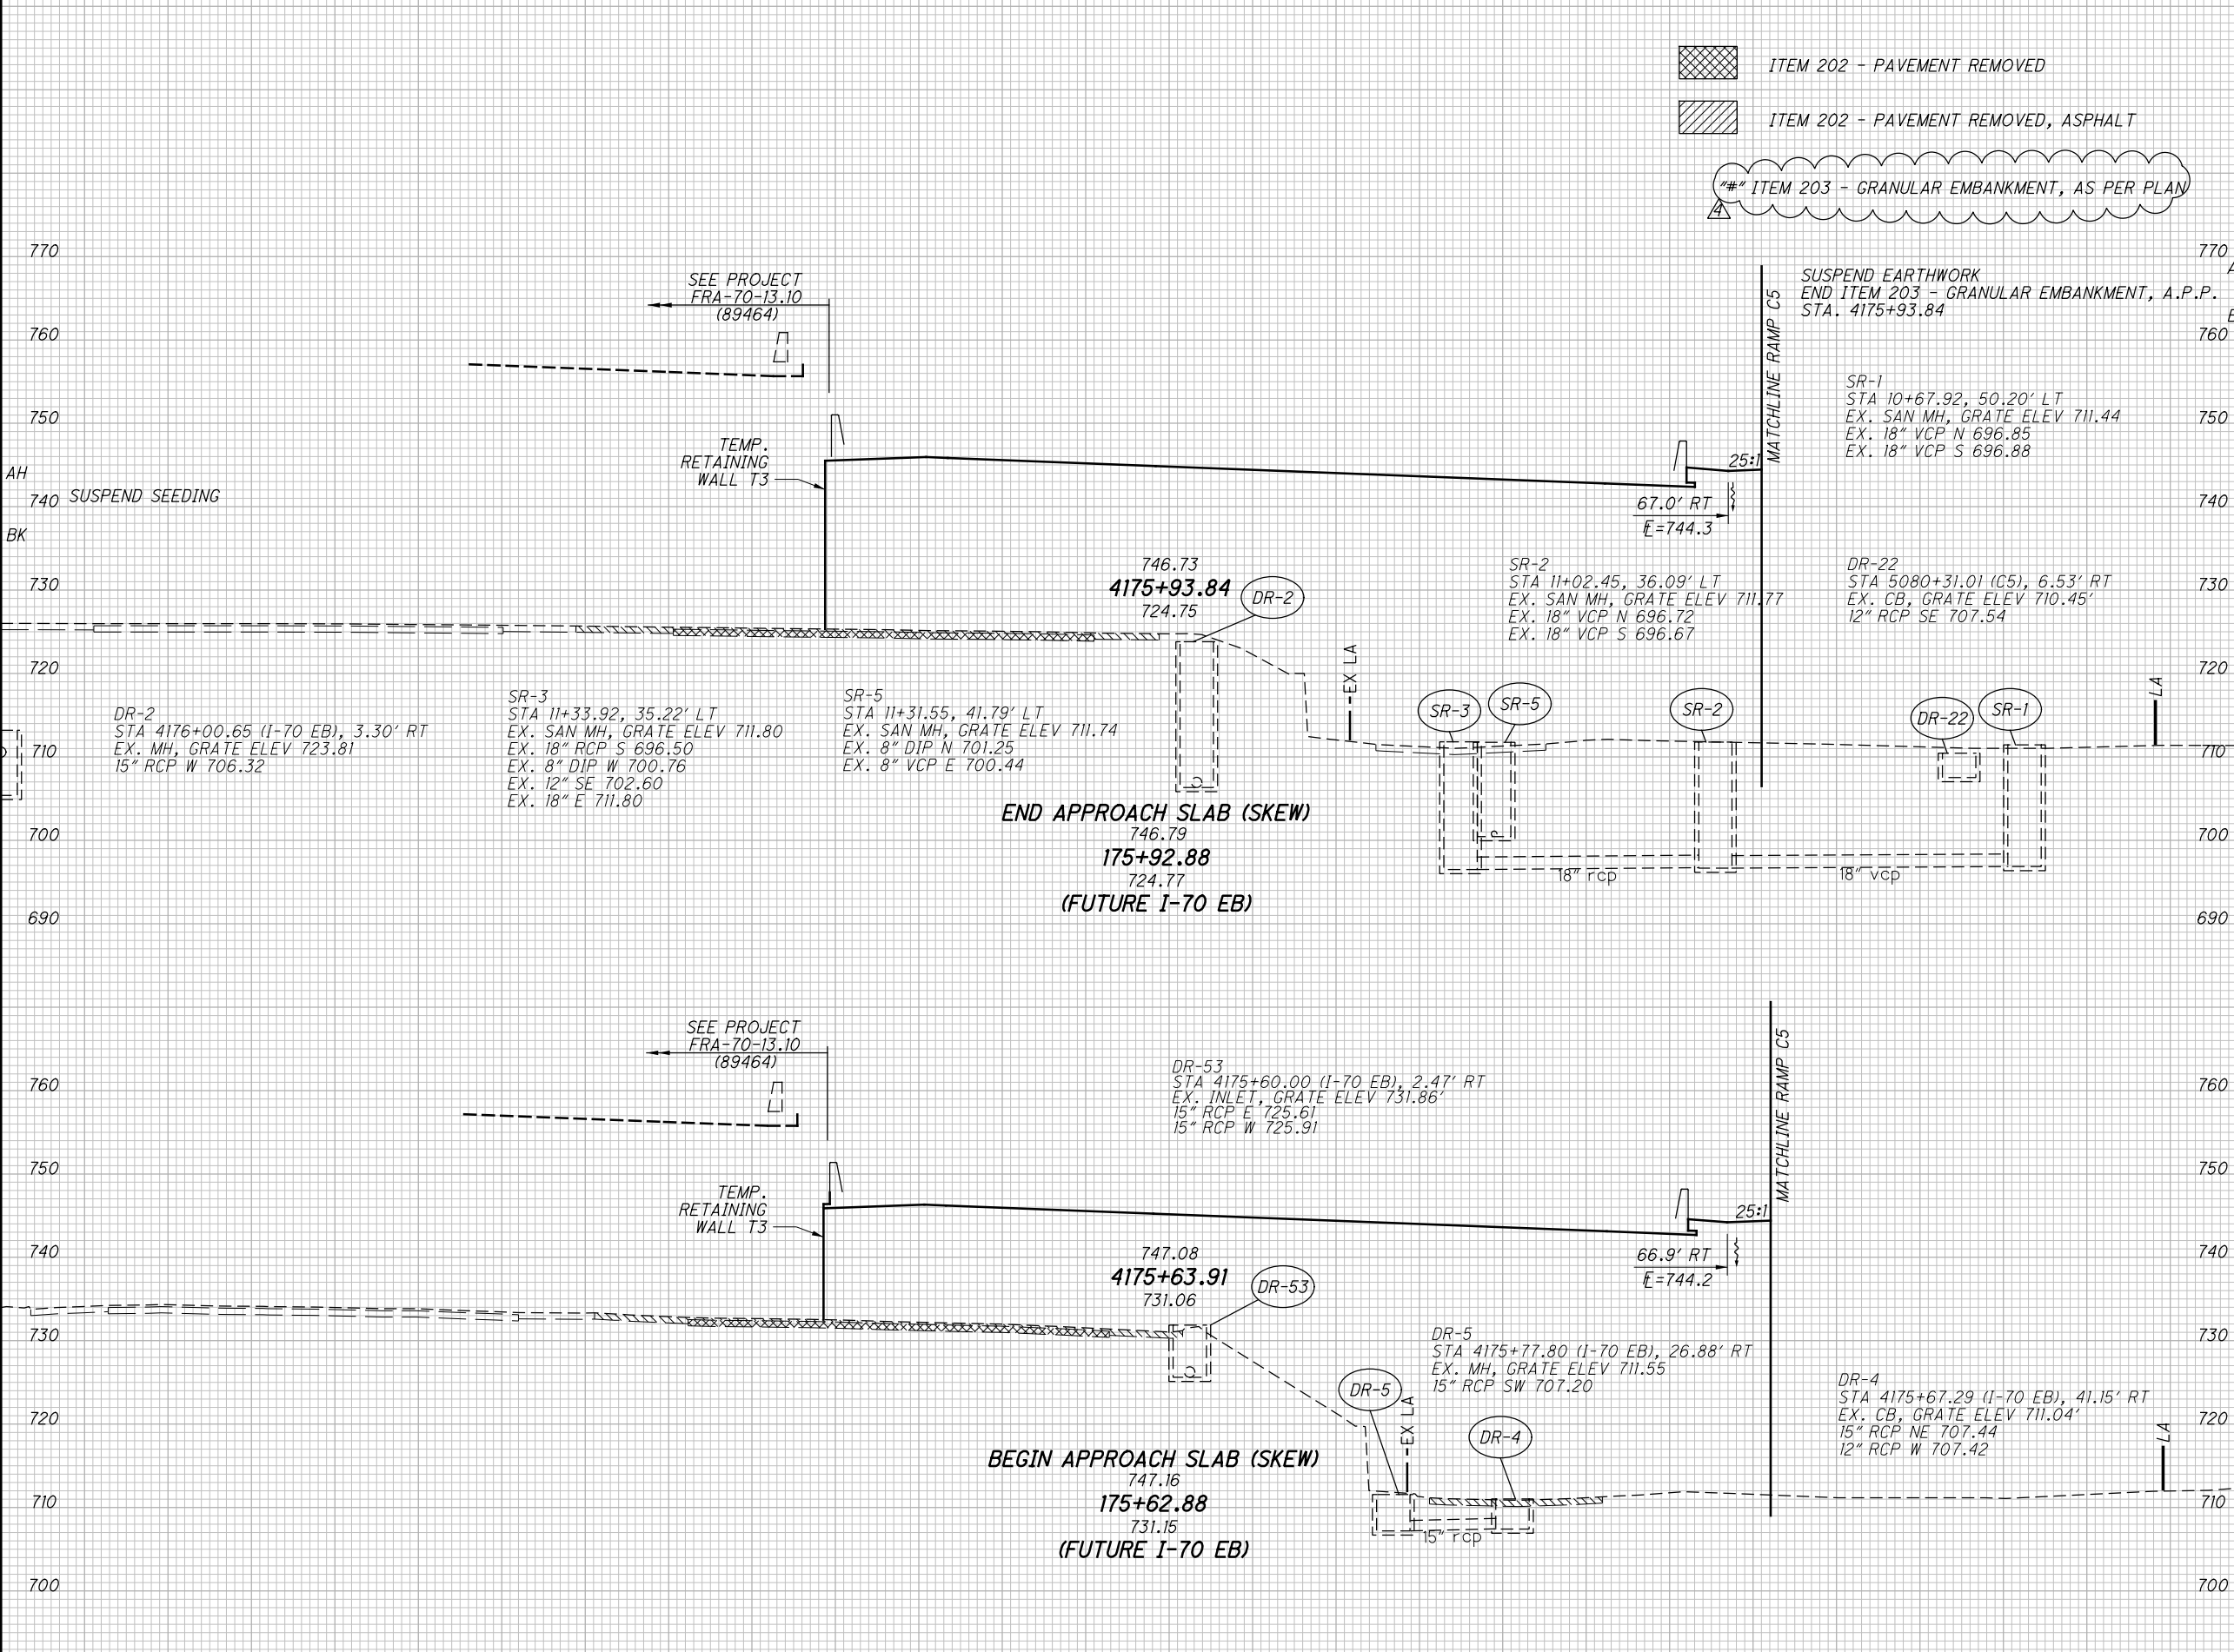

ITEM 202 - PAVEMENT REMOVED

ITEM 202 - PAVEMENT REMOVED, ASPHALT

ITEM 203 - GRANULAR EMBANKMENT, AS PER PLAN

0	770	0	0	0	0
0	760	0	0	0	0
0	750	0	0	0	0
0	740	0	0	0	0
0	730	0	0	0	0
0	720	0	0	0	0
0	710	0	0	0	0
0	700	0	0	0	0
0	690	0	0	0	0
0	760	0	0	0	0
0	750	0	0	0	0
0	740	0	0	0	0
0	730	0	0	0	0
0	720	0	0	0	0
0	710	0	0	0	0
0	700	0	0	0	0
0	700	0	0	0	0
0	700	0	0	0	0
0	700	0	0	0	0

0: \\2812-28012848\FRA\105523\ROADWAY\105523\SHEETS\105523\5001.DGN

11/24/2021

4:35:05 PM

000TV81STD.LUSER

CROSS SECTIONS I-70 EASTBOUND
STA. 4175+63.96 TO STA. 4175+93.88

FRA-70/71-12.68/14.86


402
1815

SEEDING
END WIDTH
SO. YDS.

NO.	DESCRIPTION	REV. BY	DATE
4	GRADING LINE	CWL	11-29-2021

END AREA		VOLUME		CALCULATED	TMT	CHECKED	CWL
CUT	FILL	CUT	FILL				

139
23
106
15
153
40
398

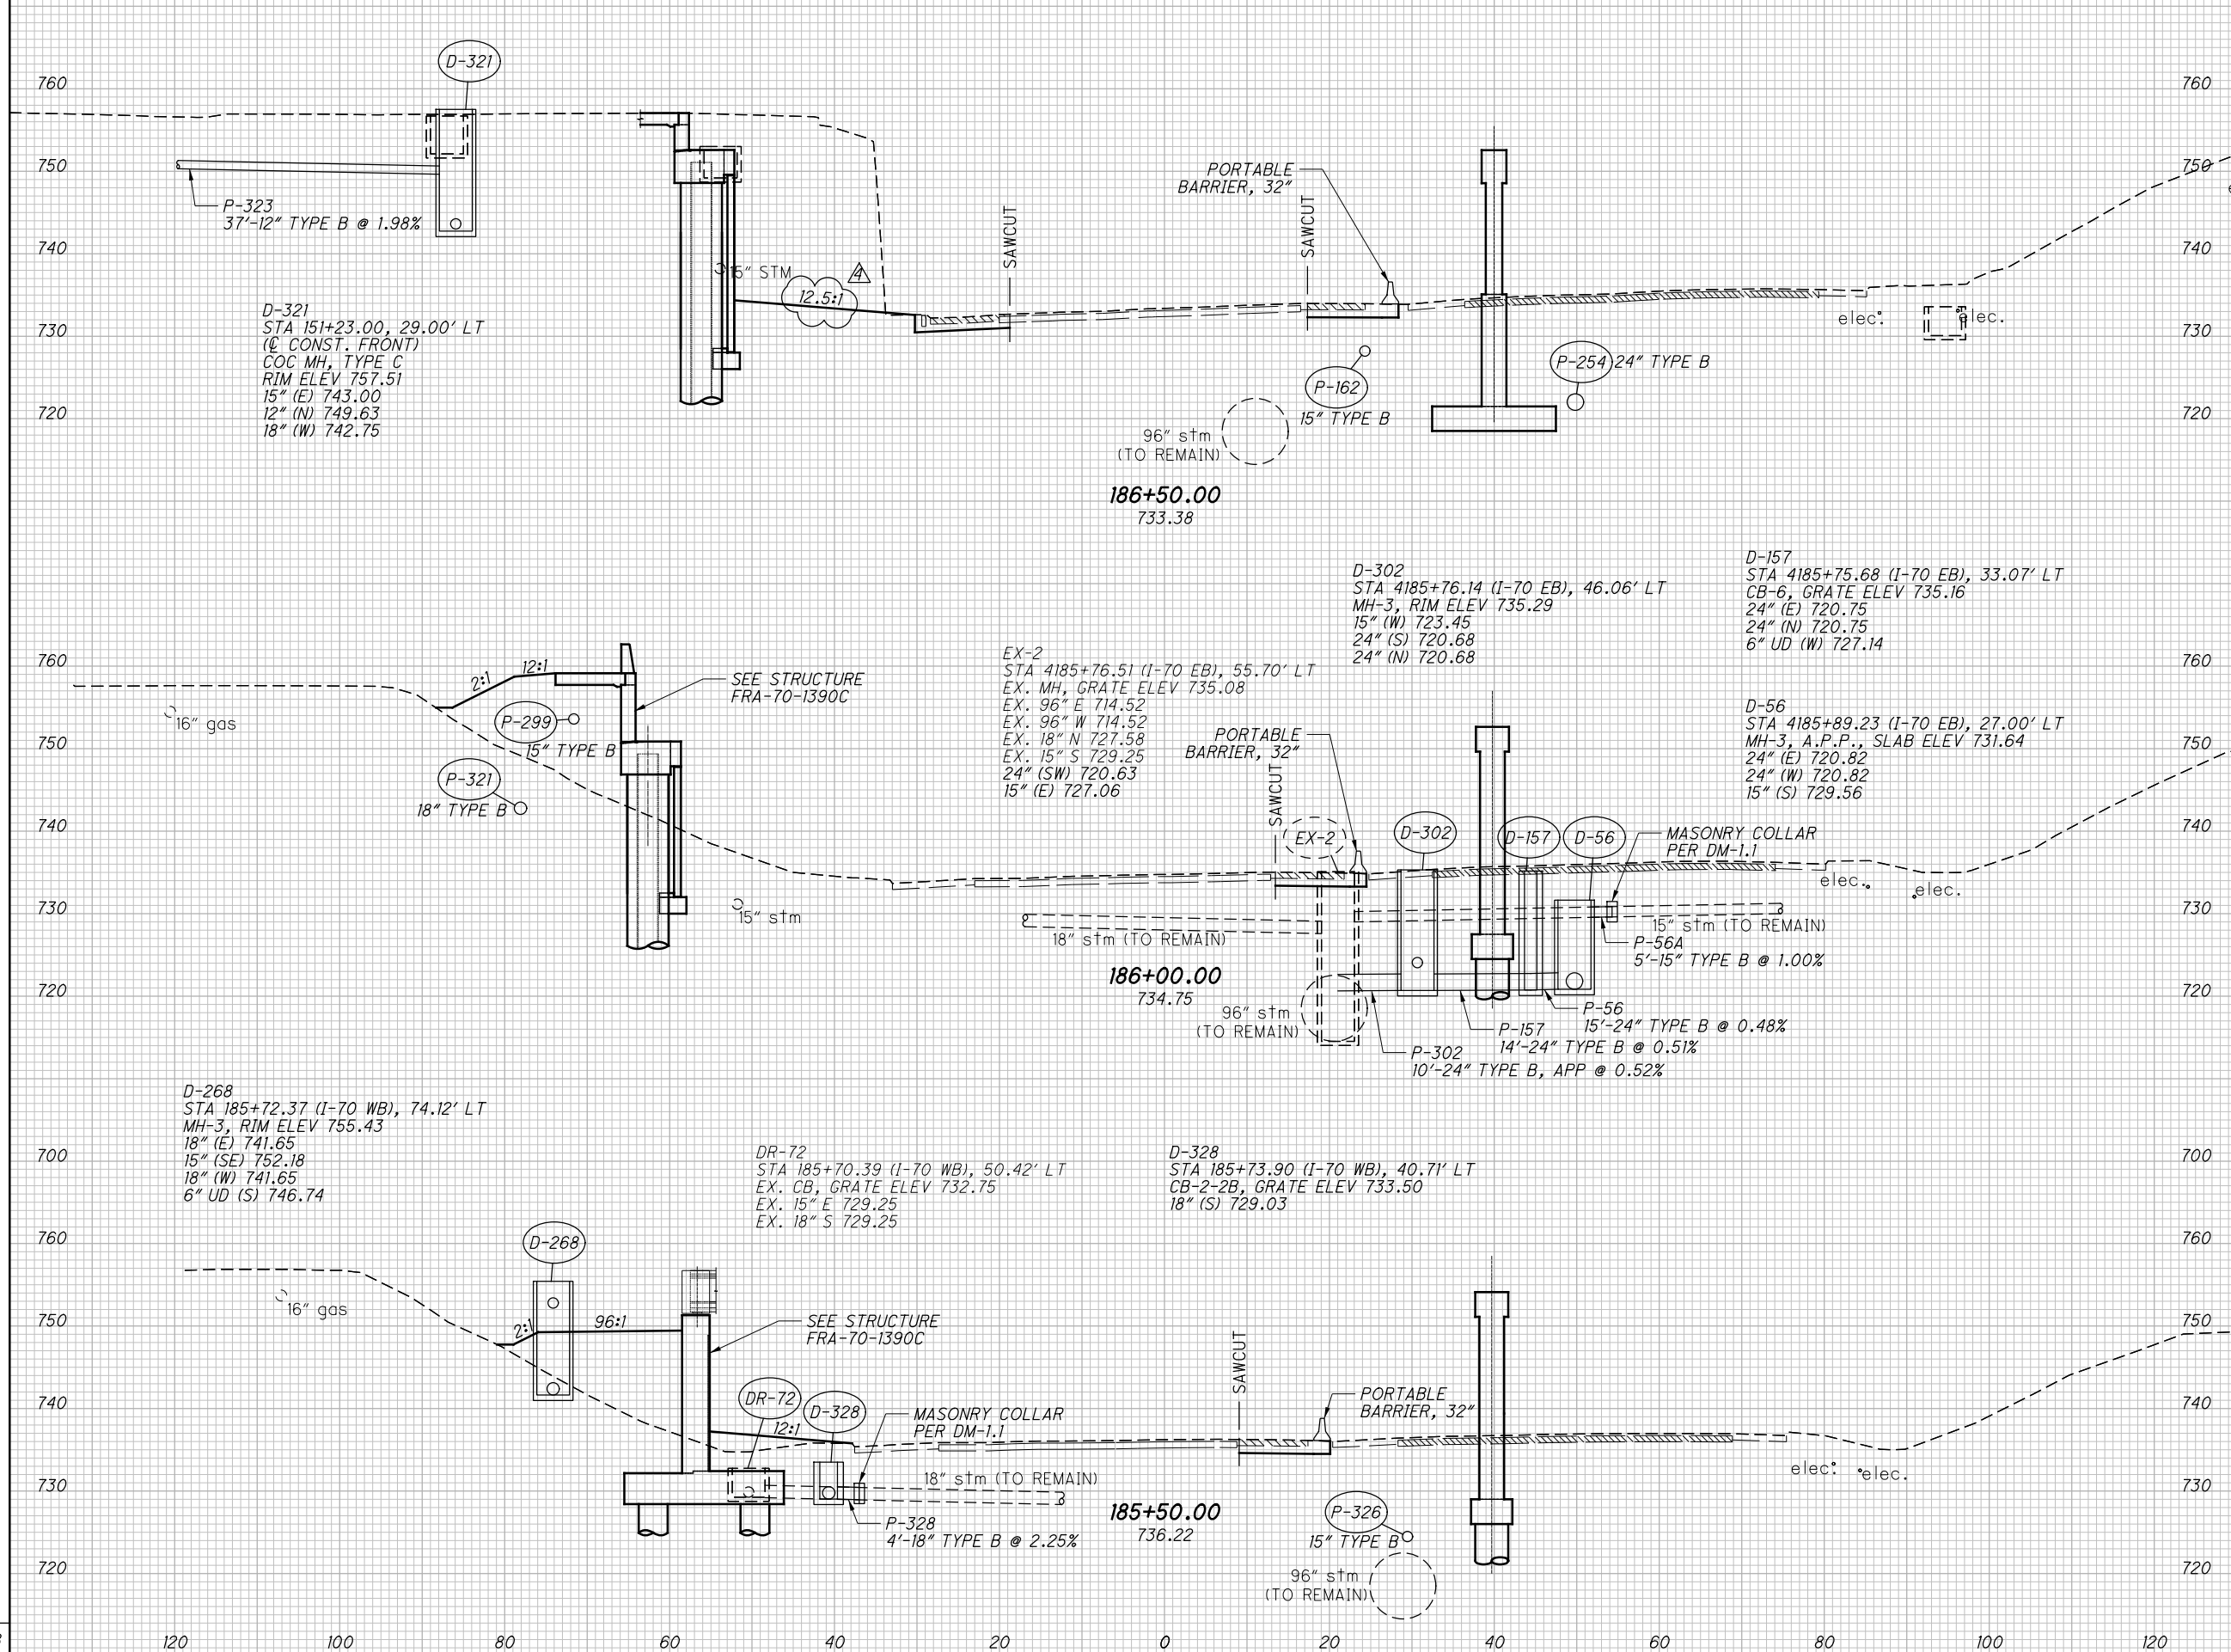


416	1	898	1				
396	184						
12	198						
22	355						
12	185						
		1316	540				

CROSS SECTIONS I-70 WESTBOUND
STA. 185+50.00 TO STA. 186+50.00

FRA-70/71-12.68/14.86

427
 1815

01-2812-2012048 V.FRA\105523\ROADWAY\105523\9095.DGN
 11/27/2021 12:54:56 PM
 0301V81STD_USER

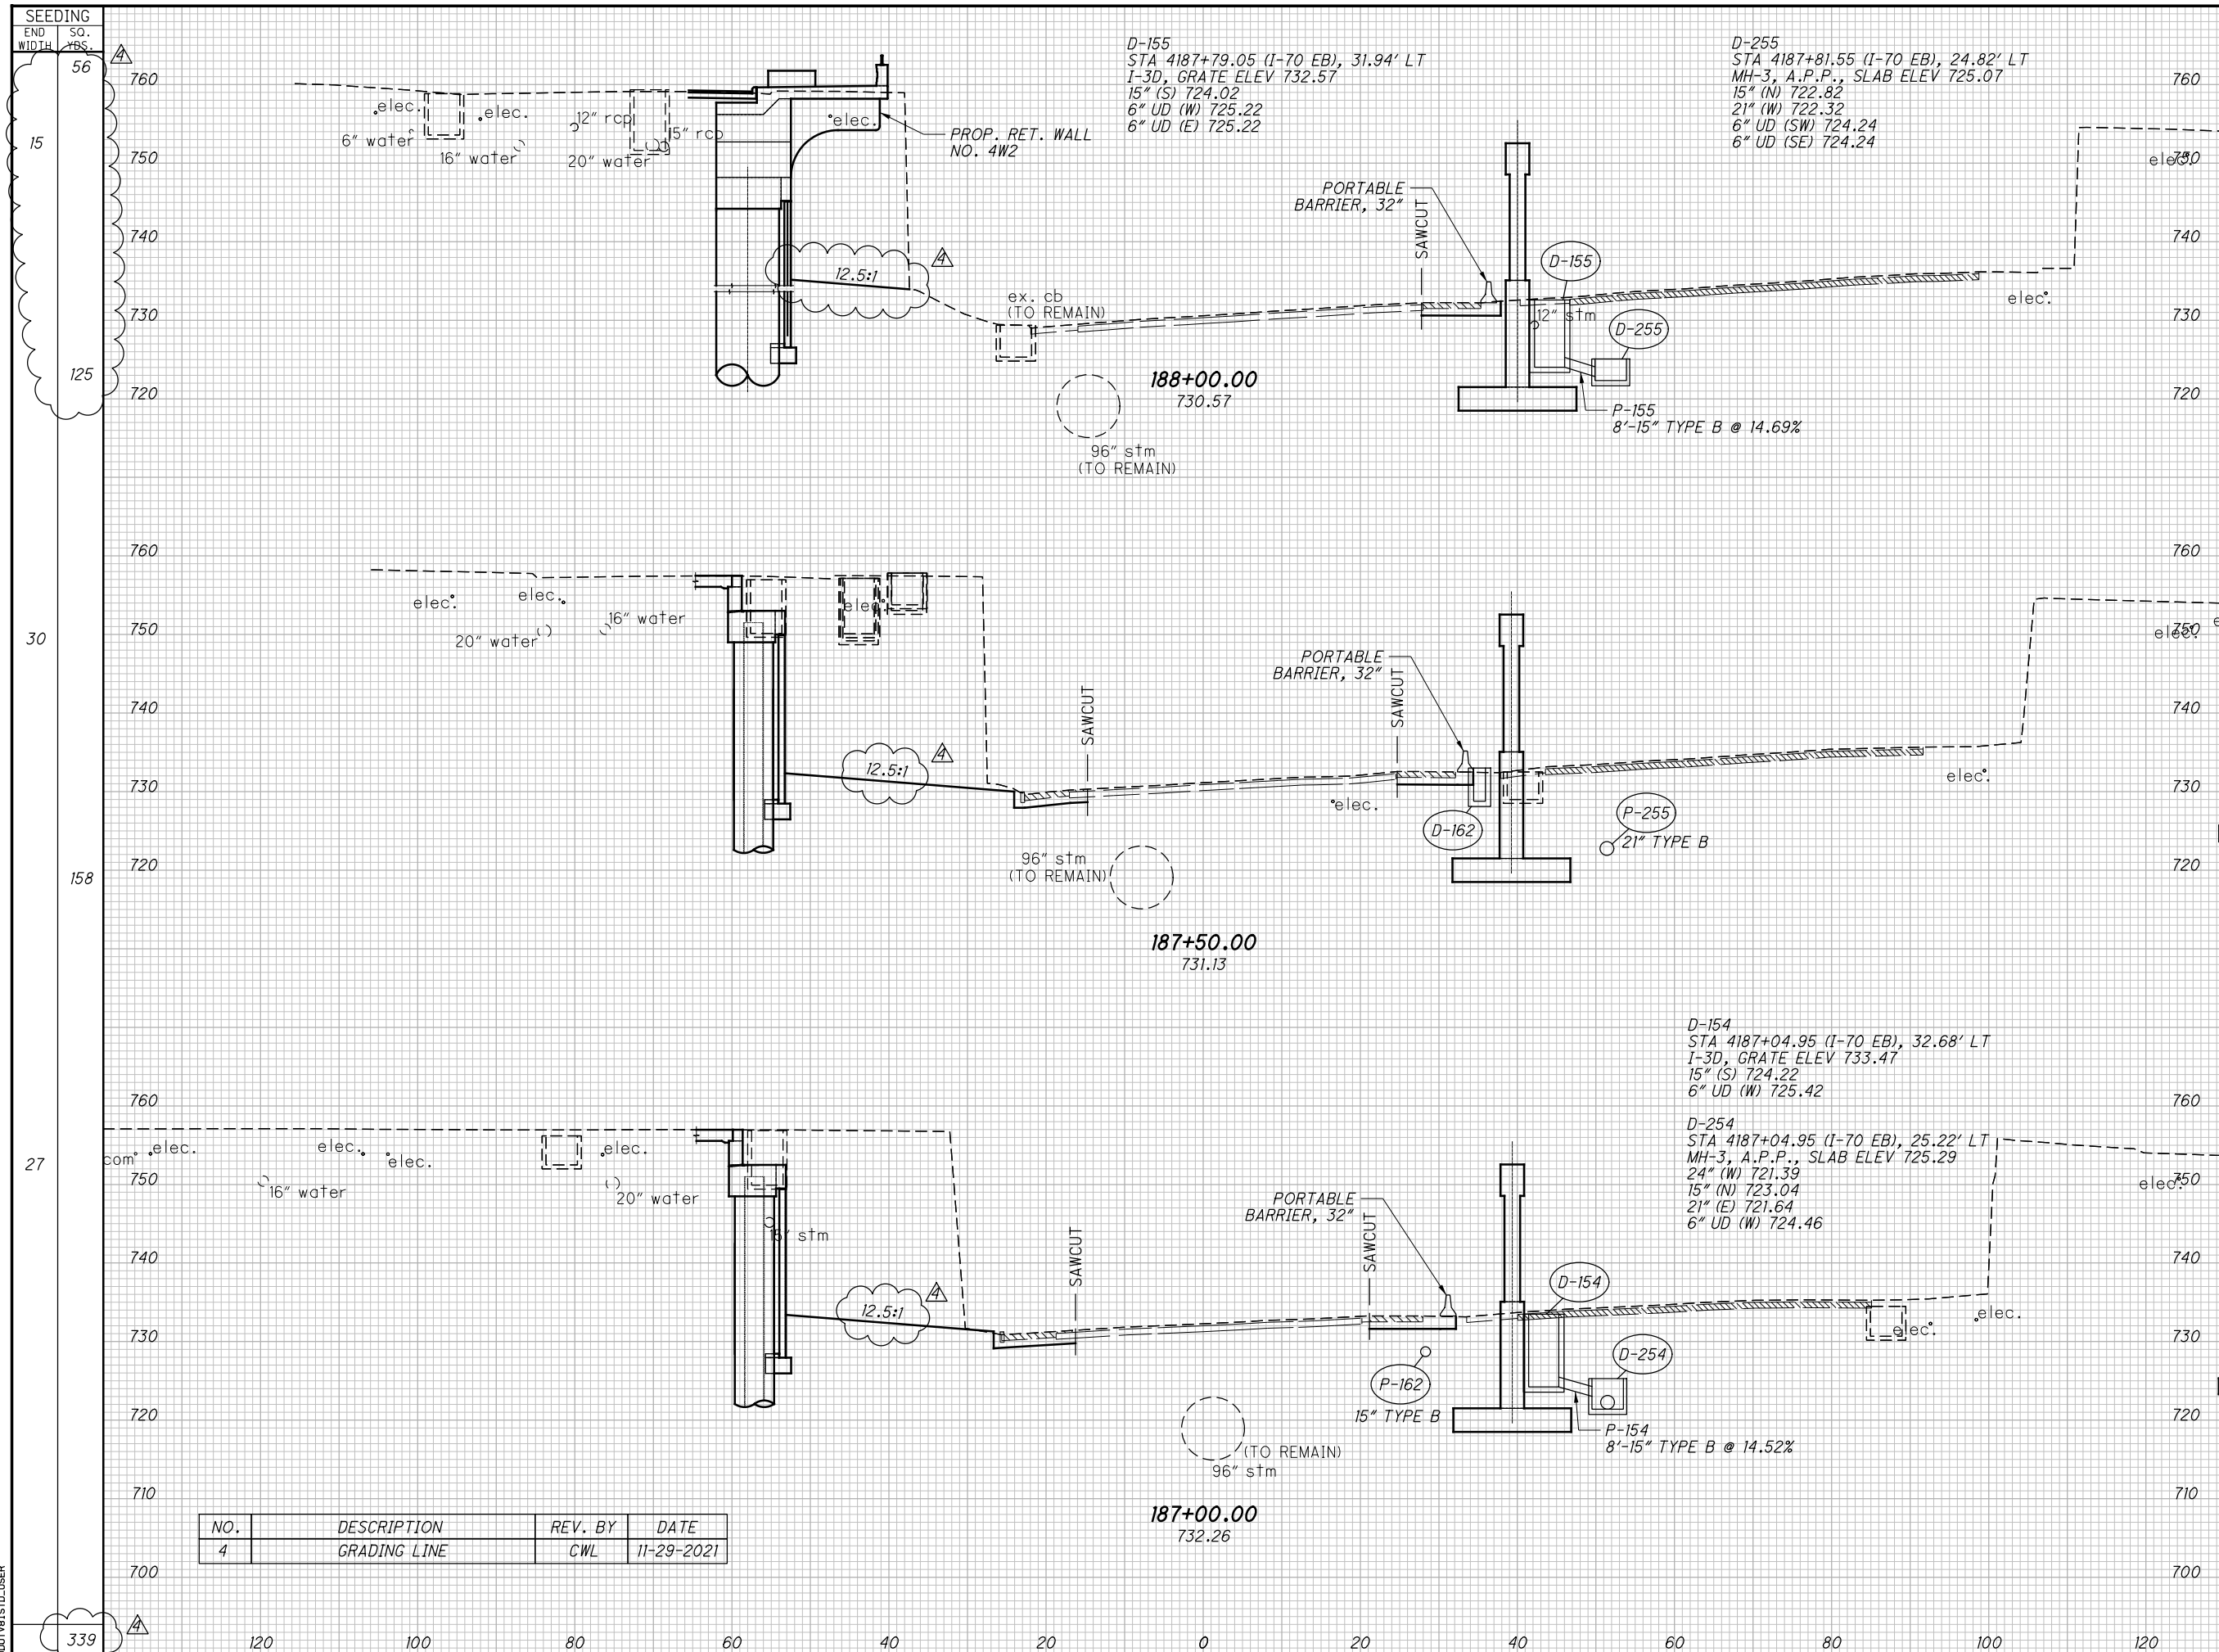

END STA.	END AREA		VOLUME		CALCULATED TMT	CHECKED CWL
	CUT	FILL	CUT	FILL		
188+00.00	10	0	645	0		
187+50.00	686	0	1148	0		
187+00.00	554	0	1803	0		
TOTAL	1803	0	1803	0		

CROSS SECTIONS I-70 WESTBOUND
STA. 187+00.00 TO STA. 188+00.00

FRA-70/71-12.68/14.86
 428
 1815

NO.	DESCRIPTION	REV. BY	DATE
4	GRADING LINE	CWL	11-29-2021

01-2812-2012048\FRA\185523\ROADWAY\185523\185523\9095.DGN
 11/27/2021 12:55:28 PM
 0301V81 STD_USER

339

SEEDING

END WIDTH	SO. YDS.
22	3
22	5


END AREA VOLUME
CUT FILL CUT FILL

END AREA		VOLUME		CALCULATED	TMT	CHECKED	CWL
CUT	FILL	CUT	FILL				
0	0	0	0				
0	0	0	0				
0	0	0	0				
0	0	0	0				

**CROSS SECTIONS I-70 WESTBOUND
STA. 188+50.00 TO STA. 189+00.00**

FRA -70/ 71-12.68 / 14.86

429
1815

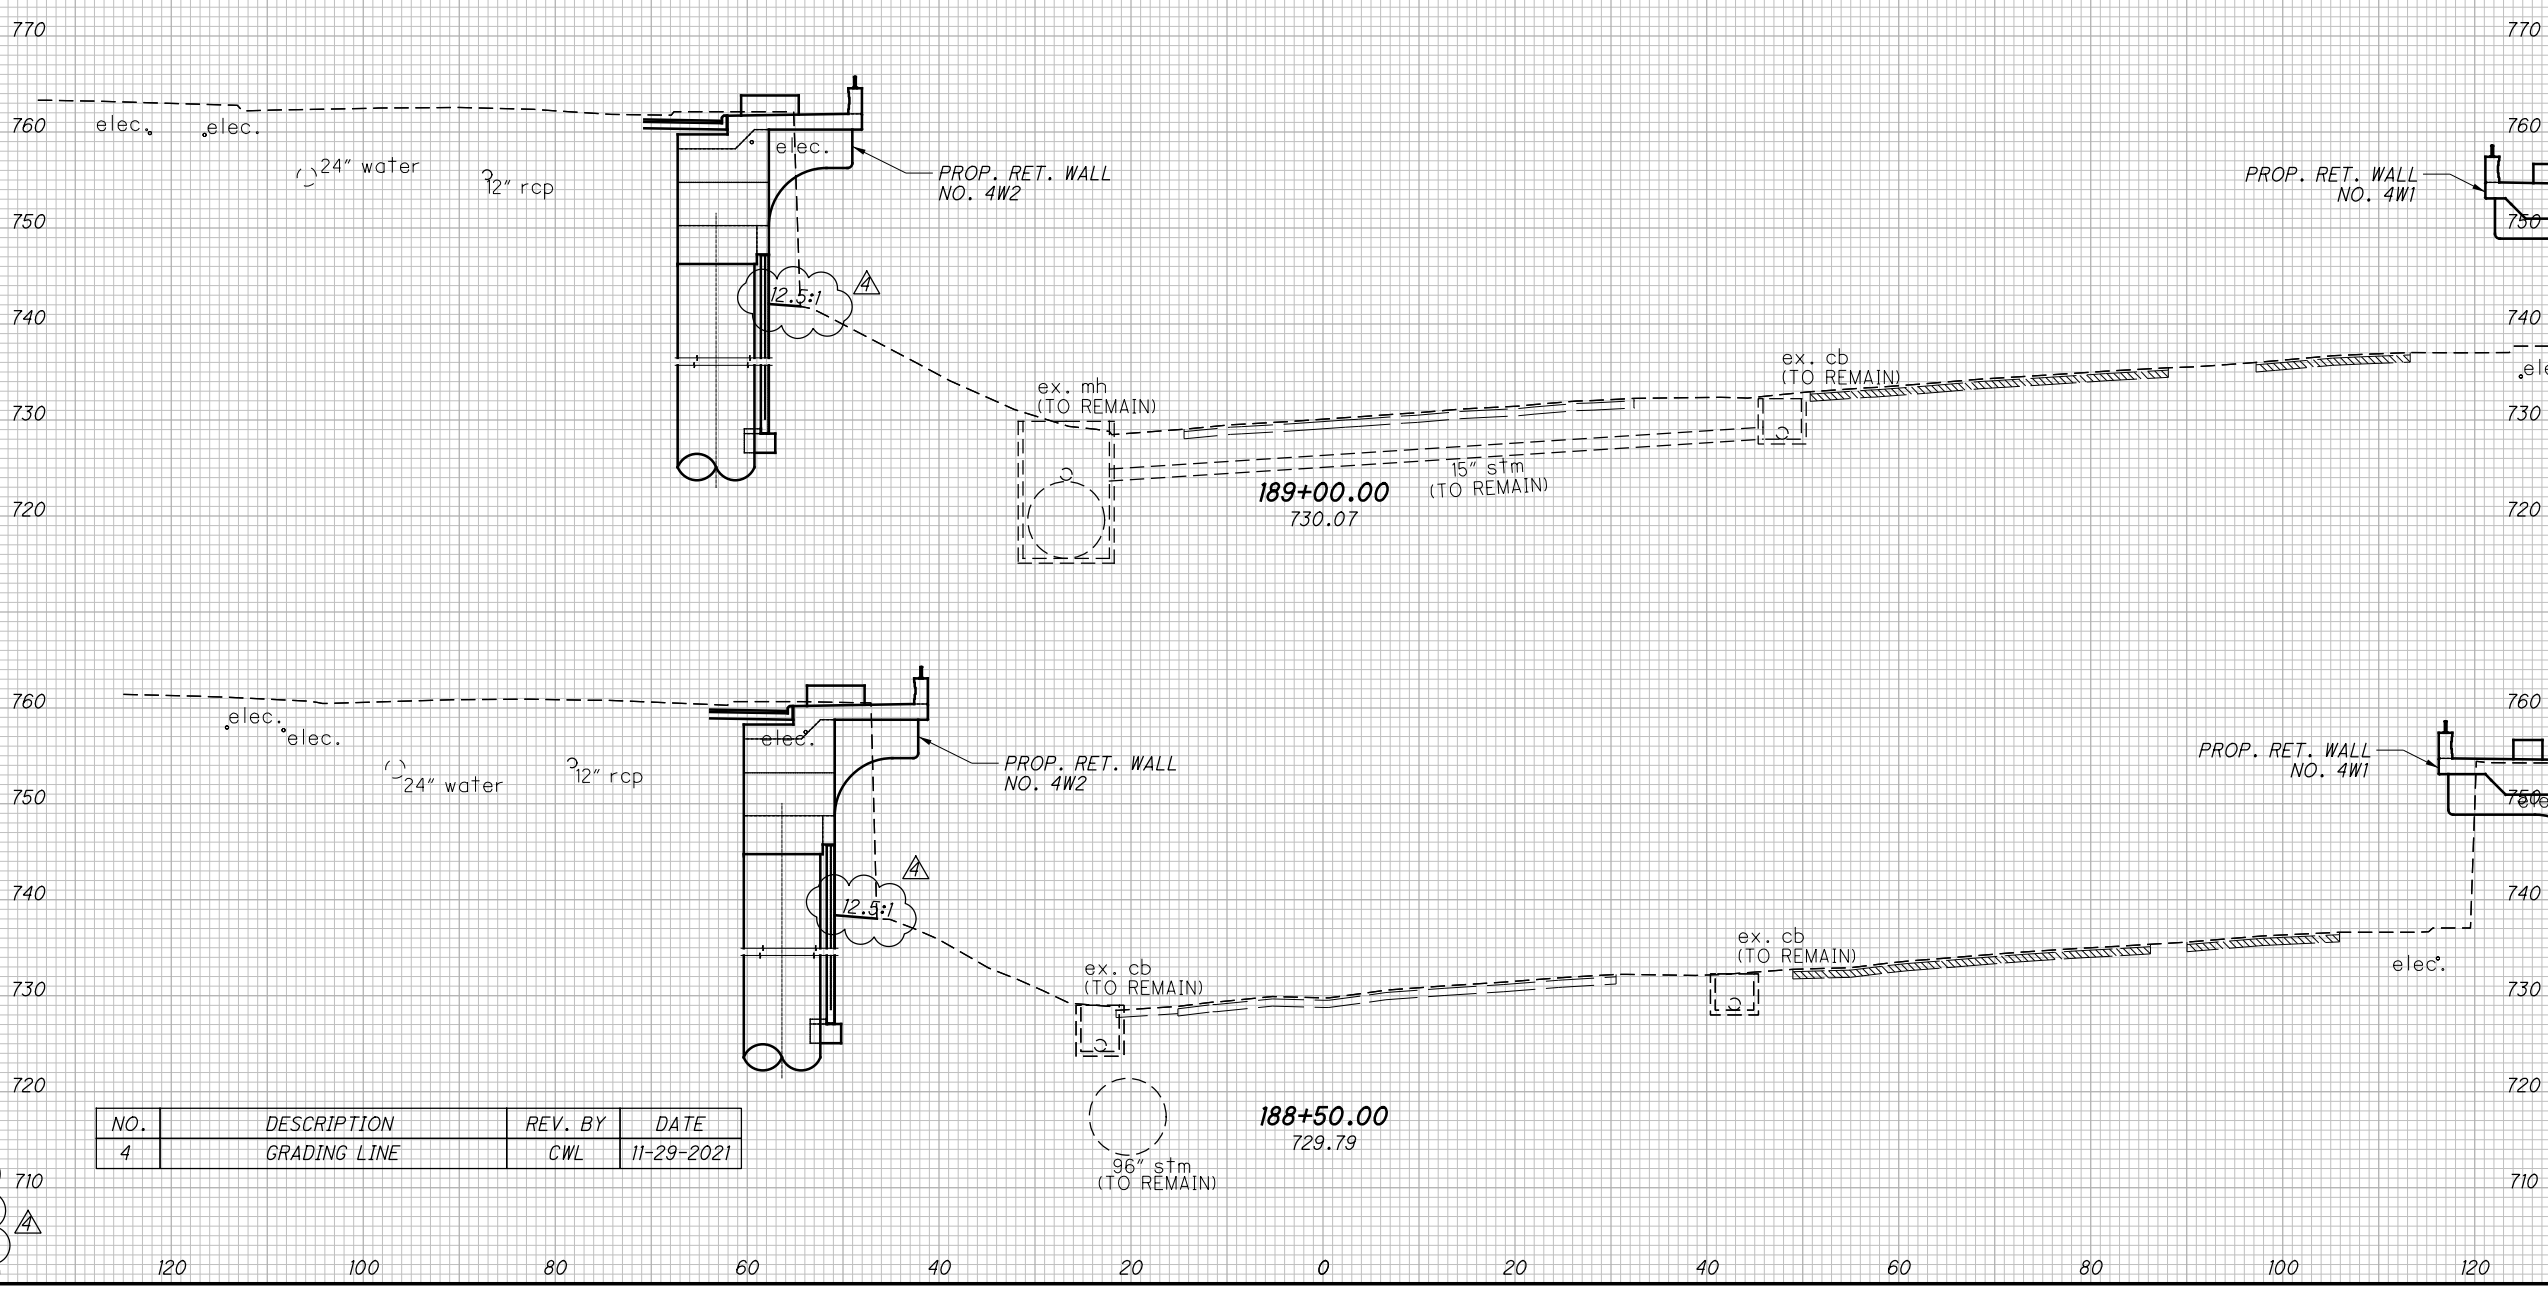


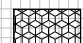
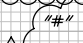
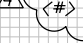

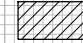





NO.	DESCRIPTION	REV. BY	DATE
4	GRADING LINE	CWL	11-29-2021

D:\2012\20120418\FRA\105523\ROADWAY\SHEETS\105523X50P5.DGN
 11/27/2021 12:55:47 PM
 D:\105523\STD_USER

SEEDING
END WIDTH SO. YDS.

NO.	DESCRIPTION	REV. BY	DATE
1	UPDATED HATCH LEGEND	CWL	11-5-2021
4	EARTHWORK REVISED	ATR	11-29-2021

-  GRANULAR BACKFILL, TYPE B (INCLUDED IN WALL QUANTITIES)
-  LOAD TRANSFER PLATFORM (INCLUDED WITH RETAINING WALL ITEM 203 - ROADWAY, MISC.: COLUMN SUPPORTED WALLS)
-  SELECT GRANULAR BACKFILL PER SS840 (INCLUDED IN WALL QUANTITIES)
-  ITEM 203 - GRANULAR MATERIAL, TYPE C (INCLUDED IN THE WALL QUANTITIES)
-  ITEM 203 - GRANULAR EMBANKMENT, AS PER PLAN
-  ITEM 203 - EMBANKMENT, AS PER PLAN "A"
-  ITEM 202 - PAVEMENT REMOVED
-  ITEM 202 - PAVEMENT REMOVED, ASPHALT

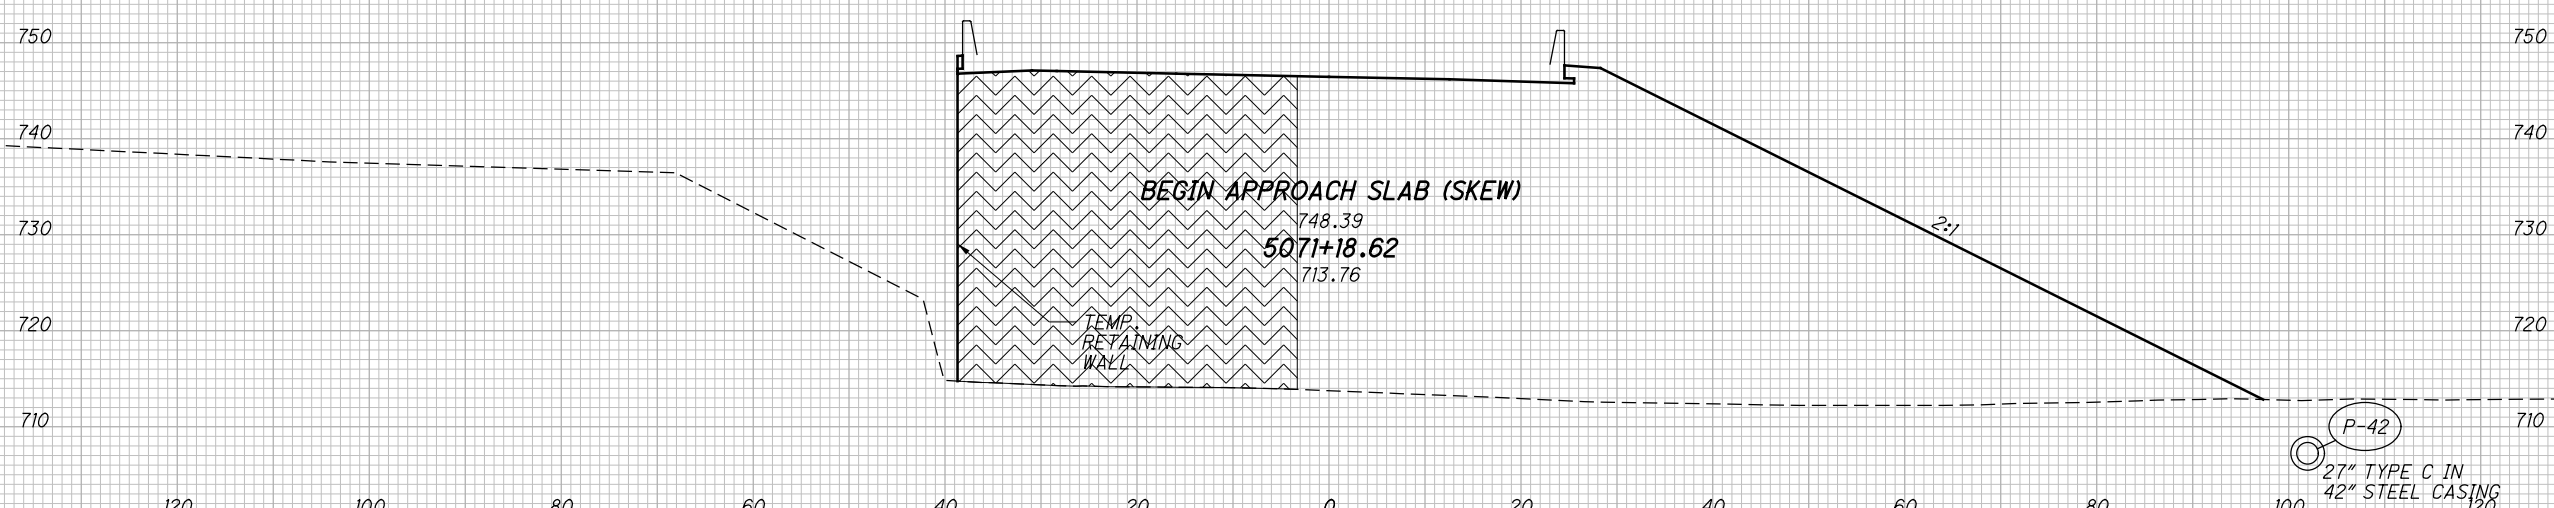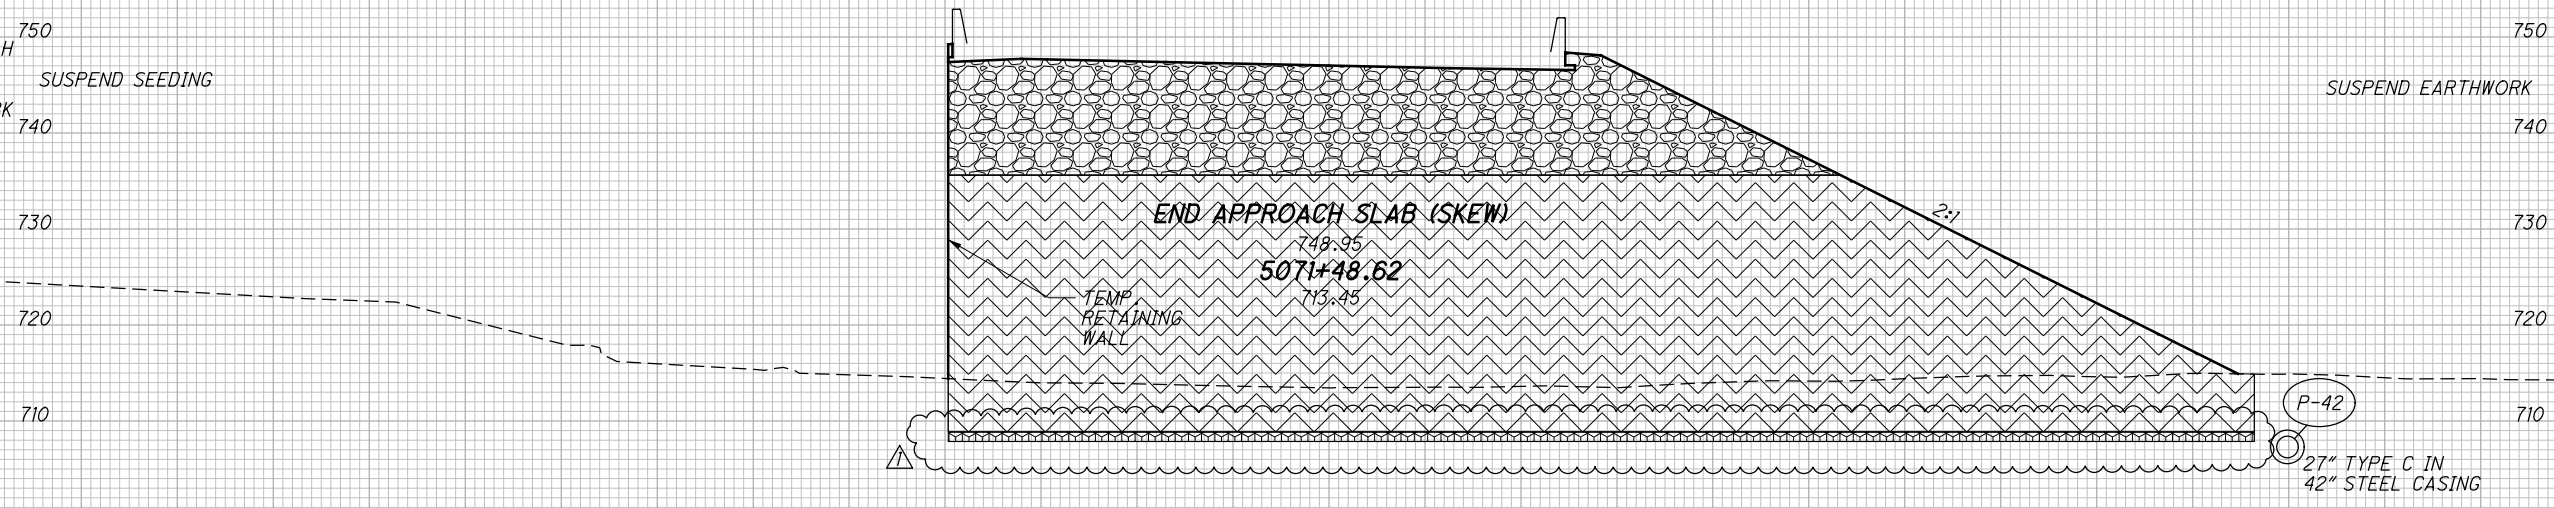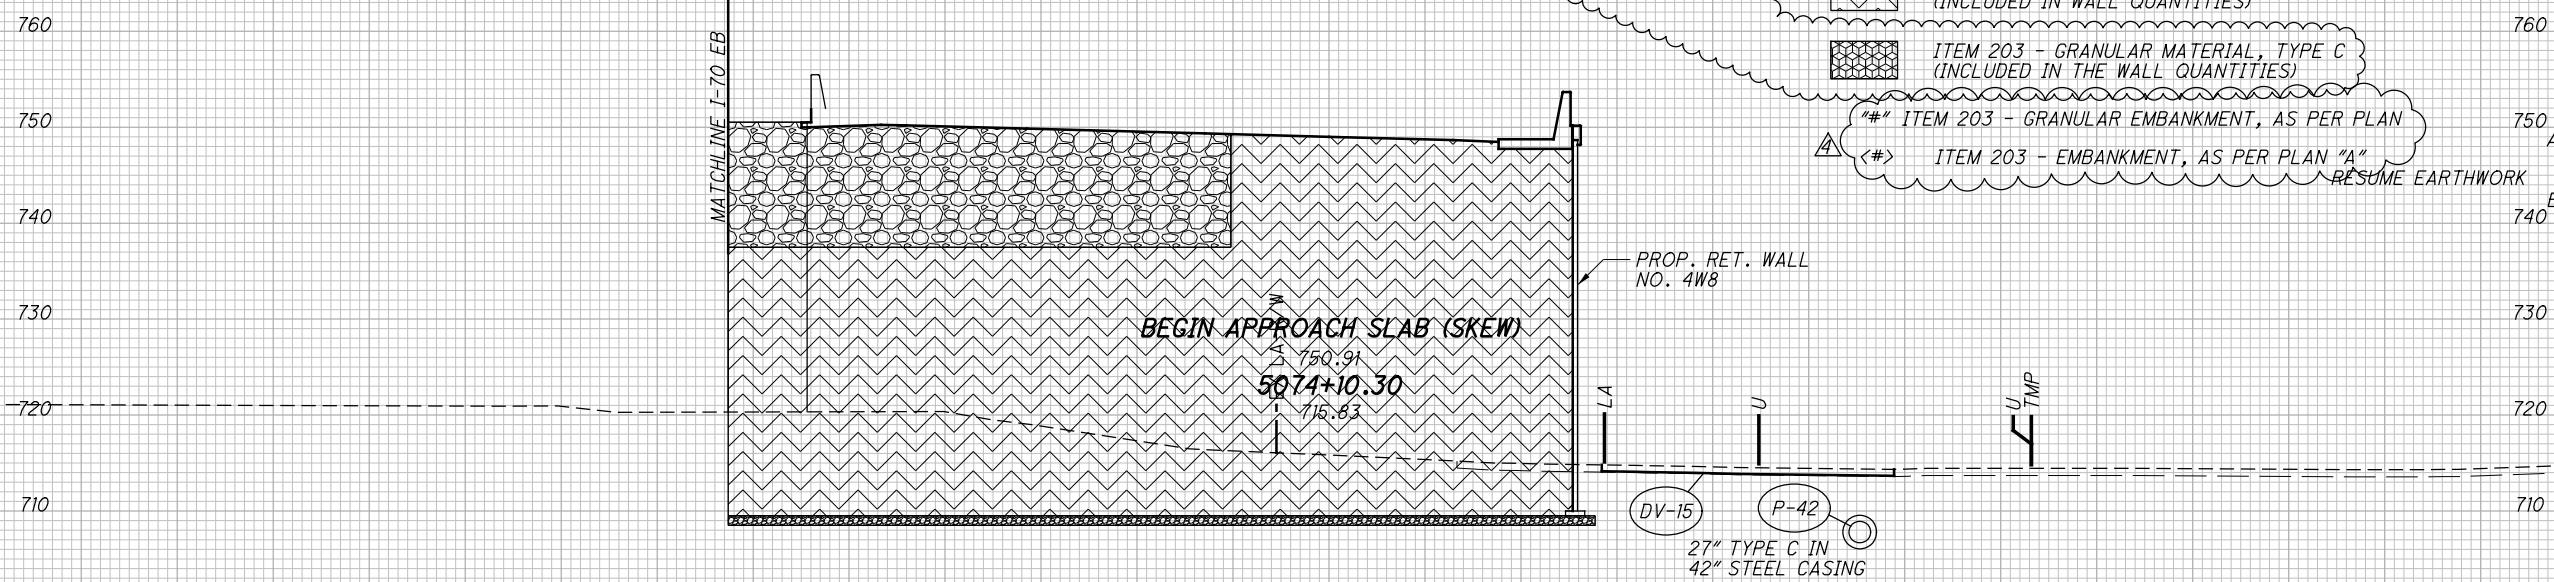






END AREA	VOLUME		CALCULATED	CHECKED
	CUT	FILL		
			99	633
			0	0
			0	0
			0	1258
			0	2265
			99	633
			485	1815

CROSS SECTIONS - RAMP C5
STA. 5071+18.62 TO STA. 5074+10.30

FRA - 70 / 71 - 12.68 / 14.86

SEEDING
END WIDTH SO. YDS.

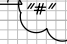NO.	DESCRIPTION	REV. BY	DATE
1	UPDATED HATCH LEGEND	CWL	11-5-2021
4	EARTHWORK REVISED	ATR	11-29-2021



-  ITEM 202 - PAVEMENT REMOVED
-  ITEM 202 - PAVEMENT REMOVED, ASPHALT
-  ITEM 203 - GRANULAR EMBANKMENT, AS PER PLAN
-  SELECT GRANULAR BACKFILL PER SS840 (INCLUDED IN WALL QUANTITIES)
-  LOAD TRANSFER PLATFORM (INCLUDED WITH RETAINING WALL ITEM 203 - ROADWAY, MISC.: COLUMN SUPPORTED WALLS)

END AREA		VOLUME		CALCULATED	CHECKED
CUT	FILL	CUT	FILL		
		220	1219		

CROSS SECTIONS - RAMP C5
STA. 5074+40.30 TO STA. 5074+50.00

FRA -70/ 71-12.68 / 14.86

486
 1815

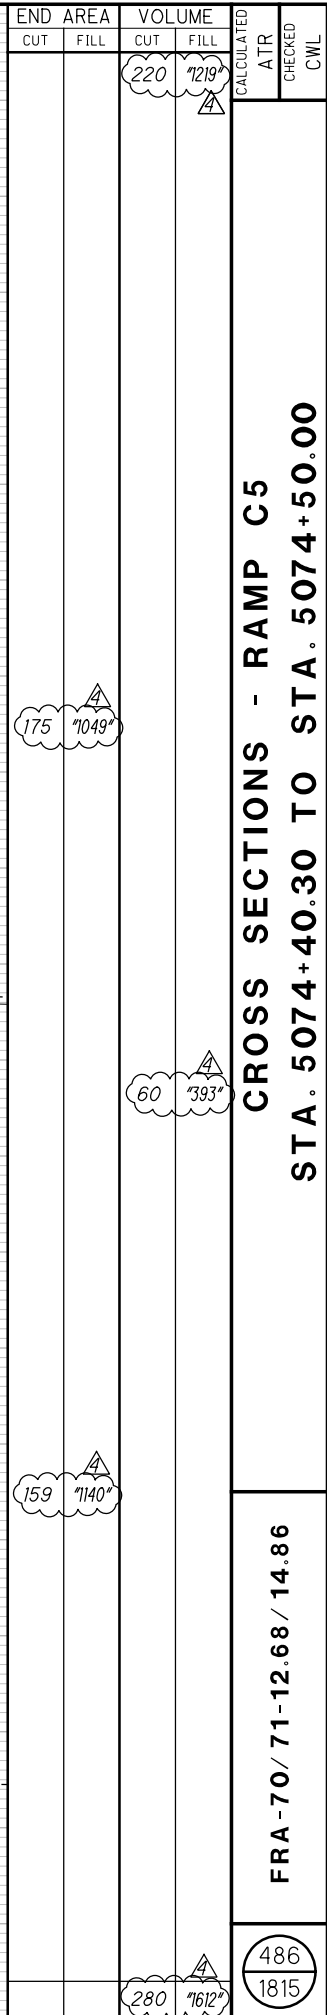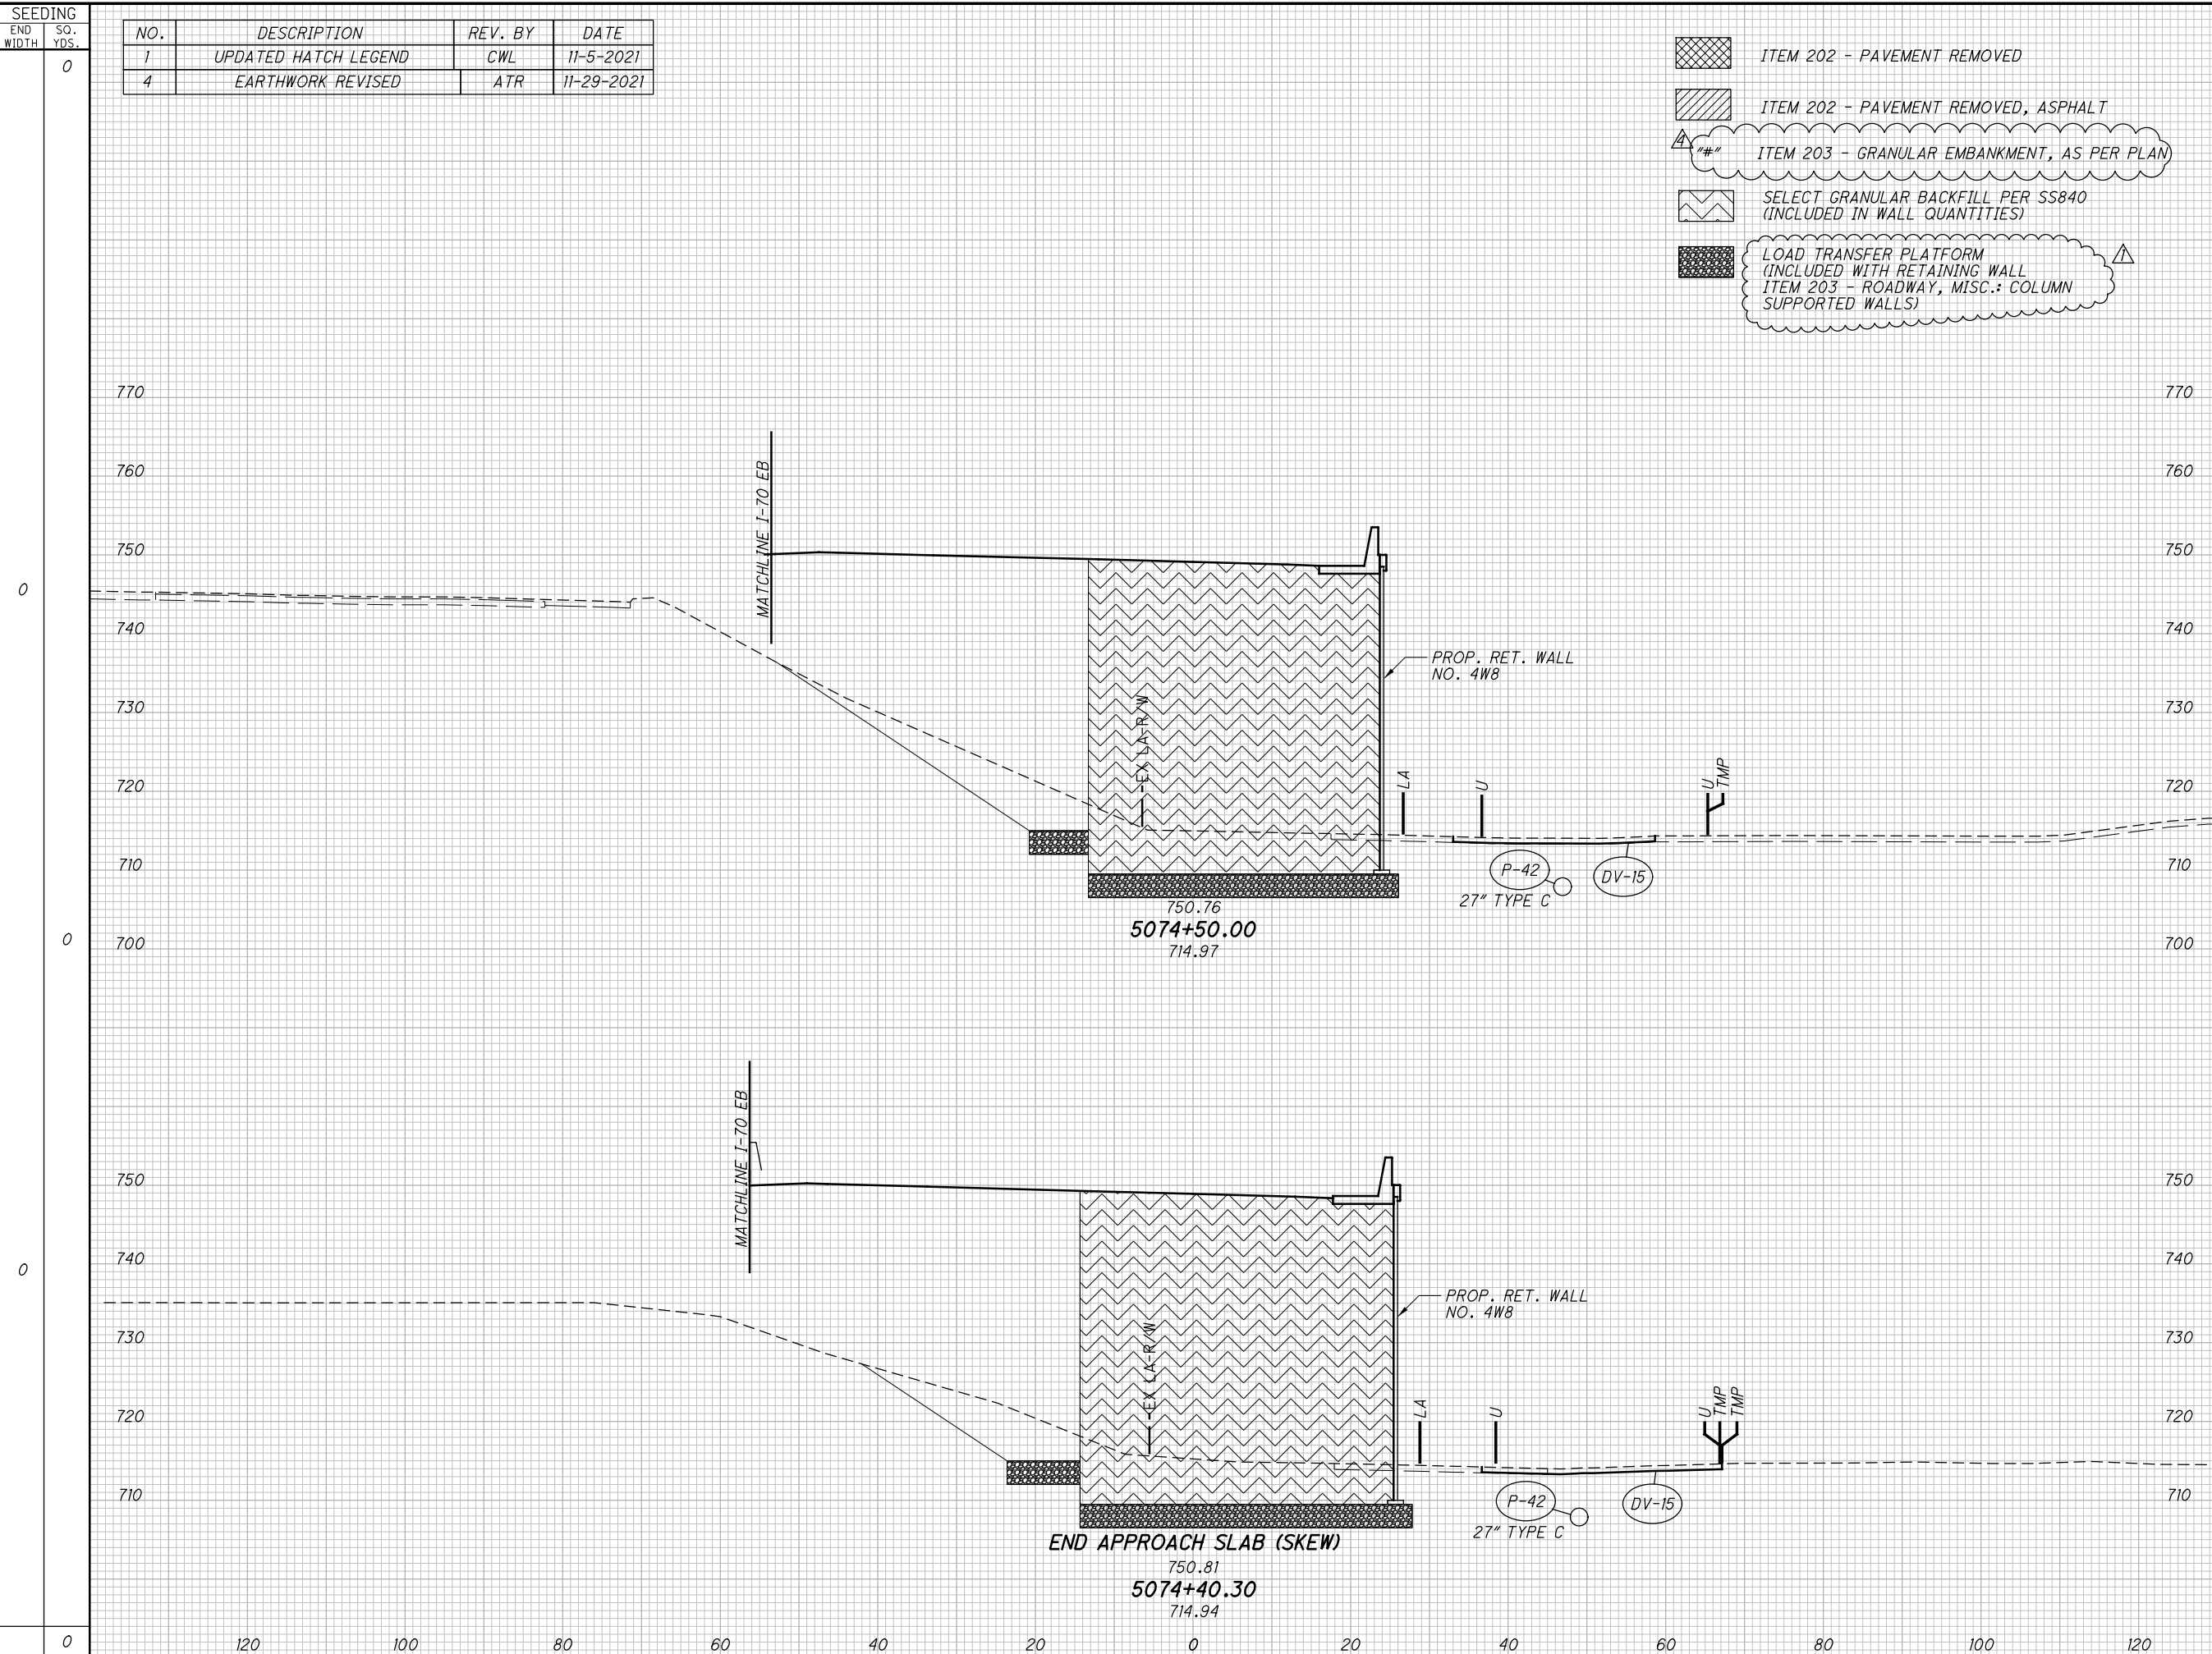


01-2812-2012048\FRA\105523\ROADWAY\105523\SHEETS\105523\S007.DGN
 11/24/2021 4:05:11 PM
 030TV81STD.LJSEB

SEEDING
END WIDTH SO. YDS.
56

NO.	DESCRIPTION	REV. BY	DATE
1	UPDATED HATCH LEGEND	CWL	11-5-2021
4	EARTHWORK REVISED	ATR	11-29-2021

END AREA
CUT FILL
VOLUME
CUT FILL
CALCULATED
ATR
CHECKED
CWL

5
28
5
0
84

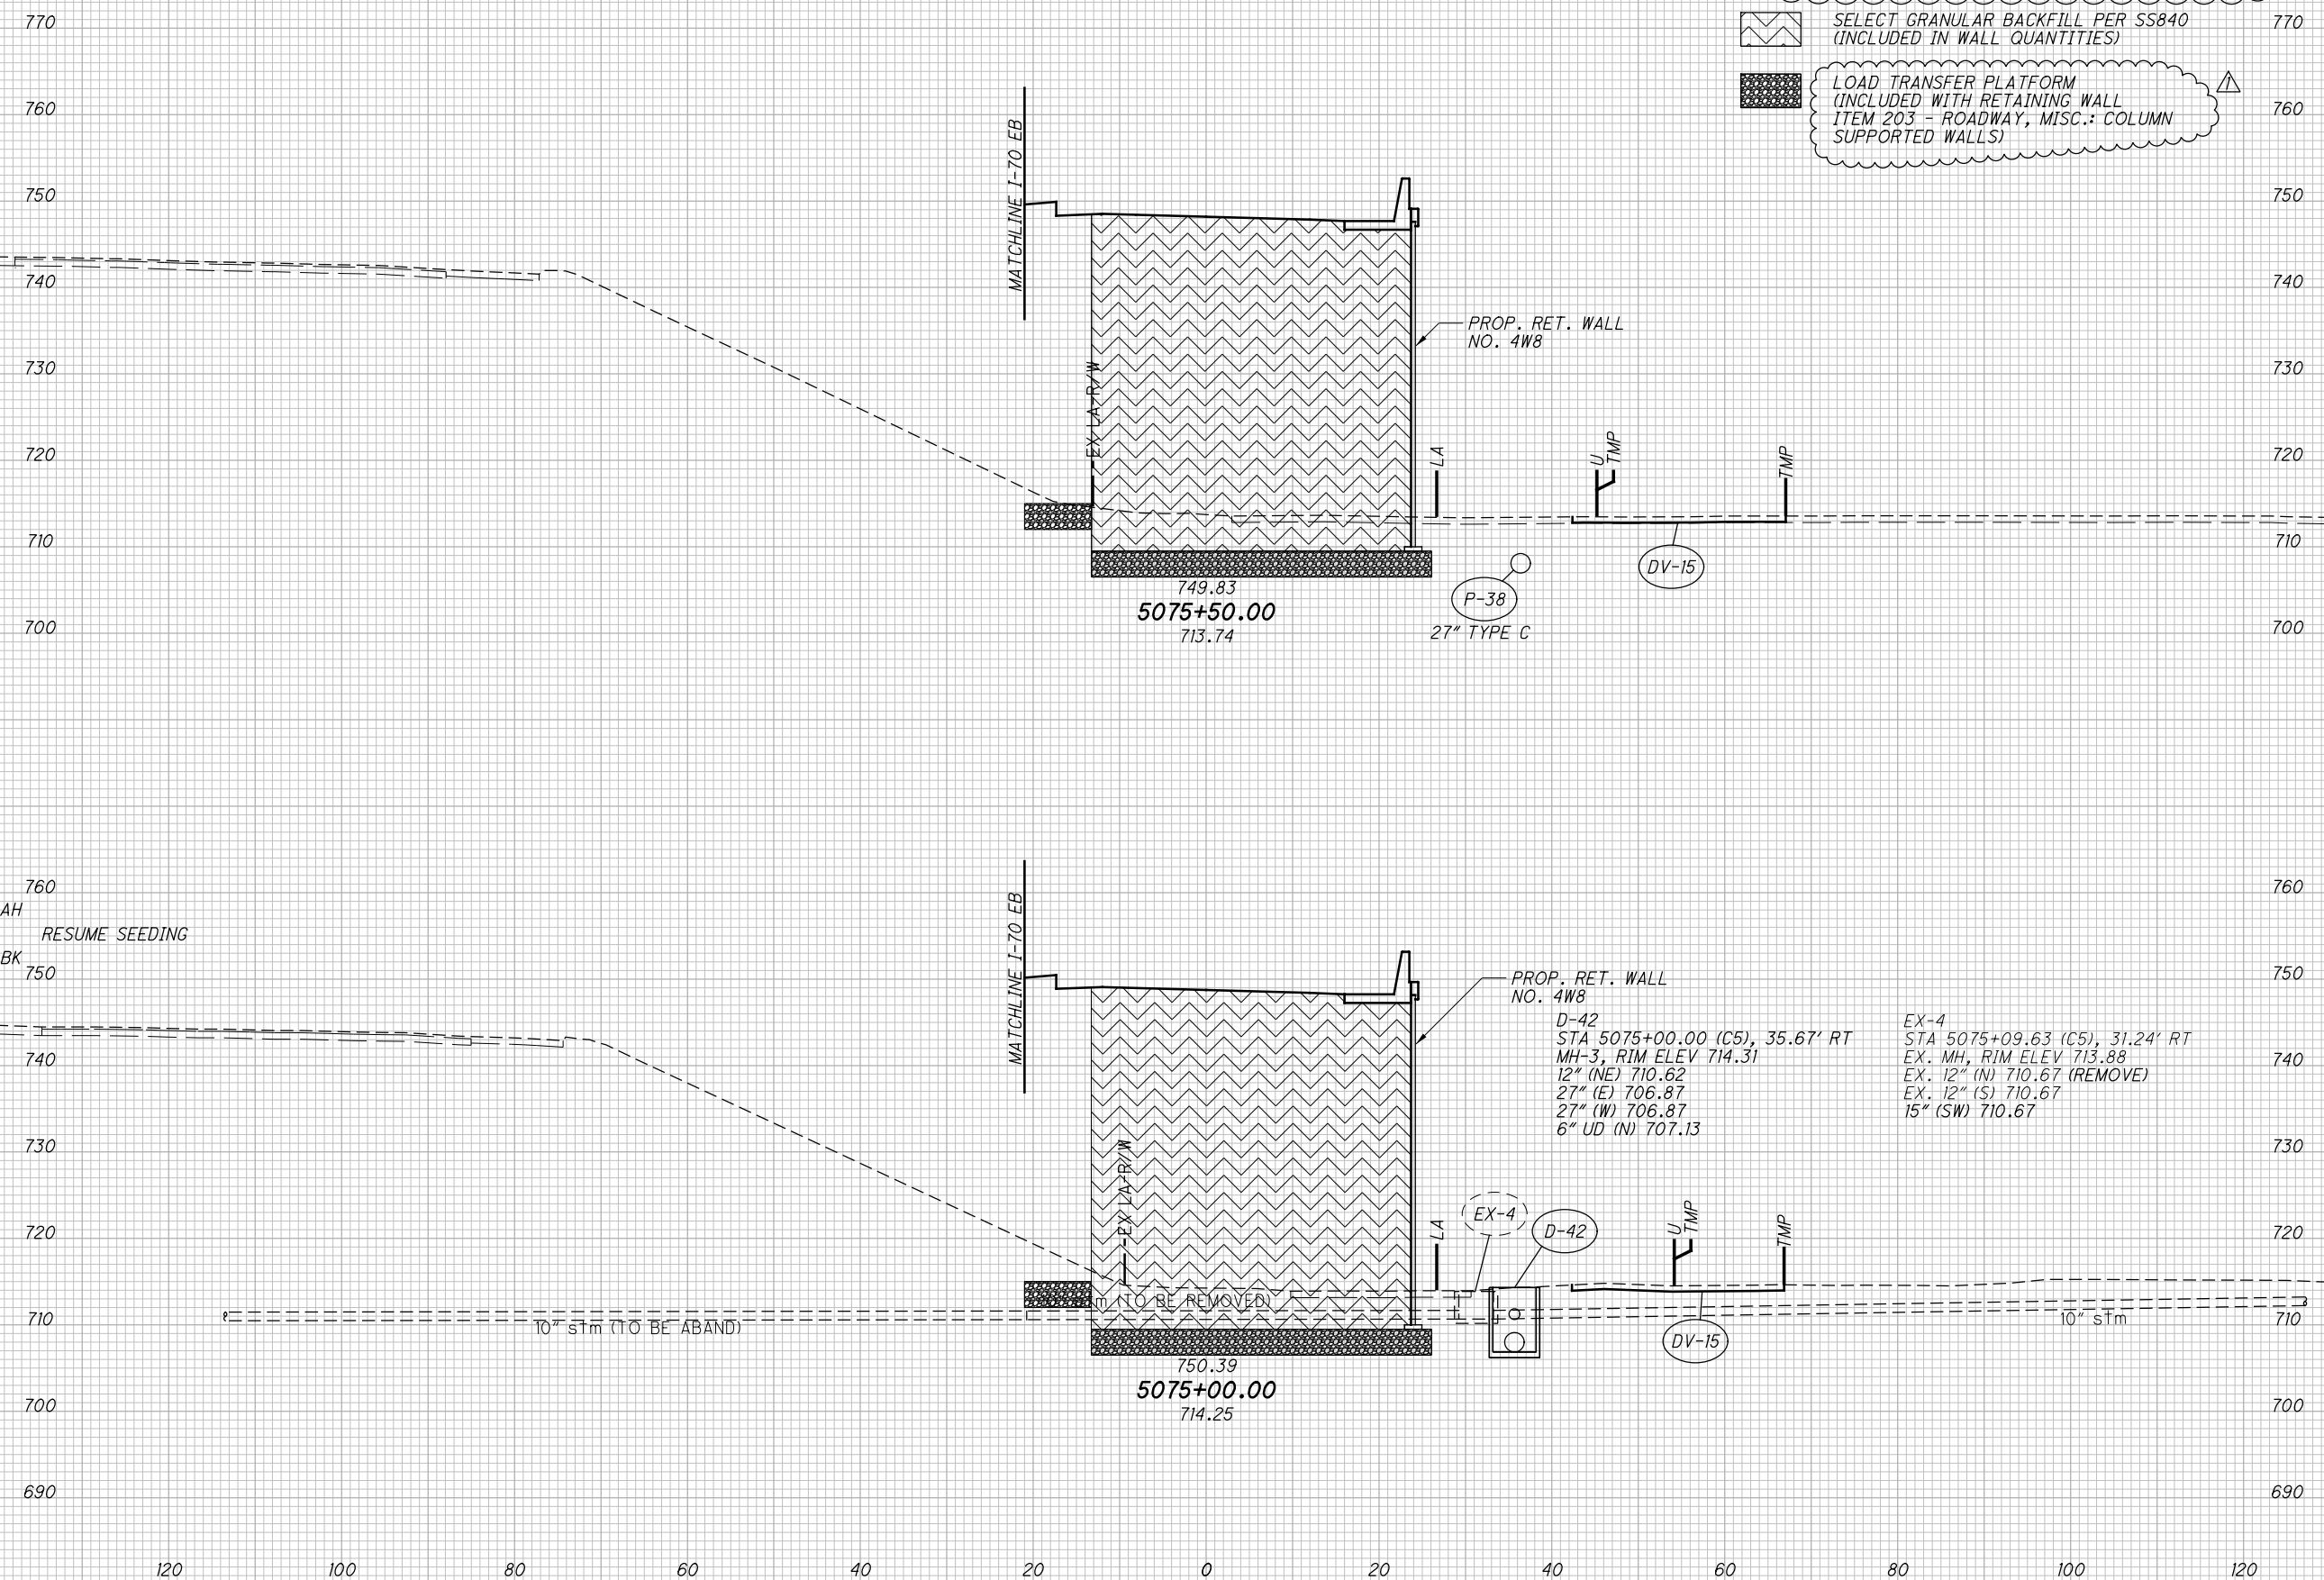

- ITEM 202 - PAVEMENT REMOVED
- ITEM 202 - PAVEMENT REMOVED, ASPHALT
- ITEM 203 - GRANULAR EMBANKMENT, AS PER PLAN
- SELECT GRANULAR BACKFILL PER SS840 (INCLUDED IN WALL QUANTITIES)
- LOAD TRANSFER PLATFORM (INCLUDED WITH RETAINING WALL ITEM 203 - ROADWAY, MISC.: COLUMN SUPPORTED WALLS)

END AREA	VOLUME	CALCULATED	CHECKED
CUT FILL	CUT FILL	ATR	CWL
72	482	2	487
43	263	4	1815
98	491	4	1815
63	267	4	1815
170	973	2	1815

**CROSS SECTIONS - RAMP C5
STA. 5075+00.00 TO STA. 5075+50.00**

FRA - 70/ 71-12.68 / 14.86

SEEDING
END WIDTH SO. YDS.

69
15
15
15
84

NO.	DESCRIPTION	REV. BY	DATE
1	UPDATED HATCH LEGEND	CWL	11-5-2021
4	EARTHWORK REVISED	ATR	11-29-2021

- SELECT GRANULAR BACKFILL PER SS840 (INCLUDED IN WALL QUANTITIES)
- LOAD TRANSFER PLATFORM (INCLUDED WITH RETAINING WALL ITEM 203 - ROADWAY, MISC.: COLUMN SUPPORTED WALLS)
- ITEM 202 - PAVEMENT REMOVED
- ITEM 202 - PAVEMENT REMOVED, ASPHALT
- ITEM 203 - GRANULAR EMBANKMENT, AS PER PLAN
- ITEM 203 - GRANULAR EMBANKMENT


END ITEM 203 - GRANULAR EMBANKMENT, A.P.P. BK STA. 5076+10.84

END AREA	VOLUME		CALCULATED	CHECKED
	CUT	FILL		
			54	[386]
			12	84"
			36	256"
			35	258"
			66	[386]
			488	1815

CROSS SECTIONS - RAMP C5
STA. 5076+00.00 TO STA. 5076+08.84




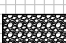
FRA -70/ 71-12.68 / 14.86

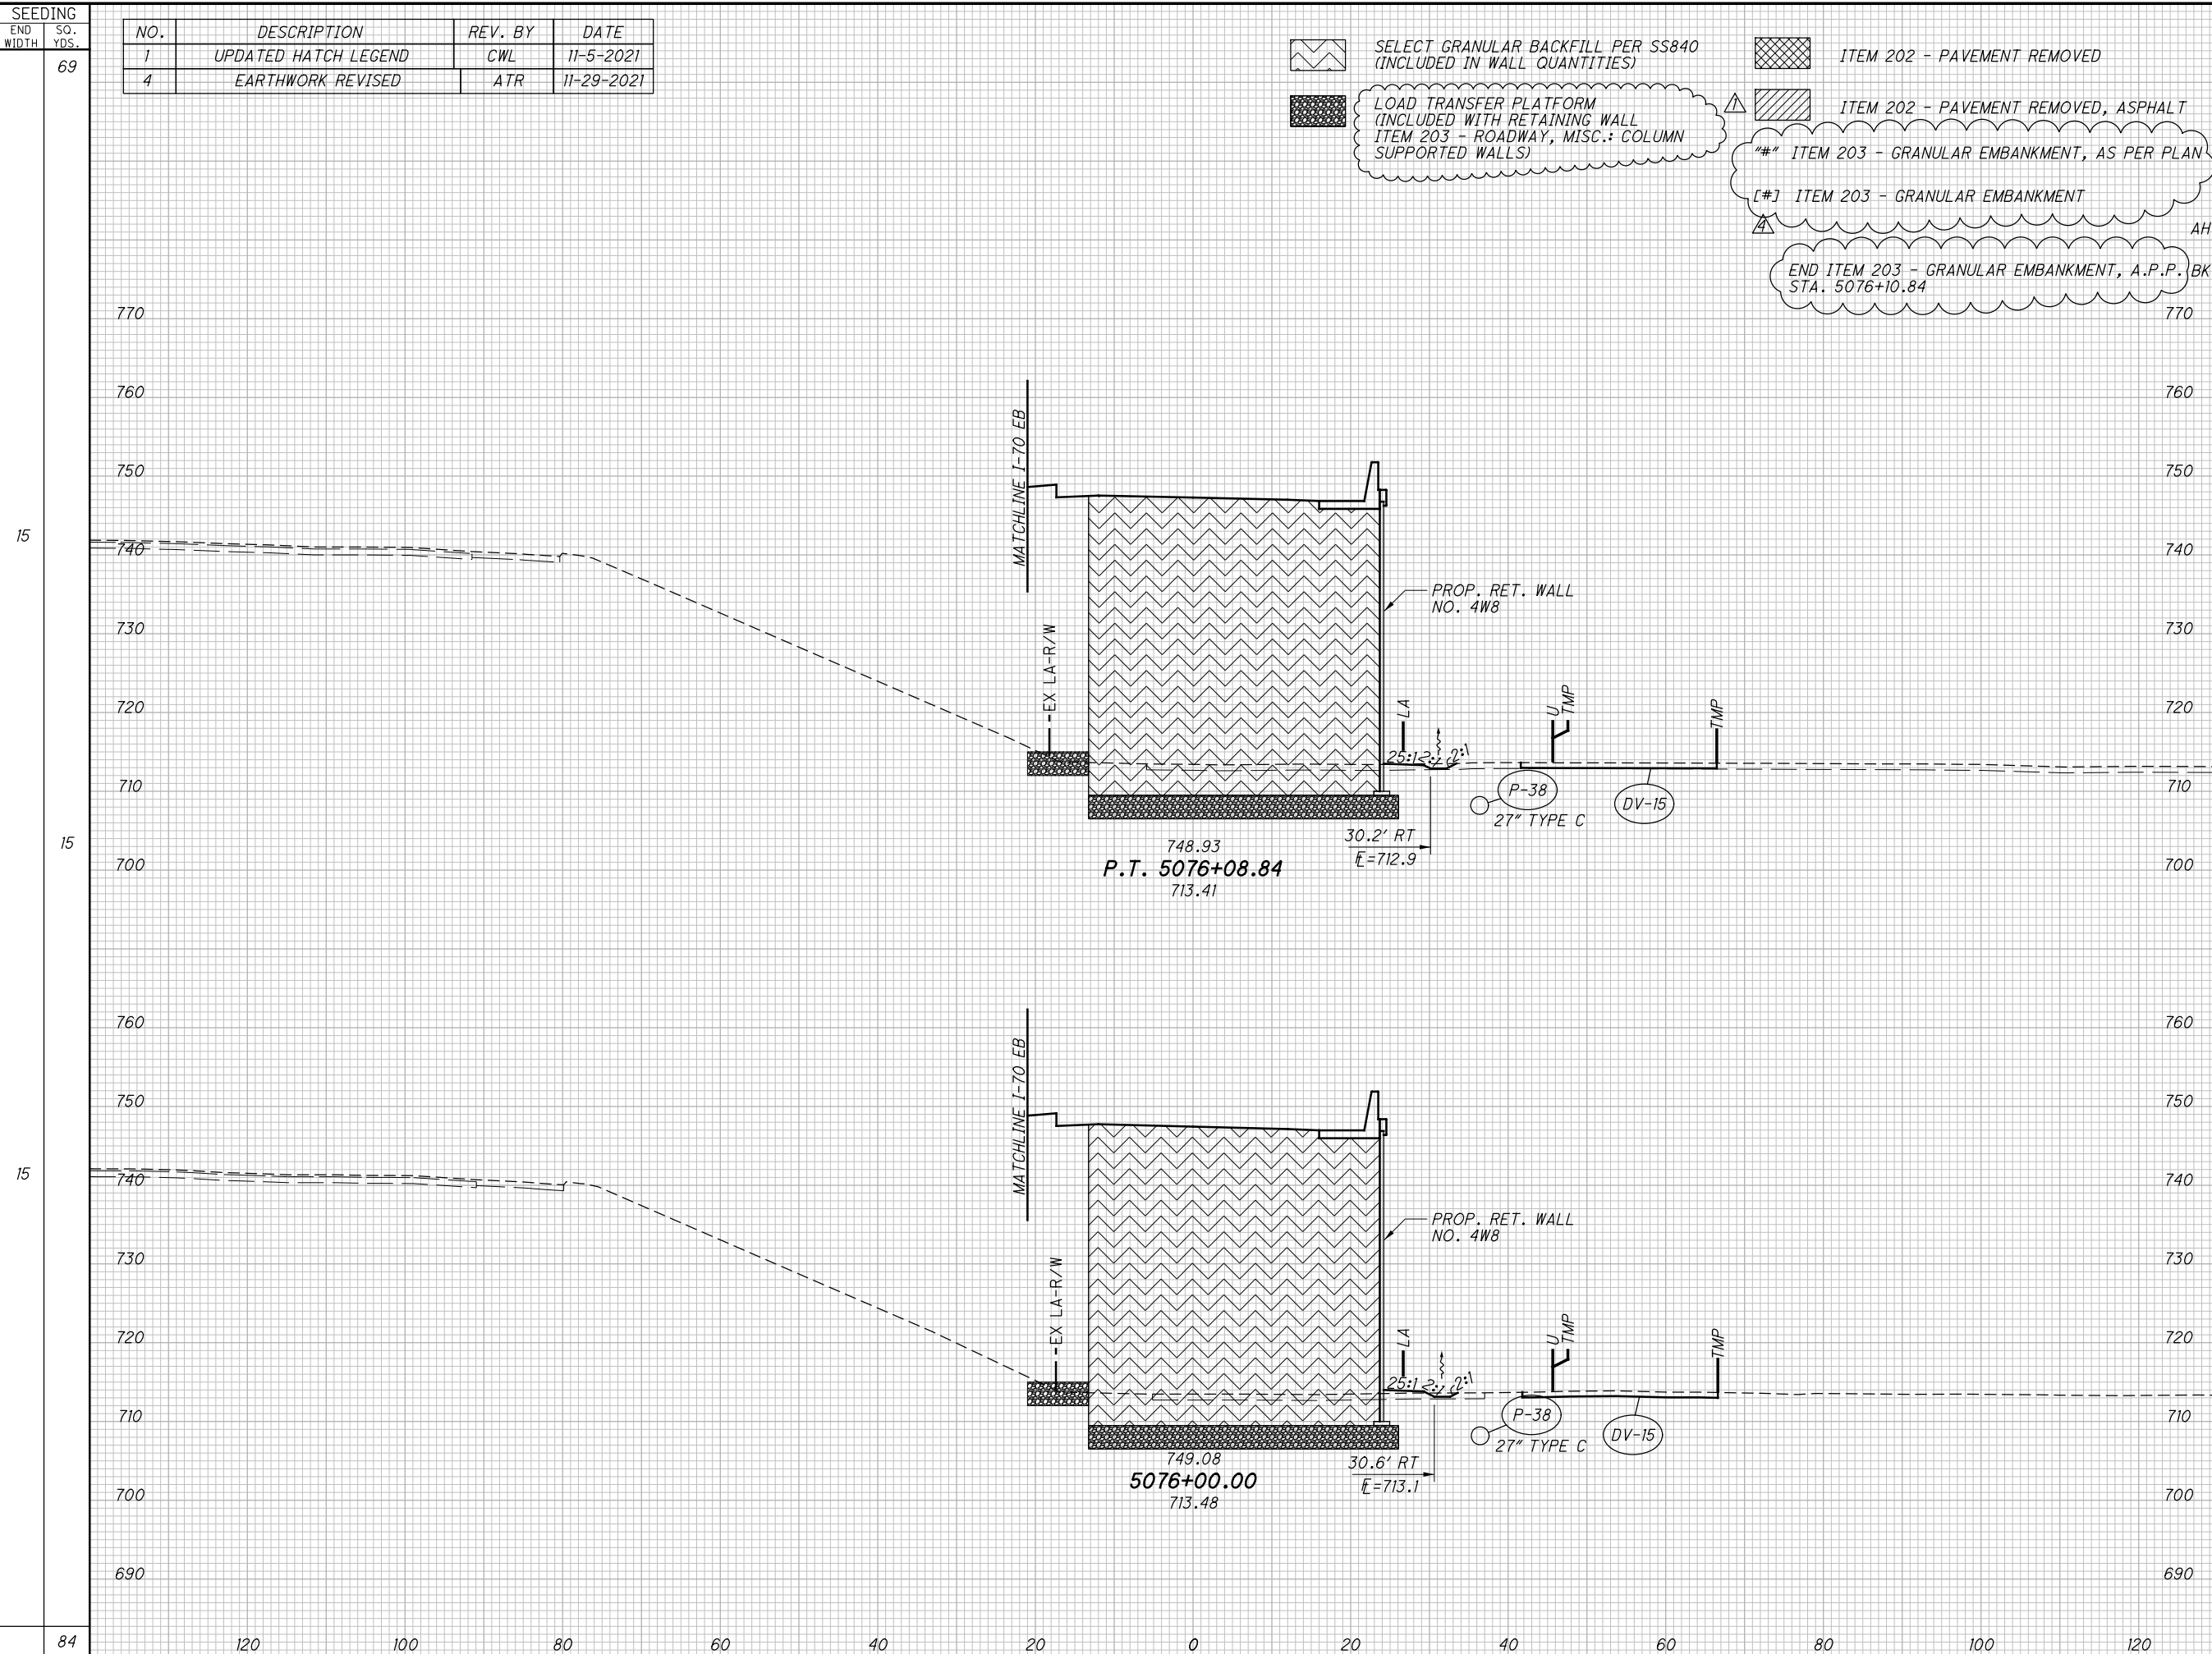D:\2012\2012048\FRA\105523\ROADWAY\105523\907.DGN
 11/24/2021 4:06:48 PM
 D:\105523\STD_USER




SEEDING	END WIDTH		SO. YDS.
	NO.	DESCRIPTION	
103	19	114	770
114	22	217	700

NO.	DESCRIPTION	REV. BY	DATE
1	UPDATED HATCH LEGEND	CWL	11-5-2021
4	EARTHWORK REVISED	ATR	11-29-2021

-  ITEM 202 - PAVEMENT REMOVED
-  ITEM 202 - PAVEMENT REMOVED, ASPHALT
-  SELECT GRANULAR BACKFILL PER SS840 (INCLUDED IN WALL QUANTITIES)
-  LOAD TRANSFER PLATFORM (INCLUDED WITH RETAINING WALL ITEM 203 - ROADWAY, MISC.: COLUMN SUPPORTED WALLS)

[#] ITEM 203 - GRANULAR EMBANKMENT

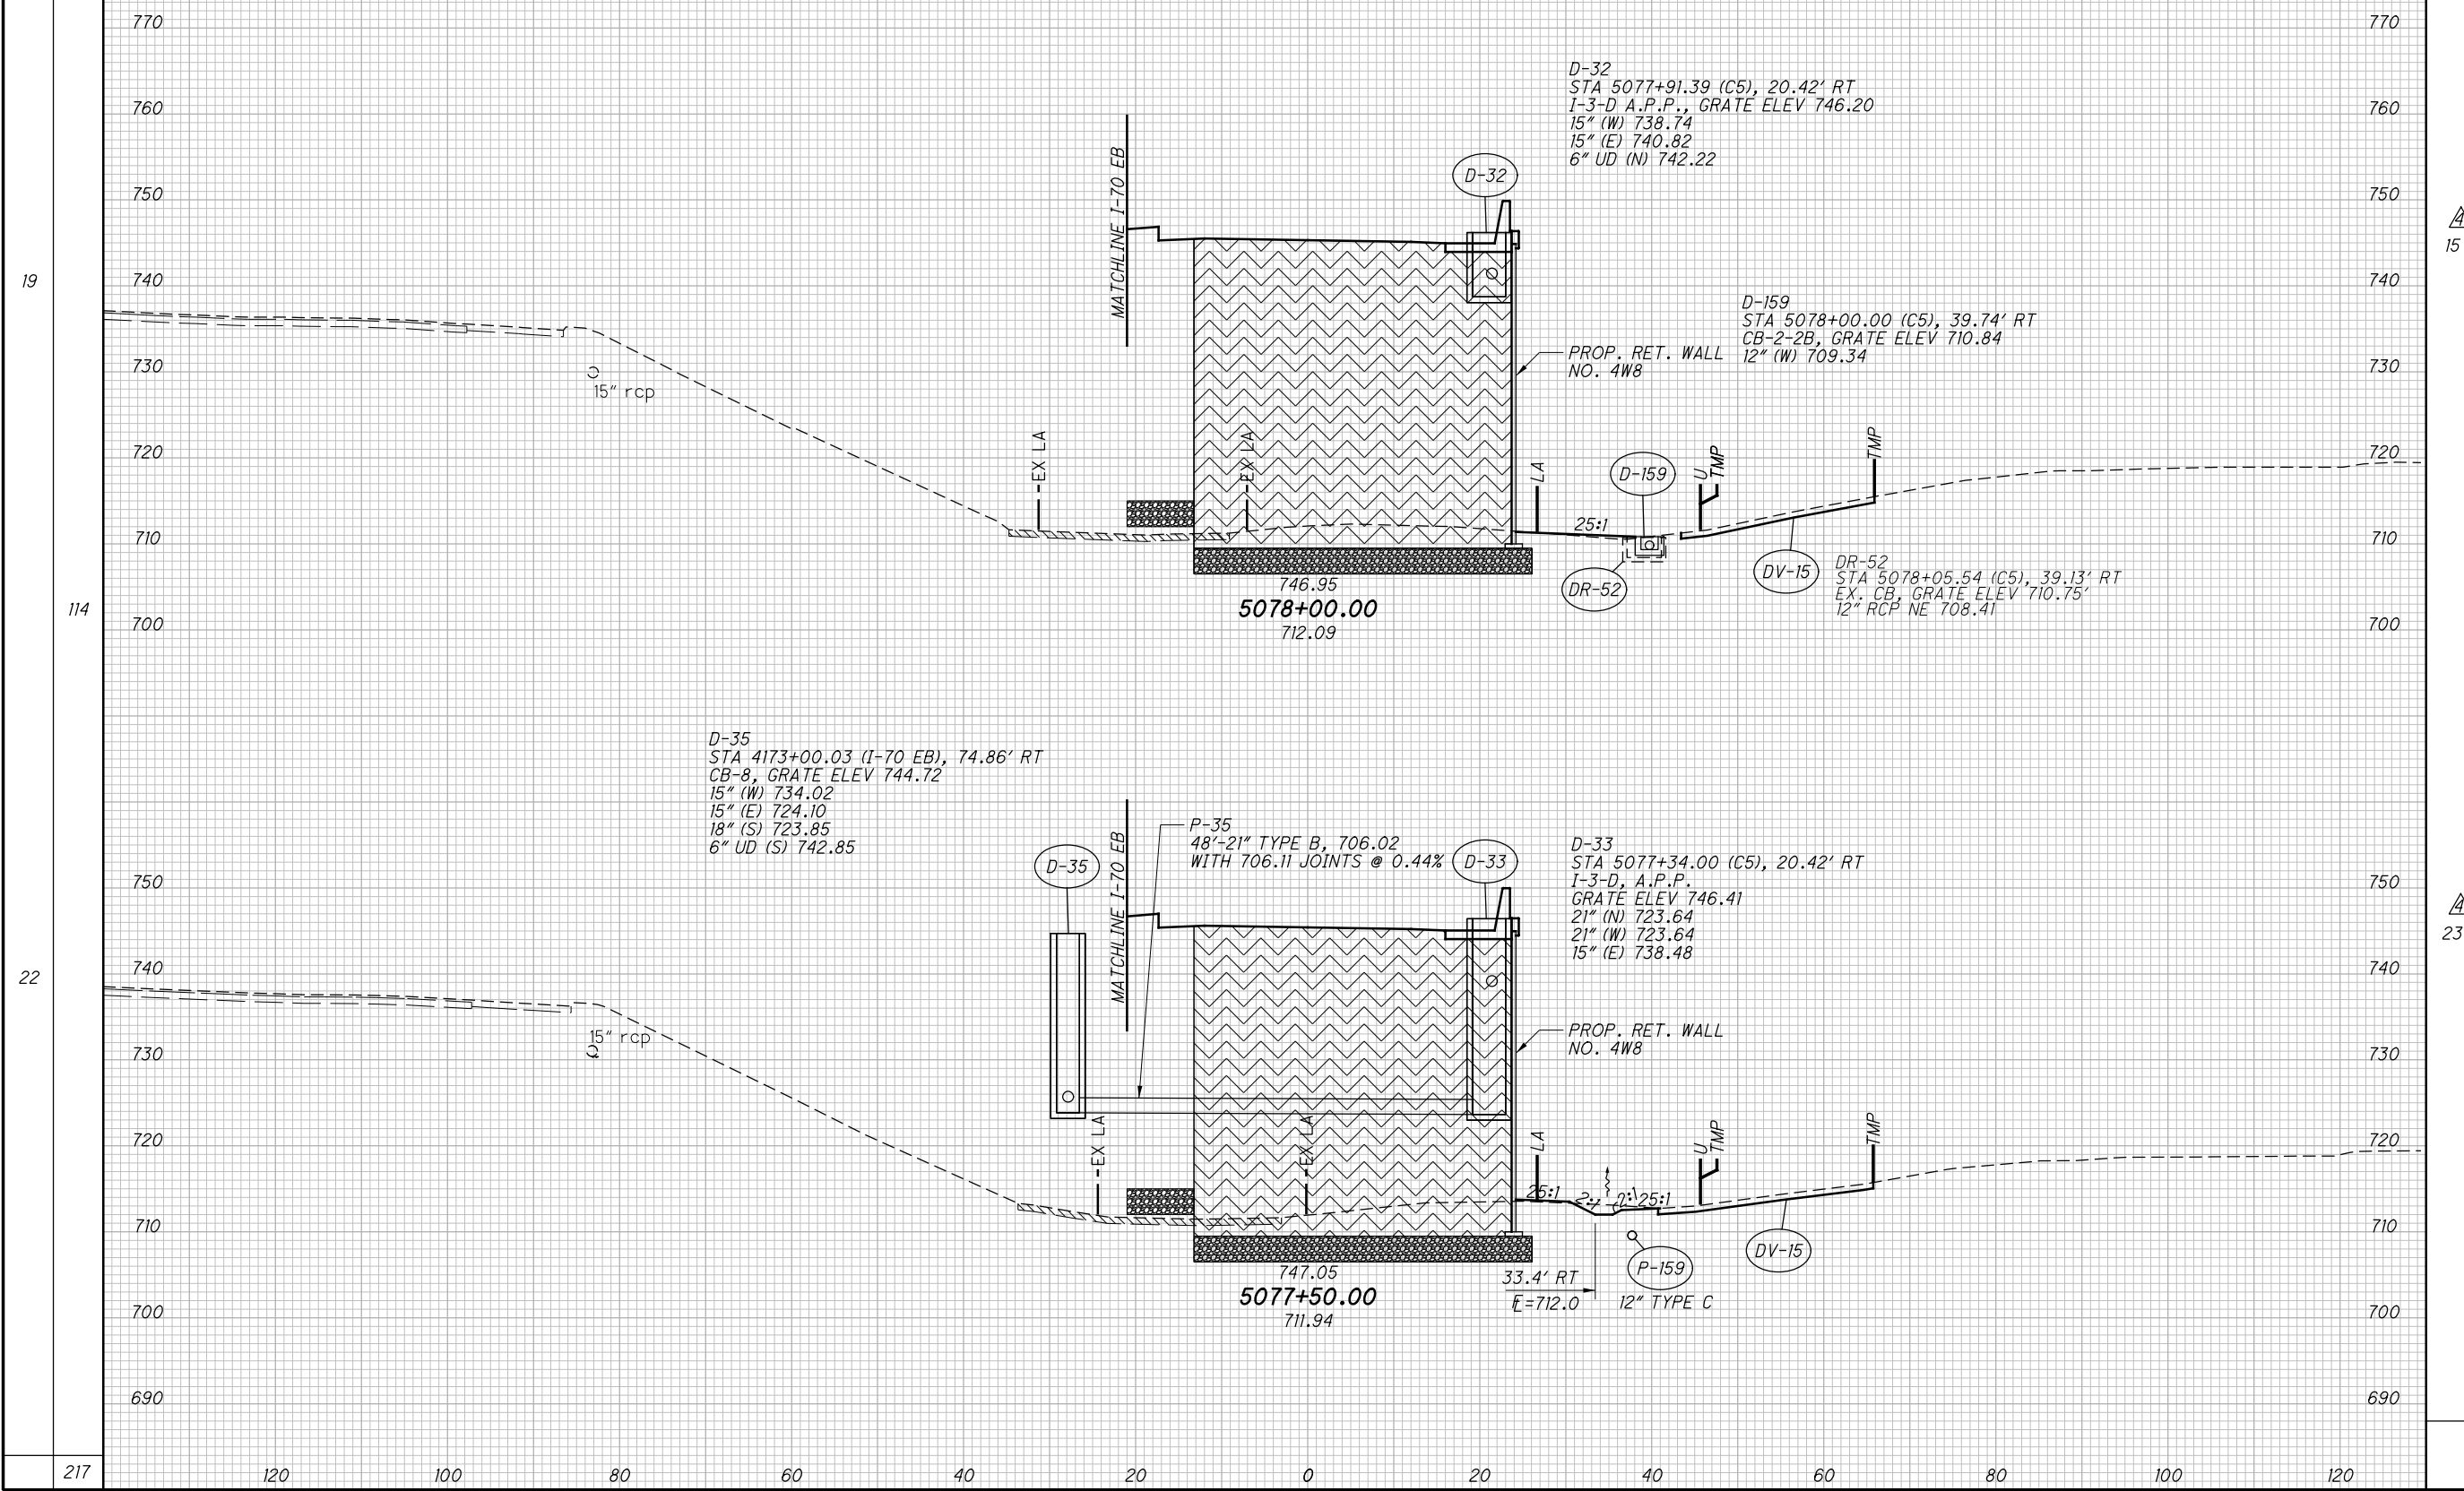

D-32
 STA 5077+91.39 (C5), 20.42' RT
 I-3-D A.P.P., GRATE ELEV 746.20
 15" (W) 738.74
 15" (E) 740.82
 6" UD (N) 742.22

D-159
 STA 5078+00.00 (C5), 39.74' RT
 CB-2-2B, GRATE ELEV 710.84
 12" (W) 709.34

DR-52
 STA 5078+05.54 (C5), 39.13' RT
 EX. CB, GRATE ELEV 710.75'
 12" RCP NE 708.41

D-35
 STA 4173+00.03 (I-70 EB), 74.86' RT
 CB-8, GRATE ELEV 744.72
 15" (W) 734.02
 15" (E) 724.10
 18" (S) 723.85
 6" UD (S) 742.85

P-35
 48"-21" TYPE B, 706.02
 WITH 706.11 JOINTS @ 0.44%

D-33
 STA 5077+34.00 (C5), 20.42' RT
 I-3-D, A.P.P.
 GRATE ELEV 746.41
 21" (N) 723.64
 21" (W) 723.64
 15" (E) 738.48

PROP. RET. WALL
 NO. 4W8

P-159
 33.4' RT
 E=712.0
 12" TYPE C




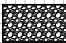
END AREA	VOLUME	CALCULATED	CHECKED
		26	
		33	
		15	
		23	
		10	
		49	
		68	
		490	
		1815	

CROSS SECTIONS - RAMP C5
 STA. 5077+50.00 TO STA. 5078+00.00
 FRA -70/ 71-12.68 / 14.86

SEEDING
END WIDTH SO. YDS.

NO.	DESCRIPTION	REV. BY	DATE
1	UPDATED HATCH LEGEND	CWL	11-5-2021
4	EARTHWORK REVISED	ATR	11-29-2021


[#] ITEM 203 - GRANULAR EMBANKMENT

-  ITEM 202 - PAVEMENT REMOVED
-  ITEM 202 - PAVEMENT REMOVED, ASPHALT
-  SELECT GRANULAR BACKFILL PER SS840 (INCLUDED IN WALL QUANTITIES)
-  LOAD TRANSFER PLATFORM (INCLUDED WITH RETAINING WALL ITEM 203 - ROADWAY, MISC.: COLUMN SUPPORTED WALLS)

END AREA	VOLUME		CALCULATED	CHECKED
	CUT	FILL		
			5	
			[84]	
			7	
			[177]	
			19	
			[389]	
			13	
			[243]	
			24	
			[473]	
			491	
			1815	

CROSS SECTIONS - RAMP C5
STA. 5078+50.00 TO STA. 5079+00.00

FRA -70/ 71-12.68 / 14.86

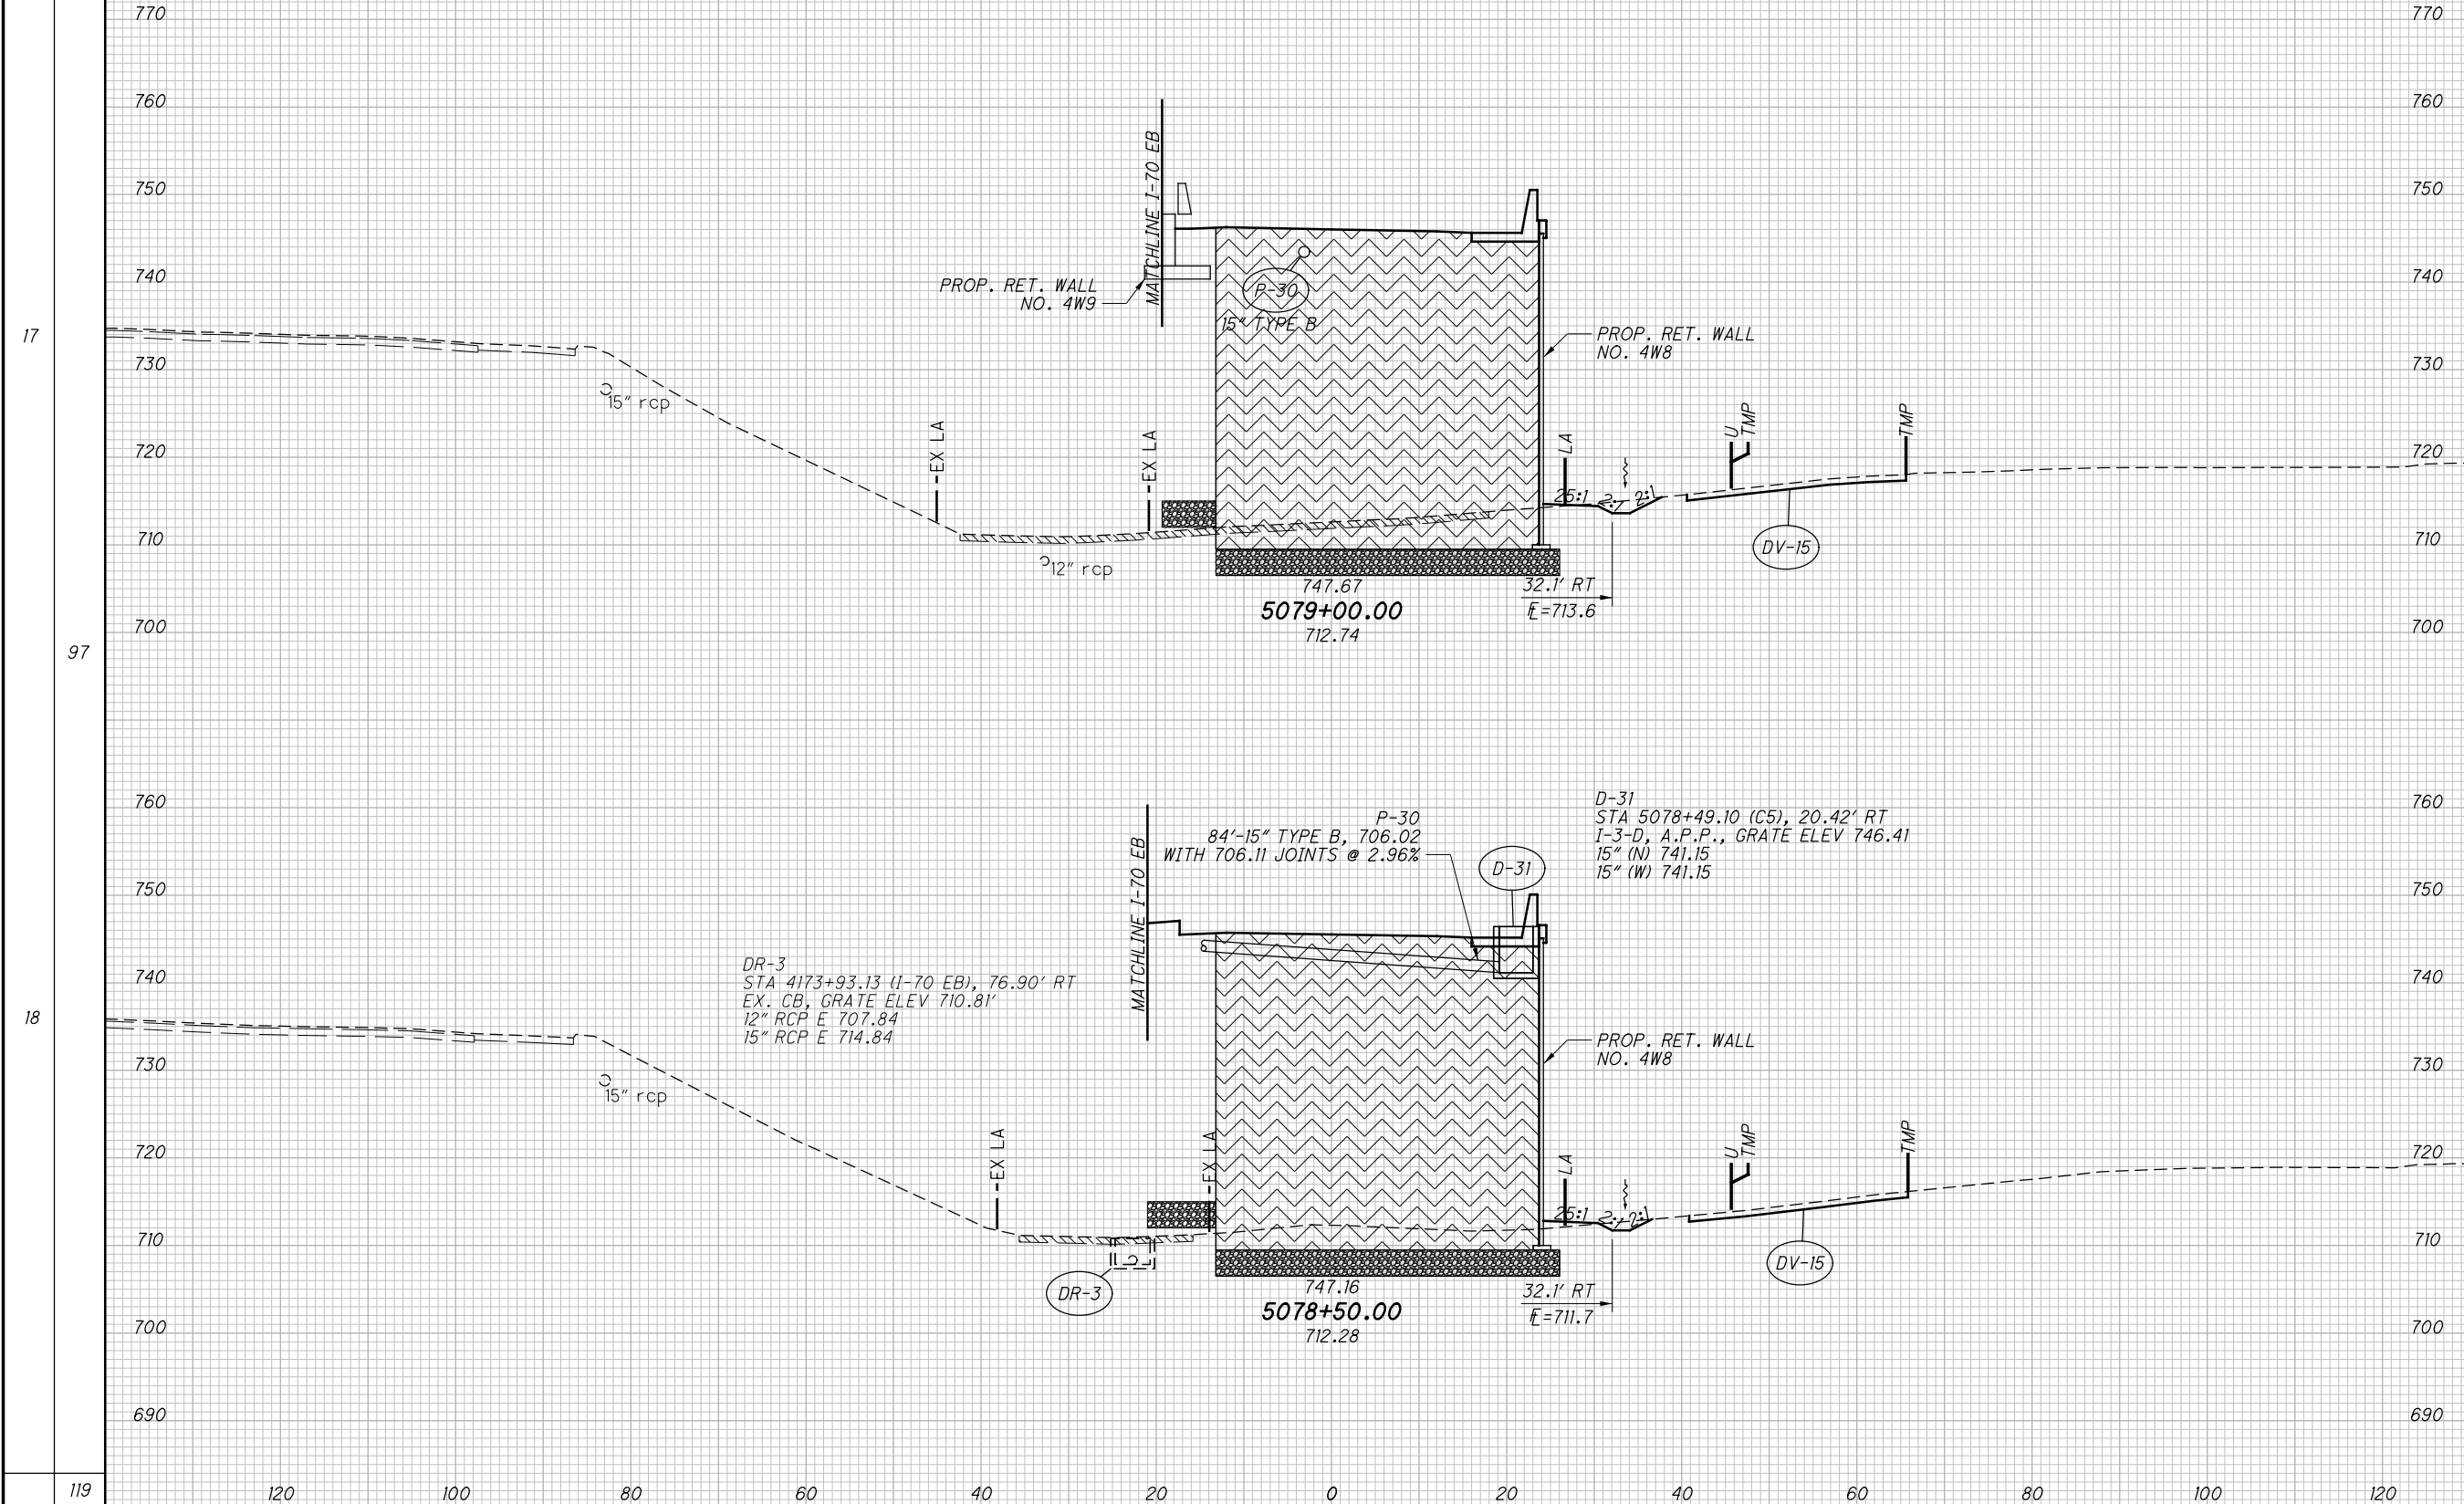

D:\2012\2012048\FRA\105523\ROADWAY\105523\907.DGN
11/24/2021
4:09:36 PM
D:\101\81\STD_USER


D:\2012\2012048\FRA\105523\ROADWAY\105523\907.DGN
 11/24/2021
 4:10:21 PM
 D:\101\81\STD_USER

SEEDING	END WIDTH		SO. YDS.	
	NO.	DESCRIPTION		
57	1	UPDATED HATCH LEGEND	CWL	11-5-2021
	4	EARTHWORK REVISED	ATR	11-29-2021

NO.	DESCRIPTION	REV. BY	DATE
1	UPDATED HATCH LEGEND	CWL	11-5-2021
4	EARTHWORK REVISED	ATR	11-29-2021

SELECT GRANULAR BACKFILL PER SS840 (INCLUDED IN WALL QUANTITIES)
 ITEM 202 - PAVEMENT REMOVED
 LOAD TRANSFER PLATFORM (INCLUDED WITH RETAINING WALL ITEM 203 - ROADWAY, MISC.: COLUMN SUPPORTED WALLS)
 ITEM 202 - PAVEMENT REMOVED, ASPHALT
 ITEM 203 - GRANULAR EMBANKMENT, AS PER PLAN
 [#] ITEM 203 - GRANULAR EMBANKMENT
 SUSPEND ITEM 203 - GRANULAR EMBANKMENT START ITEM 203 - GRANULAR EMBANKMENT, A.P.P. STA. 5079+95.31

10
50
14

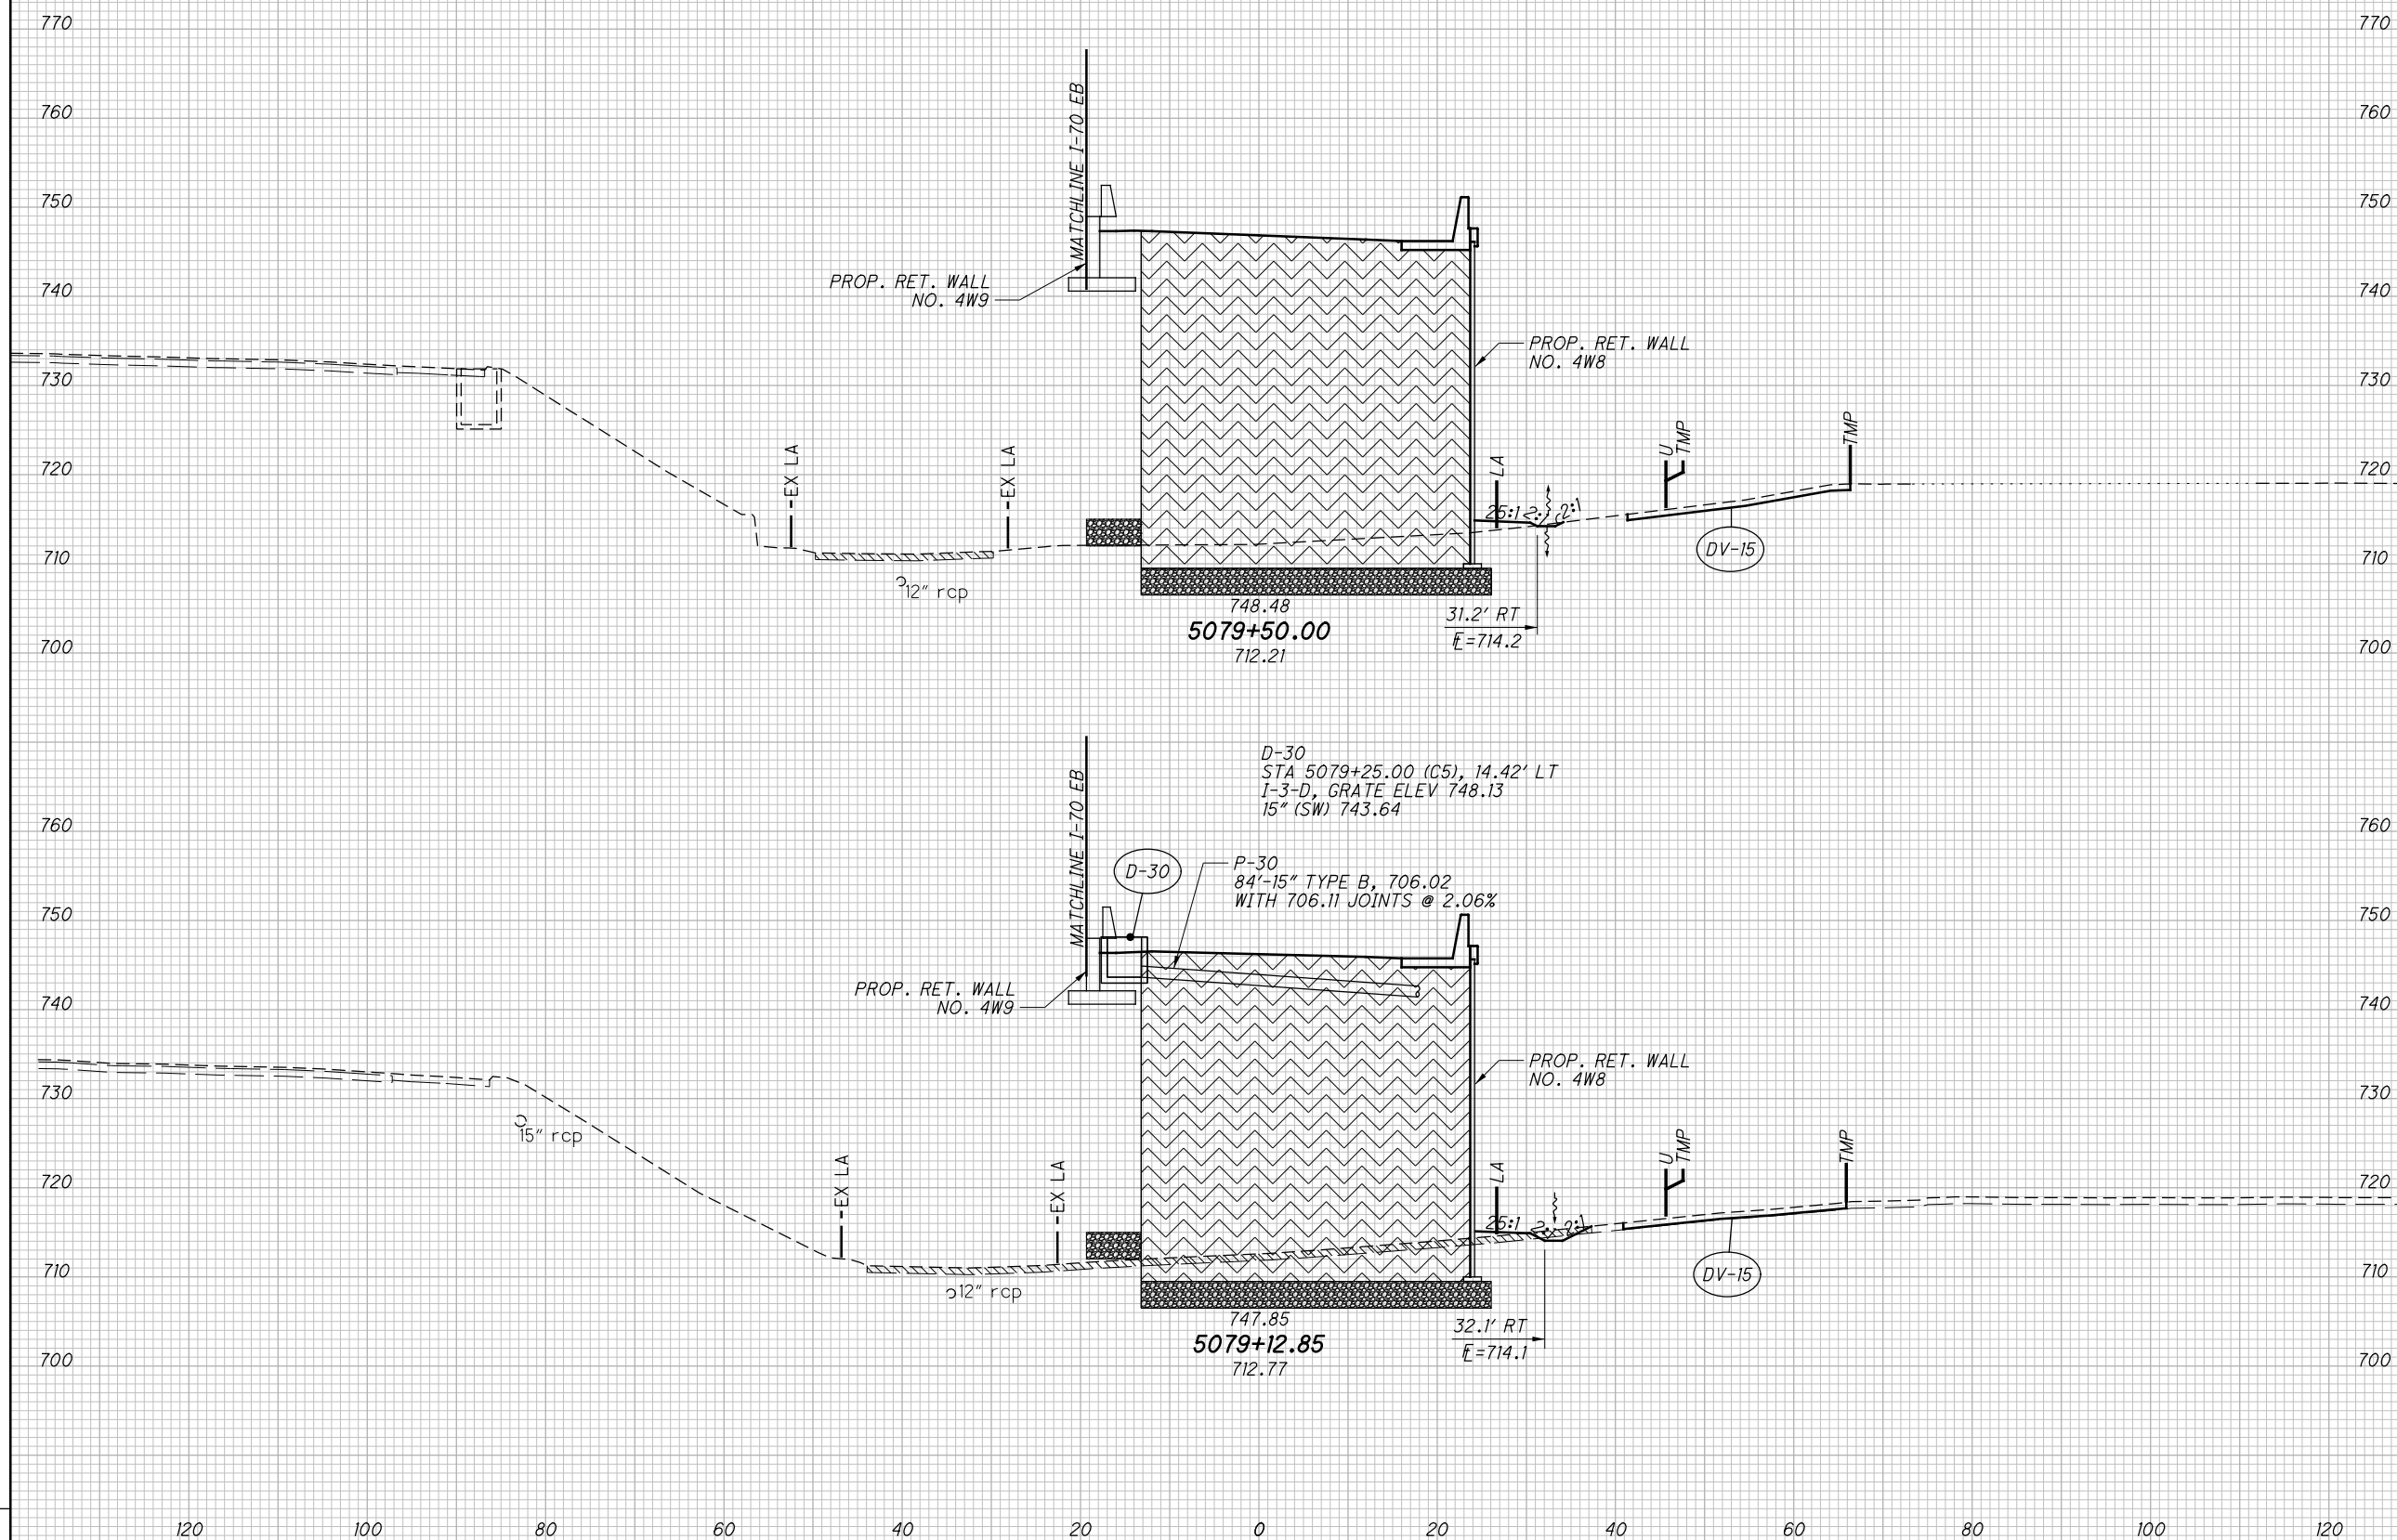






END AREA	VOLUME		CALCULATED	CHECKED
	CUT	FILL		
			33	32
			183	
			183	
			307	
			6	
			18	183
			13	
			28	248
			13	
			22	178
			13	
			61	555
			492	1815

CROSS SECTIONS - RAMP C5
 STA. 5079+12.85 TO STA. 5079+50.00
 FRA - 70/ 71-12.68 / 14.86

SEEDING
END WIDTH SO. YDS.
63

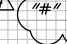NO.	DESCRIPTION	REV. BY	DATE
1	UPDATED HATCH LEGEND	CWL	11-5-2021
4	EARTHWORK REVISED	ATR	11-29-2021


-  ITEM 202 - PAVEMENT REMOVED
-  ITEM 202 - PAVEMENT REMOVED, ASPHALT
-  ITEM 203 - GRANULAR EMBANKMENT, AS PER PLAN
-  SELECT GRANULAR BACKFILL PER SS840 (INCLUDED IN WALL QUANTITIES)
-  LOAD TRANSFER PLATFORM (INCLUDED WITH RETAINING WALL ITEM 203 - ROADWAY, MISC.: COLUMN SUPPORTED WALLS)

END AREA	VOLUME		CALCULATED ATR	CHECKED CWL
	CUT	FILL		
42	34	2		
18				
18				
52				

CROSS SECTIONS - RAMP C5
STA. 5080+00.00 TO STA. 5080+15.86


FRA -70/ 71-12.68 / 14.86

493
1815

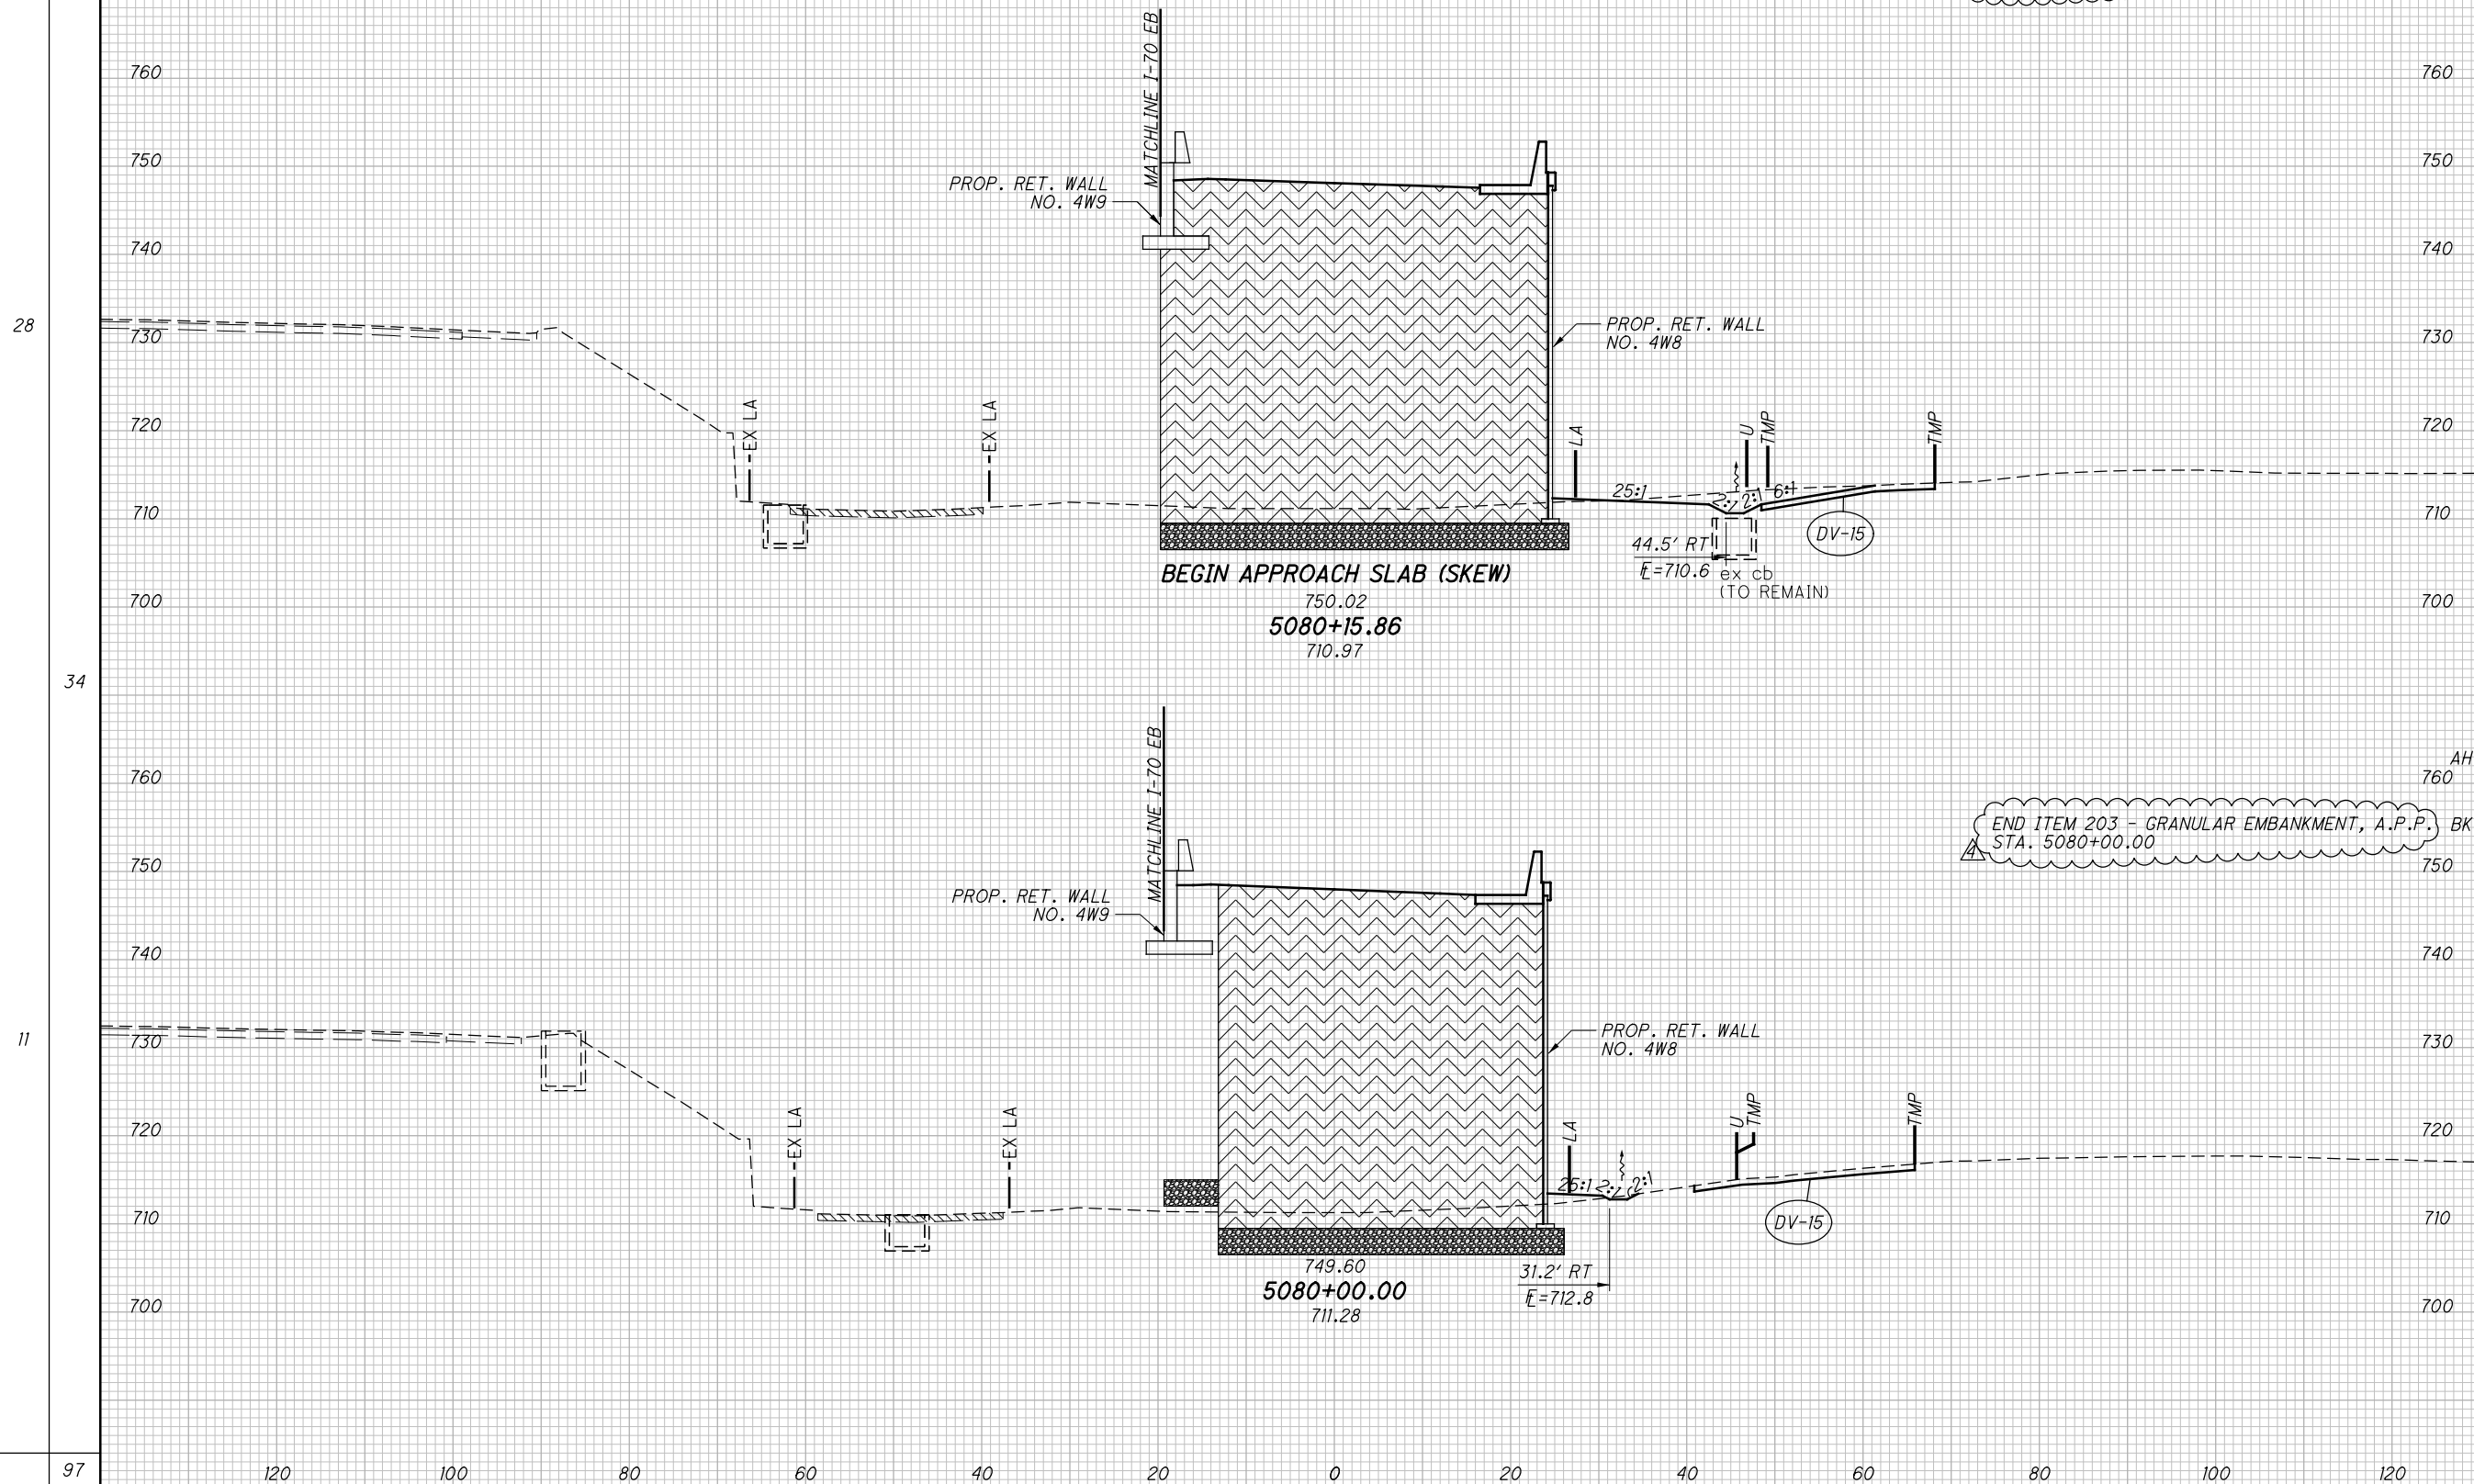

D:\2012\2012048\FRA\105523\ROADWAY\SHEETS\105523X907.DGN
 11/24/2021 4:11:13 PM
 D:\105523\STD_USER

D:\2021\2021048\FRA\105523\ROADWAY\SHEETS\105523\302.DGN
 11/23/2021 3:58:57 PM
 000TV81STD_USER

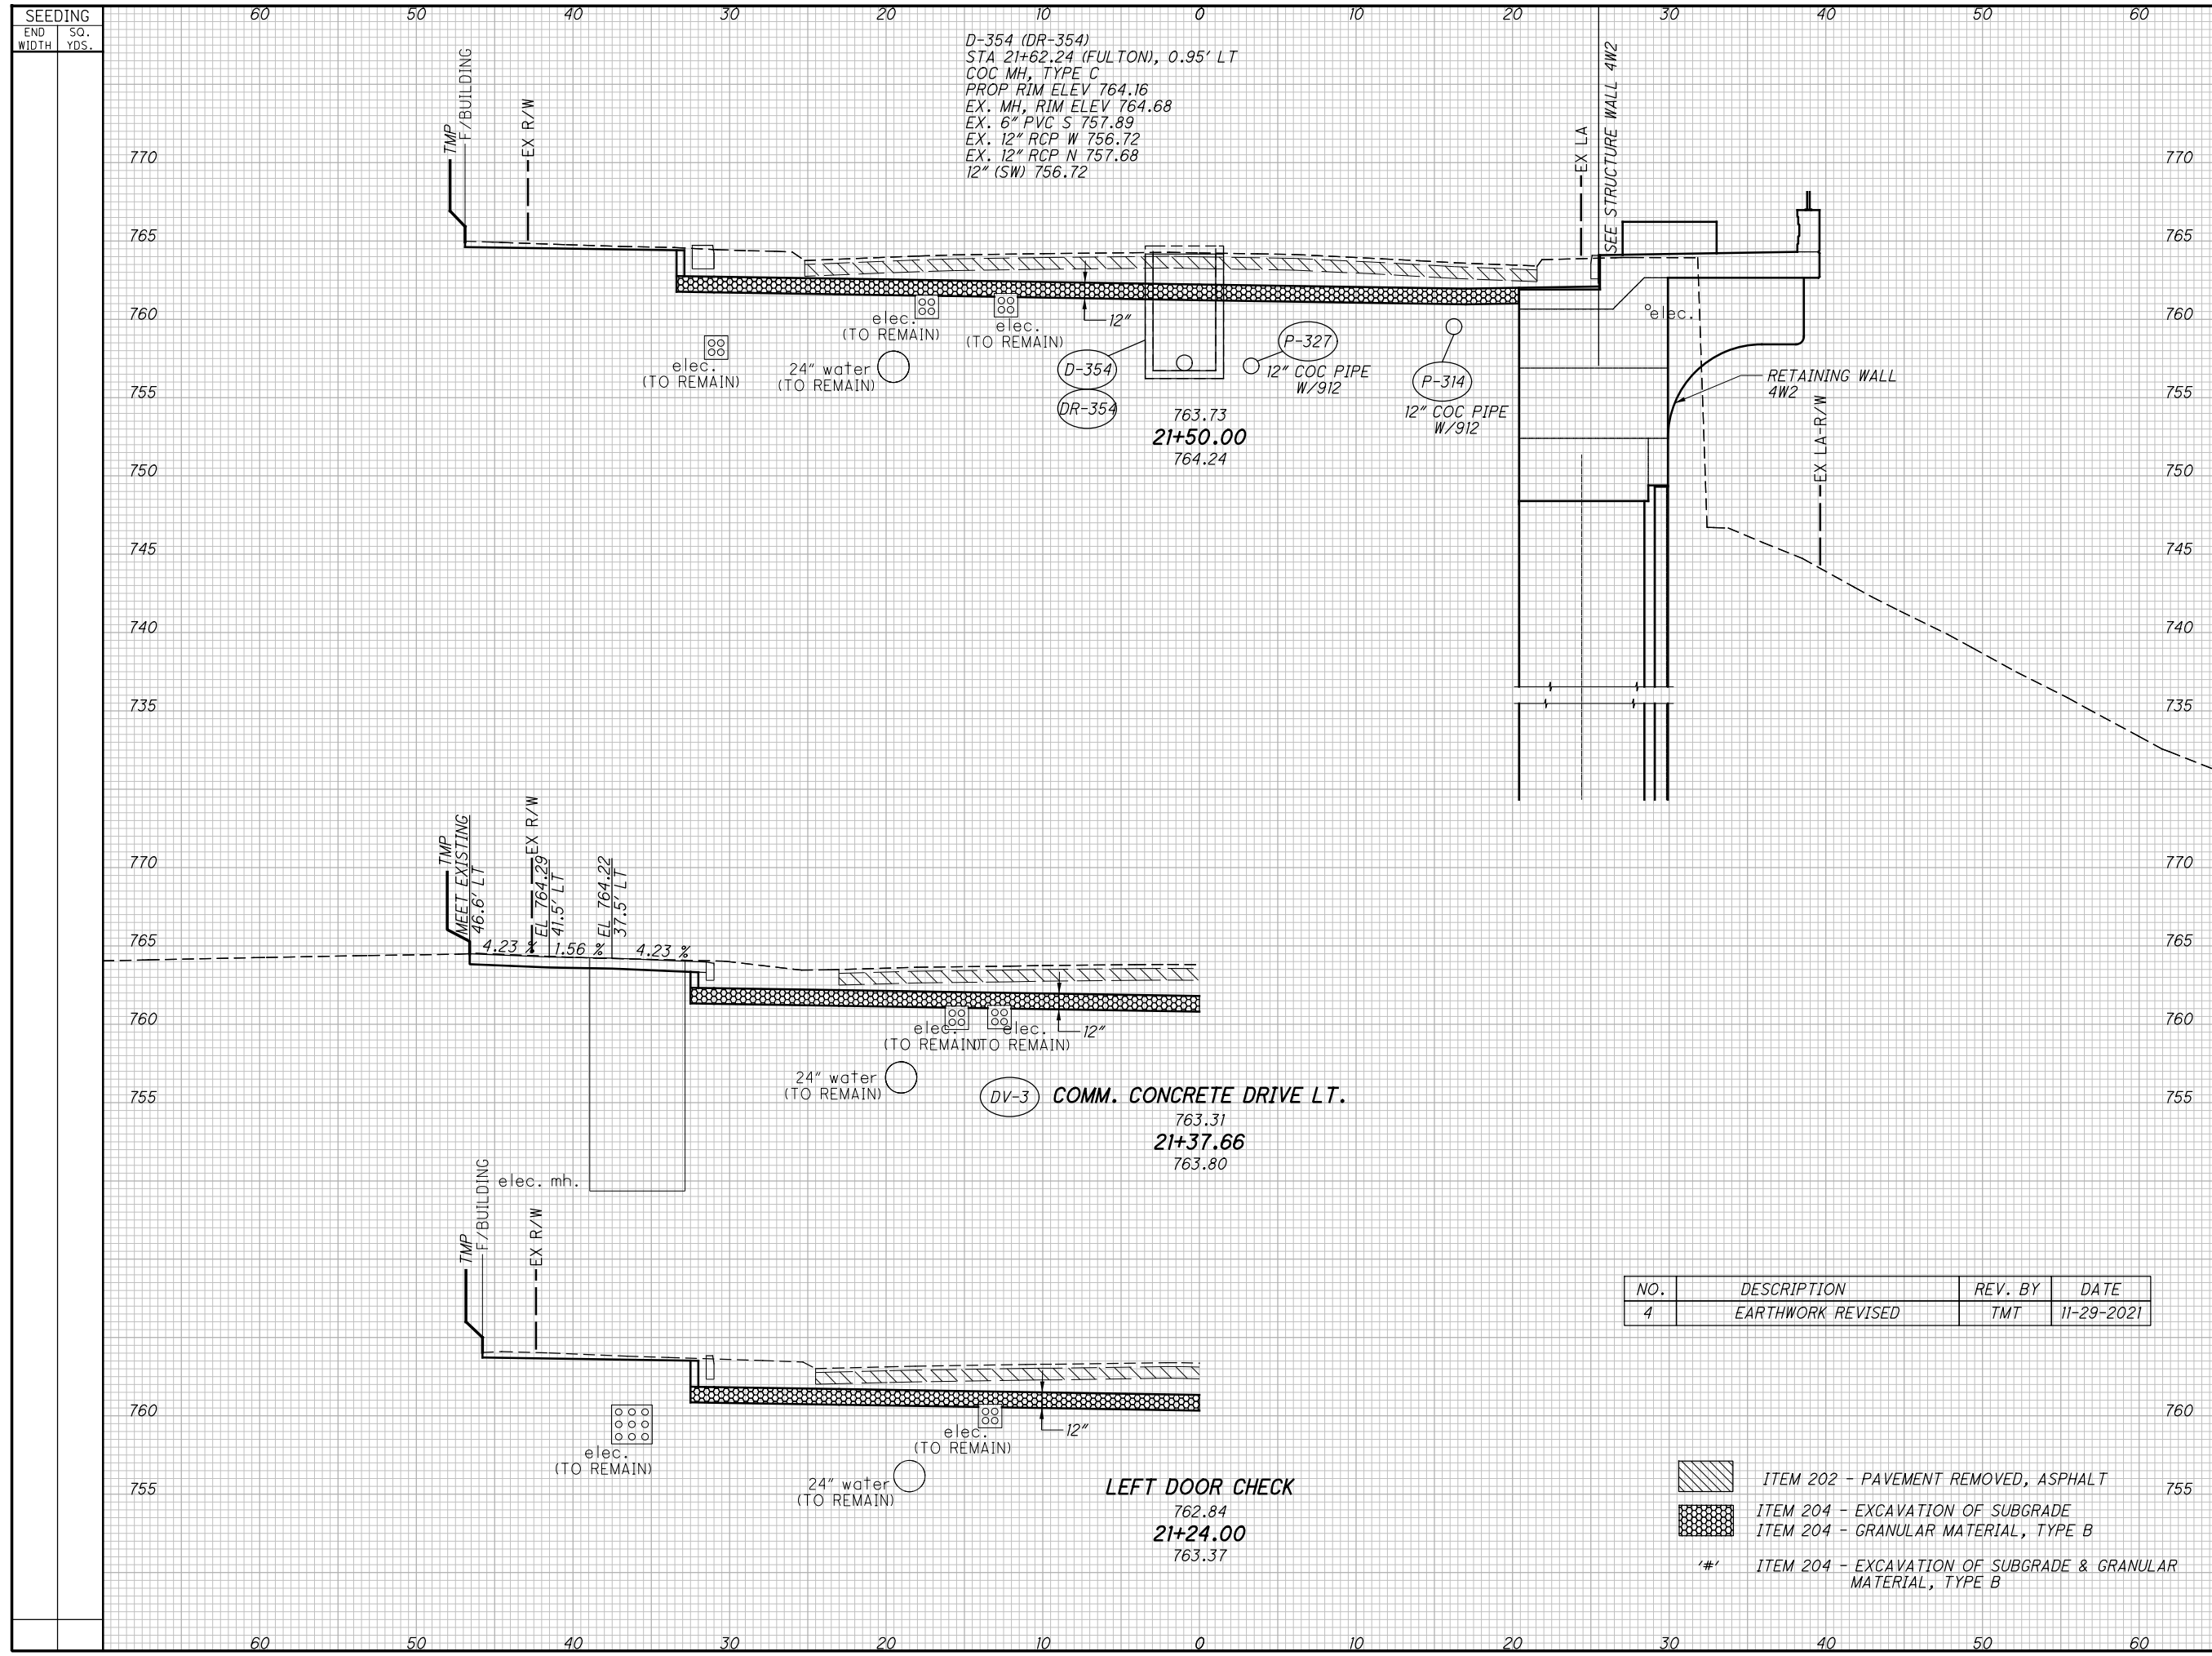

D-354 (DR-354)
 STA 21+62.24 (FULTON), 0.95' LT
 COC MH, TYPE C
 PROP RIM ELEV 764.16
 EX. MH, RIM ELEV 764.68
 EX. 6" PVC S 757.89
 EX. 12" RCP W 756.72
 EX. 12" RCP N 757.68
 12" (SW) 756.72

DV-3 COMM. CONCRETE DRIVE LT.
 763.31
 21+37.66
 763.80

LEFT DOOR CHECK
 762.84
 21+24.00
 763.37


NO.	DESCRIPTION	REV. BY	DATE
4	EARTHWORK REVISED	TMT	11-29-2021

- ITEM 202 - PAVEMENT REMOVED, ASPHALT
- ITEM 204 - EXCAVATION OF SUBGRADE
ITEM 204 - GRANULAR MATERIAL, TYPE B
- #/ ITEM 204 - EXCAVATION OF SUBGRADE & GRANULAR MATERIAL, TYPE B

END AREA	VOLUME		CALCULATED	TMT	CHECKED	CWL
	CUT	FILL				
'53'	44	'53'	2			
'104'	83	'104'	52			
						510 1815

CROSS SECTIONS FULTON ST.
 STA. 21+24.00 TO STA. 21+50.00

FRA - 70 / 71 - 12.68 / 14.86

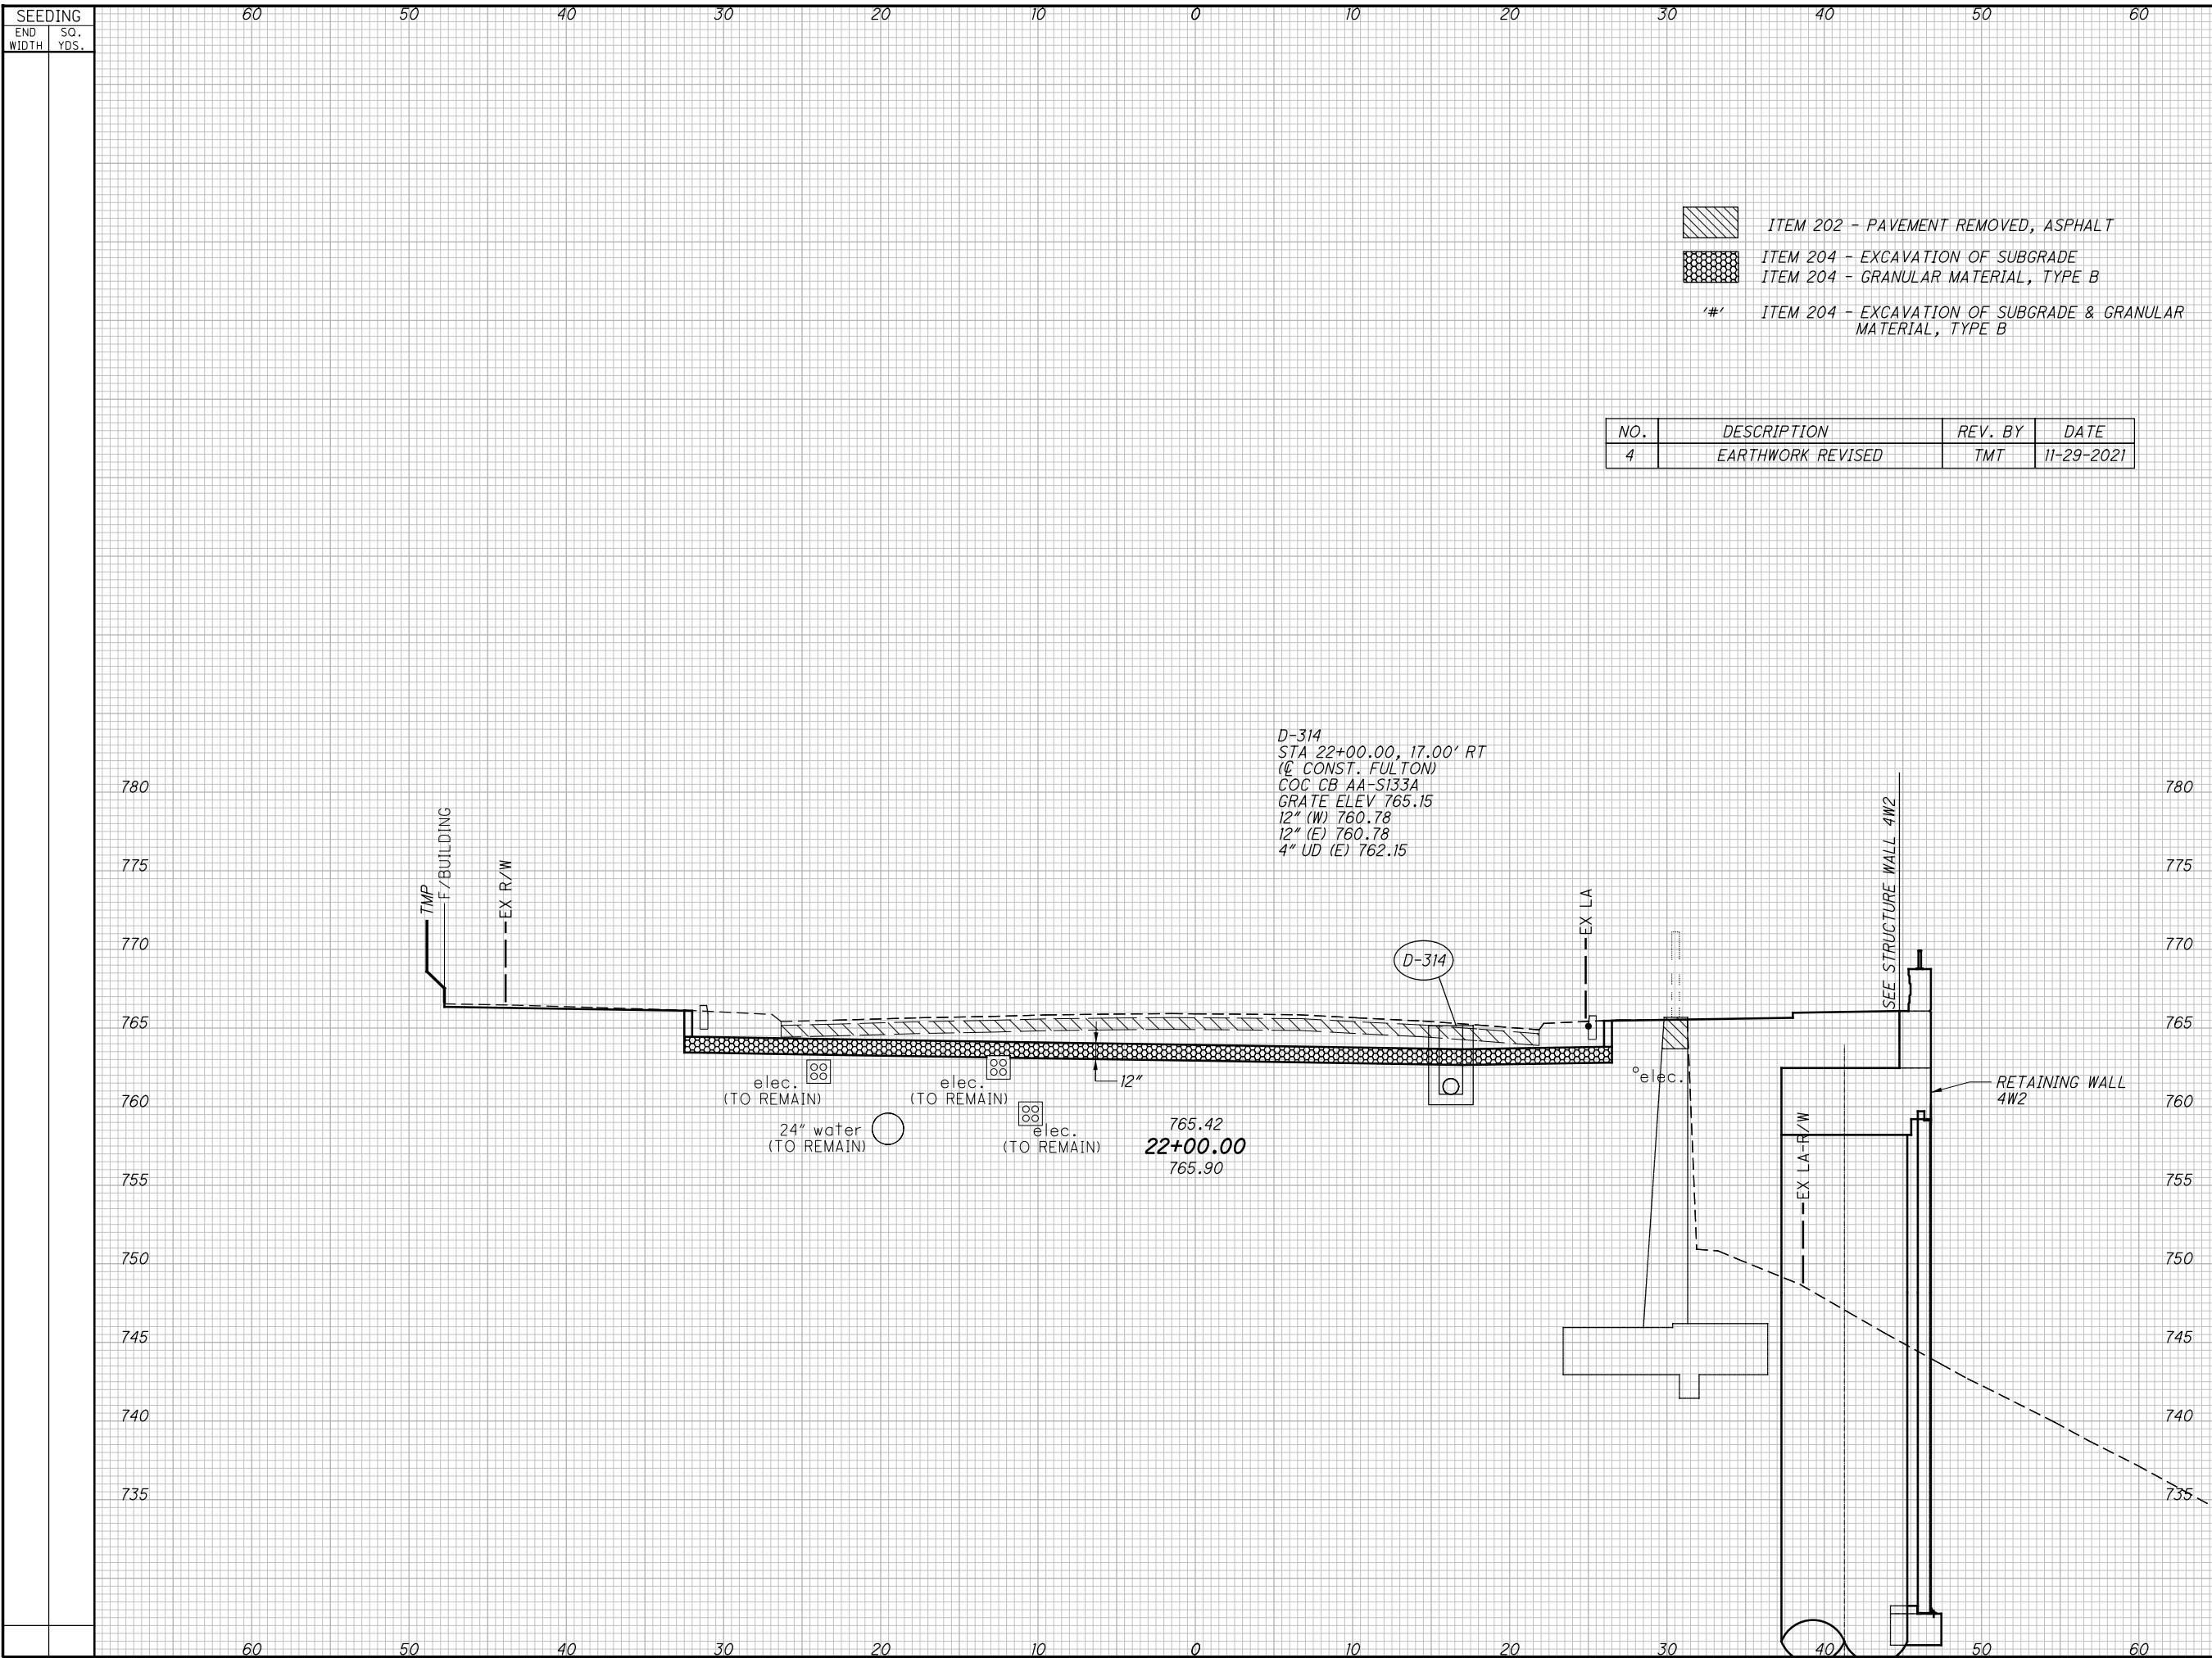

- ITEM 202 - PAVEMENT REMOVED, ASPHALT
- ITEM 204 - EXCAVATION OF SUBGRADE
ITEM 204 - GRANULAR MATERIAL, TYPE B
- ITEM 204 - EXCAVATION OF SUBGRADE & GRANULAR MATERIAL, TYPE B


NO.	DESCRIPTION	REV. BY	DATE
4	EARTHWORK REVISED	TMT	11-29-2021

END AREA	VOLUME		CALCULATED TMT	CHECKED CWL
	CUT	FILL		
	108'	108'	73	108
	45	59'	54	
	108'	108'	73	108
				511
				1815

**CROSS SECTIONS FULTON ST.
 STA. 22+00.00**

FRA - 70 / 71 - 12.68 / 14.86

D:\2021\20212048\FRA\105523\ROADWAY\SHEETS\105523\302.DGN
 11/23/2021
 4:01:13 PM
 000TV81STD_USER

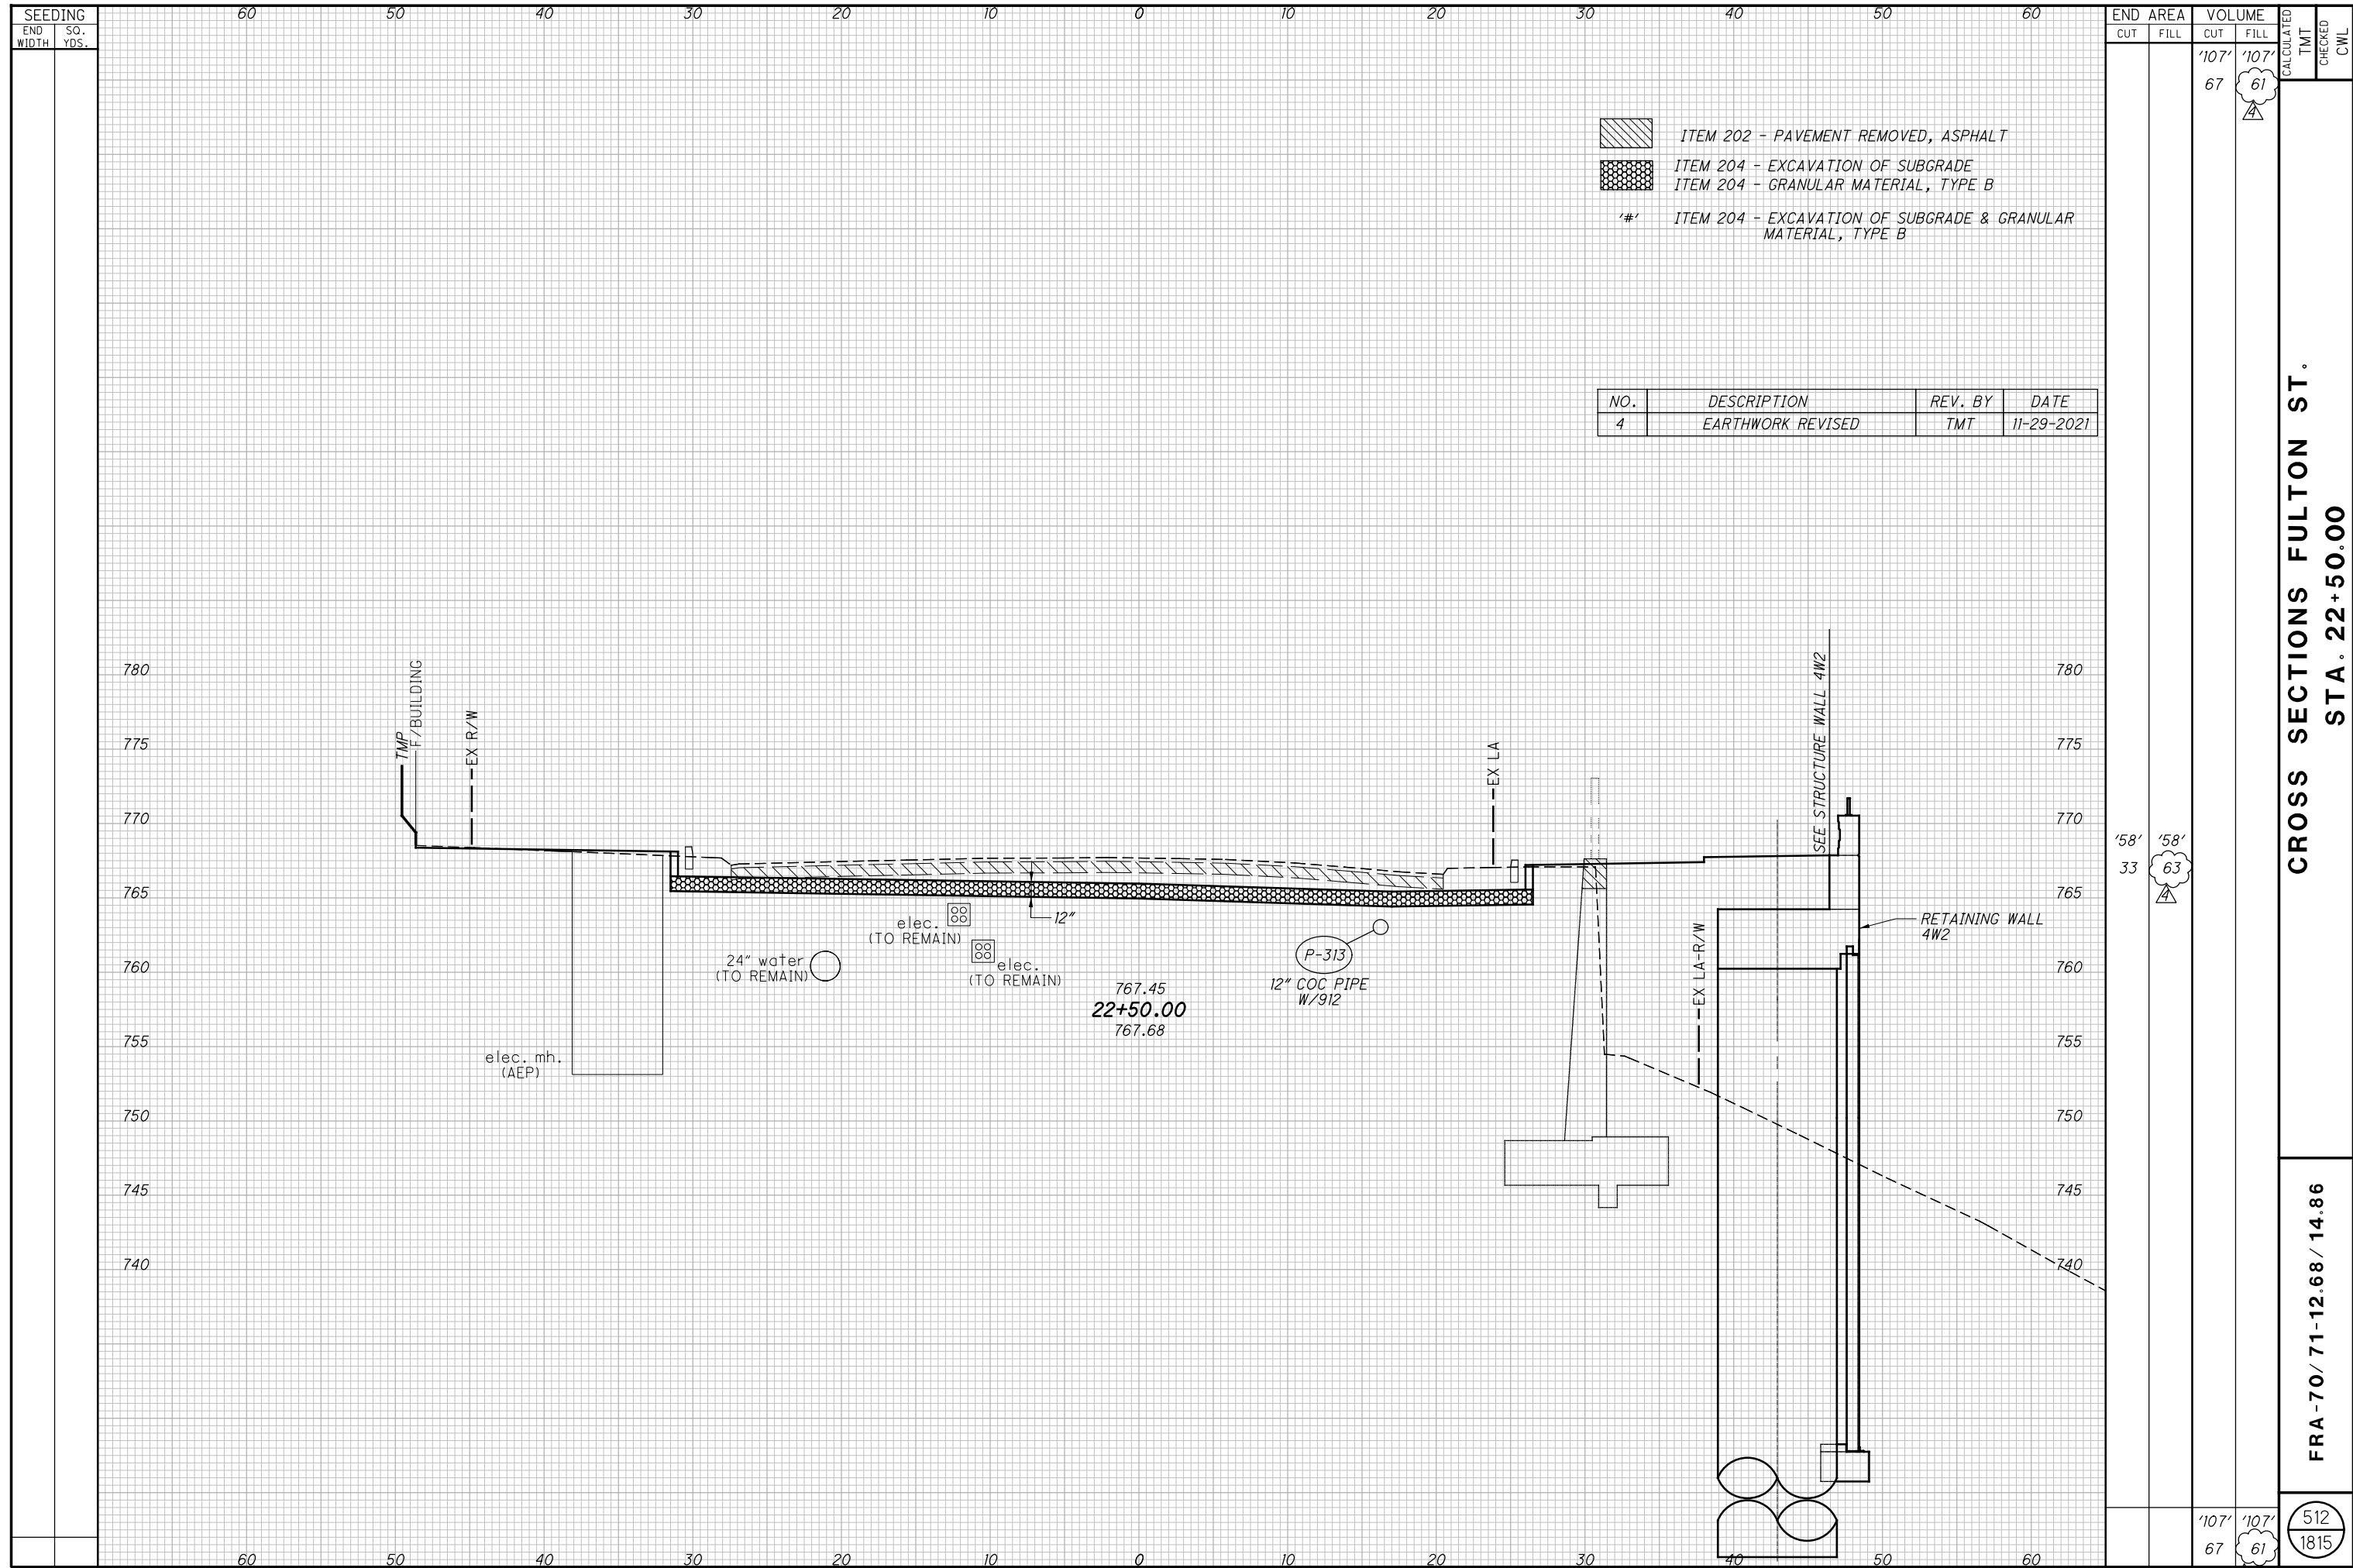


NO.	DESCRIPTION	REV. BY	DATE
4	EARTHWORK REVISED	TMT	11-29-2021

- ITEM 202 - PAVEMENT REMOVED, ASPHALT
- ITEM 204 - EXCAVATION OF SUBGRADE
- ITEM 204 - GRANULAR MATERIAL, TYPE B
- '#' ITEM 204 - EXCAVATION OF SUBGRADE & GRANULAR MATERIAL, TYPE B

END AREA	VOLUME		CALCULATED TMT	CHECKED CWL
	CUT	FILL		
	67	61		
CROSS SECTIONS FULTON ST. STA. 22+50.00				
	67	61		
			512	1815

FRA - 70 / 71 - 12.68 / 14.86

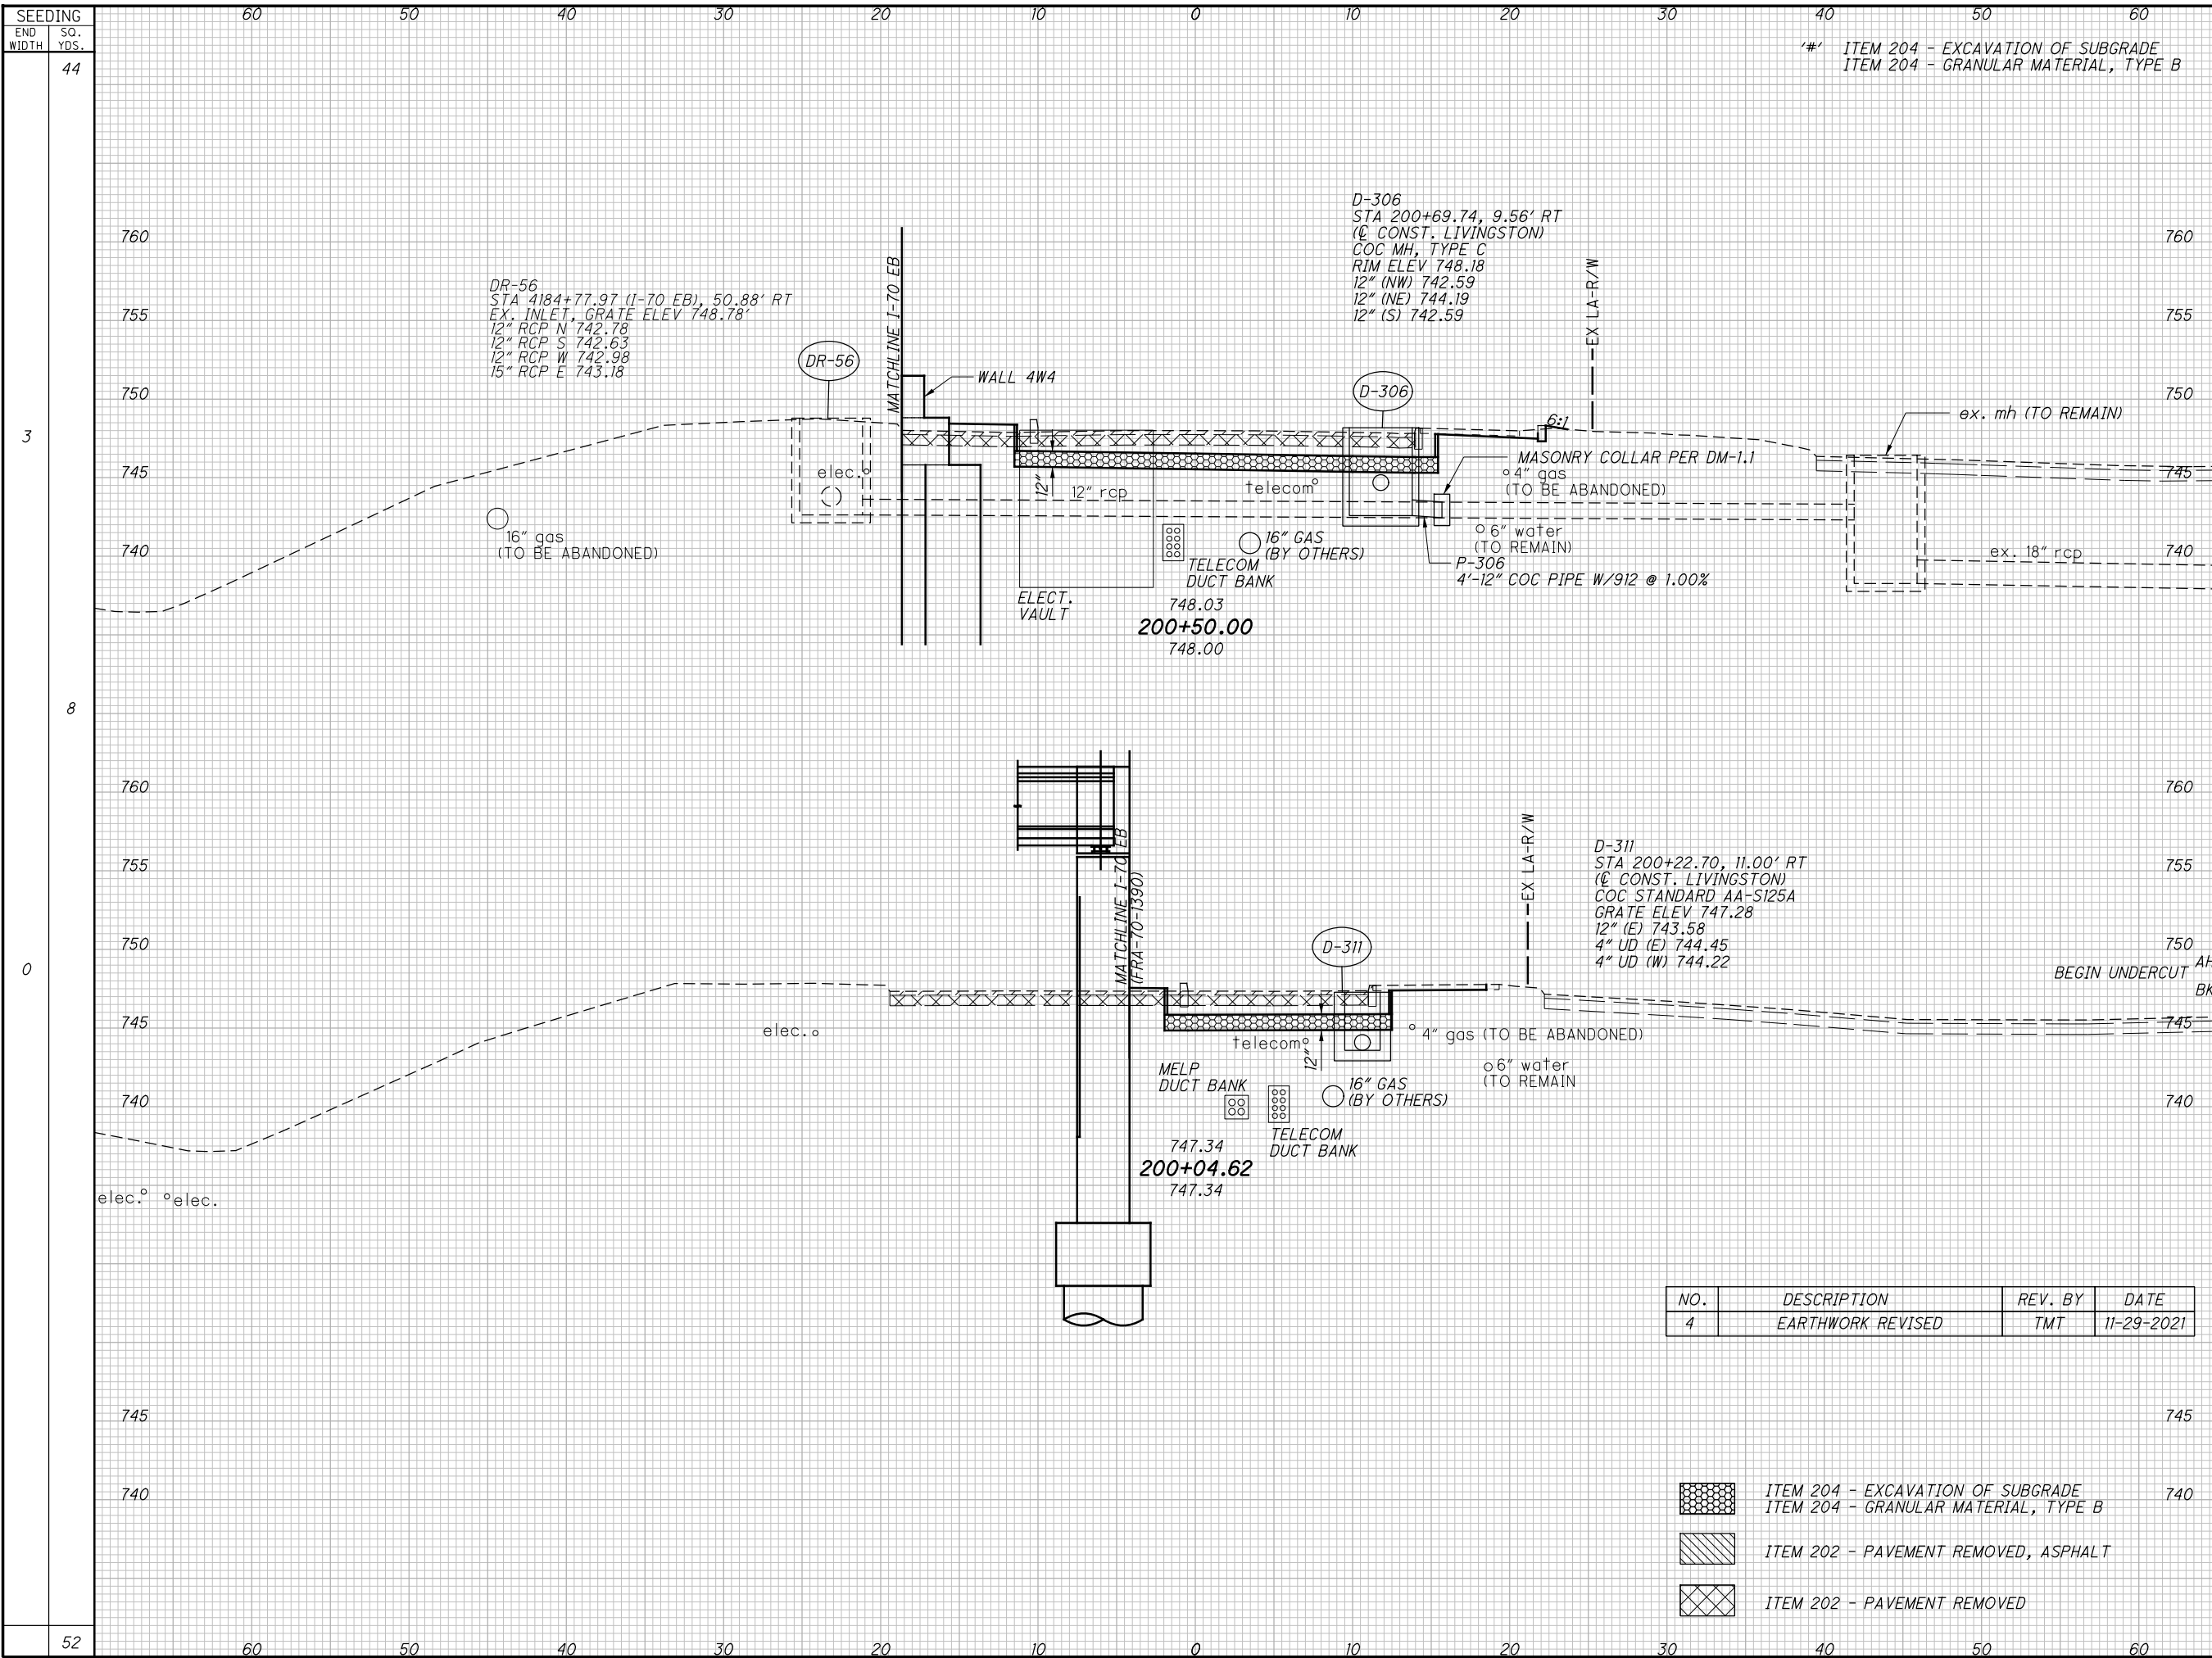

#' ITEM 204 - EXCAVATION OF SUBGRADE
 ITEM 204 - GRANULAR MATERIAL, TYPE B

END AREA	VOLUME		CALCULATED	JMB	CHECKED	TMT
	CUT	FILL				
'49'	'49'	'20'				
29	29	20				
'27'	'27'	'6'				
16	16	6				
'35'	'35'	'8'				
21	21	8				
'15'	'15'	'15'				
BK	BK	'0'				
9	9	3				
'84'	'84'	'28'				
50	50	28				

CROSS SECTIONS LIVINGSTON AVENUE
 STA. 200+00.00 TO STA. 200+50.00


FRA - 70/ 71-12.68 / 14.86

514
1815

NO.	DESCRIPTION	REV. BY	DATE
4	EARTHWORK REVISED	TMT	11-29-2021

- ITEM 204 - EXCAVATION OF SUBGRADE
 ITEM 204 - GRANULAR MATERIAL, TYPE B
- ITEM 202 - PAVEMENT REMOVED, ASPHALT
- ITEM 202 - PAVEMENT REMOVED

D:\2021\2021\2048\FRA\105523\ROADWAY\SHEETS\105523\300B.DGN
 11/23/2021
 4:15:18 PM
 GDDTV81STD.LUSER

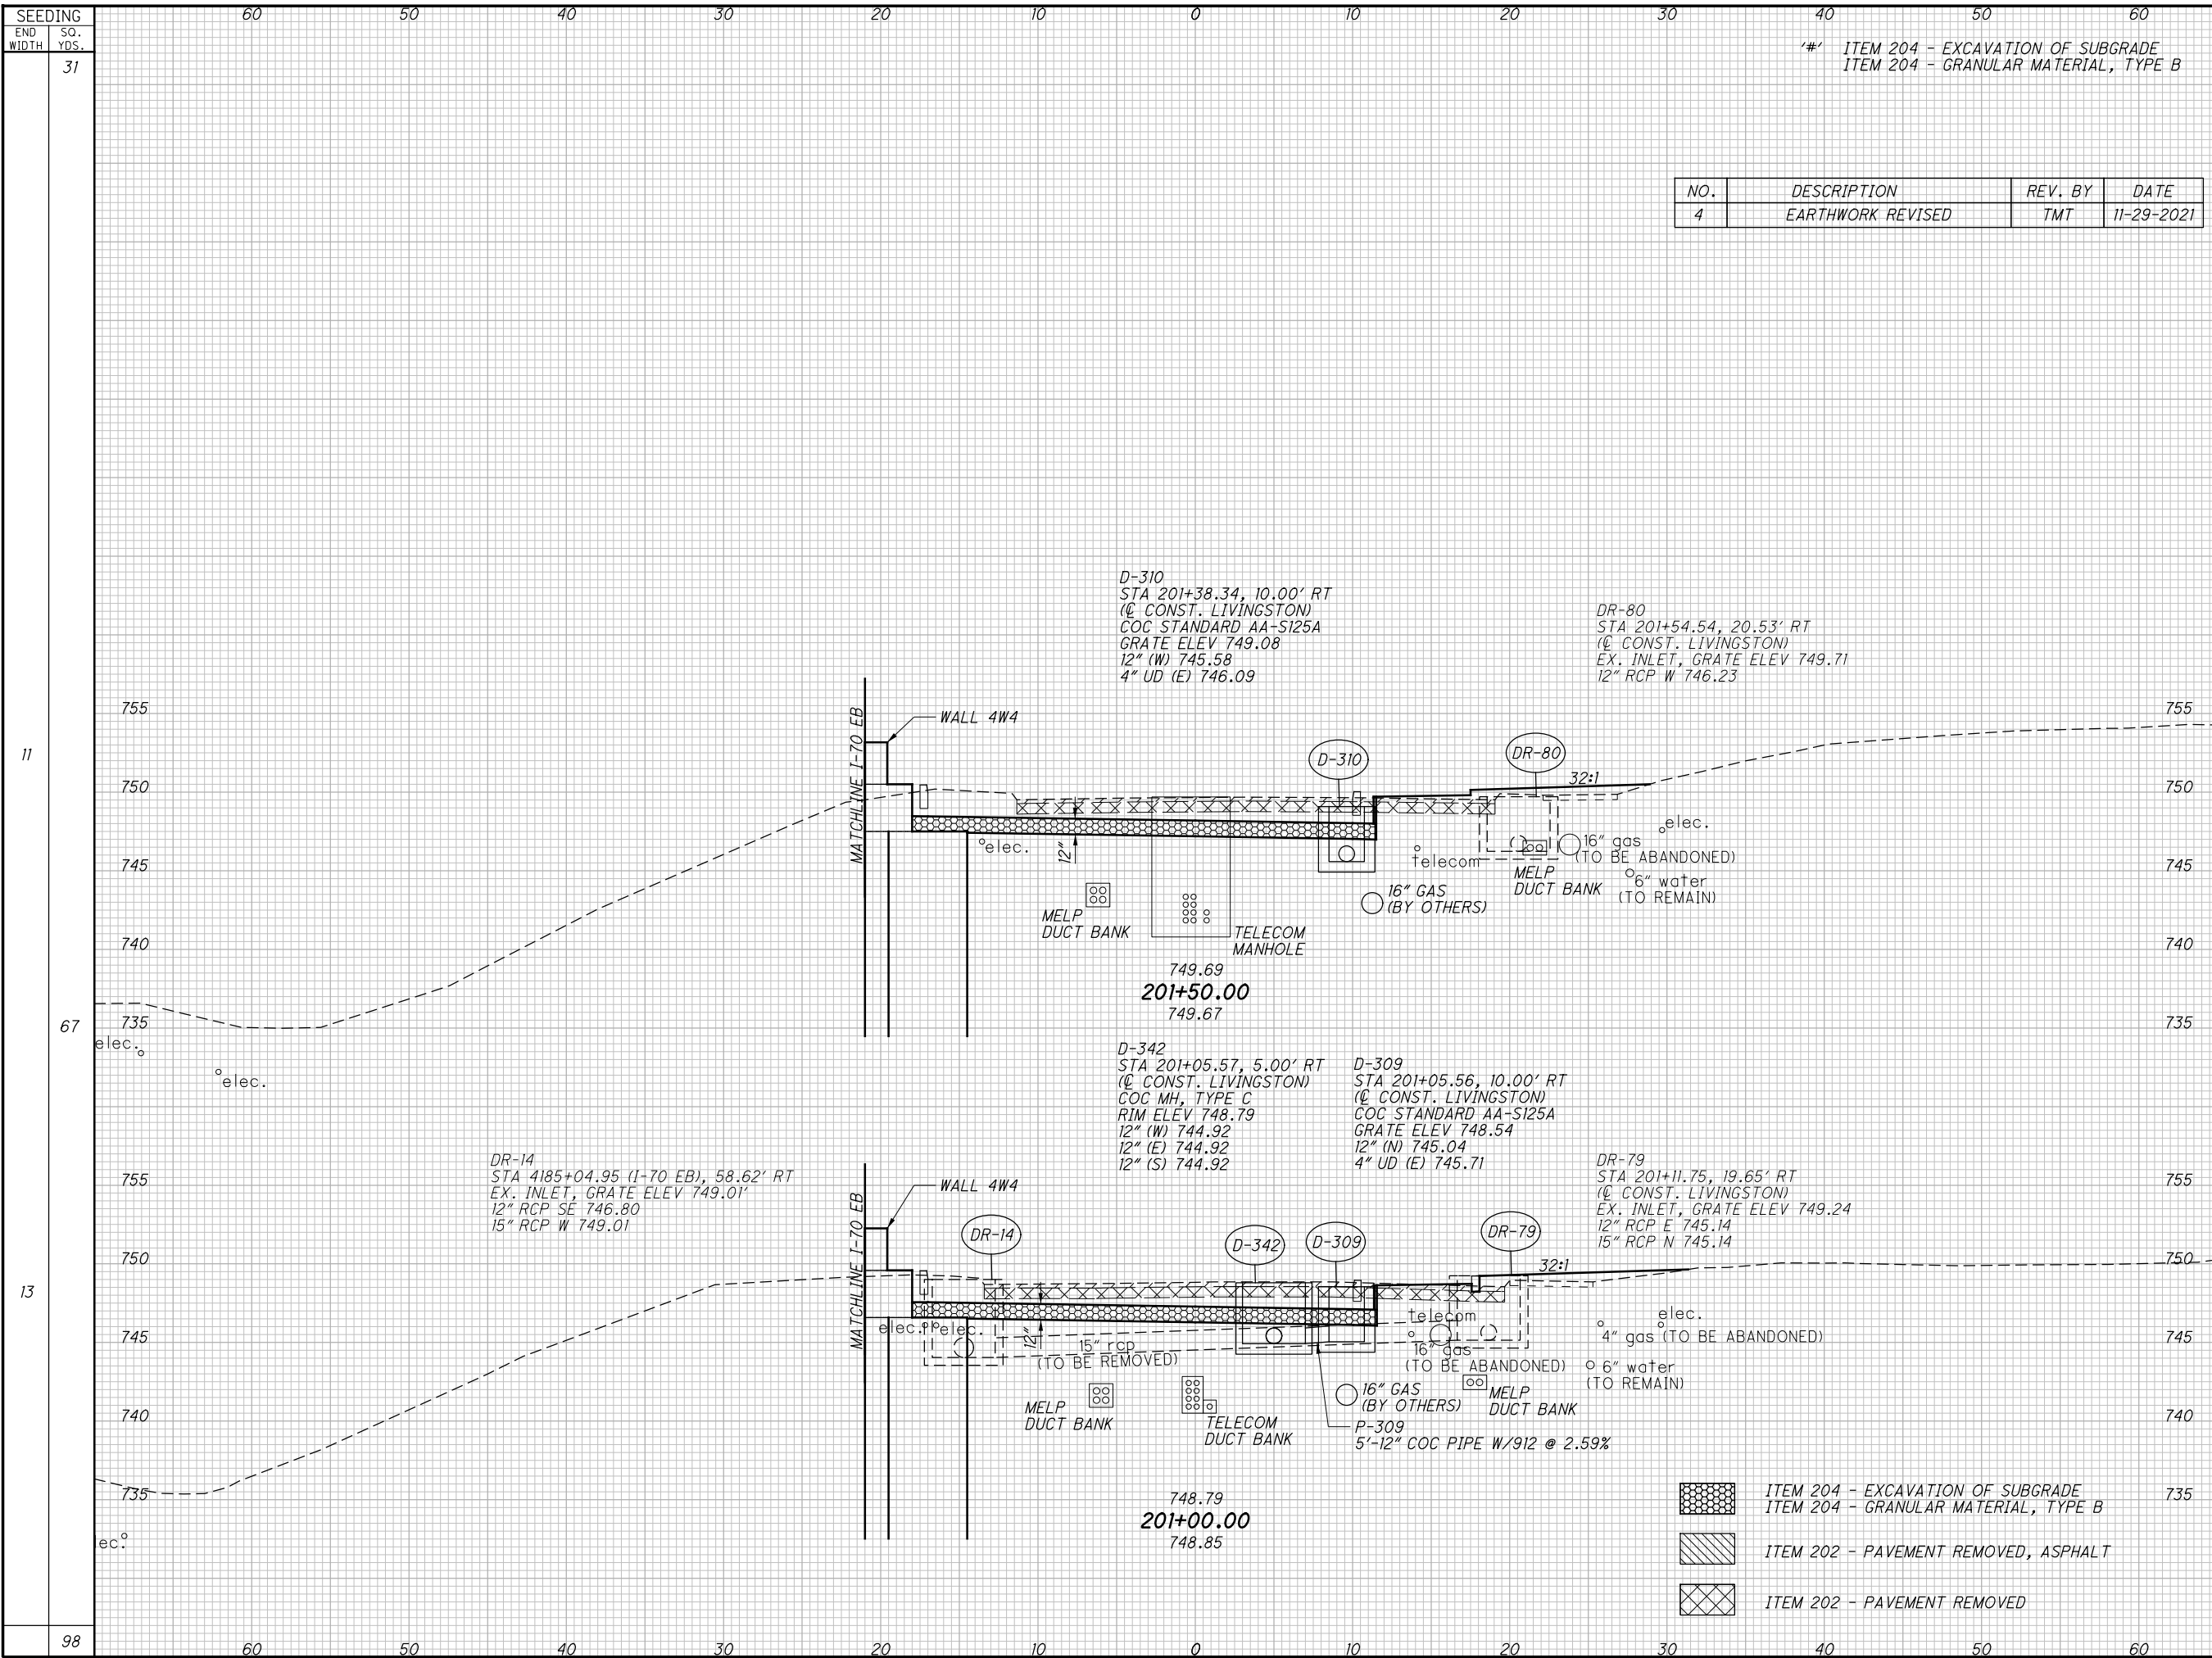

#' ITEM 204 - EXCAVATION OF SUBGRADE
 ITEM 204 - GRANULAR MATERIAL, TYPE B


NO.	DESCRIPTION	REV. BY	DATE
4	EARTHWORK REVISED	TMT	11-29-2021

END AREA	VOLUME	CALCULATED	JMB	CHECKED	TMT
17	15	21	28		
15	16	30	29		
51	57	515	1815		

CROSS SECTIONS LIVINGSTON AVENUE
 STA. 201+00.00 TO STA. 201+50.00

FRA - 70/ 71-12.68 / 14.86

D:\2021\2012048\FRA\05523\ROADWAY\SHEETS\105523\300B.DGN
 11/23/2021 4:20:53 PM
 GDOT\B1STD\USER

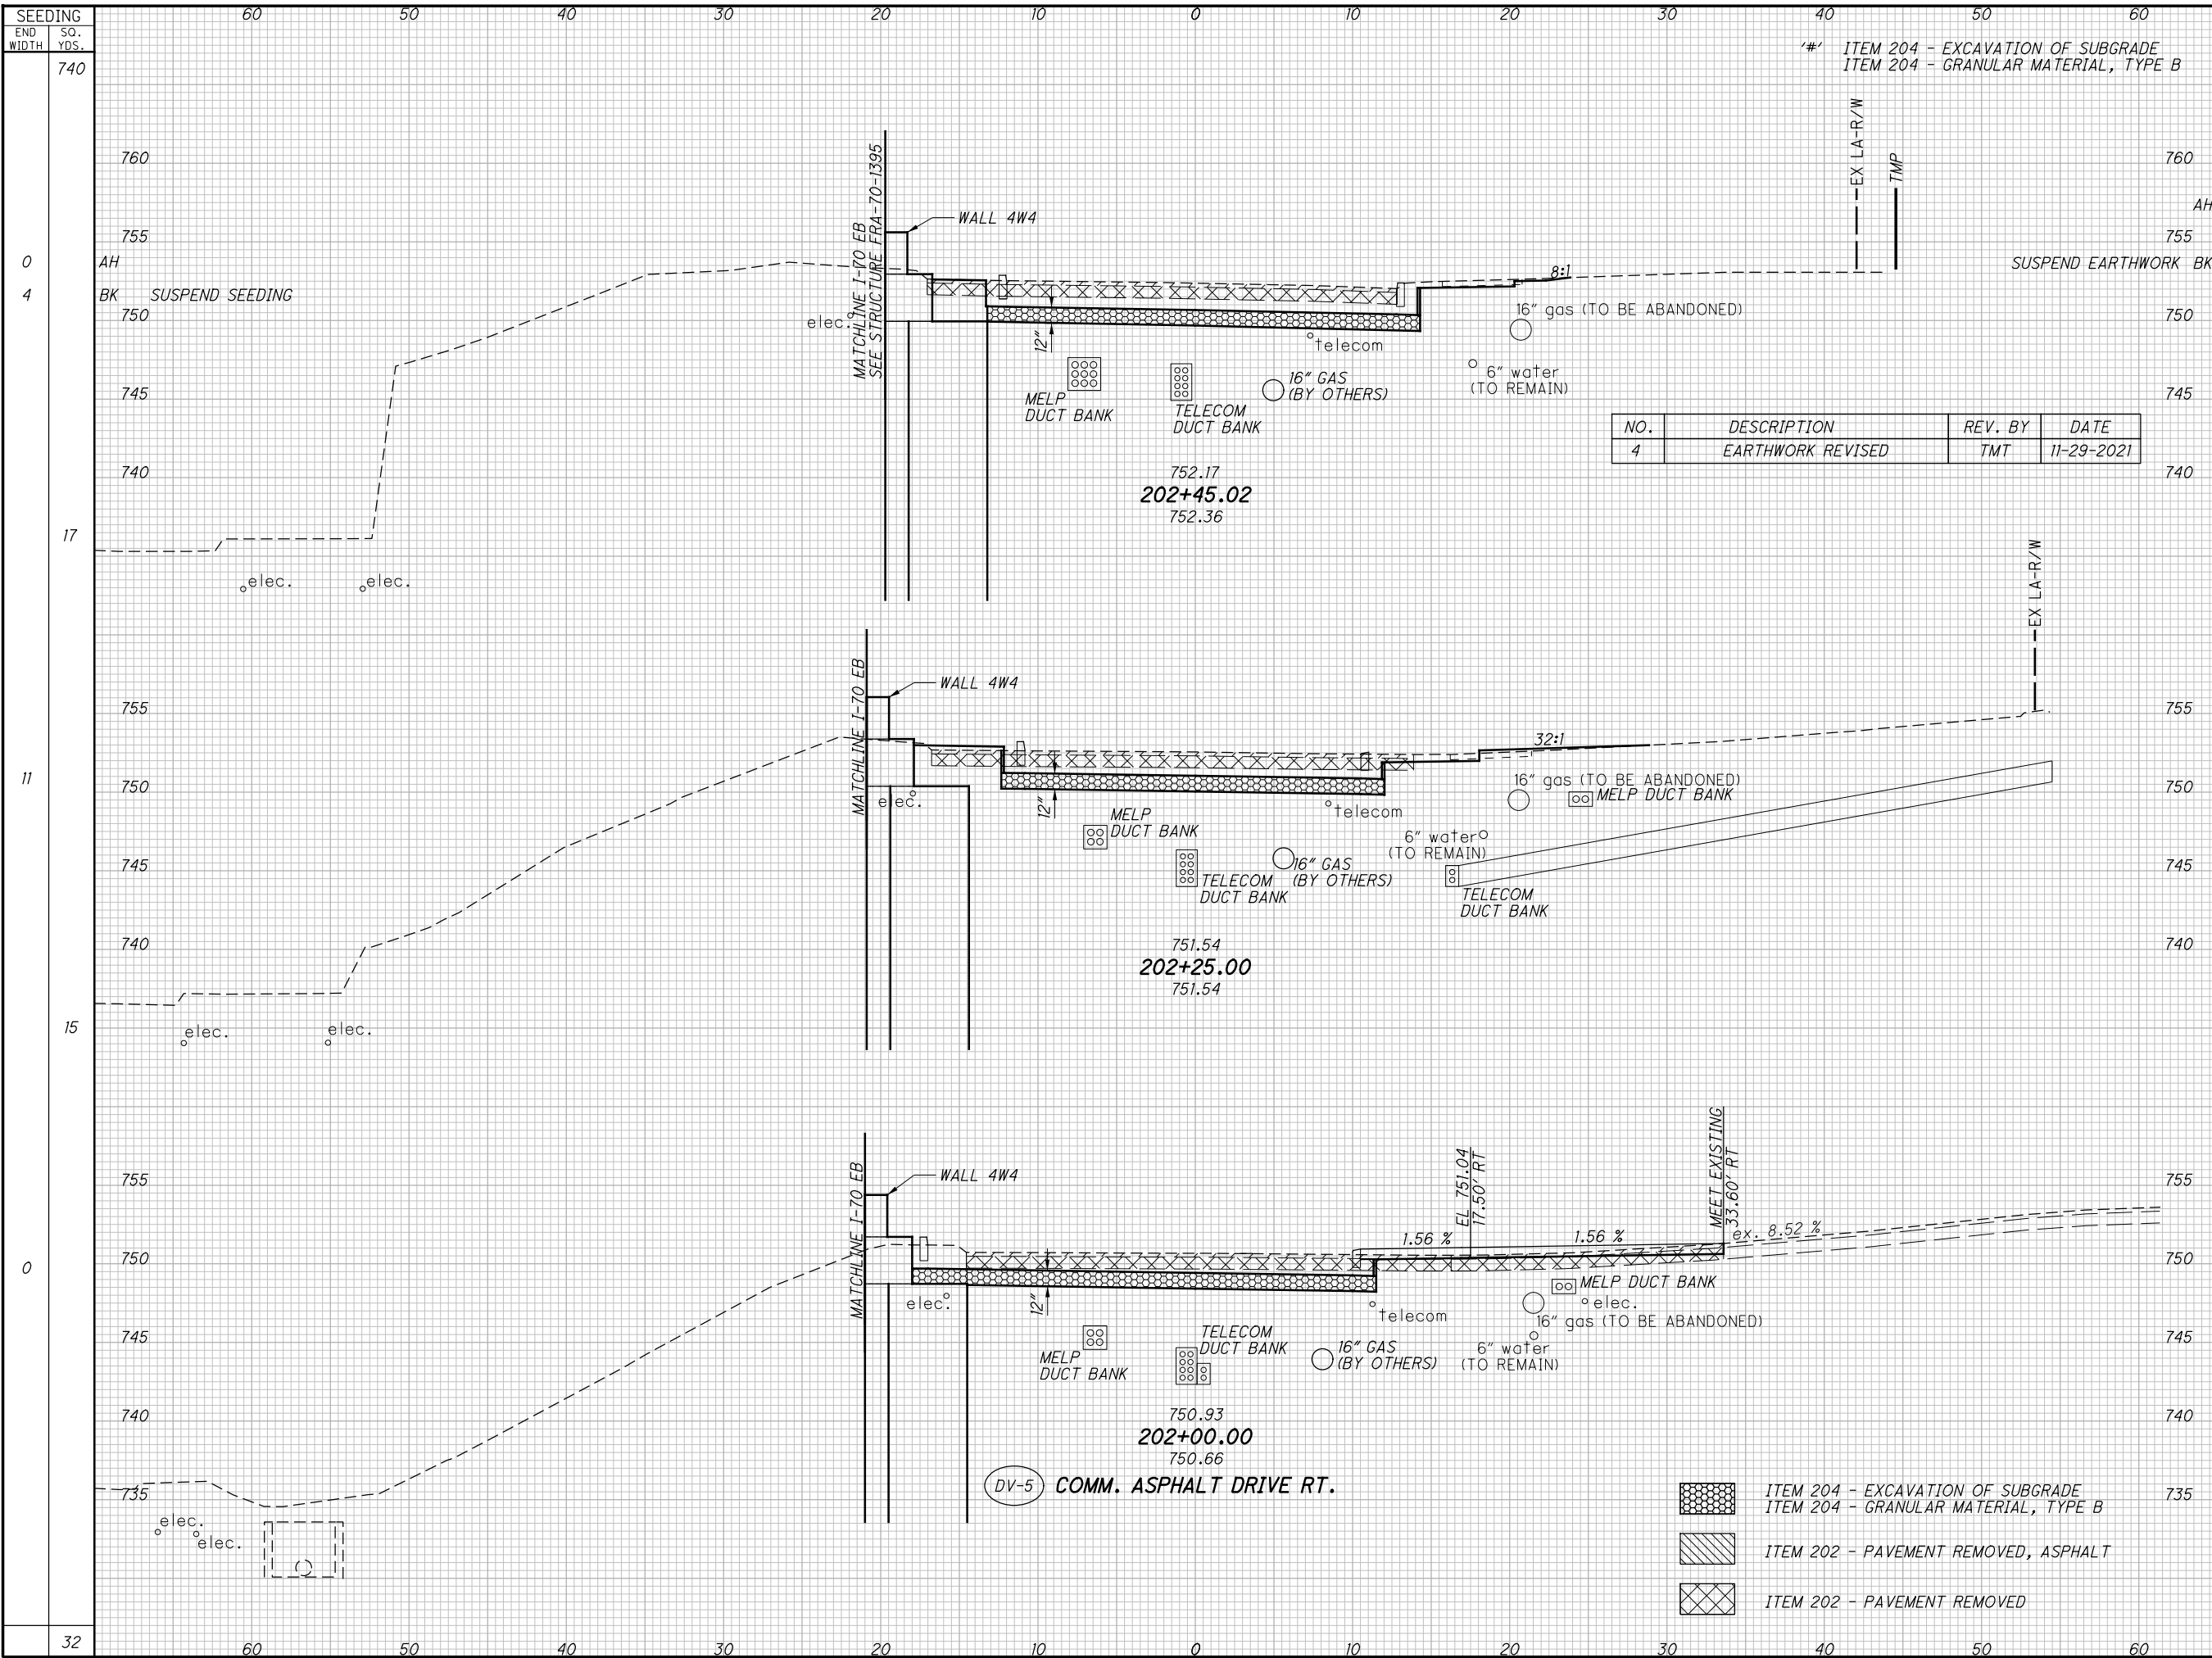


NO.	DESCRIPTION	REV. BY	DATE
4	EARTHWORK REVISED	TMT	11-29-2021

END AREA	VOLUME		CALCULATED	JMB	CHECKED	TMT
	CUT	FILL				
'0'	'0'					
0	0					
'27'	'27'					
22	4					
	'19'	'19'				
	13	5				
	'24'	'24'				
	13	9				
	'25'	'25'				
	9	11				
	'29'	'29'				
	6	15				
	'44'	'44'				
	22	16				
				516		
				1815		

CROSS SECTIONS LIVINGSTON AVENUE
STA. 202+00.00 TO STA. 202+45.02

FRA - 70/ 71-12.68 / 14.86


D:\2812\2812048\FRA\105523\ROADWAY\SHEETS\105523\S008.DGN
 11/23/2021
 4:28:24 PM
 GDOT\B1STD\USER

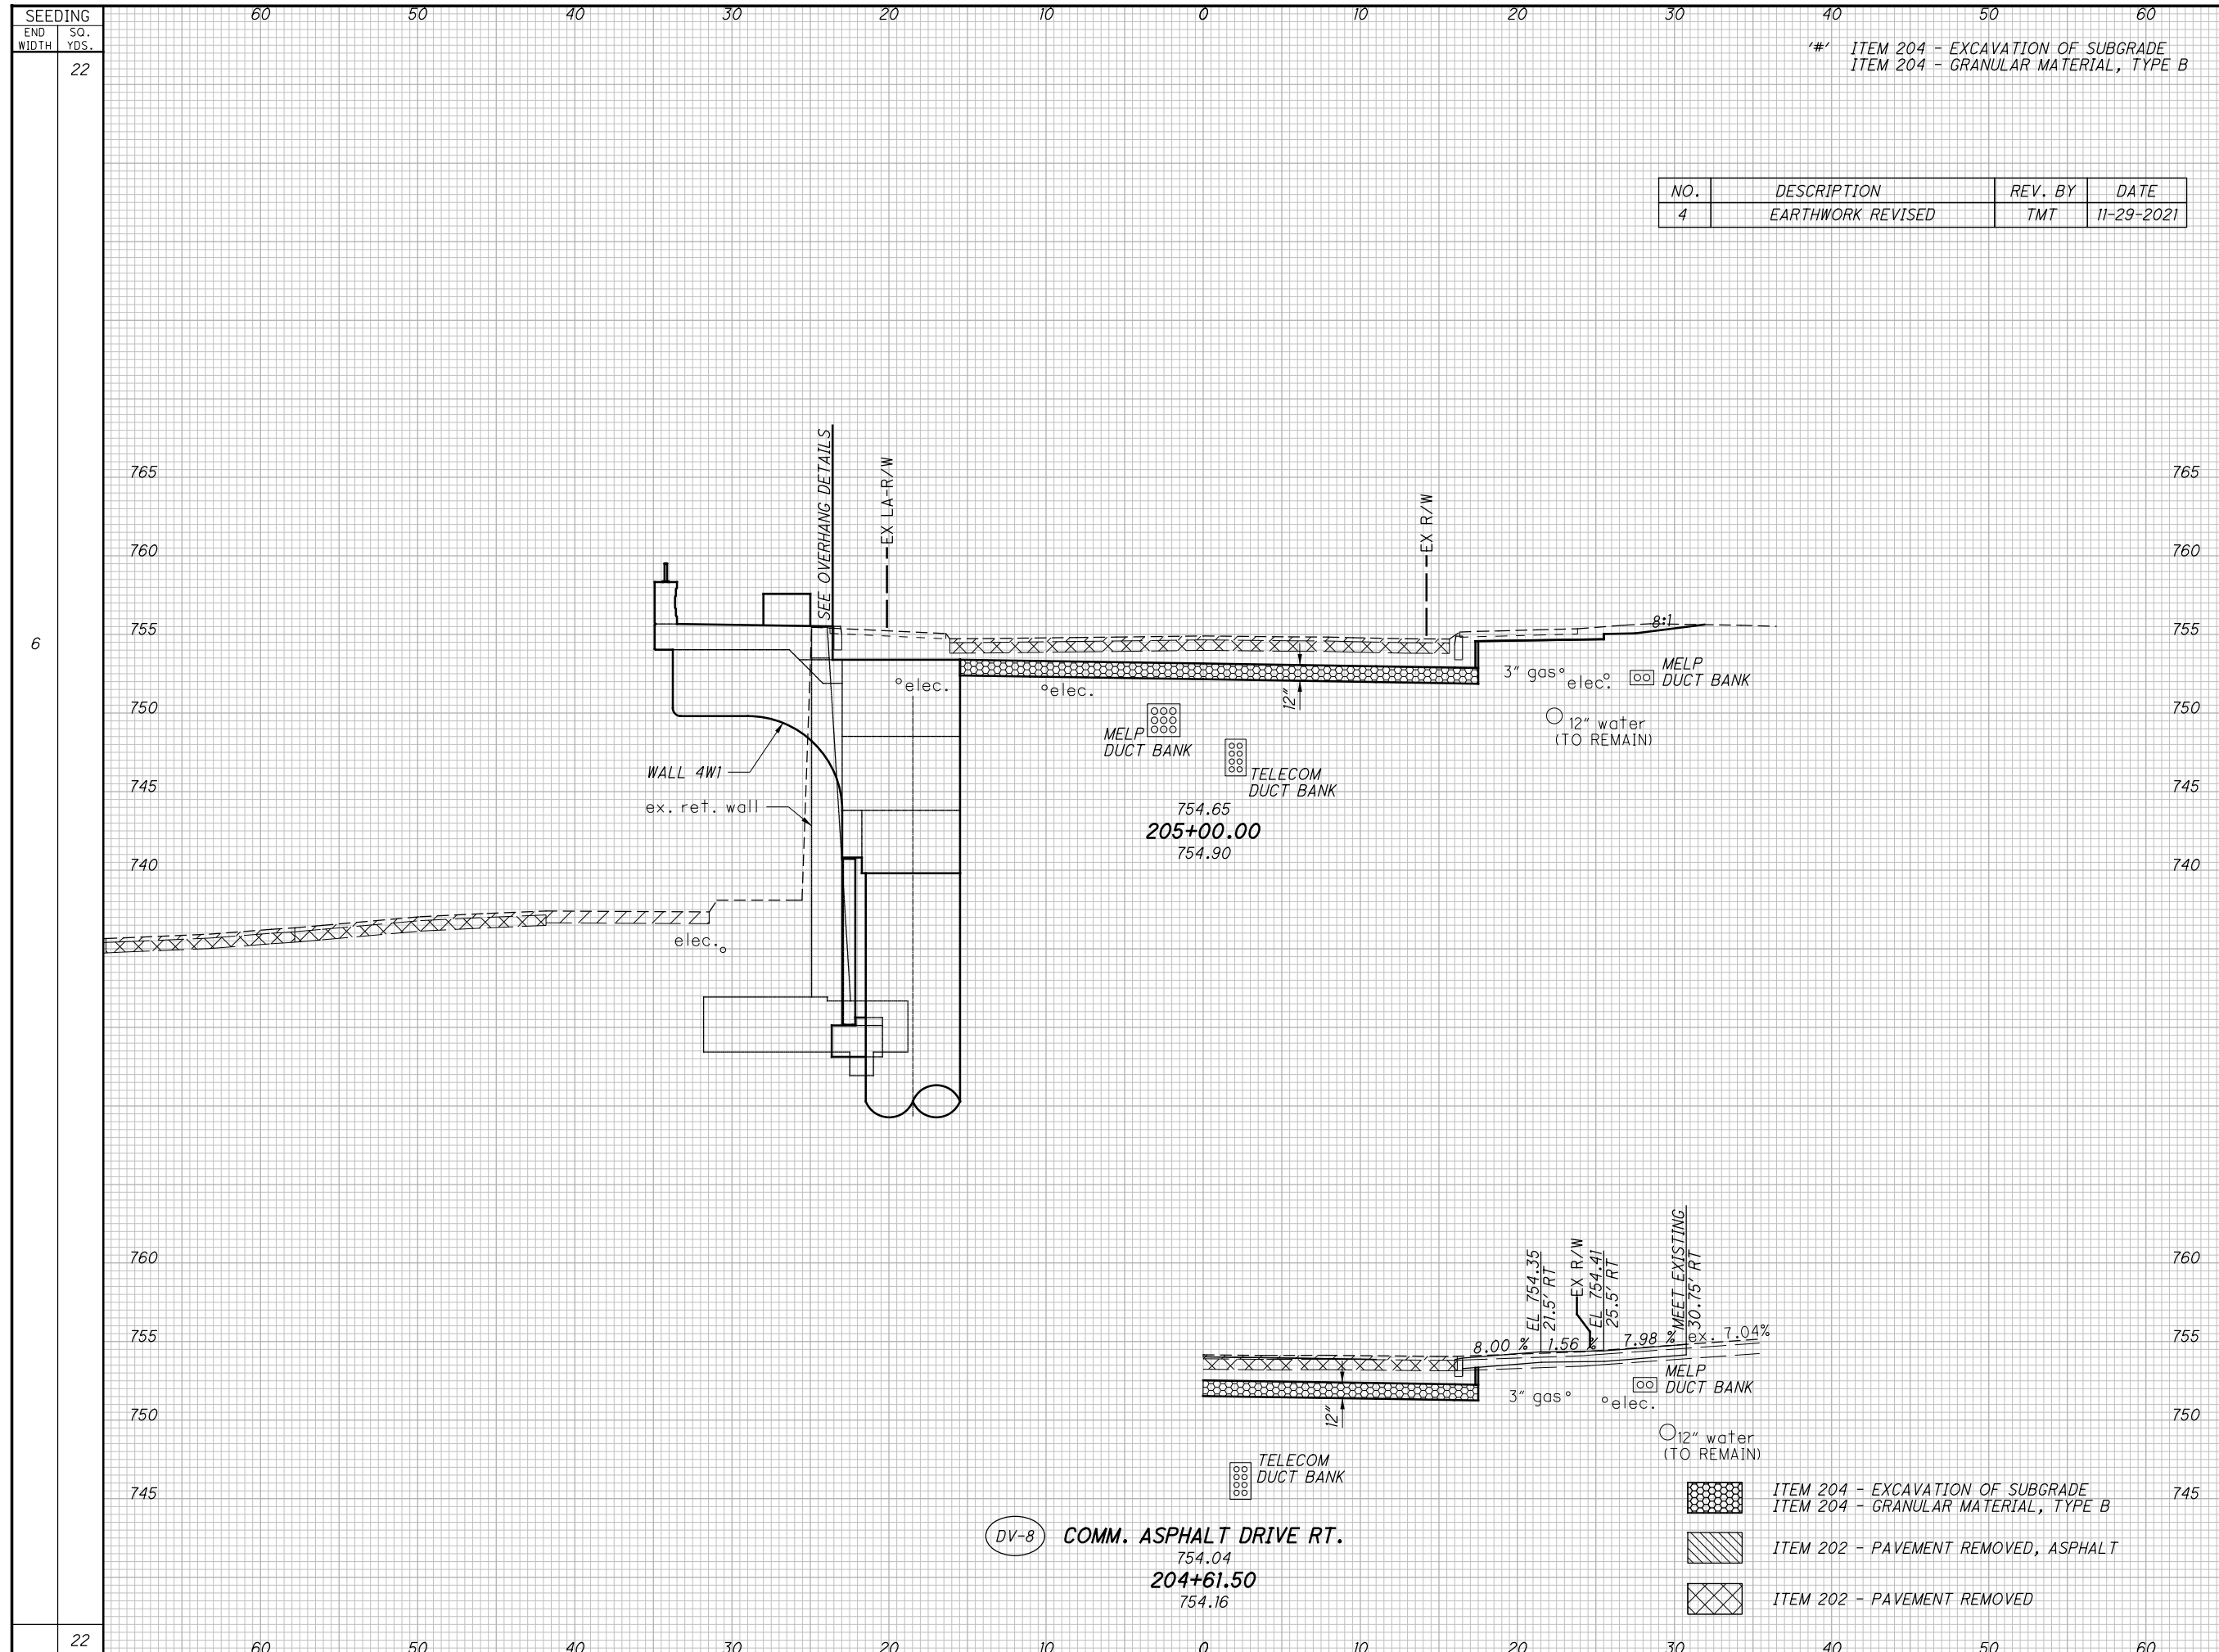

NO.	DESCRIPTION	REV. BY	DATE
4	EARTHWORK REVISED	TMT	11-29-2021

END AREA	VOLUME	CALCULATED	JMB	CHECKED	TMT
'63'	'63'	31			
55	55	31			
'33'	'33'				
32	0				
'63'	'63'	518			
55	55	1815			

CROSS SECTIONS LIVINGSTON AVENUE
 STA. 204+61.50 TO STA. 205+00.00
 FRA - 70 / 71 - 12.68 / 14.86

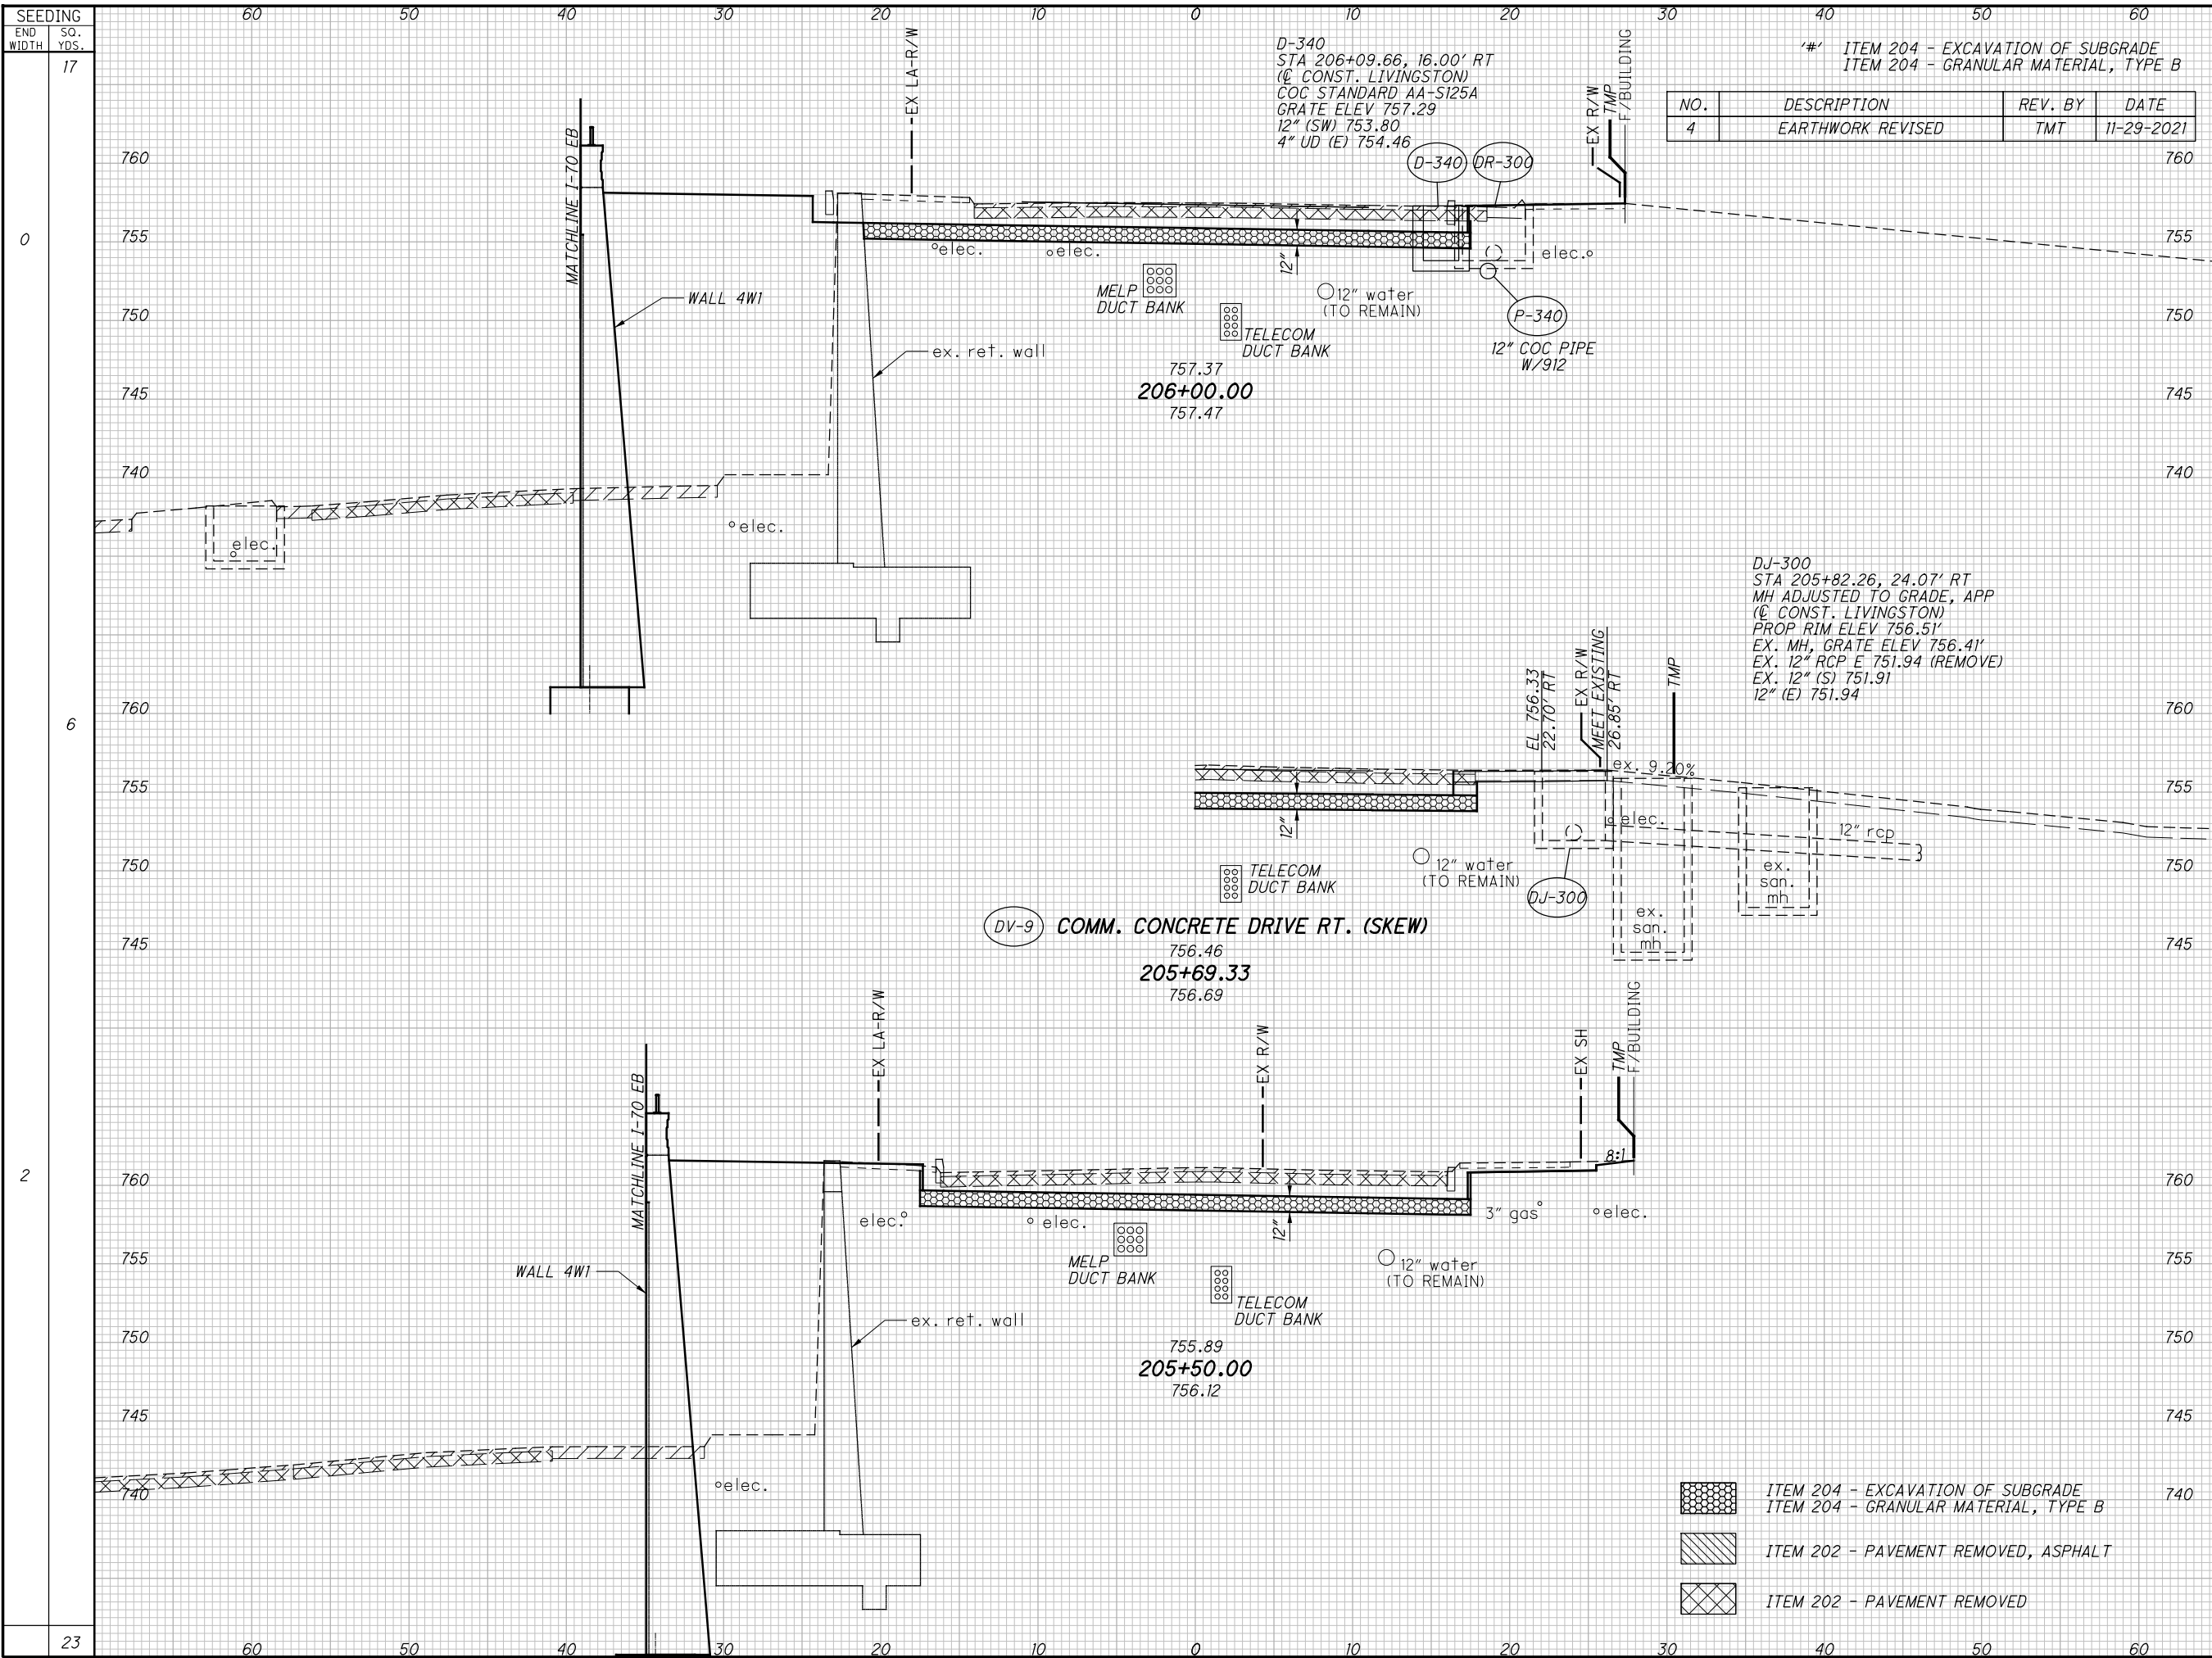


NO.	DESCRIPTION	REV. BY	DATE
4	EARTHWORK REVISED	TMT	11-29-2021

- ITEM 204 - EXCAVATION OF SUBGRADE
- ITEM 204 - GRANULAR MATERIAL, TYPE B
- ITEM 202 - PAVEMENT REMOVED, ASPHALT
- ITEM 202 - PAVEMENT REMOVED

END AREA	VOLUME		CALCULATED	CHECKED	TMT
	CUT	FILL			
'39'	'39'	'72'	44	104	
30	30	47			
'68'	'68'	'75'	53	75	
53	53	75			
'35'	'35'	'34'	27	34	
27	27	34			
'140'	'140'	'179'	97	179	
97	97	179			
					519
					1815

CROSS SECTIONS LIVINGSTON AVENUE
STA. 205+50.00 TO STA. 206+00.00

FRA - 70/ 71-12.68 / 14.86

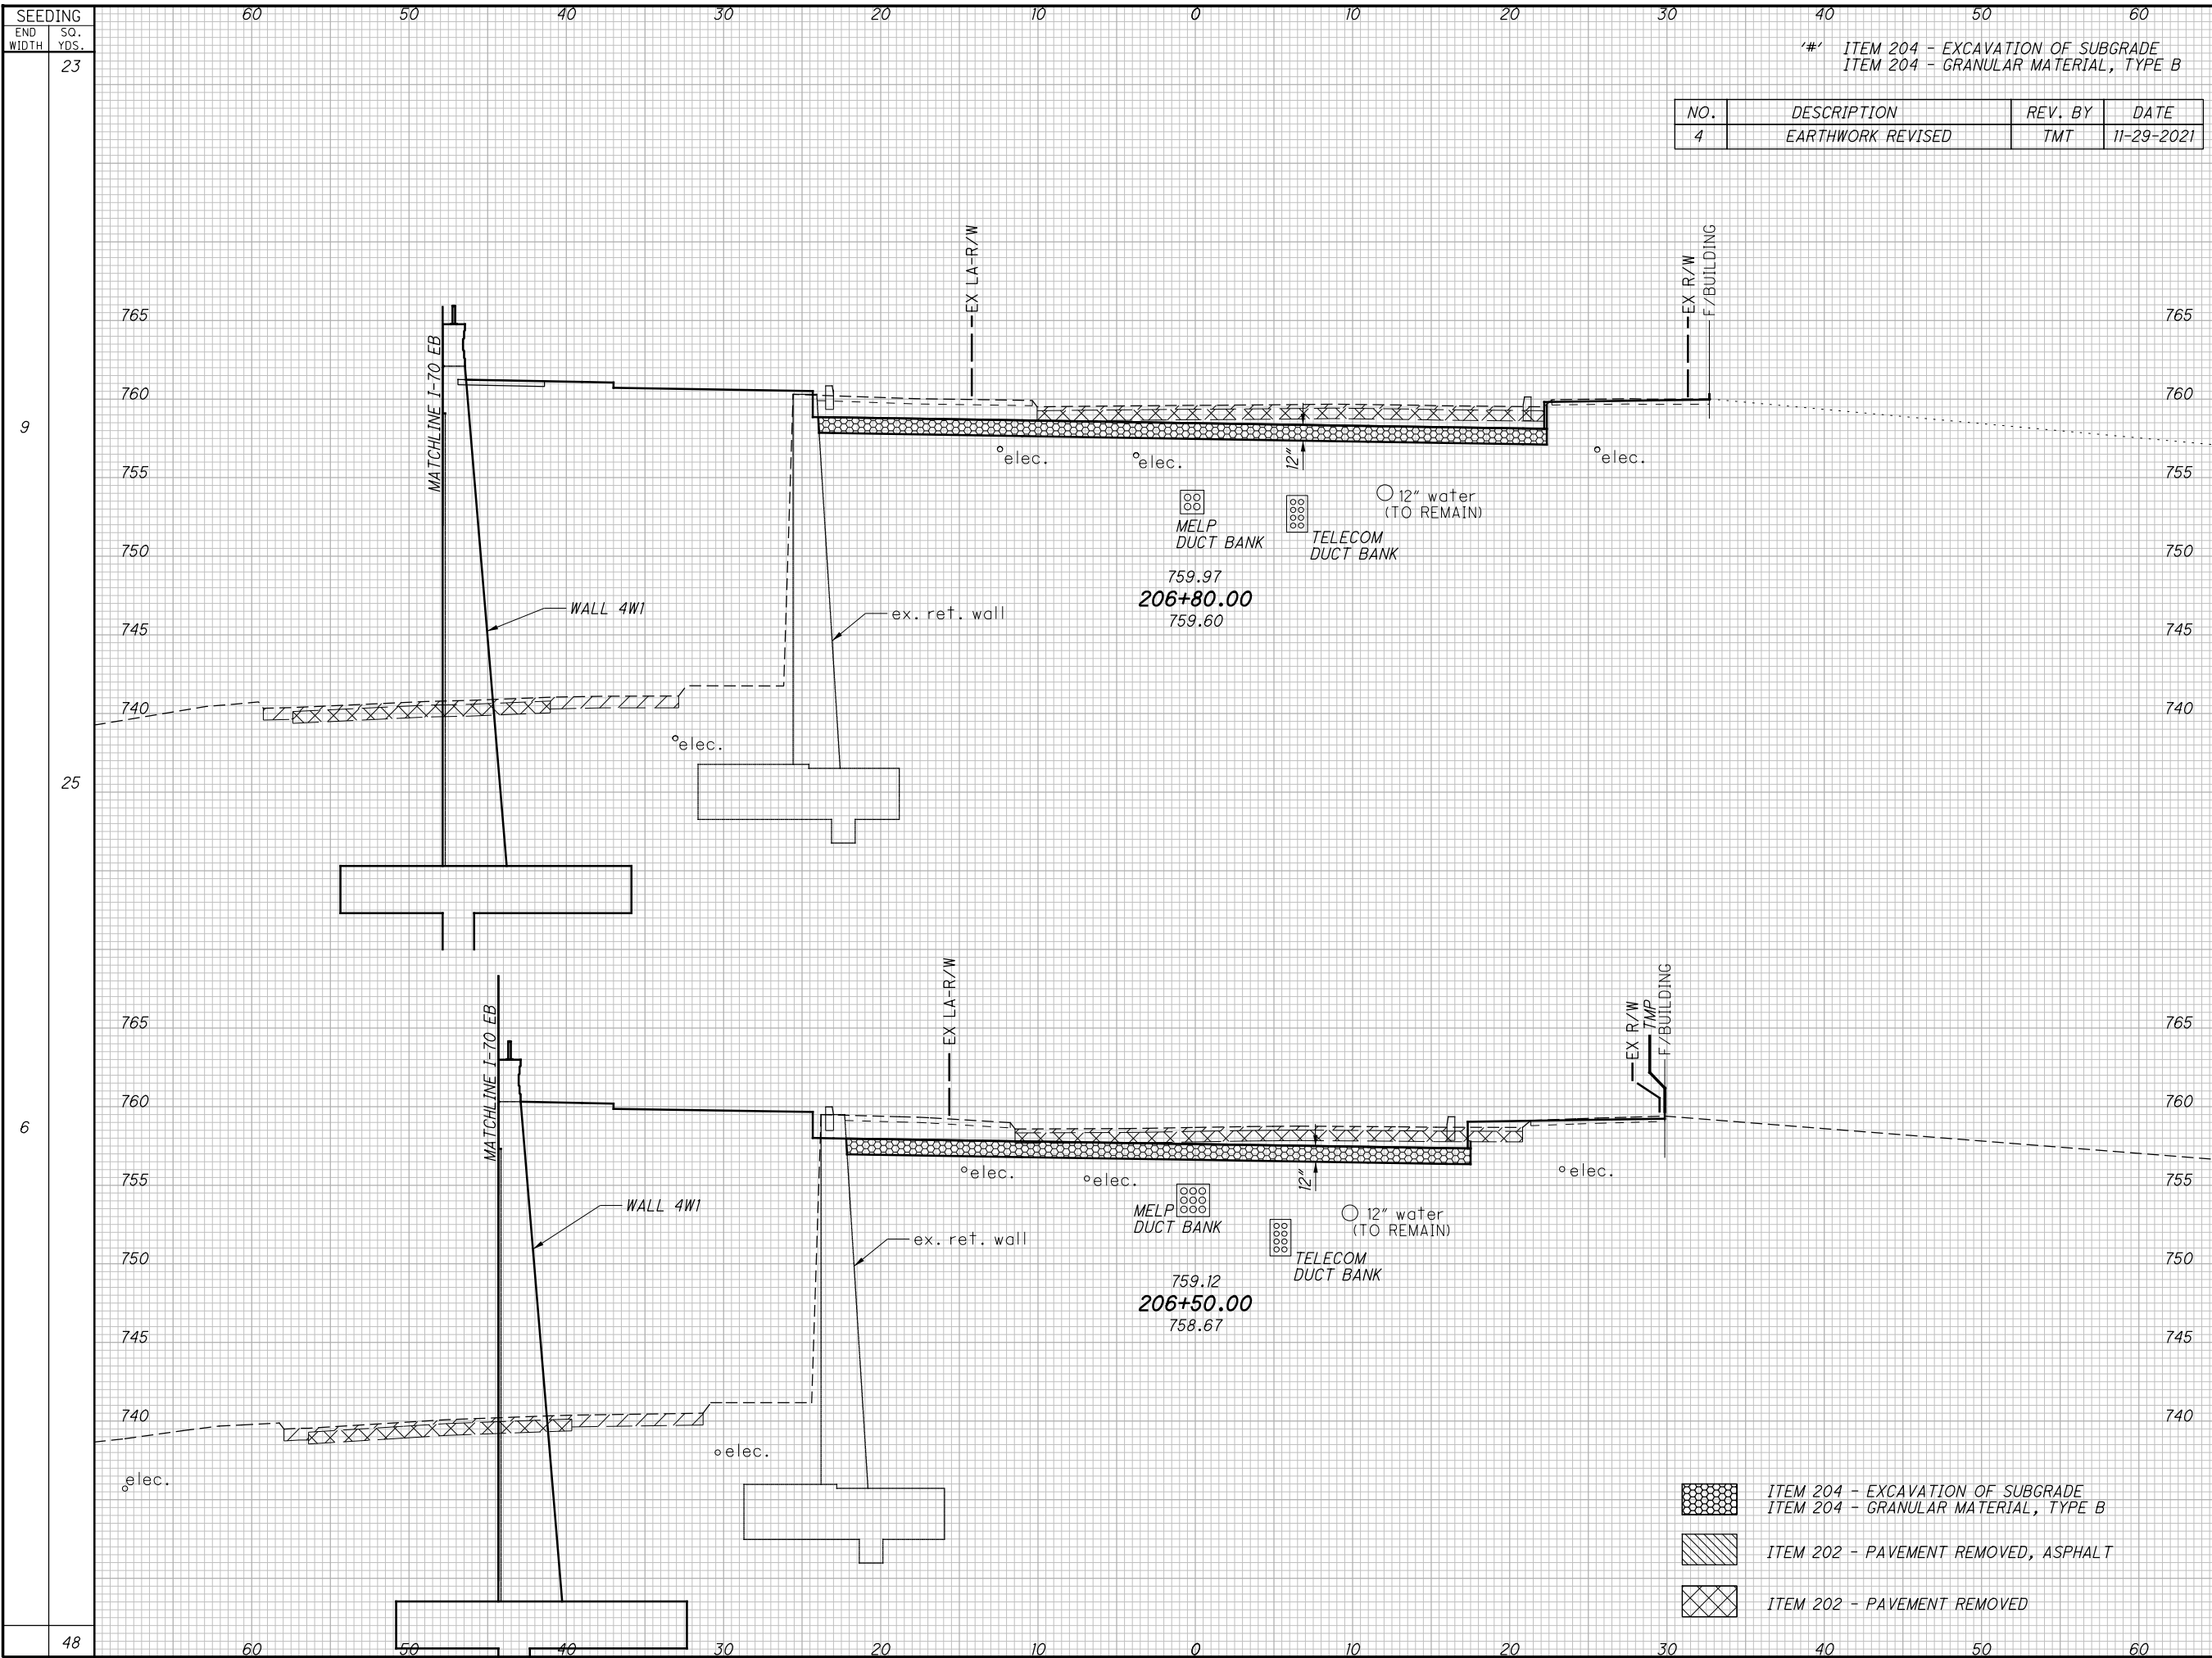


NO.	DESCRIPTION	REV. BY	DATE
4	EARTHWORK REVISED	TMT	11-29-2021

END AREA	VOLUME		CALCULATED	CHECKED	TMT
	CUT	FILL			
'35' 19			53		
'46' 23			71		
'48' 22			76		
'40' 17			65		
'83' 41			520 1815		

CROSS SECTIONS LIVINGSTON AVENUE
STA. 206+50.00 TO STA. 206+80.00

FRA - 70/ 71-12.68 / 14.86

D:\2021\206+80\FRA\105523\FRDRAW\SHEETS\105523\S006.DGN
 11/23/2021 4:39:48 PM
 900TV81STDUSER

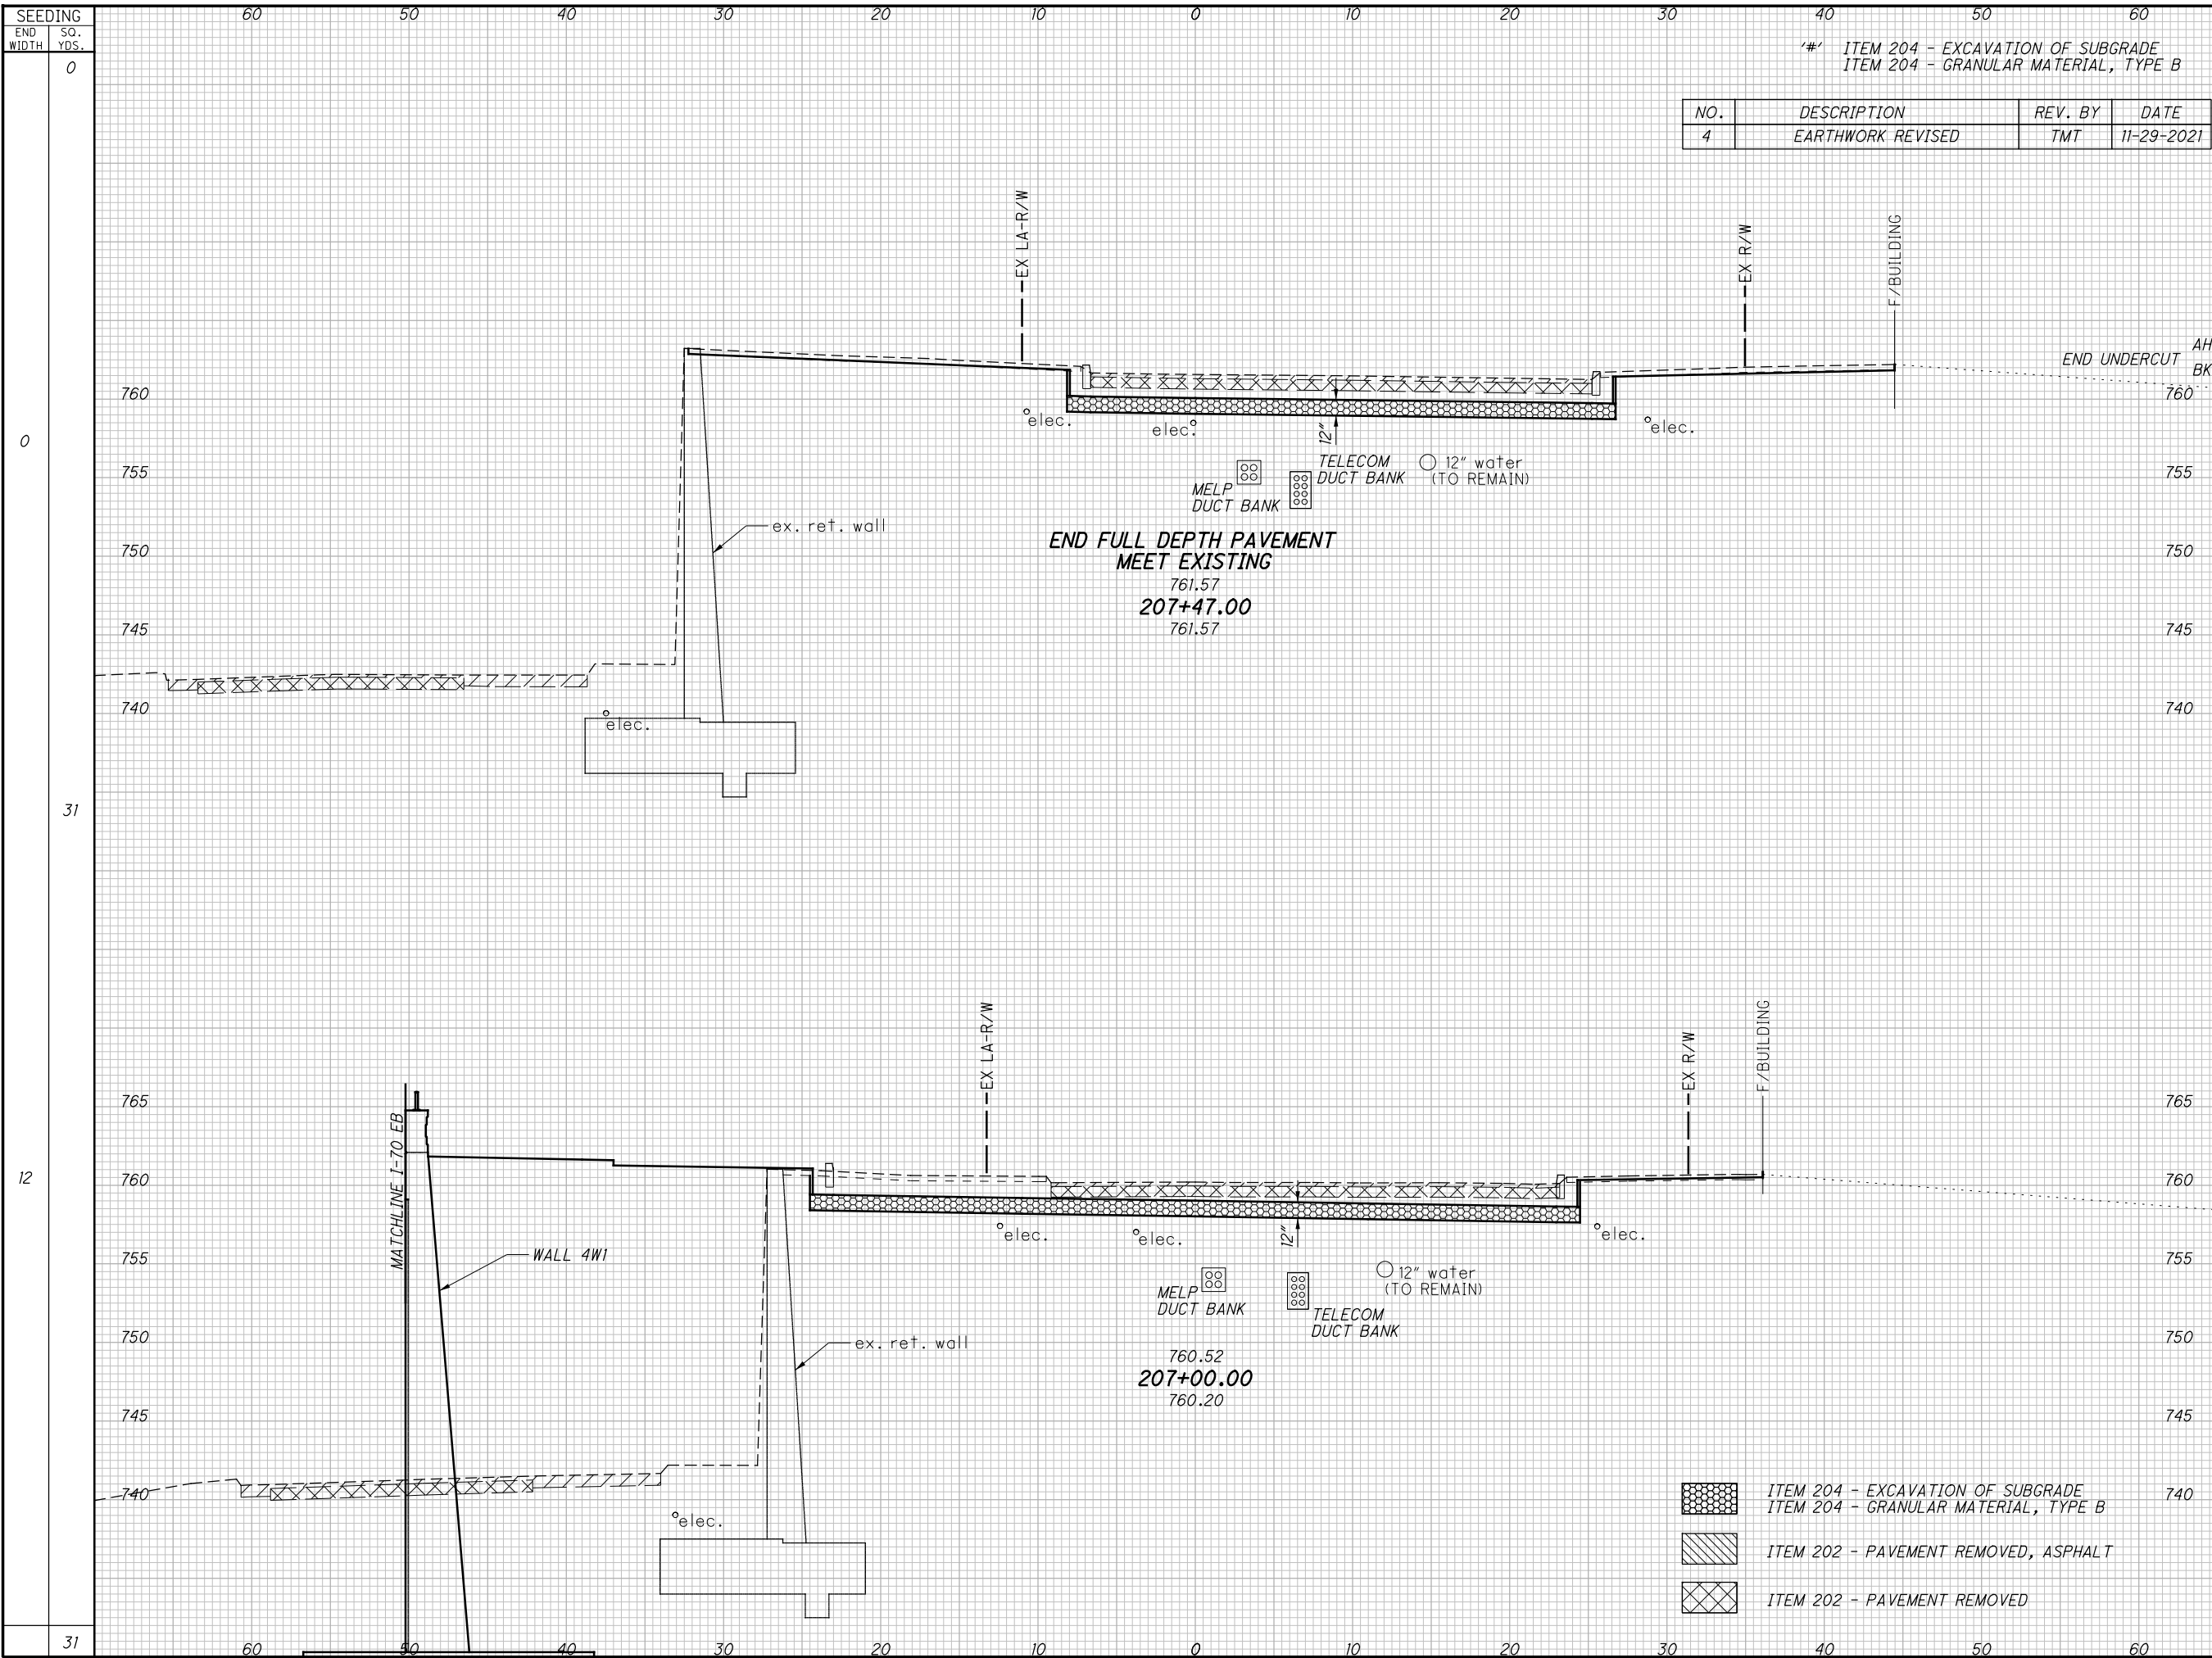

ITEM 204 - EXCAVATION OF SUBGRADE
 ITEM 204 - GRANULAR MATERIAL, TYPE B

NO.	DESCRIPTION	REV. BY	DATE
4	EARTHWORK REVISED	TMT	11-29-2021

END AREA	VOLUME		CALCULATED	CHECKED	TMT
	CUT	FILL			
'0' '35'	'0'	'35'	1	0	JMB
22	2				TMT
'73'	'73'				
44	65				
'49'	'49'				
28	73				
'73'	'73'				
45	65				
					521
					1815

**CROSS SECTIONS LIVINGSTON AVENUE
 STA. 207+00.00 TO STA. 207+47.00**



FRA -70/ 71-12.68 / 14.86

D:\2012\2012048\FRA\105523\ROADWAY\SHEETS\105523\SUBB.DGN
 11/23/2021 4:53:59 PM
 900TV81STD.LIBER



NO.	DESCRIPTION	REV. BY	DATE
4	WIDENED BPD	CWL	11-29-2021

PLAN AND PROFILE BIKE PATH DETOUR
 STA. 11+50.00 TO STA. 17+00.00
 FRA-70/71-12.68/14.86
 638
 1815

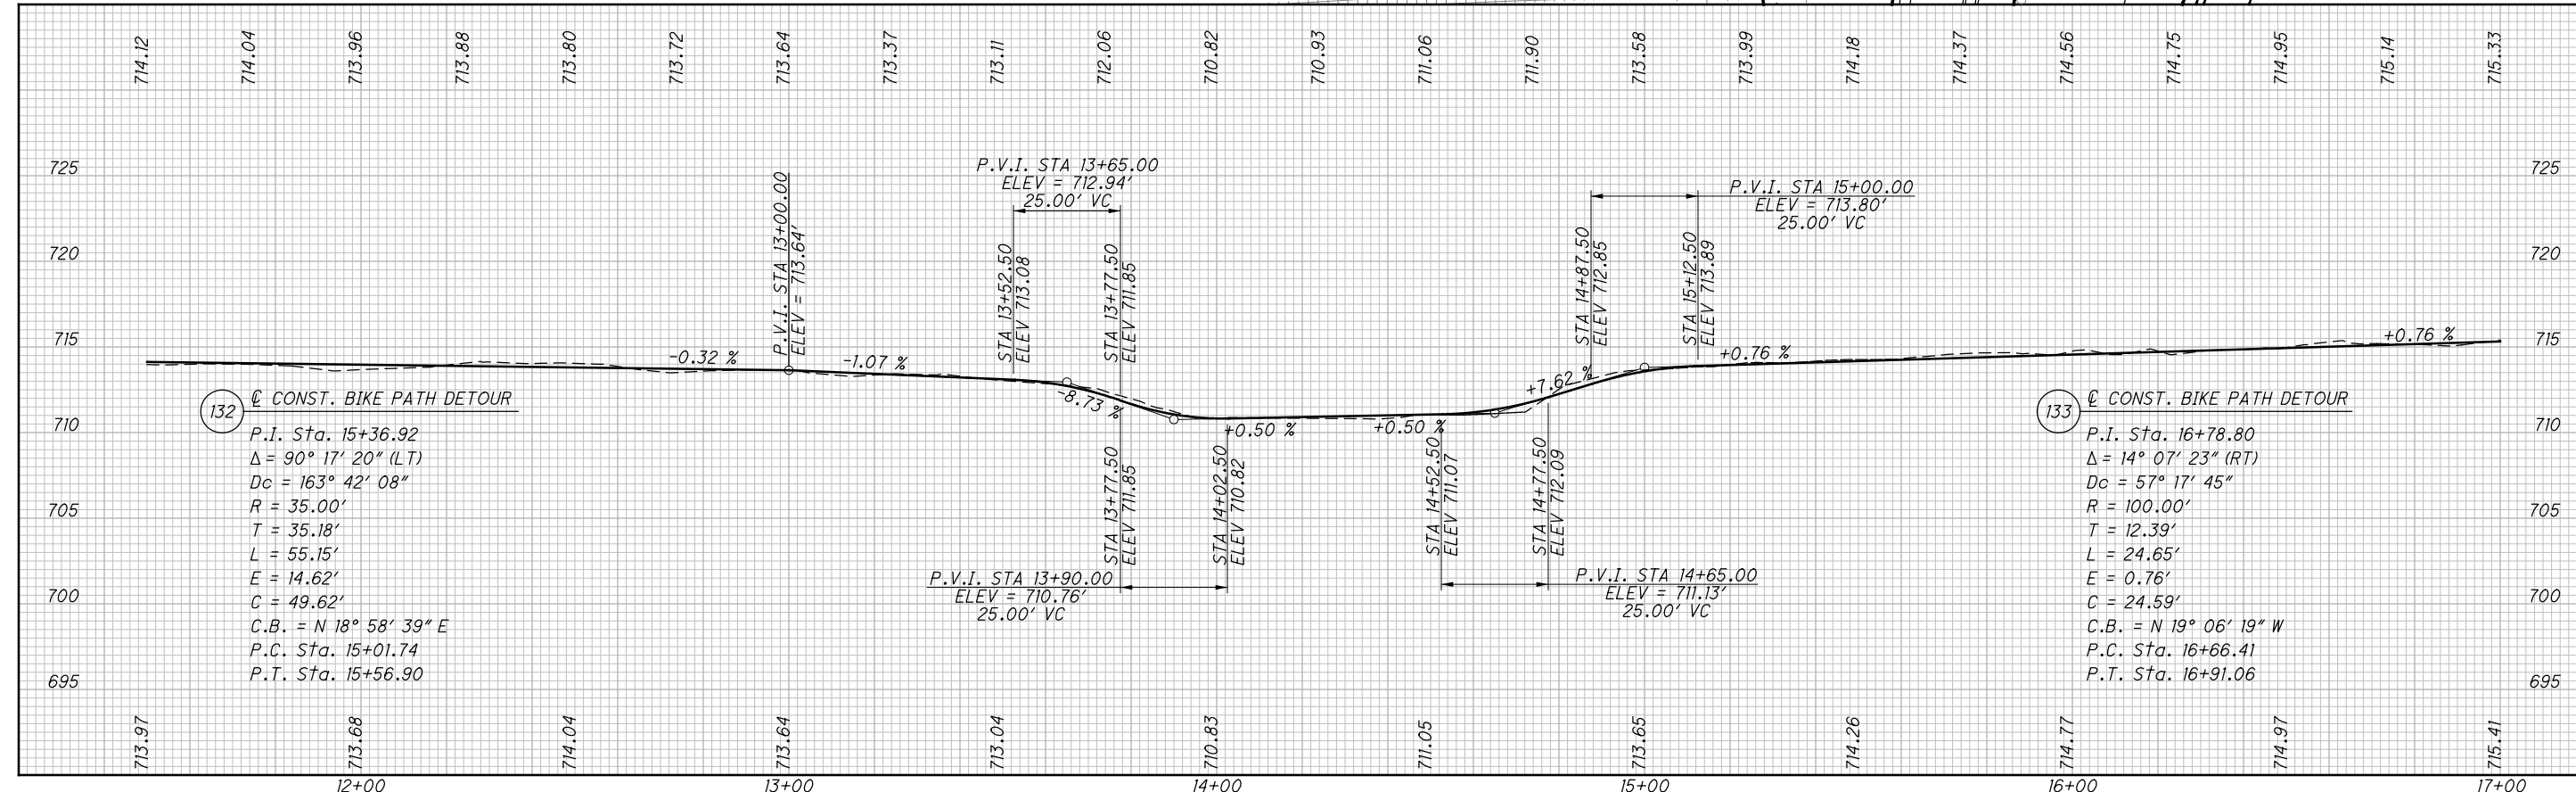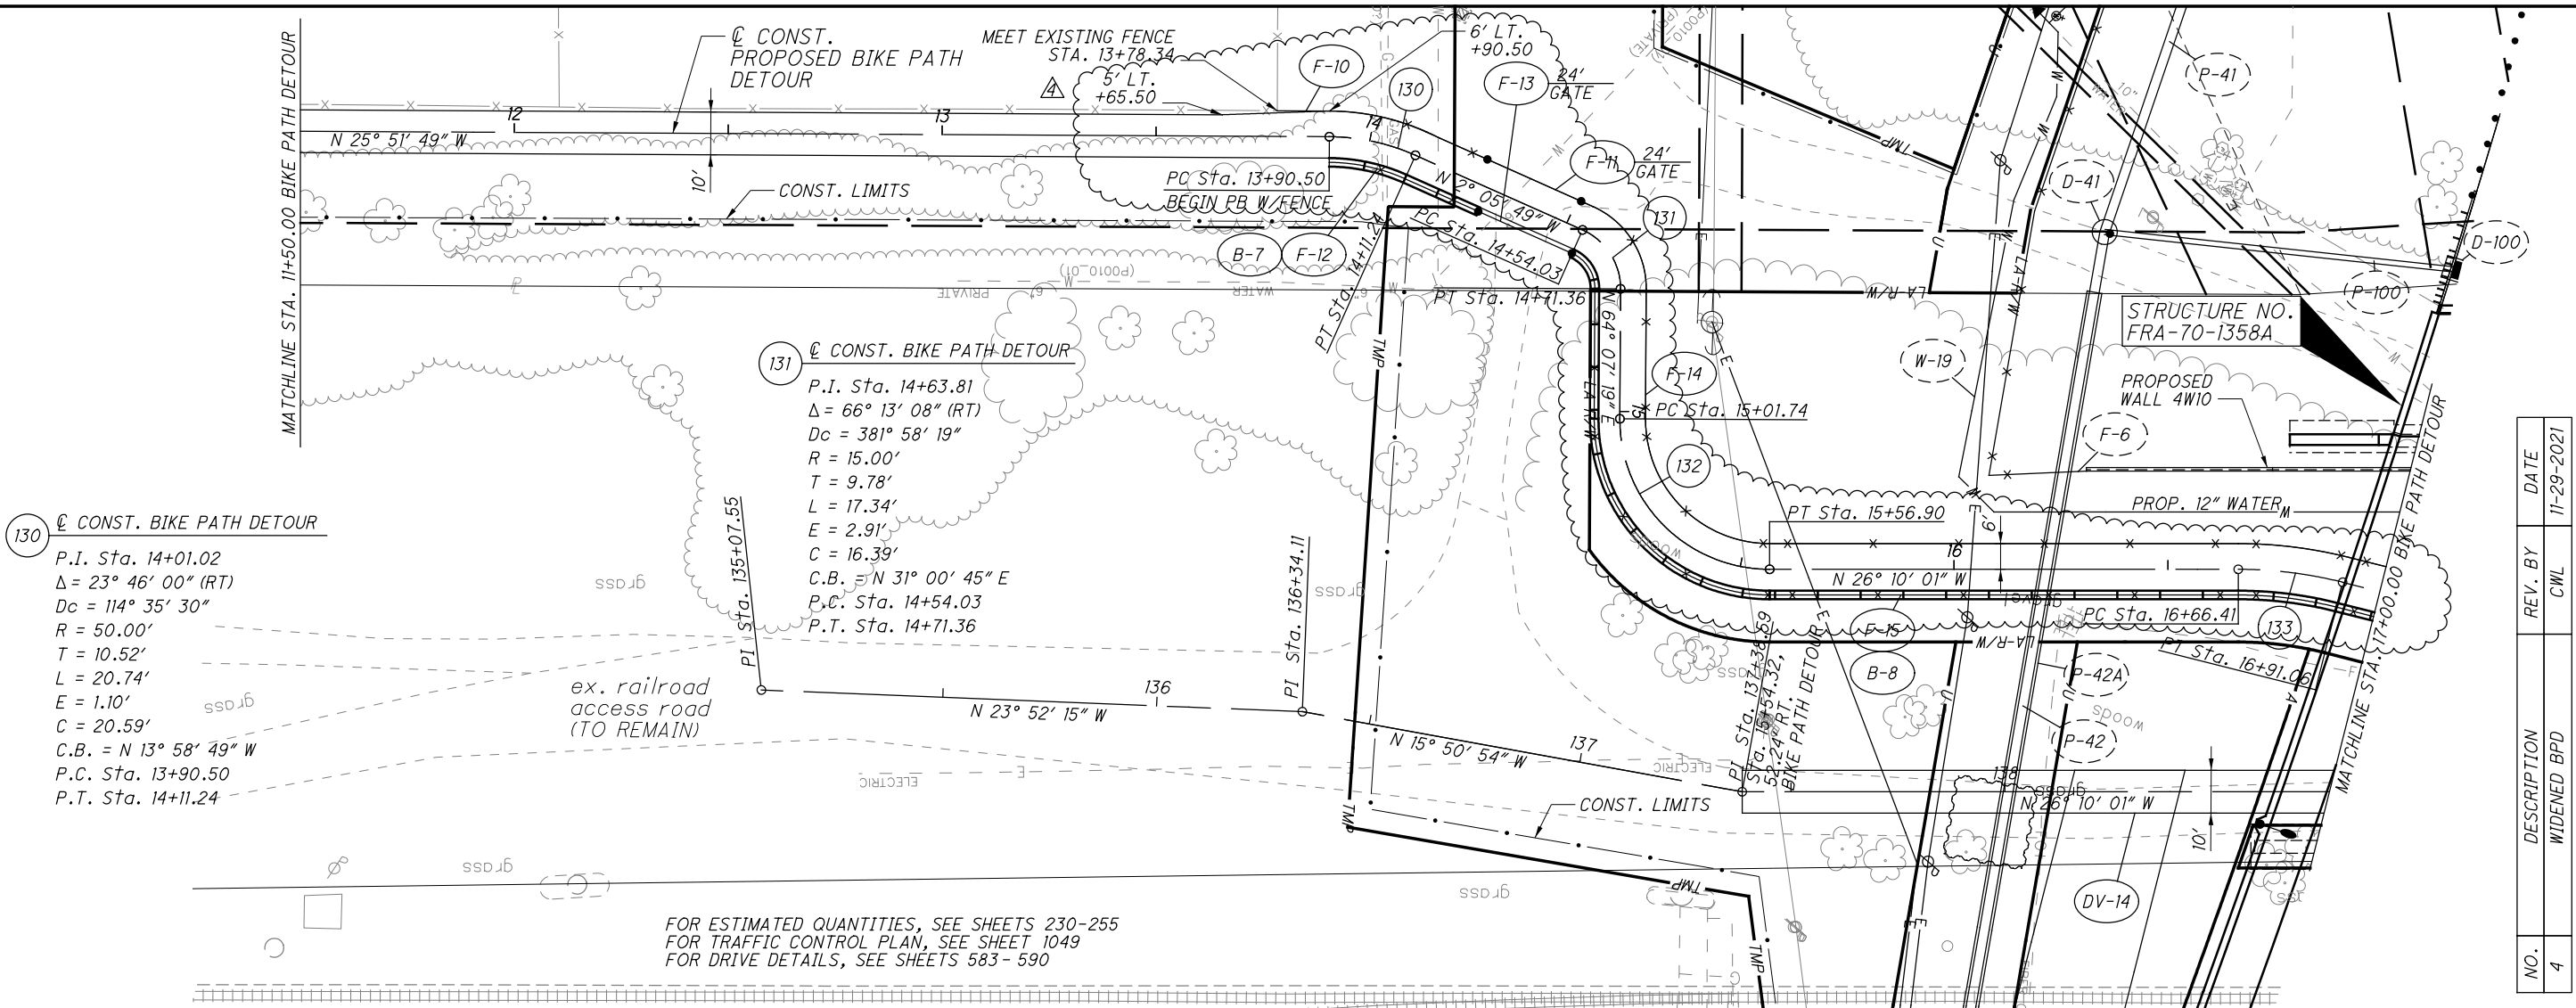

01-2012-2612048\FRA1185623\ROADWAY\SHEETS\1856230P105.DWG
 11/27/2021
 11:36:59 PM
 bob1v81STD_USER

FOR ESTIMATED QUANTITIES, SEE SHEETS 230-255
 FOR TRAFFIC CONTROL PLAN, SEE SHEET 1049
 FOR DRIVE DETAILS, SEE SHEETS 583-590




CALCULATED CJC CHECKED CWL


PLAN AND PROFILE BIKE PATH DETOUR STA. 17+00.00 TO STA. 22+57.27

FRA-70/71-12.68/14.86

638A
1815

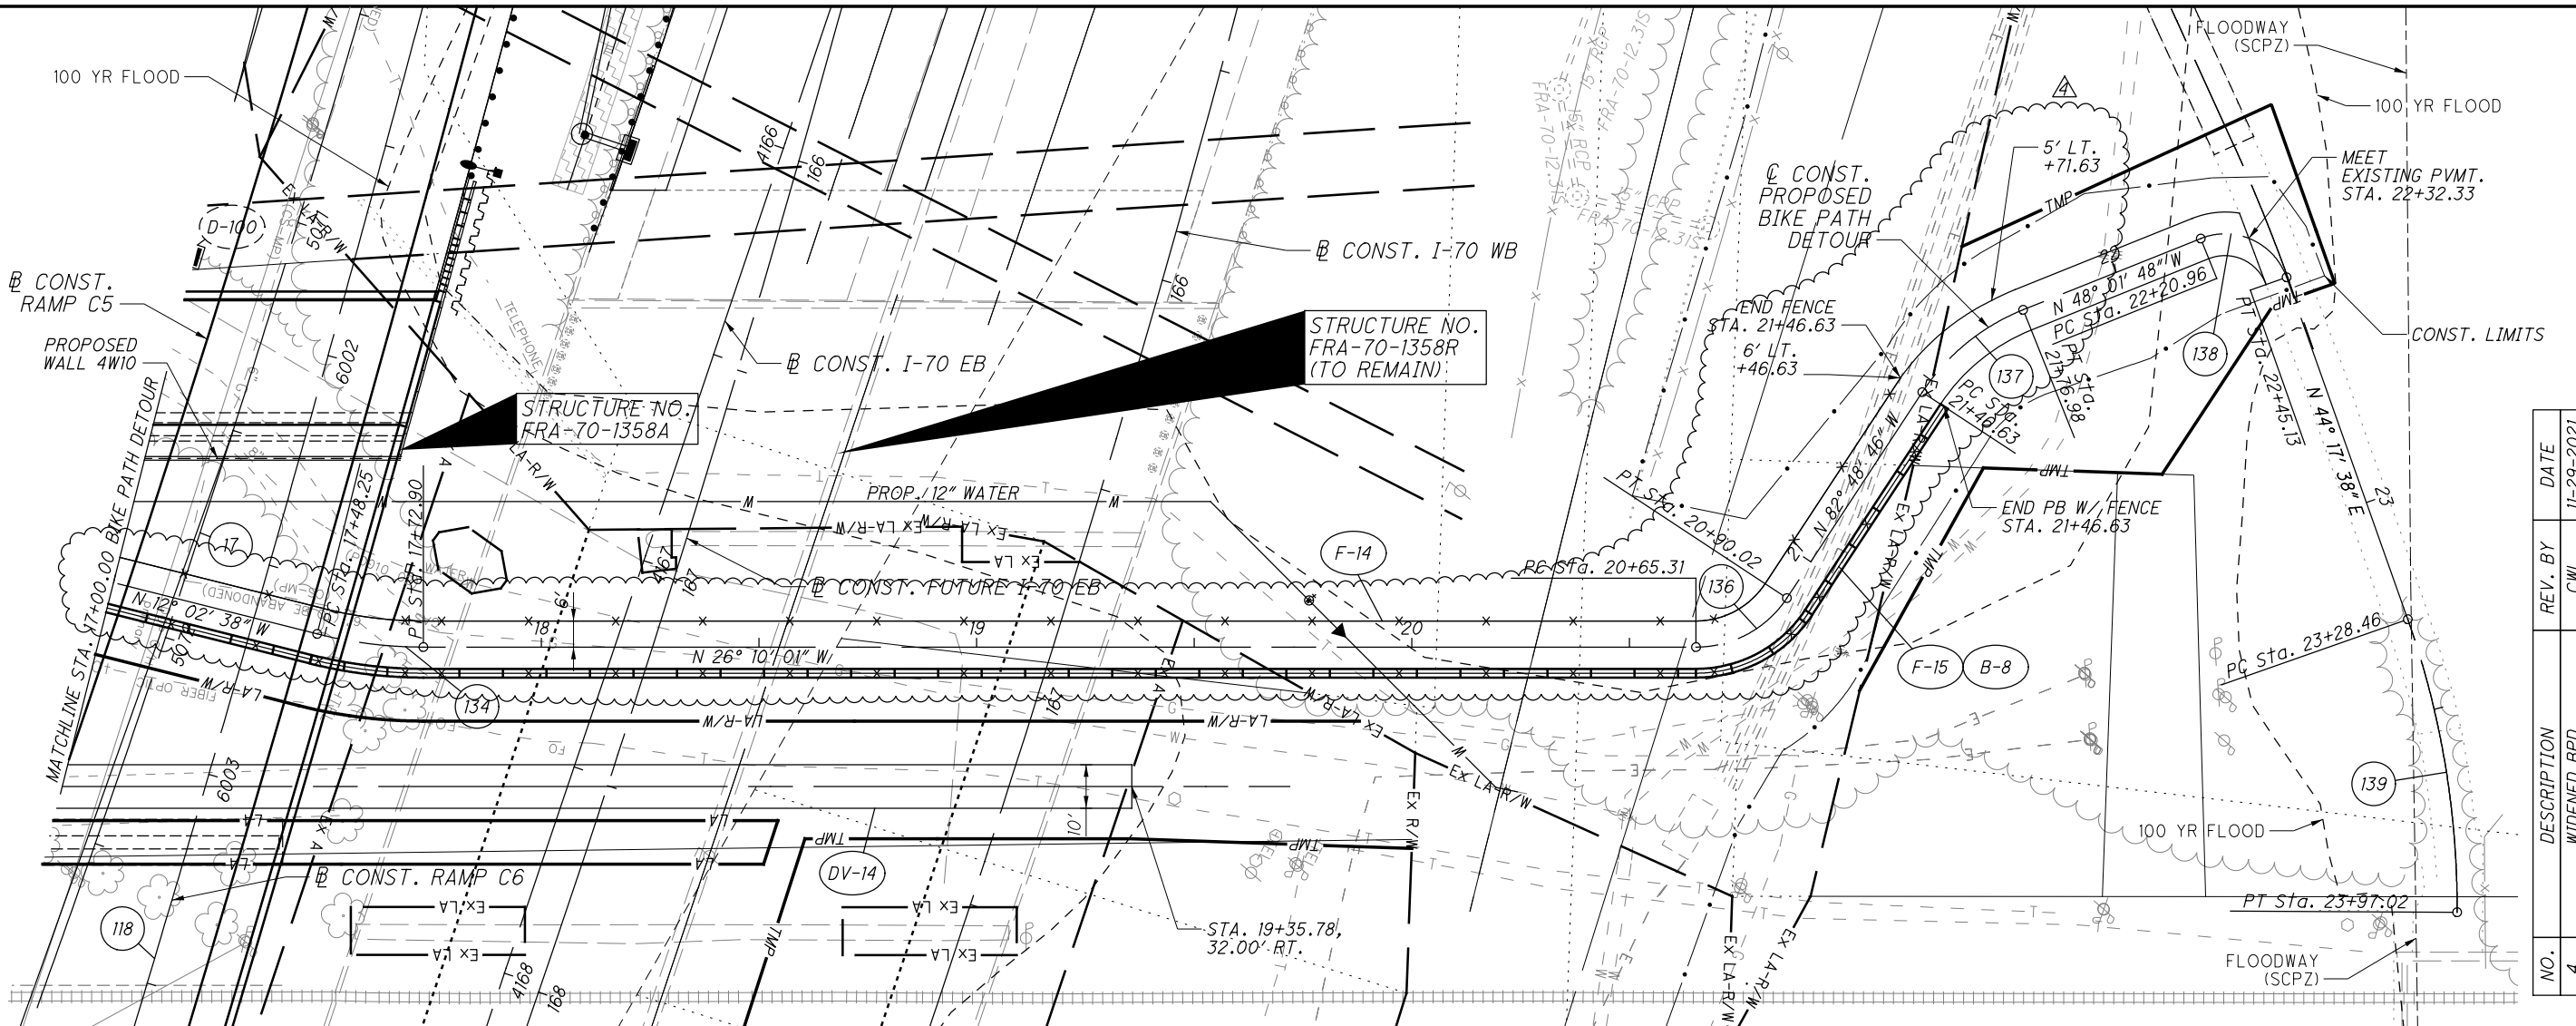

NO.	DESCRIPTION	REV. BY	DATE
4	WIDENED BPD	CWL	11-29-2021

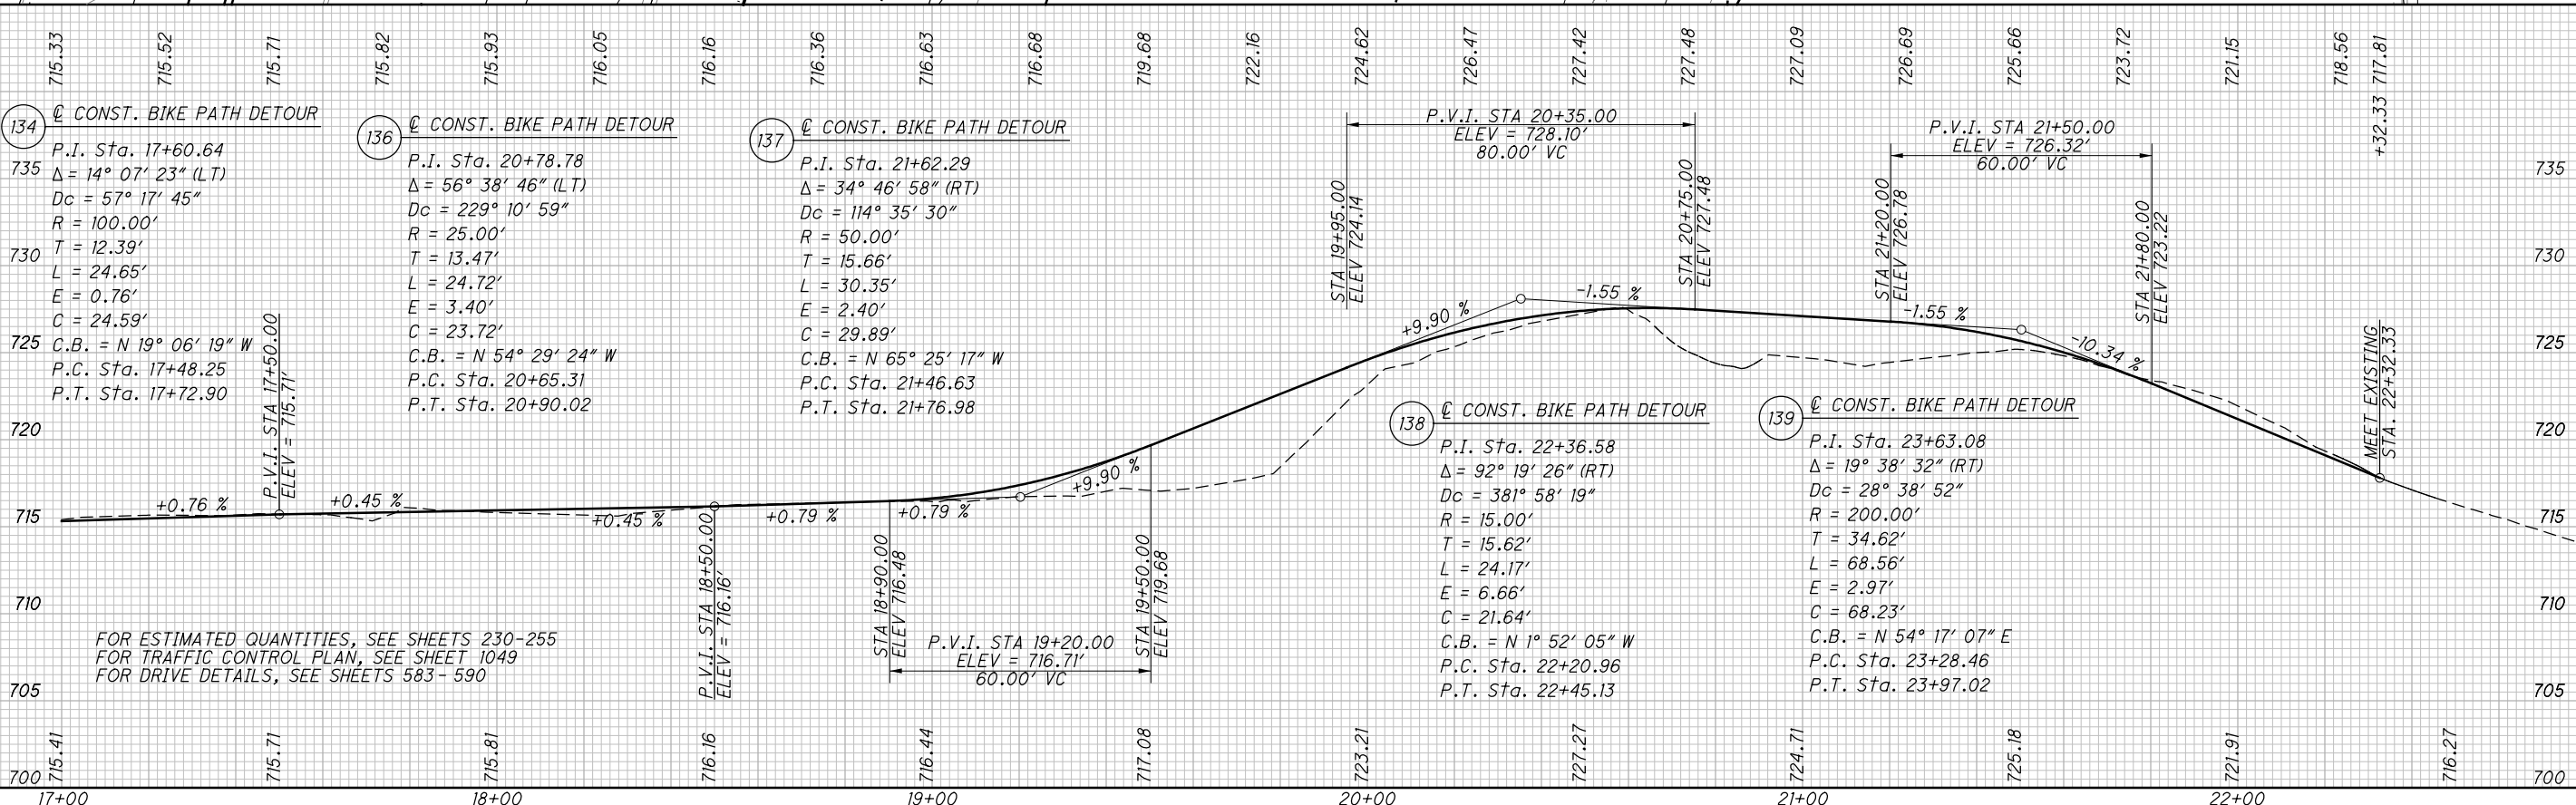

134 **CONST. BIKE PATH DETOUR**
 P.I. Sta. 17+60.64
 $\Delta = 14^\circ 07' 23''$ (LT)
 $D_c = 57^\circ 17' 45''$
 $R = 100.00'$
 $T = 12.39'$
 $L = 24.65'$
 $E = 0.76'$
 $C = 24.59'$
 C.B. = N $19^\circ 06' 19''$ W
 P.C. Sta. 17+48.25
 P.T. Sta. 17+72.90

136 **CONST. BIKE PATH DETOUR**
 P.I. Sta. 20+78.78
 $\Delta = 56^\circ 38' 46''$ (LT)
 $D_c = 229^\circ 10' 59''$
 $R = 25.00'$
 $T = 13.47'$
 $L = 24.72'$
 $E = 3.40'$
 $C = 23.72'$
 C.B. = N $54^\circ 29' 24''$ W
 P.C. Sta. 20+65.31
 P.T. Sta. 20+90.02

137 **CONST. BIKE PATH DETOUR**
 P.I. Sta. 21+62.29
 $\Delta = 34^\circ 46' 58''$ (RT)
 $D_c = 114^\circ 35' 30''$
 $R = 50.00'$
 $T = 15.66'$
 $L = 30.35'$
 $E = 2.40'$
 $C = 29.89'$
 C.B. = N $65^\circ 25' 17''$ W
 P.C. Sta. 21+46.63
 P.T. Sta. 21+76.98

138 **CONST. BIKE PATH DETOUR**
 P.I. Sta. 22+36.58
 $\Delta = 92^\circ 19' 26''$ (RT)
 $D_c = 381^\circ 58' 19''$
 $R = 15.00'$
 $T = 15.62'$
 $L = 24.17'$
 $E = 6.66'$
 $C = 21.64'$
 C.B. = N $1^\circ 52' 05''$ W
 P.C. Sta. 22+20.96
 P.T. Sta. 22+45.13

139 **CONST. BIKE PATH DETOUR**
 P.I. Sta. 23+63.08
 $\Delta = 19^\circ 38' 32''$ (RT)
 $D_c = 28^\circ 38' 52''$
 $R = 200.00'$
 $T = 34.62'$
 $L = 68.56'$
 $E = 2.97'$
 $C = 68.23'$
 C.B. = N $54^\circ 17' 07''$ E
 P.C. Sta. 23+28.46
 P.T. Sta. 23+97.02

FOR ESTIMATED QUANTITIES, SEE SHEETS 230-255
 FOR TRAFFIC CONTROL PLAN, SEE SHEET 1049
 FOR DRIVE DETAILS, SEE SHEETS 583-590

01-2012-2012048\FRA\105525\ROADWAY\SHSHEETS\105525P104.DGN
 11/27/2021 11:43:21 PM
 DDDTY81STD_USER


SEEDING
END WIDTH SO. YDS.

NO.	DESCRIPTION	REV. BY	DATE
4	WIDENED BPD	CWL	11-29-2021

END AREA VOLUME
CUT FILL CUT FILL
CALCULATED
ATR
CHECKED
CWL

39
720
715
710
705
700
28
720
715
710
705
700
4
720
715
710
705
700
56
725
720
715
710
705
700
16
123

720
715
710
705
700
8 0
16 0
9 0
18 4
10 4
17 1
16 0
18 4
10 4
51 5

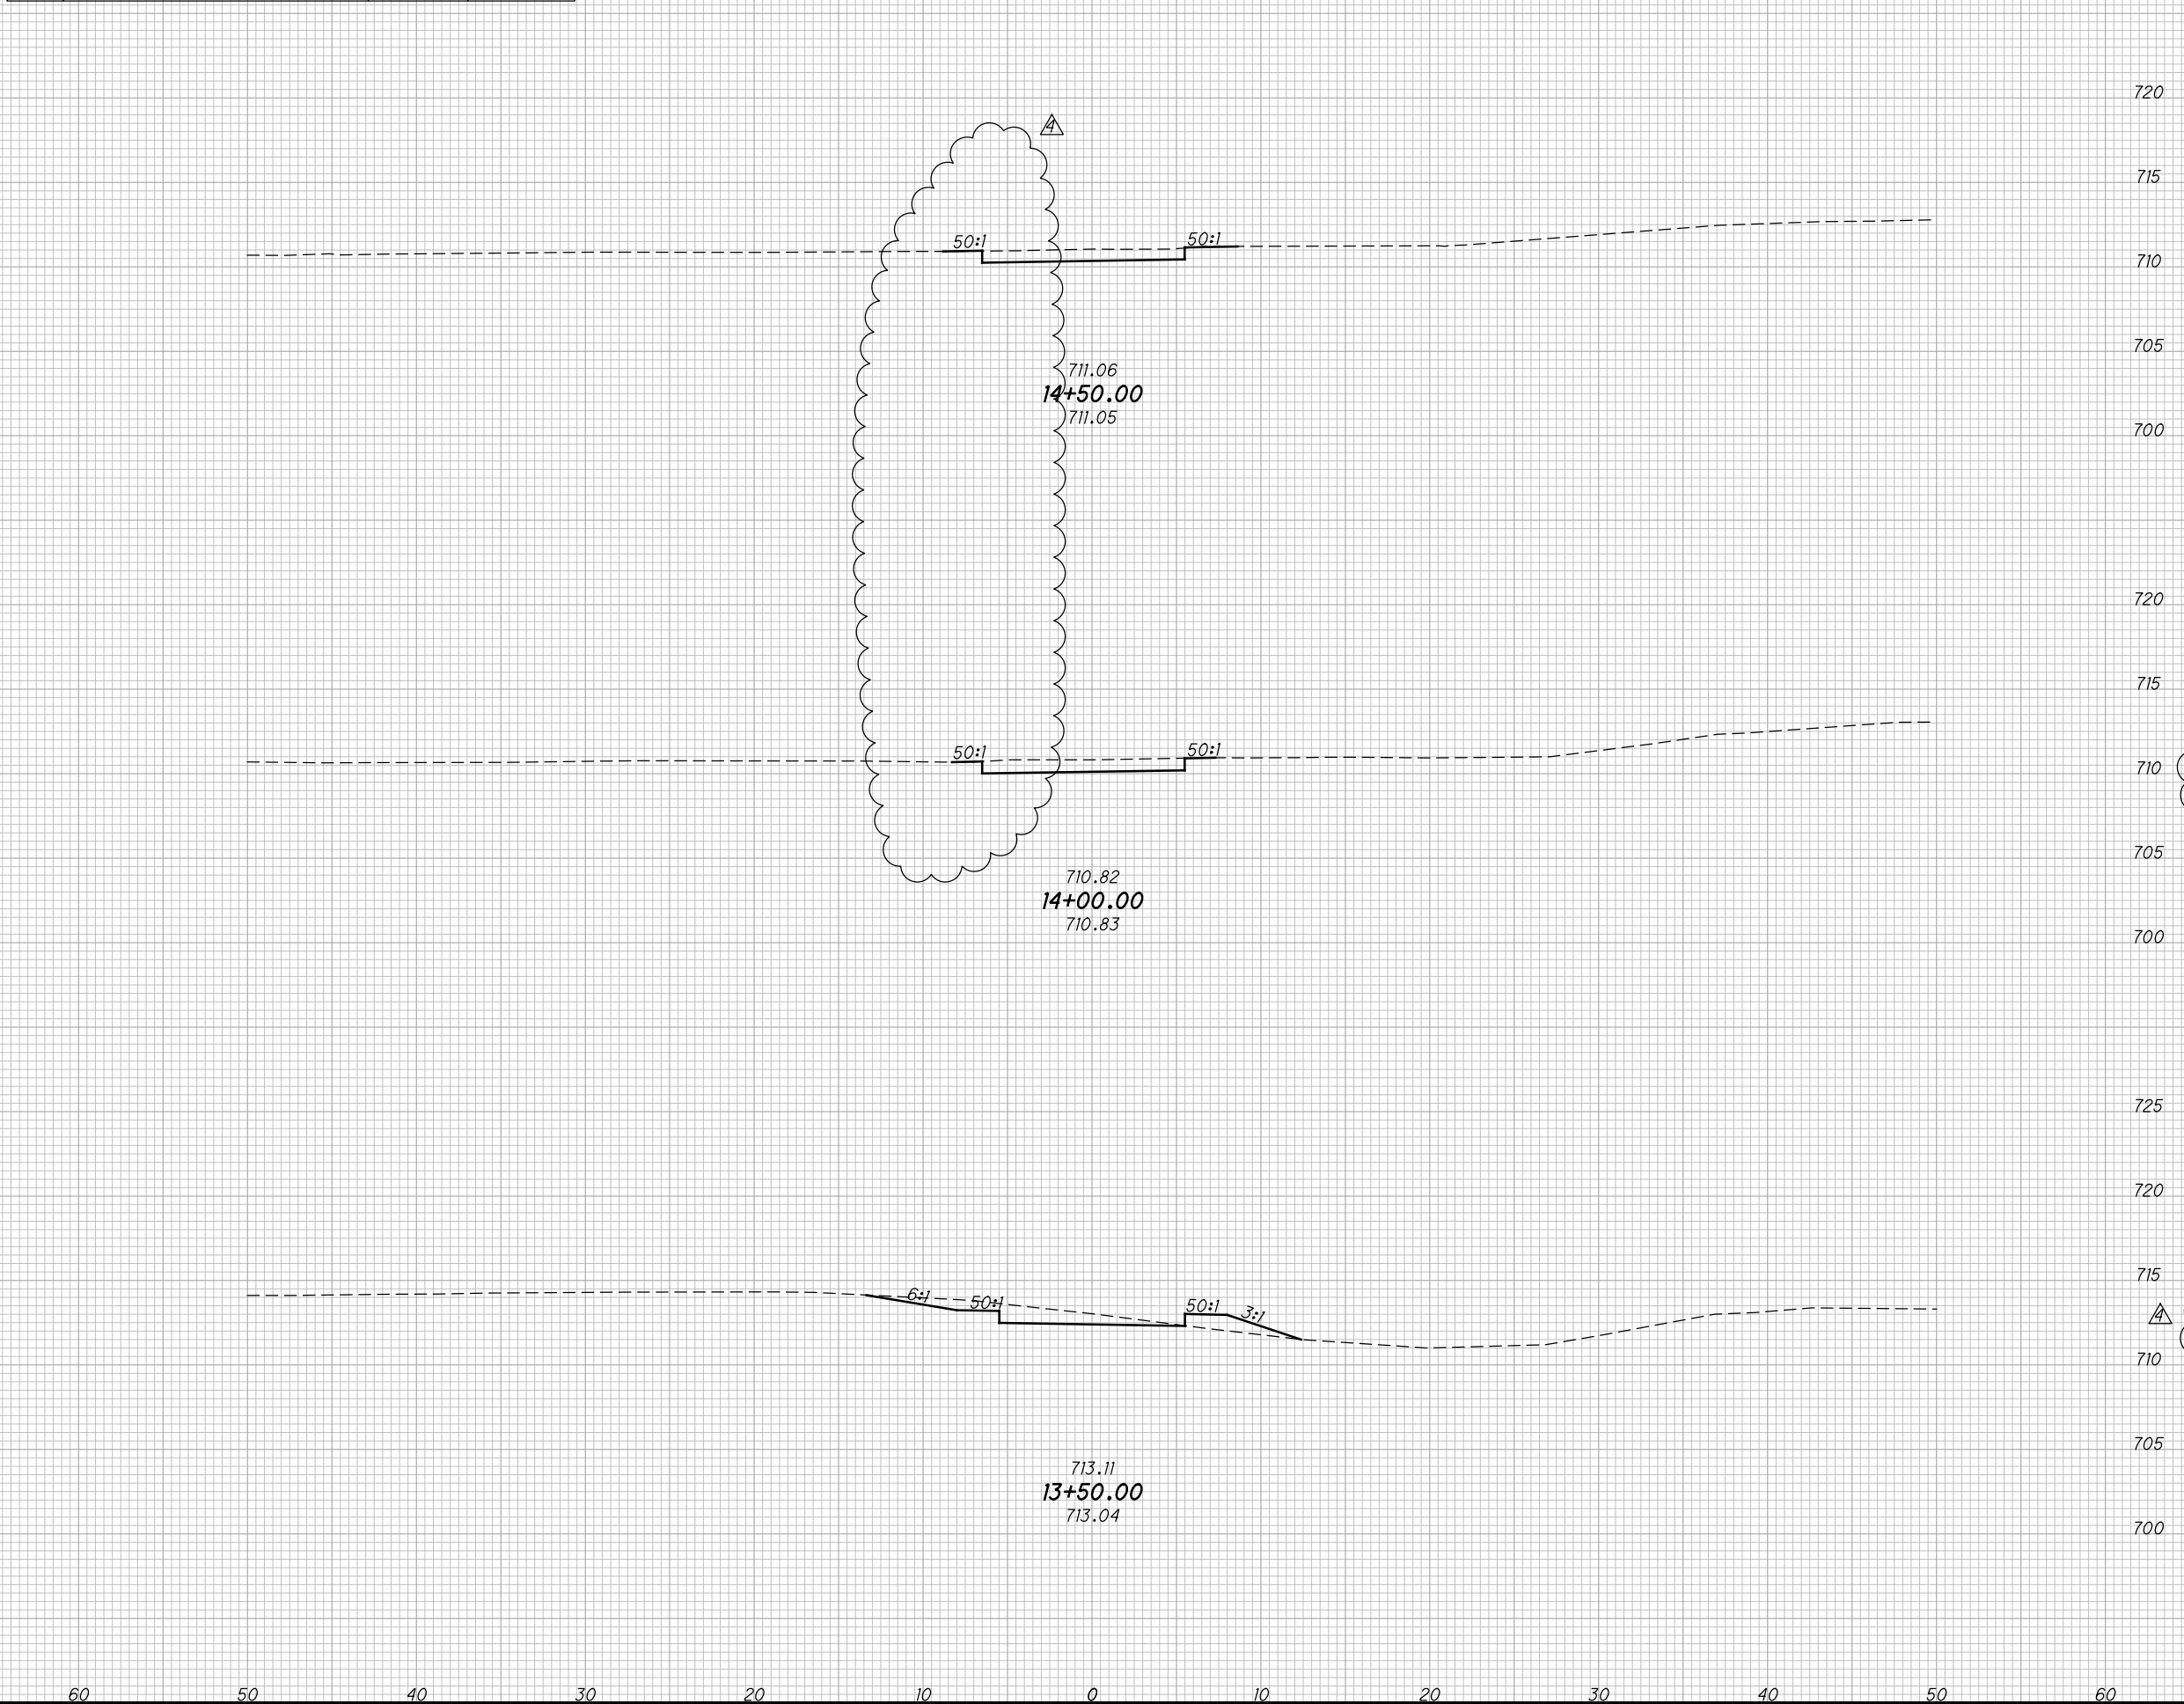

**CROSS SECTIONS BIKE PATH DETOUR
STA. 13+50.00 TO STA. 14+50.00**

FRA -70/ 71-12.68 / 14.86

643G
1815

0:\2012\2012048\FRA\105523\ROADWAY\105523\S102.DGN
 11/27/2021
 2:10:37 PM
 800F91STD.LUSER

SEEDING	
END WIDTH	SO. YRS.
39	
11	
56	
9	
47	
8	
142	


NO.	DESCRIPTION	REV. BY	DATE
4	WIDENED BPD	CWL	11-29-2021

END STA	END AREA		VOLUME		CALCULATED ATR	CHECKED CWL
	CUT	FILL	CUT	FILL		
19			19	2		
11			1			
19			19	2		
9			1			
18			18	2		
10			1			
56			56	6		

**CROSS SECTIONS BIKE PATH DETOUR
 STA. 15+00.00 TO STA. 16+00.00**

FRA -70/ 71-12.68 / 14.86


643H
 1815

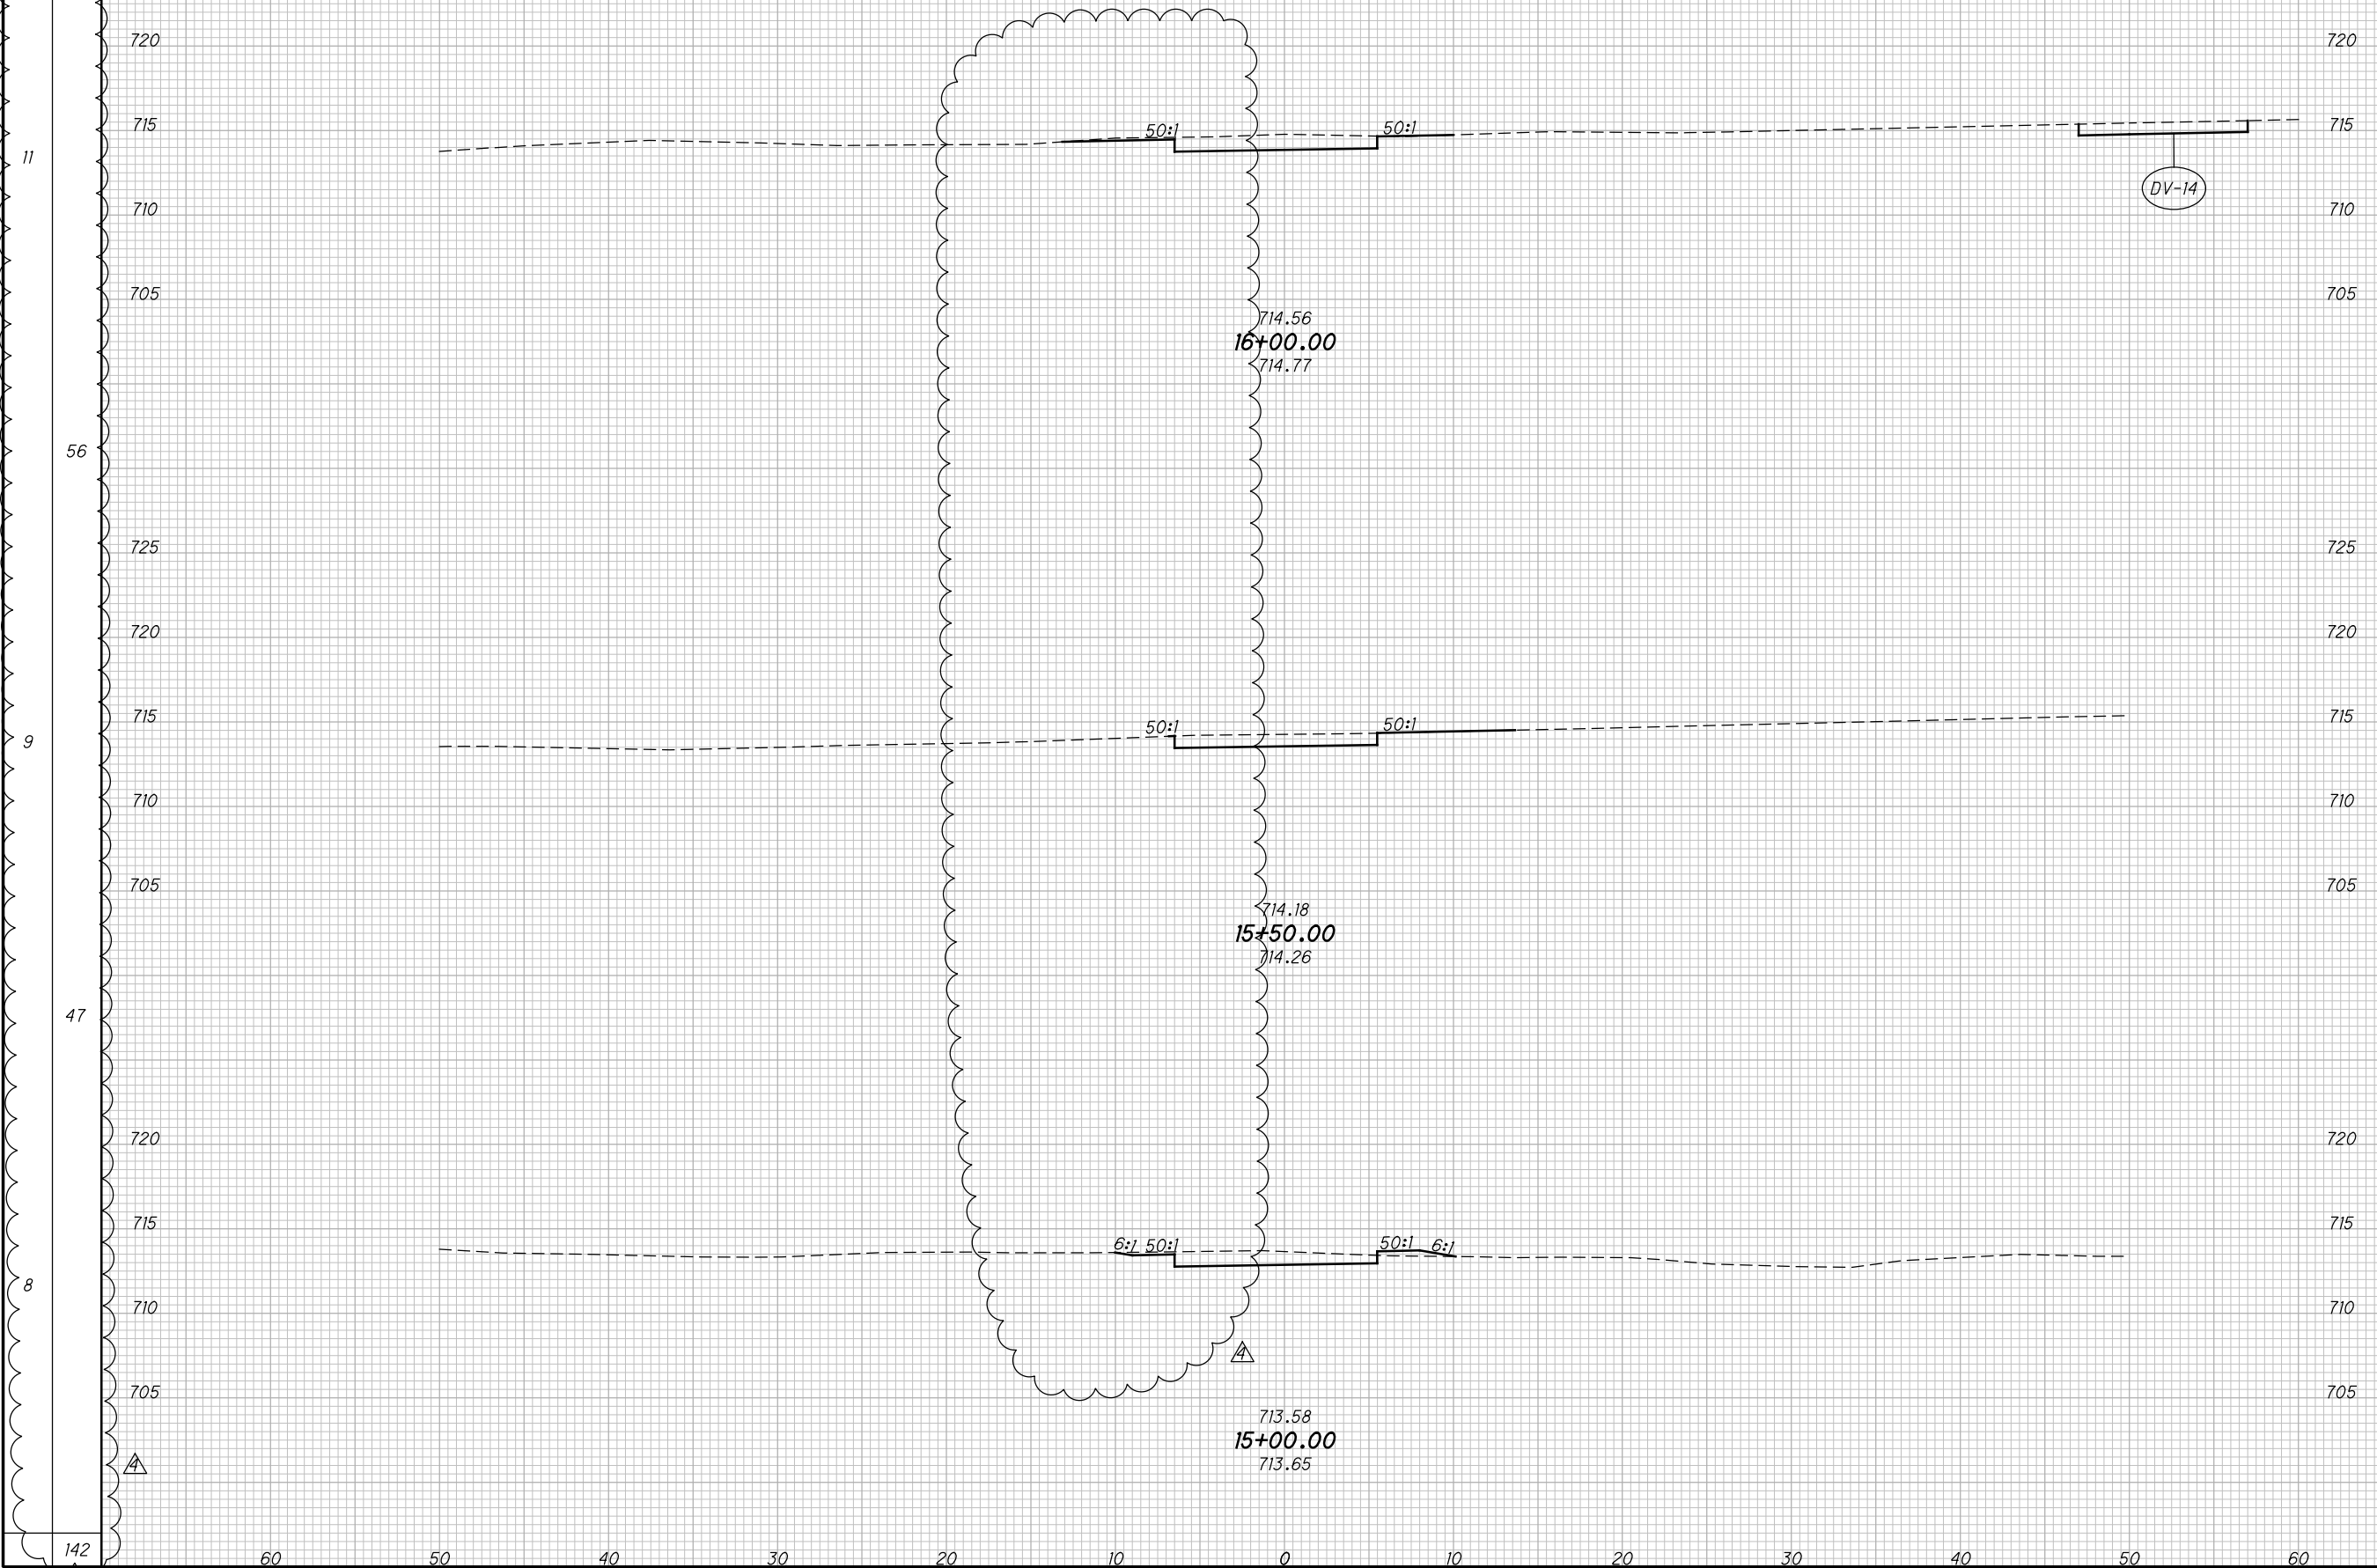

SEEDING	
END WIDTH	SO. YDS.
69	

NO.	DESCRIPTION	REV. BY	DATE
4	WIDENED BPD	CWL	11-29-2021

END AREA		VOLUME		CALCULATED ATR	CHECKED CWL
CUT	FILL	CUT	FILL		
		16	2		

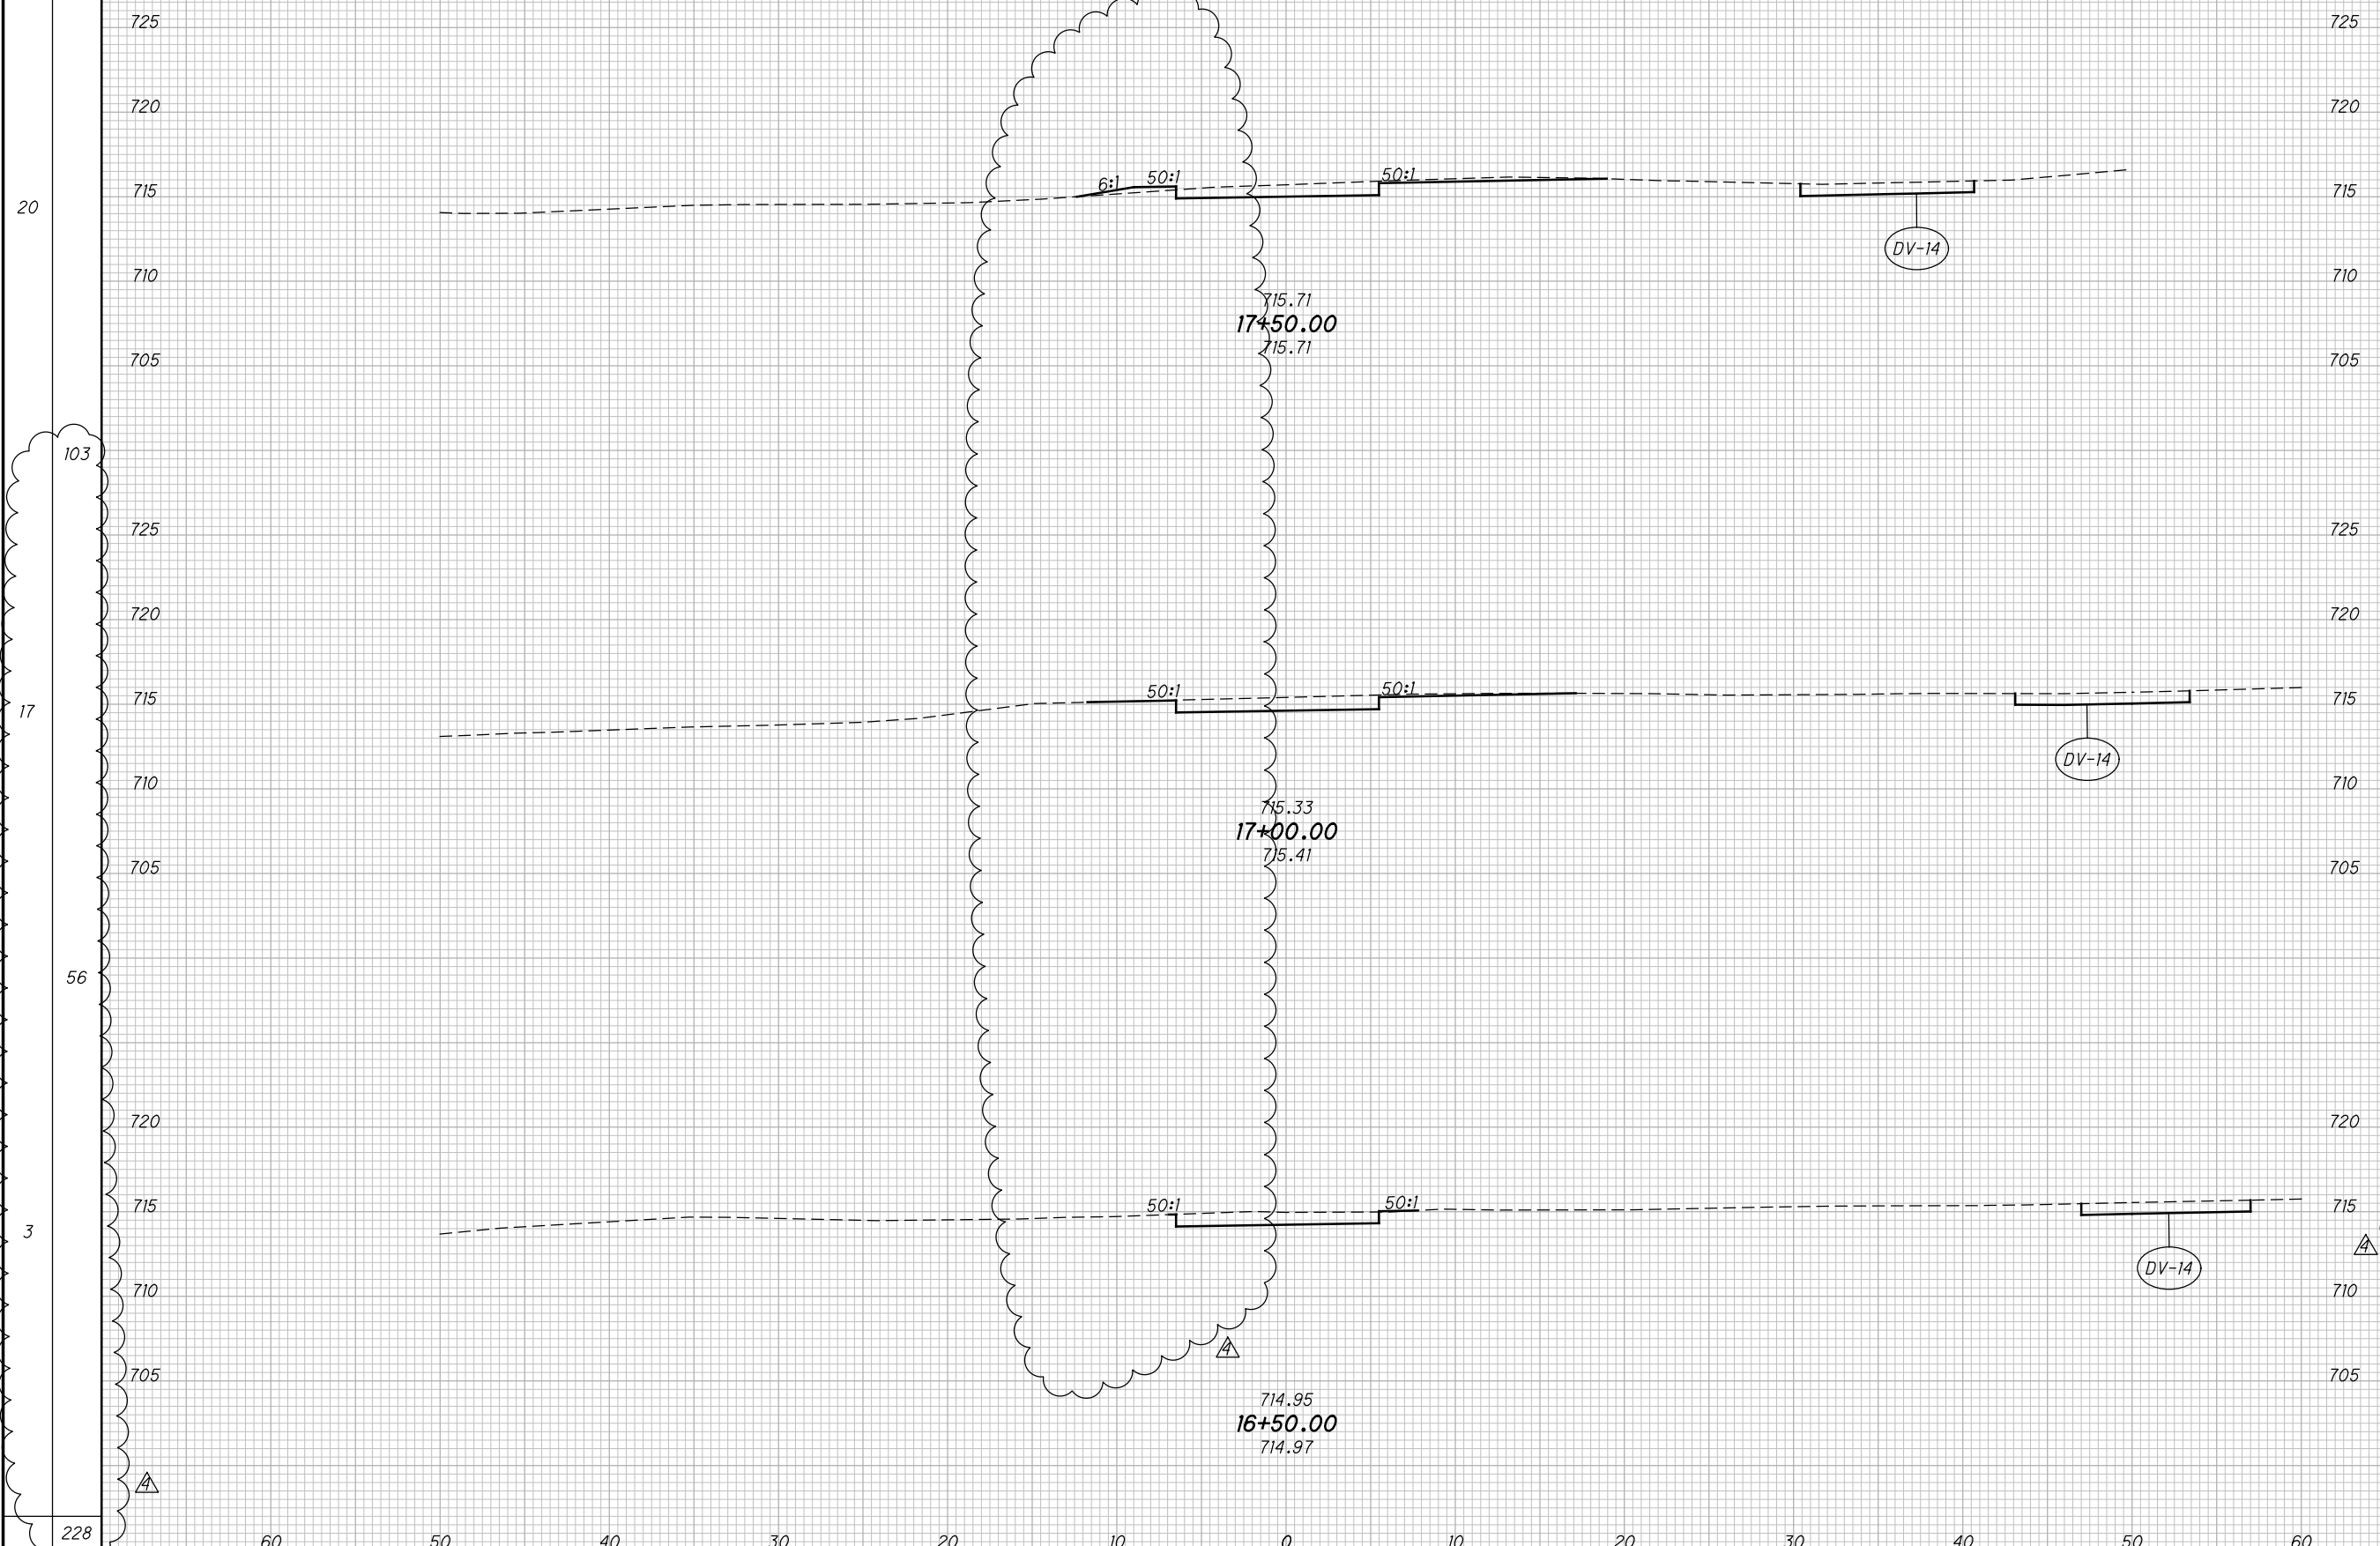

END AREA		VOLUME		CALCULATED ATR	CHECKED CWL
CUT	FILL	CUT	FILL		
10	1	16	2		
11	0	20	1		
19	1	55	4		

CROSS SECTIONS BIKE PATH DETOUR
STA. 16+50.00 TO STA. 17+50.00

FRA - 70 / 71 - 12.68 / 14.86

643J
 1815

01-2812-2012048 VFR\105523\ROADWAY\105523\102.DGN
 11/27/2021
 2:10:17 PM
 800F\81\STD_USER

60 50 40 30 20 10 0 10 20 30 40 50 60

20

17

56

3

103

228

725

720

715

710

705

725

720

715

710

705

720

715

710

705

725

720

715

710

705

725

720

715

710

705

720

715

710

705

715.71
17+50.00
715.71

715.33
17+00.00
715.41

714.95
16+50.00
714.97

DV-14

DV-14

DV-14

6:1 50:1

50:1

50:1

A



A

A

SEEDING
END WIDTH SO. YDS.
69

NO.	DESCRIPTION	REV. BY	DATE
4	WIDENED BPD	CWL	11-29-2021

END AREA		VOLUME		CALCULATED ATR	CHECKED CWL
CUT	FILL	CUT	FILL		
		15	1		

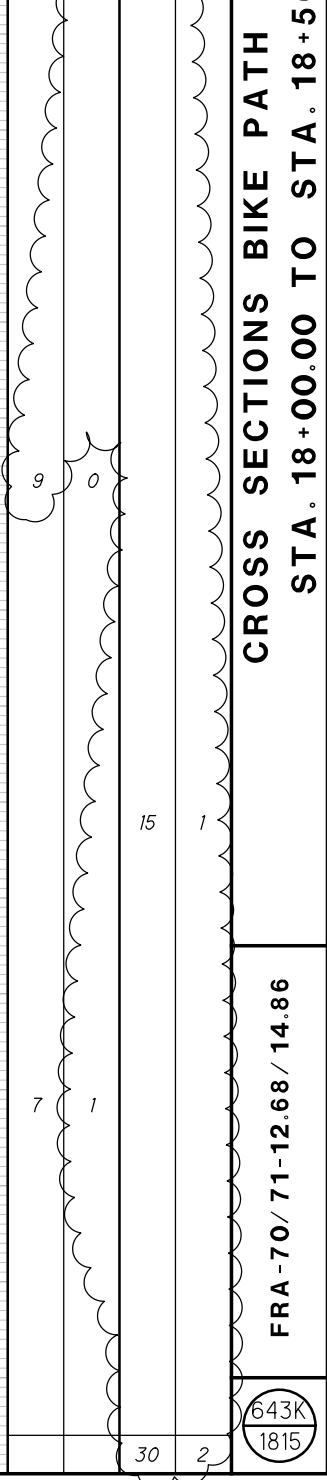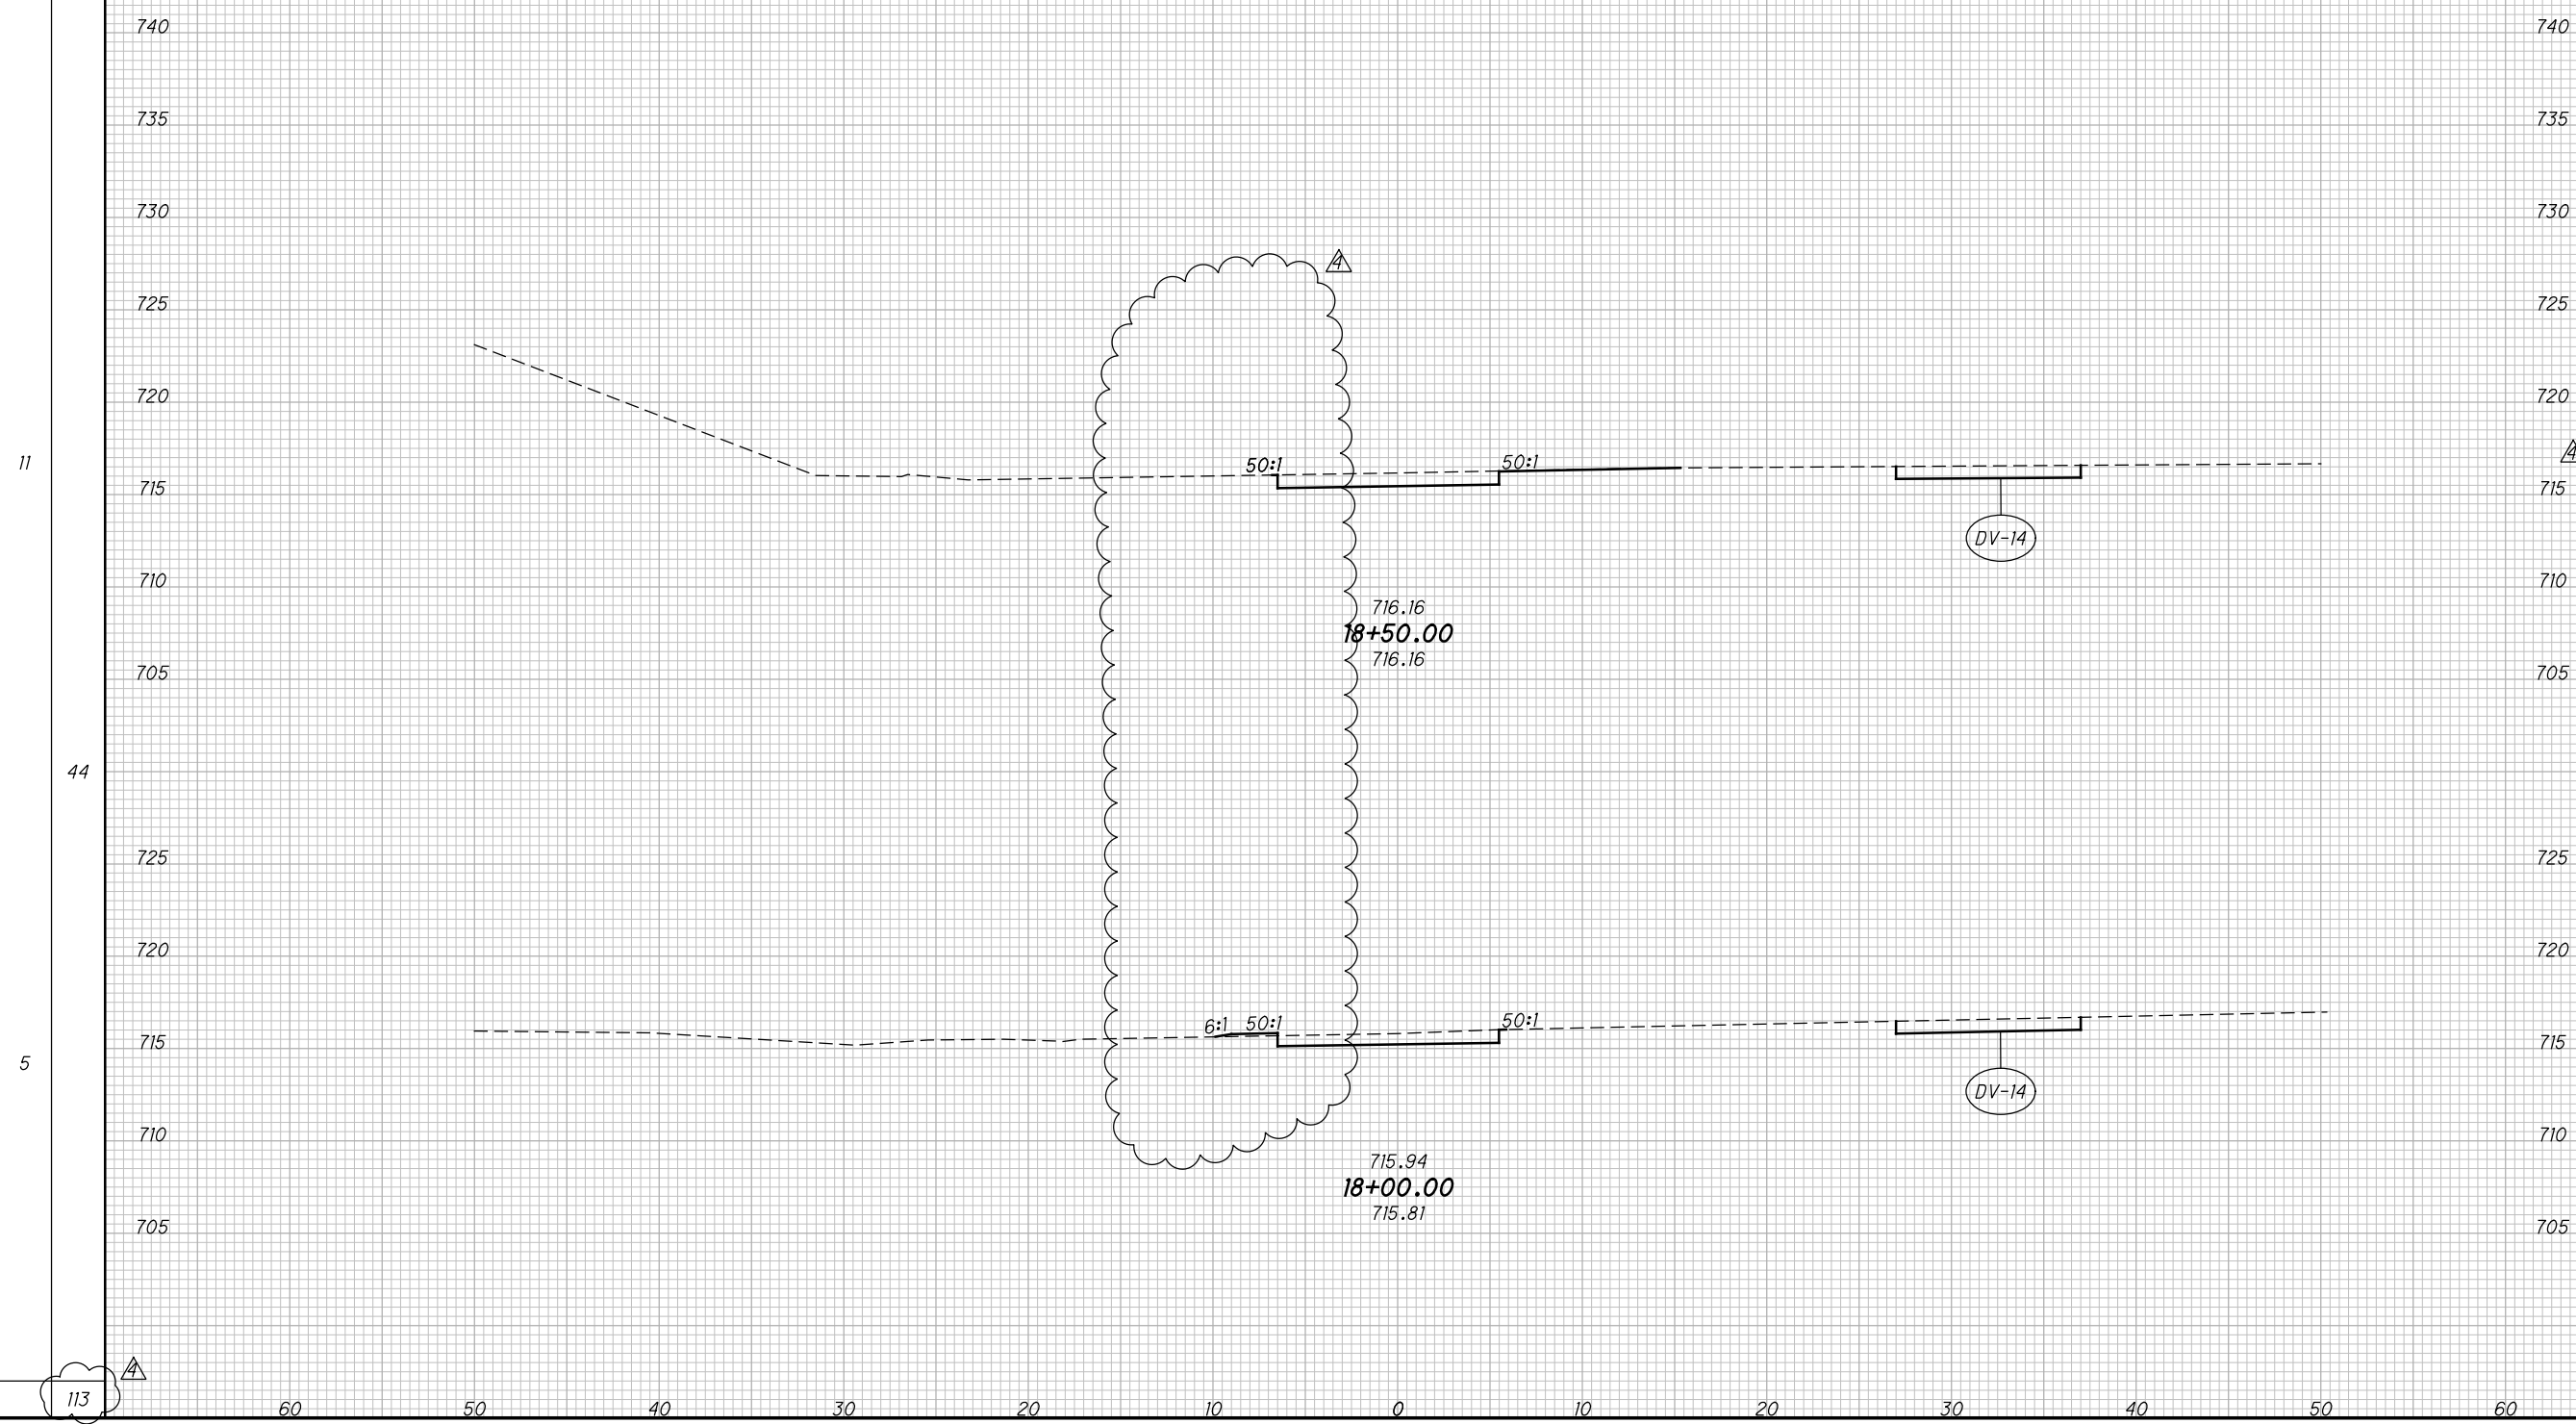

CROSS SECTIONS BIKE PATH DETOUR
STA. 18+00.00 TO STA. 18+50.00

FRA - 70 / 71 - 12.68 / 14.86

643K
1815

D:\2012\2012048\FRA\105523\ROADWAY\SHEETS\105523XS102.DGN
11/27/2021
2:09:54 PM
800F\81STD\USER

113


0:\2012\2012048\FRA\105523\ROADWAY\105523\SHEETS\105523X102.DGN
 11/27/2021
 2:09:35 PM
 800F\81\STD_LUSER

SEEDING	
END WIDTH	SO. YDS.
178	
30	
122	
14	
300	

NO.	DESCRIPTION	REV. BY	DATE
4	WIDENED BPD	CWL	11-29-2021

END AREA		VOLUME		CALCULATED ATR	CHECKED CWL
CUT	FILL	CUT	FILL		
0	79	17	121		
7	1	7	74		
7	1	24	195		

CROSS SECTIONS BIKE PATH DETOUR
STA. 19+00.00 TO STA. 19+50.00
 FRA -70/ 71-12.68 / 14.86
 643L
 1815

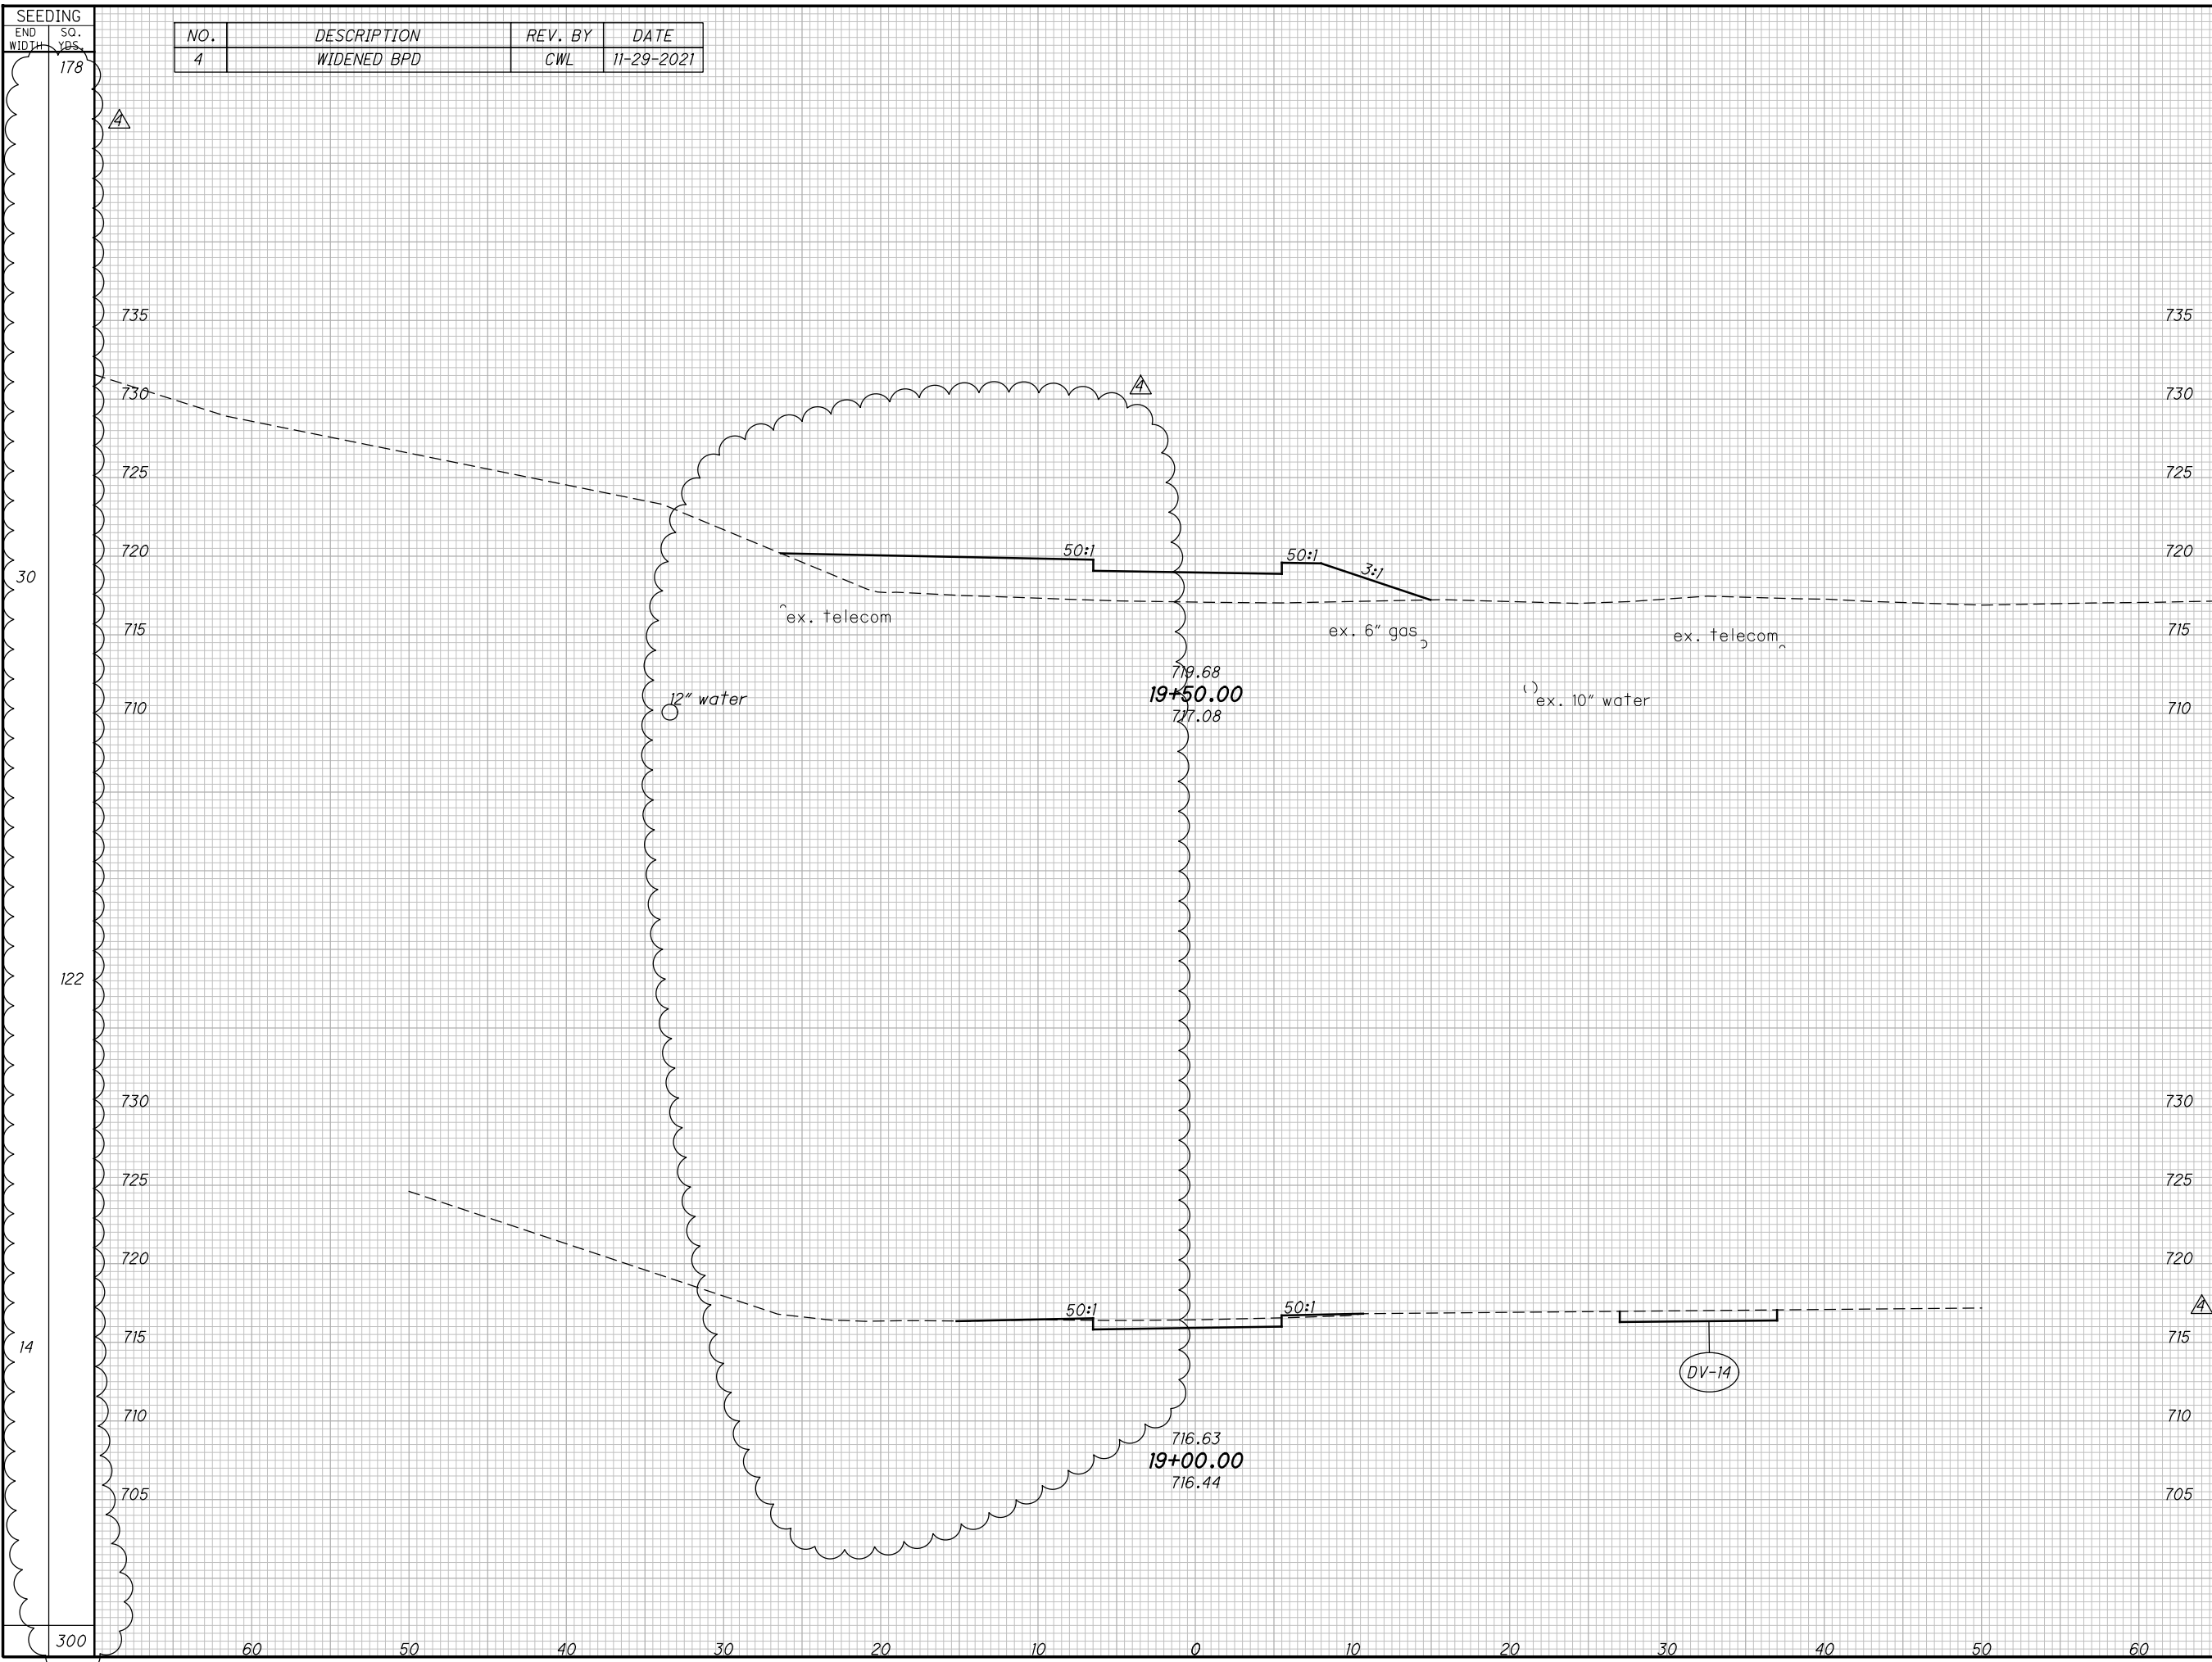


SEEDING	
END WIDTH	SO. YDS.
211	▲

NO.	DESCRIPTION	REV. BY	DATE
4	WIDENED BPD	CWL	11-29-2021

END AREA		VOLUME		CALCULATED		
CUT	FILL	CUT	FILL	ATR	CHECKED	CWL
		52	86			
48	37					
61	82					
18	52					
113	168					

47
225
34
436

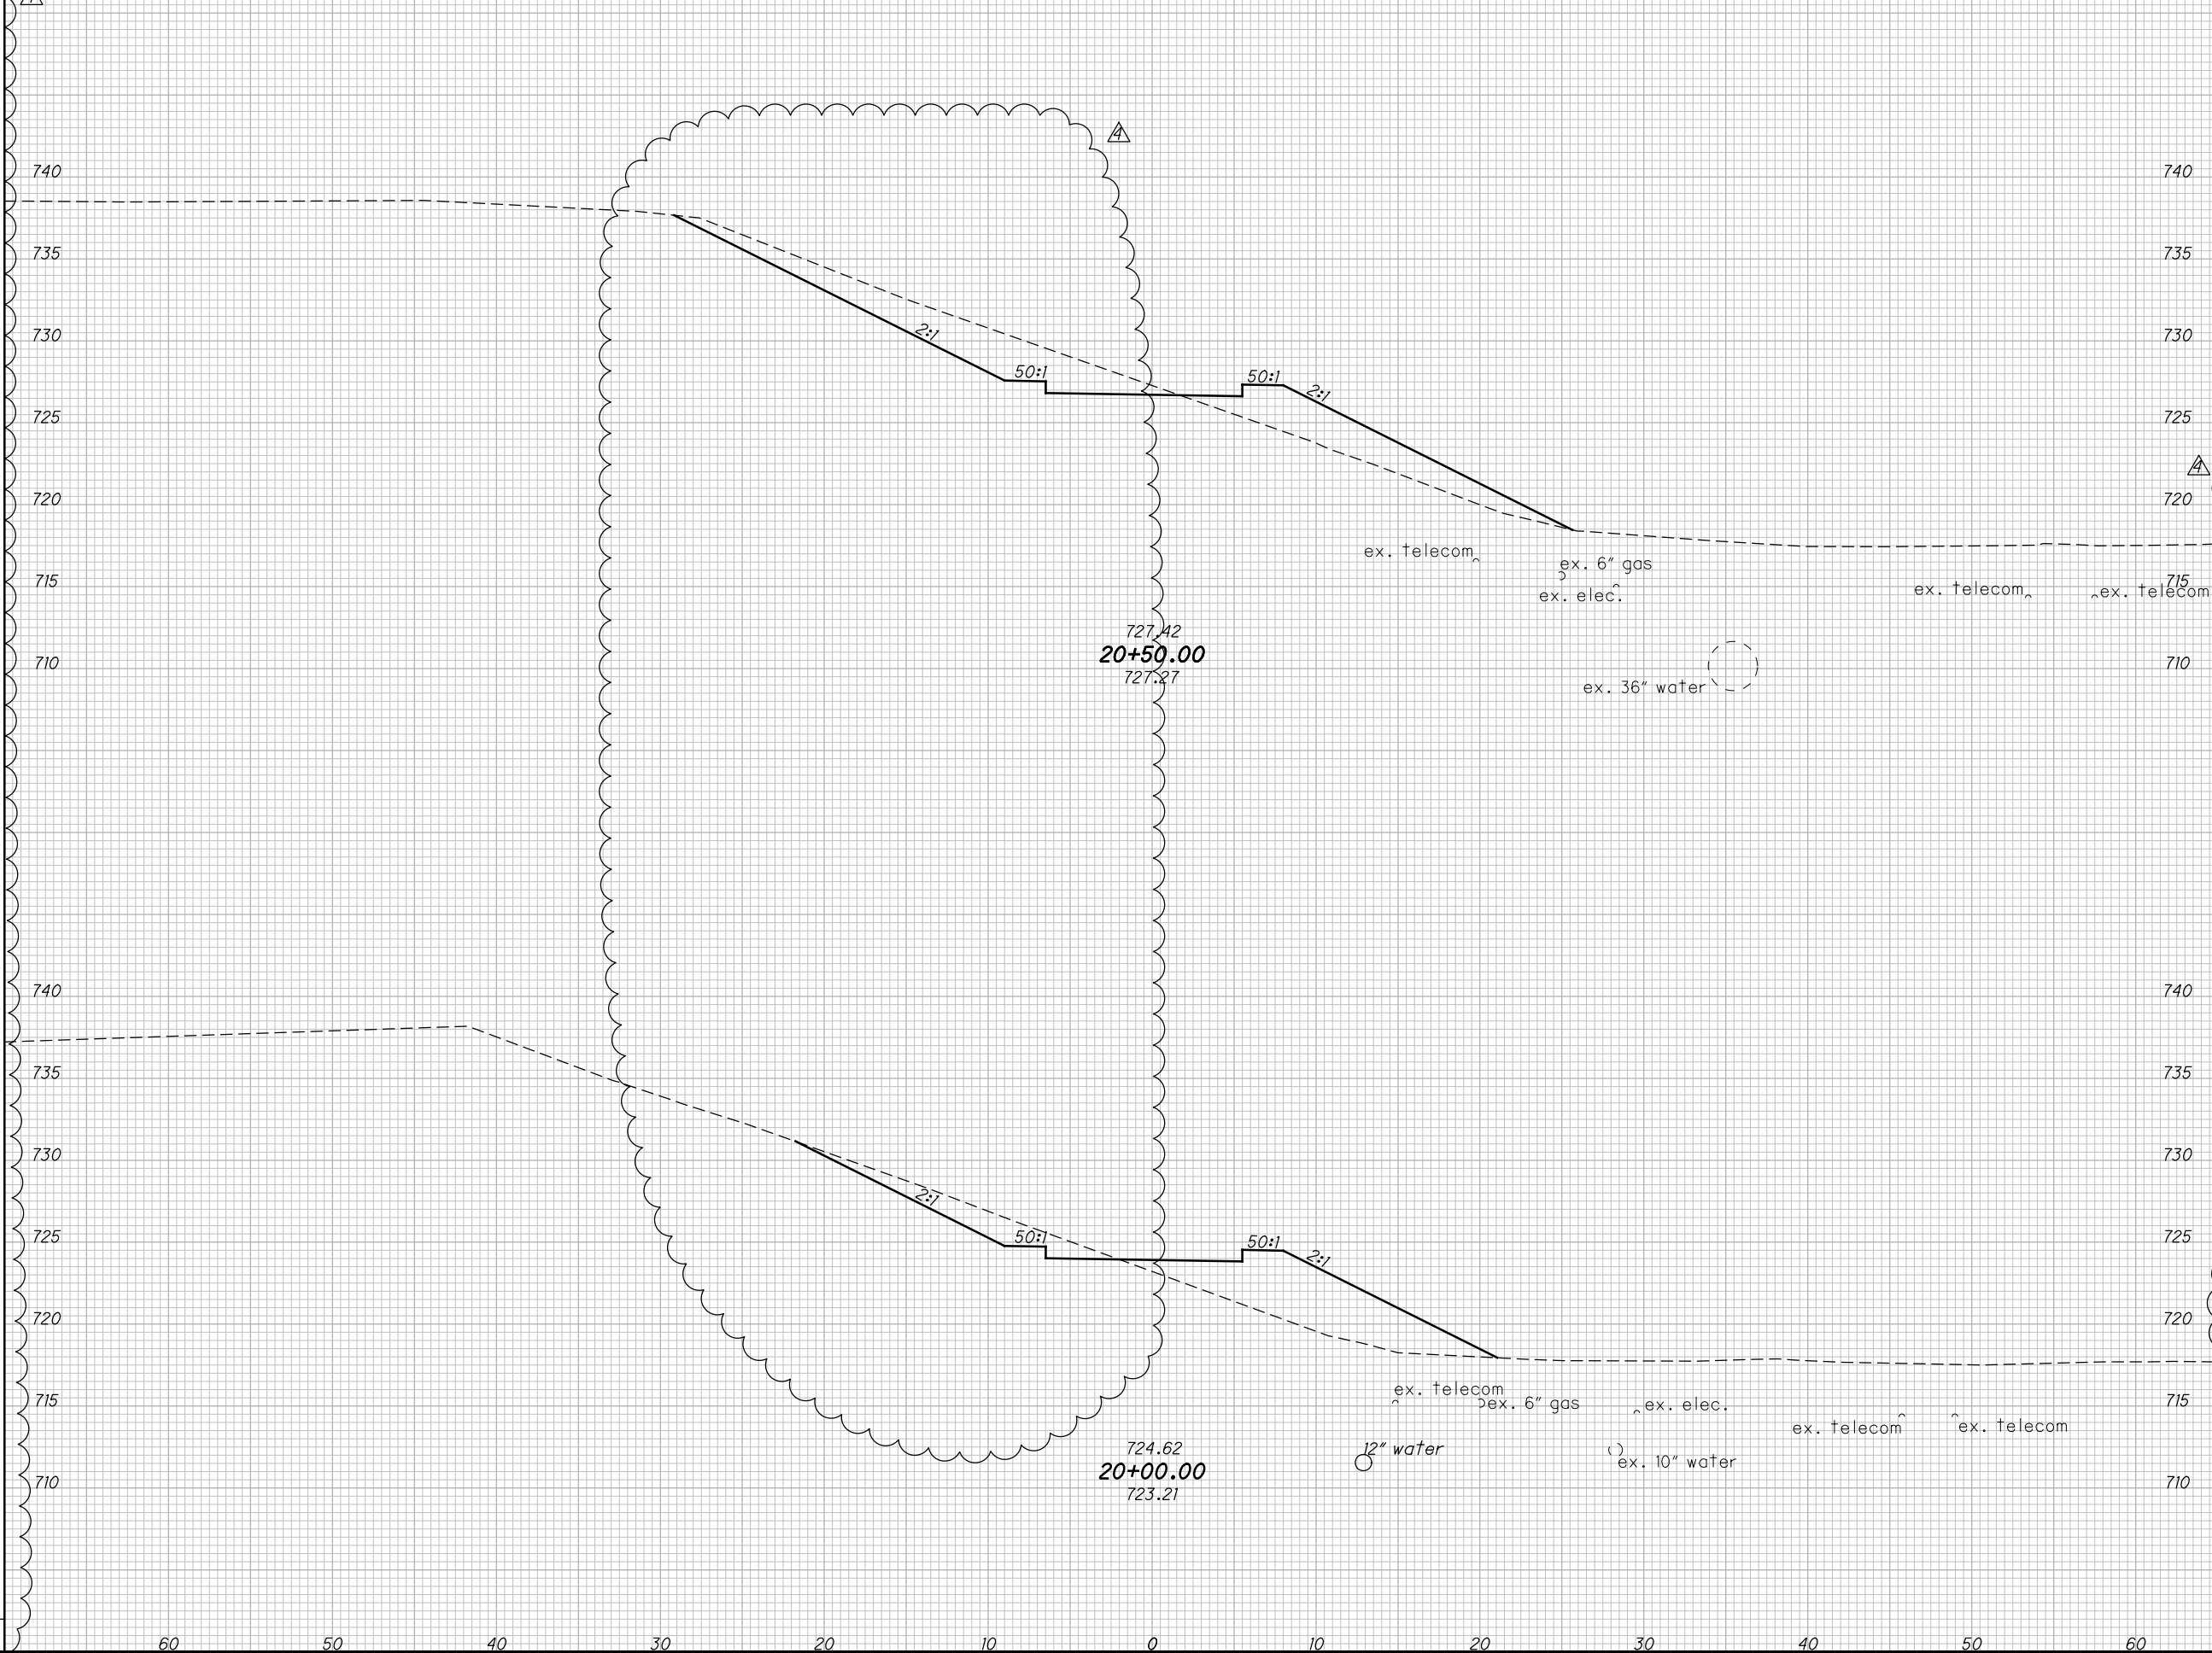

**CROSS SECTIONS BIKE PATH DETOUR
STA. 20+00.00 TO STA. 20+50.00**

FRA -70/ 71-12.68 / 14.86

643M
1815


D:\2012\2012048\FRA\105523\ROADWAY\SHEETS\105523XS102.DGN
11/27/2021
2:09:14 PM
800F\81STD_LUSER

SEEDING
END SO.
WIDTH YDS.

NO.	DESCRIPTION	REV. BY	DATE
4	WIDENED BPD	CWL	11-29-2021

END AREA
CUT FILL
VOLUME
CUT FILL
CALCULATED
ATR
CHECKED
CWL

131
18
131
29
262

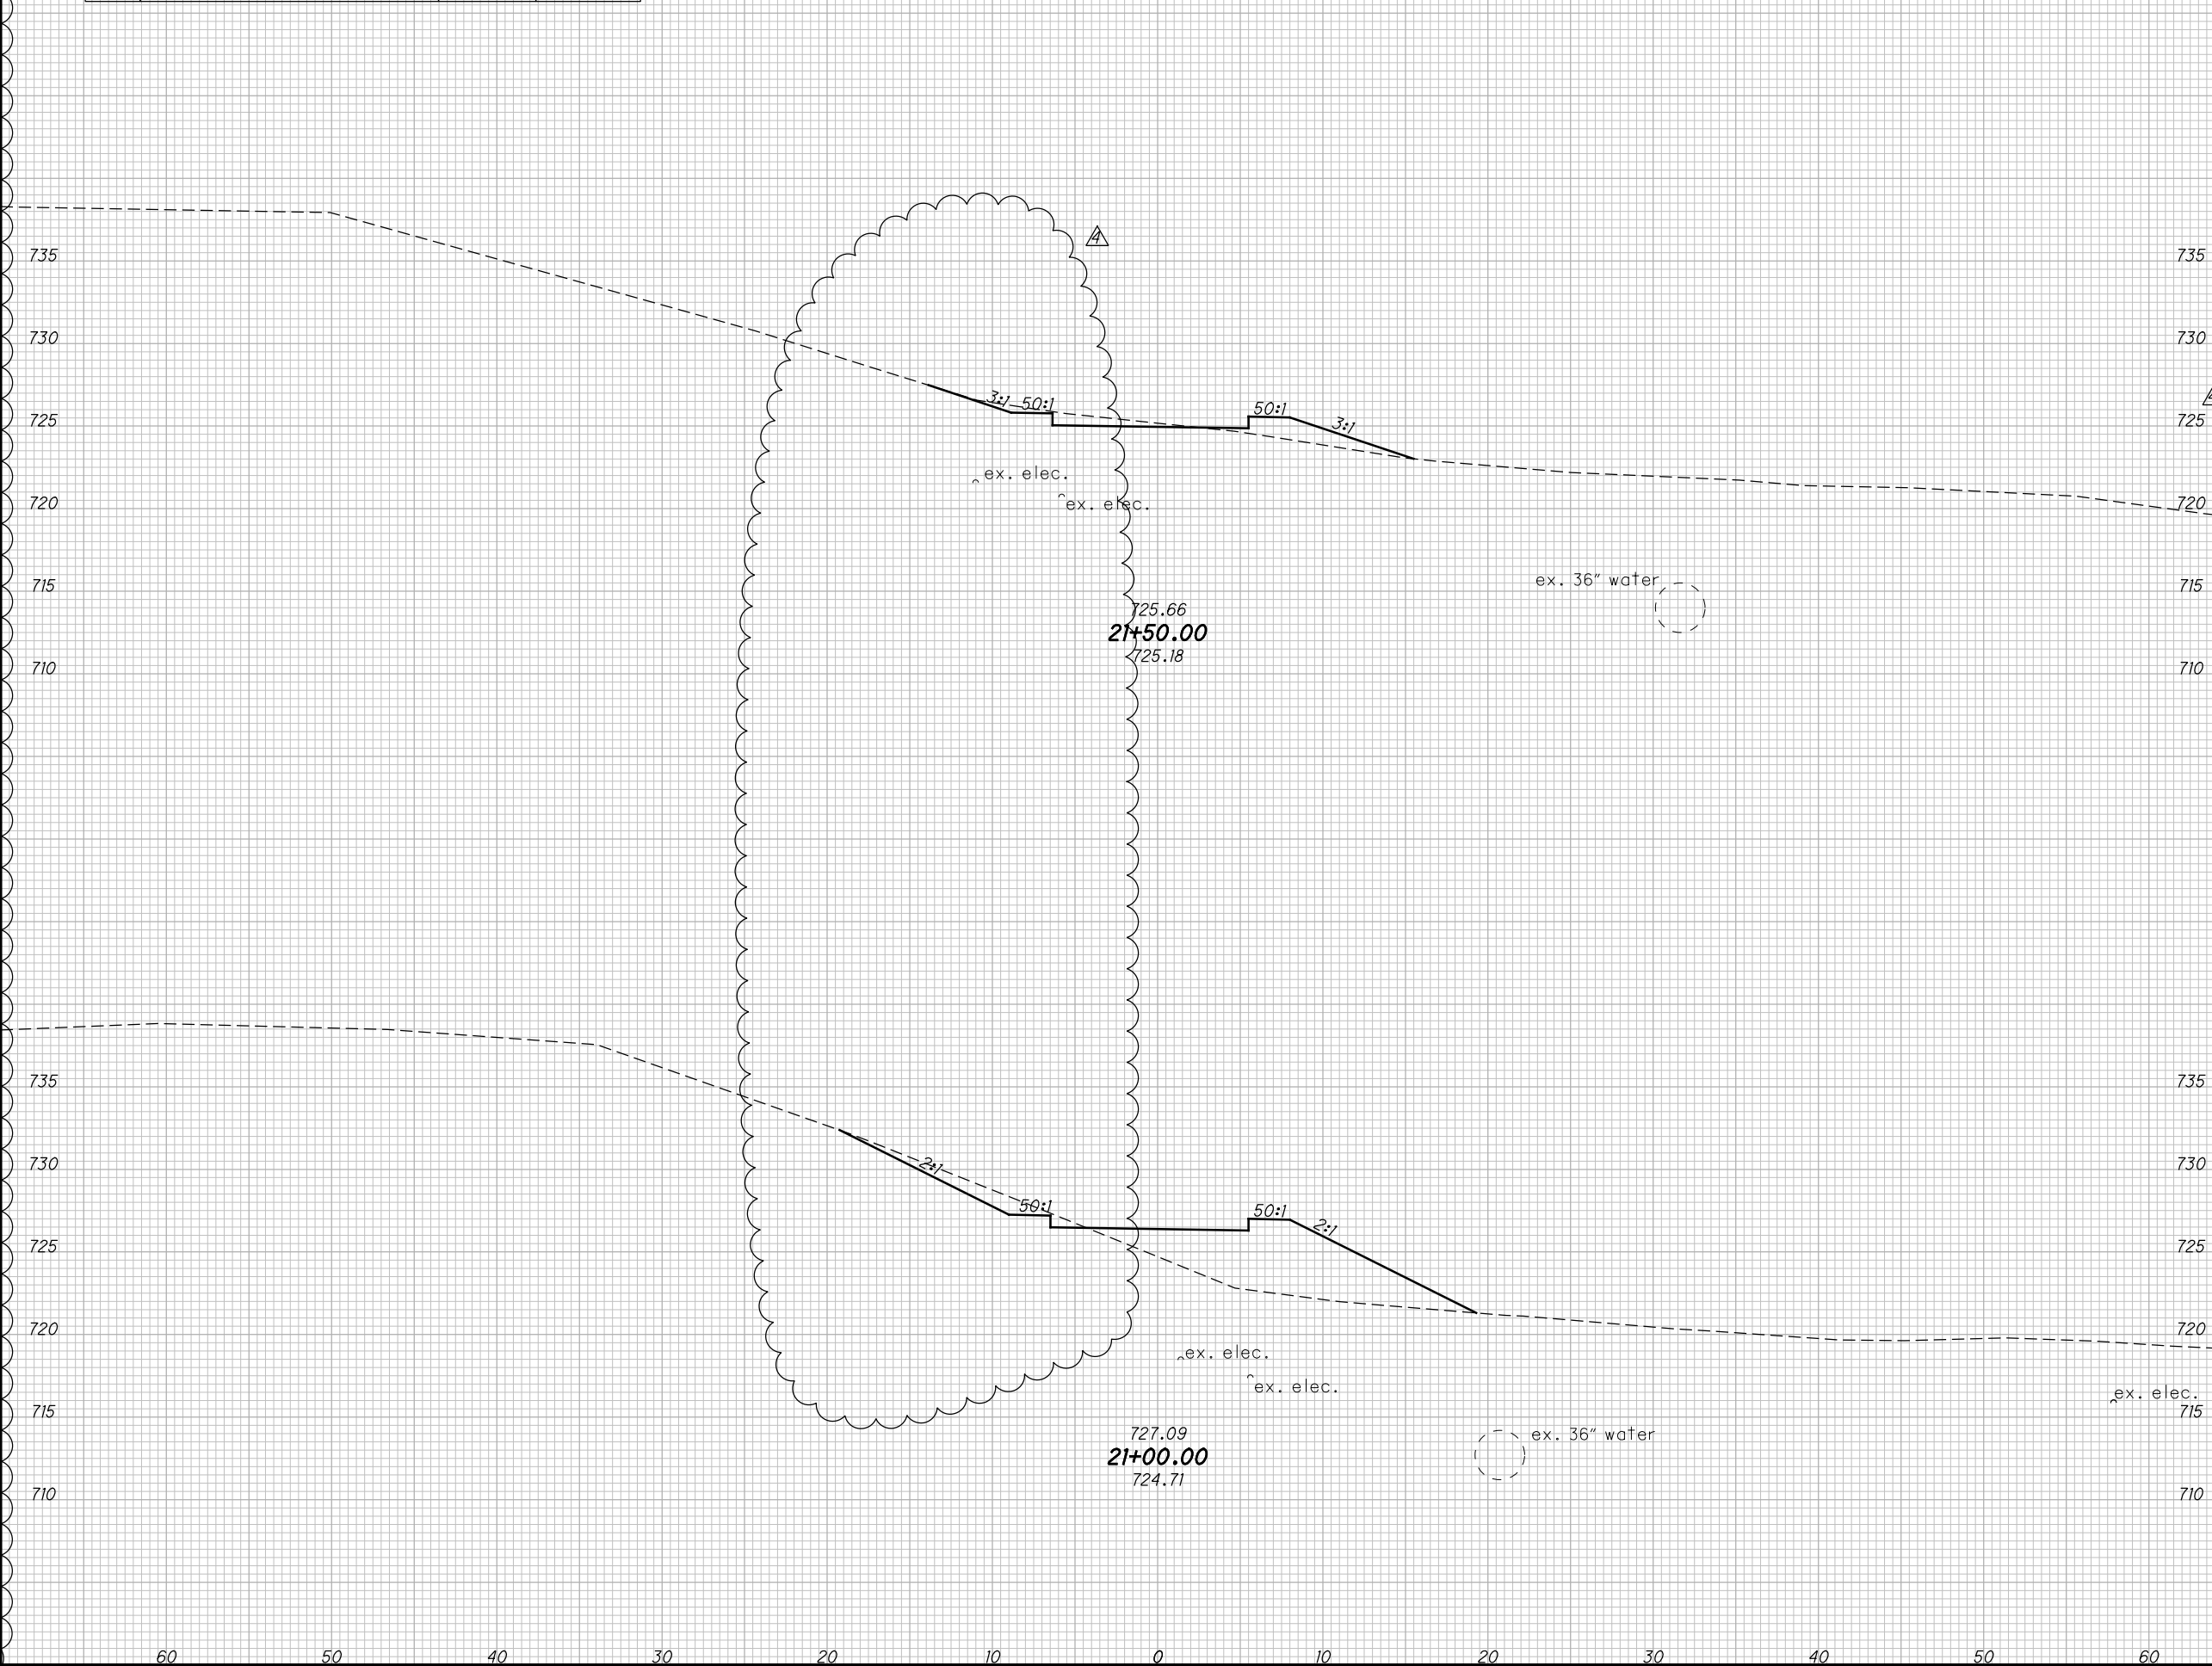



END AREA	VOLUME
CUT	FILL
34	8
5	9
12	60
8	56
46	68

CROSS SECTIONS BIKE PATH DETOUR
STA. 21+00.00 TO STA. 21+50.00

FRA -70/ 71-12.68 / 14.86

643N
1815

D:\2012\2012048\FRA\105523\ROADWAY\SHEETS\105523XS102.DGN
11/27/2021
2:08:53 PM
800F\81\STD_LUSER

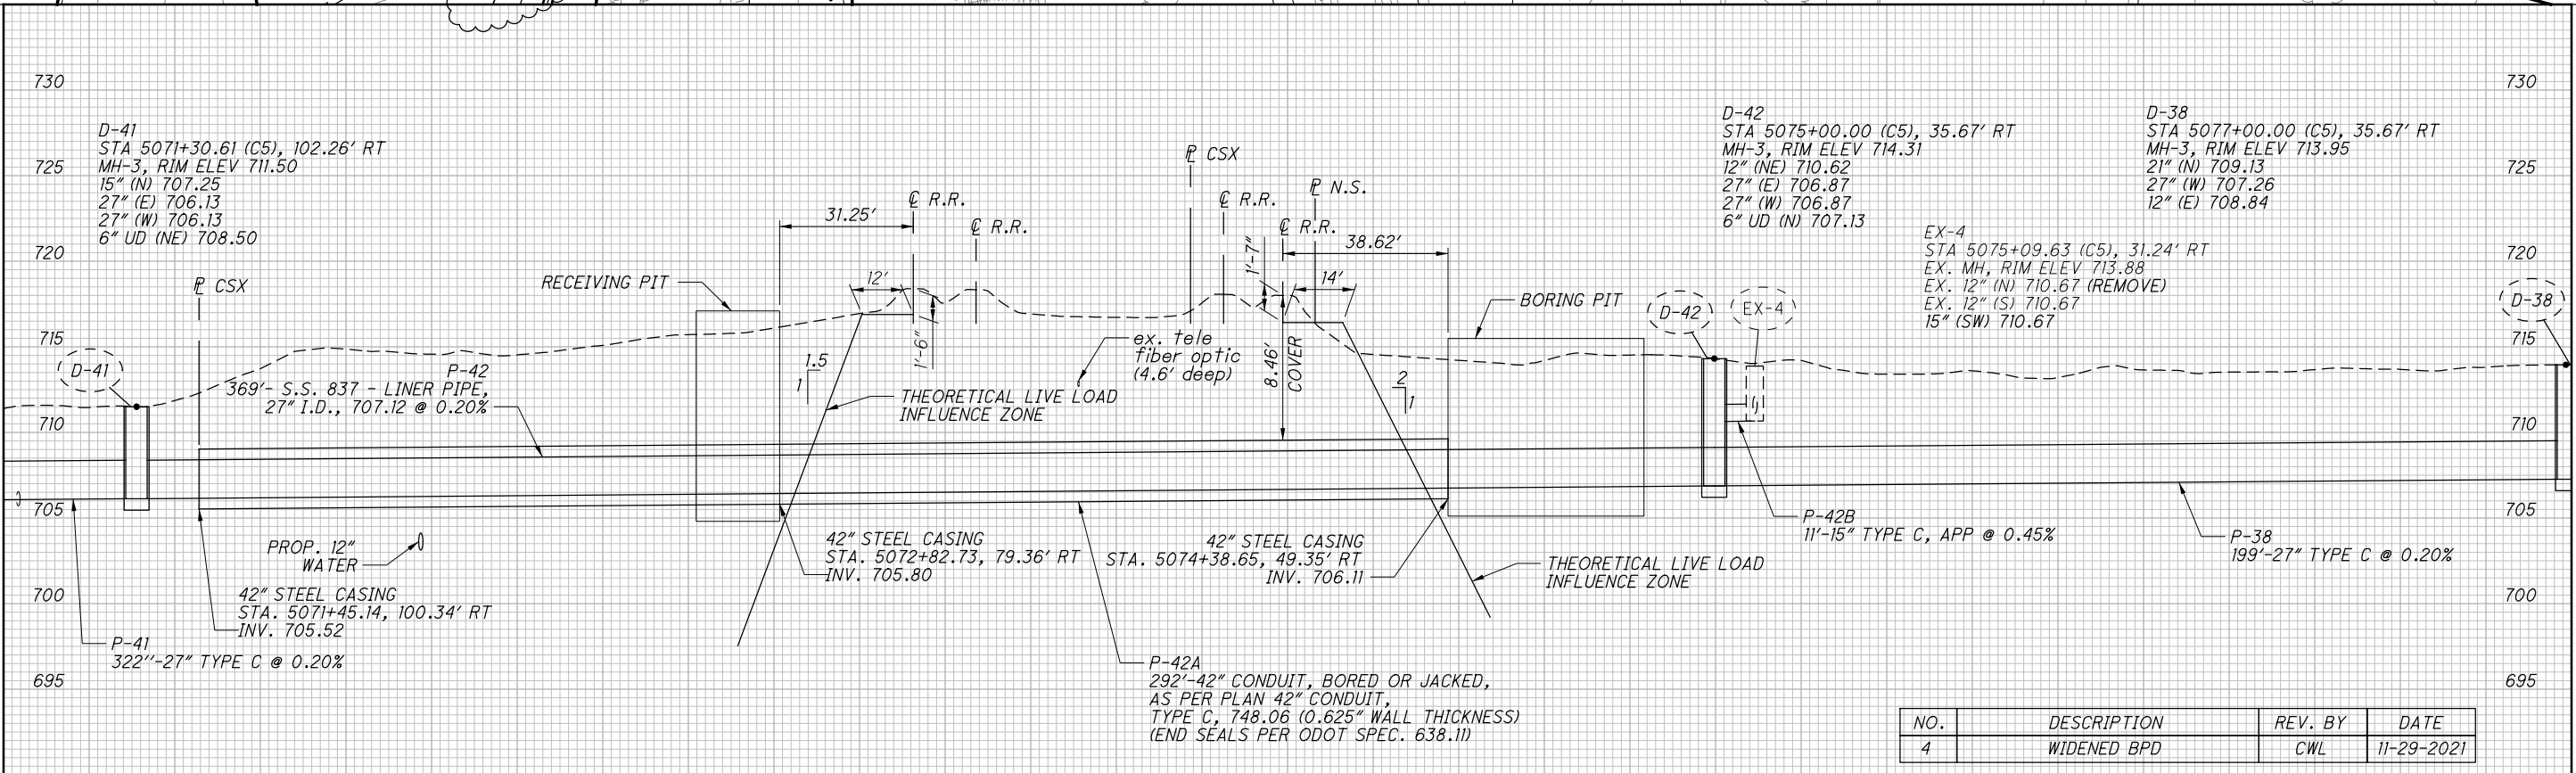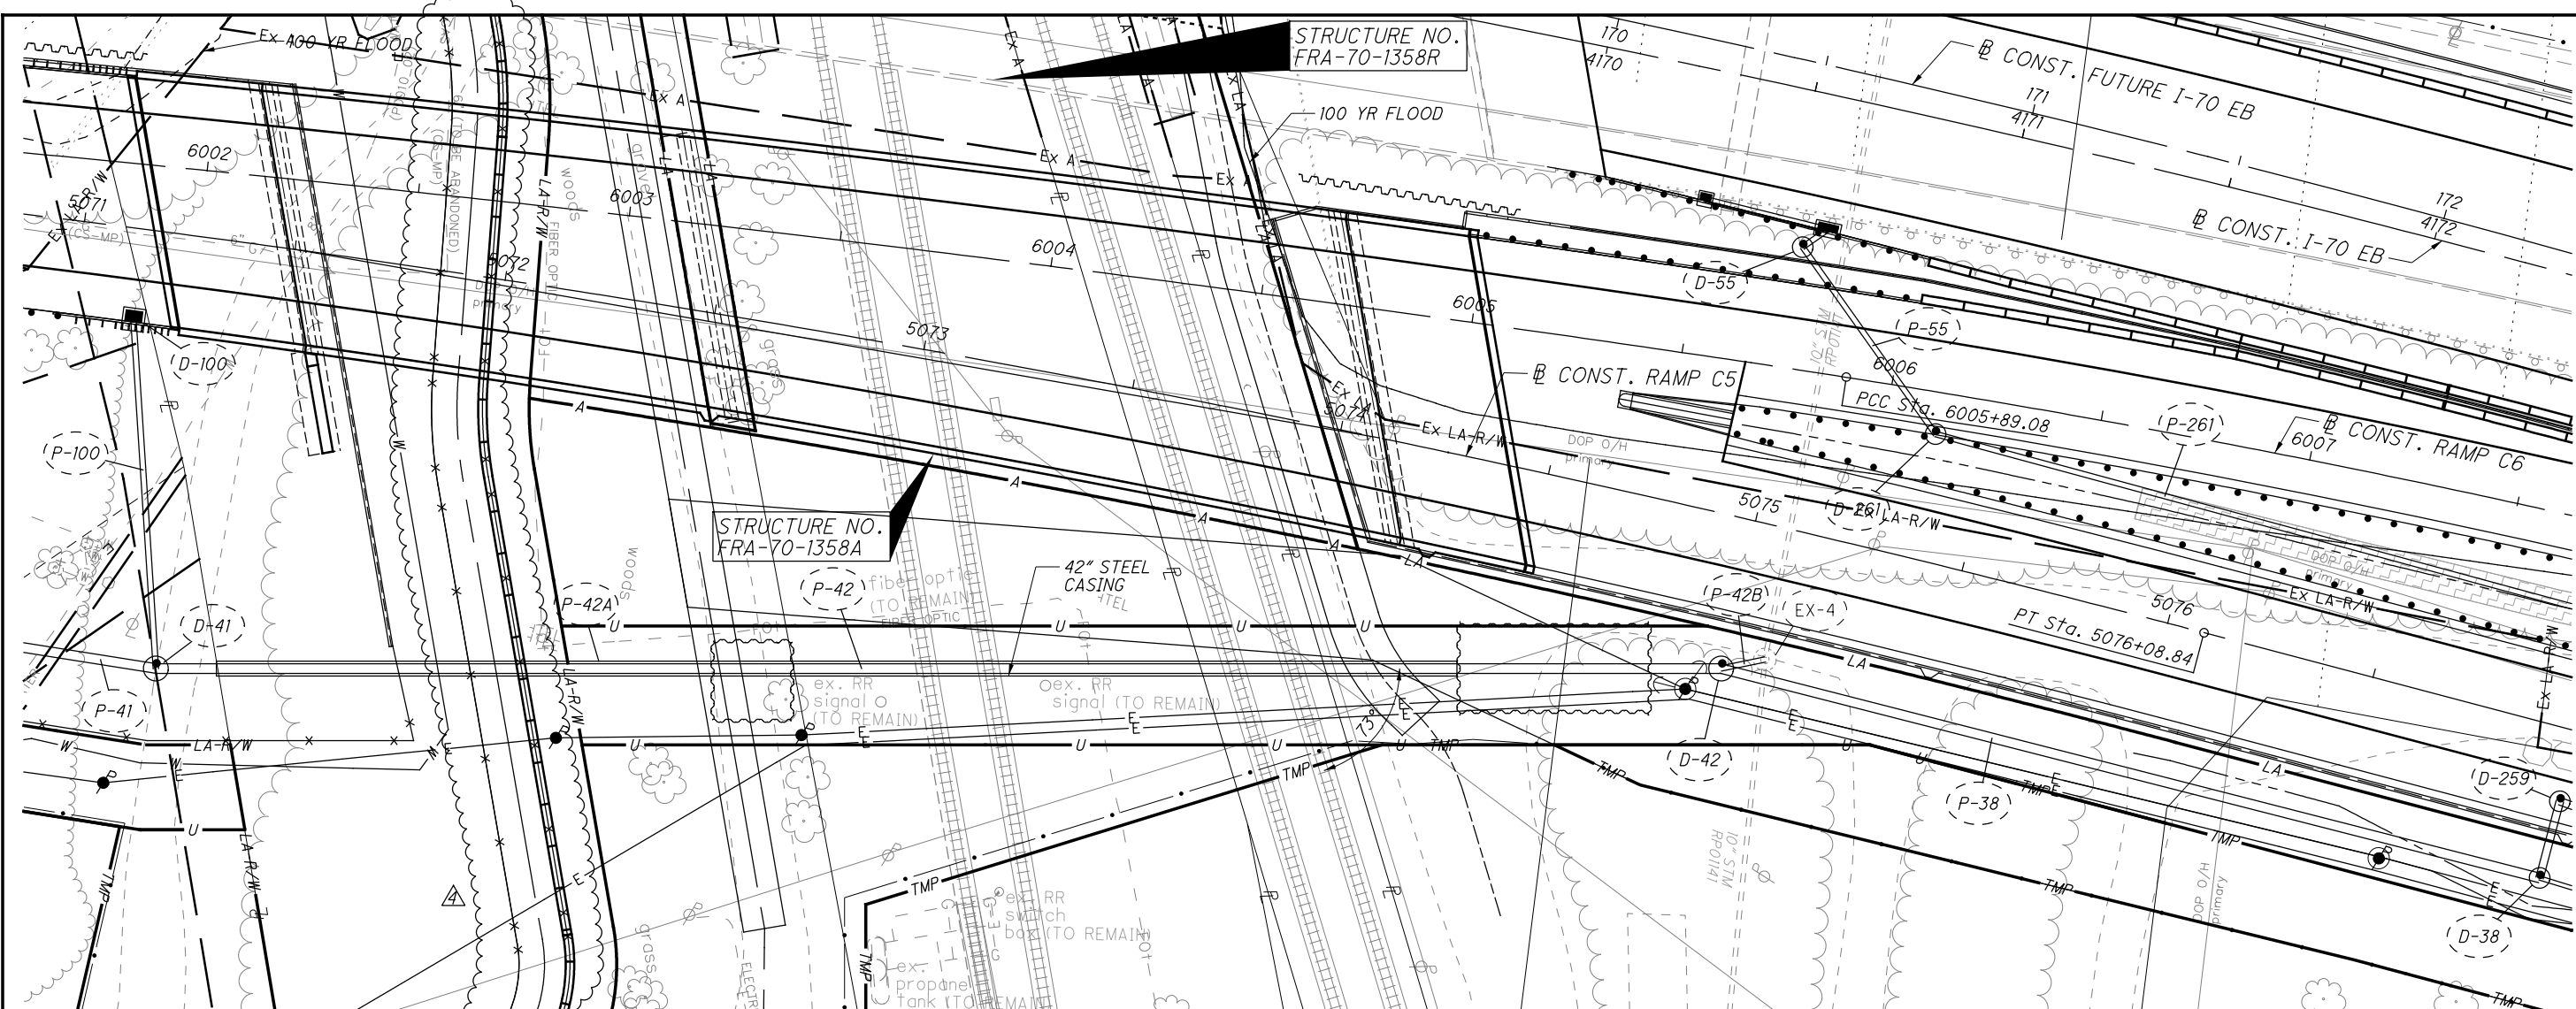

NO.	DESCRIPTION	REV. BY	DATE
4	WIDENED BPD	CWL	11-29-2021

STORM SEWER PROFILES
P-42 & P-38

FRA-70/71-12.68/14.86

665
1815

D:\2021\20211204\FRA\105523\DRAWINGS\SHEETS\10552302P002.DGN
11/27/2021
2:18:15 PM
GDDTV81STD_USER

ESTIMATED QUANTITIES

CALCULATED: TJW DATE: 1-30-2019
 CHECKED: RFV DATE: 1-30-2019

ITEM	EXT.	TOTAL	PARTICIPATION		UNITS	DESCRIPTION	A.P.P. REFERENCE SHT. NO.
			01/NHS/PV	01/NHS/PV			
202	11200	LS	LS	LS		PORTIONS OF STRUCTURE REMOVED	
503	11100	LS	LS	LS		COFFERDAMS AND EXCAVATION BRACING	2
503	21101	562	247	315	CY	UNCLASSIFIED EXCAVATION, AS PER PLAN	
504	11101	7,145	3,144	4,001	SF	STEEL SHEET PILING LEFT IN PLACE, AS PER PLAN	2
511	53012	344	151	193	CY	CLASS QC2 CONCRETE, MISC.: FLOODWALL WITH QC/QA	2
512	10100	386	170	216	SY	SEALING OF CONCRETE SURFACES (EPOXY-URETHANE)	
SPECIAL	530E00200	LS	LS	LS		SPECIAL STRUCTURES - EMERGENCY CLOSURE	2
SPECIAL	690E98400	LS	LS	LS		SPECIAL - EMERGENCY ACTION PLAN COORDINATION	2
SPECIAL	690E98400	LS	LS	LS		SPECIAL - MONITORING OF EXISTING I-WALL	2
SPECIAL	690E98400	LS	LS	LS		SPECIAL - WCLPP R/W CONSTRUCTION CAMERA	2
SPECIAL	690E98400	LS	LS	LS		SPECIAL - USACE SURVEY AND AS-BUILTS	2

ITEM SPECIAL - WCLPP R/W CONSTRUCTION CAMERA
 THIS ITEM INCLUDES ALL COSTS AND EXPENSES INCURRED BY THE CONTRACTOR TO INSTALL CAMERAS THAT COVER ALL CONSTRUCTION OCCURRING WITHIN 50 FEET OF THE WCLPP RIGHT OF WAY (EX FL LINES LABELED IN THE PLANS AS "APPROX. FLOODWALL R/W"). THE CAMERAS SHALL BE LIVE FEEDS AND VIEWABLE REMOTELY BY THE USACE, THE CITY OF COLUMBUS AND ODOT VIA THE INTERNET.

PAYMENT FOR THIS WORK SHALL BE MADE AT THE LUMP SUM PRICE BID WHICH SHALL CONSTITUTE FULL PAYMENT FOR ALL LABOR, EQUIPMENT, MATERIALS AND INCIDENTALS TO COMPLETE THE WORK.

ITEM SPECIAL - USACE SURVEY AND AS-BUILTS
 CONTRACTOR SHALL RECOVER THE USACE PRIMARY EXISTING CONTROL STATIONS NEAR THE PROJECT LIMITS AND REPORT THE CONDITION OF ALL MONUMENTS WITH CLOSE-UP AND HORIZONTAL PICTURES. CONTRACTOR SHALL LOCATE THESE STATIONS WITH REAL-TIME KINEMATIC POSITIONING FOR FIVE MINUTE OBSERVATIONS. CONTRACTOR SHALL UPDATE THE NEAREST CONTROL POINTS (215/16, 215/17, 215/18, 215/19, 215/20, 86/12-2, 86/13, 86/14, 86/14-1, OR THE NEXT NEAREST IF ONE MORE OF THESE POINTS IS FOUND TO BE DESTROYED, FOR A MINIMUM OF THREE HORIZONTAL AND TWO VERTICAL CONTROL POINTS) TO NAD83/NAV88 GEOID 18 OR THE CURRENT SURVEY DATUM AND SUBMIT TO ONLINE POSITIONING USER SERVICE SHAREPOINT (OPUS SHARE) AND PROVIDE THE UPDATED COORDINATES TO THE USACE. THE USACE CONTROL MUST BE UTILIZED FOR ALL AS-BUILT CONSTRUCTION DRAWINGS SUBMITTED TO THE CITY OF COLUMBUS AND THE USACE. EXISTING CONTROL SHOWN ON USACE PLAN INSERT SHEETS 694A - 694B.

CONTRACTOR SHALL PROVIDE TEMPORARY, HIGHLY-VISIBLE VISUAL MARKING OF THE WCLPP CENTERLINE OF PROTECTION AND OTHER FEATURES (E.G. GATEWELLS, CONDUIT OUTFALLS, ETC.) IN CONSTRUCTION AREAS AND IN AREAS IMMEDIATELY ADJACENT TO CONSTRUCTION AREAS WITHIN 50 FEET OF THE WCLPP RIGHT OF WAY. THIS SHALL SERVE TO INCREASE AWARENESS OF THE WCLPP TO THE CONSTRUCTION/FIELD PERSONNEL. THE PROPOSED MARKING METHOD SHALL BE SUBMITTED TO ODOT, THE CITY OF COLUMBUS AND THE USACE FOR CONCURRENCE.

CONTRACTOR SHALL SURVEY THE IMPACTED LEVEE/FLOODWALL FEATURES TO ENSURE THE REQUIRED TOP OF PROTECTION ELEVATION HAS BEEN SATISFACTORILY MET. SURVEYS OF LEVEE EMBANKMENT SECTIONS SHALL ALSO INCLUDE CROSS-SECTIONS AT 50 FOOT INTERVALS. THE SURVEY SHALL OCCUR PRIOR TO SUBMITTAL OF "AS-BUILT" CONSTRUCTION DRAWINGS TO ODOT, THE CITY OF COLUMBUS AND THE USACE. DATA FROM THE SURVEY SHALL BE INCLUDED THEREIN.

CONTRACTOR SHALL PROVIDE THE USACE, THE CITY OF COLUMBUS AND ODOT WITH PLANS AND SPECIFICATIONS WITH AMENDMENTS DURING CONSTRUCTION SHOWING ALTERATIONS AS FINALLY CONSTRUCTED (I.E. AS-BUILTS) WITHIN 180 DAYS OF CONSTRUCTION COMPLETION. THESE RECORD DRAWINGS WILL BE SUBJECT TO REVIEW AND APPROVAL BY THE CITY OF COLUMBUS AND THE USACE TO DETERMINE WHETHER A SUFFICIENT AMOUNT OF INFORMATION HAS BEEN PROVIDED FOR THE CITY OF COLUMBUS' CONTINUED OPERATION AND MAINTENANCE OF THE WCLPP.

PAYMENT FOR THIS WORK SHALL BE MADE AT THE LUMP SUM PRICE BID WHICH SHALL CONSTITUTE FULL PAYMENT FOR ALL LABOR, EQUIPMENT, MATERIALS AND INCIDENTALS TO COMPLETE THE WORK.

EQUIPMENT AND MATERIAL STORAGE WITHIN WCLPP
 CONTRACTOR SHALL NOT STORE ANY MATERIALS OR EQUIPMENT WITHIN THE WCLPP RIGHT OF WAY WITHOUT PRIOR WRITTEN CONSENT FROM THE CITY OF COLUMBUS.

NO.	DESCRIPTION	REV. BY	DATE
1	ADDED USACE NOTES	CWL	11-5-2021
4	FUNDING CODE CHANGE / ADD QC/QA TO ITEM	CWL	11-29-2021

GENERAL NOTES

ITEM 503 - UNCLASSIFIED EXCAVATION, AS PER PLAN

ALL WORK UNDER THIS ITEM SHALL CONFORM TO CMS 503. HOWEVER, THE STABILITY OF THE EXISTING I-WALL STRUCTURE SHALL NOT BE COMPROMISED DURING EXECUTION OF THE WORK. EXCAVATION ALONG THE RIVER SIDE OF THE EXISTING I-WALL SHALL NOT CUT BELOW THE PAVEMENT ELEVATION ON THE ROADWAY SIDE OF THE WALL. THE MAXIMUM CUT SLOPE ORIGINATING AT THE EXISTING I-WALL SHALL NOT EXCEED 3:1 HORIZONTAL TO VERTICAL. ADDITIONALLY, DISTURBANCE TO THE EXISTING EARTHEN LEVEE WHICH ABUTS THE RIVER SIDE SOUTH END OF THE EXISTING I-WALL SHALL BE MINIMIZED AT ALL TIMES. AS SUCH, SUITABLE EXCAVATION BRACING DESIGNED BY THE CONTRACTOR IN ACCORDANCE WITH CMS 501.05, PAID SEPARATELY, SHALL BE INSTALLED AT ALL LOCATIONS REQUIRED TO LIMIT EXCAVATION DISTURBANCE NOTED HEREIN.

ITEM 504 - STEEL SHEET PILING LEFT IN PLACE, AS PER PLAN

ALL LABOR, MATERIALS, EQUIPMENT AND INCIDENTALS NECESSARY TO COMPLETE THE SHEET PILE, AS SHOWN IN THESE PLANS AND AS SPECIFIED, INCLUDING WATERSTOPS, CLAMP BARS, SEALERS, SLURRY BACKFILL, STORM SEWER PIPE SLEEVES, NEOPRENE SEALS AND HARDWARE SHALL BE INCLUDED IN THE UNIT PRICE BID FOR ITEM 504 STEEL SHEET PILING LEFT IN PLACE, AS PER PLAN.

ITEM 511 - QC2 CONCRETE, MISC.: FLOODWALL WITH QC/QA

ALL WORK UNDER THIS ITEM SHALL CONFORM TO CMS 511, INCLUDING QC/QA. IN ADDITION TO THE REQUIREMENTS OF 511, THIS ITEM SHALL INCLUDE ALL WATERSTOPS EMBEDDED IN THE CONCRETE ABOVE THE STEEL SHEETING, ALL PREFORMED EXPANSION JOINT MATERIALS, JOINT SEALANTS AND OTHER INCIDENTALS NECESSARY TO COMPLETE THE WORK.

FINAL DETAILS OF THE REINFORCING STEEL FOR THE I-WALL DEPEND ON THE ACTUAL SHEET PILE SECTION TO BE SUPPLIED BY THE CONTRACTOR SINCE PANEL LENGTHS ARE A FUNCTION OF THE SHEETING DIMENSIONS. THEREFORE, THIS ITEM SHALL ALSO INCLUDE THE FULL COST OF PROVIDING FINAL REBAR SCHEDULES AND FURNISHING AND INSTALLING ALL REINFORCING STEEL AND RELATED INCIDENTALS. REINFORCING SIZE, SHAPES AND SPACING REQUIREMENTS ARE INCLUDED IN THE PLANS.

PAYMENT SHALL BE MADE AT THE UNIT PRICE BID PER CUBIC YARD WHICH SHALL CONSTITUTE FULL PAYMENT FOR ALL LABOR, EQUIPMENT, MATERIALS AND INCIDENTALS TO COMPLETE THE WORK.

ITEM SPECIAL - EMERGENCY CLOSURE

IT IS THE INTENT OF THE PROJECT TO CONSTRUCT THE NEW I-WALL WHILE THE EXISTING I-WALL REMAINS IN PLACE. HOWEVER, AT THE NORTHERLY END OF THE PROPOSED WALL WHERE IT TIES INTO THE EXISTING I-WALL, THE EXISTING WALL MUST BE REMOVED TO INSTALL THE NEW WALL. BETWEEN THE TIME WHEN THE EXISTING I-WALL IS REMOVED AND THE NEW I-WALL IS COMPLETED AND TIED INTO THE EXISTING, THE CONTRACTOR SHALL HAVE ADEQUATE MATERIAL, EQUIPMENT AND MANPOWER AVAILABLE TO CONSTRUCT AN EMERGENCY CLOSURE FOR A LENGTH OF APPROXIMATELY 100 FEET. THE ELEVATION OF THE TOP OF THE EMERGENCY CLOSURE SHALL EQUAL OR EXCEED THE ELEVATION OF THE THE EXISTING AND PROPOSED I-WALLS IMMEDIATELY ADJACENT TO IT. AT THE CONTRACTOR'S OPTION, THE EMERGENCY CLOSURE MAY BE CONSTRUCTED FROM HESCO BARRIERS, DUMPED LOW-PERMEABILITY FILL WITH GEOMEMBRANE OR PLASTIC SHEETING OR OTHER APPROVED METHOD, EXCLUDING SANDBAGS, TO CREATE A TEMPORARY IMPERMEABLE EMERGENCY CLOSURE. TEMPORARY MATERIALS FOR THIS EMERGENCY CLOSURE SHALL BE STORED ON SITE. SIDE SLOPES ON TEMPORARY EMBANKMENT SHALL NOT EXCEED 2:1 HORIZONTAL TO VERTICAL.

THE CONTRACTOR SHALL BE CAPABLE OF CONSTRUCTING THE TEMPORARY CLOSURE WITHIN 4 HOURS NOTIFICATION. THIS WORK SHALL BE PERFORMED AS DIRECTED BY THE ENGINEER. UPON COMPLETION OF THE PROPOSED I-WALL, THE TEMPORARY CLOSURE MATERIAL SHALL BE REMOVED AND THE EMBANKMENT AREA FULLY RESTORED TO THE SATISFACTION OF THE ENGINEER.

PAYMENT FOR THIS WORK SHALL BE MADE AT THE LUMP SUM PRICE BID WHICH SHALL CONSTITUTE FULL PAYMENT FOR ALL LABOR, EQUIPMENT, MATERIALS AND INCIDENTALS TO COMPLETE THE WORK.

ITEM SPECIAL - EMERGENCY ACTION PLAN COORDINATION

THIS ITEM INCLUDES ALL COSTS AND EXPENSES INCURRED BY THE CONTRACTOR TO COORDINATE WITH THE ARMY CORPS OF ENGINEERS, CITY OF COLUMBUS AND ODOT AS IT RELATES TO UPDATING THE EMERGENCY ACTION PLAN DURING CONSTRUCTION FOR THE CONTRACTOR'S ACTUAL MEANS AND METHODS FOR CONSTRUCTING THE NEW FLOODWALL AND MAINTAINING THE INTEGRITY OF THE FLOOD PROTECTION SYSTEM INCLUDING I-WALLS AND ADJACENT LEVEES. THIS ITEM IS ALSO TO INCLUDE ALL CONTRACTOR COSTS FOR ATTENDING WEEKLY PROGRESS MEETINGS AND PREPARING STATUS REPORTS RELATED TO THE WORK. CONTRACTOR SHALL SUBMIT A WORK PLAN TO ODOT, CITY OF COLUMBUS AND THE ARMY CORPS OF ENGINEERS OUTLINING THE PROPOSED SEQUENCE OF CONSTRUCTION WITHIN THE EXISTING FLOODWALL RIGHT-OF-WAY.

CONTRACTOR SHALL NOTIFY ODOT, THE CITY OF COLUMBUS INSPECTOR AND THE USACE A MINIMUM OF TWO DAYS PRIOR TO INITIATING CONSTRUCTION IN EACH OF THE FOUR IDENTIFIED IMPACT AREAS (AREA A, AREA B, AREA C, AND AREA D PER THE REVIEW PLAN DATED 14 NOVEMBER 2019 WITHIN THE 408 PERMIT DOCUMENTATION).

PAYMENT FOR THIS WORK SHALL BE MADE AT THE LUMP SUM PRICE BID WHICH SHALL CONSTITUTE FULL PAYMENT FOR ALL LABOR, EQUIPMENT, MATERIALS AND INCIDENTALS TO COMPLETE THE WORK.

ITEM SPECIAL - MONITORING OF EXISTING I-WALL

THIS WORK SHALL INCLUDE MONITORING THE EXISTING I-WALL FOR POTENTIAL MOVEMENT DURING CONSTRUCTION. PLACE A TOTAL OF FIVE (5) SURVEY REFERENCE POINTS ALONG THE EXISTING I-WALL WITHIN THE LIMITS OF WALL WHICH WILL EVENTUALLY BE REMOVED. PLACE REFERENCE POINTS AT EACH END ALONG WITH THREE (3) INTERMEDIATE POINTS EQUALLY SPACED. THE CONTRACTOR SHALL OBSERVE EACH POINT ON A WEEKLY BASIS, OR AS DIRECTED BY THE ENGINEER, AND RECORD MEASUREMENTS AND RELATIVE MOVEMENTS. IF MOVEMENT IN EXCESS OF 0.25 INCH IN ANY DIRECTION IS OBSERVED RELATIVE TO THE PRE-CONSTRUCTION OBSERVATIONS, CEASE WORK ADJACENT TO THE WALL AND NOTIFY THE ENGINEER.

ESTABLISH A SET OF SURVEY CONTROL POINTS. THESE SAME POINTS SHALL BE USED THROUGHOUT THE PROJECT AND SHALL BE INDEPENDENT OF ALL STRUCTURES.

PAYMENT FOR THIS WORK SHALL BE MADE AT THE LUMP SUM PRICE BID WHICH SHALL CONSTITUTE FULL PAYMENT FOR ALL LABOR, EQUIPMENT, MATERIALS AND INCIDENTALS TO COMPLETE THE WORK.

01-2012-2012048 VFR 105523 STRUCTURES WALL 1 SHEETS 105523-1E0001.DGN
 11/24/2021 10:08:28 AM
 000TY81STD_USER

DESIGN AGENCY
GPD GROUP
 Class, Pds, Schemer, Burns & Delavan, Inc.
 4801 Watermark Drive, Suite 210, Columbus, Ohio 43215 614-210-0731
 Copyright © Class, Pds, Schemer, Burns & Delavan, Inc. 2015

DATE
 9-6-19

REVIEWED
 DGN

STRUCTURE FILE NUMBER
 N/A

DRAWN
 RPR

REVISED

DESIGNED
 TJW

CHECKED
 DJC

FLOODWALL ESTIMATED QUANTITIES & NOTES
 RAMP A5 & I-71 NB

PID No. 105523

FRA-70/71-12.68 / 14.86

2 / 5

694
 1815

UNLESS NOTED OTHERWISE, THE FOLLOWING NOTES PERTAIN TO RETAINING WALLS 4W1, 4W2, 4W4, 4W5, 4W6, 4W7, 4W8, 4W9, 4W10, 4W11, 4W12, 4W20 AND/OR TEMPORARY RETAINING WALLS T2, T3, T4, T5, T6, T7 AND/OR TEMPORARY SHORING WALLS TS2, TS4, TS5, TS6, WHICH ARE ALL PART OF THIS PROJECT.

FOR SPECIFIC NOTES PERTAINING TO CAST-IN-PLACE REINFORCED CONCRETE WALLS ON SPREAD FOOTINGS, WHICH INCLUDE A PORTION OF 4W1, 4W7, AND 4W9, SEE SHEET **7/14**.

FOR SPECIFIC NOTES PERTAINING TO CAST-IN-PLACE REINFORCED CONCRETE WALLS ON DRILLED SHAFTS, WHICH INCLUDE A PORTION OF 4W1, SEE SHEET **8/14**.

FOR SPECIFIC NOTES PERTAINING TO TANGENT DRILLED SHAFT WALLS WITH PRECAST PANELS, WHICH INCLUDE A PORTION OF 4W1, 4W2, AND 4W4, SEE SHEETS **8/14** AND **9/14**.

FOR SPECIFIC NOTES PERTAINING TO MSE WALLS, WHICH INCLUDE 4W5, 4W6, 4W8, 4W10, 4W11, 4W12, AND 4W20, SEE SHEETS **10/14** THROUGH **12/14**.

STANDARD DRAWINGS AND SUPPLEMENTAL SPECIFICATIONS

REFER TO THE FOLLOWING SUPPLEMENTAL SPECIFICATIONS:
 840 DATED 1-18-19 (4W8, 4W10, 4W11, 4W12, 4W20, 4W5, 4W6)
 867 DATED 1-18-19 (T2, T3, T4, T5, T6, T7)

DESIGN SPECIFICATIONS

THESE STRUCTURES CONFORM TO THE "LRFD BRIDGE DESIGN SPECIFICATIONS" ADOPTED BY THE AMERICAN ASSOCIATION OF STATE HIGHWAY AND TRANSPORTATION OFFICIALS, 7TH EDITION, 2014 AND THE ODOT BRIDGE DESIGN MANUAL, 2007 EDITION, INCLUDING REVISIONS THROUGH JULY 2014.

OPERATIONAL IMPORTANCE:

(4W1 4W2 4W4 4W5 4W6)
 A LOAD MODIFIER OF 1.00 HAS BEEN ASSUMED FOR THE DESIGN OF THIS STRUCTURE IN ACCORDANCE WITH THE AASHTO LRFD BRIDGE DESIGN SPECIFICATIONS, ARTICLE 1.3.5 AND THE ODOT BRIDGE DESIGN MANUAL, 2007.

DESIGN STRESSES:

CONCRETE CLASS QC1:
 COMPRESSIVE STRENGTH - 4.0 KSI (ALL COMPONENTS OF ALL WALLS WITH CLASS QC1 CONCRETE SPECIFIED)

CONCRETE CLASS QC2:
 COMPRESSIVE STRENGTH - 4.5 KSI (ALL COMPONENTS OF ALL WALLS WITH CLASS QC2 CONCRETE SPECIFIED)

CONCRETE CLASS QC5:
 COMPRESSIVE STRENGTH - 4.5 KSI (4W1, 4W2, 4W4 DRILLED SHAFTS)

REINFORCING STEEL - MINIMUM YIELD STRENGTH 60 KSI

STRUCTURAL STEEL - ASTM A709 GRADE 50 - YIELD STRENGTH 50 KSI (4W1, 4W2)

DESIGN LOADING

LIVE LOAD SURCHARGE OF 0.240 KSF.
 FUTURE WEARING SURFACE (FWS) OF 0.060 KSF.

HL-93 (4W1, 4W2, 4W4)

EXISTING STRUCTURE PLANS:

PLANS MAY BE EXAMINED BY PROSPECTIVE BIDDERS AT THE OHIO DEPARTMENT OF TRANSPORTATION, DISTRICT 6 OFFICES, 400 E. WILLIAM ST., DELEWARE, OHIO 43015 (PHONE 740-833-8000).

CONSTRUCTION SEQUENCING

WHERE WALL CONSTRUCTION IS PHASED AND A TEMPORARY RETAINING SYSTEM IS REQUIRED, SHOP DRAWINGS OF BOTH PERMANENT AND TEMPORARY WALLS SHALL BE SUBMITTED TO THE ENGINEER FOR APPROVAL. THE COST OF THESE SUBMITTALS SHALL BE INCLUDED FOR PAYMENT WITH THE COST OF THE TEMPORARY WALLS.

ITEM 202 - PORTIONS OF STRUCTURE REMOVED, AS PER PLAN

(4W1) THIS ITEM SHALL INCLUDE REMOVAL OF THE TOP PORTION OF THE EXISTING RETAINING WALL AND FOOTING TOE AS INDICATED IN THE PLANS FROM THE EAST END OF THE NEW PROPOSED WALL TO NEAR THE ANGLE POINT OF THE NEW WALL. IT SHALL ALSO INCLUDE REMOVAL OF THE EXISTING WALL FROM THE TOP OF THE EXISTING WALL TO THE BOTTOM OF THE EXISTING FOOTING FROM THE ANGLE POINT TO THE WEST END OF THE PROPOSED NEW WALL.

(4W2) THIS ITEM SHALL INCLUDE REMOVAL OF THE TOP PORTION OF THE EXISTING RETAINING WALL AND FOOTING TOE AS INDICATED IN THE PLANS FROM THE EAST END OF THE NEW PROPOSED WALL TO NEAR THE ANGLE POINT OF THE NEW WALL. IT SHALL ALSO INCLUDE REMOVAL OF THE EXISTING WALL FROM THE TOP OF THE EXISTING WALL TO THE BOTTOM OF THE EXISTING FOOTING FROM THE ANGLE POINT TO THE WEST END OF THE PROPOSED NEW WALL.

EXCAVATION, SHEETING AND BRACING

EXCAVATION ENVELOPES AS DETAILED IN THE PLANS SHALL BE PROTECTED FROM CAVING AND SLOUGHING. WHERE CLEARANCES AND CONSTRUCTION SEQUENCING WILL NOT ALLOW FOR SLOPED EXCAVATIONS, APPROPRIATE SHEETING OR BRACING METHODS SHALL BE EMPLOYED BY THE CONTRACTOR. THIS TEMPORARY SHEETING OR BRACING IS CONSIDERED INCIDENTAL TO ITEM 503 - COFFERDAMS AND EXCAVATION BRACING.

ITEM 503 - COFFERDAMS AND EXCAVATION BRACING, AS PER PLAN (WALLS 4W5, 4W6 AND 4W7)

THE DETAILS SHOWN ON THE PLAN FOR TEMPORARY SUPPORT OF EXCAVATION ARE NOT PART OF THE CONTRACT AND ARE ONLY INCLUDED FOR INFORMATION PURPOSES. STEEL SHEETING AND VIBRATORY DRIVING METHODS ARE NOT PERMITTED TO AVOID DAMAGING THE ADJACENT 60" SANITARY SEWER. THE CONTRACTOR IS SOLELY RESPONSIBLE FOR DESIGNING THE SHORING SYSTEM, INCLUDING THE SECTION OVER THE EXISTING 60" SANITARY SEWER, PREPARING WORKING DRAWINGS, AND PERFORMING CALCULATIONS ACCORDING TO CMS 501.05. THE DEPARTMENT WILL PAY FOR TEMPORARY SUPPORT OF EXCAVATION AT THE LUMP SUM PRICE FOR ITEM 503 - COFFERDAMS AND EXCAVATION BRACING, AS PER PLAN.

ITEM 503 - COFFERDAMS AND EXCAVATION BRACING, AS PER PLAN (TS2, TS4, TS5, TS6)

THE DESIGN SHOWN ON THE PLANS FOR TEMPORARY SUPPORT OF EXCAVATION IS ONE REPRESENTATIVE DESIGN THAT MAY BE USED TO CONSTRUCT THE PROJECT. THE CONTRACTOR MAY CONSTRUCT THE DESIGN SHOWN ON THE PLANS OR PREPARE AN ALTERNATE DESIGN TO SUPPORT THE SIDES OF EXCAVATIONS. IF CONSTRUCTING AN ALTERNATE DESIGN FOR TEMPORARY SUPPORT OF EXCAVATION, PREPARE AND PROVIDE PLANS IN ACCORDANCE WITH CMS 501.05. THE DEPARTMENT WILL PAY FOR THE TEMPORARY SUPPORT OF EXCAVATION AT THE CONTRACT LUMP SUM PRICE FOR COFFERDAMS AND EXCAVATION BRACING. NO ADDITIONAL PAYMENT WILL BE MADE FOR PROVIDING AN ALTERNATE DESIGN.

**ITEM 511 - CLASS QC2 CONCRETE WITH QC/QA, BRIDGE DECK (PARAPET), AS PER PLAN (4W1, 4W2, 4W4, FRA-70-1395C)
 ITEM 511 - CLASS QC2 CONCRETE WITH QC/QA, SIDEWALK, AS PER PLAN (4W1, 4W2)**

FOR NOTES, SEE SHEET 1746A.

ITEM 511 - CLASS QC2 CONCRETE MISC.: LOAD DISTRIBUTION SLAB: (4W5, 4W6)

THIS ITEM SHALL INCLUDE THE CONCRETE CONSTRUCTION AS DETAILED IN THE PLANS INCLUDING THE WORK NECESSARY TO FURNISH & PLACE THE REINFORCING STEEL. A SINGLE LAYER OF #5 BARS SPACED AT 12" (IN BOTH DIRECTIONS) SHALL BE PLACED 3" FROM THE BOTTOM OF THE SLAB. ALL BARS SHALL BE EPOXY COATED. CONCRETE FOR THE PROPOSED WORK SHALL BE CLASS QC2 AS PER CMS 511.

METHOD OF MEASUREMENT: THE DEPARTMENT WILL MEASURE THE CONCRETE CONSTRUCTION BY THE NUMBER OF CUBIC YARDS.

PAYMENT: ALL LABOR, EQUIPMENT, MATERIALS AND INCIDENTALS NECESSARY TO COMPLETE THE WORK SHALL BE INCLUDED IN THE CONTRACT BID PRICE FOR ITEM 511 - CLASS QC2 CONCRETE MISC.: LOAD DISTRIBUTION SLAB.

ITEM 511 - CLASS QC2 CONCRETE, MISC.: PARAPET INCLUDING SLEEPER SLAB, WITH QC/QA (4W5, 4W6, 4W8, 4W12, 4W20)

ALL MATERIALS, LABOR AND INCIDENTALS NECESSARY TO FURNISH AND PLACE CONCRETE FOR THE PARAPET ATOP THE SLEEPER SLAB ALONG THE MSE WALL SHALL BE INCLUDED WITH ITEM 511 - CLASS QC2 CONCRETE, MISC.: PARAPET INCLUDING SLEEPER SLAB, WITH QC/QA. THIS ITEM SHALL INCLUDE ALL JOINT MATERIALS, DOWEL BARS AND BOND BREAKERS IN CONTACT WITH THE SLEEPER SLAB. ALL REINFORCING STEEL IN THE SLEEPER SLAB AND PARAPET SHALL BE INCLUDED WITH ITEM 509.

ALL LABOR, MATERIALS, INCIDENTALS, ETC. NECESSARY FOR SEALING THE LONGITUDINAL CONSTRUCTION JOINT BETWEEN THE SLEEPER SLABS AND THE PARAPETS WITH HMWM RESIN PER CMS 511.19 IS ALSO INCLUDED IN THIS ITEM. THE SEALING SHALL OCCUR AND BE FULLY CURED BEFORE THE FINAL PAVEMENT IS PLACED OVER THE SLEEPER SLAB.

ABBREVIATIONS

ABUT.	ABUTMENT	MIN.	MINIMUM
BRG.	BEARING	ADDIT.	ADDITIONAL
BOT.	BOTTOM	FRWD.	FORWARD
BTWN.	BETWEEN	SPL.	SPLICE
CONST. JT., C.J.	CONSTRUCTION JOINT	CLR.	CLEAR
B.S.	BOTH SIDES	P.C.P.P.	PERFORATED CORRUGATED PLASTIC PIPE
N.S.	NEAR SIDE	N.P.C.P.P.	NON-PERFORATED CORRUGATED PLASTIC PIPE
F.S.	FAR SIDE		
SER.	SERIES		
TYP.	TYPICAL		
EQ.	EQUAL		
DIM.	DIMENSION		
SPA.	SPACES		
EA.	EACH		
P.E.J.F.	PREFORMED EXPANSION JOINT FILLER		

ITEM 203 - GRANULAR EMBANKMENT, AS PER PLAN (4W8)

PLACE AND COMPACT GRANULAR EMBANKMENT MATERIAL IN 6 INCH LIFTS FOR THE CONSTRUCTION OF THE APPROACH EMBANKMENT.



01-2812-2012048\FRA\105523\STRUCTURES\WALL_4W1\SHEETS\105523_WN002.DGN
 11/23/2021 3:00:42 PM
 000181STD_USER

DESIGN AGENCY: **GPD GROUP**
 Class, Pvs, Schme, Burns & Dolan, Inc.
 1801 Watermark Drive, Suite 130, Columbus, Ohio 43215 614-210-0731
 Copyright © Class, Pvs, Schme, Burns & Dolan, Inc. 2015

DESIGNED	DGN	CHECKED	RHC
DRAWN	MOJ	REVISED	
REVIEWED	TJW	STRUCTURE FILE NUMBER	
DATE	9-6-19		

RETAINING WALL GENERAL NOTES

FRA-70/71-12.68 / 14.86
 PID No. 105523

3 / 14
 700
 1815

NO.	DESCRIPTION	REV. BY	DATE
4	ADDED NOTE	MOJ	11-29-2021

ESTIMATED QUANTITIES

CALCULATED: RHC DATE: 5/27/19
 CHECKED: DJC DATE: 5/31/19

ITEM	EXT.	TOTAL	PARTICIPATION ^A		UNITS	DESCRIPTION	REFERENCE SHEET NO. --- / 1815
			01/NHS/PV	01/NHS/PV			
202	11201	LS	LS	LS		PORTIONS OF STRUCTURE REMOVED, AS PER PLAN	700
503	11100	LS	LS	LS		COFFERDAMS AND EXCAVATION BRACING	
503	21100	710	312	398	CY	UNCLASSIFIED EXCAVATION	
509	10000	116,285	51,165	65,120	LB	EPOXY COATED REINFORCING STEEL	
511	34451	42	18	24	CY	CLASS QC2 CONCRETE WITH QC/QA, BRIDGE DECK (PARAPET), AS PER PLAN	1746A
511	46012	502	221	281	CY	CLASS QC1 CONCRETE WITH QC/QA RETAINING/WINGWALL NOT INCLUDING FOOTING	
511	46513	208	92	116	CY	CLASS QC1 CONCRETE WITH QC/QA, FOOTING, AS PER PLAN	
511	51513	179	79	100	CY	CLASS QC2 CONCRETE WITH QC/QA, SIDEWALK, AS PER PLAN	1746A
511	53010	240	106	134	CY	CLASS QC1 CONCRETE, MISC.: SUPPORT BRACKET AND DRILLED SHAFT CAP	705
511	53010	16	7	9	CY	CLASS QC1 CONCRETE, MISC.: CAST-IN-PLACE CONCRETE WALL	705
512	10050	287	126	161	SY	SEALING CONCRETE SURFACES (NON-EPOXY)	1746A
512	10100	1,069	470	599	SY	SEALING CONCRETE SURFACES (EPOXY-URETHANE)	1746A
512	33000	169	74	95	SY	TYPE 2 WATERPROOFING	
513	10220	201,414	88,622	112,792	LB	STRUCTURAL STEEL MEMBERS, LEVEL 1	
516	13600	286	126	160	SF	1" PREFORMED EXPANSION JOINT FILLER	
518	21200	306	135	171	CY	POROUS BACKFILL WITH GEOTEXTILE FABRIC	
518	39900	460	202	258	FT	4" NON-PERFORATED CORRUGATED PLASTIC PIPE, INCLUDING SPECIALS	
518	40000	417	183	234	FT	6" PERFORATED CORRUGATED PLASTIC PIPE	
524	95472	390	172	218	FT	DRILLED SHAFTS, 60" DIAMETER, ABOVE BEDROCK WITH QC/QA, AS PER PLAN	705
524	95492	1,133	499	634	FT	DRILLED SHAFTS, 72" DIAMETER, ABOVE BEDROCK WITH QC/QA, AS PER PLAN	705
607	98000	307	135	172	FT	FENCE MISC.: WALL MOUNTED TYPE A (WITH VANDAL MESH)	1746A
867	00101	LS	LS	LS		TEMPORARY WIRE FACED MECHANICALLY STABILIZED EARTH WALL, AS PER PLAN	707
SPECIAL	20302000	1,015	447	568	CY	ENGINEERED FILL: LIGHTWEIGHT CELLULAR CONCRETE FILL, PERVIOUS	702
SPECIAL	53000600	2,066	909	1,157	SF	STRUCTURES: PRECAST FACADE PANELS	706

NO.	DESCRIPTION	REV. BY	DATE
4	FUNDING CODE CHANGE	CWL	11-29-2021

G:\2012\2012048\FRA\05623\STRUCTURES WALL_4W1\SHEETS\05623_4W1\W0001.DGN
 11/21/2021 11:53:48 AM
 000TY81STD_USER

ESTIMATED QUANTITIES

CALCULATED: RHC DATE: 5/29/19
CHECKED: DGN DATE: 5/31/19

ITEM	EXT.	TOTAL	PARTICIPATION ^A		UNITS	DESCRIPTION	REFERENCE SHEET NO. --- / 1815
			01/NHS/PV	01/NHS/PV			
202	11201	LS	LS	LS		PORTIONS OF STRUCTURE REMOVED, AS PER PLAN	700
503	11100	LS	LS	LS		COFFERDAMS AND EXCAVATION BRACING	
503	21100	462	203	259	CY	UNCLASSIFIED EXCAVATION	
509	10000	69,661	30,651	39,010	LB	EPOXY COATED REINFORCING STEEL	
511	34451	42	18	24	CY	CLASS QC2 CONCRETE WITH QC/QA, BRIDGE DECK (PARAPET), AS PER PLAN	1746A
511	46512	80	35	45	CY	CLASS QC1 CONCRETE WITH QC/QA, FOOTING	
511	51513	287	126	161	CY	CLASS QC2 CONCRETE WITH QC/QA, SIDEWALK, AS PER PLAN	1746A
511	53010	17	7	10	CY	CLASS QC1 CONCRETE, MISC.: CAST-IN-PLACE CONCRETE WALL	705
511	53010	663	292	371	CY	CLASS QC1 CONCRETE, MISC.: SUPPORT BRACKET AND DRILLED SHAFT CAP	705
512	10050	323	142	181	SY	SEALING CONCRETE SURFACES (NON-EPOXY)	1746A
512	10100	1,327	584	743	SY	SEALING CONCRETE SURFACES (EPOXY-URETHANE)	1746A
512	33000	155	68	87	SY	TYPE 2 WATERPROOFING	
513	10280	325,363	143,160	182,203	LB	STRUCTURAL STEEL MEMBERS, LEVEL 4	
516	13600	72	32	40	SF	1" PREFORMED EXPANSION JOINT FILLER	
518	21200	152	67	85	CY	POROUS BACKFILL WITH GEOTEXTILE FABRIC	
518	40000	628	276	352	FT	6" PERFORATED CORRUGATED PLASTIC PIPE	
518	40010	29	13	16	FT	6" NON-PERFORATED CORRUGATED PLASTIC PIPE, INCLUDING SPECIALS	
524	95472	79	35	44	FT	DRILLED SHAFTS, 60" DIAMETER, ABOVE BEDROCK WITH QC/QA	705
524	95533	2,955	1,300	1,655	FT	DRILLED SHAFTS, 96" DIAMETER, ABOVE BEDROCK WITH QC/QA, AS PER PLAN	705
607	98000	309	136	173	FT	FENCE, MISC.: WALL MOUNTED TYPE A (WITH VANDAL MESH)	1746A
867	00101	LS	LS	LS		TEMPORARY WIRE FACED MECHANICALLY STABILIZED EARTH WALL, AS PER PLAN	707
SPECIAL	20302000	415	183	232	CY	ENGINEERED FILL (LIGHTWEIGHT CELLULAR CONCRETE FILL), PERVIOUS	702
SPECIAL	53000600	9,703	4,269	5,434	SF	STRUCTURES: PRECAST FACADE PANELS	706

G:\2012\20120418\FRA\105523\STRUCTURES WALL_4W2\SHEETS\105523_4W2\WED001.DGN
 11/23/2021 4:03:26 PM
 DDDTY81STD_USER

NO.	DESCRIPTION	REV. BY	DATE
4	FUNDING CODE/QUANTITY CHANGE	CWL/RFV	11-29-2021




DESIGN AGENCY
GPD GROUP
1801 Watermark Drive, Suite 150, Columbus, Ohio 43215 614-210-0731
Copyright © 2015, GPD Group, Inc.

REVIEWED DATE 9-6-19
DGN 9-6-19
STRUCTURE FILE NUMBER

DRAWN RFV
DESIGNED RFV
CHECKED DJC

ESTIMATED QUANTITIES
TANGENT DRILLED SHAFT WALL 4W2
NORTHSIDE OF I-70 WB FROM FRA-70-1395C TO FRA-70-1405C

FRA-70/71-12.68 / 14.86
PID No. 105523

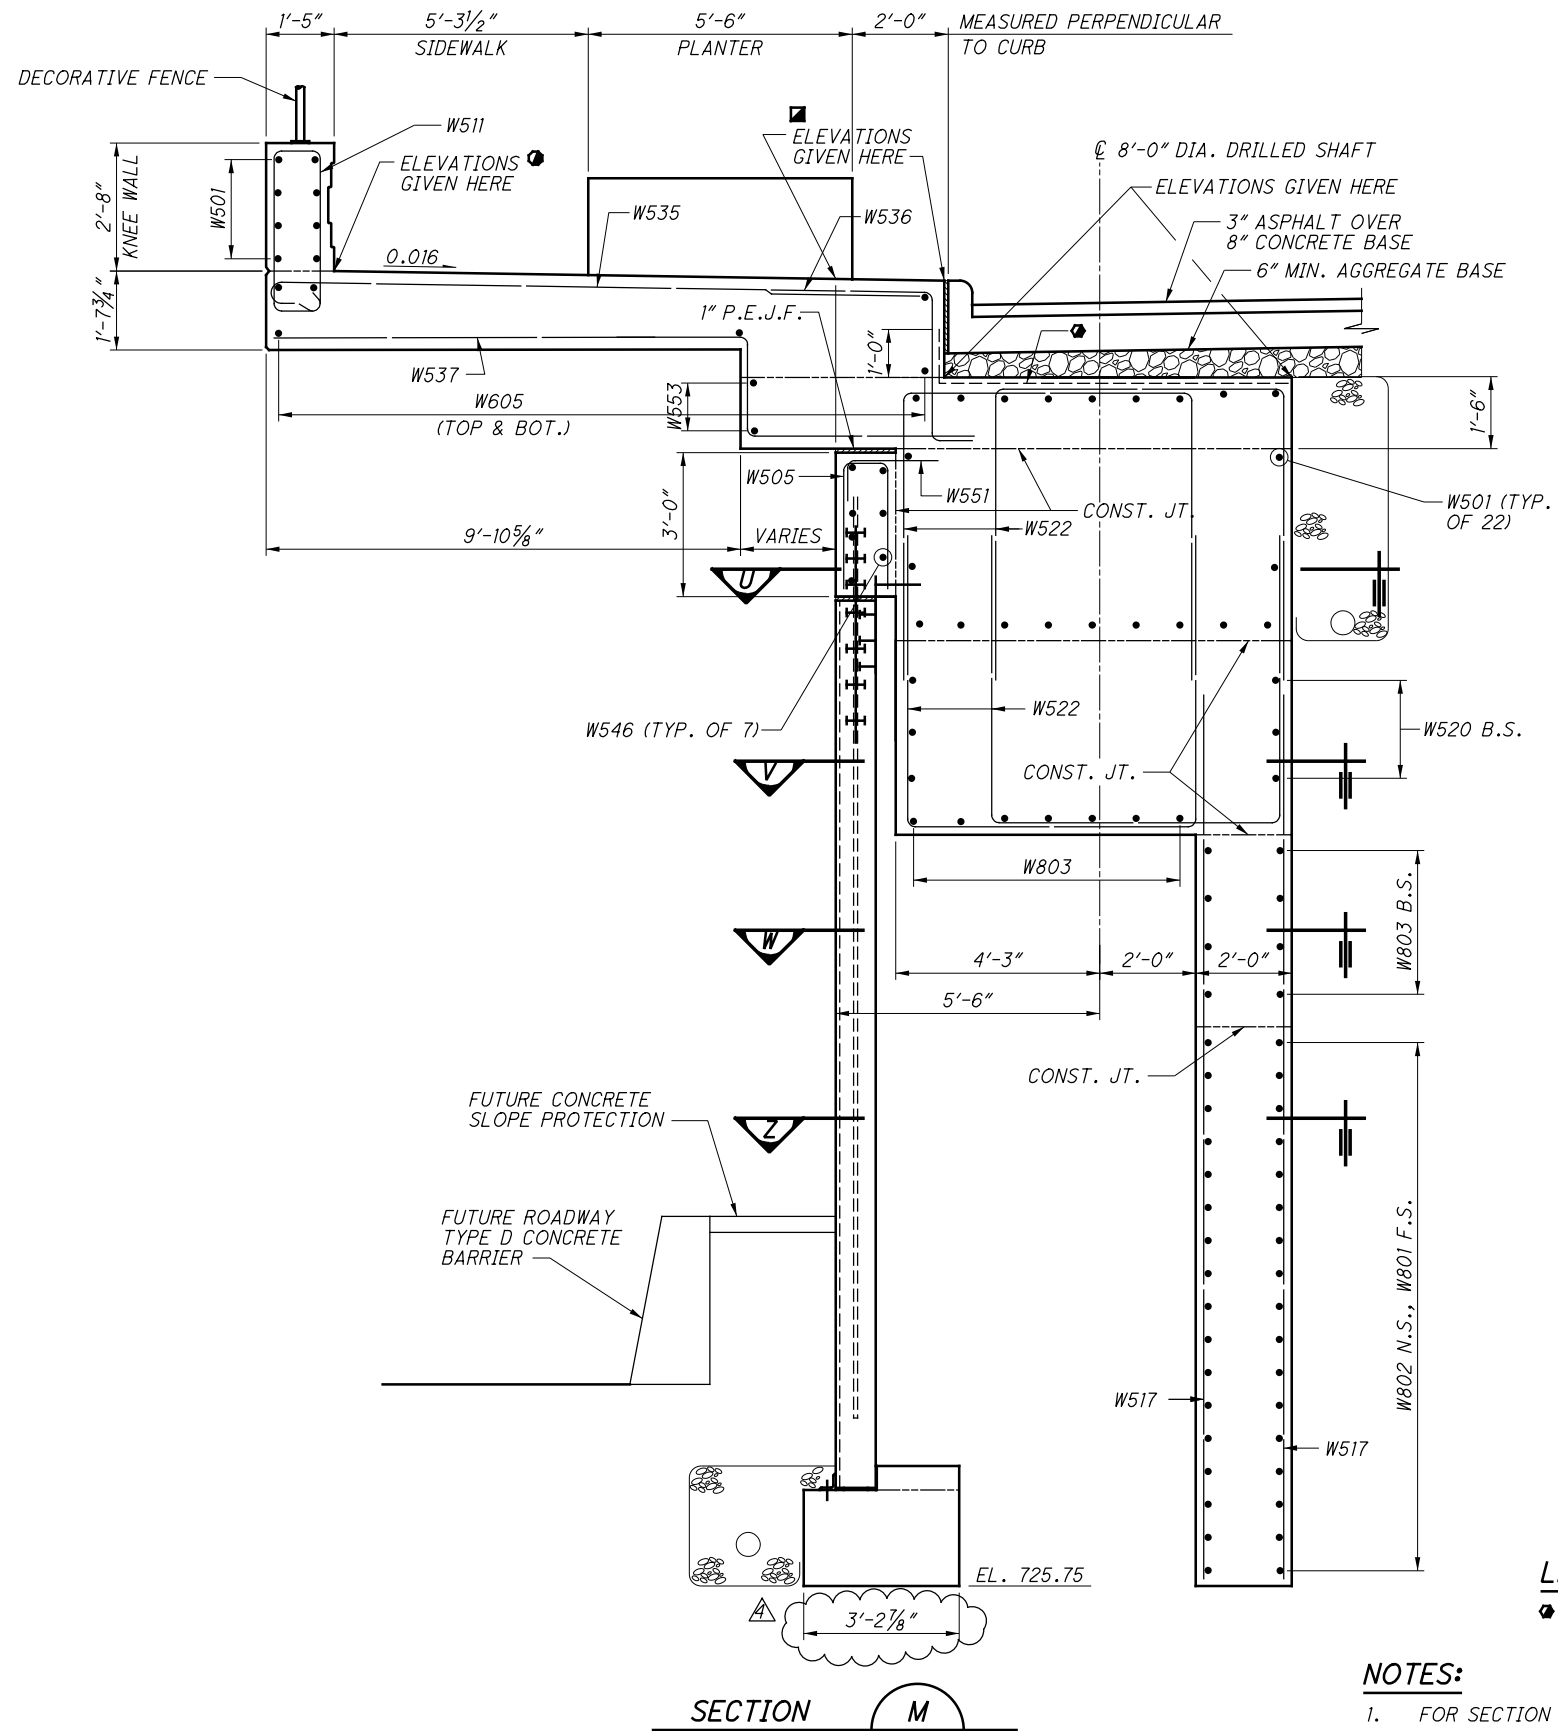

SECTION M


LEGEND:
 ● TYPE 2 WATERPROOFING

- NOTES:**
- FOR SECTION Z AND W, SEE SHT. NO. 11/24.
 - FOR SECTION U AND V, SEE SHT. NO. 20/24.
 - FOR DECORATIVE FENCE DETAILS, SEE SHT. NO. 1746D/1815.

NO.	DESCRIPTION	REV. BY	DATE
4	DIMENSION REVISION	RFV	11-29-2021

DESIGN AGENCY GPD GROUP Clark, P.C., Scherer, Burns & Dehaven, Inc. 1801 Watermark Drive, Suite 150, Columbus, Ohio 43215 614.210.0731 Copyright © Clark, P.C., Scherer, Burns & Dehaven, Inc. 2015	DATE	9-6-19
	REVIEWED	DUC
DRAWN	RFV	STRUCTURE FILE NUMBER
DESIGNED	TJW/DGN	
CHECKED	RHC	
WALL/SIDEWALK SECTION DETAILS TANGENT DRILLED SHAFT WALL 4W2 NORTHSIDE OF I-70 WB FROM FRA-70-1395C TO FRA-70-1405C		
FRA-70/71-12.68/14.86	PID No. 105523	
19/24	749	1815

01/20/21 2012048 VFR1105523 STRUCTURES WALL_4W2 SHEETS_105523_4W2.DWG
 11/23/2021 9:23:19 AM
 DDDTY81STD_USER

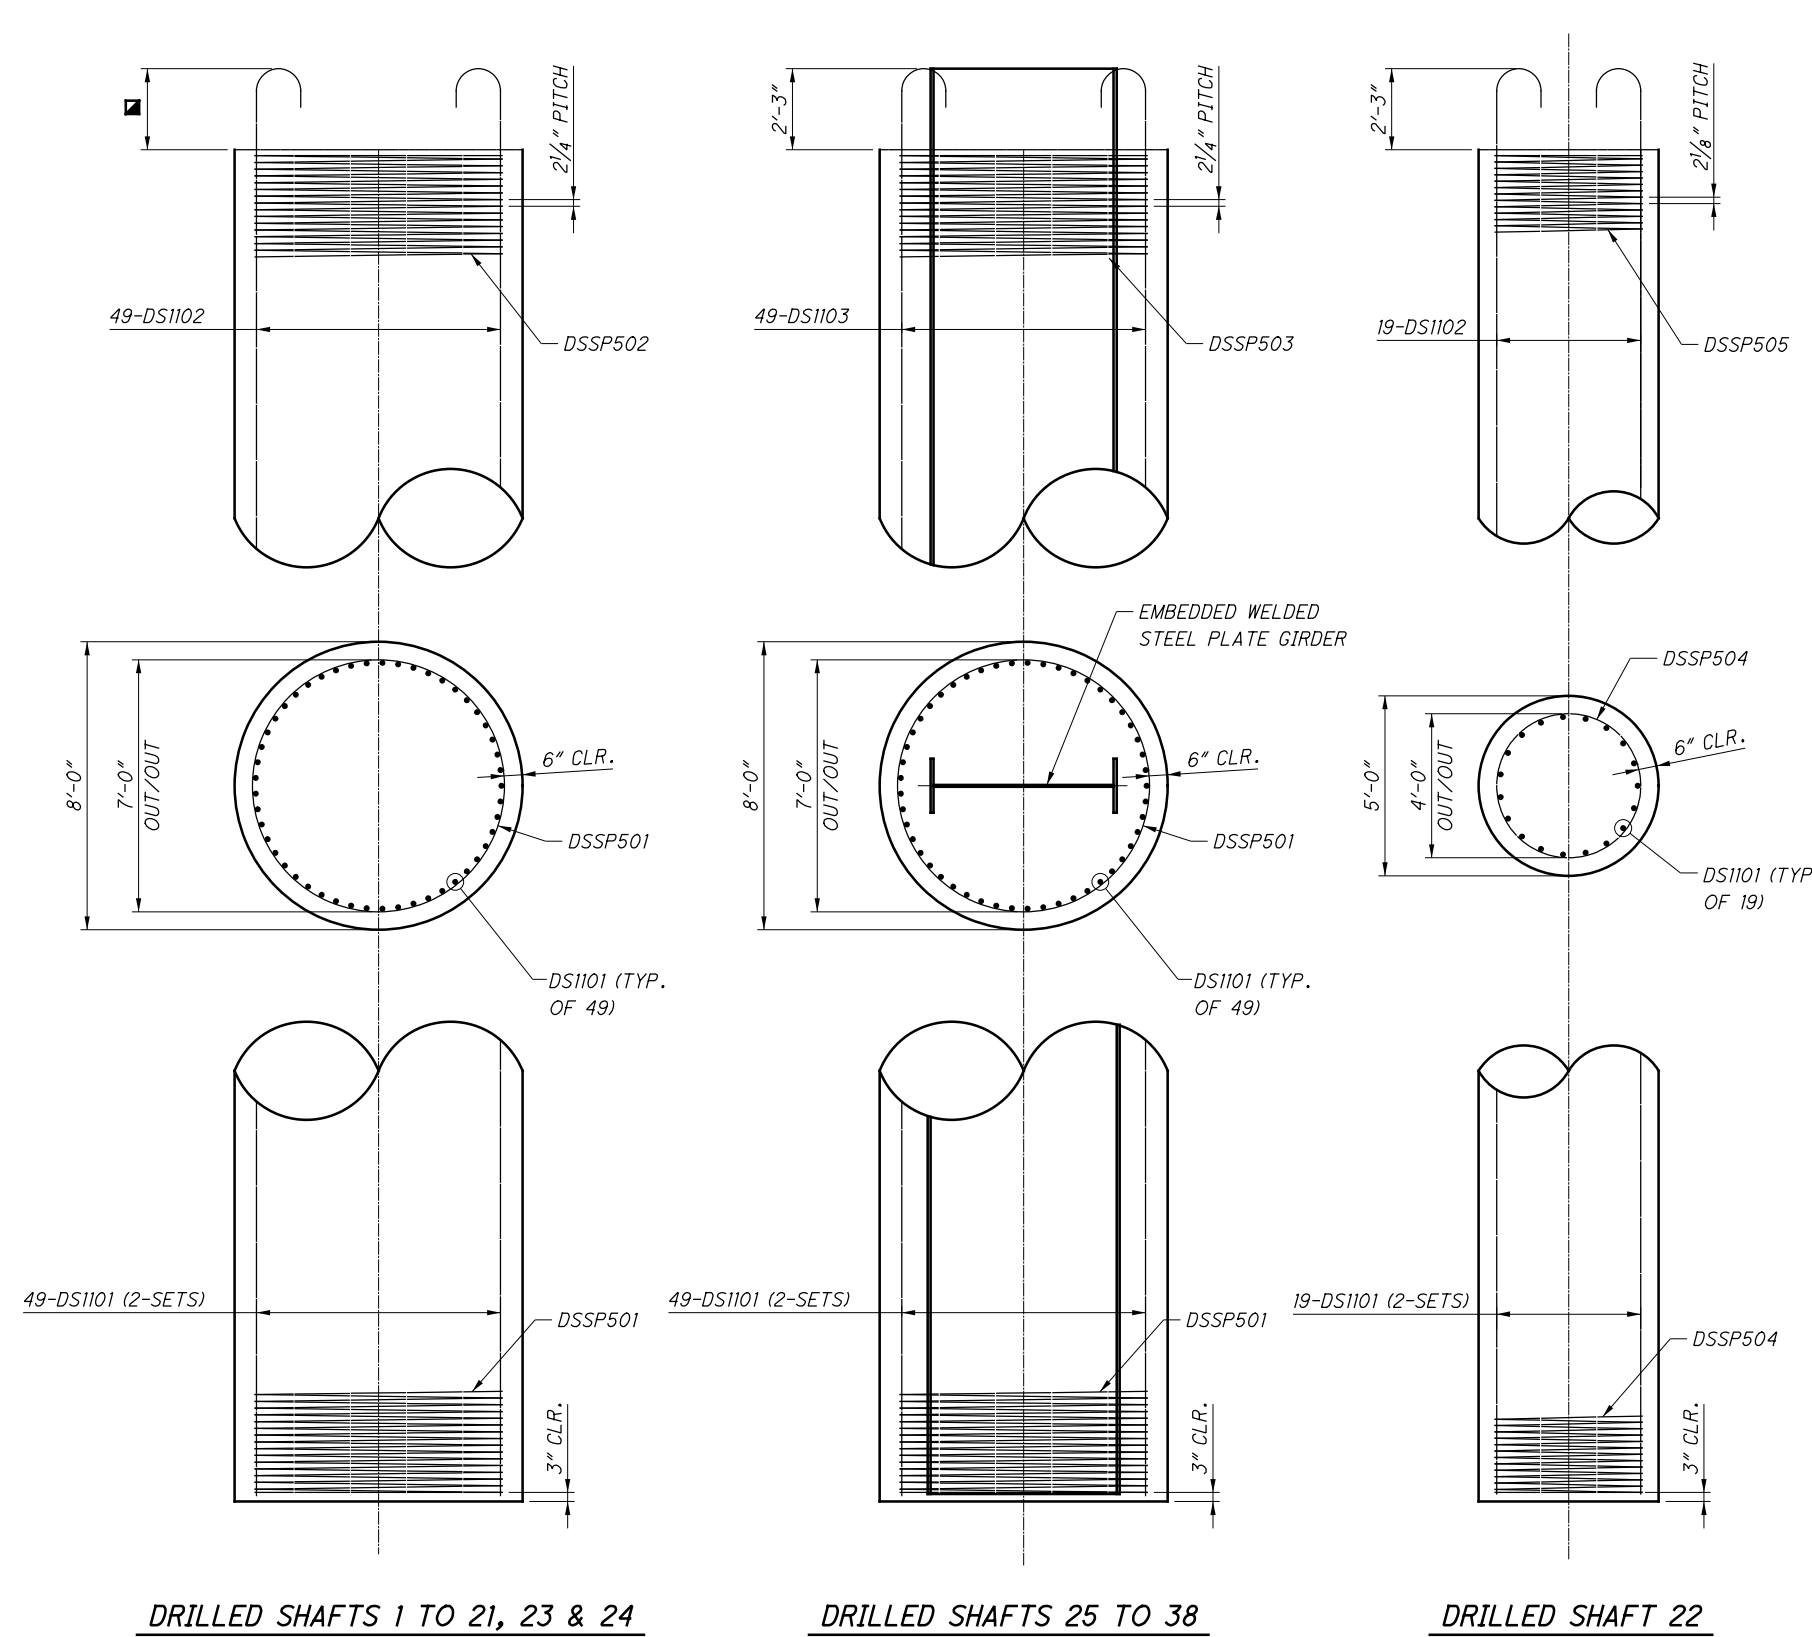

DRILLED SHAFTS 1 TO 21, 23 & 24

DRILLED SHAFTS 25 TO 38

DRILLED SHAFT 22

DRILLED SHAFT REINFORCEMENT DETAILS

MINIMUM LAP SPLICE LENGTHS FOR THE VERTICAL DRILLED SHAFT REINFORCING BARS IS AS FOLLOWS:

#11 BARS = 6'-8"

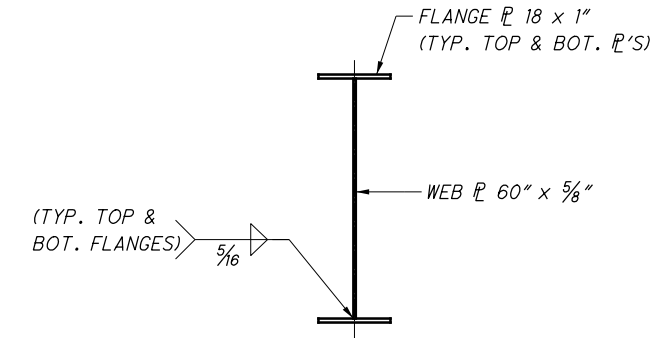


PLATE GIRDER DETAIL

EMBEDDED PLATE GIRDER LENGTH TABLE

D.S. NO.	TOTAL LENGTH
25	90'-2"
26	91'-5 1/8"
27	91'-8 3/8"
28	91'-11 7/8"
29	92'-3 5/8"
30	92'-7 1/4"
31	92'-10 1/2"
32	93'-1 1/2"
33	93'-4 3/8"
34	93'-7 1/4"
35	93'-10 1/8"
36	94'-0 7/8"
37	94'-3 3/4"
38	94'-6 5/8"

LEGEND:

- 10'-3" FOR DRILLED SHAFTS 1, 2, 4, 7, 10, 13, 16, 19 & 2'-3" FOR ALL OTHER DRILLED SHAFTS

NOTE:

- PAYMENT FOR THE PLATE GIRDER SHALL BE INCLUDED WITH ITEM 513 - STRUCTURAL STEEL MEMBERS, LEVEL 4.
- THE PLATE GIRDERS SHALL BE COATED WITH A SHOP APPLIED INORGANIC ZINC PRIME COAT CONFORMING TO CMS 514.

NO.	DESCRIPTION	REV. BY	DATE
4	ADDED PLATE GIRDER COATING REQUIREMENT	MOJ	11-23-2021

DESIGN AGENCY
GPD GROUP
 1801 Watermark Drive, Suite 150, Columbus, Ohio 43215 614.210.0731
 Copyright © 2015, GPD Group, Inc.

DESIGNED DGN RHC
CHECKED RHC
DRAWN MOJ
REVISER
REVIEWED DJC
DATE 9-6-19
STRUCTURE FILE NUMBER

DRILLED SHAFT DETAILS
 TANGENT DRILLED SHAFT WALL 4W2
 NORTHSIDE OF I-70 WB FROM FRA-70-1395C TO FRA-70-1405C

FRA-70/71-12.68 / 14.86
PID No. 105523

23A / 24
 753A
 1815

ESTIMATED QUANTITIES

CALCULATED: RFV DATE: 8-1-19
 CHECKED: MOJ DATE: 8-21-19

ITEM	EXT.	TOTAL	PARTICIPATION [△]		UNITS	DESCRIPTION	REFERENCE SHEET NO. --- / 1815
			01/NHS/PV	01/NHS/PV			
503	21100	468	206	262	CY	UNCLASSIFIED EXCAVATION	
509	10000	22,652	9,967	12,685	LB	EPOXY COATED REINFORCING STEEL	
511	34451	32	14	18	CY	CLASS QC2 CONCRETE WITH QC/QA, BRIDGE DECK (PARAPET), AS PER PLAN	1746A
511	46012	244	107	137	CY	CLASS QC1 CONCRETE WITH QC/QA, RETAINING/WINGWALL NOT INCLUDING FOOTING	
511	46512	51	22	29	CY	CLASS QC1 CONCRETE WITH QC/QA, FOOTING	
512	10050	154	68	86	SY	SEALING CONCRETE SURFACES (NON-EPOXY)	1746A
512	10100	450	198	252	SY	SEALING CONCRETE SURFACES (EPOXY-URETHANE)	1746A
512	33000	148	65	83	SY	TYPE 2 WATERPROOFING	
516	13600	96	42	54	SF	1" PREFORMED EXPANSION JOINT FILLER	
518	21200	116	51	65	CY	POROUS BACKFILL WITH GEOTEXTILE FABRIC	
518	40000	468	206	262	FT	6" PERFORATED CORRUGATED PLASTIC PIPE	
524	95442	1,442	634	808	FT	DRILLED SHAFTS, 42" DIAMETER, ABOVE BEDROCK WITH QC/QA, AS PER PLAN	705
524	95472	2,277	1,002	1,275	FT	DRILLED SHAFTS, 60" DIAMETER, ABOVE BEDROCK WITH QC/QA, AS PER PLAN	705
SPECIAL	53000600	4,332	1,906	2,426	SF	STRUCTURES: PRECAST FACADE PANELS	706
607	98000	234	103	131	FT	FENCE, MISC.: WALL MOUNTED TYPE A (W/ VANDAL MESH)	1746A

ABBREVIATIONS

ABUT.	ABUTMENT	MIN.	MINIMUM
BRG.	BEARING	ADDIT.	ADDITIONAL
BOT.	BOTTOM	FRWD.	FORWARD
BTWN.	BETWEEN	SPL.	SPLICE
CONST. JT., C.J.	CONSTRUCTION JOINT	CLR.	CLEAR
B.S.	BOTH SIDES	P.C.P.P.	PERFORATED CORRUGATED PLASTIC PIPE
N.S.	NEAR SIDE	N.P.C.P.P.	NON-PERFORATED CORRUGATED PLASTIC PIPE
F.S.	FAR SIDE	GALV.	GALVANIZED
SER.	SERIES		
TYP.	TYPICAL		
EQ.	EQUAL		
DIM.	DIMENSION		
SPA.	SPACES		
EA.	EACH		
P.E.J.F.	PREFORMED EXPANSION JOINT FILLER		



DESIGNED	RHC	CHECKED	DJC
DRAWN	RPR	REVISED	
REVIEWED	DGN	STRUCTURE FILE NUMBER	
DATE	9-6-19		

ESTIMATED QUANTITIES
 TANGENT DRILLED SHAFT WALL 4W4
 SOUTH SIDE OF RAMP C5 FROM FRA-70-1390C TO FRA-70-1395C

FRA-70/71-12.68 / 14.86
 PID No. 105523

NO.	DESCRIPTION	REV. BY	DATE
4	FUNDING CODE CHANGE	CWL	11-29-2021

O:\2012\20120418\FRA\105523\STRUCTURES WALL_4W4\SHEETS\105523_4W4\W0001.DGN
 11/21/2021 12:03:08 PM
 0001Y81STD_USER

ESTIMATED QUANTITIES

CALCULATED: DJC DATE: 7-16-19
 CHECKED: RFV DATE: 7-18-19

ITEM	EXT.	TOTAL	PARTICIPATION 01/NHS/PV	UNITS	DESCRIPTION	REFERENCE SHEET --/1815
203	20000	12723	12723	CY	EMBANKMENT	
203	35000	1160	1160	CY	GRANULAR EMBANKMENT	
503	11101	LS	LS		COFFERDAMS AND EXCAVATION BRACING, AS PER PLAN	7000767
509	10000	55191	55191	LB	EPOXY COATED REINFORCING STEEL	
511	53012	349	349	CY	CLASS QC2 CONCRETE, MISC.: PARAPET INCLUDING SLEEPER SLAB, WITH QC/QA	700
511	53012	80	80	CY	CLASS QC2 CONCRETE, MISC.: LOAD DISTRIBUTION SLAB, WITH QC/QA	700
512	10100	3163	3163	SY	SEALING OF CONCRETE SURFACES (EPOXY-URETHANE)	
516	13200	582	582	SF	1/2" PREFORMED EXPANSION JOINT FILLER	
516	13900	1961	1961	SF	2" PREFORMED EXPANSION JOINT FILLER	
840	20001	27054	27054	SF	MECHANICALLY STABILIZED EARTH WALL, AS PER PLAN	707
840	21000	10251	10251	CY	WALL EXCAVATION	
840	22000	3706	3706	SY	FOUNDATION PREPARATION	
840	23000	11660	11660	CY	SELECT GRANULAR BACKFILL	
840	25010	680	680	FT	6" DRAINAGE PIPE, PERFORATED	
840	25020	405	405	FT	6" DRAINAGE PIPE, NON-PERFORATED	
840	26000	915	915	FT	CONCRETE COPING	
840	26050	23695	23695	SF	AESTHETIC SURFACE TREATMENT	707071746A
840	27000	5	5	DAY	ON-SITE ASSISTANCE	
SPECIAL	20302000	2403	2403	CY	ENGINEERED FILL (EPS GEOFOAM FILL)	701
SPECIAL	20302000	23290	23290	CY	ENGINEERED FILL (LIGHTWEIGHT CELLULAR CONCRETE FILL), CLASS II	702
SPECIAL	20302000	2450	2450	CY	ENGINEERED FILL (LIGHTWEIGHT CELLULAR CONCRETE FILL), CLASS III	702
SPECIAL	20365000	5	5	EACH	SETTLEMENT PLATFORM	709

■ INCLUDES ALL AREAS UNDER THE ITEM 203 - GRANULAR MATERIAL, TYPE C, AS DEPICTED IN THE CROSS-SECTIONS IN THE PLANS

O:\2012\20120418\FRA\105523\STRUCTURES WALL_4WS SHEETS\105523_4WS\W0001.DGN
 11/21/2021 12:05:51 PM
 DDDTY81STD.LUSER

ESTIMATED QUANTITIES
 MSE WALLS 4W5 & 4W6
 FROM FRA-70-1373R/FRA-70-1373A TO FRA-70-1390C

DESIGN AGENCY: **GPD GROUP**
 1801 Watermark Drive, Suite 210, Columbus, Ohio 43215 614.210.0731
 Copyright © 2015, GPD Group, Inc.

DESIGNED: DGN
 CHECKED: DJC

DRAWN: RPR
 REVISED:

REVIEWED: TJW
 DATE: 9-6-19
 STRUCTURE FILE NUMBER:

FRA-70/71-12.68 / 14.86
 PID No. 105523

1 / 26
 764 / 1815

NO.	DESCRIPTION	REV. BY	DATE
4	FUNDING CODE CHANGE	CWL	11-29-2021

NOTE: QUANTITIES ARE FOR BOTH WALLS 4W5 AND 4W6.

ESTIMATED QUANTITIES

CALCULATED: MOJ DATE: 9-2-19
 CHECKED: TJW DATE: 9-5-19

ITEM	EXT.	TOTAL	PARTICIPATION		UNIT	DESCRIPTION	AS PER PLAN SHEET --/1815
			01/NHS/PV LS	01/NHS/PV LS			
503	11101	LS				COFFERDAMS AND EXCAVATION BRACING, AS PER PLAN	700, 791
503	21100	1,140	502	638	CY	UNCLASSIFIED EXCAVATION	
509	10000	138,307	60,855	77,452	LB	EPOXY COATED REINFORCING STEEL	
511	46012	1,150	506	644	CY	CLASS QC1 CONCRETE WITH QC/QA, RETAINING/WINGWALL NOT INCLUDING FOOTING	
511	46513	562	247	315	CY	CLASS QC1 CONCRETE WITH QC/QA, FOOTING, AS PER PLAN	
512	10100	1,048	461	587	SY	SEALING OF CONCRETE SURFACES (EPOXY-URETHANE)	
516	13600	292	128	164	SF	1" PREFORMED EXPANSION JOINT FILLER	
516	13900	61	27	34	SF	2" PREFORMED EXPANSION JOINT FILLER	

G:\2012\20120418\FRA\105523\STRUCTURES WALL-4W7\SHEETS\105523-4W7\W0001.DGN
 11/28/2021 10:08:25 AM
 DDDTY81STD_USER

NO.	DESCRIPTION	REV. BY	DATE
4	FUNDING CODE CHANGE/ QUANTITY REVISION	CWL/RFV	11-29-2021



DESIGNED	JMH	CHECKED	TJW
DRAWN	JMH	REVISED	
REVIEWED	DGN	STRUCTURE FILE NUMBER	
DATE	9-6-19		

ESTIMATED QUANTITIES
 C.I.P. - WALL 4W7
 1-70 MEDIAN BETWEEN FRA-70-1373R & FRA-70-1390C

FRA-70/71-12.68/14.86
PID No. 105523

CALCULATED: DK DATE: 3/12/15
 CHECKED: RA DATE: 3/12/15

ITEM	EXTENSION	TOTAL	PARTICIPATION		UNIT	DESCRIPTION	REFERENCE SHEET NO.
			01/NHS/PV	01/NHS/PV			
203	35001	644		644	CY	GRANULAR EMBANKMENT, AS PER PLAN	700
203	35110	3285		3285	CY	GRANULAR MATERIAL, TYPE B	
203	98100	5582		5582	SY	ROADWAY MISC.: COLUMN SUPPORTED WALLS	703-703B
509	10000	79170		79170	LB	EPOXY COATED REINFORCING STEEL	
511	53012	352		352	CY	CLASS QC2 CONCRETE MISC.: PARAPET INCLUDING SLEEPER SLAB WITH QC/QA	700
512	10100	3680		3680	SY	SEALING OF CONCRETE SURFACES (EPOXY-URETHANE)	
516	13200	58		58	SF	1/2" PREFORMED EXPANSION JOINT FILLER	
516	13600	268		268	SF	1" PREFORMED EXPANSION JOINT FILLER	
516	13900	1753		1753	SF	2" PREFORMED EXPANSION JOINT FILLER	
840	20001	34590		34590	SF	MECHANICALLY STABILIZED EARTH WALL, AS PER PLAN	707
840	21000	3368		3368	CY	WALL EXCAVATION	
840	23000	42100		42100	CY	SELECT GRANULAR BACKFILL	
840	25010	1620		1620	FT	6" DRAINAGE PIPE, PERFORATED	
840	25020	77		77	FT	6" DRAINAGE PIPE, NON-PERFORATED	812
840	26000	875		875	FT	CONCRETE COPING	
840	26050	34590		34590	SF	AESTHETIC SURFACE TREATMENT	707
840	27000	1		1	DAY	ON-SITE ASSISTANCE	
SPECIAL	20365000	7		7	EACH	SETTLEMENT PLATFORM	709

4
1

NO.	DESCRIPTION	REV. BY	DATE
1	REVISED ITEM	WCB	11/4/21
4	FUNDING CHANGE	WCB	11/23/21
4	REVISED EMBANKMENT INFORMATION, AS PER PLAN	WCB	11/29/21

ESTIMATED QUANTITIES



MSE WALL 4WB
 SOUTH SIDE BETWEEN FRA-70-1358A AND FRA-70-1373A

FRA-70/71-12.68 / 14.86
 PID No. 105523

1 / 15

804
1815

DESIGN AGENCY
DYNOTEC, INC.
 2931 E. DUBLIN-GRANVILLE RD. COLUMBUS, OH 43231
 614.880.7320 T • WWW.DYNOTEC.COM

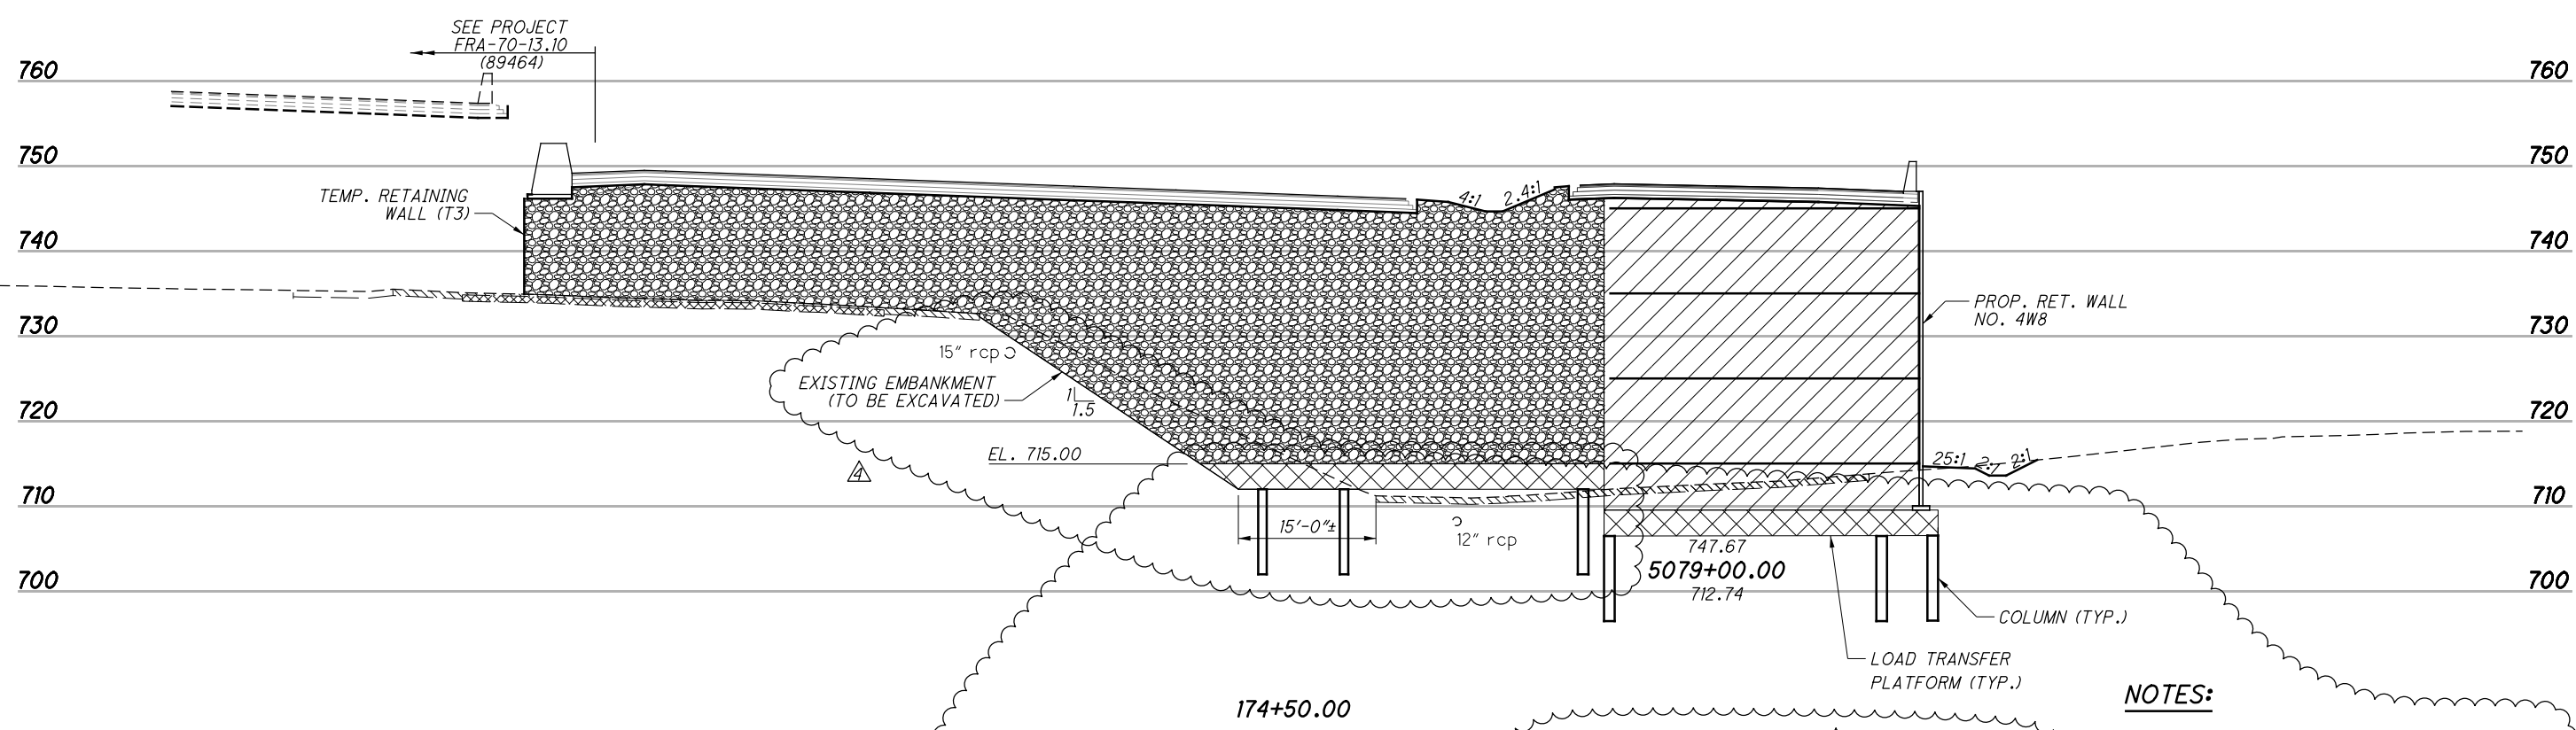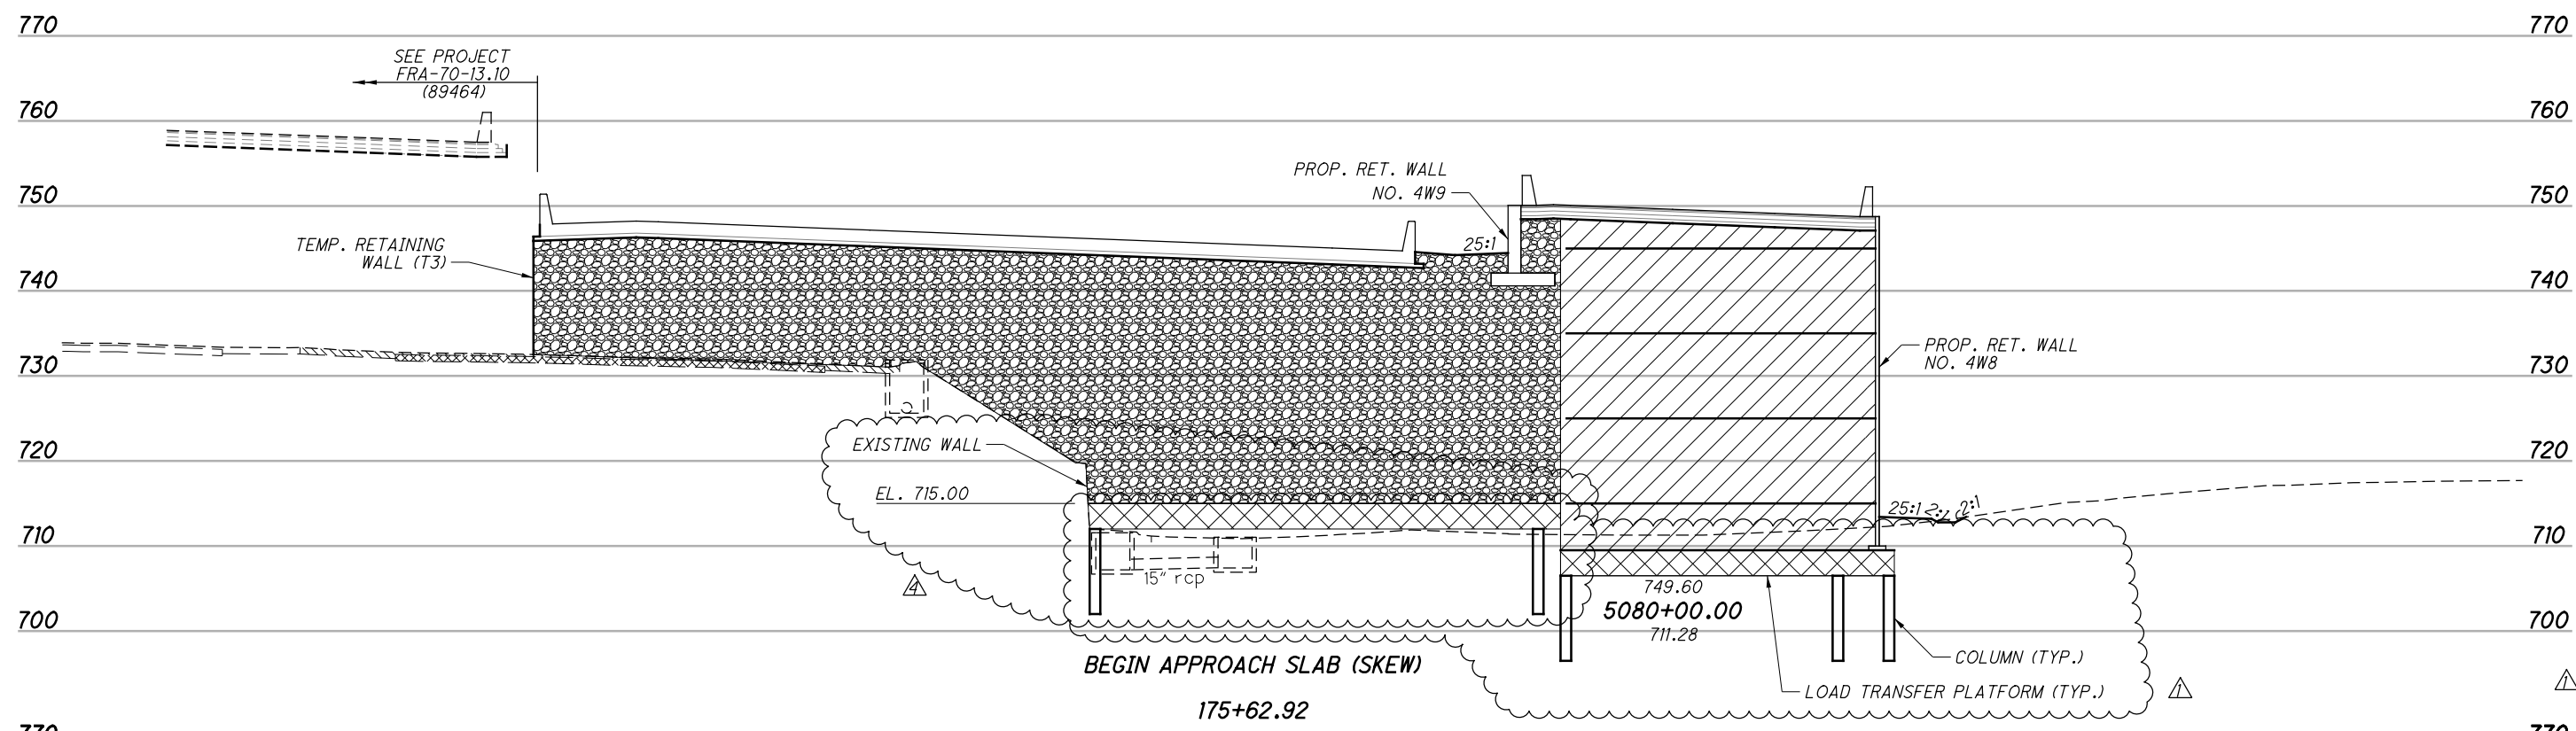

LEGEND

SELECT GRANULAR BACKFILL

ITEM 203 GRANULAR EMBANKMENT (TO BE INCLUDED WITH ROADWAY QUANTITIES)

LOAD TRANSFER PLATFORM

NO.	DESCRIPTION	REV. BY	DATE
1	REVISED GROUND IMPROVEMENT ITEM & NOTE	MOJ	11-5-2021
4	REVISED EXCAVATION/EMBANKMENT DETAILS	MOJ	11-29-2021

NOTES:

1. SIZE AND SPACING OF COLUMNS ARE SHOWN FOR REPRESENTATION ONLY. ACTUAL SIZE AND SPACING TO BE DETERMINED BY CONTRACTOR.
2. A 3'-0" DEEP LOAD TRANSFER PLATFORM WAS ASSUMED FOR ROADWAY EXCAVATION (CUT) QUANTITIES.


DESIGN AGENCY: **GPD GROUP**
 CLASS, P.C.E., SCHOMER, BARRIS & DODD, INC.
 7801 Watermark Drive, Suite 1300, Columbus, Ohio 43215 614-210-0731
 Copyright © 2021 GPD Group, P.C.E., Schomer, Barris & Dodd, Inc.

DESIGNED	RSN	CHECKED	DGN
DRAWN	RSN	REVISED	
REVIEWED	RHC	STRUCTURE FILE NUMBER	
DATE	9-6-19		

CROSS-SECTIONS OF GROUND IMPROVEMENT
 MSE WALL 4W8
 SOUTH SIDE BETWEEN FRA-70-1358A AND FRA-70-1373A

FRA-70/71-12.68 / 14.86
 PID No. 105523

8 / 15
 811
 1815

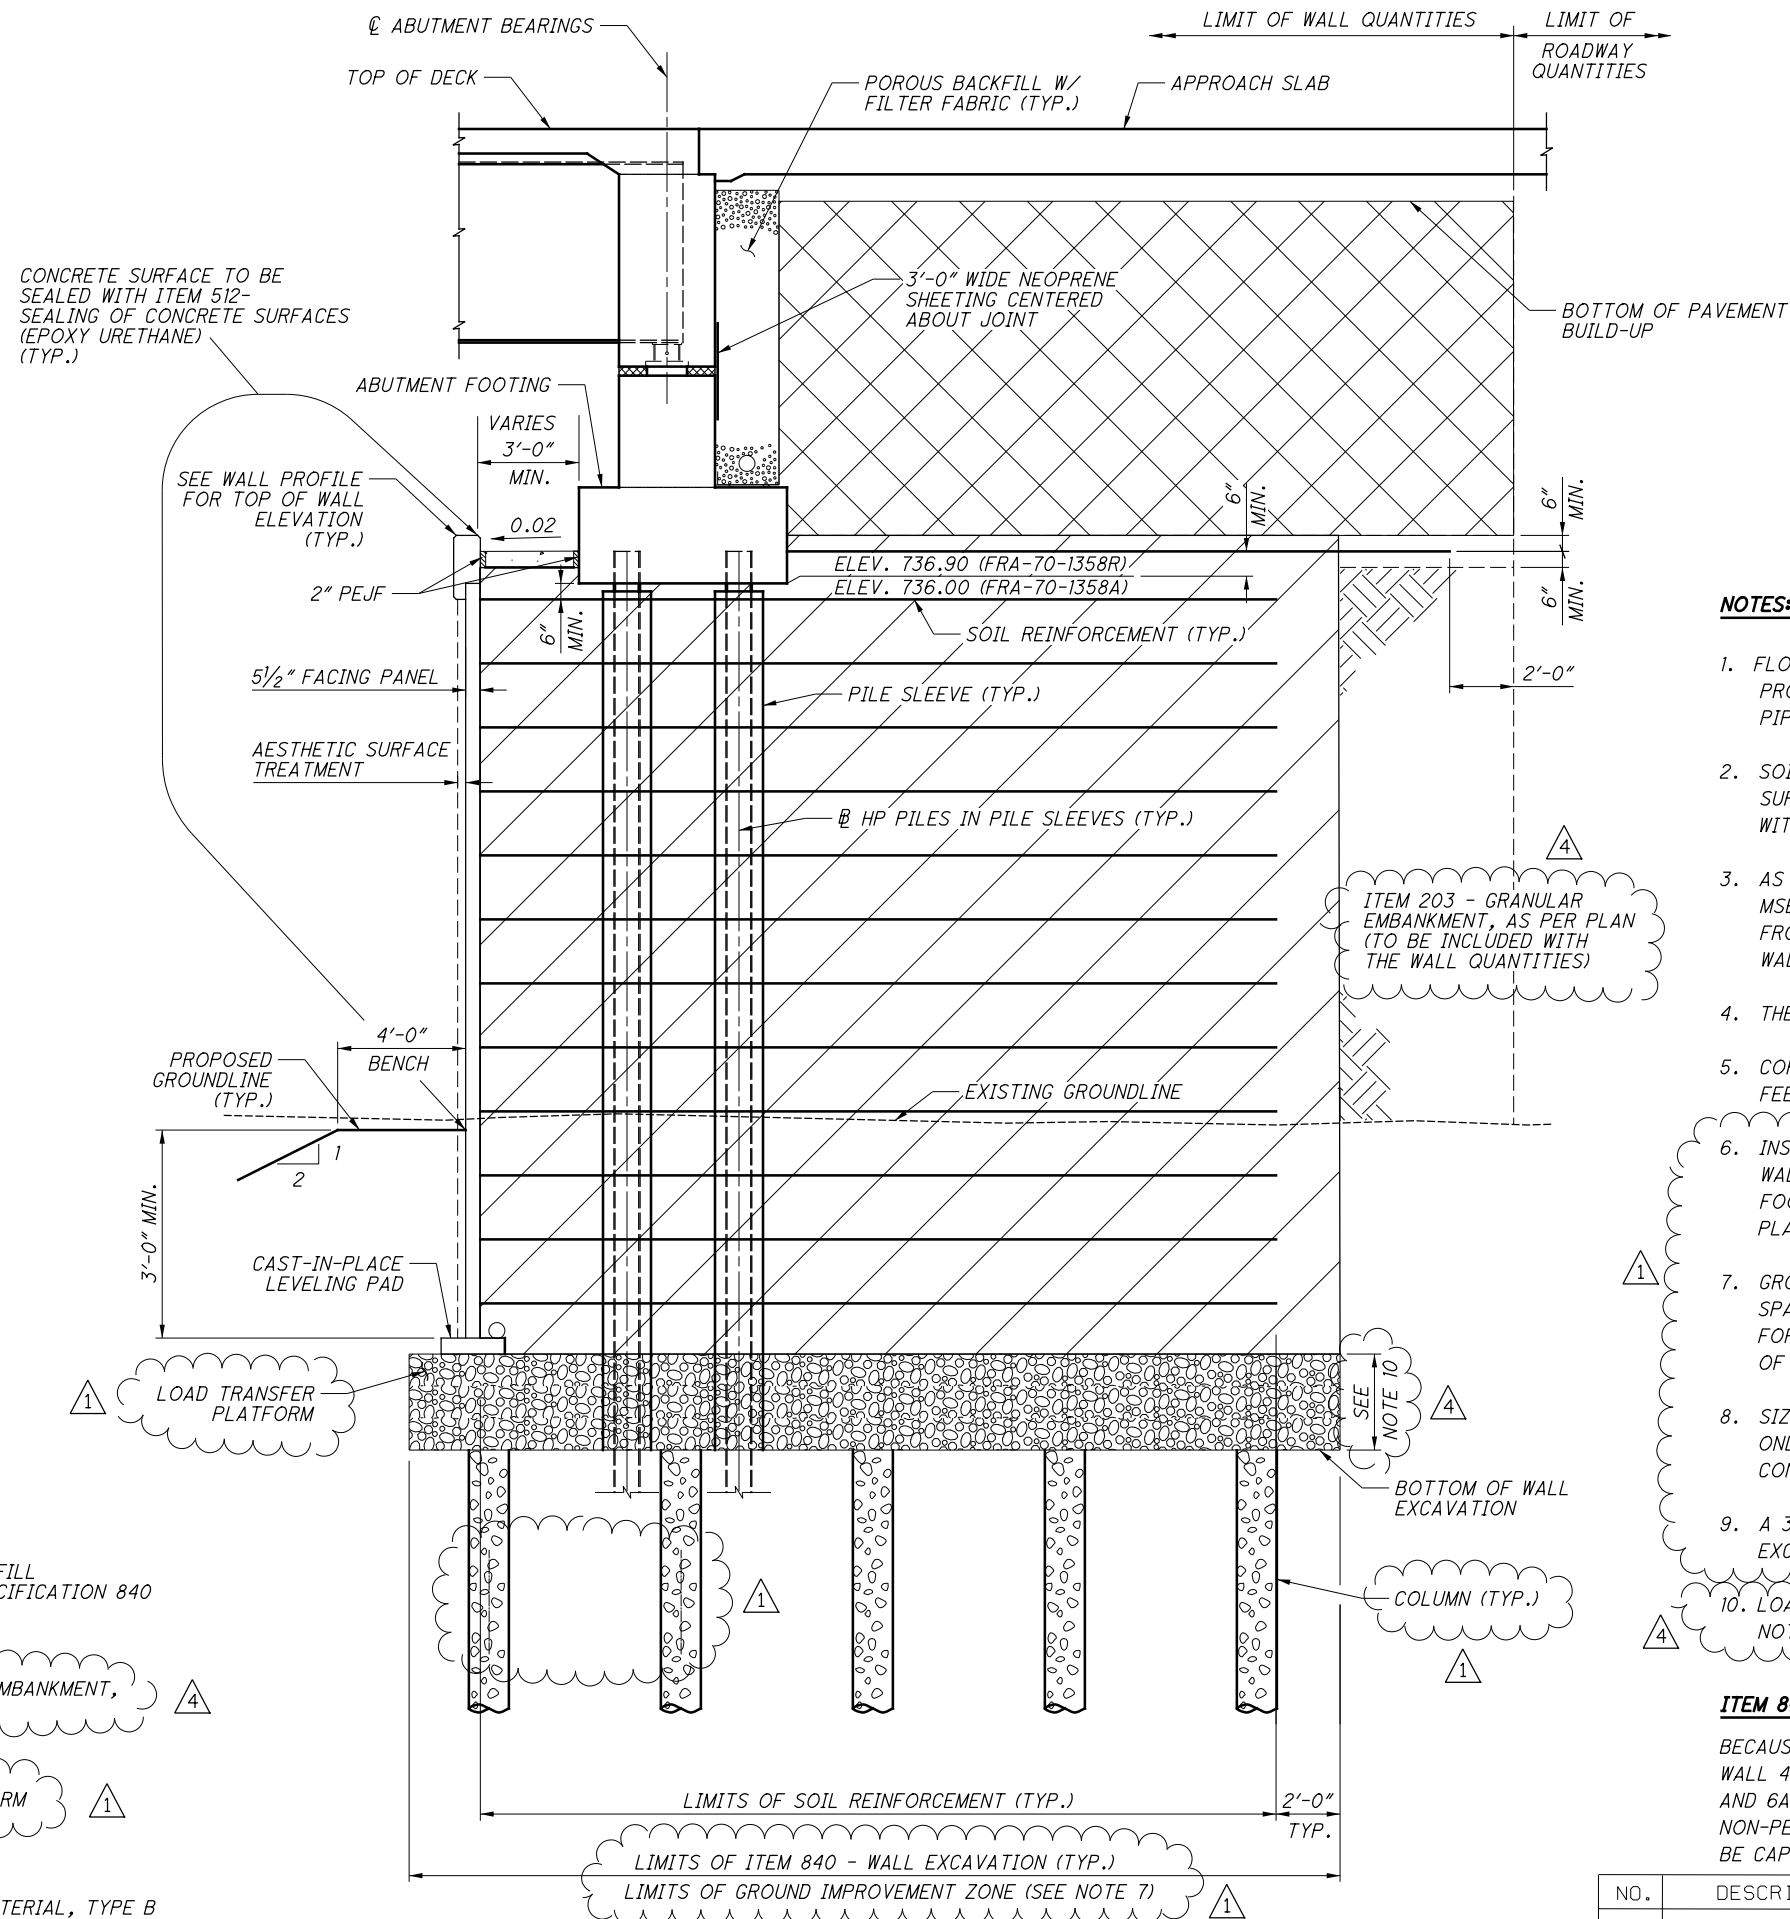

NOTES:

- FLOW LINE OF 6" DIA. PERFORATED PLASTIC PIPE WILL VARY TO PROVIDE POSITIVE DRAINAGE AT OUTLET. MINIMUM SLOPE OF PIPE SHALL BE 1/8" PER FOOT.
- SOIL REINFORCEMENT LENGTH TO BE DETERMINED BY WALL SUPPLIER OF THE APPROVED WALL SYSTEM, AND SHALL COMPLY WITH THE REQUIREMENTS LISTED ON SHEET 708 OF 1815.
- AS SHOWN IN THE PLANS, THE MAXIMUM DESIGN HEIGHT OF THE MSE WALL VARIES FROM 5'-1" TO 43'-4" (ACTUAL HEIGHT VARIES FROM 5'-1" TO 36'-4"), FINAL HEIGHTS TO BE DETERMINED BY WALL SUPPLIER.
- THE THICKNESS OF MSE WALL PANELS IS ASSUMED AT 5/2".
- COPING EXPANSION JOINTS SHALL BE SPACED NO MORE THAN 20 FEET APART AND ALIGNED WITH JOINTS BETWEEN FACING PANELS.
- INSTALL PILE SLEEVES DURING THE CONSTRUCTION OF THE MSE WALL. PILE SLEEVES SHALL EXTEND FROM BOTTOM OF ABUTMENT FOOTING TO BOTTOM OF WALL EXCAVATION/LOAD TRANSFER PLATFORM AND SHALL BE INSTALLED AS PER SS 840.06.J.
- GROUND IMPROVEMENT SHALL BE IN THE FORM OF INTERMITTENTLY SPACED COLUMNS SUPPORTING A LOAD TRANSFER PLATFORM (LTP). FOR ADDITIONAL INFORMATION, SEE NOTES ON SHEET 703-703B OF 1815.
- SIZE AND SPACING OF COLUMNS ARE SHOWN FOR REPRESENTATION ONLY. ACTUAL SIZE AND SPACING TO BE DETERMINED BY CONTRACTOR.
- A 3'-0" DEEP LOAD TRANSFER PLATFORM WAS ASSUMED FOR WALL EXCAVATION QUANTITIES.
- LOAD TRANSFER PLATFORM; DESIGN IN ACCORDANCE WITH GENERAL NOTE: ITEM 203 - ROADWAY, MISC.: COLUMN SUPPORTED WALLS.

ITEM 840 - 6" DRAINAGE PIPE, NON-PERFORATED

BECAUSE THERE IS NOT A VERY GOOD LOCATION TO CONNECT THE WALL 4W8 DRAINAGE THAT IS TO BE CONSTRUCTED IN PROJECT 4A AND 6A TO EXISTING DRAINAGE INFRASTRUCTURE, 6" DRAINAGE PIPE, NON-PERFORATED SHALL STUB THROUGH THE TEMPORARY WALL AND BE CAPPED FOR FUTURE PROJECT 4A AND 6A DRAINAGE CONNECTION.




LEGEND:

- SELECT GRANULAR BACKFILL PER SUPPLEMENTAL SPECIFICATION 840
- ITEM 203 - GRANULAR EMBANKMENT, AS PER PLAN
- LOAD TRANSFER PLATFORM
- ITEM 203 GRANULAR MATERIAL, TYPE B

SECTION A-A
 SEE NOTE 8 FOR LIMITS

NO.	DESCRIPTION	REV. BY	DATE
1	DETAILS REVISED	WCB	11/4/21
4	REVISED ITEM DESCRIPTION	WCB	11/29/21

Plot Driver: C:\000Tcadd\Standards\p1c1g\000Tcadd_PDF.plt;ig Pen Table: N:\Jobs\CADD-Dynotec\Projects\000T_Jobs\11662-South Trench (Structures)\Plotting\71372-South Trench.dwg
 File: N:\Jobs\2011\11662 - South Trench (FRA-70-1354)\71372-PROJECT 4R (105523)\STRUCTURES\WALL_4WB-...SHEETS\71372_4WB\000B2.dgn;barbera

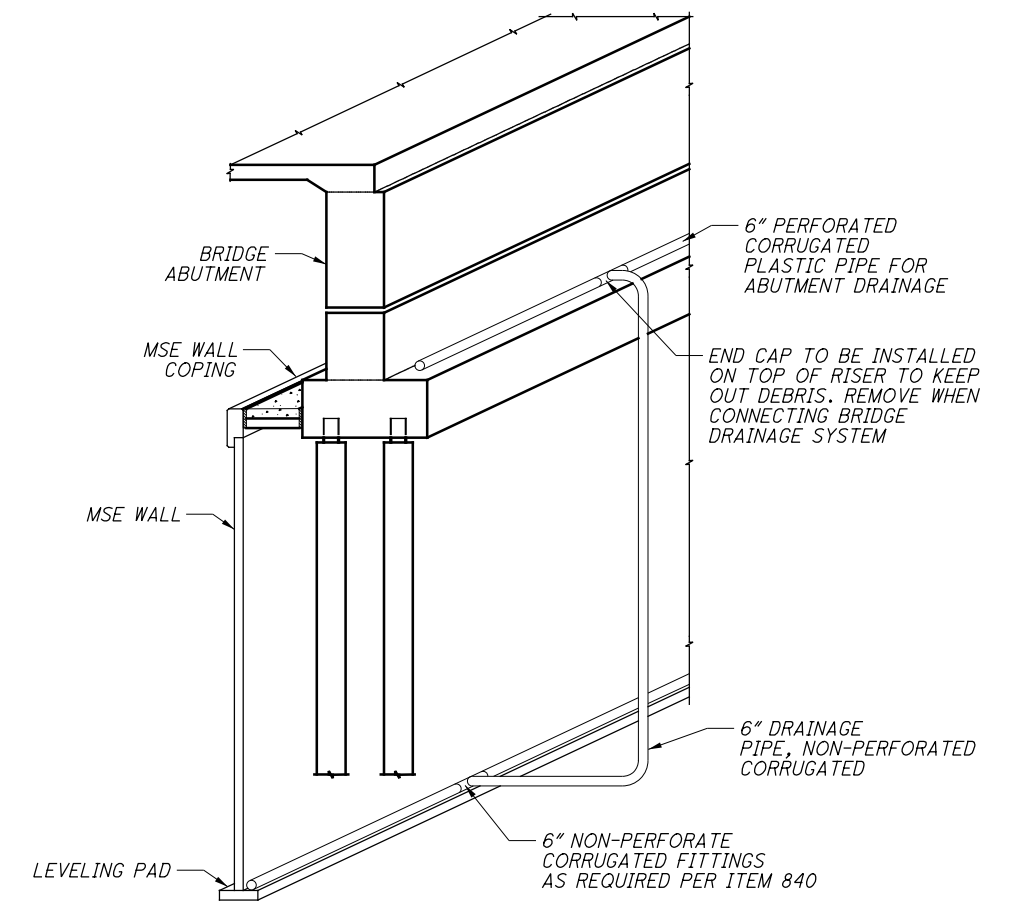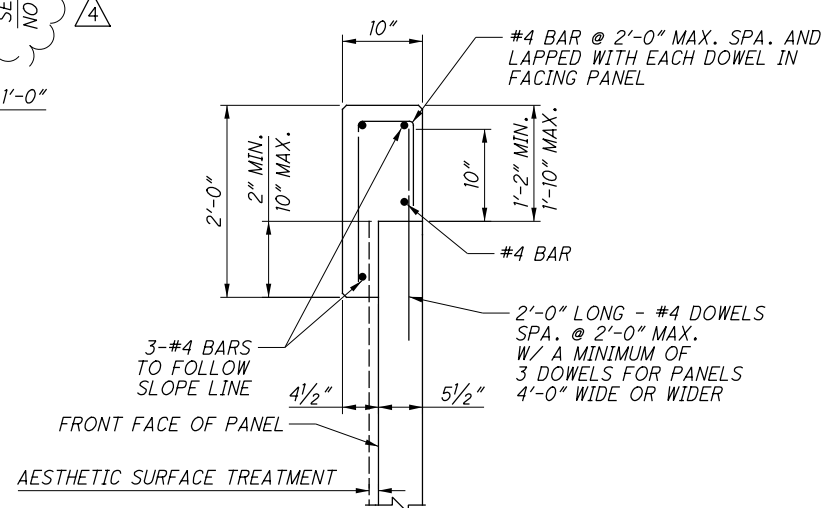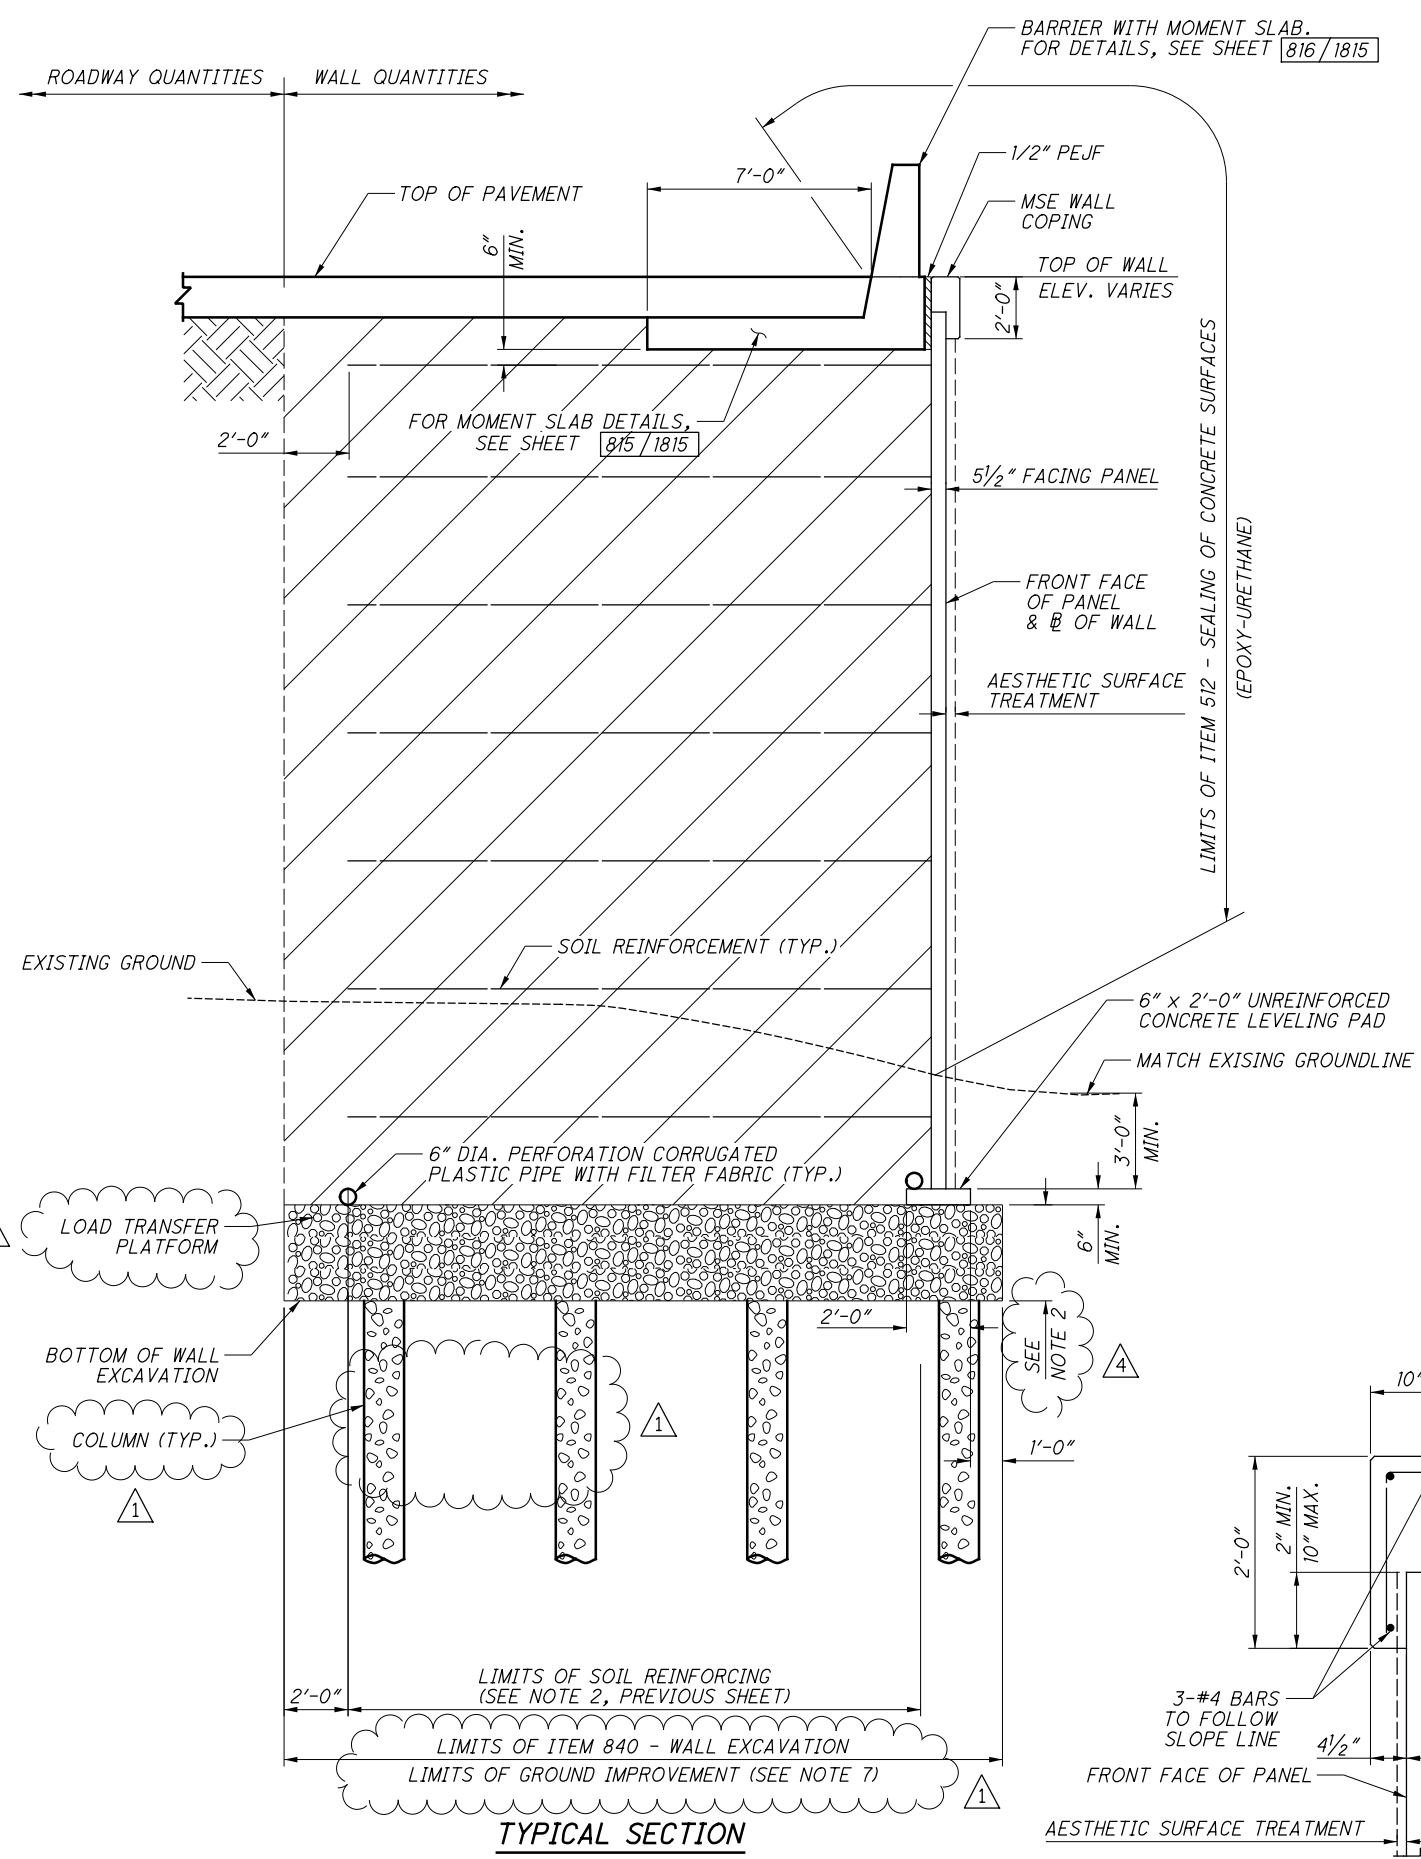

- LEGEND:**
- SELECT GRANULAR BACKFILL PER SUPPLEMENTAL SPECIFICATION 840
 - ITEM 203 - GRANULAR EMBANKMENT, AS PER PLAN (TO BE INCLUDED WITH ROADWAY QUANTITIES)
 - LOAD TRANSFER PLATFORM

- NOTES:**
1. FOR GROUND IMPROVEMENT AND MSE WALL NOTES, SEE SHEET 812/1815
 2. LOAD TRANSFER PLATFORM; DESIGN IN ACCORDANCE WITH GENERAL NOTE: ITEM 203 - ROADWAY, MISC.: COLUMN SUPPORTED WALLS.

NO.	DESCRIPTION	REV. BY	DATE
1	DETAILS REVISED	WCB	11/4/21
4	REVISED ITEM DESCRIPTION & NOTES	WCB	11/29/21

DESIGN AGENCY: **DYNOTEC, INC.**
 2331 E. DUBLIN-GRANVILLE RD. COLUMBUS, OH 43231
 614.880.7320 T • WWW.DYNOTEC.COM

DATE: 3/11/2015
 EC
 STRUCTURE FILE NUMBER

DRAWN: DNK
 CHECKED: REVISED
 DESIGNED: RA
 CHECKED: OHK

MSE WALL SECTION
 MSE WALL 4W8
 SOUTH SIDE BETWEEN FRA-70-1358A AND FRA-70-1373A

FRA-70/71-12.68 / 14.86
 PID No. 105523

10 / 15
 813
 1815

CALCULATED: DK DATE: 3/12/15
 CHECKED: RA DATE 3/12/15

ITEM	EXTENSION	TOTAL	PARTICIPATION		UNIT	DESCRIPTION	REFERENCE SHEET NO.
			01/NHS/PV	01/NHS/PV			
203	20000	871		871	CY	EMBANKMENT	
203	35110	1015		1015	CY	GRANULAR MATERIAL, TYPE B	
.	
512	10100	295		295	SY	SEALING OF CONCRETE SURFACES (EPOXY-URETHANE)	
516	13200	11		11	SF	1/2" PREFORMED EXPANSION JOINT FILLER	
516	13900	87		87	SF	2" PREFORMED EXPANSION JOINT FILLER	
840	20000	3150		3150	SF	MECHANICALLY STABILIZED EARTH WALL	707
840	21000	833		833	CY	WALL EXCAVATION	
840	22000	454		454	SY	FOUNDATION PREPARATION	
840	23000	3272		3272	CY	SELECT GRANULAR BACKFILL	
840	23050	107		107	CY	NATURAL SOIL	
840	25010	284		284	FT	6" DRAINAGE PIPE, PERFORATED	
840	25020	125		125	FT	6" DRAINAGE PIPE, NON PERFORATED	834
840	26000	141		141	FT	CONCRETE COPING	
840	26050	3150		3150	SF	AESTHETIC SURFACE TREATMENT	707
840	27000	1		1	DAY	ON-SITE ASSISTANCE	
SPECIAL	20365000	2		2	EACH	SETTLEMENT PLATFORM	709

NO.	DESCRIPTION	REV. BY	DATE
4	FUNDING CHANGE	WCB	11-23-2021

ESTIMATED QUANTITIES

MSE WALL 4W10
WEST SIDE OF FRA-70-1358R AND FRA-70-1358A

DESIGN AGENCY
DYNATEC, INC.
2931 E. DUBLIN-CRANVILLE RD. COLUMBUS, OH 43231
614.880.7320 T • WWW.DYNATEC.COM

DESIGNED: RA
CHECKED: OHK

DRAWN: DNK
REVISED:

REVIEWED: EC
STRUCTURE FILE NUMBER:

DATE: 3/11/2015

FRA-70/71-12.68 / 14.86
PID No. 105523

1 / 4

831
1815

CALCULATED: DK DATE: 3/12/15
 CHECKED: RA DATE: 3/12/15

ITEM	EXTENSION	TOTAL	PARTICIPATION		UNIT	DESCRIPTION	REFERENCE SHEET NO.
			01/NHS/PV	01/NHS/PV			
			ESTIMATED QUANTITIES				
203	20000	224		224	CY	EMBANKMENT	
203	35110	444		444	CY	GRANULAR MATERIAL, TYPE B	
.	
512	10100	616		616	SY	SEALING OF CONCRETE SURFACES (EPOXY-URETHANE)	
516	13200	24		24	SF	1/2" PREFORMED EXPANSION JOINT FILLER	
516	13900	172		172	SF	2" PREFORMED EXPANSION JOINT FILLER	
601	21000	28		28	SY	CONCRETE SLOPE PROTECTION	
840	20000	6480		6480	SF	MECHANICALLY STABILIZED EARTH WALL	707
840	21000	365		365	CY	WALL EXCAVATION	
840	22000	730		730	SY	FOUNDATION PREPARATION	
840	23000	4753		4753	CY	SELECT GRANULAR BACKFILL	
840	23050	562		562	CY	NATURAL SOIL	
840	25010	663		663	FT	6" DRAINAGE PIPE, PERFORATED	
840	25020	63		63	FT	6" DRAINAGE PIPE, NON-PERFORATED	
840	26000	352		352	FT	CONCRETE COPING	
840	26050	6480		6480	SF	AESTHETIC SURFACE TREATMENT	707
SPECIAL	27000	1		1	DAY	ON-SITE ASSISTANCE	
SPECIAL	20365000	1		1	EACH	SETTLEMENT PLATFORM	709

NO.	DESCRIPTION	REV. BY	DATE
4	FUNDING CHANGE	WCB	11-23-2021

ESTIMATED QUANTITIES

MSE WALL 4W11
 I-71 NB JUST NORTH OF GREENLAWN TO RAMP BRIDGE M9

FRA-70/71-12.68 / 14.86
 PID No. 105523

DESIGN AGENCY
DYNOTEC, INC.
 2931 E. DUBLIN-CRANVILLE RD. COLUMBUS, OH 43231
 614.880.7320 T • WWW.DYNOTEC.COM

DESIGNED: RA
 CHECKED: OHK

DRAWN: DNK
 REVISED:

REVIEWED: EC
 DATE: 3/11/2015
 STRUCTURE FILE NUMBER:

1 / 10

835
 1815

CALCULATE: DK DATE: 3/12/15

CHECKED: RA DATE: 3/12/15

ITEM	EXTENSION	TOTAL	PARTICIPATION		UNIT	DESCRIPTION	REFERENCE SHEET NO.
			01/NHS/PV	01/NHS/PV			
			ESTIMATED QUANTITIES				
.
509	10000	88774	88774		LB	EPOXY COATED REINFORCING STEEL	
511	53012	305	305		CY	CLASS QC2 CONCRETE MISC.: PARAPET INCLUDING SLEEPER SLAB WITH QC/QA	700
512	10100	2751	2751		SY	SEALING OF CONCRETE SURFACES (EPOXY-URETHANE)	
516	13200	63	63		SF	1/2" PREFORMED EXPANSION JOINT FILLER	
516	13600	254	254		SF	1" PREFORMED EXPANSION JOINT FILLER	
516	13900	1648	1648		SF	2" PREFORMED EXPANSION JOINT FILLER	
840	20000	23305	23305		SF	MECHANICALLY STABILIZED EARTH WALL	707
840	21000	8224	8224		CY	WALL EXCAVATION	
840	22000	2473	2473		SY	FOUNDATION PREPARATION	
840	23000	17963	17963		CY	SELECT GRANULAR BACKFILL	
840	23050	655	655		CY	NATURAL SOIL	
840	25010	1925	1925		FT	6" DRAINAGE PIPE, PERFORATED	
840	25020	58	58		FT	6" DRAINAGE PIPE. NON-PERFORATED	
840	26000	937	937		FT	CONCRETE COPING	
840	26050	23305	23305		SF	AESTHETIC SURFACE TREATMENT	707
840	27000	1	1		DAY	ON-SITE ASSISTANCE	

NO.	DESCRIPTION	REV. BY	DATE
4	FUNDING CHANGE	WCB	11-23-2021

ESTIMATED QUANTITIES

MSE WALL 4W12
SOUTHERN SIDE OF RAMP C5 TO RAMP C3

DESIGN AGENCY
DYNATEC, INC.
2931 E. DUBLIN-CRAWFORD RD. COLUMBUS, OH 43231
614.880.7320 T • WWW.DYNATEC.COM

DESIGNED: RA
CHECKED: OHK

DRAWN: DNK
REVISED:

REVIEWED: EC
STRUCTURE FILE NUMBER:

DATE: 3/11/2015

FRA-70/71-12.68 / 14.86
PID No. 105523

1 / 20

845
1815

ESTIMATED QUANTITIES

CALCULATED: MOJ DATE: 2-25-19
 CHECKED: TJW DATE: 3-5-19

ITEM	EXT. ^A	TOTAL 01/NHS/PV	UNIT	DESCRIPTION	AS PER PLAN SHEET --/1815
203	98100	504	SY	ROADWAY, MISC.: COLUMN SUPPORTED WALLS	703-703B ^A
509	10000	20,943	LB	EPOXY COATED REINFORCING STEEL	
511	53012	130	CY	CLASS QC2 CONCRETE, MISC.: PARAPET INCLUDING SLEEPER SLAB WITH QC/QA	700
512	10100	614	SY	SEALING OF CONCRETE SURFACES (EPOXY-URETHANE)	
516	13900	405	SF	2" PREFORMED EXPANSION JOINT FILLER	
840	20001	4,486	SF	MECHANICALLY STABILIZED EARTH WALL, AS PER PLAN	707
840	21000	1,251	CY	WALL EXCAVATION	
840	23000	2,043	CY	SELECT GRANULAR BACKFILL	
840	23050	72	CY	NATURAL SOIL	
840	25010	609	FT	6" DRAINAGE PIPE, PERFORATED	
840	25020	39	FT	6" DRAINAGE PIPE, NON-PERFORATED	
840	26000	289	FT	CONCRETE COPING	
840	27000	5	DAY	ON-SITE ASSISTANCE	

G:\2012\2012048\FRA\105523\STRUCTURES WALL_4W20\ SHEETS\105523_4W20W0201.DGN
 11/21/2021 12:14:41 PM
 000TY81STD.LUSER

NO.	DESCRIPTION	REV. BY	DATE
1	REVISED ITEM	MOJ	11-5-2021
4	FUNDING CODE CHANGE	CWL	11-29-2021

DESIGN AGENCY
GPD GROUP
Class, P.E., Engineer, Burns & McDonnell, Inc.
 1801 Watermark Drive, Suite 150, Columbus, Ohio 43215 614.210.0731
 Copyright © 2019, Burns & McDonnell, Inc. 2015

DATE
 6-9-19

REVIEWED
 DGN

STRUCTURE FILE NUMBER

DRAWN
 MOJ

REVISED

DESIGNED
 MOJ

CHECKED
 TJW




ESTIMATED QUANTITIES
 MSE WALL 4W20
 RAMP C5 ADJACENT TO SUBSTATION

FRA -70/71-12.68 / 14.86
 PID No. 105523

1 / 6

883
 1815

01-2012-2012048 VFR-105523 STRUCTURES WALL-4W20 SHEETS\105523-4W20W01.DWG
 11/24/2021 11:43:57 PM
 000TY81STD_USER

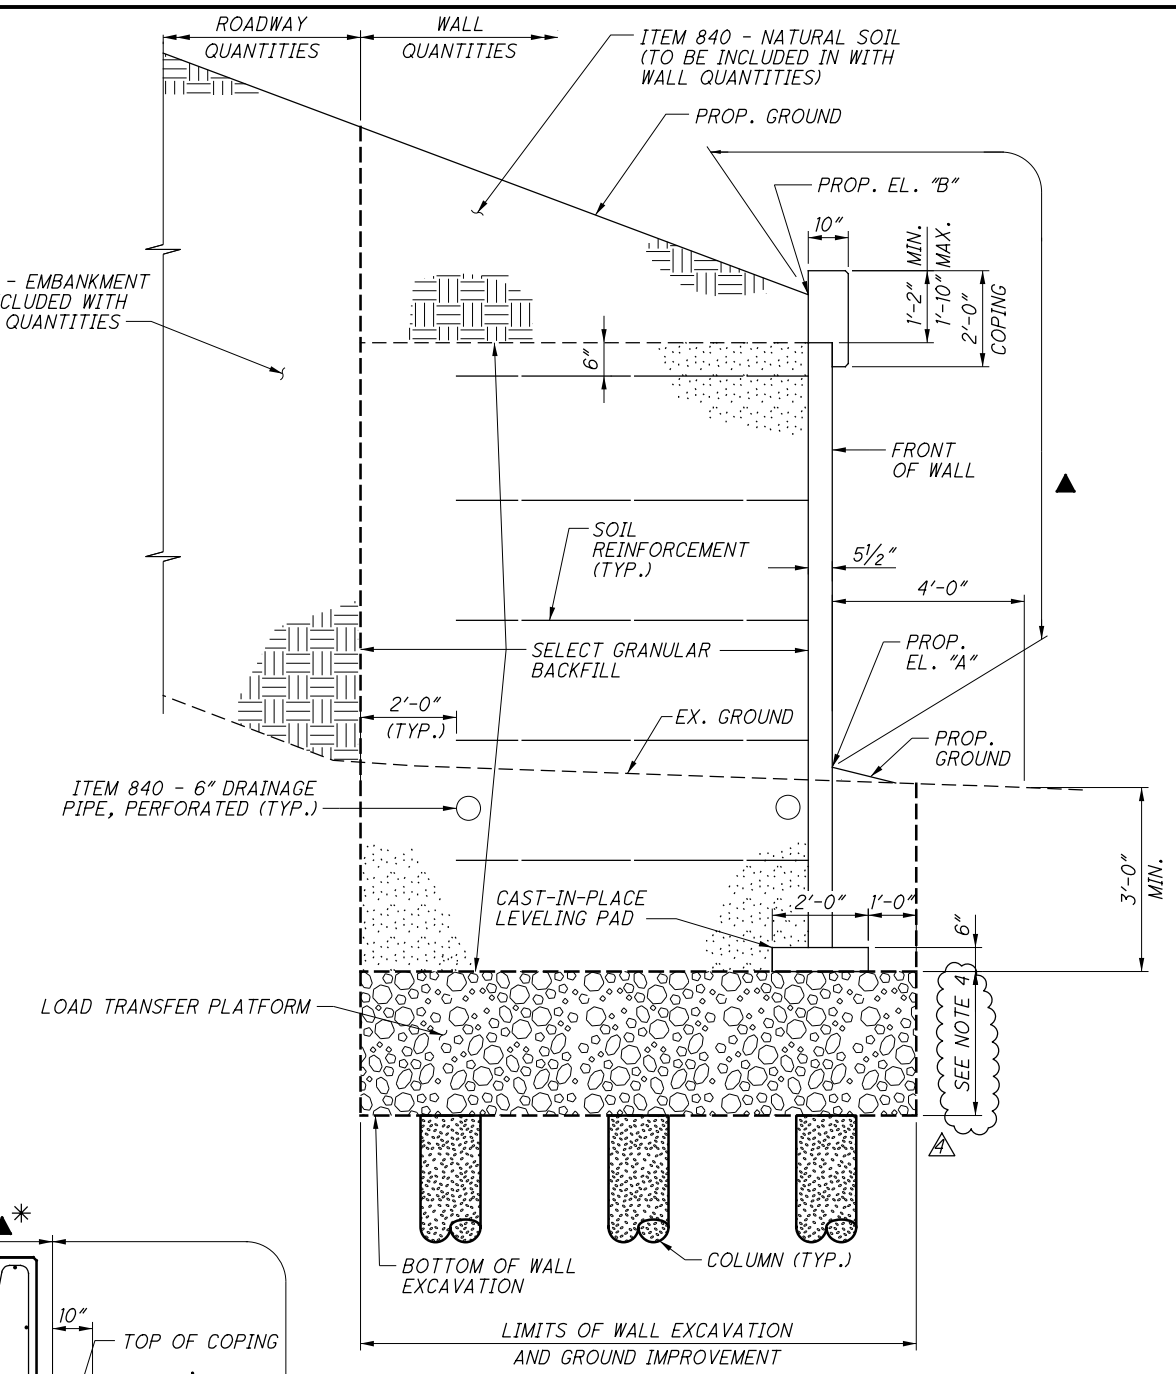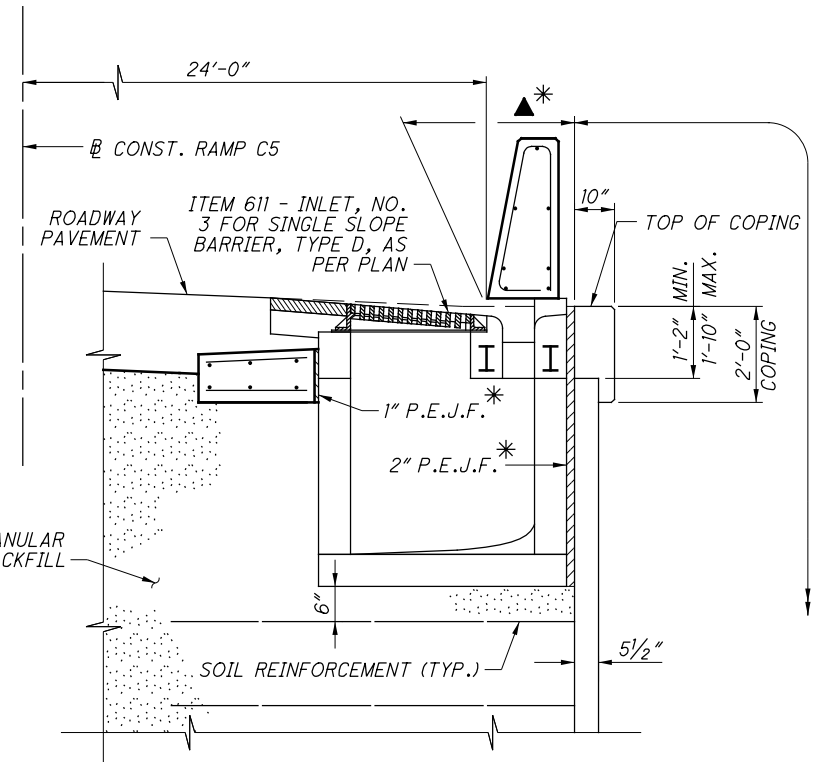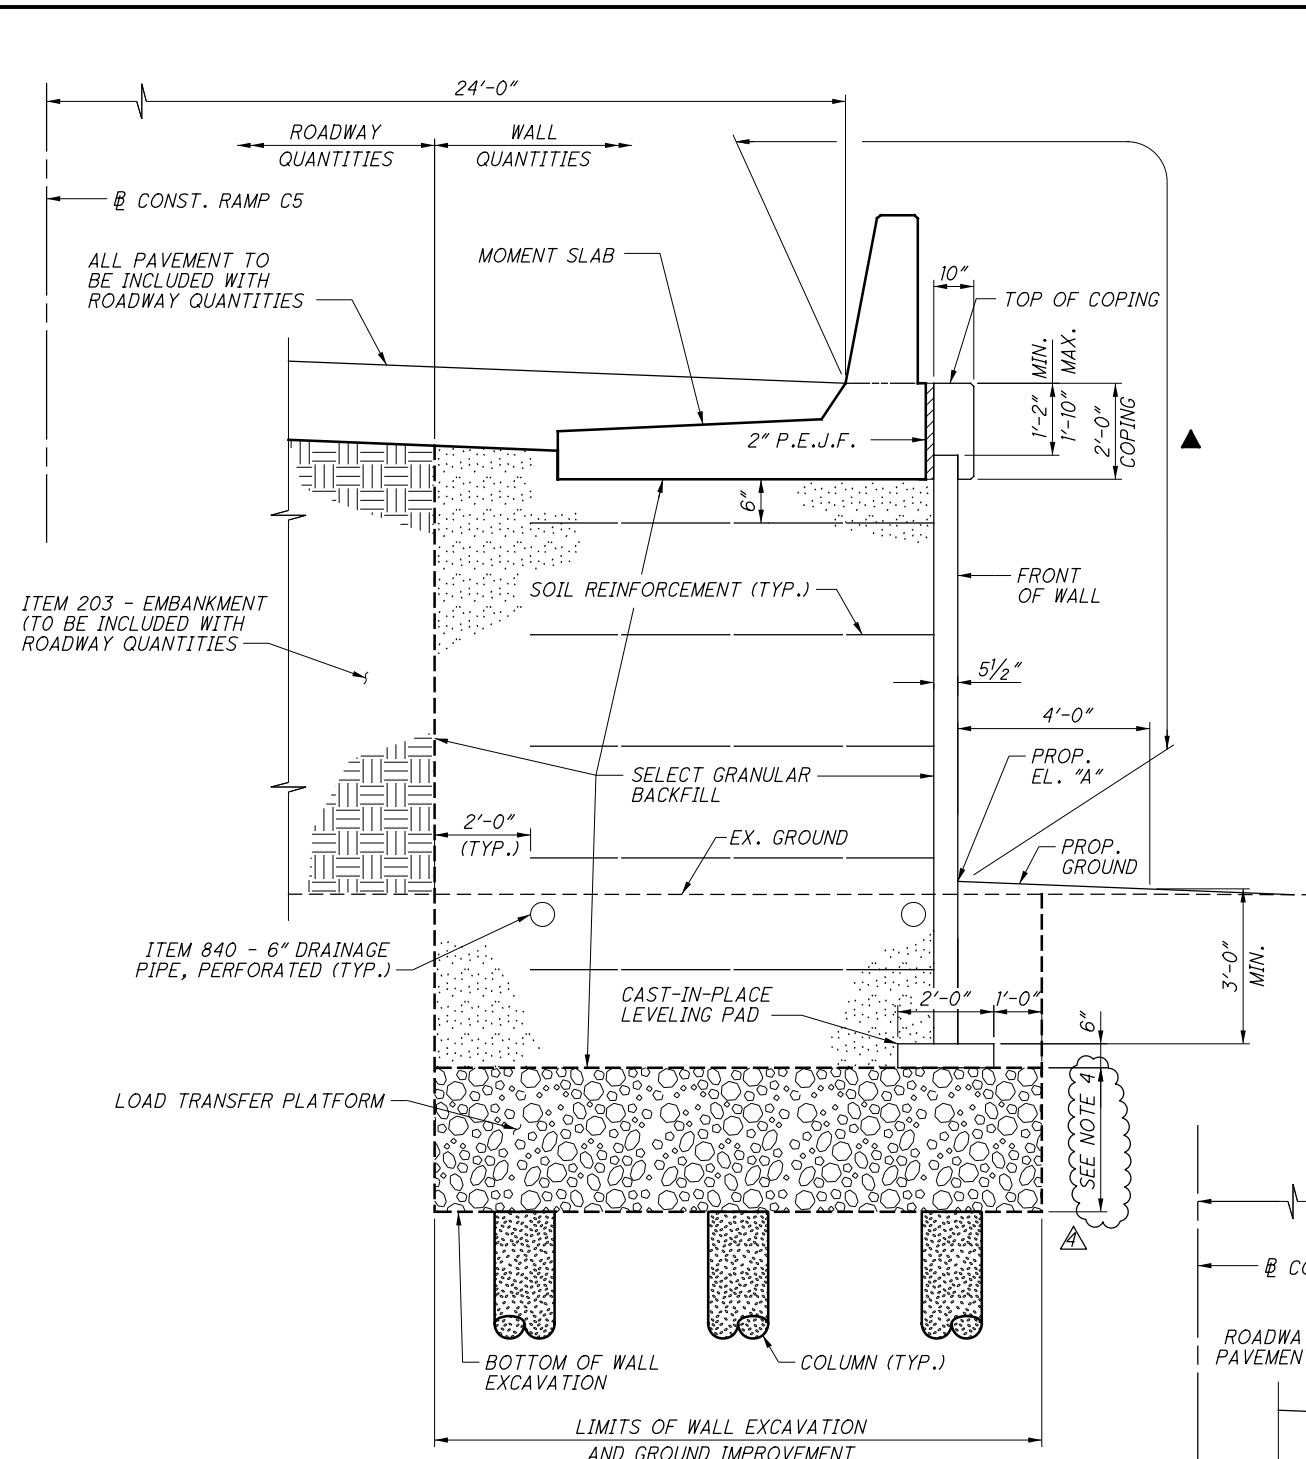

- LEGEND:**
- ▲ INDICATES LIMITS OF ITEM 512 - SEALING OF CONCRETE SURFACES (EPOXY-URETHANE)
 - * TO BE INCLUDED WITH ITEM 611 - INLET, NO. 3 FOR SINGLE SLOPE BARRIER, TYPE D, AS PER PLAN IN THE ROADWAY QUANTITIES
- NOTES:**
1. FOR LOCATIONS OF SECTIONS A, B, AND C, SEE SHEETS 2/6 AND 3/6.
 2. GROUND IMPROVEMENT SHALL BE IN THE FORM OF INTERMITTENTLY SPACED COLUMNS SUPPORTING A LOAD TRANSFER PLATFORM (LTP). FOR ADDITIONAL INFORMATION, SEE NOTES ON SHEET 703 - 703B OF 1815.
 3. A 3'-0" DEEP LOAD TRANSFER PLATFORM WAS ASSUMED FOR WALL EXCAVATION QUANTITIES.
 4. LOAD TRANSFER PLATFORM DESIGN IN ACORDANCE WITH GENERAL NOTE: ITEM 203 - ROADWAY, MISC.: COLUMN SUPPORTED WALLS

NO.	DESCRIPTION	REV. BY	DATE
4	DIMENSION/NOTE REVISION	RFV	11-29-2021

DESIGN AGENCY: **GPD GROUP**
 CLASS: P.E., S.H.M.E., B.S., & D.E.S.I.G.N.
 1801 Watermark Drive, Suite 150, Columbus, Ohio 43115 614.210.0731
 Copyright © 2015, GPD Group, Inc.

DESIGNED	MOJ	CHECKED	DGN
DRAWN	RPR	REVISED	
REVIEWED	TJW	STRUCTURE FILE NUMBER	
DATE	6-9-19		


MSE WALL SECTION
 MSE WALL 4W20
 RAMP C5 ADJACENT TO SUBSTATION

FRA-70/71-12.68 / 14.86
 PID No. 105523

4 / 6
 886
 1815

ESTIMATED QUANTITIES

CALCULATED: TJW DATE: 9-05-2019
 CHECKED: RFV DATE: 9-05-2019

ITEM	EXT.	TOTAL	PARTICIPATION 		UNITS	DESCRIPTION	A.P.P. REFERENCE SHT. NO.
			01/NHS/PV	01/NHS/PV			
504	11101	10,732	4,722	6,010	SF	STEEL SHEET PILING LEFT IN PLACE, AS PER PLAN	1
518	21200	100	44	56	CY	POROUS BACKFILL WITH GEOTEXTILE FABRIC	
518	40000	385	169	216	FT	6" PERFORATED CORRUGATED PLASTIC PIPE	
601	32105	3475	1529	1946	CY	ROCK CHANNEL PROTECTION, TYPE B WITH GEOTEXTILE FABRIC, AS PER PLAN	1
SPECIAL	690E98400	LS	LS	LS		SPECIAL - SUBSURFACE UTILITY LOCATING FOR ABANDONED SEWER	1

GENERAL NOTES

ITEM 504 - SHEET PILING LEFT IN PLACE, AS PER PLAN

THIS ITEM INCLUDES ALL LABOR, MATERIALS, EQUIPMENT AND INCIDENTALS NECESSARY TO COMPLETE PERMANENT SHEET PILE WALL 4W21, INCLUDING SEGMENTS IDENTIFIED AS 'A', 'B' AND 'C' AS SHOWN IN THESE PLANS. IN ADDITION TO THE REQUIREMENTS OF ITEM 504, THIS WORK SHALL INCLUDE CUTTING NECESSARY OPENINGS THROUGH THE SHEETING AS REQUIRED FOR OUTLETTING THE 6" PERFORATED PIPE ASSOCIATED WITH THE POROUS BACKFILL TO BE PLACED BEHIND THE SHEETING WALLS.

SHEET PILE MATERIAL SHALL BE HOT ROLLED STEEL WITH A MINIMUM YIELD STRENGTH OF 50 KSI, MINIMUM ELASTIC SECTION MODULUS OF 48.5 IN³/FT AND A MINIMUM MOMENT OF INTERIA OF 361.2 IN⁴/FT.

ALL WORK SHALL BE INCLUDED IN THE UNIT PRICE BID FOR ITEM 504 SHEET PILING LEFT IN PLACE, AS PER PLAN.

601 - ROCK CHANNEL PROTECTION, TYPE B WITH GEOTEXTILE FABRIC, AS PER PLAN

THIS WORK SHALL CONSIST OF CONSTRUCTING 2'-6" THICK TYPE B ROCK CHANNEL PROTECTION WITH GEOTEXTILE FABRIC. ROCK SHALL BE PLACED Laterally FROM THE BOTTOM OF EXISTING SLOPE UP TO THE FACE OF WALLS 4W21A, 4W21B AND 4W21C AND LONGITUDINALLY FOR THE LENGTH AS SHOWN IN THE RETAINING WALL PLANS, AS DIRECTED BY THE ENGINEER. ALL WORK SHALL CONFORM TO ITEM 601. GEOTEXTILE FABRIC SHALL MEET REQUIREMENTS OF ODOT CMS 712.09, TYPE B.

PAYMENT FOR THIS WORK SHALL BE MADE AT THE UNIT PRICE BID PER CUBIC YARD WHICH SHALL CONSTITUTE FULL PAYMENT FOR ALL LABOR, EQUIPMENT, MATERIALS AND INCIDENTALS TO COMPLETE THE WORK AS DESCRIBED AND DIRECTED.

SPECIAL - SUBSURFACE UTILITY LOCATING FOR ABANDONED SEWER

THIS WORK SHALL CONSIST OF USING QUALITY LEVEL 'B' AND LEVEL 'A' SUBSURFACE UTILITY LOCATING TECHNIQUES IN ACCORDANCE WITH ODOT SUBSURFACE UTILITY LOCATING SERVICES SPECIFICATIONS TO PRECISELY LOCATE THE EXISTING ABANDONED 48" COMBINED SEWER IN THE VICINITY OF THE PROPOSED SHEETING WALL SEGMENTS WITHOUT CAUSING UNDUE DISTURBANCE OF THE EXISTING SLOPE. IT IS THE INTENT THAT THIS WORK BE PERFORMED FIRST AT EACH WALL SEGMENT LOCATION PRIOR TO DRIVING SHEETING. THE SEWER SHALL BE AVOIDED AND NOT BE DAMAGED BY THE PILING INSTALLATION OR OTHER RELATED WORK. HOLES EXCAVATED USING LEVEL 'A' METHODS SHALL BE BACKFILLED WITH LOW-STRENGTH MORTAR MATERIAL CONFORMING TO ITEM 613. THE CONTRACTOR SHALL PROVIDE THE HORIZONTAL AND VERTICAL LOCATION OF THE SEWER TO THE ENGINEER AT LEAST 10 DAYS PRIOR TO PERFORMING THE PILING INSTALLATION.

PAYMENT FOR THIS WORK SHALL BE MADE AT THE LUMP SUM PRICE BID WHICH SHALL CONSTITUTE FULL PAYMENT FOR ALL LABOR, EQUIPMENT, MATERIALS AND INCIDENTALS TO COMPLETE THE WORK.

G:\2012\20120418\FRA\105523\STRUCTURES\WALL_4W21\SHEETS\105523_4W21\0201.DGN
 11/21/2021 12:17:25 PM
 000TY81STD.LUSER

NO.	DESCRIPTION	REV. BY	DATE
3	UPDATED NOTE	CWL	11-19-2021
4	FUNDING CODE CHANGE	CWL	11-29-2021

DESIGN AGENCY
GPD GROUP
Class, P.E., S. Shriver, Burns & Delaney, Inc.
 1801 Watermark Drive, Suite 150, Columbus, Ohio 43215 614.210.0731
 Copyright © 2015, Burns & Delaney, Inc. 2015

DATE
 9-6-19

REVIEWED
 DGN

STRUCTURE FILE NUMBER

DRAWN
 TJW

REVISED

DESIGNED
 TJW

CHECKED
 RFV

ESTIMATED QUANTITIES & NOTES
 SHEETING WALLS 4W21A, 4W21B, 4W21C
 ALONG THE EAST SIDE OF RAMP A5

FRA-70/71-12.68 / 14.86

PID No. 105523

1 / 3

888A
 1815

D:\2012\20120418\FRA\105523\STRUCTURES WALL_TEMPORARY SHEETS\105523_W0002.DGN
 11/24/2021 1:08:11 PM
 DDDTY81STD_USER

ESTIMATED QUANTITIES							
ITEM	EXT.	TOTAL	PARTICIPATION		UNIT	DESCRIPTION	AS PER PLAN SHEET __/1815
			01/NHS/PV	01/NHS/PV			
TEMPORARY SHORING WALL TS2							
503	11101	LUMP	LUMP	LUMP		COFFERDAMS AND EXCAVATION BRACING, AS PER PLAN	889A
TEMPORARY SHORING WALL TS4							
503	11101	LUMP	LUMP	LUMP		COFFERDAMS AND EXCAVATION BRACING, AS PER PLAN	890
TEMPORARY SHORING WALL TS4A							
503	11101	LUMP	LUMP	LUMP		COFFERDAMS AND EXCAVATION BRACING, AS PER PLAN	890A
TEMPORARY SHORING WALL TS5							
503	11101	LUMP	LUMP	LUMP		COFFERDAMS AND EXCAVATION BRACING, AS PER PLAN	891
TEMPORARY SHORING WALL TS6							
503	11101	LUMP	LUMP	LUMP		COFFERDAMS AND EXCAVATION BRACING, AS PER PLAN	892
TEMPORARY MSE WALL T2							
867	100	LUMP	LUMP	LUMP		TEMPORARY WIRE FACED MECHANICALLY STABILIZED EARTH WALL	
TEMPORARY MSE WALL T3							
867	100	LUMP	LUMP	LUMP		TEMPORARY WIRE FACED MECHANICALLY STABILIZED EARTH WALL	
TEMPORARY MSE WALL T4							
867	100	LUMP	LUMP	LUMP		TEMPORARY WIRE FACED MECHANICALLY STABILIZED EARTH WALL	
TEMPORARY MSE WALL T5							
867	100	LUMP	LUMP	LUMP		TEMPORARY WIRE FACED MECHANICALLY STABILIZED EARTH WALL	
TEMPORARY MSE WALL T6							
867	101	LUMP	LUMP	LUMP		TEMPORARY WIRE FACED MECHANICALLY STABILIZED EARTH WALL, AS PER PLAN	707
TEMPORARY MSE WALL T7							
867	101	LUMP	LUMP	LUMP		TEMPORARY WIRE FACED MECHANICALLY STABILIZED EARTH WALL, AS PER PLAN	707

NO.	DESCRIPTION	REV. BY	DATE
4	FUNDING CODE CHANGE / ADDED TS4A	CWL	11-29-2021

ESTIMATED QUANTITIES
TEMPORARY SHORING AND TEMPORARY WALLS


FRA-70/71-12.68 / 14.86
PID No. 105523

1 / 1

889
1815

DESIGN AGENCY
GPD GROUP
Class, P.E., Shriver, Burns & Dehaven, Inc.
1801 Watermark Drive, Suite 150, Columbus, Ohio 43215 614.210.0731
Copyright © Class, P.E., Shriver, Burns & Dehaven, Inc. 2015


DESIGNED	MOJ	CHECKED	RHC
DRAWN	MOJ	REVISED	
REVIEWED	TJW	STRUCTURE FILE NUMBER	
DATE	9-6-19		

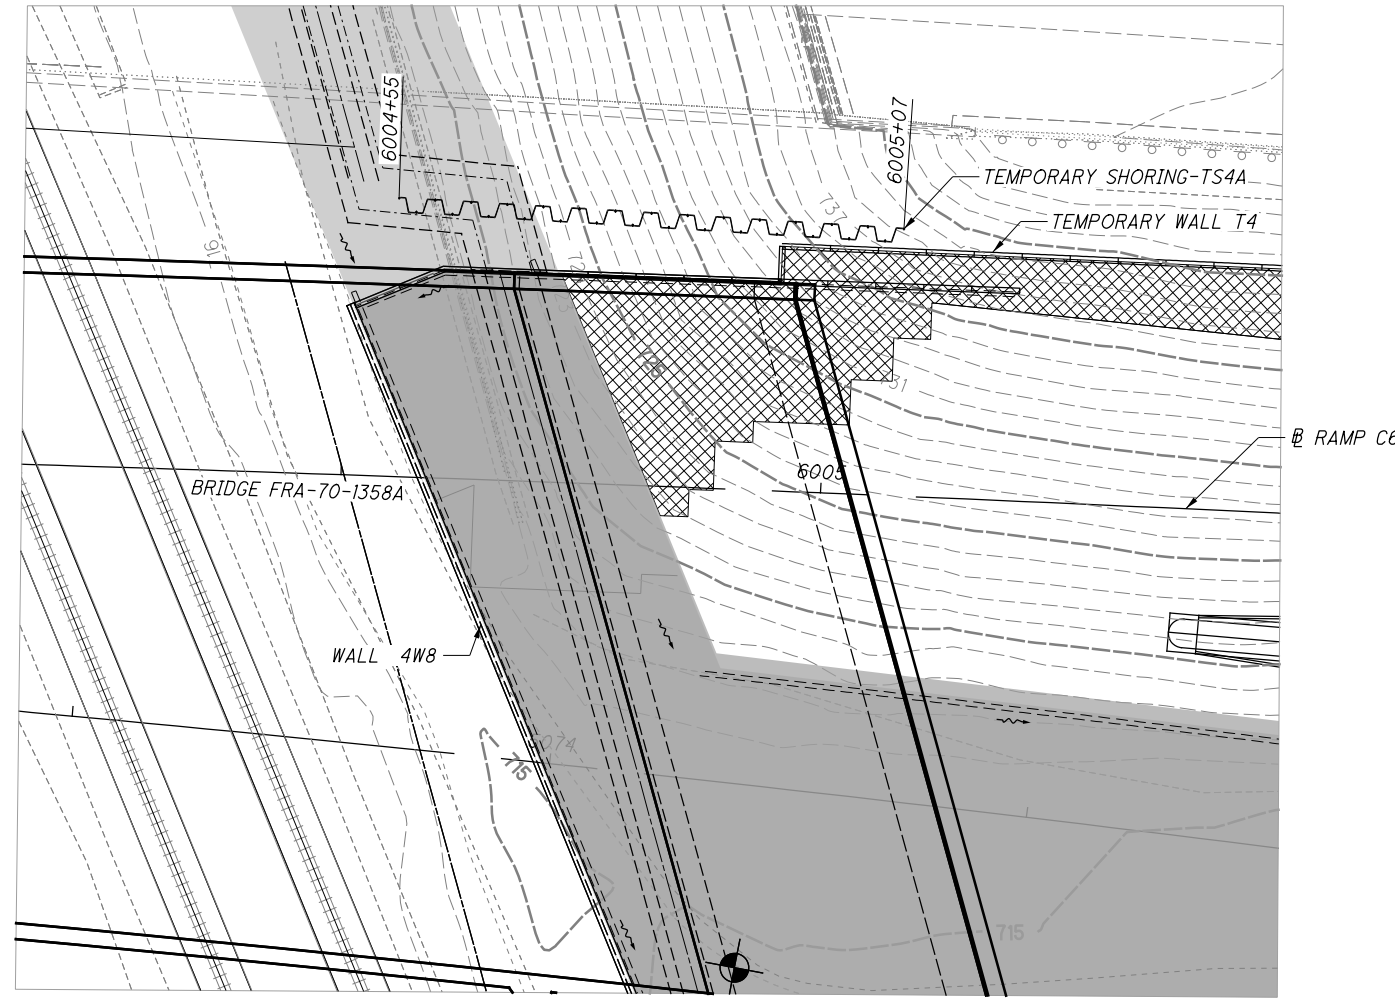

LEGEND:

- LIMITS OF TEMPORARY WALL T4 EXCAVATION
- LIMITS OF PERMANENT WALL 4W8 EXCAVATION

PLAN - TEMPORARY SHORING-TS4A AT NE CORNER, BRIDGE FRA-70-1358A

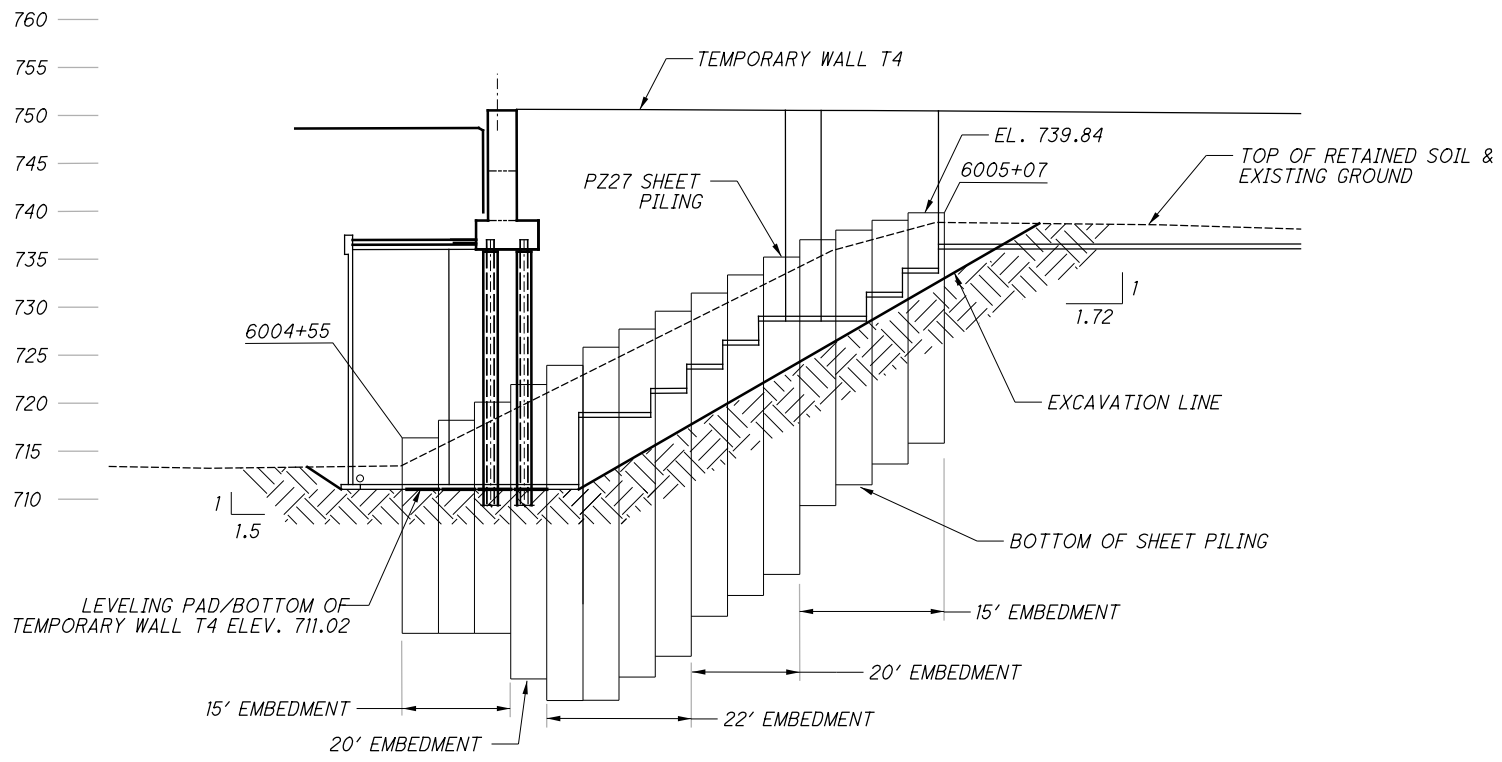

ELEVATION - TEMPORARY SHORING-TS4A AT NE CORNER, BRIDGE FRA-70-1358A

NOTES:

1. ITEM 503, COFFERDAMS AND EXCAVATION BRACING, AS PER PLAN: THE DESIGN SHOWN ON THE PLANS FOR TEMPORARY SUPPORT OF EXCAVATION IS ONE REPRESENTATIVE DESIGN THAT MAY BE USED TO CONSTRUCT THE PROJECT. THE CONTRACTOR MAY CONSTRUCT THE DESIGN SHOWN ON THE PLANS OR PREPARE AN ALTERNATE DESIGN TO SUPPORT THE SIDES OF EXCAVATIONS. IF CONSTRUCTING AN ALTERNATE DESIGN FOR TEMPORARY SUPPORT OF EXCAVATION, PREPARE AND PROVIDE PLANS IN ACCORDANCE WITH C&MS 501.05. THE DEPARTMENT WILL PAY FOR THE TEMPORARY SUPPORT OF EXCAVATION AT THE CONTRACT LUMP SUM PRIVE FOR COFFERDAMS AND EXCAVATION BRACING. NO ADDITIONAL PAYMENT WILL BE MADE FOR PROVIDING AN ALTERNATE DESIGN.

4

NO.	DESCRIPTION	REV. BY	DATE
4	NEW SHEET	WCB	11-18-2021

TEMPORARY SHORING SITE PLAN - TS4A

FRANKLIN COUNTY
 STA. 6004+16.68
 STA. 6005+47.90

RAMP C5/C6 OVER CSX & NORFOLK SOUTHERN RAILROADS

FRA-70-1358A
 PID No. 105523

1 / 1

890A
 1815

DESIGN AGENCY
DYNOTEC, INC.
 2331 E. DUBLIN-CRANVILLE RD. COLUMBUS, OH 43231
 614.880.7320 T • WWW.DYNOTEC.COM

FOR I-70 EB PLANS, SEE SHEETS 265 - 303
 FOR STRUCTURE PLANS, SEE SHEETS 1472 - 1507
 FOR RAMP C5 PLANS, SEE SHEETS 331 - 361
 FOR RETAINING WALL DETAILS, SEE SHEETS 831 - 834
 FOR RAMP C6 PLANS, SEE SHEETS 362 - 367
 FOR ESTIMATED QUANTITIES, SEE SHEETS 230 - 255





CALCULATED
 CHECKED

WATER WORK PLAN AND PROFILE

FRA-70/71-12.68 / 14.86

908
1815

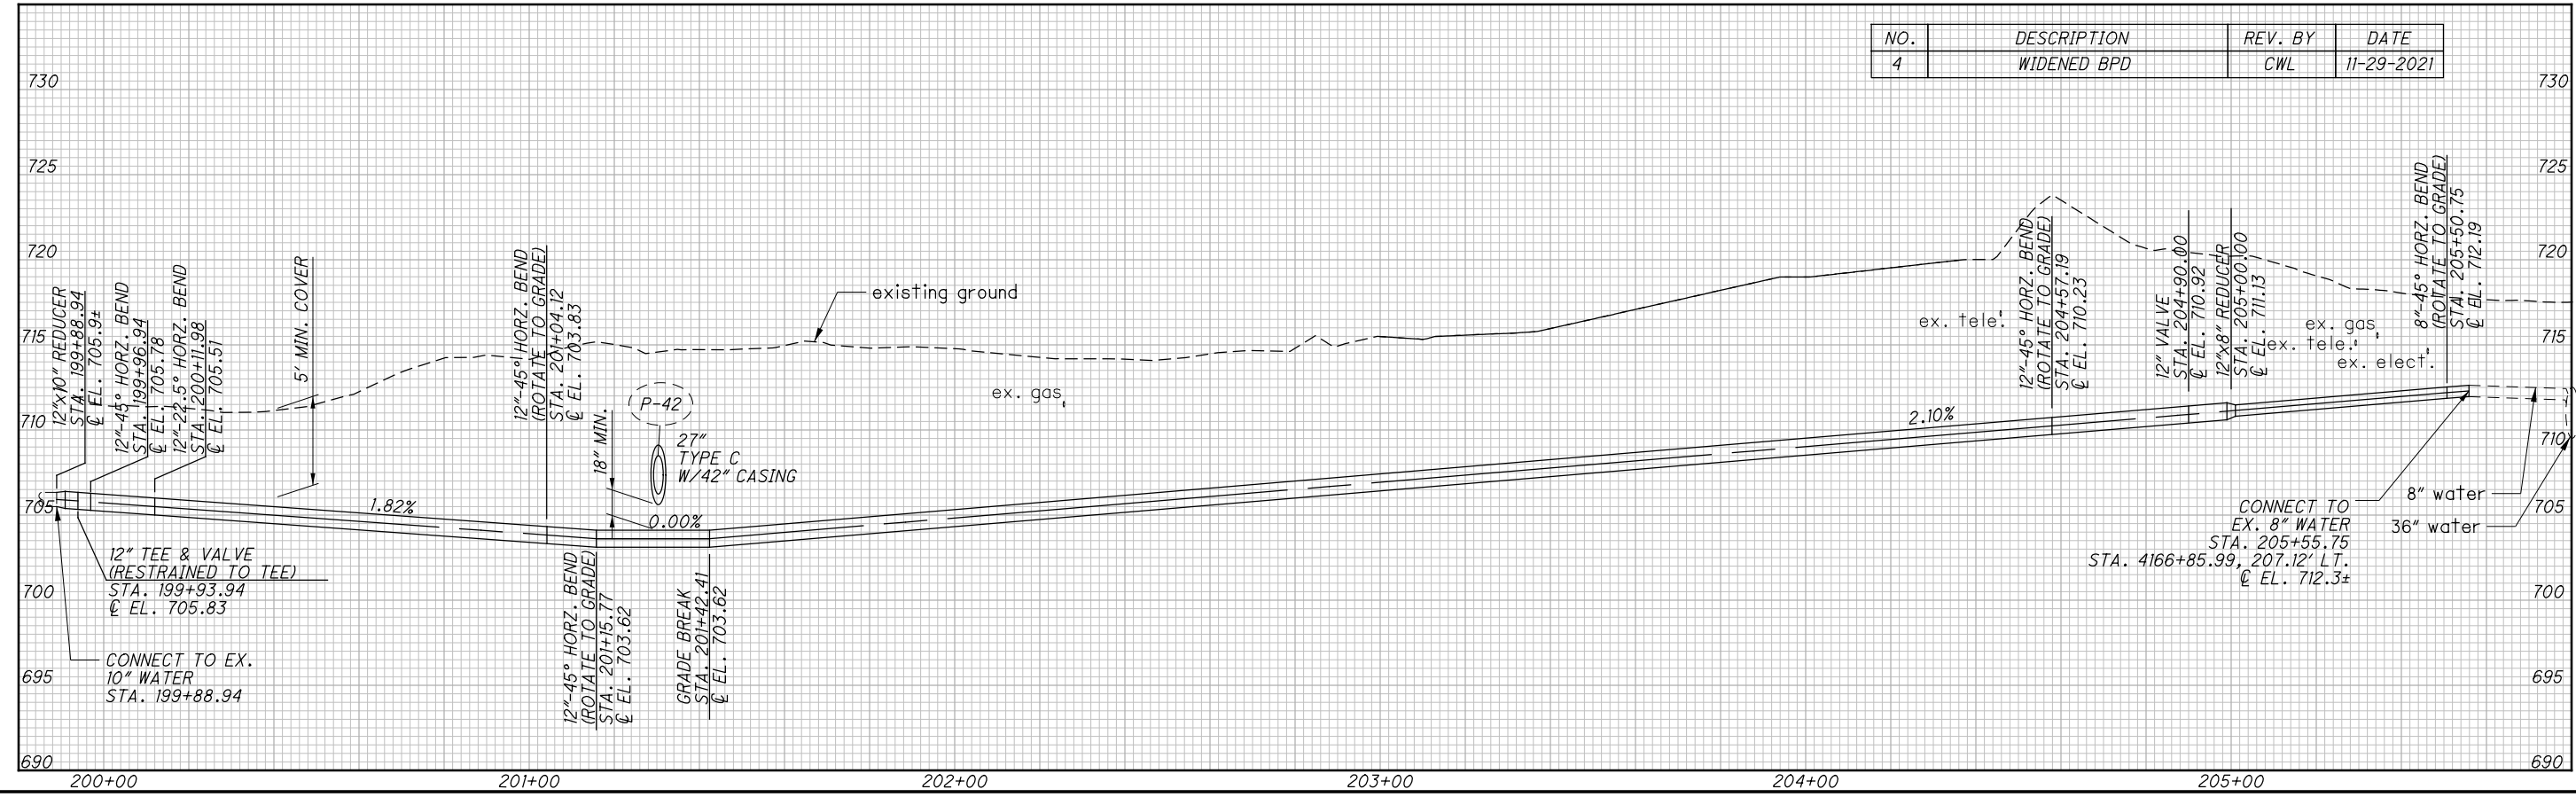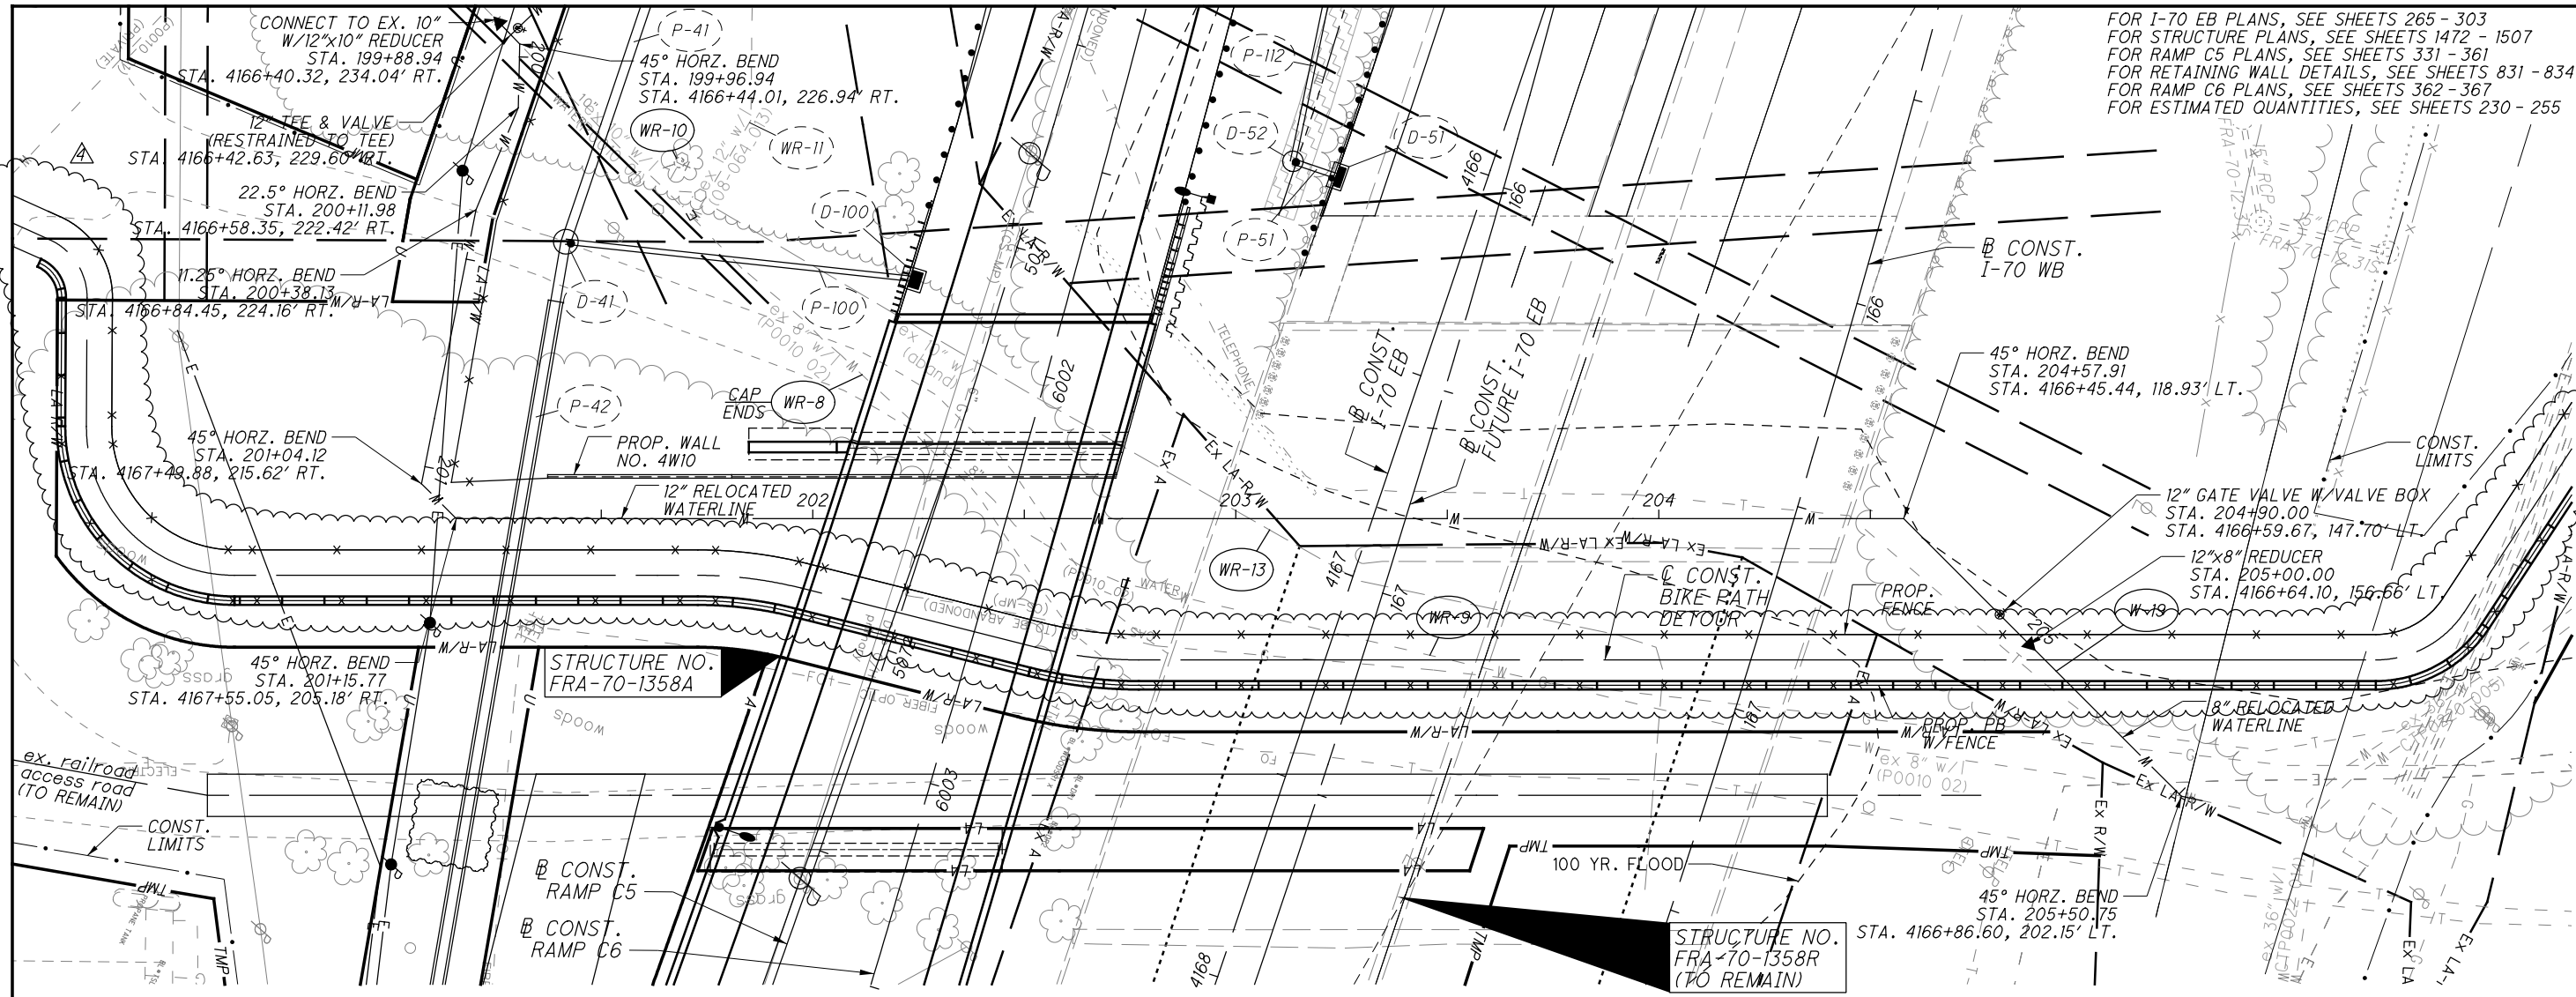

NO.	DESCRIPTION	REV. BY	DATE
4	WIDENED BPD	CWL	11-29-2021

01:201212012048 VFR110523\UTL\TIES\SHEETS\10523UPR04.DGN
 11/27/2021
 2:22:12 PM
 DDDTY81STD_USER

ITEM SPECIAL - 50'/2 WOOD POLE

THIS ITEM SHALL BE A 50'/2 WOOD POLE.

PAYMENT WILL BE MADE AT THE UNIT PRICE BID UNDER ITEM SPECIAL, "50'/2 WOOD POLE" FOR EACH POLE WHICH SHALL BE FULL COMPENSATION FOR ALL LABOR, MATERIALS AND INCIDENTALS REQUIRED TO COMPLETE THIS ITEM IN A SATISFACTORY WORKMANLIKE MANNER. SEE SHEETS 942-958 FOR DETAILS.

ITEM SPECIAL - THREE PHASE DEADEND ATTACHMENTS (TDMIS-406)

THIS ITEM SHALL BE THE THREE PHASE DEADEND ATTACHMENTS PER COLUMBUS DOP TDMIS-406.

PAYMENT SHALL BE MADE AT THE UNIT PRICE BID UNDER ITEM SPECIAL, "THREE PHASE DEADEND ATTACHMENTS (TDMIS-406)" FOR EACH ATTACHMENT SET WHICH SHALL BE FULL COMPENSATION FOR ALL LABOR, MATERIALS AND INCIDENTALS REQUIRED TO COMPLETE THIS ITEM IN A SATISFACTORY WORKMANLIKE MANNER. SEE SHEETS 942-958 FOR DETAILS.

ITEM SPECIAL - WOOD CROSSARM (TDMIS-10)

THIS ITEM SHALL BE A WOOD CROSSARM PER COLUMBUS DOP TDMIS-10.

PAYMENT SHALL BE MADE AT THE UNIT PRICE BID UNDER ITEM SPECIAL, "WOOD CROSSARM (TDMIS-10)" FOR EACH CROSSARM WHICH SHALL BE FULL COMPENSATION FOR ALL LABOR, MATERIALS AND INCIDENTALS REQUIRED TO COMPLETE THIS ITEM IN A SATISFACTORY WORKMANLIKE MANNER. SEE SHEETS 942-958 FOR DETAILS.

ITEM SPECIAL - PRIMARY DOWN GUY (TDMIS-100)

THIS ITEM SHALL BE A PRIMARY DOWN GUY PER COLUMBUS DOP TDMIS-100.

PAYMENT SHALL BE MADE AT THE UNIT PRICE BID UNDER ITEM SPECIAL, "PRIMARY DOWN GUY (TDMIS-100)" FOR EACH DOWN GUY WHICH SHALL BE FULL COMPENSATION FOR ALL LABOR, MATERIALS AND INCIDENTALS REQUIRED TO COMPLETE THIS ITEM IN A SATISFACTORY WORKMANLIKE MANNER. SEE SHEETS 942-958 FOR DETAILS.

ITEM SPECIAL - DISTRIBUTION POLE GROUND (TDMIS-7)

THIS ITEM SHALL BE A DISTRIBUTION POLE GROUND PER COLUMBUS DOP TDMIS-7.

PAYMENT SHALL BE MADE AT THE UNIT PRICE BID UNDER ITEM SPECIAL, "DISTRIBUTION POLE GROUND" FOR EACH POLE GROUND WHICH SHALL BE FULL COMPENSATION FOR ALL LABOR, MATERIALS AND INCIDENTALS REQUIRED TO COMPLETE THIS ITEM IN A SATISFACTORY WORKMANLIKE MANNER. SEE SHEETS 942-958 FOR DETAILS.

ITEM SPECIAL - DISTRIBUTION RISER (TDMIS-1001)

THIS ITEM SHALL BE A DISTRIBUTION RISER AND ALL NECESSARY APPURTENANCES PER COLUMBUS DOP TDMIS-1001.

PAYMENT SHALL BE MADE AT THE UNIT PRICE BID UNDER ITEM SPECIAL, "DISTRIBUTION RISER (TDMIS-1001)" FOR EACH RISER STRUCTURE WHICH SHALL BE FULL COMPENSATION FOR ALL LABOR, MATERIALS AND INCIDENTALS REQUIRED TO COMPLETE THIS ITEM IN A SATISFACTORY WORKMANLIKE MANNER. SEE SHEETS 942-958 FOR DETAILS.

ITEM SPECIAL - 6" SCH 40 PVC CONDUIT

THIS ITEM SHALL BE 6" SCHEDULE 40 PVC CONDUIT AND ALL NECESSARY APPURTENANCES FOR CONNECTIONS.

PAYMENT SHALL BE MADE AT THE UNIT PRICE BID UNDER ITEM SPECIAL, "6" SCH 40 PVC CONDUIT" FOR EACH LINEAR FOOT OF CONDUIT WHICH SHALL BE FULL COMPENSATION FOR ALL LABOR, MATERIALS AND INCIDENTALS REQUIRED TO COMPLETE THIS ITEM IN A SATISFACTORY WORKMANLIKE MANNER.

ITEM SPECIAL - DOP MANHOLE (TDMIS-1015)

THIS ITEM SHALL BE A DOP MANHOLE PER COLUMBUS DOP TDMIS-1015.

PAYMENT SHALL BE MADE AT THE UNIT PRICE BID UNDER ITEM SPECIAL, "DOP MANHOLE (TDMIS-1015)" FOR EACH MANHOLE WHICH SHALL BE FULL COMPENSATION FOR ALL LABOR, MATERIALS AND INCIDENTALS REQUIRED TO COMPLETE THIS ITEM IN A SATISFACTORY WORKMANLIKE MANNER. SEE SHEETS 942-958 FOR DETAILS.

ITEM SPECIAL - 30" DIRECTIONAL BORE AND PIPE, 748.06

THIS ITEM SHALL BE 30" DIRECTIONAL BORING AND PIPE, 748.06.

PAYMENT SHALL BE MADE AT THE UNIT PRICE BID UNDER ITEM SPECIAL, "30" DIRECTIONAL BORE AND PIPE, 748.06" FOR EACH LINEAR FOOT OF DIRECTIONAL BORING AND BORE PIPE WHICH SHALL BE FULL COMPENSATION FOR ALL LABOR, MATERIALS AND INCIDENTALS REQUIRED TO COMPLETE THIS ITEM IN A SATISFACTORY WORKMANLIKE MANNER.

ITEM SPECIAL - 4' x 4' x 4' PULLBOX (TDMIS-1012)

THIS ITEM SHALL BE A 4' x 4' x 4' PULLBOX PER COLUMBUS DOP TDMIS-1012.

PAYMENT SHALL BE MADE AT THE UNIT PRICE BID UNDER ITEM SPECIAL, "4' x 4' x 4' PULLBOX (TDMIS-1012)" FOR EACH PULLBOX WHICH SHALL BE FULL COMPENSATION FOR ALL LABOR, MATERIALS AND INCIDENTALS REQUIRED TO COMPLETE THIS ITEM IN A SATISFACTORY WORKMANLIKE MANNER. SEE SHEETS 942-958 FOR DETAILS.

ITEM SPECIAL - BRIDGE MOUNTED CONDUIT HANGER

THIS ITEM SHALL BE A BRIDGE MOUNTED CONDUIT SPACER AS SHOWN ON SHEET 1418

PAYMENT SHALL BE MADE AT THE UNIT PRICE BID UNDER ITEM SPECIAL, "BRIDGE MOUNTED CONDUIT SPACER" FOR EACH SPACER WHICH SHALL BE FULL COMPENSATION FOR ALL LABOR, MATERIALS AND INCIDENTALS REQUIRED TO COMPLETE THIS ITEM IN A SATISFACTORY WORKMANLIKE MANNER.

ITEM SPECIAL - 6" XHW FIBERGLASS CONDUIT

THIS ITEM SHALL BE 6" XHW FIBERGLASS CONDUIT.

PAYMENT SHALL BE MADE AT THE UNIT PRICE BID UNDER ITEM SPECIAL, "6" XHW FIBERGLASS CONDUIT" FOR EACH LINEAR FOOT OF CONDUIT WHICH SHALL BE FULL COMPENSATION FOR ALL LABOR, MATERIALS AND INCIDENTALS REQUIRED TO COMPLETE THIS ITEM IN A SATISFACTORY WORKMANLIKE MANNER.

ITEM SPECIAL - (3)-750kCMIL Cu, 15kv XLP INS. 133% w/ Cu TAPE SHIELD WITH (1)-350kCMIL Cu, 600V NEUTRAL

THIS ITEM SHALL BE (3)-750kCMIL Cu, 15kv XLP INS. 133% w/ Cu TAPE SHIELD WITH (1)-350kCMIL Cu, 600V NEUTRAL.

PAYMENT SHALL BE MADE AT THE UNIT PRICE BID UNDER ITEM SPECIAL, "750kCMIL Cu, 15kv XLP INS. 133% w/ Cu TAPE SHIELD" FOR EACH CIRCUIT FOOT OF CONDUCTOR WHICH SHALL BE FULL COMPENSATION FOR ALL LABOR, MATERIALS AND INCIDENTALS REQUIRED TO COMPLETE THIS ITEM IN A SATISFACTORY WORKMANLIKE MANNER.

ITEM SPECIAL - CABLE TRAY RISER

THIS ITEM SHALL BE A CABLE TRAY RISER SYSTEM.

PAYMENT SHALL BE MADE AT THE UNIT PRICE BID UNDER ITEM SPECIAL, "CABLE TRAY RISER SYSTEM" FOR ALL MATERIAL SHOWN ON SHEETS 923-924 WHICH SHALL BE FULL COMPENSATION FOR ALL LABOR, MATERIALS AND INCIDENTALS REQUIRED TO COMPLETE THIS ITEM IN A SATISFACTORY WORKMANLIKE MANNER.

ITEM SPECIAL - 22.5" SCH 40 PVC CONDUIT SWEEP

THIS ITEM SHALL BE A 22.5" SCH 40 PVC CONDUIT SWEEP.

PAYMENT SHALL BE MADE AT THE UNIT PRICE BID UNDER ITEM SPECIAL, "22.5" SCH 40 PVC CONDUIT SWEEP" FOR EACH SWEEP WHICH SHALL BE FULL COMPENSATION FOR ALL LABOR, MATERIALS AND INCIDENTALS REQUIRED TO COMPLETE THIS ITEM IN A SATISFACTORY WORKMANLIKE MANNER.

ITEM SPECIAL - FIBERGLASS TO PVC CONDUIT COUPLER

THIS ITEM SHALL BE A FIBERGLASS TO PVC CONDUIT COUPLER.

PAYMENT SHALL BE MADE AT THE UNIT PRICE BID UNDER ITEM SPECIAL, "FIBERGLASS TO PVC CONDUIT COUPLER" FOR EACH COUPLER WHICH SHALL BE FULL COMPENSATION FOR ALL LABOR, MATERIALS AND INCIDENTALS REQUIRED TO COMPLETE THIS ITEM IN A SATISFACTORY WORKMANLIKE MANNER.

ITEM SPECIAL - ADJUSTING EXISTING GRADE

THIS ITEM SHALL BE THE ADJUSTMENT OF THE EXISTING MANHOLE AND VAULT GRATE TO GRADE.

PAYMENT SHALL BE MADE AT THE UNIT PRICE BID UNDER ITEM SPECIAL, "ADJUSTING EXISTING GRADE" FOR EACH ADJUSTMENT WHICH SHALL BE FULL COMPENSATION FOR ALL LABOR, MATERIALS AND INCIDENTALS REQUIRED TO COMPLETE THIS ITEM IN A SATISFACTORY WORKMANLIKE MANNER.

ITEM SPECIAL - 5" XHW FIBERGLASS CONDUIT

THIS ITEM SHALL BE 5" XHW FIBERGLASS CONDUIT.

PAYMENT SHALL BE MADE AT THE UNIT PRICE BID UNDER ITEM SPECIAL, "5" XHW FIBERGLASS CONDUIT" FOR EACH LINEAR FOOT OF CONDUIT WHICH SHALL BE FULL COMPENSATION FOR ALL LABOR, MATERIALS AND INCIDENTALS REQUIRED TO COMPLETE THIS ITEM IN A SATISFACTORY WORKMANLIKE MANNER.

ITEM SPECIAL - (1)-250kCMIL Cu, 15kv XLP INS. 133% w/ Cu TAPE SHIELD WITH (1)-1/0 Cu, 600V NEUTRAL

THIS ITEM SHALL BE (1)-250kCMIL Cu, 15kv XLP INS. 133% w/ Cu TAPE SHIELD WITH (1)-1/0 Cu, 600V NEUTRAL.

PAYMENT SHALL BE MADE AT THE UNIT PRICE BID UNDER ITEM SPECIAL, "(1)-250kCMIL Cu, 15kv XLP INS. 133% w/ Cu TAPE SHIELD WITH (1)-1/0 Cu, 600V NEUTRAL" FOR EACH CIRCUIT FOOT OF CONDUCTOR WHICH SHALL BE FULL COMPENSATION FOR ALL LABOR, MATERIALS AND INCIDENTALS REQUIRED TO COMPLETE THIS ITEM IN A SATISFACTORY WORKMANLIKE MANNER.

ITEM SPECIAL - 5" SCH 40 PVC CONDUIT

THIS ITEM SHALL BE 5" SCHEDULE 40 PVC CONDUIT AND ALL NECESSARY APPURTENANCES FOR CONNECTIONS.

PAYMENT SHALL BE MADE AT THE UNIT PRICE BID UNDER ITEM SPECIAL, "5" SCH 40 PVC CONDUIT" FOR EACH LINEAR FOOT OF CONDUIT WHICH SHALL BE FULL COMPENSATION FOR ALL LABOR, MATERIALS AND INCIDENTALS REQUIRED TO COMPLETE THIS ITEM IN A SATISFACTORY WORKMANLIKE MANNER.

ITEM SPECIAL - 3 x 3 CONCRETE DUCT BANK (TDMIS-3000)

THIS ITEM SHALL BE A 3 x 3 CONCRETE DUCT BANK WITH 5" SCH 40 PVC CONDUIT PER COLUMBUS DOP TDMIS-3000.

PAYMENT SHALL BE MADE AT THE UNIT PRICE BID UNDER ITEM SPECIAL, "3x3 CONCRETE DUCT BANK (TDMIS-3000)" FOR EACH LINEAR FOOT OF CONCRETE DUCT BANK WHICH SHALL BE FULL COMPENSATION FOR ALL LABOR, MATERIALS AND INCIDENTALS REQUIRED TO COMPLETE THIS ITEM IN A SATISFACTORY WORKMANLIKE MANNER. SEE SHEETS 942-958 FOR DETAILS.

ITEM SPECIAL - 6" FIBERGLASS CONDUIT EXPANSION FITTINGS

THIS ITEM SHALL BE A 6" FIBERGLASS CONDUIT EXPANSION FITTING.

PAYMENT SHALL BE MADE AT THE UNIT PRICE BID UNDER ITEM SPECIAL, "6" FIBERGLASS CONDUIT EXPANSION FITTING" FOR EACH FITTING WHICH SHALL BE FULL COMPENSATION FOR ALL LABOR, MATERIALS AND INCIDENTALS REQUIRED TO COMPLETE THIS ITEM IN A SATISFACTORY WORKMANLIKE MANNER.

ITEM SPECIAL - 2 x 3 DUCT BANK - 6" PVC (TDMIS-3000)

THIS ITEM SHALL BE A 2 x 3 DUCT BANK WITH 6" SCH 40 PVC CONDUIT PER COLUMBUS DOP TDMIS-3000.

PAYMENT SHALL BE MADE AT THE UNIT PRICE BID UNDER ITEM SPECIAL, "2x3 BANK - 6" PVC (TDMIS-3000)" FOR EACH LINEAR FOOT OF DUCT BANK WHICH SHALL BE FULL COMPENSATION FOR ALL LABOR, MATERIALS AND INCIDENTALS REQUIRED TO COMPLETE THIS ITEM IN A SATISFACTORY WORKMANLIKE MANNER. SEE SHEETS 942-958 FOR DETAILS.

ITEM SPECIAL - (3)-350kCMIL Cu, 15kv XLP Ins. 133% w/ Cu TAPE SHIELD WITH (1)-4/0 Cu, 600V NEUTRAL

THIS ITEM SHALL BE (3)-350kCMIL Cu, 15kv XLP Ins. 133% w/ Cu TAPE SHIELD WITH (1)-4/0 Cu, 600V NEUTRAL.

PAYMENT SHALL BE MADE AT THE UNIT PRICE BID UNDER ITEM SPECIAL, "(3)-350kCMIL Cu, 15kv XLP Ins. 133% w/ Cu TAPE SHIELD WITH (1)-4/0 Cu, 600V NEUTRAL" FOR EACH CIRCUIT FOOT OF CONDUCTOR WHICH SHALL BE FULL COMPENSATION FOR ALL LABOR, MATERIALS AND INCIDENTALS REQUIRED TO COMPLETE THIS ITEM IN A SATISFACTORY WORKMANLIKE MANNER.

ITEM SPECIAL - EXISTING MANHOLE REMOVAL

THIS ITEM SHALL BE THE REMOVAL OF AN EXISTING MANHOLE.

PAYMENT SHALL BE MADE AT THE UNIT PRICE BID UNDER ITEM SPECIAL, "EXISTING MANHOLE REMOVAL" FOR EACH MANHOLE REMOVED WHICH SHALL BE FULL COMPENSATION FOR ALL LABOR, MATERIALS AND INCIDENTALS REQUIRED TO COMPLETE THIS ITEM IN A SATISFACTORY WORKMANLIKE MANNER.

ITEM SPECIAL - 5" FIBERGLASS 90° SWEEP

THIS ITEM SHALL BE A 5" FIBERGLASS 90° SWEEP.

PAYMENT SHALL BE MADE AT THE UNIT PRICE BID UNDER ITEM SPECIAL, "5" FIBERGLASS 90° SWEEP" FOR EACH SWEEP WHICH SHALL BE FULL COMPENSATION FOR ALL LABOR, MATERIALS AND INCIDENTALS REQUIRED TO COMPLETE THIS ITEM IN A SATISFACTORY WORKMANLIKE MANNER.

ITEM SPECIAL - (3)-#1 AL, 15kv XLP WITH (1)-#2 AL, 600V NEUTRAL

THIS ITEM SHALL BE (3)-#1 AL, 15kv XLP WITH (1)-#2 AL, 600V NEUTRAL.

PAYMENT SHALL BE MADE AT THE UNIT PRICE BID UNDER ITEM SPECIAL, "(3)-#1 15kv XLP WITH (1)-#2 AL, 600V NEUTRAL" FOR EACH CIRCUIT FOOT OF CONDUCTOR WHICH SHALL BE FULL COMPENSATION FOR ALL LABOR, MATERIALS AND INCIDENTALS REQUIRED TO COMPLETE THIS ITEM IN A SATISFACTORY WORKMANLIKE MANNER.

ITEM SPECIAL - 4" SCH 40 PVC CONDUIT

THIS ITEM SHALL BE 4" SCHEDULE 40 PVC CONDUIT AND ALL NECESSARY APPURTENANCES FOR CONNECTIONS.

PAYMENT SHALL BE MADE AT THE UNIT PRICE BID UNDER ITEM SPECIAL, "4" SCH 40 PVC CONDUIT" FOR EACH LINEAR FOOT OF CONDUIT WHICH SHALL BE FULL COMPENSATION FOR ALL LABOR, MATERIALS AND INCIDENTALS REQUIRED TO COMPLETE THIS ITEM IN A SATISFACTORY WORKMANLIKE MANNER.

NO.	DESCRIPTION	REV. BY	DATE
2	DOP TDMIS CHANGE	CWL	11-12-2021
4	UPDATED BORE SPACERS NOTE	CWL	11-29-2021

ITEM SPECIAL - 11.25" SCH 40 PVC CONDUIT SWEEP

THIS ITEM SHALL BE A 11.25" SCH 40 PVC CONDUIT SWEEP.

PAYMENT SHALL BE MADE AT THE UNIT PRICE BID UNDER ITEM SPECIAL, "11.25" SCH 40 PVC CONDUIT SWEEP" FOR EACH SWEEP WHICH SHALL BE FULL COMPENSATION FOR ALL LABOR, MATERIALS AND INCIDENTALS REQUIRED TO COMPLETE THIS ITEM IN A SATISFACTORY WORKMANLIKE MANNER.

ITEM SPECIAL - PADMOUNT TRANSFORMER RELOCATION

THIS ITEM SHALL BE THE RELOCATION OF AN EXISTING PADMOUNT TRANSFORMER, INCLUDING THE NEW FIBERGLASS BOXPAD SIZED PER TRANSFORMER SIZE AND INSTALLED PER MANUFACTURER RECOMMENDATION, GROUNDING, RE-ESTABLISHING ALL SECONDARY CONNECTIONS AND ALL BUSHING AND LOADBREAK ELBOW ACCESSORIES.

PAYMENT SHALL BE MADE AT THE UNIT PRICE BID UNDER ITEM SPECIAL, "PADMOUNT TRANSFORMER RELOCATION" FOR EACH PADMOUNT TRANSFORMER RELOCATED WHICH SHALL BE FULL COMPENSATION FOR ALL LABOR, MATERIALS AND INCIDENTALS REQUIRED TO COMPLETE THIS ITEM IN A SATISFACTORY WORKMANLIKE MANNER.

CASTING ALLOWABLE TOLERANCE ON CITY OF COLUMBUS STREETS - AS PER PLAN

FOR ALL MANHOLES, WATERVALVES, TRAFFIC AND INTERCONNECT PULL BOXES, ELECTRIC AND COMMUNICATION VAULTS, AND ANY OTHER UTILITY STRUCTURE IN THE ROADWAY OF CITY OF COLUMBUS STREETS AND ALLEYS WITHIN THE PAVING LIMITS OF THE PROJECT, THE MAXIMUM ALLOWABLE TOLERANCE IS MINUS 1/4 INCH BELOW THE FINISHED PAVEMENT SURFACE. THERE IS NO ALLOWABLE TOLERANCE ABOVE THE FINISHED PAVEMENT SURFACE. ALL PRIVATE UTILITY CASTINGS WILL BE ADJUSTED TO GRADE BY THE PRIVATE UTILITY COMPANY.

THE CONTRACTOR SHALL MAKE EVERY EFFORT TO INSTALL OR ADJUST CASTINGS TO BE WITHIN THIS TOLERANCE. IT IS ALSO THE RESPONSIBILITY OF THE CONTRACTOR TO NOTIFY THE ODOT PROJECT ENGINEER OF ANY CASTINGS THAT NEED TO BE ADJUSTED TO GRADE THAT WERE NOT PART OF THE PLAN QUANTITIES FOR NEW CONSTRUCTION OR ADJUSTMENT TO GRADE.

MEASUREMENT WILL BE BY PLACING A 10 FOOT STRAIGHTEDGE CENTERED OVER THE CENTER OF THE CASTING IN THE DIRECTION OF TRAFFIC, MEASURED TO VARIOUS POINTS ON THE TOP OF THE CASTING FRAME OF THE STRUCTURE. IF ANY MEASUREMENT EXCEEDS 1/4 INCH, THE CASTING WILL BE DEEMED OUT OF TOLERANCE AND ADJUSTED TO GRADE BY THE CONTRACTOR AT NO ADDITIONAL COST TO THE PROJECT.

THE ODOT PROJECT ENGINEER, ALONG WITH ATTENDANCE BY A REPRESENTATIVE OF THE CITY OF COLUMBUS, WILL CONDUCT THE MEASUREMENTS AFTER THE FINAL SURFACE COURSE IS PLACED.

TWO METHODS OF ADJUSTING CASTINGS TO GRADE WILL BE ACCEPTED:

- SAWCUT THE PAVEMENT AROUND THE CASTING STRUCTURE IN A SQUARE SHAPE. SAWCUT LINE MUST BE AT LEAST 1 FOOT OUTSIDE OF THE OUTER DIAMETER OF THE CASTING. REMOVE PAVEMENT FULL DEPTH AROUND THE CASTING IN ORDER TO COMPLETELY REMOVE THE CASTING STRUCTURE, HEAVY DUTY VALVE BOX, OR OTHER TYPE OF UTILITY STRUCTURE. REMOVE AND CLEAN THE EXISTING FRAME, ADJUST THE HEIGHT OF THE SUPPORTING WALLS, AND RESET THE EXISTING FRAME IN A BED OF CONCRETE MORTAR OR STRUCTURE CONCRETE TO THE NEW GRADE. PLACE CONCRETE PAVEMENT AROUND THE STRUCTURE, HOLDING THE CONCRETE 2 INCHES BELOW THE FINISHED PAVEMENT SURFACE. FOR PULLBOXES, MANHOLES AND CASTINGS GREATER THAN 30 INCHES, INCLUDE TWO #4 REBAR EVENLY SPACED ON ALL FOUR SIDES OF THE CASTING IN THE CONCRETE PAVEMENT. ONCE THE CONCRETE HAS PROPERLY CURED, PLACE TACK COAT AND SURFACE ASPHALT PAVEMENT NEATLY AROUND THE STRUCTURE AND SEAL THE JOINT WITH A HOT APPLIED JOINT SEALER PER CITY OF COLUMBUS CMSC ITEM 705.04.

2) SAWCUT THE PAVEMENT AROUND THE CASTING STRUCTURE WITH A LARGER CIRCULAR CUTTING SAW. SAWCUT LINE MUST BE AT LEAST 1 FOOT OUTSIDE OF THE OUTER DIAMETER OF THE CASTING. REMOVE PAVEMENT FULL DEPTH AROUND THE CASTING IN ORDER TO COMPLETELY REMOVE THE CASTING STRUCTURE, HEAVY DUTY VALVE BOX, OR OTHER TYPE OF UTILITY STRUCTURE. REMOVE AND CLEAN THE EXISTING FRAME, ADJUST THE HEIGHT OF THE SUPPORTING WALLS, AND RESET THE EXISTING FRAME IN A BED OF CONCRETE MORTAR OR STRUCTURE CONCRETE TO THE NEW GRADE. PLACE CONCRETE PAVEMENT AROUND THE STRUCTURE FULL DEPTH NEATLY AROUND THE STRUCTURE AND UP TO THE FINISHED GRADE. FOR PULLBOXES, MANHOLES AND CASTINGS GREATER THAN 30 INCHES, INCLUDE TWO CIRCULAR RINGS OF #4 REBAR EVENLY SPACED IN THE CONCRETE PAVEMENT. SEAL JOINT WITH A HOT APPLIED JOINT SEALER PER CITY OF COLUMBUS CMSC ITEM 705.04.

ALL CASTINGS BEING ADJUSTED TO GRADE WITH EITHER METHOD MUST BE PROPERLY COVERED WITH A STEEL PLATE DURING THE ADJUSTMENT WORK AND UNTIL THE CONCRETE MATERIAL USED IS PROPERLY CURED. FULL DEPTH IS DEFINED AS FROM THE TOP SURFACE OF THE SURFACE COURSE PAVEMENT TO THE BOTTOM OF THE PAVEMENT BASE MATERIAL. PRIVATE UTILITY COMPANY CASTINGS WILL BE ADJUSTED TO GRADE BY THE PRIVATE UTILITY, WITH NOTICE GIVEN BY THE ODOT PROJECT ENGINEER.

CITY DOP FURNACE STREET SUBSTATION SAFETY PROTOCOL AND REGULATIONS

FOR ALL WORK WITHIN THE CITY OF COLUMBUS DOP FURNACE STREET SUBSTATION, ALL NORMAL SAFETY PROTOCOL AND PRACTICES SHALL BE FOLLOWED FOR WORKING IN AN ENERGIZED SUBSTATION YARD. CITY DOP REQUIRES ALL CONTRACTORS TO TAKE A CITY CONTRACTOR SAFETY COURSE THAT IS ONLINE PRIOR TO PERFORMING ANY WORK.


ANY GROUND GRID THAT IS DISTURBED SHALL BE REPAIRED DURING CONSTRUCTION. FENCE SHALL BE IN PLACE THE ENTIRE DURATION OF CONSTRUCTION. ALL FENCE SHALL BE BONDED TO THE GRID. CONTRACTOR SHALL EXCAVATE WITH CARE AND CAUTION. SUBSTATION LIGHTING SHALL BE MAINTAINED. SUBSTATION ACCESS SHALL BE PROVIDED FOR CITY DOP FOR EMERGENCY CASES.

ALL LABOR, EQUIPMENT AND MATERIALS NECESSARY TO MEET THESE REQUIREMENTS SHALL BE CONSIDERED INCIDENTAL TO THE VARIOUS ELECTRICAL PAY ITEMS.


ITEM SPECIAL - DIRECTIONAL BORE SPACERS FOR 6" SCH 40 PVC

THIS ITEM SHALL BE DIRECTIONAL BORE SPACERS FOR 6" SCH 40 PVC PER THE DETAIL BELOW OR AS APPROVED EQUAL. CONTRACTOR SHALL USE A THERMAL GROUT AS RECOMMENDED BY THE BORE SPACER MANUFACTURER.

PAYMENT SHALL BE MADE AT THE UNIT PRICE BID UNDER ITEM SPECIAL, "DIRECTIONAL BORE SPACERS FOR 6" SCH 40 PVC" FOR EACH SPACER WHICH SHALL BE FULL COMPENSATION FOR ALL LABOR, MATERIALS AND INCIDENTALS REQUIRED INCLUDING ANY NECESSARY GROUT TO COMPLETE THIS ITEM IN A SATISFACTORY WORKMANLIKE MANNER.

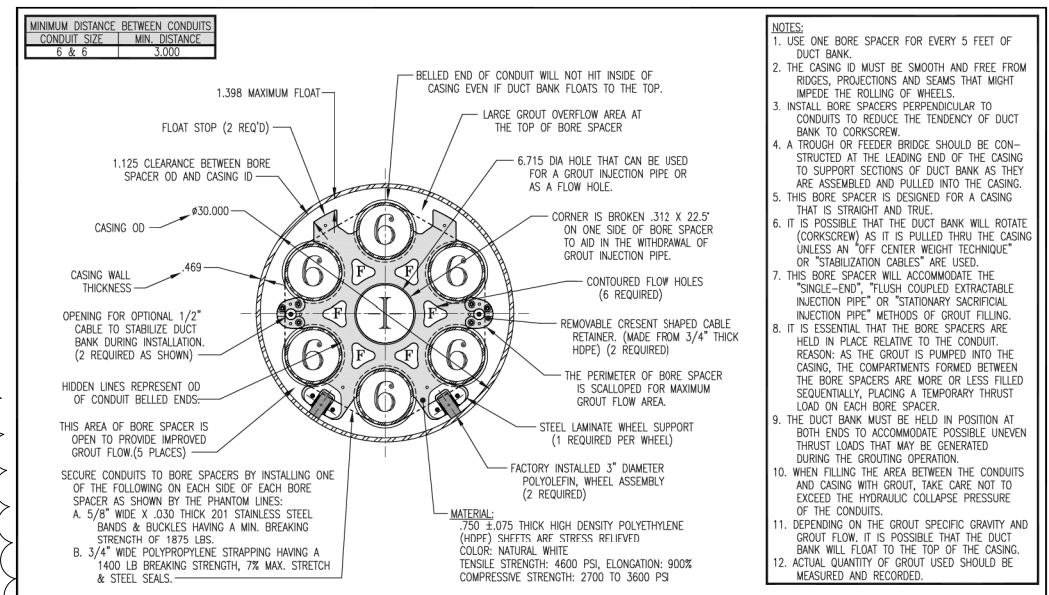

DIRECTIONAL BORE SPACERS DETAIL

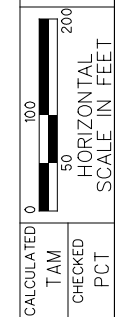

ELECTRICAL RELOCATION PAYMENT NOTES

FRA - 70 / 71 - 12.89 / 14.93

SHEET NUMBER										PARTICIPATION			ITEM	ITEM EXT.	GRAND TOTAL	UNIT	DESCRIPTION	SEE SHEET NO.
220	963		971	981	985	986	1049			01/NHS/PV	01/NHS/PV	05/NHS/OT/COL						
	550									242	308		621	00100	550	EACH	RPM	
	393									173	220		621	54000	393	EACH	RAISED PAVEMENT MARKER REMOVED	
						15				7	8		625	32000	15	EACH	GROUND ROD	
						4				2	2		625	32001	4	EACH	GROUND ROD, AS PER PLAN	959
240										106	134		626	00102	240	EACH	BARRIER REFLECTOR, TYPE 1, ONE-WAY	
135										59	76		626	00110	135	EACH	BARRIER REFLECTOR, TYPE 2, ONE-WAY	
					817.1					330.7	420.9	65.5	630	02100	817.1	FT	GROUND MOUNTED SUPPORT, NO. 2 POST	
					802.1					333.6	424.6	43.9	630	03100	802.1	FT	GROUND MOUNTED SUPPORT, NO. 3 POST	
					74.5					32.8	41.7		630	04101	74.5	FT	GROUND MOUNTED SUPPORT, NO. 4 POST, AS PER PLAN	959
					42.2					18.6	23.6		630	07600	42.2	FT	GROUND MOUNTED STRUCTURAL BEAM SUPPORT, W10X12	
					△ 53.0					23.3	29.7		630	08000	53.0	FT	GROUND MOUNTED STRUCTURAL BEAM SUPPORT, W12X30	
					86.6					38.1	48.5		630	08004	86.6	FT	ONE WAY SUPPORT, NO. 3 POST	
					4					2	2		630	08200	4	EACH	GROUND MOUNTED SUPPORT, PIPE	
					1					0	1		630	08501	1	EACH	STREET NAME SIGN SUPPORT, AS PER PLAN	959
					42					18	24		630	08600	42	EACH	SIGN POST REFLECTOR	
					△ 4					2	2		630	09000	4	EACH	BREAKAWAY STRUCTURAL BEAM CONNECTION	
					1					0	1		630	21000	1	EACH	OVERHEAD SIGN SUPPORT, TYPE TC-12.30, DESIGN 10	
					4					2	2		630	35500	4	EACH	OVERHEAD SIGN SUPPORT, TYPE TC-7.65, DESIGN 6	
					5					2	3		630	45500	5	EACH	OVERHEAD SIGN SUPPORT, TYPE TC-7.65, DESIGN 8	
					3					1	2		630	74500	3	EACH	OVERHEAD SIGN SUPPORT, MISC.: ANCHOR BOLT	959
					58					26	32		630	75000	58	EACH	SIGN ATTACHMENT ASSEMBLY	
					4					0	1	3	630	79001	4	EACH	SIGN HANGER ASSEMBLY, SPAN WIRE, AS PER PLAN	959
					17					7	8	2	630	79101	17	EACH	SIGN HANGER ASSEMBLY, MAST ARM, AS PER PLAN	959
					5					2	3		630	79500	5	EACH	SIGN SUPPORT ASSEMBLY, POLE MOUNTED	
					15					3	4	8	630	79501	15	EACH	SIGN SUPPORT ASSEMBLY, POLE MOUNTED, AS PER PLAN	959
					1184.9	268.3	△			603.8	768.5	80.9	630	80100	1453.2	SF	SIGN, FLAT SHEET	
					112.0	276.0				170.7	217.3		630	80200	388.0	SF	SIGN, GROUND MOUNTED EXTRUSHEET	
					6729.0					2960.8	3769.2		630	80224	8729.0	SF	SIGN, OVERHEAD EXTRUSHEET	
					9					1	1	7	630	80500	9	EACH	SIGN, DOUBLE FACED, STREET NAME	
					5					2	3		630	81020	5	EACH	CONCRETE MEDIAN BARRIER SIGN BRACKET	
					8					4	4		630	84000	8	EACH	CONCRETE BARRIER MEDIAN OVERHEAD SIGN SUPPORT FOUNDATION, TC-21.40	
					2					1	1		630	84010	2	EACH	CONCRETE BARRIER MEDIAN OVERHEAD SIGN SUPPORT FOUNDATION, TC-21.50	
					△ 4					2	2		630	84500	4	EACH	GROUND MOUNTED STRUCTURAL BEAM SUPPORT FOUNDATION	
					19					8	11		630	84510	19	EACH	RIGID OVERHEAD SIGN SUPPORT FOUNDATION	
					4					2	2		630	84600	4	EACH	GROUND MOUNTED PIPE SUPPORT FOUNDATION	
					120					48	61	11	630	84900	120	EACH	REMOVAL OF GROUND MOUNTED SIGN AND DISPOSAL	
					2					0	1	1	630	85100	2	EACH	REMOVAL OF GROUND MOUNTED SIGN AND REERECTION	
					10					4	6		630	85400	10	EACH	REMOVAL OF GROUND MOUNTED MAJOR SIGN AND DISPOSAL	
					121					49	62	10	630	86002	121	EACH	REMOVAL OF GROUND MOUNTED POST SUPPORT AND DISPOSAL	
					15					7	8		630	86102	15	EACH	REMOVAL OF GROUND MOUNTED STRUCTURAL BEAM SUPPORT AND DISPOSAL	
					2					1	1		630	86272	2	EACH	REMOVAL OF GROUND MOUNTED PIPE SUPPORT AND DISPOSAL	
					3					1	2		630	87100	3	EACH	REMOVAL OF OVERHEAD MOUNTED SIGN AND REERECTION	
					94					39	50	5	630	87400	94	EACH	REMOVAL OF OVERHEAD MOUNTED SIGN AND DISPOSAL	
					66					23	30	13	630	87500	66	EACH	REMOVAL OF POLE MOUNTED SIGN AND DISPOSAL	
					6					3	3		630	89702	6	EACH	REMOVAL OF OVERHEAD SIGN SUPPORT AND DISPOSAL	
					8					4	4		630	89902	8	EACH	REMOVAL OF MISCELLANEOUS TRAFFIC CONTROL ITEM: REBOUNDABLE LONGITUDINAL CHANNELIZER TRAFFIC POST	959
							LS				1		630	95000	LS		SIGNING, MISC.: BIKE DETOUR ROUTE	1049
					1					0	1		631	94490	1	EACH	REMOVAL, MISC.: REMOVAL OF SIGN FLASHER ASSEMBLY	959
					86					38	48		644	00601	86	FT	CROSSWALK LINE, AS PER PLAN	959A
					529					233	296		644	00720	529	FT	CHEVRON MARKING	
					327					101	128	98	644	01200	327	FT	PARKING LOT STALL MARKING	
					19					8	11		644	01300	19	FT	LANE ARROW	
					3					1	2		644	01400	3	EACH	WORD ON PAVEMENT, 72"	

NO.	DESCRIPTION	REV. BY	DATE	NO.	DESCRIPTION	REV. BY	DATE
1	ADDED BEAM SIGN	AKF	10/22/21	4	FUNDING CODE CHANGE	CWL	11/29/21

SHEET NUMBER											PARTICIPATION			ITEM	ITEM EXT.	GRAND TOTAL	UNIT	DESCRIPTION	SEE SHEET NO.
964	959A	965	971	975	01/NHS/P V	01/NHS/P V	05/NHS/ OT/COL												
			6		1	1	4	644	01630	6	EACH	BIKE LANE SYMBOL MARKING							
			10		4	6		644	19000	10	EACH	SHARED LANE MARKING							
		435			191	244		644	30000	435	FT	REMOVAL OF PAVEMENT MARKING							
		15			7	8		644	30020	15	EACH	REMOVAL OF PAVEMENT MARKING							
		0.14			0.06	0.08		644	30030	0.14	MILE	REMOVAL OF PAVEMENT MARKING							
			199		88	111		644	50300	199	FT	PAVEMENT MARKING, MISC.: BIKE LANE DOTTED LINE, 5"	959A						
			344		151	193		644	50300	344	FT	PAVEMENT MARKING, MISC.: DOTTED LINE, 5"	959A						
			855		376	479		644	50300	855	FT	PAVEMENT MARKING, MISC.: CHANNELIZING LINE, 10"	959A						
			259		107	136	16	644	50300	259	FT	PAVEMENT MARKING, MISC.: STOP LINE, 20"	959A						
			522		220	279	23	644	50300	522	FT	PAVEMENT MARKING, MISC.: TRANSVERSE / DIAGONAL LINE, 20"	959A						
	150						150	644	50300	150	FT	PAVEMENT MARKING, MISC.: SEPARATOR CURB ASSEMBLY	959A						
			0.48		0.11	0.15	0.22	644	50400	0.48	MILE	PAVEMENT MARKING, MISC.: EDGE LINE, 5"	959A						
			0.34		0.15	0.19		644	50400	0.34	MILE	PAVEMENT MARKING, MISC.: LANE LINE, 5"	959A						
			0.22		0.07	0.08	0.07	644	50400	0.22	MILE	PAVEMENT MARKING, MISC.: CENTER LINE, 5"	959A						
				0.04	0.01	0.01	0.02	645	90000	0.04	MILE	PAVEMENT MARKING, MISC.: EDGE LINE, 5", TYPE A1	959A						
				0.02	0.01	0.01		645	90000	0.02	MILE	PAVEMENT MARKING, MISC.: LANE LINE, 5", TYPE A1	959A						
				0.05	0.02	0.02	0.01	645	90000	0.05	MILE	PAVEMENT MARKING, MISC.: CENTER LINE, 5", TYPE A1	959A						
				231	102	129		645	98000	231	FT	PAVEMENT MARKING, MISC.: CHANNELIZING LINE, 10", TYPE A1	959A						
				94	41	53		645	98000	94	FT	PAVEMENT MARKING, MISC.: DOTTED LINE, 5", TYPE A1	959A						
				62	27	35		646	10400	62	FT	STOP LINE							
				238	105	133		646	10620	238	FT	CHEVRON MARKING							
				28	12	16		646	20300	28	EACH	LANE ARROW							
				5	2	3		647	20610	5	EACH	LANE ARROW, TYPE B90							
				1	0	1		647	20710	1	EACH	WORD ON PAVEMENT, 72", TYPE B90							
				3	0	1	2	647	20910	3	EACH	BIKE LANE SYMBOL MARKING, TYPE B90							
				2	1	1		647	20940	2	EACH	SHARED LANE MARKING, TYPE B90							
				1	0	1		647	50100	1	EACH	PAVEMENT MARKING MISC.: BIKE BOX, TYPE B90	959A						
				76	20	26	30	647	50120	76	FT	PAVEMENT MARKING, MISC.: STOP LINE, 20", TYPE B90	959A						
				24	11	13		647	50120	24	FT	PAVEMENT MARKING, MISC.: TRANSVERSE / DIAGONAL LINE, 20", TYPE B90	959A						
				633	209	267	157	647	50120	633	FT	PAVEMENT MARKING, MISC.: CROSSWALK LINE, 10", TYPE B90	959A						
				50	22	28		647	50120	50	FT	PAVEMENT MARKING, MISC.: DOTTED LINE, 5", TYPE B90	959A						
				568	250	318		647	60020	568	SF	GREEN COLORED PAVEMENT FOR BIKES, TYPE B90							
	77				24	30	23	SPECIAL	690E98000	77	EACH	PARKING METER POST REMOVAL	959A						
	19				2	3	14	SPECIAL	690E98000	19	EACH	PARKING METER POST CORE AND PARKING METER POST	959A						
	19				2	3	14	SPECIAL	690E98000	19	EACH	PARKING METER POST AND INSTALLATION	959A						
				7.98	3.51	4.47		807	14010	7.98	MILE	WET REFLECTIVE THERMOPLASTIC PAVEMENT MARKING, EDGE LINE, 6"							
				6.13	2.70	3.43		807	14110	6.13	MILE	WET REFLECTIVE THERMOPLASTIC PAVEMENT MARKING, LANE LINE, 6"							
				0.19	0.08	0.11		807	14200	0.19	MILE	WET REFLECTIVE THERMOPLASTIC PAVEMENT MARKING, CENTER LINE							
				12672	5576	7096		807	14310	12672	FT	WET REFLECTIVE THERMOPLASTIC PAVEMENT MARKING, CHANNELIZING LINE, 12"							
				8157	3589	4568		807	14410	8157	FT	WET REFLECTIVE THERMOPLASTIC PAVEMENT MARKING, DOTTED LINE, 6"							
				1.39	0.61	0.78		807	12010	1.39	MILE	WET REFLECTIVE EPOXY PAVEMENT MARKING, EDGE LINE, 6"							
				0.48	0.21	0.27		807	12110	0.48	MILE	WET REFLECTIVE EPOXY PAVEMENT MARKING, LANE LINE, 6"							
				4233	1863	2370		807	12310	4233	FT	WET REFLECTIVE EPOXY PAVEMENT MARKING, CHANNELIZING LINE, 12"							
				14.30	6.29	8.01		850	10010	14.30	MILE	GROOVING FOR 6" RECESSED PAVEMENT MARKING, (ASPHALT)							
				8157	3589	4568		850	10110	8157	FT	GROOVING FOR 6" RECESSED PAVEMENT MARKING, (ASPHALT)							
				12672	5576	7096		850	10130	12672	FT	GROOVING FOR 12" RECESSED PAVEMENT MARKING, (ASPHALT)							
				1.87	0.82	1.05		850	20010	1.87	MILE	GROOVING FOR 6" RECESSED PAVEMENT MARKING, (CONCRETE)							
				4233	1863	2370		850	20130	4233	FT	GROOVING FOR 12" RECESSED PAVEMENT MARKING, (CONCRETE)							

NO.	DESCRIPTION	REV. BY	DATE
4	FUNDING CODE CHANGE	CWL	11/29/21

D:\2012\20120418\FRA\105923\TRAFFIC\SHEETS\105923T002.DGN
11/21/2021
12:35:44 PM
DDOTV81STD_USER

SHEET NUMBER															PART.	ITEM	ITEM	GRAND	UNIT	DESCRIPTION	SEE SHEET NO.	
1125	1126	1127	1128	1129	1130	1131	1132	1133	1134	1135	1136	1137	1138	1139	01/NHS/EX	Δ	EXT	TOTAL				
				94									168		262	625	25502	262	FT	CONDUIT, 3", 725.05		
				1328	2280	3912	2224			2190	2192	2404			16530	625	25752	16530	FT	CONDUIT, 4" MULTICELL, 725.20, AS PER PLAN		
	34		12												12	625	25900	12	FT	CONDUIT, JACKED OR DRILLED, 2", 725.04	1091	
				94											34	625	25900	34	FT	CONDUIT, JACKED OR DRILLED, 3", 725.04		
				1	2	3				1	1	2			178	625	29100	178	FT	TRENCH, 36" DEEP		
				1											10	625	29931	10	EACH	MEDIAN JUNCTION BOX, AS PER PLAN	1092	
					4	1	3			2	3	2			15	625	31600	15	EACH	PULL BOX, MISC.: 32" ROUND CONCRETE (725.08)	1083,1084	
				1		2						1			4	625	31600	4	EACH	PULL BOX, MISC.: 48" ROUND CONCRETE (725.08), TYPE 1, AS PER PLAN	1083,1084	
	1	4	5	3											13	625	32000	13	EACH	GROUND ROD		
				1											1	625	34000	1	EACH	POWER SERVICE		
	416	1487	692										244		2839	632	29901	2839	FT	MESSENGER WIRE, 7 STRAND, 1/4" DIAMETER WITH ACCESSORIES, AS PER PLAN	1091	
	2	2	3												7	632	62820	7	EACH	INTERCONNECT, MISC.: MODIFIED CONDUIT RISER	1123	
															1	632	62820	1	EACH	INTERCONNECT, MISC.: FIBER OPTIC SPLICE ENCLOSURE, CLAMSHELL, 288 SPLICE	1092	
1						2									3	632	62820	3	EACH	INTERCONNECT, MISC.: FIBER OPTIC SPLICE ENCLOSURE, DOME, 800 SPLICE	1092	
				109											109	632	68300	109	FT	POWER CABLE, 3 CONDUCTOR, NO. 6 AWG		
	1	4	5												10	632	89300	10	EACH	WOOD POLE		
	1	2	4												7	632	89400	7	EACH	DOWN GUY		
892			227										700		1819	804	15010	1819	FT	FIBER OPTIC CABLE, 24 FIBER		
840	1105	2292	1906										1910	1957	10010	804	15040	10010	FT	FIBER OPTIC CABLE, 144 FIBER		
				898	1410	3007	1322	2594	801	2555	2617	3479	1963		20646	804	15050	20646	FT	FIBER OPTIC CABLE, 288 FIBER		
			356	21					17						847	804	32060	847	FT	DROP CABLE, 24 FIBER		
				1					1						2	804	37000	2	EACH	SPLICE ENCLOSURE, BUTT STYLE		
				948	1605	1248	1322	2594	669						8386	804	98000	8386	FT	FIBER OPTIC CABLE, MISC.: 96 FIBER, AS PER PLAN	1091	
661	1105	1261	553												3580	804	98000	3580	FT	FIBER OPTIC CABLE, MISC.: 432 FIBER, AS PER PLAN	1091	
				1											1	809	60030	1	EACH	CCTV IP-CAMERA SYSTEM, ENHANCED		
				1											1	809	61002	1	EACH	CCTV CONCRETE POLE, 70 FEET		
				1											1	809	65000	1	EACH	ITS CABINET - GROUND MOUNTED		
				1											1	809	68900	1	EACH	SIDE-FIRED RADAR DETECTOR		

ITS GENERAL SUMMARY

FRA-70/71-12.68 / 14.86

NO.	DESCRIPTION	REV. BY	DATE
4	FUNDING SPLIT CHANGE	JML	11-26-2021

1122
1815

Project Files\GPD\Project 4R\Cadd\Sheets\05526s01.c\boxed.dgn
11/22/2021 8:20:46 AM
Latham, JY

Z:\2013\proj\13-003-06\ODOT\FRA-70-13-4A.GPD\CAD\Projects\FRA\105523\lighting\105523\G001.dgn 22-NOV-2021 10:34AM Jordan.Steele

SHEET NUM.									PART.					ITEM	ITEM EXT	GRAND TOTAL	UNIT	DESCRIPTION	SEE SHEET NO.
1165	1166	1167	1168	1169	1170	1171	1172	1202	01/NHS/PV	01/NHS/PV	04/MPO/OT	05/NHS/OT/COL	06/ENH/OT/COL						
12		26	24	27					39	50				625	00450	89	EACH	CONNECTION, FUSED PULL APART	
3			6	3					5	7				625	00470	12	EACH	CONNECTION, UNFUSED BOLTED	
12		21	3	6	15				18	24	15			625	00480	57	EACH	CONNECTION, UNFUSED PERMANENT	
			1							1				625	10490	1	EACH	LIGHT POLE, CONVENTIONAL, DESIGN AT15B40	
3			4						3	4				625	10490	7	EACH	LIGHT POLE, CONVENTIONAL, DESIGN AT18B40	
		3							1	2				625	10490	3	EACH	LIGHT POLE, CONVENTIONAL, DESIGN ST10B40	
		4							2	2				625	10490	4	EACH	LIGHT POLE, CONVENTIONAL, DESIGN ST12B40	
			1							1				625	10490	1	EACH	LIGHT POLE, CONVENTIONAL, DESIGN ST15B40	
			2	9					5	6				625	10490	11	EACH	LIGHT POLE, CONVENTIONAL, DESIGN A12B40	
1										1				625	10490	1	EACH	LIGHT POLE, CONVENTIONAL, DESIGN A18B40	
					3				1	2				625	10494	3	EACH	LIGHT POLE, LOW MAST, DESIGN ALM40	
2									1	1				625	10494	2	EACH	LIGHT POLE, LOW MAST, DESIGN ALM50	
			4						2	2				625	10494	4	EACH	LIGHT POLE, LOW MAST, DESIGN ATLM50	
4		28	12	48					40	52				625	10614	92	EACH	LIGHT POLE ANCHOR BOLTS ON STRUCTURE	
		2							1	1				625	13200	2	EACH	LIGHT TOWER, BBBB100	
1										1				625	13210	1	EACH	LIGHT TOWER, BBBB130	
									4	4				625	14100	8	EACH	LIGHT POLE FOUNDATION, 24" X 8' DEEP	
3			5						2	2				625	14200	4	EACH	LIGHT POLE FOUNDATION, 24" X 10' DEEP	
			4						1	1				625	14306	2	EACH	MEDIAN LIGHT POLE FOUNDATION, 10' DEEP	
2									1	2				625	15300	3	EACH	LIGHT TOWER FOUNDATION, 36" X 30' DEEP	
1		2								1				625	15500	1	EACH	LIGHT TOWER FOUNDATION, 42" X 30' DEEP	
					1,650				726	924				625	22900	1,650	FT	NO. 1/0 AWG 2400 VOLT DISTRIBUTION CABLE	
1,766		8,010	7,437	12,066	1,761				12,542	15,963	2,535			625	23200	31,040	FT	NO. 4 AWG 2400 VOLT DISTRIBUTION CABLE	
996		1,074	1,938	1,764					2,540	3,232				625	23400	5,772	FT	NO. 10 AWG POLE AND BRACKET CABLE	
101									44	57				625	24100	101	FT	1-1/2" DUCT CABLE WITH TWO NO. 4 AWG 2400 VOLT CABLES	
3,183		1,172	947						2,333	2,969				625	24320	5,302	FT	1-1/2" DUCT CABLE WITH THREE NO. 4 AWG 2400 VOLT CABLES	
									2,110	2,685				625	25400	4,795	FT	CONDUIT, 2", 725.04	
131		1,251	547	2,843	23				787	1,002	785			625	25500	2,574	FT	CONDUIT, 3", 725.04	
161		280	546	802	785				31	40				625	25900	71	FT	CONDUIT, JACKED OR DRILLED, 3"	
71						847	2,065		1,281	1,631				625	25910	2,912	FT	CONDUIT CLEANED AND CABLES REMOVED	
									11	13				625	26253	24	EACH	LUMINAIRE, CONVENTIONAL, SOLID STATE (LED), AS PER PLAN, 133W, TYPE II	1163
4		7	8	9					2	2				625	26253	4	EACH	LUMINAIRE, CONVENTIONAL, SOLID STATE (LED), AS PER PLAN, 133W, TYPE III	1163
12		20							14	18				625	26263	32	EACH	LUMINAIRE, HIGH MAST, SOLID STATE (LED), AS PER PLAN, 209W, TYPE V	1163
									2	2				625	26273	4	EACH	LUMINAIRE, LOW MAST, SOLID STATE (LED), AS PER PLAN, 209W, TYPE III	1163
2									2	3				625	26273	5	EACH	LUMINAIRE, LOW MAST, SOLID STATE (LED), AS PER PLAN, 209W, TYPE V	1163
					44				19	25				625	27503	44	EACH	LUMINAIRE, UNDERPASS, SOLID STATE (LED), AS PER PLAN, 67W	1163
									3	3				625	27503	6	EACH	LUMINAIRE, UNDERPASS, SOLID STATE (LED), AS PER PLAN, 45W	1163
		3	3						74	95				625	27504	169	EACH	LUMINAIRE, TUNNEL, SOLID STATE (LED), 240W	1163
											16			625	27551	16	EACH	LUMINAIRE, DECORATIVE, AS PER PLAN, RECESSED WALL LIGHT 9W	1193
											5			625	27551	5	EACH	LUMINAIRE, DECORATIVE, AS PER PLAN, LED TAPE LIGHT, 3W	1193
											5			625	27551	5	EACH	LUMINAIRE, DECORATIVE, AS PER PLAN, LINEAR LED, 6W	1193
2,945		1,436	1,493	612	631				2,864	3,645	608			625	29000	7,117	FT	TRENCH	
									1	1				625	29910	2	EACH	TRANSITION JUNCTION BOX	
2		8	6	13	3				13	16	3			625	29920	32	EACH	STRUCTURE JUNCTION BOX	
1									2	2				625	29930	4	EACH	MEDIAN JUNCTION BOX	
									1	1				625	29940	2	EACH	BARRIER JUNCTION BOX	
5		3	3	2	2				5	7	3			625	30700	15	EACH	PULL BOX, 725.08, 18"	
		2			2				2	3				625	30706	5	EACH	PULL BOX, 725.08, 24"	
						6	4		4	6				625	31510	10	EACH	PULL BOX REMOVED	
									15	18				625	32000	33	EACH	GROUND ROD	
									3	4				625	33000	7	EACH	STRUCTURE GROUNDING SYSTEM	
									2	3				625	34001	5	EACH	POWER SERVICE, AS PER PLAN	1163
										1				625	35020	1	EACH	RE-ERECT EXISTING LIGHT TOWER	
														625	36010	7,117	FT	UNDERGROUND WARNING/MARKING TAPE	
		2,945	1,436	1,493	612	631			2	3				625	37101	5	EACH	SERVICE TO UNDERPASS LIGHTING, AS PER PLAN	1163
									4	6				625	39520	10	EACH	PULL BOX CLEANED	
									LS	LS				SPECIAL	62540000	LS		MAINTAIN EXISTING LIGHTING	1163
									1	1				625	75350	2	EACH	LIGHT TOWER REMOVED	

LIGHTING GENERAL SUMMARY

FRA-70/71-12.68 / 14.86

1164
1815

Z:\2013\proj\13-003-06 ODOT FRA-70-13 -4A GPD\CAD\Projects\FRA\105523\lighting\sheets\105523.G002.dgn 22-NOV-2021 10:34AM Jordan.Steele

SHEET NUM.									PART.					ITEM	ITEM EXT	GRAND TOTAL	UNIT	DESCRIPTION	SEE SHEET NO.	CALCULATED	JCS	CHECKED	LH	
1165	1166	1167	1168	1169	1170	1171	1172	1202	01/NHS/PV	01/NHS/PV	04/MPO/OT	05/NHS/OT/COL	06/ENH/OT/COL											
						1									625	75361	1	EACH	LIGHT TOWER REMOVED FOR STORAGE, AS PER PLAN	1175				
						8	8								625	75400	16	EACH	LIGHT POLE REMOVED					
						8	8								625	75500	16	EACH	LIGHT POLE FOUNDATION REMOVED					
						44	11								625	75506	55	EACH	LUMINAIRE REMOVED					
						1	1								625	75510	2	EACH	POWER SERVICE REMOVED					
							3								625	75521	3	EACH	LUMINAIRE SUPPORT REMOVED, AS PER PLAN	1180				
						3									625	75540	3	EACH	LIGHT TOWER FOUNDATION REMOVED					
						2,842									625	75550	2,842	FT	DISTRIBUTION CABLE REMOVED					
						19	12								625	75801	31	EACH	DISCONNECT CIRCUIT, AS PER PLAN	1163				
	2														625	98000	2	EACH	LIGHTING, MISC.: REFURBISH EXISTING LIGHT TOWER	1163				
					3										625	98000	3	EACH	LIGHTING, MISC.: SERVICE TO DECORATIVE LIGHTING	1163				
					1										625	98000	1	EACH	LIGHTING, MISC.: SERVICE TO TUNNEL LIGHTING	1196				
						220									625	98100	220	FT	LIGHTING, MISC.: CONDUIT REMOVED	1163				
																			CITY OF COLUMBUS PAY ITEMS					
								6							625	98000	6	EACH	LIGHTING, MISC.: UNDERPASS LUMINAIRE, 39W	1202				
								1							625	98000	1	EACH	LIGHTING, MISC.: MIS-56: RISER, STREET LIGHT CIRCUIT, AS PER PLAN	1202				
								2							625	98000	2	EACH	LIGHTING, MISC.: MIS-57: 100 AMP METER, SELF-CONTAINED WITH METER SOCKET	1202				
								7							625	98000	7	EACH	LIGHTING, MISC.: MIS-104: BRACKET ASSEMBLY, TRAFFIC/LIGHT COMB. POLE, DOWNTOWN	1202				
								7					2	5	625	98000	7	EACH	LIGHTING, MISC.: MIS-203: STREET LIGHT FOUNDATION, 6', DOWNTOWN	1202				
								7					2	5	625	98000	7	EACH	LIGHTING, MISC.: MIS-308: POLE, DOWNTOWN	1202				
								14					3	11	625	98000	14	EACH	LIGHTING, MISC.: MIS-501: POLE TO BE WIRED, 3 WIRE	1202				
								9	7				2		625	98000	9	EACH	LIGHTING, MISC.: MIS-54: PULL BOX, 13"X24"	1202,1202A				
								2	2						625	98000	2	EACH	LIGHTING, MISC.: MIS-54: PULL BOX, AS PER PLAN, 17"X30"	1202,1202A				
								5	4				1		625	98000	5	EACH	LIGHTING, MISC.: MIS-502: 3-WIRE RETROFIT LIGHT POLE WITH FOUNDATION	1202				
								2	2						625	98000	2	EACH	LIGHTING, MISC.: MIS-603: CONTROLLER, 3 WIRE, 480V, PAD MOUNT	1202				
								7						7	625	98000	7	EACH	LIGHTING, MISC.: MIS-801: LUMINAIRE, LED, TEARDROP (120V)	1202				
								7					2	5	625	98000	7	EACH	LIGHTING, MISC.: MIS-801: LUMINAIRE, LED, TEARDROP (480V)	1202				
								8	3				5		625	98000	8	EACH	LIGHTING, MISC.: MIS-900: FOUNDATION REMOVAL	1202				
								4	4						625	98000	4	EACH	LIGHTING, MISC.: SPECIAL: STRUCTURE JUNCTION BOX	1202,1202A				
								8	8						625	98000	8	EACH	LIGHTING, MISC.: SPECIAL: NON-METALLIC JUNCTION BOX	1202				
								1	1						625	98000	1	EACH	LIGHTING, MISC.: MIS-501, AS PER PLAN: PULL BOX UNDERPASS WIRING	1202				
								2,602	2,104				498		625	98100	2,602	FT	LIGHTING, MISC.: MIS-404: UNDERGROUND CIRCUIT, 3 WIRE	1202				
								2,093	1,681				412		625	98100	2,093	FT	LIGHTING, MISC.: MIS-700: 2-INCH CONDUIT, CONCRETE ENCASED	1202				
								418	418						625	98100	418	FT	LIGHTING, MISC.: SPECIAL: 1-1/4" SCHEDULE 40 PVC CONDUIT	1202				
								6	6						625	98100	6	FT	LIGHTING, MISC.: SPECIAL: 3/4" SCHEDULE 40 PVC CONDUIT	1202				
								465	465						625	98100	465	FT	LIGHTING, MISC.: SPECIAL: CIRCUIT CABLE - (3) #10 AWG COPPER, XHHW	1202				
									LS				LS		625	98200	LS		LIGHTING, MISC.: MIS-901: EXISTING OVERHEAD SYSTEM REMOVAL	1202				
									LS				LS		625	98200	LS		LIGHTING, MISC.: MIS-902: EXISTING UNDERGROUND SYSTEM REMOVAL	1202				

LIGHTING GENERAL SUMMARY

FRA-70/71-12.68 / 14.86

1164A
1815

LANDSCAPE GENERAL SUMMARY - URBAN AVENUES

CALCULATED
RDH
CHECKED
JRB

P:\2013\c13811.06-70-71 4R & 4H\MICROSTATION\4R (105523)\Sheets\105523PN001a.dgn Sheet 11/18/2021 2:16:09 PM InWilson

PLAN SHEET NUMBER								ITEM	ITEM EXT	GRAND TOTAL	UNIT	DESCRIPTION	DETAIL SHEET NO.		
1208	1210	1212	1213	1214	1217	1218	1219								
					164	270	118	552	659	10001	552	SY	SEEDING AND MULCHING, AS PER PLAN	1222	
					26		26	52	661	20001	52	EACH	DECIDUOUS SHRUB, 15" HEIGHT, AS PER PLAN - RIBES ALPINUM 'GREEN MOUND' - GREEN MOUND ALPINE CURRANT	1222	
							12	12	661	20041	12	EACH	DECIDUOUS SHRUB, 24" HEIGHT, AS PER PLAN - VIBURNUM OPULUS 'COMPACTUM' - COMPACT EUROPEAN VIBURNUM	1222	
					129		50	161	661	30061	161	EACH	EVERGREEN SHRUB, 2' HEIGHT, AS PER PLAN - BUXUS X 'GREEN VELVET'- GREEN VELVET BOXWOOD	1222	
							2	2	661	40141	2	EACH	DECIDUOUS TREE, 4" CALIPER, AS PER PLAN - GLEDISTIA T.I. 'IMPERIAL' - IMPERIAL HONEYLOCUST	1222	
					2			2	661	40141	2	EACH	DECIDUOUS TREE, 4" CALIPER, AS PER PLAN - ULMUS PARVIFOLIA 'ALLEE' - LACEBARK ELM	1222	
					23			23	661	40141	23	EACH	DECIDUOUS TREE, 4" CALIPER, AS PER PLAN - GINGKO B. 'PRINCETON SENTRY' - PRINCETON SENTRY MAIDENHAIR TREE	1222	
							5	5	661	40141	5	EACH	DECIDUOUS TREE, 4" CALIPER, AS PER PLAN - PLATANUS ACERFOLIA 'EXCLAMATION' - EXCLAMATION LONDON PLANE TREE	1222	
							16	16	661	99900	16	EACH	PLANTING, MISC: 24" SPREAD, AS PER PLAN - SCHIZACHYRIUM SCOPARIUM 'SMOKE SIGNAL' - SMOKE SIGNAL LITTLE BLUESTEM	1222	
						34	5	39	661	99900	39	EACH	PLANTING, MISC: 18" SPREAD, AS PER PLAN - JUNIPERUS SABINA 'BUFFALO' - BUFFALO JUNIPER	1222	
					6			6	661	99900	6	EACH	PLANTING, MISC: 14" HEIGHT - CRATAEGUS VIRIDIS 'WINTER KING'- WINTER KING HAWTHORN	1222	
					374			374	661	99900	374	EACH	PLANTING, MISC.: 18" SPREAD ARCTOSTAPHYLOS U. 'MASSACHUSETTS'- MASSACHUSETTS BEARBERRY	1222	
					102			102	661	99900	102	EACH	PLANTING, MISC.: HELICTRICHON SEMPERVIRENS 'SAPPHIRE'- SAPPHIRE BLUE OATS GRASS	1222	
							315	315	661	99900	315	EACH	PLANTING, MISC.: LIRIOPE MUSCARI - BIG BLUE LILY TURF	1222	
					605	575	134	1,314	661	99900	1,314	EACH	PLANTING, MISC.: HEDERA HELIX- ENGLISH IVY	1222	
						26		26	661	99900	26	EACH	PLANTING, MISC.: PARTHENOCISSUS TRICUSPIDATA- BOSTON IVY	1222	
2	1							3	SPECIAL	68014550	3	EACH	TRASH (LITTER) RECEPTACLE	1785	
							4	2	6	SPECIAL	69098000	6	EACH	TREE GRATE, 4' X 8'	1224
									17	SPECIAL	69098000	17	EACH	LIVINGSTON AVE. PLANTER POT TYPE B	1773
									375	SPECIAL	69098100	375	FT	CURB, GRANITE CURB AT LIVINGSTON PLANTERS	1773
									750	SPECIAL	69098100	750	FT	CURB, PRECAST CONCRETE CURB AT FULTON STREET PLANTERS	1773
									1	SPECIAL	69098400	1		PRECAST CONCRETE PLANTERS AT FULTON STREET CANTILEVER	1773
					55	117	66.5	238.5	SPECIAL	69098700	238.5	CY	TURFGRASS SOIL MIX FURNISHED & PLACED, AS PER PLAN (12" DEPTH UPPER HORIZON)	1222	
					21	45	25	91	SPECIAL	69098700	91	CY	TURFGRASS BASE MIX FURNISHED & PLACED, AS PER PLAN (4 1/2" DEPTH LOWER HORIZON)	1222	
					236	60	12	308	SPECIAL	69098700	308	CY	TREE AND PLANTS SOIL MIX FURNISHED & PLACED, AS PER PLAN (24" DEPTH UPPER HORIZON)	1222	
					88.5	22.5	5	116	SPECIAL	69098700	116	CY	TREE AND PLANTS BASE MIX FURNISHED & PLACED, AS PER PLAN (9" DEPTH LOWER HORIZON)	1222	
					240		236	476	SPECIAL	69098700	476	CY	SAND-BASED STRUCTURAL SOIL MIX FURNISHED & PLACED, AS PER PLAN (24" DEPTH UPPER HORIZON)	1224	
					90		88.5	178.5	SPECIAL	69098700	178.5	CY	SAND-BASED STRUCTURAL SOIL BASE MIX FURNISHED & PLACED, (9" DEPTH LOWER HORIZON)	1224	

LANDSCAPE GENERAL SUMMARY

FRA-70/71-
12.68/14.86

NO.	DESCRIPTION	REV. BY	DATE
4	FUNDING SPLIT CODE CHANGE	MKSK/LHW	11.26.2021

3486 - E

1207
1815

GENERAL NOTES:

REFER TO THE FOLLOWING STANDARD BRIDGE DRAWINGS:

AS-1-15 (REVISED) 07-17-15 SBR-1-13 (REVISED) 07-20-18
 AS-2-15 (REVISED) 01-18-19 SICD-1-96 (REVISED) 07-18-14
 PCB-91 (REVISED) 07-17-20 SICD-2-14 (REVISED) 01-15-21
 PSD-1-13 (REVISED) 01-15-21

AND TO THE FOLLOWING SUPPLEMENTAL SPECIFICATIONS:

800 DATED 10-15-21
 832 DATED 10-19-18

DESIGN SPECIFICATIONS:

THIS STRUCTURE CONFORMS TO "STANDARD SPECIFICATIONS FOR HIGHWAY BRIDGES" ADOPTED BY THE AMERICAN ASSOCIATION OF STATE HIGHWAY AND TRANSPORTATION OFFICIALS, 17TH EDITION, 2002 AND THE ODOT BRIDGE DESIGN MANUAL, 2004 EDITION, INCLUDING REVISIONS THROUGH JANUARY 2015.

DESIGN LOADING:

HS25 AND THE ALTERNATE MILITARY LOADING
 FUTURE WEARING SURFACE (FWS) = 60 PSF

DESIGN DATA:

CLASS QC2 CONCRETE WITH QC/QA - COMPRESSIVE STRENGTH 4500 PSI (SUPERSTRUCTURE)

CLASS QC1 CONCRETE WITH QC/QA - COMPRESSIVE STRENGTH 4000 PSI (SUBSTRUCTURE)

REINFORCING STEEL - ASTM A615 OR A996 GRADE 60
 MINIMUM YIELD STRENGTH 60,000 PSI

STEEL H-PILES - ASTM A572 GRADE 50 - YIELD STRENGTH 50 KSI

CONCRETE FOR PRESTRESSED BEAMS:

COMPRESSIVE STRENGTH (FINAL) - 7500 PSI
 COMPRESSIVE STRENGTH (RELEASE) - 5000 PSI

WELDED WIRE FABRIC:

YIELD STRENGTH - 70 KSI

PRESTRESSING STRAND - ASTM A416 0.6" DIA.

AREA = 0.217 SQ. IN.
 ULTIMATE STRENGTH = 270 KSI
 INITIAL STRESS = 202.5 KSI (LOW RELAXATION STRANDS)

DECK PROTECTION METHOD:

CLASS QC2 CONCRETE
 EPOXY COATED REINFORCING STEEL
 2 1/2" CONCRETE COVER

MONOLITHIC WEARING SURFACE IS ASSUMED, FOR DESIGN PURPOSES, TO BE 1 INCH THICK

EXISTING STRUCTURE VERIFICATION:

DETAILS AND DIMENSIONS SHOWN ON THESE PLANS PERTAINING TO THE EXISTING STRUCTURE HAVE BEEN OBTAINED FROM PLANS OF THE EXISTING STRUCTURE AND FROM FIELD OBSERVATIONS AND MEASUREMENTS. CONSEQUENTLY, THEY ARE INDICATIVE OF THE EXISTING STRUCTURE AND THE PROPOSED WORK BUT THEY SHALL BE CONSIDERED TENTATIVE AND APPROXIMATE. THE CONTRACTOR IS REFERRED TO CMS SECTIONS 102.05 AND 105.02.

BASE CONTRACT BID PRICES UPON A RECOGNITION OF THE UNCERTAINTIES DESCRIBED ABOVE AND UPON A PREBID EXAMINATION OF THE EXISTING STRUCTURE. HOWEVER, THE DEPARTMENT WILL PAY FOR ALL PROJECT WORK BASED UPON ACTUAL DETAILS AND DIMENSIONS THAT HAVE BEEN VERIFIED IN THE FIELD.

EXISTING STRUCTURE PLANS:

PLANS MAY BE EXAMINED BY PROSPECTIVE BIDDERS AT THE OHIO DEPARTMENT OF TRANSPORTATION, DISTRICT 6 OFFICES, 400 E. WILLIAM STREET, DELAWARE, OHIO 43015, PHONE (740) 833-8000.

ITEM 202 - PORTIONS OF STRUCTURE REMOVED, OVER 20 FOOT SPAN, AS PER PLAN:
ITEM 202 - APPROACH SLAB REMOVED, AS PER PLAN:

CUT LINE CONSTRUCTION JOINT PREPARATION: SAW CUT BOUNDARIES OF PROPOSED CONCRETE REMOVALS 1 INCH DEEP AT SUBSTRUCTURE REMOVAL AND FULL DEPTH AT DECK REMOVAL. REMOVE CONCRETE TO A ROUGH SURFACE AT SUBSTRUCTURE REMOVAL LIMITS. LEAVE THE EXISTING REINFORCING STEEL, IF REQUIRED IN THE PLANS, IN PLACE. INSTALL DOWEL BARS IF SPECIFIED. PRIOR TO CONCRETE PLACEMENT ABRASIVELY CLEAN JOINT SURFACES AND EXISTING EXPOSED REINFORCEMENT TO REMOVE LOOSE AND DISINTEGRATED CONCRETE AND LOOSE RUST. THOROUGHLY CLEAN THE JOINT SURFACE AND EXPOSED REINFORCEMENT OF ALL DIRT, DUST, RUST OR OTHER FOREIGN MATERIAL BY THE USE OF WATER, AIR UNDER PRESSURE, OR OTHER METHODS THAT PRODUCE SATISFACTORY RESULTS. EXISTING REINFORCING STEEL DOES NOT HAVE TO HAVE A BRIGHT STEEL FINISH, BUT REMOVE ALL PACK AND LOOSE RUST. THOROUGHLY DRENCH EXISTING CONCRETE SURFACES WITH CLEAN WATER AND ALLOW TO DRY TO A DAMP CONDITION BEFORE PLACING CONCRETE.

SUBSTRUCTURE CONCRETE REMOVAL: REMOVE CONCRETE BY MEANS OF APPROVED PNEUMATIC HAMMERS EMPLOYING POINTED AND BLUNT CHISEL TOOLS. HYDRAULIC HOE-RAM TYPE HAMMERS WILL NOT BE PERMITTED. THE WEIGHT OF THE HAMMER SHALL NOT BE MORE THAN 35 POUNDS FOR REMOVAL WITHIN 18 INCHES OF PORTIONS TO BE PRESERVED. OUTSIDE THE 18 INCH LIMIT, THE CONTRACTOR MAY USE HAMMERS NOT EXCEEDING 90 POUNDS UPON APPROVAL OF THE ENGINEER. DO NOT PLACE PNEUMATIC HAMMERS IN DIRECT CONTACT WITH REINFORCING STEEL THAT IS TO BE RETAINED IN THE REBUILT STRUCTURE.

PILE DRIVING CONSTRAINTS:

PRIOR TO DRIVING PILES AT THE ABUTMENTS, CONSTRUCT THE BRIDGE APPROACH EMBANKMENT BEHIND THE ABUTMENTS UP AT A 1:1 SLOPE FROM THE TOP OF THE HEEL OF THE FOOTING TO THE SUBGRADE ELEVATION AND FOR A MINIMUM DISTANCE OF 250 FEET BEHIND THE ABUTMENTS. DO NOT BEGIN THE INSTALLATION OF THE ABUTMENT PILES UNTIL AFTER THE ABOVE REQUIRED EMBANKMENT HAS BEEN CONSTRUCTED. AFTER THE FOOTING AND THE BREASTWALL HAVE BEEN CONSTRUCTED, CONSTRUCT THE EMBANKMENT IMMEDIATELY BEHIND THE ABUTMENTS UP TO THE BEAM SEAT ELEVATION AND ON A 1:1 SLOPE UP TO THE SUBGRADE ELEVATION PRIOR TO SETTING THE BEAMS ON THE ABUTMENTS.

PILES TO BEDROCK: DRIVE PILES TO REFUSAL ON BEDROCK. THE DEPARTMENT WILL CONSIDER REFUSAL TO BE OBTAINED WHEN THE PILE PENETRATION IS AN INCH OR LESS AFTER RECEIVING AT LEAST 20 BLOWS FROM THE PILE HAMMER. SELECT THE HAMMER SIZE TO ACHIEVE THE REQUIRED DEPTH TO BEDROCK AND REFUSAL. PROVIDE PILE POINTS TO PROTECT THE TIPS OF THE PROPOSED H-PILES AT ALL SUBSTRUCTURE UNITS.

THE ULTIMATE BEARING VALUE IS 148 TONS PER PILE FOR THE HP10x42 ABUTMENT PILES.

ABUTMENT PILES:

32 REAR ABUTMENT PILES AT 60 FEET, ORDER LENGTH AND
 20 FORWARD ABUTMENT PILES AT 60 FEET, ORDER LENGTH

PILE SPLICES: IN LIEU OF USING FULL PENETRATION BUTT WELDS SPECIFIED IN CMS 507.06 TO SPLICE STEEL H-PILES, THE CONTRACTOR MAY USE A MANUFACTURED H-PILE SPLICER. FURNISH SPLICERS FROM THE FOLLOWING MANUFACTURER:

ASSOCIATED PILE AND FITTING CORPORATION
 8 WOOD HOLLOW RD. PLAZA 1
 PARSIPPANY, NEW JERSEY 07054

INSTALL AND WELD THE PILE SECTIONS IN ACCORDANCE WITH THE MANUFACTURER'S WRITTEN ASSEMBLY PROCEDURE SUPPLIED TO THE ENGINEER BEFORE WELDING IS PERFORMED.

ITEM 503 - COFFERDAMS AND EXCAVATION BRACING, AS PER PLAN:

THE DESIGN SHOWN ON THE PLANS FOR TEMPORARY SUPPORT OF EXCAVATION IS ONE REPRESENTATIVE DESIGN THAT MAY BE USED TO CONSTRUCT THE PROJECT. THE CONTRACTOR MAY CONSTRUCT THE DESIGN SHOWN ON THE PLANS OR PREPARE AN ALTERNATE DESIGN TO SUPPORT THE SIDES OF THE EXCAVATIONS. IF CONSTRUCTING AN ALTERNATE DESIGN FOR TEMPORARY SUPPORT OF EXCAVATION, PREPARE AND PROVIDE PLANS IN ACCORDANCE WITH C&MS 501.05. THE DEPARTMENT WILL PAY FOR THE TEMPORARY SUPPORT OF EXCAVATION AT THE CONTRACT LUMP SUM PRICE FOR COFFERDAMS AND EXCAVATION BRACING. NO ADDITIONAL PAYMENT WILL BE MADE FOR PROVIDING AN ALTERNATE DESIGN.

ITEM 509 - EPOXY COATED REINFORCING STEEL, AS PER PLAN:

GLASS FIBER REINFORCED POLYMER (GFRP) PARAPET STIFFENING BARS SHALL BE INCLUDED IN THIS ITEM. SEE SHEET

34	/	41
----	---	----

 FOR QUANTITIES.

ITEM 511 - CLASS QC2 CONCRETE WITH QC/QA, SUPERSTRUCTURE, AS PER PLAN:

THIS ITEM SHALL INCLUDE THE BRIDGE DECK, THE END DIAPHRAGMS AT THE ABUTMENTS AND THE EXPANDED POLYSTYRENE FILLER USED TO FORM THE BOTTOM OF THE DIAPHRAGMS.

DECK PLACEMENT ASSUMPTIONS:

THE FOLLOWING ASSUMPTIONS OF CONSTRUCTION MEANS AND METHODS WERE MADE FOR THE ANALYSIS AND DESIGN OF THE SUPERSTRUCTURE. THE CONTRACTOR IS RESPONSIBLE FOR THE DESIGN OF THE FALSEWORK SUPPORT SYSTEM WITHIN THESE PARAMETERS AND WILL ASSUME RESPONSIBILITY FOR SUPERSTRUCTURE ANALYSIS FOR DEVIATION FROM THESE DESIGN ASSUMPTIONS.

AN EIGHT WHEEL FINISHING MACHINE WITH A MAXIMUM WHEEL LOAD OF 2.43 KIPS.

A MINIMUM OUT-TO-OUT WHEEL SPACING AT EACH END OF THE MACHINE OF 103 INCHES.

A MAXIMUM SPACING OF OVERHANG FALSEWORK BRACKETS OF 48 INCHES.

A MAXIMUM DISTANCE FROM THE CENTERLINE OF THE FASCIA GIRDER TO THE FACE OF THE SAFETY HANDRAIL OF 65 INCHES (EXCEPT AT THE RIGHT FORWARD DECK OVERHANG EXCEEDING 4'-0", USE 71 INCHES).

UTILITY LINES:

THE UTILITY(IES) SHALL BEAR ALL EXPENSE INVOLVED IN RELOCATING (INSTALLING) THE AFFECTED UTILITY LINES. THE CONTRACTOR AND UTILITY(IES) ARE TO COOPERATE BY ARRANGING THEIR WORK IN SUCH A MANNER THAT INCONVENIENCE TO EITHER WILL BE HELD TO A MINIMUM.

PROPOSED BRIDGE WORK AND SEQUENCE OF CONSTRUCTION:
 THE WORK TO BE PERFORMED UNDER THIS CONTRACT IS AS SHOWN IN THE CONSTRUCTION PLANS AND, IN GENERAL, INCLUDES THE FOLLOWING:

1. INSTALL PORTABLE CONCRETE BARRIER
2. REMOVE ROADWAY APPROACH PAVEMENT
3. CONSTRUCT COFFERDAMS AND EXCAVATION BRACING
4. SAWCUT DECK SLAB AND REMOVE DECK AND BEAMS
5. SAWCUT PORTIONS OF ABUTMENTS AND REMOVE
6. CONSTRUCT ABUTMENT SUBSTRUCTURE EXTENSIONS
7. CONSTRUCT 4W12 MSE WALL (SEE MSE WALL PLANS FOR DETAILS AND PAYMENT)
8. CONSTRUCT SUPERSTRUCTURE
9. CONSTRUCT APPROACH SLAB AND APPROACH PAVEMENT
10. RELOCATE PORTABLE CONCRETE BARRIER
11. REMOVE REMAINING ROADWAY APPROACH PAVEMENT
12. REMOVE REMAINING DECK SLAB AND BEAMS
13. SAWCUT REMAINING PORTIONS OF ABUTMENT AND REMOVE
14. CONSTRUCT REMAINING ABUTMENT
15. CONSTRUCT REMAINING SUPERSTRUCTURE
16. CONSTRUCT REMAINING APPROACH SLAB AND APPROACH PAVEMENT

ASBESTOS SURVEY:

AN ASBESTOS SURVEY FOR THE BRIDGE STRUCTURE SCHEDULED FOR DEMOLITION WORK WAS CONDUCTED BY A LICENSED ASBESTOS HAZARD EVALUATION SPECIALIST. THE ASBESTOS INSPECTION REPORT DID NOT IDENTIFY THE PRESENCE OF ANY ASBESTOS CONTAINING MATERIALS ABOVE REGULATORY LIMITS. A COPY OF THE ASBESTOS INSPECTION REPORT FOR THE STRUCTURE IS INCLUDED IN THE PLAN PACKAGE FOR THIS PROJECT.

ELECTRONIC SUBMISSION:

SUBMIT A COMPLETED ELECTRONIC NOTIFICATION OF DEMOLITION AND RENOVATION FORM (NDRF), APPLICABLE FEES, AND THE ASBESTOS INSPECTION REPORT TO THE OEPA AT LEAST 10 DAYS PRIOR TO ANY DEMOLITION ACTIVITY, RENOVATION ACTIVITY, OR BOTH. SUBMIT THE NDRF AND PAYMENT ALONG WITH THE ASBESTOS INSPECTION REPORT USING THE OEPA EBUSINESS CENTER. SUBMIT ONE ELECTRONIC PDF COPY AND ONE HARD COPY OF THE NDRF TO THE ENGINEER. THE ENGINEER WILL PROVIDE ONE COPY TO THE DISTRICT ENVIRONMENTAL STAFF.

HARD COPY SUBMISSION:

THE CONTRACTOR MAY SUBMIT A HARD COPY OF THE COMPLETED NDRF AND PAYMENT ALONG WITH THE ASBESTOS INSPECTION REPORT. FOLLOW THE MAILING INSTRUCTIONS ON THE NDRF. CHECK WITH LOCAL HEALTH DEPARTMENT, COLUMBUS PUBLIC HEALTH, 240 PARSONS AVE., COLUMBUS, OHIO 43215, (614) 645-7005, TO DETERMINE IF THEY REQUIRE A HARD COPY SUBMITTAL.

SUBMIT THE COMPLETED NDRF TO OEPA AT LEAST 10 DAYS PRIOR TO DEMOLITION ACTIVITY, RENOVATION ACTIVITY, OR BOTH. RETAIN TWO HARD COPIES OF THE NDRF AND SUBMIT ONE COPY TO THE ENGINEER AND EMAIL ONE COPY TO THE ODOT DISTRICT ENVIRONMENTAL COORDINATOR AT: janice.gartner@dot.ohio.gov.

BASIS OF PAYMENT:

THE CONTRACTOR SHALL FURNISH ALL FEES, LABOR, AND MATERIALS NECESSARY TO COMPLETE AND SUBMIT THE OEPA NOTIFICATION FORM. PAYMENT FOR THIS WORK SHALL BE INCLUDED IN ITEM 202 - PORTIONS OF STRUCTURE REMOVED, OVER 20 FOOT SPAN, AS PER PLAN.

NUMBER	DESCRIPTION	REVISED BY	DATE
4	ADDED ASBESTOS NOTE	CAS	11-29-2021

P:\PR51781\fra\77372\structures\FRA070_1282R\Slogge 2\Sheets\070_1282RGN001.dgn 11/24/2021 10:23:41 AM alibey

P:\PR5178\18\17372\structures\FRA070_1282R\Stage 2\Sheets\070_1282REQ001.dgn 11/22/2021 8:27:54 AM albey

ESTIMATED QUANTITIES

ITEM	ITEM EXT.	UNIT	DESCRIPTION	ABUTMENTS	CALC. JHL	DATE 12/31/2014	CHK'D ABP	CHK'D ABP	DATE 1/5/2015
202	11203		PORTIONS OF STRUCTURE REMOVED, OVER 20 FOOT SPAN, AS PER PLAN					LS	
202	22901	SY	APPROACH SLAB REMOVED, AS PER PLAN					320	320
202	23500	SY	WEARING COURSE REMOVED			519		320	839
503	11101		COFFERDAMS AND EXCAVATION BRACING, AS PER PLAN					LS	LS
503	21100	CY	UNCLASSIFIED EXCAVATION	395				395	395
505	11100		PILE DRIVING EQUIPMENT MOBILIZATION					LS	LS
507	00100	FT	STEEL PILES HPI0X42, FURNISHED	3,120				3,120	3,120
507	00150	FT	STEEL PILES HPI0X42, DRIVEN	2,860				2,860	2,860
507	93300	EACH	STEEL POINTS OR SHOES	52				52	52
509	10001	LB	EPOXY COATED REINFORCING STEEL, AS PER PLAN	41,233	79,646	1,109		121,988	121,988
510	10000	EACH	DOWEL HOLES WITH NONSHRINK, NONMETALLIC GROUT	220				220	220
511	21523	CY	CLASS QC2 CONCRETE WITH QC/QA, SUPERSTRUCTURE, AS PER PLAN		380			380	380
511	33500	EACH	SEMI-INTEGRAL DIAPHRAGM GUIDE	2				2	2
511	34450	CY	CLASS QC2 CONCRETE WITH QC/QA, BRIDGE DECK (PARAPET)		21			21	21
511	44112	CY	CLASS QC1 CONCRETE WITH QC/QA, ABUTMENT NOT INCLUDING FOOTING	289				289	289
511	46512	CY	CLASS QC1 CONCRETE WITH QC/QA, FOOTING	163				163	163
511	53010	CY	CLASS QC1 CONCRETE, MISC.: MOMENT SLAB AND PARAPET WITH QC/QA			8		8	8
512	10100	SY	SEALING OF CONCRETE SURFACES (EPOXY-URETHANE)	587	299	118		1,004	1,004
512	33000	SY	TYPE 2 WATERPROOFING	26	5			31	31
515	14080	EACH	STRAIGHT STRAND PRESTRESSED CONCRETE BRIDGE I-BEAM MEMBERS, LEVEL 2, TYPE WF42-49 (67'-6" BEAM LENGTH)		10			10	10
515	20001	EACH	INTERMEDIATE DIAPHRAGMS, AS PER PLAN		9			9	9
516	10010	FT	ARMORLESS PREFORMED JOINT SEAL			221		221	221
516	13600	SF	1" PREFORMED EXPANSION JOINT FILLER	250		15		265	265
516	13900	SF	2" PREFORMED EXPANSION JOINT FILLER		81	67		148	148
516	14020	FT	SEMI-INTEGRAL ABUTMENT EXPANSION JOINT SEAL	241				241	241
516	44301	EACH	ELASTOMERIC BEARING WITH INTERNAL LAMINATES AND LOAD PLATE (NEOPRENE), AS PER PLAN (BEARING: 1'-8" x 1'-2" x 4 1/2", LOAD PLATE: 1'-9" x 1'-3" x 1 1/2")		20			20	20
518	21200	CY	POROUS BACKFILL WITH GEOTEXTILE FABRIC	241				241	241
518	40000	FT	6" PERFORATED CORRUGATED PLASTIC PIPE	110				110	110
518	40010	FT	6" NON-PERFORATED CORRUGATED PLASTIC PIPE, INCLUDING SPECIALS	10				10	10
526	30011	SY	REINFORCED CONCRETE APPROACH SLABS WITH QC/QA (T=17"), AS PER PLAN			729		729	729
526	90030	FT	TYPE C INSTALLATION			221		221	221

NUMBER	DESCRIPTION	REVISED BY	DATE
4	FUNDING PARTICIPATION CHANGE	CAS	11-29-2021

ESTIMATED QUANTITIES
FRA-70-1282R
RAMP C5 OVER SOUDER AVE.

FRA-70/71-12.68 / 14.86 (PROJ. 4R)
PID No. 105523

5 / 41

1232
1815

BURGESS & NIPLÉ
Engineers ■ Architects ■ Planners
5085 REED ROAD, COLUMBUS, OHIO 43220

DATE 10/17/18
REVIEWED CAS
DRAWN JHL
DESIGNED JHL
CHECKED ABP
STRUCTURE FILE NUMBER 2504669

P:\PR51781\fr077372\structures\FRA070_1301A\Stage_2\Sheets\070_1301AE0001.dgn 11/22/2021 8:32:46 AM alibey

ESTIMATED QUANTITIES							CALC'D	DATE	CHK'D	DATE
ITEM	EXTENSION	TOTAL	PARTICIPATION 02/NHS/BR LUMP 4	UNIT	DESCRIPTION	ABUT.	SJA	12/10/2014	XAC	12/23/2014
							PIERS	SUPER.	GEN.	SHEET REF.
202	11201	LUMP	LUMP		PORTIONS OF STRUCTURE REMOVED, AS PER PLAN					10 / 64
202	22900	52	52	SY	APPROACH SLAB REMOVED				52	
202	98100	1	1	EACH	REMOVAL MISC.: VERTICAL PILE				1	6 / 64
202	98100	10	10	EACH	REMOVAL MISC.: BATTERED PILE				10	6 / 64
503	11100	LUMP	LUMP		COFFERDAMS AND EXCAVATION BRACING					
503	21100	522	522	CY	UNCLASSIFIED EXCAVATION	82	440			
505	11100	LUMP	LUMP		PILE DRIVING EQUIPMENT MOBILIZATION					
507	00100	1995	1995	FT	STEEL PILES HP10X42, FURNISHED	1995				
507	00150	1890	1890	FT	STEEL PILES HP10X42, DRIVEN	1890				
507	00300	3475	3475	FT	STEEL PILES HP14X73, FURNISHED		3475			
507	00350	3210	3210	FT	STEEL PILES HP14X73, DRIVEN		3210			
507	93300	74	74	EACH	STEEL POINTS OR SHOES	21	53			
509	10001	492817	492817	LB	EPOXY COATED REINFORCING STEEL, AS PER PLAN	14126	146718	331973		6, 61-63 / 64
511	21523	1143	1143	CY	CLASS QC2 CONCRETE WITH QC/QA, SUPERSTRUCTURE, AS PER PLAN			1143		6 / 64
511	34450	298	298	CY	CLASS QC2 CONCRETE WITH QC/QA, BRIDGE DECK (PARAPET)			298		
511	41012	45	45	CY	CLASS QC1 CONCRETE WITH QC/QA, PIER ABOVE FOOTINGS (CAP AND COLUMN)		45			
511	42012	495	495	CY	CLASS QC1 CONCRETE WITH QC/QA, PIER ABOVE FOOTINGS (T-TYPE)		495			
511	44112	48	48	CY	CLASS QC1 CONCRETE WITH QC/QA, ABUTMENT NOT INCLUDING FOOTING	48				
511	45602	347	347	CY	CLASS QC4 MASS CONCRETE, SUBSTRUCTURE WITH QC/QA	76	271			
511	46512	324	324	CY	CLASS QC1 CONCRETE WITH QC/QA, FOOTING	69	255			
512	10100	6206	6206	SY	SEALING OF CONCRETE SURFACES (EPOXY-URETHANE)	99	1361	4746		
513	95030	2	2	EACH	STRUCTURAL STEEL, MISC.: PARAPET SLIDING PLATE JOINT			2		
515	16000	32	32	EACH	PRESTRESSED CONCRETE BRIDGE I-BEAM MEMBERS, MISC.: LEVEL 3, TYPE WF78-49			32		
515	20000	72	72	EACH	INTERMEDIATE DIAPHRAGMS			72		
SPECIAL	51612400	28	28	FT	MODULAR EXPANSION JOINT			28		7 / 64
516	13600	36	36	SF	1" PREFORMED EXPANSION JOINT FILLER		36			
516	13900	28	28	SF	2" PREFORMED EXPANSION JOINT FILLER		28			
516	44100	8	8	EACH	ELASTOMERIC BEARING WITH INTERNAL LAMINATES AND LOAD PLATE (NEOPRENE) (9" x2'-8"x2 1/4")			8		
516	44100	8	8	EACH	ELASTOMERIC BEARING WITH INTERNAL LAMINATES AND LOAD PLATE (NEOPRENE) (10" x2'-10"x2 1/4")			8		
516	44101	4	4	EACH	ELASTOMERIC BEARING WITH INTERNAL LAMINATES AND LOAD PLATE (NEOPRENE), AS PER PLAN (9"x2'-10"x2 1/2") (PTFE)			4		8 / 64
516	44101	12	12	EACH	ELASTOMERIC BEARING WITH INTERNAL LAMINATES AND LOAD PLATE (NEOPRENE), AS PER PLAN (10"x2'-10"x2 1/2") (PTFE)			12		8 / 64
516	44101	8	8	EACH	ELASTOMERIC BEARING WITH INTERNAL LAMINATES AND LOAD PLATE (NEOPRENE), AS PER PLAN (11"x2'-10"x2 1/2") (PTFE)			8		8 / 64
516	44200	8	8	EACH	ELASTOMERIC BEARING WITH INTERNAL LAMINATES AND LOAD PLATE (NEOPRENE) (10"x2'-8"x3")			8		
516	44200	16	16	EACH	ELASTOMERIC BEARING WITH INTERNAL LAMINATES AND LOAD PLATE (NEOPRENE) (1'-1"x2'-8"x4")			16		
518	12300	1	1	EACH	SCUPPERS, INCLUDING SUPPORTS			1		
518	21200	66	66	CY	POROUS BACKFILL WITH GEOTEXTILE FABRIC	66				
518	40000	57	57	FT	6" PERFORATED CORRUGATED PLASTIC PIPE	57				
518	40010	15	15	FT	6" NON-PERFORATED CORRUGATED PLASTIC PIPE, INCLUDING SPECIALS	15				
524	94904	16	16	FT	DRILLED SHAFTS, 48" DIAMETER, INTO BEDROCK		16			
524	94906	268	268	FT	DRILLED SHAFTS, 54" DIAMETER, ABOVE BEDROCK		268			
524	95100	4	4	EACH	DRILLED SHAFTS, MISC.: THERMAL INTEGRITY PROFILER (T.I.P.) WIRE CABLE TESTING OF DRILLED SHAFTS		4			7 / 64
526	30010	94	94	SY	REINFORCED CONCRETE APPROACH SLABS WITH QC/QA (T=17")				94	
526	90010	29	29	FT	TYPE A INSTALLATION				29	
601	21000	249	249	SY	CONCRETE SLOPE PROTECTION				249	

PIER NO.	CAP	STEM/COLUMNS
1	C	B
2	C	B
3	C	B
4	C	B
5	C	B
6	C	A
7	C	A

A = ITEM 41012 (CAP AND COLUMN)
 B = ITEM 42012 (T-TYPE)
 C = ITEM 45602 (MASS CONCRETE)

NUMBER	DESCRIPTION	REVISED BY	DATE
4	FUNDING PARTICIPATION CHANGE	CAS	11-29-2021

BURGESS & NIPLE
 Engineers - Architects - Planners
 5085 REED ROAD, COLUMBUS, OHIO 43220
 DATE: 10/18/18
 REVIEWED: CAS
 DRAWN: AAA
 DESIGNED: SJA
 CHECKED: XAC
 STRUCTURE FILE NUMBER: 2570014
 ESTIMATED QUANTITIES
 FRA-70-1301A
 RAMP C5 OVER SR 315
 FRA-70/71-12.68/
 14.86 (PROJ. 4R)
 PID No. 105523
 9 / 64
 1277
 1815

P:\PR51781\fra\77372\structures\FRA071_1518A\Stage 2\Sheets\071_1518AEQ001.dgn 11/22/2021 8:36:26 AM ailbey

ESTIMATED QUANTITIES							CALC.	DATE	CHECKED	DATE
ITEM	ITEM EXT.	UNIT	DESCRIPTION	ABUTMENT	PIER	SUPERSTR.	JDH	3/6/2015	BEN	3/24/2015
							GENERAL	TOTAL	PARTICIPATION 02/NHS/BR	SHEET REF.
505	11100		PILE DRIVING EQUIPMENT MOBILIZATION	LS				LS	LS	
507	00100	FT	STEEL PILES HPI0X42, FURNISHED	800				800	800	
507	00150	FT	STEEL PILES HPI0X42, DRIVEN	760				760	760	
507	93300	EACH	STEEL POINTS OR SHOES	8				8	8	
509	10001	LB	EPOXY COATED REINFORCING STEEL, AS PER PLAN	6,094	11,434	70,330		87,858	87,858	3/31
510	10000	EACH	DOWEL HOLES WITH NONSHRINK, NONMETALLIC GROUT		16			16	16	
511	21523	CY	CLASS QC2 CONCRETE WITH QC/QA, SUPERSTRUCTURE, AS PER PLAN			194		194	194	3/31
511	34450	CY	CLASS QC2 CONCRETE WITH QC/QA, BRIDGE DECK (PARAPET)			54		54	54	
511	41510	CY	CLASS QC1 CONCRETE, PIER ABOVE FOOTINGS		30			30	30	
511	44110	CY	CLASS QC1 CONCRETE, ABUTMENT NOT INCLUDING FOOTING	39				39	39	
511	45600	CY	CLASS QC4 MASS CONCRETE, SUBSTRUCTURE		32			32	32	
511	46510	CY	CLASS QC1 CONCRETE, FOOTING	25				25	25	
512	10100	SY	SEALING OF CONCRETE SURFACES (EPOXY-URETHANE)	77		712	52	841	841	
512	33000	SY	TYPE 2 WATERPROOFING	72				72	72	
513	95030	EACH	STRUCTURAL STEEL, MISC.: PARAPET SLIDING PLATE JOINT			2		2	2	26/31
515	15020	EACH	DRAPED STRAND PRESTRESSED CONCRETE BRIDGE I-BEAM MEMBERS, LEVEL 3, TYPE 4 (BEAM LENGTH VARIES 67'-3 7/8" TO 103'-2 5/8")			8		8	8	12/31
515	20001	EACH	INTERMEDIATE DIAPHRAGMS, AS PER PLAN			18		18	32	
516	11210	FT	STRUCTURAL EXPANSION JOINT INCLUDING ELASTOMERIC STRIP SEAL			32		32	44	
516	13900	SF	2" PREFORMED EXPANSION JOINT FILLER	44				44	8	27/31
516	44101	EACH	ELASTOMERIC BEARING WITH INTERNAL LAMINATES AND LOAD PLATE (NEOPRENE), AS PER PLAN (BEARING: 16.5" x 11.5" x 2.25")			8		8	8	
516	44201	EACH	ELASTOMERIC BEARING WITH INTERNAL LAMINATES AND LOAD PLATE (NEOPRENE), AS PER PLAN (BEARING: 16" x 15" x 4")			8		8	8	27/31
518	21200	CY	POROUS BACKFILL WITH GEOTEXTILE FABRIC	23				23	23	
518	40000	FT	6" PERFORATED CORRUGATED PLASTIC PIPE	32				32	32	
524	94908	FT	DRILLED SHAFTS, 54" DIAMETER, INTO BEDROCK		9			9	9	
524	94915	FT	DRILLED SHAFTS, 60" DIAMETER, ABOVE BEDROCK, AS PER PLAN		136			136	136	3/31
524	95100	EACH	DRILLED SHAFTS, MISC.: THERMAL INTEGRITY PROFILER (T.I.P.) WIRE CABLE TESTING OF DRILLED SHAFTS		2			2	2	3/31
526	30011	SY	REINFORCED CONCRETE APPROACH SLABS WITH QC/QA (T=17"), AS PER PLAN				105	105	105	3/31
526	90010	FT	TYPE A INSTALLATION				32	32	32	

NUMBER	DESCRIPTION	REVISED BY	DATE
4	FUNDING PARTICIPATION CHANGE	CAS	11-29-2021

BURGESS & NIPLÉ
Engineers - Architects - Planners
5085 REED ROAD, COLUMBUS, OHIO 43220

DATE 10/18/18
REVIEWED CAS
STRUCTURE FILE NUMBER 2510013

DRAWN AAA
REVISED

DESIGNED BES
CHECKED MAB

ESTIMATED QUANTITIES
BRIDGE NO. FRA-71-1518A
RAMP A5 OVER THE SCIOTO RIVER

FRA-70/71-12.68 /
14.86 (PROJ. 4R)
PID No. 105523

4 / 31

1336
1815

3486 - E

ESTIMATED QUANTITIES

CALCULATED: RFV DATE: 5-29-19
CHECKED: TJW DATE: 5-30-19

ITEM	EXT.	TOTAL 02/NHS/B R	UNITS	DESCRIPTION	ABUTMENT	PIER	SUPER.	GENERAL	A.P.P. REFERENCE SHEET NO.
503	11100	LS		COFFERDAMS AND EXCAVATION BRACING					
503	21100	767	CY	UNCLASSIFIED EXCAVATION	767				
505	11100	LS		PILE DRIVING EQUIPMENT MOBILIZATION					
507	00100	1,890	FT	STEEL PILES HPI0X42, FURNISHED	1,890				
507	00150	1,755	FT	STEEL PILES HPI0X42, DRIVEN	1,755				
507	93300	27	EACH	STEEL POINTS OR SHOES	27				
509	10001	895,729	LB	EPOXY COATED REINFORCING STEEL, AS PER PLAN	23,664	216,790	655,275		8
511	34447	2,274	CY	CLASS QC2 CONCRETE WITH QC/QA, BRIDGE DECK, AS PER PLAN			2,274		8
511	34450	326	CY	CLASS QC2 CONCRETE WITH QC/QA, BRIDGE DECK (PARAPET)			326		
511	43512	289	CY	CLASS QC1 CONCRETE WITH QC/QA, ABUTMENT INCLUDING FOOTING	289				
511	45602	1,236	CY	CLASS QC4 MASS CONCRETE, SUBSTRUCTURE WITH QC/QA		1236			
512	10100	4,775	SY	SEALING CONCRETE SURFACES (EPOXY-URETHANE)	222	2309	2244		
513	10300	2,355,836	LB	STRUCTURAL STEEL MEMBERS, LEVEL 5			2,355,836		
513	10401	1,495,251	LB	STRUCTURAL STEEL MEMBERS, HYBRID GIRDER, LEVEL SIX (6) FABRICATION, AS PER PLAN			1,495,251		8
513	20000	27,788	EACH	WELDED STUD SHEAR CONNECTORS			27,788		
513	95030	6	EACH	STRUCTURAL STEEL, MISC.: PARAPET SLIDING PLATE JOINT			6		8
514	00060	3,476	SF	FIELD PAINTING STRUCTURAL STEEL, INTERMEDIATE COAT			3,476		
514	00066	3,476	SF	FIELD PAINTING STRUCTURAL STEEL, FINISH COAT			3,476		
514	10000	3	EACH	FINAL INSPECTION REPAIR			3		
516	12400	163	FT	SPECIAL - MODULAR EXPANSION JOINT			163		8
516	44101	10	EACH	ELASTOMERIC BEARING WITH INTERNAL LAMINATES AND LOAD PLATE (NEOPRENE), AS PER PLAN (1'-5" DIA.) (PTFE)			10		10
516	44101	6	EACH	ELASTOMERIC BEARING WITH INTERNAL LAMINATES AND LOAD PLATE (NEOPRENE), AS PER PLAN (1'-6 1/2" DIA.) (PTFE)			6		10
518	12301	8	EACH	SCUPPER, INCLUDING SUPPORTS, AS PER PLAN			8		64
518	21200	81	CY	POROUS BACKFILL WITH GEOTEXTILE FABRIC	81				
518	40000	100	FT	6" PERFORATED CORRUGATED PLASTIC PIPE	100				
518	40010	30	FT	6" NON-PERFORATED CORRUGATED PLASTIC PIPE, INCLUDING SPECIALS	30				
518	51201	60	FT	PIPE DOWNSPOUT, INCLUDING SPECIALS, AS PER PLAN (DIAMETER = 10")		60			65
518	60031	15	FT	PIPE HORIZONTAL CONDUCTOR, AS PER PLAN			15		66
524	94919	107	FT	DRILLED SHAFTS, 60" DIAMETER, INTO BEDROCK, AS PER PLAN		107			11
524	94931	814	FT	DRILLED SHAFTS, 66" DIAMETER, ABOVE BEDROCK, AS PER PLAN		814			11
524	94931	235	FT	DRILLED SHAFTS, 66" DIAMETER, ABOVE BEDROCK, AS PER PLAN, PIER 4		235			11
524	94935	36	FT	DRILLED SHAFTS, 66" DIAMETER, INTO BEDROCK, AS PER PLAN		36			11
524	94947	182	FT	DRILLED SHAFTS, 72" DIAMETER, ABOVE BEDROCK, AS PER PLAN		182			11
526	30010	187	SY	REINFORCED CONCRETE APPROACH SLABS WITH QC/QA (T=17")				187	
526	90010	85	FT	TYPE A INSTALLATION				85	
601	21000	870	SY	CONCRETE SLOPE PROTECTION				870	
601	32104	1,190	CY	ROCK CHANNEL PROTECTION, TYPE B WITH GEOTEXTILE FABRIC				1190	
869	00101	28	EACH	HIGH LOAD MULTI-ROTATIONAL (HLMR) BEARINGS, AS PER PLAN			28		11
SPECIAL	69098100	181	FT	COVERED WALKWAY SYSTEM				181	7

DESIGN AGENCY
GPD GROUP
Class, P.E., Schaner, Burns & DeHaven, Inc.
1801 Watermark Drive, Suite 210, Columbus, Ohio 43215 614-210-0731
Copyright © 2015, Schaner, Burns & DeHaven, Inc.

REVIEWED DATE 9-6-19
DGN STRUCTURE FILE NUMBER 2510015

DRAWN MLS REVISIONS
DESIGNED TJW CHECKED RHC

ESTIMATED QUANTITIES
BRIDGE NO. FRA-70-1321A
RAMP A5/B5/C5 OVER THE SCIOTO RIVER

FRA-70/71-12.68/14.86
PID No. 105523

12/99

1375
1815



NO.	DESCRIPTION	REV. BY	DATE	NO.	DESCRIPTION	REV. BY	DATE
2	REVISED QUANTITY	MOJ	11-12-2021	4	FUNDING CODE CHANGE	CWL	11-29-2021

G:\2012\20120418\FRA\105523\STRUCTURES\FRA070_1321A\SHEETS\070_1321A\0001.DGN
 11/21/2021 12:49:01 PM
 0001Y81STD.LUSER

ITEM	EXT.	TOTAL	PARTICIPATION		UNIT	DESCRIPTION	GENERAL	AS PER PLAN SHEET --/1815
			01/NHS/PV	01/NHS/PV				
202	11203	LS	LS	LS		PORTIONS OF STRUCTURE REMOVED, OVER 20 FOOT SPAN, AS PER PLAN	LUMP	1462A
202	22900	187	82	105	SY	APPROACH SLAB REMOVED	187	

NO.	DESCRIPTION	REV. BY	DATE
3	UPDATED NOTE	CWL	11-19-2021
4	FUNDING CODE CHANGE / ADDED ASBESTOS NOTE	CWL	11-29-2021

LEGEND:

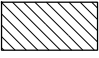-  PORTIONS OF STRUCTURE REMOVED, OVER 20 FOOT SPAN, AS PER PLAN
-  APPROACH SLAB REMOVED



NOTES:

- SEE ROADWAY PLANS FOR FINAL GRADING.

ITEM 202 - PORTIONS OF STRUCTURE REMOVED, OVER 20 FOOT SPAN, AS PER PLAN

THIS ITEM SHALL INCLUDE THE REMOVAL OF THE ENTIRE STRUCTURE NOT ALREADY REMOVED UNDER SEPARATE ITEMS EXCEPT THE LEFT FORWARD WINGWALL (LABELED "RETAINING WALL C" IN THE EXISTING PLANS), THE EXISTING MEDIAN BARRIER AND EXISTING WB-70 CONCRETE BARRIER, WHICH ARE TO REMAIN. CONTRACTOR SHALL USE CAUTION DURING REMOVAL OF THE STRUCTURE TO KEEP THE EXISTING MEDIAN BARRIER AND EXISTING WB-70 CONCRETE BARRIER INTACT WITHOUT UNNECESSARY DAMAGE. THE EXISTING VERTICAL EXPANSION JOINT (FILLED WITH 1" P-E.J.F.) BETWEEN THE WINGWALL AND ABUTMENT IS TO SERVE AS THE REMOVAL LIMIT. THE CONTRACTOR IS RESPONSIBLE FOR OBTAINING THE EXISTING PLANS, PERFORMING THE EXISTING STRUCTURE VERIFICATION, AND DETERMINING REMOVAL EFFORTS. EXISTING PLANS MAY BE EXAMINED BY PROSPECTIVE BIDDERS AT THE OHIO DEPARTMENT OF TRANSPORTATION, DISTRICT 6 OFFICES, 400 E. WILLIAM ST., DELEWARE, OHIO 43015 (PHONE 740-833-8000). ALL WORK SHALL BE PERFORMED IN ACCORDANCE WITH CMS 202 AND CMS 501.05.

ASBESTOS SURVEY

AN ASBESTOS SURVEY FOR THE BRIDGE STRUCTURE SCHEDULED FOR DEMOLITION WORK WAS CONDUCTED BY A LICENSED ASBESTOS HAZARD EVALUATION SPECIALIST. THE ASBESTOS INSPECTION REPORT DID NOT IDENTIFY THE PRESENCE OF ANY ASBESTOS CONTAINING MATERIALS ABOVE REGULATORY LIMITS. A COPY OF THE ASBESTOS INSPECTION REPORT FOR THE STRUCTURE IS INCLUDED IN THE PLAN PACKAGE FOR THIS PROJECT.

ELECTRONIC SUBMISSION:

SUBMIT A COMPLETED ELECTRONIC NOTIFICATION OF DEMOLITION AND RENOVATION FORM (NDRF), APPLICABLE FEES, AND THE ASBESTOS INSPECTION REPORT TO THE OEPA AT LEAST 10 DAYS PRIOR TO ANY DEMOLITION ACTIVITY, RENOVATION ACTIVITY, OR BOTH. SUBMIT THE NDRF AND PAYMENT ALONG WITH THE ASBESTOS INSPECTION REPORT USING THE OEPA EBUSINESS CENTER. SUBMIT ONE ELECTRONIC PDF COPY AND ONE HARD COPY OF THE NDRF TO THE ENGINEER. THE ENGINEER WILL PROVIDE ONE COPY TO THE DISTRICT ENVIRONMENTAL STAFF.


HARD COPY SUBMISSION:

THE CONTRACTOR MAY SUBMIT A HARD COPY OF THE COMPLETED NDRF AND PAYMENT ALONG WITH THE ASBESTOS INSPECTION REPORT. FOLLOW THE MAILING INSTRUCTIONS ON THE NDRF. CHECK WITH LOCAL HEALTH DEPARTMENT (COLUMBUS PUBLIC HEALTH, 240 PARSONS AVE. COLUMBUS, OH 43215, 614-645-7005) TO DETERMINE IF THEY REQUIRE A HARD COPY SUBMITTAL.

SUBMIT THE COMPLETED NDRF TO OEPA AT LEAST 10 DAYS PRIOR TO DEMOLITION ACTIVITY, RENOVATION ACTIVITY, OR BOTH. RETAIN TWO HARD COPIES OF THE NDRF AND SUBMIT ONE COPY TO THE ENGINEER AND EMAIL ONE COPY TO THE ODOT DISTRICT ENVIRONMENTAL COORDINATOR AT: Janice.Gartner@dot.ohio.gov

BASIS OF PAYMENT:

THE CONTRACTOR SHALL FURNISH ALL FEES, LABOR, AND MATERIALS NECESSARY TO COMPLETE AND SUBMIT THE OEPA NOTIFICATION FORM. PAYMENT FOR THIS WORK SHALL BE INCLUDED IN ITEM 202 - PORTIONS OF STRUCTURE REMOVED, OVER 20 FOOT SPAN, AS PER PLAN.

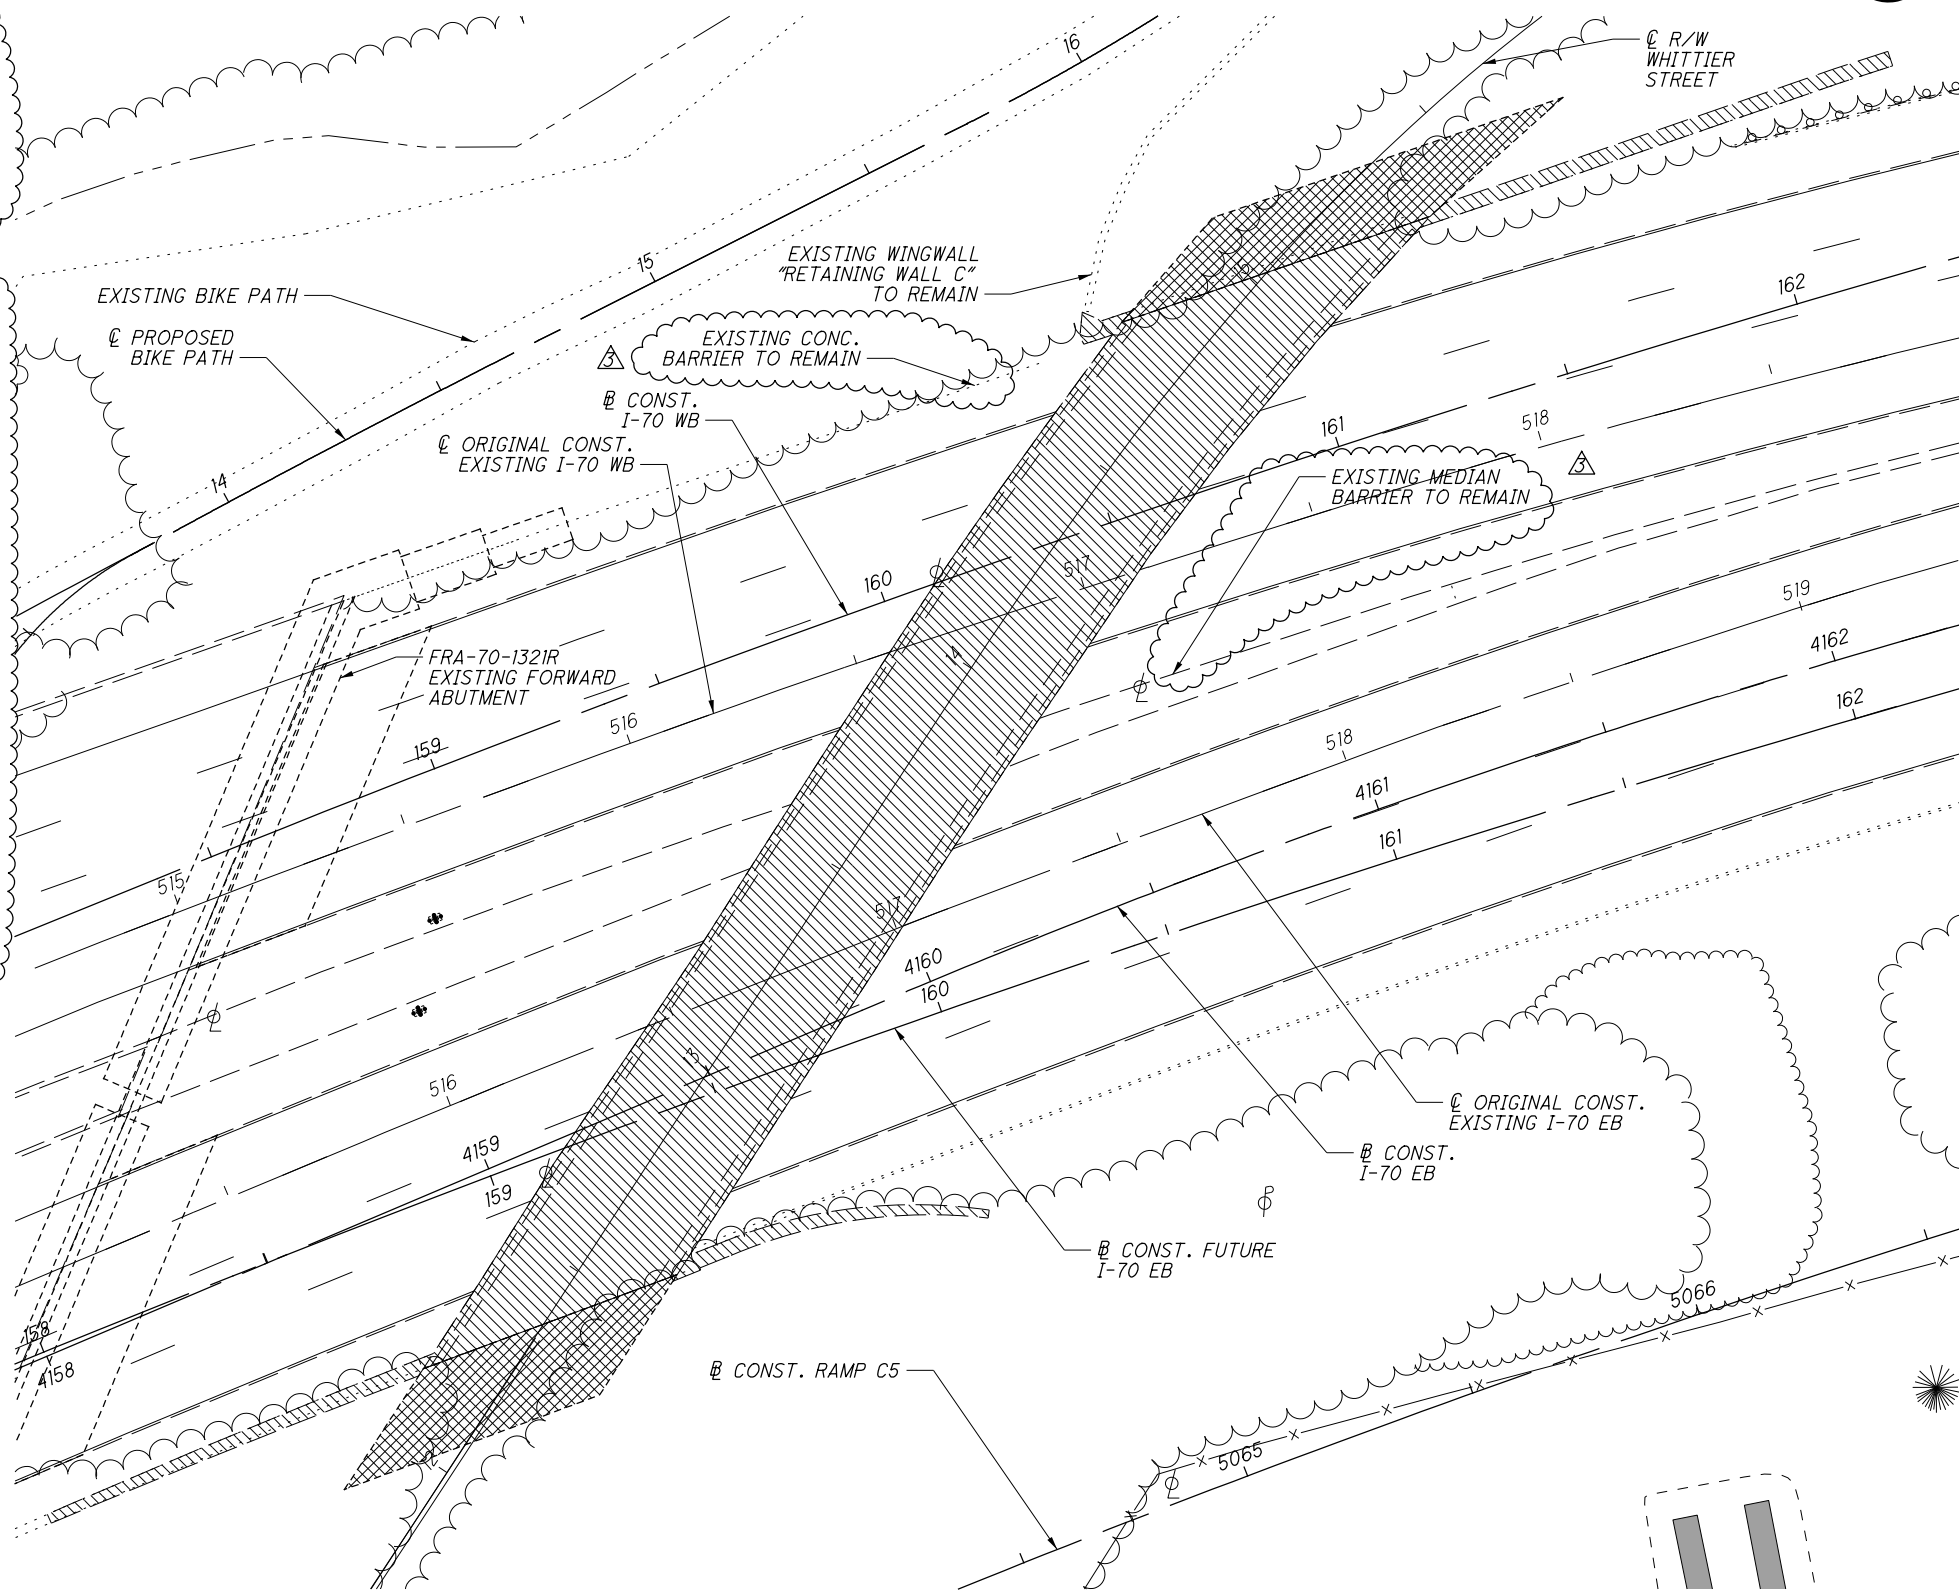

PLAN

EXISTING STRUCTURE

TYPE:	TWO SPAN CONTINUOUS STEEL GIRDER BRIDGE WITH NON-COMPOSITE REINFORCED CONCRETE DECK AND SUBSTRUCTURE UNITS
SPANS:	132'-0"±, 132'-0"± C/C BEARINGS MEASURED ALONG ORIGINAL SURVEY
ROADWAY:	28'-0" F/F OF 2'-0" SAFETY CURBS 34'-0" O/O DECK
SKEW:	55°0'0" RF REAR ABUTMENT AND PIER 52°0'0" RF FORWARD ABUTMENT MEASURED TO ORIGINAL REFERENCE TANGENT
LOADING:	HS20-44
DATE BUILT:	1975
STRUCTURE FILE NUMBER (SFN):	2504464
APPROACH SLABS:	30'-0" LONG, AS-1-69
WEARING SURFACE:	1" MONOLITHIC CONCRETE
DISPOSITION:	TO BE REMOVED

REMOVAL NOTES AND ESTIMATED QUANTITIES
 BRIDGE NO. FRA-70-1343
 WHITTIER STREET OVER I-70/77
 DESIGN AGENCY: **GPD GROUP**
 Ohio, Pa., Schenck, Burns & Dehaven, Inc.
 1801 Watermark Drive, Suite 150, Columbus, Ohio 43215 614.210.0731
 Copyright © Schenck, Burns & Dehaven, Inc. 2015
 DATE: 9-6-19
 REVIEWED: T J W
 DRAWN: M O J
 CHECKED: D G N
 STRUCTURE FILE NUMBER: 2504464
 FRA-70/71-12.68 / 14.86
 PID No. 105523
 1 / 1
 1462A
 1815

01_2012_2012048_VFR_105523_STRUCTURES_FRA070_1343_SHEETS_072_1343SN001.DGN
 11/24/2021 8:59:48 AM
 DDDTY81STD_USER

DESIGN STRESSES

CONCRETE CLASS QC1 - COMPRESSIVE STRENGTH 4.0 KSI
(CULVERT, WINGWALLS & FOOTINGS)

REINFORCING STEEL - MINIMUM YIELD STRENGTH 60 KSI

FOUNDATION BEARING RESISTANCE


THE FOOTINGS, AS DESIGNED, PRODUCE A MAXIMUM SERVICE LOAD PRESSURE OF 5.0 KIPS PER SQUARE FOOT AND A MAXIMUM STRENGTH LOAD PRESSURE OF 8.7 KIPS PER SQUARE FOOT. THE FACTORED BEARING RESISTANCE IS 19.6 KIPS PER SQUARE FOOT.

ITEM 503 - UNCLASSIFIED EXCAVATION, AS PER PLAN

ALL WORK SHALL BE AS PER ITEM 503, EXCEPT THE LIMITS OF EXCAVATION SHALL BE PER THE DETAILS ON THIS SHEET. BACKFILL TO THE BOTTOM OF FOOTING ELEVATION WITH GRANULAR MATERIAL TYPE C.

CALCULATED: RFV DATE: 2/27/19
CHECKED: DJC DATE: 2/28/19

ESTIMATED QUANTITIES						
ITEM	EXT.	TOTAL	PARTICIPATION 02/NHS/BR	UNIT	DESCRIPTION	SHEET REF.
203	35120	91	91	CY	GRANULAR MATERIAL, TYPE C	
503	21101	293	293	CY	UNCLASSIFIED EXCAVATION, AS PER PLAN	1
509	10000	65,042	65,042	LB	EPOXY COATED REINFORCING STEEL	
511	46012	52	52	CY	CLASS QC1 CONCRETE WITH QC/QA, RETAINING/WINGWALL NOT INCLUDING FOOTING	
511	46512	68	68	CY	CLASS QC1 CONCRETE WITH QC/QA, FOOTING	
511	47012	158	158	CY	CLASS QC1 CONCRETE WITH QC/QA, CULVERT	
512	10100	111	111	SY	SEALING OF CONCRETE SURFACES (EPOXY-URETHANE)	
512	33000	270	270	SY	TYPE 2 WATERPROOFING	
516	13600	65	65	SF	1" PREFORMED EXPANSION JOINT FILLER	
518	21200	62	62	CY	POROUS BACKFILL WITH GEOTEXTILE FABRIC	
518	40000	60	60	FT	6" PERFORATED CORRUGATED PLASTIC PIPE	
518	40010	20	20	FT	6" NON-PERFORATED CORRUGATED PLASTIC PIPE, INCLUDING SPECIALS	

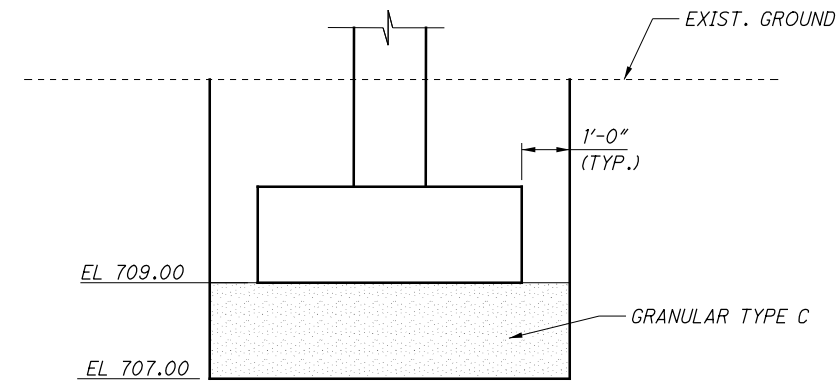

FOOTING EXCAVATION DETAIL

ABBREVIATIONS

ABUT.	ABUTMENT	N.P.C.P.P.	NON-PERFORATED CORRUGATED PLASTIC PIPE
ADDIT.	ADDITIONAL	N.S.	NEAR SIDE
A.P.P.	AS PER PLAN	P.C.P.P.	PERFORATED CORRUGATED PLASTIC PIPE
BOT.	BOTTOM	P.E.J.F.	PREFORMED EXPANSION JOINT FILLER
BRG.	BEARING	R.A.	REAR ABUTMENT
B.S.	BOTH SIDES	SER.	SERIES
BTWN.	BETWEEN	SHT.	SHEET
CLR.	CLEAR	SPA.	SPACES OR SPACED
CONST. JT.	CONSTRUCTION JOINT	SPL.	SPLICE
DIA.	DIAMETER	SR	SERIES (REINFORCING STEEL LIST SHEETS)
DIM.	DIMENSION	STD.	STANDARD
D.N.D.	DO NOT DISTURB	T.B.R.	TO BE REMOVED
DWG.	DRAWING	TYP.	TYPICAL
EA.	EACH		
EQ.	EQUAL OR EQUALLY		
F.A.	FORWARD ABUTMENT		
FRWD.	FORWARD		
F.S.	FAR SIDE		
MIN.	MINIMUM		
NO.	NUMBER		

NO.	DESCRIPTION	REV. BY	DATE
4	FUNDING CODE CHANGE	CWL	11-29-2021

DESIGN AGENCY
GPD GROUP
 1801 Watermark Drive, Suite 150, Columbus, Ohio 43215 614.210.0731
 Copyright © 2019, GPD Group, Inc.


ESTIMATED QUANTITIES
 BRIDGE NO. FRA-70-1357A
 RAMP C5 OVER ELECTRICAL VAULT

FRA-70/71-12.68 / 14.86
 PID No. 105523

1 / 12
 1463
 1815

DATE: 9-6-19
 REVIEWED: DGN
 DRAWN: RPR
 DESIGNED: RHC
 CHECKED: DJC
 STRUCTURE FILE NUMBER: 2503749
 REVISED:

P:\PR5178\1\ro\77372\structures\FRA070_1358A\Stage_2\Sheets\070_1358A5P001.dgn 11/24/2021 9:17:33 AM alibey

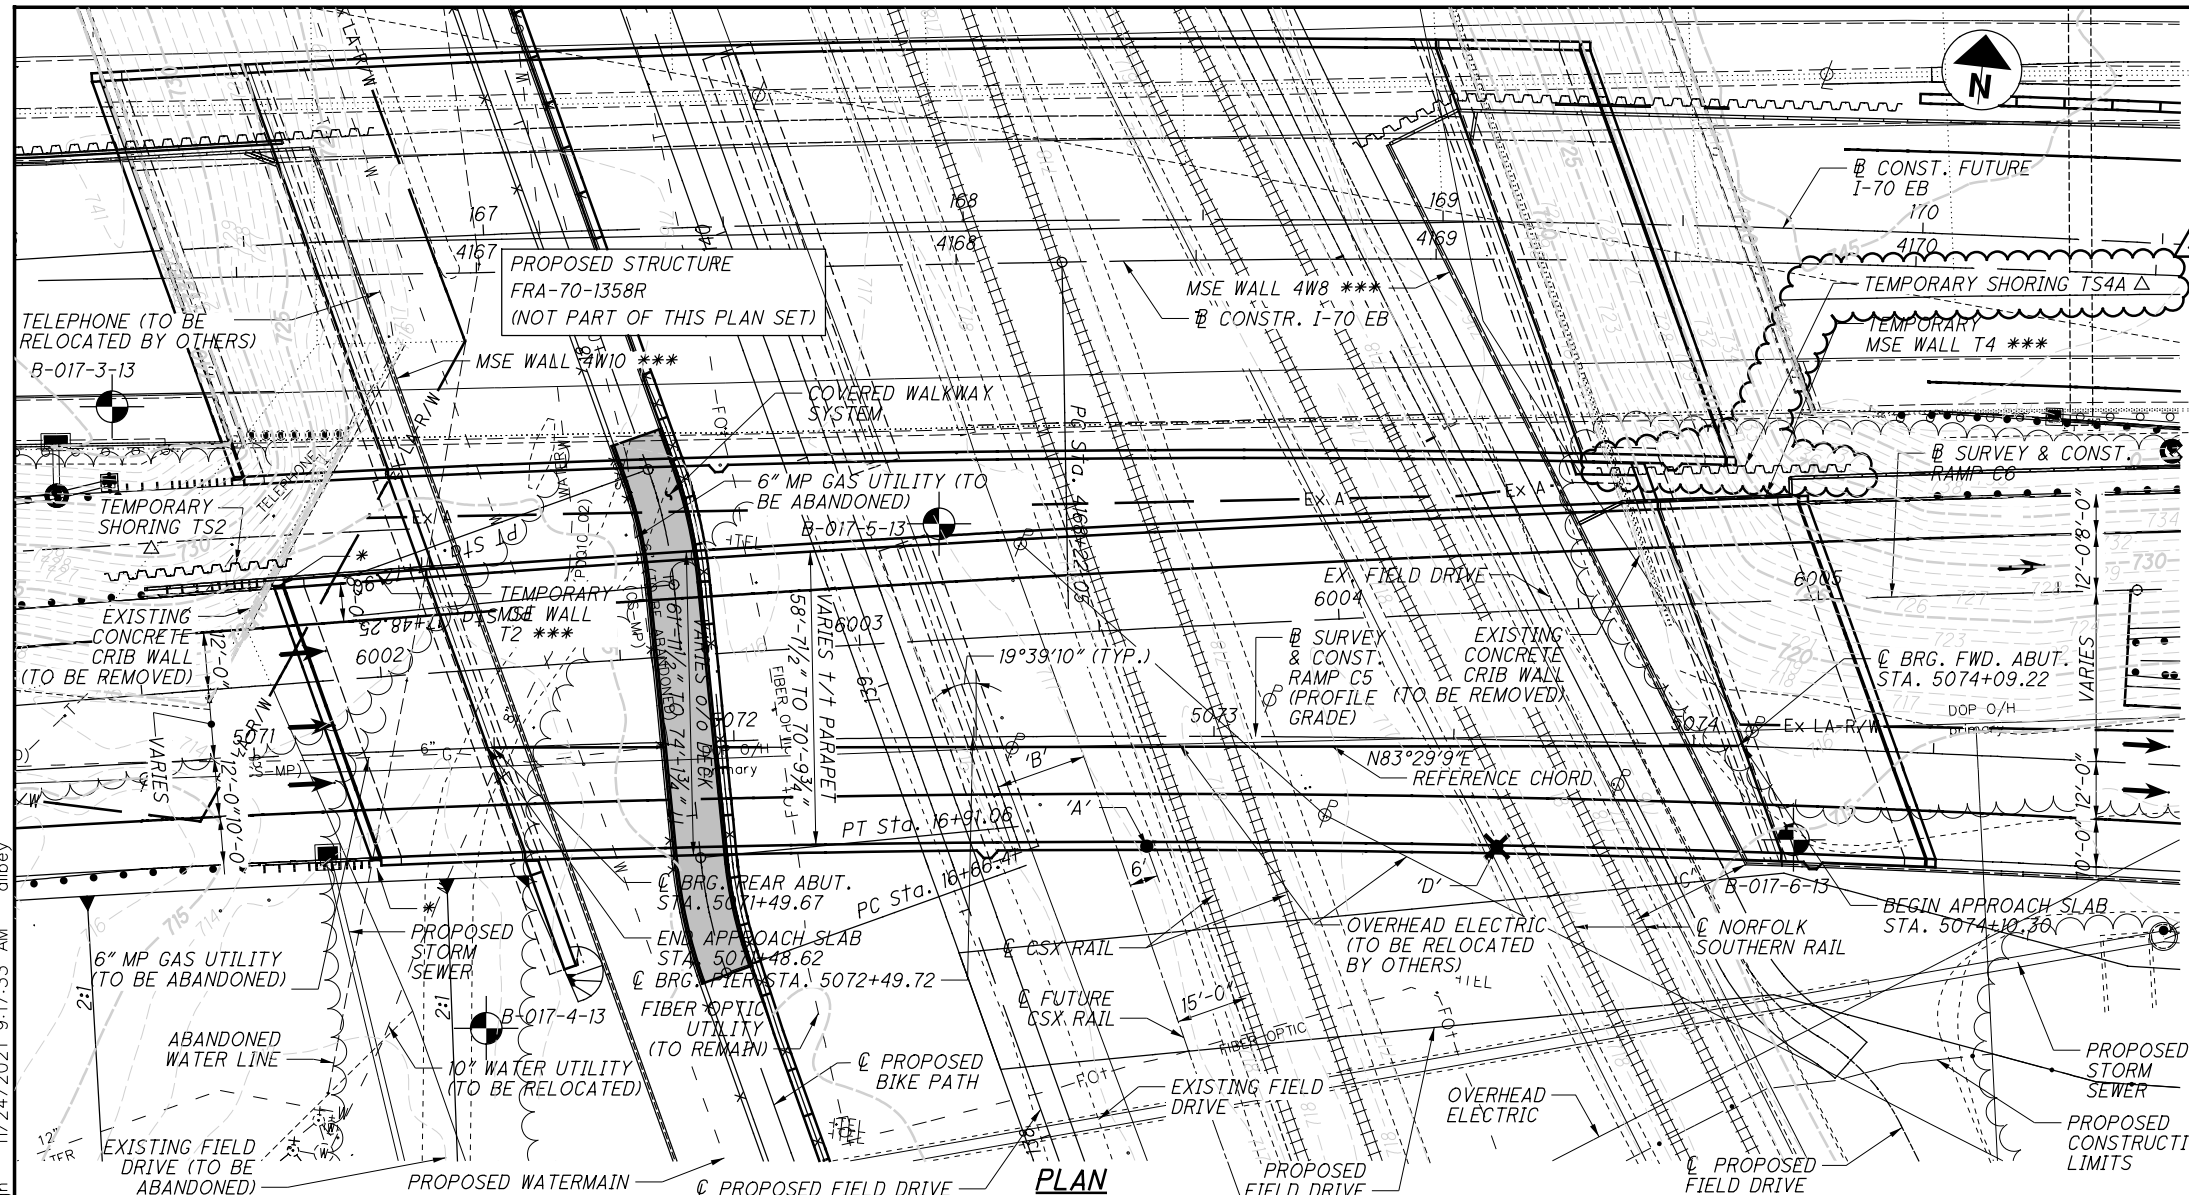

BENCHMARK DATA

CP4, CONCRETE MONUMENT WITH 2" ALUMINUM CAP
 "AZIMUTH MARK" APPROXIMATELY ON THE WEST
 SIDE OF THE CUL-DE-SAC AT THE WEST END OF
 W. MOUND ST. ELEVATION 714.392
 NORTHING 712059.179 EASTING 1826322.295

FOR ADDITIONAL BENCHMARK INFORMATION, SEE ROADWAY PLAN
 SHEET 17 OF 1815

NOTES

EARTHWORK LIMITS SHOWN ARE APPROXIMATE.
 ACTUAL SLOPES SHALL CONFORM TO PLAN CROSS SECTIONS.

DESIGN TRAFFIC:
 2015 ADT = 31,130 2015 ADTT = 3,269
 2035 ADT = 32,510 2035 ADTT = 3,414
 DIRECTIONAL DISTRIBUTION = 100%

HORIZONTAL CURVE DATA

RAMP C5	RAMP C6
P.I. = STA. 5073+05.04	P.I. = STA. 6002+94.69
$\Delta = 9^{\circ}08'00.15''$ RT	$\Delta = 4^{\circ}25'05.22''$ RT
$D_c = 1^{\circ}30'00''$	$D_c = 0^{\circ}45'00''$
$R = 3,819.72'$	$R = 7,639.44'$
$T = 305.09'$	$T = 294.69'$
$L = 608.89'$	$L = 589.02'$
$E = 12.16'$	$E = 5.68'$

LEGEND

ABUT. = ABUTMENT
 BRG. = BEARING
 CONC. = CONCRETE
 CONST. = CONSTRUCTION
 EXP. = EXPANSION
 FWD. = FORWARD

- = PROJECT BORING LOCATION
- * = MGS BRIDGE TERMINAL ASSEMBLY, TYPE 1 - FIRST POST
 STATION 5071+06.91 (REAR LEFT)
 STATION 5071+24.53 (REAR RIGHT)
 (SEE ROADWAY PLANS FOR DETAILS AND PAYMENT)
- ** = REFER TO UTILITY PLANS FOR ADDITIONAL INFORMATION.
- POINT/DIMENSION "A" = 24'-4" ACTUAL MINIMUM VERTICAL CLEARANCE (LOW STEEL TO TOP OF RAIL) (23'-0" MINIMUM REQUIRED) (CSX)
- DIMENSION "B" = 18'-11 1/4" ACTUAL MINIMUM HORIZONTAL CLEARANCE (18'-0" MINIMUM REQUIRED) (CSX)
- DIMENSION "C" = 25'-4 7/8" ACTUAL MINIMUM HORIZONTAL CLEARANCE (18'-0" MINIMUM REQUIRED) (NORFOLK SOUTHERN)
- ✕ POINT/DIMENSION "D" = 25'-4" ACTUAL MINIMUM VERTICAL CLEARANCE (LOW STEEL TO TOP OF RAIL) (23'-0" MIN. REQ.) (NORFOLK SOUTHERN)
- *** = SEE MSE WALL PLANS FOR DETAILS AND PAYMENT
- △ = SEE TEMPORARY SHORING PLANS FOR DETAILS AND PAYMENT

BORING LOCATIONS


BORING	STATION	OFFSET	APPROX. TOP OF BEDROCK ELEV.
B-017-3-13	5070+74.38	74.56' LT	656.8
B-017-4-13	5071+46.22	58.40' RT	659.3
B-017-5-13	5072+43.22	44.50' LT	650.0
B-017-6-13	5071+21.50	19.10' RT	650.6
B-017-7-13	5075+20.51	85.33' LT	653.1

PROPOSED STRUCTURE

TYPE: 2-SPAN CONTINUOUS STRAIGHT WELDED STEEL PLATE GIRDER WITH COMPOSITE REINFORCED CONCRETE DECK, SEMI-INTEGRAL PILE SUPPORTED STUB ABUTMENTS BEHIND MSE WALLS AND A REINFORCED CONCRETE WALL-TYPE PIER

SPANS: 100'-9 1/4", 158'-8 3/4" c/c BRGS. ALONG REFERENCE CHORD
 ROADWAY: VARIES TOE/TOE PARAPET
 LOADING: HL-93 AND 60 PSF FUTURE WEARING SURFACE
 SKEW: 19°39'10" RIGHT FORWARD (MEASURED FROM REFERENCE CHORD)
 APPROACH SLABS: 30'-0" LONG (AS-1-15 MODIFIED) WITH SLEEPER SLAB (AS-2-15)

ALIGNMENT: 1°30'00" CURVE TO THE RIGHT
 SUPERELEVATION: 0.024 FT/FT
 WEARING SURFACE: 1" MONOLITHIC CONCRETE
 COORDINATES: LATITUDE 39°57'10.30" N
 LONGITUDE 83°00'27.82" W

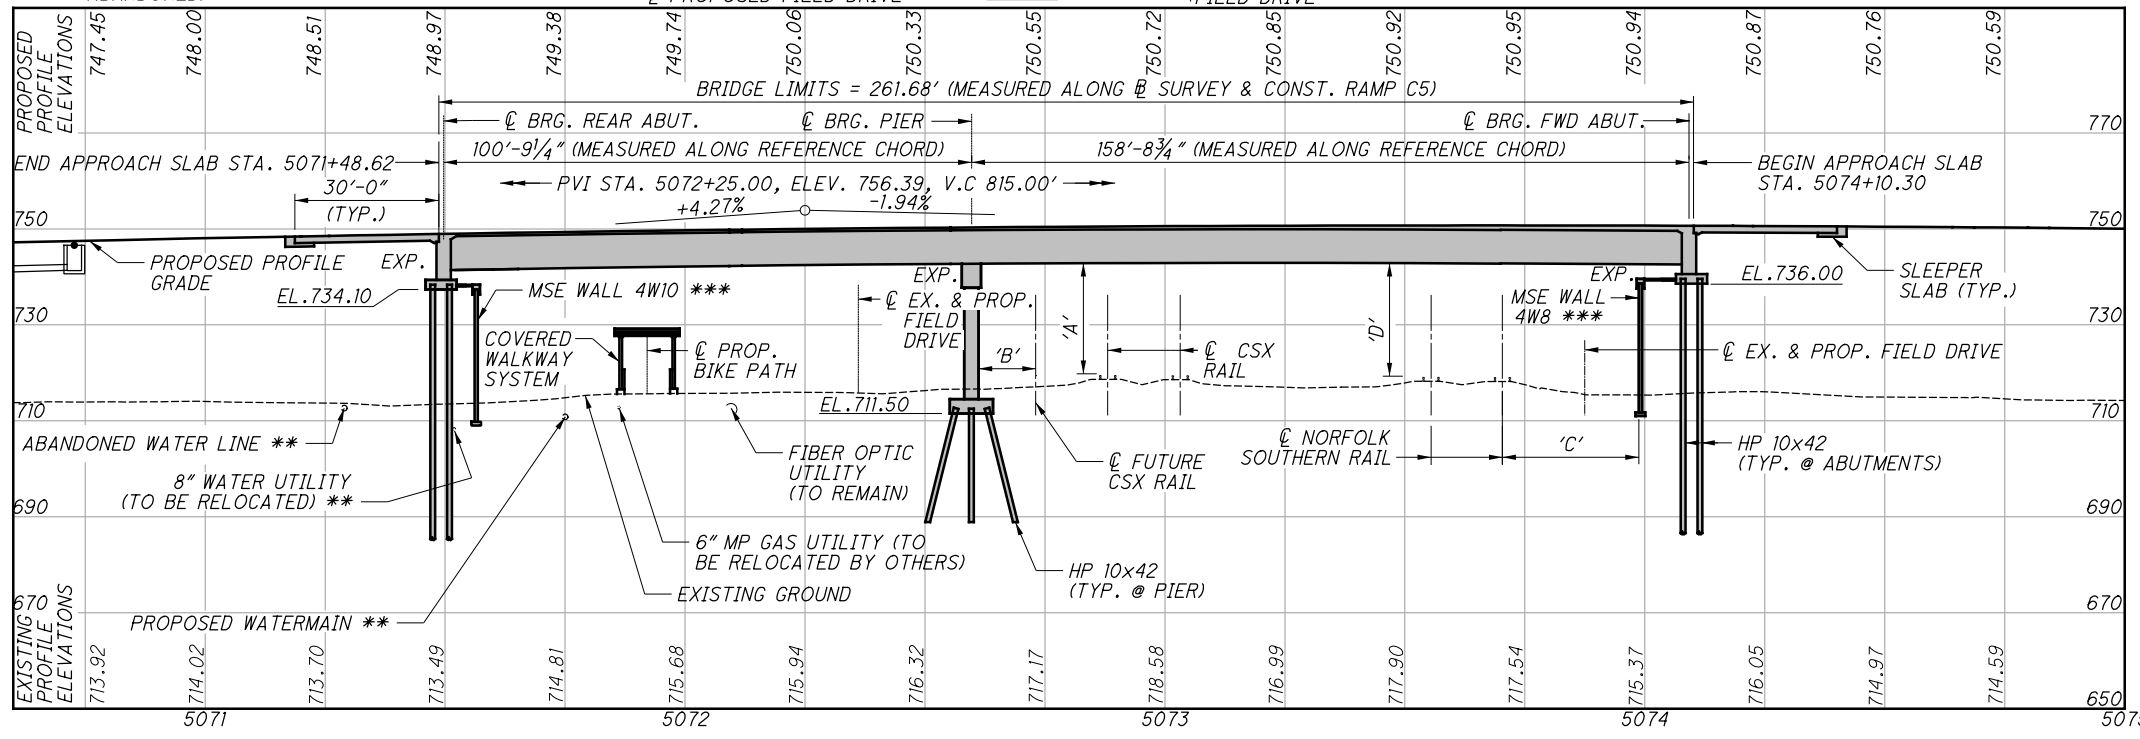

ESTIMATED PILE LENGTHS:
 REAR ABUTMENT: 90'
 PIER: 70'
 FORWARD ABUTMENT: 100'

PROFILE ALONG B SURVEY & CONSTRUCTION RAMP C5

NUMBER	DESCRIPTION	REVISED BY	DATE
4	ADDED TEMPORARY SHORING TS4A	CAS	11-29-2021

3486-E

BURGESS & NIPLE
 Engineers & Architects & Planners
 5085 REED ROAD, COLUMBUS, OHIO 43220


DATE: 10/18/18
 REVIEWED: CAS
 DRAWN: MAK
 DESIGNED: MAK
 CHECKED: JHL

FRANKLIN COUNTY
 STA. 5071+48.62
 STA. 5074+10.30


SITE PLAN
 BRIDGE NO. FRA-70-1358A
 RAMP C5 OVER CSX AND NS RAILROAD

FRA-70/71-12.68/
 14.86 (PROJ. 4R)
 PID No. 103523
 1/36
 1472
 1815

P:\PR51781\fra\77372\structures\FRA070_1358A\Stage_2\Sheets\070_1358AGP001.dgn 11/24/2021 9:31:32 AM albey

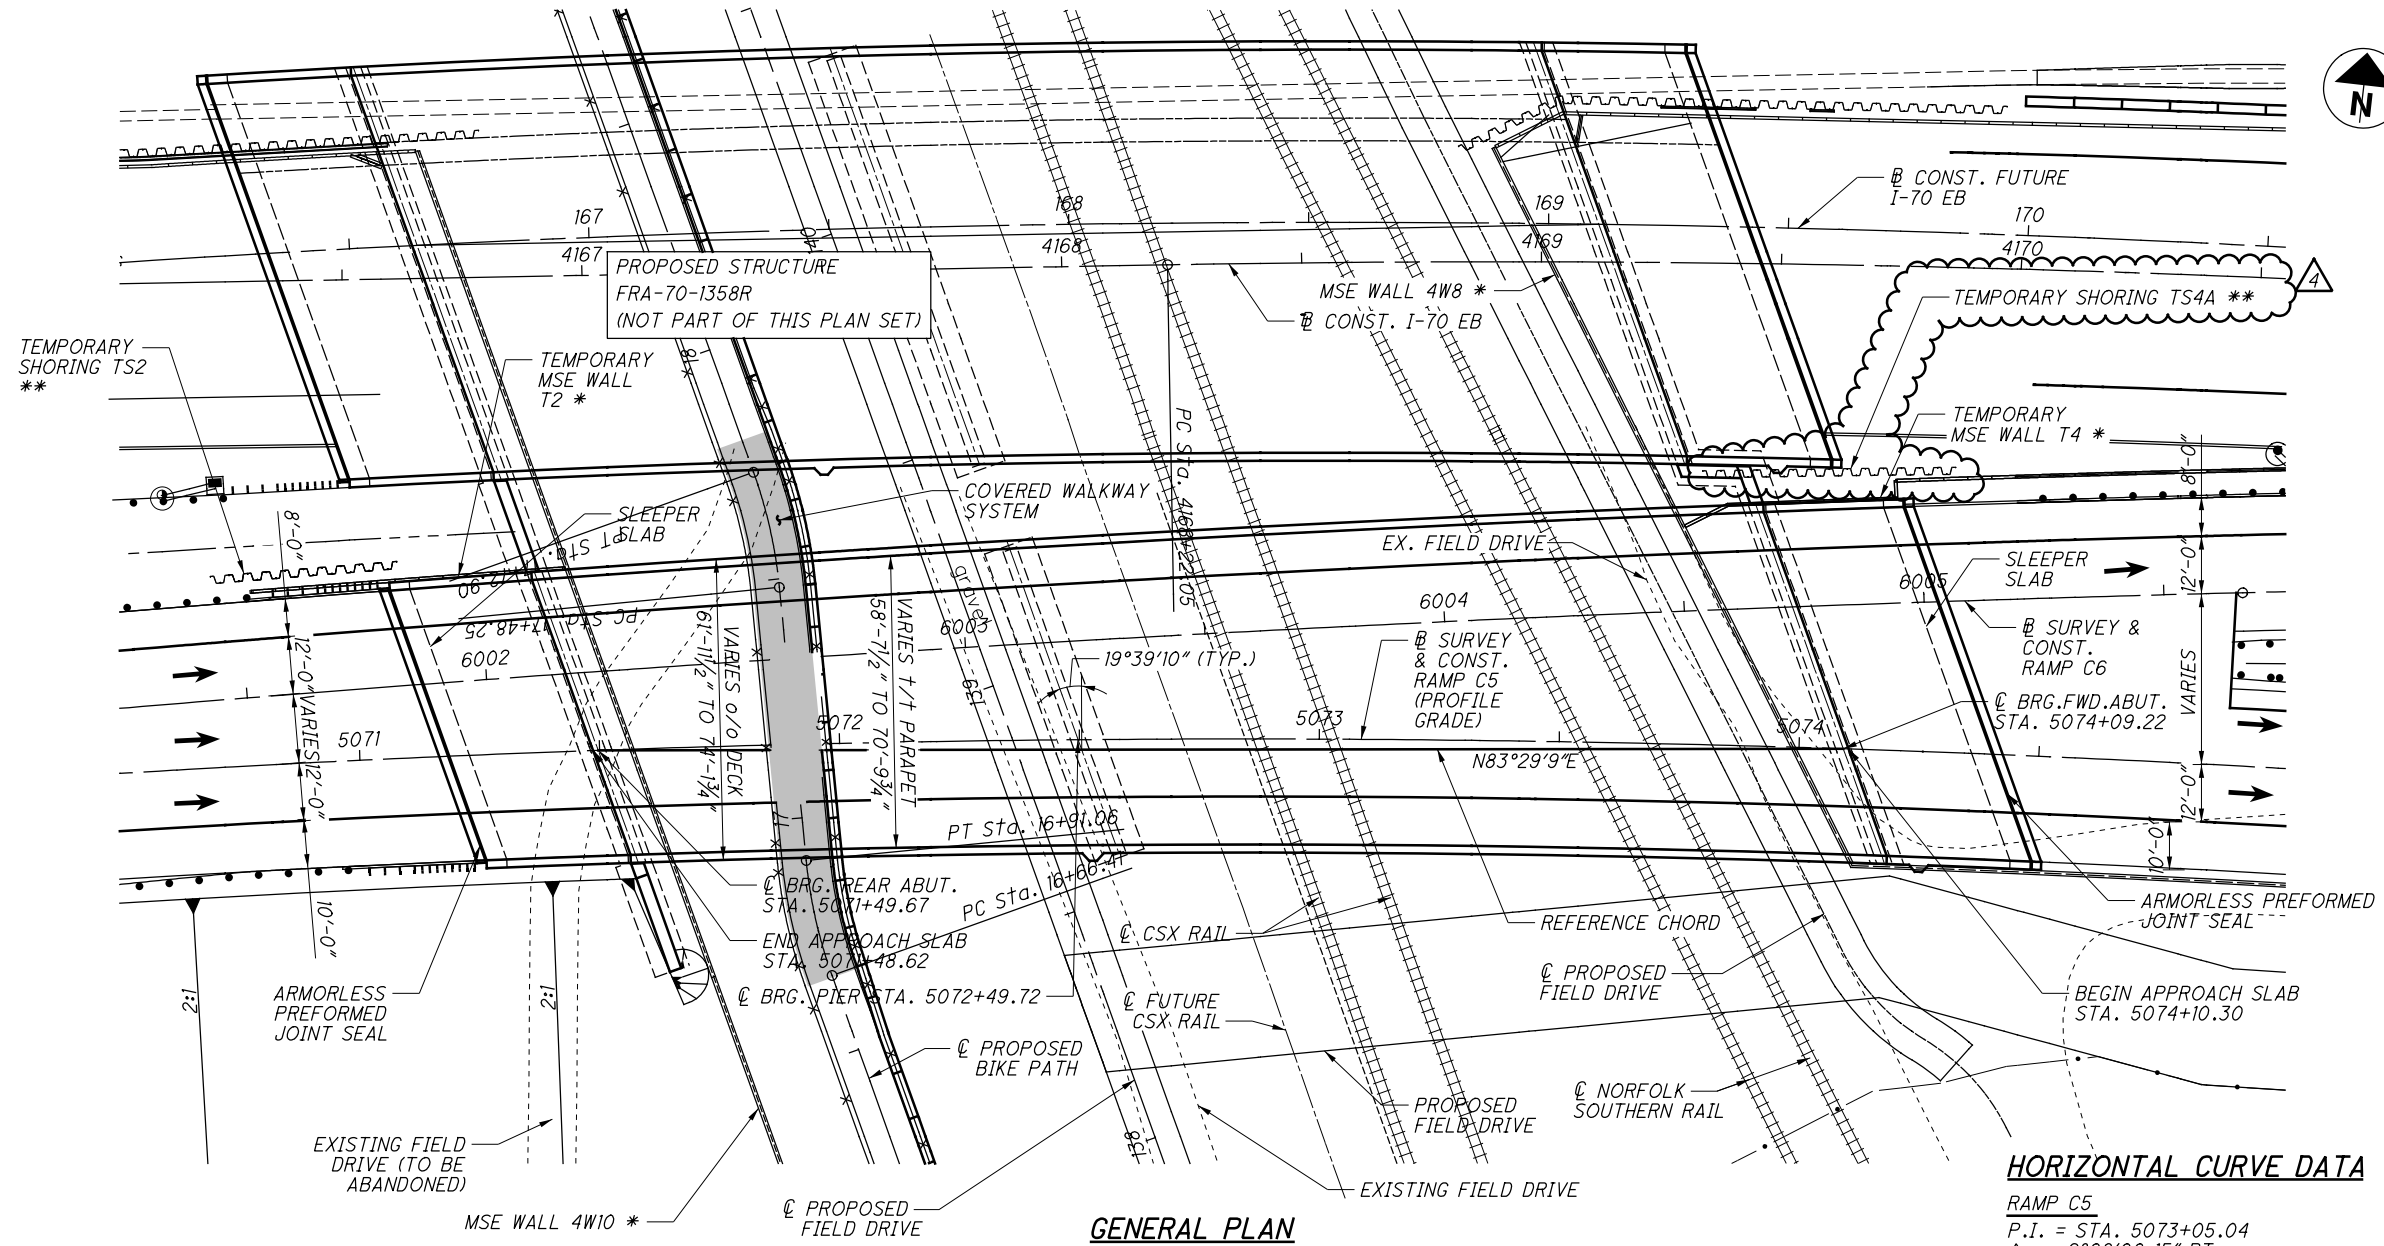

GENERAL PLAN

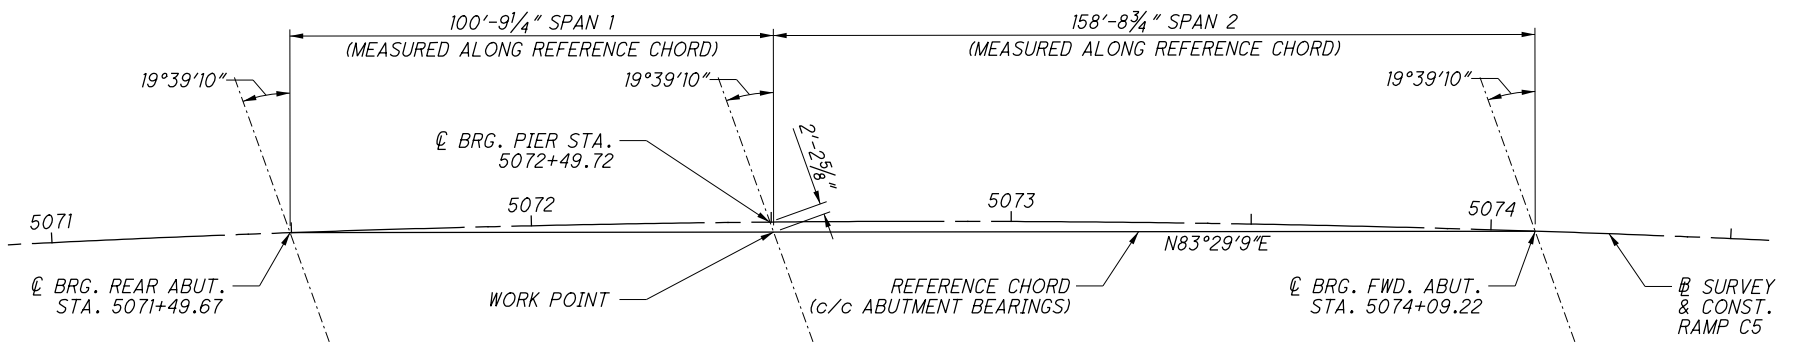

LAYOUT DIAGRAM

HORIZONTAL CURVE DATA

RAMP C5
 P.I. = STA. 5073+05.04
 $\Delta = 9^{\circ}08'00.15''$ RT
 $D_c = 1^{\circ}30'00''$
 $R = 3,819.72'$
 $T = 305.09'$
 $L = 608.89'$
 $E = 12.16'$

RAMP C6
 P.I. = STA. 6002+94.69
 $\Delta = 4^{\circ}25'05.22''$ RT
 $D_c = 0^{\circ}45'00''$
 $R = 7,639.44'$
 $T = 294.69'$
 $L = 589.02'$
 $E = 5.68'$

LEGEND

ABUT. = ABUTMENT
 BRG. = BEARING
 CONST. = CONSTRUCTION
 FWD. = FORWARD

* = SEE MSE WALL PLANS FOR DETAILS AND PAYMENT
 ** = SEE TEMPORARY SHORING PLANS FOR DETAILS AND PAYMENT

NUMBER	DESCRIPTION	REVISED BY	DATE
4	ADDED TEMPORARY SHORING TS4A	CAS	11-29-2021

P:\PR51781\fr077372\structures\FRA070_1358A\Stage 2\Sheets\070_1358AEQ001.dgn 11/22/2021 8:39:47 AM allbey

ESTIMATED QUANTITIES

ITEM	ITEM EXT.	TOTAL	PARTICIPATION 02/NHS/BR	UNIT	DESCRIPTION	ABUTS.	CALC'D	DATE	CHK'D	DATE
							MAK	12/10/2014	JHL	12/12/2014
						PIERS	SUPER	GENERAL	SHEET REF.	
202	11201	LS	LS	4	PORTIONS OF STRUCTURE REMOVED, AS PER PLAN					3 / 36
503	21100	132	132	CY	UNCLASSIFIED EXCAVATION					
505	11100	LS	LS		PILE DRIVING EQUIPMENT MOBILIZATION			132		
507	00100	5,795	5,795	FT	STEEL PILES HPI0X42, FURNISHED	3,695		2,100		
507	00150	5,470	5,470	FT	STEEL PILES HPI0X42, DRIVEN	3,510		1,960		
507	93300	65	65	EACH	STEEL POINTS OR SHOES	37		28		
509	10001	220,342	220,342	LB	EPOXY COATED REINFORCING STEEL, AS PER PLAN	20,594		22,644	177,104	3 / 36
511	21523	676	676	CY	CLASS QC2 CONCRETE WITH QC/QA, SUPERSTRUCTURE, AS PER PLAN			676		3 / 36
511	33500	2	2	EACH	SEMI-INTEGRAL DIAPHRAGM GUIDE	2				
511	34450	79	79	CY	CLASS QC2 CONCRETE WITH QC/QA, BRIDGE DECK (PARAPET)			79		
511	40512	214	214	CY	CLASS QC1 CONCRETE WITH QC/QA, PIER ABOVE FOOTINGS			214		
511	44112	86	86	CY	CLASS QC1 CONCRETE WITH QC/QA, ABUTMENT NOT INCLUDING FOOTING	86				
511	46512	206	206	CY	CLASS QC1 CONCRETE WITH QC/QA, FOOTING	125		81		
512	10100	1,353	1,353	SY	SEALING OF CONCRETE SURFACES (EPOXY-URETHANE)	258		432	558	105
513	10280	598,100	598,100	LB	STRUCTURAL STEEL MEMBERS, LEVEL 4			598,100		
513	20000	4,386	4,386	EACH	WELDED STUD SHEAR CONNECTORS			4,386		
516	10010	141	141	FT	ARMORLESS PREFORMED JOINT SEAL				141	
516	13900	34	34	SF	2" PREFORMED EXPANSION JOINT FILLER			34		
516	14020	170	170	FT	SEMI-INTEGRAL ABUTMENT EXPANSION JOINT SEAL	170				
516	44201	7	7	EACH	ELASTOMERIC BEARING WITH INTERNAL LAMINATES AND LOAD PLATE (NEOPRENE), AS PER PLAN (BEARING: 25"x21"x3 7/8")			7		29 / 36
516	44201	7	7	EACH	ELASTOMERIC BEARING WITH INTERNAL LAMINATES AND LOAD PLATE (NEOPRENE), AS PER PLAN (BEARING: 15"x12"x3 3/4")	7				29 / 36
516	44201	7	7	EACH	ELASTOMERIC BEARING WITH INTERNAL LAMINATES AND LOAD PLATE (NEOPRENE), AS PER PLAN (BEARING: 18"x16"x3 3/4")	7				29 / 36
518	21200	127	127	CY	POROUS BACKFILL WITH GEOTEXTILE FABRIC	127				
518	40000	170	170	FT	6" PERFORATED CORRUGATED PLASTIC PIPE				170	
526	30011	453	453	SY	REINFORCED CONCRETE APPROACH SLABS WITH QC/QA (T=17"), AS PER PLAN				453	3, 30-32/36
526	90030	140	140	FT	TYPE C INSTALLATION				140	
SPECIAL	6074000	519	519	FT	VANDAL PROTECTION FENCE: 6 FT STRAIGHT, COATED FABRIC				519	26 & 27/36
SPECIAL	69098100	114	114	FT	COVERED WALKWAY SYSTEM				114	3 / 36

NUMBER	DESCRIPTION	REVISED BY	DATE
4	FUNDING PARTICIPATION CHANGE	CAS	11-29-2021

BURGESS & NIPL
 Engineers Architects Planners
 5085 REED ROAD, COLUMBUS, OHIO 43220

DATE: 10/18/18
 REVIEWED: CAS
 DRAWN: AAA
 DESIGNED: MAK
 CHECKED: BLS

ESTIMATED QUANTITIES
 BRIDGE NO. FRA-70-1358A
 RAMP C5 OVER CSX AND NS RAILROAD

FRA-70/71-12.68 /
 14.86 (PROJ. 4R)
 PID No. 105523

5 / 36

1476
 1815

P:\PR51781\fra\77372\structures\FRA070_1373R\Sigs 2\Sheets\070_1373REQ001.dgn 11/24/2021 10:20:48 AM albey

ESTIMATED QUANTITIES

ITEM	ITEM EXT.	UNIT	DESCRIPTION	ABUTMENTS	SUPERSTR.	GENERAL	TOTAL	CALC.	DATE	CHK'D	DATE
								JHL	6/2/2015	JDH	6/2/2015
202	11203		PORTIONS OF STRUCTURE REMOVED, OVER 20 FOOT SPAN, AS PER PLAN				LS				
202	22900	SY	APPROACH SLAB REMOVED			323	323	LS	6/2/2015	LS	3 & 4 / 31
202	23500	SY	WEARING COURSE REMOVED			367	986	LS	6/2/2015	LS	
505	11100		PILE DRIVING EQUIPMENT MOBILIZATION				LS				
507	00100	FT	STEEL PILES HP10X42, FURNISHED	4,390			4,390	LS	6/2/2015	LS	
507	00150	FT	STEEL PILES HP10X42, DRIVEN	4,165			4,165	LS	6/2/2015	LS	
507	92201	FT	PREBORED HOLES, AS PER PLAN	92			92	LS	6/2/2015	LS	3 / 31
507	93300	EACH	STEEL POINTS OR SHOES	45			45	LS	6/2/2015	LS	
509	10001	LB	EPOXY COATED REINFORCING STEEL, AS PER PLAN	32,020	93,877		125,897	LS	6/2/2015	LS	3 / 31
511	21523	CY	CLASS QC2 CONCRETE WITH QC/QA, SUPERSTRUCTURE, AS PER PLAN		501		501	LS	6/2/2015	LS	3 / 31
511	33500	EACH	SEMI-INTEGRAL DIAPHRAGM GUIDE	2			2	LS	6/2/2015	LS	
511	34450	CY	CLASS QC2 CONCRETE WITH QC/QA, BRIDGE DECK (PARAPET)		29		29	LS	6/2/2015	LS	
511	44112	CY	CLASS QC1 CONCRETE WITH QC/QA, ABUTMENT NOT INCLUDING FOOTING	192			192	LS	6/2/2015	LS	
511	46512	CY	CLASS QC1 CONCRETE WITH QC/QA, FOOTING	158			158	LS	6/2/2015	LS	
512	10100	SY	SEALING OF CONCRETE SURFACES (EPOXY-URETHANE)	343	405	105	853	LS	6/2/2015	LS	
512	33000	SY	TYPE 2 WATERPROOFING	3	8		11	LS	6/2/2015	LS	
515	15030	EACH	DRAPED STRAND PRESTRESSED CONCRETE BRIDGE I-BEAM MEMBERS, LEVEL 3, TYPE 4 MOD. (60 IN.) (91'-10" BEAM LENGTH)		9		9	LS	6/2/2015	LS	
515	20001	EACH	INTERMEDIATE DIAPHRAGMS, AS PER PLAN		24		24	LS	6/2/2015	LS	16 / 31
516	10010	FT	ARMORLESS PREFORMED JOINT SEAL			204	204	LS	6/2/2015	LS	
516	13900	SF	2" PREFORMED EXPANSION JOINT FILLER		167		167	LS	6/2/2015	LS	
516	14020	FT	SEMI-INTEGRAL ABUTMENT EXPANSION JOINT SEAL	234			234	LS	6/2/2015	LS	
516	44201	EACH	ELASTOMERIC BEARING WITH INTERNAL STEEL LAMINATES AND LOAD PLATE (NEOPRENE), AS PER PLAN (BEARING: 1'-6" x 1'-4" x 3/8". LOAD PLATE: 1'-7" x 1'-5" x 2")		18		18	LS	6/2/2015	LS	26 / 31
518	21200	CY	POROUS BACKFILL WITH GEOTEXTILE FABRIC	164			164	LS	6/2/2015	LS	
518	40000	FT	6" PERFORATED CORRUGATED PLASTIC PIPE	192			192	LS	6/2/2015	LS	
526	30011	SY	REINFORCED CONCRETE APPROACH SLABS WITH QC/QA (T=17"), AS PER PLAN			655	655	LS	6/2/2015	LS	4 / 31
526	90030	FT	TYPE C INSTALLATION			204	204	LS	6/2/2015	LS	

GENERAL NOTES (CONTINUED):

ITEM 526 - REINFORCED CONCRETE APPROACH SLABS WITH QC/QA (T=17"), AS PER PLAN: THE REQUIREMENTS OF 511.03 AND 511.04 SHALL APPLY TO THIS ITEM OF WORK. THIS ITEM SHALL INCLUDE, BUT IS NOT LIMITED TO THE CONCRETE, REINFORCING STEEL, PEJF, GFRP BARS, AND HMWM SEALER NECESSARY TO FORM AND PLACE THE APPROACH SLABS AND CONCRETE PARAPETS ON THE APPROACH SLABS, AS SHOWN IN THE PLANS. PAYMENT FOR THIS ITEM SHALL ALSO INCLUDE THE ITEMS LISTED ON STANDARD DRAWING AS-1-15 AND ALL OTHER NECESSARY MATERIALS, LABOR, AND EQUIPMENT AND SHALL BE INCLUDED IN THE UNIT PRICE BID PER SQUARE YARD FOR ITEM 526 REINFORCED CONCRETE APPROACH SLABS WITH QC/QA (T=17"), AS PER PLAN.

DECK PLACEMENT DESIGN ASSUMPTIONS:

THE FOLLOWING ASSUMPTIONS OF CONSTRUCTION MEANS AND METHODS WERE MADE FOR THE ANALYSIS AND DESIGN OF THE SUPERSTRUCTURE. THE CONTRACTOR IS RESPONSIBLE FOR THE DESIGN OF THE FALSEWORK SUPPORT SYSTEM WITHIN THESE PARAMETERS AND WILL ASSUME RESPONSIBILITY FOR SUPERSTRUCTURE ANALYSIS FOR DEVIATION FROM THESE DESIGN ASSUMPTIONS.

AN EIGHT WHEEL FINISHING MACHINE WITH A MAXIMUM WHEEL LOAD OF 2.51 KIPS. A MINIMUM OUT-TO-OUT WHEEL SPACING AT EACH END OF THE MACHINE OF 103 INCHES. A MAXIMUM SPACING OF OVERHANG FALSEWORK BRACKETS OF 48 INCHES. A MAXIMUM DISTANCE FROM THE CENTERLINE OF THE FASCIA GIRDER TO THE FACE OF THE SAFETY HANDRAIL OF 65 INCHES.

ASBESTOS SURVEY:

AN ASBESTOS SURVEY FOR THE BRIDGE STRUCTURE SCHEDULED FOR DEMOLITION WORK WAS CONDUCTED BY A LICENSED ASBESTOS HAZARD EVALUATION SPECIALIST. THE ASBESTOS INSPECTION REPORT DID NOT IDENTIFY THE PRESENCE OF ANY ASBESTOS CONTAINING MATERIALS ABOVE REGULATORY LIMITS. A COPY OF THE ASBESTOS INSPECTION REPORT FOR THE STRUCTURE IS INCLUDED IN THE PLAN PACKAGE FOR THIS PROJECT.

ELECTRONIC SUBMISSION:

SUBMIT A COMPLETED ELECTRONIC NOTIFICATION OF DEMOLITION AND RENOVATION FORM (NDRF), APPLICABLE FEES, AND THE ASBESTOS INSPECTION REPORT TO THE OEPA AT LEAST 10 DAYS PRIOR TO ANY DEMOLITION ACTIVITY, RENOVATION ACTIVITY, OR BOTH. SUBMIT THE NDRF AND PAYMENT ALONG WITH THE ASBESTOS INSPECTION REPORT USING THE OEPA EBUSINESS CENTER. SUBMIT ONE ELECTRONIC PDF COPY AND ONE HARD COPY OF THE NDRF TO THE ENGINEER. THE ENGINEER WILL PROVIDE ONE COPY TO THE DISTRICT ENVIRONMENTAL STAFF.

HARD COPY SUBMISSION:

THE CONTRACTOR MAY SUBMIT A HARD COPY OF THE COMPLETED NDRF AND PAYMENT ALONG WITH THE ASBESTOS INSPECTION REPORT. FOLLOW THE MAILING INSTRUCTIONS ON THE NDRF. CHECK WITH LOCAL HEALTH DEPARTMENT, COLUMBUS PUBLIC HEALTH, 240 PARSONS AVE., COLUMBUS, OHIO 43215, (614) 645-7005, TO DETERMINE IF THEY REQUIRE A HARD COPY SUBMITTAL.

SUBMIT THE COMPLETED NDRF TO OEPA AT LEAST 10 DAYS PRIOR TO DEMOLITION ACTIVITY, RENOVATION ACTIVITY, OR BOTH. RETAIN TWO HARD COPIES OF THE NDRF AND SUBMIT ONE COPY TO THE ENGINEER AND EMAIL ONE COPY TO THE ODOT DISTRICT ENVIRONMENTAL COORDINATOR AT: janice.garntner@dot.ohio.gov.

BASIS OF PAYMENT:

THE CONTRACTOR SHALL FURNISH ALL FEES, LABOR, AND MATERIALS NECESSARY TO COMPLETE AND SUBMIT THE OEPA NOTIFICATION FORM. PAYMENT FOR THIS WORK SHALL BE INCLUDED IN ITEM 202 - PORTIONS OF STRUCTURE REMOVED, OVER 20 FOOT SPAN, AS PER PLAN.

STANDARD ABBREVIATIONS:

ABUT. = ABUTMENT
 BOT. = BOTTOM
 BRG. = BEARINGS
 C/C = CENTER-TO-CENTER
 CIP = CAST-IN-PLACE
 C.J. = CONSTRUCTION JOINT
 CLR. = CLEAR
 CMS = CONSTRUCTION AND MATERIAL SPECIFICATIONS
 CONST. = CONSTRUCTION
 C.P.P. = CORRUGATED PLASTIC PIPE
 DIA. = DIAMETER
 DIM. = DIMENSION
 DWG. = DRAWING
 E.F. = EACH FACE
 EB = EASTBOUND
 EL. = ELEVATION
 EQ. = EQUAL
 EXP. = EXPANSION
 F.A. = FORWARD ABUTMENT
 F.F. = FAR FACE
 FWD. = FORWARD
 GFRP = GLASS FIBER REINFORCED POLYMER
 HMWM = HIGH MOLECULAR WEIGHT METHACRYLATE
 LT. = LEFT
 M.C. = MECHANICAL CONNECTOR
 MAX. = MAXIMUM
 MGS = MIDWEST GUARDRAIL SYSTEM
 MID. = MIDDLE
 MIN. = MINIMUM
 MSE = MECHANICALLY STABILIZED EARTH
 N.F. = NEAR FACE
 O/O = OUT-TO-OUT
 PEJF = PREFORMED EXPANSION JOINT FILLER
 R.A. = REAR ABUTMENT
 RT. = RIGHT
 S.O. = SERIES OF
 SPA. = SPACES
 STA. = STATION
 STD. = STANDARD
 T&B = TOP & BOTTOM
 T/T = TOE-TO-TOE
 TYP. = TYPICAL
 U.N.O. = UNLESS NOTED OTHERWISE

NUMBER	DESCRIPTION	REVISED BY	DATE
4	- FUNDING PARTICIPATION CHANGE - ADDED ASBESTOS NOTE	CAS	11-29-2021

BURGESS & NIPL
 Engineers Architects Planners
 5085 REED ROAD, COLUMBUS, OHIO 43220

DATE: 10/18/18
 REVISED: CAS
 DRAWN: AAA
 DESIGNED: TTK
 STRUCTURE FILE NUMBER: 2510020

GENERAL NOTES AND ESTIMATED QUANTITIES
 FRA-70-1373R
 I-70 EB OVER SHORT STREET

FRA-70/71-12.68 / 14.86 (PROJ. 4R)
 PID No. 105523

4 / 31

1511 / 1815

ESTIMATED QUANTITIES

ITEM	ITEM EXT.	UNIT	DESCRIPTION	ABUTMENTS	SUPERSTR.	CALC'D	DATE	CHK'D	DATE
						ABP	7/27/2015	JDH	7/30/2015
						GENERAL	TOTAL	PARTICIPATION 02/NHS/BR	SHT. REF.
505	11100		PILE DRIVING EQUIPMENT MOBILIZATION				LS	LS	
507	00100	FT	STEEL PILES HPI0X42, FURNISHED	2,155			2,155	2,155	
507	00150	FT	STEEL PILES HPI0X42, DRIVEN	2,050			2,050	2,050	
507	93300	EACH	STEEL POINTS OR SHOES	21			21	21	
509	10001	LB	EPOXY COATED REINFORCING STEEL, AS PER PLAN	12,564	42,810		55,374	55,374	3 / 25
511	21523	CY	CLASS QC2 CONCRETE WITH QC/QA, SUPERSTRUCTURE, AS PER PLAN		212		212	212	3 / 25
511	33500	EACH	SEMI-INTEGRAL DIAPHRAGM GUIDE	2			2	2	
511	34450	CY	CLASS QC2 CONCRETE WITH QC/QA, BRIDGE DECK (PARAPET)		29		29	29	
511	44112	CY	CLASS QC1 CONCRETE WITH QC/QA, ABUTMENT NOT INCLUDING FOOTING	66			66	66	
511	46512	CY	CLASS QC1 CONCRETE WITH QC/QA, FOOTING	70			70	70	
512	10100	SY	SEALING OF CONCRETE SURFACES (EPOXY-URETHANE)	124	404		528	528	
515	15030	EACH	DRAPED STRAND PRESTRESSED CONCRETE BRIDGE I-BEAM MEMBERS, LEVEL 3, TYPE 4 MOD. (60 IN.) (9'-2" BEAM LENGTH)		4		4	4	
515	20001	EACH	INTERMEDIATE DIAPHRAGMS, AS PER PLAN		9		9	9	11 / 25
516	10010	FT	ARMORLESS PREFORMED JOINT SEAL			85	85	85	
516	13900	SF	2" PREFORMED EXPANSION JOINT FILLER		167		167	167	
516	14020	FT	SEMI-INTEGRAL ABUTMENT EXPANSION JOINT SEAL	124			124	124	
516	44201	EACH	ELASTOMERIC BEARING WITH INTERNAL LAMINATES AND LOAD PLATE (NEOPRENE), AS PER PLAN (BEARING: 1'-6" x 1'-4" x 3 1/8", LOAD PLATE: 1'-7" x 1'-5" x 2")		8		8	8	21 / 25
518	21200	CY	POROUS BACKFILL WITH GEOTEXTILE FABRIC	63			63	63	
518	40000	FT	6" PERFORATED CORRUGATED PLASTIC PIPE	88			88	88	
526	30011	SY	REINFORCED CONCRETE APPROACH SLABS WITH QC/QA (T=17"), AS PER PLAN			276	276	276	3 / 25
526	90030	FT	TYPE C INSTALLATION			85	85	85	

STANDARD ABBREVIATIONS:

- | | |
|--|---|
| ABUT. = ABUTMENT | GFRP = GLASS FIBER REINFORCED POLYMER |
| BOT. = BOTTOM | LT. = LEFT |
| BRG. = BEARINGS | MAX. = MAXIMUM |
| c/c = CENTER-TO-CENTER | MID. = MIDDLE |
| CIP = CAST-IN-PLACE | MIN. = MINIMUM |
| C.J. = CONSTRUCTION JOINT | MSE = MECHANICALLY STABILIZED EARTH |
| CLR. = CLEAR | N.F. = NEAR FACE |
| CMS = CONSTRUCTION AND MATERIAL SPECIFICATIONS | o/o = OUT-TO-OUT |
| CONST. = CONSTRUCTION | PEJF = PREFORMED EXPANSION JOINT FILLER |
| C.P.P. = CORRUGATED PLASTIC PIPE | R.A. = REAR ABUTMENT |
| DIA. = DIAMETER | RT. = RIGHT |
| DIM. = DIMENSION | S.O. = SERIES OF |
| DWG. = DRAWING | SPA. = SPACES |
| E.F. = EACH FACE | STA. = STATION |
| EB = EASTBOUND | STD. = STANDARD |
| EL. = ELEVATION | T&B = TOP & BOTTOM |
| EQ. = EQUAL | †/† = TOE-TO-TOE |
| EXP. = EXPANSION | TYP. = TYPICAL |
| F.A. = FORWARD ABUTMENT | U.N.O. = UNLESS NOTED OTHERWISE |
| F.F. = FAR FACE | V.C. = VERTICAL CURVE |
| FWD. = FORWARD | |

NUMBER	DESCRIPTION	REVISED BY	DATE
4	FUNDING PARTICIPATION CHANGE	CAS	11-29-2021

BURGESS & NIPLÉ
Engineers - Architects - Planners
5085 REED ROAD, COLUMBUS, OHIO 43220

DATE: 10/18/18
REVIEWED: CAS
STRUCTURE FILE NUMBER: 2510019

DRAWN: JHL
DESIGNED: JHL
CHECKED: TTK

ESTIMATED QUANTITIES
FRA-70-1373A
RAMP C5 OVER SHORT STREET

FRA-70/71-12.68 /
14.86 (PROJ. 4R)
PID No. 105523

P:\PR51781\fr077372\structures\FRA070_1373A\Stage 2\Sheets\070_1373AE0001.dgn 11/22/2021 8:47:32 AM allbey

ESTIMATED QUANTITIES

CALCULATED: RFV DATE: 4/6/2018
 CHECKED: MLS DATE: 5/23/2019

ITEM	EXT.	TOTAL	PARTICIPATION	UNITS	DESCRIPTION	ABUT.	PIER	SUPER.	GENERAL	A.P.P. REFERENCE SHEET NO.
			02/NHS/BR							
503	11101	LS	LS		COFFERDAMS AND EXCAVATION BRACING, AS PER PLAN					1569
503	21100	7,708	7,708	CY	UNCLASSIFIED EXCAVATION	5,878	1,830			
509	10001	1,508,568	1,508,568	LB	EPOXY COATED REINFORCING STEEL, AS PER PLAN	571,149	388,043	474,768	74,608	1569
511	33418	871	871	CY	CLASS QC2 CONCRETE WITH QC/QA, SUPERSTRUCTURE	469	402			
511	33500	7	7	EACH	SEMI-INTEGRAL DIAPHRAGM GUIDE	7				
511	34446	1,097	1,097	CY	CLASS QC2 CONCRETE WITH QC/QA, BRIDGE DECK			1,097		
511	34450	139	139	CY	CLASS QC2 CONCRETE WITH QC/QA, BRIDGE DECK (PARAPET)			139		
511	41012	1,238	1,238	CY	CLASS QC1 CONCRETE WITH QC/QA, PIER ABOVE FOOTING		1,238			
511	44112	2,713	2,713	CY	CLASS QC1 CONCRETE WITH QC/QA, ABUTMENT NOT INCLUDING FOOTING	2,713				
511	46512	1,922	1,922	CY	CLASS QC1 CONCRETE WITH QC/QA, FOOTING	1,567	355			
512	10100	7,010	7,010	SY	SEALING OF CONCRETE SURFACES (EPOXY-URETHANE), LIGHT NEUTRAL	3,231	2,889	890		
512	10100	8,863	8,863	SY	SEALING OF CONCRETE SURFACES (EPOXY-URETHANE), BLACK			8,863		
512	33000	22	22	SY	TYPE 2 WATERPROOFING	22				
513	10200	3,250	3,250	LB	STRUCTURAL STEEL MEMBERS, LEVEL UF	3,250				
513	10220	135,978	135,978	LB	STRUCTURAL STEEL MEMBERS, LEVEL 1	135,978				
515	15110	45	45	EACH	DRAPED STRAND PRESTRESSED CONCRETE BRIDGE I-BEAM MEMBERS, LEVEL 3, WF60-49 (BEAM LENGTH VARIES 93'-1 1/2" TO 99'-2 3/8")			45		
515	20000	129	129	EACH	INTERMEDIATE DIAPHRAGMS			129		
516	11211	254	254	FT	STRUCTURAL EXPANSION JOINT INCLUDING ELASTOMERIC STRIP SEAL, AS PER PLAN (4")			254		1661
516	13600	2,057	2,057	SF	1" PREFORMED EXPANSION JOINT FILLER	304	1,823			
516	13900	1,040	1,040	SF	2" PREFORMED EXPANSION JOINT FILLER	674	366			
516	14020	23	23	FT	SEMI-INTEGRAL ABUTMENT EXPANSION JOINT SEAL	23				
516	44101	90	90	EACH	ELASTOMERIC BEARING WITH INTERNAL LAMINATES AND LOAD PLATE (NEOPRENE) (1'-1" x 1'-11" x 2.70"), AS PER PLAN	45	45			1628
518	12000	4	4	EACH	SCUPPERS, INCLUDING SUPPORTS			4		
518	21200	922	922	CY	POROUS BACKFILL WITH GEOTEXTILE FABRIC	922				
518	40000	835	835	FT	6" PERFORATED CORRUGATED PLASTIC PIPE	835				
518	40010	44	44	FT	6" NON-PERFORATED CORRUGATED PLASTIC PIPE, INCLUDING SPECIALS	44				
518	51100	35	35	FT	8" PIPE DOWNSPOUT, INCLUDING SPECIALS				35	
518	60030	272	272	FT	PIPE HORIZONTAL CONDUCTOR				272	
524	95442	234	234	FT	DRILLED SHAFTS, 42" DIAMETER, ABOVE BEDROCK WITH QC/QA	234				
524	95452	1,686	1,686	FT	DRILLED SHAFTS, 48" DIAMETER, ABOVE BEDROCK WITH QC/QA		1,686			
524	95472	3,751	3,751	FT	DRILLED SHAFTS, 60" DIAMETER, ABOVE BEDROCK WITH QC/QA, AS PER PLAN	3,751				1569
526	30011	661	661	SY	REINFORCED CONCRETE APPROACH SLABS WITH QC/QA (T=17"), AS PER PLAN				661	1668
526	90010	47	47	FT	TYPE A INSTALLATION				47	
SPECIAL	53013000	6,060	6,060	SF	SPECIAL - FORM LINER	4,830		1,230		1569
SPECIAL	53000600	1,200	1,200	SF	STRUCTURES: PRECAST FACADE PANELS	1,200				1570

DESIGN AGENCY
GPD GROUP
 Class, P.E., Schmeer, Burns & Dehaven, Inc.
 1801 Watermark Drive, Suite 150, Columbus, Ohio 43215 614.210.0731
 Copyright © Class, P.E., Schmeer, Burns & Dehaven, Inc. 2015

DATE: 9-6-19
 REVIEWED: DGN
 STRUCTURE FILE NUMBER: 2510021

DRAWN: MLS
 CHECKED: RHC
 REVISIONS: REVISED

ESTIMATED QUANTITIES
 BRIDGE NO. FRA-70-1390C
 RAMP C5 OVER I-70/71


FRA-70/71-12.68 / 14.86
 PID No. 105523

8 / 118

1571
 1815

NO.	DESCRIPTION	REV. BY	DATE
4	FUNDING CODE CHANGE/ADDED ITEM	CWL/RFV	11-29-2021

D:\2012\20120418\FRA\105523\STRUCTURES\FRA070_1390C\SHEETS\070_1390CE001.DGN
 11/29/2021 9:39:25 AM
 DDDTY81STD_USER

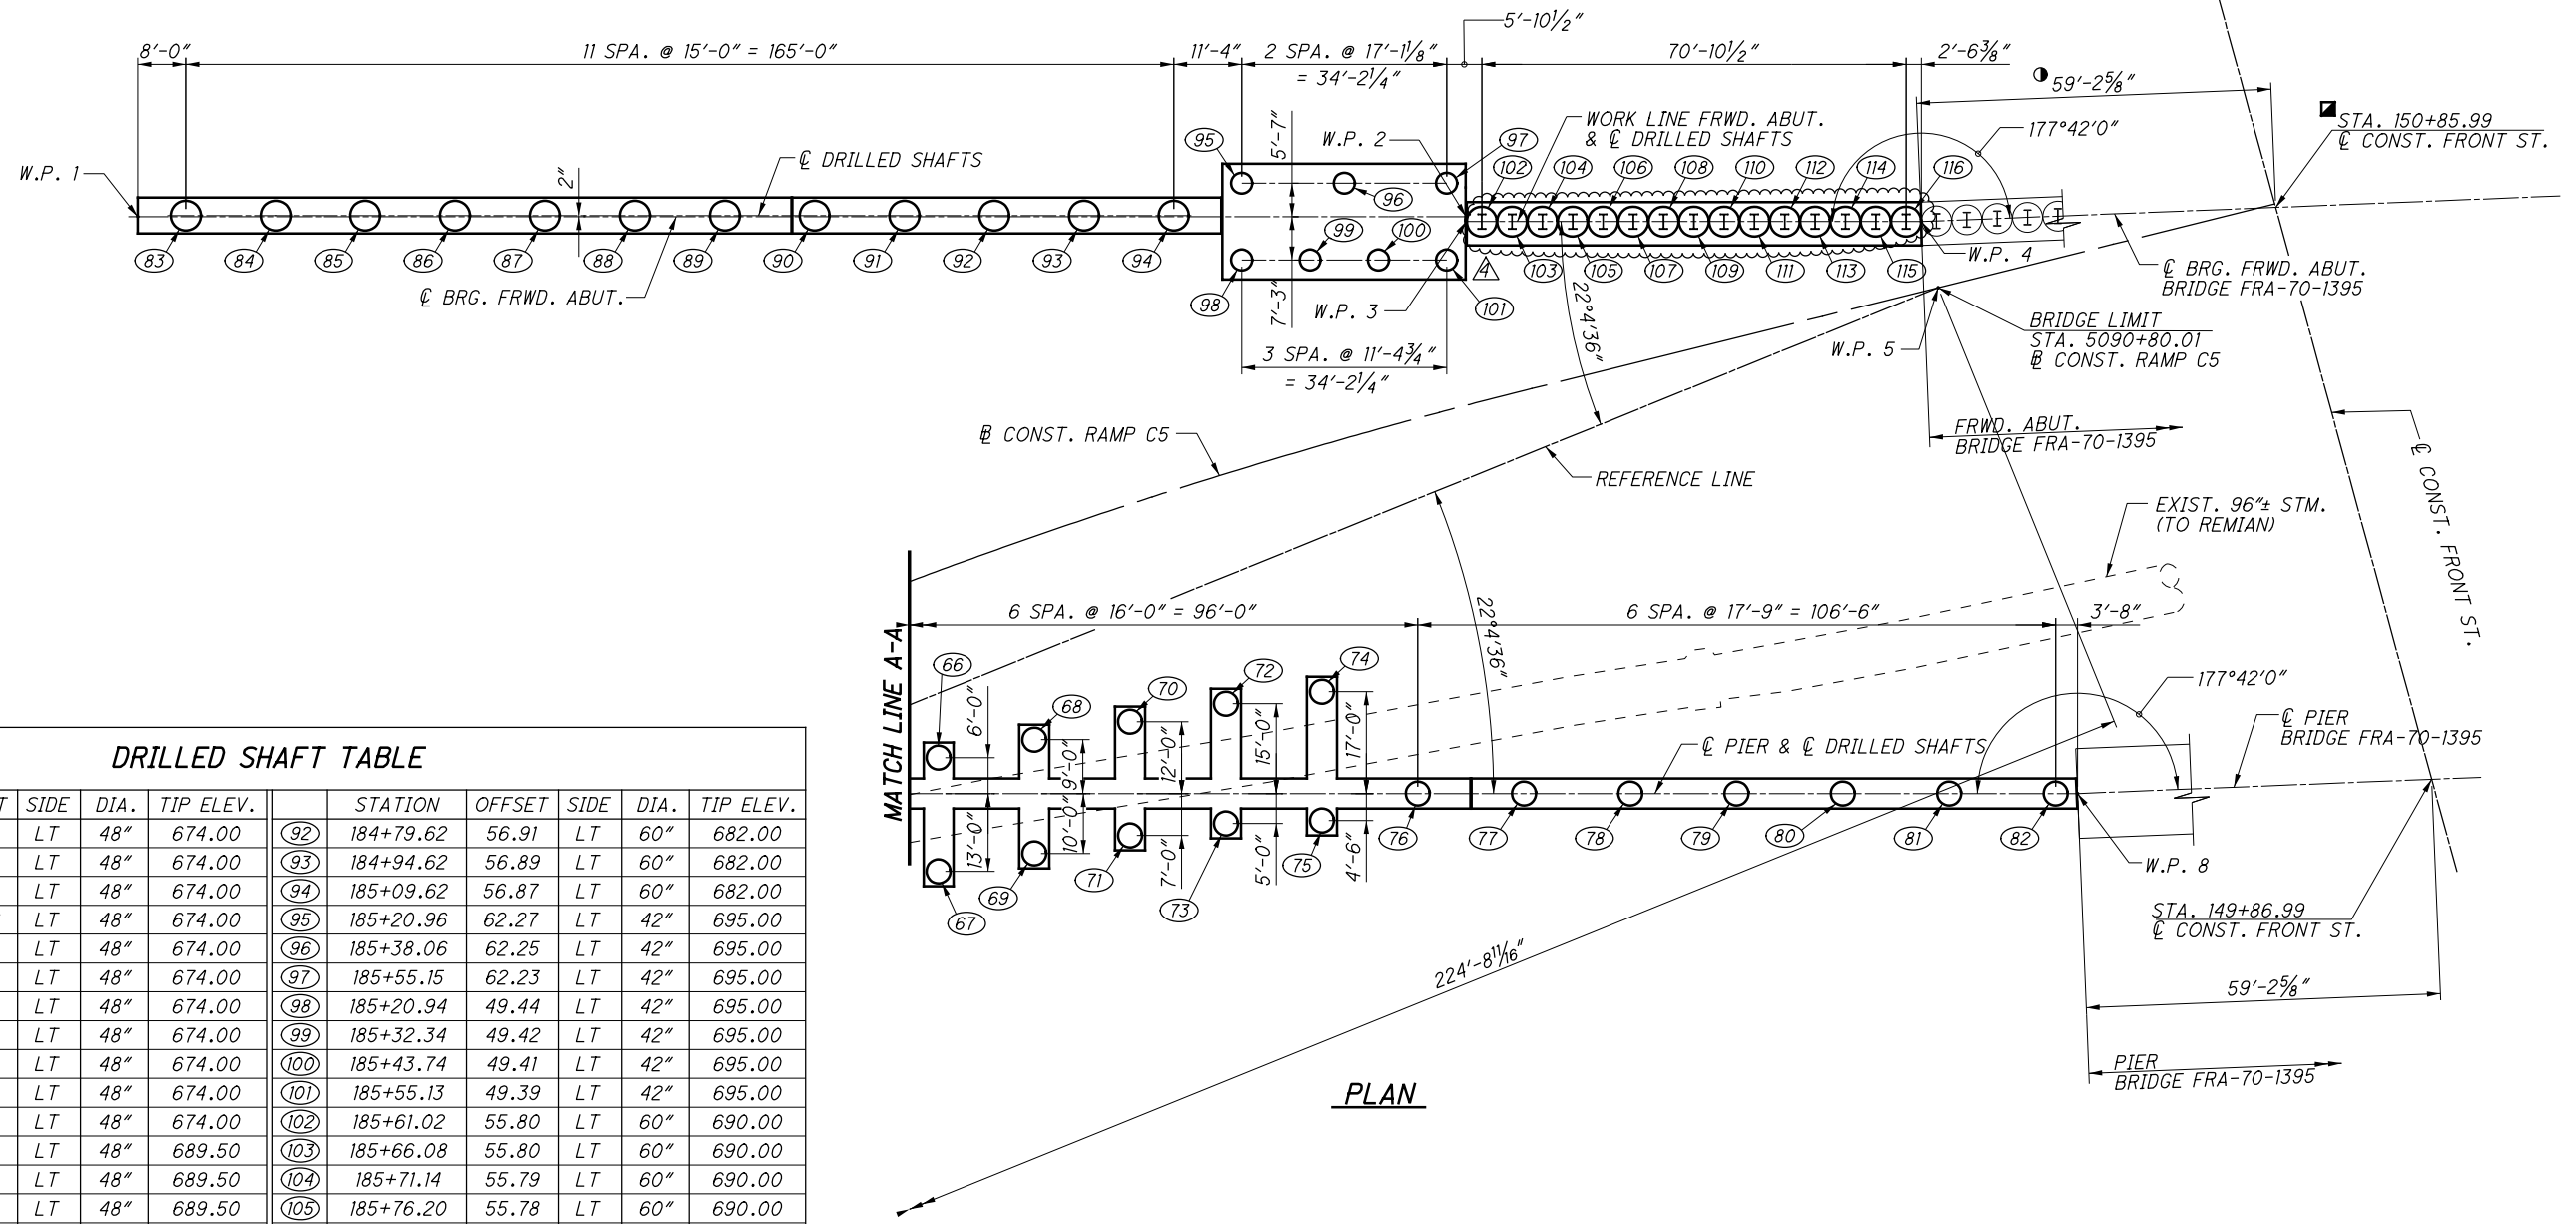

DRILLED SHAFT TABLE

STATION	OFFSET	SIDE	DIA.	TIP ELEV.	STATION	OFFSET	SIDE	DIA.	TIP ELEV.		
66	184+48.11	46.04	LT	48"	674.00	92	184+79.62	56.91	LT	60"	682.00
67	184+48.13	27.04	LT	48"	674.00	93	184+94.62	56.89	LT	60"	682.00
68	184+64.10	49.06	LT	48"	674.00	94	185+09.62	56.87	LT	60"	682.00
69	184+64.13	30.06	LT	48"	674.00	95	185+20.96	62.27	LT	42"	695.00
70	184+80.10	52.08	LT	48"	674.00	96	185+38.06	62.25	LT	42"	695.00
71	184+80.12	33.08	LT	48"	674.00	97	185+55.15	62.23	LT	42"	695.00
72	184+96.09	55.10	LT	48"	674.00	98	185+20.94	49.44	LT	42"	695.00
73	184+96.12	35.10	LT	48"	674.00	99	185+32.34	49.42	LT	42"	695.00
74	185+12.09	57.12	LT	48"	674.00	100	185+43.74	49.41	LT	42"	695.00
75	185+12.12	35.62	LT	48"	674.00	101	185+55.13	49.39	LT	42"	695.00
76	185+28.11	40.14	LT	48"	674.00	102	185+61.02	55.80	LT	60"	690.00
77	185+45.86	40.16	LT	48"	689.50	103	185+66.08	55.80	LT	60"	690.00
78	185+63.61	40.18	LT	48"	689.50	104	185+71.14	55.79	LT	60"	690.00
79	185+81.36	40.20	LT	48"	689.50	105	185+76.20	55.78	LT	60"	690.00
80	185+99.21	40.22	LT	48"	689.50	106	185+81.27	55.78	LT	60"	690.00
81	186+17.21	40.14	LT	48"	689.50	107	185+86.33	55.77	LT	60"	690.00
82	186+35.20	39.96	LT	48"	689.50	108	185+91.39	55.76	LT	60"	690.00
83	183+44.62	57.09	LT	60"	682.00	109	185+96.45	55.76	LT	60"	690.00
84	183+59.62	57.07	LT	60"	682.00	110	186+01.52	55.75	LT	60"	690.00
85	183+74.62	57.05	LT	60"	682.00	111	186+06.58	55.74	LT	60"	690.00
86	183+89.62	57.03	LT	60"	682.00	112	186+11.64	55.74	LT	60"	690.00
87	184+04.62	57.01	LT	60"	682.00	113	186+16.70	55.73	LT	60"	690.00
88	184+19.62	56.99	LT	60"	682.00	114	186+21.77	55.72	LT	60"	690.00
89	184+34.62	56.97	LT	60"	682.00	115	186+26.93	55.71	LT	60"	690.00
90	184+49.62	56.95	LT	60"	682.00	116	186+32.09	55.69	LT	60"	690.00
91	184+64.62	56.93	LT	60"	682.00						

NOTE: STATIONS AND OFFSETS FOR DRILLED SHAFT NOS. (1) TO (82) GIVEN TO CONST. FUTURE I-70 EB STATIONS AND OFFSETS FOR DRILLED SHAFT NOS. (83) TO (116) GIVEN TO CONST. I-70 WB

LEGEND:

- INDICATES MEASURED FROM W.P. 4 TO INTERSECTION OF CONST. FRONT ST. AND BRG. FRWD. ABUT. BRIDGE FRA-70-1395
- INDICATES STATION GIVEN AT INTERSECTION OF CONST. FRONT ST. AND BRG. FRWD. ABUT. BRIDGE FRA-70-1395

NOTES:

1. FOR MATCHLINE A-A, SEE SHT. NO. 14/118.
2. FOR GEOMETRY PLAN, SEE SHT. NO. 5/118.

NO.	DESCRIPTION	REV. BY	DATE
4	ADDED STEEL IN DRILLED SHAFTS	RFV	11-29-2021

01-2012-2012048 VFR-105523 STRUCTURES FRA70-1390C SHEETS 076-1390C.FP001.DGN
 11/27/2021 2:22:03 PM 0001Y81STD.LUSER




DESIGN AGENCY
GPD GROUP
Class, P.E., Scheme, Burns & McDonnell, Inc.
 1801 Watermark Drive, Suite 130, Columbus, Ohio 43215 614-210-0731
 Copyright © Class, P.E., Scheme, Burns & McDonnell, Inc. 2015

DESIGNED	DGN	CHECKED	MOJ
DRAWN	RFR	REVISED	
REVIEWED	RHC	DATE	9-6-19
STRUCTURE FILE NUMBER		2510021	


DRILLED SHAFT PLAN - 2
 BRIDGE NO. FRA-70-1390C
 RAMP C5 OVER I-70/71

15 / 118
 1578
 1815

01-2812-2812048 VFR1\105523\STRUCTURES\FRA70_1390C\SHEETS\070_1390C\F003.DGN
 11/27/2021 2:31:50 PM DDDTY81STD_USER

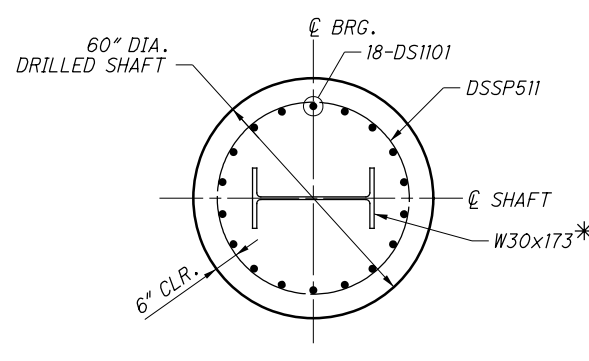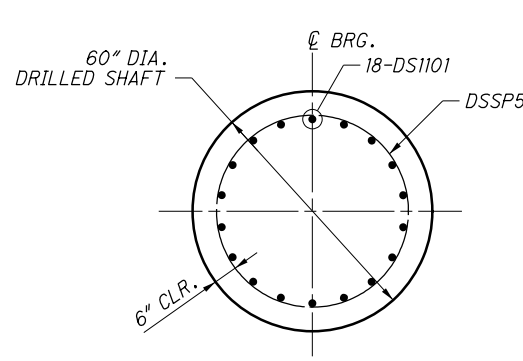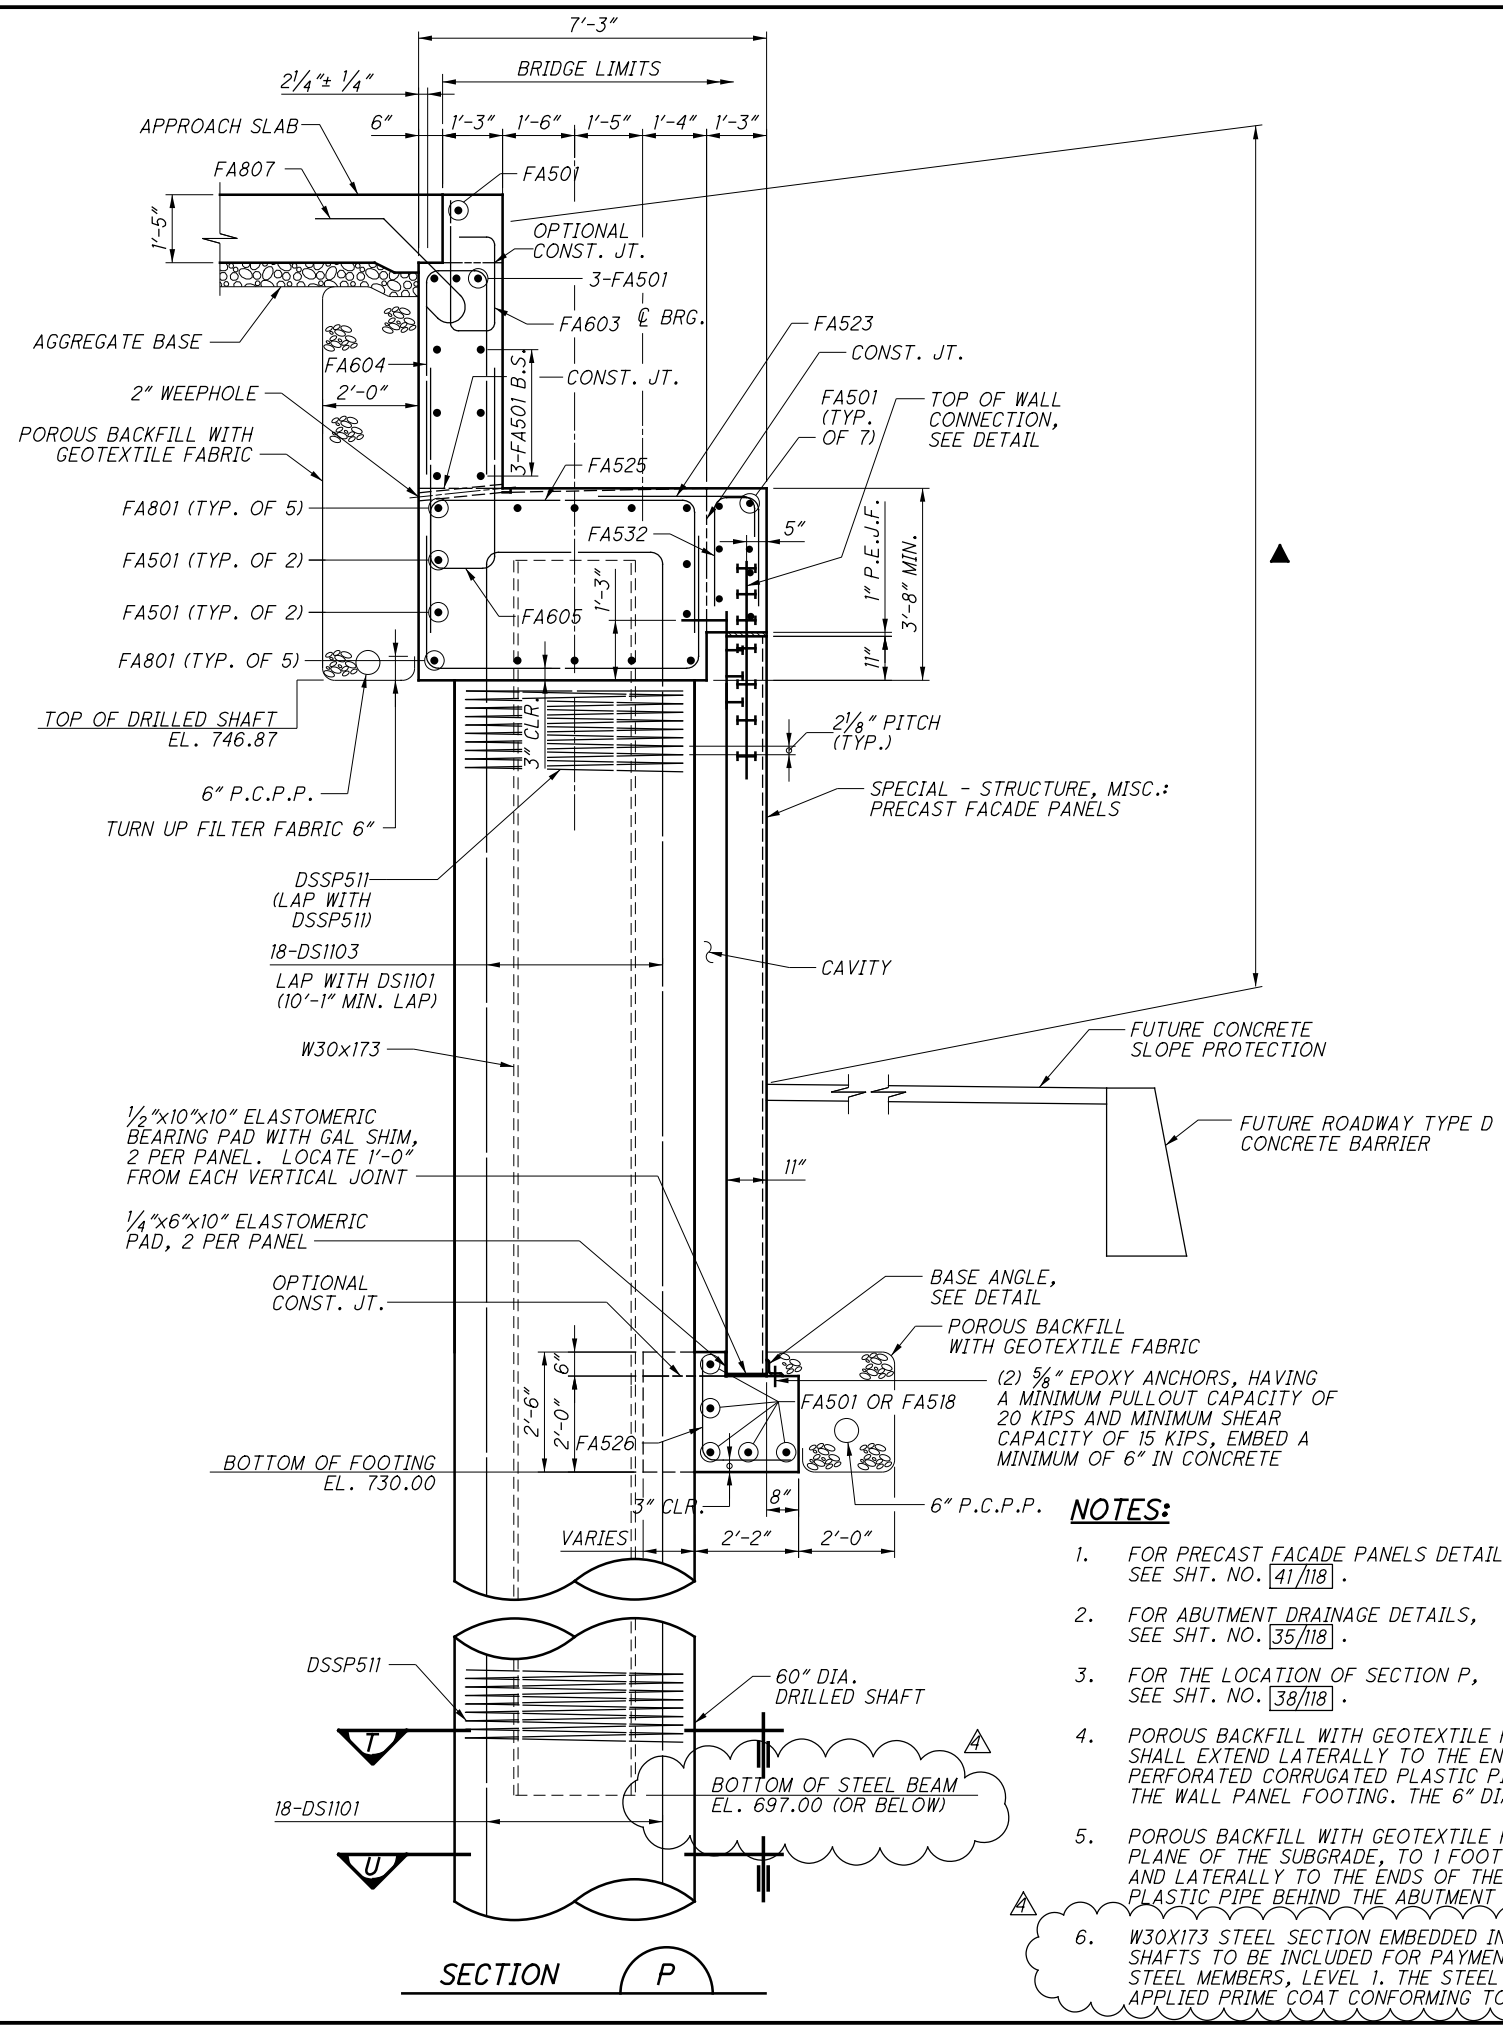


* EXTEND W30x173 SECTION TO AT LEAST EL. 697 (OR BELOW) AND PROJECT IT 2'-6\"/>

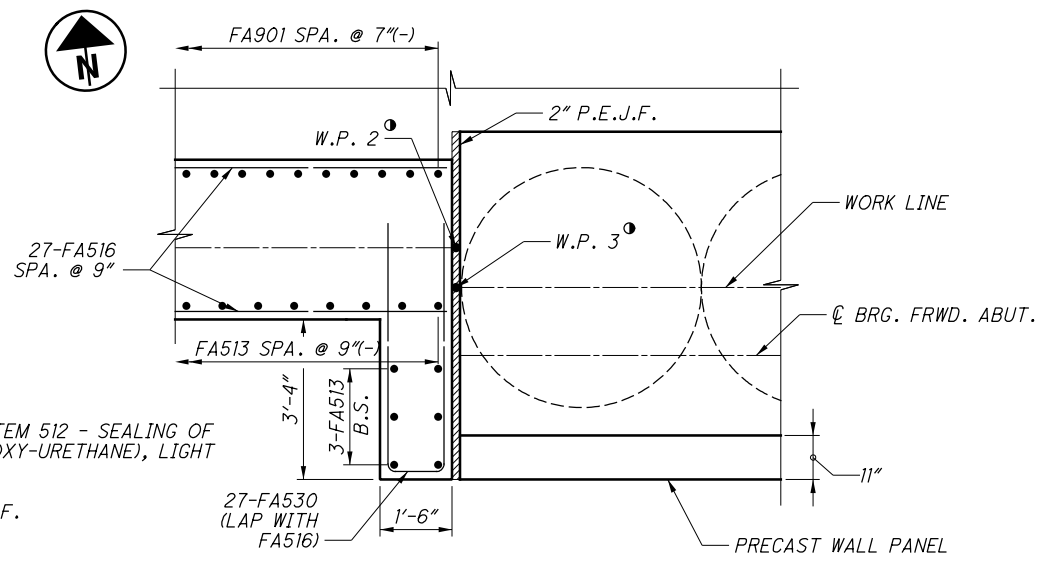

LEGEND:

- ▲ INDICATES LIMITS OF "ITEM 512 - SEALING OF CONCRETE SURFACES (EPOXY-URETHANE), LIGHT NEUTRAL"
- LOCATED AT @ 2\"/>

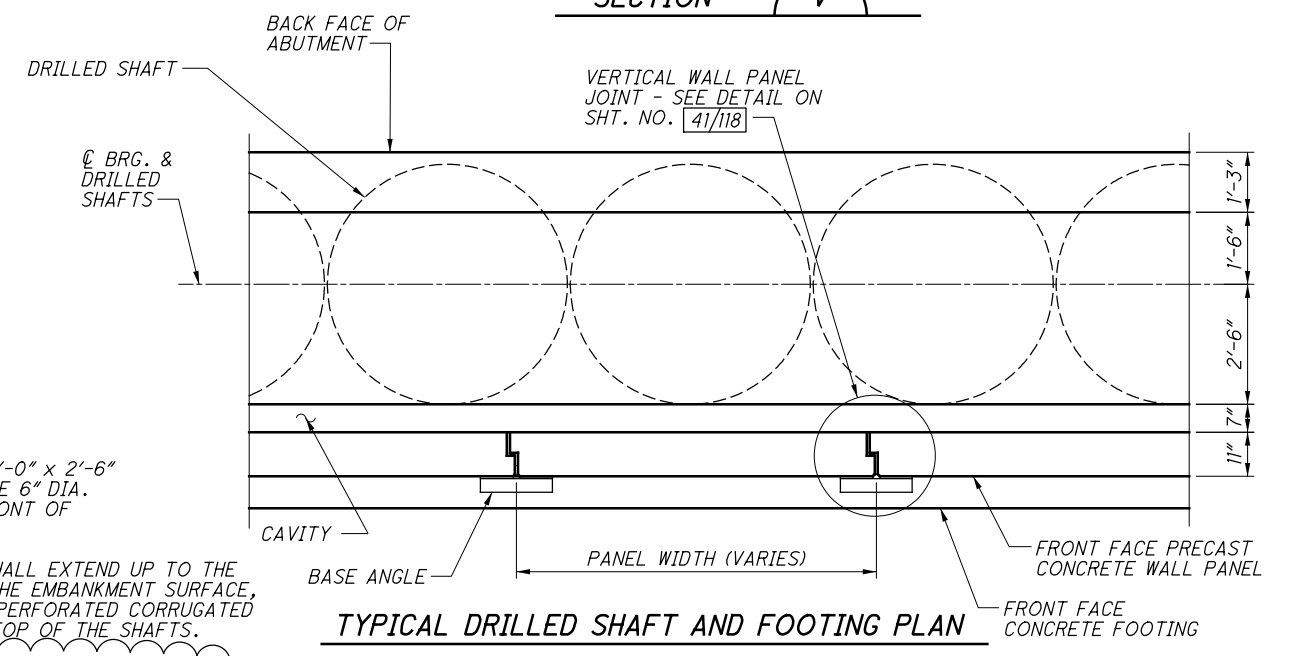

NOTES:

1. FOR PRECAST FACADE PANELS DETAILS, SEE SHT. NO. 41/118.
2. FOR ABUTMENT DRAINAGE DETAILS, SEE SHT. NO. 35/118.
3. FOR THE LOCATION OF SECTION P, SEE SHT. NO. 38/118.
4. POROUS BACKFILL WITH GEOTEXTILE FABRIC: 2'-0\"/>
5. POROUS BACKFILL WITH GEOTEXTILE FABRIC SHALL EXTEND UP TO THE PLANE OF THE SUBGRADE, TO 1 FOOT BELOW THE EMBANKMENT SURFACE, AND LATERALLY TO THE ENDS OF THE 6\"/>
6. W30x173 STEEL SECTION EMBEDDED IN THE THE ABUTMENT DRILLED SHAFTS TO BE INCLUDED FOR PAYMENT WITH ITEM 513 - STRUCTURAL STEEL MEMBERS, LEVEL 1. THE STEEL SHALL BE COATED WITH A SHOP APPLIED PRIME COAT CONFORMING TO CMS 514.

NO.	DESCRIPTION	REV. BY	DATE
4	ADDITIONAL DETAIL & NOTE	RFV	11-29-2021

DESIGN AGENCY
GPD GROUP
Class, Pyle, Schutte, Burns & DeLaney, Inc.
1801 Watermark Drive, Suite 130, Columbus, Ohio 43215 614-210-0731
Copyright © Class, Pyle, Schutte, Burns & DeLaney, Inc. 2015

DATE
9-6-19

REVIEWED
DGN

STRUCTURE FILE NUMBER
2510021

DESIGNED
RHC

CHECKED
MOJ

DRAWN
RFR

REVISED

FORWARD ABUTMENT SECTIONS
BRIDGE NO. FRA-70-1390C
RAMP C5 OVER I-70/71

FRA-70/71-12.68 / 14.86
PID No. 105523

40/118

1603
1815

ESTIMATED QUANTITIES

CALCULATED: RFV DATE: 9-3-19
CHECKED: DJC DATE: 9-6-19

ITEM	EXT.	TOTAL		PARTICIPATION ^Δ		UNITS	DESCRIPTION	ABUT		PIER		SUPER		GENERAL		A.P.P. REFERENCE SHT. NO.
		BRIDGE	EAST CAP	03/NHS/BR	07/NHS/OT/AEP			BRIDGE	EAST CAP	BRIDGE	EAST CAP	BRIDGE	EAST CAP	BRIDGE	EAST CAP	
202	11003	LS	LS	LS			STRUCTURE REMOVED, OVER 20 FOOT SPAN, AS PER PLAN									8
202	22900	336		336		SY	APPROACH SLAB REMOVED							336		
202	23500	1271		1271		SY	WEARING COURSE REMOVED							1271		
503	11101	LS	LS	LS			COFFERDAMS AND EXCAVATION BRACING, AS PER PLAN									8
503	21100	7806		7806		CY	UNCLASSIFIED EXCAVATION	6781		1025						
509	10000	^Δ 584,714		584,714		LB	EPOXY COATED REINFORCING STEEL	48,657		110,481		312,908		112,668		
511	34446	644	217	861		CY	CLASS QC2 CONCRETE WITH QC/QA, BRIDGE DECK					644	217			
511	34451	39	41	80		CY	CLASS QC2 CONCRETE WITH QC/QA, BRIDGE DECK (PARAPET), AS PER PLAN					39	41			1746A
511	41012	393		393		CY	CLASS QC1 CONCRETE WITH QC/QA, PIER ABOVE FOOTINGS			393						
511	44113	315	131	446		CY	CLASS QC1 CONCRETE WITH QC/QA, ABUTMENT NOT INCLUDING FOOTING, AS PER PLAN	315	131							5
511	46513	290	18	308		CY	CLASS QC1 CONCRETE WITH QC/QA, FOOTING, AS PER PLAN	43	18	247						4
511	51513	130	134	264		CY	CLASS QC2 CONCRETE WITH QC/QA, SIDEWALK, AS PER PLAN					130	134			1746A
512	10050	714	547	1261		SY	SEALING OF CONCRETE SURFACES (NON-EPOXY)					714	547			1746A
512	10100	1031	307	1338		SY	SEALING OF CONCRETE SURFACES (EPOXY-URETHANE)	737	307	294						1746A
512	33000	7		7		SY	TYPE 2 WATERPROOFING	7								
^Δ 513	10220	385,790	161,582	547,372		LB	STRUCTURAL STEEL MEMBERS, LEVEL 1	385,790	161,582							
513	10280	591,983	274,536	866,519		LB	STRUCTURAL STEEL MEMBERS, LEVEL 4					591,983	274,536			
513	20000	7920	4865	12785		EACH	WELDED STUD SHEAR CONNECTORS					7920	4865			
514	00060	30594	13784	44378		SF	FIELD PAINTING STRUCTURAL STEEL, INTERMEDIATE COAT					30594	13784			
514	00066	30594	13784	44378		SF	FIELD PAINTING STRUCTURAL STEEL, FINISH COAT					30594	13784			
514	10000	22	10	32		EACH	FINAL INSPECTION REPAIR					22	10			
^Δ 516	10011	178	53	231		FT	ARMORLESS PREFORMED JOINT SEAL, AS PER PLAN							178	53	58-59
516	11211	218	333	551		FT	STRUCTURAL EXPANSION JOINT INCLUDING ELASTOMERIC STRIP SEAL, AS PER PLAN (4')					218	333			44A
516	13600	397		397		SF	1" PREFORMED EXPANSION JOINT FILLER	397								
516	13900	84		84		SF	2" PREFORMED EXPANSION JOINT FILLER			84						
516	44101	20	10	30		EACH	ELASTOMERIC BEARING WITH INTERNAL LAMINATES AND LOAD PLATE (NEOPRENE) 10 1/2" x 1'-4" x 2.45" PAD WITH 11 1/2" x 1'-10" BEVELED PLATE, AS PER PAN					20	10			25
516	44201	10	5	15		EACH	ELASTOMERIC BEARING WITH INTERNAL LAMINATES AND LOAD PLATE (NEOPRENE) 1'-6" x 2'-0" x 3.40" PAD WITH 1'-7" x 2'-9" BEVELED PLATE, AS PER PLAN					10	5			25
518	12500	2		2		EA	SCUPPER, MISC.: NEENAH R-4014-TL SCUPPER & TYPE V GATE					2				33
518	21200	177	69	246		CY	POROUS BACKFILL WITH GEOTEXTILE FABRIC	177	69							
518	40000	445	175	620		FT	6" PERFORATED CORRUGATED PLASTIC PIPE	445	175							
518	40010	25	25	50		FT	6" NON-PERFORATED CORRUGATED PLASTIC PIPE, INCLUDING SPECIALS	25	25							
518	62100	110		110		FT	STRUCTURE DRAINAGE, MISC.: DOWNSPOUT/REDUCER/ELBOW CONDUIT DRAINAGE COLLECTION SYSTEM					110				33
^Δ 524	95472	2,423	1,015	3,438		FT	DRILLED SHAFTS, 60" DIAMETER, ABOVE BEDROCK WITH QC/QA, AS PER PLAN	2,423	1,015							4
526	25011	700	258	958		SY	REINFORCED CONCRETE APPROACH SLABS WITH QC/QA (T=15"), AS PER PLAN					700	258			58-60
^Δ 526	90031	178	53	231		FT	TYPE C INSTALLATION, AS PER PLAN					178	53			58-59
SPECIAL	53000200	LS		LS			STRUCTURES: PERMANENT UTILITY SUPPORTS (TRAFFIC, ITS, DOT, CITY OF COLUMBUS DOP)									5
SPECIAL	53000200	LS		LS			STRUCTURES: PERMANENT UTILITY SUPPORTS (AEP DUCTS)									5
SPECIAL	53000600	4258	1774	6032		SF	STRUCTURES: PRECAST FACADE PANELS	4258	1774							5
607	98000	20		20		FT	FENCE, MISC.: WALL MOUNTED TYPE A (W/ VANDAL MESH)	4.5				15.5				1746A
625	10620	6	2	8		EACH	LIGHT POLE ANCHOR BOLTS, MISC.: COMBINATION SIGNAL POLE AND PEDESTRIAN POLE ANCHOR BOLT ASSEMBLIES EMBEDDED IN CONCRETE BRIDGE DECK					6	2			4
^Δ SPECIAL	69098100	1650		1650		FT	5" XHW FIBERGLASS CONDUIT					1650				5

NO.	DESCRIPTION	REV. BY	DATE	NO.	DESCRIPTION	REV. BY	DATE
2	ADDED/CORRECTED ITEMS/QUANTITIES	DJC	11-12-2021	4	FUNDING CODE CHANGE/ADDED ITEM/ REVISED ITEM	CWL/RFV	11-29-2021

ESTIMATED QUANTITIES - EASTBOUND

BRIDGE NO. FRA-70-1395C
S. FRONT STREET OVER I-70/71

PID No. 105523

FRA-70/71-12.68/14.86

6 / 65

1687
1815


DESIGN AGENCY: GPD GROUP
Class, P.E., S. Scherer, Burns & McDonnell, Inc.
1801 Watermark Drive, Suite 150, Columbus, Ohio 43215 614-210-0731
Copyright © Class, P.E., Scherer, Burns & McDonnell, Inc. 2015

DATE: 9-6-19
REVIEWED: DGN
DRAWN: RFV
DESIGNED: RFV
CHECKED: DJC

STRUCTURE FILE NUMBER: 2510023

D:\2012\20120418\FRA\105523\STRUCTURES\FRA70_1395C\SHEETS\070_1395CE0001.DGN
11/29/2021 10:16:43 AM
D:\2012\20120418\FRA\105523\STRUCTURES\FRA70_1395C\SHEETS\070_1395CE0001.DGN

G:\2012\2012048\FRA\105523\STRUCTURES\FRA070_1395C\SHEETS\070_1395CFP001.DGN
 11/24/2021 5:08:14 PM
 DDDTY81STD_USER

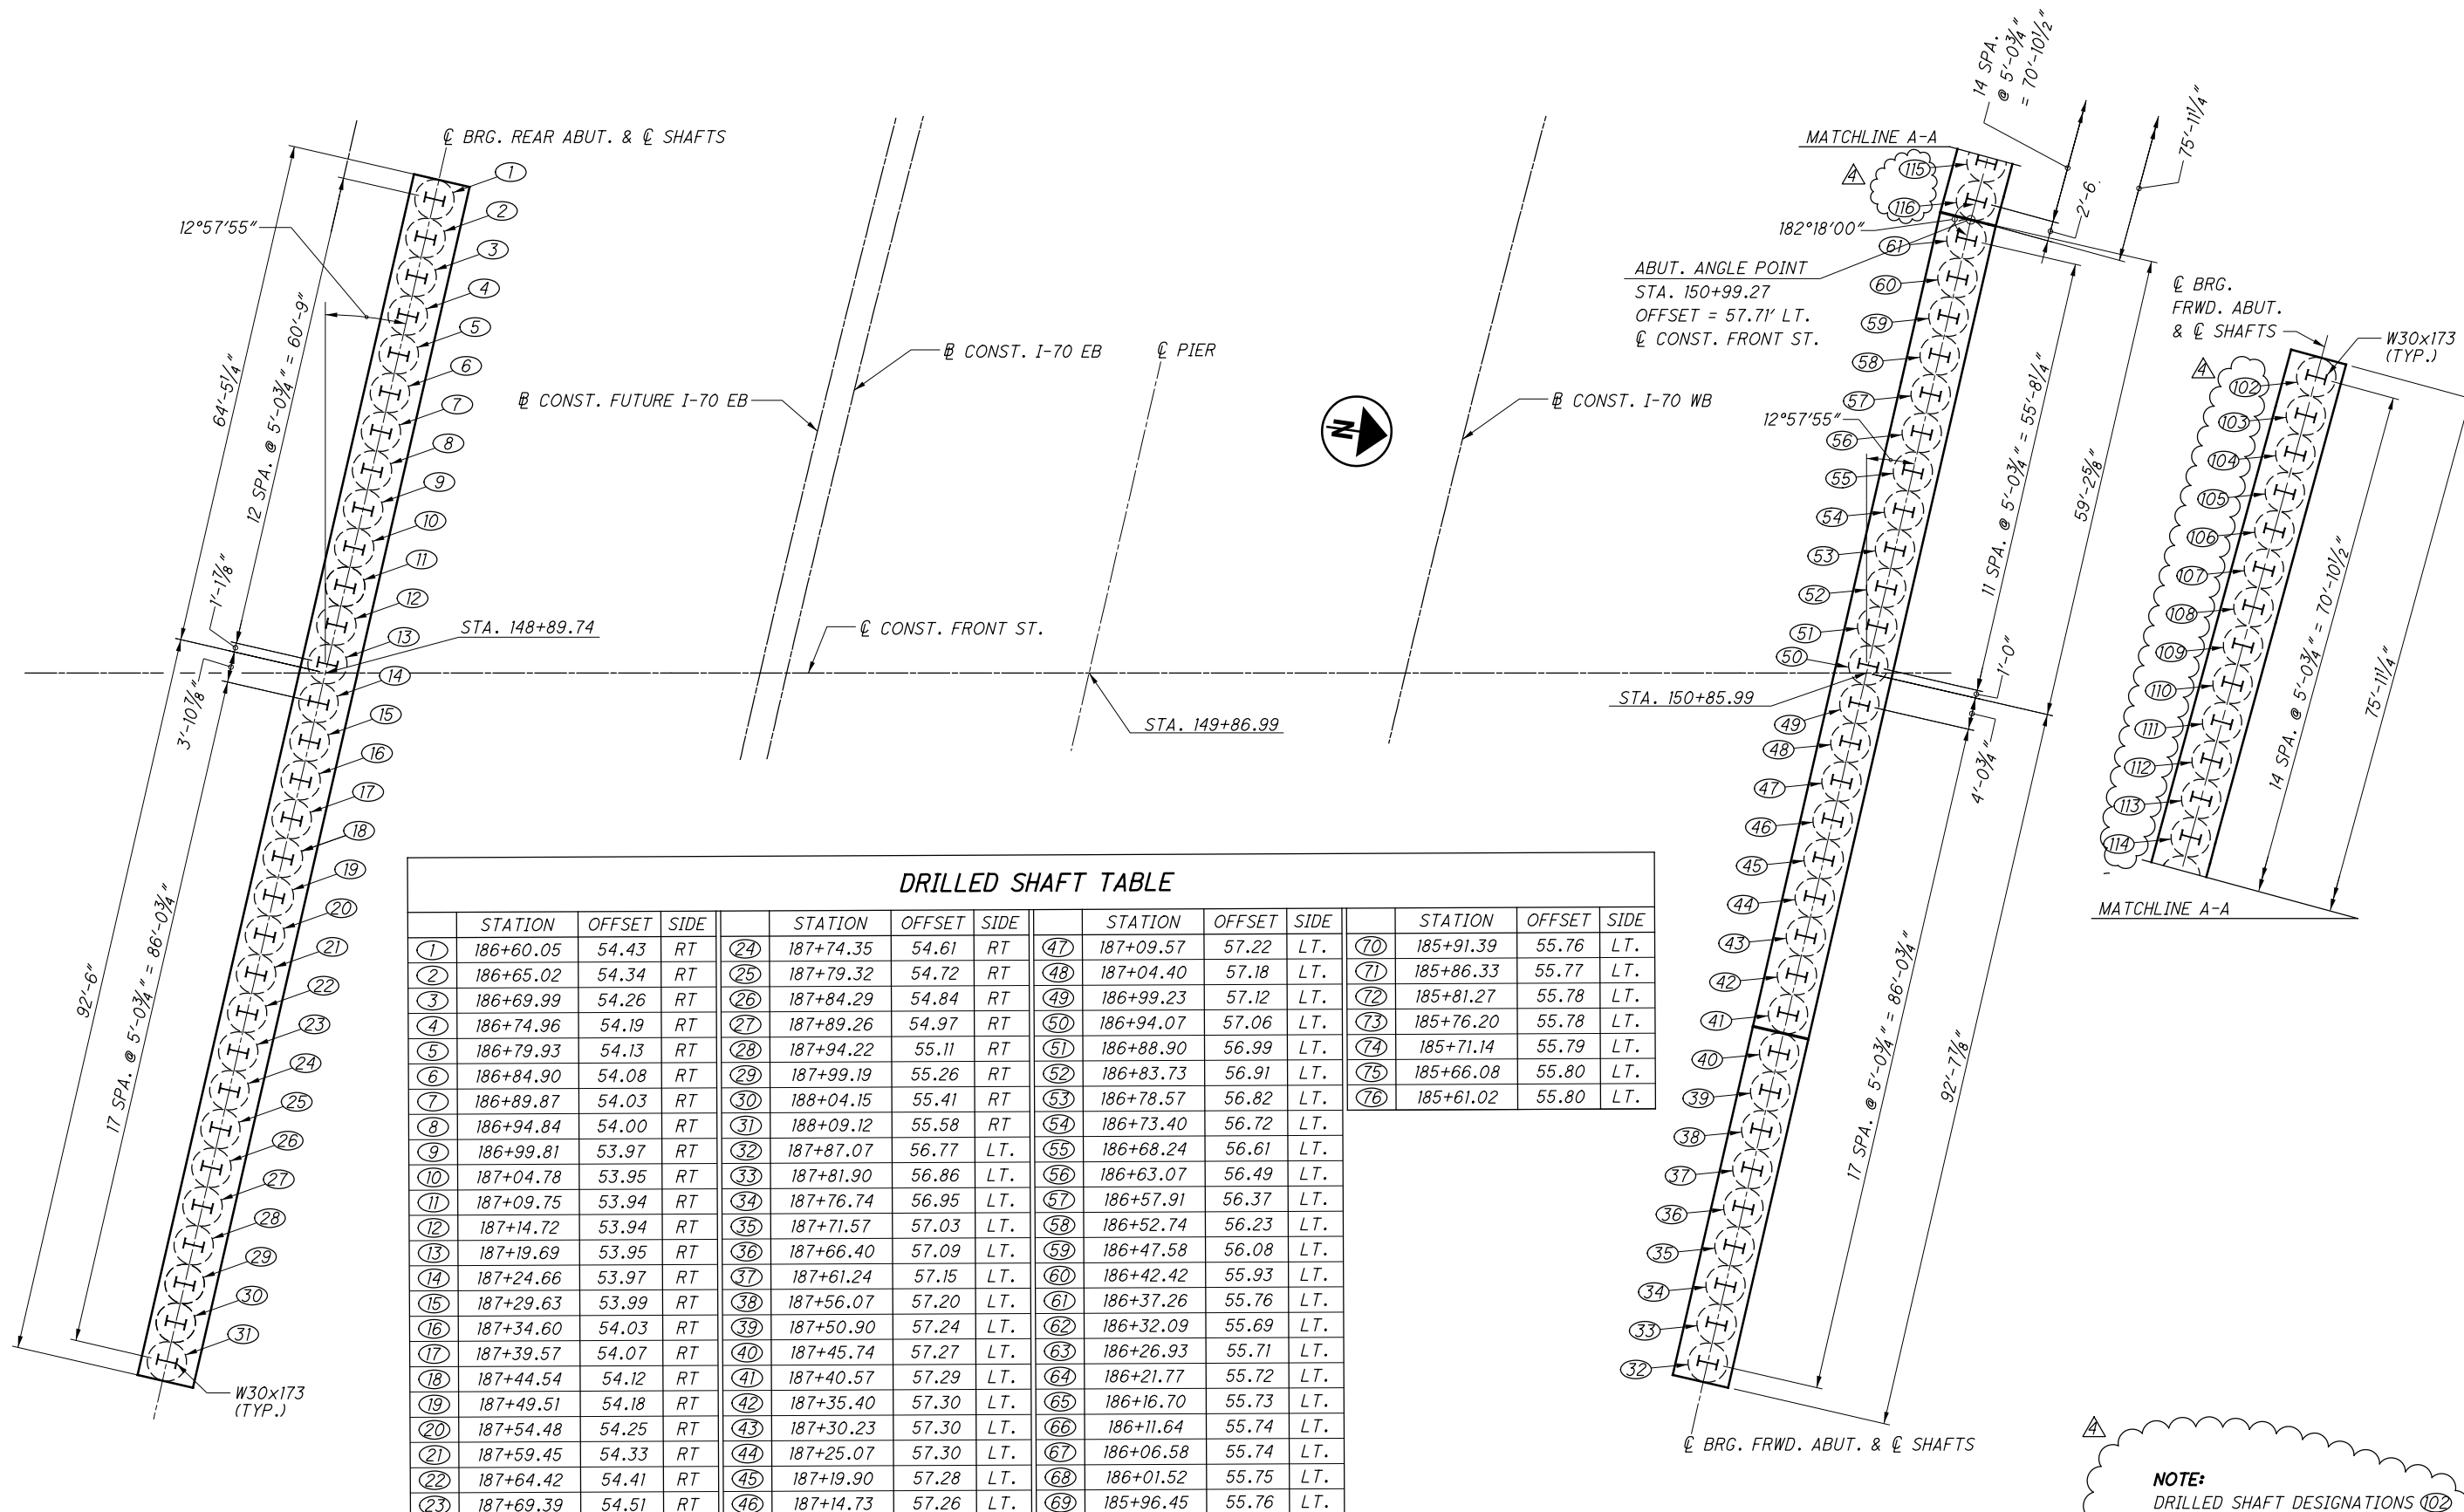

DRILLED SHAFT TABLE											
STATION	OFFSET	SIDE	STATION	OFFSET	SIDE	STATION	OFFSET	SIDE	STATION	OFFSET	SIDE
1	186+60.05	54.43	RT	24	187+74.35	54.61	RT	47	187+09.57	57.22	LT.
2	186+65.02	54.34	RT	25	187+79.32	54.72	RT	48	187+04.40	57.18	LT.
3	186+69.99	54.26	RT	26	187+84.29	54.84	RT	49	186+99.23	57.12	LT.
4	186+74.96	54.19	RT	27	187+89.26	54.97	RT	50	186+94.07	57.06	LT.
5	186+79.93	54.13	RT	28	187+94.22	55.11	RT	51	186+88.90	56.99	LT.
6	186+84.90	54.08	RT	29	187+99.19	55.26	RT	52	186+83.73	56.91	LT.
7	186+89.87	54.03	RT	30	188+04.15	55.41	RT	53	186+78.57	56.82	LT.
8	186+94.84	54.00	RT	31	188+09.12	55.58	RT	54	186+73.40	56.72	LT.
9	186+99.81	53.97	RT	32	187+87.07	56.77	LT.	55	186+68.24	56.61	LT.
10	187+04.78	53.95	RT	33	187+81.90	56.86	LT.	56	186+63.07	56.49	LT.
11	187+09.75	53.94	RT	34	187+76.74	56.95	LT.	57	186+57.91	56.37	LT.
12	187+14.72	53.94	RT	35	187+71.57	57.03	LT.	58	186+52.74	56.23	LT.
13	187+19.69	53.95	RT	36	187+66.40	57.09	LT.	59	186+47.58	56.08	LT.
14	187+24.66	53.97	RT	37	187+61.24	57.15	LT.	60	186+42.42	55.93	LT.
15	187+29.63	53.99	RT	38	187+56.07	57.20	LT.	61	186+37.26	55.76	LT.
16	187+34.60	54.03	RT	39	187+50.90	57.24	LT.	62	186+32.09	55.69	LT.
17	187+39.57	54.07	RT	40	187+45.74	57.27	LT.	63	186+26.93	55.51	LT.
18	187+44.54	54.12	RT	41	187+40.57	57.29	LT.	64	186+21.77	55.32	LT.
19	187+49.51	54.18	RT	42	187+35.40	57.30	LT.	65	186+16.60	55.13	LT.
20	187+54.48	54.25	RT	43	187+30.23	57.30	LT.	66	186+11.44	54.94	LT.
21	187+59.45	54.33	RT	44	187+25.07	57.30	LT.	67	186+06.28	54.75	LT.
22	187+64.42	54.41	RT	45	187+19.90	57.28	LT.	68	186+01.12	54.56	LT.
23	187+69.39	54.51	RT	46	187+14.73	57.26	LT.	69	185+96.45	54.37	LT.
								70	185+91.29	54.18	LT.
								71	185+86.13	54.00	LT.
								72	185+80.97	53.82	LT.
								73	185+75.81	53.64	LT.
								74	185+70.65	53.46	LT.
								75	185+65.49	53.28	LT.
								76	185+60.33	53.10	LT.

NOTE: STATIONS AND OFFSETS FOR DRILLED SHAFT NOS. 1 TO 31 GIVEN TO CONST. FUTURE I-70 EB
 STATIONS AND OFFSETS FOR DRILLED SHAFT NOS. 32 TO 76 GIVEN TO CONST. I-70 WB

5'-0" DIAMETER DRILLED SHAFT PLAN

NOTE:
 DRILLED SHAFT DESIGNATIONS 102
 THRU 116 ARE INCLUDED FOR
 PAYMENT WITH BRIDGE NO.
 FRA-70-1390C.

NO.	DESCRIPTION	REV. BY	DATE
4	DRILLED SHAFT REVISION AND NOTE	RFV	11-29-2021

DESIGN AGENCY
GPD GROUP
Class, P.E., S. Scherer, Burns & McDonnell, Inc.
 1801 Watermark Drive, Suite 150, Columbus, Ohio 43215 614.210.0731
 Copyright © Class, P.E., Scherer, Burns & McDonnell, Inc. 2015

DRILLED SHAFT PLAN
 BRIDGE NO. FRA-70-1395C
 S. FRONT STREET OVER I-70/71

DESIGNED	DGN	CHECKED	DUC
DRAWN	RFV	REVISED	
REVIEWED	TJW	DATE	9-6-19

STRUCTURE FILE NUMBER: 2510023
 STRUCTURE FILE NUMBER: 2510023



PID No. 105523

FRA-70/71-12.68 / 14.86


9 / 65

1690
1815


01:\2012\20120418\FRA\105525\STRUCTURES\FRA070_1395C\SHEETS\070_1395C\RA003.DGN
 11/24/2021 3:27:01 PM DDDTY81STD_USER

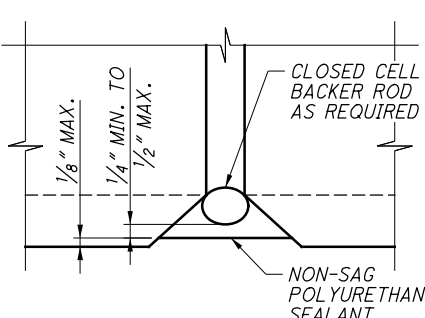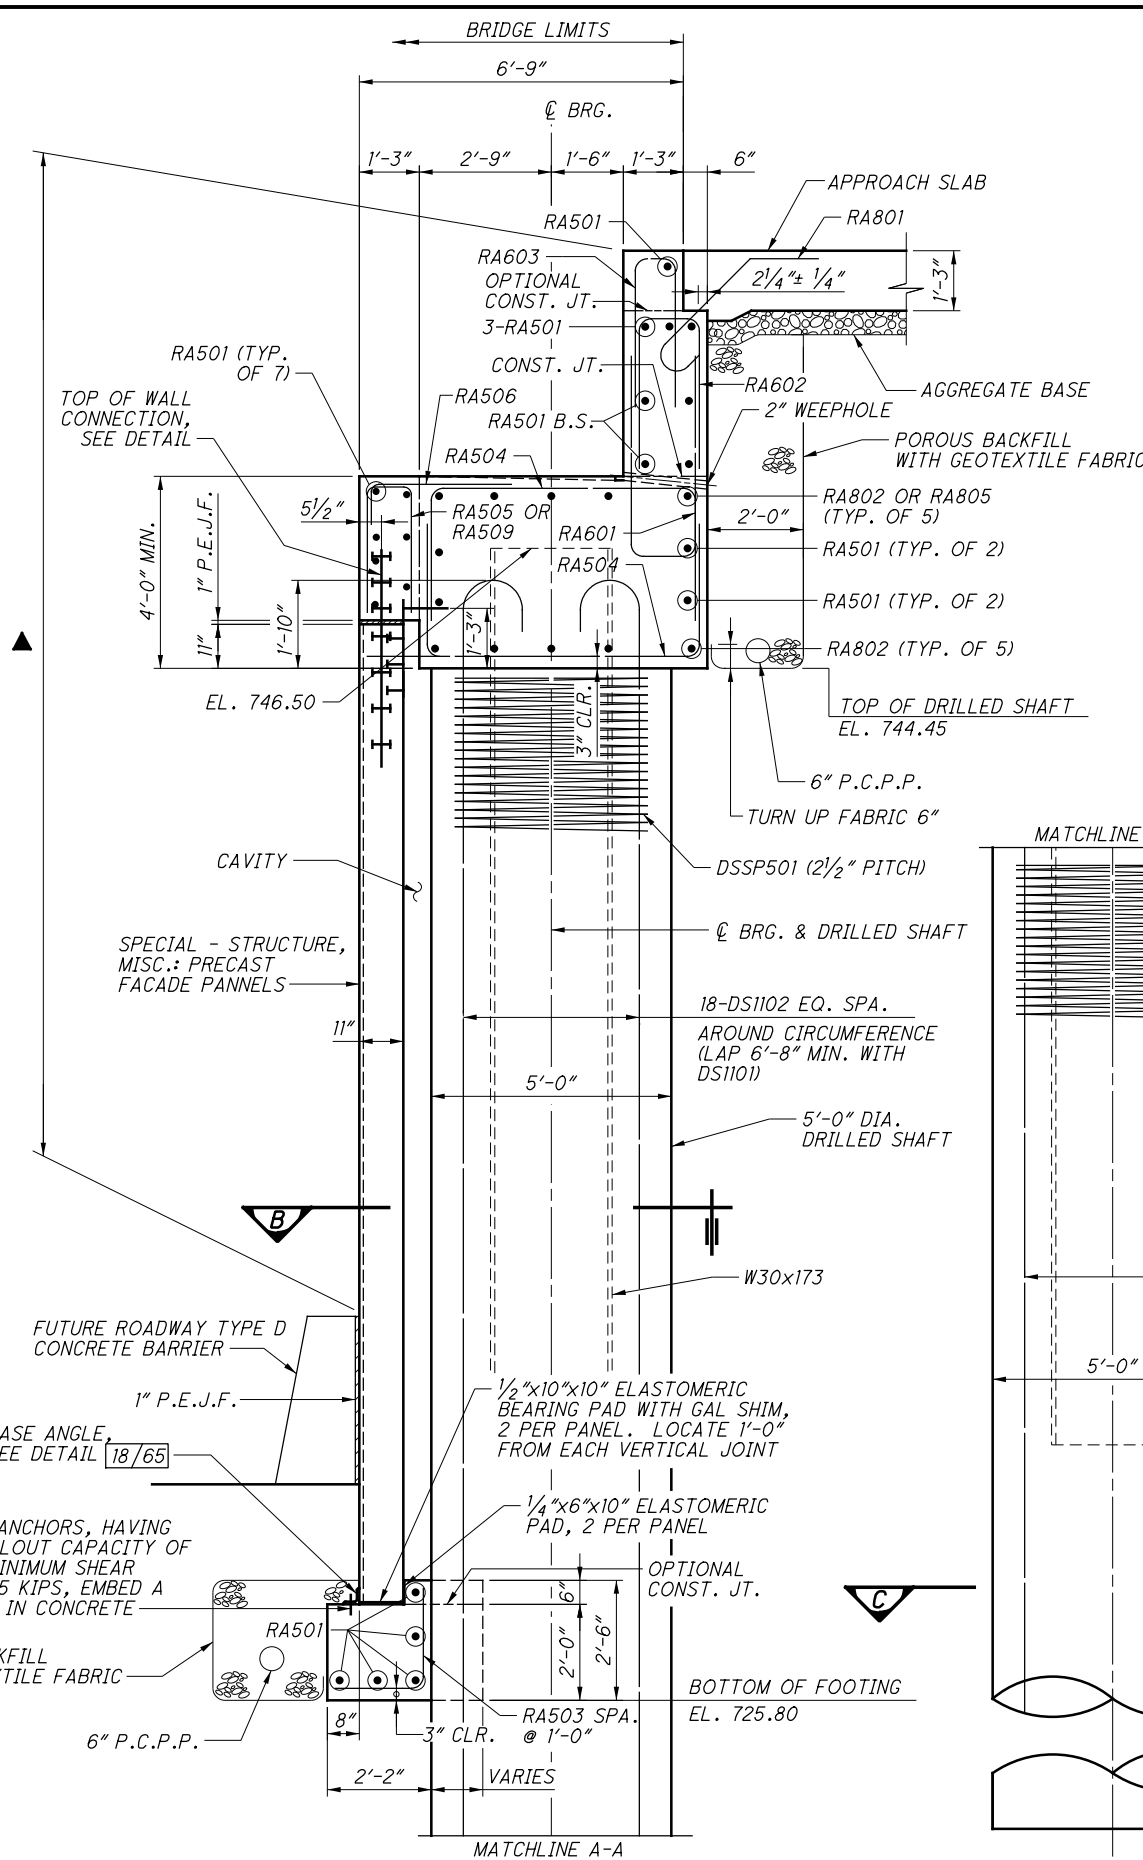


CAULKING DETAIL
TYPICAL ALL PRECAST PANEL JOINTS

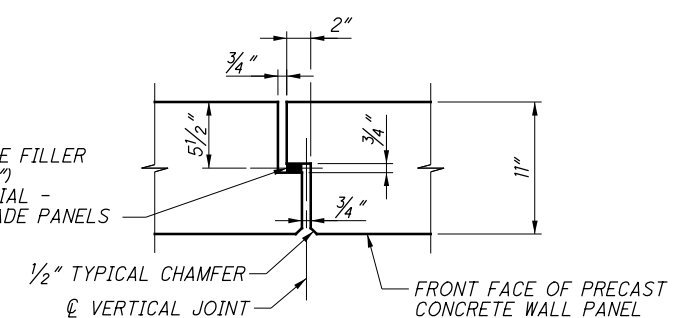

VERTICAL WALL PANEL JOINT DETAIL

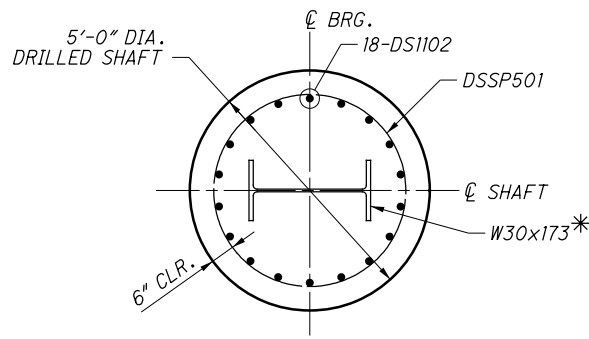


SECTION B

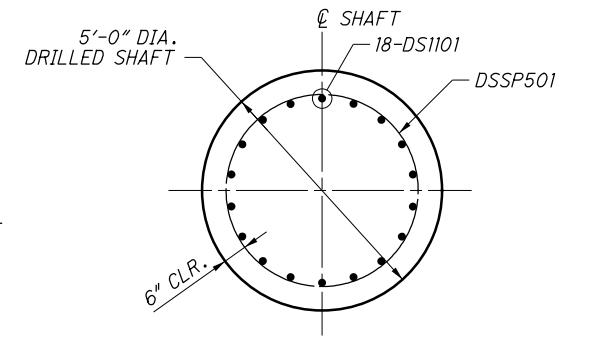

SECTION C

* EXTEND W30x173 SECTION TO AT LEAST EL. 697 (OR BELOW) AND PROJECT IT 2'-6" MIN. INTO THE BOTTOM OF THE ABUTMENT SHAFT CAP

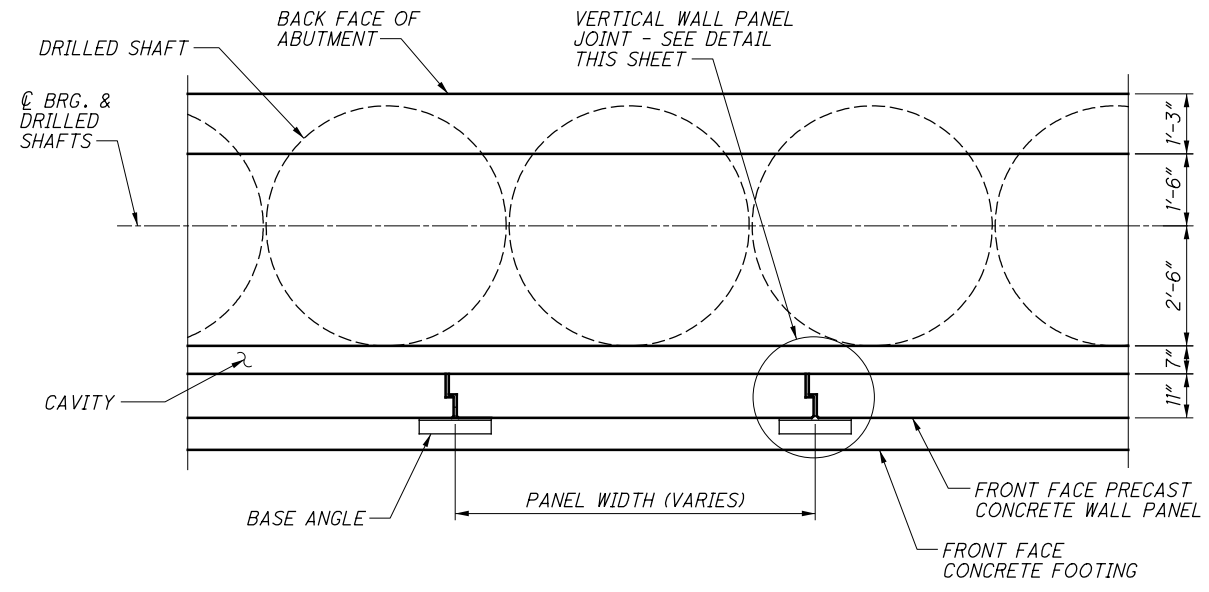

TYPICAL DRILLED SHAFT AND FOOTING PLAN

NOTES:

- FOR PRECAST FACADE PANELS DETAILS, SEE SHT. NO. 18/65.
- FOR ABUTMENT DRAINAGE DETAIL, SEE SHT. NO. 19/65.
- FOR LOCATION OF SECTION A, SEE SHT. NOS. 11/65 & 12/65.
- POROUS BACKFILL WITH GEOTEXTILE FABRIC: 2'-0" x 2'-6" SHALL EXTEND LATERALLY TO THE ENDS OF THE 6" DIA. PERFORATED CORRUGATED PLASTIC PIPE IN FRONT OF THE WALL PANEL FOOTING.
- POROUS BACKFILL WITH GEOTEXTILE FABRIC SHALL EXTEND UP TO THE PLANE OF THE SUBGRADE, TO 1 FOOT BELOW THE EMBANKMENT SURFACE, AND LATERALLY TO THE ENDS OF THE 6" DIA. PERFORATED CORRUGATED PLASTIC PIPE BEHIND THE ABUTMENT CAP ON TOP OF THE SHAFTS.

LEGEND:

▲ - INDICATES LIMITS OF ITEM 512 SEALING OF CONCRETE SURFACES (EPOXY-URETHANE)

SECTION A

NO.	DESCRIPTION	REV. BY	DATE
4	ADDITIONAL NOTE	RFV	11-29-2021



DESIGN AGENCY
GPD GROUP
 1801 Watermark Drive, Suite 150, Columbus, Ohio 43215 614.210.0731
 Copyright © 2015, GPD Group, Inc.

REAR ABUTMENT SECTIONS
 BRIDGE NO. FRA-70-1395C
 S. FRONT STREET OVER I-70/71


DATE 9-6-19
REVIEWED T J W
STRUCTURE FILE NUMBER 2510023
DRAWN RFV
CHECKED DJC
DESIGNED DGN/RSN
REVISIONS

FRA-70/71-12.68 / 14.86
PID No. 105523
 13/65
 1694
 1815


01-2012-2012048 VFR-105523 STRUCTURES FRA70_1395C SHEETS 070_1395C 003.DGN
 11/24/2021 3:25:40 PM
 DDDTY81STD_USER

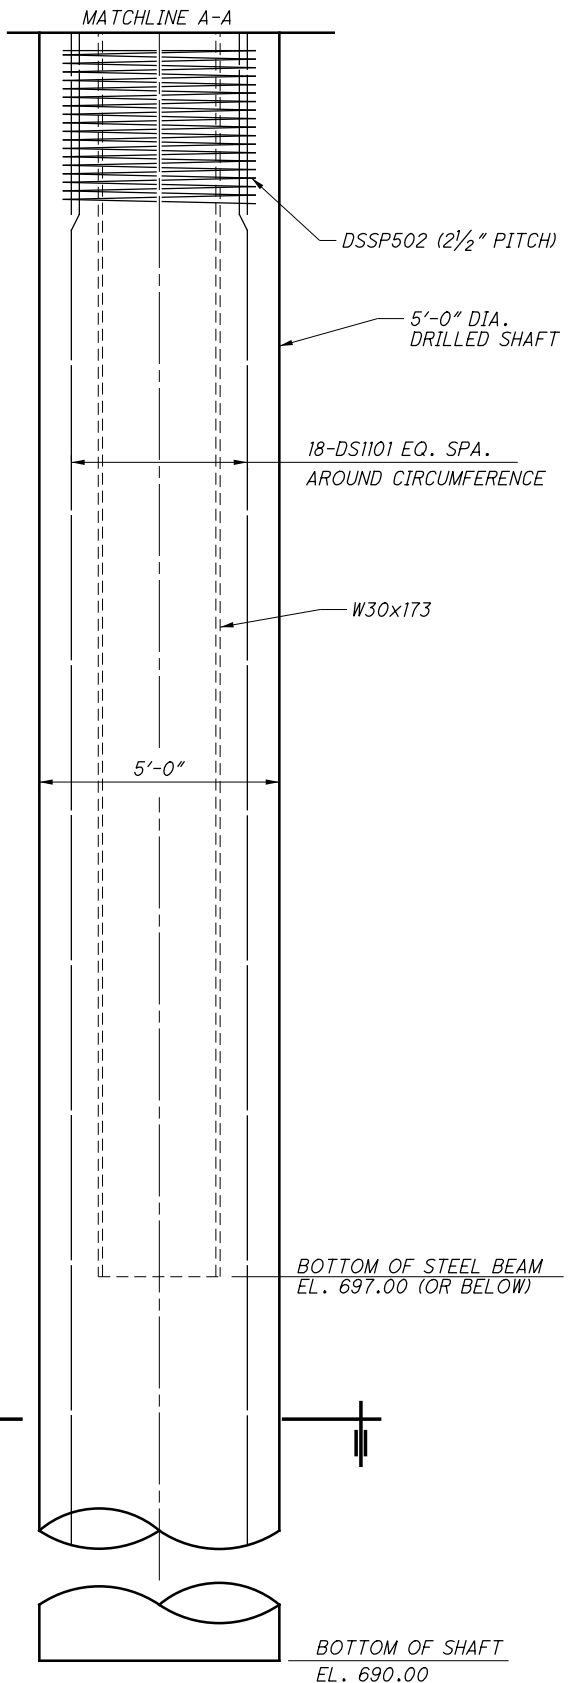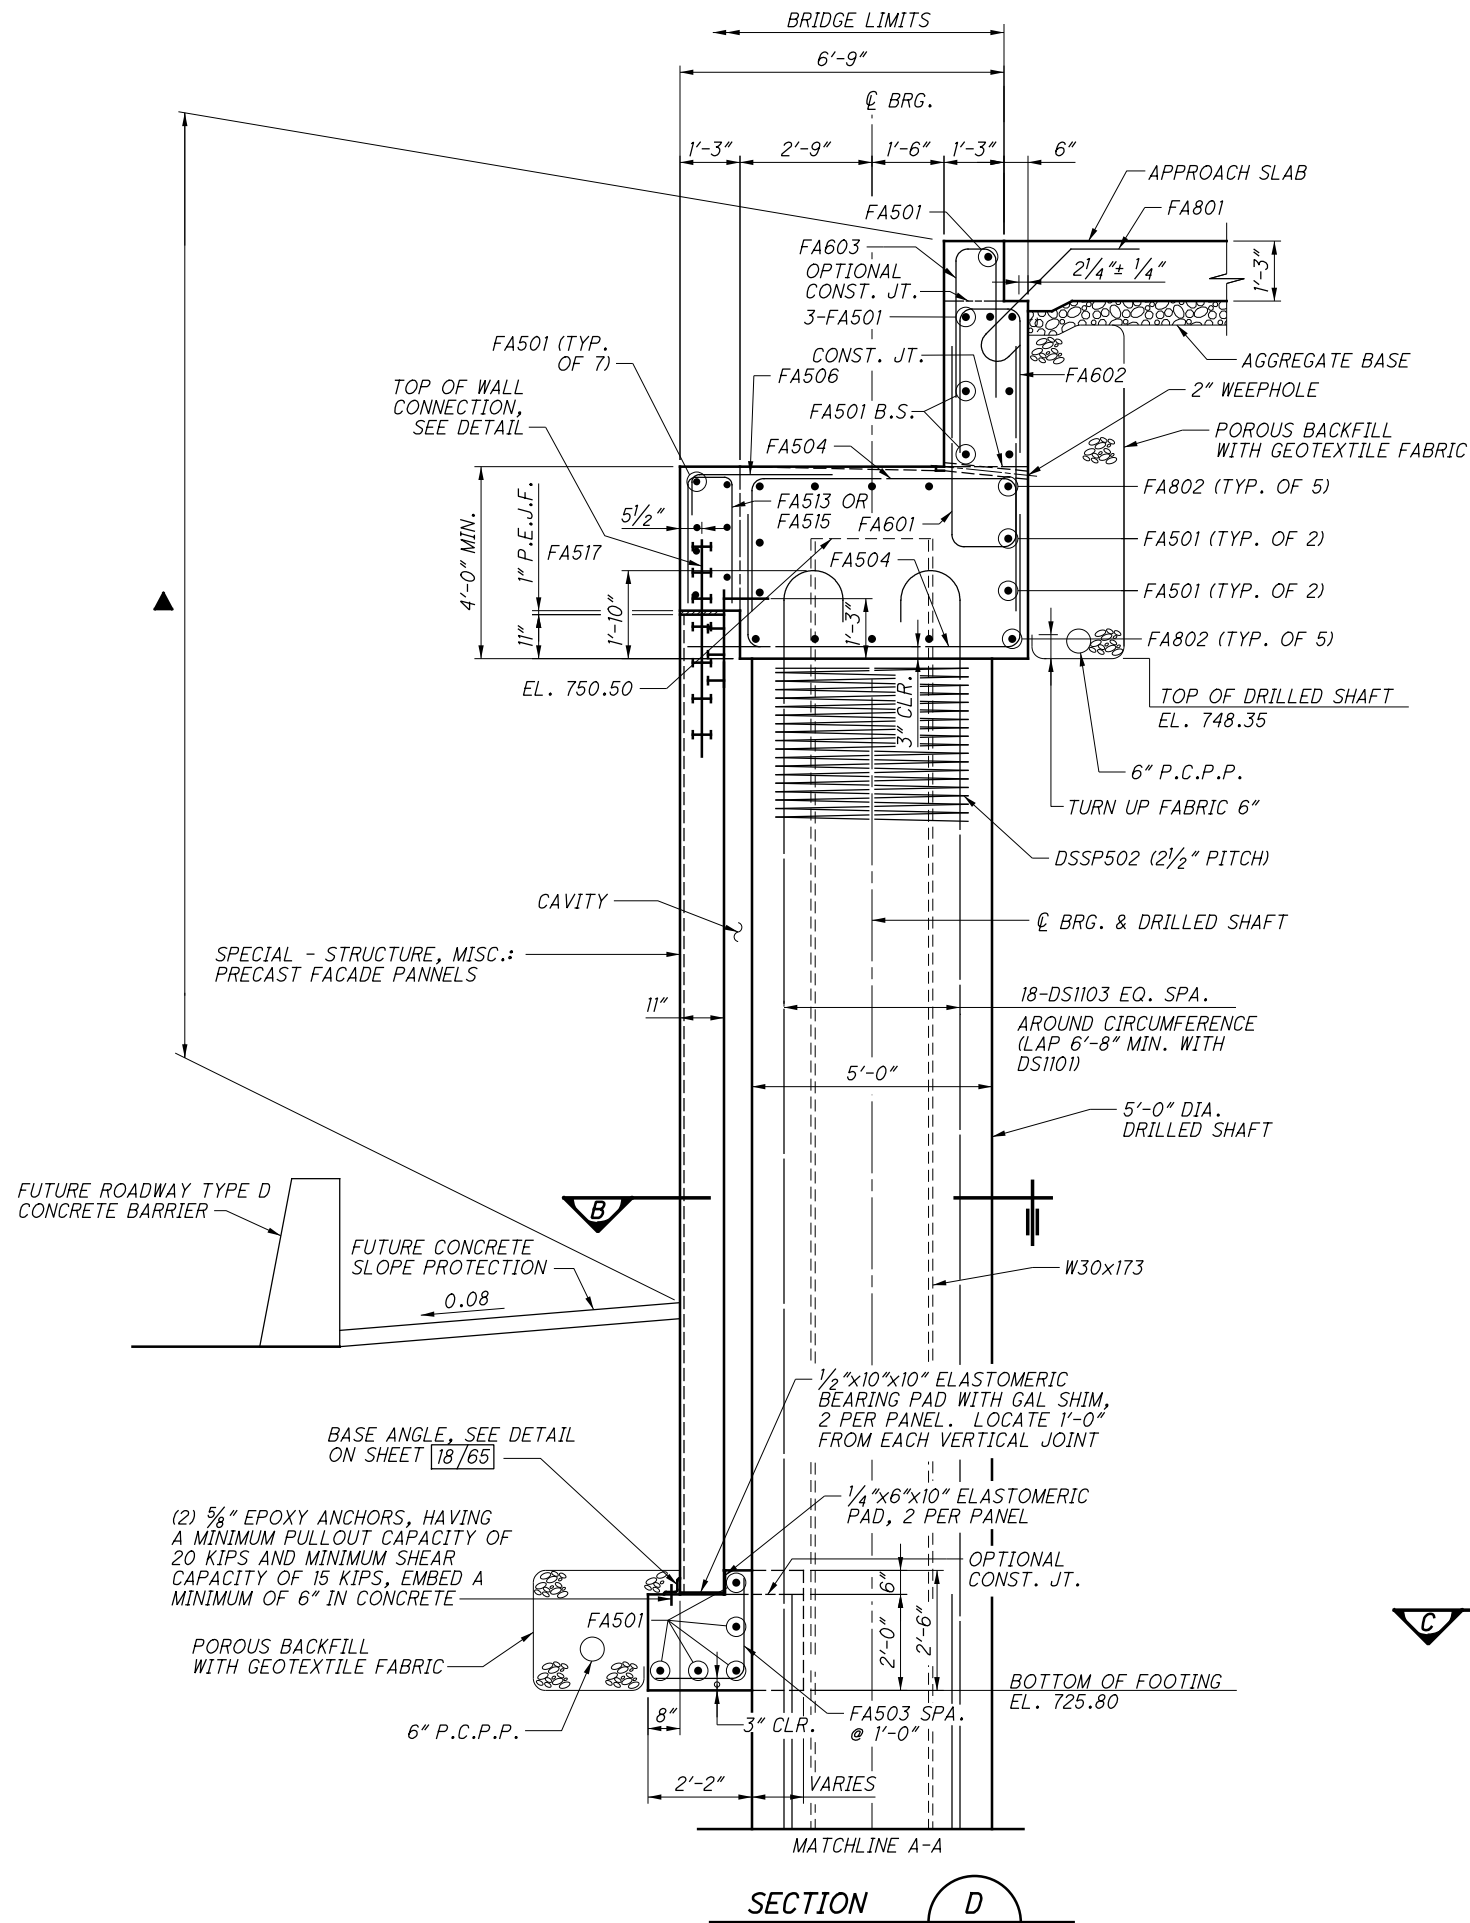

LEGEND:
 ▲ - INDICATES LIMITS OF ITEM 512 SEALING OF CONCRETE SURFACES (EPOXY-URETHANE)

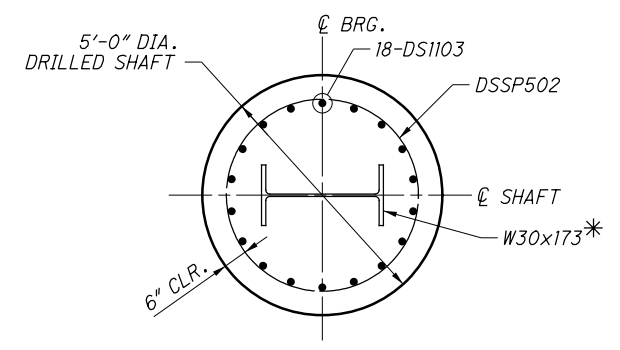

SECTION B
 * EXTEND W30x173 SECTION TO AT LEAST EL. 697 (OR BELOW) AND PROJECT IT 2'-6" MIN. INTO THE BOTTOM OF THE ABUTMENT SHAFT CAP

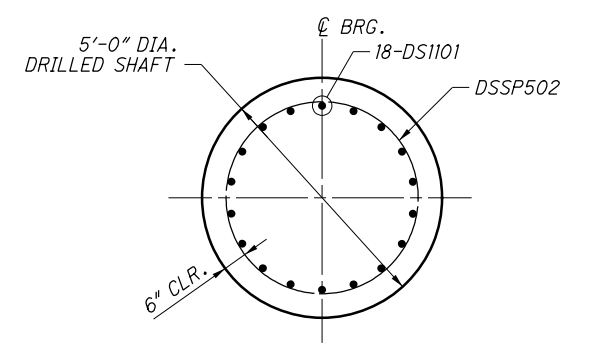

SECTION C

- NOTES:**
- FOR PRECAST FACADE PANELS DETAILS, SEE SHT. NO. 18/65
 - FOR ABUTMENT DRAINAGE DETAIL, SEE SHT. NO. 19/65
 - FOR LOCATION OF SECTION D, SEE SHT. NOS. 15/65 & 16/65
 - FOR VERTICAL WALL PANEL JOINT DETAIL, AND DRILLED SHAFT AND FOOTING PLAN DETAIL, SEE SHT. NO. 13/65
 - W30x173 STEEL SECTION EMBEDDED IN THE THE ABUTMENT DRILLED SHAFTS TO BE INCLUDED FOR PAYMENT WITH ITEM 513 - STRUCTURAL STEEL MEMBERS, LEVEL 1. THE STEEL SHALL BE COATED WITH A SHOP APPLIED PRIME COAT CONFORMING TO CMS 514.

NO.	DESCRIPTION	REV. BY	DATE
4	ADDITIONAL NOTE	RFV	11-29-2021

4

AE SUMMARY - FRONT STREET BRIDGE

PARTICIPATION
04/MPO/OT

PLAN SHEET NUMBER						ITEM	ITEM EXT.	GRAND TOTAL	UNIT	DESCRIPTION	DETAIL SHEET NO.		
1750	1751	1753	1756	1757	1761								
		479				479	605	98000	479	FT	UNDERDRAINS, MISC.: 4" PERFORATED PLANTER UNDERDRAIN	1754	
		16				16	611	97200	16	EACH	CONDUIT, MISC.: CLEANOUT STRUCTURE AND PLUG SET WITH 45° WYE	1754	
		2				2	611	97200	2	EACH	CONDUIT, MISC.: DRAINAGE OUTLET STRUCTURE	1754	
16						16	625	98000	16	EACH	LIGHTING, MISC.: RECESSED WALL LIGHT- TYPE 1	1781 to 1784	
5						5	625	98000	5	EACH	LIGHTING, MISC.: SEATWALL LIGHT TYPE 2	1781 to 1784	
20						20	625	98000	20	EACH	LIGHTING, MISC.: TRELIS LIGHT TYPE 3	1781 to 1784	
4						4	SPECIAL	63097700	4	EACH	SIGNING, MISC.: BRIDGE PYLON ALUMINUM LETTERS	1811 and 1814	
						774	774	661	14001	774	EACH	PERENNIALS, LIRIOPE MUSCARI 'BIG BLUE'- BIG BLUE LILYTURF, AS PER PLAN	1222
						36	36	661	20041	36	EACH	DECIDUOUS SHRUB. 2' HEIGHT, AS PER PLAN - HYDRANGEA QUERCIFOLIA 'MUNCHKIN'	1222
						82	82	661	20041	82	EACH	DECIDUOUS SHRUB, 2' HEIGHT, AS PER PLAN - ROSA 'RADTKO'	1222
						100	100	661	30061	100	EACH	EVERGREEN SHRUB, 2' HEIGHT, AS PER PLAN - BUXUS X 'GREEN VELVET'	1222
						55	55	661	99900	55	EACH	PLANTING, MISC.: ORNAMENTAL GRASS, 24" HEIGHT, AS PER PLAN - CALAMAGROSTIS ACUTIFOLIA 'KARL FOERSTER'	1222
						430	430	661	99900	430	EACH	PLANTING, MISC.; ORNAMENTAL GRASS, 6" HEIGHT FESTUCA GLAUCA 'ELIJAH BLUE', #1 CONTAINER	1222
						28	28	661	99900	28	EACH	PLANTING, MISC.; ORNAMENTAL GRASS, 24" HEIGHT, AS PER PLAN - SCHIZACHYRIUM SCOPARIUM 'SMOKE SIGNAL', #2 CONTAINER	1222
						736	736	661	99900	736	EACH	PLANTING, MISC.: 12-14 cm BULB, NARCISSUS 'SHERBORNE'- SHERBORNE DAFFODIL, AS PER PLAN	1222
						430	430	661	99900	430	EACH	PLANTING, MISC.; GROUND COVER, 12" SPREAD SEDUM RUPESTRE 'ANGELINA', #1 CONTAINER	1222
						350	350	661	99900	350	EACH	PLANTING, MISC.; GROUND COVER, 8" SPREAD SEDUM HISPANICUM 'BLUE CARPET', #1 CONTAINER	1222
						20	20	661	99900	20	EACH	PLANTING, MISC: DECIDUOUS TREE, 14' HEIGHT, AS PER PLAN - MAGNOLIA VIRGINIANA 'JIM WILSON'	1222
						59	59	661	99900	59	EACH	PLANTING, MISC: EVERGREEN SHRUB, 18" SPREAD, AS PER PLAN - JUNIPERUS CONFERTA 'BLUE PACIFIC'	1222
2						2	SPECIAL	68014550	2	EACH	TRASH (LITTER) RECEPTACLE	1785	
												1785	
				1		LS	SPECIAL	68043100	1		COMPLETE IRRIGATION SYSTEM	1798 to 1800	
14						14	SPECIAL	69098000	14	EACH	FRONT STREET ALUMINUM PLANTER POT TYPE A	1771	
56						56	SPECIAL	69098000	56	EACH	SKATE GUARDS - TYPE A	1767 to 1769	
143						143	SPECIAL	69098000	143	EACH	SKATE GUARDS - TYPE B	1767 to 1769	
1						LS	SPECIAL	69098400	1		ARCHITECTURAL PRECAST CONCRETE PLANTERS (FRONT ST BRIDGE)	1801 to 1803	
		1				LS	SPECIAL	69098400	1		COMPLETE PLANTER WATERPROOFING SYSTEM (FRONT ST BRIDGE)	1804	
1						LS	SPECIAL	69098400	1		ARCHITECTURAL TRELIS (FRONT ST BRIDGE)	1750 1766 1768 1769 1772 1776-1778	
1						LS	SPECIAL	69098400	1		ILLUMINATED SCREEN WALL (FRONT ST BRIDGE)	1781 to 1784	
			295			295	SPECIAL	69098700	295	CY	TREE AND PLANTS SOIL MIX FURNISHED & PLACED, AS PER PLAN (24" DEPTH UPPER HORIZON)	1790 to 1793	
			110			110	SPECIAL	69098700	110	CY	TREE AND PLANTS SOIL MIX FURNISHED & PLACED, AS PER PLAN (9" DEPTH LOWER HORIZON)	1790 to 1793	

MKSK
LANDSCAPE ARCHITECTURE + URBAN PLANNING

CALCULATED
CHECKED

AESTHETIC ENHANCEMENTS SUMMARY

FRA-70/71-
12.68/14.86

NO.	DESCRIPTION	REV. BY	DATE
4	FUNDING SPLIT CODE CHANGE	MKSK/LHW	11.26.2021

3486 - E

1748
1815

P:\2013\c13811.06-70-71 4R & 4H\MICROSTATION\4R (105523)\Sheets\105523\PMJ01a.dgn Sheet 11/18/2021 2:07:47 PM InWilson