

P:\PR51781\fra\7372\mot\sheet\Project_4R\105523MS400.dgn \$d08/2021 11:17:53 PM worley

ITEM	EXTENSION	FUNDING SPLIT		TOTAL	UNIT	DESCRIPTION	SEE SHEET
		01/NHS/PV	01/NHS/PV				
410	12000			200	CY	TRAFFIC COMPACTED SURFACE, TYPE A OR B	70
503	1100			LS		COFFERDAMS AND EXCAVATION BRACING	
607	30001	440	560	1000	FT	FENCE, SNOW, AS PER PLAN	
611	05900	2	2	4	FT	15" CONDUIT, TYPE B	
611	07400	55	71	126	FT	18" CONDUIT, TYPE B	
611	98700	0	1	1	EACH	INLET, SIDE DITCH	
611	99114	0	1	1	EACH	INLET, NO. 3 FOR SINGLE SLOPE BARRIER, TYPE D	
611	99500	2	2	4	EACH	INLET, MISC.: LOCAL DEPRESSION REMOVE FROM INLET	
611	99500	0	1	1	EACH	INLET, MISC.: INLET, CAPPED BELOW GRADE	78
611	99574	0	1	1	EACH	MANHOLE, NO. 3	
611	99910	316	402	718	FT	DRAINAGE STRUCTURE, MISC.: LONGITUDINAL TRENCH DRAIN FOR MOT	78
614	11000			LS		MAINTAINING TRAFFIC	70
614	11110	1980	2520	4500	HOURL	LAW ENFORCEMENT OFFICER WITH PATROL CAR FOR ASSISTANCE	73
614	11630	16786	21364	38150	FT	INCREASED BARRIER DELINEATION	74
614	12380	14	17	31	EACH	WORK ZONE IMPACT ATTENUATOR, 24" WIDE HAZARDS, (UNIDIRECTIONAL)	73
614	12420			LS		DETOUR SIGNING	75
614	12484	2.64	3.36	6	EACH	WORK ZONE INCREASED PENALTIES SIGN	75
614	12500	22	28	50	EACH	REPLACEMENT SIGN	74
614	12600	132	168	300	EACH	REPLACEMENT DRUM	74
614	12801	443	563	1006	EACH	WORK ZONE RAISED PAVEMENT MARKER, AS PER PLAN	70
614	13310	350	446	796	EACH	BARRIER REFLECTOR, TYPE 1, ONE-WAY	74
614	13312	7	9	16	EACH	BARRIER REFLECTOR, TYPE 2, ONE-WAY	76
614	13350	356	454	810	EACH	OBJECT MARKER, ONE WAY	74 / 76
614	18000	66000	84000	150000	EACH	MAINTAINING TRAFFIC, MISC.: BRIDGE DECK AND PAVEMENT PATCHING	77
614	18030	440	560	1000	FT	MAINTAINING TRAFFIC, MISC.: CONSTRUCTION FENCE	77
614	18601	112	142	254	SNMT	PORTABLE CHANGEABLE MESSAGE SIGN, AS PER PLAN	74
614	20011	0.96	1.23	2.19	MILE	WORK ZONE LANE LINE, CLASS I, 6" SPRAY THERMOPLASTIC, AS PER PLAN	74
614	20056	2.55	3.24	5.79	MILE	WORK ZONE LANE LINE, CLASS I, 6", 807 PAINT	
614	21001	0.01	0.02	0.03	MILE	WORK ZONE CENTER LINE, CLASS I SPRAY THERMOPLASTIC, AS PER PLAN	74
614	21058	0.26	0.33	0.59	MILE	WORK ZONE CENTER LINE, CLASS I, 807 PAINT	
614	21100	0.29	0.37	0.66	MILE	WORK ZONE CENTER LINE, CLASS I, 642 PAINT	
614	22011	2.24	2.85	5.09	MILE	WORK ZONE EDGE LINE, CLASS I, 6" SPRAY THERMOPLASTIC, AS PER PLAN	74
614	22056	6.53	8.31	14.84	MILE	WORK ZONE EDGE LINE, CLASS I, 6", 807 PAINT	
614	22110	0.34	0.43	0.77	MILE	WORK ZONE EDGE LINE, CLASS I, 6", 642 PAINT	
614	23011	4319	5498	9817	FT	WORK ZONE CHANNELIZING LINE, CLASS I, 12" SPRAY THERMOPLASTIC, AS PER PLAN	74
614	23100	11612	14780	26392	FT	WORK ZONE CHANNELIZING LINE, CLASS I, 12", 807 PAINT	
614	24001	93	119	212	FT	WORK ZONE DOTTED LINE, CLASS I SPRAY THERMOPLASTIC, AS PER PLAN	74
614	24100	3572	4546	8118	FT	WORK ZONE DOTTED LINE, CLASS I, 4", 807 PAINT	
614	24200	474	603	1077	FT	WORK ZONE DOTTED LINE, CLASS I, 642 PAINT	
614	25200	525	669	1194	FT	WORK ZONE TRANSVERSE/DIAGONAL LINE, CLASS I, 642 PAINT	
614	26200	27	34	61	FT	WORK ZONE STOP LINE, CLASS I, 642 PAINT	
614	30200	8	10	18	EACH	WORK ZONE ARROW, CLASS I, 642 PAINT	
614	40000	191	244	435	FT	LONGITUDINAL CHANNELIZER	76
615	10000			LS		ROADS FOR MAINTAINING TRAFFIC	
615	25000	2145	2729	4874	SY	PAVEMENT FOR MAINTAINING TRAFFIC, CLASS B	
615	25001	44	56	100	SY	PAVEMENT FOR MAINTAINING TRAFFIC, CLASS B, AS PER PLAN, TYPE 1	77
615	25001	22	28	50	SY	PAVEMENT FOR MAINTAINING TRAFFIC, CLASS B, AS PER PLAN, TYPE 2	77
615	25001	9	11	20	SY	PAVEMENT FOR MAINTAINING TRAFFIC, CLASS B, AS PER PLAN, TYPE 3	77
615	25001	9	11	20	SY	PAVEMENT FOR MAINTAINING TRAFFIC, CLASS B, AS PER PLAN, TYPE 4	77
615	20001	2958	3765	6723	SY	PAVEMENT FOR MAINTAINING TRAFFIC, CLASS A, AS PER PLAN	70
616	10000	601	764	1365	MGAL	WATER	74
622	41100	14102	17948	32050		PORTABLE BARRIER, UNANCHORED	
622	4110	97	123	220		PORTABLE BARRIER, ANCHORED	
622	41050	1	2	3	EACH	PORTABLE BARRIER, 4" CONNECTOR	
808	18700	55	69	124	SNMT	DIGITAL SPEED LIMIT (DSL) SIGN ASSEMBLY	75
896	00010	82	104	186	SNMT	PORTABLE NON-INTRUSIVE TRAFFIC SENSOR, CLASS I	77
896	00021	27	35	62	SNMT	PORTABLE CHANGEABLE MESSAGE SIGN, AS PER PLAN	77

NO.	DESCRIPTION	REV. BY	DATE
4	FUNDING SPLIT CHANGE	EMW	11-29-2021
8	ITEM EXTENSION UPDATES	EMW	12-6-2021

MAINTENANCE OF TRAFFIC GENERAL SUMMARY

FRA-70-12.68

CALCULATED
EMW
CHECKED
RMK

UNLESS NOTED OTHERWISE, THE FOLLOWING NOTES PERTAIN TO RETAINING WALLS 4W1, 4W2, 4W4, 4W5, 4W6, 4W7, 4W8, 4W9, 4W10, 4W11, 4W12, 4W20 AND/OR TEMPORARY RETAINING WALLS T2, T3, T4, T5, T6, T7 AND/OR TEMPORARY SHORING WALLS TS2, TS4, TS5, TS6, WHICH ARE ALL PART OF THIS PROJECT.

FOR SPECIFIC NOTES PERTAINING TO CAST-IN-PLACE REINFORCED CONCRETE WALLS ON SPREAD FOOTINGS, WHICH INCLUDE A PORTION OF 4W1, 4W7, AND 4W9, SEE SHEET **7/14**.

FOR SPECIFIC NOTES PERTAINING TO CAST-IN-PLACE REINFORCED CONCRETE WALLS ON DRILLED SHAFTS, WHICH INCLUDE A PORTION OF 4W1, SEE SHEET **8/14**.

FOR SPECIFIC NOTES PERTAINING TO TANGENT DRILLED SHAFT WALLS WITH PRECAST PANELS, WHICH INCLUDE A PORTION OF 4W1, 4W2, AND 4W4, SEE SHEETS **8/14** AND **9/14**.

FOR SPECIFIC NOTES PERTAINING TO MSE WALLS, WHICH INCLUDE 4W5, 4W6, 4W8, 4W10, 4W11, 4W12, AND 4W20, SEE SHEETS **10/14** THROUGH **12/14**.

STANDARD DRAWINGS AND SUPPLEMENTAL SPECIFICATIONS

REFER TO THE FOLLOWING SUPPLEMENTAL SPECIFICATIONS:
 840 DATED 1-18-19 (4W8, 4W10, 4W11, 4W12, 4W20, 4W5, 4W6)
 867 DATED 1-18-19 (T2, T3, T4, T5, T6, T7)

DESIGN SPECIFICATIONS

THESE STRUCTURES CONFORM TO THE "LRFD BRIDGE DESIGN SPECIFICATIONS" ADOPTED BY THE AMERICAN ASSOCIATION OF STATE HIGHWAY AND TRANSPORTATION OFFICIALS, 7TH EDITION, 2014 AND THE ODOT BRIDGE DESIGN MANUAL, 2007 EDITION, INCLUDING REVISIONS THROUGH JULY 2014.

OPERATIONAL IMPORTANCE:

(4W1 4W2 4W4 4W5 4W6)
 A LOAD MODIFIER OF 1.00 HAS BEEN ASSUMED FOR THE DESIGN OF THIS STRUCTURE IN ACCORDANCE WITH THE AASHTO LRFD BRIDGE DESIGN SPECIFICATIONS, ARTICLE 1.3.5 AND THE ODOT BRIDGE DESIGN MANUAL, 2007.

DESIGN STRESSES:

CONCRETE CLASS QC1:
 COMPRESSIVE STRENGTH - 4.0 KSI (ALL COMPONENTS OF ALL WALLS WITH CLASS QC1 CONCRETE SPECIFIED)

CONCRETE CLASS QC2:
 COMPRESSIVE STRENGTH - 4.5 KSI (ALL COMPONENTS OF ALL WALLS WITH CLASS QC2 CONCRETE SPECIFIED)

CONCRETE CLASS QC5:
 COMPRESSIVE STRENGTH - 4.5 KSI (4W1, 4W2, 4W4 DRILLED SHAFTS)

REINFORCING STEEL - MINIMUM YIELD STRENGTH 60 KSI

STRUCTURAL STEEL - ASTM A709 GRADE 50 - YIELD STRENGTH 50 KSI (4W1, 4W2)

DESIGN LOADING

LIVE LOAD SURCHARGE OF 0.240 KSF.
 FUTURE WEARING SURFACE (FWS) OF 0.060 KSF.

HL-93 (4W1, 4W2, 4W4)

EXISTING STRUCTURE PLANS:

PLANS MAY BE EXAMINED BY PROSPECTIVE BIDDERS AT THE OHIO DEPARTMENT OF TRANSPORTATION, DISTRICT 6 OFFICES, 400 E. WILLIAM ST., DELEWARE, OHIO 43015 (PHONE 740-833-8000).

CONSTRUCTION SEQUENCING

WHERE WALL CONSTRUCTION IS PHASED AND A TEMPORARY RETAINING SYSTEM IS REQUIRED, SHOP DRAWINGS OF BOTH PERMANENT AND TEMPORARY WALLS SHALL BE SUBMITTED TO THE ENGINEER FOR APPROVAL. THE COST OF THESE SUBMITTALS SHALL BE INCLUDED FOR PAYMENT WITH THE COST OF THE TEMPORARY WALLS.

ITEM 202 - PORTIONS OF STRUCTURE REMOVED, AS PER PLAN

(4W1) THIS ITEM SHALL INCLUDE REMOVAL OF THE TOP PORTION OF THE EXISTING RETAINING WALL AND FOOTING TOE AS INDICATED IN THE PLANS FROM THE EAST END OF THE NEW PROPOSED WALL TO NEAR THE ANGLE POINT OF THE NEW WALL. IT SHALL ALSO INCLUDE REMOVAL OF THE EXISTING WALL FROM THE TOP OF THE EXISTING WALL TO THE BOTTOM OF THE EXISTING FOOTING FROM THE ANGLE POINT TO THE WEST END OF THE PROPOSED NEW WALL.

(4W2) THIS ITEM SHALL INCLUDE REMOVAL OF THE TOP PORTION OF THE EXISTING RETAINING WALL AND FOOTING TOE AS INDICATED IN THE PLANS FROM THE EAST END OF THE NEW PROPOSED WALL TO NEAR THE ANGLE POINT OF THE NEW WALL. IT SHALL ALSO INCLUDE REMOVAL OF THE EXISTING WALL FROM THE TOP OF THE EXISTING WALL TO THE BOTTOM OF THE EXISTING FOOTING FROM THE ANGLE POINT TO THE WEST END OF THE PROPOSED NEW WALL.

EXCAVATION, SHEETING AND BRACING

EXCAVATION ENVELOPES AS DETAILED IN THE PLANS SHALL BE PROTECTED FROM CAVING AND SLOUGHING. WHERE CLEARANCES AND CONSTRUCTION SEQUENCING WILL NOT ALLOW FOR SLOPED EXCAVATIONS, APPROPRIATE SHEETING OR BRACING METHODS SHALL BE EMPLOYED BY THE CONTRACTOR. THIS TEMPORARY SHEETING OR BRACING IS CONSIDERED INCIDENTAL TO ITEM 503 - COFFERDAMS AND EXCAVATION BRACING.

ITEM 503 - COFFERDAMS AND EXCAVATION BRACING, AS PER PLAN (WALLS 4W1)

THE LEFT IN PLACE SOLDIER PILE DETAILS SHOWN ON THE PLAN FOR TEMPORARY SUPPORT OF EXCAVATION ARE NOT PART OF THE CONTRACT AND ARE ONLY INCLUDED FOR INFORMATION PURPOSES. THE CONTRACTOR IS SOLELY RESPONSIBLE FOR DESIGNING THE SHORING SYSTEM, PREPARING WORKING DRAWINGS, AND PERFORMING CALCULATIONS ACCORDING TO CMS 501.05. THE DEPARTMENT WILL PAY FOR TEMPORARY SUPPORT OF EXCAVATION AT THE LUMP SUM PRICE FOR ITEM 503 - COFFERDAMS AND EXCAVATION BRACING, AS PER PLAN.

ITEM 503 - COFFERDAMS AND EXCAVATION BRACING, AS PER PLAN (WALLS 4W5, 4W6 AND 4W7)

THE DETAILS SHOWN ON THE PLAN FOR TEMPORARY SUPPORT OF EXCAVATION ARE NOT PART OF THE CONTRACT AND ARE ONLY INCLUDED FOR INFORMATION PURPOSES. STEEL SHEETING AND VIBRATORY DRIVING METHODS ARE NOT PERMITTED TO AVOID DAMAGING THE ADJACENT 60" SANITARY SEWER. THE CONTRACTOR IS SOLELY RESPONSIBLE FOR DESIGNING THE SHORING SYSTEM, INCLUDING THE SECTION OVER THE EXISTING 60" SANITARY SEWER, PREPARING WORKING DRAWINGS, AND PERFORMING CALCULATIONS ACCORDING TO CMS 501.05. TEMPORARY SHORING FOR 4W5 AND 4W6 SHALL REMAIN. THE DEPARTMENT WILL PAY FOR TEMPORARY SUPPORT OF EXCAVATION AT THE LUMP SUM PRICE FOR ITEM 503 - COFFERDAMS AND EXCAVATION BRACING, AS PER PLAN.

ITEM 503 - COFFERDAMS AND EXCAVATION BRACING, AS PER PLAN (TS2, TS4, TS5, TS6)

THE DESIGN SHOWN ON THE PLANS FOR TEMPORARY SUPPORT OF EXCAVATION IS ONE REPRESENTATIVE DESIGN THAT MAY BE USED TO CONSTRUCT THE PROJECT. THE CONTRACTOR MAY CONSTRUCT THE DESIGN SHOWN ON THE PLANS OR PREPARE AN ALTERNATE DESIGN TO SUPPORT THE SIDES OF EXCAVATIONS. IF CONSTRUCTING AN ALTERNATE DESIGN FOR TEMPORARY SUPPORT OF EXCAVATION, PREPARE AND PROVIDE PLANS IN ACCORDANCE WITH CMS 501.05. TEMPORARY SHORING OF TS2, TS4 AND TS6 SHALL REMAIN. THE DEPARTMENT WILL PAY FOR THE TEMPORARY SUPPORT OF EXCAVATION AT THE CONTRACT LUMP SUM PRICE FOR COFFERDAMS AND EXCAVATION BRACING. NO ADDITIONAL PAYMENT WILL BE MADE FOR PROVIDING AN ALTERNATE DESIGN.

**ITEM 511 - CLASS QC2 CONCRETE WITH QC/QA, BRIDGE DECK (PARAPET), AS PER PLAN (4W1, 4W2, 4W4, FRA-70-1395C)
 ITEM 511 - CLASS QC2 CONCRETE WITH QC/QA, SIDEWALK, AS PER PLAN (4W1, 4W2)**

FOR NOTES, SEE SHEET 1746A.

ITEM 511 - CLASS QC2 CONCRETE MISC.: LOAD DISTRIBUTION SLAB: (4W5, 4W6)

THIS ITEM SHALL INCLUDE THE CONCRETE CONSTRUCTION AS DETAILED IN THE PLANS INCLUDING THE WORK NECESSARY TO FURNISH & PLACE THE REINFORCING STEEL. A SINGLE LAYER OF #5 BARS SPACED AT 12" (IN BOTH DIRECTIONS) SHALL BE PLACED 3" FROM THE BOTTOM OF THE SLAB. ALL BARS SHALL BE EPOXY COATED. CONCRETE FOR THE PROPOSED WORK SHALL BE CLASS QC2 AS PER CMS 511.

METHOD OF MEASUREMENT: THE DEPARTMENT WILL MEASURE THE CONCRETE CONSTRUCTION BY THE NUMBER OF CUBIC YARDS.

PAYMENT: ALL LABOR, EQUIPMENT, MATERIALS AND INCIDENTALS NECESSARY TO COMPLETE THE WORK SHALL BE INCLUDED IN THE CONTRACT BID PRICE FOR ITEM 511 - CLASS QC2 CONCRETE MISC.: LOAD DISTRIBUTION SLAB.

ITEM 511 - CLASS QC2 CONCRETE, MISC.: PARAPET INCLUDING SLEEPER SLAB, WITH QC/QA (4W5, 4W6, 4W8, 4W12, 4W20)

ALL MATERIALS, LABOR AND INCIDENTALS NECESSARY TO FURNISH AND PLACE CONCRETE FOR THE PARAPET ATOP THE SLEEPER SLAB ALONG THE MSE WALL SHALL BE INCLUDED WITH ITEM 511 - CLASS QC2 CONCRETE, MISC.: PARAPET INCLUDING SLEEPER SLAB, WITH QC/QA. THIS ITEM SHALL INCLUDE ALL JOINT MATERIALS, DOWEL BARS AND BOND BREAKERS IN CONTACT WITH THE SLEEPER SLAB. ALL REINFORCING STEEL IN THE SLEEPER SLAB AND PARAPET SHALL BE INCLUDED WITH ITEM 509.

ALL LABOR, MATERIALS, INCIDENTALS, ETC. NECESSARY FOR SEALING THE LONGITUDINAL CONSTRUCTION JOINT BETWEEN THE SLEEPER SLABS AND THE PARAPETS WITH HMW RESIN PER CMS 511.19 IS ALSO INCLUDED IN THIS ITEM. THE SEALING SHALL OCCUR AND BE FULLY CURED BEFORE THE FINAL PAVEMENT IS PLACED OVER THE SLEEPER SLAB.

ABBREVIATIONS

ABUT.	ABUTMENT	MIN.	MINIMUM
BRG.	BEARING	ADDIT.	ADDITIONAL
BOT.	BOTTOM	FRWD.	FORWARD
BTWN.	BETWEEN	SPL.	SPLICE
CONST. JT., C.J.	CONSTRUCTION JOINT	CLR.	CLEAR
B.S.	BOTH SIDES	P.C.P.P.	PERFORATED CORRUGATED PLASTIC PIPE
N.S.	NEAR SIDE	N.P.C.P.P.	NON-PERFORATED CORRUGATED PLASTIC PIPE
F.S.	FAR SIDE		
SER.	SERIES		
TYP.	TYPICAL		
EQ.	EQUAL		
DIM.	DIMENSION		
SPA.	SPACES		
EA.	EACH		
P.E.J.F.	PERFORMED EXPANSION JOINT FILLER		

ITEM 203 - GRANULAR EMBANKMENT, AS PER PLAN (4W8)

PLACE AND COMPACT GRANULAR EMBANKMENT MATERIAL IN 6 INCH LIFTS FOR THE CONSTRUCTION OF THE APPROACH EMBANKMENT.



DESIGN AGENCY: **GPD GROUP**
 Class, Pyle, Schoner, Burns & DeLaney, Inc.
 1801 Watermark Drive, Suite 130, Columbus, Ohio 43215 614-210-0731
 Copyright © Class, Pyle, Schoner, Burns & DeLaney, Inc. 2015

DESIGNED	DGN	CHECKED	RHC
DRAWN	MOJ	REVISED	
REVIEWED	TJW	STRUCTURE FILE NUMBER	
DATE	9-6-19		

RETAINING WALL GENERAL NOTES
 FRA-70/71-12.68 / 14.86
 PID No. 105523

NO.	DESCRIPTION	REV. BY	DATE
4	ADDED NOTE	MOJ	11-29-2021
8	ADDED NOTE	RFV	12-7-2021

3 / 14
 700
 1815

ITEM 203, SPECIAL - ENGINEERED FILL (EPS GEOFOAM FILL) (4W5, 4W6)

THIS ITEM OF WORK SHALL CONSIST OF FURNISHING AND PLACING EPS GEOFOAM CONFORMING TO ASTM D6817 TYPE EPS 19 GEOFOAM. THE MATERIAL SHALL HAVE A MINIMUM DENSITY OF 1.15 POUNDS PER CUBIC FEET, AND A MINIMUM COMPRESSIVE RESISTANCE OF 5.8 PSI AT 1% STRAIN DEFORMATION.

ALL EPS GEOFOAM BLOCKS SHALL BE TREATED BY THE MANUFACTURER WITH A TESTED AND PROVEN TERMITE TREATMENT FOR BELOW GRADE APPLICATIONS. THE TREATMENT SHALL BE EPA REGISTERED, MEET REQUIREMENTS OF ICC ES AC239, AND BE RECOGNIZED IN AN ICC ES REPORT.

PRIOR TO ORDERING THE MATERIAL FOR THIS ITEM OF WORK, THE CONTRACTOR SHALL FURNISH THE ENGINEER WITH THE FOLLOWING ITEMS:

- EPS GEOFOAM MANUFACTURERS PRODUCT LITERATURE AND TECH DATA INCLUDING PHYSICAL PROPERTIES IN COMPLIANCE WITH THE ASTM D6817 TYPE SPECIFIED.
- SUMMARY OF TEST COMPLIANCE WITH SPECIFIED PERFORMANCE CHARACTERISTICS AND PHYSICAL PROPERTIES.
- PRODUCT CERTIFICATE SHOWING EVIDENCE OF THIRD PARTY QUALITY CONTROL.
- A SIGNED/NOTARIZED CERTIFICATION FROM THE MANUFACTURER THAT THEIR EPS GEOFOAM MATERIAL MEETS THE PLAN REQUIREMENTS
- SHOP DRAWINGS SHOWING BLOCK THICKNESS, WIDTH, LENGTH, AND LAYING PATTERN OR SCHEDULE.

A GEOMEMBRANE SHALL BE PLACED ON THE TOP AND SIDES OF THE GEOFOAM FILL. THE CONTRACTOR SHALL NOT PLACE THE CELLULAR CONCRETE FILL DIRECTLY AGAINST THE GEOFOAM. THE GEOMEMBRANE MATERIAL SHALL BE TRI-POLYMER CONSISTENT WITH POLYVINYL CHLORIDE, ETHYLENE INTERPOLYMER ALLOY, AND A POLYURETHANE, OR A COMPARABLE POLYMER COMBINATION. THE MATERIAL SHALL MEET THE FOLLOWING PHYSICAL AND CHEMICAL REQUIREMENTS.

- THICKNESS: MIN. 28 MILS (ATSM D751)
- UNLEADED GASOLINE VAPOR MAXIMUM 0.40 TRANSMISSION RATE, OZ. PER SQUARE PER 24 HOURS (ASTM D814)
- GRAB TENSILE STRENGTH: MIN. 600 LBS. BOTH MACHINE AND CROSS DIRECTION (1" GRIP 4' x 8' SAMPLE ASTM D751)
- ELONGATION AT BREAK: 20% MIN. (ASTM D751)
- TOUGHNESS: 14,000 MIN. (GRAB TENSILE STRENGTH x PERCENT ELONGATION)
- PUNCTURE RESISTANCE: 800 LB. MIN. (ASTM D751 BALL TIP)
- COLD CRACK: PASS -30° FAHRENHEIT (ASTM D2136 1" MANDREL, 4 HR)
- FACTORY SEAMS: 2 INCH MIN. BONDED WIDTH
- SHEAR: 320 LBS. MIN. (ASTM D751)

A SIGNED/NOTARIZED CERTIFICATION OF COMPLIANCE SHALL BE FURNISHED BY THE MANUFACTURER STATING THE SELECTED GEOMEMBRANE HAS BEEN TESTED AND MEETS THE ABOVE REQUIREMENTS. JOINTS IN THE GEOMEMBRANE WRAP SHALL BE LAPPED A MINIMUM OF 18 INCHES.

ON THE SOUTH SIDE OF THE EXISTING RETAINING WALL ALONG FULTON STREET, THE GEOFOAM SHALL BE PLACED ON A BASE OF CELLULAR CONCRETE FILL, CLASS II. ON THE NORTH SIDE OF THE RETAINING WALL, THE GEOFOAM FILL SHALL BE PLACED ON A BASE OF GRANULAR MATERIAL CONFORMING TO SIZE NO. 9 OF TABLE 703.01-1 OF THE CMS. THE GRANULAR BASE SHALL ALSO BE PLACED ALONG THE SIDES OF THE GEOFOAM FILL THAT ARE IN CONTACT WITH SOIL (NORTH AND EAST SIDES OF THE GEOFOAM).

CARE SHALL BE TAKEN TO PROTECT THE GEOFOAM BLOCKS FROM EXPOSURE TO GASOLINE, SOLVENT NAPHTHA, FUEL OIL, MINERAL OIL, TURPENTINE, OR ANY OTHER SOLVENT. THE BLOCKS SHALL ALSO BE PROTECTED FROM EXPOSURE TO ANY HEAT SOURCE WHICH WOULD REACH 175 DEGREES (F). GEOFOAM SHALL BE STORED ABOVE GROUND, AND PROTECTED FROM MOISTURE AND SUNLIGHT PRIOR TO INSTALLATION.

DAMAGE TO GEOFOAM SHALL BE CORRECTED AS FOLLOWS:

- SLIGHT DAMAGE (< 0.12 CU FT) WITH NO LINEAR DIMENSION GREATER THAN 1 FOOT MAY BE LEFT IN PLACE AS IS.
- MODERATE DAMAGE (< 0.35 CU FEET) WITH NO LINEAR DIMENSION GREATER THAN 1 FOOT SHALL BE FILLED IN WITH SAND.
- GEOFOAM BLOCKS WITH EXCESSIVE DAMAGE (I.E. EXCEEDING THE MODERATE CATEGORY) SHALL BE REPLACED WITH GEOFOAM BLOCKS WHICH MEET THE DAMAGE CRITERIA. GEOFOAM BLOCKS NOT MEETING THE CRITERIA MAY BE CUT TO ELIMINATE THE EXCESSIVE DAMAGE AND THE REMAINING UNDAMAGED PORTION OF THE BLOCK MAY BE USED WITHIN THE FILL, PROVIDED THE UNDAMAGED PORTION OF THE BLOCK MEETS ALL OTHER REQUIREMENTS. SEE SHEETS 111 & 186A FOR SITE PREPARATION, 1815 & 1815

AREA OF APPLICATION, AND EMBANKMENT TO BE PLACED ON TOP OF THE GEOFOAM BLOCKS.

PLACEMENT:

THE SURFACE OF A LAYER OF GEOFOAM BLOCKS TO RECEIVE ADDITIONAL GEOFOAM BLOCKS SHALL BE CONSTRUCTED WITH A VARIATION IN SURFACE TOLERANCE OF NO MORE THAN 1/2" IN ANY 10 FOOT INTERVAL. ALL BLOCKS SHALL BE ACCURATELY FIT RELATIVE TO ADJACENT BLOCKS. NO GAPS GREATER THAN 1" WILL BE ALLOWED ON VERTICAL JOINTS. THE FINISHED SURFACE OF THE GEOFOAM FILL BENEATH PAVEMENT SECTIONS SHALL BE CONSTRUCTED TO WITHIN THE TOLERANCE OF ZERO MINUS 2.5" OF THE INDICATED GRADE.

BLOCKS PLACED IN A ROW IN A PARTICULAR LAYER SHALL BE OFFSET 2 FEET RELATIVE TO BLOCKS PLACED IN ADJACENT ROWS OF THE SAME LAYER. IN ORDER TO AVOID CONTINUOUS JOINTS, EACH SUBSEQUENT LAYER OF BLOCKS SHALL BE ROTATED ON THE HORIZONTAL PLANE 90 DEGREES FROM THE DIRECTION OF PLACEMENT OF THE PREVIOUS LAYER.

THE LONGITUDINAL AXES OF THE UPPERMOST LAYER OF BLOCKS MUST BE PERPENDICULAR TO THE LONGITUDINAL AXIS OF THE ROAD ALIGNMENT.

CONNECTOR PLATES SHALL BE PLACED BETWEEN HORIZONTAL LAYERS OF BLOCK. A MINIMUM OF TWO CONNECTOR PLATES SHALL BE USED BETWEEN BLOCKS.

CONNECTORS SHALL BE GALVANIZED STEEL OR STAINLESS STEEL TWO SIDED MULTI-BARBED CONNECTORS. EACH CONNECTOR SHALL HAVE A LATERAL HOLDING STRENGTH OF AT LEAST 60 LBS. PROVIDE A SIGNED/NOTARIZED CERTIFICATION FROM THE MANUFACTURER THAT THE CONNECTOR PLATES MEET MATERIAL, DESIGN AND STRENGTH REQUIREMENTS OF THESE PLANS.

BLOCKS SHALL BE CUT USING A SAW OR HOT WIRE.

TO PREVENT THE COMPLETED GEOFOAM STRUCTURE FROM DISLODGING OR SHIFTING, CONSTRUCTION OF EMBANKMENT ADJACENT TO THE GEOFOAM SHALL BE DONE SO THAT THE LATERAL EARTH PRESSURES FROM OPPOSITE SIDES REMAIN APPROXIMATELY EQUAL.

NO VEHICLE OR CONSTRUCTION EQUIPMENT SHALL TRAVERSE DIRECTLY ON THE EPS BLOCKS OR ON ANY SEPARATION MATERIAL PLACED BETWEEN THE EPS BLOCKS AND THE PAVEMENT SYSTEM. SOIL FOR THE PAVEMENT SYSTEM SHALL BE PUSHED ONTO THE EPS BLOCKS OR SEPARATION LAYER USING APPROPRIATE EQUIPMENT. A MINIMUM OF 12 INCHES OF FILL SHALL COVER THE TOP OF THE GEOFOAM BLOCK OR SEPARATION LAYER BEFORE COMPACTION COMMENCES. THE CONTRACTOR'S EQUIPMENT USED DURING COMPACTION SHALL NOT PLACE A PRESSURE GREATER THAN 18 PSI ON THE GEOFOAM BLOCKS AT ANY TIME DURING CONSTRUCTION. ANY DAMAGE TO THE GEOFOAM BLOCKS RESULTING FROM THE CONTRACTOR'S VEHICLES, EQUIPMENT, OR OPERATIONS SHALL BE REPLACED BY THE CONTRACTOR.

PAYMENT FOR THIS ITEM OF WORK SHALL BE PAID FOR BY THE UNIT PRICE BID PER CUBIC YARD OF ITEM SPECIAL - ENGINEERED FILL (EPS GEOFOAM FILL), WHICH PRICE AND PAYMENT INCLUDES ALL MATERIALS, SITE PREPARATION (EXCLUDING EXCAVATION), GRANULAR BASE, GEOMEMBRANE WRAP, TOOLS, EQUIPMENT, AND LABOR TO COMPLETE THIS ITEM OF WORK IN PLACE.

ALL QUANTITIES AND COSTS ASSOCIATED WITH THIS ITEM SHALL BE INCLUDED IN THE ESTIMATED QUANTITIES AND COST ESTIMATE FOR WALLS 4W5 AND 4W6 ONLY.

NO.	DESCRIPTION	REV. BY	DATE
8	ADDED SHEET CALLOUT	RFV	12-7-2021

ITEM 203, SPECIAL - ENGINEERED FILL (LIGHTWEIGHT CELLULAR CONCRETE FILL): (4W1, 4W2, 4W5, 4W6)

A. DESCRIPTION.

THIS WORK CONSISTS OF FURNISHING AND PLACING A LOW DENSITY, LIGHTWEIGHT, FLOWABLE, CEMENTITIOUS FILL MATERIAL, HEREIN REFERRED TO AS CELLULAR CONCRETE FILL (CCF).

B. QUALIFICATIONS.

1. **CONTRACTOR.**
PROVIDE CCF FROM A CONTRACTOR REGULARLY ENGAGED IN THE PLACEMENT OF CCF MATERIAL, WHO HAS IN THE PAST THREE YEARS COMPLETED MASS FILLS HAVING A COMBINED QUANTITY OF AT LEAST 10,000 TOTAL CUBIC YARDS (7,650 CUBIC METERS).

2. **CCF MATERIAL.**

PROVIDE CCF MATERIAL, MEETING THE REQUIREMENT OF SECTION C OF THIS SPECIFICATION, WHICH HAS BEEN SUCCESSFULLY PLACED ON AT LEAST 5 PROJECTS THAT HAVE PERFORMED SATISFACTORY FOR AT LEAST FIVE YEARS.

C. MATERIALS

1. **FOAM.**

USE A FOAMING AGENT CONFORMING TO ASTM C796. PERVIOUS CCF SHALL COMPLY WITH THE STANDARD SPECIFICATIONS OF ASTM C869 WHEN TESTED IN ACCORDANCE WITH ASTM C796.

2. **CEMENT.**

USE PORTLAND CEMENT CONFORMING TO C&MS 701.04 OR C&MS 701.05

3. **WATER.**

USE WATER ACCORDING TO C&MS 499.02. POTABLE WATER IS SATISFACTORY FOR USE IN CCF.

4. **ADMIXTURES.**

USE ADMIXTURES CONFORMING TO C&MS 499.02 FOR WATER REDUCING, RETARDING, ACCELERATING, IMPROVING THE BOND, OR FOR OTHER SPECIFIC PROPERTIES, WHEN SPECIFICALLY APPROVED BY THE SUPPLIER/PRODUCER OF THE CCF.

5. 701.10 MICRO-SILICA, 701.11 GGBF SLAG, OR FLY ASH SHALL BE CLASS C OR CLASS F AND COMPATIBLE WITH FOAMING AGENT.

D. MIX DESIGN.

DESIGN OF THE PROPOSED CCF MIX WILL BE PROVIDED BY THE SUPPLIER/PRODUCER. THE PROPOSED MIX DESIGN MUST MEET THE PROPERTIES OF TABLE A.

E. QUALITY CONTROL AND ASSURANCE.

PERFORM CAST DENSITY MEASUREMENTS HOURLY ON EACH DAY OF PRODUCTION. MAINTAIN A LOG OF THE CAST DENSITY MEASUREMENTS. QUALITY ASSURANCE WILL BE BASED ON THE CAST DENSITY AND COMPRESSIVE STRENGTH AT THE POINT OF PLACEMENT. ANY MIXES NOT MEETING THE TABLE A PROPERTIES WILL BE REJECTED.

COMPRESSIVE STRENGTH.

TAKE AT LEAST FOUR (4) TEST SPECIMENS FOR EACH 300 CUBIC YARDS (230 CUBIC METERS) OF CCF PLACED OR FOR EACH DAY'S PRODUCTION, PREPARE, CURE, AND TEST THE SPECIMENS IN ACCORDANCE WITH ASTM C796 EXCEPT AS FOLLOWS:

1) FILL AN APPROPRIATE 3-INCH BY 6-INCH (75 MM BY 150 MM) CYLINDER MOLD ACCORDING TO ASTM C796, EXCEPT STRIKE OFF THE EXCESS CCF WITH A TROWEL.

2) CURE THE MOLDS IN A CURING BOX.

3) AFTER CURING, DO NOT OVEN DRY THE SPECIMENS THAT ARE TO BE LOAD TESTED. AIR DRY THE SPECIMENS FOR 1 TO 3 DAYS PRIOR TO TESTING.

4) PROVIDE THE SPECIMENS TO THE ENGINEER FOR TESTING. WHILE SPECIMENS MAY BE TESTED AT ANY AGE TO MONITOR COMPRESSIVE STRENGTH OF THE CCF, A MINIMUM OF TWO SPECIMENS SHALL BE TESTED AT 28 DAYS FOR ACCEPTANCE.

5. CONSTRUCTION METHODS.

PLACEMENT OF CCF SHALL BE ACCORDING TO PROCEDURES PROVIDED BY THE CONTRACTOR. PORTABLE PLANT SHALL COMPLY WITH CMS ITEM 107.11.C AND ALL APPLICABLE ENVIRONMENTAL PERMITS AND REGULATIONS.

i. PREPARATION.

THE ENGINEER WILL EXAMINE THE SUBSOIL CONDITIONS IN THE PLACEMENT AREAS. CORRECT UNSUITABLE SOIL CONDITIONS PRIOR TO PLACING THE CCF. PROPERLY FIX IN PLAN POSITION ITEMS TO BE ENCASED IN THE CCF. COAT ANY ALUMINUM TO PREVENT OXIDATION FROM THE FRESH CONCRETE.

ii. WEATHER.

DO NOT PLACE CCF WHEN THE SUBSOIL IS FROZEN, WHEN THE AMBIENT TEMPERATURE IS LESS THAN 32°F (0°C), OR WHEN FREEZING CONDITIONS ARE EXPECTED IN LESS THAN 24 HOURS. IF THESE CONDITIONS CANNOT BE MET, FOLLOW THE MATERIAL PRODUCER/SUPPLIER'S RECOMMENDATIONS TO DETERMINE PRECAUTIONS NECESSARY TO ASSURE ACCEPTABLE INSTALLATION.

TAKE PRECAUTIONS TO AVOID DAMAGE TO THE CCF FROM FREEZING TEMPERATURES PER THE MATERIAL PRODUCER/SUPPLIER'S RECOMMENDATIONS.

iii. MIXING AND CONVEYING.

USE JOB SITE MIXING AND CONVEYING EQUIPMENT FOR PROPORTIONING, MIXING AND PLACING THE CCF APPROVED BY THE SUPPLIER/PRODUCER. MIX THE MATERIALS ACCORDING TO THE SUPPLIER/PRODUCER MIX DESIGN PROCEDURES AND, PROMPTLY AFTER MIXING, CONVEY THE CCF TO ITS FINAL POSITION. AVOID EXCESSIVE HANDLING OF THE CCF.

iv. PLACEMENT.

1) TOP OF THE CLASS III CCF SHALL NOT BE LESS THAN 2'-0" BELOW THE TOP OF PAVEMENT.

2) THE TOP OF THE CLASS II CCF SHALL NOT BE LESS THAN 4'-0" FROM THE TOP OF PAVEMENT.

3) THE TOP OF THE PERVIOUS CCF SHALL NOT BE LESS THAN 3'-0" FROM THE BOTTOM OF THE SIDEWALK.

DO NOT PLACE CCF IN LIFTS GREATER THAN 48" UNLESS RECOMMENDED BY THE MANUFACTURER.

DO NOT PLACE CCF INTO AN AREA OF STANDING WATER. PROVIDE AN INVERTED CROWN IN THE CLASS III CCF, AND PIPE UNDERDRAINS, AS SHOWN IN THE DETAILS.

FINISHING THE CCF:

THE TOP SURFACE OF THE CCF SHALL BE FINISHED TO DRAIN AS SHOWN ON THE PLANS. THE FINISHING MAY BE EXECUTED DURING PLACEMENT, OR GRADED AFTERWARDS, AT THE CONTRACTOR'S DISCRETION. THE FINISHED SURFACE SHALL NOT EXHIBIT EXCESSIVE CRACKING SUBJECT TO THE APPROVAL OF THE ENGINEER.

v. LOADING.

DO NOT APPLY ANY LOAD ONTO THE CCF UNTIL IT HAS ATTAINED A COMPRESSIVE STRENGTH OF AT LEAST 20 PSI (0.14 MPA).

TABLE A - CELLULAR CONCRETE FILL PROPERTIES

PROPERTY	CLASS II	CLASS III	PERVIOUS
*-CAST DENSITY, MAX	30 LB/FT ³ (481 KG/M ³)	36 LB/FT ³ (577 KG/M ³)	35 LB/FT ³ (561 KG/M ³)
** - COMPRESSIVE STRENGTH, MIN. @ 28 DAYS	40 PSI (0.28 MPA)	80 PSI (0.55 MPA)	210 PSI (1.45 MPA)
*** - WATER ABSORPTION, ASTM C796, MAX.	20 PERCENT	16 PERCENT	N/A
COEFFICIENT OF PERMEABILITY	N/A	N/A	247 FT/DAY (0.087 CM/SEC)

* - SPECIFIED IN SECTION F.1 OF THIS SPECIFICATION
** - SPECIFIED IN SECTION F.2 OF THIS CLASSIFICATION
*** - EXPRESSED AS PERCENT OF CAST DENSITY

F. SUBMITTALS TO THE ENGINEER.

PROVIDE THE FOLLOWING SUBMITTALS TO THE ENGINEER A MINIMUM OF 30 DAYS PRIOR TO PLACEMENT OF CCF FOR EACH LOCATION:

1. RESUME OF CONTRACTOR'S SHOWING EXPERIENCE AS SPECIFIED ABOVE, INCLUDING QUALIFICATIONS OF CONTRACTOR'S SUPERINTENDENT AND/OR FOREMAN.

2. CCF MIX DESIGN MEETING THE REQUIREMENTS SPECIFIED ABOVE, INCLUDING MATERIALS TO BE USED, THEIR SOURCES AND TEST DATA.

3. QC PLAN IDENTIFYING THE METHOD AND FREQUENCY OF TESTING IN ACCORDANCE WITH ASTM C796 AND MEETING THE REQUIREMENTS ABOVE.

4. DESCRIPTION OF EQUIPMENT AND PLACEMENT METHODS TO VERIFY COMPLIANCE WITH THE MIXING AND CONVEYING REQUIREMENTS GIVEN IN THIS NOTE.

5. WORKING DRAWINGS SHOWING METHOD OF PLACEMENT FOR CONSTRUCTION PER THE PLANS AND DEMONSTRATING COMPLIANCE WITH THIS NOTE. THESE DRAWINGS SHALL PROVIDE SECTIONS LOCATING THE CROWNS AND LOCATIONS OF THE STEPS IN THE CLASS III CCF LIFT.

G. METHOD OF MEASUREMENT.

THE DEPARTMENT WILL MEASURE EACH CLASS OF CCF BY THE NUMBER OF CUBIC YARDS COMPLETE IN PLACE.

H. BASIS OF PAYMENT.

THE DEPARTMENT WILL PAY FOR ACCEPTED QUANTITIES AT THE CONTRACT PRICE AS FOLLOWS:

ITEM	UNIT	DESCRIPTION
SPECIAL	CUBIC YARD	ENGINEERED FILL: LIGHTWEIGHT CELLULAR CONCRETE FILL, CLASS II (4W5, 4W6)
SPECIAL	CUBIC YARD	ENGINEERED FILL: LIGHTWEIGHT CELLULAR CONCRETE FILL, CLASS III (4W5, 4W6)
SPECIAL	CUBIC YARD	ENGINEERED FILL: LIGHTWEIGHT CELLULAR CONCRETE FILL, PERVIOUS (4W1, 4W2)

ALL QUANTITIES AND COSTS ASSOCIATED WITH THIS ITEM BETWEEN STA. 176+50 AND STA. 182+00 (B CONST. FUTURE I-70 EB) SHALL BE INCLUDED IN THE ESTIMATED QUANTITIES AND COST ESTIMATE FOR WALLS 4W5 AND 4W6.

NO.	DESCRIPTION	REV. BY	DATE
1	REVISED NOTE	MOJ	11-5-2021
8	REVISED NOTE	RFV	12-7-2021

FOUNDATION BEARING RESISTANCE (4W1, 4W7, 4W9)

THE C.I.P. PORTION OF WALL 4W1 FOOTINGS, AS DESIGNED, PRODUCE A MAXIMUM SERVICE LOAD PRESSURE OF 3.1 KIPS PER SQUARE FOOT AND A MAXIMUM STRENGTH LOAD PRESSURE OF 4.5 KIPS PER SQUARE FOOT. THE FACTORED BEARING RESISTANCE IS 50.4 KIPS PER SQUARE FOOT.

THE 15'-0" WIDE PORTION OF C.I.P. WALL 4W7 FOOTINGS, AS DESIGNED, PRODUCE A MAXIMUM SERVICE LOAD PRESSURE OF 4.8 KIPS PER SQUARE FOOT AND A MAXIMUM STRENGTH LOAD PRESSURE OF 7.6 KIPS PER SQUARE FOOT. THE FACTORED BEARING RESISTANCE IS 18.8 KIPS PER SQUARE FOOT.

THE 12'-0" WIDE PORTION OF C.I.P. WALL 4W7 FOOTINGS, AS DESIGNED, PRODUCE A MAXIMUM SERVICE LOAD PRESSURE OF 3.7 KIPS PER SQUARE FOOT AND A MAXIMUM STRENGTH LOAD PRESSURE OF 5.9 KIPS PER SQUARE FOOT. THE FACTORED BEARING RESISTANCE IS 17.3 KIPS PER SQUARE FOOT.

THE 11'-0" WIDE PORTION OF C.I.P. WALL 4W7 FOOTINGS, AS DESIGNED, PRODUCE A MAXIMUM SERVICE LOAD PRESSURE OF 2.6 KIPS PER SQUARE FOOT AND A MAXIMUM STRENGTH LOAD PRESSURE OF 3.8 KIPS PER SQUARE FOOT. THE FACTORED BEARING RESISTANCE IS 16.8 KIPS PER SQUARE FOOT.

C.I.P. WALL 4W9 FOOTINGS, AS DESIGNED, PRODUCE A MAXIMUM SERVICE LOAD PRESSURE OF 1.7 KIPS PER SQUARE FOOT AND A MAXIMUM STRENGTH LOAD PRESSURE OF 2.4 KIPS PER SQUARE FOOT. THE FACTORED BEARING RESISTANCE IS 15.0 KIPS PER SQUARE FOOT.

- ITEM 511 - CLASS QC1 CONCRETE WITH QC/QA, RETAINING/WINGWALL INCLUDING FOOTING, AS PER PLAN (4W9)**
- ITEM 511 - CLASS QC1 CONCRETE WITH QC/QA, FOOTING, AS PER PLAN: (4W1, 4W7)**

IN ADDITION TO THE REQUIREMENTS OF THE 511 ITEMS LISTED ABOVE, INSTALL A REFERENCE MONUMENT AT THE LOCATIONS SHOWN IN THE TABLES TO THE RIGHT. THE REFERENCE MONUMENT SHALL CONSIST OF A #8, OR LARGER, EPOXY COATED REBAR EMBEDDED AT LEAST 6" INTO THE FOOTING AND EXTENDED VERTICALLY 4 TO 6 INCHES ABOVE THE TOP OF THE FOOTING. INSTALL A SIX INCH DIAMETER, SCHEDULE 40, PLASTIC PIPE AROUND THE REFERENCE MONUMENT. CENTER THE PIPE ON THE REFERENCE MONUMENT AND PLACE THE PIPE VERTICAL WITH ITS TOP AT THE FINISHED GRADE. THE PIPE SHALL HAVE A REMOVABLE, SCHEDULE 40, PLASTIC CAP. PERMANENTLY ATTACH THE BOTTOM OF THE PIPE TO THE TOP OF THE FOOTING.

ESTABLISH A BENCHMARK TO DETERMINE THE ELEVATIONS OF THE REFERENCE MONUMENTS AT VARIOUS MONITORING PERIODS THROUGHOUT THE LENGTH OF THE CONSTRUCTION PROJECT. THE BENCHMARK SHALL BE THE SAME THROUGHOUT THE PROJECT AND SHALL BE INDEPENDENT OF ALL STRUCTURES.

RECORD THE ELEVATION OF EACH REFERENCE MONUMENT AT EACH MONITORING PERIOD SHOWN IN THE TABLES TO THE RIGHT.

THE ORIGINAL COMPLETED TABLES WILL BECOME PART OF THE DISTRICT'S PROJECT PLAN RECORDS.

PROJECT NUMBER:		FRA-70/71-12.68/14.86, PID: 105523			
BENCHMARK LOCATION:					
SPREAD FOOTING PORTION OF WALL 4W1	15'-0" WIDE FOOTING				
MAX. FACTORED BEARING PRESSURE	4.5 KIPS PER SQUARE FOOT				
MONITORING PERIOD	MONUMENT #1 ALIGNMENT: B/L CONST. FUTURE I-70 EB STA. 190+51.17 OFFSET: 47.41' RT.	MONUMENT #2 ALIGNMENT: B/L CONST. FUTURE I-70 EB STA. 191+03.92 OFFSET: 47.54' RT.			
AFTER FOOTING CONCRETE IS PLACED:					
AFTER STEM CONCRETE IS PLACED					
AFTER BARRIER CONCRETE IS PLACED:					
PROJECT COMPLETION:					

PROJECT NUMBER:		FRA-70/71-12.68/14.86, PID: 105523			
BENCHMARK LOCATION:					
C.I.P. WALL 4W7	15'-0" WIDE FOOTING PORTION	12'-0" WIDE PORTION	11'-0" WIDE FOOTING PORTION		
MAX. FACTORED BEARING PRESSURE	7.6 KIPS PER SQUARE FOOT	5.9 KSF	3.8 KIPS PER SQUARE FOOT		
MONITORING PERIOD	MONUMENT #1 ALIGNMENT: B/L CONST. FUTURE I-70 EB STA. 177+04.32 OFFSET: 43.01' LT.	MONUMENT #2 ALIGNMENT: B/L CONST. FUTURE I-70 EB STA. 178+36.73 OFFSET: 41.78' LT.	MONUMENT #3 ALIGNMENT: B/L CONST. FUTURE I-70 EB STA. 179+73.73 OFFSET: 41.95' LT.	MONUMENT #4 ALIGNMENT: B/L CONST. FUTURE I-70 EB STA. 180+63.73 OFFSET: 42.07' LT.	MONUMENT #5 ALIGNMENT: B/L CONST. FUTURE I-70 EB STA. 181+15.28 OFFSET: 43.53' LT.
AFTER FOOTING CONCRETE IS PLACED:					
AFTER STEM CONCRETE IS PLACED					
AFTER BARRIER CONCRETE IS PLACED:					
PROJECT COMPLETION:					

PROJECT NUMBER:		FRA-70/71-12.68/14.86, PID: 105523			
BENCHMARK LOCATION:					
C.I.P. WALL 4W9	6'-6" WIDE FOOTING				
MAX. FACTORED BEARING PRESSURE	2.4 KIPS PER SQUARE FOOT				
MONITORING PERIOD	MONUMENT #1 ALIGNMENT: B/L WALL 4W9 STA. 1+02.00 OFFSET: 2.50' LT.	MONUMENT #2 ALIGNMENT: B/L WALL 4W9 STA. 2+39.07 OFFSET: 2.50' LT.			
AFTER FOOTING CONCRETE IS PLACED:					
AFTER STEM CONCRETE IS PLACED					
AFTER BARRIER CONCRETE IS PLACED:					
PROJECT COMPLETION:					



NO.	DESCRIPTION	REV. BY	DATE
8	REMOVED TABLE	RFV	12-7-2021

01-2012-2012048 VFR\105523\STRUCTURES\WALL_4W1\SHEETS\105523_MN02.DGN
 12/6/2021 11:43:22 PM
 0001Y81STD_USER

RETAINING WALL GENERAL NOTES
 CAST-IN-PLACE CONCRETE WALLS

DESIGN AGENCY: **GPD GROUP**
 Class, P.E., Schaner, Burns & DeLaney, Inc.
 1801 Watermark Drive, Suite 130, Columbus, Ohio 43215 614-210-0731
 Copyright © Schaner, Burns & DeLaney, Inc. 2015

REVIEWED: T.J.W. DATE: 9-6-19
 DRAWN: MOJ STRUCTURE FILE NUMBER:

DESIGNED: DGN CHECKED: RHC

FRA-70/71-12.68 / 14.86
 PID No. 105523

7 / 14
 704
 1815

ESTIMATED QUANTITIES

CALCULATED: RHC DATE: 5/27/19
 CHECKED: DJC DATE: 5/31/19

ITEM	EXT.	TOTAL	PARTICIPATION [△]		UNITS	DESCRIPTION	REFERENCE SHEET NO. --- / 1815
			01/NHS/PV	01/NHS/PV			
202	11201	LS	LS	LS		PORTIONS OF STRUCTURE REMOVED, AS PER PLAN	700
[△] 503	11100	LS	LS	LS		COFFERDAMS AND EXCAVATION BRACING	
503	11101	LS	LS	LS		COFFERDAMS AND EXCAVATION BRACING, AS PER PLAN	700
503	21100	710	312	398	CY	UNCLASSIFIED EXCAVATION	
509	10000	116,285	51,165	65,120	LB	EPOXY COATED REINFORCING STEEL	
511	34451	42	18	24	CY	CLASS QC2 CONCRETE WITH QC/QA, BRIDGE DECK (PARAPET), AS PER PLAN	1746A
511	46012	502	221	281	CY	CLASS QC1 CONCRETE WITH QC/QA RETAINING/WINGWALL NOT INCLUDING FOOTING	
511	46513	208	92	116	CY	CLASS QC1 CONCRETE WITH QC/QA, FOOTING, AS PER PLAN	
511	51513	179	79	100	CY	CLASS QC2 CONCRETE WITH QC/QA, SIDEWALK, AS PER PLAN	1746A
511	53010	240	106	134	CY	CLASS QC1 CONCRETE, MISC.: SUPPORT BRACKET AND DRILLED SHAFT CAP	705
511	53010	16	7	9	CY	CLASS QC1 CONCRETE, MISC.: CAST-IN-PLACE CONCRETE WALL	705
512	10050	287	126	161	SY	SEALING CONCRETE SURFACES (NON-EPOXY)	1746A
512	10100	1,069	470	599	SY	SEALING CONCRETE SURFACES (EPOXY-URETHANE)	1746A
512	33000	169	74	95	SY	TYPE 2 WATERPROOFING	
513	10220	201,414	88,622	112,792	LB	STRUCTURAL STEEL MEMBERS, LEVEL 1	
516	13600	286	126	160	SF	1" PREFORMED EXPANSION JOINT FILLER	
518	21200	306	135	171	CY	POROUS BACKFILL WITH GEOTEXTILE FABRIC	
518	39900	460	202	258	FT	4" NON-PERFORATED CORRUGATED PLASTIC PIPE, INCLUDING SPECIALS	
518	40000	417	183	234	FT	6" PERFORATED CORRUGATED PLASTIC PIPE	
524	95472	390	172	218	FT	DRILLED SHAFTS, 60" DIAMETER, ABOVE BEDROCK WITH QC/QA, AS PER PLAN	705
524	95492	1,133	499	634	FT	DRILLED SHAFTS, 72" DIAMETER, ABOVE BEDROCK WITH QC/QA, AS PER PLAN	705
607	98000	307	135	172	FT	FENCE MISC.: WALL MOUNTED TYPE A (WITH VANDAL MESH)	1746A
867	00101	LS	LS	LS		TEMPORARY WIRE FACED MECHANICALLY STABILIZED EARTH WALL, AS PER PLAN	707
SPECIAL	20302000	1,496	658	838	CY	ENGINEERED FILL: LIGHTWEIGHT CELLULAR CONCRETE FILL, PERVIOUS	702

NO.	DESCRIPTION	REV. BY	DATE
4	FUNDING CODE CHANGE	CWL	11-29-2021
6	QUANTITY UPDATE	MOJ	12-3-2021
8	ADDED ITEM	RFV	12-7-2021

DESIGN SPECIFICATIONS

THIS STRUCTURE CONFORMS TO THE "LRFD BRIDGE DESIGN SPECIFICATIONS" ADOPTED BY THE AMERICAN ASSOCIATION OF STATE HIGHWAY AND TRANSPORTATION OFFICIALS, 7TH EDITION, 2014 AND THE ODOT BRIDGE DESIGN MANUAL, 2007 EDITION, INCLUDING REVISIONS THROUGH JULY 2015.

STANDARD DRAWINGS

REFER TO THE FOLLOWING ODOT STANDARD BRIDGE DRAWINGS:

- AS-1-15 REVISED: 7-17-15
- AS-2-15 REVISED: 1-18-19
- EXJ-4-87 REVISED: 1-19-18
- GSD-1-19 REVISED: 1-18-19

AND TO THE FOLLOWING SUPPLEMENTAL SPECIFICATION:

- 800 DATED: 10-15-21
- 832 DATED: 10-19-18
- 846 DATED: 4-17-15

DESIGN DATA

OPERATIONAL IMPORTANCE: A LOAD MODIFIER OF 1.00 HAS BEEN ASSUMED FOR THE DESIGN OF THIS STRUCTURE IN ACCORDANCE WITH THE AASHTO LRFD BRIDGE DESIGN SPECIFICATIONS, ARTICLE 1.3.5 AND THE ODOT BRIDGE DESIGN MANUAL, 2007.

DESIGN LOADING

- HL-93 (VEHICULAR BRIDGE)
- AASHTO STANDARD SPECIFICATIONS H-10 TRUCK (CAP)
- FUTURE WEARING SURFACE (FWS) OF 0.060 KIPS PER SQUARE FOOT (EXCLUDING THE EAST CAP)
- SATURATED SOIL UNIT WEIGHT OF 0.120 KIPS/CU. FT.
- PLANTER BOX PRECAST CONCRETE UNIT WEIGHT OF 0.150 KIPS/CU. FT.
- DECORATIVE TRELLIS - REAR SUPPORT POSTS UNIT WEIGHT OF 6.0 KIPS/EACH (INCLUDING TRELLIS PADS); FRONT SUPPORT POSTS UNIT OF 6.8 KIPS/EACH (INCLUDING TRELLIS PADS)
- SCREEN WALL UNIT WEIGHT OF 0.095 KIPS/FT.
- PEDESTRIAN PED POLE UNIT WEIGHT OF 0.20 KIPS/EACH
- LIGHT POLE UNIT WEIGHT OF 0.30 KIPS/EACH
- MAST ARM SIGNAL POLE UNIT WEIGHT OF 1.50 KIPS/EACH
- UTILITY CONDUITS INCLUDING HANGER SUPPORTS UNIT WEIGHT OF 0.080 KIPS/FT.
- MATURE TREE UNIT WEIGHT OF 3.2 KIPS/EACH
- SIDEWALK LIVE LOAD OF 0.075 KIPS/SQ. FT.

DESIGN STRESSES

- CONCRETE CLASS QC2 - COMPRESSIVE STRENGTH 4.0 KSI (DRILLED SHAFTS)
- CONCRETE CLASS QC2 - COMPRESSIVE STRENGTH 4.5 KSI (SUPERSTRUCTURE)
- CONCRETE CLASS QC1 - COMPRESSIVE STRENGTH 4.0 KSI (SUBSTRUCTURE)
- REINFORCING STEEL - MINIMUM YIELD STRENGTH 60 KSI
- STRUCTURAL STEEL - ASTM A709 GRADE 50 - YIELD STRENGTH 50 KSI

DECK PROTECTION METHOD

EPOXY COATED REINFORCING STEEL
2 1/2" CONCRETE COVER

MONOLITHIC WEARING SURFACE

MONOLITHIC WEARING SURFACE IS ASSUMED, FOR DESIGN PURPOSES, TO BE 1 INCH THICK.

ABBREVIATIONS

ABUT.	ABUTMENT	MIN.	MINIMUM
BRG.	BEARING	ADDIT.	ADDITIONAL
BOT.	BOTTOM	FRWD.	FORWARD
BTWN.	BETWEEN	SPL.	SPLICE
CONST. JT., C.J.	CONSTRUCTION JOINT	CLR.	CLEAR
B.S.	BOTH SIDES	P.C.P.P.	PERFORATED CORRUGATED PLASTIC PIPE
N.S.	NEAR SIDE	N.P.C.P.P.	NON-PERFORATED CORRUGATED PLASTIC PIPE
F.S.	FAR SIDE	SER.	SERIES (IN REINFORCING STEEL LIST)
SER.	SERIES		
TYP.	TYPICAL		
EQ.	EQUAL		
DIM.	DIMENSION		
SPA.	SPACES		
EA.	EACH		
P.E.J.F.	PREFORMED EXPANSION JOINT FILLER		

EXISTING STRUCTURE VERIFICATION:

DETAILS AND DIMENSIONS SHOWN ON THESE PLANS PERTAINING TO EXISTING STRUCTURE HAVE BEEN OBTAINED FROM PLANS OF THE EXISTING STRUCTURE AND FROM FIELD OBSERVATIONS AND MEASUREMENTS. CONSEQUENTLY, THEY ARE INDICATIVE OF THE EXISTING AND THE PROPOSED WORK BUT THEY SHALL BE CONSIDERED TENTATIVE AND APPROXIMATE. THE CONTRACTOR IS REFERRED TO CMS SECTIONS 102.05, 105.02 AND 513.04.

BASE CONTRACT BID PRICES UPON A RECOGNITION OF THE UNCERTAINTIES DESCRIBED ABOVE AND UPON A PREBID EXAMINATION OF THE EXISTING STRUCTURE. HOWEVER, THE DEPARTMENT WILL PAY FOR ALL PROJECT WORK BASED UPON ACTUAL DETAILS AND DIMENSIONS THAT HAVE BEEN VERIFIED IN THE FIELD.

EXISTING STRUCTURE PLANS:

PLANS MAY BE EXAMINED BY PROSPECTIVE BIDDERS AT THE OHIO DEPARTMENT OF TRANSPORTATION, DISTRICT 6 OFFICES, 400 E. WILLIAM ST., DELAWARE, OHIO 43015 (PHONE 740-833-8000).

ITEM 203 - EMBANKMENT, AS PER PLAN

PLACE AND COMPACT EMBANKMENT MATERIAL IN 6 INCH LIFTS FOR THE CONSTRUCTION OF THE APPROACH EMBANKMENT. PAID FOR IN THE ROADWAY QUANTITIES.

FOUNDATION BEARING RESISTANCE

PIER FOOTINGS, AS DESIGNED, PRODUCE A MAXIMUM SERVICE LOAD PRESSURE OF 8.22 KIPS PER SQUARE FOOT AND A MAXIMUM STRENGTH LOAD PRESSURE OF 10.65 KIPS PER SQUARE FOOT. THE FACTORED BEARING RESISTANCE IS 65.58 KIPS PER SQUARE FOOT.

DRILLED SHAFTS

THE MAXIMUM FACTORED LOAD TO BE SUPPORTED BY EACH DRILLED SHAFT IS 273 KIPS AT THE REAR ABUTMENT AND 289 KIPS AT THE FORWARD ABUTMENT. THIS LOAD IS RESISTED BY TIP RESISTANCE ONLY. THE FACTORED RESISTANCE DEVELOPED BY THE DRILLED SHAFT TIP IS 530 KIPS.

THE MAXIMUM COARSE AGGREGATE SIZE TO BE USED IN THE DRILLED SHAFT CONCRETE SHALL BE NO. 67.

DECK PLACEMENT DESIGN ASSUMPTIONS

THE FOLLOWING ASSUMPTION OF CONSTRUCTION MEANS AND METHODS WERE MADE FOR THE ANALYSIS AND DESIGN OF THE SUPERSTRUCTURE. THE CONTRACTOR IS RESPONSIBLE FOR THE DESIGN OF THE FALSEWORK SUPPORT SYSTEM WITHIN THESE PARAMETERS AND WILL ASSUME RESPONSIBILITY FOR SUPERSTRUCTURE ANALYSIS FOR DEVIATION FROM THESE DESIGN ASSUMPTIONS.

AN EIGHT WHEEL FINISHING MACHINE WITH A MAXIMUM WHEEL LOAD OF 3.12 KIPS FOR A TOTAL MACHINE LOAD OF 24.96 KIPS.

A MINIMUM OUT-TO-OUT WHEEL SPACING AT EACH END OF THE MACHINE OF 103 IN.

A MAXIMUM SPACING OF OVERHANG FALSEWORK OF 48 IN.

A MAXIMUM DISTANCE FROM THE CENTERLINE OF THE FASCIA GIRDER TO THE FACE OF THE SAFETY HANDLE OF 65 IN.

STRUCTURE GROUNDING

GROUND THE PROPOSED BRIDGE ACCORDING TO THE REQUIREMENTS OF ODOT STD. DWG. HL-50.21 - STRUCTURE GROUNDING. THE FOLLOWING BRIDGE COMPONENTS SHALL BE CONNECTED TO THE GROUNDING SYSTEM: ALL STRUCTURAL STEEL, UTILITY SUPPORTS, STEEL SCREEN WALL COMPONENTS, STEEL TRELLIS, LIGHT POLES, AND SIGNAL PEDESTALS.

ITEM 503-COFFERDAMS AND EXCAVATION BRACING, AS PER PLAN

THE DESIGN SHOWN ON THE PLANS FOR TEMPORARY SUPPORT OF EXCAVATION IS ONE REPRESENTATIVE DESIGN THAT MAY BE USED TO CONSTRUCT THE PROJECT. THE CONTRACTOR MAY CONSTRUCT THE DESIGN SHOWN ON THE PLANS OR PREPARE AN ALTERNATE DESIGN TO SUPPORT THE SIDES OF EXCAVATION. IF CONSTRUCTING AN ALTERNATE DESIGN FOR TEMPORARY SUPPORT OF EXCAVATION, PREPARE AND PROVIDE PLANS IN ACCORDANCE WITH CMS 501.05. THE DEPARTMENT WILL PAY FOR THE TEMPORARY SUPPORT OF EXCAVATION AT THE CONTRACT LUMP SUM PRICE FOR COFFERDAMS AND EXCAVATION BRACING, AS PER PLAN. NO ADDITIONAL PAYMENT WILL BE MADE FOR PROVIDING AN ALTERNATE DESIGN.

ITEM 625. LIGHT POLE ANCHOR BOLTS, MISC.: COMBINATION SIGNAL POLE & PEDESTRIAN POLE ANCHOR BOLT ASSEMBLIES EMBEDDED IN CONCRETE BRIDGE DECK:

FURNISH ANCHOR ASSEMBLIES FOR COMBINATION SIGNAL POLES AND PEDESTRIAN POLES MOUNTED ON THE BRIDGE. THE ITEM INCLUDES STEEL PLATES, ANCHOR RODS, NUTS, AND WASHERS AS SHOWN ON THE DRAWINGS OR AS REQUIRED FOR INSTALLATION. ANCHOR RODS SHALL CONFORM TO ASTM F1554 GRADE 55. COORDINATE DIMENSIONS OF ASSEMBLY WITH THE TRAFFIC PLANS. FABRICATE ASSEMBLY IN ACCORDANCE WITH CMS 513 AND 730. GALVANIZE THE ASSEMBLY AFTER FABRICATION IN ACCORDANCE WITH CMS 711.02.

ITEM 511 - CLASS QC1 CONCRETE WITH QC/QA, FOOTING, AS PER PLAN

IN ADDITION TO THE REQUIREMENTS OF ITEM 511, INSTALL A REFERENCE MONUMENT AT EACH END OF THE PIER SPREAD FOOTING. THE REFERENCE MONUMENT SHALL CONSIST OF #8, OR LARGER, EPOXY COATED REBAR EMBEDDED AT LEAST 6" INTO THE FOOTING AND EXTENDED VERTICALLY 4 TO 6 INCHES ABOVE THE TOP OF THE FOOTING. INSTALL A SIX INCH DIAMETER, SCHEDULE 40, MONUMENT AND PLACE THE PIPE VERTICAL WITH ITS TOP AT THE FINISHED GRADE. THE PIPE SHALL HAVE A REMOVABLE, SCHEDULE 40, PLASTIC PIPE. PERMANENTLY ATTACH THE BOTTOM OF THE PIPE TO THE TOP OF THE FOOTING.

ESTABLISH A BENCHMARK TO DETERMINE THE ELEVATION OF THE REFERENCE MONUMENTS AT VARIOUS MONITORING PERIODS THROUGHOUT THE LENGTH OF THE CONSTRUCTION PROJECT. THE BENCHMARK SHALL BE THE THROUGHOUT THE PROJECT AND SHALL BE INDEPENDENT OF ALL STRUCTURES.

RECORD THE ELEVATION OF EACH REFERENCE MONUMENT AT EACH MONITORING PERIOD SHOWN IN THE TABLE BELOW.

THE ORIGINAL COMPLETED TABLES WILL BECOME PART OF THE DISTRICT'S PROJECT PLAN RECORDS.

PROJECT NAME: FRA-70/71-12.68/14.86		MAXIMUM BEARING PRESSURE: 8.22 KSF	
BRIDGE NUMBER: FRA-70-1395		STRUCTURE FILE NUMBER: 2510023	
BENCHMARK LOCATION:			
FOOTING LOCATION: PIER			
MONITORING PERIOD	LEFT MONUMENT	RIGHT MONUMENT	
AFTER FOOTING CONCRETE IS PLACED			
BEFORE PLACEMENT OF SUPERSTRUCTURE MEMBERS			
BEFORE DECK PLACEMENT			
AFTER DECK PLACEMENT			
PROJECT COMPLETION			

PROJECT NAME: FRA-70/71-12.68/14.86		MAXIMUM BEARING PRESSURE: 8.22 KSF	
BRIDGE NUMBER: FRA-70-1395		STRUCTURE FILE NUMBER: 2510023	
BENCHMARK LOCATION:			
FOOTING LOCATION: PIER			
MONITORING PERIOD	LEFT MONUMENT	RIGHT MONUMENT	
AFTER FOOTING CONCRETE IS PLACED			
BEFORE PLACEMENT OF SUPERSTRUCTURE MEMBERS			
BEFORE DECK PLACEMENT			
AFTER DECK PLACEMENT			
PROJECT COMPLETION			

ITEM 512 - SEALING OF CONCRETE SURFACES (NON-EPOXY)

THIS ITEM SHALL COVER THE SEALING OF THE SUPERSTRUCTURE, INCLUDING THE TOP AND BOTH FACES OF THE PARAPETS, PILASTERS, PYLONS, DECK EDGES, AND SIDEWALKS. PROVIDE A BUFF-WASH FINISH.

ITEM 512 - SEALING OF CONCRETE SURFACES (EPOXY-URETHANE)

THIS ITEM SHALL COVER THE SEALING OF THE SUBSTRUCTURES, INCLUDING ALL EXPOSED SURFACES OF THE ABUTMENTS AND THE PIER. THE FINAL COAT SHALL BE TINTED SO THAT THE FINAL COLOR IS FEDERAL COLOR STANDARD NO. 17778--LIGHT NEUTRAL.

ITEM 524 - DRILLED SHAFTS, 60" DIAMETER, ABOVE BEDROCK WITH QC/QA, AS PER PLAN:

THE DRILLED SHAFT CAP AND P.E.J.F. JOINTS SHALL BE ACCURATELY PLACED ACCORDING TO THE DESIGN PLAN. IF THE LOCATIONS OF THE INSTALLED DRILLED SHAFTS VARY FROM THE DESIGN PLAN AND RESULT IN THE P.E.J.F. IN THE DRILLED SHAFT CAP FALLING OVER A DRILLED SHAFT INSTEAD OF BETWEEN SHAFTS, ALL VERTICAL SHAFT BARS INTERFERING WITH, OR CROSSING, THE CAP JOINT SHALL BE CUT FLUSH WITH THE TOP OF THE DRILLED SHAFT SO THAT BOTH SIDES OF THE CAP ARE NOT TIED TOGETHER BY SHAFT REINFORCING STEEL. THE CONTRACTOR SHALL OBTAIN APPROVAL FROM THE ENGINEER PRIOR TO CUTTING ANY REINFORCING STEEL. THE DEPARTMENT WILL CONSIDER THIS WORK AS INCIDENTAL AND SHALL BE INCLUDED WITH ITEM 524 FOR PAYMENT.

NO.	DESCRIPTION	REV. BY	DATE
8	ADDED ITEM	RFV	12-7-2021

GENERAL NOTES

BRIDGE NO. FRA-70-1395C
S. FRONT STREET OVER I-70/71

PID No. 105523

4 / 65

1885
1815

DESIGN AGENCY
GPD GROUP
Class, P.E., S. Schinner, Burns & Osherson, Inc.
1801 Watermark Drive, Suite 130, Columbus, Ohio 43123 614-210-0731
Copyright © Class, P.E., Schinner, Burns & Osherson, Inc. 2015

DATE
9-6-19

REVIEWED
DGN

DRAWN
RPR


DESIGNED
DGN

CHECKED
DJC

STRUCTURE FILE NUMBER
2510023

D:\2012\20120418\FRA\105523\STRUCTURES\FRA070_1395C\SHEETS\070_1395C\DWG01.DGN
12/6/2021 4:39:22 PM
D:\1\81STD_USER

Batchplot Spec: \\msconsultants.com\files\Production\03\60\06634_6R\standards\plotdrv\batchplot.dwg
 Pen Table: \\msconsultants.com\files\standards\user\table\1\81\ms\plot\pen.tbl
 Plot Driver: \\msconsultants.com\files\standards\user\table\1\81\ms\plot\pen.tbl
 Model Sheet
 Printed: 12/7/2021 3:55:15 PM
 File: \\msconsultants.com\files\Production\03\60\06634_6R\roadway\sheet\0558860014.dwg
 View: FENCE - NEW1
 By: tzangmeister

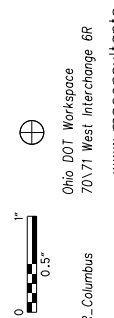

Ohio DOT Workspace
 70\71 West Interchange 6R
 www.msconsultants.com


34" x 22"

SHEET NUM.										PART.	ITEM	ITEM	GRAND	UNIT	DESCRIPTION	SEE SHEET NO.
857	864									08/NHS/P V.	4	EXT	TOTAL			
RETAINING WALLS (E5)																
438										438	203	20000	438	CY	EMBANKMENT	
24,388										24,388	509	10001	24,388	LB	EPOXY COATED REINFORCING STEEL, AS PER PLAN	838
150										150	511	53012	150	CY	CLASS QC2 CONCRETE, MISC.: PARAPET INCLUDING SLEEPER SLAB WITH QC/QA	838
449										449	512	10001	449	SY	SEALING OF CONCRETE SURFACES, AS PER PLAN, (PERMANENT GRAFFITI PROTECTION)	838
698										698	512	10100	698	SY	SEALING OF CONCRETE SURFACES (EPOXY-URETHANE)	
875										875	516	13900	875	SF	2" PREFORMED EXPANSION JOINT FILLER	
179										179	607	39901	179	FT	VANDAL PROTECTION FENCE, 6' STRAIGHT, COATED FABRIC, AS PER PLAN	838
5,533										5,533	840	20001	5,533	SF	MECHANICALLY STABILIZED EARTH WALL, AS PER PLAN	843
1,162										1,162	840	21000	1,162	CY	WALL EXCAVATION	
691										691	840	22000	691	SY	FOUNDATION PREPARATION	
2,164										2,164	840	23000	2,164	CY	SELECT GRANULAR BACKFILL	
997										997	840	25010	997	FT	6" DRAINAGE PIPE, PERFORATED	
438										438	840	26000	438	FT	CONCRETE COPING	
4,658										4,658	840	26050	4,658	SF	AESTHETIC SURFACE TREATMENT	
5										5	840	27000	5	DAY	ON-SITE ASSISTANCE	
RETAINING WALLS (E7)																
9,684										9,684	SPECIAL	20302000	9,684	CY	ENGINEERED FILL: LIGHTWEIGHT CELLULAR CONCRETE FILL, CLASS II	841
451										451	SPECIAL	20302000	451	CY	ENGINEERED FILL: LIGHTWEIGHT CELLULAR CONCRETE FILL, CLASS III	841
436										436	203	20000	436	CY	EMBANKMENT	
935										935	203	35110	935	CY	GRANULAR MATERIAL TYPE B	
2										2	SPECIAL	20365000	2	EACH	SETTLEMENT PLATFORM	841
4,687										4,687	203	98000	4,687	CY	ROADWAY, MISC.: EPS GEOFOAM FILL	840
LUMP										LUMP	503	11101	LS		COFFERDAMS AND EXCAVATION BRACING, AS PER PLAN	838
31,202										31,202	509	10001	31,202	LB	EPOXY COATED REINFORCING STEEL, AS PER PLAN	838
199										199	511	53012	199	CY	CLASS QC2 CONCRETE, MISC.: PARAPET INCLUDING SLEEPER SLAB WITH QC/QA	838
6	132									132	511	53012	132	CY	CLASS QC2 CONCRETE, MISC.: LOAD DISTRIBUTION SLAB	838
5,058										5,058	511	71200	5,058	SF	CONCRETE, MISC.: PRECAST WALL PANELS	838
121										121	511	81100	121	FT	CONCRETE, MISC.: PRECAST FOOTING	838
2,080										2,080	512	10100	2,080	SY	SEALING OF CONCRETE SURFACES (EPOXY-URETHANE)	
76										76	516	13200	76	SF	1/2" PREFORMED EXPANSION JOINT FILLER	
857										857	516	13900	857	SF	2" PREFORMED EXPANSION JOINT FILLER	
363										363	607	39901	363	FT	VANDAL PROTECTION FENCE, 6' STRAIGHT, COATED FABRIC, AS PER PLAN	838
8	12,751									12,751	840	20001	12,751	SF	MECHANICALLY STABILIZED EARTH WALL, AS PER PLAN	839, 843
4,995										4,995	840	21000	4,995	CY	WALL EXCAVATION	
1,485										1,485	840	22000	1,485	SY	FOUNDATION PREPARATION	
2,660										2,660	840	23000	2,660	CY	SELECT GRANULAR BACKFILL	
506										506	840	25010	506	FT	6" DRAINAGE PIPE, PERFORATED	
523										523	840	26000	523	FT	CONCRETE COPING	
16,763										16,763	840	26050	16,763	SF	AESTHETIC SURFACE TREATMENT	
5										5	840	27000	5	DAY	ON-SITE ASSISTANCE	

NO.	DESCRIPTION	REV. BY	DATE
1	Removal of Item 203E35120	TAZ	11-05-2021
3	Remove Item 840E28000	TAZ	11-19-2021
3	Update Item 509 to A.P.P.	TAZ	11-19-2021
4	Update Funding Splits	TAZ	11-24-2021
6	Update 511E53012 Qty.	TAZ	12-03-2021
6	Remove Item 503E11100	TAZ	12-03-2021
8	Update 840E20001 Qty.	TAZ	12-07-2021

CALCULATED HRB CHECKED TAZ
GENERAL SUMMARY
FRA - 71 - 14.36
 (275C)
 1228
 ms consultants, inc.

Batchplot Spec: \\msconsultants.com\files\Production\03\60\06634_6R\Standards\plotdrv\batchplot.dwg
 Pen Table: \\msconsultants.com\files\Standards\user\ahad\1\81\ms\plotting\pen\181.ms_std.plt
 Plot Driver: \\msconsultants.com\files\Standards\user\ahad\1\81\ms\plotting\PDF.plt
 View: FENCE - MEWT
 Printed: 12/7/2021 3:27:38 PM By: tzongmeister
 File: \\msconsultants.com\files\Production\03\60\06634_6R\roadway\sheet\055880015.dgn

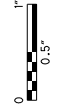

34" x 22"



SHEET NUM.

SHEET NUM.		PART.	ITEM	ITEM	GRAND	UNIT	DESCRIPTION	SEE SHEET NO.
874	884	08/NHSP V.	4	EXT	TOTAL			
RETAINING WALLS (E10)								
1,346		1,346	SPECIAL	20302000	1,346	CY	ENGINEERED FILL: LIGHTWEIGHT CELLULAR CONCRETE FILL, CLASS II	841
122		122	SPECIAL	20302000	122	CY	ENGINEERED FILL: LIGHTWEIGHT CELLULAR CONCRETE FILL, CLASS III	841
678		678	203	20000	678	CY	EMBANKMENT	
827		827	203	35110	827	CY	GRANULAR MATERIAL TYPE B	
6,138		6,138	203	98000	6,138	CY	ROADWAY, MISC.: EPS GEOFOAM FILL	840
LUMP		LUMP	503	11101	LS		COFFERDAMS AND EXCAVATION BRACING, AS PER PLAN	838
39,409		39,409	509	10001	39,409	LB	EPOXY COATED REINFORCING STEEL, AS PER PLAN	838
247	6	247	511	53012	247	CY	CLASS QC2 CONCRETE, MISC.: PARAPET INCLUDING SLEEPER SLAB WITH QC/QA	838
129		129	511	53012	129	CY	CLASS QC2 CONCRETE, MISC.: LOAD DISTRIBUTION SLAB	838
4,628		4,628	511	71200	4,628	SF	CONCRETE, MISC.: PRECAST WALL PANELS	838
152		152	511	81100	152	FT	CONCRETE, MISC.: PRECAST FOOTING	838
1,240		1,240	512	10100	1,240	SY	SEALING OF CONCRETE SURFACES (EPOXY-URETHANE)	
5,717		5,717	840	20001	5,717	SF	MECHANICALLY STABILIZED EARTH WALL, AS PER PLAN	839
4,104		4,104	840	21000	4,104	CY	WALL EXCAVATION	
743		743	840	22000	743	SY	FOUNDATION PREPARATION	
1,748		1,748	840	23000	1,748	CY	SELECT GRANULAR BACKFILL	
455		455	840	25010	455	FT	6" DRAINAGE PIPE, PERFORATED	
5		5	840	27000	5	DAY	ON-SITE ASSISTANCE	
RETAINING WALLS (W2)								
2,649		2,649	203	20000	2,649	CY	EMBANKMENT	
LUMP		LUMP	503	11100	LS		COFFERDAMS AND EXCAVATION BRACING	838
87,095		87,095	509	10001	87,095	LB	EPOXY COATED REINFORCING STEEL, AS PER PLAN	838
560		560	511	53012	560	CY	CLASS QC2 CONCRETE, MISC.: PARAPET INCLUDING SLEEPER SLAB WITH QC/QA	838
1,627		1,627	512	10001	1,627	SY	SEALING OF CONCRETE SURFACES, AS PER PLAN, (PERMANENT GRAFFITI PROTECTION)	838
4,459		4,459	512	10100	4,459	SY	SEALING OF CONCRETE SURFACES (EPOXY-URETHANE)	
216		216	516	13200	216	SF	1/2" PREFORMED EXPANSION JOINT FILLER	
2,217		2,217	516	13900	2,217	SF	2" PREFORMED EXPANSION JOINT FILLER	
431		431	601	37500	431	FT	PAVED GUTTER, TYPE 1-2	
36,756		36,756	840	20001	36,756	SF	MECHANICALLY STABILIZED EARTH WALL, AS PER PLAN	843
6,905		6,905	840	21000	6,905	CY	WALL EXCAVATION	
3,332		3,332	840	22000	3,332	SY	FOUNDATION PREPARATION	
27,781		27,781	840	23000	27,781	CY	SELECT GRANULAR BACKFILL	
924		924	840	23050	924	CY	NATURAL SOIL	
3,135		3,135	840	25010	3,135	FT	6" DRAINAGE PIPE, PERFORATED	
1,555		1,555	840	26000	1,555	FT	CONCRETE COPING	
33,647		33,647	840	26050	33,647	SF	AESTHETIC SURFACE TREATMENT	
5		5	840	27000	5	DAY	ON-SITE ASSISTANCE	

NO.	DESCRIPTION	REV. BY	DATE
1	Removal of Item 203E35120	TAZ	11-05-2021
3	Remove Item 840E28000	TAZ	11-19-2021
3	Update Item 509 to A.P.P.	TAZ	11-19-2021
4	Update Funding Splits	TAZ	11-24-2021
6	Add Load Dist. Slab Qty.	TAZ	12-03-2021
8	Update 840E20001 Qty.	TAZ	12-07-2021

CALCULATED HRB CHECKED TAZ

GENERAL SUMMARY

FRA - 71 - 14.36

275D
1228

ms consultants, inc.

SHEET NUM.							PART.			ITEM	ITEM EXT	GRAND TOTAL	UNIT	DESCRIPTION	SEE SHEET NO.
912	944					09/NHS/B R	09/NHS/B R	09/NHS/B R							
STRUCTURE REPAIR (FRA-70-1373L)															
LUMP								LUMP	202	11203	LS		PORTIONS OF STRUCTURE REMOVED, OVER 20 FOOT SPAN, AS PER PLAN	911	
157								157	202	22900	157	SY	APPROACH SLAB REMOVED		
705								705	202	23501	705	SY	WEARING COURSE REMOVED, AS PER PLAN	911	
3								3	202	98100	3	EACH	REMOVAL MISC.: PILE REMOVED, EXISTING STRUCTURE	917	
8								8	407	20000	8	GAL	NON-TRACKING TACK COAT		
5								5	441	10000	5	CY	ASPHALT CONCRETE SURFACE COURSE, TYPE 1, (446), PG64-22		
LUMP								LUMP	503	11100	LS		COFFERDAMS AND EXCAVATION BRACING		
11,409								11,409	509	25000	11,409	LB	UNCOATED REINFORCING STEEL		
372								372	510	10000	372	EACH	DOWEL HOLES WITH NONSHRINK, NONMETALLIC GROUT		
48								48	511	21521	48	CY	CLASS QC2 CONCRETE, SUPERSTRUCTURE, AS PER PLAN	911	
117								117	512	33010	117	SY	TYPE 3 WATERPROOFING		
987								987	513	10200	987	LB	STRUCTURAL STEEL MEMBERS, LEVEL UF		
1,005								1,005	513	10240	1,005	LB	STRUCTURAL STEEL MEMBERS, LEVEL 2		
4								4	518	12200	4	EACH	SCUPPERS, INCLUDING SUPPORTS		
32								32	SPECIAL	51912510	32	SY	PATCHING CONCRETE BRIDGE DECK	911	
4								4	846	00110	4	CF	POLYMER MODIFIED ASPHALT EXPANSION JOINT SYSTEM		
STRUCTURE (FRA-71-1503L)															
LUMP								LUMP	202	11003	LS		STRUCTURE REMOVED, OVER 20 FOOT SPAN, AS PER PLAN	941	
LUMP								LUMP	202	11201	LS		PORTIONS OF STRUCTURE REMOVED, AS PER PLAN	941	
159								80	79	22900	159	SY	APPROACH SLAB REMOVED		
2,034								1,017	1,017	23500	2,034	SY	WEARING COURSE REMOVED		
21								11	10	98100	21	EACH	REMOVAL MISC.: PILE REMOVED, EXISTING STRUCTURE	946	
LUMP								LUMP	503	11101	LS		COFFERDAMS AND EXCAVATION BRACING, AS PER PLAN	942	
6,586								3,293	3,293	21101	6,586	CY	UNCLASSIFIED EXCAVATION, AS PER PLAN	942	
LUMP								LUMP	505	11100	LS		PILE DRIVING EQUIPMENT MOBILIZATION		
980								490	490	00100	980	FT	STEEL PILES HP10X42, FURNISHED		
935								468	467	00150	935	FT	STEEL PILES HP10X42, DRIVEN		
1,760								880	880	00200	1,760	FT	STEEL PILES HP12X53, FURNISHED		
1,680								840	840	00250	1,680	FT	STEEL PILES HP12X53, DRIVEN		
27								14	13	93300	27	EACH	STEEL POINTS OR SHOES		
3	6,011,221							3,005,611	3,005,610	10001	6,011,221	LB	EPOXY COATED REINFORCING STEEL, AS PER PLAN	942	
8,950								4,475	4,475	34447	8,950	CY	CLASS QC2 CONCRETE WITH QC/QA, BRIDGE DECK, AS PER PLAN	942	
1,506								753	753	34451	1,506	CY	CLASS QC2 CONCRETE WITH QC/QA, BRIDGE DECK (PARAPET), AS PER PLAN	942, 1143	
278								139	139	43512	278	CY	CLASS QC1 CONCRETE WITH QC/QA, ABUTMENT INCLUDING FOOTING		
11,516								5,758	5,758	45602	11,516	CY	CLASS QC4 MASS CONCRETE, SUBSTRUCTURE WITH QC/QA		
1,642								821	821	10001	1,642	SY	SEALING OF CONCRETE SURFACES, AS PER PLAN, (PERMANENT GRAFFITI PROTECTION)	942, 1143	
22,021								11,011	11,010	10100	22,021	SY	SEALING OF CONCRETE SURFACES (EPOXY-URETHANE)		
19								10	9	33000	19	SY	TYPE 2 WATERPROOFING		
13,156,600								6,578,300	6,578,300	10401	13,156,600	LB	STRUCTURAL STEEL MEMBERS, HYBRID GIRDER, LEVEL SIX (6) FABRICATION, AS PER PLAN	942, 1035	
84,927								42,464	42,463	20000	84,927	EACH	WELDED STUD SHEAR CONNECTORS		
154,349								77,175	77,174	00060	154,349	SF	FIELD PAINTING STRUCTURAL STEEL, INTERMEDIATE COAT		
154,349								77,175	77,174	00066	154,349	SF	FIELD PAINTING STRUCTURAL STEEL, FINISH COAT		
118								59	59	10010	118	FT	ARMORLESS PREFORMED JOINT SEAL		
263								132	131	51612400	263	FT	MODULAR EXPANSION JOINT	943	
26								13	13	13600	26	SF	1" PREFORMED EXPANSION JOINT FILLER		
10								5	5	12200	10	EACH	SCUPPERS, INCLUDING SUPPORTS		
83								42	41	21200	83	CY	POROUS BACKFILL WITH GEOTEXTILE FABRIC		
46								23	23	40000	46	FT	6" PERFORATED CORRUGATED PLASTIC PIPE		
38								19	19	40010	38	FT	6" NON-PERFORATED CORRUGATED PLASTIC PIPE, INCLUDING SPECIALS		
229								115	114	51200	229	FT	PIPE DOWNSPOUT, INCLUDING SPECIALS, 10"		
130								65	65	94804	130	FT	DRILLED SHAFTS, 42" DIAMETER, INTO BEDROCK		
1,340								670	670	94902	1,340	FT	DRILLED SHAFTS, 48" DIAMETER, ABOVE BEDROCK		
725								363	362	94904	725	FT	DRILLED SHAFTS, 48" DIAMETER, INTO BEDROCK		
2,854								1,427	1,427	94906	2,854	FT	DRILLED SHAFTS, 54" DIAMETER, ABOVE BEDROCK		
290								145	145	94994	290	FT	DRILLED SHAFTS, 90" DIAMETER, INTO BEDROCK		
633								317	316	94996	633	FT	DRILLED SHAFTS, 96" DIAMETER, ABOVE BEDROCK		

NO.	DESCRIPTION	REV.	BY	DATE
2	DOWEL PILE ITEM INCL	TAL		11-10-2021
3	update Item & Qty	TAL		11-19-2021
4	update Funding Split	TAL		11-24-2021
8	update 518E10210 Qty.	TAL		12-07-2021

GENERAL NOTES

PROPOSED WORK:

THE PROPOSED WORK CONSISTS OF BUILDING RETAINING WALLS W2, W3, W5, E4, E5, E7 & E10 WITHIN THE I-70/I-71 WEST INTERCHANGE.

STANDARD DRAWING AND SUPPLEMENTAL SPECIFICATIONS:

REFER TO THE FOLLOWING SUPPLEMENTAL SPECIFICATONS:

840 DATED 4-16-21
867 DATED 1-15-21

DESIGN SPECIFICATIONS:

THESE STRUCTURES CONFORM TO THE "LRFD BRIDGE DESIGN SPECIFICATIONS" ADOPTED BY THE AMERICAN ASSOCIATION OF STATE HIGHWAY AND TRANSPORTATION OFFICIALS, 9TH EDITION, 2020, AND THE ODOT BRIDGE DESIGN MANUAL, 2021 EDITION, INCLUDING REVISIONS THROUGH JANUARY 2021.

DESIGN LOADING:

HL-93 AND
250 PSF LIVE LOAD SURCHARGE

DESIGN DATA:

CONCRETE CLASS QC1 - COMPRESSIVE STRENGTH 4.0 KSI (COPING & LEVELING PAD)

CONCRETE CLASS QC2 - COMPRESSIVE STRENGTH 4.5 KSI (PARAPET & MOMENT SLAB)

REINFORCING STEEL - ASTM A615 OR A996 GRADE 60, MINIMUM YIELD STRENGTH 60 KSI

MAINTENANCE OF TRAFFIC:

FOR MAINTENANCE OF TRAFFIC DETAILS, SEE THE ROADWAY PLANS.

UTILITIES:

THE LOCATION OF UNDERGROUND UTILITIES SHOWN ON THE PLANS ARE OBTAINED THROUGH UTILITY OWNERS AS REQUIRED BY SECTION 153.64 O.R.C.

PROPRIETARY RETAINING WALL DATA:

FOR ALL MSE WALL PORTIONS BELOW A BRIDGE ABUTMENT, THE PROPRIETARY WALL SUPPLIER SHALL DESIGN THE INTERNAL STABILITY OF A MECHANICALLY STABILIZED EARTH (MSE) WALL IN ACCORDANCE WITH SUPPLEMENTAL SPECIFICATION 840 TO SUPPORT THE ABUTMENT. THE DESIGN FOR INTERNAL STABILITY SHALL INCLUDE A NOMINAL (I.E. UNFACTORED) HORIZONTAL STRIP LOAD DUE TO FRICTION (FR) FROM THE SUPERSTRUCTURE APPLIED PERPENDICULAR TO THE FACE OF WALL AT THE BASE OF THE CONCRETE FOOTING. SEE BELOW FOR STRIP LOADS AT INDIVIDUAL WALLS/BRIDGES. THIS STRIP LOAD DOES NOT INCLUDE EARTH PRESSURE LOADS FROM THE ABUTMENT BACKFILL. HOWEVER, THE PROPRIETARY WALL SUPPLIER SHALL INCLUDE EARTH PRESSURE LOADS FROM THE ABUTMENT BACKFILL IN THE DESIGN CALCULATIONS.

MSE WALL	BRIDGE	NOMINAL HORIZONTAL STRIP LOAD DUE TO FRICTION
E4	FRA-70-1373B	2.4 K/FT
E7	FRA-71-1503L	1.0 K/FT
W5	FRA-71-1503L	1.2 K/FT

CONSTRUCTION SEQUENCING:

WHERE WALL CONSTRUCTION IS PHASED AND A TEMPORARY RETAINING SYSTEM IS REQUIRED, SHOP DRAWINGS OF BOTH PERMANENT AND TEMPORARY WALLS SHALL BE SUBMITTED TO THE ENGINEER FOR APPROVAL. THE COST OF THESE SUBMITTALS SHALL BE INCLUDED FOR PAYMENT WITH THE COST OF THE TEMPORARY WALLS.

EXCAVATION, SHEETING AND BRACING

EXCAVATION ENVELOPES AS DETAILED IN THE PLANS SHALL BE PROTECTED FROM CAVING AND SLOUGHING. WHERE CLEARANCES AND CONSTRUCTION SEQUENCING WILL NOT ALLOW FOR SLOPED EXCAVATIONS, APPROPRIATE SHEETING OR BRACING METHODS SHALL BE EMPLOYED BY THE CONTRACTOR. THIS TEMPORARY SHEETING OR BRACING IS CONSIDERED INCIDENTAL TO ITEM 503 - COFFERDAMS AND EXCAVATION BRACING.

ITEM 503 - COFFERDAMS AND EXCAVATION BRACING, AS PER PLAN (WALLS E4, E7 & E10)

THE DESIGN SHOWN ON THE PLANS FOR TEMPORARY SUPPORT OF EXCAVATION IS ONE REPRESENTATIVE DESIGN THAT MAY BE USED TO CONSTRUCT THE PROJECT. THE CONTRACTOR MAY CONSTRUCT THE DESIGN SHOWN ON THE PLANS OR PREPARE AN ALTERNATE DESIGN TO SUPPORT THE SIDES OF EXCAVATIONS. IF CONSTRUCTING AN ALTERNATE DESIGN FOR TEMPORARY SUPPORT OF EXCAVATION, PREPARE AND PROVIDE PLANS IN ACCORDANCE WITH C&MS 501.05. THE DEPARTMENT WILL PAY FOR THE TEMPORARY SUPPORT OF EXCAVATION AT THE CONTRACT LUMP SUM PRICE FOR COFFERDAMS AND EXCAVATION BRACING. NO ADDITIONAL PAYMENT WILL BE MADE FOR PROVIDING AN ALTERNATE DESIGN.

ITEM 509 - EPOXY COATED REINFORCING STEEL, AS PER PLAN

GLASS FIBER REINFORCED POLYMER (GFRP) BARSH SHALL BE USED FOR DIAGONAL REINFORCEMENT AS SHOWN IN THE PLANS. PAYMENT FOR GFRP BARS SHALL BE INCIDENTAL TO THE COST OF ITEM 509 - EPOXY COATED REINFORCING STEEL, AS PER PLAN.

ITEM 511 CONCRETE MISC.: PRECAST WALL PANELS (WALLS E7 & E10)

THIS ITEM SHALL INCLUDE THE FABRICATION AND ERECTION OF THE PRECAST WALL PANELS AS DETAILED IN THE PLANS. CONCRETE FOR THE PRECAST PANELS SHALL BE CLASS QC 1 AS PER CMS 511. PRECAST WALL PANELS SHALL BE USED ADJACENT TO WHERE EPS GEOFOAM FILL IS USED. THE FABRICATION OF THE PANELS, TESTING OF THE CONCRETE AND ERECTION OF THE PANELS SHALL MEET THE REQUIREMENTS OF SS 840.04B, 840.05, 840.06A, B, C, D, F, G, K & L, WITH THE FOLLOWING EXCEPTIONS:

1. IN ALL CASES, REPLACE "SOIL REINFORCEMENT CONNECTION" WITH "ANCHOR PLATE AND STUD CONNECTION"
2. REPLACE "(ACCREDITED) MSE WALL SYSTEM" WITH "PRECAST WALL PANELS"
3. REPLACE "LEVELING PAD" WITH "PRECAST FOOTING."
4. IGNORE REFERENCES TO HORIZONTAL JOINTS, BATTER OF PANELS, MULTIPLE ROWS OR LIFTS OF PANELS, AND SELECT GRANULAR BACKFILL (SGB).
5. FOLLOW THE SPECIFICATION FOR SECTION 840.04B WITH THE EXCEPTION TO REQUIREMENTS REGARDING SOIL REINFORCEMENT AND REINFORCED SOIL ZONE.
6. PROVIDE A DETAILED SEQUENCE OF CONSTRUCTION FOR THE ERECTION OF THE PANELS RATHER THAN AN MSE CONSTRUCTION MANUAL.

FORMLINERS SHALL BE USED TO PROVIDE AN AESTHETIC TREATMENT ON WALL E7. THE AESTHETIC TREATMENT SHALL BE AN ASHLAR STONE FINISH WITH A MINIMUM OF 1" AND A MAXIMUM OF 1 1/2" RELIEF. THIS WORK ALSO INCLUDES THE PLACEMENT OF THE ANCHOR PLATE AND STUDS. THE STEEL PLATE SHALL BE GALVANIZED AS PER CMS 711.02.

SEQUENCE OF CONSTRUCTION: THE CONTRACTOR SHALL DEVELOP A SEQUENCE OF CONSTRUCTION FOR THE INSTALLATION OF THE WALLS IN THE GEOFOAM AREA. TO MINIMIZE THE TIME FOR TEMPORARY SUPPORTING THE PRECAST PANEL, THE CONTRACTOR MAY FORM AND POUR THE CELLULAR CONCRETE AND PLACE THE GEOFOAM BLOCKS PRIOR TO INSTALLATION OF THE PRECAST PANELS.

SETTLEMENT OF THE PRECAST CONCRETE PANELS IS EXPECTED ADJACENT TO THE GEOFOAM. FINAL SETTLEMENT IS CONSIDERED COMPLETE WHEN LESS THAN A 1/8" SETTLEMENT IS MEASURED OVER A SINGLE 48 HOUR PERIODS. ONCE FINAL SETTLEMENT HAS BEEN ACHIEVED, THE PRECAST PANELS CAN BE CONNECTED TO THE LOAD DISTRIBUTION SLAB. THE CONTRACTOR SHALL MONITOR THE SETTLEMENT OF THE PANELS IN THE GEOFOAM AREA NEAR THE WALL TO TRACK THE SETTLEMENT PRIOR TO ANCHORING THE WALL TO THE LOAD DISTRIBUTION SLAB.

8

ITEM 511 CONCRETE MISC.: PRECAST WALL PANELS (WALLS E7 & E10) CONT.

THE CONTRACTOR SHALL ESTABLISH FIVE (5) REFERENCE POINTS ALONG EACH WALL (E7 & E10) TO BE USED TO MONITOR THE SETTLEMENT OF THE PRECAST CONCRET PANELS. PLACE REFERENCE POINTS AT THE BEGINNING AND END OF THE WALLS AND THREE (3) INTERMEDIATE POINTS EQUALLY SPACED. THE CONTRACTOR SHALL MONITOR THESE POINTS ON A DAILY BASIS UNTIL FINAL SETTLEMENT HAS BEEN ACHIEVED. ONCE THE FINAL SETTLEMENT HAS BEEN ACHIEVED THESE REFERENCE POINT CAN BE REMOVED.

METHOD OF MEASUREMENT: THE DEPARTMENT WILL MEASURE THE PRECAST PANELS BY THE NUMBER OF SQUARE FEET.

PAYMENT: ALL LABOR, EQUIPMENT, MATERIALS AND INCIDENTALS NECESSARY TO COMPLETE THE WORK SHALL BE INCLUDED IN THE CONTRACT BID PRICE FOR ITEM 511 CONCRETE MISC.: PRECAST WALL PANELS.

3

ITEM 511 CONCRETE MISC.: PRECAST FOOTING (WALLS E7 & E10)

THIS ITEM SHALL INCLUDE THE FABRICATION AND PLACEMENT OF THE PRECAST FOOTINGS AS DETAILED IN THE PLANS. INCLUDING THE REINFORCING STEEL. CONCRETE FOR THE PRECAST FOOTING SHALL BE CLASS QC1 AS PER CMS 511.

PRECAST FOOTING SHALL BE FOUNDED ON EITHER A GRANULAR EMBANKMENT TYPE C OR A CAST-IN-PLACE LEVELING PAD OR A LEVEL SURFACE OF LOW STRENGTH MORTAR BACKFILL (LSM) OR CLASSIC QC MISC CONCRETE. PRECAST FOOTING SHALL BE LEVEL.

METHOD OF MEASUREMENT: THE DEPARTMENT WILL MEASURE THE PRECAST FOOTINGS BY THE NUMBER OF FEET.

PAYMENT: ALL LABOR, EQUIPMENT, MATERIALS AND INCIDENTALS NECESSARY TO COMPLETE THE WORK SHALL BE INCLUDED IN THE CONTRACT BID PRICE FOR ITEM 511 CONCRETE MISC.: PRECAST FOOTING.

ITEM 511 CLASS QC2 CONCRETE MISC.: LOAD DISTRIBUTION SLAB (WALLS E7 & E10)

THIS ITEM SHALL INCLUDE THE CONCRETE CONSTRUCTION AS DETAILED IN THE PLANS INCLUDING THE WORK NECESSARY TO FURNISH & PLACE THE REINFORCING STEEL. CONCRETE FOR THE PROPOSED WORK SHALL BE CLASS QC2 AS PER CMS 511.

METHOD OF MEASUREMENT: THE DEPARTMENT WILL MEASURE THE CONCRETE CONSTRUCTION BY THE NUMBER OF CUBIC YARDS.

PAYMENT: ALL LABOR, EQUIPMENT, MATERIALS AND INCIDENTALS NECESSARY TO COMPLETE THE WORK SHALL BE INCLUDED WITH WALL E7 IN THE CONTRACT BID PRICE FOR ITEM 511 CLASS QC2 CONCRETE MISC.: LOAD DISTRIBUTION SLAB.

ABBREVIATIONS:

- CCF - CELLULAR CONCRETE FILL
- CJ - CONSTRUCTION JOINT
- C/C - CENTER TO CENTER
- CLR - CLEAR
- CONSTR - CONSTRUCTION
- CSW - COLUMN SUPPORTED WALLS
- DIA - DIAMETER
- EF - EACH FACE
- ELEV - ELEVATION
- EOP - EDGE OF PAVEMENT
- EPS - EXPANDED POLYSTYRENE
- EX - EXISTING
- FF - FAR FACE
- I.R. 75 - INTERSTATE ROUTE 75
- INC - INCREMENT
- LT - LEFT
- LDS - LOAD DISTRIBUTION SLAB
- MAX - MAXIMUM
- MIN - MINIMUM
- MISC - MISCELLANEOUS
- NF - NEAR FACE
- PEJF - PREFORMED EXPANSION JOINT FILLER
- PERF CPP - PERFORATED CORRUGATED PLASTIC PIPE
- PROP - PROPOSED
- RT - RIGHT
- SB - SOUTHBOUND
- SER - SERIES
- SGB - SELECT GRANULAR BACKFILL
- SPA - SPACING
- STA - STATION
- ST - STRAIGHT
- TBA - TO BE ABANDONED
- TBR - TO BE REMOVED
- TBRL - TO BE RELOCATED
- TYP - TYPICAL
- VPF - VANDAL PROTECTION FENCE

ITEM 512 - SEALING OF CONCRETE SURFACES, AS PER PLAN. (PERMANENT GRAFFITI PROTECTIN) (WALLS E4, E5 & W2):

APPLY A PERMANENT GRAFFITI COATING QUALIFIED ACCORDING TO SUPPLEMENT 1083 THAT IS COMPATIBLE WITH THE CONCRETE SEALER OVER WHICH IT IS APPLIED. APPLY THE GRAFFITI COATING IN ACCORDNACE WITH MANUFACTURER'S PRINTED INSTRUCTIONS. APPLY PERMANENT GRAFFITI COATING TO THE WALLS E4 TO THE RAILROAD, E5 NORTH FACING, AND W2.

ITEM 607 - VANDAL PROTECTION FENCE, 6' STRAIGHT, COATED FABRIC, AS PER PLAN:

ALL FENCE POSTS, RAILS, FABRIC, BASE PLATES, POST SLEEVES, TENSION BANDS, TRUSS RODS, FABRIC TIES AND ALL OTHER VISIBLE PORTIONS OF FENCE NOT LISTED SHALL BE BLACK PVC COATED.

THE MOUNTING BASE PLATE AND SLEEVE SHALL BE BP-5 PER STANDARD DRAWING VPF-1-90. FOR THE ROADWAY PLANS WHERE VANDAL PROTECTION FENCE IS MOUNTED ON THE BARRIER, THE POST SPACING SHALL BE 5 FOOT. SEE THE STRUCTURES PLANS FOR POST SPACING ON BRIDGE AND WALLS.

ITEM 840 - DRAINAGE PIPE:

PROVIDE A MINIMUM SLOPE OF 1.00% ON ALL MSE WALL DRAINS UNLESS NOTED OTHERWISE.

PIPE LOCATED OUTSIDE THE FACE OF THE MSE WALL PANEL SHALL BE INCLUDED WITH THE ROADWAY QUANTITIES FOR PAYMENT.

LOCATE THE PIPE AS CLOSE AS POSSIBLE TO THE TOP OF THE LEVELING PAD. IT MAY BE LOCATED ABOVE THE BOTTOM ROW OF REINFORCING STRAPS. HOWEVER, AT NO TIME SHALL THE PIPE BE LOCATED WITHIN 1 FOOT OF THE PROPOSED GROUND LINE.

NO.	DESCRIPTION	REV. BY	DATE
1	CHANGED CMC- CONTROLLED MODULUS COLUMNS TO CSW - COLUMN SUPPORTED WALLS	MMS	11/5/21
1	UPDATED SHEET TITLE	MMS	11/5/21
3	ADDED NOTE	MMS	11/18/21
3	REMOVED NOTE	MMS	11/18/21
8	REVISED NOTE	JWE	12/7/21



G:\projects\2013\w-13-072_FRA-70-13-10_6A\89464\1715B_PHASE_3\structures\sheets\105588_MSEWN001.dgn 12/7/2021 2:14:35 PM meets

G:\projects\2013\W-13-072_FRA-70-13-10_6A\89464\1715B_PHASE_3\structures\sheets\105588_MSEWN007.dgn 12/7/2021 2:14:36 PM meets

ITEM 203, SPECIAL - ENGINEERED FILL (LIGHTWEIGHT CELLULAR CONCRETE FILL): (WALL E7 AND WALL E10)

A. DESCRIPTION.
THIS WORK CONSISTS OF FURNISHING AND PLACING A LOW DENSITY, LIGHTWEIGHT, FLOWABLE, LOW ABSORBABILITY, CEMENTITIOUS FILL MATERIAL, HEREIN REFERRED TO AS CELLULAR CONCRETE FILL (CCF).

B. QUALIFICATIONS.
1. CONTRACTOR.
PROVIDE CCF FROM A CONTRACTOR REGULARLY ENGAGED IN THE PLACEMENT OF CCF MATERIAL, WHO HAS IN THE PAST THREE YEARS COMPLETED MASS FILLS HAVING A COMBINED QUANTITY OF AT LEAST 10,000 TOTAL CUBIC YARDS (7650 CUBIC METERS).

2. CCF MATERIAL.
PROVIDE CCF MATERIAL, MEETING THE REQUIREMENT OF SECTION C OF THIS SPECIFICATION, WHICH HAS BEEN SUCCESSFULLY PLACED ON AT LEAST 5 PROJECTS THAT HAVE PERFORMED SATISFACTORY FOR AT LEAST FIVE YEARS.

C. MATERIALS
1. FOAM.
USE A FOAMING AGENT CONFORMING TO ASTM C796.

2. CEMENT.
USE PORTLAND CEMENT COMPLYING WITH ASTM C150 (TYPE I, II OR III).

3. WATER.
USE WATER ACCORDING TO C&MS 499.02. POTABLE WATER IS SATISFACTORY FOR USE IN CCF. WATER SHALL BE FREE FROM DELETERIOUS SUBSTANCES.

4. ADMIXTURES.
USE ADMIXTURES CONFORMING TO C&MS 499.02 FOR WATER REDUCING, RETARDING, ACCELERATING, ANTI-WASHOUT, IMPROVING THE BOND, OR FOR OTHER SPECIFIC PROPERTIES, WHEN SPECIFICALLY APPROVED BY THE MANUFACTURER OF THE PRE-FORMED FOAM.

701.10 MICRO-SILICA, 701.11 GGBF SLAG, OR FLY ASH SHALL BE CLASS C OR CLASS F AND COMPATIBLE WITH FOAMING AGENT.

D. MIX DESIGN.
DESIGN OF THE PROPOSED CCF MIX WILL BE PROVIDED BY THE SUPPLIER/PRODUCER. THE PROPOSED MIX DESIGN MUST MEET THE PROPERTIES OF TABLE A.

E. QUALITY CONTROL AND ASSURANCE.
PERFORM CAST DENSITY MEASUREMENTS HOURLY ON EACH DAY OF PRODUCTION. MAINTAIN A LOG OF THE CAST DENSITY MEASUREMENTS.

QUALITY ASSURANCE WILL BE BASED ON THE CAST DENSITY AND COMPRESSIVE STRENGTH AT THE POINT OF PLACEMENT. ANY MIXES NOT MEETING THE TABLE A PROPERTIES WILL BE REJECTED.

2. COMPRESSIVE STRENGTH.
TAKE AT LEAST FOUR (4) TEST SPECIMENS FOR EACH 300 CUBIC YARDS (230 CUBIC METERS) OF CCF PLACED OR FOR EACH DAY'S PRODUCTION, PREPARE, CURE, AND TEST THE SPECIMENS IN ACCORDANCE WITH ASTM C796 EXCEPT AS FOLLOWS:

A) FILL AN APPROPRIATE 3-INCH BY 6-INCH (75 MM BY 150 MM) CYLINDER MOLD ACCORDING TO ASTM C796, EXCEPT STRIKE OFF THE EXCESS CCF WITH A TROWEL.

B) CURE THE MOLDS IN A CURING BOX.

C) AFTER CURING, DO NOT OVEN DRY THE SPECIMENS THAT ARE TO BE LOAD TESTED. AIR DRY THE SPECIMENS FOR 1 TO 3 DAYS PRIOR TO TESTING.

D) PROVIDE THE SPECIMENS TO THE ENGINEER FOR TESTING. WHILE SPECIMENS MAY BE TESTED AT ANY AGE TO MONITOR COMPRESSIVE STRENGTH OF THE CCF, A MINIMUM OF TWO SPECIMENS SHALL BE TESTED AT 28 DAYS FOR ACCEPTANCE.

F. CONSTRUCTION METHODS.
PORTABLE PLANT SHALL COMPLY WITH C&MS ITEM 107.11.C AND ALL APPLICABLE ENVIRONMENTAL PERMITS AND REGULATIONS.

PLACEMENT OF CCF SHALL BE ACCORDING TO PROCEDURES PROVIDED BY THE SUPPLIER/PRODUCER.

1. PREPARATION.
THE ENGINEER WILL EXAMINE THE SUBSOIL CONDITIONS IN THE PLACEMENT AREAS. CORRECT UNSUITABLE SOIL CONDITIONS PRIOR TO PLACING THE CCF. PROPERLY FIX IN PLAN POSITION ITEMS TO BE ENCASED IN THE CCF. COAT ANY ALUMINUM TO PREVENT OXIDATION FROM THE FRESH CONCRETE.

2. WEATHER.
DO NOT PLACE CCF IF THE SUBSOIL IS FROZEN. WHEN THE AMBIENT TEMPERATURE IS LESS THAN 32°F (0°C), FOLLOW THE MATERIAL PRODUCER/SUPPLIER'S RECOMMENDATIONS SUCH AS HEATED MIX WATER OR TYP III CEMENT.

TAKE PRECAUTIONS TO AVOID DAMAGE TO THE CCF FROM FREEZING TEMPERATURES PER THE MATERIAL PRODUCER/SUPPLIER'S RECOMMENDATIONS.

3. MIXING AND CONVEYING.
USE JOB SITE MIXING AND CONVEYING EQUIPMENT FOR PROPORTIONING, MIXING AND PLACING THE CCF APPROVED BY THE SUPPLIER/PRODUCER. MIX THE MATERIALS ACCORDING TO THE SUPPLIER/PRODUCER MIX DESIGN PROCEDURES AND, PROMPTLY AFTER MIXING, CONVEY THE CCF TO ITS FINAL POSITION. AVOID EXCESSIVE HANDLING OF THE CCF.

4. PLACEMENT.
1) TOP OF THE CLASS III CCF SHALL NOT BE LESS THAN 2'-0" BELOW THE TOP OF PAVEMENT.

2) THE TOP OF THE CLASS II CCF SHALL NOT BE LESS THAN 4'-0" FROM THE TOP OF PAVEMENT.

DO NOT PLACE CCF INTO AN AREA OF STANDING WATER. PROVIDE AN INVERTED CROWN IN THE CLASS III CCF, AND PIPE UNDERDRAINS, AS SHOWN IN THE DETAILS.

DO NOT PLACE REINFORCEMENTS AT COLD JOINTS. SUPPORT REINFORCEMENTS IN A LEVEL POSITION THROUGHOUT THEIR LENGTH AND KEEP THEM AT LEAST 6 INCHES ABOVE THE PREVIOUS DAY'S COLD JOINT.

FINISHING THE CCF:
THE TOP SURFACE OF THE CCF SHALL BE FINISHED TO DRAIN AS SHOWN ON THE PLANS. THE FINISHING MAY BE EXECUTED DURING PLACEMENT, OR GRADED AFTERWARDS, AT THE CONTRACTOR'S DISCRETION. THE FINISHED SURFACE SHALL NOT EXHIBIT EXCESSIVE CRACKING SUBJECT TO THE APPROVAL OF THE ENGINEER.

5. LOADING.
DO NOT APPLY ANY LOAD ONTO THE CCF UNTIL IT HAS ATTAINED A COMPRESSIVE STRENGTH OF AT LEAST 20 PSI (0.14 MPA).

TABLE A - CELLULAR CONCRETE FILL PROPERTIES		
PROPERTY	CLASS II	CLASS III
*-CAST DENSITY, MAX	30 LB/FT ³ (481 KG/M ³)	36 LB/FT ³ (577 KG/M ³)
**--COMPRESSIVE STRENGTH, MIN. @ 28 DAYS	40 PSI (0.28 MPA)	80 PSI (0.55 MPA)
***-WATER ABSORPTION, ASTM C796, MAX.	20 PERCENT	16 PERCENT

* - SPECIFIED IN SECTION F.1 OF THIS SPECIFICATION
** - SPECIFIED IN SECTION F.2 OF THIS CLASSIFICATION
*** - EXPRESSED AS PERCENT OF CAST DENSITY

G. SUBMITTALS TO THE ENGINEER.
PROVIDE THE FOLLOWING SUBMITTALS TO THE ENGINEER A MINIMUM OF 30 DAYS PRIOR TO PLACEMENT OF CCF FOR EACH LOACTION:

1. RESUME OF CONTRACOTR'S SHOWING EXPERIENCE AS SPECIFIED ABOVE, INCLUDING QUALIFICATIONS OF CONTRACTOR'S SUPERINTENDENT AND/OR FOREMAN.

2. CCF MIX DESIGN MEETING THE REQUIREMENTS SPECIFIED ABOVE, INCLUDING MATERIALS TO BE USED, THEIR SOURCES AND TEST DATA.

3. QC PLAN IDENTIFYING THE METHOD AND FREQUENCY OF TESTING IN ACCORDANCE WITH ASTM C796 AND MEETING THE REQUIREMENTS ABOVE.

4. DESCRIPTION OF EQUIPMENT AND PLACEMENT METHODS TO VERIFY COMPLIANCE WITH THE MIXING AND CONVEYING THE REQUIRMENTS ABOVE.

5. WORKING DRAWINGS SHOWING METHOD OF PLACEMENT FOR CONSTRUCTION PER THE PLANS AND DEMONSTRATING COMPLIANCE WITH THIS NOTE. THESE DRAWINGS SHALL PROVIDE SECTIONS LOCATING THE CROWNS AND LOCATIONS OF THE STEPS IN THE CLASS III CCF LIFT.

H. METHOD OF MEASUREMENT.
THE DEPARTMENT WILL MEASURE EACH CLASS OF CCF BY THE NUMBER OF CUBIC YARDS COMPLETE IN PLACE.

I. BASIS OF PAYMENT.
THE DEPARTMENT WILL PAY FOR ACCEPTED QUANTITIES AT THE CONTRACT PRICE AS FOLLOWS:

ITEM	UNIT	DESCRIPTION
SPECIAL	CUBIC YARD	ENGINEERED FILL: LIGHTWEIGHT CELLULAR CONCRETE FILL, CLASS II
SPECIAL	CUBIC YARD	ENGINEERED FILL: LIGHTWEIGHT CELLULAR CONCRETE FILL, CLASS III

ALL QUANTITIES AND COSTS ASSOCIATED WITH THIS ITEM BETWEEN STA. 702+19.50 AND STA. 705+60.87 (WALL E7) SHALL BE INCLUDED IN THE ESTIMATED QUANTITIES AND COST ESTIMATE FOR WALL E7.

ALL QUANTITIES AND COSTS ASSOCIATED WITH THIS ITEM BETWEEN STA. 277+97.19 AND STA. 380+20.00 (I-71 S.B.) SHALL BE INCLUDED IN THE ESTIMATED QUANTITIES AND COST ESTIMATE FOR WALL E10.

NO.	DESCRIPTION	REV. BY	DATE
1	UPDATED SHEET TITLE	MMS	11/5/21
1	MODIFIED NOTES	MMS	11/5/21
6	MODIFIED TITLE	MMS	12/1/21
6	MODIFIED NOTE	MMS	12/1/21
8	MODIFIED NOTE	KSJ	12/7/21

RESOURCE INTERNATIONAL, INC.
6350 PRESIDENTIAL GATEWAY
COLUMBUS, OHIO 43231
(614) 823-4949

Rii

REVIEWED	DATE	DESIGNED	DATE
NCK	6/23/2021	MMS	6/23/2021
STRUCTURE FILE NUMBER		CHECKED	DATE
		JGM	

RETAINING WALL NOTES 4 OF 9

RETAINING WALLS

I-70/I-71 WEST INTERCHANGE PROJECT

FRA - 71 - 14.36

PID No. 105588

4 / 9


841
1228

G:\projects\2013\W-13-072_FRA-70-13-10_6A\89464\structures\wall_OE7\sheets\105588_OE7W0001.dgn 12/7/2021 3:26:15 PM meets

CALCULATED BY: KSJ DATE: 06/08/2020
 CHECKED BY: MMS DATE: 06/08/2020

ESTIMATED QUANTITIES					AS PER PLAN REFERENCE SHEET
ITEM	ITEM EXT.	TOTAL	UNIT	DESCRIPTION	
203	02000	9684	CU YD	SPECIAL - ENGINEERED FILL: LIGHTWEIGHT CELLULAR CONCRETE FILL, CLASS II	
203	02000	451	CU YD	SPECIAL - ENGINEERED FILL: LIGHTWEIGHT CELLULAR CONCRETE FILL, CLASS III	
203	20000	436	CU YD	EMBANKMENT	
203	35110	935	CU YD	GRANULAR MATERIAL, TYPE B	
203	65000	2	EACH	SPECIAL - SETTLEMENT PLATFORM	
203	98000	4687	CU YD	ROADWAY MISC.: EPS GEOFOAM FILL	
508	11001	15	LS	SOFFERDAMS AND EXCAVATION, AS PER PLAN	838
509	10001	31202	LB	EPOXY COATED REINFORCING STEEL, AS PER PLAN	838
511	53012	199	CU YD	CLASS QC2 CONCRETE, MISC.: PARAPET INCLUDING SLEEPER SLAB WITH QC2A	
511	53012	132	CU YD	CLASS QC2 CONCRETE, MISC.: LOAD DISTRIBUTION SLAB	
511	71200	5058	SQ FT	CONCRETE MISC.: PRECAST WALL PANELS	
511	81100	121	FT	CONCRETE MISC.: PRECAST FOOTING	
512	10100	2080	SQ YD	SEALING OF CONCRETE SURFACES (EPOXY URETHANE)	
516	13200	76	SQ FT	1/2" PREFORMED EXPANSION JOINT FILLER	
516	13900	857	SQ FT	2" PREFORMED EXPANSION JOINT FILLER	
607	39901	363	FT	VANDAL PROTECTION FENCE, 6' STRAIGHT, COATED FABRIC, AS PER PLAN	838
840	20001	12751	SQ FT	MECHANICALLY STABILIZED EARTH WALL, AS PER PLAN	839 & 843
840	21000	4995	CU YD	WALL EXCAVATION	
840	22000	1485	SQ YD	FOUNDATION PREPARATION	
840	23000	2660	CU YD	SELECT GRANULAR BACKFILL	
840	25010	506	FT	6" DRAINAGE PIPE, PERFORATED	
840	26000	523	FT	CONCRETE COPING	
840	26050	16763	SQ FT	AESTHETIC SURFACE TREATMENT	
840	27000	5	DAY	ON-SITE ASSISTANCE	

NO.	DESCRIPTION	REV. BY	DATE
1	REMOVED ITEM 203 - GRANULAR MATERIAL, TYPE C QUANTITY	KSJ	11/5/21
3	UPDATED ITEM 509 TO AS PER PLAN	MMS	11/18/21
3	REMOVED ITEM 840E28000 - SGB INSPECTION AND COMPACTION TESTING	MMS	11/18/21
6	UPDATED QUANTITY	MMS	12/1/21
8	UPDATED ITEM 840 - MSE WALL QUANTITY	MMS	12/7/21

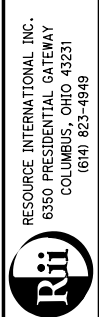

REVIEWED DATE: 6/23/2021
 NCK: 6/23/2021
 STRUCTURE FILE NUMBER


DRAWN: MMS
 CHECKED: MMS
 REVISED:

DESIGNED: KSJ
 CHECKED: MMS

ESTIMATED QUANTITIES
 RETAINING WALL ET
 I-70/I-71 WEST INTERCHANGE PROJECT

FRA-71-14.36
 PID No. 105588

G:\projects\2013\W-13-072_FRA-70-13-10_6A\89464_structures_wall_OE7\sheets\105588_OE7WP001.dgn 12/7/2021 2:15:24 PM meets

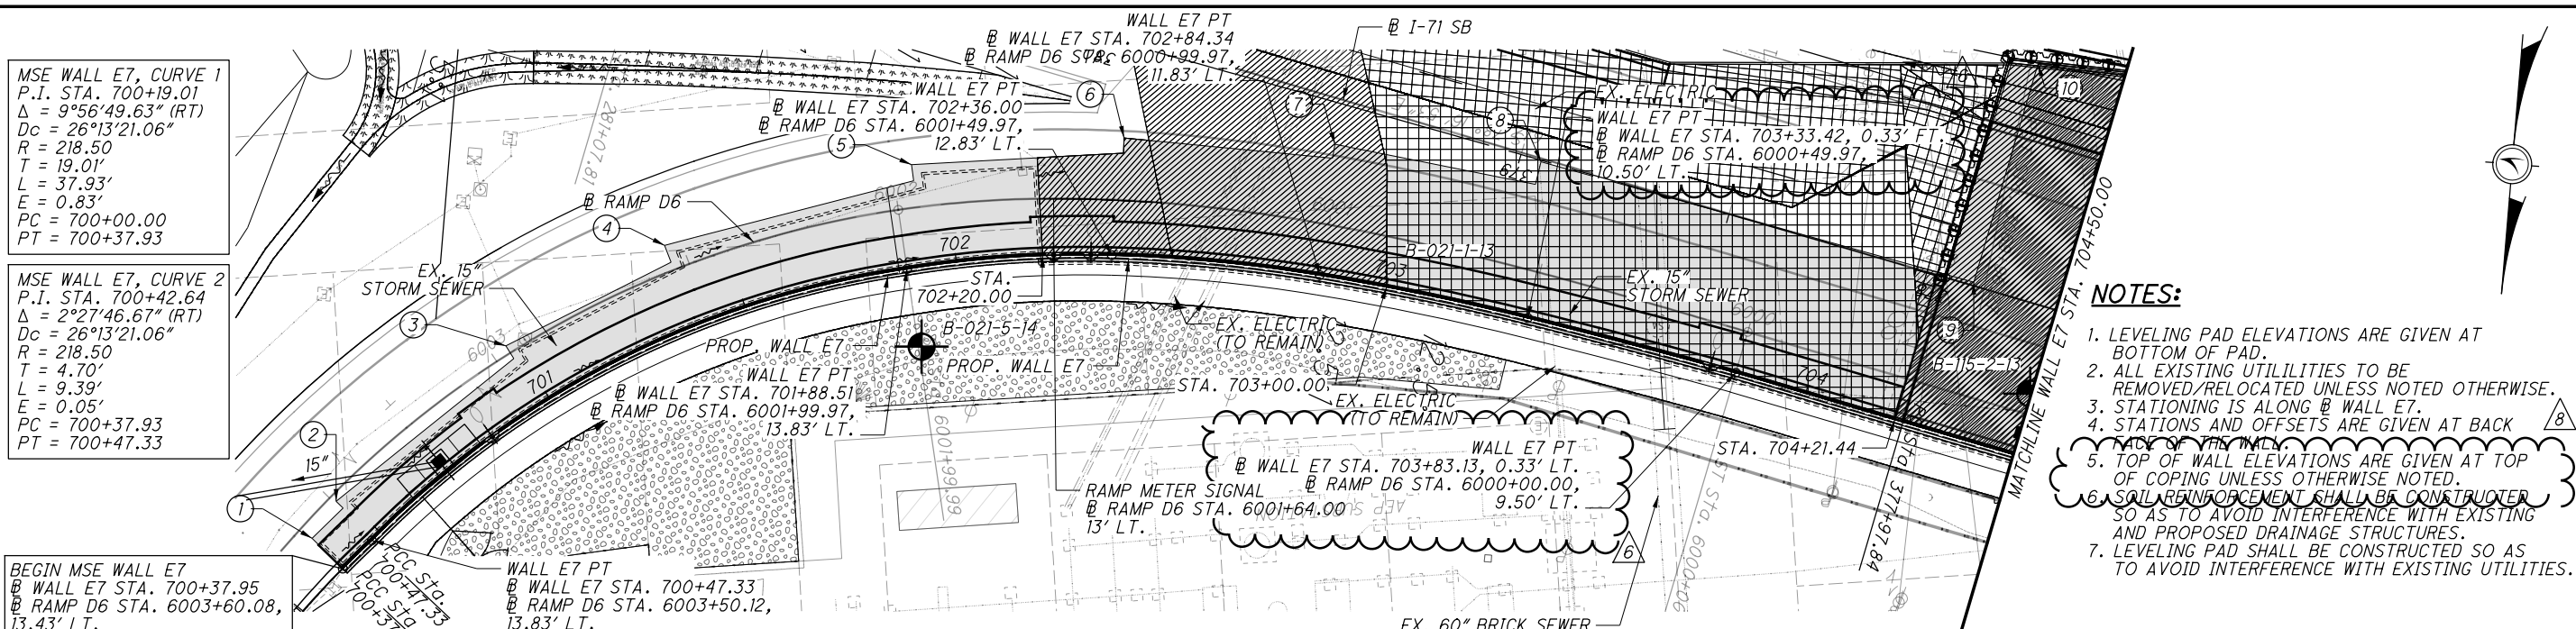

MSE WALL E7, CURVE 1
 P.I. STA. 700+19.01
 $\Delta = 9^{\circ}56'49.63''$ (RT)
 $Dc = 26^{\circ}13'21.06''$
 $R = 218.50$
 $T = 19.01'$
 $L = 37.93'$
 $E = 0.83'$
 $PC = 700+00.00$
 $PT = 700+37.93$

MSE WALL E7, CURVE 2
 P.I. STA. 700+42.64
 $\Delta = 2^{\circ}27'46.67''$ (RT)
 $Dc = 26^{\circ}13'21.06''$
 $R = 218.50$
 $T = 4.70'$
 $L = 9.39'$
 $E = 0.05'$
 $PC = 700+37.93$
 $PT = 700+47.33$

BEGIN MSE WALL E7
 WALL E7 STA. 700+37.95
 RAMP D6 STA. 6003+60.08,
 13.43' LT.

MSE WALL E7, CURVE 3
 P.I. STA. 701+20.50
 $\Delta = 37^{\circ}09'38.88''$ (RT)
 $Dc = 26^{\circ}19'22.59''$
 $R = 217.66$
 $T = 73.17'$
 $L = 141.17'$
 $E = 11.97'$
 $PC = 700+47.33$
 $PT = 701+88.51$

MSE WALL E7, CURVE 4
 P.I. STA. 702+12.32
 $\Delta = 10^{\circ}50'57.51''$ (RT)
 $Dc = 22^{\circ}50'42.06''$
 $R = 250.80$
 $T = 23.82'$
 $L = 47.49'$
 $E = 1.13'$
 $PC = 701+88.51$
 $PT = 702+36.00$

MSE WALL E7, CURVE 5
 P.I. STA. 702+60.20
 $\Delta = 7^{\circ}45'01.77''$ (RT)
 $Dc = 16^{\circ}01'59.41''$
 $R = 357.36$
 $T = 24.21'$
 $L = 48.34'$
 $E = 0.82'$
 $PC = 702+36.00$
 $PT = 702+84.34$


MSE WALL E7, CURVE 6
 P.I. STA. 703+08.89
 $\Delta = 4^{\circ}39'13.93''$ (RT)
 $Dc = 9^{\circ}28'51.13''$
 $R = 604.33$
 $T = 24.56'$
 $L = 49.09'$
 $E = 0.50'$
 $PC = 702+84.34$
 $PT = 703+33.42$

MSE WALL E7, CURVE 7
 P.I. STA. 703+58.28
 $\Delta = 1^{\circ}33'25.47''$ (RT)
 $Dc = 3^{\circ}07'55.79''$
 $R = 1,829.27$
 $T = 24.86'$
 $L = 49.71'$
 $E = 0.17'$
 $PC = 703+33.42$
 $PT = 703+83.14$

MSE WALL E7, TANGENT 1
 STA. 703+83.14
 STA. 704+66.26
 $L = 83.12'$
 BRG. = N 78°16'53" W

MSE WALL E7, TANGENT 2
 STA. 704+66.26
 STA. 705+60.87
 $L = 94.62'$
 BRG. = S 11°43'07" W

PLAN

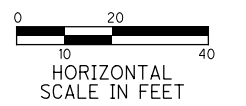


LEGEND:

- 6" DIA PERF CPP
- PROJECT BORING LOCATION
- SETTLEMENT PLATFORM
- HISTORIC BORING LOCATION
- PLAN BOUNDARY FOR ITEMS INCLUDED WITH MSE WALL E7 FOR PAYMENT
- LIMITS OF GEOFOAM BACKFILL
- LIMITS OF CELLULAR CONCRETE FILL

NOTES:

1. LEVELING PAD ELEVATIONS ARE GIVEN AT BOTTOM OF PAD.
2. ALL EXISTING UTILITIES TO BE REMOVED/RELOCATED UNLESS NOTED OTHERWISE.
3. STATIONING IS ALONG WALL E7.
4. STATIONS AND OFFSETS ARE GIVEN AT BACK FACE OF THE WALL.
5. TOP OF WALL ELEVATIONS ARE GIVEN AT TOP OF COPING UNLESS OTHERWISE NOTED.
6. SOIL REINFORCEMENT SHALL BE CONSTRUCTED SO AS TO AVOID INTERFERENCE WITH EXISTING AND PROPOSED DRAINAGE STRUCTURES.
7. LEVELING PAD SHALL BE CONSTRUCTED SO AS TO AVOID INTERFERENCE WITH EXISTING UTILITIES.

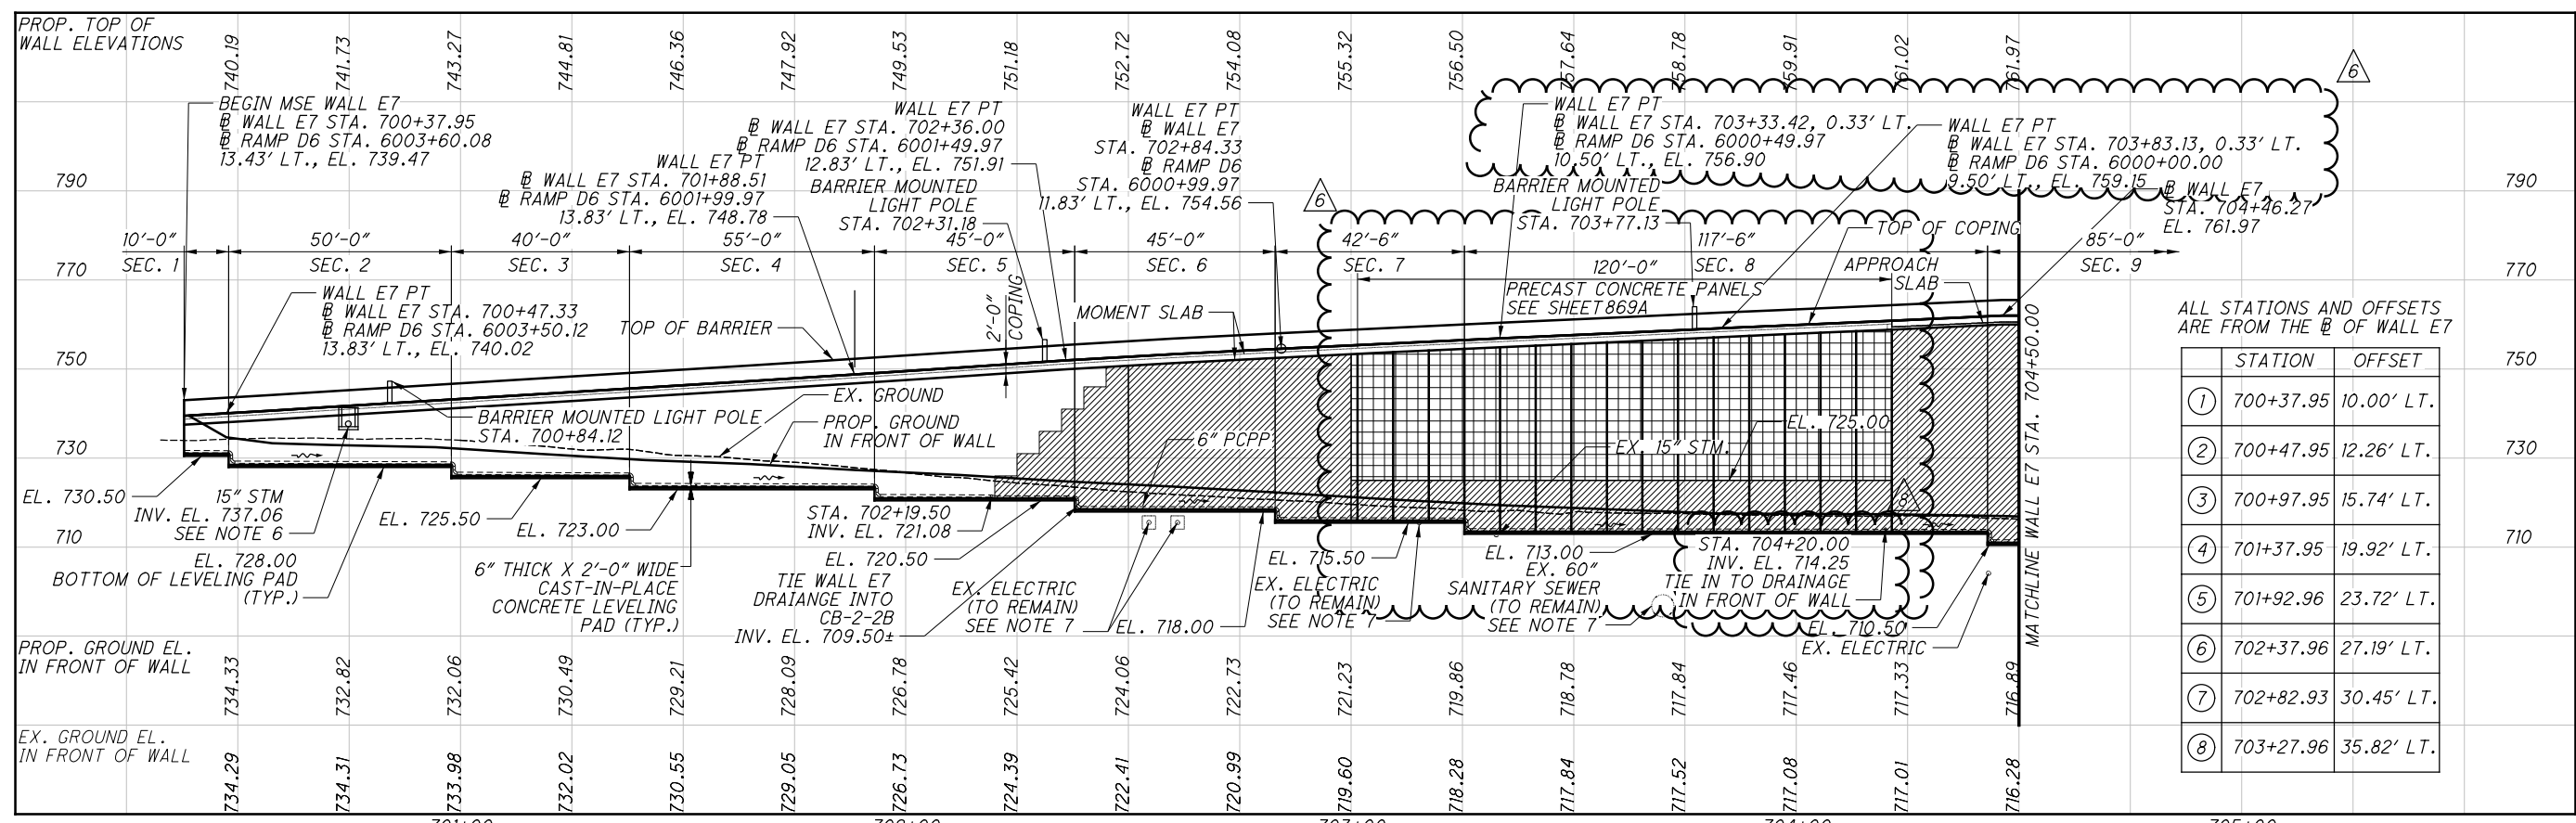

ALL STATIONS AND OFFSETS ARE FROM THE @ OF WALL E7

STATION	OFFSET
① 700+37.95	10.00' LT.
② 700+47.95	12.26' LT.
③ 700+97.95	15.74' LT.
④ 701+37.95	19.92' LT.
⑤ 701+92.96	23.72' LT.
⑥ 702+37.96	27.19' LT.
⑦ 702+82.93	30.45' LT.
⑧ 703+27.96	35.82' LT.

ELEVATION ALONG FACE OF WALL

NO.	DESCRIPTION	REV. BY	DATE
6	MODIFIED PRECAST PANEL DETAIL	MMS	12/2/21
7	UPDATED WALL STATIONS	MMS	12/2/21
8	UPDATED DRAINAGE BEHIND PRECAST PANEL	MMS	12/7/21
8	MODIFIED NOTES	MMS	12/7/21

RESOURCE INTERNATIONAL, INC.
 6550 PRESIDENTIAL GATEWAY
 COLUMBIAS, MISSOURI 65201
 (616) 824-8484

Rii

DATE: 6/23/2021
 REVIEWED: NCK
 DRAWN: JGM
 CHECKED: MMS

STRUCTURE FILE NUMBER: 1-70/1-71 WEST INTERCHANGE PROJECT


PLAN AND ELEVATION 1 OF 2
 RETAINING WALL E7 (RAMP D6 & SHORT ST.)

FRA-71-14.36
 PID No. 105588

2 / 11


865
1228

G:\projects\2013\W-13-072_FRA-70-13-10_6A\89464_structures\wall_OE7\sheets\105588_OE7WD005.dgn 12/7/2021 2:15:27 PM meels

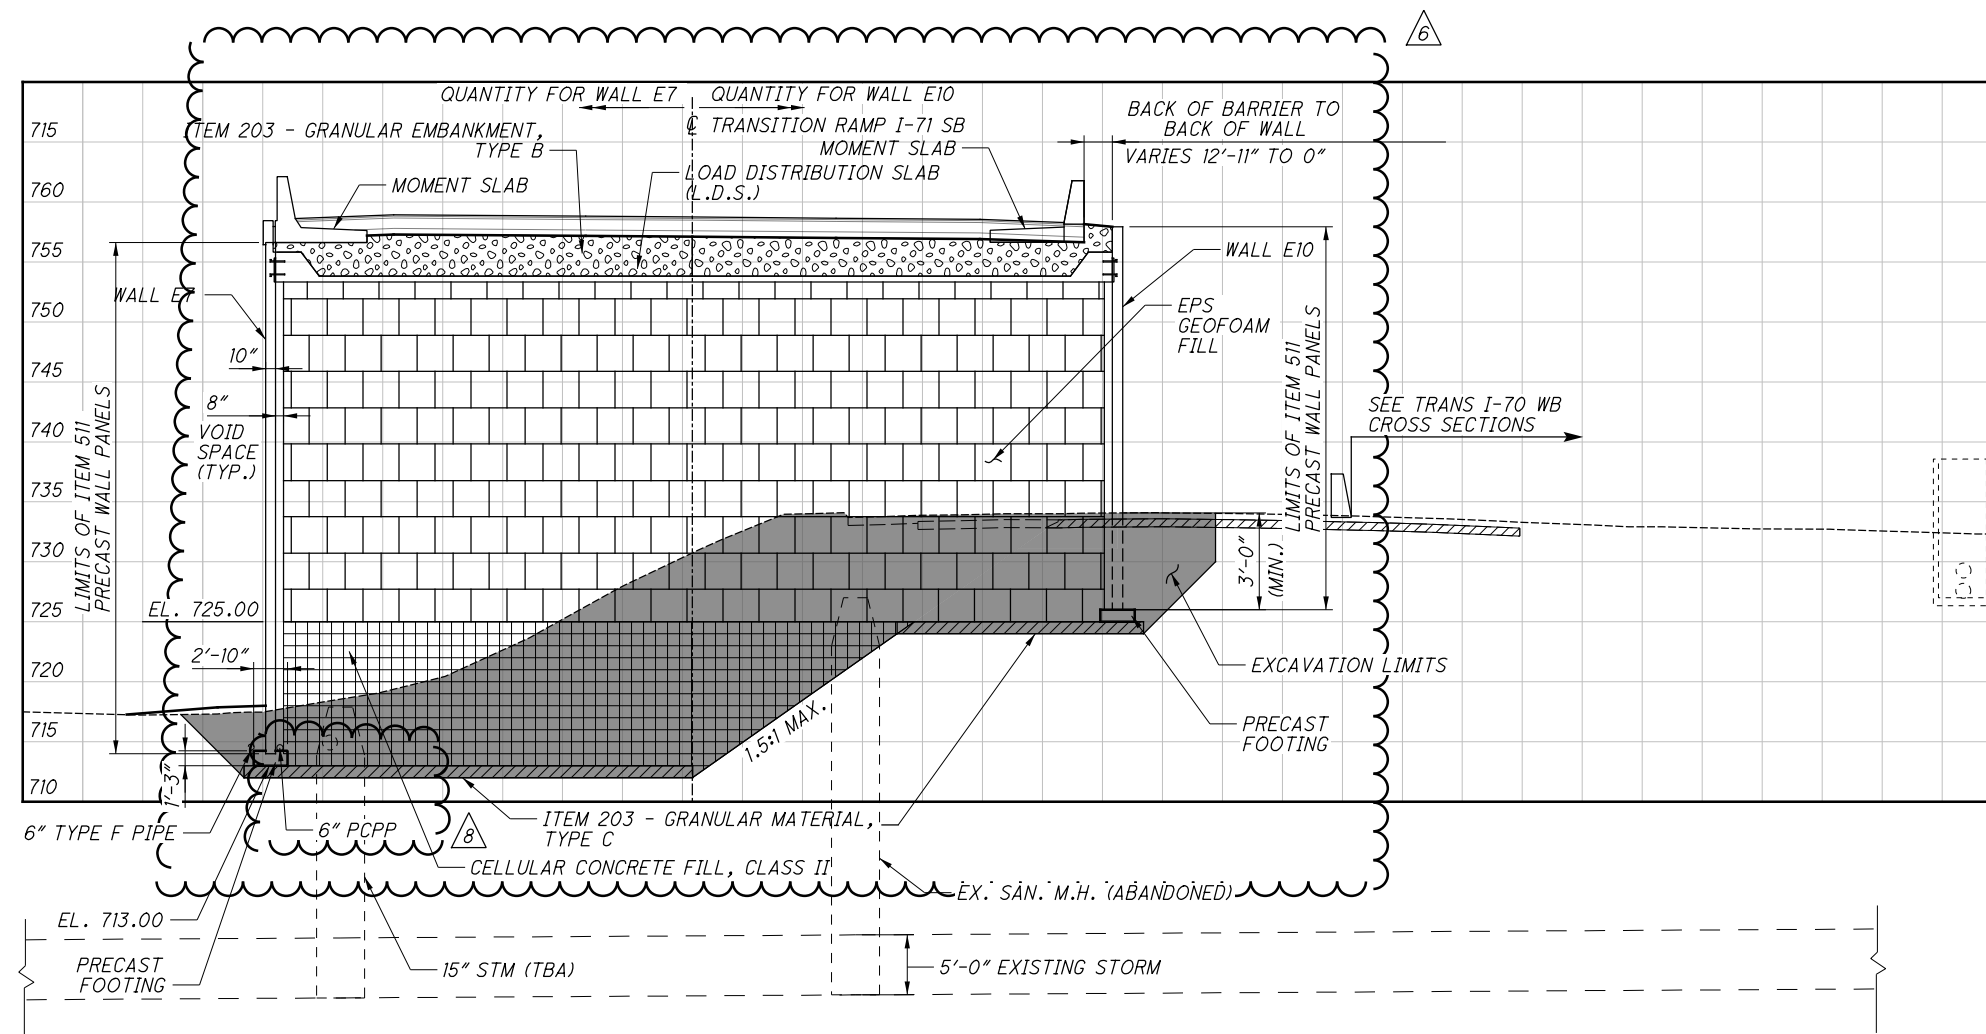


RAMP D6, STA. 6000+11.70
 @ WALL E7, STA. 703+71.43
 @ I-71 TRANSITION SB RAMP, STA. 378+50.00


NO.	DESCRIPTION	REV. BY	DATE
6	UPDATED SECTION	MMS	12/2/21
6	REMOVED REDUNDANT GEOFOAM WALL SECTION	MMS	12/2/21
6	REMOVED REDUNDANT L.D.S. DETAIL	MMS	12/2/21
8	ADDED 6" PCPP	MMS	12/7/21

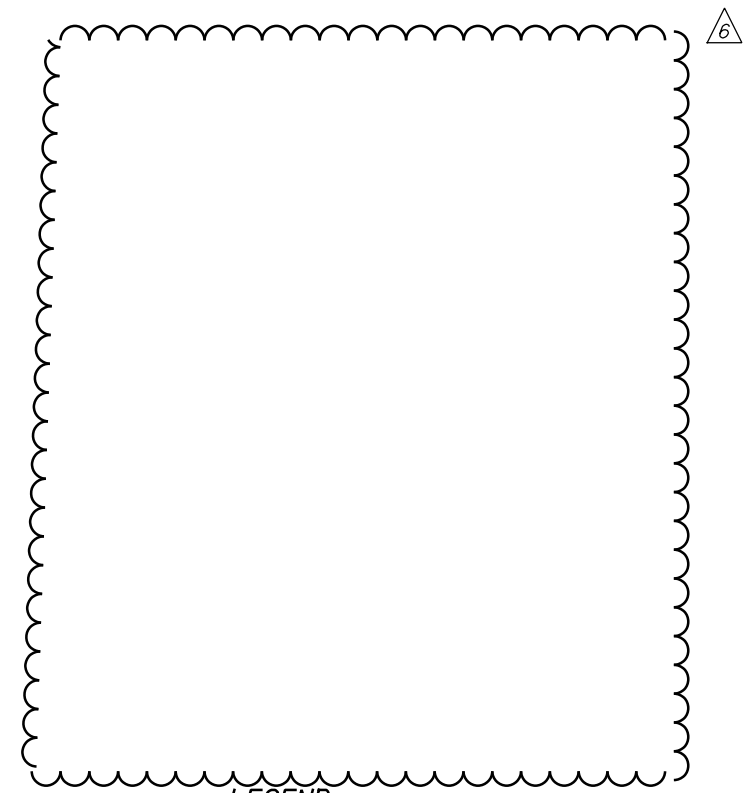


- LEGEND:**
- CELLULAR CONCRETE FILL, CLASS II
 - GRANULAR EMBANKMENT, TYPE B
 - EPS GEOFOAM FILL
 - EXCAVATION LIMITS
 - GRANULAR MATERIAL, TYPE C

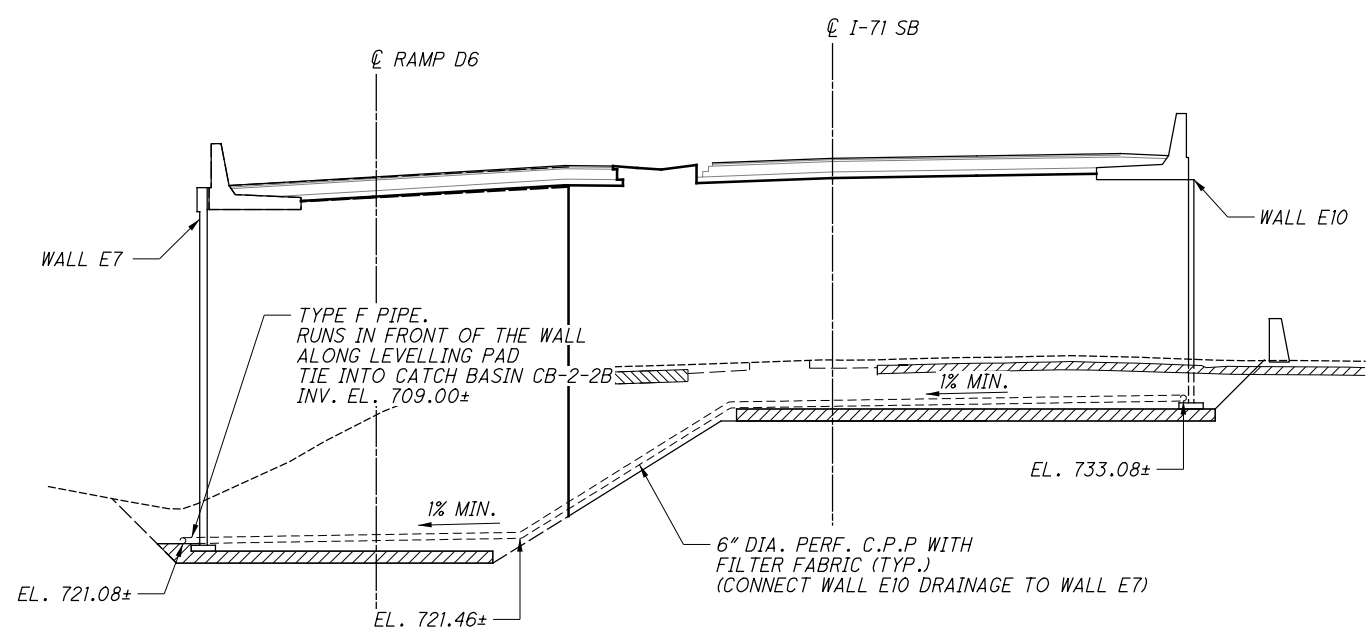

RAMP D6, STA. 6001+67.73
 @ WALL E7, STA. 702+19.50
 @ I-71 TRANSITION SB RAMP, STA. 380+20.00

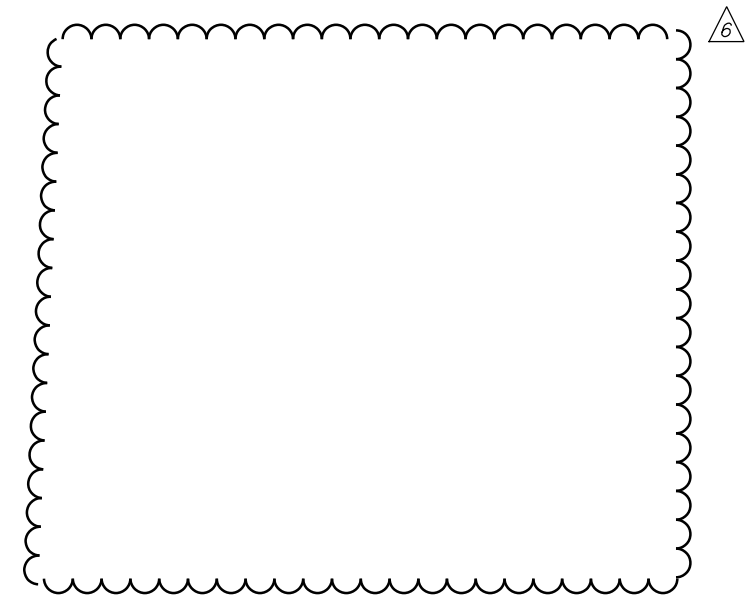


G:\projects\2013\W-13-072_FRA-70-13.10_6A\89464_structures\wall_OE7\sheets\105588_OE7WD009.dgn 12/7/2021 2:15:30 PM meets

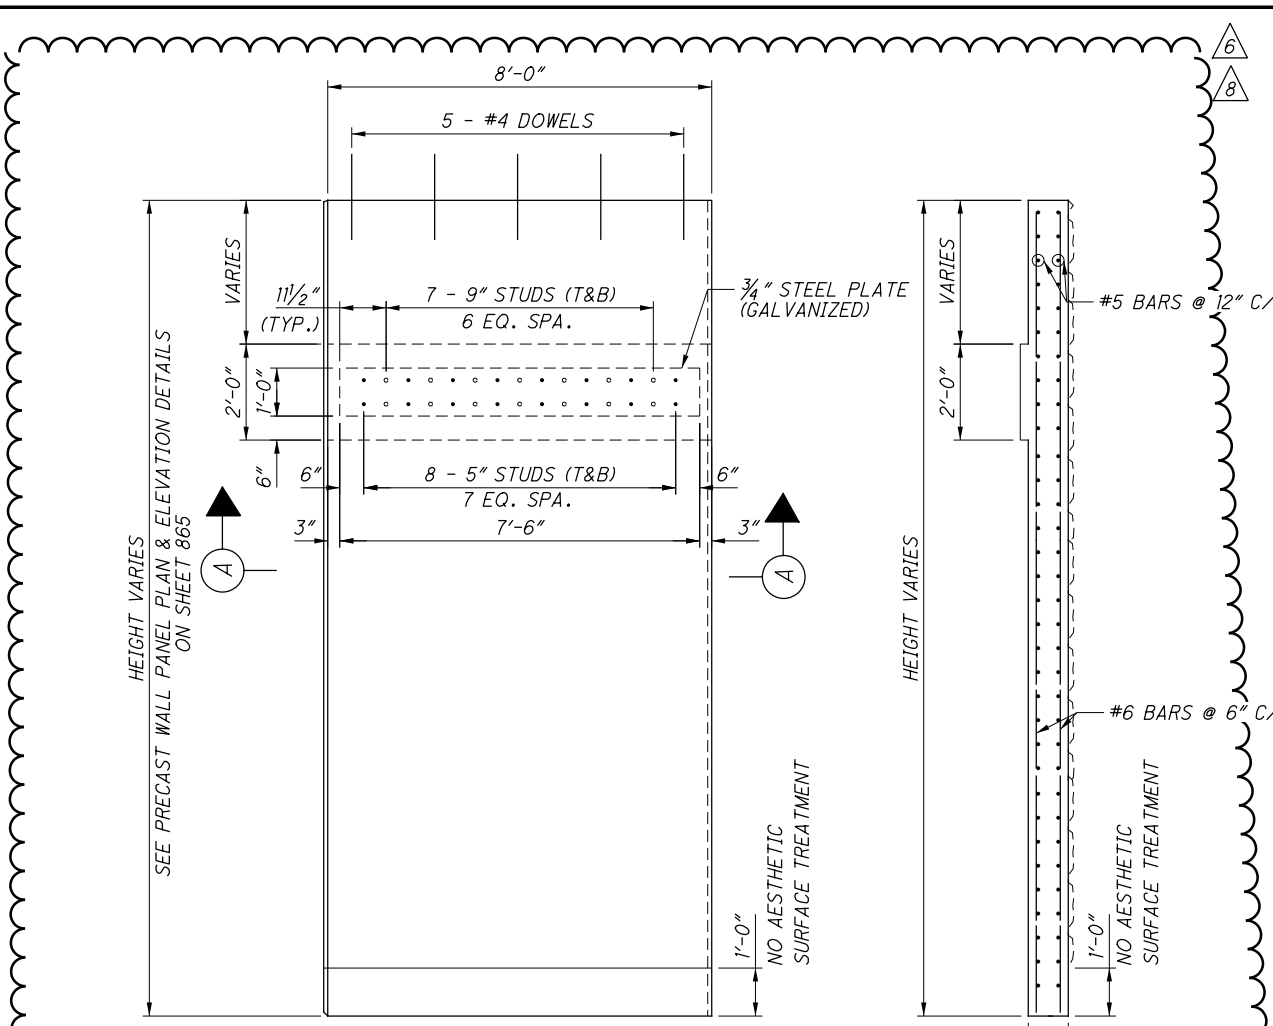

PRECAST PANEL DETAILS

SECTION

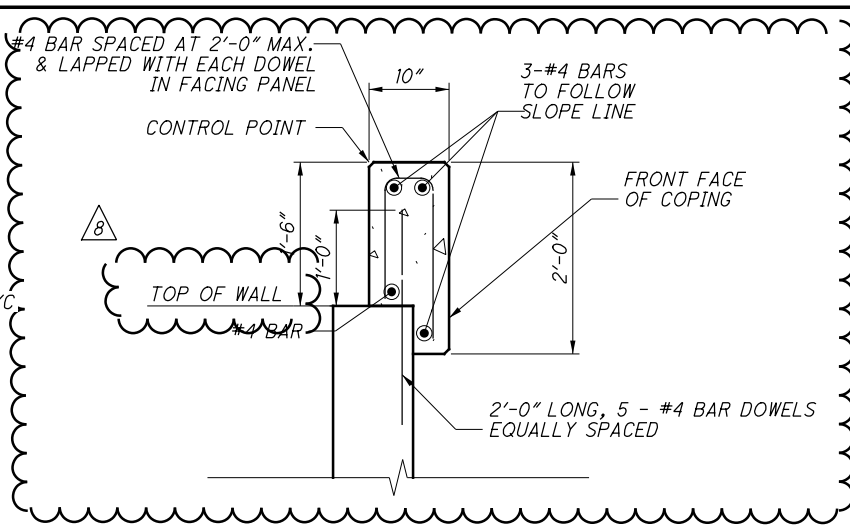


COPING DETAIL


PRECAST CONCRETE PANELS*

	STA.	OFFSET	B/L	TOP OF WALL
BEGIN	703+01.44	0.33' LT.	E7	753.88
END	704+21.44	0.33' LT.	E7	759.36

* - ALL STATIONS, OFFSETS AND ELEVATIONS ARE TO THE BACK FACE OF THE PRECAST WALL.

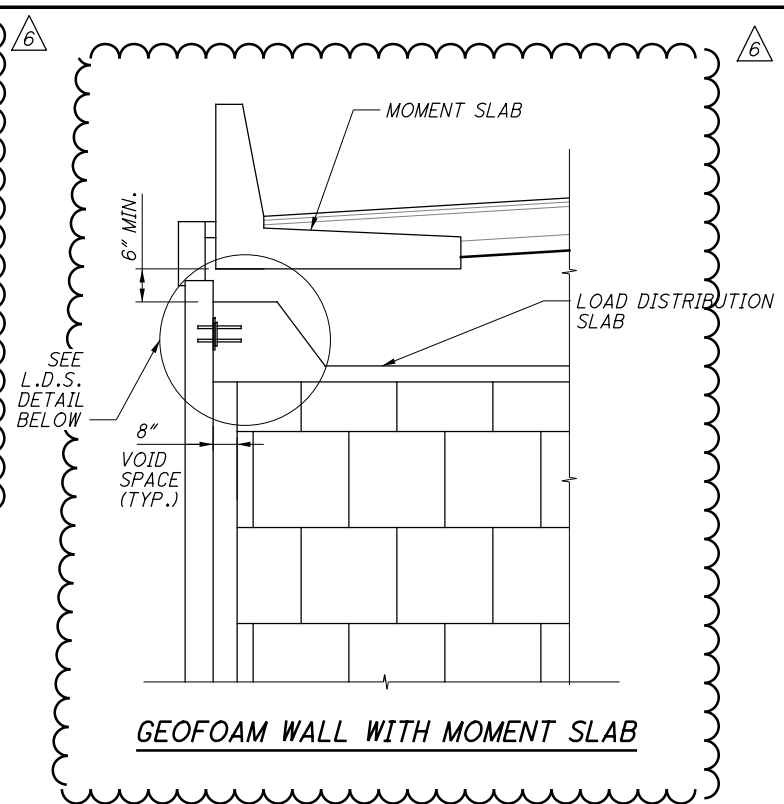


NO.	DESCRIPTION	REV. BY	DATE
6	MODIFIED PRECAST PANEL AND FOOTING DETAIL	MMS	12/2/21
6	UPDATED COPING DETAIL	MMS	12/2/21
6	UPDATED GEOFOAM WALL SECTION	MMS	12/2/21
6	MIRRORED L.D.S. DETAIL	MMS	12/2/21
6	REMOVED TIE STRIP DETAIL	MMS	12/2/21
6	ADDED WALL BEGIN AND END STATION	MMS	12/3/21
8	UPDATED PRECAST PANEL DETAILS	MMS	12/7/21
8	UPDATED TOP OF WALL ELEVATION	MMS	12/7/21
8	UPDATED L.D.S. DETAIL	MMS	12/7/21

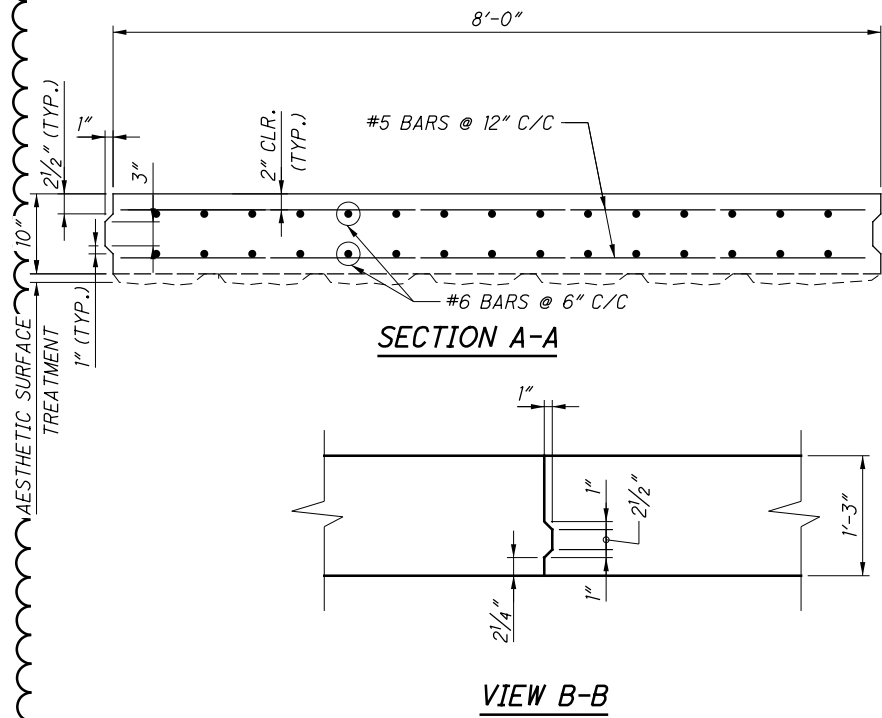


SECTION A-A

VIEW B-B

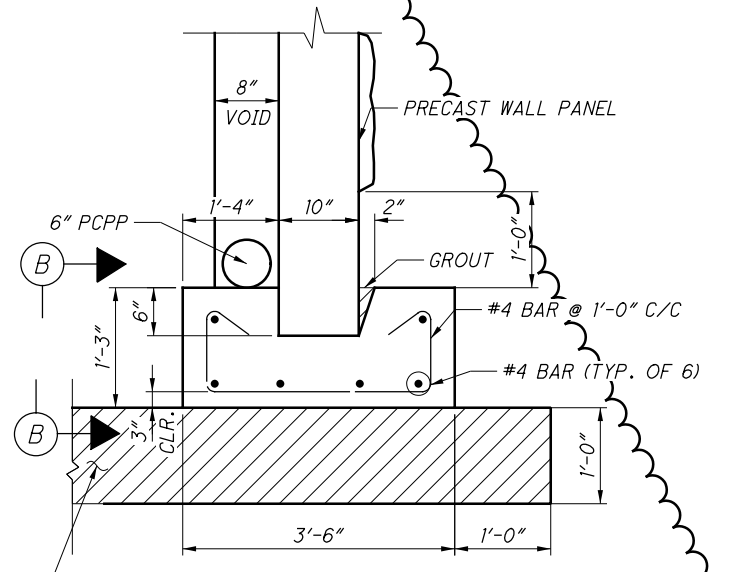

PRECAST FOOTING DETAIL

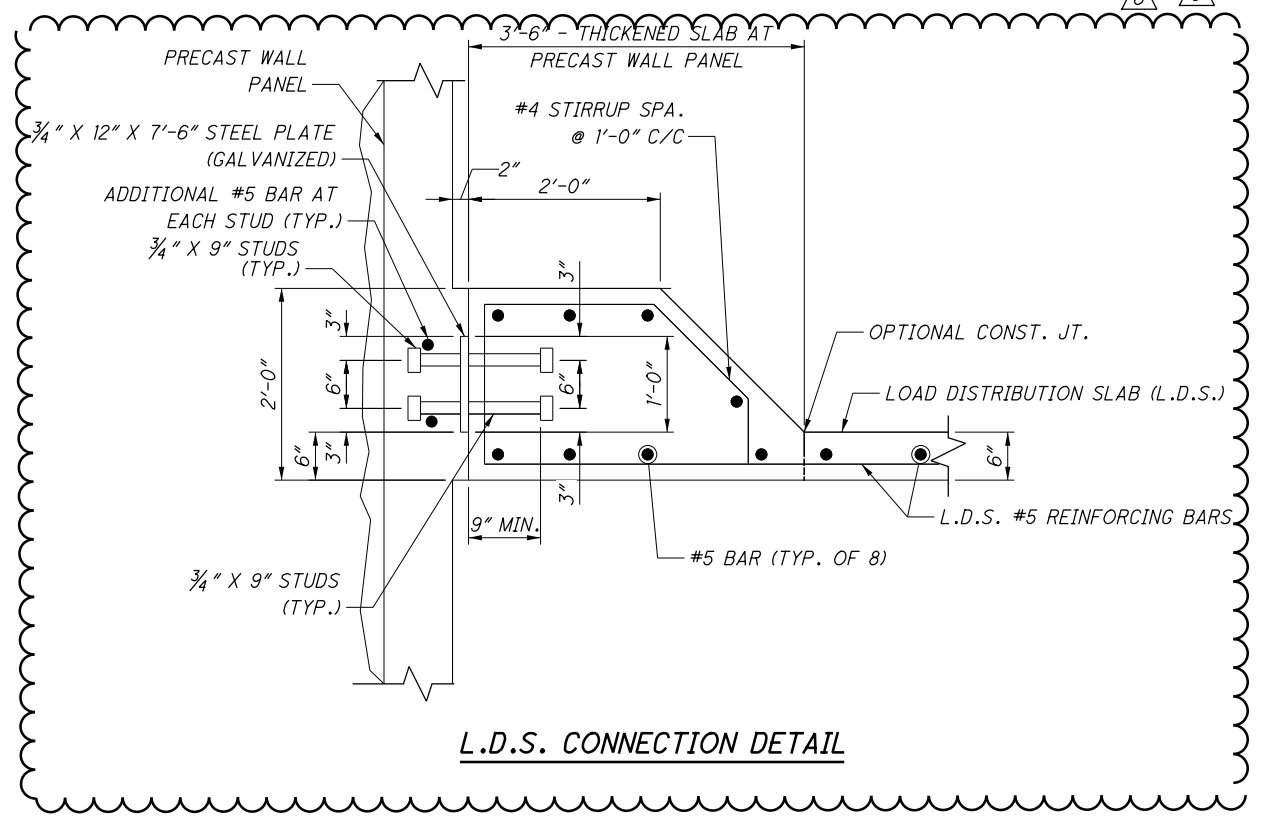

L.D.S. CONNECTION DETAIL

G:\projects\2013\W-13-072_FRA-70-13-10_6A\89464_structures\wall_OE10\sheets\105588_OE10W0001.dgn 12/7/2021 3:26:16 PM meets

CALCULATED BY: KSJ DATE: 03/04/2020
 CHECKED BY: MMS DATE: 03/04/2020

ESTIMATED QUANTITIES

ITEM	ITEM EXT.	TOTAL	UNIT	DESCRIPTION	AS PER PLAN REFERENCE SHEET
203	02000	1346	CU YD	SPECIAL - ENGINEERED FILL: LIGHTWEIGHT CELLULAR CONCRETE FILL, CLASS II	
203	02000	122	CU YD	SPECIAL - ENGINEERED FILL: LIGHTWEIGHT CELLULAR CONCRETE FILL, CLASS III	
203	20000	678	CU YD	EMBANKMENT	
203	35110	827	CU YD	GRANULAR MATERIAL, TYPE B	
203	98000	6138	CU YD	ROADWAY MISC.: EPS GEOFOAM FILL	
503	11101	LS	LS	COFFERDAMS AND EXCAVATION, AS PER PLAN	838
509	10001	39409	LB	EPOXY COATED REINFORCING STEEL, AS PER PLAN	838
51	53012	247	CU YD	CLASS QC2 CONCRETE, MISC.: PARAPET INCLUDING SLEEPER SLAB WITH OC/DA	
511	53012	129	CU YD	CLASS QC2 CONCRETE, MISC.: LOAD DISTRIBUTION SLAB	
511	71200	1628	SQ FT	CONCRETE MISC.: PRECAST WALL PANELS	
511	81100	152	FT	CONCRETE MISC.: PRECAST FOOTING	
512	10100	1240	SQ YD	SEALING OF CONCRETE SURFACES (EPOXY URETHANE)	
840	20001	5717	SQ FT	MECHANICALLY STABILIZED EARTH WALL, AS PER PLAN	839
840	21000	1104	CU YD	WALL EXCAVATION	
840	22000	743	SQ YD	FOUNDATION PREPARATION	
840	23000	1748	CU YD	SELECT GRANULAR BACKFILL	
840	25010	455	FT	6" DRAINAGE PIPE, PERFORATED	
840	27000	5	DAY	ON-SITE ASSISTANCE	

NO.	DESCRIPTION	REV. BY	DATE
1	REMOVED ITEM 203 - GRANULAR MATERIAL, TYPE C QUANTITY	KSJ	11/5/21
3	UPDATED ITEM 509 TO AS PER PLAN	MMS	11/18/21
3	REMOVED ITEM 840E28000 - SGB INSPECTION AND COMPACTION TESTING	MMS	11/18/21
6	ADDED ITEM-511 LOAD DISTRIBUTION SLAB	MMS	12/1/21
8	UPDATED ITEM 840 - MSE WALL QUANTITY	MMS	12/7/21

RESOURCE INTERNATIONAL INC.
 6350 PRESIDENTIAL GATEWAY
 COLUMBUS, OHIO 43231
 (614) 823-4949



REVIEWED DATE: 6/23/2021
 NCK
 STRUCTURE FILE NUMBER


DRAWN MMS
 REVISIONS

DESIGNED KSJ
 CHECKED MMS

ESTIMATED QUANTITIES
 RETAINING WALL E10
 I-70/I-71 WEST INTERCHANGE PROJECT

FRA-71-14.36
 PID No. 105588

G:\projects\2013\W-13-072_FRA-70-13-10_6A\89464_structures_wall_0E10\sheets\105588_0E10WP001.dgn 12/17/2021 2:16:08 PM meets

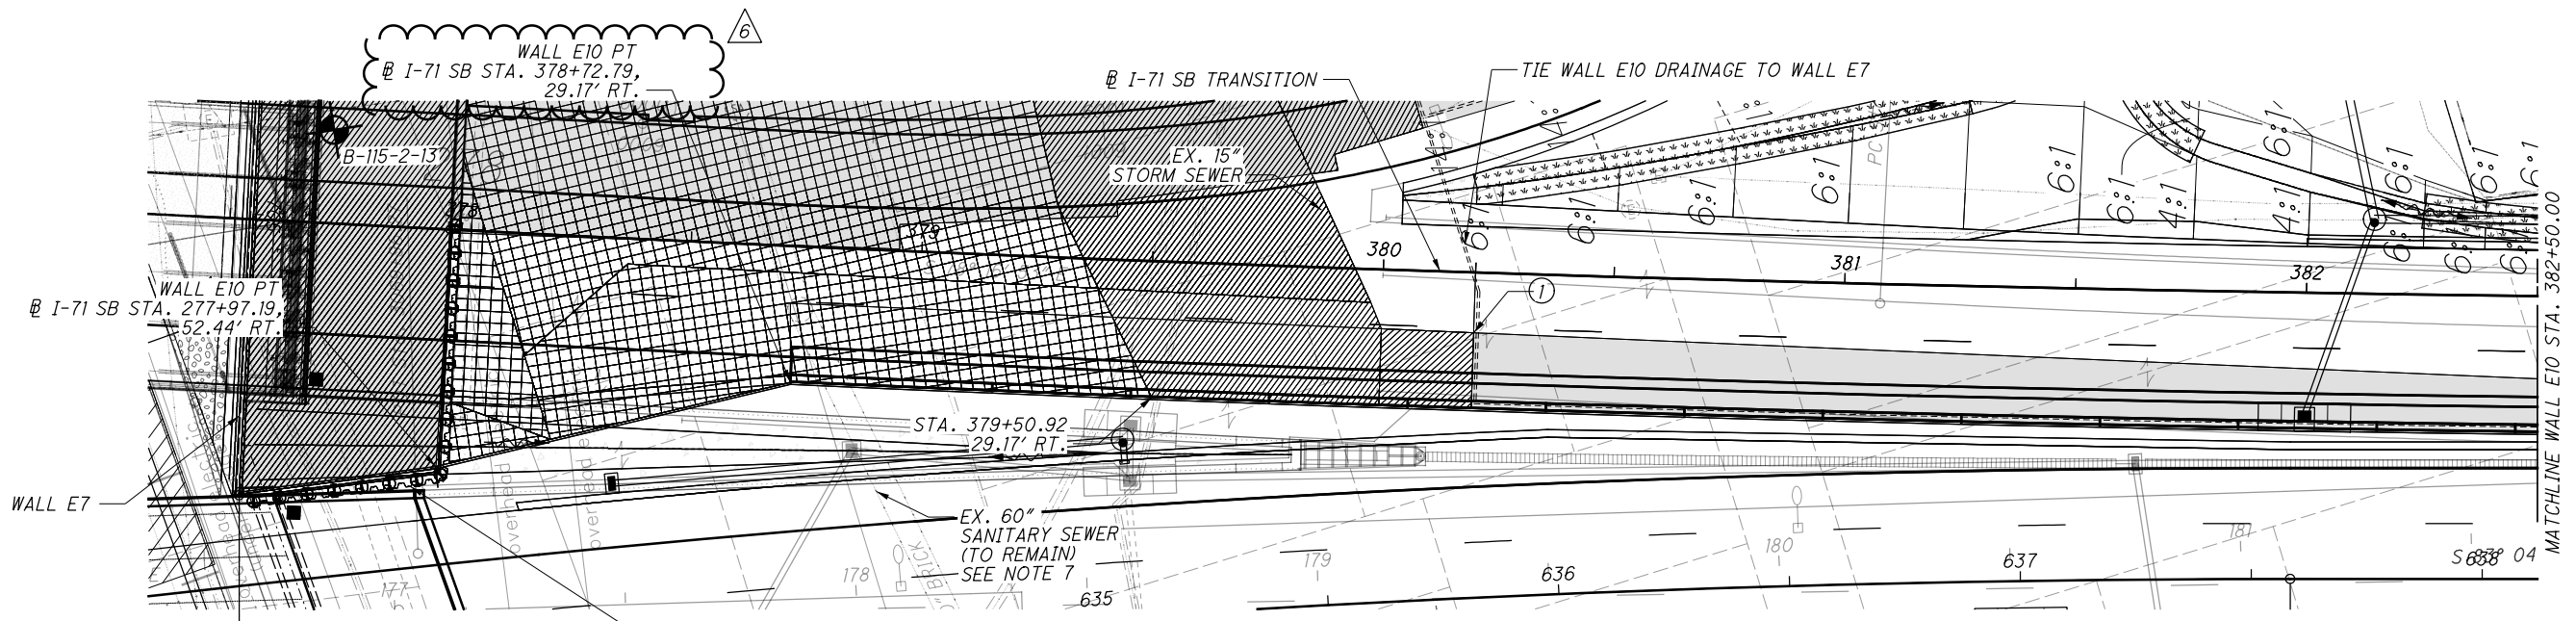

PLAN

STATION	OFFSET
① 380+20.00	13.05' RT.


NOTES:

1. LEVELLING PAD ELEVATIONS ARE GIVEN AT BOTTOM OF PAD.
2. ALL EXISTING UTILITIES TO BE REMOVED/RELOCATED UNLESS NOTED OTHERWISE.
3. STATIONING IS ALONG I-71 SB TRANSITION.
4. STATIONS AND OFFSETS ARE GIVEN AT BACK FACE OF THE WALL.
5. TOP OF WALL ELEVATIONS ARE GIVEN AT TOP OF MSE WALL PANEL.
6. SOIL REINFORCEMENT SHALL BE CONSTRUCTED SO AS TO AVOID INTERFERENCE WITH EXISTING AND PROPOSED DRAINAGE STRUCTURES.
7. LEVELLING PAD SHALL BE CONSTRUCTED SO AS TO AVOID INTERFERENCE WITH EXISTING UTILITIES.

LEGEND:

- - - 6" DIA PERF CPP
- ⊙ - PROJECT BORING LOCATION
- ⊕ - HISTORIC BORING LOCATION
- - SETTLEMENT PLATFORM
- [Hatched Box] = LIMITS OF CELLULAR CONCRETE FILL
- [Grid Box] = LIMITS OF GEOFOAM BACKFILL
- [Shaded Box] = PLAN BOUNDARY FOR ITEMS INCLUDED WITH MSE WALL E10 FOR PAYMENT



0 10 20 40
HORIZONTAL SCALE IN FEET

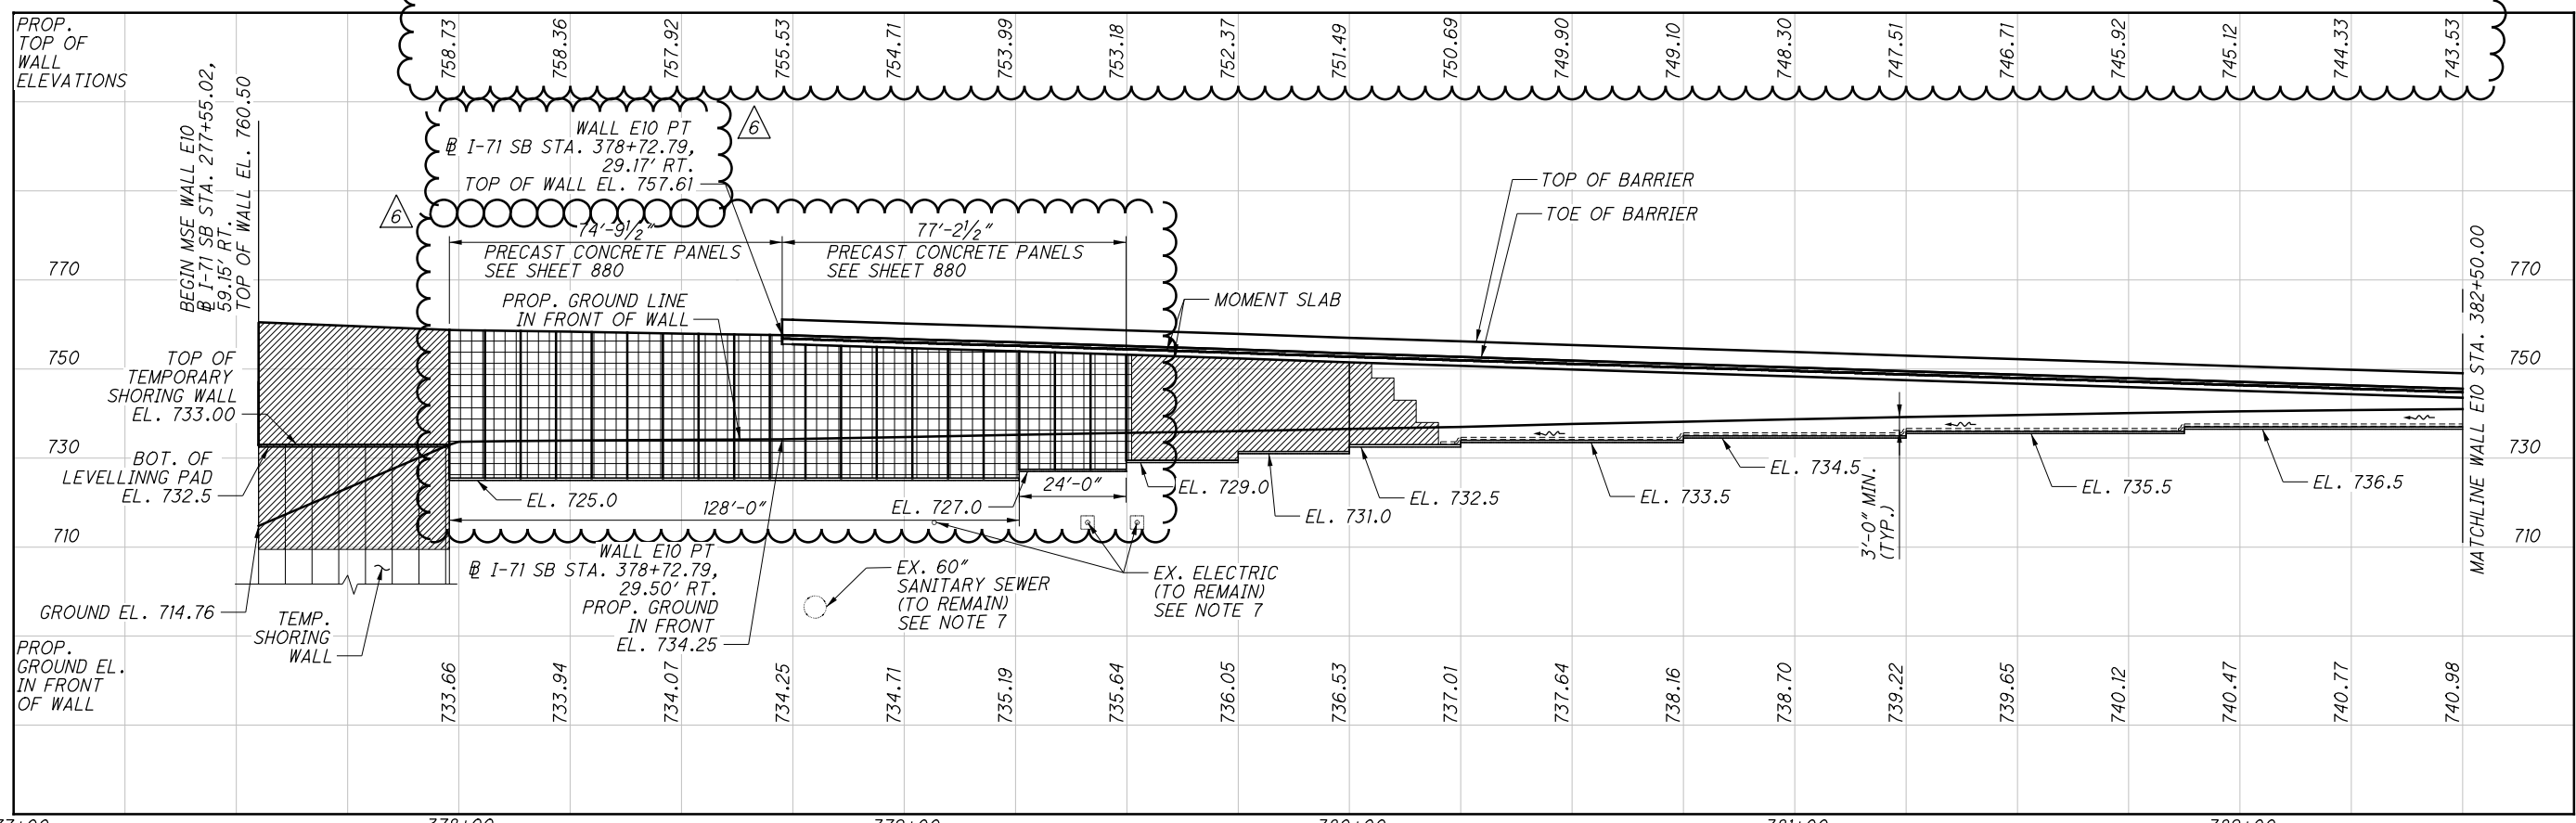

ELEVATION ALONG FACE OF WALL

NO.	DESCRIPTION	REV. BY	DATE
6	MODIFIED PRECAST PANEL DETAIL	MMS	12/2/21
6	UPDATED WALL STATION OFFSETS	MMS	12/2/21
8	UPDATED TOP OF WALL ELEVATIONS	MMS	12/6/21

G:\projects\2013\W-13-072_FRA-70-13-10_6A\89464_structures\wall_OE10\sheets\105588_OE10WP002.dgn 12/7/2021 2:16:16 PM meets

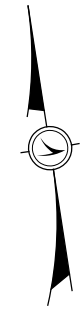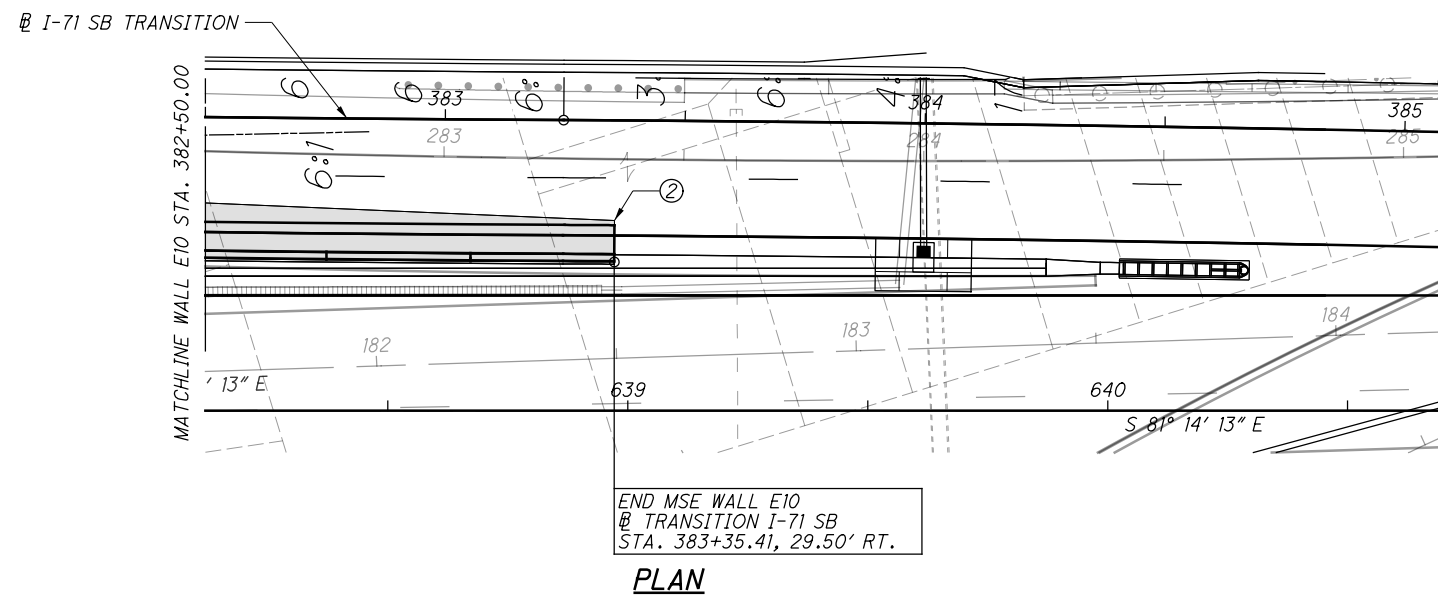

	STATION	OFFSET
②	383+35.41	20.87' RT.

NOTES:


1. ALL EXISTING UTILITIES TO BE REMOVED/RELOCATED UNLESS NOTED OTHERWISE.
2. STATIONING IS ALONG @ I-71 SB TRANSITION.
3. STATIONS AND OFFSETS ARE GIVEN AT TOP OF THE WALL.

LEGEND:

- - - - - 6" DIA PERF CPP
- PROJECT BORING LOCATION
- SETTLEMENT PLATFORM
- HISTORIC BORING LOCATION

= PLAN BOUNDARY FOR ITEMS INCLUDED WITH MSE WALL E10 FOR PAYMENT

HORIZONTAL SCALE IN FEET

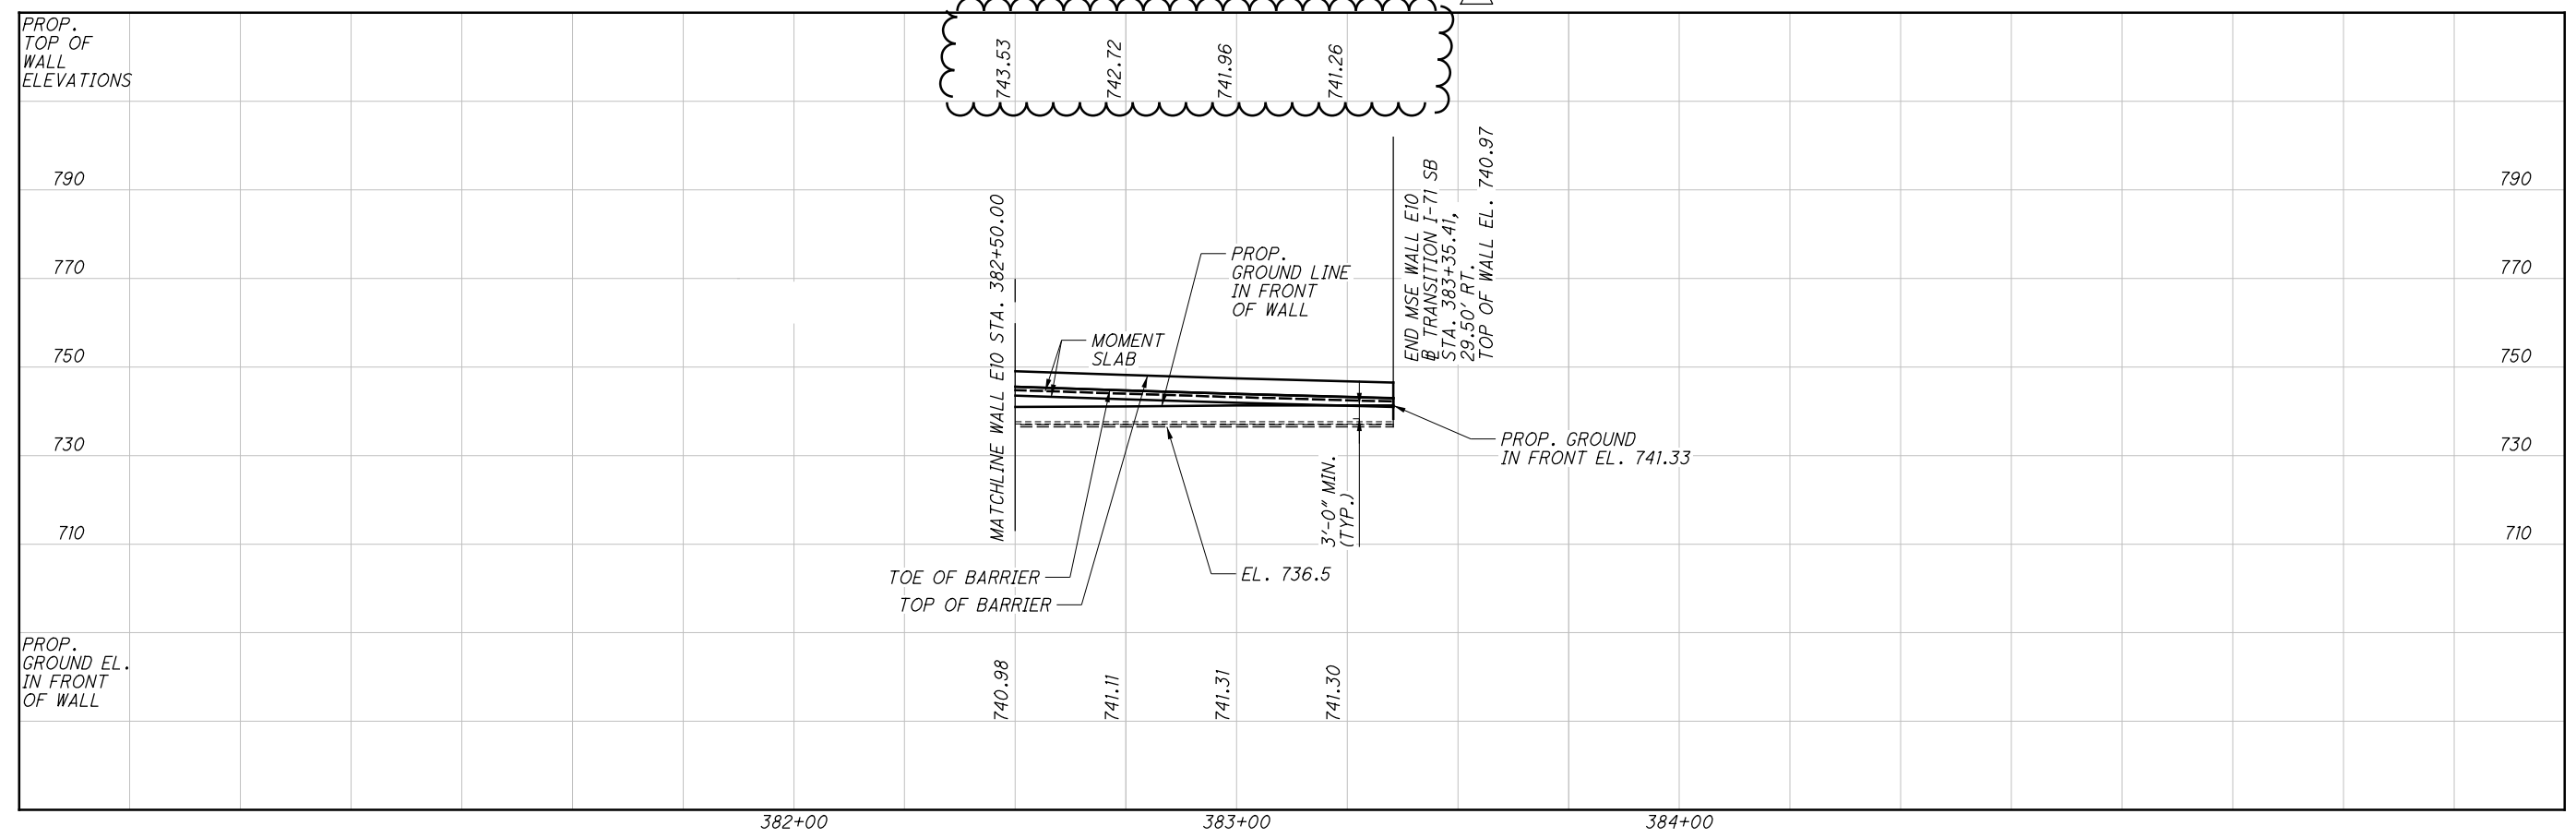

ELEVATION ALONG FACE OF WALL

NO.	DESCRIPTION	REV. BY	DATE
8	UPDATED TOP OF WALL ELEVATIONS	MMS	12/6/21

RESOURCE INTERNATIONAL INC.
6350 PRESIDENTIAL GATEWAY
COLUMBUS, OHIO 43231
(614) 823-4949

Rii

DESIGNED	DRAWN	REVIEWED	DATE
MMS	MMS	NCK	6/23/2021
CHECKED	REVISED	STRUCTURE FILE NUMBER	
JGM			

PLAN AND ELEVATION 2 OF 2


RETAINING WALL E10 (MAINLINE I-71 SB, I-70WB & SHORT ST.)
I-70/I-71 WEST INTERCHANGE PROJECT

FRA-71-14.36
PID No. 105588

3 / 10


876
1228

G:\projects\2013\W-13-072_FRA-70-13-10_6A\89464_structures_wall_OE10\sheets\105588_OE10WD007.dgn 12/7/2021 2:16:18 PM meets

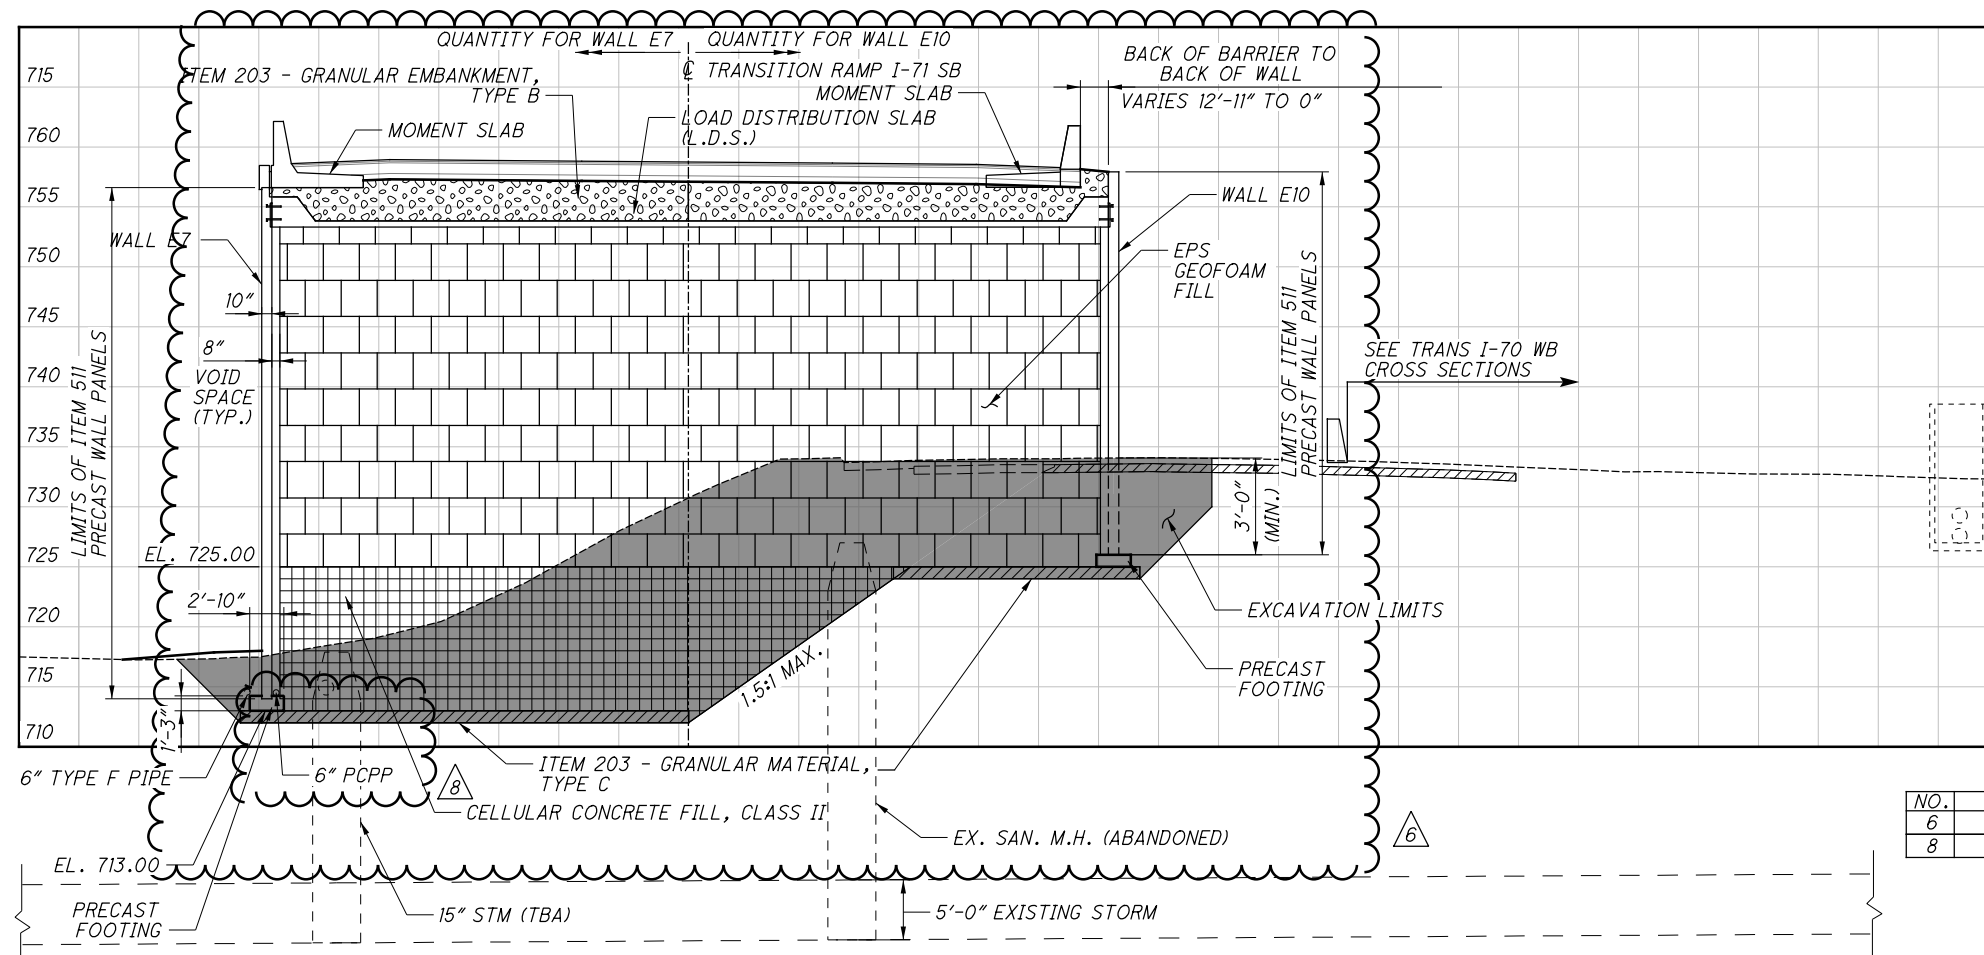

NO.	DESCRIPTION	REV. BY	DATE
6	UPDATED SECTION	MMS	12/2/21
8	ADDED 6" PCPP	MMS	12/7/21

**B RAMP I-71 SB TRANSITION, WALL E10 STA. 277+97.84 TO STA. 379+50
TYPICAL SECTION**

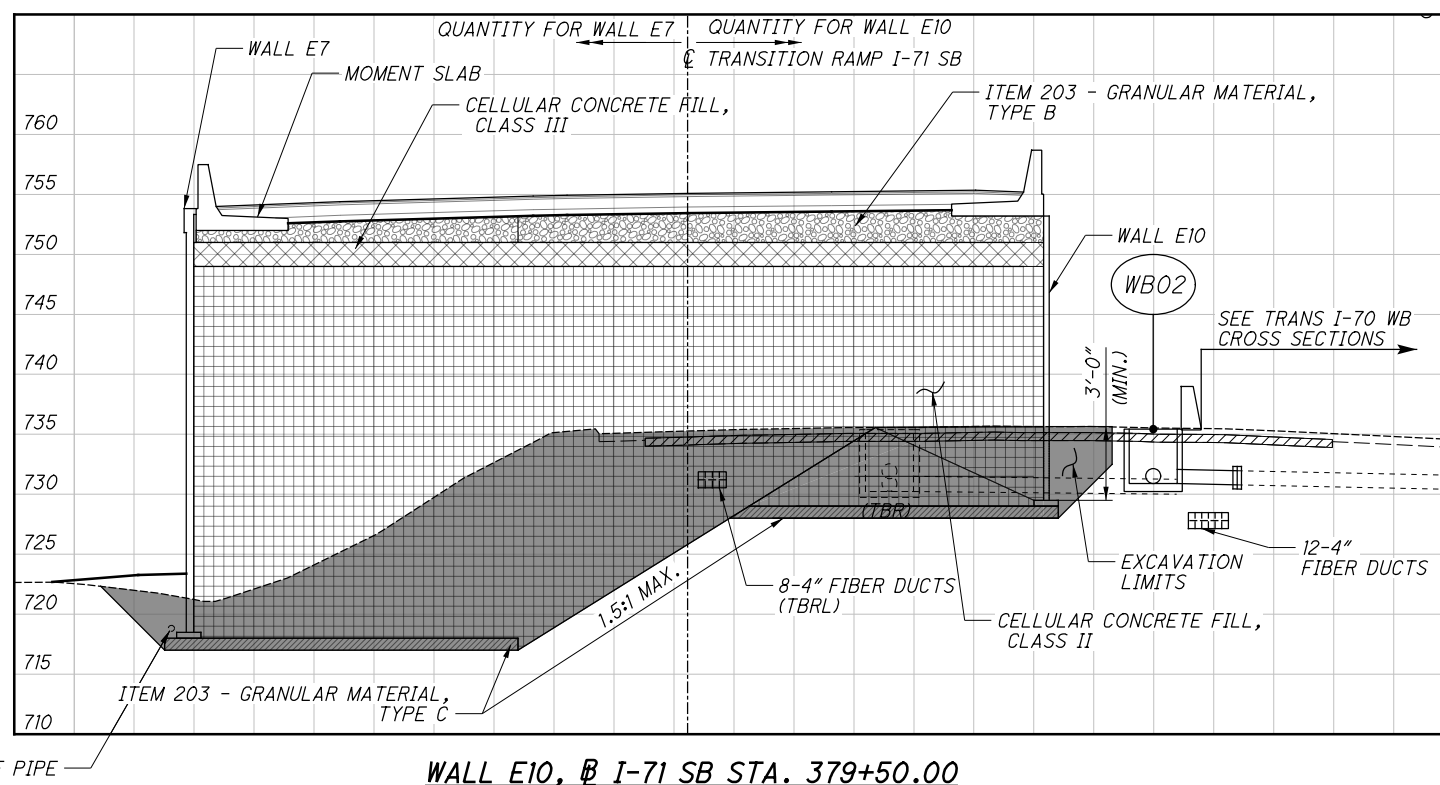

WALL E10, B I-71 SB STA. 379+50.00

NOTES:


- SEE BRIDGE PLANS FOR ADDITIONAL ABUTMENT AND WINGWALL DETAILS.
- SOIL REINFORCEMENT SHALL BE CONSTRUCTED SO AS TO AVOID INTERFERENCE WITH BRIDGE PILING.
- FOR ABBREVIATION LEGEND, SEE SHEET 838

LEGEND:

* - LIMITS OF ITEM 512 - SEALING OF CONCRETE SURFACES, AS PER PLAN (PERMANENT GRAFFITI PROTECTION) SEAL ALL EXPOSED SURFACES EXTENDING 10'-0" VERTICAL FROM GROUND LINE.


- CELLULAR CONCRETE FILL, CLASS II
- CELLULAR CONCRETE FILL, CLASS III
- GRANULAR MATERIAL, TYPE B
- GRANULAR MATERIAL, TYPE C
- EXCAVATION LIMITS
- EPS GEOFOAM FILL

G:\projects\2013\W-13-072_FRA-70-13.10_6A\89464_structures\wall_OE10\sheets\105588_OE10WD005.dgn 12/7/2021 2:30:00 PM meets



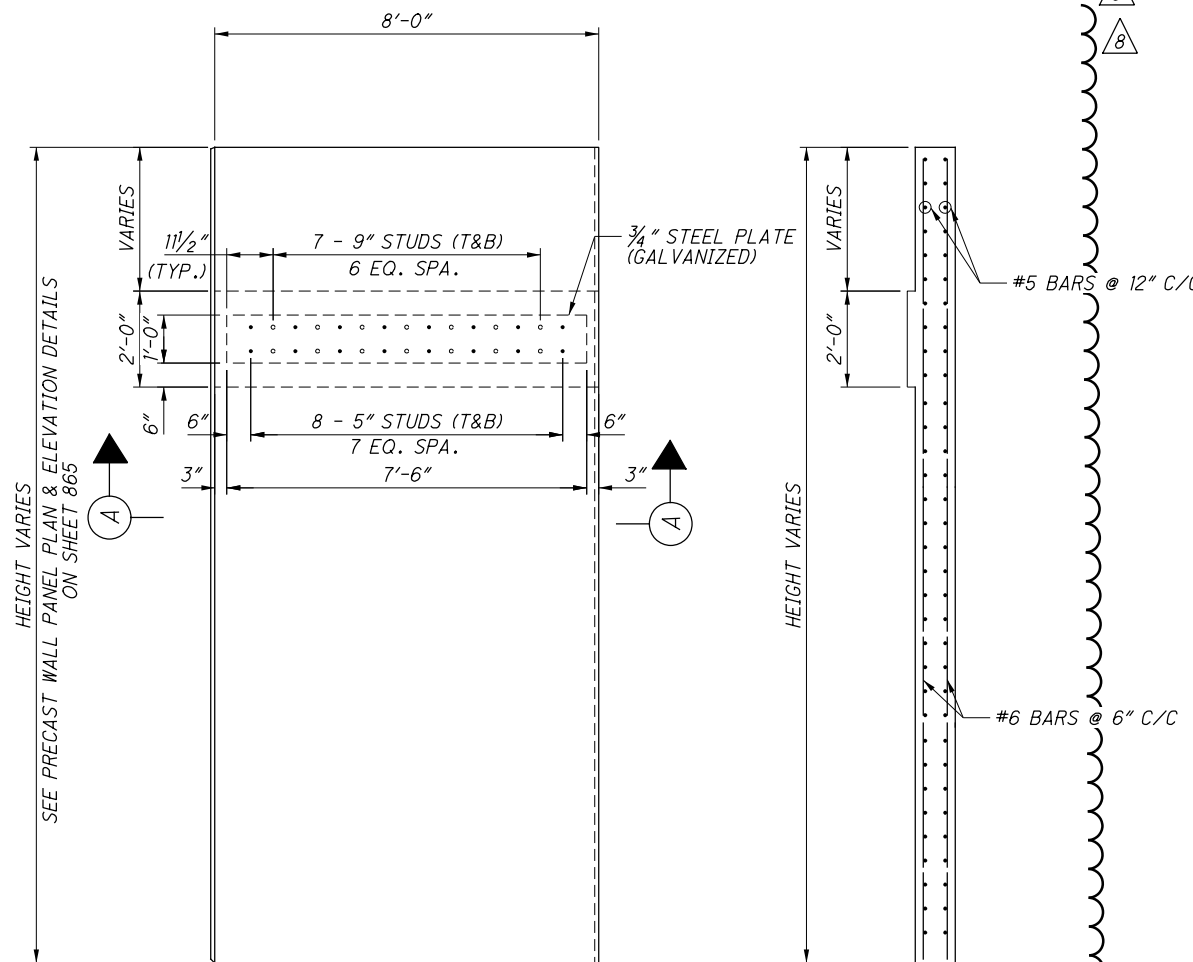


PRECAST CONCRETE PANELS*			
STA.	OFFSET	B/L	TOP OF WALL
BEGIN	277+97.84	50.79' RT.	I-71 SB 758.75
END	379+50.92	29.17' RT.	I-71 SB 753.19

* - ALL STATIONS, OFFSETS AND ELEVATIONS ARE TO THE BACK FACE OF THE PRECAST WALL.

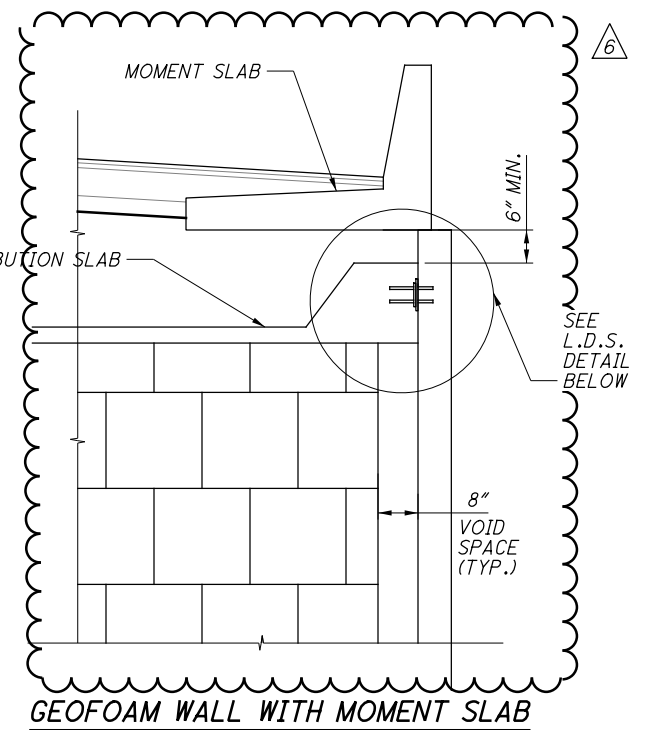

NO.	DESCRIPTION	REV. BY	DATE
6	MODIFIED PRECAST PANEL AND FOOTING DETAIL	MMS	12/2/21
6	UPDATED SECTION TO SHOW 8" VOID	MMS	12/2/21
6	REMOVED TIE STRIP DETAIL	MMS	12/2/21
6	ADDED WALL BEGIN AND END STATION	MMS	12/3/21
8	UPDATED TOP OF WALL ELEVATION	MMS	12/6/21
8	UPDATED PRECAST PANEL DETAILS	MMS	12/7/21
8	UPDATED L.D.S DETAIL	MMS	12/7/21

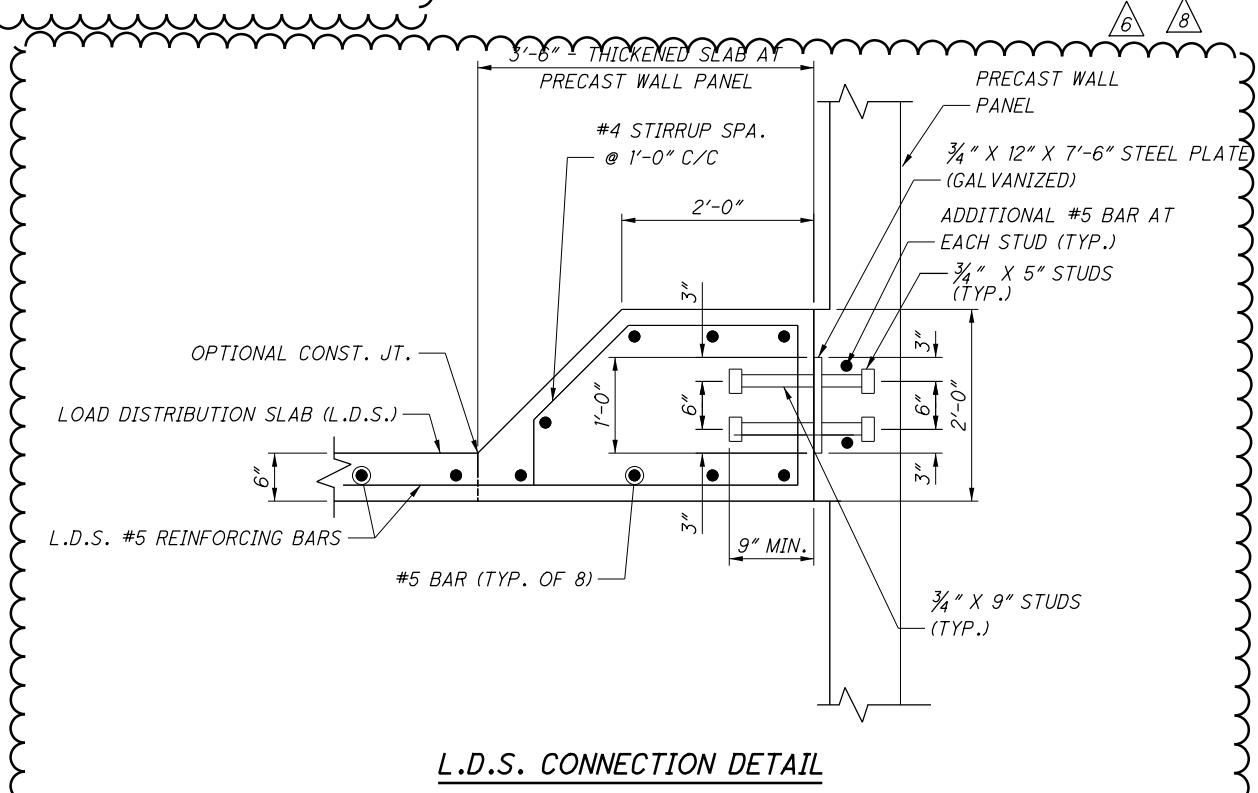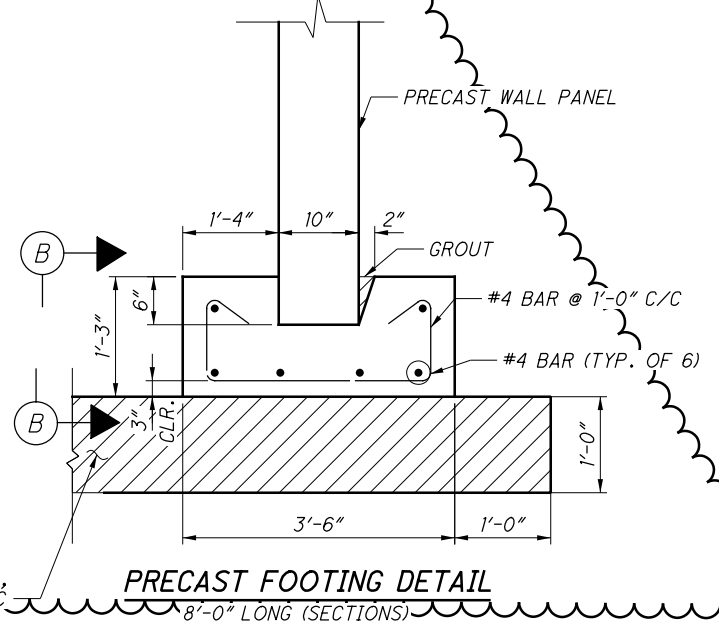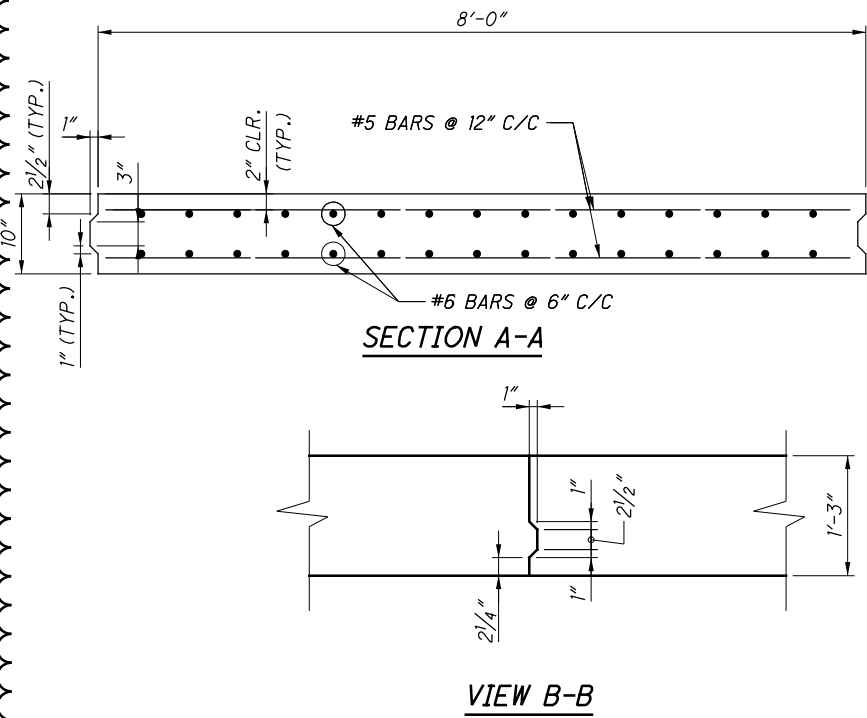

PARTICIPATION		ESTIMATED QUANTITIES						
	09/NHS/BR	ITEM	ITEM EXT.	TOTAL	UNIT	DESCRIPTION	SHEET REF.	
4		202	11203		LUMP	PORTIONS OF STRUCTURE REMOVED, OVER 20 FOOT SPAN, AS PER PLAN	2/12	
		705	23501	705	SY	WEARING COURSE REMOVED, AS PER PLAN	2/12	
		157	22900	157	SY	APPROACH SLAB REMOVED		
		3	98100	3	EACH	REMOVAL MISC.: PILE REMOVED, EXISTING STRUCTURE		
		8	407	20000	8	GAL	NON-TRACKING TACK COAT	
		5	441	10000	5	CY	ASPHALT CONCRETE SURFACE COURSE, TYPE 1, (446), PG64-22	
		503	11100		LUMP	COFFERDAMS AND EXCAVATION BRACING		
2		11,409	509	25000	11,409	LB	REINFORCING STEEL	
		372	510	10000	372	EACH	DOWEL HOLES WITH NONSHRINK, NONMETALLIC GROUT	
		48	511	21521	48	CY	CLASS QC2 CONCRETE, SUPERSTRUCTURE, AS PER PLAN	2/12
		117	512	33010	117	SY	TYPE 3 WATERPROOFING	2/12
8		987	513	10200	987	LB	STRUCTURAL STEEL MEMBERS, LEVEL UF	
		1,005	513	10240	1,005	LB	STRUCTURAL STEEL MEMBERS, LEVEL 2	
		4	518	12200	4	EACH	SCUPPERS, INCLUDING SUPPORTS	
		32	519	12510	32	SY	SPECIAL - PATCHING CONCRETE BRIDGE DECK - TYPE A	
		4	846	00110	4	CF	POLYMER MODIFIED ASPHALT EXPANSION JOINT SYSTEM	10/12

NO.	DESCRIPTION	REV. BY	DATE
2	DOWEL PAY ITEM INCLUDED	DEA	11-09-2021
4	PARTICIPATION CODE	DEA	11-23-2021
8	QUANTITY REVISION	DEA	12-7-2021

DESIGN AGENCY
ms consultants, inc.
2221 Schrock Road
Columbus, Ohio 43229

DESIGNED
DEA

CHECKED
ELP

DRAWN
CDH

REVISED

REVIEWED
GLG

DATE
20-APR

STRUCTURE FILE NUMBER
2504537

ESTIMATED QUANTITIES
BRIDGE NO. FRA-70-1373L
I-70 OVER SHORT STREET

FRA-71-14.36
PID No. 105588

3 / 12


912
1228

ms consultants, inc.



ITEM 503 - UNCLASSIFIED EXCAVATION, AS PER PLAN

THE BACKFILL MATERIAL SHALL BE PLACED AND COMPACTED IN 6" MAXIMUM LIFTS. THE LIMITS OF UNCLASSIFIED EXCAVATION ARE AS FOLLOWS:

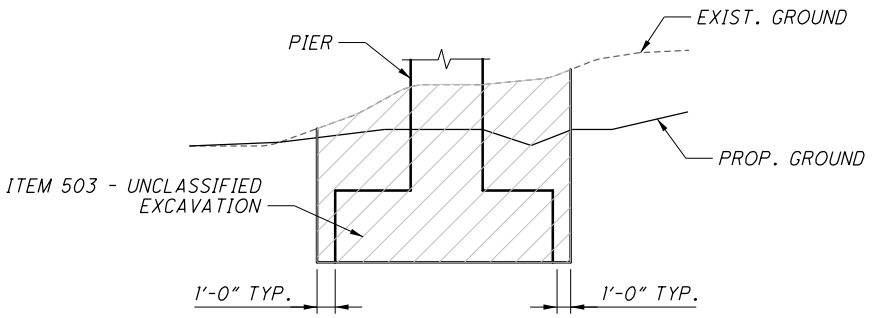

TYPICAL PIER

ITEM 503 - COFFERDAMS AND EXCAVATION BRACING, AS PER PLAN

THE DESIGN SHOWN ON THE PLANS FOR TEMPORARY SUPPORT OF EXCAVATION IS ONE REPRESENTATIVE DESIGN THAT MAY BE USED TO CONSTRUCT THE PROJECT. THE CONTRACTOR MAY CONSTRUCT THE DESIGN SHOWN ON THE PLANS OR PREPARE AN ALTERNATE DESIGN TO SUPPORT THE SIDES OF EXCAVATIONS. IF CONSTRUCTING AN ALTERNATE DESIGN FOR TEMPORARY SUPPORT OF EXCAVATION, PREPARE AND PROVIDE PLANS IN ACCORDANCE WITH CMS 501.05. THE DEPARTMENT WILL PAY FOR TEMPORARY SUPPORT OF EXCAVATION AT THE CONTRACT LUMP SUM PRICE FOR COFFERDAMS AND EXCAVATION BRACING. NO ADDITIONAL PAYMENT WILL BE MADE FOR PROVIDING AN ALTERNATE DESIGN.

ITEM 511 - CLASS QC2 CONCRETE WITH QC/QA, BRIDGE DECK (PARAPET), AS PER PLAN

PROVIDE LONG TERM TEMPORARY BRIDGE BARRIER IN ACCORDANCE WITH THE PLAN DETAILS. PAYMENT IS BASED ON VOLUME THE OF BARRIER CONCRETE. ALL OTHER REQUIRED MATERIALS SHALL BE INCIDENTAL TO THE COST OF ITEM 511 - CLASS QC2 CONCRETE WITH QC/QA, BRIDGE DECK (PARAPET), AS PER PLAN.

ITEM 512 - SEALING OF CONCRETE SURFACES, AS PER PLAN, (PERMANENT GRAFFITI PROTECTION)

APPLY A PERMANENT GRAFFITI COATING QUALIFIED ACCORDING TO SUPPLEMENT 1083 THAT IS COMPATIBLE WITH THE CONCRETE SEALER OVER WHICH IT IS APPLIED. APPLY THE GRAFFITI COATING IN ACCORDANCE WITH MANUFACTURER'S PRINTED INSTRUCTIONS.

ITEM 509 - EPOXY COATED REINFORCING STEEL, AS PER PLAN

GLASS FIBER REINFORCED POLYMER (GFRP) BARS SHALL BE USED FOR DIAGONAL REINFORCEMENT AS SHOWN IN THE PLANS. PAYMENT FOR GFRP BARS SHALL BE INCIDENTAL TO THE COST OF ITEM 509 - EPOXY COATED REINFORCING STEEL, AS PER PLAN.

ITEM 513 - STRUCTURAL STEEL MEMBERS, HYBRID GIRDER, LEVEL SIX (6) FABRICATION, AS PER PLAN

A. DESCRIPTION

1. THIS WORK CONSIST OF FURNISHING ALL NECESSARY LABOR, MATERIALS AND EQUIPMENT TO FURNISH AND ERECT STRUCTURAL STEEL MEMBERS, DESIGNED AS A HYBRID/ MIX OF STEEL MATERIALS CONSISTING OF: ASTM A709, HIGH PERFORMANCE GRADE HPSTOW IN COMBINATION WITH GRADE 50W STEEL.
2. THIS WORK SHALL BE PERFORMED PER ITEM 513 STRUCTURAL STEEL MEMBER, LEVEL SIX(6) EXCEPT AS MODIFIED BY THE APRIL, 2011 3RD EDITION OF THE GUIDE FOR HIGHWAY BRIDGE FABRICATION WITH HPSTOW STEEL, A SUPPLEMENT TO ANSI/AASHTO AWS D1.5" AND AS MODIFIED BY THESE PLAN NOTES.

B. MATERIALS

1. STEEL FOR GIRDER WEBS AND FLANGES SHALL BE A COMBINATION OF ASTM A709 GRADE HPSTOW MANUFACTURED BY THE THERMO-MECHANICAL CONTROLLED PROCESSING (TMCP) OR QUENCHED AND TEMPERED HEAT TREATMENT PROCESSING ALONG WITH ASTM A588/709 GRADE 50W. ALL OTHER STEEL SHALL BE ASTM A709 GRADE 50W.
2. STEEL DESIGNATED CVN SHALL BE IMPACT TESTED TO EXCEED THE TEST VALUES OF ASTM A709 TABLE S1.2 NON-FRACTURE CRITICAL IMPACT TEST REQUIREMENTS FOR ZONE 2, TEMPERATURE RANGE.

C. ADDITIONAL FABRICATION RESTRICTIONS / WARNINGS

1. APPLICATION OF HEAT FOR CURVING AND STRAIGHTENING APPLICATIONS, CAMBER AND SWEEP ADJUSTMENT, OR OTHER REASON HEATING IS LIMITED TO 1100° F/590° C MAXIMUM, AND MUST BE DONE BY PROCEDURES APPROVED BY THE DIRECTOR OR HIS AUTHORIZED REPRESENTATIVE.
2. THE MATCHING SUBMERGED ARC WELDING CONSUMABLES ESAB EN14 ELECTRODE IN COMBINATION WITH LINCOLN MIL800H, RECOMMENDED IN APPENDIX A OF THE AASHTO GUIDE FOR HIGHWAY BRIDGE FABRICATION WITH HPSTOW STEEL, HAS PRODUCED WELDMENT CONTAINING UNACCEPTABLE DISCONTINUITIES IN A SUBSTANTIAL NUMBER OF COMPLETE PENETRATION GROOVE WELDS IN ONE STRUCTURE, BASED ON THE PARAMETERS USED AND EXPERIENCE OF ONE FABRICATOR. EXTREME CAUTION SHOULD BE EXERCISED WHEN USING THIS ELECTRODE/FLUX COMBINATION.
3. CONSIDERATION WILL BE GIVEN TO OTHER WELDING PROCESSES IF A WRITTEN REQUEST IS SUBMITTED TO THE OFFICE OF MATERIALS MANAGEMENT IN ACCORDANCE WITH CMS 108.05. OTHER WELDING PROCESSES MUST BE QUALIFIED AND TESTED AS REQUIRED BY THE REFERENCED SPECIFICATIONS AND THESE NOTES.
4. IN ADDITION TO THE REQUIREMENTS OF ANSI/AASHTO/AWS D1.5 SECTION 5.17. ALL PROCEDURE QUALIFICATION TESTS MUST BE ULTRASONICALLY TESTED IN CONFORMANCE WITH THE REQUIREMENTS OF AWS D1.5, SECTION 6, PART C. EVALUATION MUST BE IN ACCORDANCE WITH AWS D1.5, TABLE 6.3, ULTRASONIC ACCEPTANCE/REJECTION CRITERIA, TENSILE STRESS. INDICATIONS FOUND AT THE INTERFACE OF THE BACKING BAR MAY BE DISREGARDED, REGARDLESS OF THE DEFECT RATING.
5. WHENEVER MAGNETIC PARTICLE TESTING IS DONE, ONLY THE YOKE TECHNIQUE WILL BE ALLOWED, AS DESCRIBED IN SECTION 6.7.6.2 OF THE ANSI/AASHTO/AWS D1.5 BRIDGE WELDING CODE, MODIFIED TO TEST USING ALTERNATING CURRENT ONLY. THE PROD TECHNIQUE WILL NOT BE ALLOWED.

D. BASIS OF PAYMENT

PAYMENT FOR THE ABOVE COMPLETED AND ACCEPTED QUANTITIES WILL BE MADE AT THE CONTRACT BID PRICE FOR:

ITEM	EXT	UNITS	DESCRIPTION
513	10401	POUND	STRUCTURAL STEEL MEMBERS, HYBRID GIRDER, LEVEL SIX FABRICATION, AS PER PLAN

ITEM 530 - SPECIAL STRUCTURE, MISC.: SOLDIER PILE RETAINING WALL

FURNISH AND INSTALL SOLDIER PILE RETAINING WALL AS INDICATED. ITEM INCLUDES PRE BORED HOLES, CONCRETE BACKFILL OR PREBORED HOLES, STEEL SOLDIER PILES, TIMBER LAGGING, BLOCKING, EXCAVATION FOR THE BOTTOM ROWS OF TIMBERS, AND ALL OTHER INCIDENTALS.

ITEM 607 - VANDAL PROTECTION FENCE, 6' STRAIGHT, COATED FABRIC, AS PER PLAN

ALL FENCE POSTS, RAILS, FABRIC, BASE PLATES, POST SLEEVES, TENSION BANDS, TRUSS RODS, FABRIC TIES, AND ALL OTHER VISIBLE PORTIONS OF FENCE NOT LISTED SHALL BE BLACK PVC COATED.

ASBESTOS NOTIFICATION

AN ASBESTOS SURVEY FOR THE BRIDGE STRUCTURE SCHEDULED FOR DEMOLITION WORK WAS CONDUCTED BY A LICENSED ASBESTOS HAZARD EVALUATION SPECIALIST. THE ASBESTOS INSPECTION REPORT DID NOT IDENTIFY THE PRESENCE OF ANY ASBESTOS CONTAINING MATERIALS ABOVE REGULATORY LIMITS. A COPY OF THE ASBESTOS INSPECTION REPORT FOR THE STRUCTURE IS INCLUDED IN THE PLAN PACKAGE FOR THIS PROJECT.

ELECTRONIC SUBMISSION:

SUBMIT A COMPLETED ELECTRONIC NOTIFICATION OF DEMOLITION AND RENOVATION FORM (NDRF), APPLICABLE FEES, AND THE ASBESTOS INSPECTION REPORT TO THE OEPA AT LEAST 10 DAYS PRIOR TO ANY DEMOLITION ACTIVITY, RENOVATION ACTIVITY, OR BOTH. SUBMIT THE NDRF AND PAYMENT ALONG WITH THE ASBESTOS INSPECTION REPORT USING THE OEPA EBUSINESS CENTER. SUBMIT ONE ELECTRONIC PDF COPY AND ONE HARD COPY OF THE NDRF TO THE ENGINEER. THE ENGINEER WILL PROVIDE ONE COPY TO THE DISTRICT ENVIRONMENTAL STAFF.

HARD COPY SUBMISSION:

THE CONTRACTOR MAY SUBMIT A HARD COPY OF THE COMPLETED NDRF AND PAYMENT ALONG WITH THE ASBESTOS INSPECTION REPORT. FOLLOW THE MAILING INSTRUCTIONS ON THE NDRF. CHECK WITH LOCAL HEALTH DEPARTMENT, COLUMBUS PUBLIC HEALTH, 240 PARSONS AVE. COLUMBUS, OH 43215, 614-645-7005 TO DETERMINE IF THEY REQUIRE A HARD COPY SUBMITTAL.

SUBMIT THE COMPLETED NDRF TO OEPA AT LEAST 10 DAYS PRIOR TO DEMOLITION ACTIVITY, RENOVATION ACTIVITY, OR BOTH. RETAIN TWO HARD COPIES OF THE NDRF AND SUBMIT ONE COPY TO THE ENGINEER AND EMAIL ONE COPY TO THE ODOT DISTRICT ENVIRONMENTAL COORDINATOR AT: MARCI.LININGER@DOT.OHIO.GOV

BASIS OF PAYMENT

THE CONTRACTOR SHALL FURNISH ALL FEES, LABOR, AND MATERIALS NECESSARY TO COMPLETE AND SUBMIT THE OEPA NOTIFICATION FORM. PAYMENT FOR THIS WORK SHALL BE INCLUDED IN ITEM 202 1/2 PORTIONS OF STRUCTURE REMOVED, AS PER PLAN.



NO.	DESCRIPTION	REV. BY	DATE
3	GFRP PAYMENT MOVED TO ITEM 509	DEA	11-16-2021
8	REVISE ASBESTOS NOTE	DEA	12-7-2021