

**US Army Corps
of Engineers**

Huntington District

As Constructed Plans

**Phase IID – LOCAL PROTECTION PROJECT
WEST COLUMBUS, OHIO**

FEBRUARY 2003

CC-13249

REDUCED 50%

I N D E X

SHEET NO.	DRAWING NO.	TITLE	SHEET NO.	DRAWING NO.	TITLE	SHEET NO.	DRAWING NO.	TITLE	SHEET NO.	DRAWING NO.	TITLE
		GENERAL	49	15/6	HEADWALL DETAILS	99	20.1/5	CONRAIL EAST SHORING PLAN	144	20.2/34	GRADING PLAN (2 OF 2)
1	0/1	INDEX (1 OF 2)	50	15/7	HEADWALL REINFORCING STEEL	100	20.1/6	CONRAIL EAST SHORING DETAILS	145	20.2/35	LAYOUT PLAN (1 OF 3)
2	0/2	INDEX (2 OF 2)				101	20.1/7	FLOODWALL TEXTURE DETAILS	146	20.2/36	LAYOUT PLAN (2 OF 3)
3	0/3	LEGEND			WATER	102	20.1/8	FLOODWALL PLAN STA. 155+00 TO 159+24	147	20.2/37	LAYOUT PLAN (3 OF 3)
4	0/4	NOTES	51	15/10	WATER LINE RELOCATION (1 OF 3)	103	20.1/9	FLOODWALL PLAN STA. 159+24 TO 162+00	148	20.2/38	MATERIALS PLAN (1 OF 3)
5	0/5	PROJECT MAPS	52	15/11	WATER LINE RELOCATION (2 OF 3)	104	20.1/10	FLOODWALL PLAN STA. 162+00 TO 164+40	149	20.2/39	MATERIALS PLAN (2 OF 3)
6	0/6	SITE PLAN	53	15/12	WATER LINE RELOCATION (3 OF 3)	105	20.1/11	I-WALL PLAN STA. 189+60 TO 194+00	150	20.2/40	MATERIALS PLAN (3 OF 3)
7	0/7	SITE PLAN - BASE BID				106	20.1/12	I-WALL PLAN STA. 204+60 TO 210+75	151	20.2/41	PAVEMENT JOINTING PLAN (1 OF 3)
8	0/8	SITE PLAN - OPTION 1			GENERAL PROTECTION	107	20.1/13	I-WALL PLAN STA. 210+75 TO 213+50	152	20.2/42	PAVEMENT JOINTING PLAN (2 OF 3)
9	0/9	SITE PLAN - OPTION 2	54	16/1	PLAN AND PROFILE STA. 151+26.73 TO 156+00	108	20.1/14	MISCELLANEOUS DETAILS	153	20.2/43	PAVEMENT JOINTING PLAN (3 OF 3)
10	0/10	SITE PLAN - OPTION 3	55	16/2	PLAN AND PROFILE STA. 156+00 TO 161+00				154	20.2/44	FLOODWALL ELEVATION (1 OF 3)
			56	16/3	PLAN AND PROFILE STA. 161+00 TO 166+00			CONRAIL EAST RAILROAD CLOSURE	155	20.2/45	FLOODWALL ELEVATION (2 OF 3)
		CONTRACTOR WORK LIMITS	57	16/4	PLAN AND PROFILE STA. 166+00 TO 171+00	109	20.2/1	PLAN AND PROFILE	156	20.2/46	FLOODWALL ELEVATION (3 OF 3)
11	6/1	MONUMENT PLAN (1 OF 4)	58	16/5	PLAN AND PROFILE STA. 171+00 TO 176+00	110	20.2/2	CONRAIL EAST RR CLOSURE DETAILS	157	20.2/47	TRELLIS PLAN
12	6/2	MONUMENT PLAN (2 OF 4)	59	16/6	PLAN AND PROFILE STA. 176+00 TO 181+00	111	20.2/3	CONRAIL EAST RR SHEETPILE CUTOFF WALL	158	20.2/48	TRELLIS DETAILS (1 OF 3)
13	6/3	MONUMENT PLAN (3 OF 4)	60	16/7	PLAN AND PROFILE STA. 181+00 TO 186+00				159	20.2/49	TRELLIS DETAILS (2 OF 3)
14	6/4	MONUMENT PLAN (4 OF 4)	61	16/8	PLAN AND PROFILE STA. 186+00 TO 191+00			TOWN STREET AREA AND CLOSURE	160	20.2/50	TRELLIS DETAILS (3 OF 3)
15	6/5	CWL MONUMENT TABLES	62	16/9	PLAN AND PROFILE STA. 191+00 TO 196+00	112	20.2/4	TOWN STREET SANDBAG CLOSURE	161	20.2/51	SITE DETAILS (1 OF 4)
			63	16/10	PLAN AND PROFILE STA. 196+00 TO 201+00	113	20.2/5	TOWN STREET WALKWAY ACCESS PLAN AND PROFILE	162	20.2/52	SITE DETAILS (2 OF 4)
		RIGHT OF WAY	64	16/11	PLAN AND PROFILE STA. 201+00 TO 206+00				163	20.2/53	SITE DETAILS (3 OF 4)
16	6/6	MONUMENT PLAN (1 OF 4)	65	16/12	PLAN AND PROFILE STA. 206+00 TO 211+00			WASHINGTON BOULEVARD CLOSURE	164	20.2/54	SITE DETAILS (4 OF 4)
17	6/7	MONUMENT PLAN (2 OF 4)	66	16/13	PLAN AND PROFILE STA. 211+00 TO 215+82.37	114	20.2/6	PLAN AND PROFILE	165	20.2/55	RAILING DETAILS
18	6/8	MONUMENT PLAN (3 OF 4)	-	16/14	(NOT USED)				166	20.2/56	RETAINING WALL PLAN
19	6/9	MONUMENT PLAN (4 OF 4)	67	16/15	CROSS SECTIONS 151+26.73 TO 153+00			RICH STREET GATE CLOSURE	167	20.2/57	RETAINING WALL NO.1 PLAN (1 OF 2)
20	6/10	R/W MONUMENT TABLES	68	16/16	CROSS SECTIONS 153+50 TO 156+00	115	20.2/7	PLAN AND PROFILE	168	20.2/58	RETAINING WALL NO.1 PLAN (2 OF 2)
			69	16/17	CROSS SECTIONS 156+50 TO 159+00	116	20.2/8	PLAN AND ELEVATION	169	20.2/59	RETAINING WALL NO.1 SECTIONS (1 OF 2)
		SURVEY	70	16/18	CROSS SECTIONS 159+50 TO 162+00	117	20.2/9	BUTTRESS MONOLITHS REINFORCEMENT	170	20.2/60	RETAINING WALL NO.1 SECTIONS (2 OF 2)
21	11/1	SURVEY REFERENCES	71	16/19	CROSS SECTIONS 162+50 TO 165+00	118	20.2/10	MISCELLANEOUS DETAILS	171	20.2/61	RETAINING WALL NOS.2 AND 3 ELEVATIONS
22	11/2	CENTERLINE OF PROTECTION (1 OF 6)	72	16/20	CROSS SECTIONS 165+50 TO 168+00	119	20.2/11	EMBEDDED SILL BEAM AND DETAILS	172	20.2/62	RETAINING WALL NO.2 SECTIONS
23	11/3	CENTERLINE OF PROTECTION (2 OF 6)	73	16/21	CROSS SECTIONS 168+50 TO 171+00	120	20.2/12	STOP LOGS AND POST DETAILS	173	20.2/63	RETAINING WALL NO.3 SECTIONS
24	11/4	CENTERLINE OF PROTECTION (3 OF 6)	74	16/22	CROSS SECTIONS 171+50 TO 174+00	121	20.2/13	MISCELLANEOUS METALS	174	20.2/64	MISCELLANEOUS STRUCTURAL DETAILS
25	11/5	CENTERLINE OF PROTECTION (4 OF 6)	75	16/23	CROSS SECTIONS 174+50 TO 177+00	122	20.2/14	EMBEDDED POCKET AND COVER	175	20.2/65	STAIRWAY PLAN
26	11/6	CENTERLINE OF PROTECTION (5 OF 6)	76	16/24	CROSS SECTIONS 177+50 TO 180+00	123	20.2/15	STOP LOG STORAGE BUILDING - SITE PLAN	176	20.2/66	STAIRWAY SECTIONS AND DETAILS
27	11/7	CENTERLINE OF PROTECTION (6 OF 6)	77	16/25	CROSS SECTIONS 180+50 TO 183+00	124	20.2/16	STOP LOG STORAGE BUILDING - PLAN AND ELEVATION	177	20.2/67	BROAD STREET PLAZA PLAN
28	11/8	CENTERLINE OF PROTECTION - HORZ. ALIGN. (1 OF 3)	78	16/26	CROSS SECTIONS 183+50 TO 186+00	125	20.2/16A	STOP LOG STORAGE BUILDING - DETAILS	178	20.2/68	BROAD STREET PLAZA SECTIONS
29	11/9	CENTERLINE OF PROTECTION - HORZ. ALIGN. (2 OF 3)	79	16/27	CROSS SECTIONS 186+50 TO 189+00	126	20.2/17	STOP LOG STORAGE BUILDING - ELECTRICAL	179	20.2/69	ELECTRICAL PLAN (1 OF 3)
30	11/10	CENTERLINE OF PROTECTION - HORZ. ALIGN. (3 OF 3)	80	16/28	CROSS SECTIONS 189+50 TO 192+00				180	20.2/70	ELECTRICAL PLAN (2 OF 3)
31	11/11	RECREATIONAL TRAIL ALIGNMENT	81	16/29	CROSS SECTIONS 192+50 TO 195+00			CONRAIL/CSX RAILROAD CLOSURE	181	20.2/71	ELECTRICAL PLAN (3 OF 3)
32	11/12	RECREATIONAL TRAIL ALIGNMENT DATA	82	16/30	CROSS SECTIONS 195+50 TO 198+00	127	20.2/18	PLAN AND PROFILE	182	20.2/72	ELECTRICAL DETAILS (1 OF 2)
			83	16/31	CROSS SECTIONS 198+50 TO 201+00	128	20.2/19	CONRAIL/CSX RR CLOSURE DETAILS			
		LANDSCAPING	84	16/32	CROSS SECTIONS 201+50 TO 204+00	129	20.2/20	CONRAIL/CSX RR SHEETPILE CUTOFF WALL			
33	12/1	VETERANS MEMORIAL PLANTING PLAN (1 OF 3)	85	16/33	CROSS SECTIONS 204+50 TO 207+00						
34	12/2	VETERANS MEMORIAL PLANTING PLAN (2 OF 3)	86	16/34	CROSS SECTIONS 207+50 TO 210+00			DODGE PARK			
35	12/3	VETERANS MEMORIAL PLANTING PLAN (3 OF 3)	87	16/35	CROSS SECTIONS 210+50 TO 213+00	130	20.2/21	DODGE PARK ACCESS RAMP PLAN AND DETAILS			
36	12/4	MISCELLANEOUS LANDSCAPING DETAILS	88	16/36	CROSS SECTIONS 213+50 TO 215+82.37	131	20.2/22	DODGE PARK DEMOLITION PLAN (1 OF 2)			
37	12/5	VETERANS MEMORIAL IRRIGATION PLAN (1 OF 2)				132	20.2/23	DODGE PARK DEMOLITION PLAN (2 OF 2)			
38	12/6	VETERANS MEMORIAL IRRIGATION PLAN (2 OF 3)			RECREATIONAL TRAIL (PARTIAL)	133	20.2/24	DODGE PARK SITE PLAN (1 OF 2)			
39	12/7	MISCELLANEOUS LANDSCAPING DETAILS (IRRIGATION)	89	16/50	PLAN AND PROFILE STA. 34+40 TO 39+00	134	20.2/25	DODGE PARK SITE PLAN (2 OF 2)			
40	12/8	DODGE PARK LANDSCAPING PLAN (1 OF 2)	90	16/51	PLAN AND PROFILE STA. 39+00 TO 41+50	135	20.2/26	DODGE PARK OVERLOOK PLANS (1 OF 2)			
41	12/9	DODGE PARK LANDSCAPING PLAN (2 OF 2)	91	16/52	CROSS SECTIONS 34+40 TO 36+50	136	20.2/27	DODGE PARK OVERLOOK PLANS (2 OF 2)			
42	12/10	MISCELLANEOUS LANDSCAPING DETAILS	92	16/53	CROSS SECTIONS 37+00 TO 39+50	137	20.2/28	DODGE PARK OVERLOOK SECTIONS AND DETAILS			
43	12/11	RICH STREET PARK LANDSCAPE PLAN	93	16/54	CROSS SECTIONS 40+00 TO 41+50	138	20.2/28A	RIVER GAGE MOUNTS			
			94	16/55	TYPICAL DETAILS						
		INTERIOR DRAINAGE						VETERANS MEMORIAL			
44	15/1	INTERIOR DRAINAGE VETERANS MEMORIAL			FLOODWALL	139	20.2/29	DEMOLITION PLAN (1 OF 3)	Prepared by:		
45	15/2	INTERIOR DRAINAGE RICH STREET	95	20.1/1	TYPICAL FLOODWALL AND I-WALL DETAILS	140	20.2/30	DEMOLITION PLAN (2 OF 3)	CHIEF, DESIGN BRANCH		
46	15/3	GATEWELL PLAN AND SECTIONS	96	20.1/2	TYPICAL I-WALL DETAILS	141	20.2/31	DEMOLITION PLAN (3 OF 3)	Recommended by:		
47	15/4	GATEWELL DETAILS	97	20.1/3	TYPICAL T-WALL DETAILS (1 OF 2)	142	20.2/32	SITE PLAN	CHIEF, ENGINEERING DIVISION		
48	15/5	GATEWELL REINFORCING STEEL	98	20.1/4	TYPICAL T-WALL DETAILS (2 OF 2)	143	20.2/33	GRADING PLAN (1 OF 2)	Approved by:		
									COL. C. E. DISTRICT ENGINEER		
									Date:		

Revisions			
Symbol	Descriptions	Date	Approved

BURGESS & NIPLE, LIMITED
COLUMBUS, OHIO

Designed by: **P.CONROY**

Drawn by: **T.MULLINS**

Checked by: **R.ROMAN**

Reviewed by:

Approved by:

U.S. ARMY ENGINEER DISTRICT
CORPS OF ENGINEERS
HUNTINGTON, WEST VIRGINIA

SCIO TO RIVER
COLUMBUS, OHIO
WEST COLUMBUS, L.P.P.
PHASE IID

GENERAL INDEX (1 OF 2)

Scale: **NONE**

Date: **MARCH 1998**

Drawing Code: **16-PWC-10-**

Sheet reference number: **01**

FILENAME: 00gdn01.dgn

PEN TABLE:

Sheet **1** of **2**

	DRAINAGE
	GUARDRAIL
	EXISTING SANITARY SEWER
	EXISTING GAS LINE
	EXISTING WATER LINE
	EXISTING SLUDGE LINE
	EXISTING U.G. FIBER OPTIC
	EXISTING FORCE MAIN
	EXISTING STORM SEWER
	RELOCATED SANITARY SEWER
	RELOCATED GAS LINE
	RELOCATED WATER LINE
	RELOCATED STORM SEWER
	RELOCATED SLUDGE LINE
	RELOCATED U. G. FIBER OPTIC
	RELOCATED POWER
	RELOCATED TELEPHONE
	RELOCATED CABLE TV
	RELOCATED CITY COMM.
	RELOCATED FIBER OPTIC
	EXISTING POWER
	EXISTING TELEPHONE
	EXISTING CABLE TV
	EXISTING CITY COMM.
	EXISTING FIBER OPTIC
	NEW SANITARY SEWER, SLUDGE MAIN OR FORCE MAIN
	NEW INTERCEPTOR
	NEW STORM SEWER
	NEW DRAINAGE DITCH
	NEW WATER LINE
	EXISTING PIPE TO BE PLUGGED AND ABANDONED
	EXISTING PIPE TO BE REMOVED
	DIRECTION OF RIVER FLOW

	SWAMP
	CORPORATE BOUNDARY LIMITS
	RAILROAD
	RAILROAD
	CHAIN-LINK FENCE
	TREELINE
	BRUSH LINE
	TANKS
	TREE / BUSH
	CONTRACTOR WORK LIMITS
	LIMITED WORK LIMITS
	RIGHT OF WAY
	CURB
	ROAD
	UNIMPROVED ROAD
	TRAIL
	STONE SLOPE PROTECTION LIMITS (PLAN)
	CENTERLINE OF PROJECT
	UNIFORM SLOPE DESIGNATION
	EXISTING SLOPE
	STATE HIGHWAY
	INTERSTATE HIGHWAY
	U.S. HIGHWAY
	IRON PIN AND CAP
	TREE W/BASE
	CULVERT
	TRAFFIC SIGNAL
	TRANS. TOWER
	CATCH BASIN
	EXISTING MANHOLE
	NEW MANHOLE
	L.P.
	FIRE HYDRANT
	SIGN POST
	V. CONTROL
	H.-H./V. CONTROL
	POWER POLE
	POST
	MAIL BOX
	METER
	SIGN
	IN SITU ROCK
	IN SITU EARTH
	EARTH FILL



	SURFACE DRAINAGE FLOW
	CULVERT END
	HEADWALL
	CENTERLINE
	VALVE
	CONTAMINATED SOIL

ABBREVIATIONS

ACI	AMERICAN CONCRETE INSTITUTE	N	NORTH
ALT	ALTERNATE	#, NO	NUMBER
ALUM	ALUMINUM	OC	ON CENTER
AWWA	AMERICAN WATER WORKS ASSOC.	OD	OUTSIDE DIAMETER
@	AT	OF	OUTSIDE FACE
B	BASE, BEAM OR BOTTOM	OPG	OPENING
BM	BENCH MARK	OPP	OPPOSITE
BOT	BOTTOM	OZ	OUNCE
C	CHANNEL, CONDUIT	PC	PIPE COVER (MIN.)
CC	CENTER TO CENTER	PI	POINT OF INTERSECTION
CTRS	CENTERS	PL	PLATE OR PROPERTY LINE
CL	CENTERLINE	PROJ	PROJECTION
CJ	CONSTRUCTION JOINT	PSI	POUNDS PER SQUARE INCH
CL, CLR	CLEAR	PSF	POUNDS PER SQUARE FOOT
COL	COLUMN	QUAN	QUANTITY
CONC	CONCRETE	R	RADIUS OR RISER
CONST	CONSTRUCTION	RCP	REINFORCED CONCRETE PIPE
CONT	CONTINUOUS	RD	ROOF DRAIN
CRS	CORROSION RESISTANCE STEEL	REINF	REINFORCING
CWL	CONTRACTOR'S WORK LIMITS	REQ'D	REQUIRED
CY	CUBIC YARD	RGC	RIGID GALVANIZED CONDUIT
DCIP	DUCTILE CAST IRON PIPE	RF	ROOF FRAME
DI	DROP INLET	RT	RIGHT
DIA	DIAMETER	S	SOUTH
DIM	DIMENSION	SECT	SECTION
DWG	DRAWING	SF	SQUARE FEET
E	EAST	SHT	SHEET
EA	EACH	SIM	SIMILAR
EF	EACH FACE	SPC	SPACES
EJ	EXPANSION JOINT	SQ	SQUARE
EJFS	EXPANSION JOINT FILLER STRIP	SS	STAINLESS STEEL
EL, ELEV	ELEVATION	STA	STATION
EQ	EQUAL	STD	STANDARD
EW	EACH WAY	STIR	STIRRUPS
EX, EXIST	EXISTING	STL	STEEL
EXP	EXPANSION	STR	STRAIGHT, STRUCTURAL
FIN	FINISHED	SY	SQUARE YARD
FT	FEET, FOOT	SYM	SYMMETRICAL
GA	GAUGE OR GAGE	T	TOP OR TREAD
GALV	GALVANIZED	TOE	TOP OF EXCAVATION
GRD	GROUND	TYP	TYPICAL
H, HORIZ	HORIZONTAL	UNO	UNLESS NOTED OTHERWISE
HEX HD	HEXAGONAL HEAD	V, VERT	VERTICAL
HS	HIGH STRENGTH, HEADED STUD	VAR	VARIABLE
IF	INSIDE FACE	VC	VERTICAL CURVE
IJ	ISOLATION JOINT	VPT	VERTICAL POINT OF TANGENCY
INV	INVERT	VPC	VERTICAL POINT OF CURVATURE
IP	IRON PIN	VPI	VERTICAL POINT OF INTERSECTION
JT	JOINT	W	WIDE FLANGE, WEST
LB	POUND	W/	WITH
Ld	TENSILE DEVELOPMENT LENGTH	W/O	WITHOUT
LT	LEFT	WS	WATERSTOP
LLH	LONG LEG HORIZONTAL		
MAX	MAXIMUM		
MH	MANHOLE		
MIN	MINIMUM		
MJ	MECHANICAL JOINT, MONOLITH JOINT		
MK	MARK		

Revisions			
Symbol	Descriptions	Date	Approved

BURGESS & NIPLE, LIMITED COLUMBUS, OHIO	U.S. ARMY ENGINEER DISTRICT CORPS OF ENGINEERS HUNTINGTON, WEST VIRGINIA		
Designed by: P. CONROY	 SCIOTO RIVER COLUMBUS, OHIO WEST COLUMBUS, L.P.P. PHASE IID GENERAL LEGEND		
Drawn by: T. MULLINS			
Checked by: R. OMAN			
Reviewed by:	Scale: NONE	Sheet reference number: 0/3	FILENAME: 00dgl01.dgn
Approved by:	Date: MARCH 1998	Drawing Code: 16-PWC-10-	PIN TABLE:
			Sheet 1 of 1

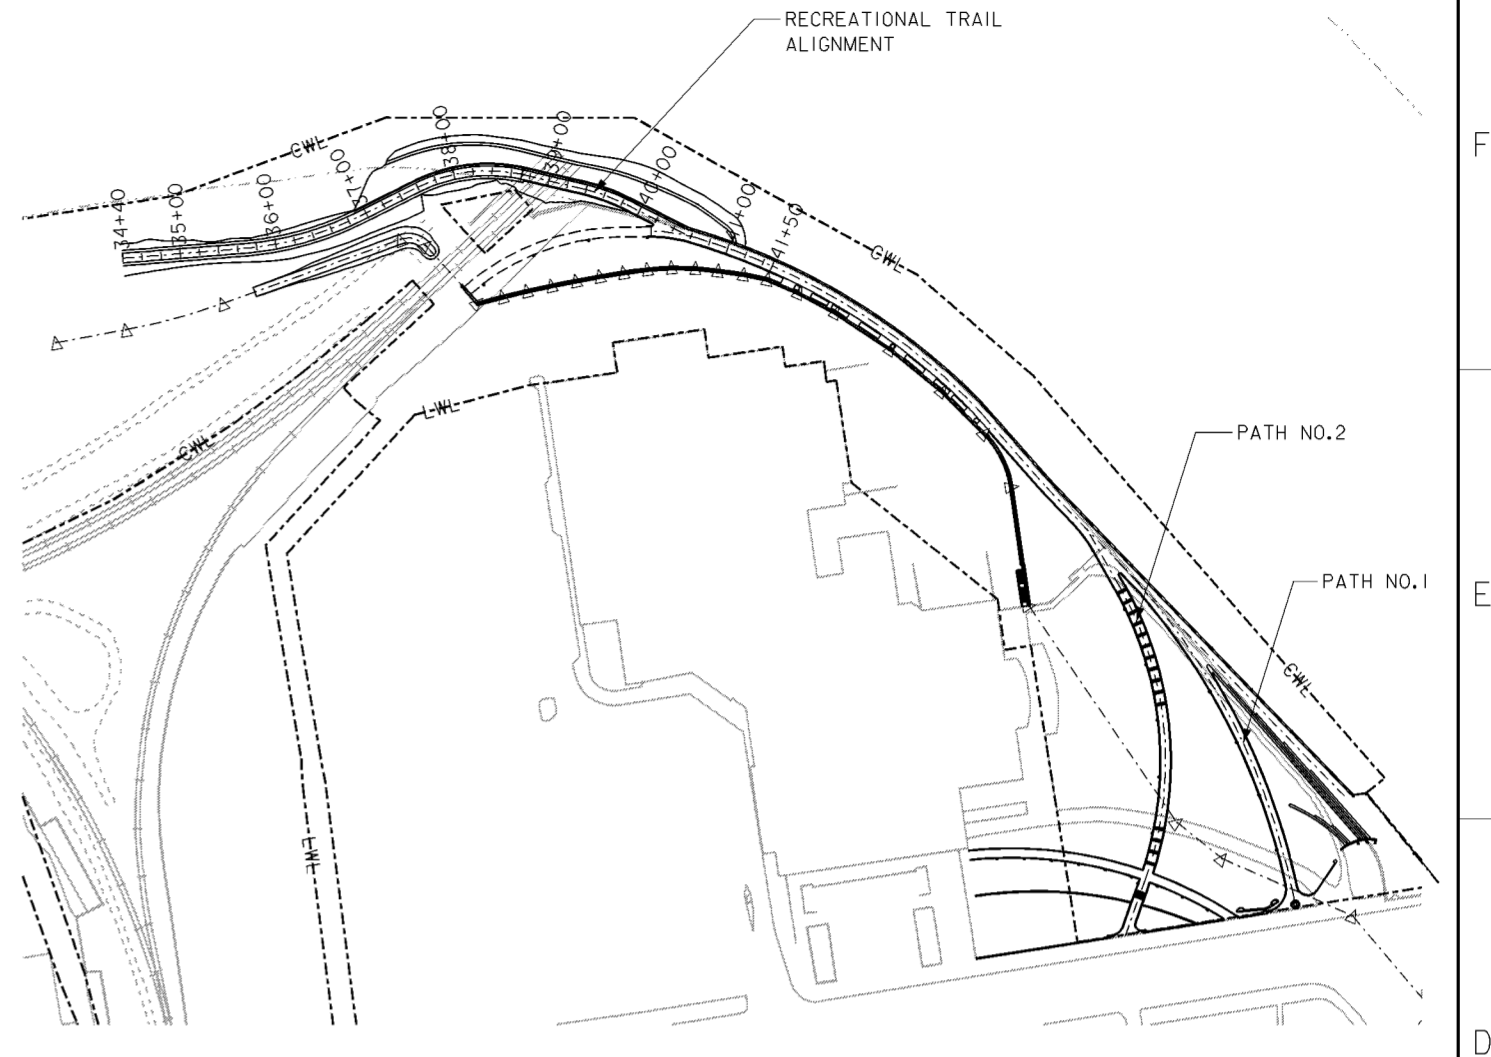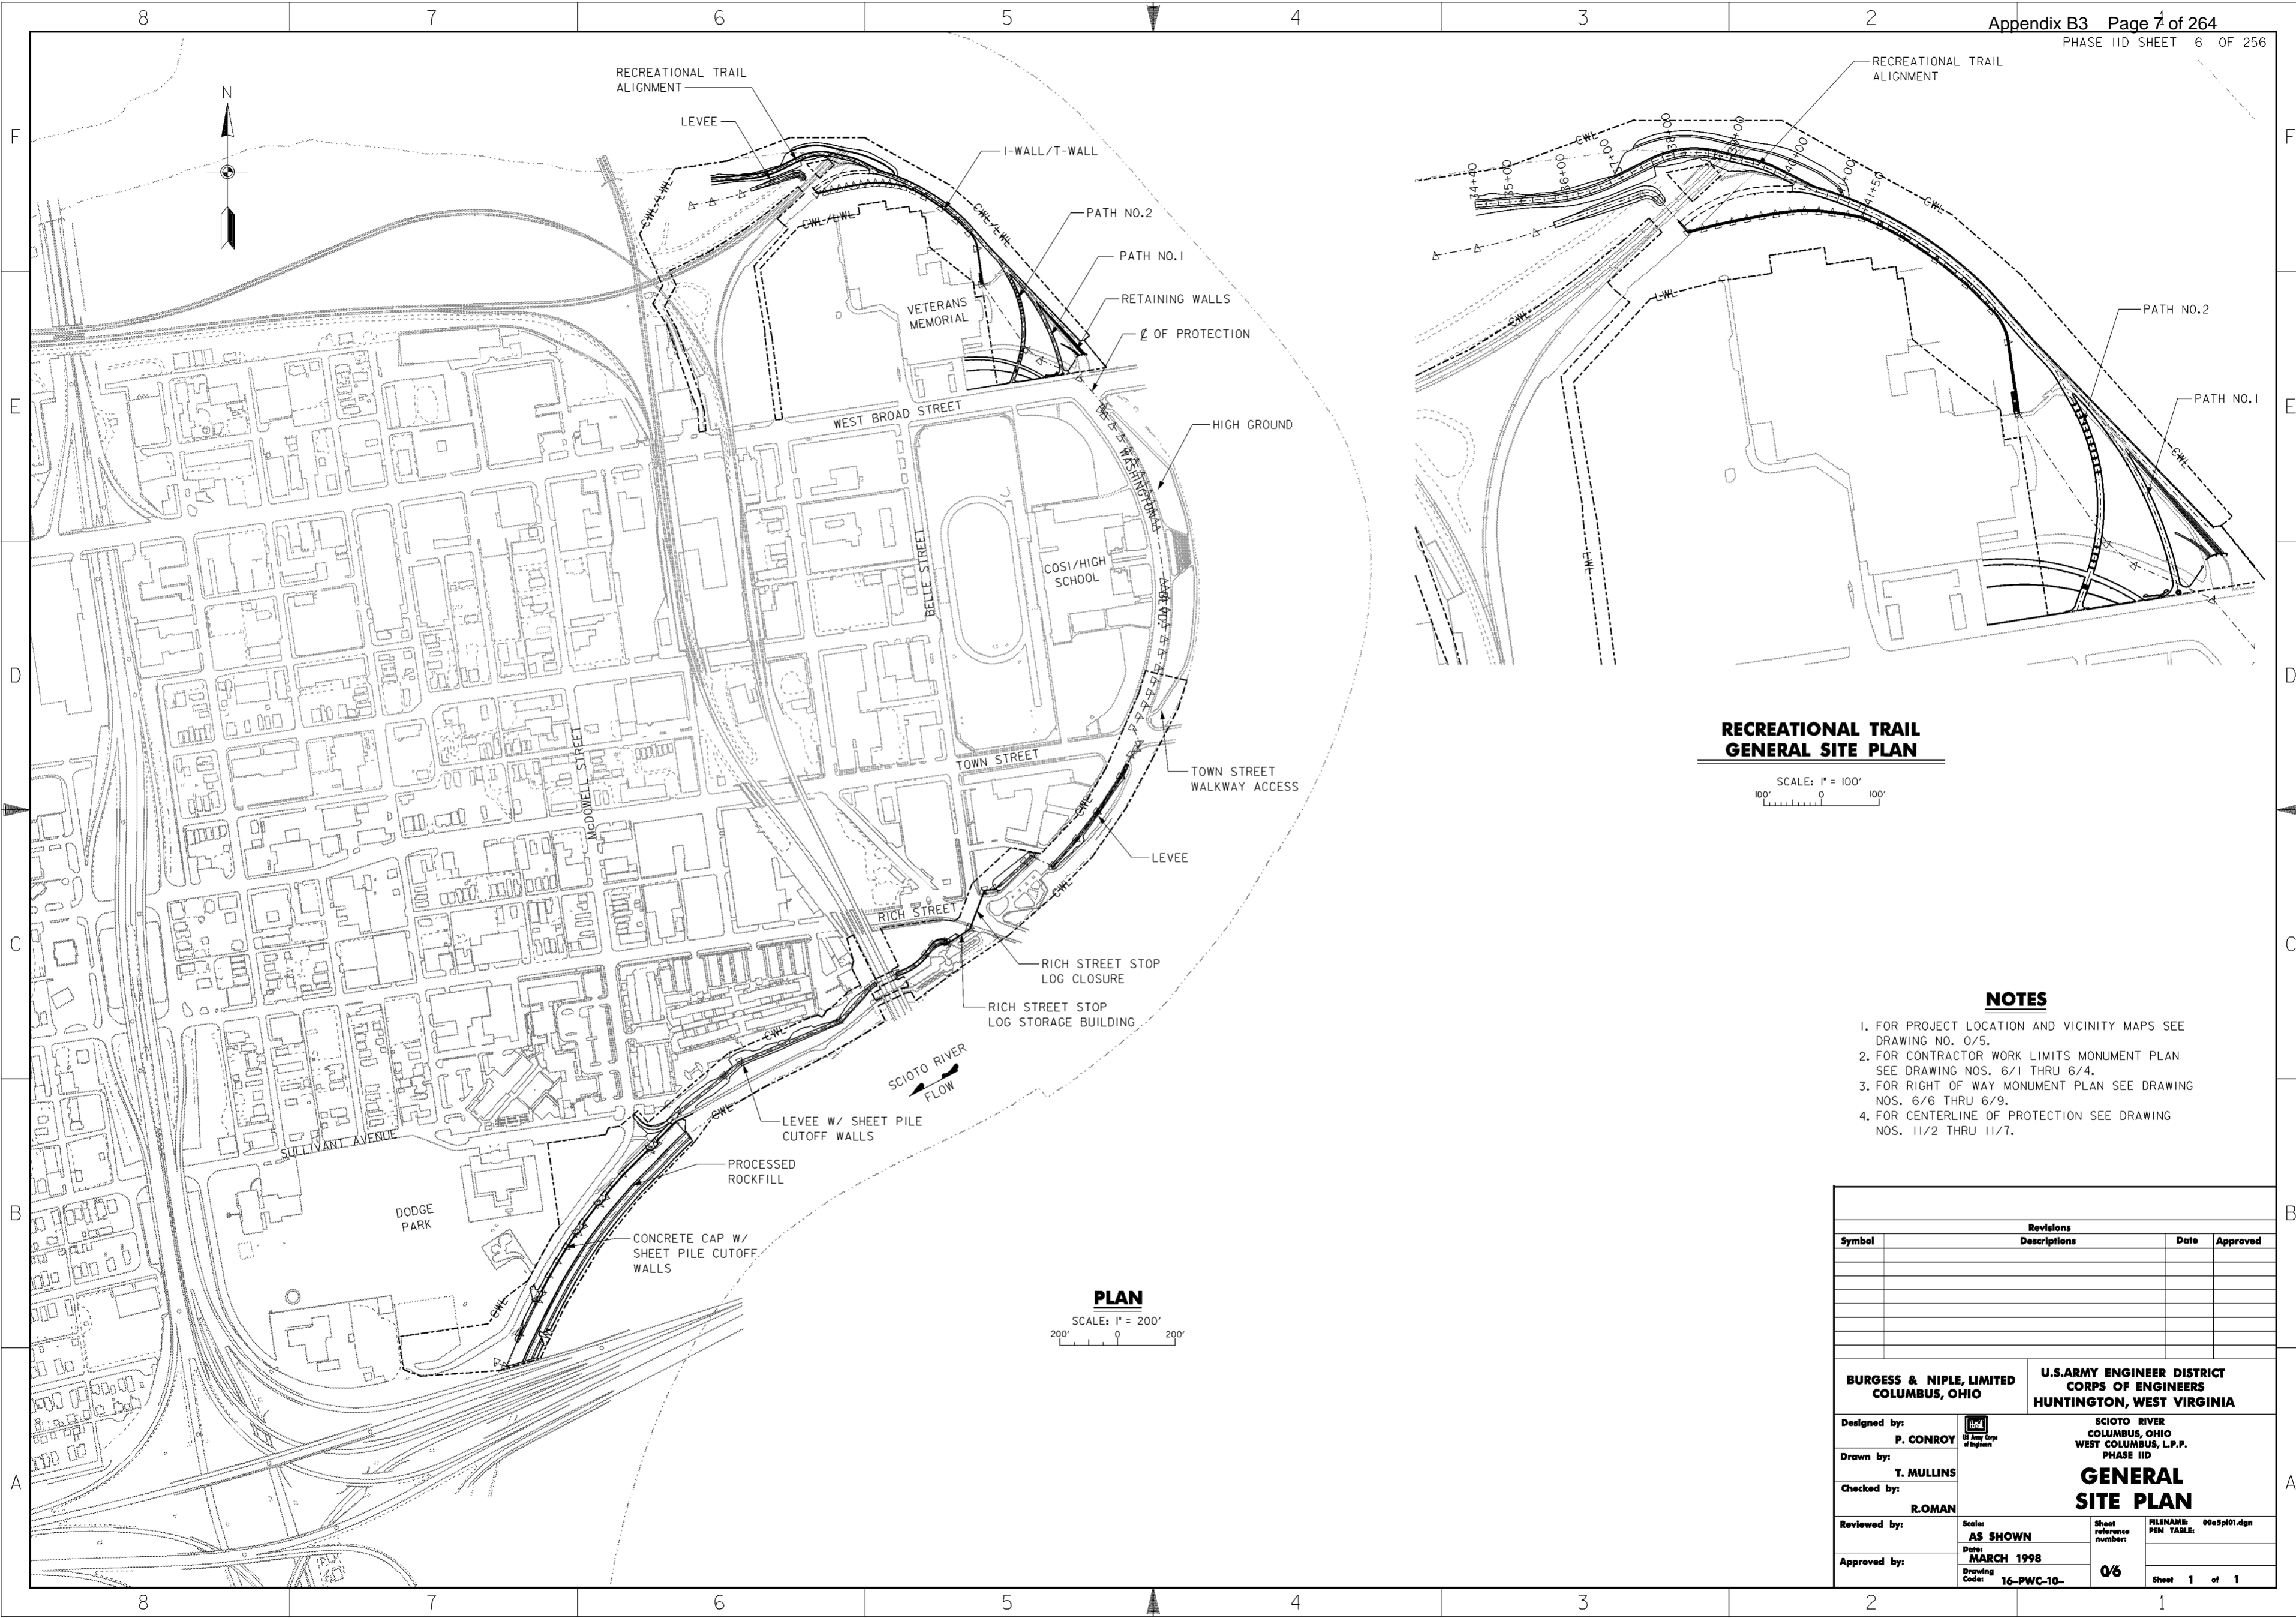

**RECREATIONAL TRAIL
 GENERAL SITE PLAN**

SCALE: 1" = 100'
 100' 0 100'



NOTES

1. FOR PROJECT LOCATION AND VICINITY MAPS SEE DRAWING NO. 0/5.
2. FOR CONTRACTOR WORK LIMITS MONUMENT PLAN SEE DRAWING NOS. 6/1 THRU 6/4.
3. FOR RIGHT OF WAY MONUMENT PLAN SEE DRAWING NOS. 6/6 THRU 6/9.
4. FOR CENTERLINE OF PROTECTION SEE DRAWING NOS. 11/2 THRU 11/7.

Revisions			
Symbol	Descriptions	Date	Approved

BURGESS & NIPLE, LIMITED COLUMBUS, OHIO		U.S. ARMY ENGINEER DISTRICT CORPS OF ENGINEERS HUNTINGTON, WEST VIRGINIA	
Designed by: P. CONROY		SCIOTO RIVER COLUMBUS, OHIO WEST COLUMBUS, L.P.P. PHASE IID GENERAL SITE PLAN	
Drawn by: T. MULLINS			
Checked by: R.ROMAN	Reviewed by:	Scale: AS SHOWN	Sheet reference number: 0/6
Approved by:	Date: MARCH 1998	Drawing Code: 16-PWC-10-	FILENAME: PEN TABLE: 00c5p101.dgn Sheet 1 of 1

WORK AS CONSTRUCTED

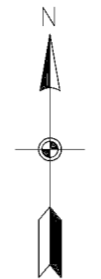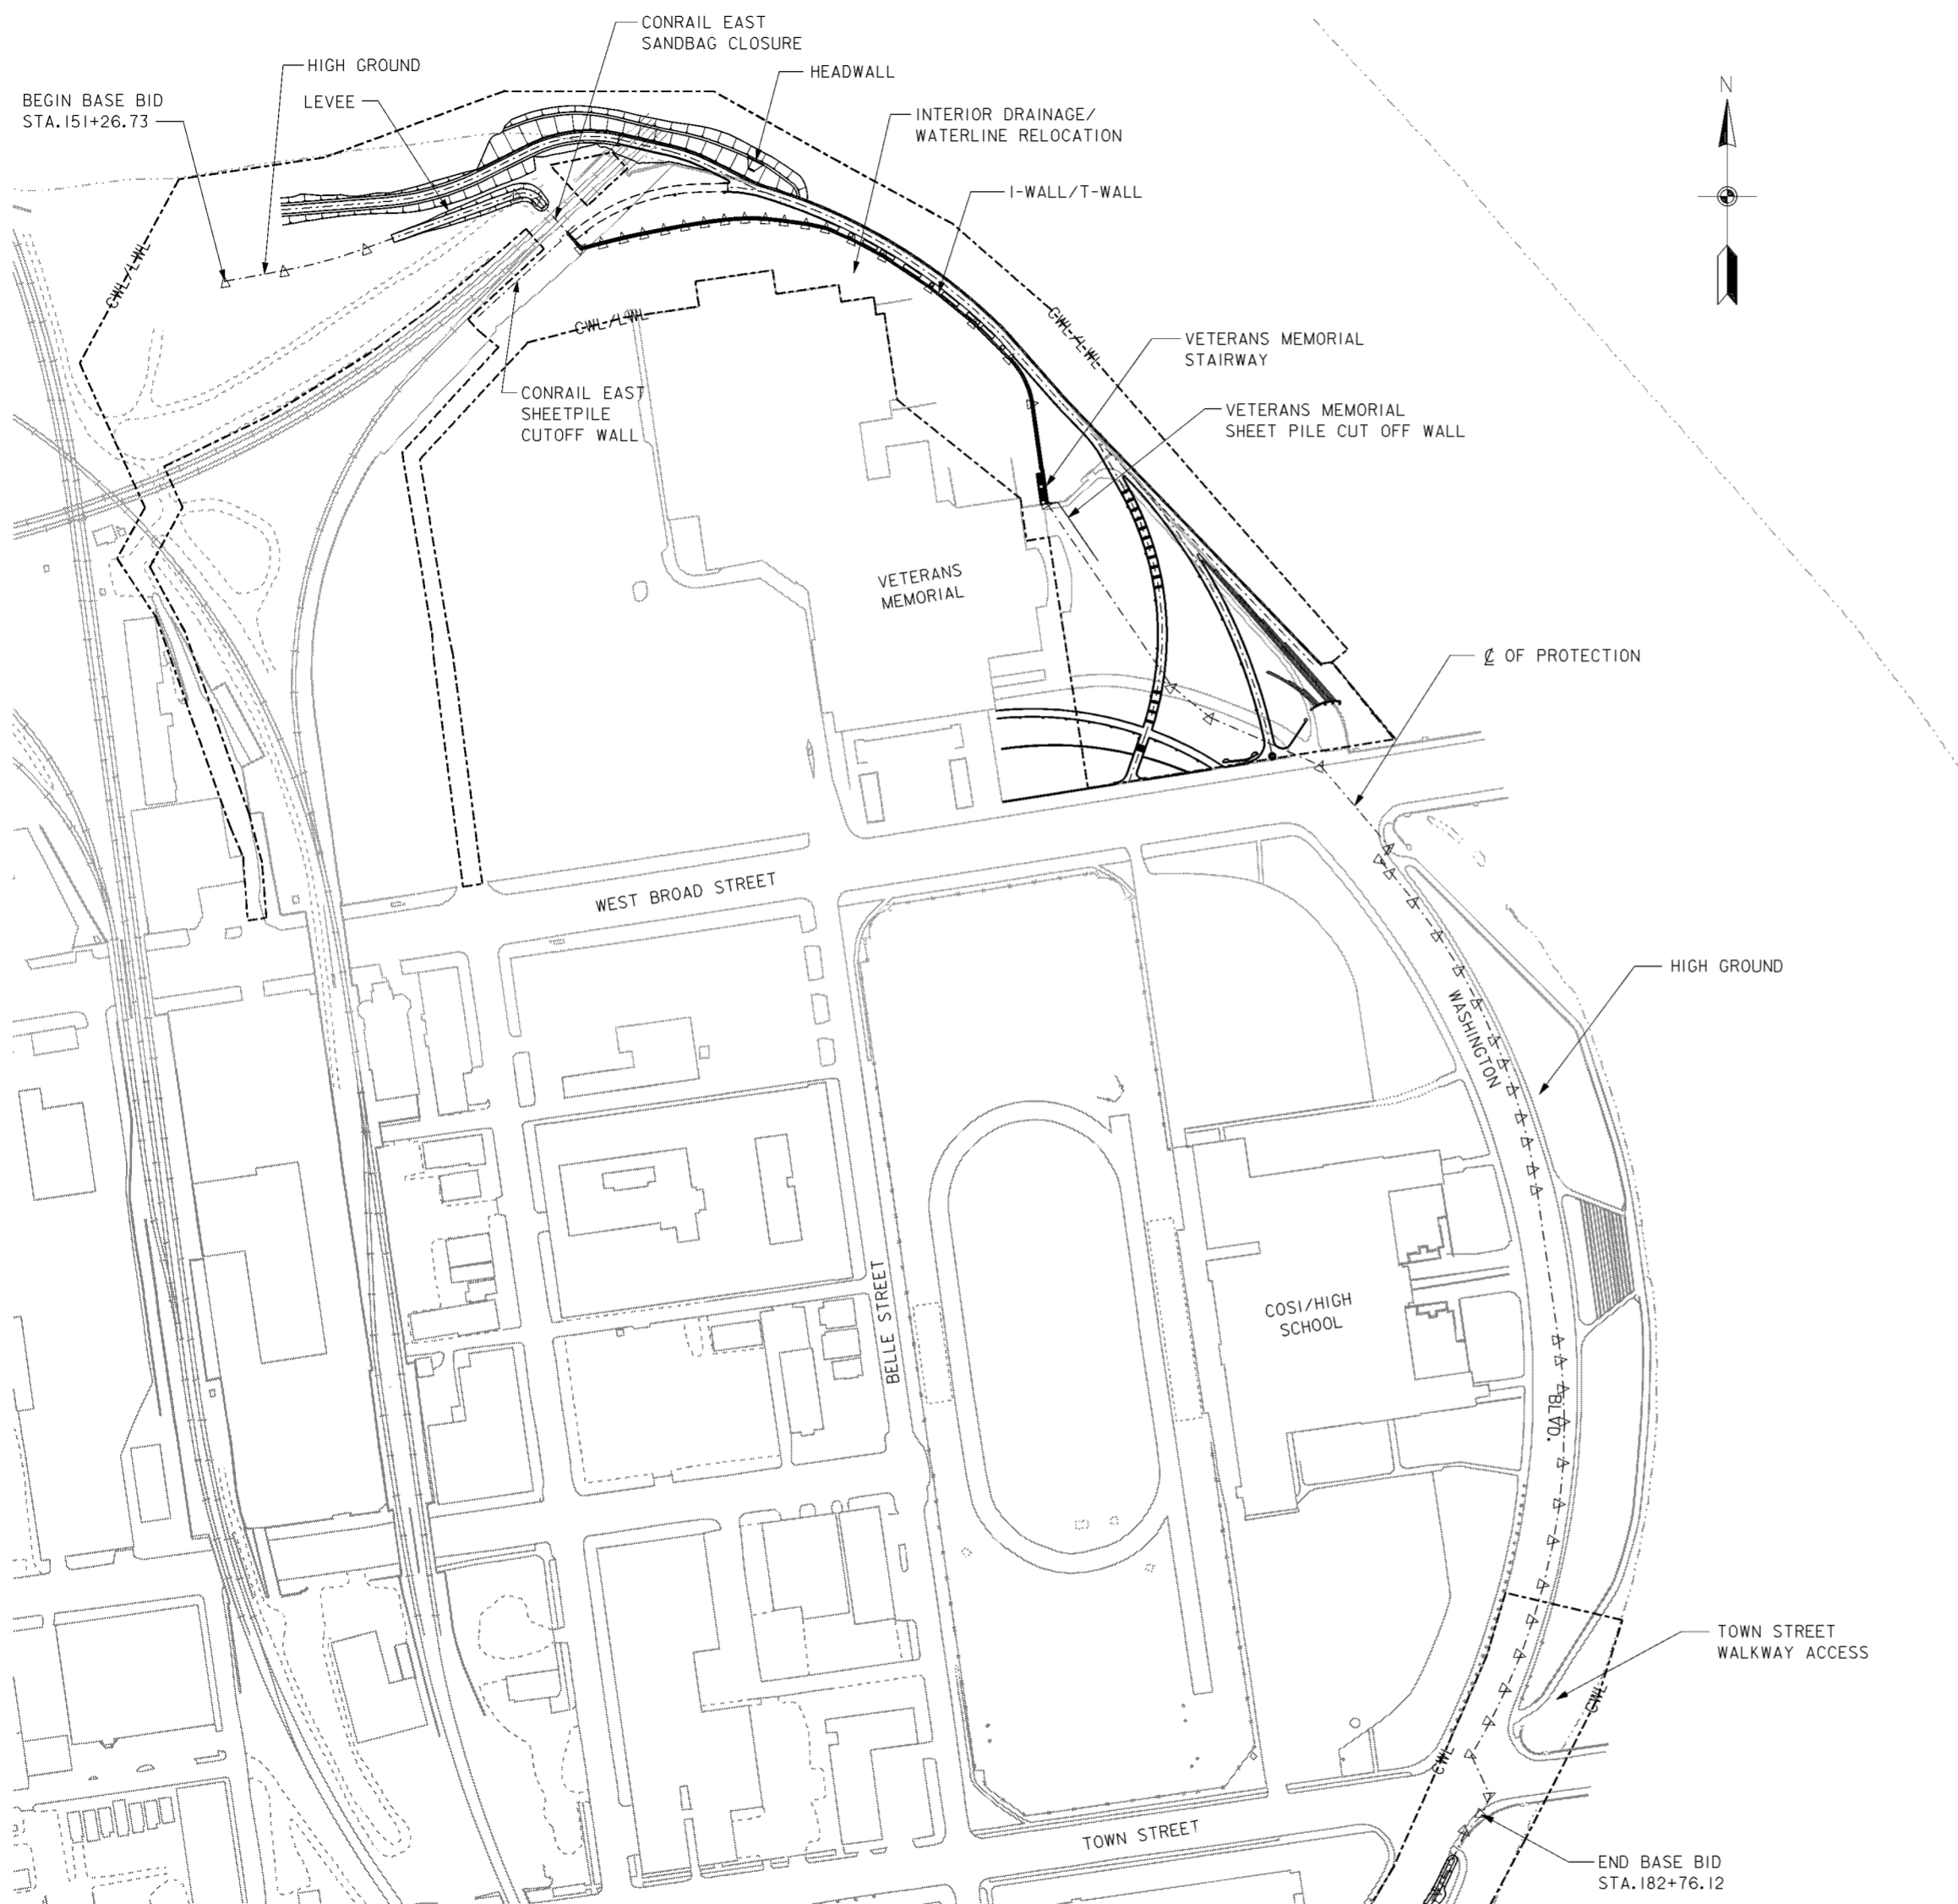

SCOPE OF WORK

THE BASE BID INCLUDES THE CONSTRUCTION OF THE FLOOD PROTECTION FEATURES (LEVEE, I-WALL, AND T-WALL) FROM THE BEGINNING OF THE PROJECT, STATION 151+26.73, TO THE SOUTH SIDE OF TOWN STREET AT STATION 182+76.12. THE BASE BID ALSO INCLUDES THE CONSTRUCTION OF THE CONRAIL EAST SANDBAG CLOSURE AND SHEET PILE CUTOFF WALL; INTERIOR DRAINAGE SYSTEM, HEADWALL, GATEWELL, AND WATER LINE RELOCATION BEHIND VETERANS MEMORIAL; VETERANS MEMORIAL SHEET PILE CUTOFF WALL; AND THE TOWN STREET WALKWAY ACCESS.

**RELATED DRAWINGS
 BASE BID**

- 0/1 THRU 0/6
- 6/1 THRU 6/3 AND 6/5
- 6/6 THRU 6/8 AND 6/10
- 11/1 THRU 11/4
- 11/8 AND 11/9
- 15/1 AND 15/3 THRU 15/7
- 15/10 AND 15/11
- 16/1 THRU 16/7
- 16/15 THRU 16/25
- 20.1/1 THRU 20.1/10 AND 20.1/14
- 20.2/1 THRU 20.2/5
- 20.2/29 AND 20.2/30 (PAVEMENT REMOVAL/REPLACEMENT ONLY)
- 20.2/44 THRU 20.2/46
- 20.2/55 (FLOODWALL AND STAIRWAY RAILING ONLY)
- 20.2/65 AND 20.2/66
- 20.3/1 AND 20.3/2
- 107/1 AND 107/2
- 10/1 THRU 10/18
- 14/1 THRU 14/16

NOTES


1. FOR PROJECT LOCATION AND VICINITY MAPS SEE DRAWING NO. 0/5.
2. FOR CONTRACTOR WORK LIMITS MONUMENT PLAN SEE DRAWING NOS. 6/1 THRU 6/4.
3. FOR RIGHT OF WAY MONUMENT PLAN SEE DRAWING NOS. 6/6 THRU 6/9.
4. FOR CENTERLINE OF PROTECTION SEE DRAWING NOS. 11/2 THRU 11/7.

PLAN

SCALE: 1" = 100'
 100' 0 100'

Revisions			
Symbol	Descriptions	Date	Approved

BURGESS & NIPLE, LIMITED COLUMBUS, OHIO		U.S. ARMY ENGINEER DISTRICT CORPS OF ENGINEERS HUNTINGTON, WEST VIRGINIA	
Designed by: P. CONROY		SCIOTO RIVER COLUMBUS, OHIO WEST COLUMBUS, L.P.P. PHASE IID	
Drawn by: T. MULLINS		BASE BID SITE PLAN	
Checked by: R. ROMAN	Reviewed by:	Scale: AS SHOWN	Sheet reference number: 07
Approved by:	Date: MARCH 1998	Drawing Code: 16-PWC-10-	FILENAME: PEN TABLE: 00c5p102.dgn
Sheet 1 of 1		Sheet 1 of 1	

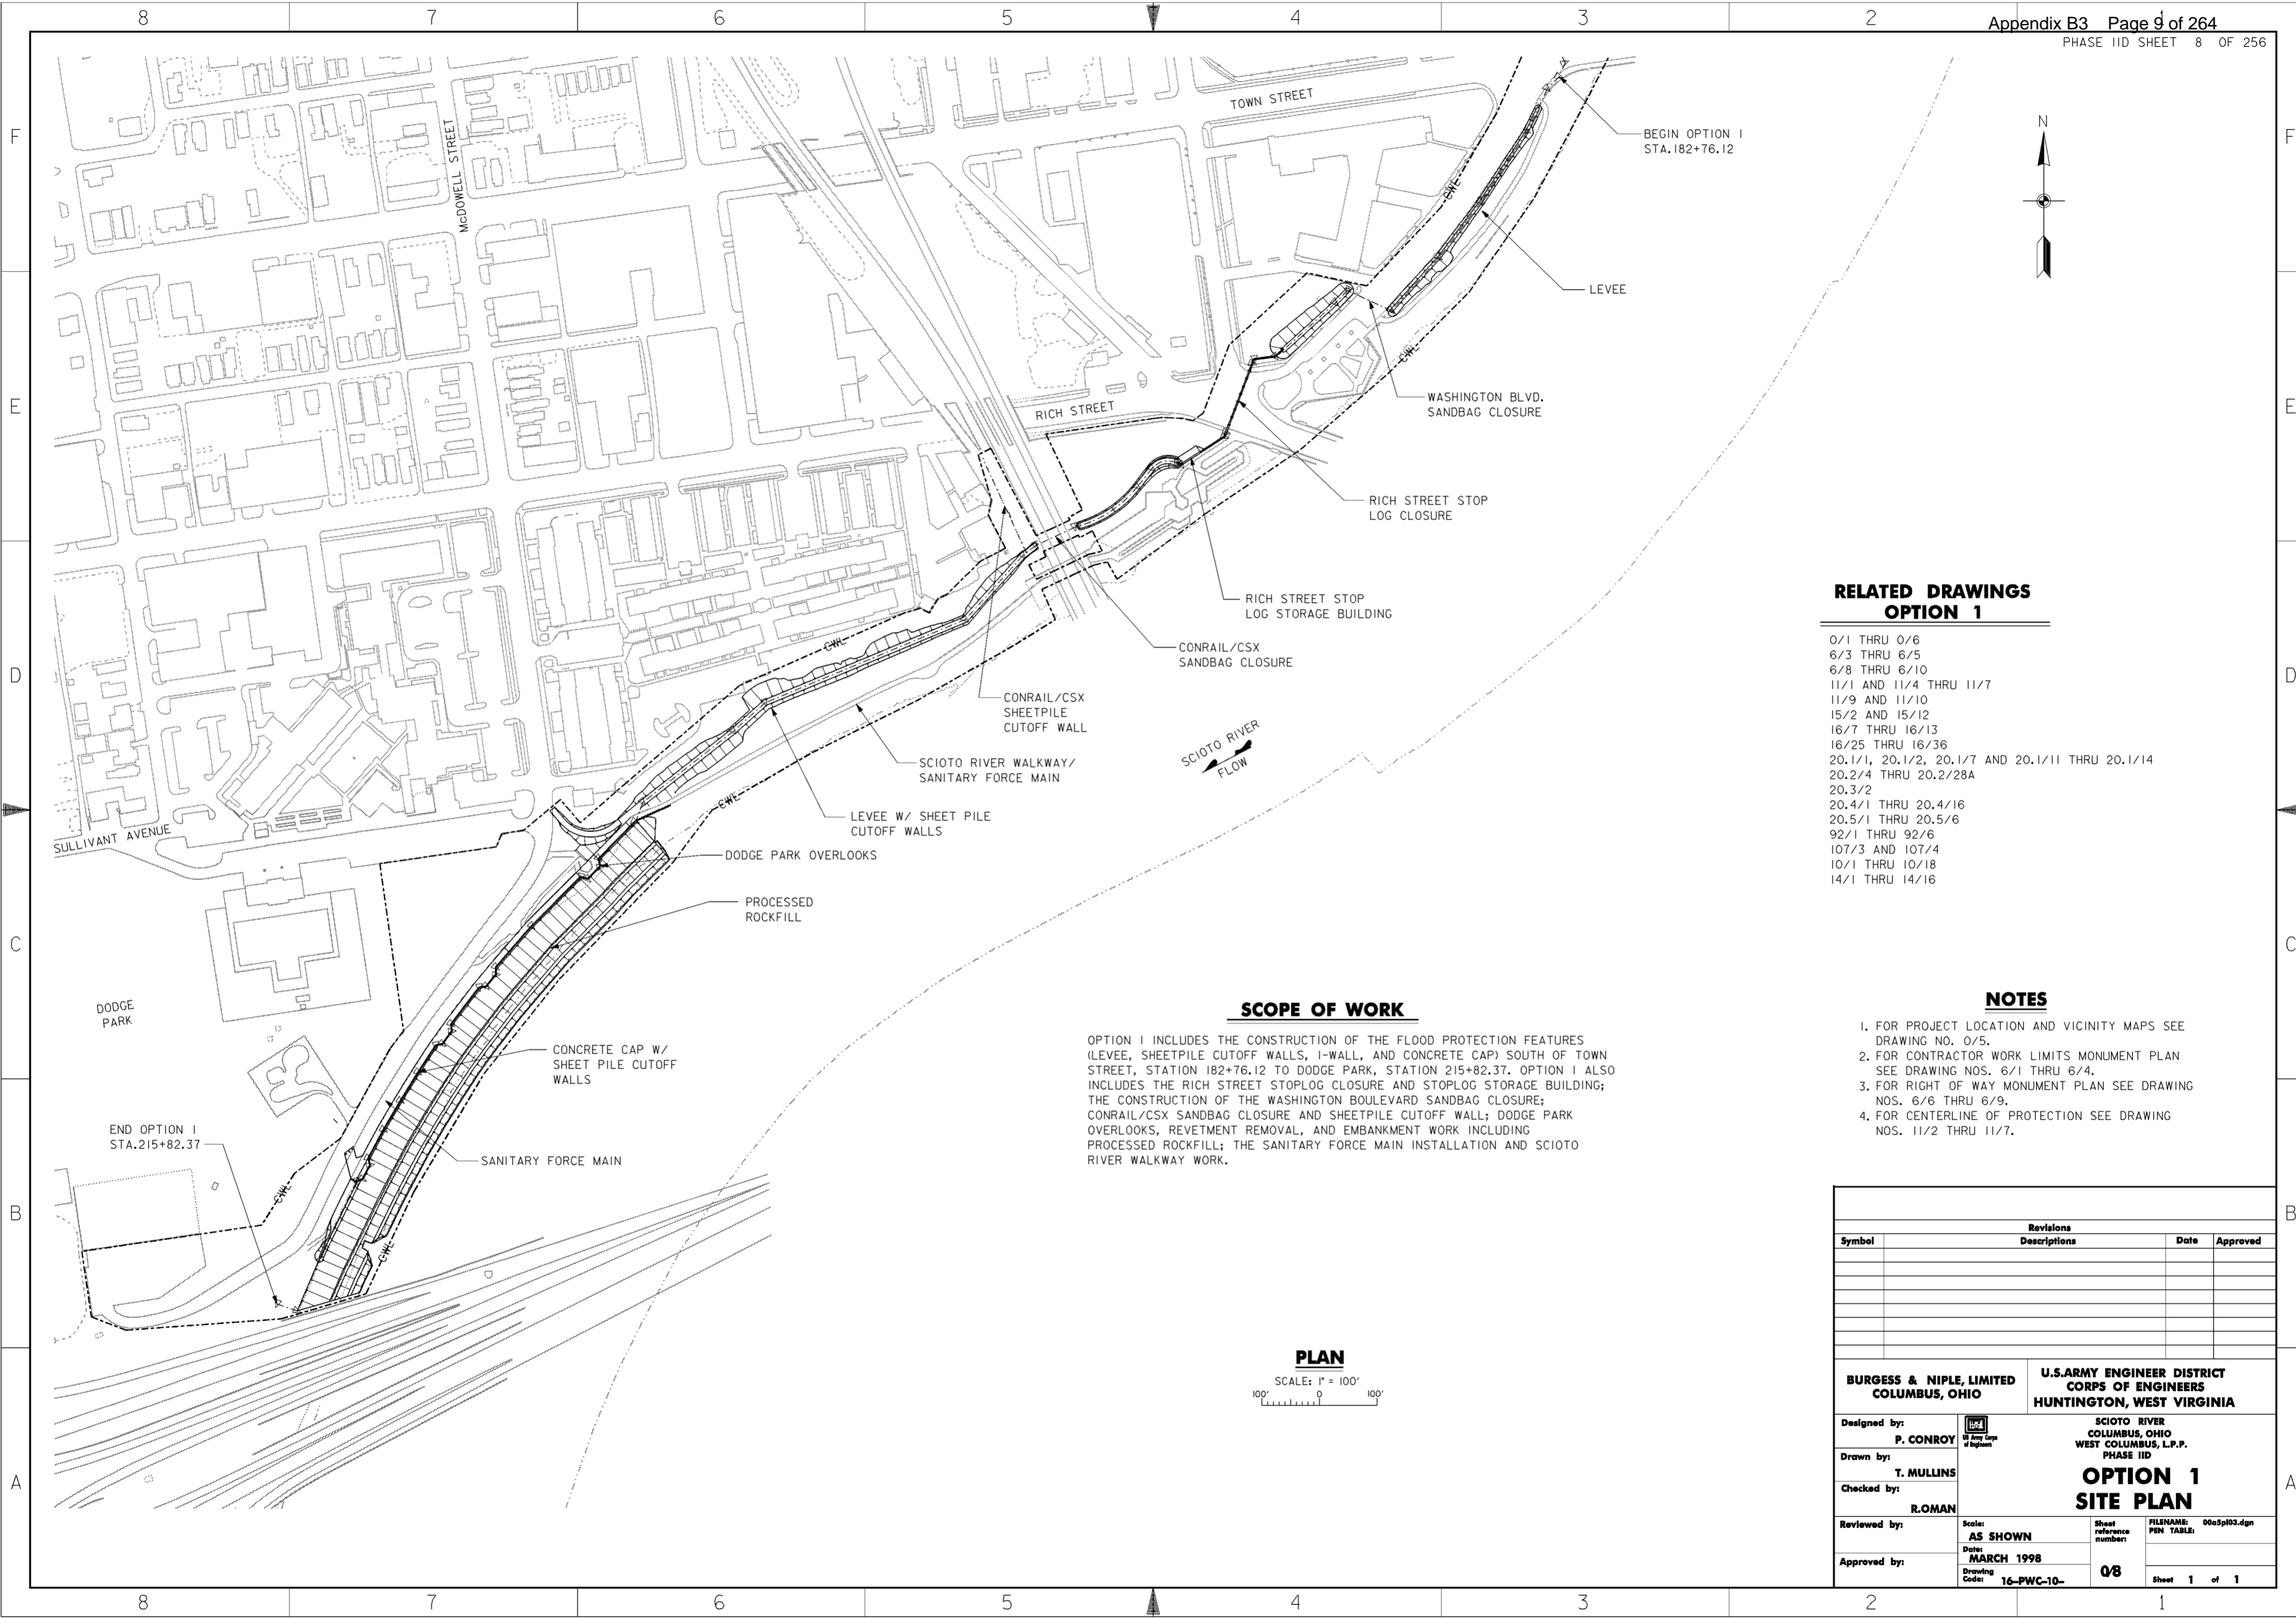

**RELATED DRAWINGS
 OPTION 1**


- 0/1 THRU 0/6
- 6/3 THRU 6/5
- 6/8 THRU 6/10
- 11/1 AND 11/4 THRU 11/7
- 11/9 AND 11/10
- 15/2 AND 15/12
- 16/7 THRU 16/13
- 16/25 THRU 16/36
- 20.1/1, 20.1/2, 20.1/7 AND 20.1/11 THRU 20.1/14
- 20.2/4 THRU 20.2/28A
- 20.3/2
- 20.4/1 THRU 20.4/16
- 20.5/1 THRU 20.5/6
- 92/1 THRU 92/6
- 107/3 AND 107/4
- 10/1 THRU 10/18
- 14/1 THRU 14/16

SCOPE OF WORK

OPTION 1 INCLUDES THE CONSTRUCTION OF THE FLOOD PROTECTION FEATURES (LEVEE, SHEETPILE CUTOFF WALLS, I-WALL, AND CONCRETE CAP) SOUTH OF TOWN STREET, STATION 182+76.12 TO DODGE PARK, STATION 215+82.37. OPTION 1 ALSO INCLUDES THE RICH STREET STOPLOG CLOSURE AND STOPLOG STORAGE BUILDING; THE CONSTRUCTION OF THE WASHINGTON BOULEVARD SANDBAG CLOSURE; CONRAIL/CSX SANDBAG CLOSURE AND SHEETPILE CUTOFF WALL; DODGE PARK OVERLOOKS, REVETMENT REMOVAL, AND EMBANKMENT WORK INCLUDING PROCESSED ROCKFILL; THE SANITARY FORCE MAIN INSTALLATION AND SCIOTO RIVER WALKWAY WORK.


NOTES

1. FOR PROJECT LOCATION AND VICINITY MAPS SEE DRAWING NO. 0/5.
2. FOR CONTRACTOR WORK LIMITS MONUMENT PLAN SEE DRAWING NOS. 6/1 THRU 6/4.
3. FOR RIGHT OF WAY MONUMENT PLAN SEE DRAWING NOS. 6/6 THRU 6/9.
4. FOR CENTERLINE OF PROTECTION SEE DRAWING NOS. 11/2 THRU 11/7.

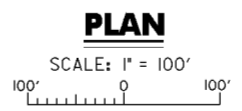

Revisions			
Symbol	Descriptions	Date	Approved

BURGESS & NIPLE, LIMITED COLUMBUS, OHIO	P. CONROY T. MULLINS R. ROMAN	U.S. ARMY ENGINEER DISTRICT CORPS OF ENGINEERS HUNTINGTON, WEST VIRGINIA	SCIOTO RIVER COLUMBUS, OHIO WEST COLUMBUS, L.P.P. PHASE IID OPTION 1 SITE PLAN

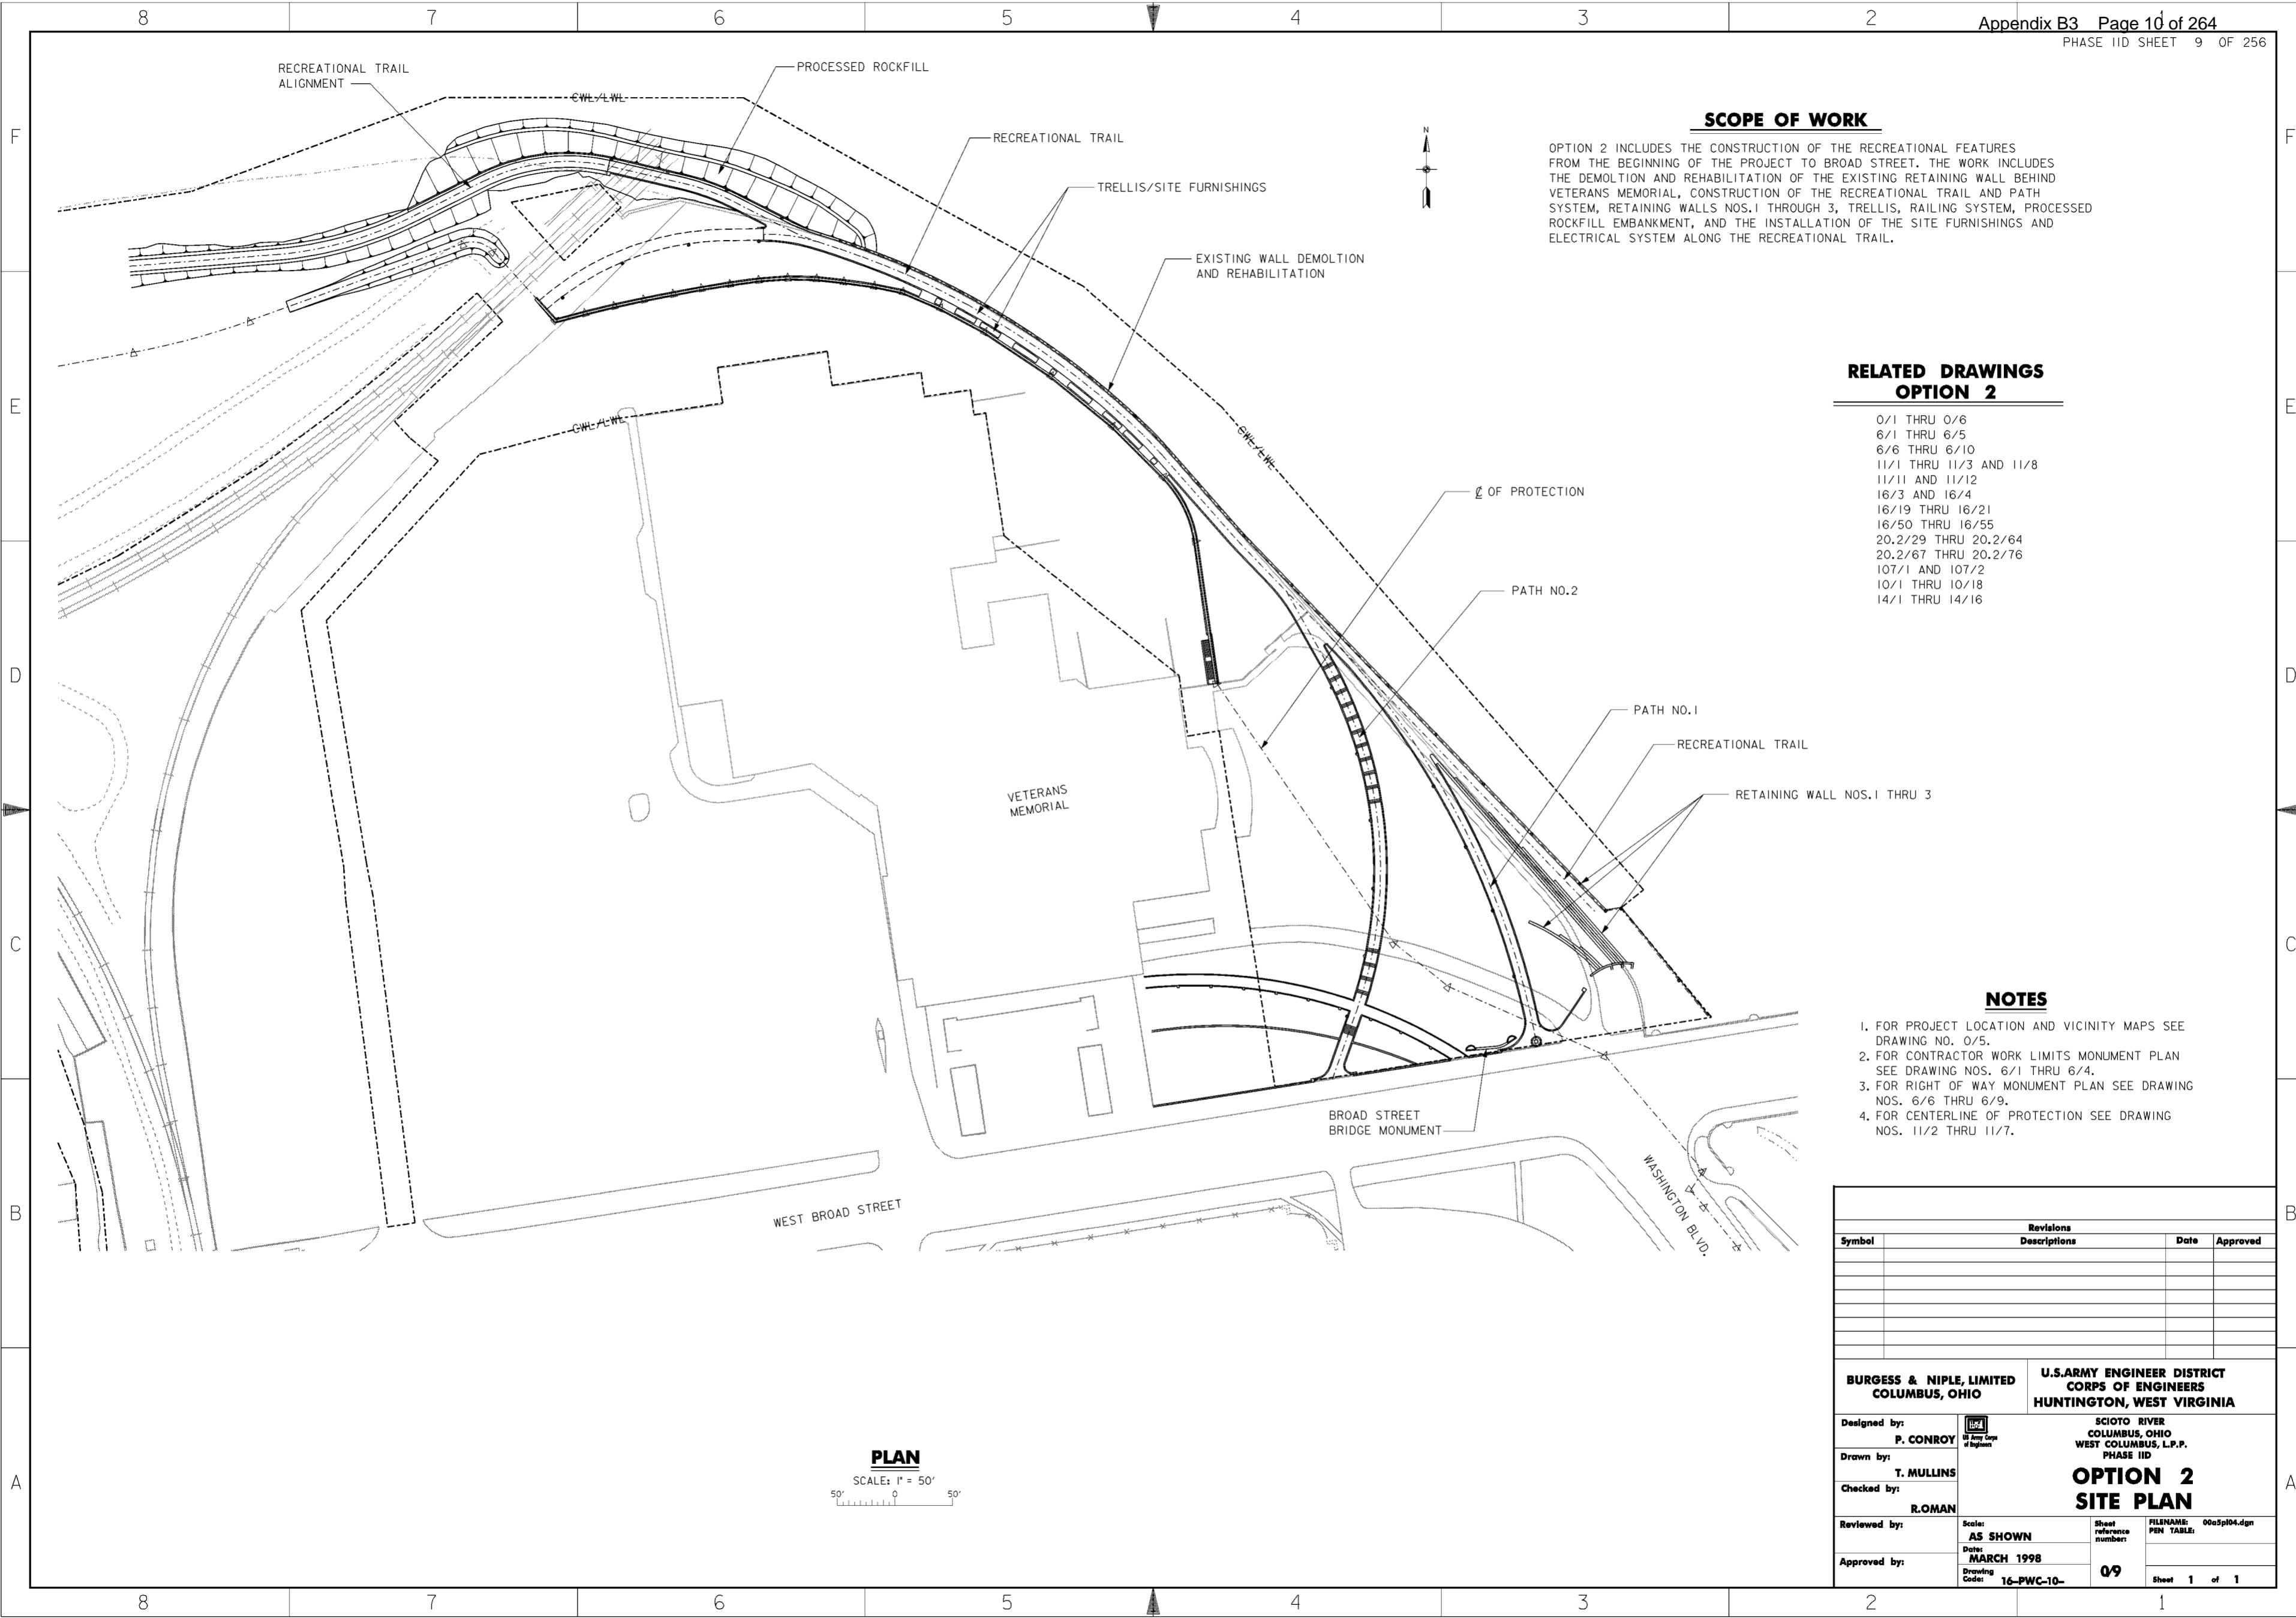

SCOPE OF WORK

OPTION 2 INCLUDES THE CONSTRUCTION OF THE RECREATIONAL FEATURES FROM THE BEGINNING OF THE PROJECT TO BROAD STREET. THE WORK INCLUDES THE DEMOLITION AND REHABILITATION OF THE EXISTING RETAINING WALL BEHIND VETERANS MEMORIAL, CONSTRUCTION OF THE RECREATIONAL TRAIL AND PATH SYSTEM, RETAINING WALLS NOS.1 THROUGH 3, TRELLIS, RAILING SYSTEM, PROCESSED ROCKFILL EMBANKMENT, AND THE INSTALLATION OF THE SITE FURNISHINGS AND ELECTRICAL SYSTEM ALONG THE RECREATIONAL TRAIL.

**RELATED DRAWINGS
OPTION 2**

- 0/1 THRU 0/6
- 6/1 THRU 6/5
- 6/6 THRU 6/10
- 11/1 THRU 11/3 AND 11/8
- 11/11 AND 11/12
- 16/3 AND 16/4
- 16/19 THRU 16/21
- 16/50 THRU 16/55
- 20.2/29 THRU 20.2/64
- 20.2/67 THRU 20.2/76
- 107/1 AND 107/2
- 10/1 THRU 10/18
- 14/1 THRU 14/16

NOTES

1. FOR PROJECT LOCATION AND VICINITY MAPS SEE DRAWING NO. 0/5.
2. FOR CONTRACTOR WORK LIMITS MONUMENT PLAN SEE DRAWING NOS. 6/1 THRU 6/4.
3. FOR RIGHT OF WAY MONUMENT PLAN SEE DRAWING NOS. 6/6 THRU 6/9.
4. FOR CENTERLINE OF PROTECTION SEE DRAWING NOS. 11/2 THRU 11/7.

PLAN
SCALE: 1" = 50'

Revisions			
Symbol	Descriptions	Date	Approved

BURGESS & NIPLE, LIMITED COLUMBUS, OHIO	U.S. ARMY ENGINEER DISTRICT CORPS OF ENGINEERS HUNTINGTON, WEST VIRGINIA	
Designed by: P. CONROY	SCIOTO RIVER COLUMBUS, OHIO WEST COLUMBUS, L.P.P. PHASE IID OPTION 2 SITE PLAN	
Drawn by: T. MULLINS		
Checked by: R. ROMAN		
Reviewed by:		
Approved by:	Scale: AS SHOWN Date: MARCH 1998 Drawing Code: 16-PWC-10-	Sheet reference number: 09 FILENAME: PEN TABLE: 00c5p104.dgn Sheet 1 of 1



SCOPE OF WORK

OPTION 3 INCLUDES ALL LANDSCAPING AND IRRIGATION FOR THE PHASE IID PROJECT. LANDSCAPING AND IRRIGATION WORK IS REQUIRED AT VETERANS MEMORIAL, RICH STREET PARK, AND DODGE PARK.

**RELATED DRAWINGS
 OPTION 3**

0/1 THRU 0/6
 12/1 THRU 12/11

NOTES


1. FOR PROJECT LOCATION AND VICINITY MAPS SEE DRAWING NO. 0/5.
2. FOR CONTRACTOR WORK LIMITS MONUMENT PLAN SEE DRAWING NOS. 6/1 THRU 6/4.

PLAN
 SCALE: 1" = 200'
 200' 0 200'

Revisions			
Symbol	Descriptions	Date	Approved

BURGESS & NIPLE, LIMITED COLUMBUS, OHIO	U.S. ARMY ENGINEER DISTRICT CORPS OF ENGINEERS HUNTINGTON, WEST VIRGINIA	SCIOTO RIVER COLUMBUS, OHIO WEST COLUMBUS, L.P.P. PHASE IID	
		OPTION 3 SITE PLAN	
Designed by: P. CONROY		Scale: AS SHOWN	FILENAME: 00c5p105.dgn
Drawn by: T. MULLINS		Date: MARCH 1998	Sheet reference number: 0/10
Checked by: R.OMAN		Drawing Code: 16-PWC-10-	PEN TABLE: Sheet 1 of 1
Reviewed by: Approved by:		Date: Drawing Code:	Sheet reference number: PEN TABLE:

WORK AS CONSTRUCTED

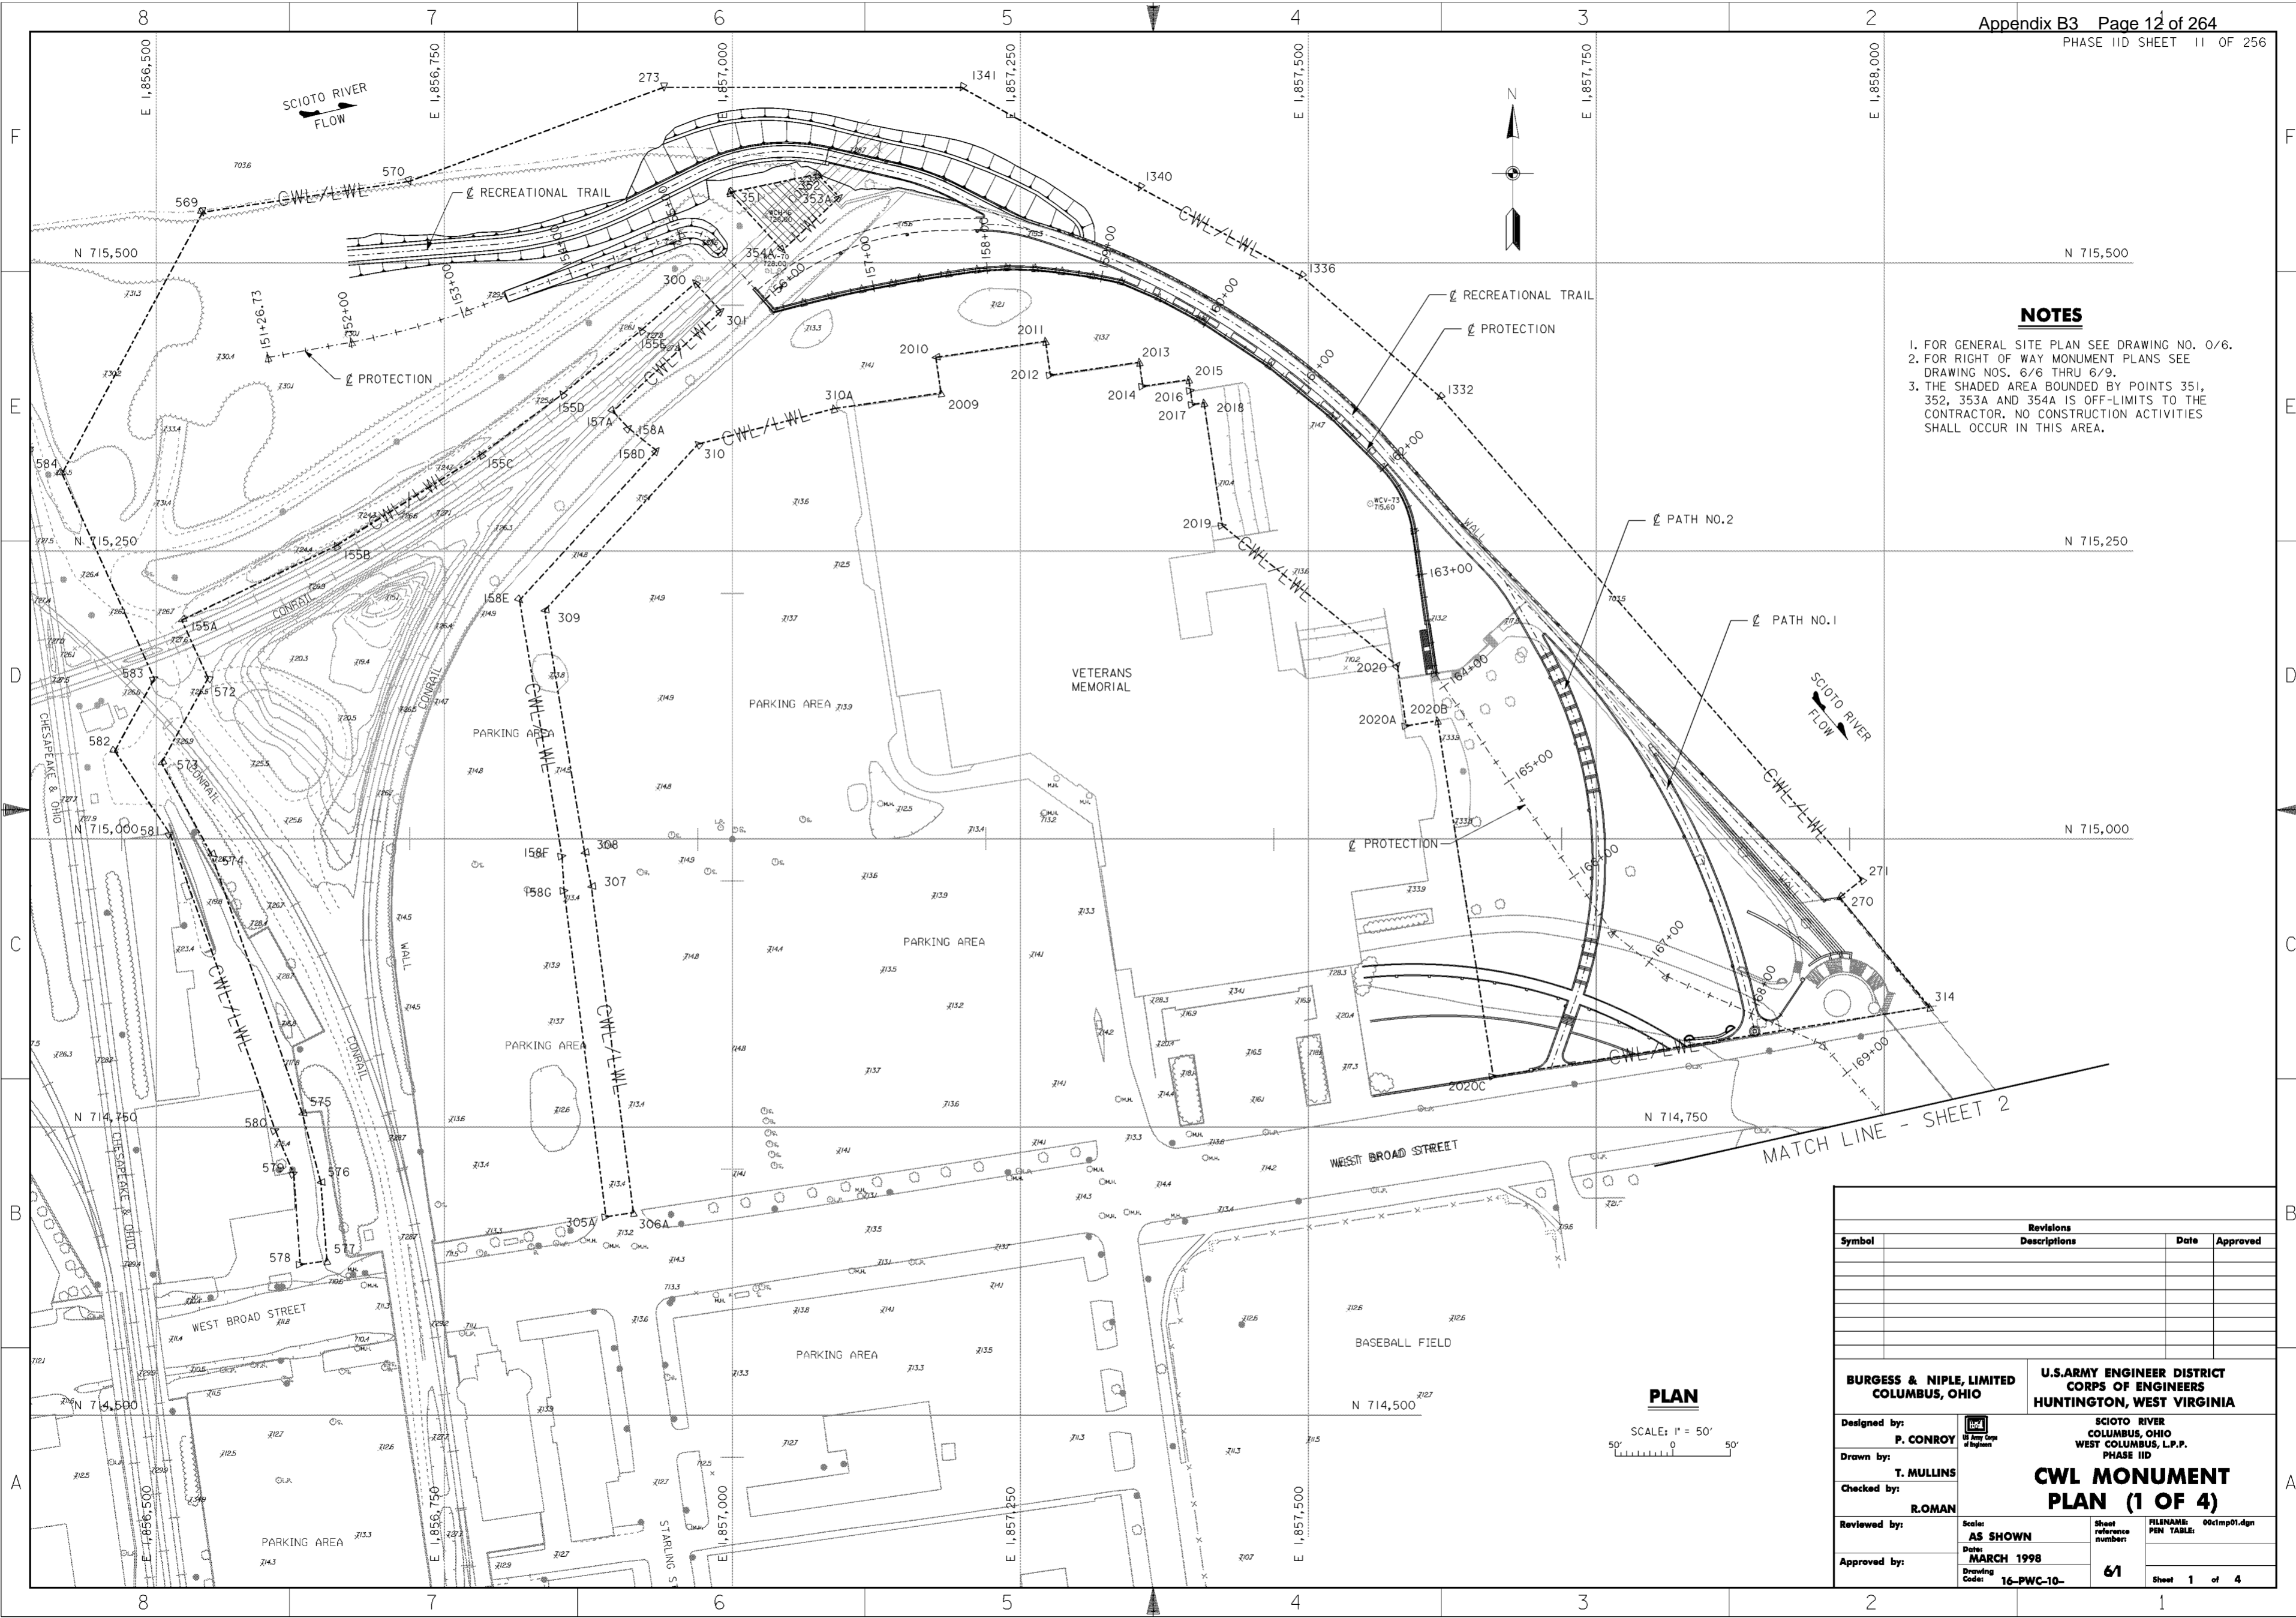


NOTES

1. FOR GENERAL SITE PLAN SEE DRAWING NO. 0/6.
2. FOR RIGHT OF WAY MONUMENT PLANS SEE DRAWING NOS. 6/6 THRU 6/9.
3. THE SHADED AREA BOUNDED BY POINTS 351, 352, 353A AND 354A IS OFF-LIMITS TO THE CONTRACTOR. NO CONSTRUCTION ACTIVITIES SHALL OCCUR IN THIS AREA.


Revisions			
Symbol	Descriptions	Date	Approved

BURGESS & NIPLÉ, LIMITED COLUMBUS, OHIO	U.S. ARMY ENGINEER DISTRICT CORPS OF ENGINEERS HUNTINGTON, WEST VIRGINIA		
		SCIOTO RIVER COLUMBUS, OHIO WEST COLUMBUS, L.P.P. PHASE IID	
Designed by: P. CONROY	<p align="center">CWL MONUMENT PLAN (1 OF 4)</p>		
Drawn by: T. MULLINS			
Checked by: ROMAN			
Reviewed by:			
Approved by:	Scale: AS SHOWN	Sheet reference number: 61	FILENAME: 00c1mp01.dgn PEN TABLE: Sheet 1 of 4
Date: MARCH 1998	Drawing Code: 16-PWC-10-		

PLAN

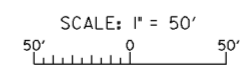

WORK AS CONSTRUCTED

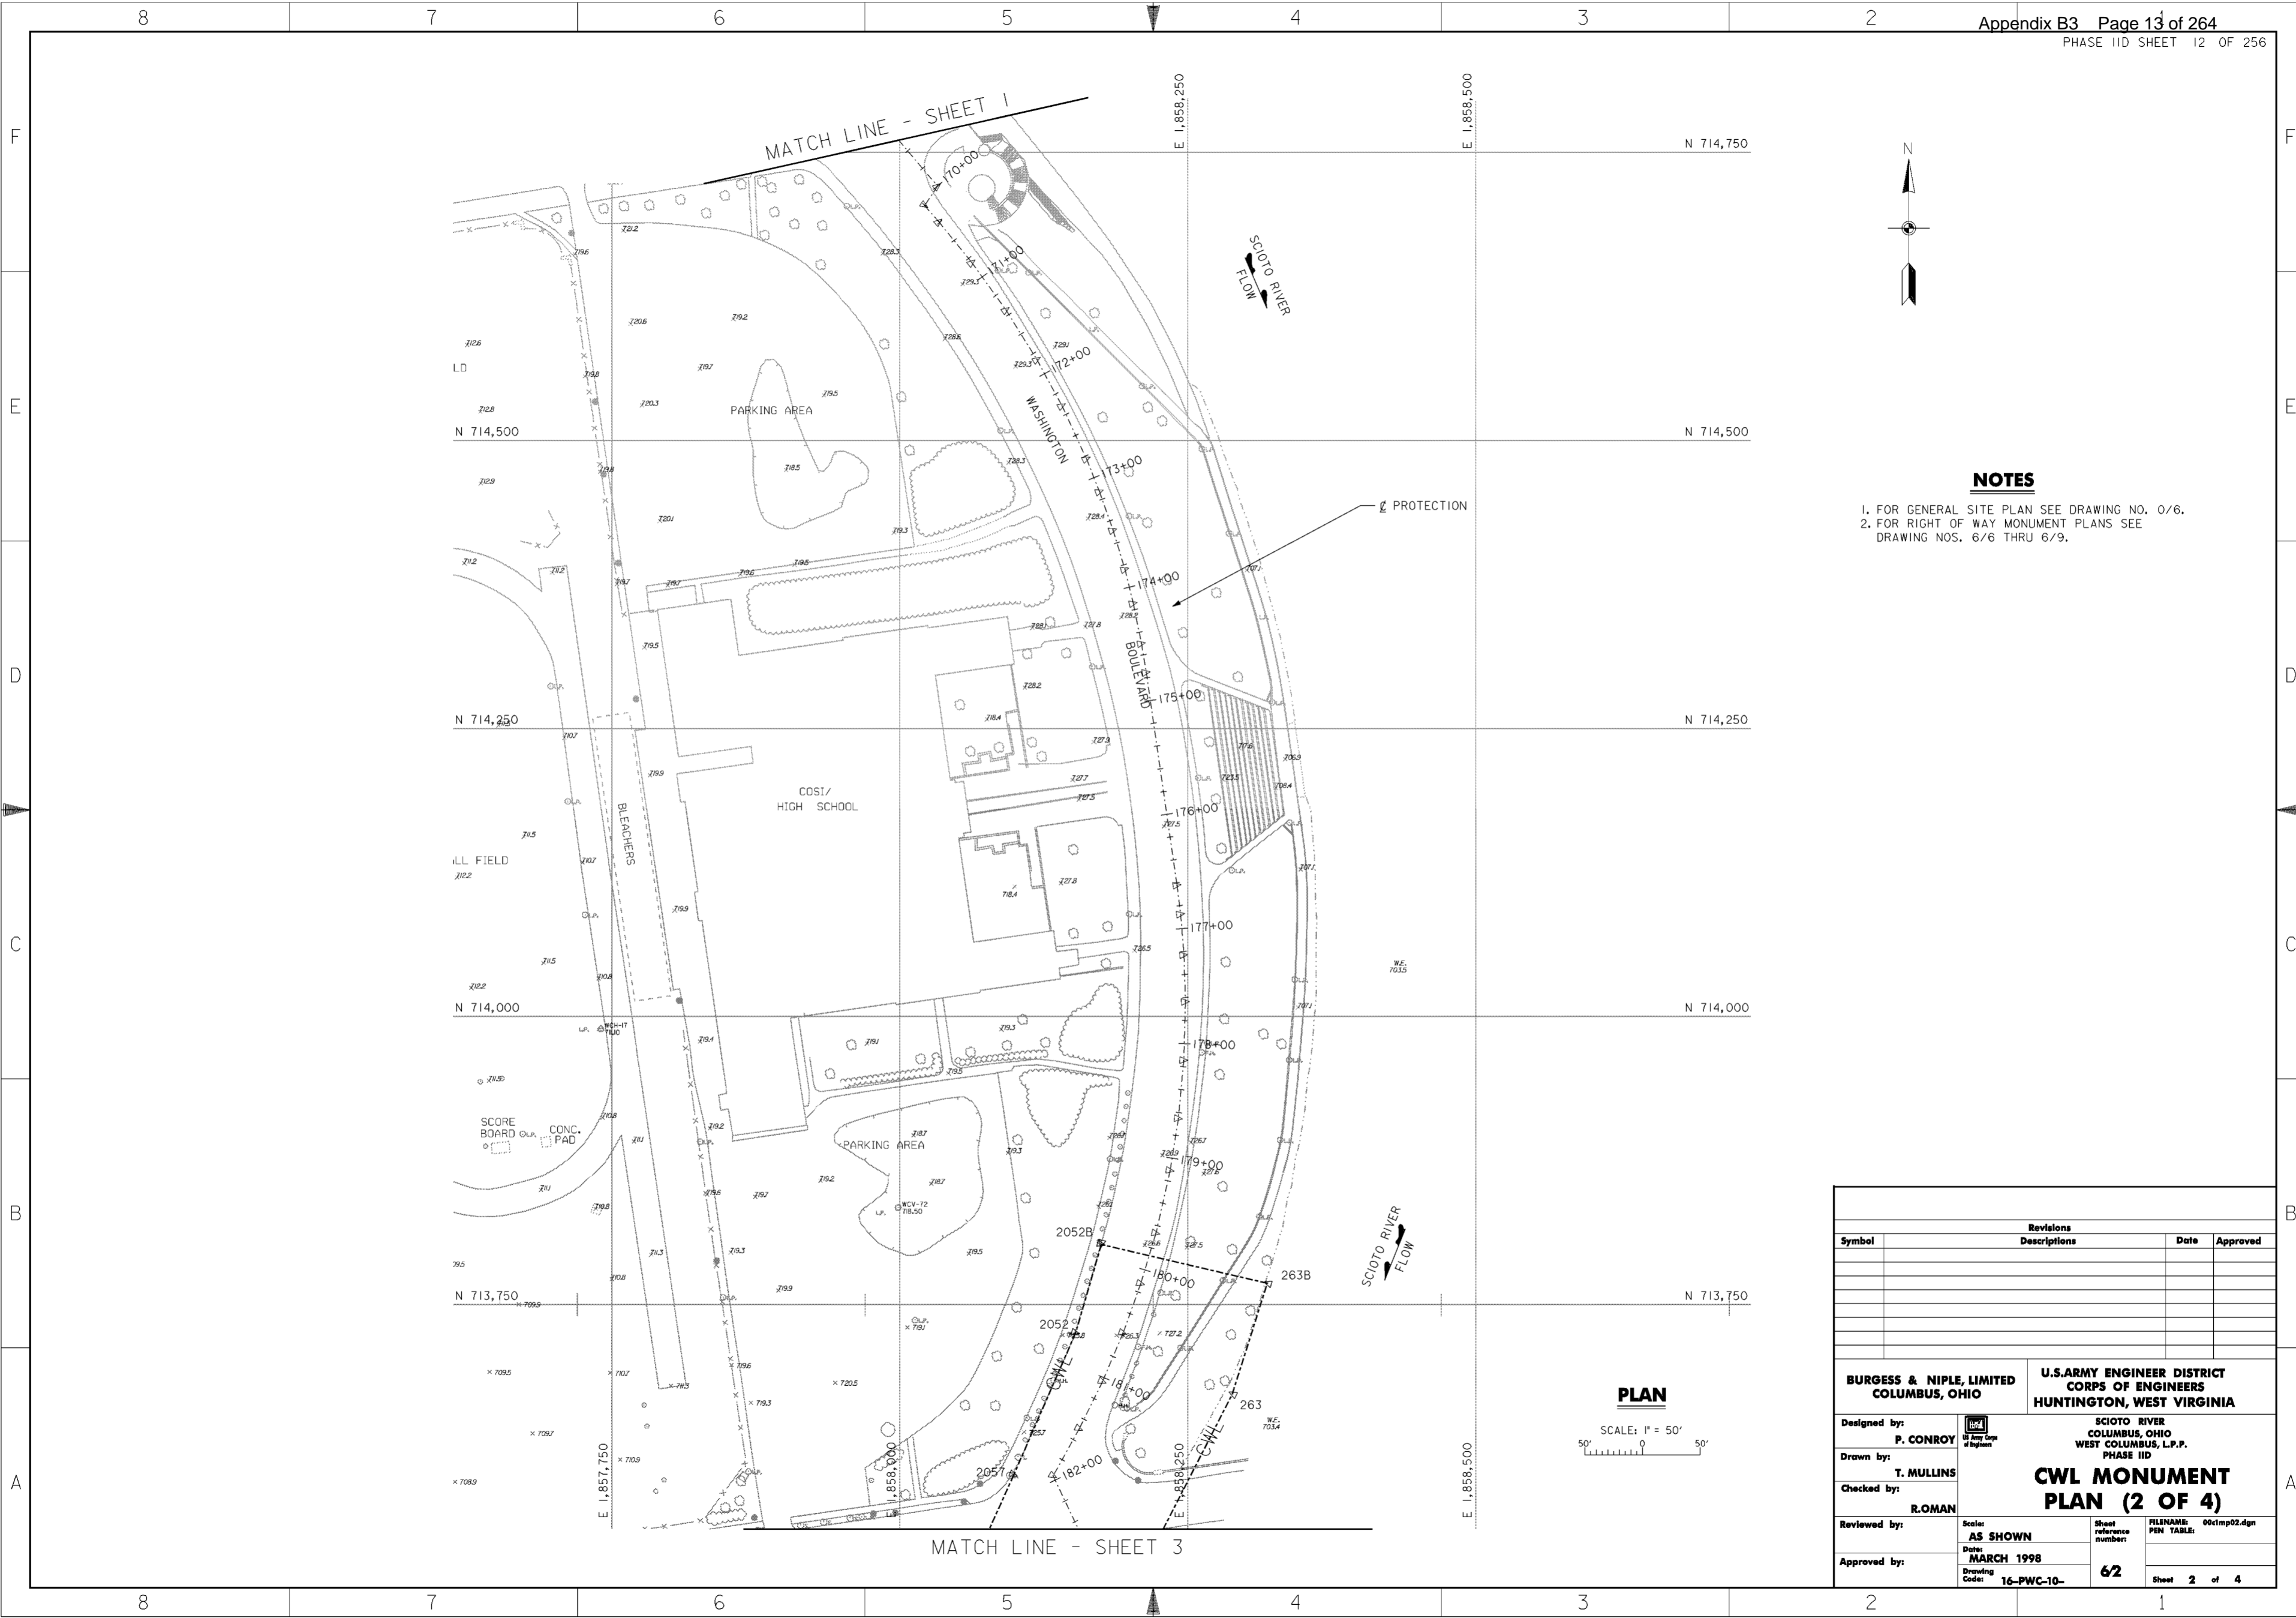

NOTES


1. FOR GENERAL SITE PLAN SEE DRAWING NO. 0/6.
2. FOR RIGHT OF WAY MONUMENT PLANS SEE DRAWING NOS. 6/6 THRU 6/9.

PLAN

SCALE: 1" = 50'

Revisions			
Symbol	Descriptions	Date	Approved

BURGESS & NIPLE, LIMITED COLUMBUS, OHIO	U.S. ARMY ENGINEER DISTRICT CORPS OF ENGINEERS HUNTINGTON, WEST VIRGINIA	SCIOTO RIVER COLUMBUS, OHIO WEST COLUMBUS, L.P.P. PHASE IID	
		CWL MONUMENT PLAN (2 OF 4)	
Designed by: P. CONROY	Scale: AS SHOWN Date: MARCH 1998 Drawing Code: 16-PWC-10-	Sheet reference number: 62	FILENAME: 00c1mp02.dgn
Drawn by: T. MULLINS		PEN TABLE:	
Checked by: R. ROMAN		Sheet 2 of 4	
Reviewed by:		Approved by:	

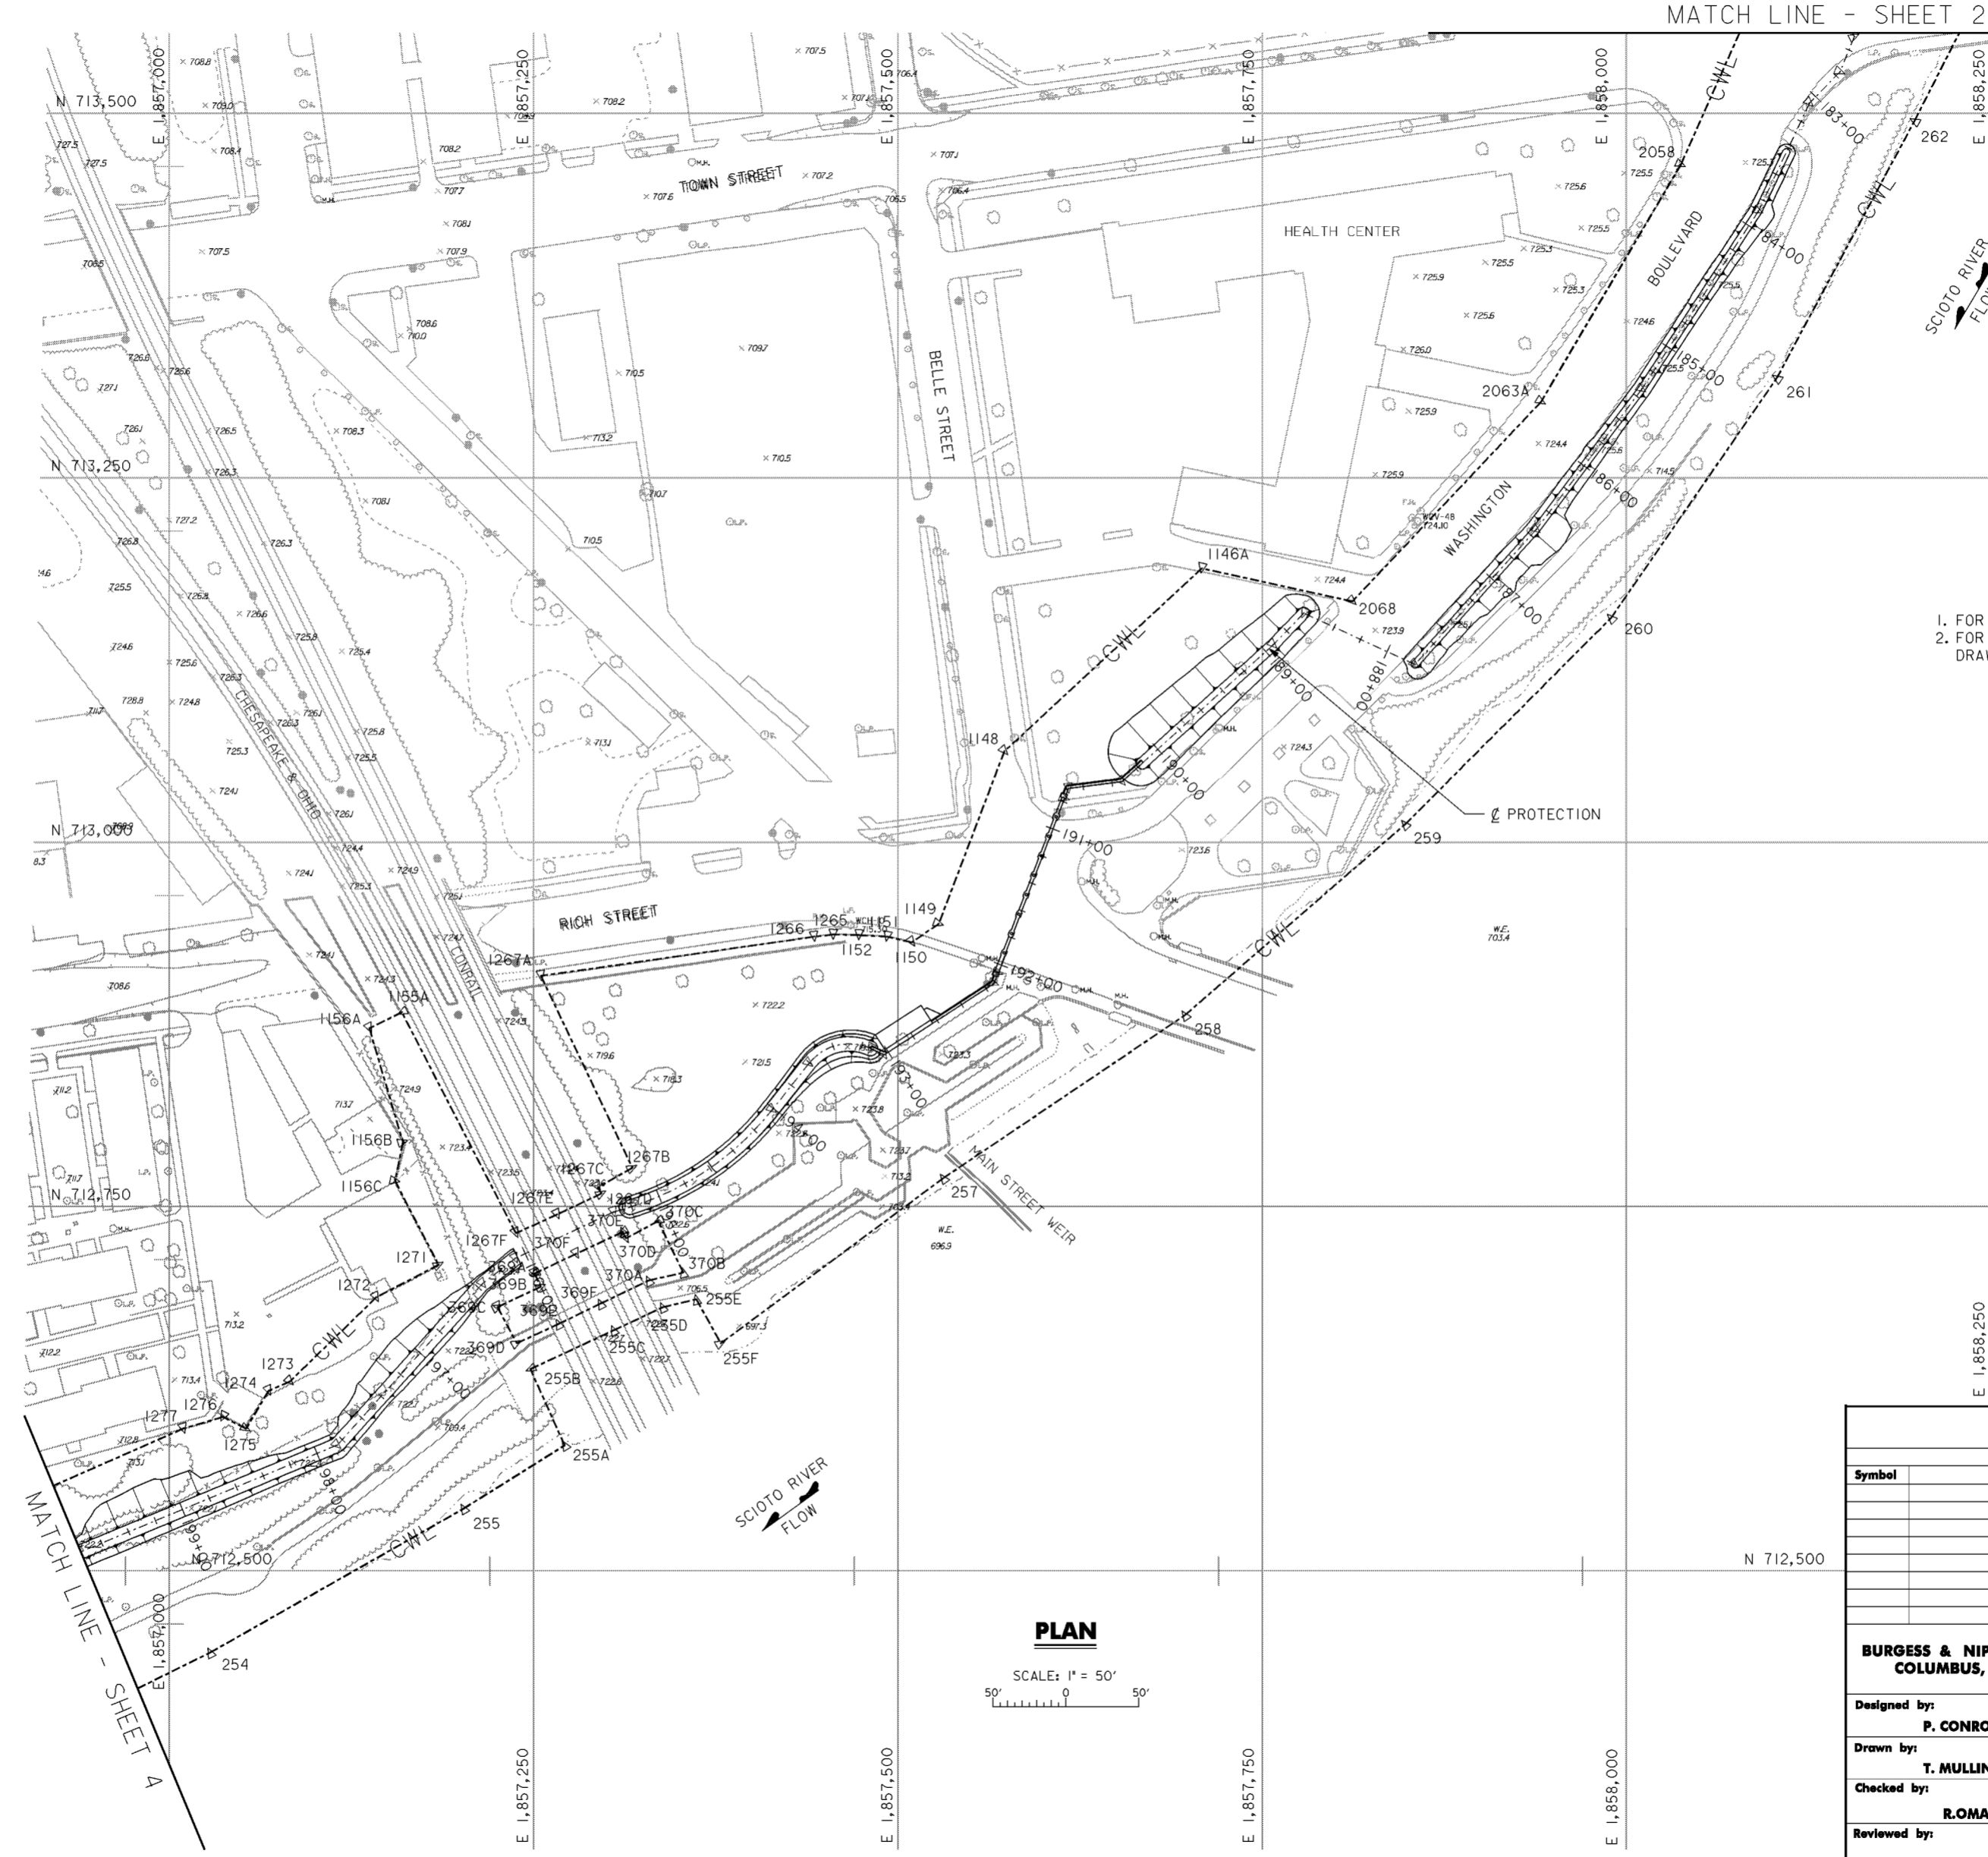

MATCH LINE - SHEET 2

MATCH LINE - SHEET 4



NOTES

1. FOR GENERAL SITE PLAN SEE DRAWING NO. 0/6.
2. FOR RIGHT OF WAY MONUMENT PLANS SEE DRAWING NOS. 6/6 THRU 6/9.


PLAN

SCALE: 1" = 50'

Revisions			
Symbol	Descriptions	Date	Approved



BURGESS & NIPLE, LIMITED COLUMBUS, OHIO		U.S. ARMY ENGINEER DISTRICT CORPS OF ENGINEERS HUNTINGTON, WEST VIRGINIA	
Designed by: P. CONROY		SCIOTO RIVER COLUMBUS, OHIO WEST COLUMBUS, L.P.P. PHASE IID	
Drawn by: T. MULLINS			
Checked by: ROMAN		CWL MONUMENT PLAN (3 OF 4)	
Reviewed by:			
Approved by:	Scale: AS SHOWN	Sheet reference number: 63	FILENAME: PEN TABLE: 00cimp03.dgn
	Date: MARCH 1998		Sheet 3 of 4
	Drawing Code: 16-PWC-10-		

WORK AS CONSTRUCTED

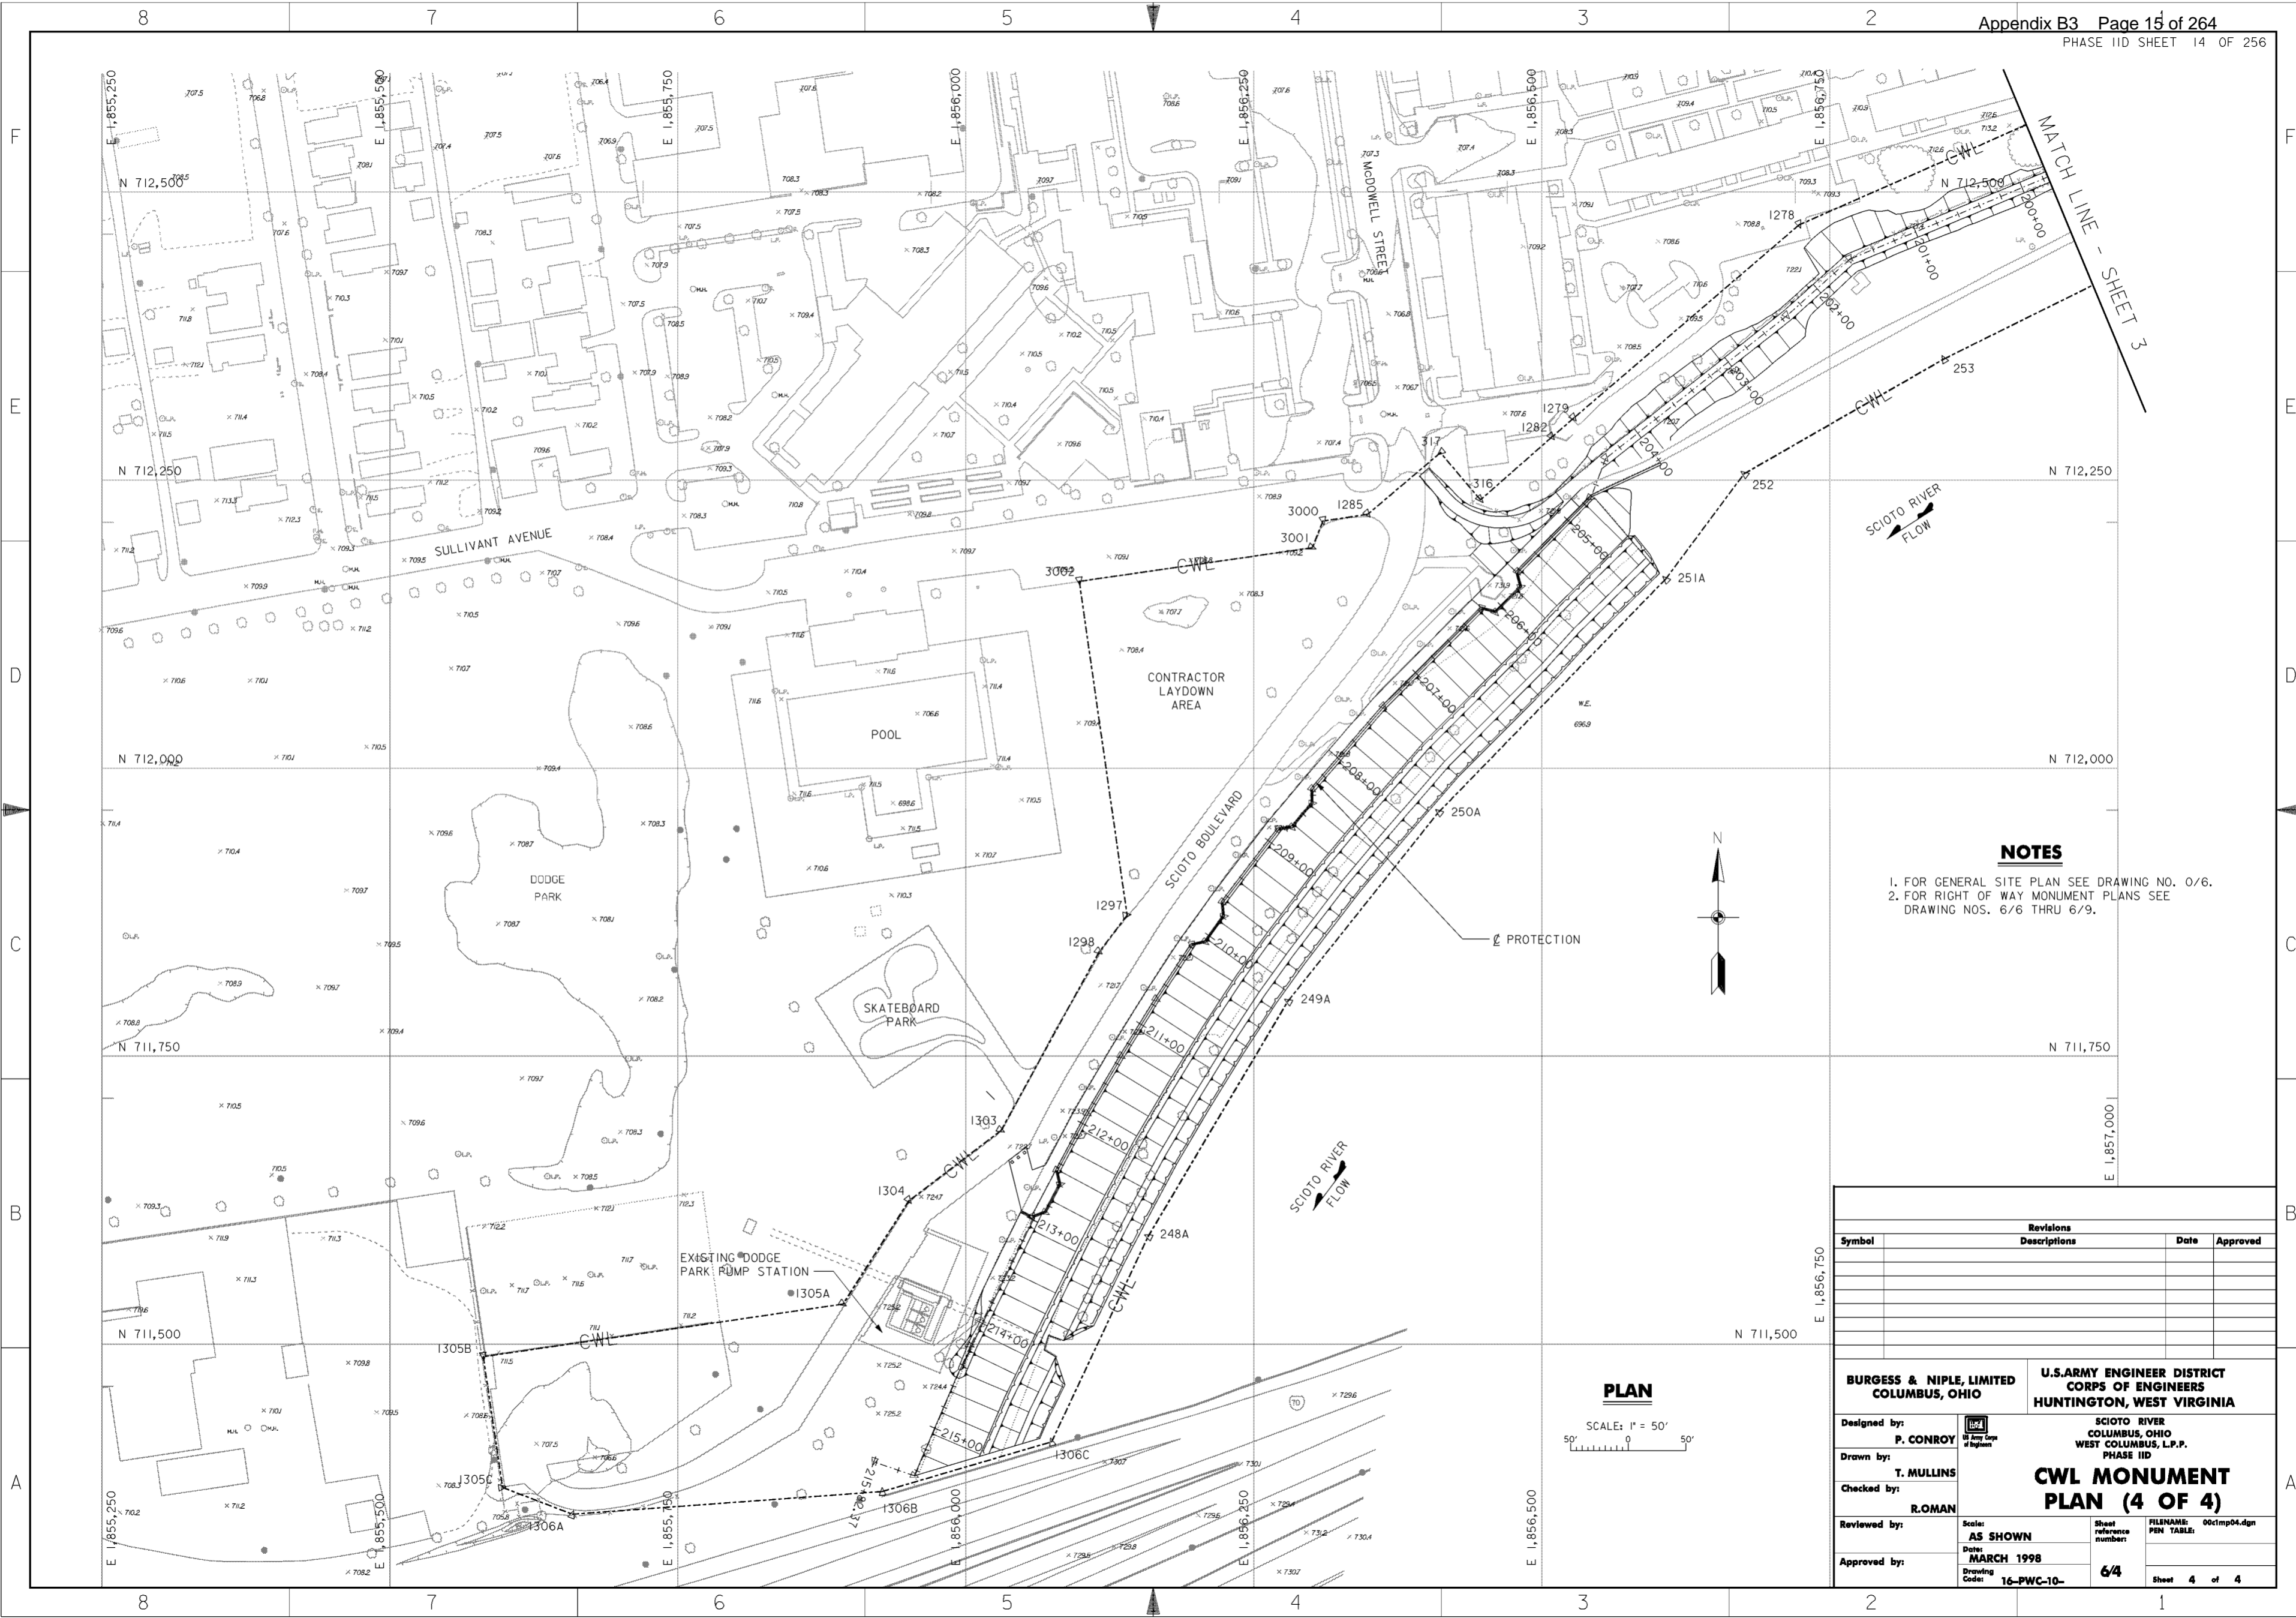

NOTES

1. FOR GENERAL SITE PLAN SEE DRAWING NO. 0/6.
2. FOR RIGHT OF WAY MONUMENT PLANS SEE DRAWING NOS. 6/6 THRU 6/9.

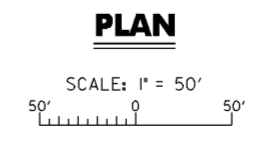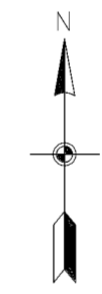

Symbol	Revisions Descriptions	Date	Approved

BURGESS & NIPLÉ, LIMITED COLUMBUS, OHIO		U.S. ARMY ENGINEER DISTRICT CORPS OF ENGINEERS HUNTINGTON, WEST VIRGINIA	
Designed by: P. CONROY		SCIOTO RIVER COLUMBUS, OHIO WEST COLUMBUS, L.P.P. PHASE IID CWL MONUMENT PLAN (4 OF 4)	
Drawn by: T. MULLINS			
Checked by: R. ROMAN	Scale: AS SHOWN	Sheet reference number: 64	FILENAME: PEN TABLE: 00c1mp04.dgn
Reviewed by:	Date: MARCH 1998	Drawing Code: 16-PWC-10-	Sheet 4 of 4
Approved by:			

WORK AS CONSTRUCTED

CWL MONUMENT TABLES

CWL/LWL NORTH OF BROAD STREET

POINT#	EASTING	NORTHING	BEARING	DISTANCE
569	1856540.24700	715544.29500	S 28°19'24.83" W	257.59918
584	1856418.02900	715317.53500	S 24°15'56.44" E	195.38976
583	1856498.32800	715139.40800	S 28°46'57.94" W	71.54873
582	1856463.87800	715076.69900	S 33°38'01.70" E	86.70967
581	1856511.90500	715004.50500	S 19°32'43.55" E	272.93337
580	1856603.21600	714747.29900	S 23°05'56.12" E	40.98697
579	1856619.29600	714709.59800	S 4°08'42.76" E	78.91043
578	1856625.00000	714630.89400	N 81°54'39.12" E	23.33821
577	1856648.10600	714634.17800	N 4°32'56.24" W	68.17476
576	1856642.69900	714702.13800	N 15°02'12.91" W	61.67482
575	1856626.69800	714761.70100	N 19°19'54.30" W	238.41118
574	1856547.77500	714986.67000	N 28°31'05.77" W	90.71945
573	1856504.46200	715066.38200	N 28°46'56.46" E	83.93015
572	1856544.87300	715139.94300	N 24°15'58.51" W	55.29013
155A	1856522.15000	715190.34800	N 64°19'33.95" E	148.60290
155B	1856656.08200	715254.73000	N 57°48'23.23" E	148.60328
155C	1856781.83800	715333.90300	N 53°21'58.88" E	87.84035
155D	1856852.32700	715386.31700	N 51°00'24.77" E	87.84111
155E	1856920.59900	715441.58900	N 48°51'59.42" E	62.70754
300	1856967.82900	715482.83900	S 42°18'19.49" E	33.16533
301	1856990.15200	715458.31100	S 47°11'30.03" W	127.85853
157A	1856896.35100	715371.42500	S 42°48'35.21" E	20.00099
158A	1856909.94300	715356.75200	S 51°17'37.12" E	31.14200
158D	1856934.24500	715337.27800	S 42°30'43.15" W	175.93633
158E	1856815.35700	715207.58900	S 9°23'25.56" E	225.36604
158F	1856852.12800	714985.24300	S 3°28'27.16" E	30.13238
158G	1856853.95400	714955.16600	S 7°20'03.84" E	285.17128
305A	1856890.35900	714672.32800	N 81°03'58.84" E	24.00015
306A	1856914.06800	714676.05500	N 7°19'56.57" W	285.13974
307	1856877.67700	714958.86300	N 11°12'39.98" W	30.01680
308	1856871.84100	714988.30700	N 9°22'21.61" W	213.28131
309	1856837.10700	715198.74100	N 42°41'41.65" E	196.28833
310	1856970.20900	715343.00800	N 75°23'56.20" E	121.86261
310A	1857088.13600	715373.72800	N 81°37'29.69" E	94.06614
2009	1857181.19900	715387.42900	N 8°22'26.77" W	31.24917
2010	1857176.64800	715418.34500	N 81°37'29.83" E	96.26357
2011	1857271.88500	715432.36600	S 8°22'33.54" E	29.88982
2012	1857276.23900	715402.79500	N 81°37'30.46" E	77.92699
2013	1857353.33500	715414.14500	S 8°22'34.80" E	21.22542
2014	1857356.42700	715393.14600	N 81°37'31.07" E	40.28254
2015	1857396.28000	715399.01300	S 8°22'33.62" E	9.72069
2016	1857397.69600	715389.39600	S 8°22'25.05" E	12.27789
2017	1857399.48400	715377.24900	N 80°36'34.93" E	10.06994
2018	1857409.41900	715378.89200	S 8°32'13.84" E	107.80652
2019	1857425.42300	715272.28000	S 51°23'38.11" E	194.35942
2020	1857577.30600	715151.00700	S 8°14'22.99" E	53.14865
2020A	1857584.92300	715098.40700	N 80°20'30.64" E	27.65700
2020B	1857612.18800	715103.04700	S 8°54'00.35" E	312.61298
2020C	1857660.55300	714794.19800	N 80°58'53.94" E	383.63442
314	1858039.44500	714854.33300	N 39°20'41.18" W	123.12745
270	1857961.38400	714949.55300	N 51°03'45.06" E	24.49114
271	1857980.43400	714964.94500	N 41°08'29.67" W	556.29914
1332	1857614.43262	715383.88620	N 48°55'23.27" W	159.65739
1336	1857494.07830	715488.79244	N 61°17'20.40" W	159.73308
1340	1857353.98377	715565.52692	N 60°40'38.20" W	177.35771
1341	1857199.35000	715652.38400	N 89°56'16.69" W	258.62815
273	1856940.72200	715652.66400	S 69°44'00.96" W	235.76040
570	1856719.55700	715571.00000	S 81°31'44.72" W	181.28771

LWL AT CONRAIL EAST RR

POINT#	EASTING	NORTHING	BEARING	DISTANCE
351	1856997.72900	715561.55700	N 78°18'32.84" E	78.16656
352	1857074.27400	715577.39600	S 42°30'28.87" E	27.53320
353A	1857092.87800	715557.09900	S 47°01'11.06" W	67.37256
354A	1857043.58900	715511.16800	N 42°18'21.36" W	68.13363

CWL SOUTH OF COSI


POINT#	EASTING	NORTHING	BEARING	DISTANCE
2052B	1858174.81100	713802.43700	S 16°14'33.99" W	79.95124
2052	1858152.44800	713725.67700	S 23°35'12.85" W	134.32313
2057	1858098.70000	713602.57600	S 24°02'08.64" W	150.67039
2058	1858037.33100	713464.97000	S 30°31'57.95" W	188.77589
2063A	1857941.42700	713302.37000	S 43°24'12.88" W	188.50793
2068	1857811.89700	713165.41300	N 77°42'10.32" W	105.76976
1146A	1857708.55400	713187.94000	S 47°12'54.35" W	184.63001
1148	1857573.05240	713062.53045	S 20°51'16.05" W	126.64632
1149	1857527.96690	712944.18102	S 55°14'49.41" W	22.46166
1150	1857509.51200	712931.37700	N 77°30'56.04" W	17.36561
1151	1857492.55700	712935.13100	N 86°24'52.06" W	19.41200
1152	1857473.18300	712936.34500	N 89°15'29.30" W	17.60948
1265	1857455.57500	712936.57300	S 83°43'31.02" W	13.23931
1266	1857442.41500	712935.12600	S 81°49'50.19" W	189.32421
1267A	1857255.01200	712908.22300	S 25°29'16.45" E	145.85408
1267B	1857237.79600	712776.56400	S 60°44'51.51" W	27.18471
1267C	1857294.05800	712763.28000	S 29°13'22.11" E	4.99583
1267D	1857296.49700	712758.92000	S 64°43'36.83" W	33.63991
1267E	1857266.07700	712744.55800	S 65°35'58.98" W	31.05476
1267F	1857237.79600	712731.72900	N 27°16'05.35" W	170.55998
1155A	1857159.65300	712883.33500	S 63°40'14.33" W	25.00392
1156A	1857137.24300	712872.24500	S 16°30'08.40" E	81.24148
1156B	1857160.32000	712794.35000	S 11°28'09.01" W	27.25393
1156C	1857154.90081	712767.64028	S 27°31'22.44" E	64.85164
1271	1857184.86896	712710.12815	S 62°28'37.51" W	48.43122
1272	1857141.91889	712687.74792	S 45°42'47.49" W	82.65855
1273	1857082.74747	712630.03154	S 66°13'45.20" W	15.96851
1274	1857068.13365	712623.59498	S 30°47'43.29" W	30.17966
1275	1857052.68247	712597.67061	N 62°42'56.85" W	17.81541
1276	1857036.84914	712605.83728	S 73°35'35.61" W	28.40804
1277	1857009.59785	712597.81329	S 66°13'45.24" W	312.88199
1278	1856723.25907	712471.69731	S 49°23'55.34" W	257.78377
1279	1856527.53504	712303.93385	S 49°15'45.88" W	25.12858
1282	1856508.49487	712287.53517	S 48°39'20.38" W	82.48499
316	1856446.56900	712233.04700	N 40°14'03.89" W	53.61221
317	1856411.94000	712273.97500	S 49°45'57.59" W	82.89224
1285	1856348.65900	712220.43400	S 81°28'05.34" W	39.14823
3000	1856309.94400	712214.62600	S 21°50'07.97" W	24.93388
3001	1856300.67000	712191.48100	S 81°47'45.31" W	204.38062
3002	1856098.38100	712162.31600	S 8°08'45.65" E	292.79525
1297	1856139.86900	711872.47500	S 37°21'16.64" W	40.00023
1298	1856115.59900	711840.67900	S 28°47'09.58" W	176.72488
1303	1856030.49900	711685.79300	S 52°41'47.03" W	100.69329
1304	1855950.40400	711624.76900	S 32°26'13.12" W	106.34232
1305A	1855893.36500	711535.01800	S 81°40'28.35" W	315.72728
1305B	1855580.96500	711489.30200	S 8°24'16.83" E	114.67961
1305C	1855597.72700	711375.85400	S 68°58'46.45" E	64.78101
1306A	1855658.19700	711352.61700	N 85°48'11.34" E	269.88369
1306B	1855927.35700	711372.36800	N 73°36'44.34" E	153.12162
1306C	1856074.25800	711415.56900	N 25°11'00.87" E	196.70057
248A	1856157.95800	711593.57300	N 30°43'48.27" E	237.49390
249A	1856279.31600	711797.71900	N 38°34'17.63" E	209.99961
250A	1856410.24900	711961.90300	N 44°15'24.39" E	282.32270
251A	1856607.27500	712164.10800	N 36°39'32.28" E	114.03217
252	1856675.35800	712255.58500	N 60°07'25.38" E	200.00046
253	1856848.77900	712355.21100	N 63°38'19.62" E	200.00055
254	1857027.98200	712444.01700	N 60°23'50.62" E	199.99943
255	1857201.87600	712542.81300	N 57°55'08.23" E	81.95349
255A	1857271.31500	712586.34000	N 24°15'55.95" W	57.30156
255B	1857247.76600	712638.57900	N 65°01'46.02" E	62.88961
255C	1857304.77700	712665.12800	N 64°54'28.18" E	37.19855
255D	1857338.46500	712680.90300	N 76°46'37.92" E	23.88319
255E	1857361.71500	712686.36600	S 29°06'30.91" E	34.53476
255F	1857378.51500	712656.19300	N 53°25'27.47" E	189.96470
257	1857531.07000	712769.39000	N 55°59'04.42" E	199.99955
258	1857696.84700	712881.27300	N 49°01'54.00" E	199.99945
259	1857847.86100	713012.40100	N 44°58'46.35" E	200.00022

CWL SOUTH OF COSI

POINT#	EASTING	NORTHING	BEARING	DISTANCE
260	1857989.23200	713153.87300	N 34°38'11.68" E	200.00032
261	1858102.90600	713318.42800	N 28°13'02.92" E	200.00017
262	1858197.47000	713494.66000	N 27°04'30.79" E	200.00006
263	1858288.50200	713672.74200	N 17°33'50.61" E	100.63562
263B	1858318.87100	713768.68600	N 76°48'51.53" W	147.96085

LWL AT CONRAIL/CSX RR

POINT#	EASTING	NORTHING	BEARING	DISTANCE
369C	1857225.21400	712681.04000	S 28°10'24.18" E	28.05940
369D	1857238.46200	712656.30500	N 65°09'10.09" E	31.43267
369E	1857266.98500	712669.51300	N 64°23'07.04" E	32.05979
369F	1857295.89400	712683.37300	N 64°23'11.57" E	36.59517
370A	1857328.89300	712699.19300	N 76°45'16.29" E	24.49770
370B	1857352.73900	712704.80600	N 25°58'35.19" W	39.35374
370C	1857335.50200	712740.18400	S 61°33'15.84" W	25.15724
370D	1857313.38200	712728.20100	N 28°27'27.48" W	4.99676

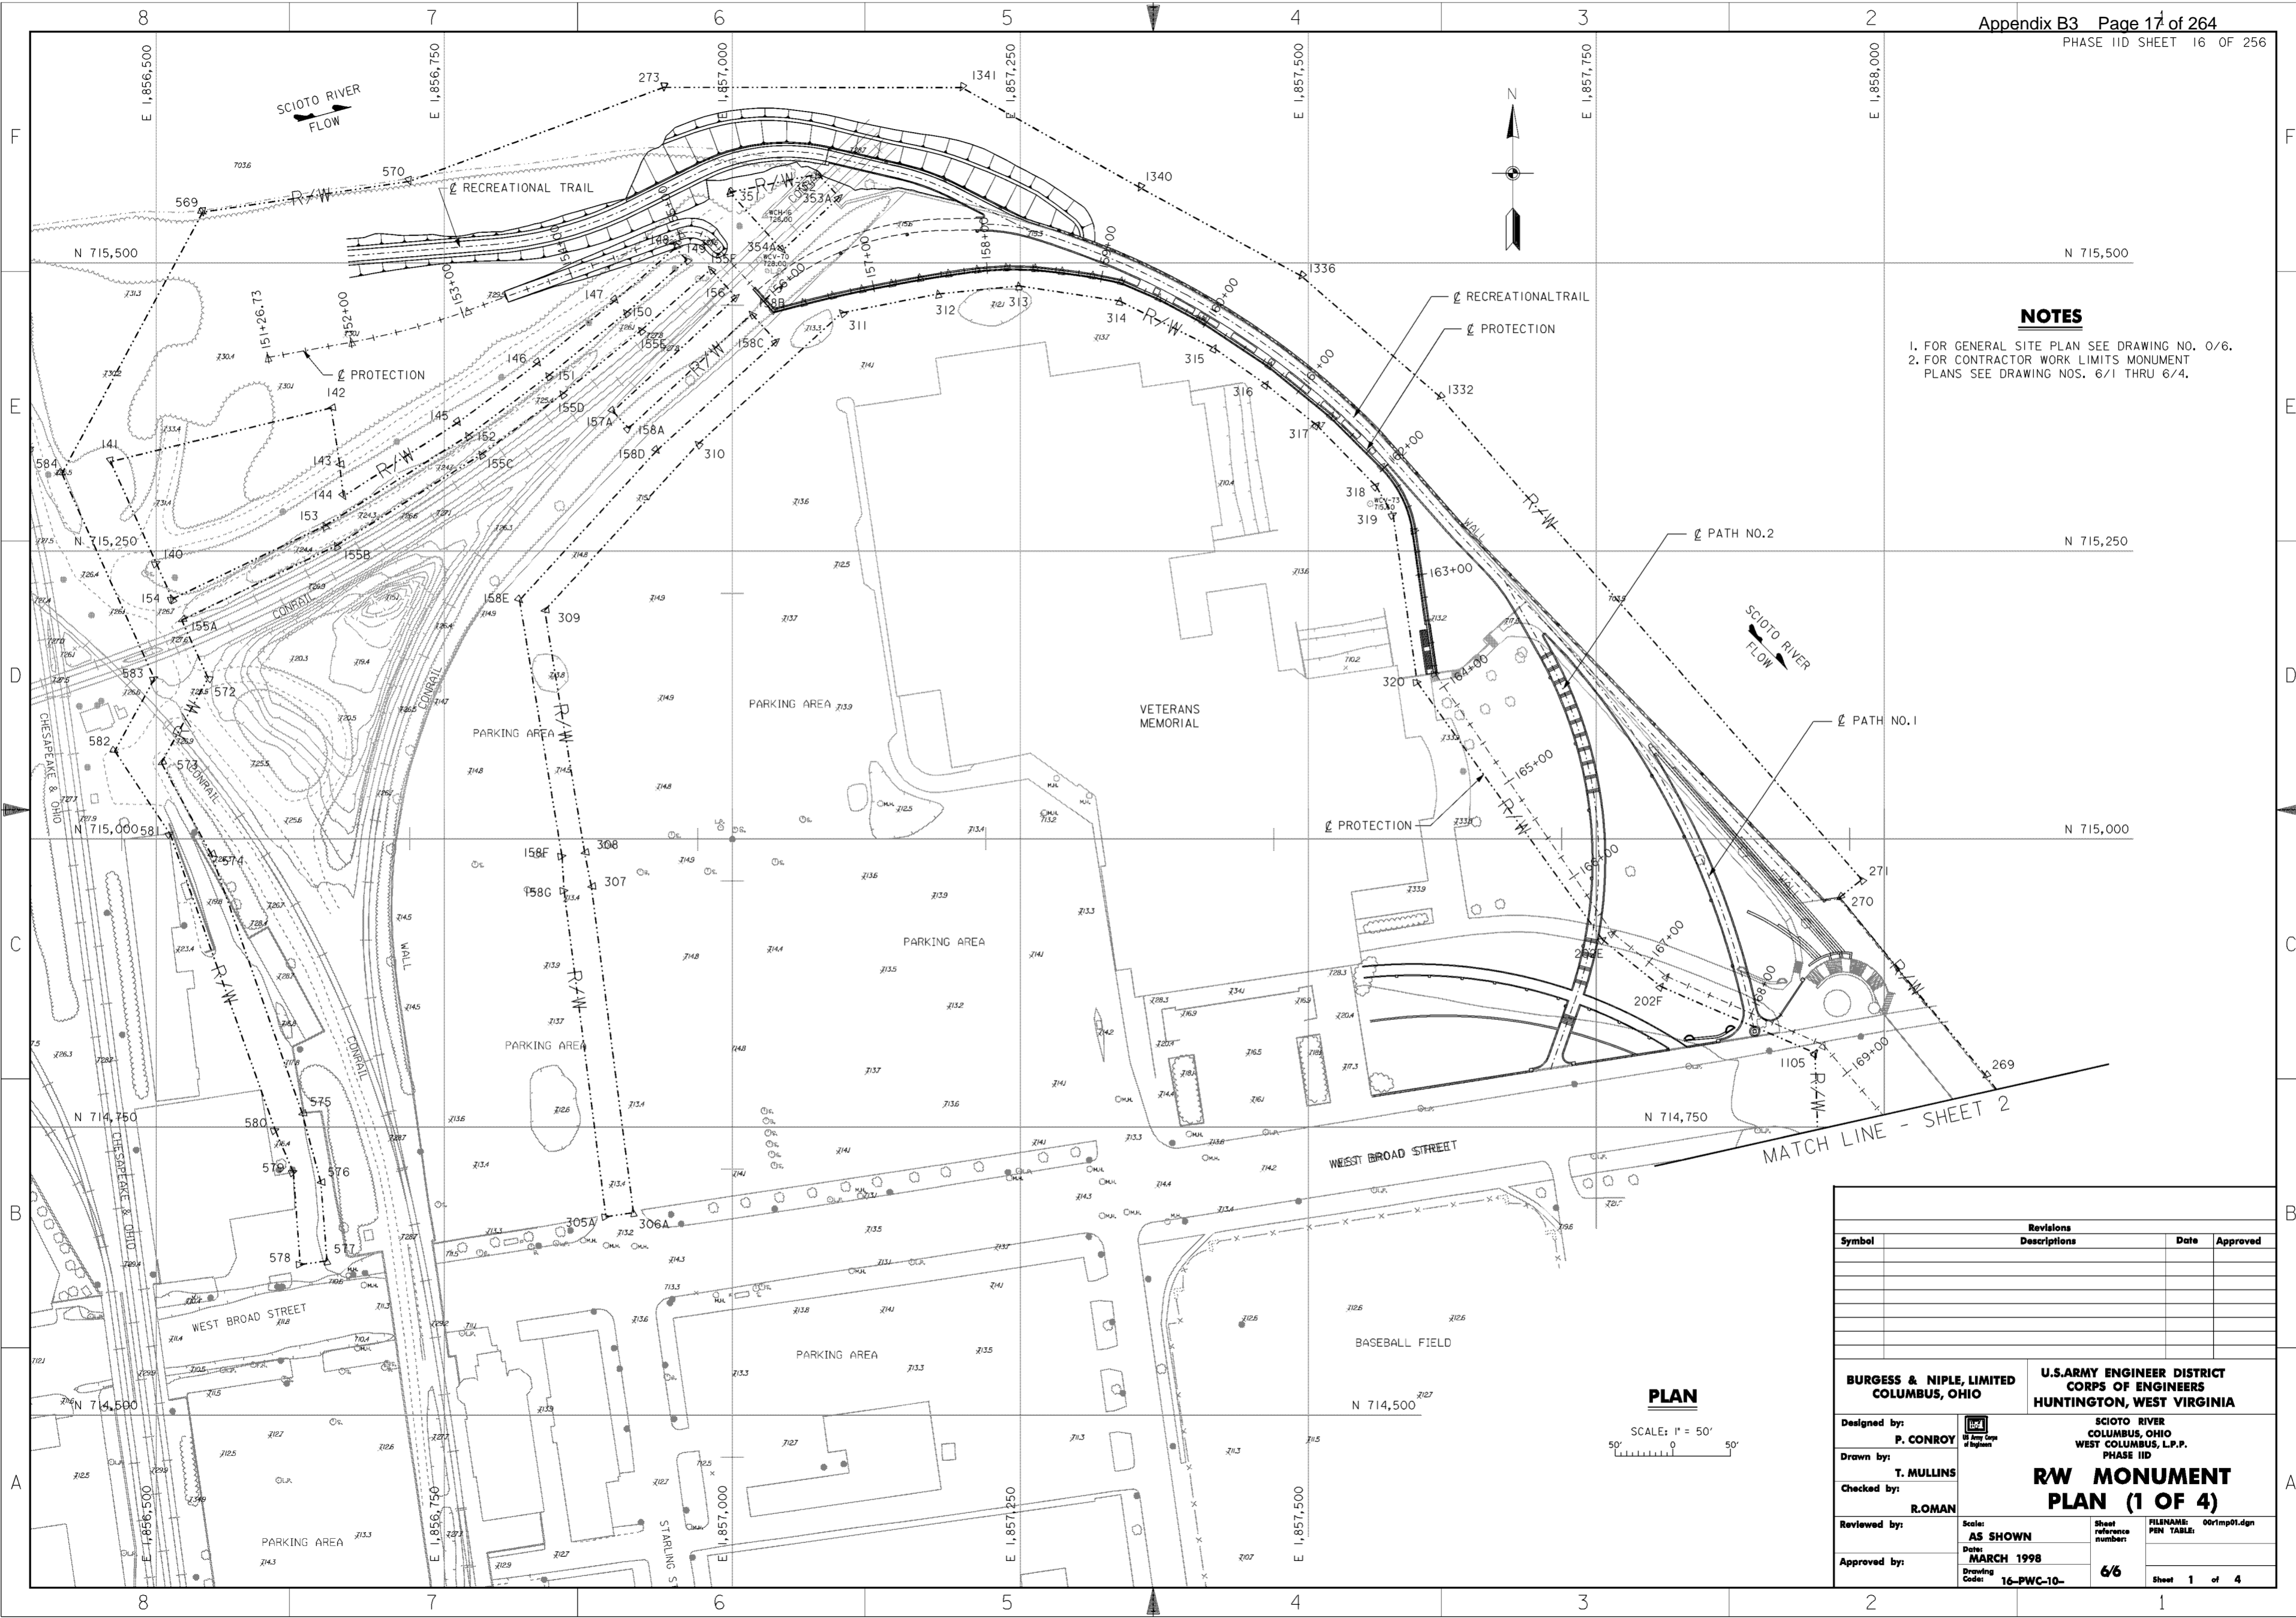

NOTES

1. FOR GENERAL SITE PLAN SEE DRAWING NO. 0/6.
2. FOR CONTRACTOR WORK LIMITS MONUMENT PLANS SEE DRAWING NOS. 6/1 THRU 6/4.


PLAN

SCALE: 1" = 50'


Revisions			
Symbol	Descriptions	Date	Approved

BURGESS & NIPLE, LIMITED COLUMBUS, OHIO	U.S. ARMY ENGINEER DISTRICT CORPS OF ENGINEERS HUNTINGTON, WEST VIRGINIA		
		SCIOTO RIVER COLUMBUS, OHIO WEST COLUMBUS, L.P.P. PHASE IID	
Designed by: P. CONROY	<p align="center">RW MONUMENT PLAN (1 OF 4)</p>		
Drawn by: T. MULLINS			
Checked by: ROMAN			
Reviewed by:			
Approved by:	Scale: AS SHOWN	Sheet reference number: 6/6	FILENAME: 00r1mp01.dgn
Date: MARCH 1998	Drawing Code: 16-PWC-10-	Sheet 1 of 4	PEN TABLE:

WORK AS CONSTRUCTED

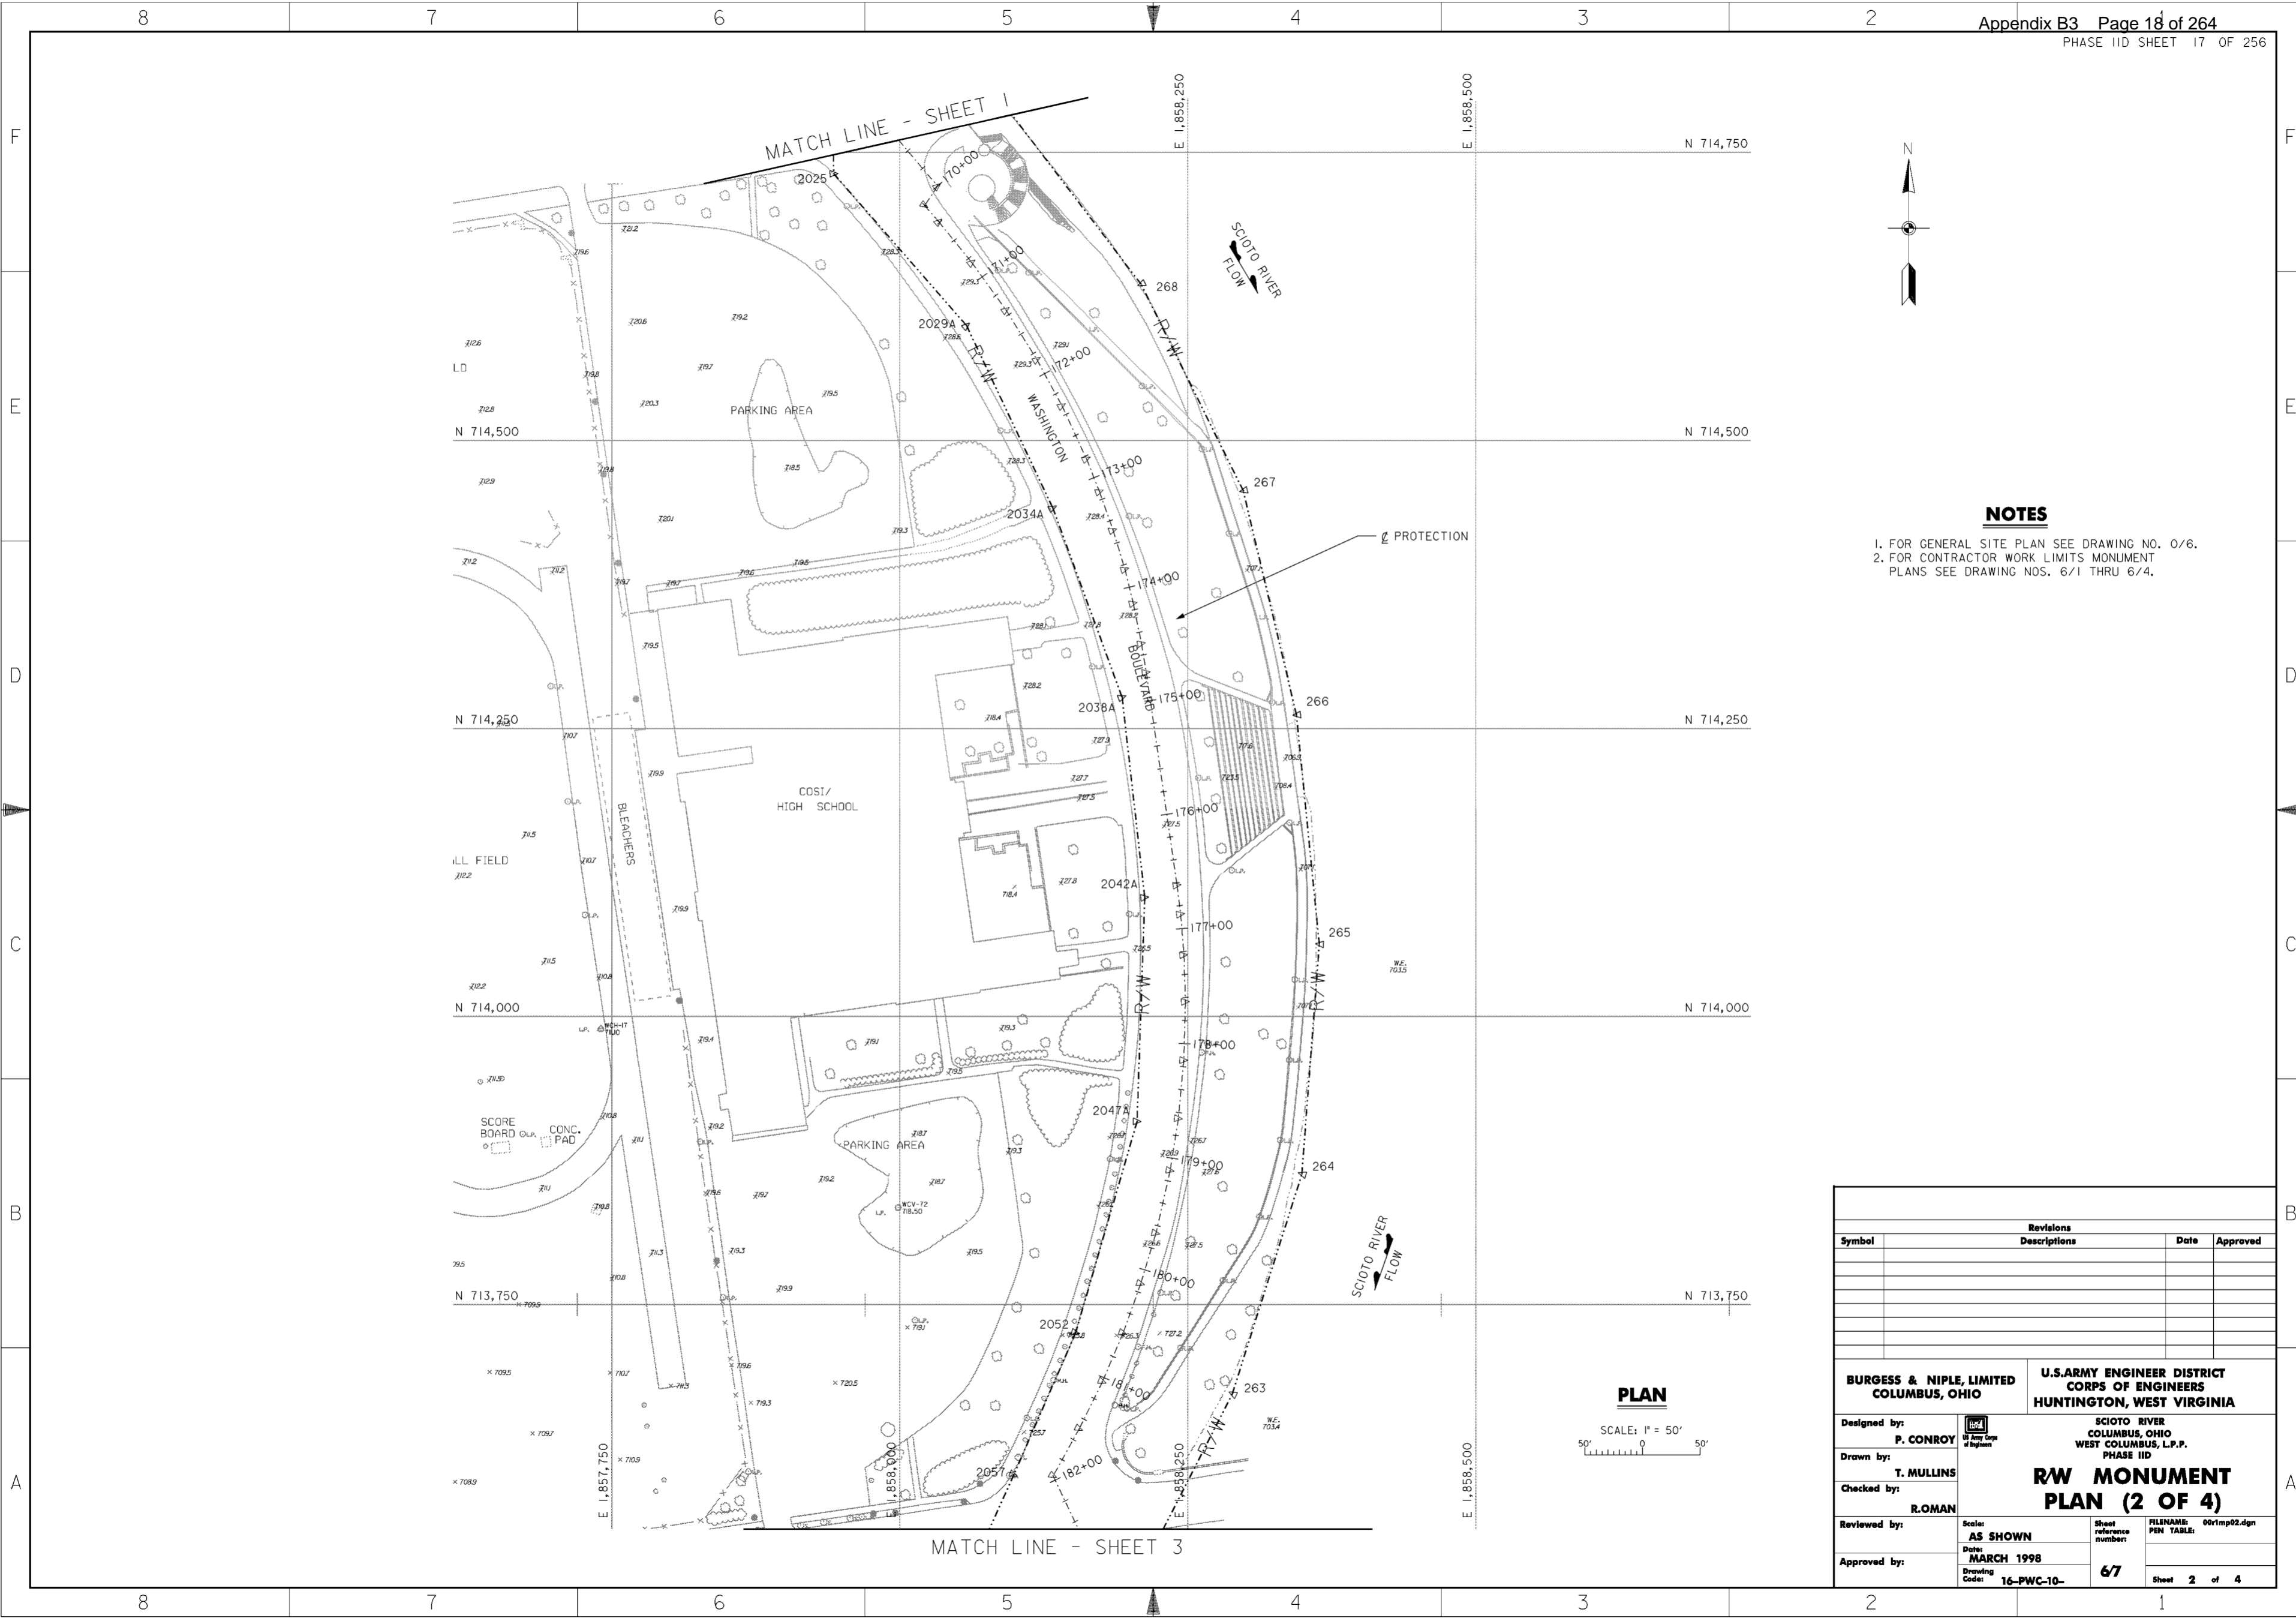

- NOTES**
1. FOR GENERAL SITE PLAN SEE DRAWING NO. 0/6.
 2. FOR CONTRACTOR WORK LIMITS MONUMENT PLANS SEE DRAWING NOS. 6/1 THRU 6/4.


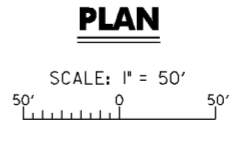


Revisions			
Symbol	Descriptions	Date	Approved

BURGESS & NIPLE, LIMITED COLUMBUS, OHIO	U.S. ARMY ENGINEER DISTRICT CORPS OF ENGINEERS HUNTINGTON, WEST VIRGINIA	
Designed by: P. CONROY	SCIOTO RIVER COLUMBUS, OHIO WEST COLUMBUS, L.P.P. PHASE IID RW MONUMENT PLAN (2 OF 4)	
Drawn by: T. MULLINS		
Checked by: R. ROMAN		
Reviewed by:		
Approved by:	Scale: AS SHOWN Date: MARCH 1998 Drawing Code: 16-PWC-10-	Sheet reference number: 67 FILENAME: 00r1mp02.dgn PEN TABLE: Sheet 2 of 4

WORK AS CONSTRUCTED

MATCH LINE - SHEET 2

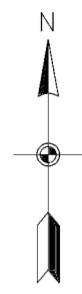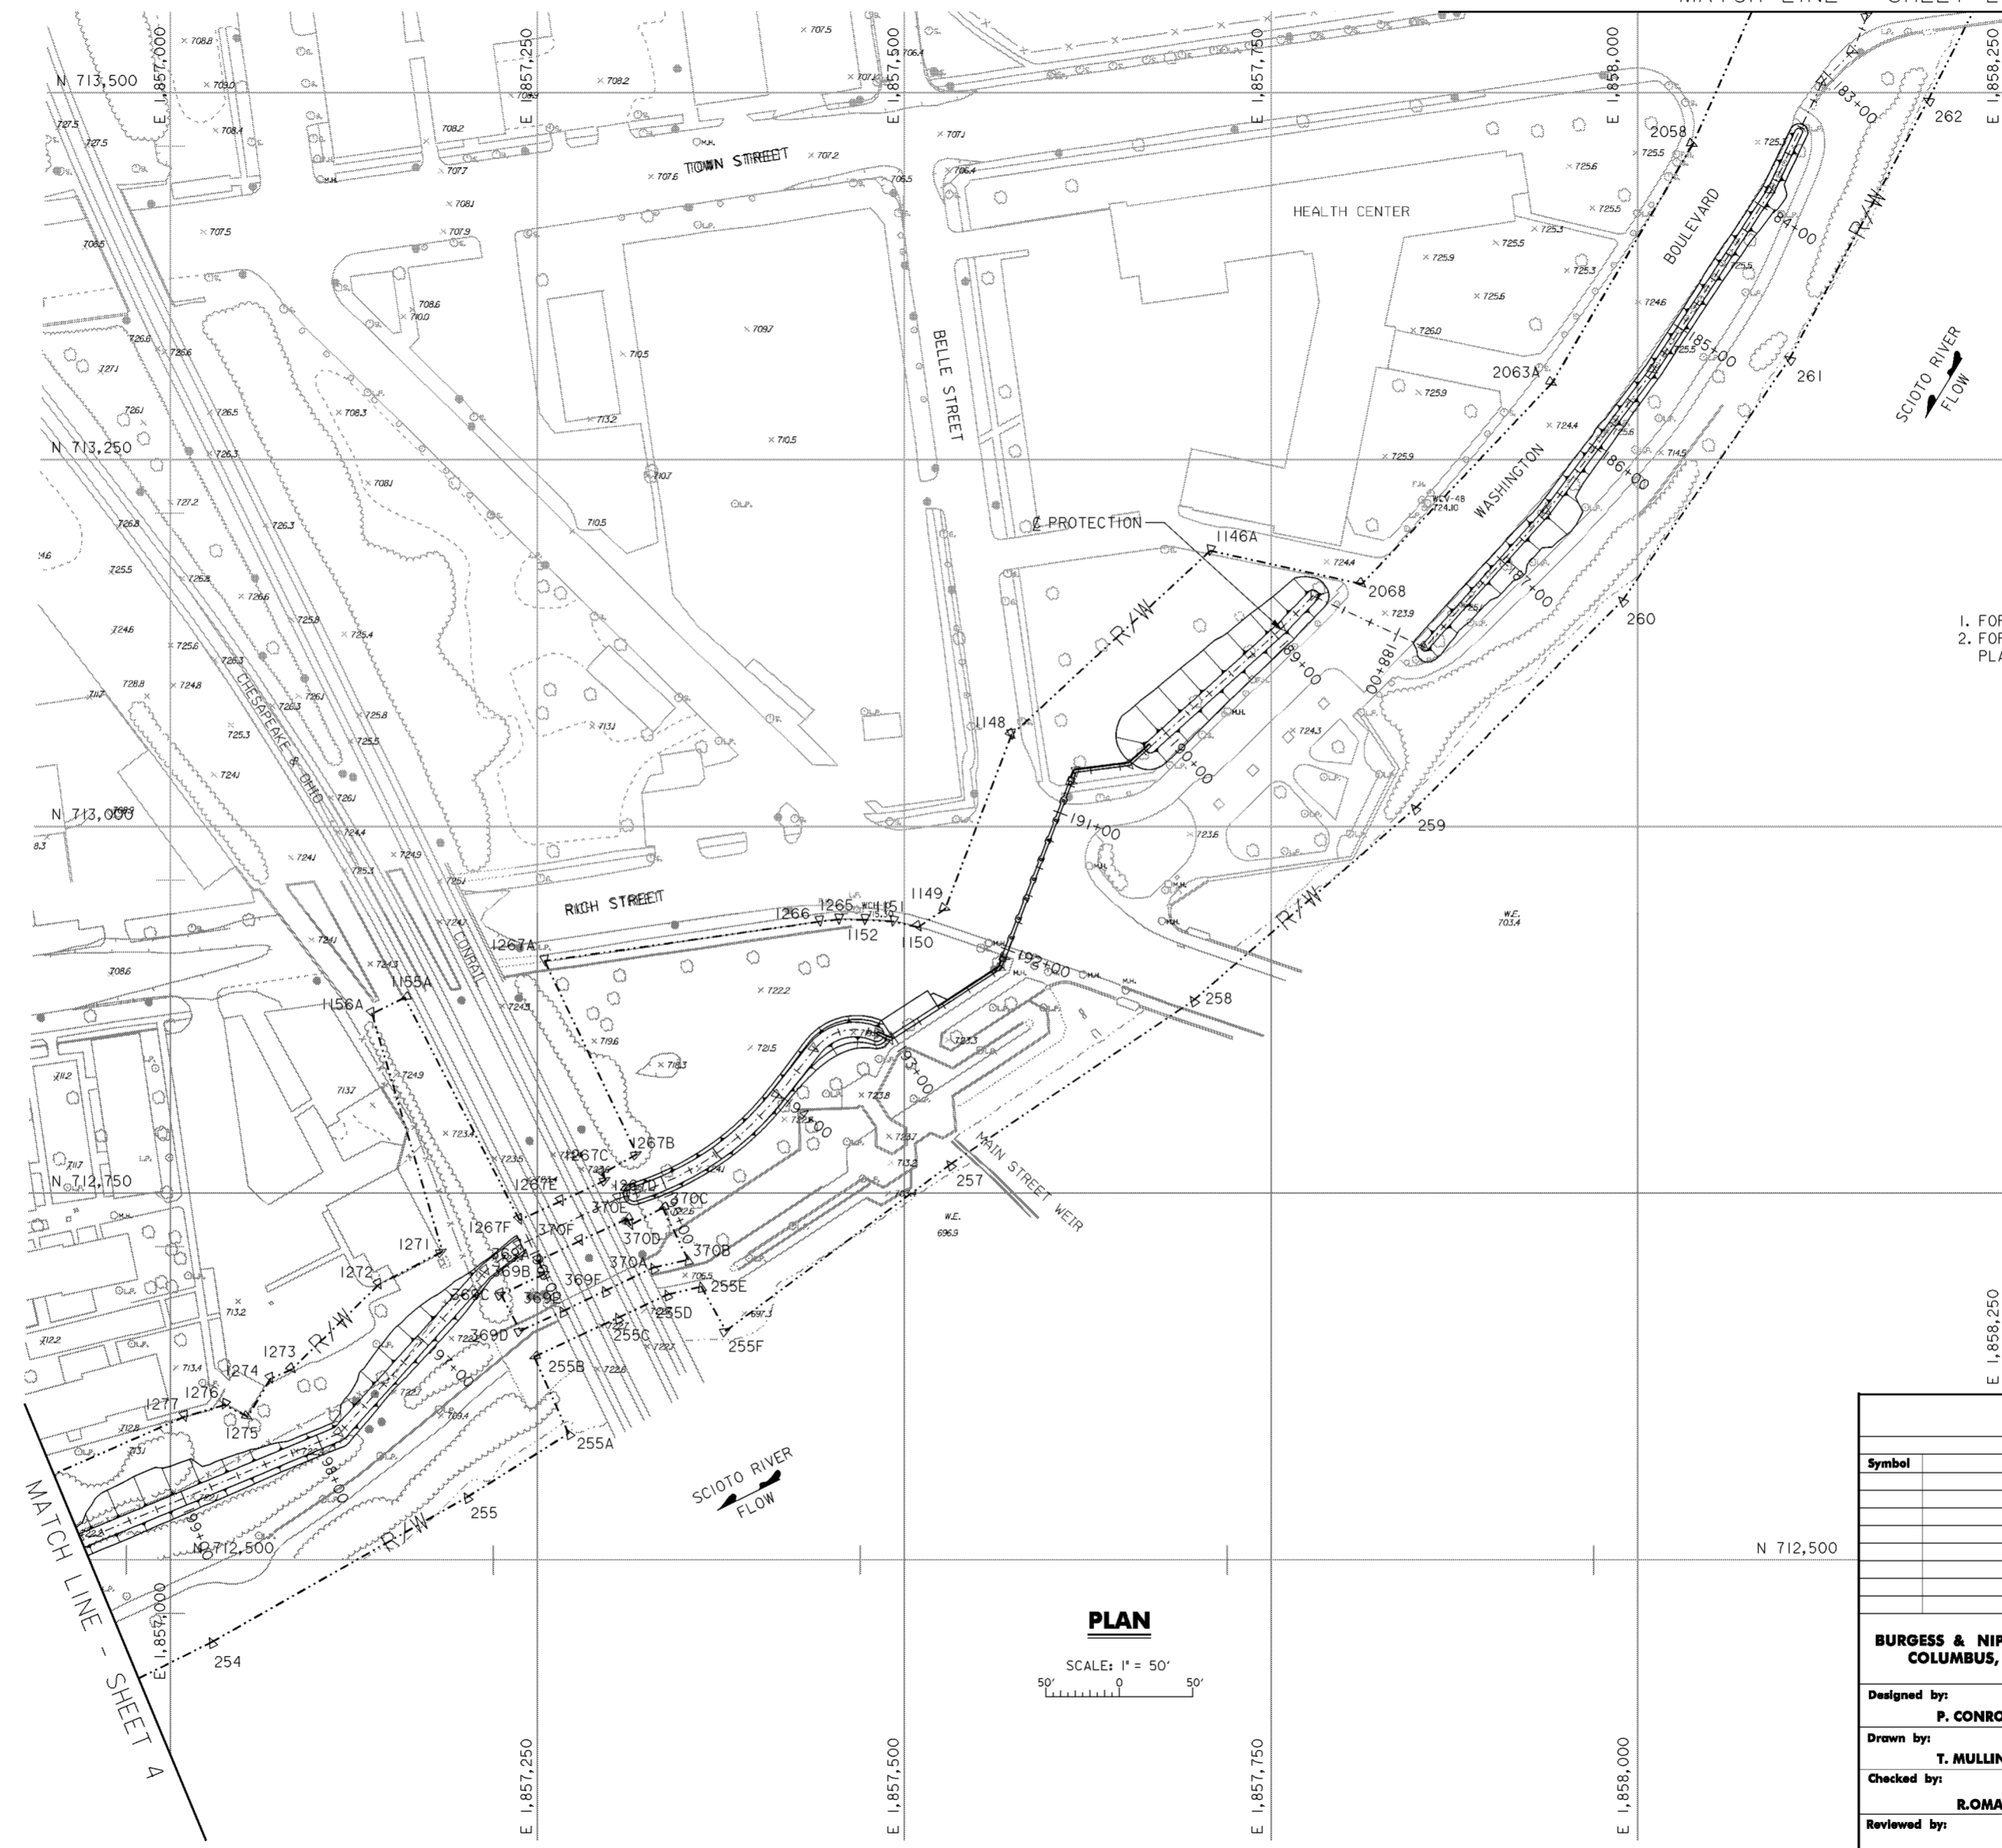

NOTES

1. FOR GENERAL SITE PLAN SEE DRAWING NO. 0/6.
2. FOR CONTRACTOR WORK LIMITS MONUMENT PLANS SEE DRAWING NOS. 6/1 THRU 6/4.


PLAN

SCALE: 1" = 50'

Revisions			
Symbol	Descriptions	Date	Approved

BURGESS & NIPLE, LIMITED COLUMBUS, OHIO	U.S. ARMY ENGINEER DISTRICT CORPS OF ENGINEERS HUNTINGTON, WEST VIRGINIA	SCIOTO RIVER COLUMBUS, OHIO WEST COLUMBUS, L.P.P. PHASE IID	
		RW MONUMENT PLAN (3 OF 4)	
Designed by: P. CONROY		Scale: AS SHOWN	FILENAME: 00r1mp03.dgn
Drawn by: T. MULLINS		Date: MARCH 1998	Sheet reference number: 6/8
Checked by: R.ROMAN	Approved by:	Drawing Code: 16-PWC-10-	Sheet 3 of 4

WORK AS CONSTRUCTED

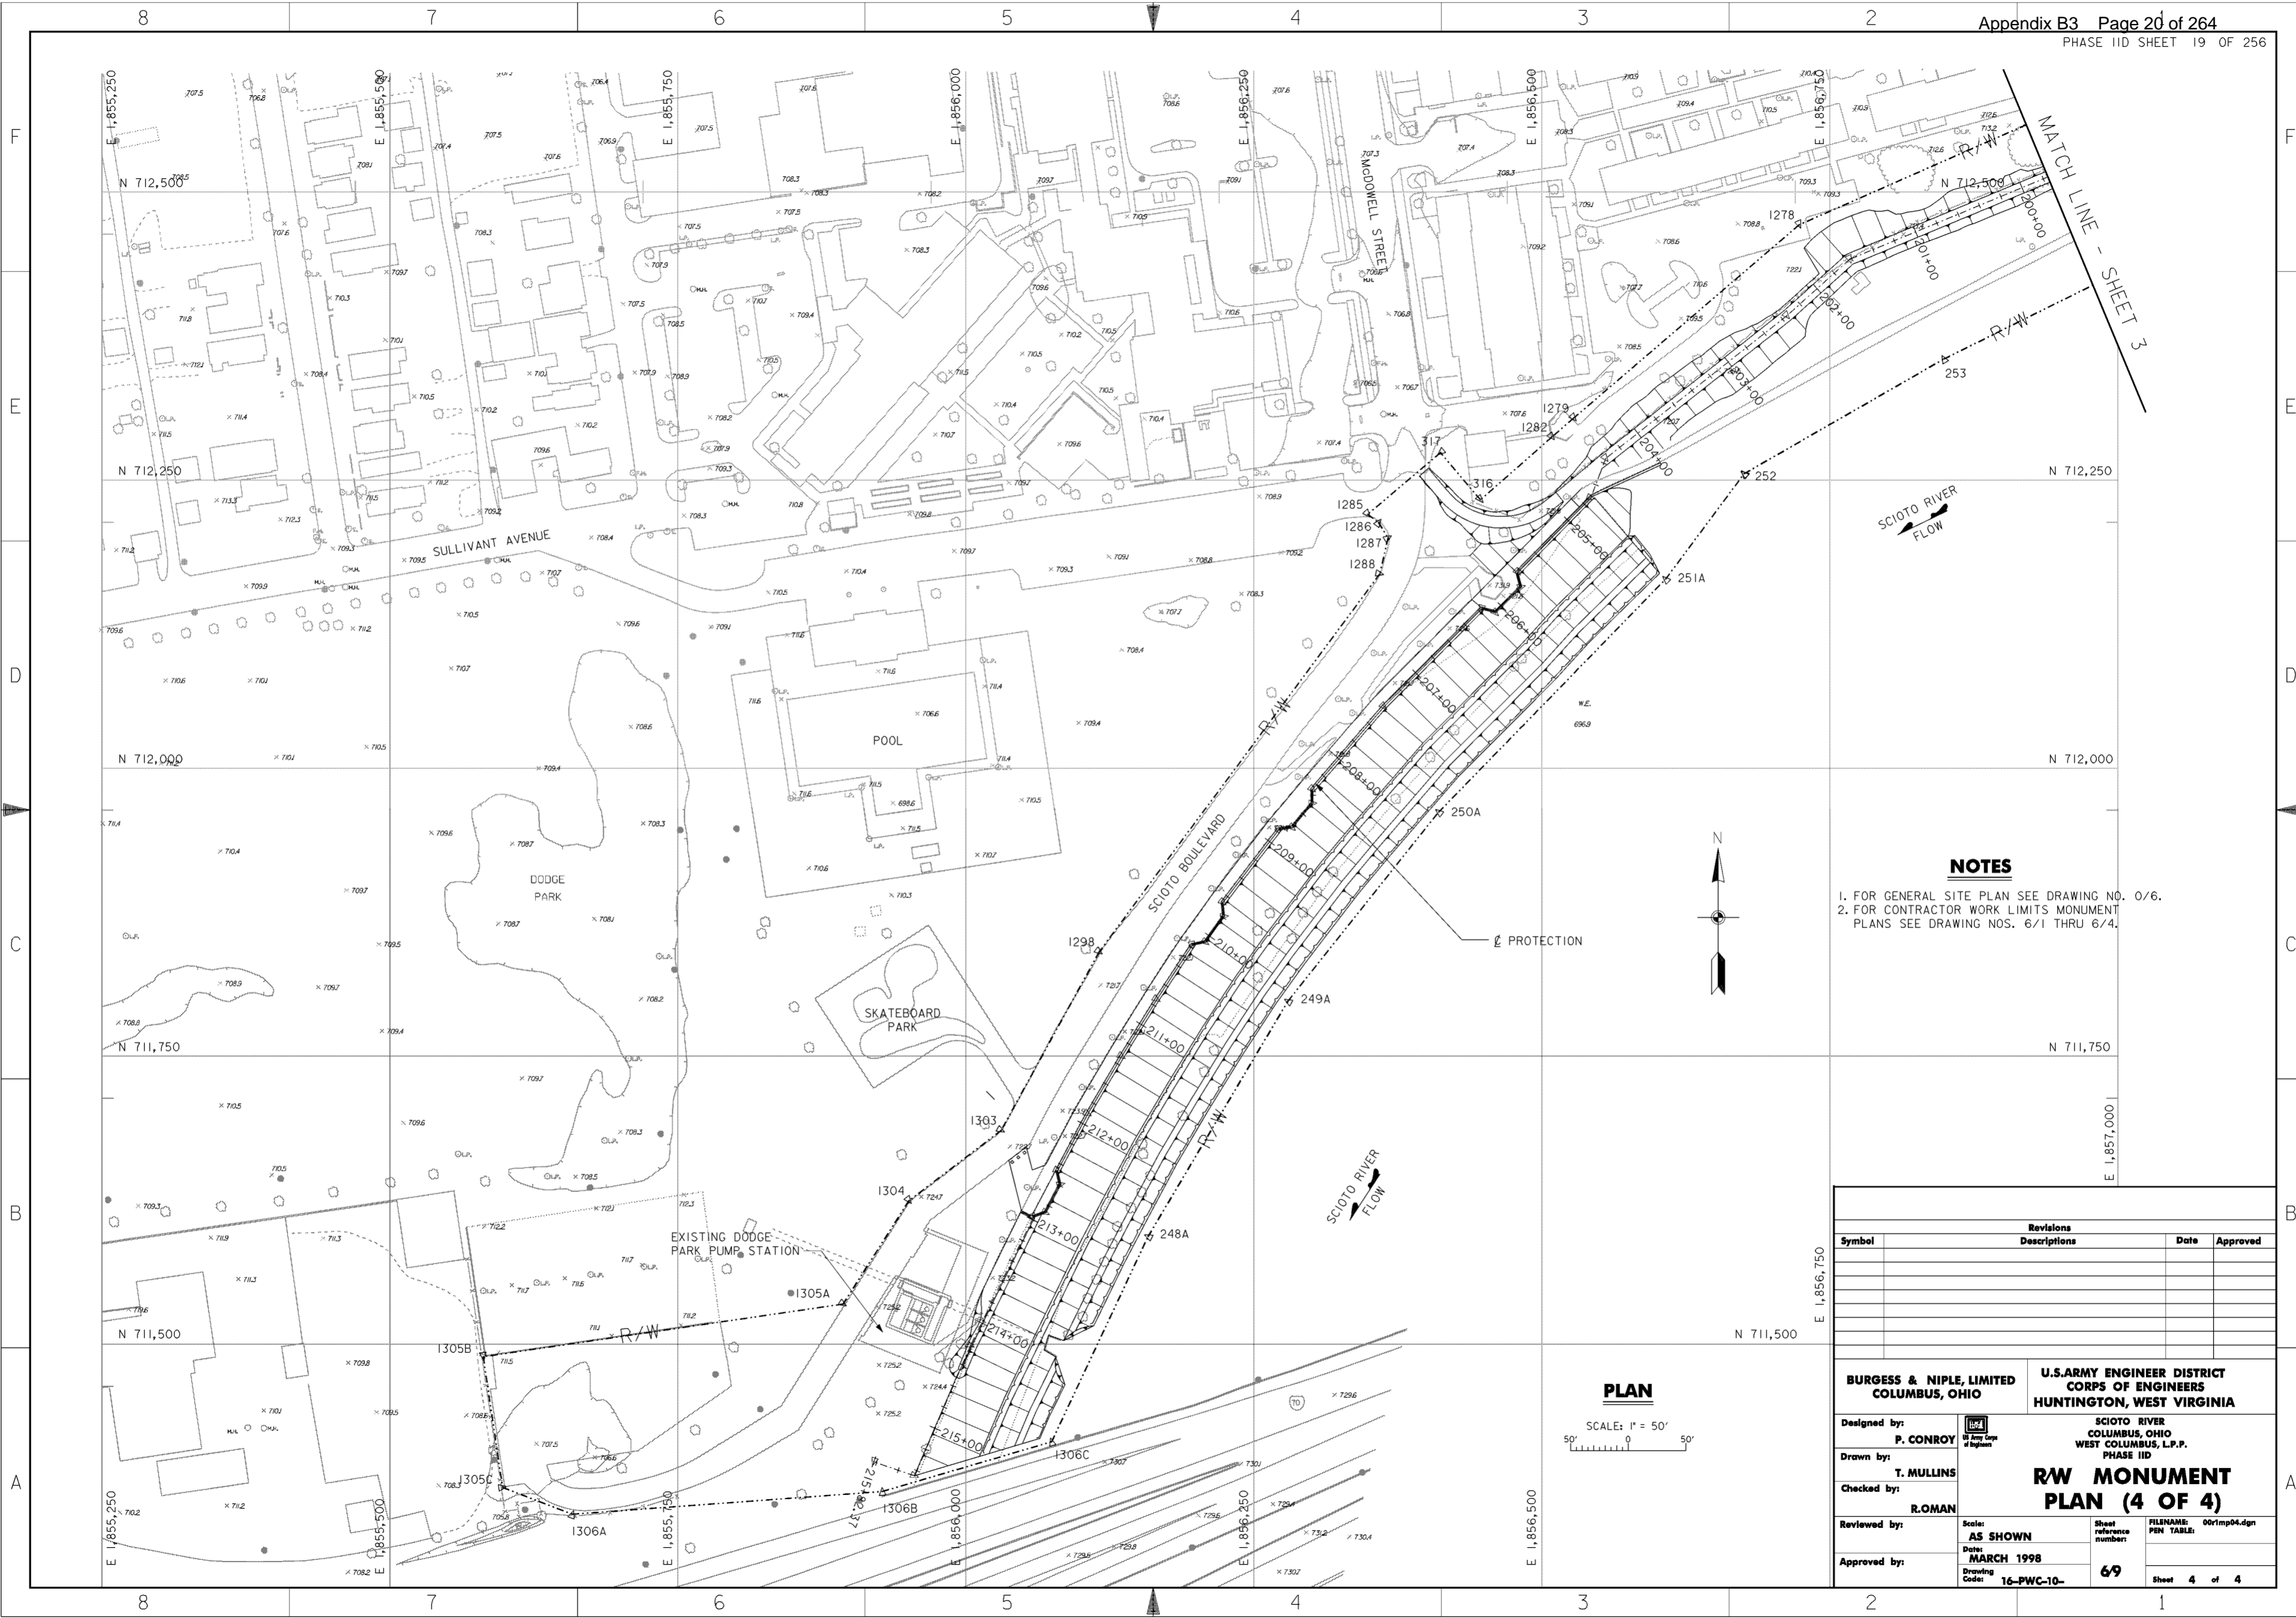

- NOTES**
1. FOR GENERAL SITE PLAN SEE DRAWING NO. 0/6.
 2. FOR CONTRACTOR WORK LIMITS MONUMENT PLANS SEE DRAWING NOS. 6/1 THRU 6/4.

Revisions			
Symbol	Descriptions	Date	Approved

BURGESS & NIPL, LIMITED COLUMBUS, OHIO		U.S. ARMY ENGINEER DISTRICT CORPS OF ENGINEERS HUNTINGTON, WEST VIRGINIA	
Designed by: P. CONROY		SCIOTO RIVER COLUMBUS, OHIO WEST COLUMBUS, L.P.P. PHASE IID RW MONUMENT PLAN (4 OF 4)	
Drawn by: T. MULLINS			
Checked by: R.ROMAN	Scale: AS SHOWN	Sheet reference number: 69	FILENAME: 00r1mp04.dgn
Reviewed by:	Date: MARCH 1998	Drawing Code: 16-PWC-10-	Sheet 4 of 4

PLAN
 SCALE: 1" = 50'
 50' 0 50'

**RIGHT OF WAY
 MONUMENT TABLES**

OUTER RW

OUTER RW

R/W AT CONRAIL EAST RR

R/W WEST OF CONRAIL EAST RR BRIDGE

R/W WEST OF CONRAIL/CSX RR


POINT#	EASTING	NORTHING	BEARING	DISTANCE
569	1856540.24700	715544.29500	S 28°19'24.83" W	257.59918
584	1856418.02900	715317.53500	S 24°15'56.44" W	195.38976
583	1856498.32800	715139.40800	S 28°46'57.94" W	71.54873
582	1856463.87800	715076.69900	S 33°38'01.70" E	86.70967
581	1856511.90500	715004.50500	S 19°32'43.55" E	272.93337
580	1856603.21600	714747.29900	S 23°17'26.48" E	39.61849
579	1856618.88100	714710.90900	S 4°22'23.08" E	80.24863
578	1856625.00000	714630.89400	N 81°54'39.12" E	23.33821
577	1856648.10600	714634.17800	N 4°32'56.24" W	68.17476
576	1856642.69900	714702.13800	N 15°02'12.91" W	61.67482
575	1856626.69800	714761.70100	N 19°19'54.30" W	238.41118
574	1856547.77500	714986.67000	N 28°31'05.77" W	90.71945
573	1856504.46200	715066.38200	N 28°46'56.46" E	83.93015
572	1856544.87300	715139.94300	N 24°15'58.51" W	55.29013
155A	1856522.15000	715190.34800	N 64°19'33.95" E	148.60290
155B	1856656.08200	715254.73000	N 57°48'23.23" E	148.60328
155C	1856781.83800	715333.90300	N 53°21'58.88" E	87.84035
155D	1856852.32700	715386.31700	N 51°00'24.77" E	87.84111
155E	1856920.59900	715441.58900	N 48°51'59.63" E	80.71116
155F	1856981.38900	715494.68200	S 42°18'23.88" E	32.63863
156	1857003.35800	715470.54400	S 47°11'29.46" W	145.85978
157A	1856896.35100	715371.42500	S 42°48'35.21" E	20.00099
158A	1856909.94300	715356.75200	N 47°11'26.95" E	145.68422
158B	1857016.82000	715455.75300	S 42°18'23.59" E	31.90030
158C	1857038.29200	715432.16100	S 47°38'15.18" W	140.81393
158D	1856934.24500	715337.27800	S 42°30'43.15" W	175.93633
158E	1856815.35700	715207.58900	S 9°23'25.56" E	225.36604
158F	1856852.12800	714985.24300	S 3°28'27.16" E	30.13238
158G	1856853.95400	714955.16600	S 7°20'03.84" E	285.17128
305A	1856890.35900	714672.32800	N 81°03'58.84" E	24.00015
306A	1856914.06800	714676.05500	N 7°19'56.57" W	285.13974
307	1856877.67700	714958.86300	N 11°12'39.98" W	30.01680
308	1856871.84100	714988.30700	N 9°22'21.61" W	213.28131
309	1856837.10700	715198.74100	N 42°41'41.77" E	196.29116
310	1856970.21100	715343.01000	N 47°38'05.11" E	169.05137
311	1857095.11700	715456.92600	N 78°52'53.05" E	85.09625
312	1857178.61600	715473.33600	N 84°18'59.64" E	70.32068
313	1857248.59100	715480.30000	S 81°25'22.21" E	88.72127
314	1857336.32000	715467.06800	S 63°30'09.23" E	91.70747
315	1857418.39400	715426.15200	S 55°05'22.78" E	54.76382
316	1857463.30300	715394.81100	S 51°16'38.38" E	56.22399
317	1857507.16800	715359.64000	S 44°15'58.48" E	73.93478
318	1857558.77400	715306.69500	S 30°32'30.48" E	29.29550
319	1857573.66100	715281.46400	S 8°11'08.40" E	146.70464
320	1857594.54900	715136.25400	S 35°46'10.72" E	275.61902
202E	1857755.65600	714912.62400	S 51°18'51.83" E	64.52320
202F	1857806.02200	714872.29400	S 66°41'26.64" E	145.80963
1105	1857939.93100	714814.59800	S 1°50'27.14" E	83.05386
2025	1857942.59900	714731.58700	S 41°07'56.84" E	174.99946
2029A	1858057.71400	714599.77900	S 25°20'58.85" E	175.00051
2034A	1858132.63900	714441.62900	S 20°07'18.35" E	175.00039
2038A	1858192.84200	714277.31000	S 6°26'23.41" E	175.00022
2042A	1858212.47000	714103.41400	S 1°56'45.97" E	194.49718
2047A	1858205.86500	713909.02900	S 16°14'33.81" W	190.97469
2052	1858152.44800	713725.67700	S 23°35'12.85" W	134.32313
2057	1858098.70000	713602.57600	S 24°02'08.64" W	150.67039
2058	1858037.33100	713464.97000	S 30°31'57.95" W	188.77589
2063A	1857941.42700	713302.37000	S 43°24'12.88" W	188.50793
2068	1857811.89700	713165.41300	N 77°42'10.32" W	105.76976
1146A	1857708.55400	713187.94000	S 47°12'54.35" W	184.63001
1148	1857573.05240	713062.53045	S 20°51'16.05" W	126.64632
1149	1857527.96690	712944.18102	S 55°14'49.41" W	22.46166
1150	1857509.51200	712931.37700	N 77°30'56.04" W	17.36561
1151	1857492.55700	712935.13100	N 86°24'52.06" W	19.41200
1152	1857473.18300	712936.34500	N 89°15'29.30" W	17.60948
1265	1857455.57500	712936.57300	S 83°43'31.02" W	13.23931
1266	1857442.41500	712935.12600	S 81°49'50.19" W	189.32421
1267A	1857255.01200	712908.22300	S 25°29'16.45" E	145.85408
1267B	1857317.77600	712776.56400	S 60°44'51.51" W	27.18471

POINT#	EASTING	NORTHING	BEARING	DISTANCE
1267C	1857294.05800	712763.28000	S 29°13'22.11" E	4.99583
1267D	1857296.49700	712758.92000	S 64°43'36.83" W	33.63991
1267E	1857266.07700	712744.55800	S 65°35'58.98" W	31.05476
1267F	1857237.79600	712731.72900	N 27°16'05.35" W	170.55998
1155A	1857159.65300	712883.33500	S 63°40'14.33" W	25.00392
1156A	1857137.24300	712872.24500	S 16°22'17.38" E	168.96792
1271	1857184.86900	712710.12800	S 62°28'38.14" W	48.43119
1272	1857141.91889	712687.74792	S 45°42'47.49" W	82.65855
1273	1857082.74747	712630.03154	S 66°13'45.20" W	15.96851
1274	1857068.13365	712623.59498	S 30°47'43.29" W	30.17966
1275	1857052.68247	712597.67061	N 62°42'56.85" W	17.81541
1276	1857036.84914	712605.83728	S 73°35'35.61" W	28.40804
1277	1857009.59785	712597.81329	S 66°13'45.24" W	312.88199
1278	1856723.25907	712471.69731	S 49°23'55.34" W	257.78377
1279	1856527.53504	712303.93385	S 49°15'45.88" W	25.12858
1282	1856508.49487	712287.53517	S 48°39'20.38" W	82.48499
316	1856446.56900	712233.04700	N 40°14'03.89" W	53.61221
317	1856411.94000	712273.97500	S 49°45'57.59" W	82.89224
1285	1856348.65900	712220.43400	S 53°02'05.68" E	11.79722
1286	1856358.08500	712213.34000	S 31°59'52.90" E	15.68627
1287	1856366.39700	712200.03700	S 12°58'13.91" W	32.09180
1288	1856359.19400	712168.76400	S 36°35'34.70" W	408.62977
1298	1856115.59900	711840.67900	S 28°47'09.58" W	176.72488
1303	1856030.49900	711685.79300	S 52°41'47.03" W	100.69329
1304	1855950.40400	711624.76900	S 32°26'13.12" W	106.34232
1305A	1855893.36500	711535.01800	S 81°40'28.35" W	315.72728
1305B	1855580.96500	711489.30200	S 8°24'16.83" E	114.67961
1305C	1855597.72700	711375.85400	S 68°58'46.45" E	64.78101
1306A	1855658.19700	711352.61700	N 85°48'11.34" E	269.88369
1306B	1855927.35700	711372.36800	N 73°36'44.34" E	153.12162
1306C	1856074.25800	711415.56900	N 25°11'00.87" E	196.70057
248A	1856157.95800	711593.57300	N 30°43'48.27" E	237.49390
249A	1856279.31600	711797.71900	N 38°34'17.63" E	209.99961
250A	1856410.24900	711961.90300	N 44°15'24.39" E	282.32270
251A	1856607.27500	712164.10800	N 36°39'32.28" E	114.03217
252	1856675.35800	712255.58500	N 60°07'25.38" E	200.00046
253	1856848.77900	712355.21100	N 63°38'19.62" E	200.00055
254	1857027.98200	712444.01700	N 60°23'50.62" E	199.99943
255	1857201.87600	712542.81300	N 57°55'08.23" E	81.95349
255A	1857271.131500	712586.34000	N 24°15'55.95" W	57.30156
255B	1857247.76600	712638.57900	N 65°01'46.02" E	62.88961
255C	1857304.77700	712665.12800	N 64°54'28.18" E	37.19855
255D	1857338.46500	712680.90300	N 76°46'37.92" E	23.88319
255E	1857361.71500	712686.36600	S 29°06'30.91" E	34.53476
255F	1857378.51500	712656.19300	N 53°25'27.47" E	189.96470
257	1857531.07000	712769.39000	N 55°59'04.42" E	199.99955
258	1857696.84700	712881.27300	N 49°01'54.00" E	199.99945
259	1857847.86100	713012.40100	N 44°58'46.35" E	200.00022
260	1857989.23200	713153.87300	N 34°38'11.68" E	200.00032
261	1858102.90600	713318.42800	N 28°13'02.92" E	200.00017
262	1858197.47000	713494.66000	N 27°04'30.79" E	200.00006
263	1858288.50200	713672.74200	N 17°33'50.25" E	199.99986
264	1858348.85600	713863.41800	N 4°20'21.93" E	200.00034
265	1858363.98900	714062.84500	N 5°40'39.20" W	200.00012
266	1858344.20300	714261.86400	N 13°21'22.37" W	200.00047
267	1858298.00200	714456.45500	N 26°21'10.86" W	199.99976
268	1858209.22200	714635.67000	N 37°14'36.90" W	200.00005
269	1858088.18100	714794.88400	N 39°20'41.12" W	199.99995
270	1857961.38400	714949.55300	N 51°03'45.06" E	24.49114
271	1857980.43400	714964.94500	N 41°08'29.67" W	556.29914
1332	1857614.43262	715383.88620	N 48°55'23.27" W	159.65739
1336	1857494.07830	715488.79244	N 61°17'20.40" W	159.73308
1340	1857353.98377	715565.52692	N 60°40'38.20" W	177.35771
1341	1857199.35000	715652.38400	N 89°56'16.69" W	258.62915
273	1856940.72100	715652.66400	S 69°44'00.66" W	235.75946
570	1856719.55700	715571.00000	S 81°31'44.72" W	181.28771


POINT#	EASTING	NORTHING	BEARING	DISTANCE
351	1856997.72900	715561.55700	N 78°18'32.84" E	78.16656
352	1857074.27400	715577.39600	S 42°30'28.87" E	27.53320
353A	1857092.87800	715557.09900	S 47°01'11.06" W	67.37256
354A	1857043.58900	715511.16800	N 42°18'21.36" W	68.13363

POINT#	EASTING	NORTHING	BEARING	DISTANCE
154	1856513.92600	715208.58900	N 64°20'51.85" E	146.65235
153	1856646.12400	715272.07600	N 57°48'48.51" E	146.65165
152	1856770.23800	715350.19400	N 53°22'01.24" E	87.01714
151	1856840.06700	715402.11600	N 51°00'24.53" E	87.01775
150				


COUNTRY U.S.A.	TYPE OF MARK IP&C	STATION 17/10	ELEVATION 746.99 TRIG (FT)
LOCALITY FRANKLIN COUNTY	STAMPING ON MARK	AGENCY (CAST IN MARKS) OHIO/SOUTH	DATE 1927 NGS
LATITUDE	LONGITUDE	DATUM 1927 NGS	DATUM 1929 NGVD
(NORTHING) (EASTING) (FT) (MM)	(EASTING) (NORTHING) (FT) (MM)	GRID AND ZONE OHIO/SOUTH	ESTABLISHED BY (AGENCY) C.S.C.
710979.23	1854770.44		
(NORTHING) (EASTING) (FT) (MM)	(EASTING) (NORTHING) (FT) (MM)	GRID AND ZONE	DATE
			1/90 TRIG.
TO OBTAIN			
TO OBTAIN	GRID AZ. (ADD/SUB)	TO THE GEODETIC AZIMUTH	
OBJECT	AZIMUTH OR DIRECTION (GEODETIC/GRID) (MAGNETIC)	BACK AZIMUTH	GEOD. DISTANCE (METERS) (FEET)
	S60°19'00"W		348.052

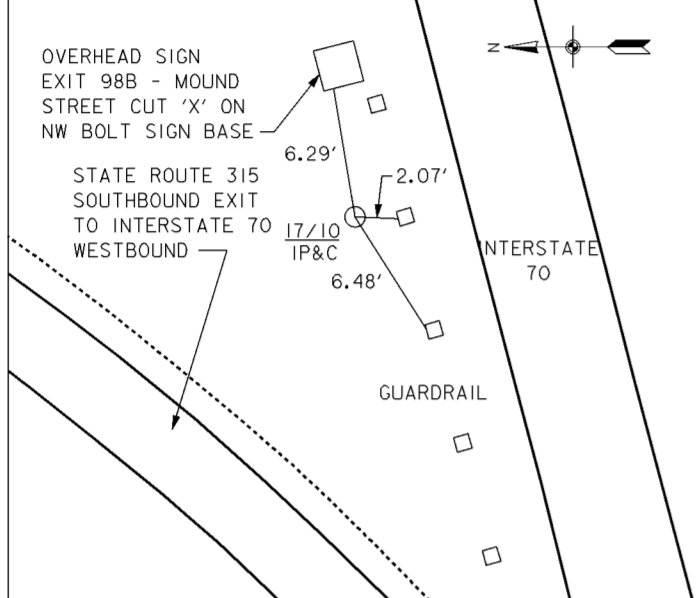


COUNTRY U.S.A.	TYPE OF MARK IP&C	STATION 17/12	ELEVATION 721.98 TRIG (FT)
LOCALITY FRANKLIN COUNTY	STAMPING ON MARK	AGENCY (CAST IN MARKS) OHIO/SOUTH	DATE 1927 NGS
LATITUDE	LONGITUDE	DATUM 1927 NGS	DATUM 1929 NGVD
(NORTHING) (EASTING) (FT) (MM)	(EASTING) (NORTHING) (FT) (MM)	GRID AND ZONE OHIO/SOUTH	ESTABLISHED BY (AGENCY) C.S.C.
711989.06	1856303.00		
(NORTHING) (EASTING) (FT) (MM)	(EASTING) (NORTHING) (FT) (MM)	GRID AND ZONE	DATE
			1/90 TRIG.
TO OBTAIN			
TO OBTAIN	GRID AZ. (ADD/SUB)	TO THE GEODETIC AZIMUTH	
OBJECT	AZIMUTH OR DIRECTION (GEODETIC/GRID) (MAGNETIC)	BACK AZIMUTH	GEOD. DISTANCE (METERS) (FEET)
	S44°50'53"W		491.14
	S59°25'14"W		851.22

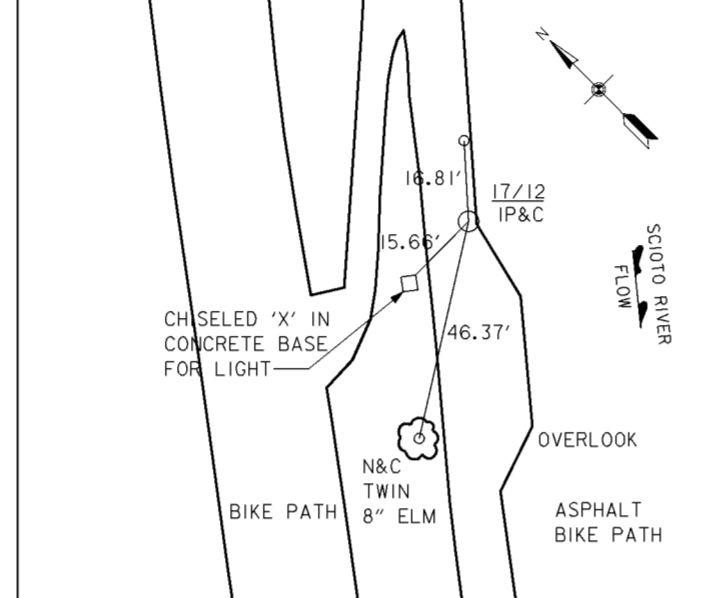


COUNTRY U.S.A.	TYPE OF MARK IP&C	STATION 93/18	ELEVATION 727.63
LOCALITY FRANKLIN COUNTY	STAMPING ON MARK	AGENCY (CAST IN MARKS) OHIO/SOUTH	DATE 1927 NGS
LATITUDE	LONGITUDE	DATUM 1927 NGS	DATUM 1929 NGVD
(NORTHING) (EASTING) (FT) (MM)	(EASTING) (NORTHING) (FT) (MM)	GRID AND ZONE OHIO/SOUTH	ESTABLISHED BY (AGENCY) P.E.H. ENGINEERS
715531.0783	1857077.9577		
(NORTHING) (EASTING) (FT) (MM)	(EASTING) (NORTHING) (FT) (MM)	GRID AND ZONE	DATE
			1/90 TRIG.
TO OBTAIN			
TO OBTAIN	GRID AZ. (ADD/SUB)	TO THE GEODETIC AZIMUTH	
OBJECT	AZIMUTH OR DIRECTION (GEODETIC/GRID) (MAGNETIC)	BACK AZIMUTH	GEOD. DISTANCE (METERS) (FEET)
64/25	S44°50'53"W		491.14
93/20	S59°25'14"W		851.22

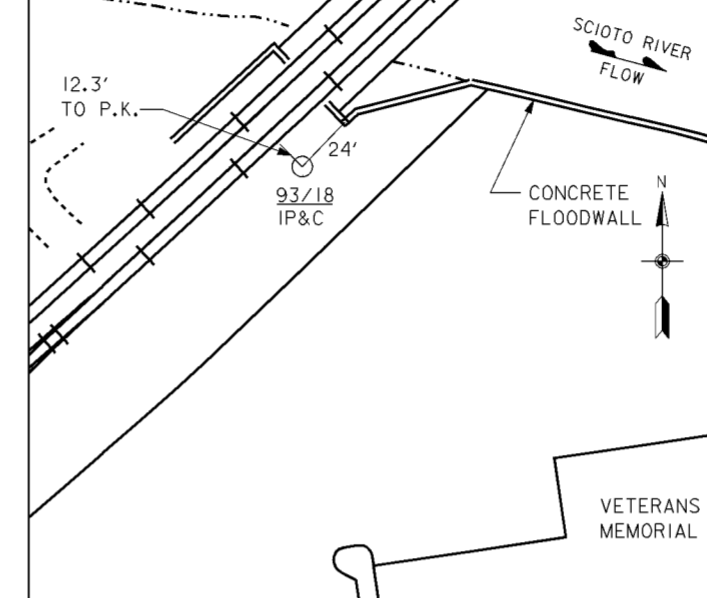


COUNTRY U.S.A.	TYPE OF MARK IP&C	STATION 93/20	ELEVATION 726.11 T (FT)
LOCALITY FRANKLIN COUNTY	STAMPING ON MARK	AGENCY (CAST IN MARKS) OHIO/SOUTH	DATE 1927 NGS
LATITUDE	LONGITUDE	DATUM 1927 NGS	DATUM 1929 NGVD
(NORTHING) (EASTING) (FT) (MM)	(EASTING) (NORTHING) (FT) (MM)	GRID AND ZONE OHIO/SOUTH	ESTABLISHED BY (AGENCY) P.E.H. ENGINEERS
715098.0372	1856345.1212		
(NORTHING) (EASTING) (FT) (MM)	(EASTING) (NORTHING) (FT) (MM)	GRID AND ZONE	DATE
			1/90 TRIG.
TO OBTAIN			
TO OBTAIN	GRID AZ. (ADD/SUB)	TO THE GEODETIC AZIMUTH	
OBJECT	AZIMUTH OR DIRECTION (GEODETIC/GRID) (MAGNETIC)	BACK AZIMUTH	GEOD. DISTANCE (METERS) (FEET)
93/18	N59°25'14"E		851.22
64/24	S85°23'04"W		883.77

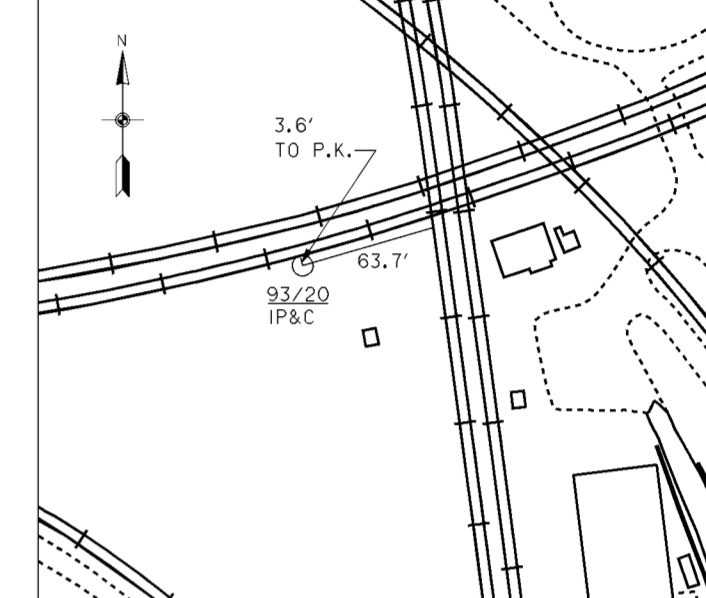


COUNTRY U.S.A.	TYPE OF MARK IP&C	STATION 111/12 (354)	ELEVATION 722.3
LOCALITY FRANKLIN COUNTY	STAMPING ON MARK	AGENCY (CAST IN MARKS) OHIO/SOUTH	DATE 1929 NGVD
LATITUDE	LONGITUDE	DATUM 1927 NGS	DATUM 1929 NGVD
(NORTHING) (EASTING) (FT) (MM)	(EASTING) (NORTHING) (FT) (MM)	GRID AND ZONE OHIO/SOUTH	ESTABLISHED BY (AGENCY) D.L.A. INC.
712548.780	1857030.481		
(NORTHING) (EASTING) (FT) (MM)	(EASTING) (NORTHING) (FT) (MM)	GRID AND ZONE	DATE
			3/91 3RD.
TO OBTAIN			
TO OBTAIN	GRID AZ. (ADD/SUB)	TO THE GEODETIC AZIMUTH	
OBJECT	AZIMUTH OR DIRECTION (GEODETIC/GRID) (MAGNETIC)	BACK AZIMUTH	GEOD. DISTANCE (METERS) (FEET)
111/11	S60°19'00"W		348.052

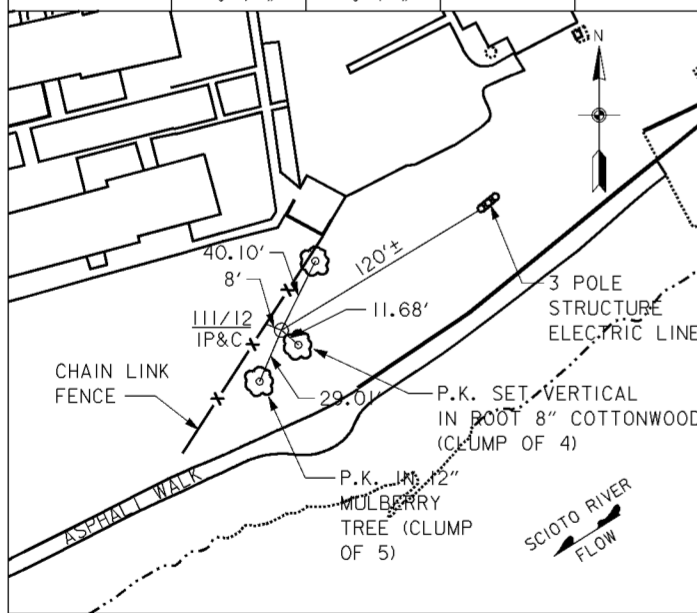

COUNTRY U.S.A.	TYPE OF MARK IP&C	STATION 111/13 (355)	ELEVATION 721.5
LOCALITY FRANKLIN COUNTY	STAMPING ON MARK	AGENCY (CAST IN MARKS) OHIO/SOUTH	DATE 1929 NGVD
LATITUDE	LONGITUDE	DATUM 1927 NGS	DATUM 1929 NGVD
(NORTHING) (EASTING) (FT) (MM)	(EASTING) (NORTHING) (FT) (MM)	GRID AND ZONE OHIO/SOUTH	ESTABLISHED BY (AGENCY) D.L.A. INC.
712416.204	1856733.089		
(NORTHING) (EASTING) (FT) (MM)	(EASTING) (NORTHING) (FT) (MM)	GRID AND ZONE	DATE
			3/91 3RD.
TO OBTAIN			
TO OBTAIN	GRID AZ. (ADD/SUB)	TO THE GEODETIC AZIMUTH	
OBJECT	AZIMUTH OR DIRECTION (GEODETIC/GRID) (MAGNETIC)	BACK AZIMUTH	GEOD. DISTANCE (METERS) (FEET)
111/12	S65°58'22"W		325.604

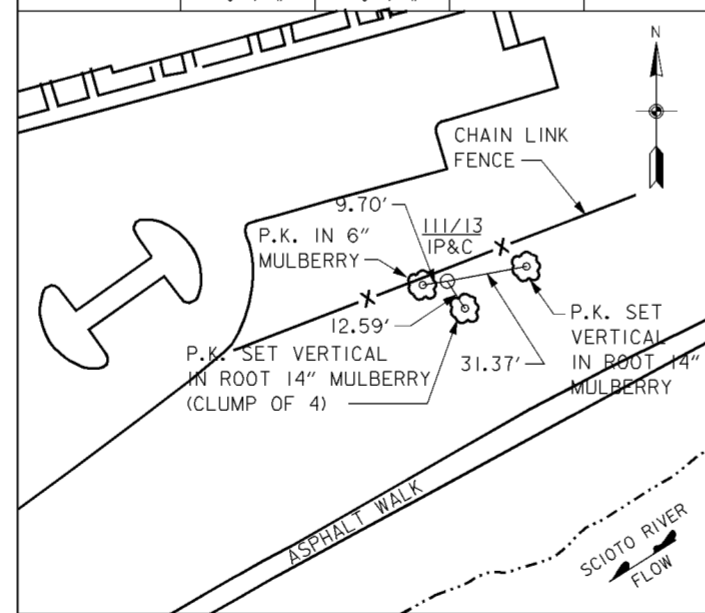

COUNTRY U.S.A.	TYPE OF MARK PK NAIL	STATION 111/14 (356)	ELEVATION 721.5
LOCALITY FRANKLIN COUNTY	STAMPING ON MARK	AGENCY (CAST IN MARKS) OHIO/SOUTH	DATE 1929 NGVD
LATITUDE	LONGITUDE	DATUM 1927 NGS	DATUM 1929 NGVD
(NORTHING) (EASTING) (FT) (MM)	(EASTING) (NORTHING) (FT) (MM)	GRID AND ZONE OHIO/SOUTH	ESTABLISHED BY (AGENCY) D.L.A. INC.
712196.482	1856494.127		
(NORTHING) (EASTING) (FT) (MM)	(EASTING) (NORTHING) (FT) (MM)	GRID AND ZONE	DATE
			3/91 3RD.
TO OBTAIN			
TO OBTAIN	GRID AZ. (ADD/SUB)	TO THE GEODETIC AZIMUTH	
OBJECT	AZIMUTH OR DIRECTION (GEODETIC/GRID) (MAGNETIC)	BACK AZIMUTH	GEOD. DISTANCE (METERS) (FEET)
111/13	S47°24'07"W		324.624

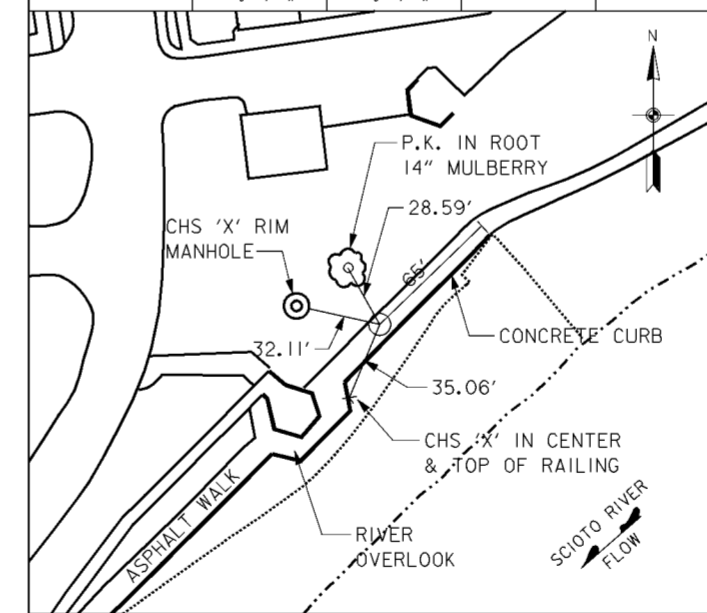

NOTES

- 1. FOR GENERAL SITE PLAN SEE DRAWING NO.0/6.


LEVELMAN : K. ELLIOTT DATE : FEB.12, 1990 BOOK NO. : CEN-5 95 V COMPUTED BY : K. ELLIOTT CHECKED BY : R. TANN	PROJECT NO. 19/0 DESC. WEST COLUMBUS BORING LOCATION VERTICAL DATUM : 1929 NGS
T.B.M. : 95/8 ELEV. : 721.840 DESC. : BRASS DISK QUAD. : S.W. COLUMBUS COORD. : N. = 711,970.0 E. = 1,856,280.0	LOCATION : 95/8 BRASS DISK SET IN CONCRETE OVERLOOK TO THE SCIOTO RIVER, SOUTH-EAST SIDE OF SUNSHINE PARK AND 300' SOUTH OF SULLIVANT AVE. TOPO SHEET NO. : 12

LEVELMAN : K. ELLIOTT DATE : FEB.12, 1990 BOOK NO. : CEN-5 95 V COMPUTED BY : K. ELLIOTT CHECKED BY : R. TANN	PROJECT NO. 19/0 DESC. WEST COLUMBUS BORING LOCATION VERTICAL DATUM : 1929 NGS
T.B.M. : 95/9 ELEV. : 722.436 DESC. : BRASS DISK QUAD. : S.W. COLUMBUS COORD. : N. = 714,920.0 E. = 1,851,950.0	LOCATION : 95/9 BRASS DISK SET IN THE WEST FLOODWALL OF THE SCIOTO RIVER, 100 FT. NORTH OF WEST BROAD STREET IN THE YARD OF THE FRANKLIN COUNTY VETERANS MEMORIAL. TOPO SHEET NO. : 8


LEVELMAN : SMITH/CSC DATE : JANUARY, 1989 BOOK NO. : COMPUTED BY : ZINSMEISTER/CSC CHECKED BY : WILLIS/CSC	PROJECT NO. WEST COLUMBUS, OHIO - LPP DESC. PHOTO CONTROL JOB 05/9 W.D. 0009 VERTICAL DATUM : 1929 NGS DATUM
T.B.M. : 60/26 ELEV. : 728.139 DESC. : BRASS DISK QUAD. : S.W. COLUMBUS COORD. : N. = E. =	LOCATION : BRASS DISK IN SOUTHEAST ABUTMENT OF CONRAIL BRIDGE OVER SCIOTO RIVER.

Symbol	Revisions Descriptions	Date	Approved

BURGESS & NIPLE, LIMITED COLUMBUS, OHIO	U.S. ARMY ENGINEER DISTRICT CORPS OF ENGINEERS HUNTINGTON, WEST VIRGINIA
Designed by: P. CONROY	SCIOTO RIVER COLUMBUS, OHIO WEST COLUMBUS, L.P.P. PHASE IID SURVEY REFERENCES
Drawn by: T. MULLINS	
Checked by: R. ROMAN	
Reviewed by:	
Approved by:	Scale: NONE Date: MARCH 1998 Drawing Code: 16-PWC-10-
	Sheet reference number: 1/1 FILENAME: 00sur01.dgn PIN TABLE: Sheet 1 of 1

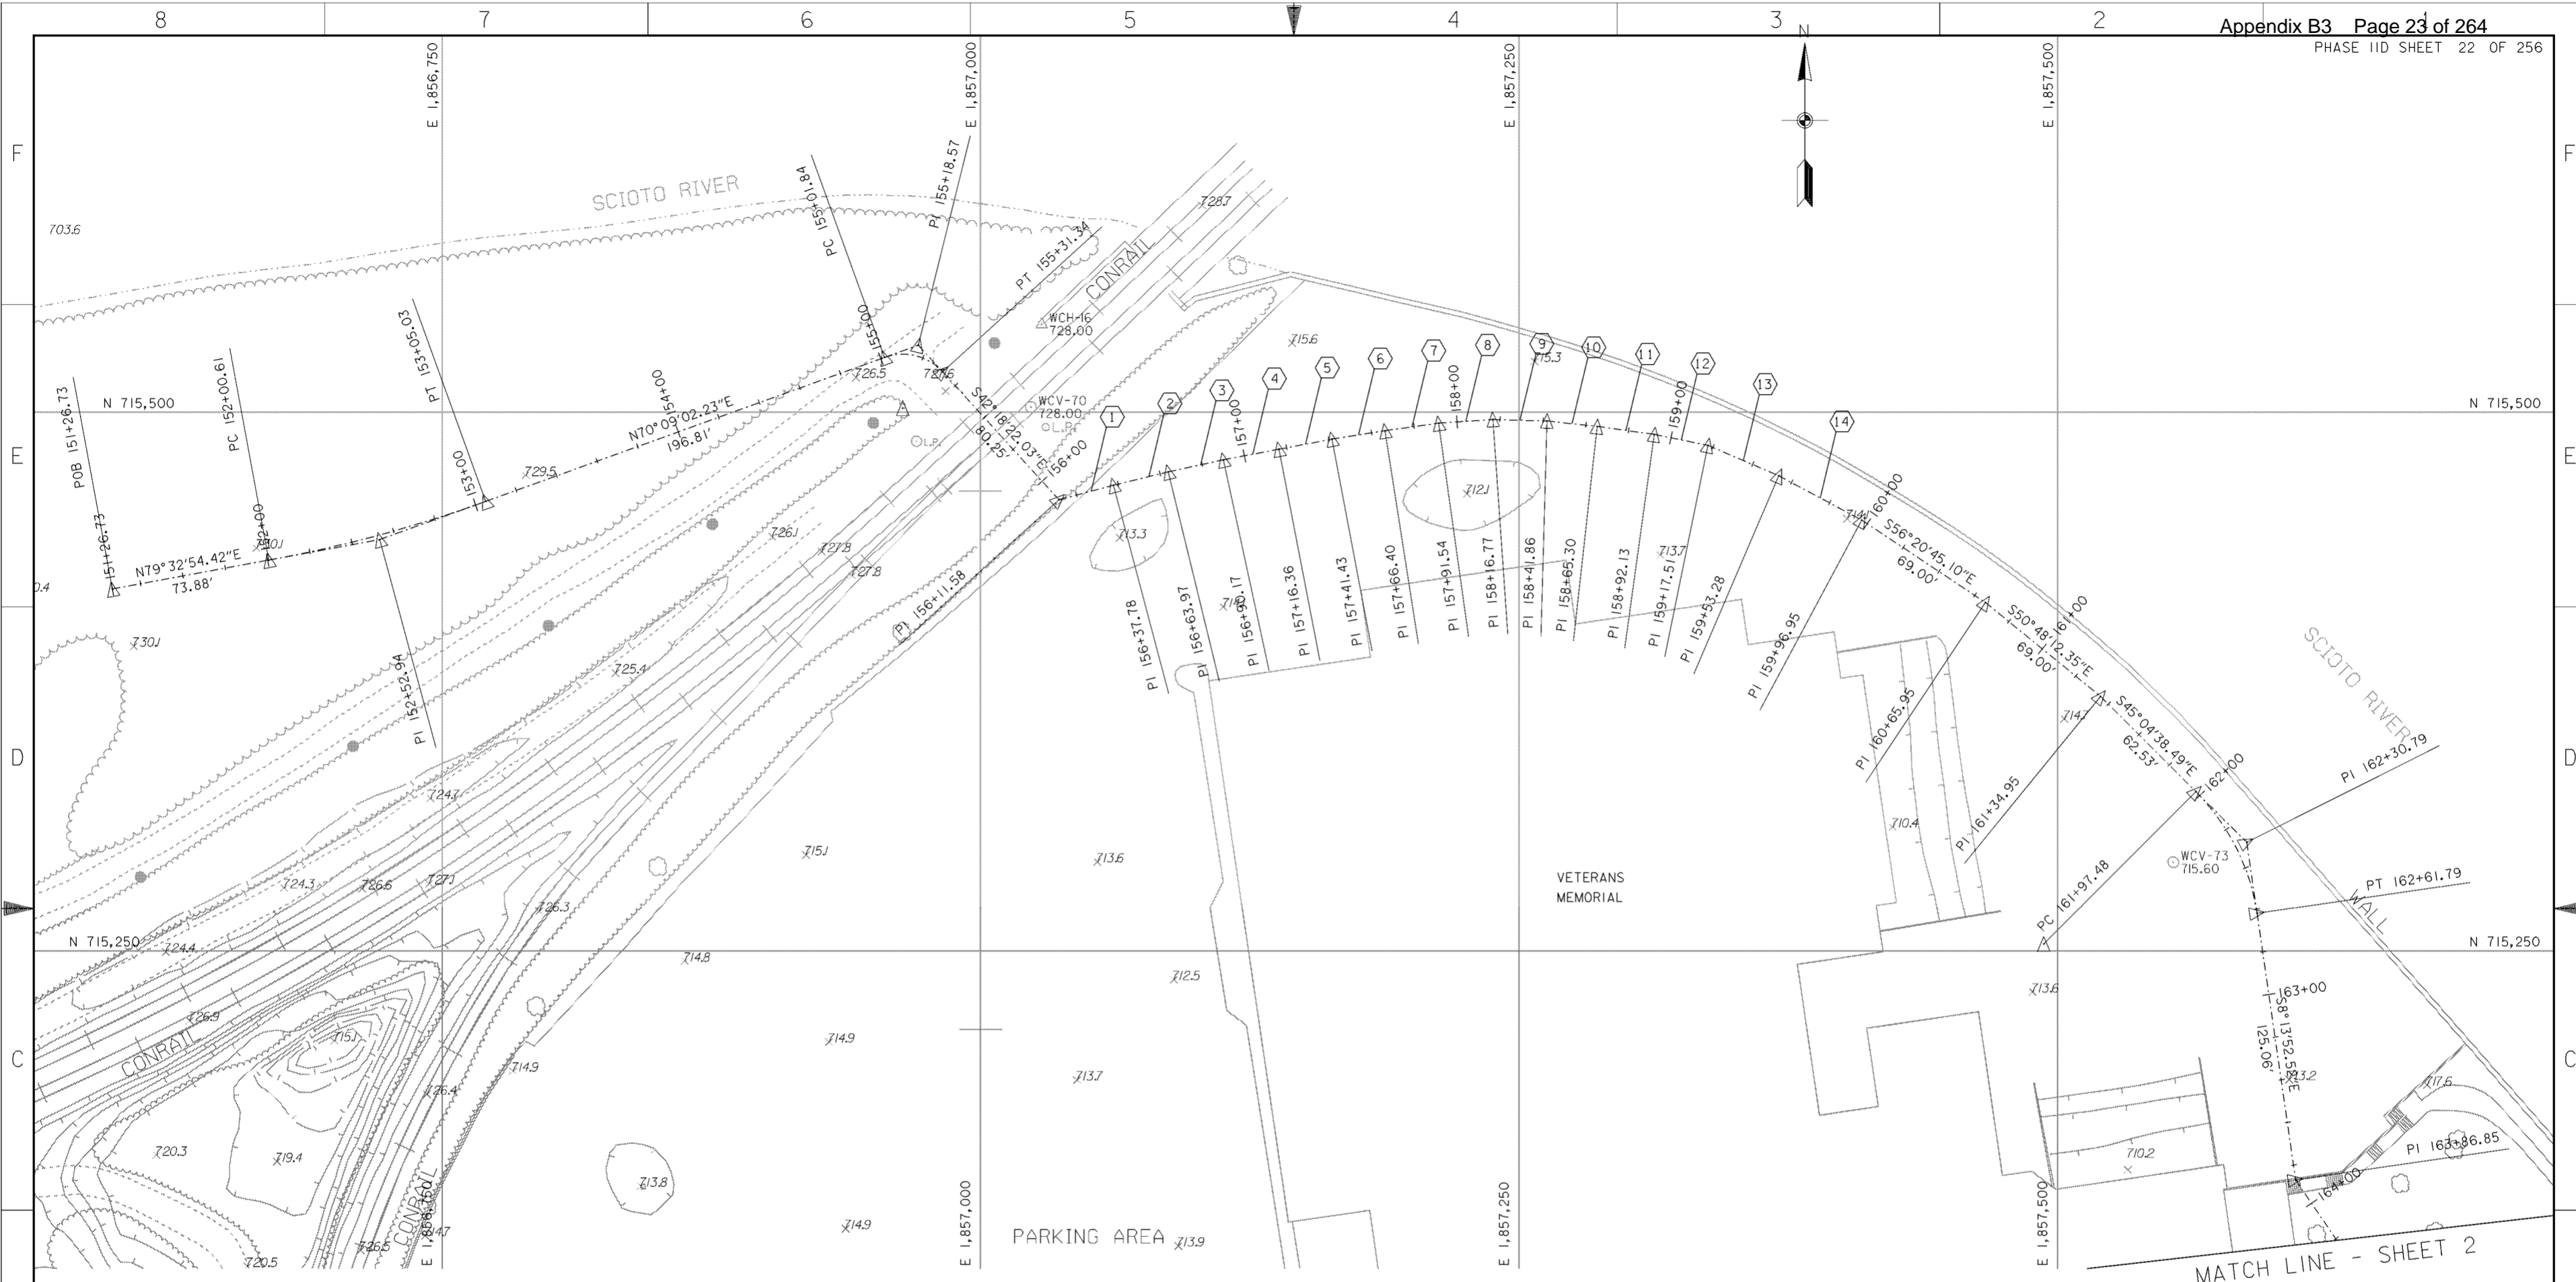


SEGMENT	BEARING	LENGTH	SEGMENT	BEARING	LENGTH
①	N 75° 10' 18.18" E	26.20	⑩	S 83° 41' 23.19" E	23.44
②	N 76° 17' 58.45" E	26.19	⑪	S 82° 05' 50.07" E	26.83
③	N 77° 46' 45.72" E	26.20	⑫	S 78° 27' 41.71" E	25.38
④	N 79° 02' 25.92" E	26.19	⑬	S 66° 47' 24.19" E	35.77
⑤	N 79° 14' 35.44" E	25.07	⑭	S 61° 50' 43.17" E	43.67
⑥	N 81° 06' 02.28" E	24.97			
⑦	N 82° 00' 40.99" E	25.14			
⑧	N 86° 00' 56.42" E	25.23			
⑨	S 88° 25' 51.79" E	25.09			

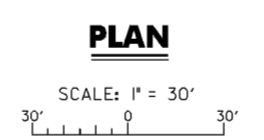

- NOTES**
- FOR GENERAL SITE PLAN SEE DRAWING NO. 0/6.
 - FOR CENTERLINE OF PROTECTION ALIGNMENT DATA SEE DRAWING NOS. 11/8 THRU 11/10.

Revisions			
Symbol	Descriptions	Date	Approved


BURGESS & NIPLE, LIMITED COLUMBUS, OHIO	U.S. ARMY ENGINEER DISTRICT CORPS OF ENGINEERS HUNTINGTON, WEST VIRGINIA
Designed by: P. CONROY	SCIOTO RIVER COLUMBUS, OHIO WEST COLUMBUS, L.P.P. PHASE IID CENTERLINE OF PROTECTION (1 OF 6)
Drawn by: T. MULLINS	
Checked by: R. ROMAN	Scale: AS SHOWN Date: MARCH 1998 Drawing Code: 16-PWC-10-
Reviewed by:	Sheet reference number: 11/2 FILENAME: 00scd01.dgn PEN TABLE: Sheet 1 of 6
Approved by:	

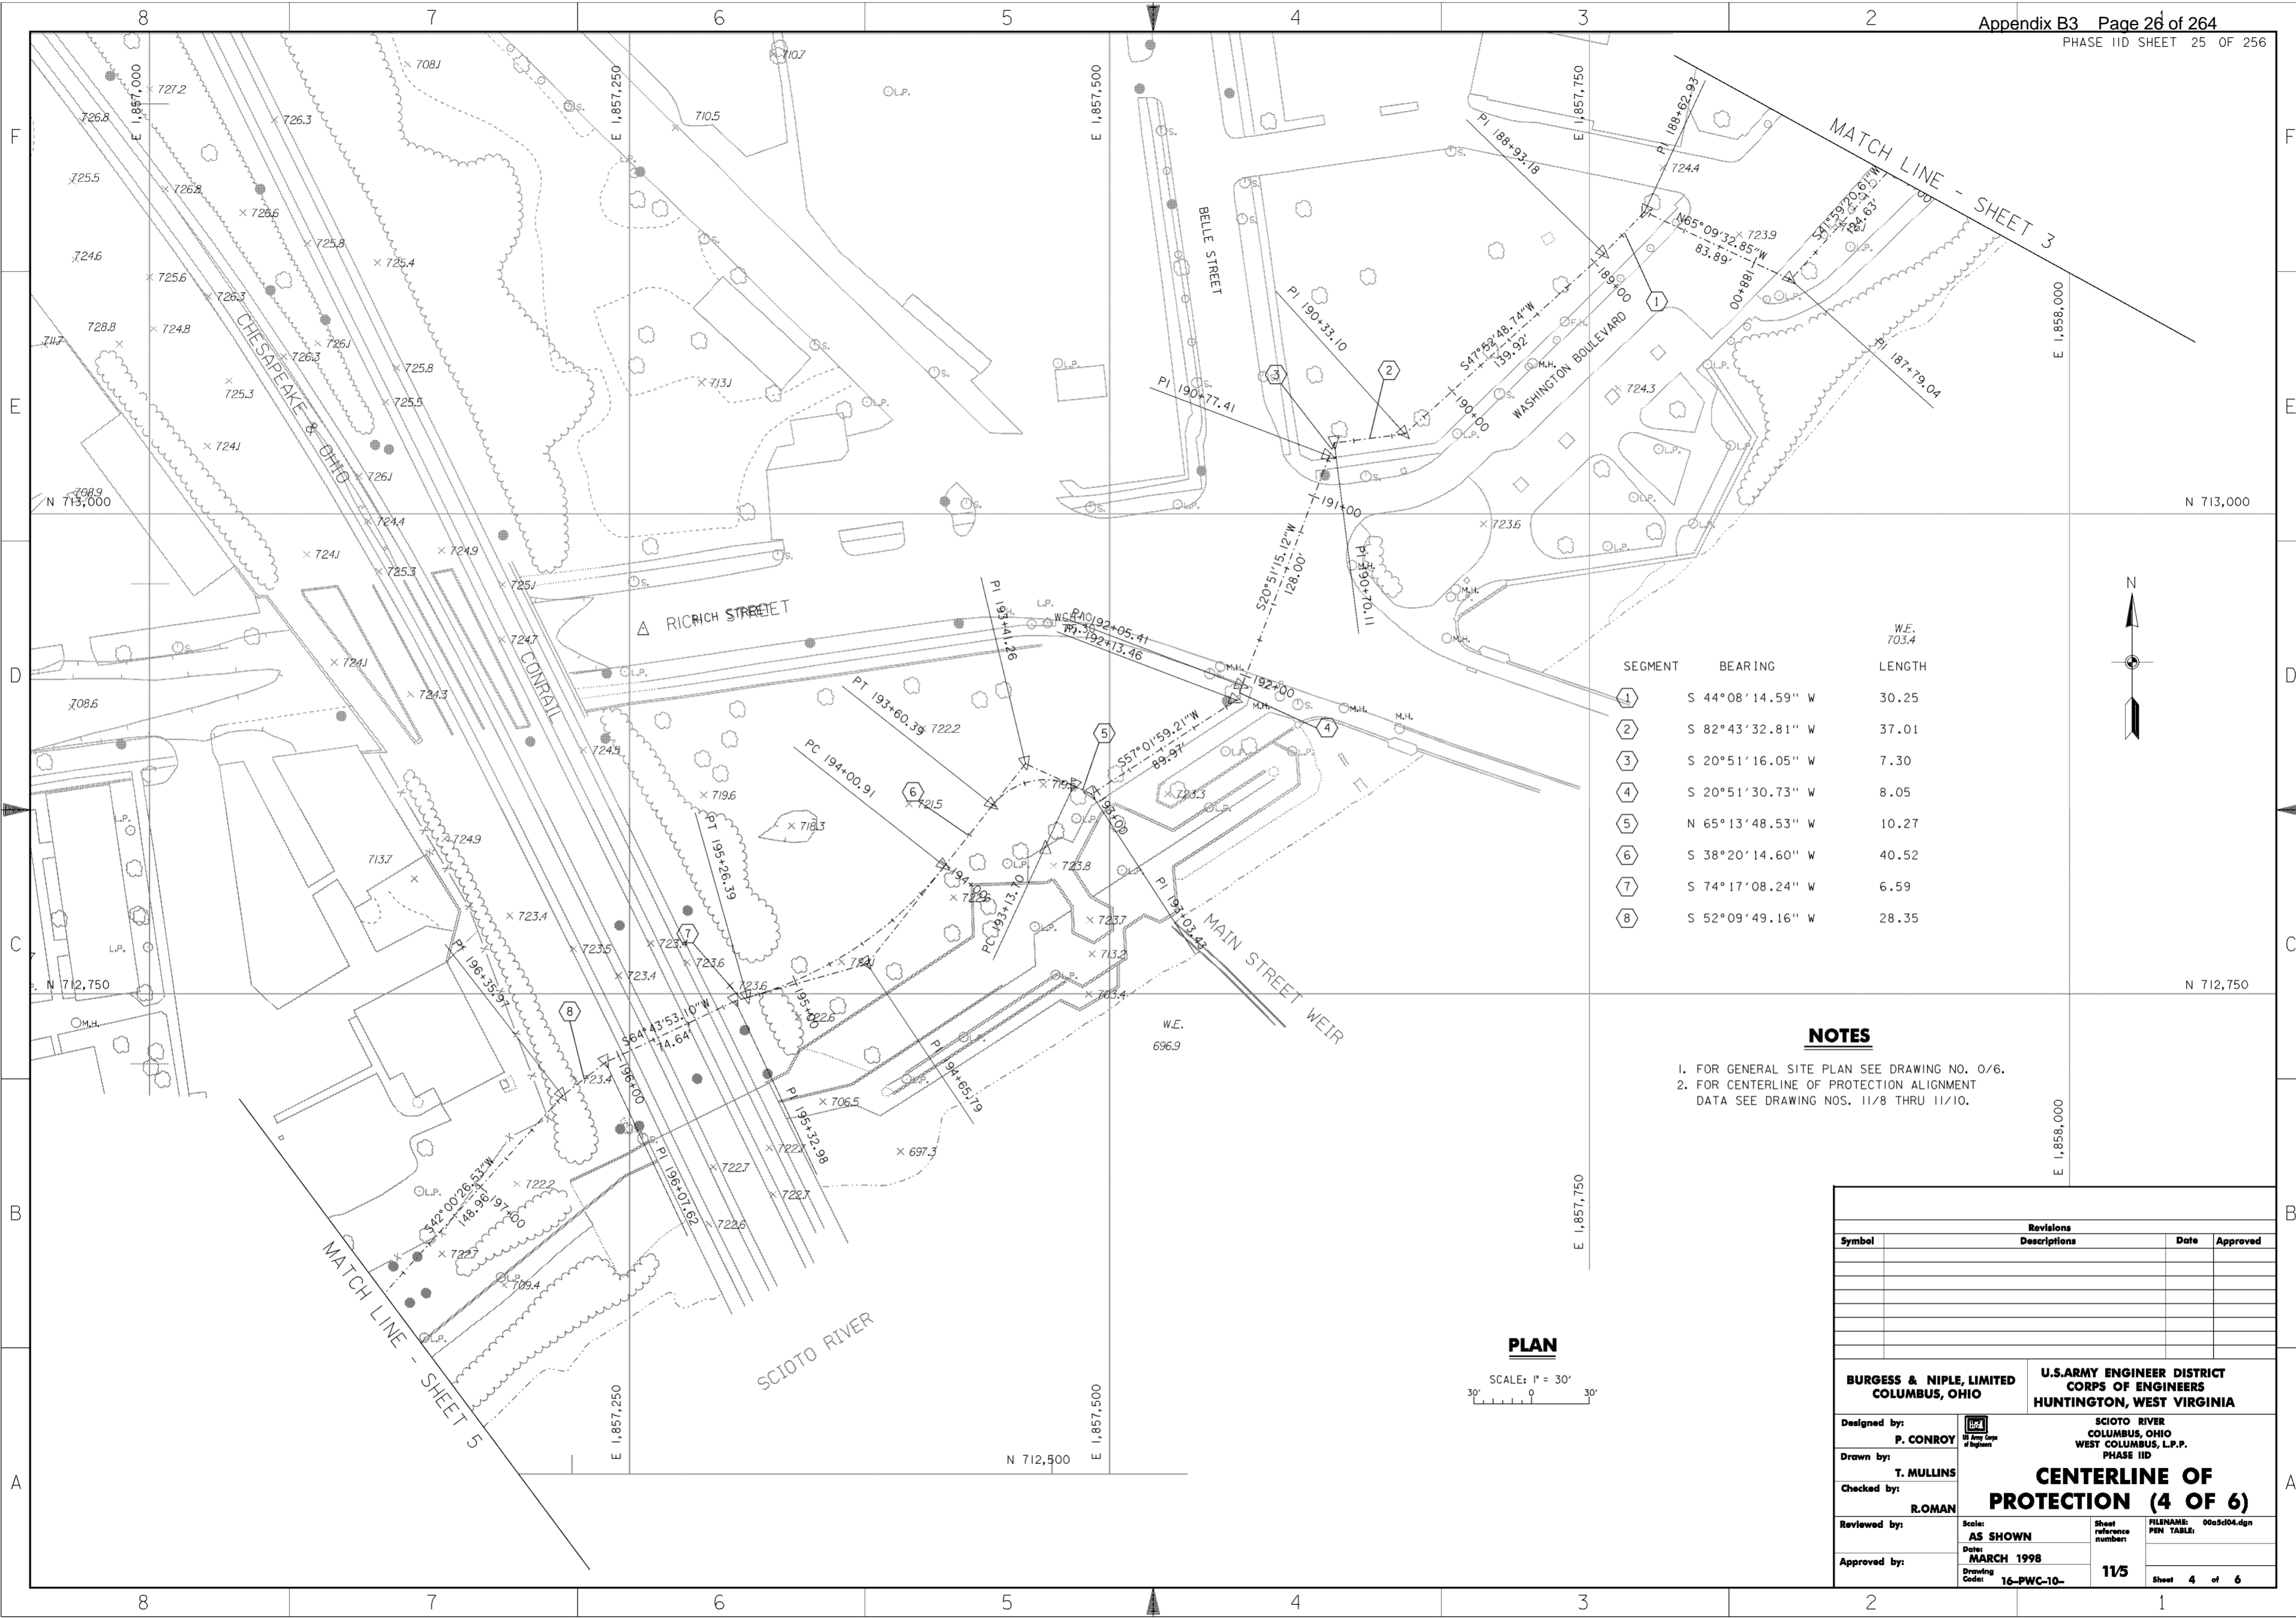

SEGMENT	BEARING	LENGTH	W.E.
①	S 44°08'14.59" W	30.25	703.4
②	S 82°43'32.81" W	37.01	
③	S 20°51'16.05" W	7.30	
④	S 20°51'30.73" W	8.05	
⑤	N 65°13'48.53" W	10.27	
⑥	S 38°20'14.60" W	40.52	
⑦	S 74°17'08.24" W	6.59	
⑧	S 52°09'49.16" W	28.35	

NOTES


1. FOR GENERAL SITE PLAN SEE DRAWING NO. 0/6.
2. FOR CENTERLINE OF PROTECTION ALIGNMENT DATA SEE DRAWING NOS. 11/8 THRU 11/10.

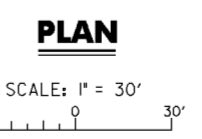

Revisions			
Symbol	Descriptions	Date	Approved


BURGESS & NIPLE, LIMITED COLUMBUS, OHIO	U.S. ARMY ENGINEER DISTRICT CORPS OF ENGINEERS HUNTINGTON, WEST VIRGINIA		
Designed by: P. CONROY	SCIOTO RIVER COLUMBUS, OHIO WEST COLUMBUS, L.P.P. PHASE IID CENTERLINE OF PROTECTION (4 OF 6)		
Drawn by: T. MULLINS			
Checked by: ROMAN			
Reviewed by: AS SHOWN			
Approved by:	Scale: AS SHOWN	Sheet reference number: 11/5	FILENAME: 00sc04.dgn
Drawing Code: 16-PWC-10-	Date: MARCH 1998	Sheet 4 of 6	PEN TABLE:

WORK AS CONSTRUCTED

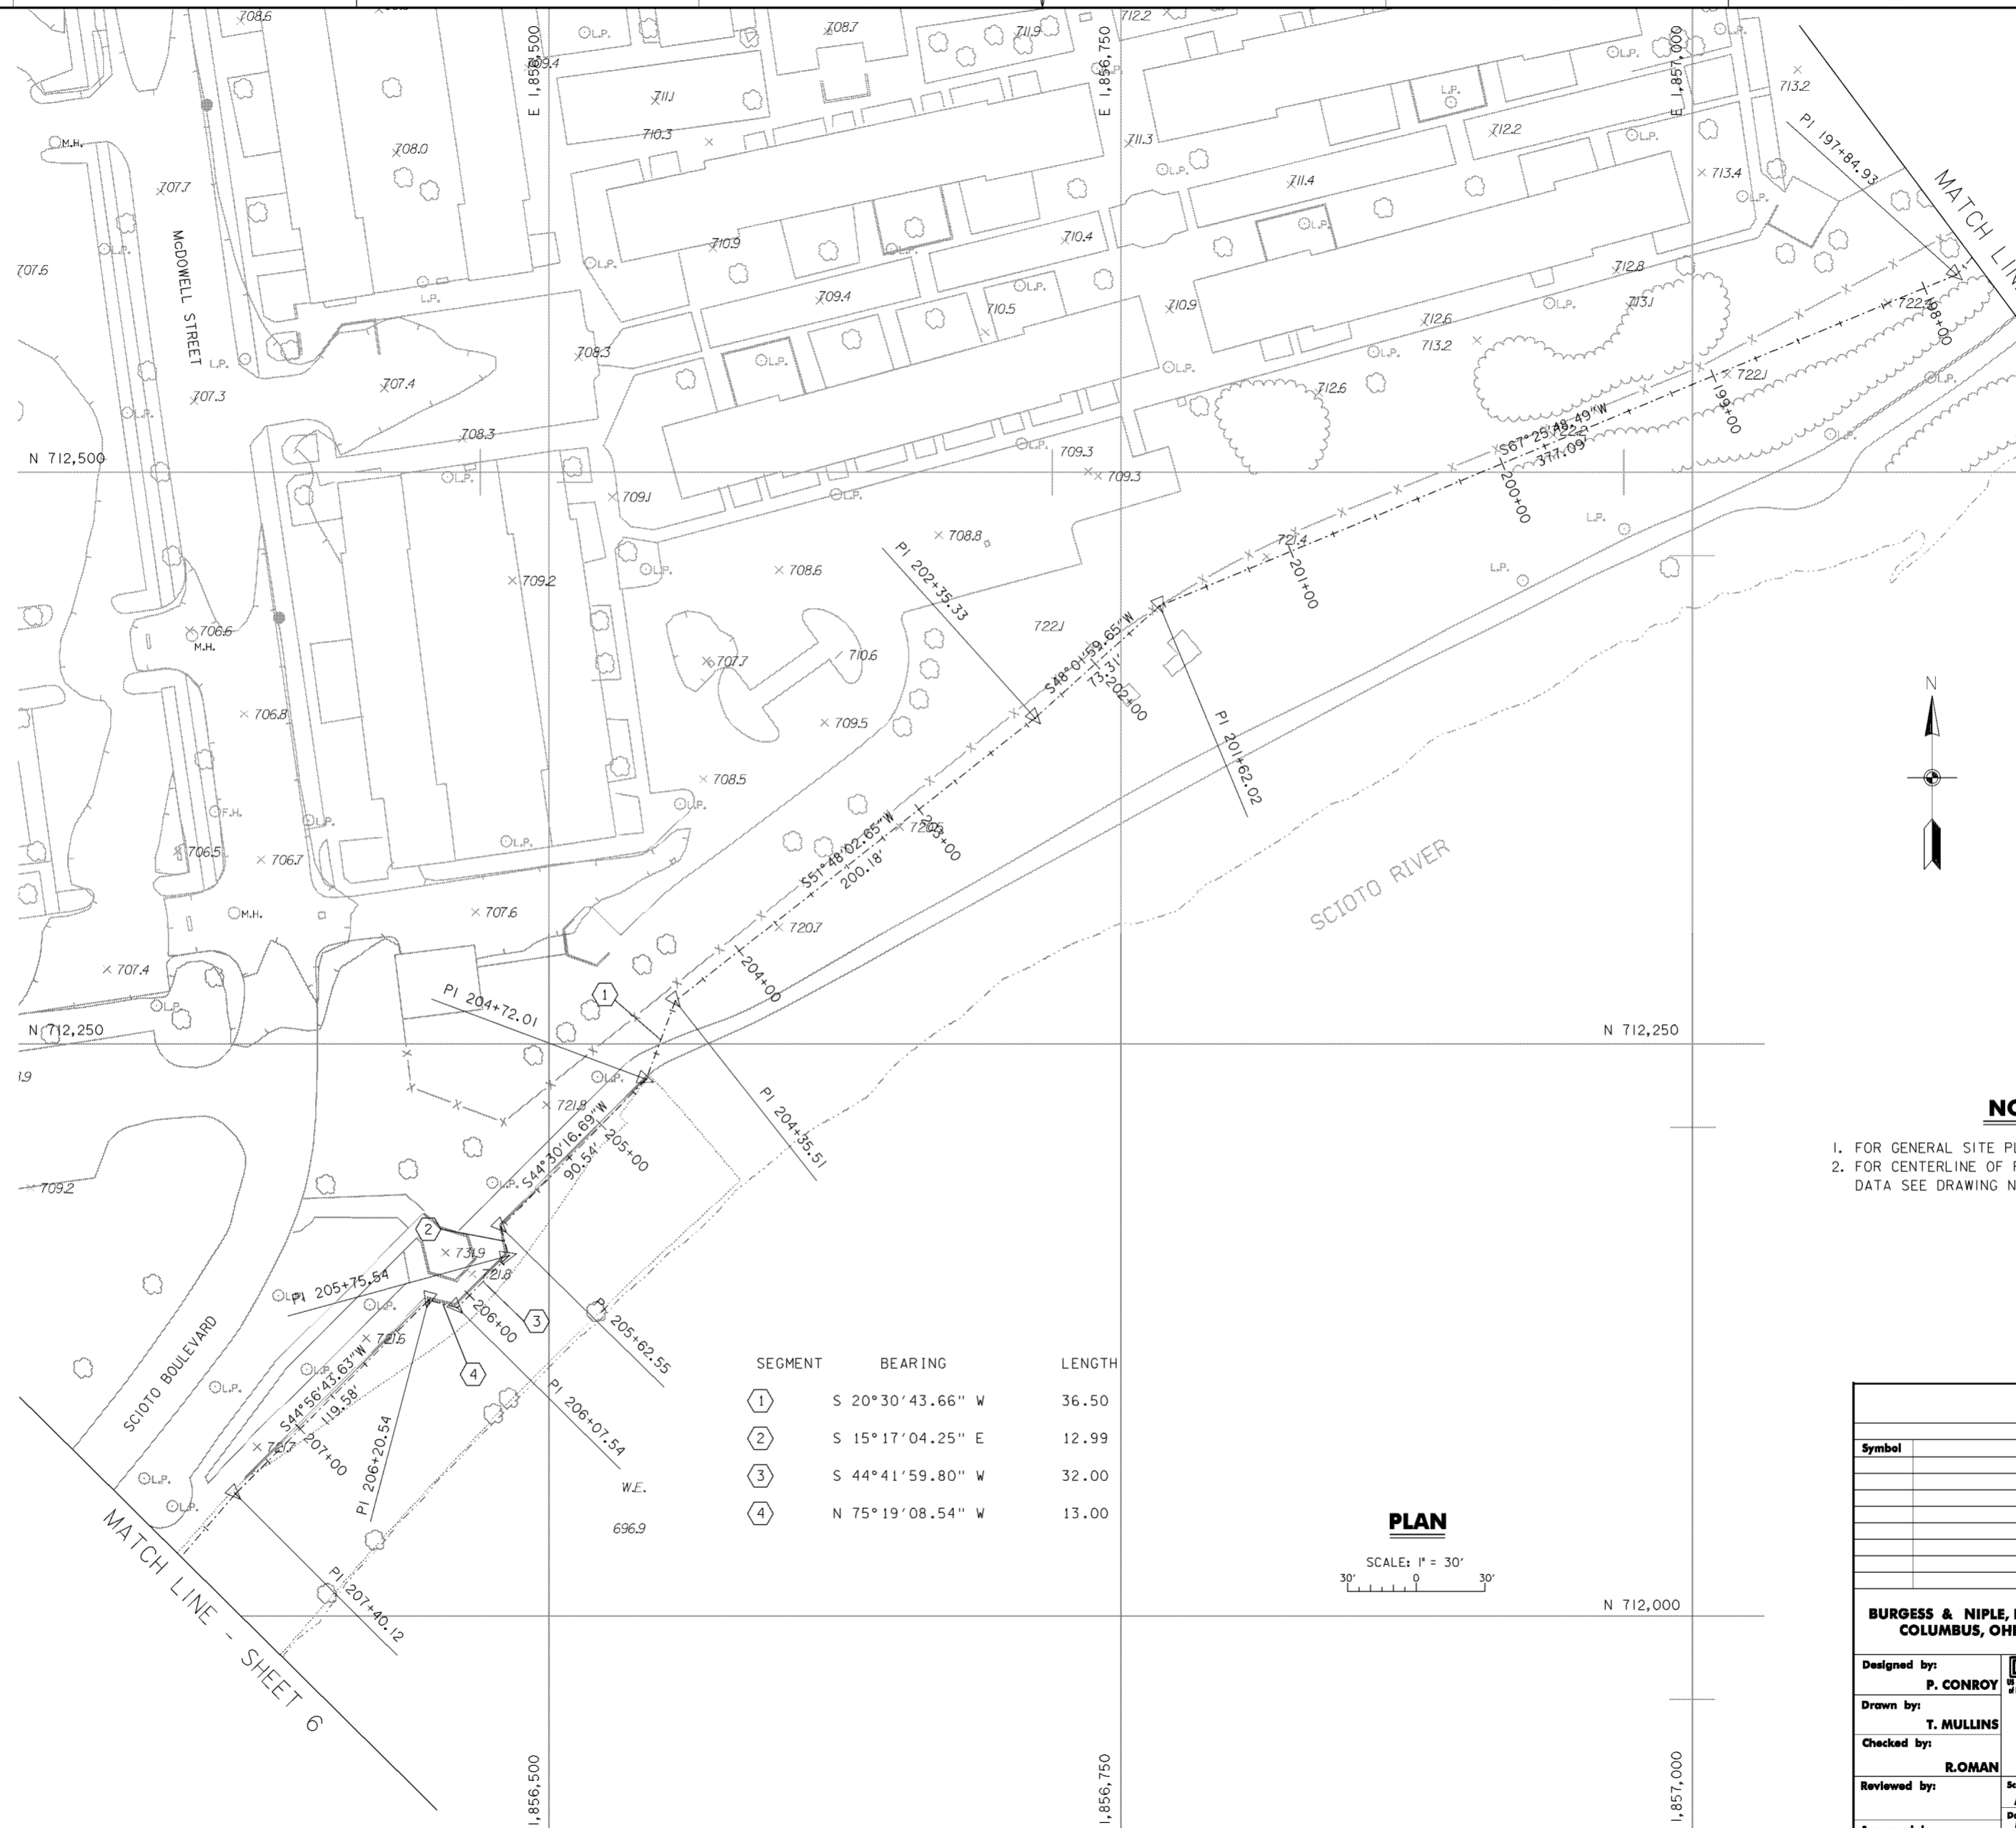

SEGMENT	BEARING	LENGTH
①	S 20° 30' 43.66" W	36.50
②	S 15° 17' 04.25" E	12.99
③	S 44° 41' 59.80" W	32.00
④	N 75° 19' 08.54" W	13.00

PLAN
 SCALE: 1" = 30'
 30' 0 30'

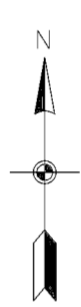


NOTES


1. FOR GENERAL SITE PLAN SEE DRAWING NO. 0/6.
2. FOR CENTERLINE OF PROTECTION ALIGNMENT DATA SEE DRAWING NOS. 11/8 THRU 11/10.

Revisions			
Symbol	Descriptions	Date	Approved

BURGESS & NIPLÉ, LIMITED COLUMBUS, OHIO		U.S. ARMY ENGINEER DISTRICT CORPS OF ENGINEERS HUNTINGTON, WEST VIRGINIA		
		SCIOTO RIVER COLUMBUS, OHIO WEST COLUMBUS, L.P.P. PHASE IID		
Designed by: P. CONROY	CENTERLINE OF PROTECTION (5 OF 6)	Drawn by: T. MULLINS	FILENAME: 00sc05.dgn PEN TABLE:	
Checked by: R.ROMAN		Reviewed by: AS SHOWN		
Approved by:		Date: MARCH 1998		Sheet reference number: 11/6
Drawing Code: 16-PWC-10-		Sheet 5 of 6		

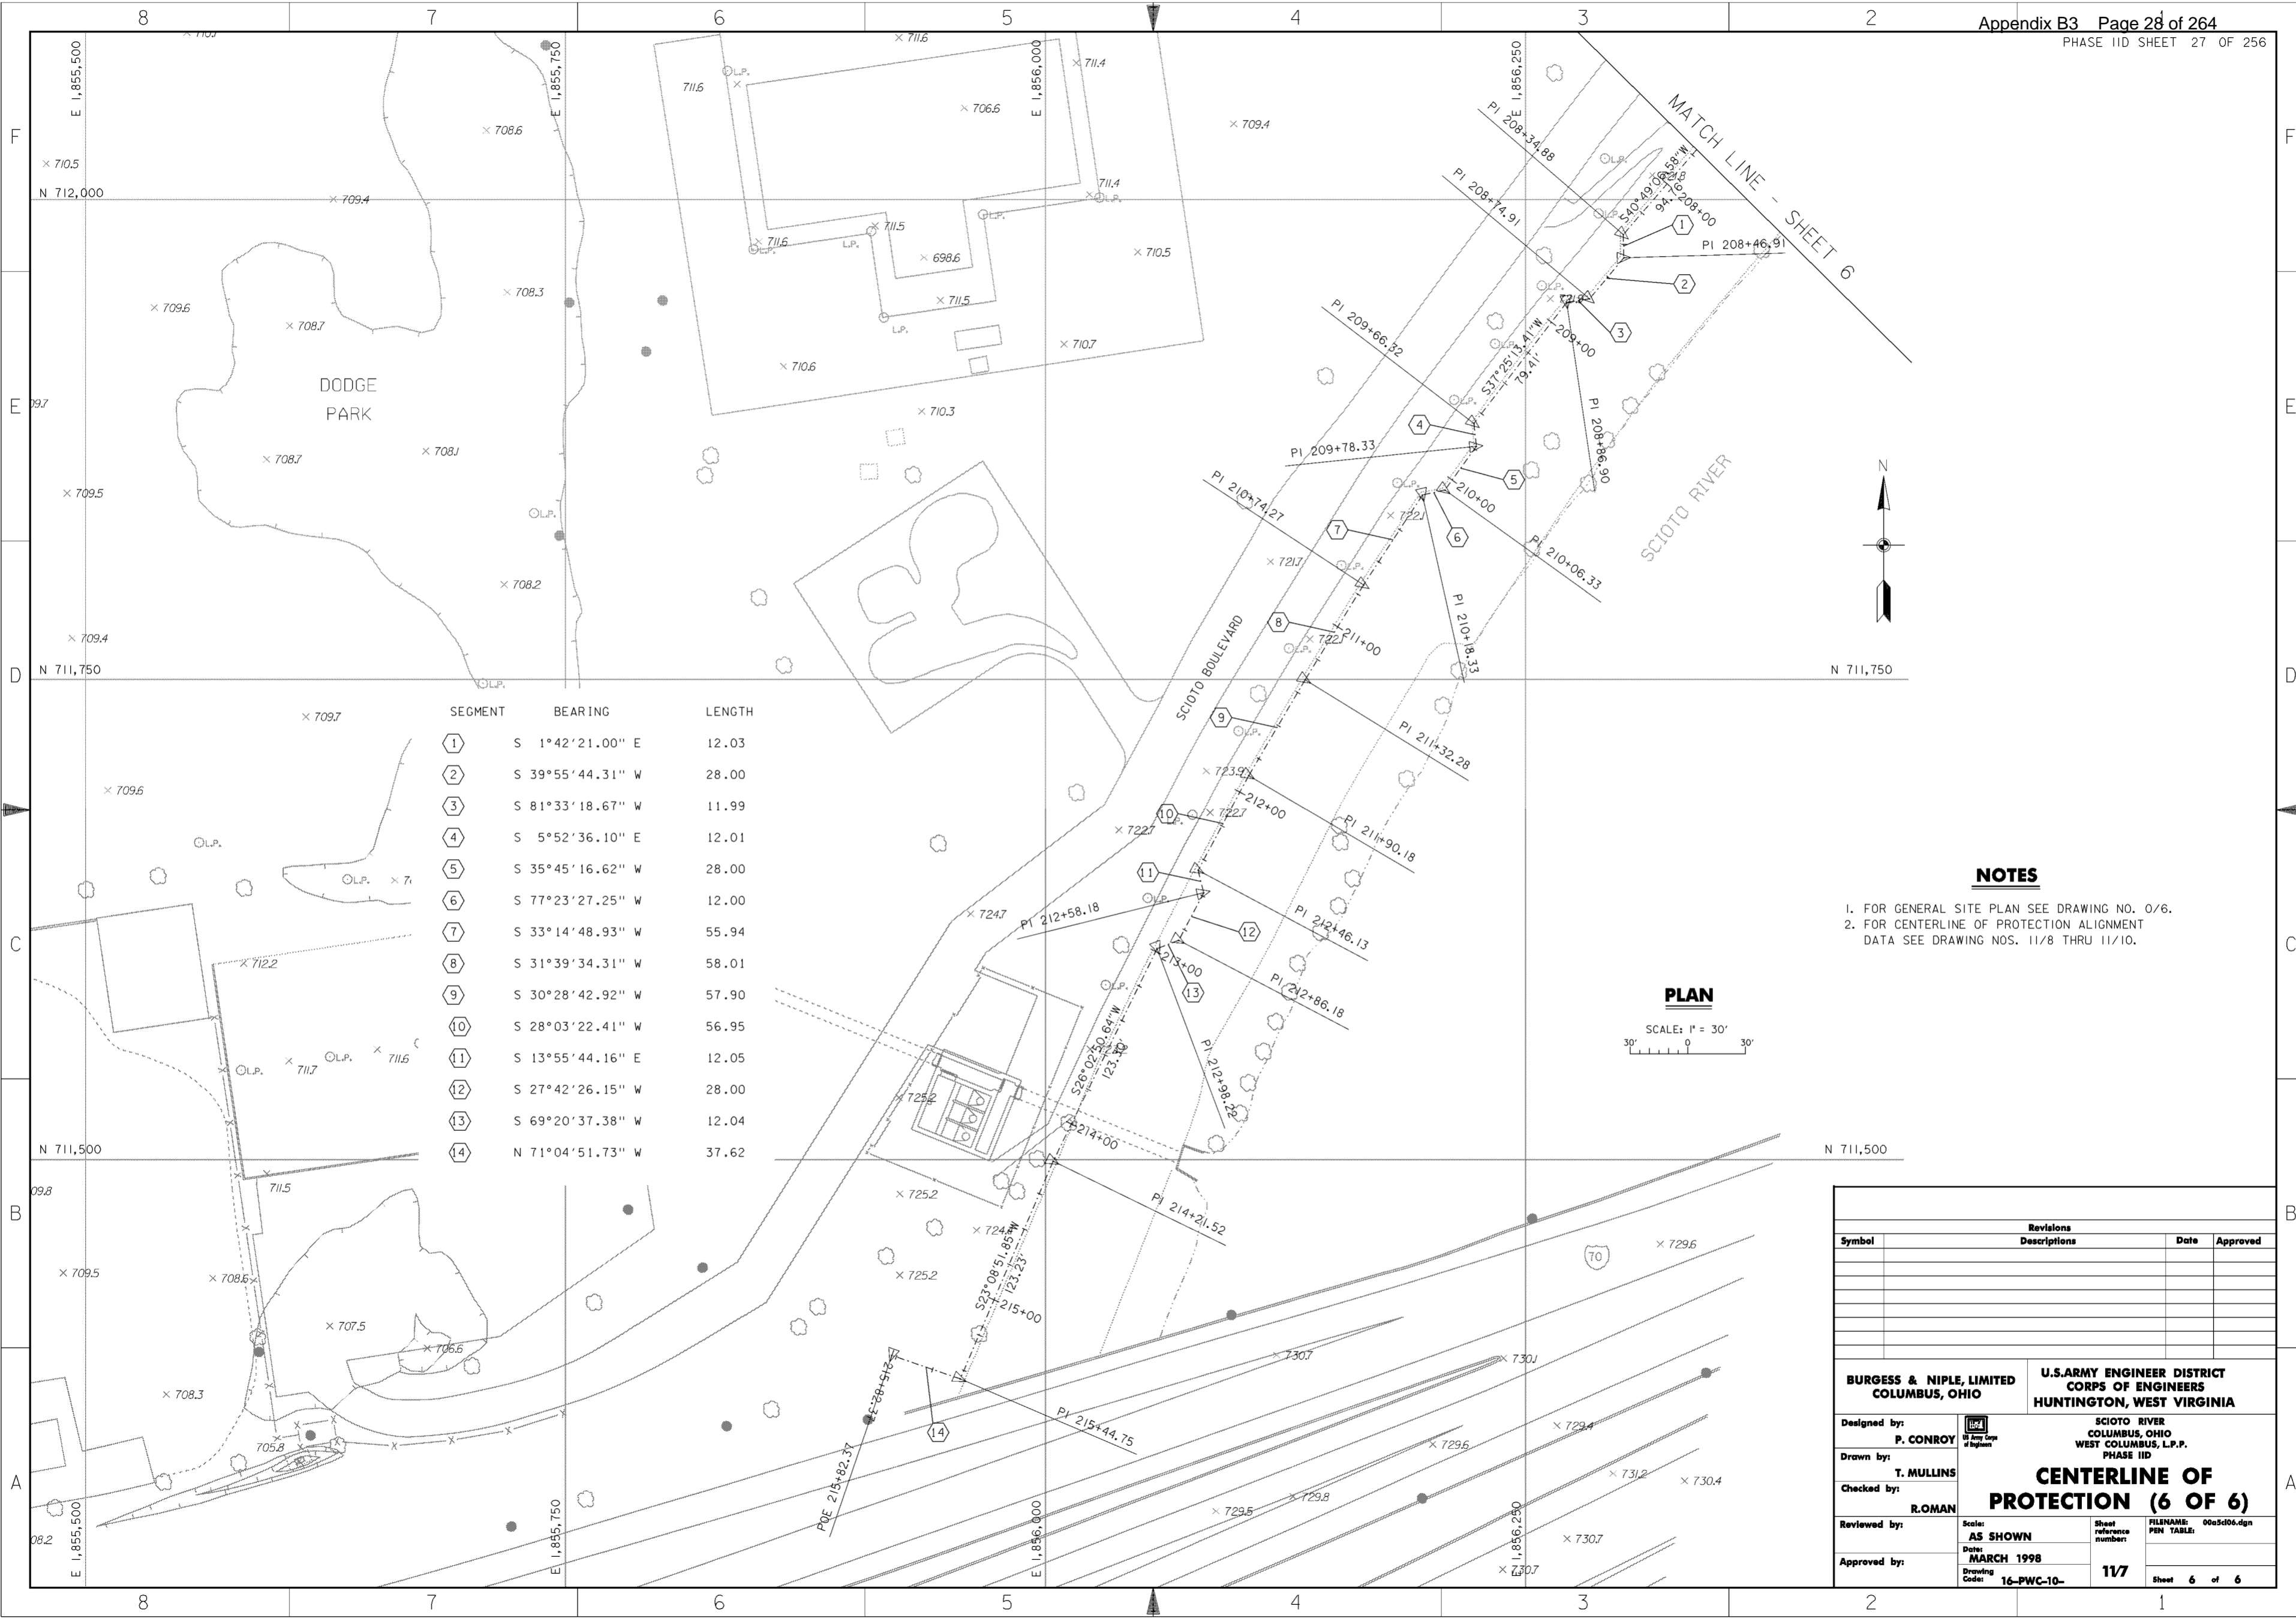

SEGMENT	BEARING	LENGTH
①	S 1°42'21.00" E	12.03
②	S 39°55'44.31" W	28.00
③	S 81°33'18.67" W	11.99
④	S 5°52'36.10" E	12.01
⑤	S 35°45'16.62" W	28.00
⑥	S 77°23'27.25" W	12.00
⑦	S 33°14'48.93" W	55.94
⑧	S 31°39'34.31" W	58.01
⑨	S 30°28'42.92" W	57.90
⑩	S 28°03'22.41" W	56.95
⑪	S 13°55'44.16" E	12.05
⑫	S 27°42'26.15" W	28.00
⑬	S 69°20'37.38" W	12.04
⑭	N 71°04'51.73" W	37.62

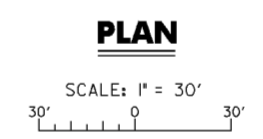


NOTES

1. FOR GENERAL SITE PLAN SEE DRAWING NO. 0/6.
2. FOR CENTERLINE OF PROTECTION ALIGNMENT DATA SEE DRAWING NOS. 11/8 THRU 11/10.

Revisions			
Symbol	Descriptions	Date	Approved

BURGESS & NIPLE, LIMITED COLUMBUS, OHIO	U.S. ARMY ENGINEER DISTRICT CORPS OF ENGINEERS HUNTINGTON, WEST VIRGINIA		
Designed by: P. CONROY	SCIOTO RIVER COLUMBUS, OHIO WEST COLUMBUS, L.P.P. PHASE IID CENTERLINE OF PROTECTION (6 OF 6)		
Drawn by: T. MULLINS			
Checked by: ROMAN			
Reviewed by:			
Approved by:	Scale: AS SHOWN Date: MARCH 1998 Drawing Code: 16-PWC-10-	Sheet reference number: 11/7	FILENAME: 00scd06.dgn PEN TABLE: Sheet 6 of 6

WORK AS CONSTRUCTED

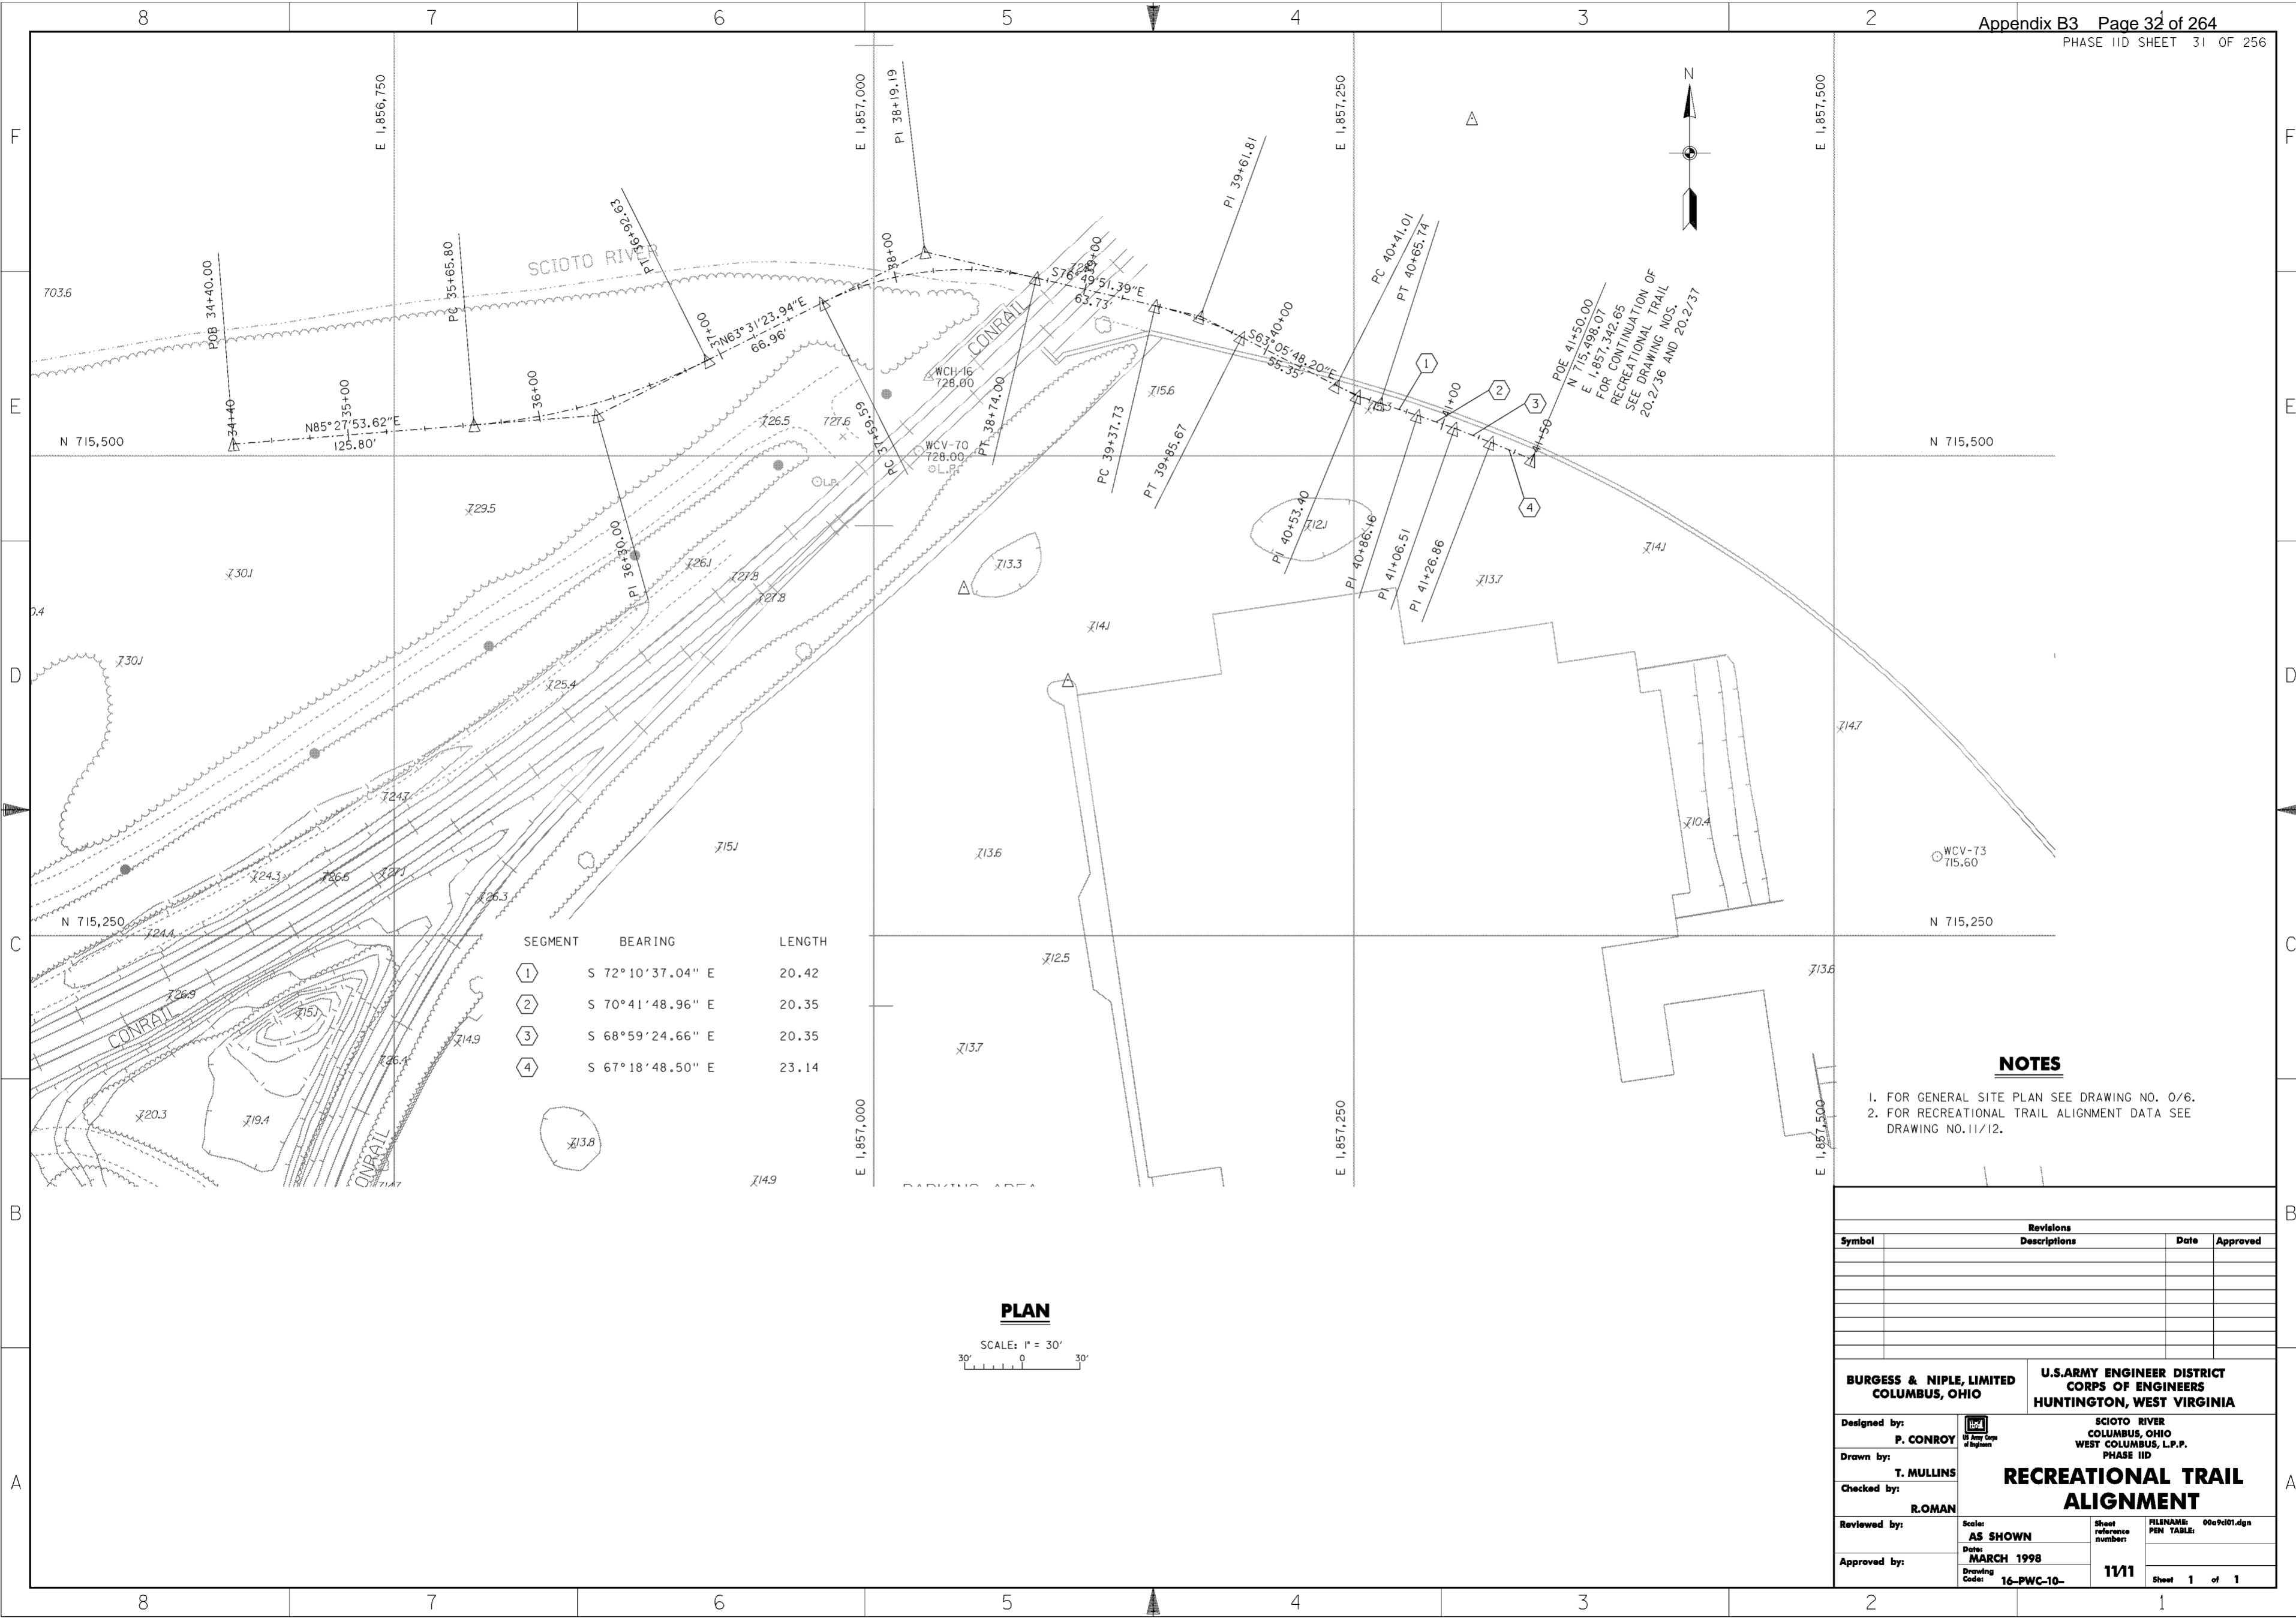

SEGMENT	BEARING	LENGTH
①	S 72° 10' 37.04" E	20.42
②	S 70° 41' 48.96" E	20.35
③	S 68° 59' 24.66" E	20.35
④	S 67° 18' 48.50" E	23.14

PLAN
 SCALE: 1" = 30'

NOTES

- FOR GENERAL SITE PLAN SEE DRAWING NO. 0/6.
- FOR RECREATIONAL TRAIL ALIGNMENT DATA SEE DRAWING NO. 11/12.

Revisions			
Symbol	Descriptions	Date	Approved

BURGESS & NIPLE, LIMITED COLUMBUS, OHIO	U.S. ARMY ENGINEER DISTRICT CORPS OF ENGINEERS HUNTINGTON, WEST VIRGINIA		
Designed by: P. CONROY	SCIOTO RIVER COLUMBUS, OHIO WEST COLUMBUS, L.P.P. PHASE IID RECREATIONAL TRAIL ALIGNMENT		
Drawn by: T. MULLINS			
Checked by: R. OMAN			
Reviewed by:			
Approved by:	Scale: AS SHOWN Date: MARCH 1998 Drawing Code: 16-PWC-10-	Sheet reference number: 11/11	FILENAME: PEN TABLE: 0009d01.dgn Sheet 1 of 1

HORIZONTAL ALIGNMENT DATA FOR RECREATIONAL TRAIL

Element	STATION	NORTH(Y)	EAST(X)
Element: LINEAR			
POB	34+40.00	715506.121	1856666.275
PC	35+65.80	715516.068	1856791.681
Tangent Direction:	N 85°27'53.62" E		
Tangent Length:	125.800		
Element: CIRCULAR CURVE			
PC	35+65.80	715516.068	1856791.681
PI	36+30.00	715521.144	1856855.680
CC	36+92.63	715846.212	1856765.494
PT	36+92.63	715549.767	1856913.146
Curve Radius:	-331.181		
Curve Length:	126.827		
Total Central Angle:	21°56'29.67"		
1st Subtangent Distance:	64.200		
2nd Subtangent Distance:	64.200		
Element: LINEAR			
PT	36+92.63	715549.767	1856913.146
PC	37+59.59	715579.620	1856973.084
Tangent Direction:	N 63°31'23.94" E		
Tangent Length:	66.962		
Element: CIRCULAR CURVE			
PC	37+59.59	715579.620	1856973.084
PI	38+19.19	715606.194	1857026.437
CC	38+74.00	715431.613	1857046.803
PT	38+74.00	715592.615	1857084.474
Curve Radius:	165.350		
Curve Length:	114.414		
Total Central Angle:	39°38'44.67"		
1st Subtangent Distance:	59.604		
2nd Subtangent Distance:	59.604		
Element: LINEAR			
PT	38+74.00	715592.615	1857084.474
PC	39+37.73	715578.096	1857146.523
Tangent Direction:	S 76°49'51.39" E		
Tangent Length:	63.725		
Element: CIRCULAR CURVE			
PC	39+37.73	715578.096	1857146.523
PI	39+61.81	715572.609	1857169.976
CC	39+85.67	715383.356	1857100.958
PT	39+85.67	715561.710	1857191.455
Curve Radius:	200.000		
Curve Length:	47.941		
Total Central Angle:	13°44'03.19"		
1st Subtangent Distance:	24.086		
2nd Subtangent Distance:	24.086		
Element: LINEAR			
PT	39+85.67	715561.710	1857191.455
PC	40+41.01	715536.667	1857240.811
Tangent Direction:	S 63°05'48.20" E		
Tangent Length:	55.346		
Element: CIRCULAR CURVE			
PC	40+41.01	715536.667	1857240.811
PI	40+53.40	715531.062	1857251.858
CC	40+65.74	715675.783	1857311.399
PT	40+65.74	715527.270	1857263.651
Curve Radius:	-156.000		
Curve Length:	24.723		
Total Central Angle:	9°04'48.84"		
1st Subtangent Distance:	12.387		
2nd Subtangent Distance:	12.387		
Element: LINEAR			
PT	40+65.74	715527.270	1857263.651
PI	40+86.16	715521.020	1857283.092
Tangent Direction:	S 72°10'37.04" E		
Tangent Length:	20.421		
Element: LINEAR			
PI	40+86.16	715521.020	1857283.092
PI	41+06.51	715514.293	1857302.298
Tangent Direction:	S 70°41'48.96" E		
Tangent Length:	20.350		

Element	STATION	ELEVATION
Element: LINEAR		
PI	41+06.51	715514.293
PI	41+26.86	715506.997
Tangent Direction:	S 68°59'24.66" E	
Tangent Length:	20.350	
Element: LINEAR		
PI	41+26.86	715506.997
POE	41+50.00	715498.072
Tangent Direction:	S 67°18'48.50" E	
Tangent Length:	23.140	
Element: Linear		
POB	34+40.00	724.24
PVC	34+50.00	724.75
Tangent Grade:	5.0588	
Tangent Length:	10.00	
Element: Parabola		
PVC	34+50.00	724.75
PVI	35+25.00	728.54
PVT	36+00.00	724.73
VHIGH	35+24.89	726.64
Length:	150.00	
Entrance Grade:	5.0588	
Exit Grade:	-5.0740	
r = (g2 - g1) / L:	-6.7552	
K = 1 / (g2 - g1):	14.8034	
Middle Ordinate:	-1.90	
Element: Linear		
PVT	36+00.00	724.73
PVC	38+44.70	712.32
Tangent Grade:	-5.0740	
Tangent Length:	244.70	
Element: Parabola		
PVC	38+44.70	712.32
PVI	38+69.70	711.05
PVT	38+94.70	711.05
VLOW	38+94.70	711.05
Length:	50.00	
Entrance Grade:	-5.0740	
Exit Grade:	0.0000	
r = (g2 - g1) / L:	10.1480	
K = 1 / (g2 - g1):	9.8542	
Middle Ordinate:	0.32	
Element: Linear		
PVT	38+94.70	711.05
PVC	39+20.00	711.05
Tangent Grade:	0.0000	
Tangent Length:	25.30	
Element: Parabola		
PVC	39+20.00	711.05
PVI	39+40.00	711.05
PVT	39+60.00	712.05
VLOW	39+20.00	711.05
Length:	40.00	
Entrance Grade:	0.0000	
Exit Grade:	5.0000	
r = (g2 - g1) / L:	12.5000	
K = 1 / (g2 - g1):	8.0000	
Middle Ordinate:	0.25	

VERTICAL ALIGNMENT DATA FOR RECREATIONAL TRAIL

Element	STATION	ELEVATION
Element: Linear		
PVT	39+60.00	712.05
PVC	39+99.00	714.00
Tangent Grade:	5.0000	
Tangent Length:	39.00	
Element: Parabola		
PVC	39+99.00	714.00
PVI	40+19.00	715.00
PVT	40+39.00	715.00
VHIGH	40+39.00	715.00
Length:	40.00	
Entrance Grade:	5.0000	
Exit Grade:	0.0000	
r = (g2 - g1) / L:	-12.5000	
K = 1 / (g2 - g1):	8.0000	
Middle Ordinate:	-0.25	
Element: Linear		
PVT	40+39.00	715.00
PVI	41+50.00	715.00
Tangent Grade:	0.0000	
Tangent Length:	111.00	

Revisions			
Symbol	Descriptions	Date	Approved

BURGESS & NIPLE, LIMITED COLUMBUS, OHIO	U.S. ARMY ENGINEER DISTRICT CORPS OF ENGINEERS HUNTINGTON, WEST VIRGINIA
Designed by: J.HALL	SCIO TO RIVER COLUMBUS, OHIO WEST COLUMBUS, L.P.P. PHASE IID
Drawn by: T.MULLINS	RECREATIONAL TRAIL ALIGNMENT DATA
Checked by: P.CONROY	Scale: NONE Date: MARCH 1998 Drawing Code: 16-PWC-10-
Reviewed by:	Sheet reference number: 11/12 FILENAME: 009m01.dgn PEN TABLE:
Approved by:	Sheet 1 of 1

GENERAL NOTES:

- 1) MAINLINE PIPING SHALL BE BURIED A MINIMUM OF 16" OF COVER AND A MAXIMUM OF 24" OF COVER. LATERAL LINE PIPING A MIN. OF 12" OF COVER. ALL BACKFILL SURROUNDING THE PIPE SHALL BE SCREENED AND CLEANED OF MATERIAL LARGER THAN 1" IN SIZE. BACKFILL SHALL BE ADDED IN 6" INCREMENTS AND MECHANICALLY TAMPED.
- 2) SYSTEM REQUIREMENTS ARE 35 GPM @ 85 PSI AT POINT OF CONNECTION. PRESSURE REQUIREMENTS ARE 45 PSI THRU THE ROTARY HEADS AND 30 PSI AT THE FIXED SPRAY HEADS.
- 3) UNMARKED PIPING SHALL BE 1" PVC PIPE UNLESS OTHERWISE NOTED.
- 4) PIPE SHOWN IN PAVED AREA WITHOUT SLEEVE SHALL BE LOCATED INSIDE OF AND WITHIN 12" OF CURB OR EDGE OF WALK.
- 5) NOTE ZONES THAT ARE SERVICING SHRUB & GROUND COVER AREAS. OVERSPRAY FROM TURF ZONES INTO SHRUB & GROUND COVER AREAS IS TO BE AVOIDED.
- 6) FOR MISCELLANEOUS IRRIGATION DETAILS, SEE DRAWING NO. 12/7

IRRIGATION PIPE TABLE


LENGTH	SYMBOL	PIPE
2820	-	1" 200 PSI SDR 21 PVC PIPE ENGLISH UNITS
870	-	1/2" 200 PSI SDR 21 PVC PIPE ENGLISH UNITS
190	-	1/2" 200 PSI SDR 21 PVC PIPE ENGLISH UNITS
922	-	2" 200 PSI SDR 21 PVC PIPE ENGLISH UNITS
50	-	6" 200 PSI SDR 21 PVC PIPE ENGLISH UNITS

IRRIGATION EQUIPMENT TABLE

QUANTITY	SYMBOL	EQUIPMENT
4	⊗	OB5RC-10 QUICK COUPLER VALVE
1	⊠	RAINBIRD ESP-12 SAI-25, 12 STATION CONTROLLER
1	⊞	FEBCO 325 SERIES 1/2" REDUCED PRESSURE ASSEMBLY
1	⊕	METER
19	⊙	HUNTER ICV SERIES ZONE VALVE
1	⊖	HUNTER MINI-CLIK RAIN SENSOR


IRRIGATION HEADS TABLE

QUANTITY	SYMBOL	EQUIPMENT
5	⊙	OB5RC-10 QUICK COUPLER VALVE
33	⊙	HUNTER SRS MODEL -10A 180
6	⊙	HUNTER SRS MODEL -10A 90
7	⊙	HUNTER SRS MODEL CST
19	⊙	HUNTER SRS MODEL EST
10	⊙	HUNTER SRS MODEL SST
15	⊙	HUNTER PGP NOZZLE 2.0 ADJ
12	⊙	HUNTER PGP NOZZLE 7 ADJ
15	⊙	HUNTER 1-25/31 PLUS 1-25-*10- LT GREEN ADJ
1	⊙	HUNTER 1-25/31 PLUS 1-25-*7- ORANGE ADJ
5	⊙	HUNTER PGP NOZZLE 8 360
4	⊙	HUNTER PGP NOZZLE 6 ADJ
4	⊙	HUNTER PGP NOZZLE 1.5 ADJ
6	⊙	HUNTER SRS-04 MODEL -15A 180
1	⊙	HUNTER PGM NOZZLE 3.0 360

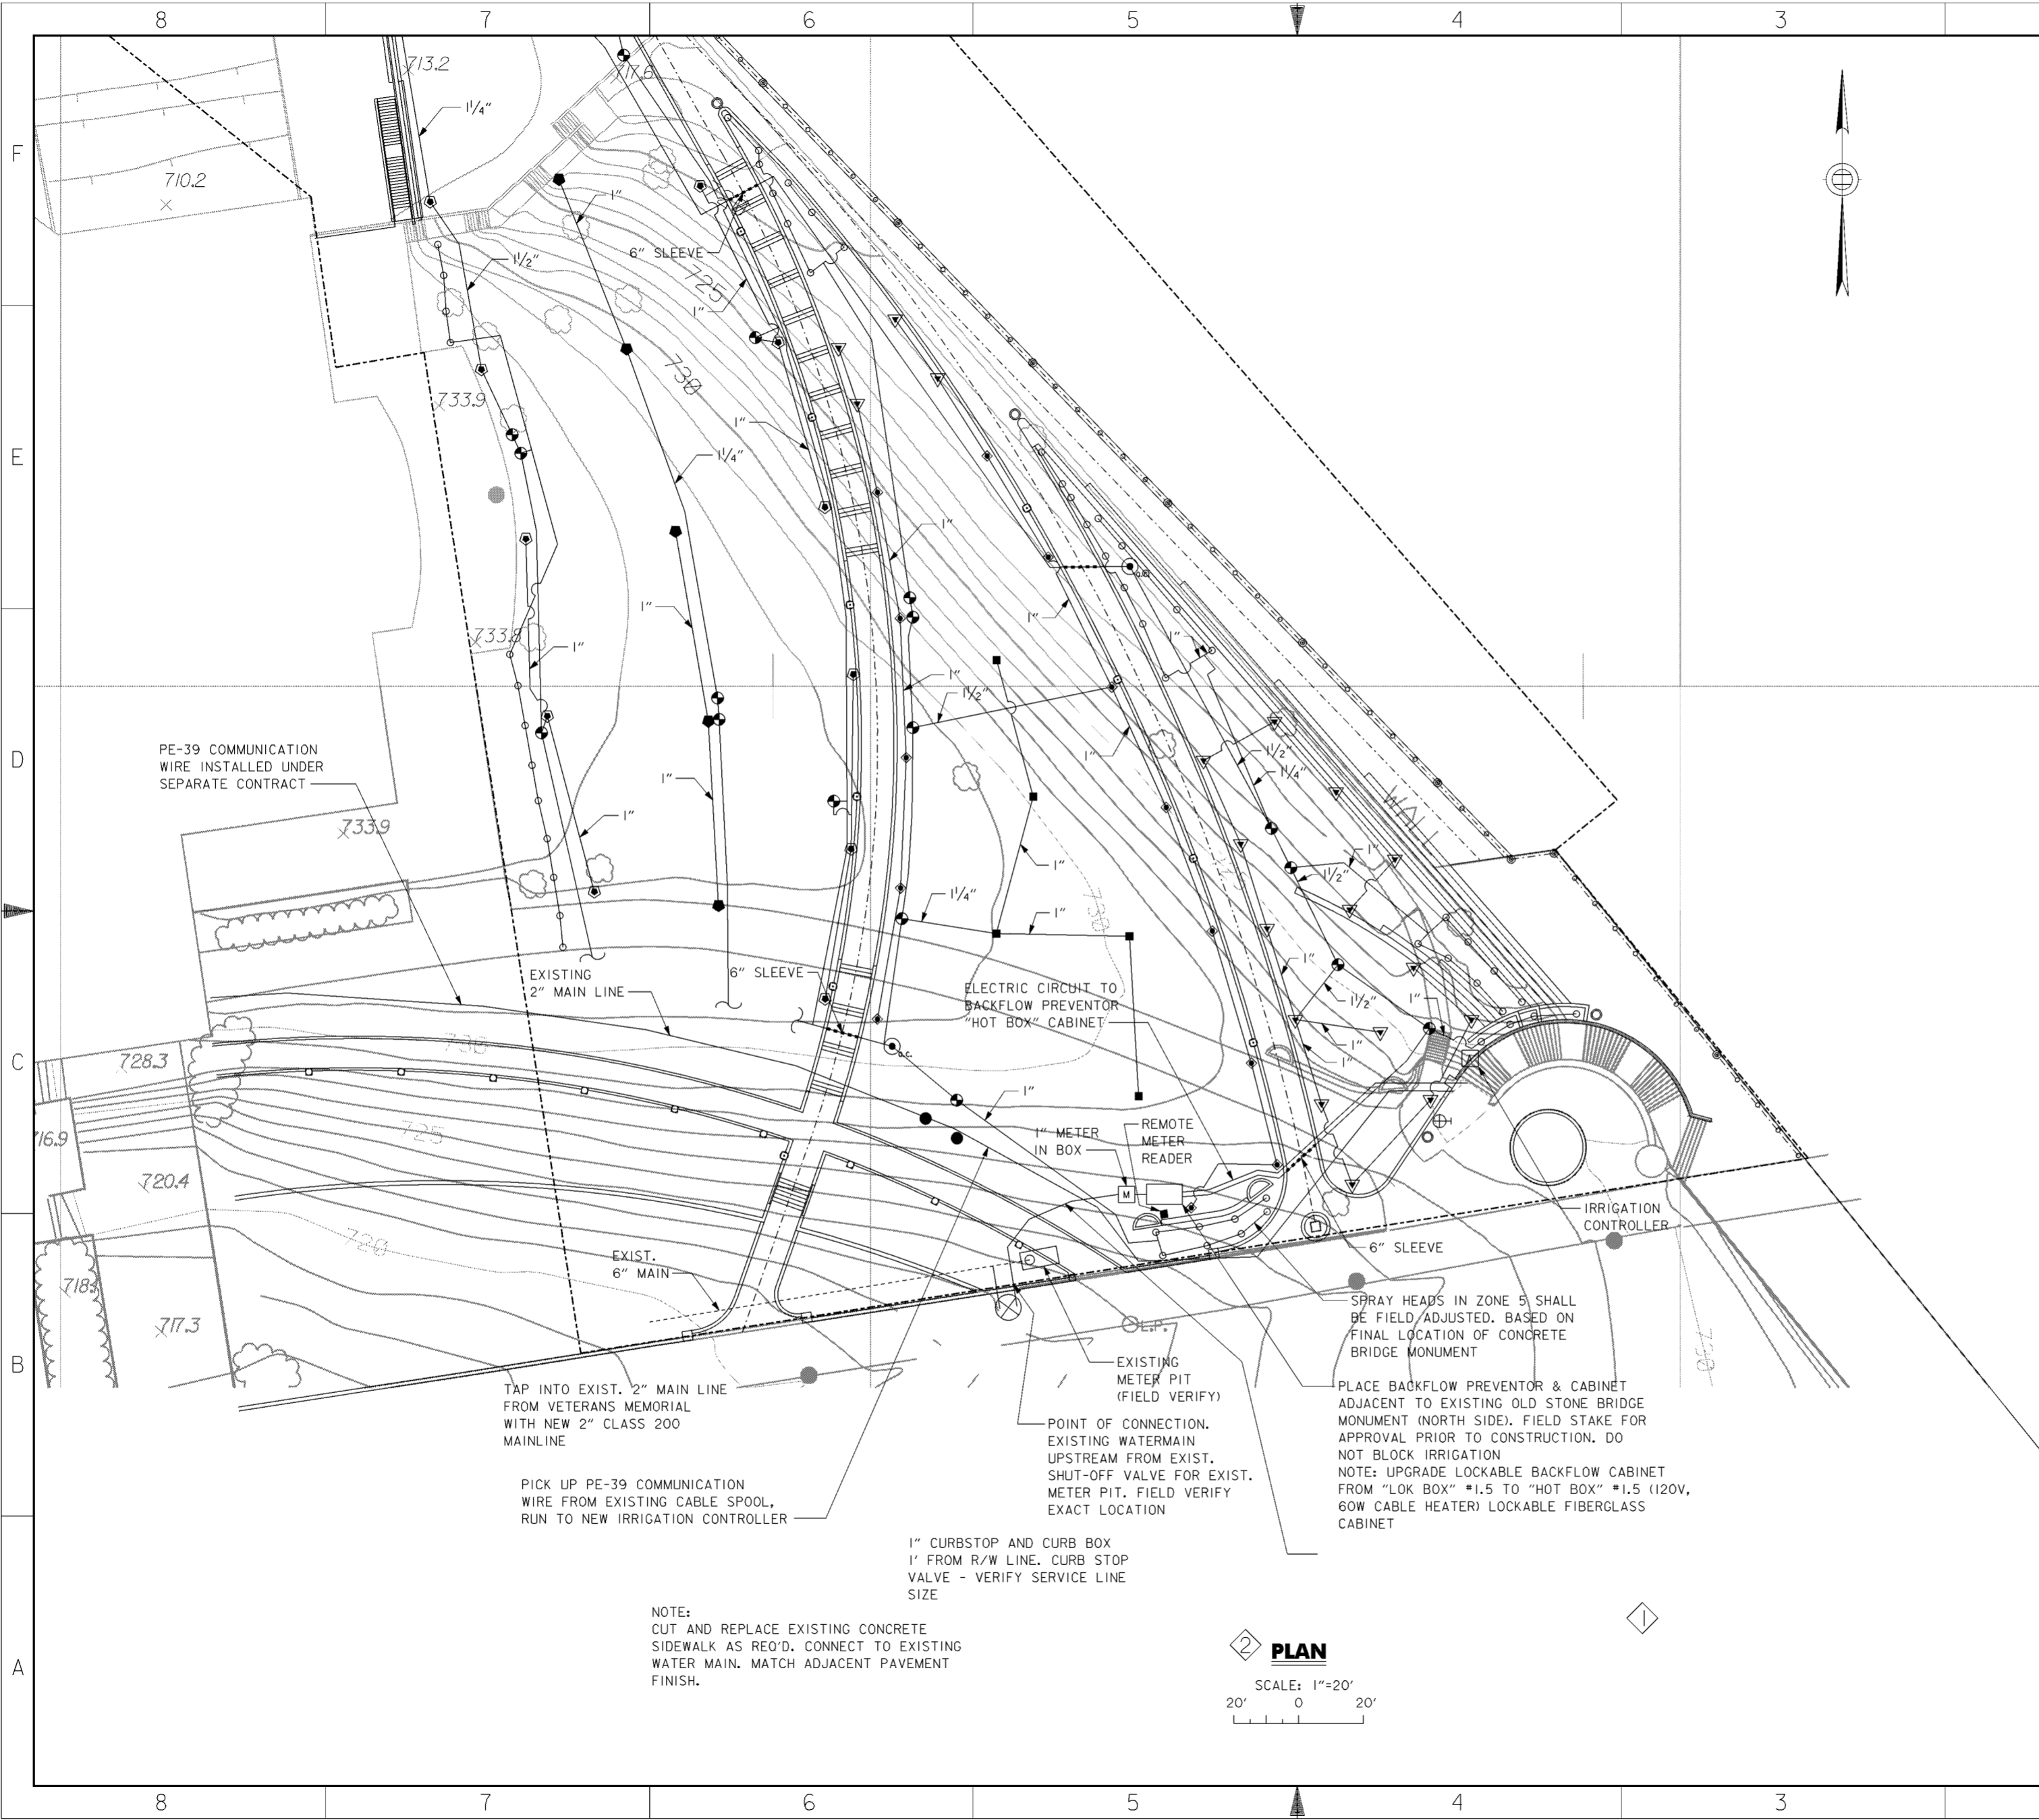


Symbol	Revisions Descriptions	Date	Approved
⊠	REVISED AS CONSTRUCTED	7/02	P.O.C.
⊠	REVISED IN ACCORDANCE WITH MC0032	8/9/00	P.O.C.

BURGESS & NIPLE, LIMITED COLUMBUS, OHIO		U.S. ARMY ENGINEER DISTRICT CORPS OF ENGINEERS HUNTINGTON, WEST VIRGINIA	
Designed by:	WPC	SCIOTO RIVER COLUMBUS, OHIO WEST COLUMBUS, L.P.P. PHASE IID	
Drawn by:	TS	VETERANS MEMORIAL IRRIGATION PLAN (2 OF 2)	
Checked by:	TSS	Scale: 1" = 20'-0"	Sheet reference number: 12 / 6
Reviewed by:		Date: MARCH 1998	Sheet 2 of 2
Approved by:		Drawing Code: 16-PWC-10-	

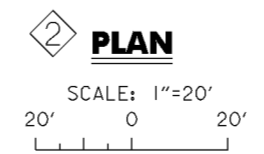

WORK AS CONSTRUCTED

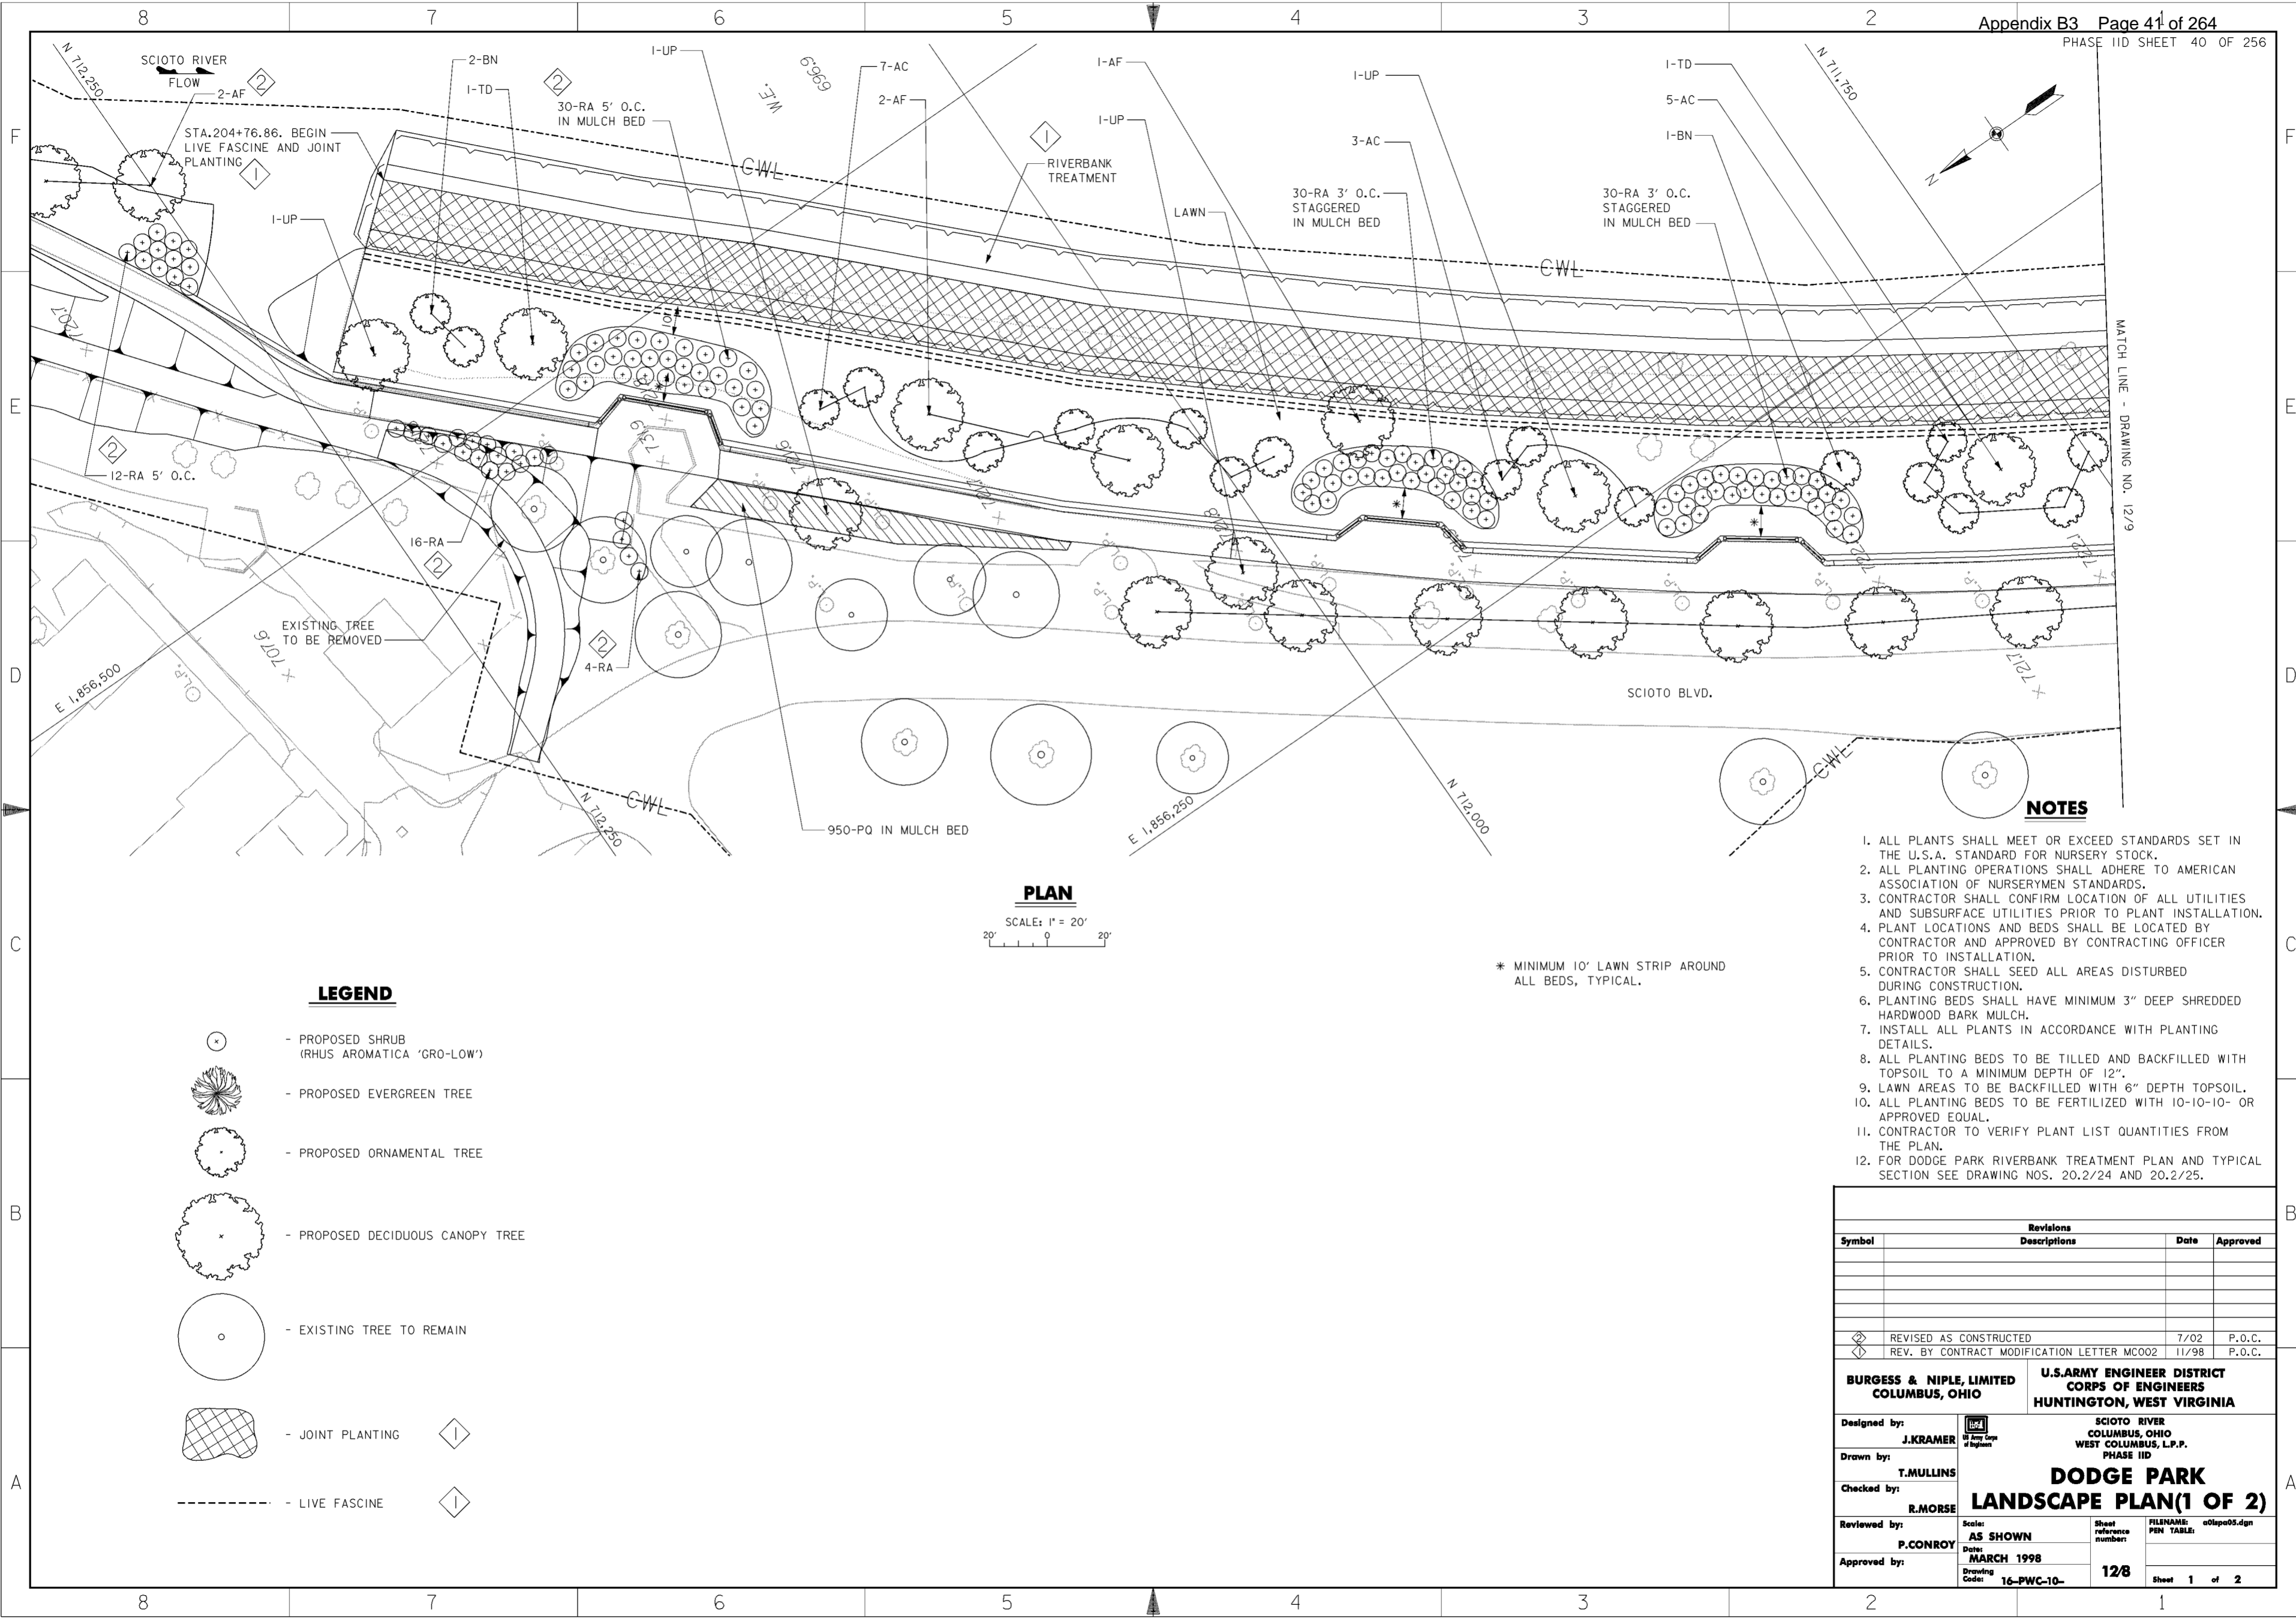

PLAN

SCALE: 1" = 20'

NOTES

1. ALL PLANTS SHALL MEET OR EXCEED STANDARDS SET IN THE U.S.A. STANDARD FOR NURSERY STOCK.
2. ALL PLANTING OPERATIONS SHALL ADHERE TO AMERICAN ASSOCIATION OF NURSERYMEN STANDARDS.
3. CONTRACTOR SHALL CONFIRM LOCATION OF ALL UTILITIES AND SUBSURFACE UTILITIES PRIOR TO PLANT INSTALLATION.
4. PLANT LOCATIONS AND BEDS SHALL BE LOCATED BY CONTRACTOR AND APPROVED BY CONTRACTING OFFICER PRIOR TO INSTALLATION.
5. CONTRACTOR SHALL SEED ALL AREAS DISTURBED DURING CONSTRUCTION.
6. PLANTING BEDS SHALL HAVE MINIMUM 3" DEEP SHREDDED HARDWOOD BARK MULCH.
7. INSTALL ALL PLANTS IN ACCORDANCE WITH PLANTING DETAILS.
8. ALL PLANTING BEDS TO BE TILLED AND BACKFILLED WITH TOPSOIL TO A MINIMUM DEPTH OF 12".
9. LAWN AREAS TO BE BACKFILLED WITH 6" DEPTH TOPSOIL.
10. ALL PLANTING BEDS TO BE FERTILIZED WITH 10-10-10- OR APPROVED EQUAL.
11. CONTRACTOR TO VERIFY PLANT LIST QUANTITIES FROM THE PLAN.
12. FOR DODGE PARK RIVERBANK TREATMENT PLAN AND TYPICAL SECTION SEE DRAWING NOS. 20.2/24 AND 20.2/25.


LEGEND

- PROPOSED SHRUB (RHUS AROMATICA 'GRO-LOW')
- PROPOSED EVERGREEN TREE
- PROPOSED ORNAMENTAL TREE
- PROPOSED DECIDUOUS CANOPY TREE
- EXISTING TREE TO REMAIN
- JOINT PLANTING
- LIVE FASCINE

* MINIMUM 10' LAWN STRIP AROUND ALL BEDS, TYPICAL.

Revisions			
Symbol	Descriptions	Date	Approved
◇	REVISED AS CONSTRUCTED	7/02	P.O.C.
◇	REV. BY CONTRACT MODIFICATION LETTER MCO02	11/98	P.O.C.

BURGESS & NIPLE, LIMITED COLUMBUS, OHIO	U.S. ARMY ENGINEER DISTRICT CORPS OF ENGINEERS HUNTINGTON, WEST VIRGINIA	Designed by: J.KRAMER	SCIOTO RIVER COLUMBUS, OHIO WEST COLUMBUS, L.P.P. PHASE IID
		Drawn by: T.MULLINS	
Checked by: R.MORSE	DODGE PARK LANDSCAPE PLAN(1 OF 2)		Reviewed by: P.CONROY
Approved by: P.CONROY			Scale: AS SHOWN

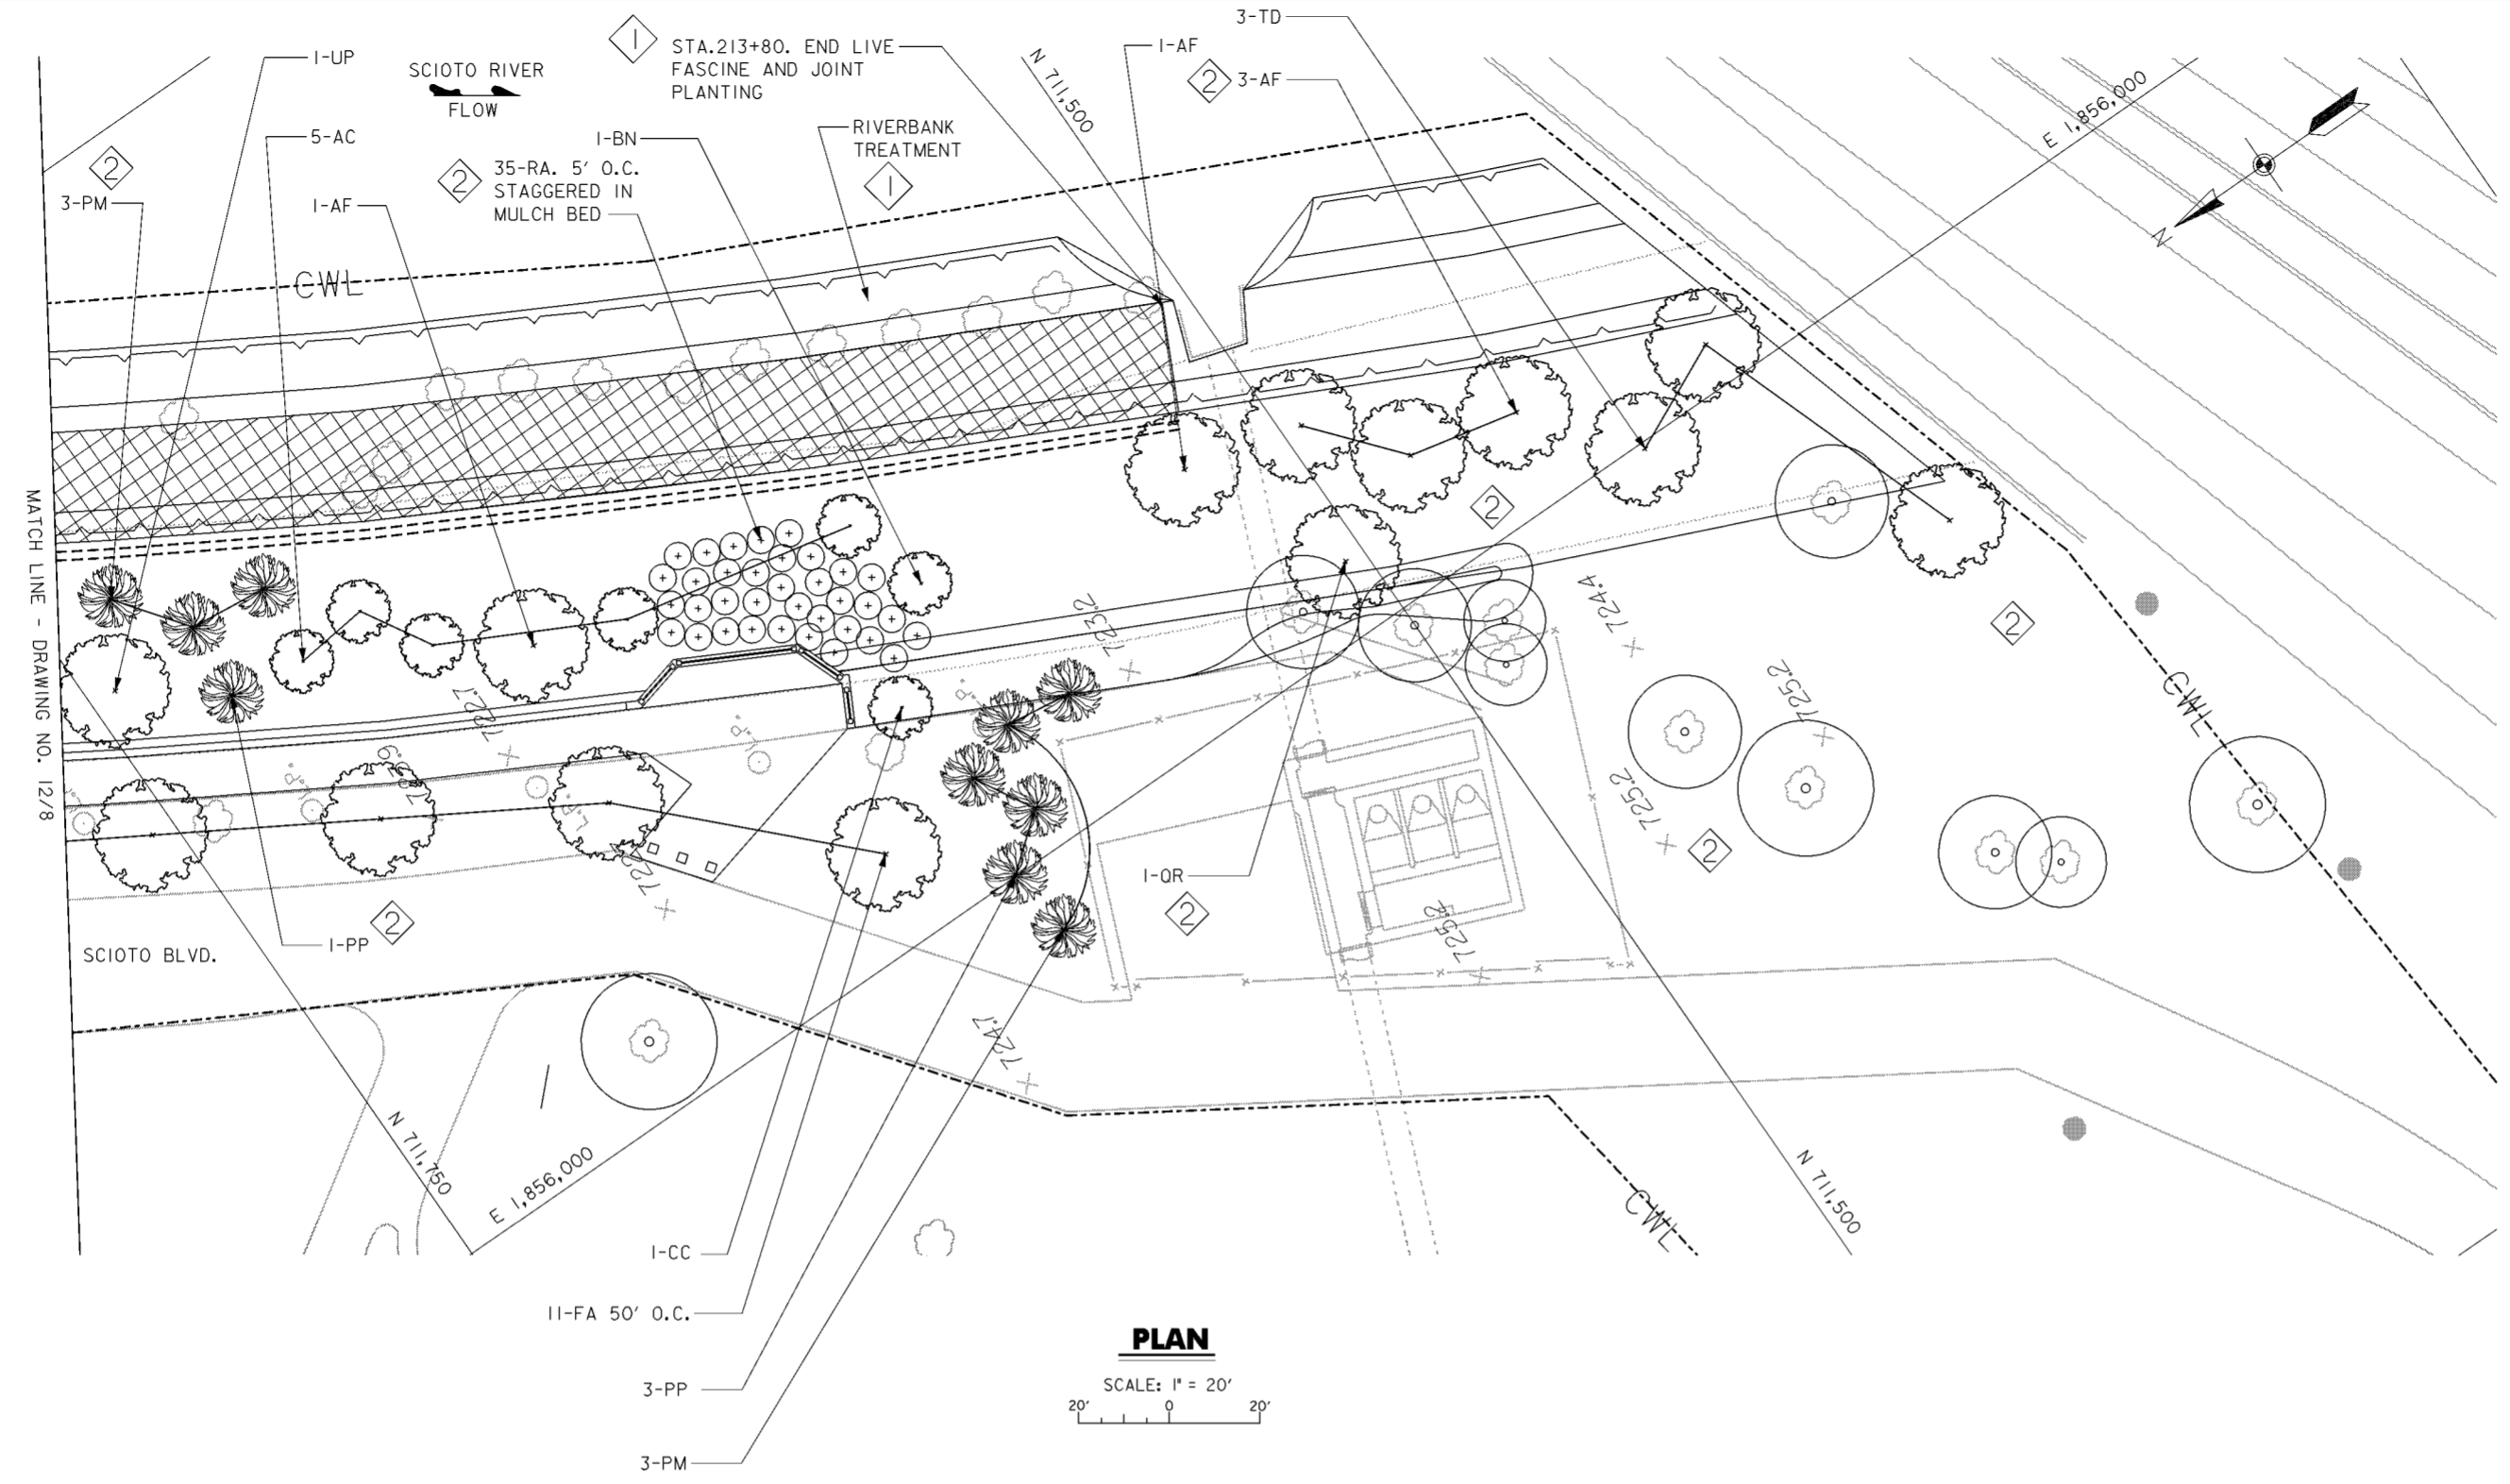

PLAN
 SCALE: 1" = 20'

LEGEND

- PROPOSED SHRUB (RHUS AROMATICA 'GRO-LOW')
- PROPOSED EVERGREEN TREE
- PROPOSED ORNAMENTAL TREE
- PROPOSED DECIDUOUS CANOPY TREE
- EXISTING TREE TO REMAIN
- JOINT PLANTING
- LIVE FASCINE

NOTES


1. ALL PLANTS SHALL MEET OR EXCEED STANDARDS SET IN THE U.S.A. STANDARD FOR NURSERY STOCK.
2. ALL PLANTING OPERATIONS SHALL ADHERE TO AMERICAN ASSOCIATION OF NURSERYMEN STANDARDS.
3. CONTRACTOR SHALL CONFIRM LOCATION OF ALL UTILITIES AND SUBSURFACE UTILITIES PRIOR TO PLANT INSTALLATION.
4. PLANT LOCATIONS AND BEDS SHALL BE LOCATED BY CONTRACTOR AND APPROVED BY CONTRACTING OFFICER PRIOR TO INSTALLATION.
5. CONTRACTOR SHALL SEED ALL AREAS DISTURBED DURING CONSTRUCTION.
6. PLANTING BEDS SHALL HAVE MINIMUM 3" DEEP SHREDDED HARDWOOD BARK MULCH.
7. INSTALL ALL PLANTS IN ACCORDANCE WITH PLANTING DETAILS.
8. ALL PLANTING BEDS TO BE TILLED AND BACKFILLED WITH TOPSOIL TO A MINIMUM DEPTH OF 12".
9. LAWN AREAS TO BE BACKFILLED WITH 6" DEPTH TOPSOIL.
10. ALL PLANTING BEDS TO BE FERTILIZED WITH 10-10-10- OR APPROVED EQUAL.
11. CONTRACTOR TO VERIFY PLANT LIST QUANTITIES FROM THE PLAN.
12. FOR DODGE PARK RIVERBANK TREATMENT PLAN AND TYPICAL SECTION SEE DRAWING NOS. 20.2/24 AND 20.2/25.

Revisions			
Symbol	Descriptions	Date	Approved
◊	REVISED AS CONSTRUCTED	7/02	P.O.C.
◊	REV. BY CONTRACT MODIFICATION LETTER MCO02	11/98	P.O.C.

BURGESS & NIPLE, LIMITED COLUMBUS, OHIO	U.S. ARMY ENGINEER DISTRICT CORPS OF ENGINEERS HUNTINGTON, WEST VIRGINIA
Designed by: J. KRAMER	SCIOTO RIVER COLUMBUS, OHIO WEST COLUMBUS, L.P.P. PHASE IID DODGE PARK LANDSCAPE PLAN(2 OF 2)
Drawn by: T. MULLINS	
Checked by: R. MORSE	
Reviewed by: P. CONROY	
Approved by:	Scale: AS SHOWN Date: MARCH 1998 Drawing Code: 16-PWC-10-
	Sheet reference number: 12/9 FILENAME: a0lap06.dgn PEN TABLE: Sheet 2 of 2


PLANT LIST (DODGE PARK)						
KEY	QUAN.	BOTANICAL NAME	COMMON NAME	SIZE	COND.	REMARKS
SHADE TREES						
AF	14	ACER FREEMANII 'AUTUMN BLAZE'	AUTUMN BLAZE MAPLE	2" CAL.	B&B	
FA	11	FRAXINUS AMERICANA 'AUTUMN PURPLE'	AUTUMN PURPLE ASH	3" CAL.	B&B	
QR	2	QUERCUS RUBRA	RED OAK	3" CAL.	B&B	
TD	5	TAXODIUM DISTICHUM	BALD CYPRESS	2" CAL.	B&B	
UP	5	ULMUS PARVIFOLIA	CHINESE ELM	2" CAL.	B&B	
EVERGREEN TREES						
PM	7	PSEUDOTSUGA MENZIESII	DOUGLAS FIR	6' HT.	B&B	
PP	3	PICEA PUNGENS	COLORADO SPRUCE	6' HT.	B&B	
ORNAMENTAL TREES						
AC	20	AMELANCHIER CANADENSIS	SHADBLow SERVICEBERRY	5- 6' HT.	B&B	
BN	4	BETULA NIGRA	RIVER BIRCH	12' HT.	B&B	
CC	1	CERCIS CANADENSIS	REDBUD	5- 6' HT.	B&B	
SHRUBS						
RA	201	RHUS AROMATICA "GRO-LOW"	FRAGRANT SUMAC "GRO-LOW"	18"	B&B OR NO.5 CONT.	
GROUNDCOVERS						
PQ	950	PARTHENOISSUS QUINQUEFOLIA	VIRGINIA CREEPER	1 GAL.	CONT.	12" O.C.

SPACING	A	B	C	D	
12"	12"	6"	10"	12"	A=SPACING
18"	18"	8"	15"	12"	B=SPACING/2
24"	24"	10"	20"	24"	C=SPACING/1.2
48"	48"	21"	41"	48"	D=SPACING

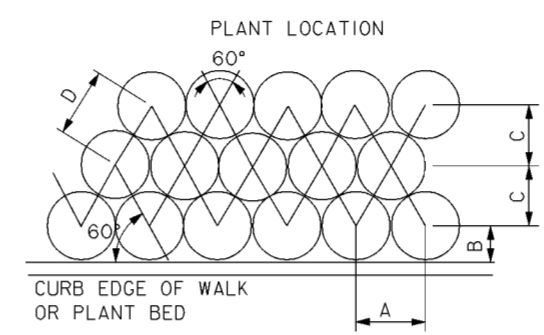

SHRUB AND PERENNIAL SPACING


SCALE: NONE

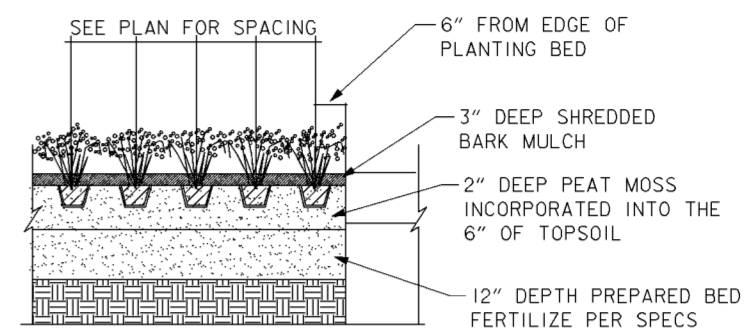

POTTED PLANTING


SCALE: NONE

THE AMOUNT OF PRUNING OF THE BRANCHES SHALL BE LIMITED TO 1/3 TO COMPENSATE FOR THE LOSS OF ROOTS FROM TRANSPLANTING, OR TO REMOVE DEAD OR INJURED LIMBS. RETAIN NATURAL SHAPE.

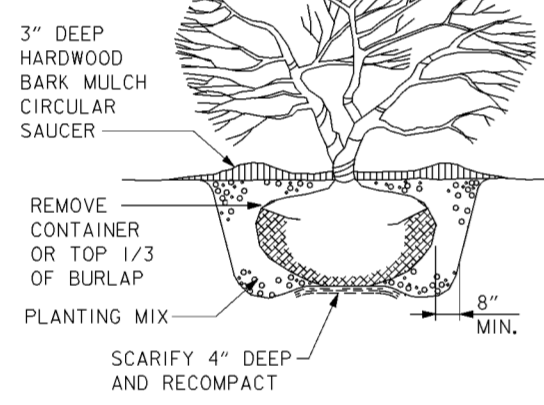


SHRUB PLANTING

SCALE: NONE

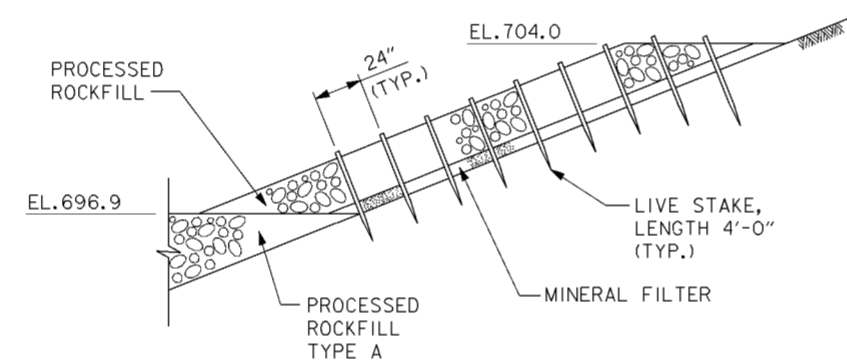


JOINT PLANTING DETAIL

SCALE: 1/4" = 1'-0"
 12' 0' 5'

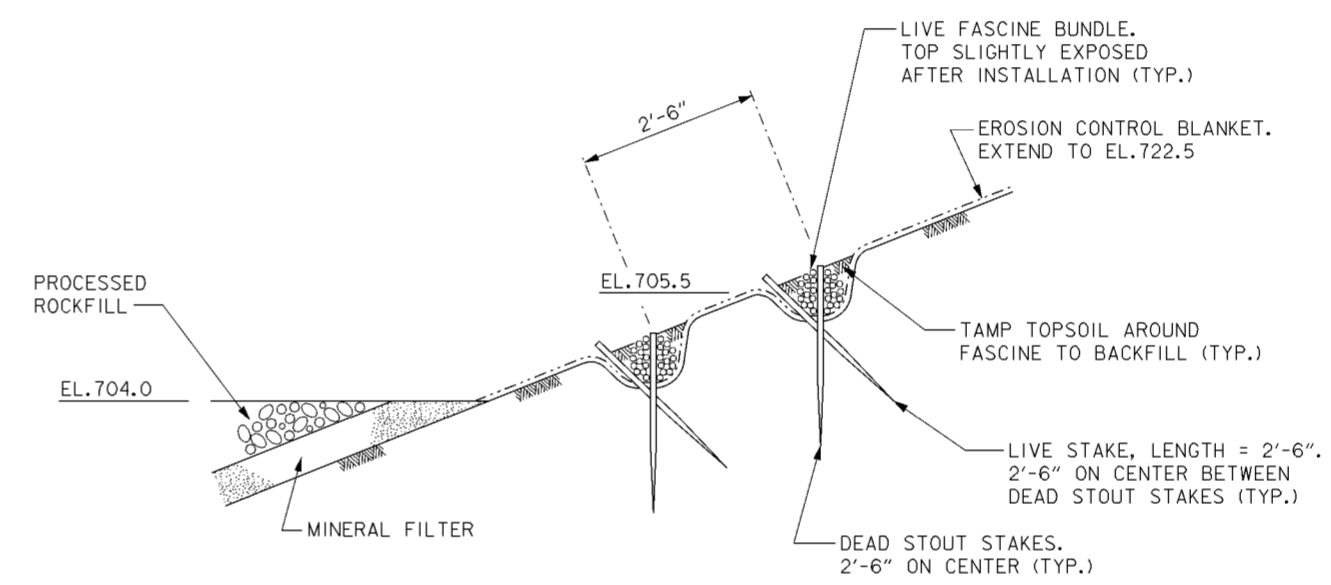

LIVE FASCINE DETAIL


SCALE: 3/4" = 1'-0"
 12' 6' 0' 1' 2'

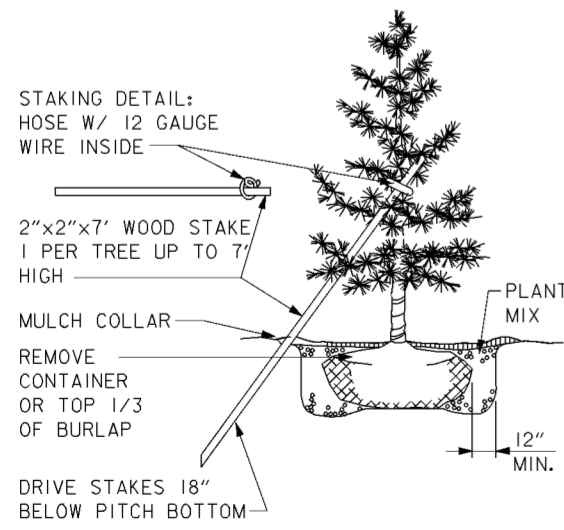

EVERGREEN TREE PLANTING UNDER 7' HEIGHT

SCALE: NONE

- NOTES:
- LIVE FASCINE SHALL CONSIST OF RIVER BIRCH (BETULA NIAGRA), WILLOW (SALIX, SPP.) OR ALDER (ALNUS, SPP.).
 - LIVE STAKES SHALL CONSIST OF WILLOW (SALIX, SPP.) OR RIVER BIRCH (BETULA NIAGRA).
 - LIVE STAKES SHALL BE 1/2" MINIMUM DIAMETER WITH SIDE BRANCHES REMOVED AND BARK INTACT.

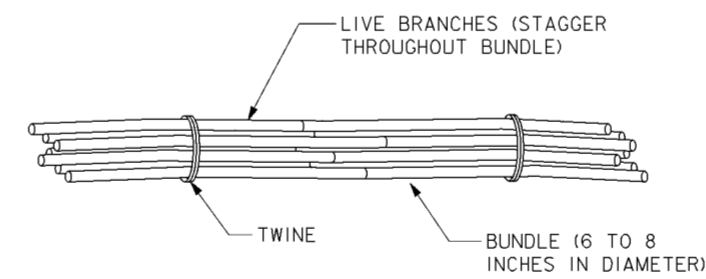

FASCINE BUNDLE DETAIL

SCALE: NONE

- NOTES:
- BUNDLE LENGTHS MAY VARY BETWEEN 5 AND 10 FEET. PROVIDE EXTRA DEAD STOUT STAKES THROUGH BUNDLE ENDS.
 - CUTTINGS FOR FASCINE SHALL BE LONG AND STRAIGHT WITH 1/2" MAX. DIAMETER.

RIVERBANK TREATMENT LANDSCAPING DETAILS


STA.204+76.86 TO STA.213+80

NOTES


- FOR DECIDUOUS TREE PLANTING DETAIL SEE DRAWING NO. 12/4.
- FOR DODGE PARK RIVERBANK TREATMENT TYPICAL SECTION SEE DRAWING NO. 20.2/25.

Revisions			
Symbol	Descriptions	Date	Approved
◇	REVISED AS CONSTRUCTED	7/02	P.O.C.
◇	REV. BY CONTRACT MODIFICATION LETTER MCO02	11/98	P.O.C.

BURGESS & NIPLE, LIMITED COLUMBUS, OHIO	U.S. ARMY ENGINEER DISTRICT CORPS OF ENGINEERS HUNTINGTON, WEST VIRGINIA
Designed by: J.KRAMER	SCIO TO RIVER COLUMBUS, OHIO WEST COLUMBUS, L.P.P. PHASE IID
Drawn by: T.MULLINS	MISCELLANEOUS LANDSCAPING DETAILS
Checked by: R.MORSE	Scale: AS SHOWN
Reviewed by: P.CONROY	Sheet reference number: 12/10
Approved by:	FILENAME: a01ad01.dgn
Date: MARCH 1998	PIN TABLE:
Drawing Code: 16-PWC-10-	Sheet 1 of 1

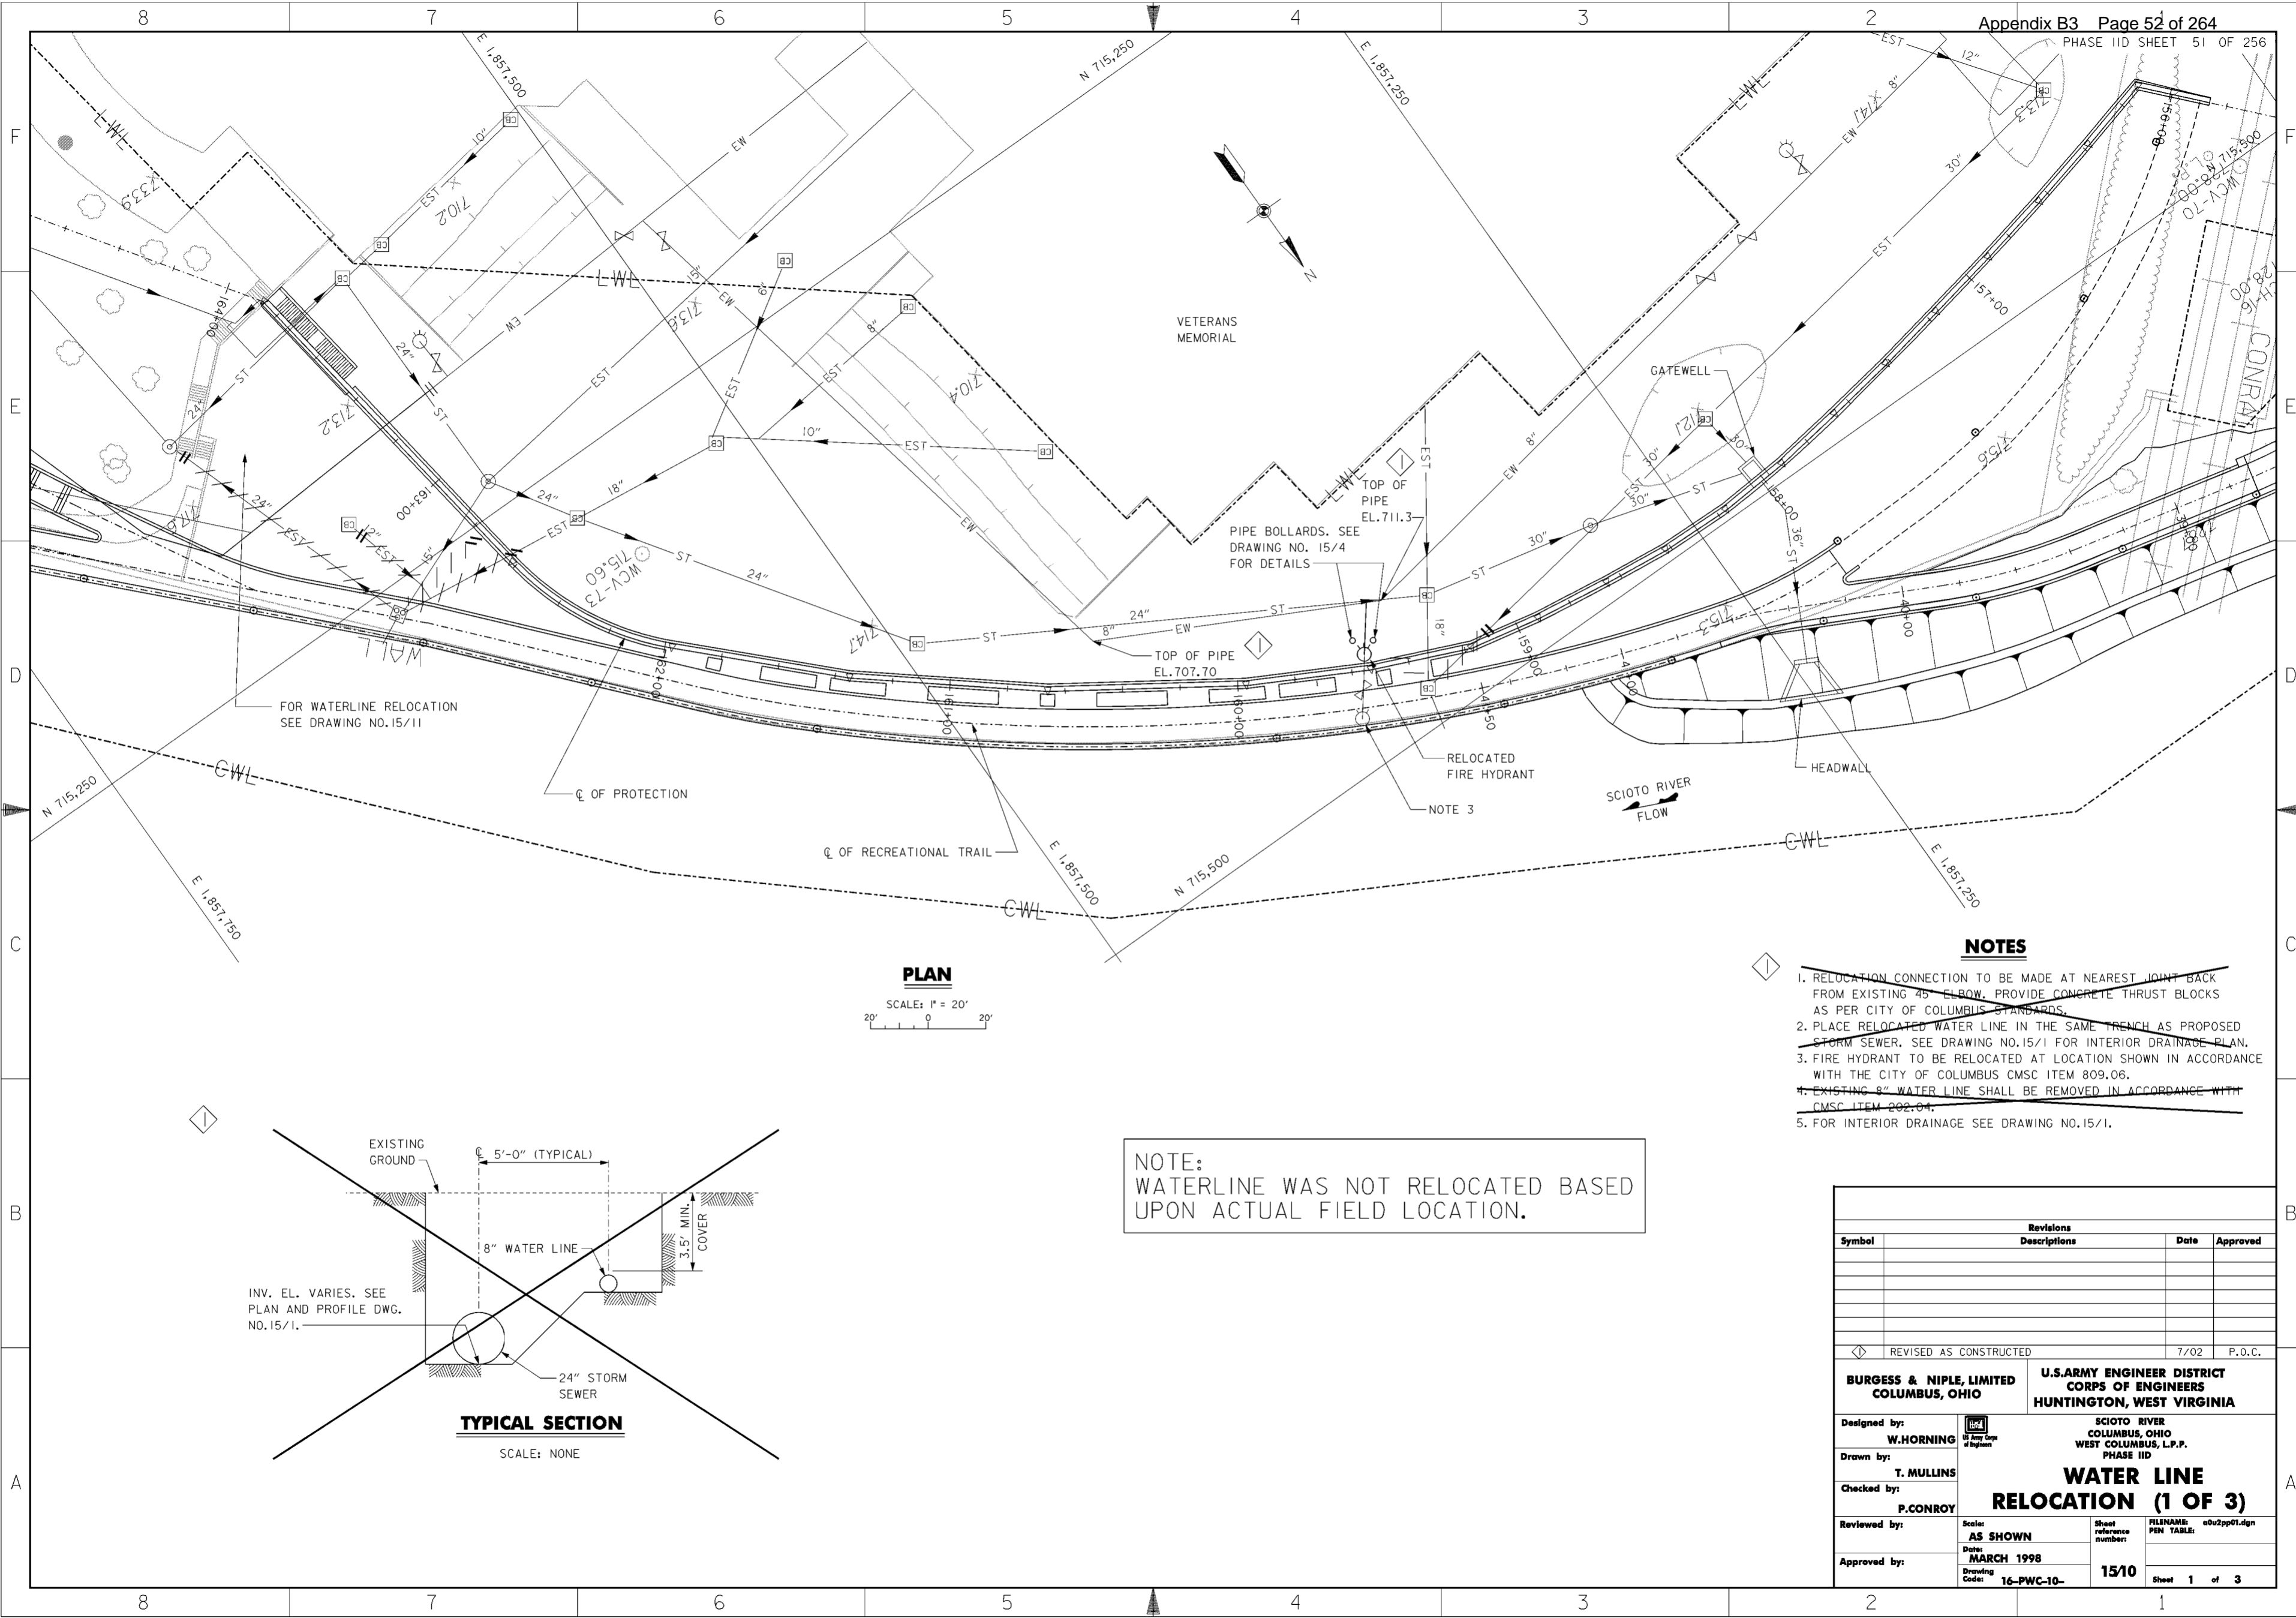

PLAN
 SCALE: 1" = 20'
 20" 0 20"

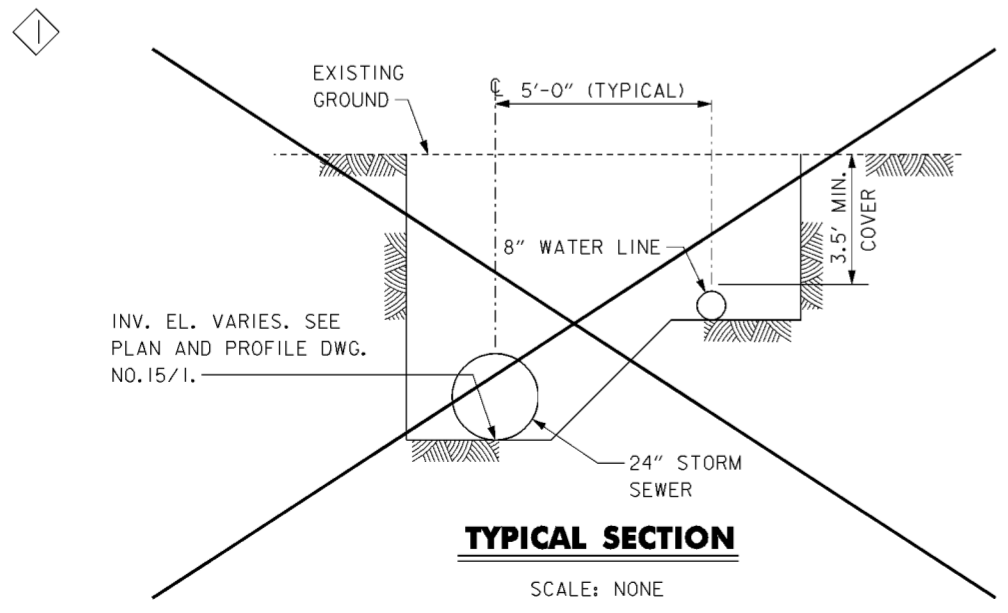



TYPICAL SECTION
 SCALE: NONE

NOTE:
 WATERLINE WAS NOT RELOCATED BASED
 UPON ACTUAL FIELD LOCATION.

- NOTES**
1. RELOCATION CONNECTION TO BE MADE AT NEAREST JOINT BACK FROM EXISTING 45° ELBOW. PROVIDE CONCRETE THRUST BLOCKS AS PER CITY OF COLUMBUS STANDARDS.
 2. PLACE RELOCATED WATER LINE IN THE SAME TRENCH AS PROPOSED STORM SEWER. SEE DRAWING NO. 15/1 FOR INTERIOR DRAINAGE PLAN.
 3. FIRE HYDRANT TO BE RELOCATED AT LOCATION SHOWN IN ACCORDANCE WITH THE CITY OF COLUMBUS CMSC ITEM 809.06.
 4. EXISTING 8" WATER LINE SHALL BE REMOVED IN ACCORDANCE WITH CMSC ITEM 202.04.
 5. FOR INTERIOR DRAINAGE SEE DRAWING NO. 15/1.

Revisions			
Symbol	Descriptions	Date	Approved
◊	REVISED AS CONSTRUCTED	7/02	P.O.C.

BURGESS & NIPLE, LIMITED COLUMBUS, OHIO		U.S. ARMY ENGINEER DISTRICT CORPS OF ENGINEERS HUNTINGTON, WEST VIRGINIA	
Designed by: W. HORNING		SCIOTO RIVER COLUMBUS, OHIO WEST COLUMBUS, L.P.P. PHASE IID	
Drawn by: T. MULLINS		WATER LINE RELOCATION (1 OF 3)	
Checked by: P. CONROY			
Reviewed by:	Scale: AS SHOWN	Sheet reference number: 1510	FILENAME: a0u2pp01.dgn
Approved by:	Date: MARCH 1998	Drawing Code: 16-PWC-10-	Sheet 1 of 3

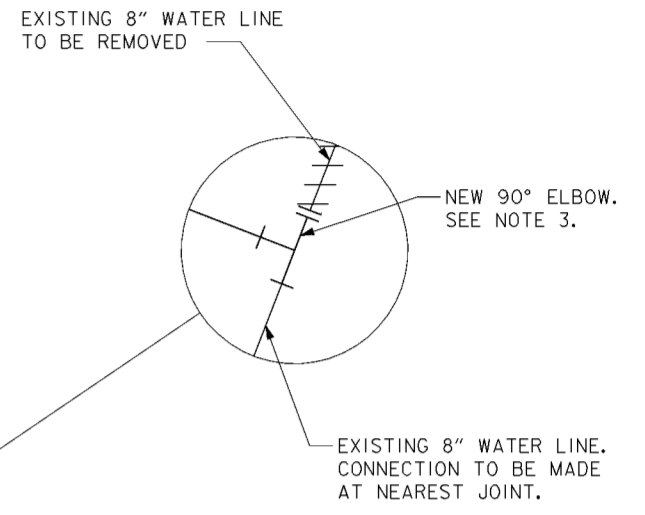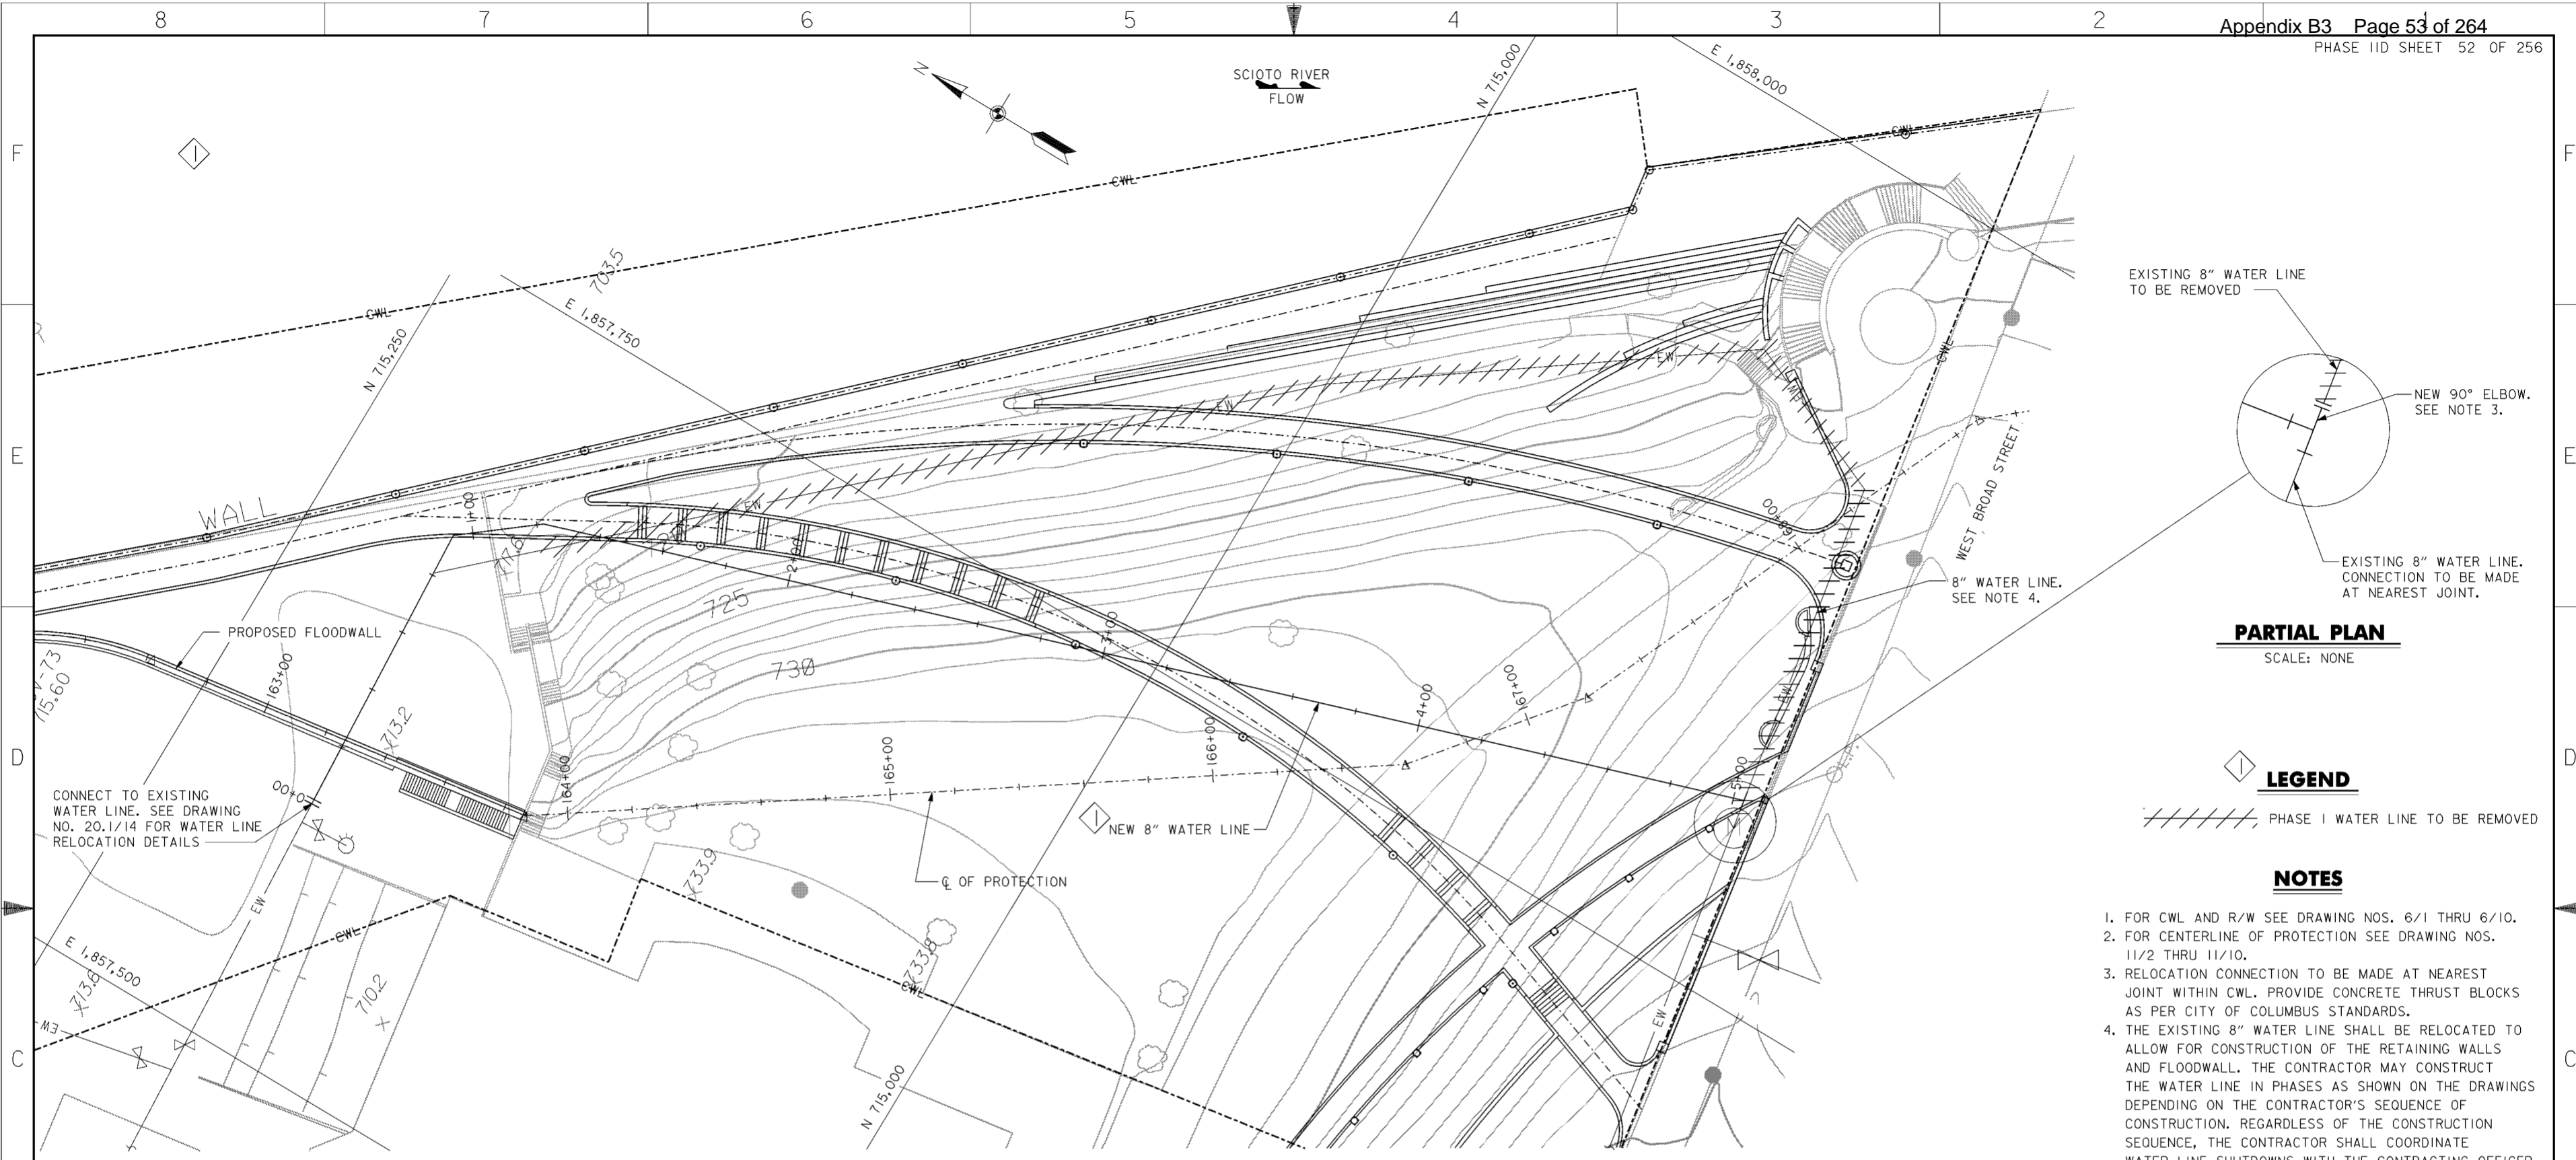

PARTIAL PLAN
 SCALE: NONE


LEGEND

/// PHASE I WATER LINE TO BE REMOVED

NOTES

- FOR CWL AND R/W SEE DRAWING NOS. 6/1 THRU 6/10.
- FOR CENTERLINE OF PROTECTION SEE DRAWING NOS. 11/2 THRU 11/10.
- RELOCATION CONNECTION TO BE MADE AT NEAREST JOINT WITHIN CWL. PROVIDE CONCRETE THRUST BLOCKS AS PER CITY OF COLUMBUS STANDARDS.
- THE EXISTING 8" WATER LINE SHALL BE RELOCATED TO ALLOW FOR CONSTRUCTION OF THE RETAINING WALLS AND FLOODWALL. THE CONTRACTOR MAY CONSTRUCT THE WATER LINE IN PHASES AS SHOWN ON THE DRAWINGS DEPENDING ON THE CONTRACTOR'S SEQUENCE OF CONSTRUCTION. REGARDLESS OF THE CONSTRUCTION SEQUENCE, THE CONTRACTOR SHALL COORDINATE WATER LINE SHUTDOWNS WITH THE CONTRACTING OFFICER AND VETERANS MEMORIAL REPRESENTATIVES.
- ELEVATION OF TIE-IN LOCATIONS ARE APPROXIMATE. CONTRACTOR SHALL FIELD VERIFY.
- FINISHED GRADING NOT SHOWN IN PLAN VIEW FOR CLARITY. SEE DRAWING NO. 20.2/34.
- FOR THE TYPICAL PIPE THROUGH SHEET PILING DETAIL SEE DRAWING NO. 20.1/14.


PLAN
 SCALE: 1" = 20'

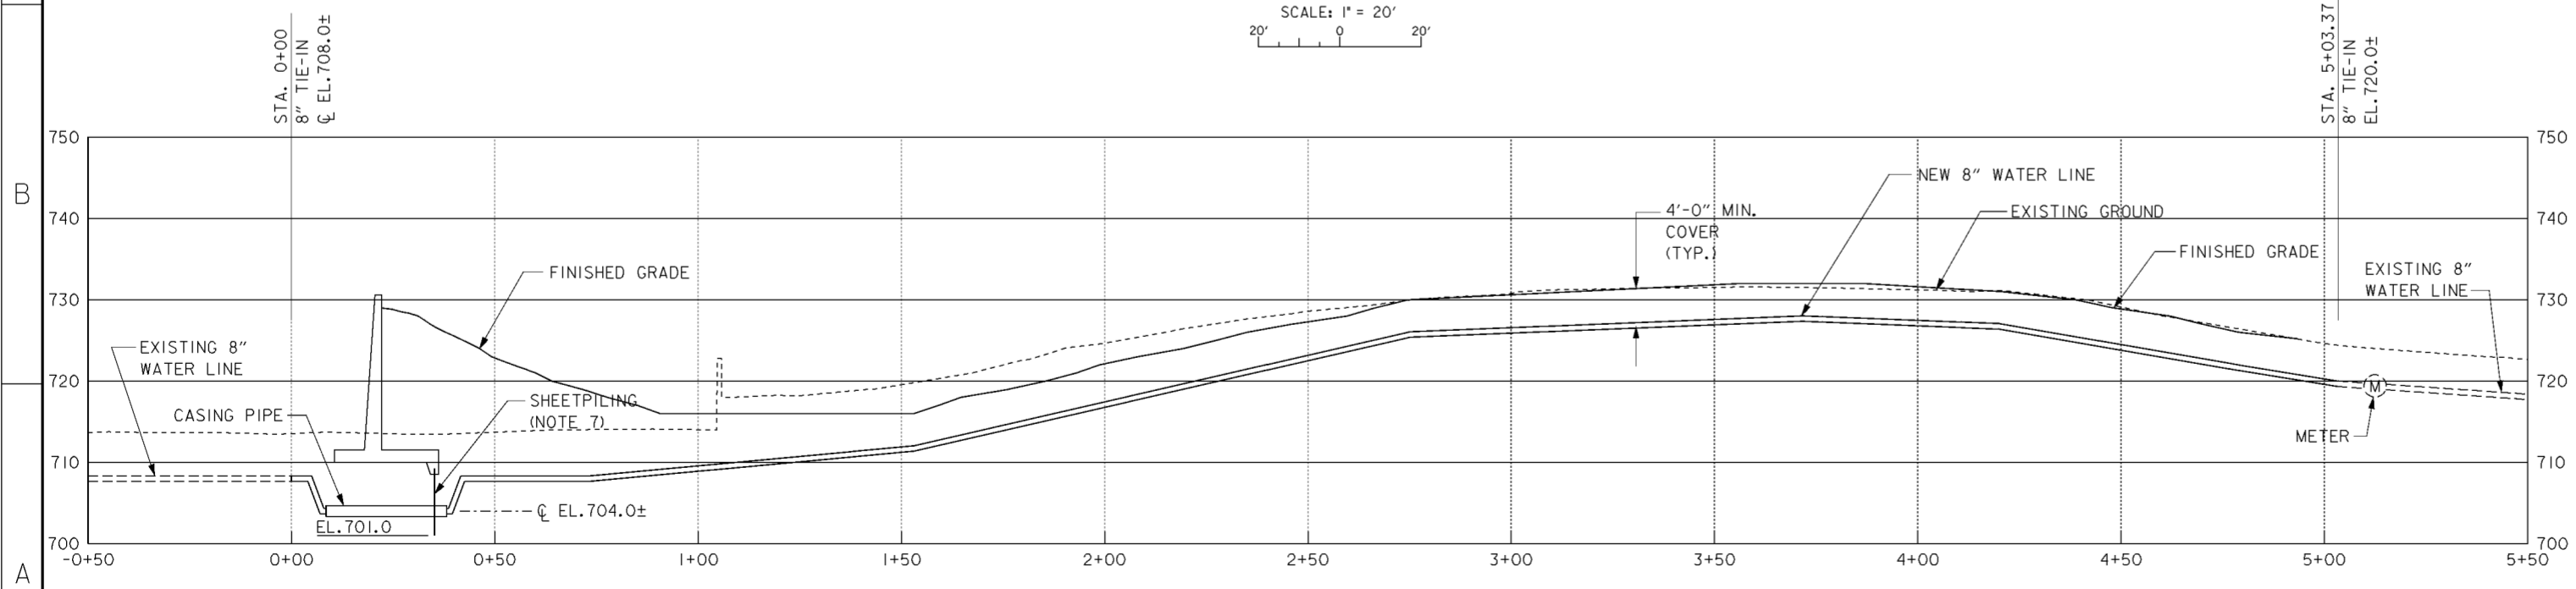

PROFILE
 SCALE IN FEET

Revisions			
Symbol	Descriptions	Date	Approved

BURGESS & NIPLE, LIMITED COLUMBUS, OHIO	U.S. ARMY ENGINEER DISTRICT CORPS OF ENGINEERS WEST COLUMBUS, WEST VIRGINIA	SCIOTO RIVER COLUMBUS, OHIO WEST COLUMBUS, L.P.P. PHASE IID	
		WATER LINE RELOCATION (2 OF 3)	
Designed by: P. CONROY		Checked by: R. ROMAN	FILENAME: 00u2pp02.dgn
Drawn by: T. MULLINS		Reviewed by: AS SHOWN	SHEET PEN TABLE: 15/11
Approved by: _____	Date: MARCH 1998	Drawing Code: 16-PWC-10-	Sheet 2 of 3

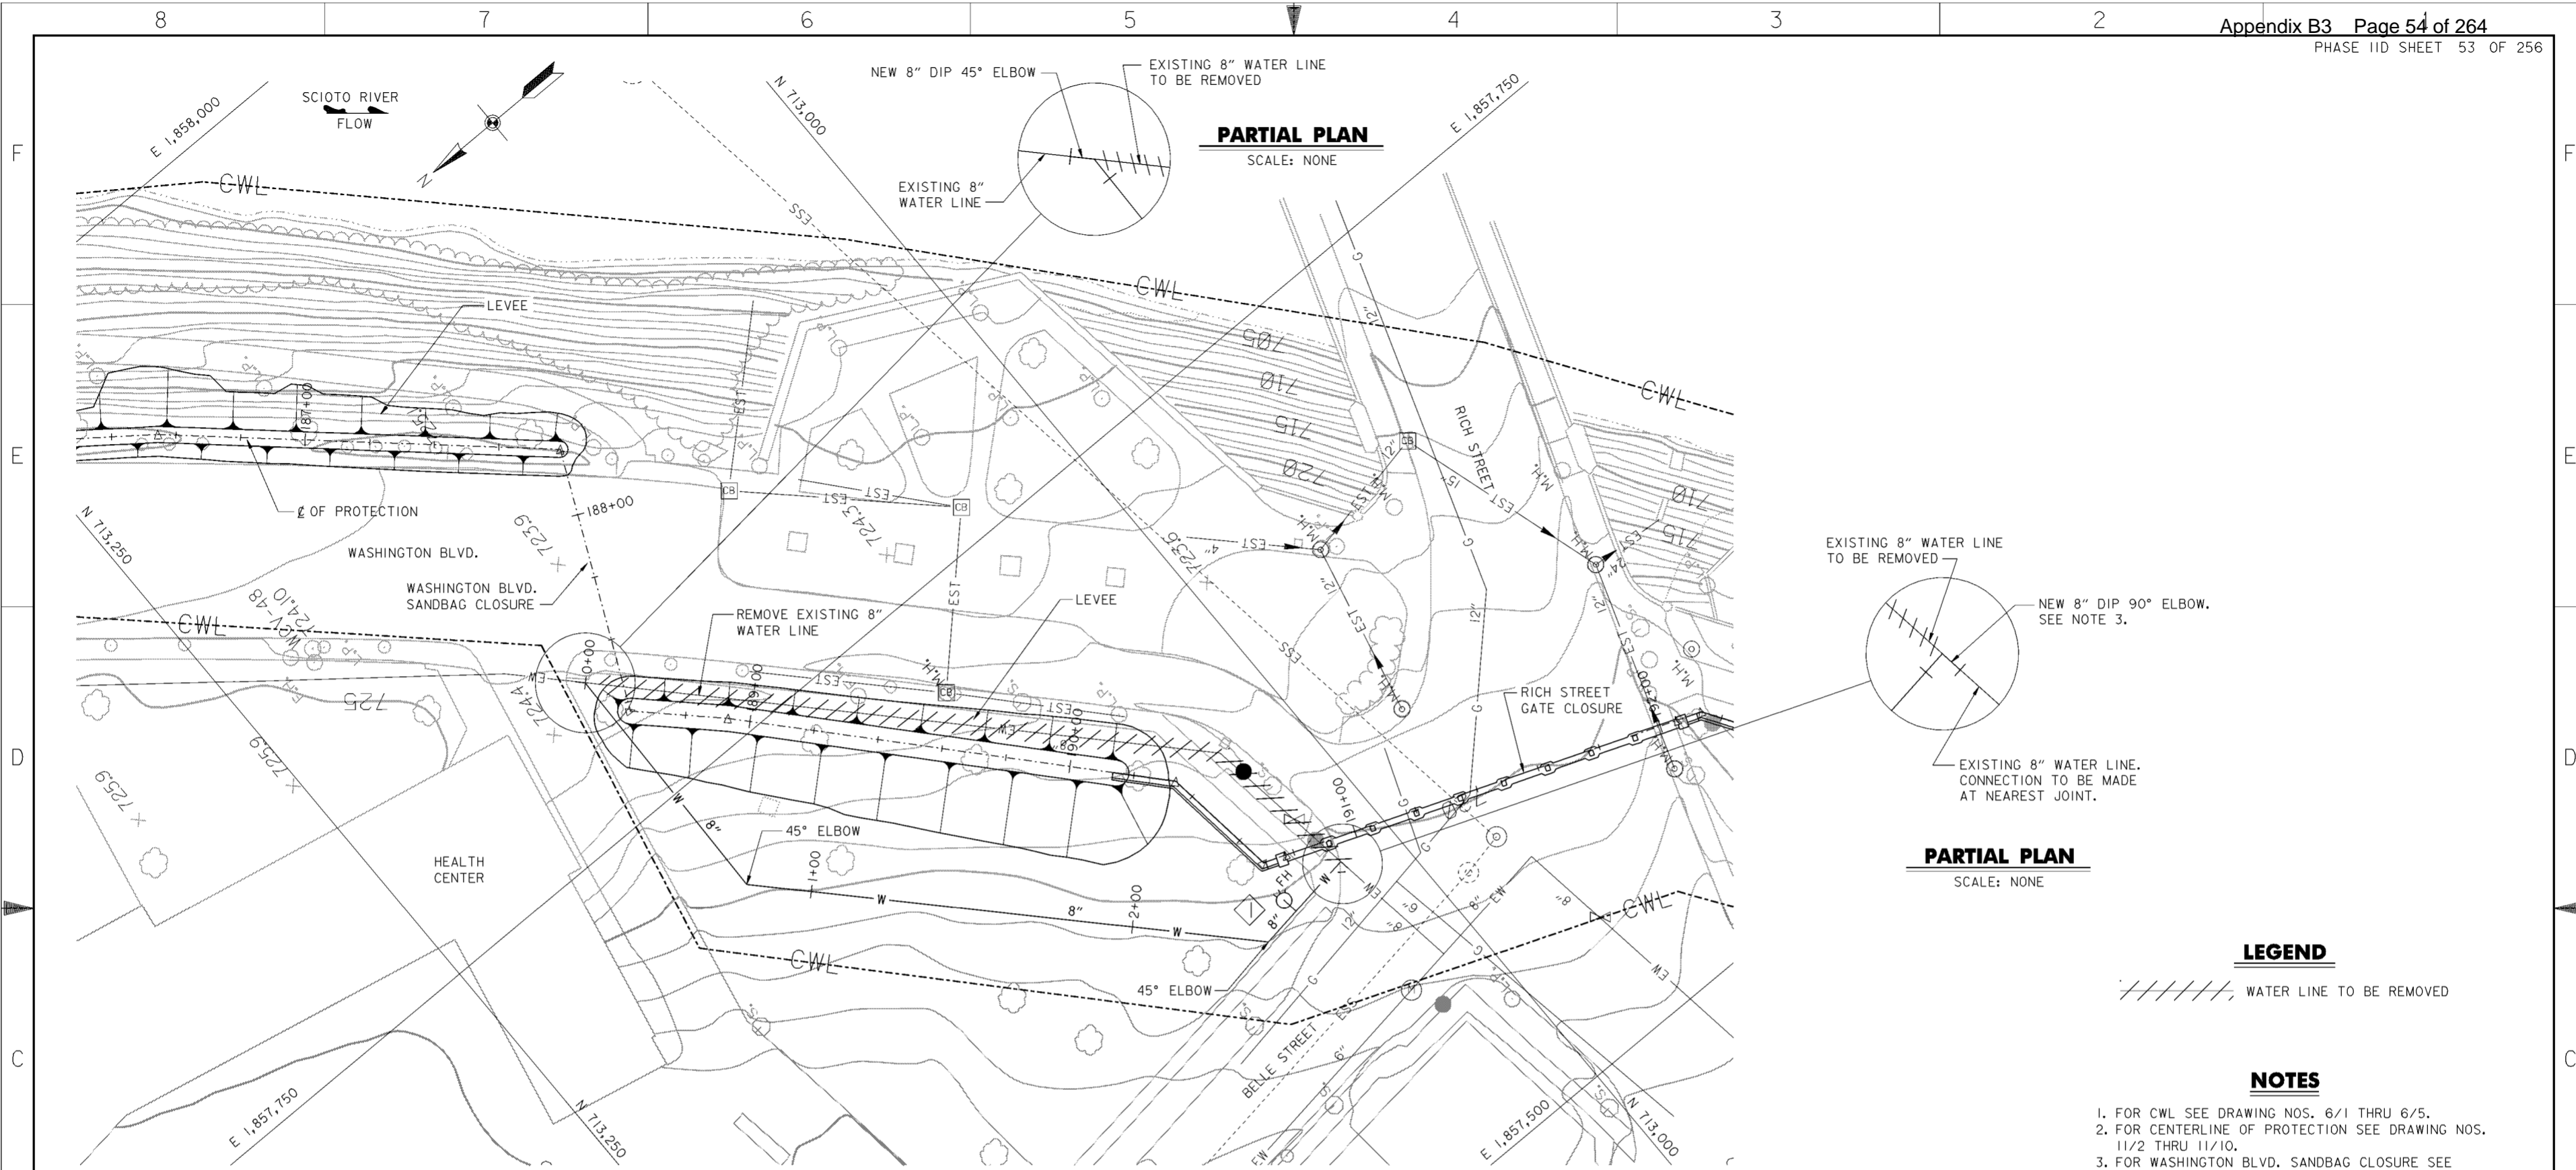

PARTIAL PLAN
 SCALE: NONE


PARTIAL PLAN
 SCALE: NONE

LEGEND

////// WATER LINE TO BE REMOVED



NOTES

1. FOR CWL SEE DRAWING NOS. 6/1 THRU 6/5.
2. FOR CENTERLINE OF PROTECTION SEE DRAWING NOS. 11/2 THRU 11/10.
3. FOR WASHINGTON BLVD. SANDBAG CLOSURE SEE DRAWING NO. 20.2/6.
4. FOR RICH STREET GATE CLOSURE SEE DRAWING NO. 20.2/7.
5. RELOCATION CONNECTION TO BE MADE AT NEAREST JOINT WITHIN CWL. PROVIDE CONCRETE THRUST BLOCKS AS PER CITY OF COLUMBUS STANDARDS.
6. ELEVATIONS OF TIE-IN LOCATIONS ARE APPROXIMATE. CONTRACTOR SHALL FIELD VERIFY.

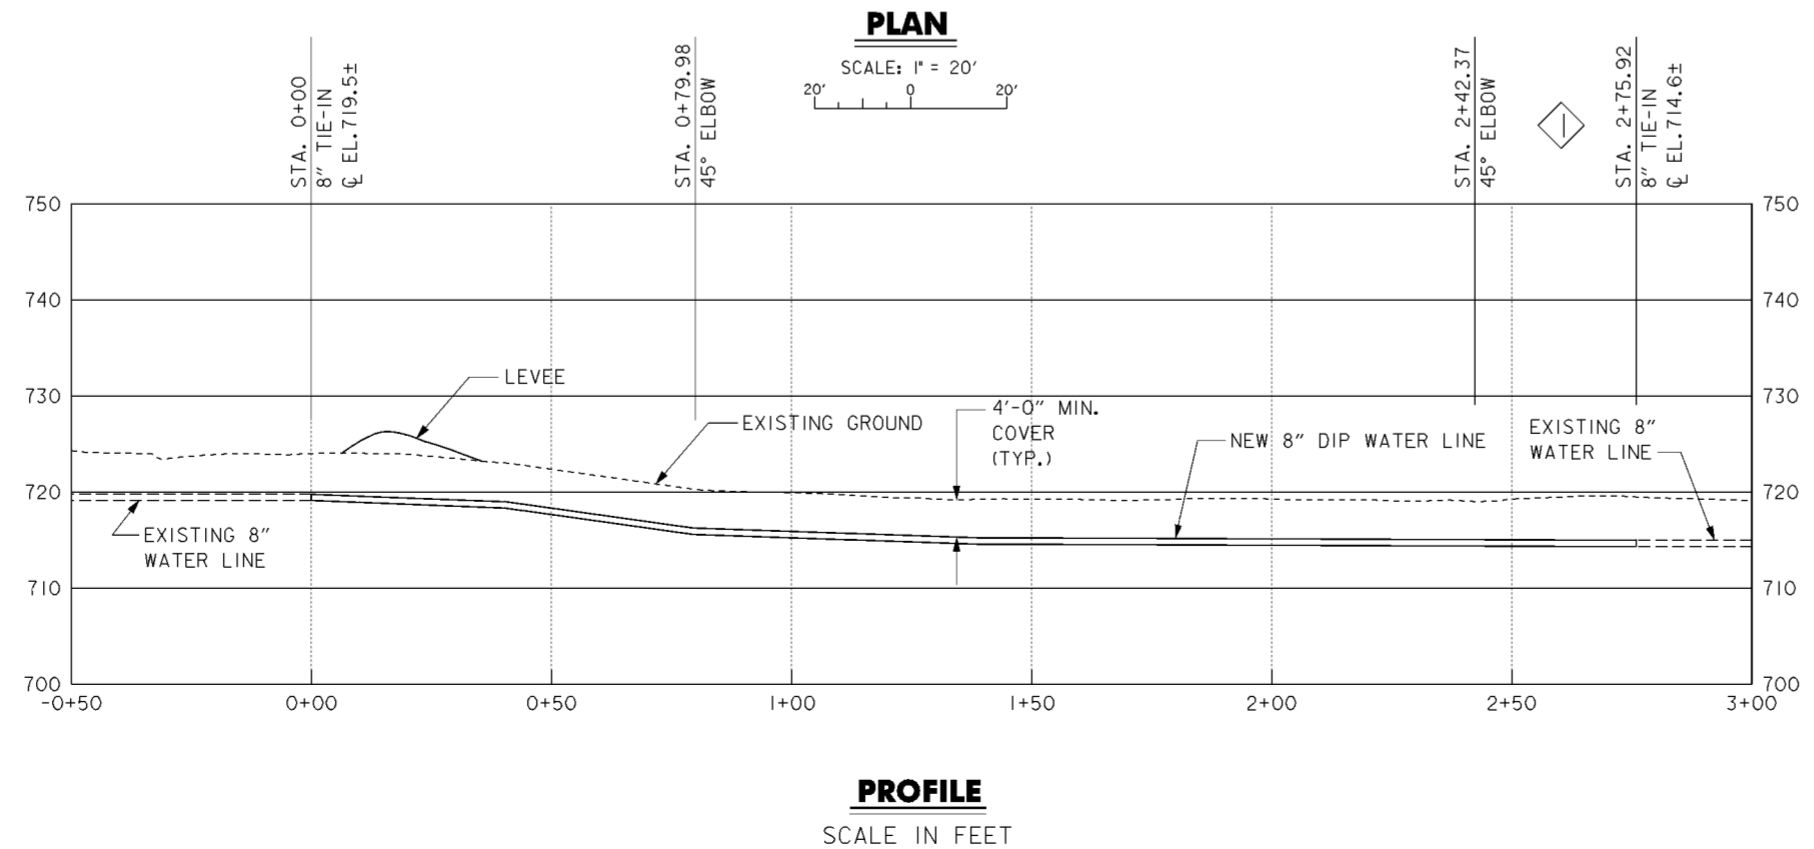

Revisions			
Symbol	Descriptions	Date	Approved
◁	REVISED AS CONSTRUCTED	7/02	P.O.C.


BURGESS & NIPLE, LIMITED COLUMBUS, OHIO	U.S. ARMY ENGINEER DISTRICT CORPS OF ENGINEERS HUNTINGTON, WEST VIRGINIA	Designed by: P.CONROY	SCIOTO RIVER COLUMBUS, OHIO WEST COLUMBUS, L.P.P. PHASE IID
		Drawn by: T.MULLINS	
Checked by: R.ROMAN	Reviewed by: AS SHOWN	Date: MARCH 1998	FILENAME: a02pp03.dgn
Approved by:	Drawing Code: 16-PWC-10-	Sheet reference number: 15/12	PEN TABLE: Sheet 3 of 3

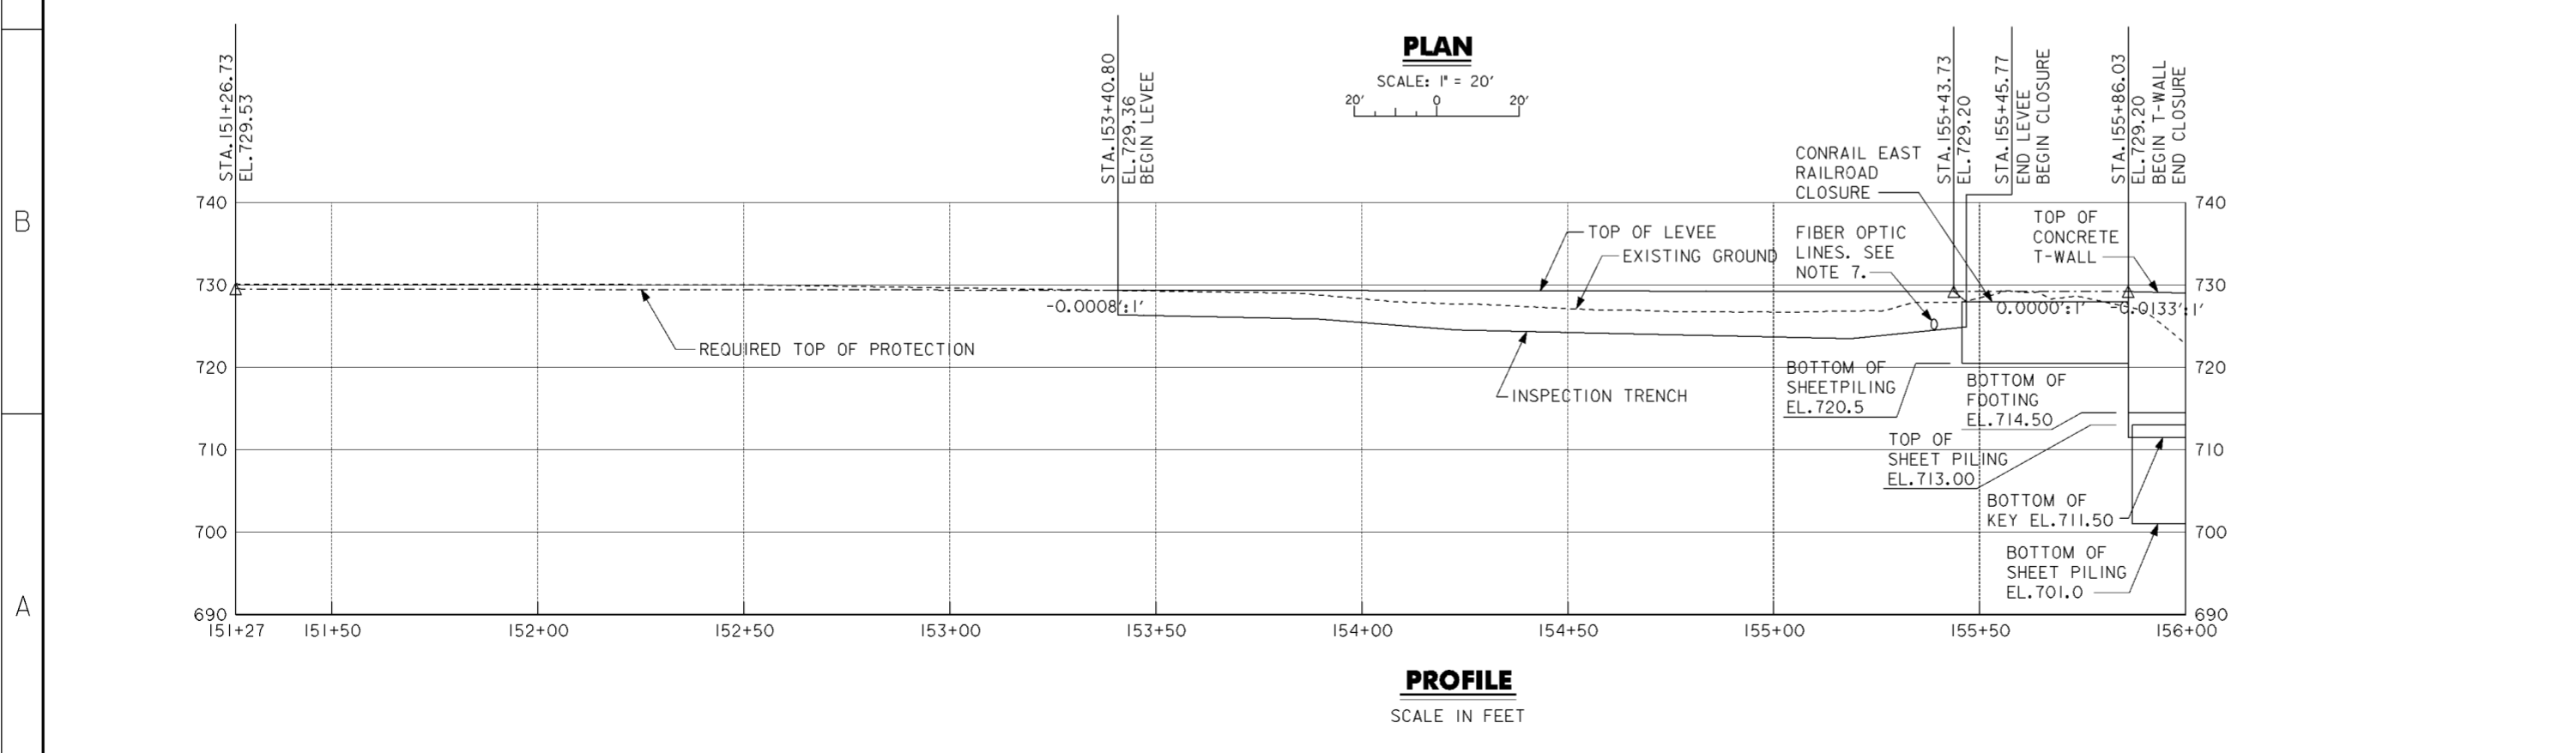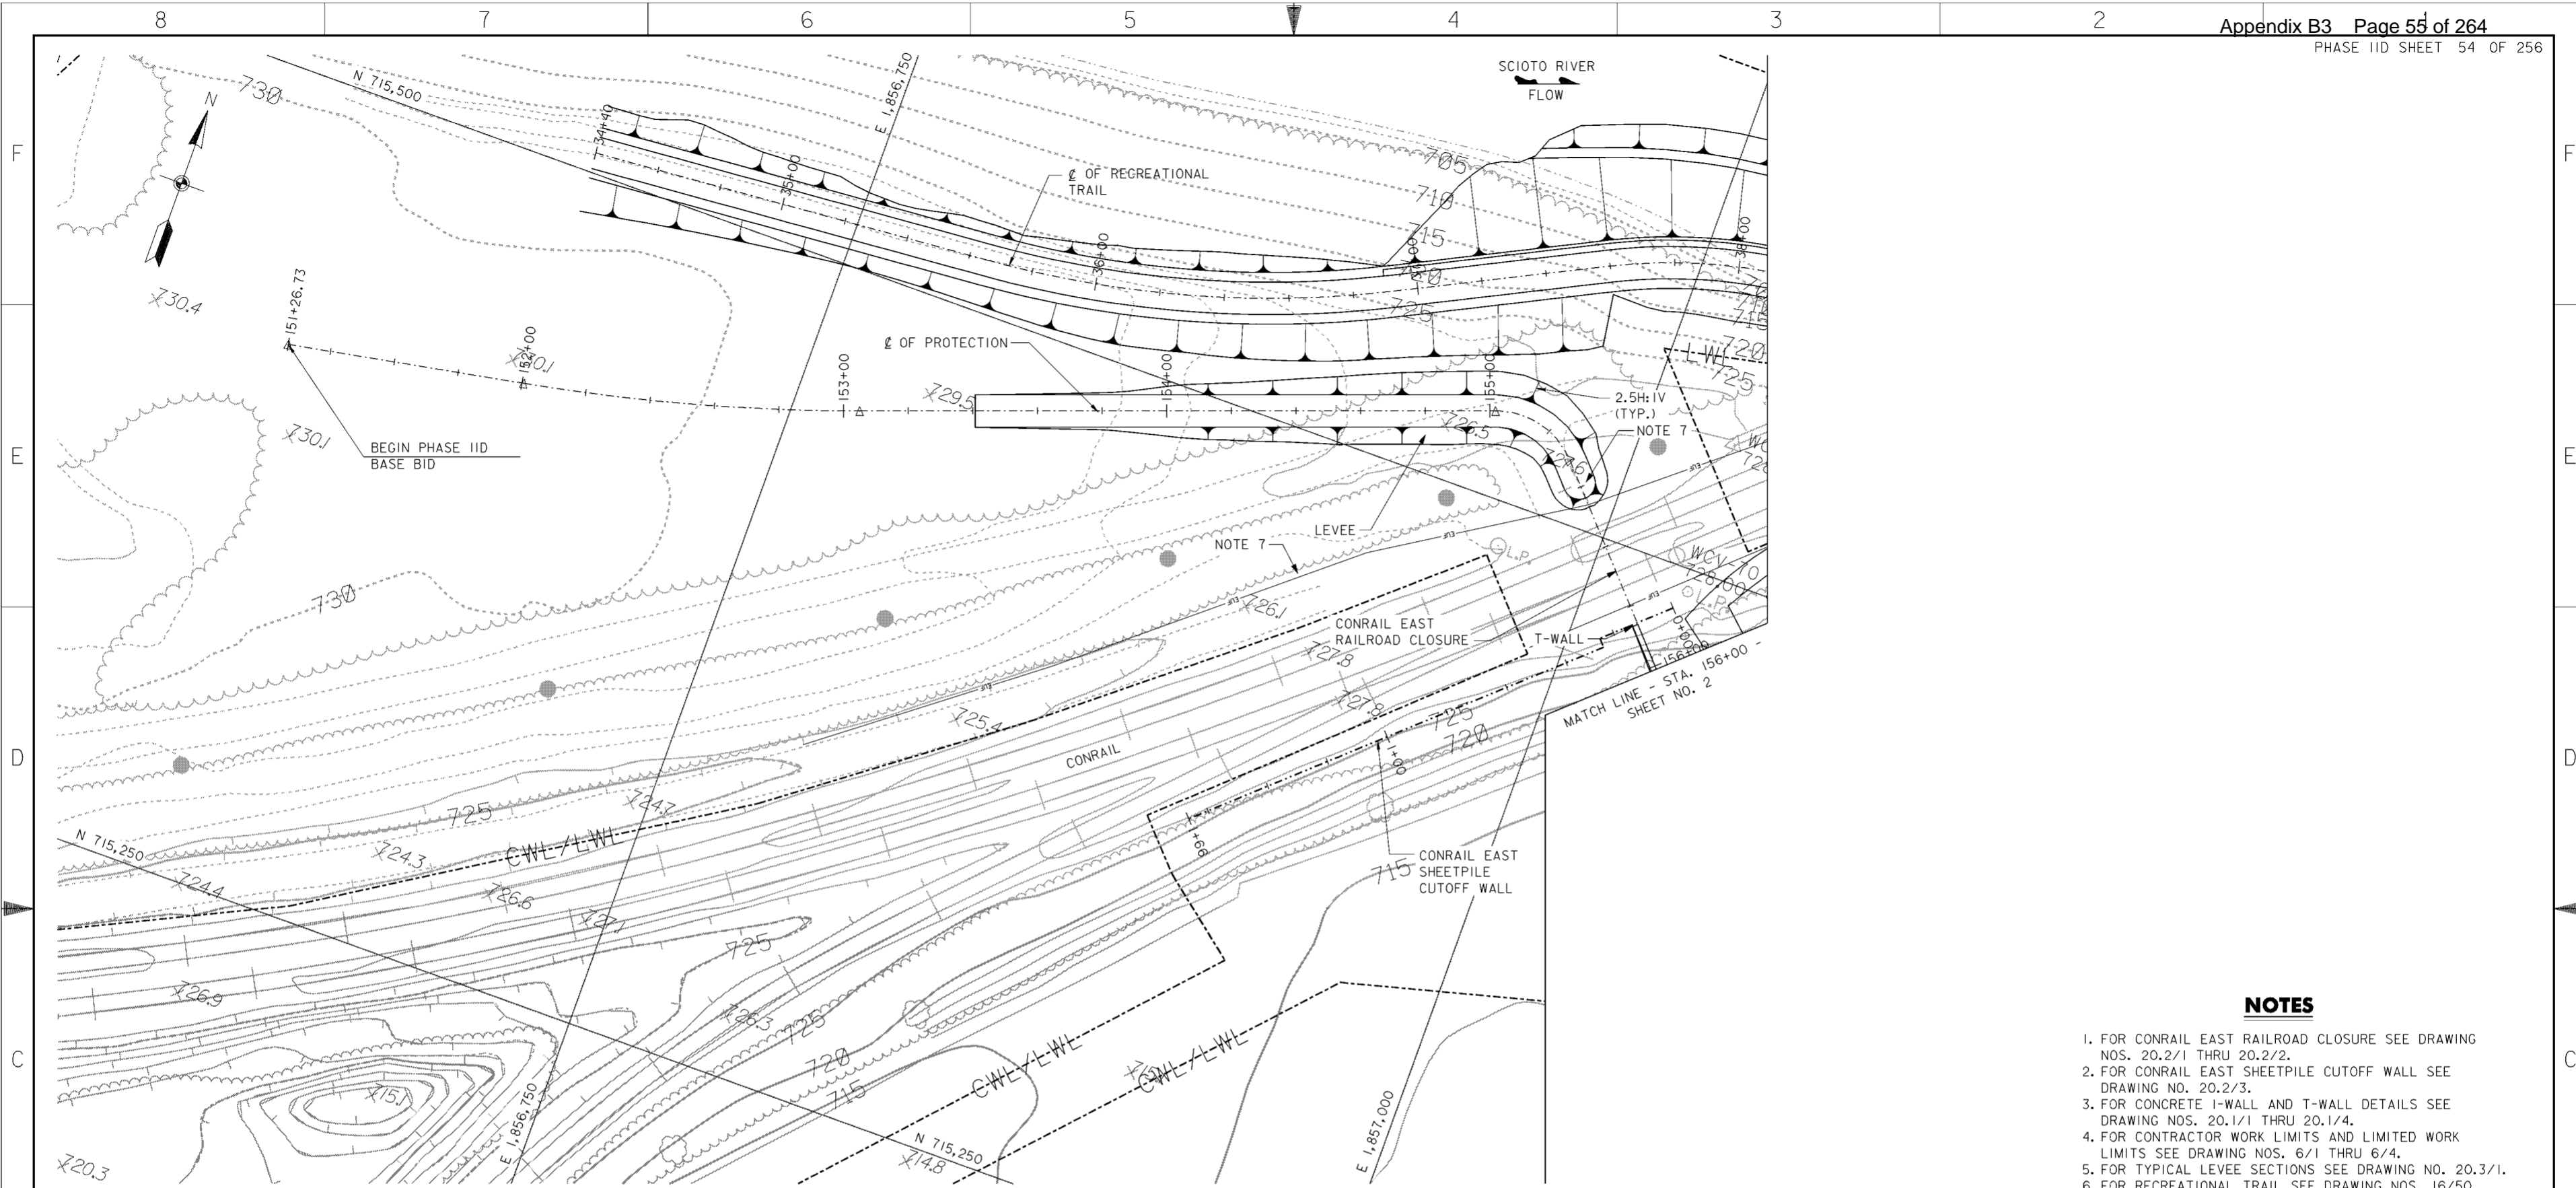

- NOTES**
1. FOR CONRAIL EAST RAILROAD CLOSURE SEE DRAWING NOS. 20.2/1 THRU 20.2/2.
 2. FOR CONRAIL EAST SHEETPILE CUTOFF WALL SEE DRAWING NO. 20.2/3.
 3. FOR CONCRETE T-WALL AND T-WALL DETAILS SEE DRAWING NOS. 20.1/1 THRU 20.1/4.
 4. FOR CONTRACTOR WORK LIMITS AND LIMITED WORK LIMITS SEE DRAWING NOS. 6/1 THRU 6/4.
 5. FOR TYPICAL LEVEE SECTIONS SEE DRAWING NO. 20.3/1.
 6. FOR RECREATIONAL TRAIL SEE DRAWING NOS. 16/50 AND 16/51 AND 20.2/35 THRU 20.2/37.
 7. MULTIPLE EXISTING FIBER OPTIC LINES (5-SPRINT, LCI, AT&T, WORLDCOM AND ONE UNKNOWN OWNER) LOCATED IN RAILROAD RIGHT-OF-WAY NORTH OF CONRAIL TRACKS. THE CONTRACTOR SHALL HAVE LINES LOCATED BY THE OWNING COMPANY PRIOR TO EXCAVATION FOR THE INSPECTION TRENCH AND PLACEMENT OF EMBANKMENT.


Revisions			
Symbol	Descriptions	Date	Approved

BURGESS & NIPLE, LIMITED COLUMBUS, OHIO		U.S. ARMY ENGINEER DISTRICT CORPUS OF ENGINEERS HUNTINGTON, WEST VIRGINIA	
		SCIOTO RIVER COLUMBUS, OHIO WEST COLUMBUS, L.P.P. PHASE IID	
Designed by: J. HALL	Drawn by: T. MULLINS		
Checked by: P. CONROY	Reviewed by: AS SHOWN		
Approved by: _____	Date: MARCH 1998	Sheet reference number: 161	FILENAME: 0003pp01.dgn
Drawing Code: 16-PWC-10-		Sheet 1 of 13	

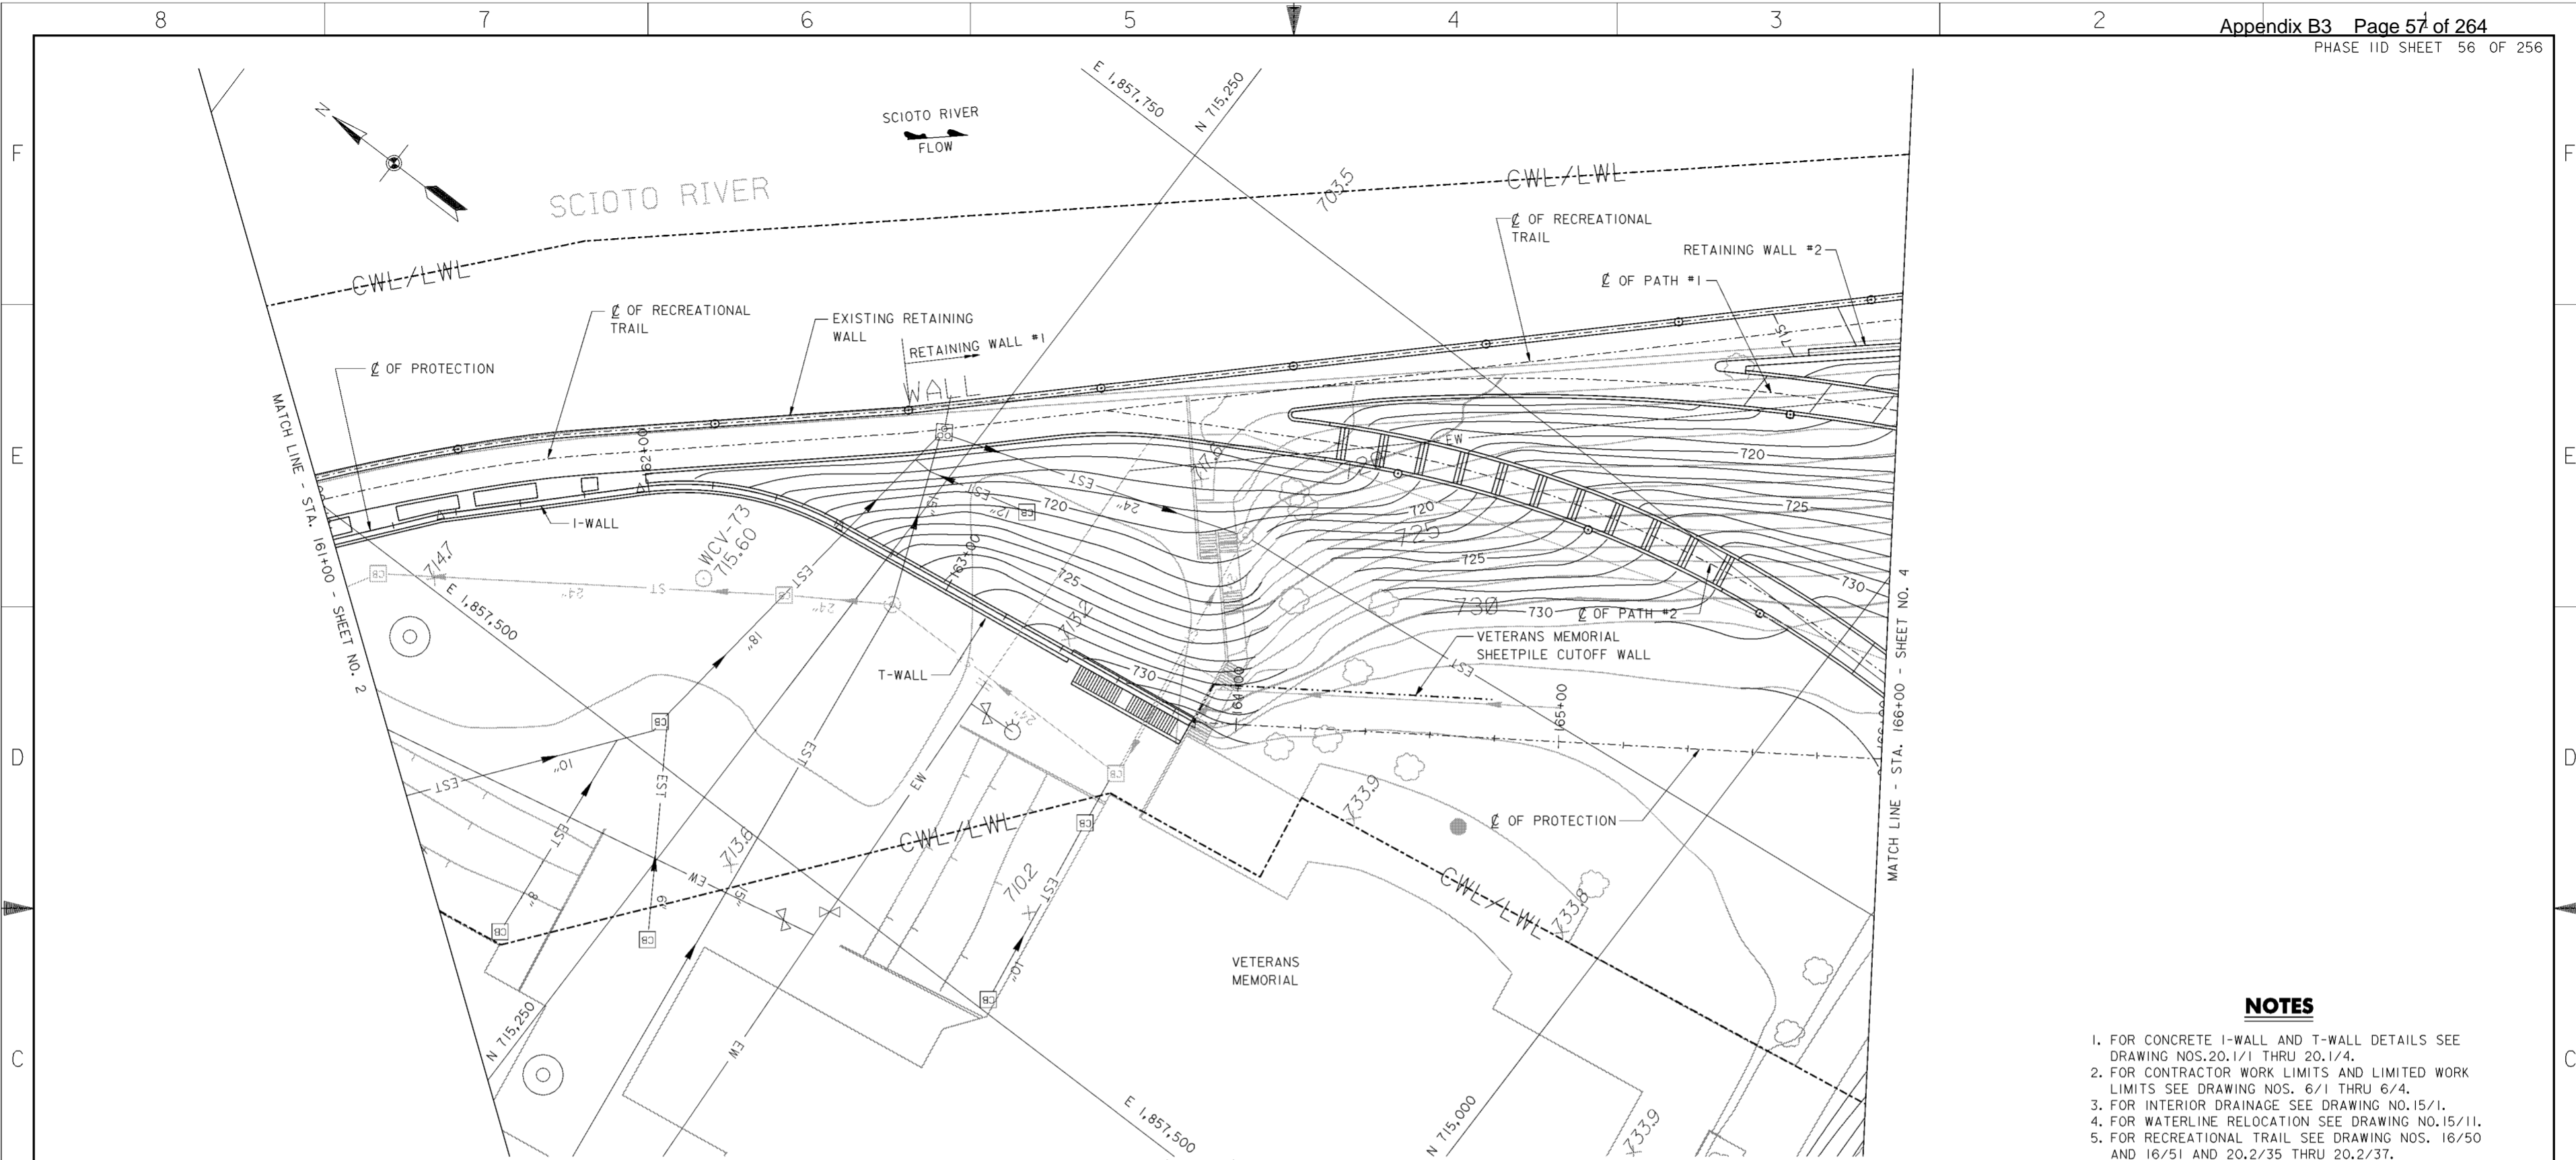

PLAN

SCALE: 1" = 20'

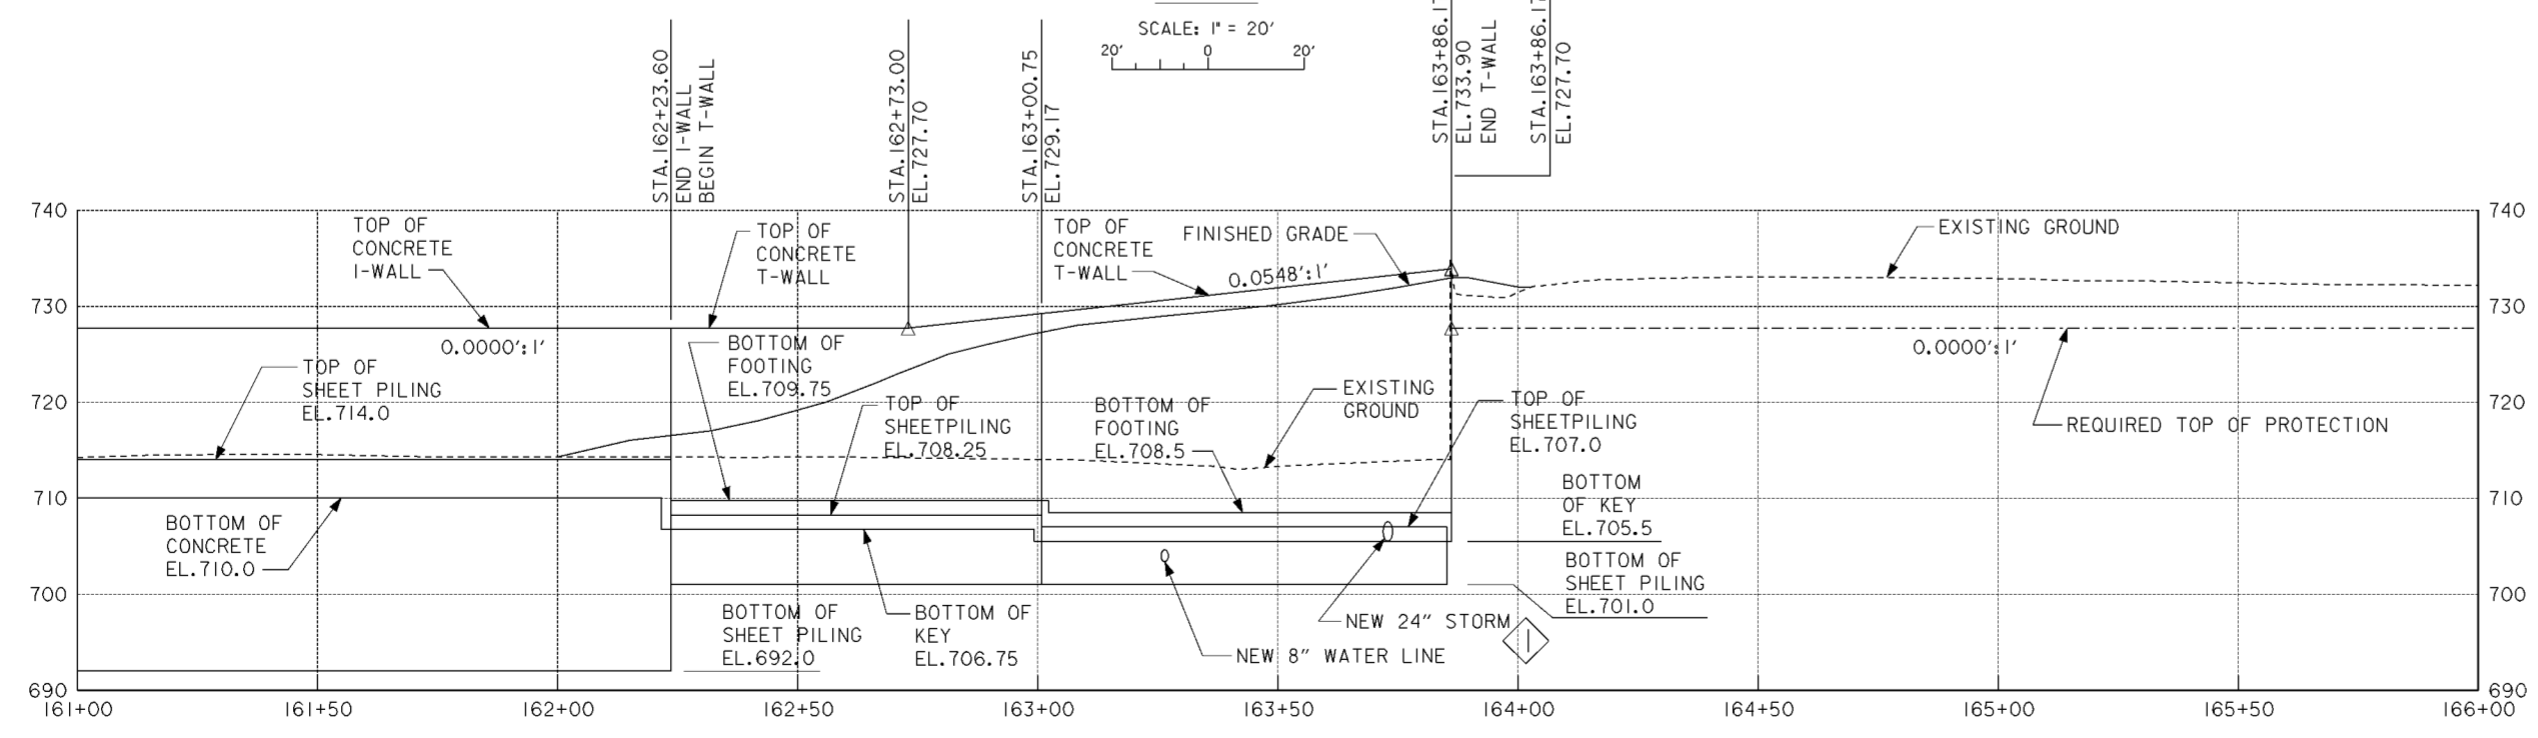

PROFILE

SCALE IN FEET


NOTES

1. FOR CONCRETE I-WALL AND T-WALL DETAILS SEE DRAWING NOS. 20.1/1 THRU 20.1/4.
2. FOR CONTRACTOR WORK LIMITS AND LIMITED WORK LIMITS SEE DRAWING NOS. 6/1 THRU 6/4.
3. FOR INTERIOR DRAINAGE SEE DRAWING NO. 15/1.
4. FOR WATERLINE RELOCATION SEE DRAWING NO. 15/11.
5. FOR RECREATIONAL TRAIL SEE DRAWING NOS. 16/50 AND 16/51 AND 20.2/35 THRU 20.2/37.
6. FOR DETAILS OF VETERAN'S MEMORIAL LAWN AND RETAINING WALLS SEE DRAWING NOS. 20.2/56 THRU 20.2/63.
7. FOR RETAINING WALL DETAILS SEE DRAWING NOS. 20.2/57 THRU 20.2/64.
8. FOR VETERANS MEMORIAL SHEETPILE CUTOFF WALL SEE DRAWING NO. 20.1/10.

Revisions			
Symbol	Descriptions	Date	Approved
◁	REVISED AS CONSTRUCTED	7/02	P.O.C.


BURGESS & NIPLE, LIMITED COLUMBUS, OHIO	U.S. ARMY ENGINEER DISTRICT CORPS OF ENGINEERS HUNTINGTON, WEST VIRGINIA	Designed by: J. HALL	SCIOTO RIVER COLUMBUS, OHIO WEST COLUMBUS, L.P.P. PHASE IID
		Drawn by: T. MULLINS	
Checked by: P. CONROY	PLAN AND PROFILE STA. 161+00 TO 166+00		FILENAME: a05pp03.dgn
Reviewed by:	Scale: AS SHOWN	Sheet reference number: 163	Date: MARCH 1998
Approved by:	Drawing Code: 16-PWC-10-	Sheet 3 of 13	P.O.C.

WORK AS CONSTRUCTED

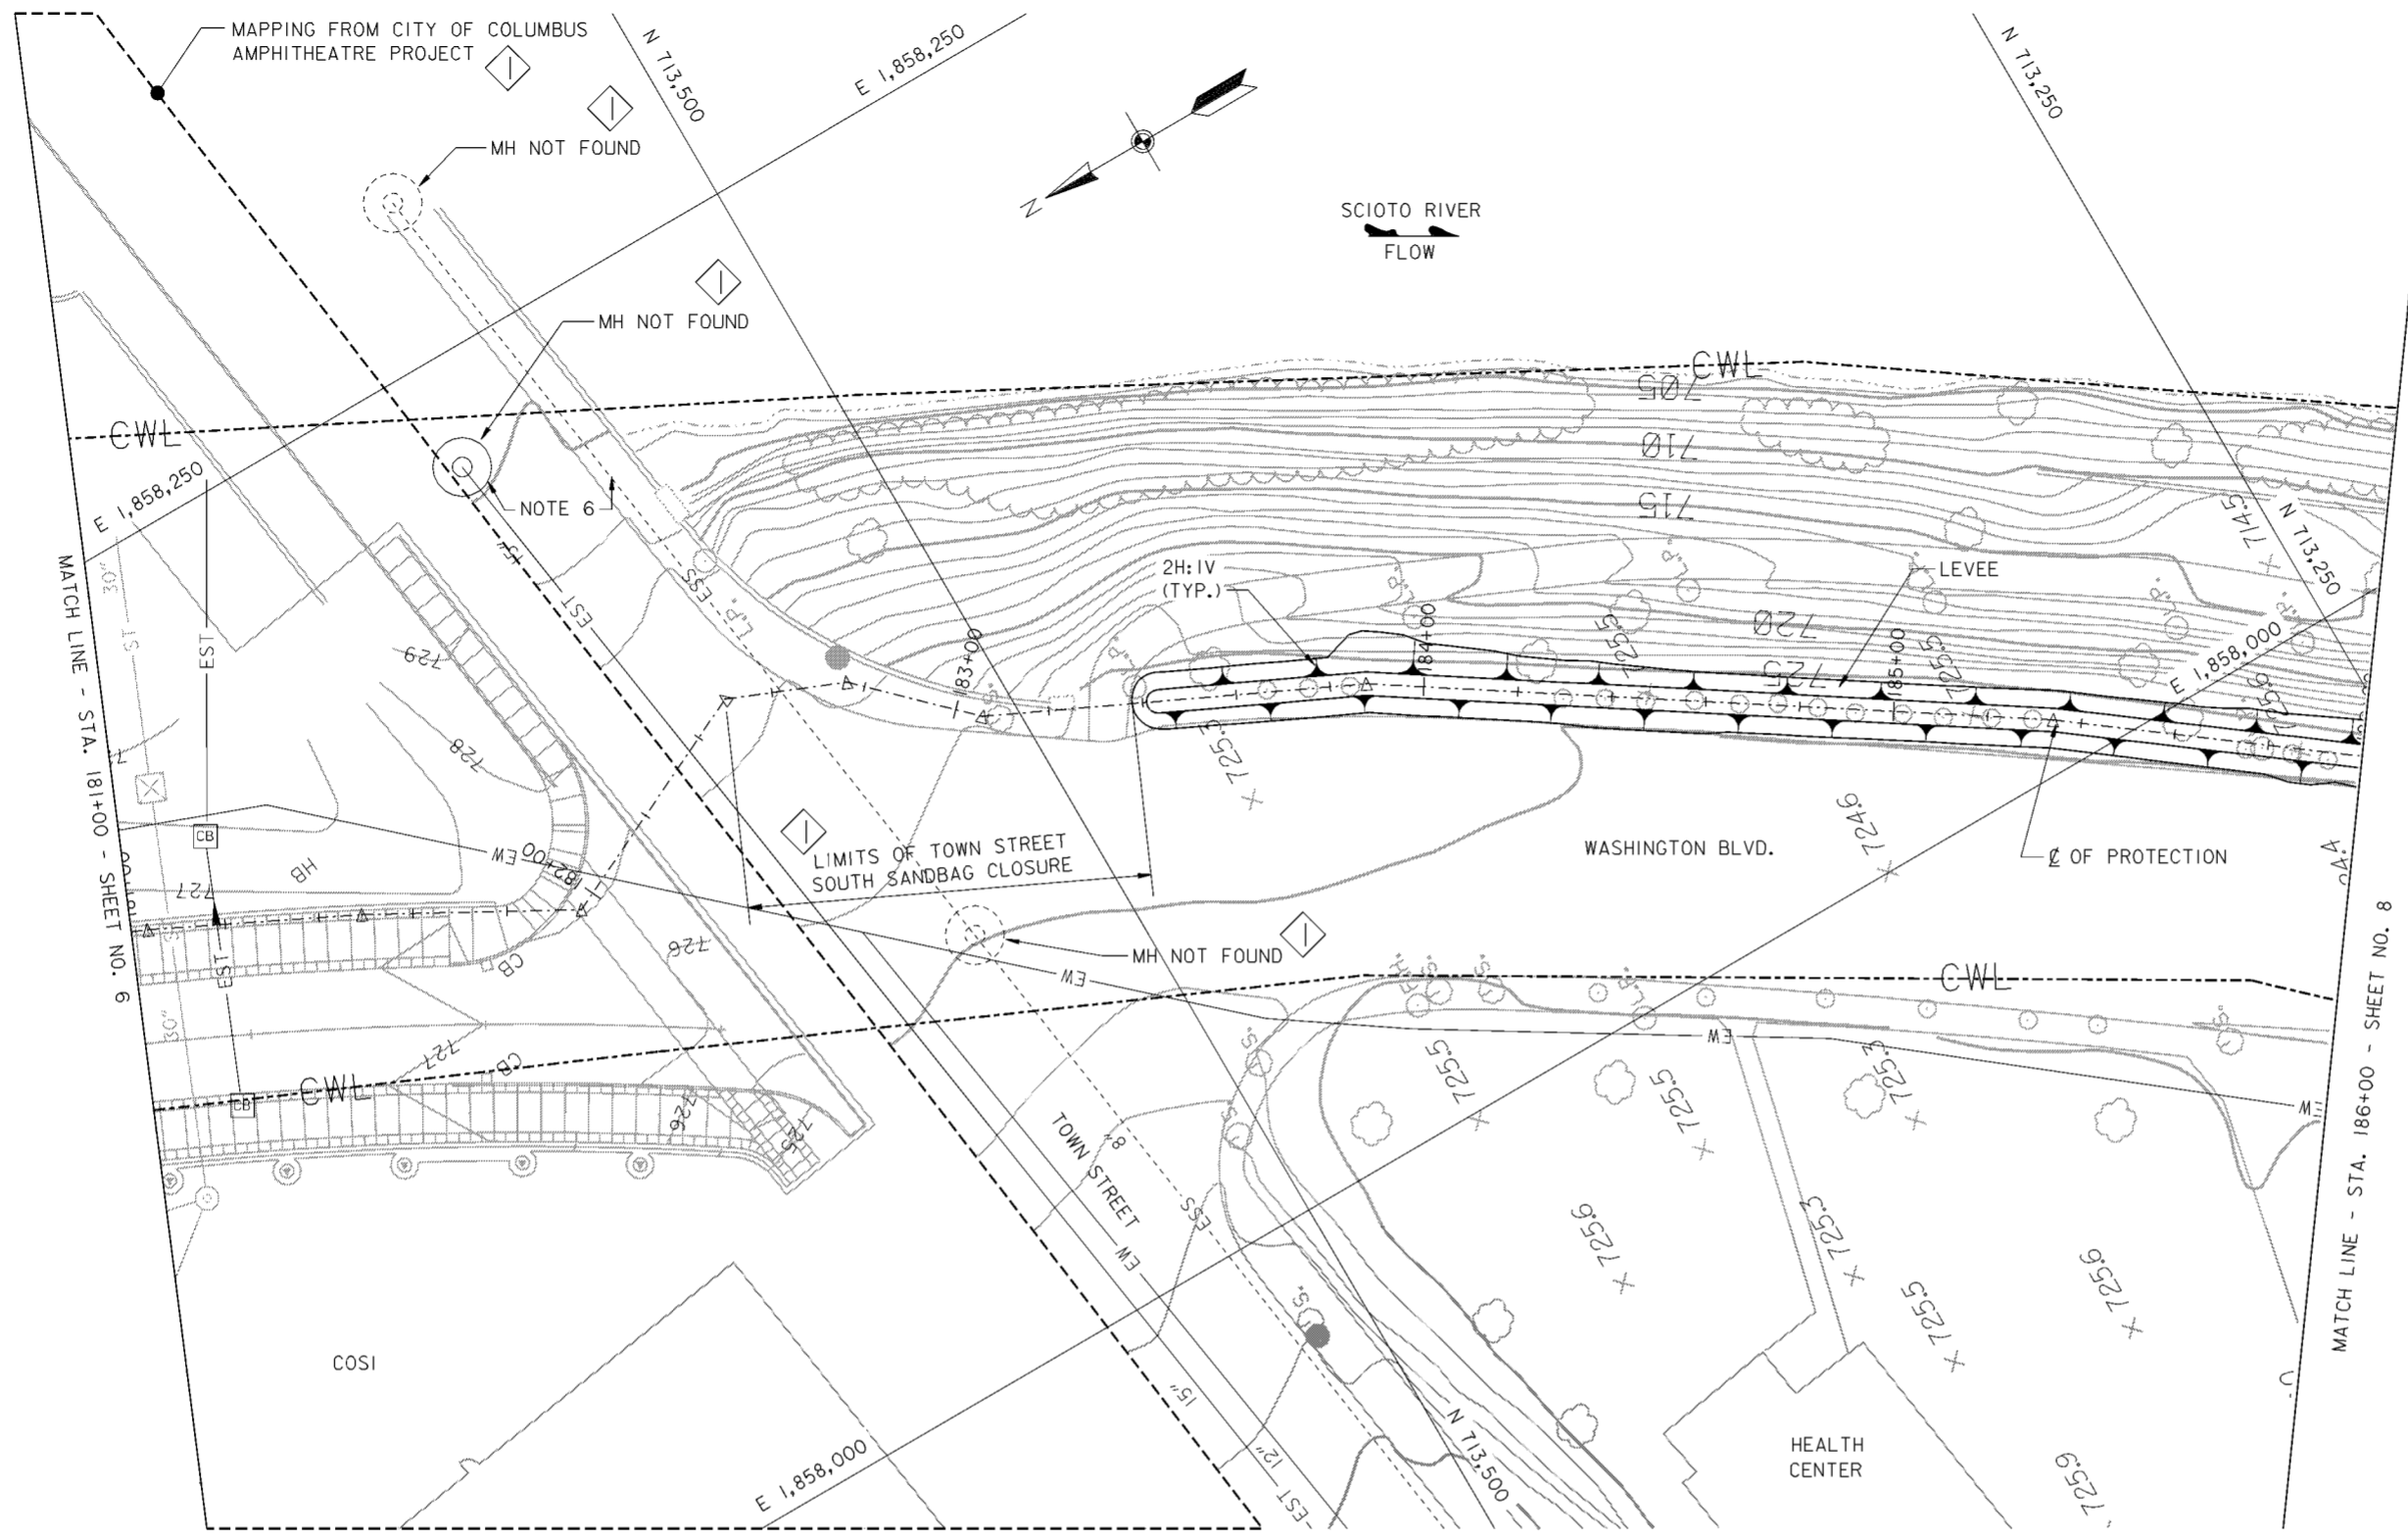

PLAN

SCALE: 1" = 20'

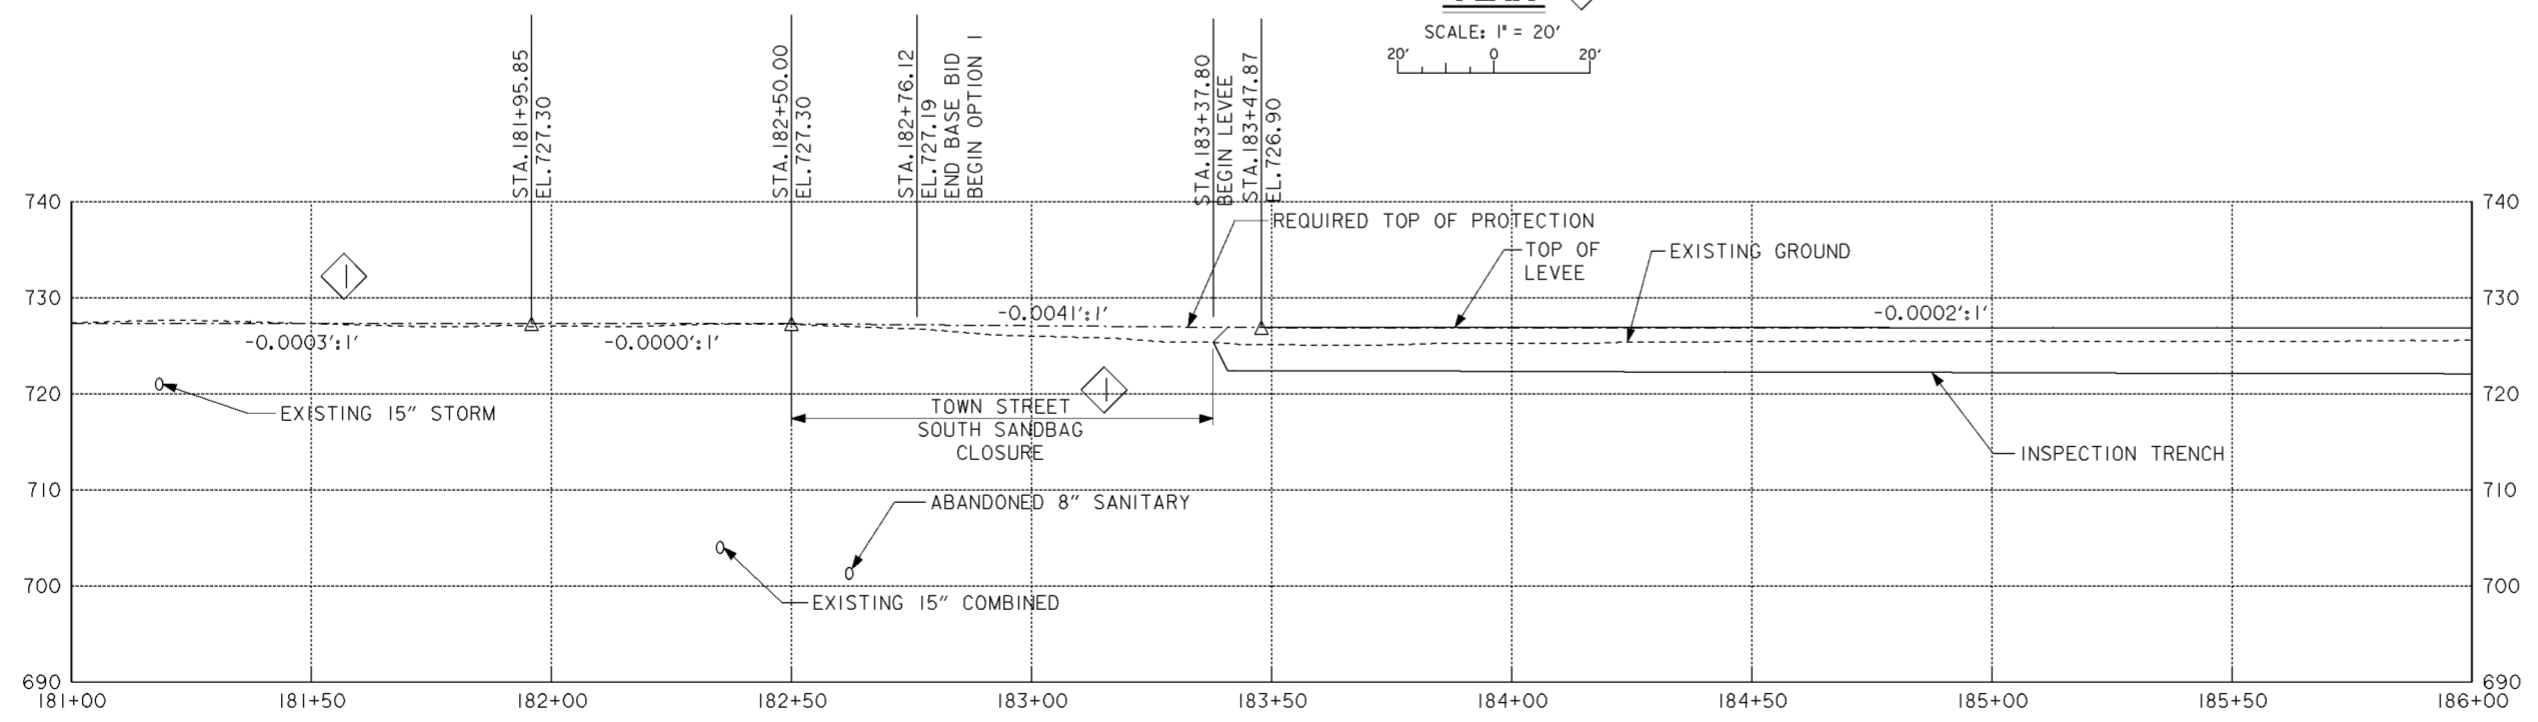


PROFILE

SCALE IN FEET

- NOTES**
1. FOR CONTRACTOR WORK LIMITS SEE DRAWING NOS. 6/1 THRU 6/4.
 2. FOR TYPICAL LEVEE SECTIONS SEE DRAWING NOS. 20.3/1 AND 20.3/2.
 3. FOR TOWN STREET SOUTH SANDBAG CLOSURE PLAN AND PROFILE SEE DRAWING NO. 20.2/4.
 4. FOR TOWN STREET WALKWAY ACCESS PLAN AND PROFILE SEE DRAWING NO. 20.2/5.
 5. SEE GENERAL NOTE 12 ON DRAWING NO. 0/4 FOR REMOVAL AND INSTALLATION OF PARKING METERS ALONG WASHINGTON BOULEVARD.
 6. THE CONTRACTOR SHALL FIELD LOCATE THE EXISTING 15-INCH STORM SEWER AND 8-INCH SANITARY SEWER AND FILL THE ABANDONED SECTIONS BACK TO THE EXISTING BULKHEADS SHOWN ON DRAWING NO. 11/4 IN ACCORDANCE WITH CMSC ITEM 202.

Revisions			
Symbol	Descriptions	Date	Approved
◊	REVISED AS CONSTRUCTED	7/02	P.O.C.

BURGESS & NIPLE, LIMITED COLUMBUS, OHIO	U.S. ARMY ENGINEER DISTRICT CORPS OF ENGINEERS WEST COLUMBUS, OHIO WEST COLUMBUS, L.P.P. PHASE IID
Designed by: J. HALL	SCIOTO RIVER COLUMBUS, OHIO WEST COLUMBUS, L.P.P. PHASE IID
Drawn by: T. MULLINS	PLAN AND PROFILE STA. 181+00 TO 186+00
Checked by: P. CONROY	Scale: AS SHOWN
Reviewed by:	Date: MARCH 1998
Approved by:	Drawing Code: 16-PWC-10-
	Sheet reference number: 167
	FILENAME: PEN TABLE: a005pp07.dgn
	Sheet 7 of 13

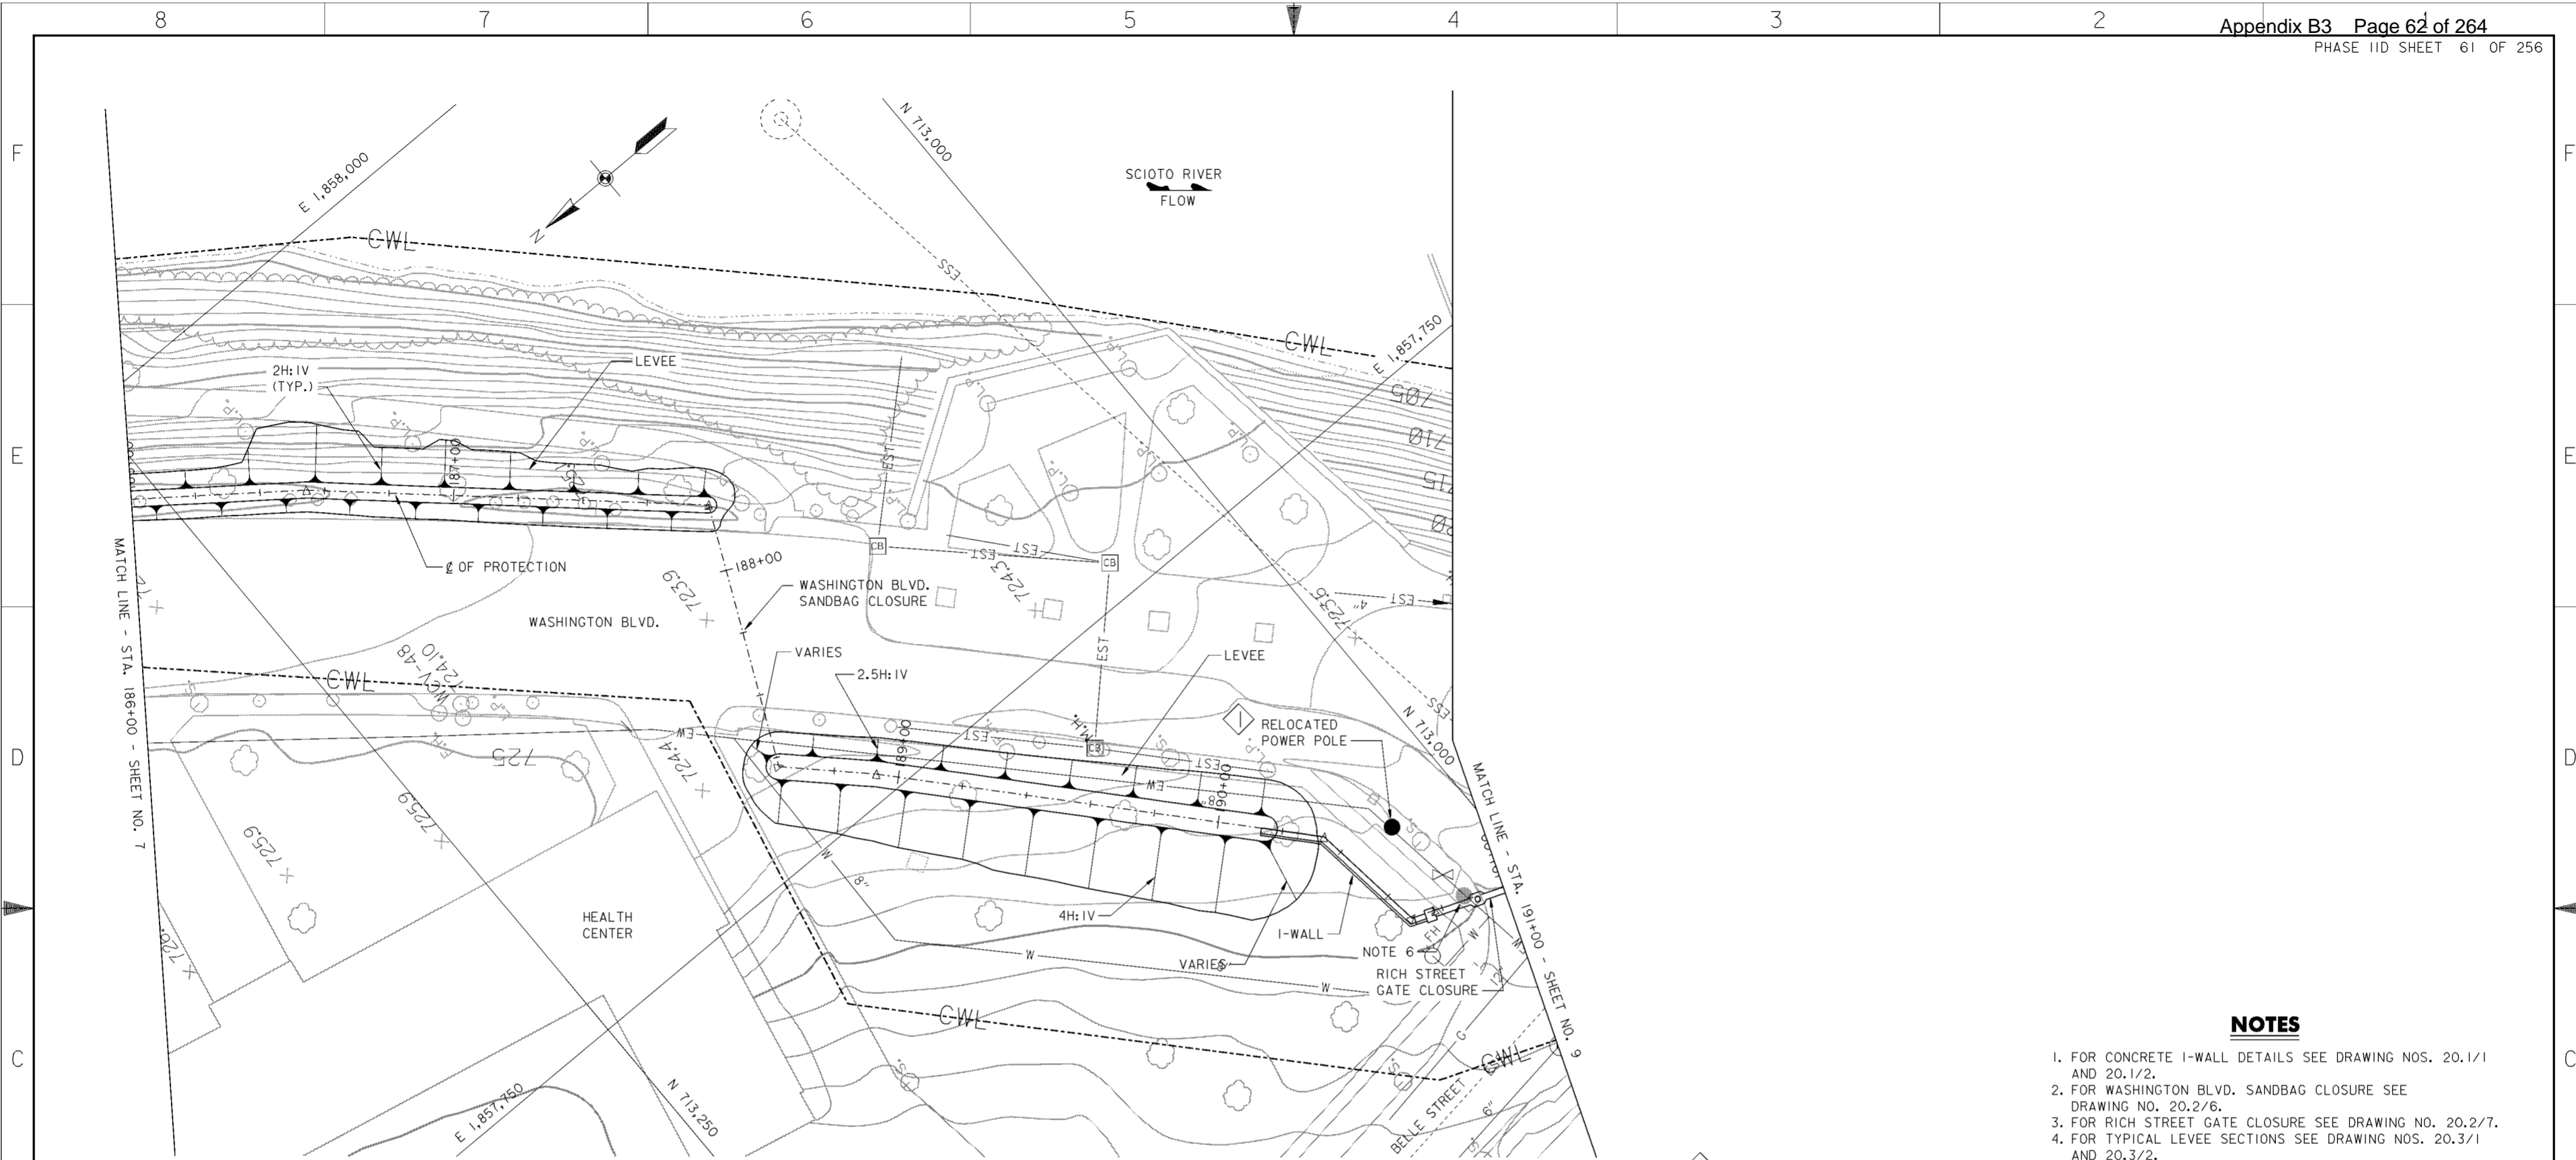


NOTES

1. FOR CONCRETE I-WALL DETAILS SEE DRAWING NOS. 20.1/1 AND 20.1/2.
2. FOR WASHINGTON BLVD. SANDBAG CLOSURE SEE DRAWING NO. 20.2/6.
3. FOR RICH STREET GATE CLOSURE SEE DRAWING NO. 20.2/7.
4. FOR TYPICAL LEVEE SECTIONS SEE DRAWING NOS. 20.3/1 AND 20.3/2.
5. SEE GENERAL NOTE 12 ON DRAWING NO. 0/4 FOR REMOVAL AND INSTALLATION OF PARKING METERS ALONG WASHINGTON BOULEVARD.
6. CITY OF COLUMBUS DIVISION OF ELECTRICITY POWER POLE TO BE RELOCATED BY CITY OF COLUMBUS. THE CONTRACTOR SHALL COORDINATE THE RICH STREET STOP LOG CLOSURE CONSTRUCTION AT LEAST FOUR WEEKS PRIOR TO COMMENCEMENT OF THIS WORK WITH THE CITY OF COLUMBUS DIVISION OF ELECTRICITY.

PLAN

SCALE: 1" = 20'

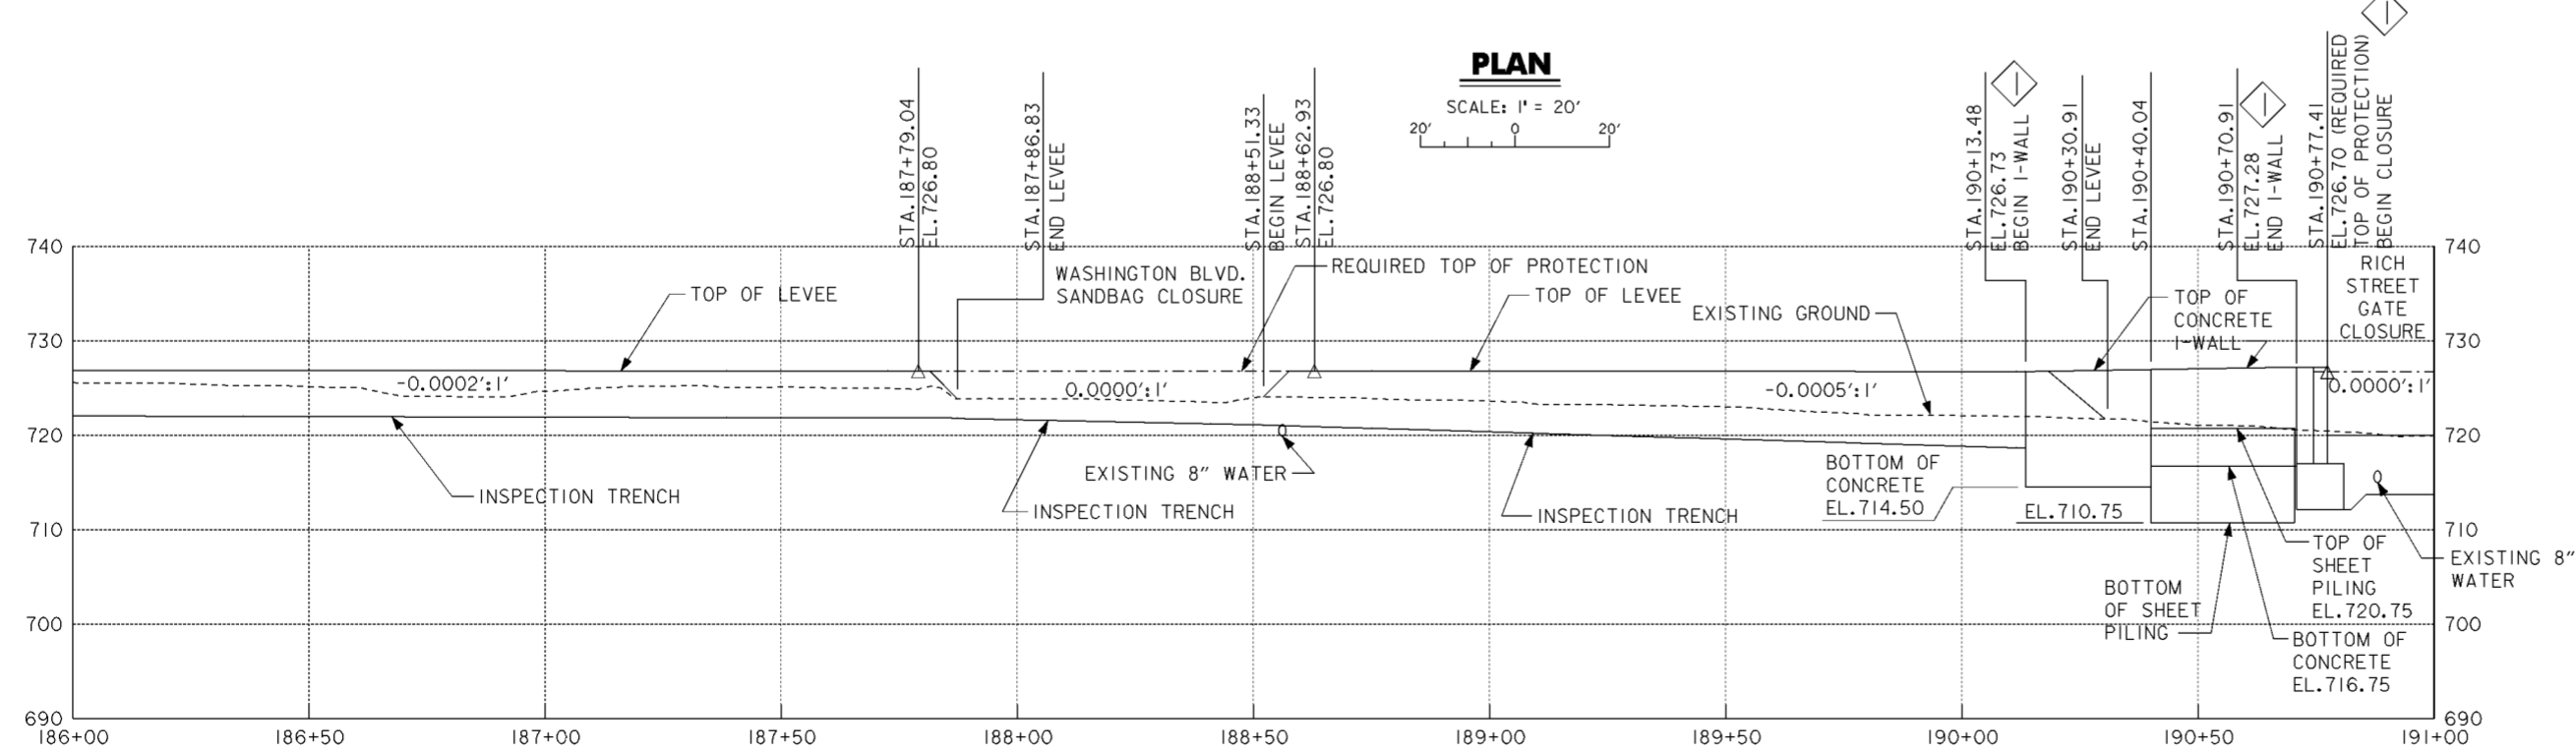


PROFILE


SCALE IN FEET

Revisions			
Symbol	Descriptions	Date	Approved
◊	REVISED AS CONSTRUCTED	7/02	P.O.C.

BURGESS & NIPLE, LIMITED COLUMBUS, OHIO	U.S. ARMY ENGINEER DISTRICT CORPS OF ENGINEERS HUNTINGTON, WEST VIRGINIA		
Designed by: J. HALL	SCIO TO RIVER COLUMBUS, OHIO WEST COLUMBUS, L.P.P. PHASE IID		
Drawn by: T. MULLINS	PLAN AND PROFILE STA. 186 + 00 TO 191 + 00		
Checked by: P. CONROY			
Reviewed by:	Scale: AS SHOWN	Sheet reference number: 16/8	FILENAME: a05pp08.dgn
Approved by:	Date: MARCH 1998	Drawing Code: 16-PWC-10-	PIN TABLE:

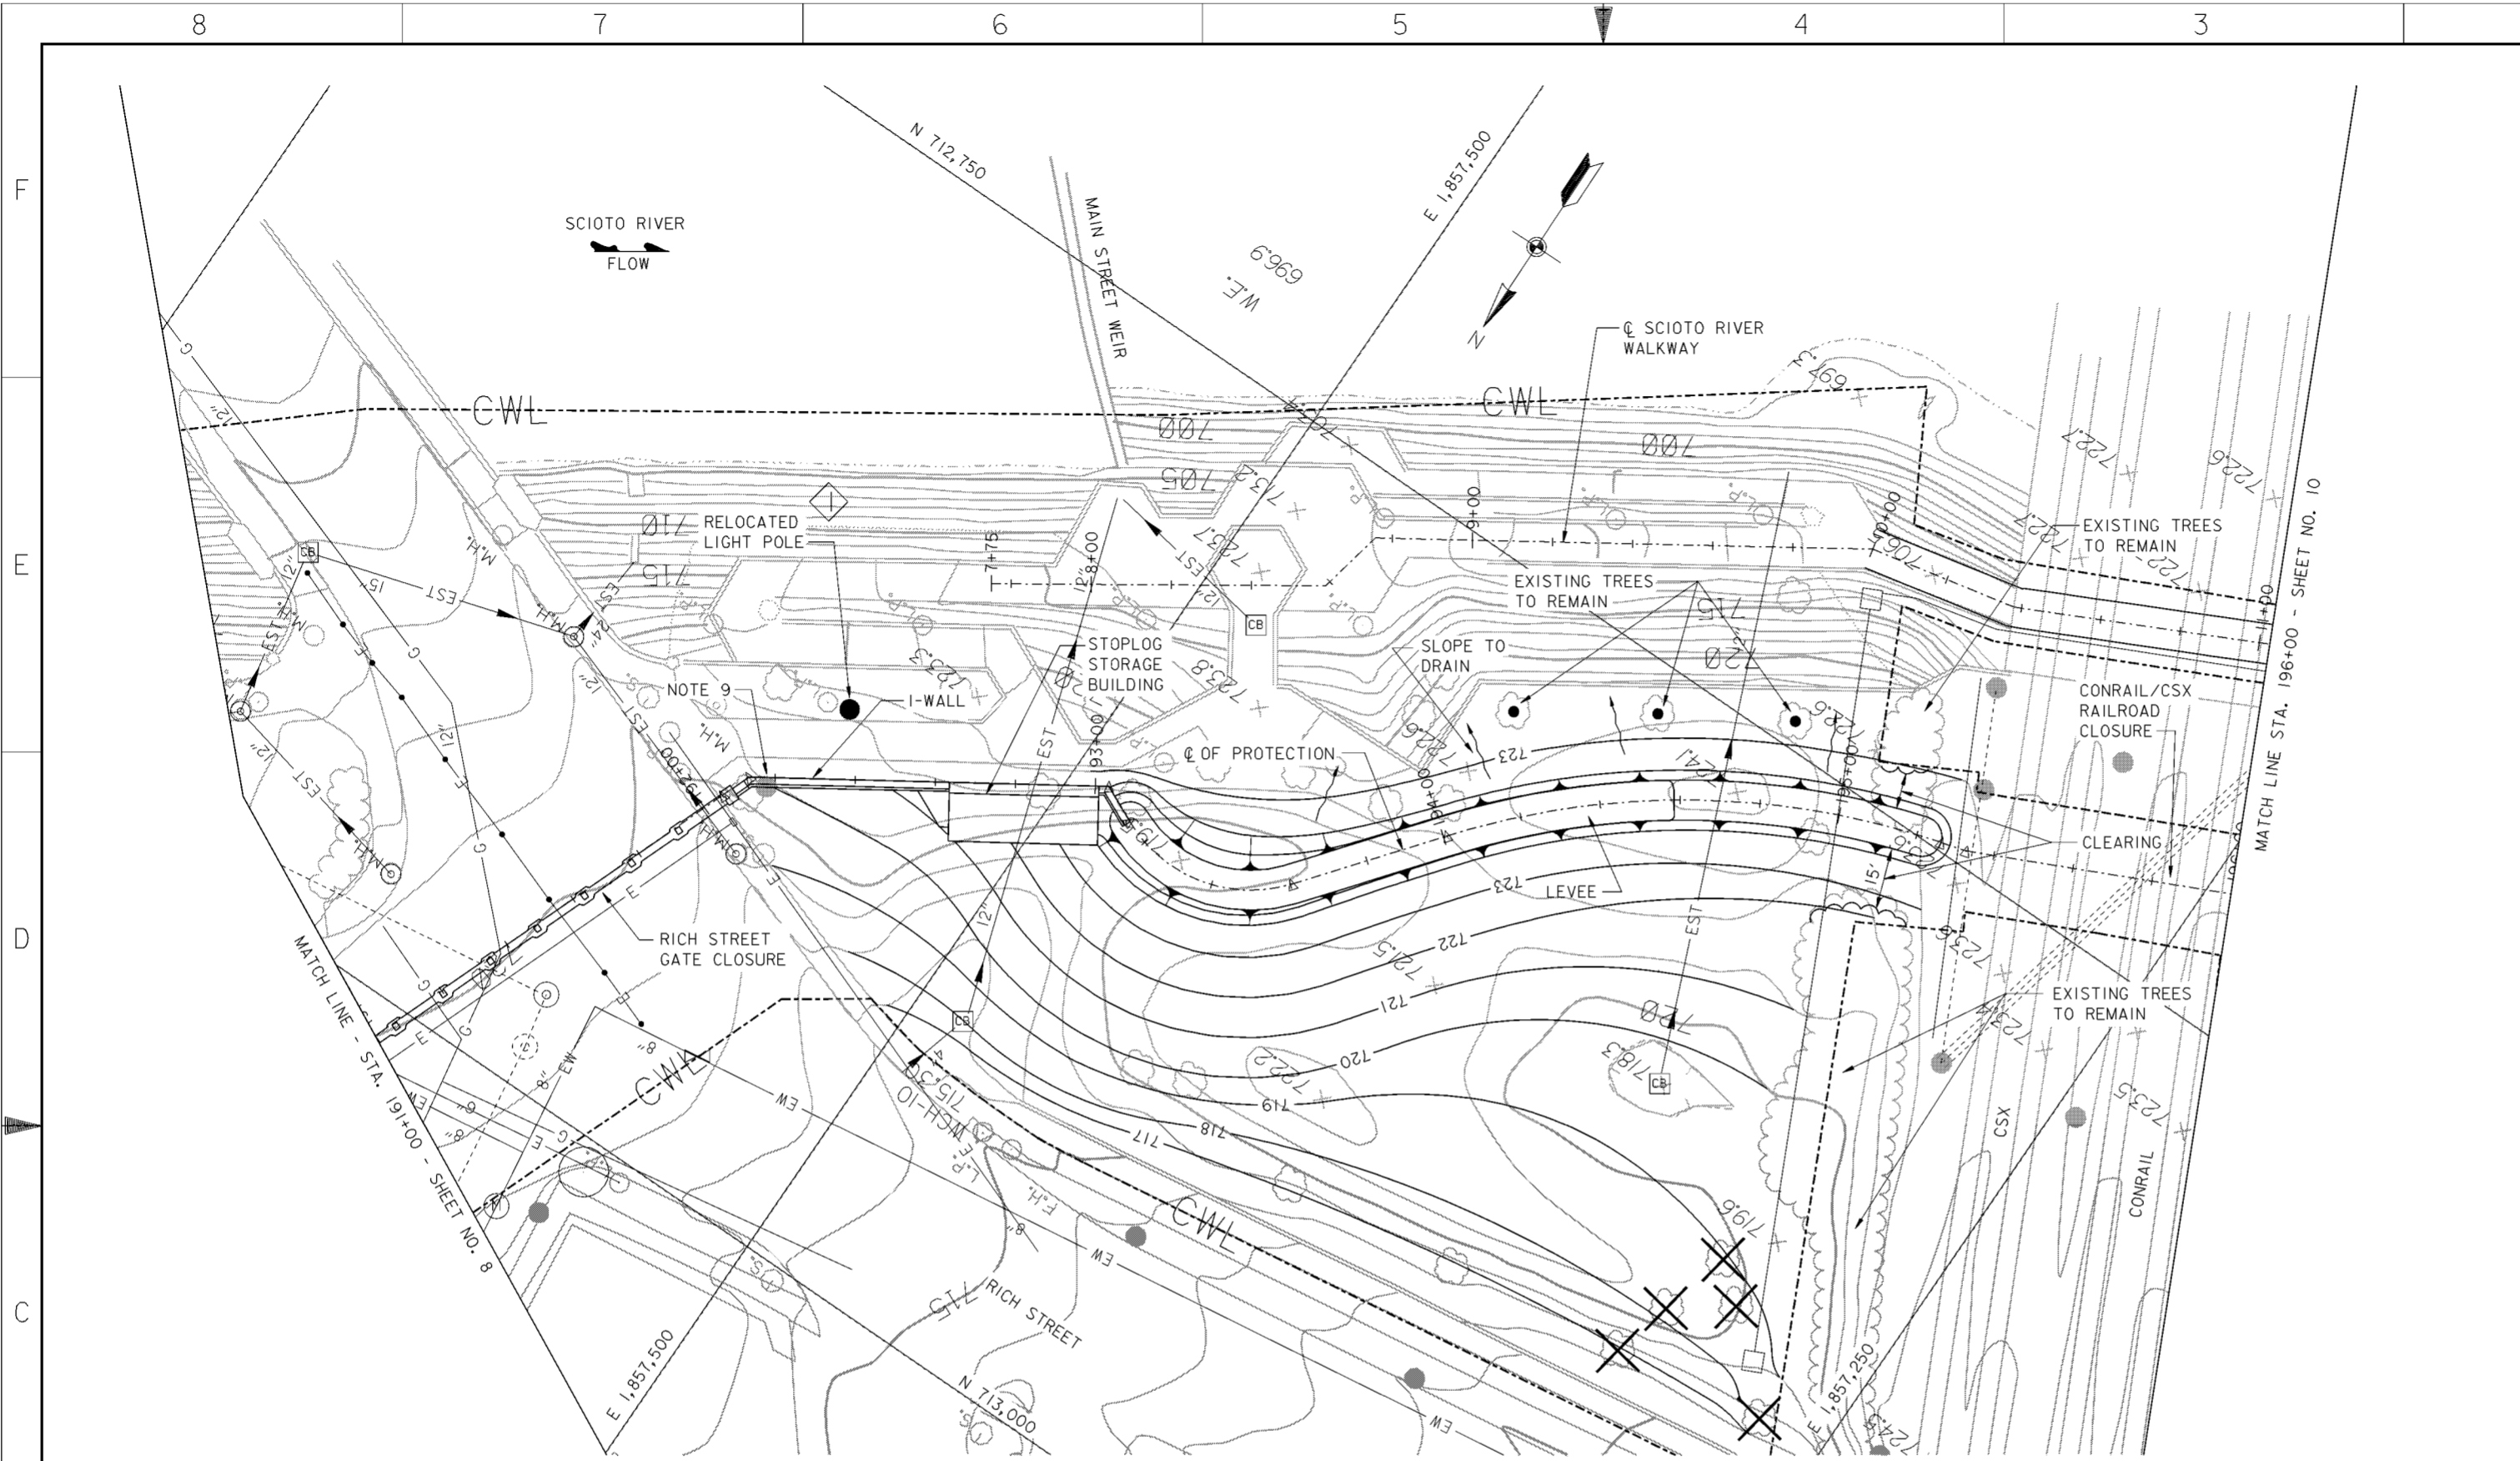

PLAN

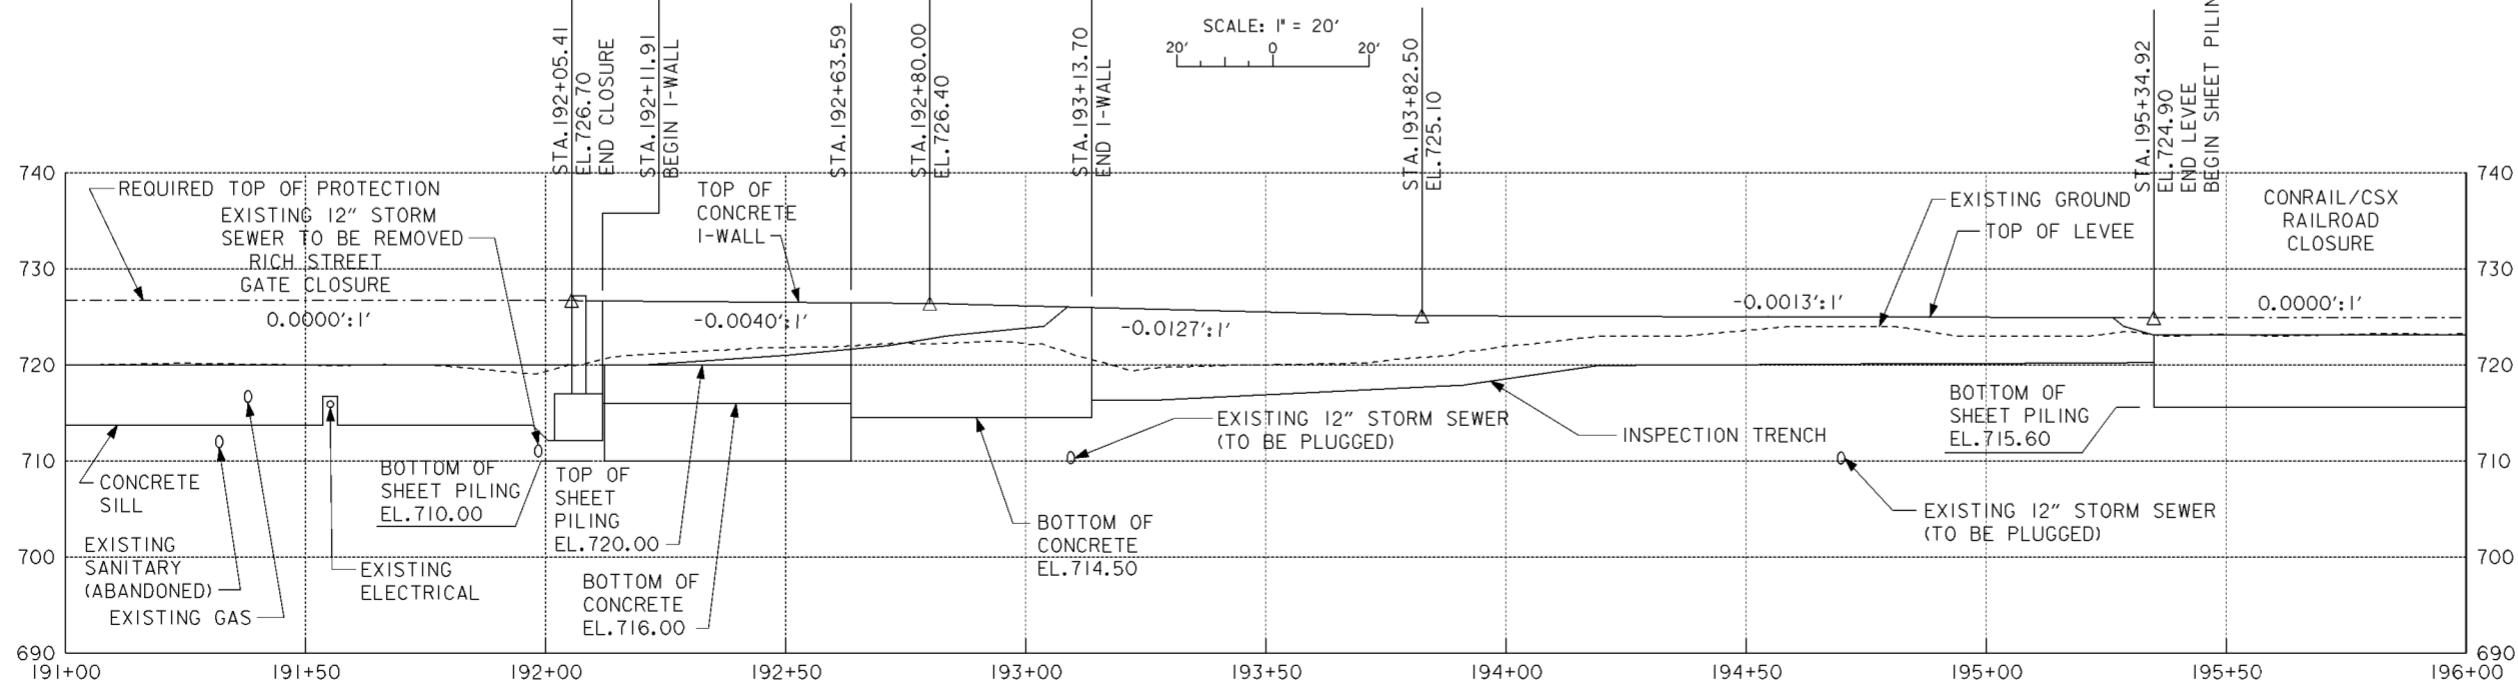

PROFILE

SCALE IN FEET

NOTE: Line of Protection alignment has been changed per E-1934 pgs. 88-94

LEGEND

✕ - EXISTING TREE TO BE REMOVED


NOTES

1. FOR CONCRETE I-WALL DETAILS SEE DRAWING NOS. 20.1/1 AND 20.1/2.
2. FOR CONTRACTOR WORK LIMITS SEE DRAWING NOS. 6/1 THRU 6/4.
3. FOR RICH STREET GATE CLOSURE SEE DRAWING NO. 20.2/7.
4. FOR RICH STREET STOPLOG STORAGE BUILDING SEE DRAWING NOS. 20.2/15 THRU 20.2/17.
5. FOR RICH STREET INTERIOR DRAINAGE SEE DRAWING NO. 15/2.
6. FOR TYPICAL LEVEE SECTIONS SEE DRAWING NOS. 20.3/1 AND 20.3/2.
7. FOR CONRAIL/CSX RAILROAD CLOSURE SEE DRAWING NO. 20.2/18.
8. FOR SCIOTO RIVER WALKWAY SEE DRAWING NOS. 20.5/2 THRU 20.5/4.
9. CITY OF COLUMBUS DIVISION OF ELECTRICITY POWER POLE TO BE RELOCATED BY CITY OF COLUMBUS. THE CONTRACTOR SHALL COORDINATE THE RICH STREET STOP LOG STORAGE CONSTRUCTION AT LEAST FOUR WEEKS PRIOR TO COMMENCEMENT OF THIS WORK WITH THE CITY OF COLUMBUS DIVISION OF ELECTRICITY.


Revisions			
Symbol	Descriptions	Date	Approved
◊	REVISED AS CONSTRUCTED	7/02	P.O.C.

BURGESS & NIPLE, LIMITED COLUMBUS, OHIO	U.S. ARMY ENGINEER DISTRICT CORPS OF ENGINEERS HUNTINGTON, WEST VIRGINIA
Designed by: J. HALL	SCIO TO RIVER COLUMBUS, OHIO WEST COLUMBUS, L.P.P. PHASE IID
Drawn by: T. MULLINS	PLAN AND PROFILE
Checked by: P. CONROY	STA. 191+00 TO 196+00
Reviewed by:	Scale: AS SHOWN
Approved by:	Date: MARCH 1998
	Drawing Code: 16-PWC-10-
	Sheet reference number: 16/9
	FILENAME: PEN TABLE: a05pp09.dgn
	Sheet 9 of 13

WORK AS CONSTRUCTED

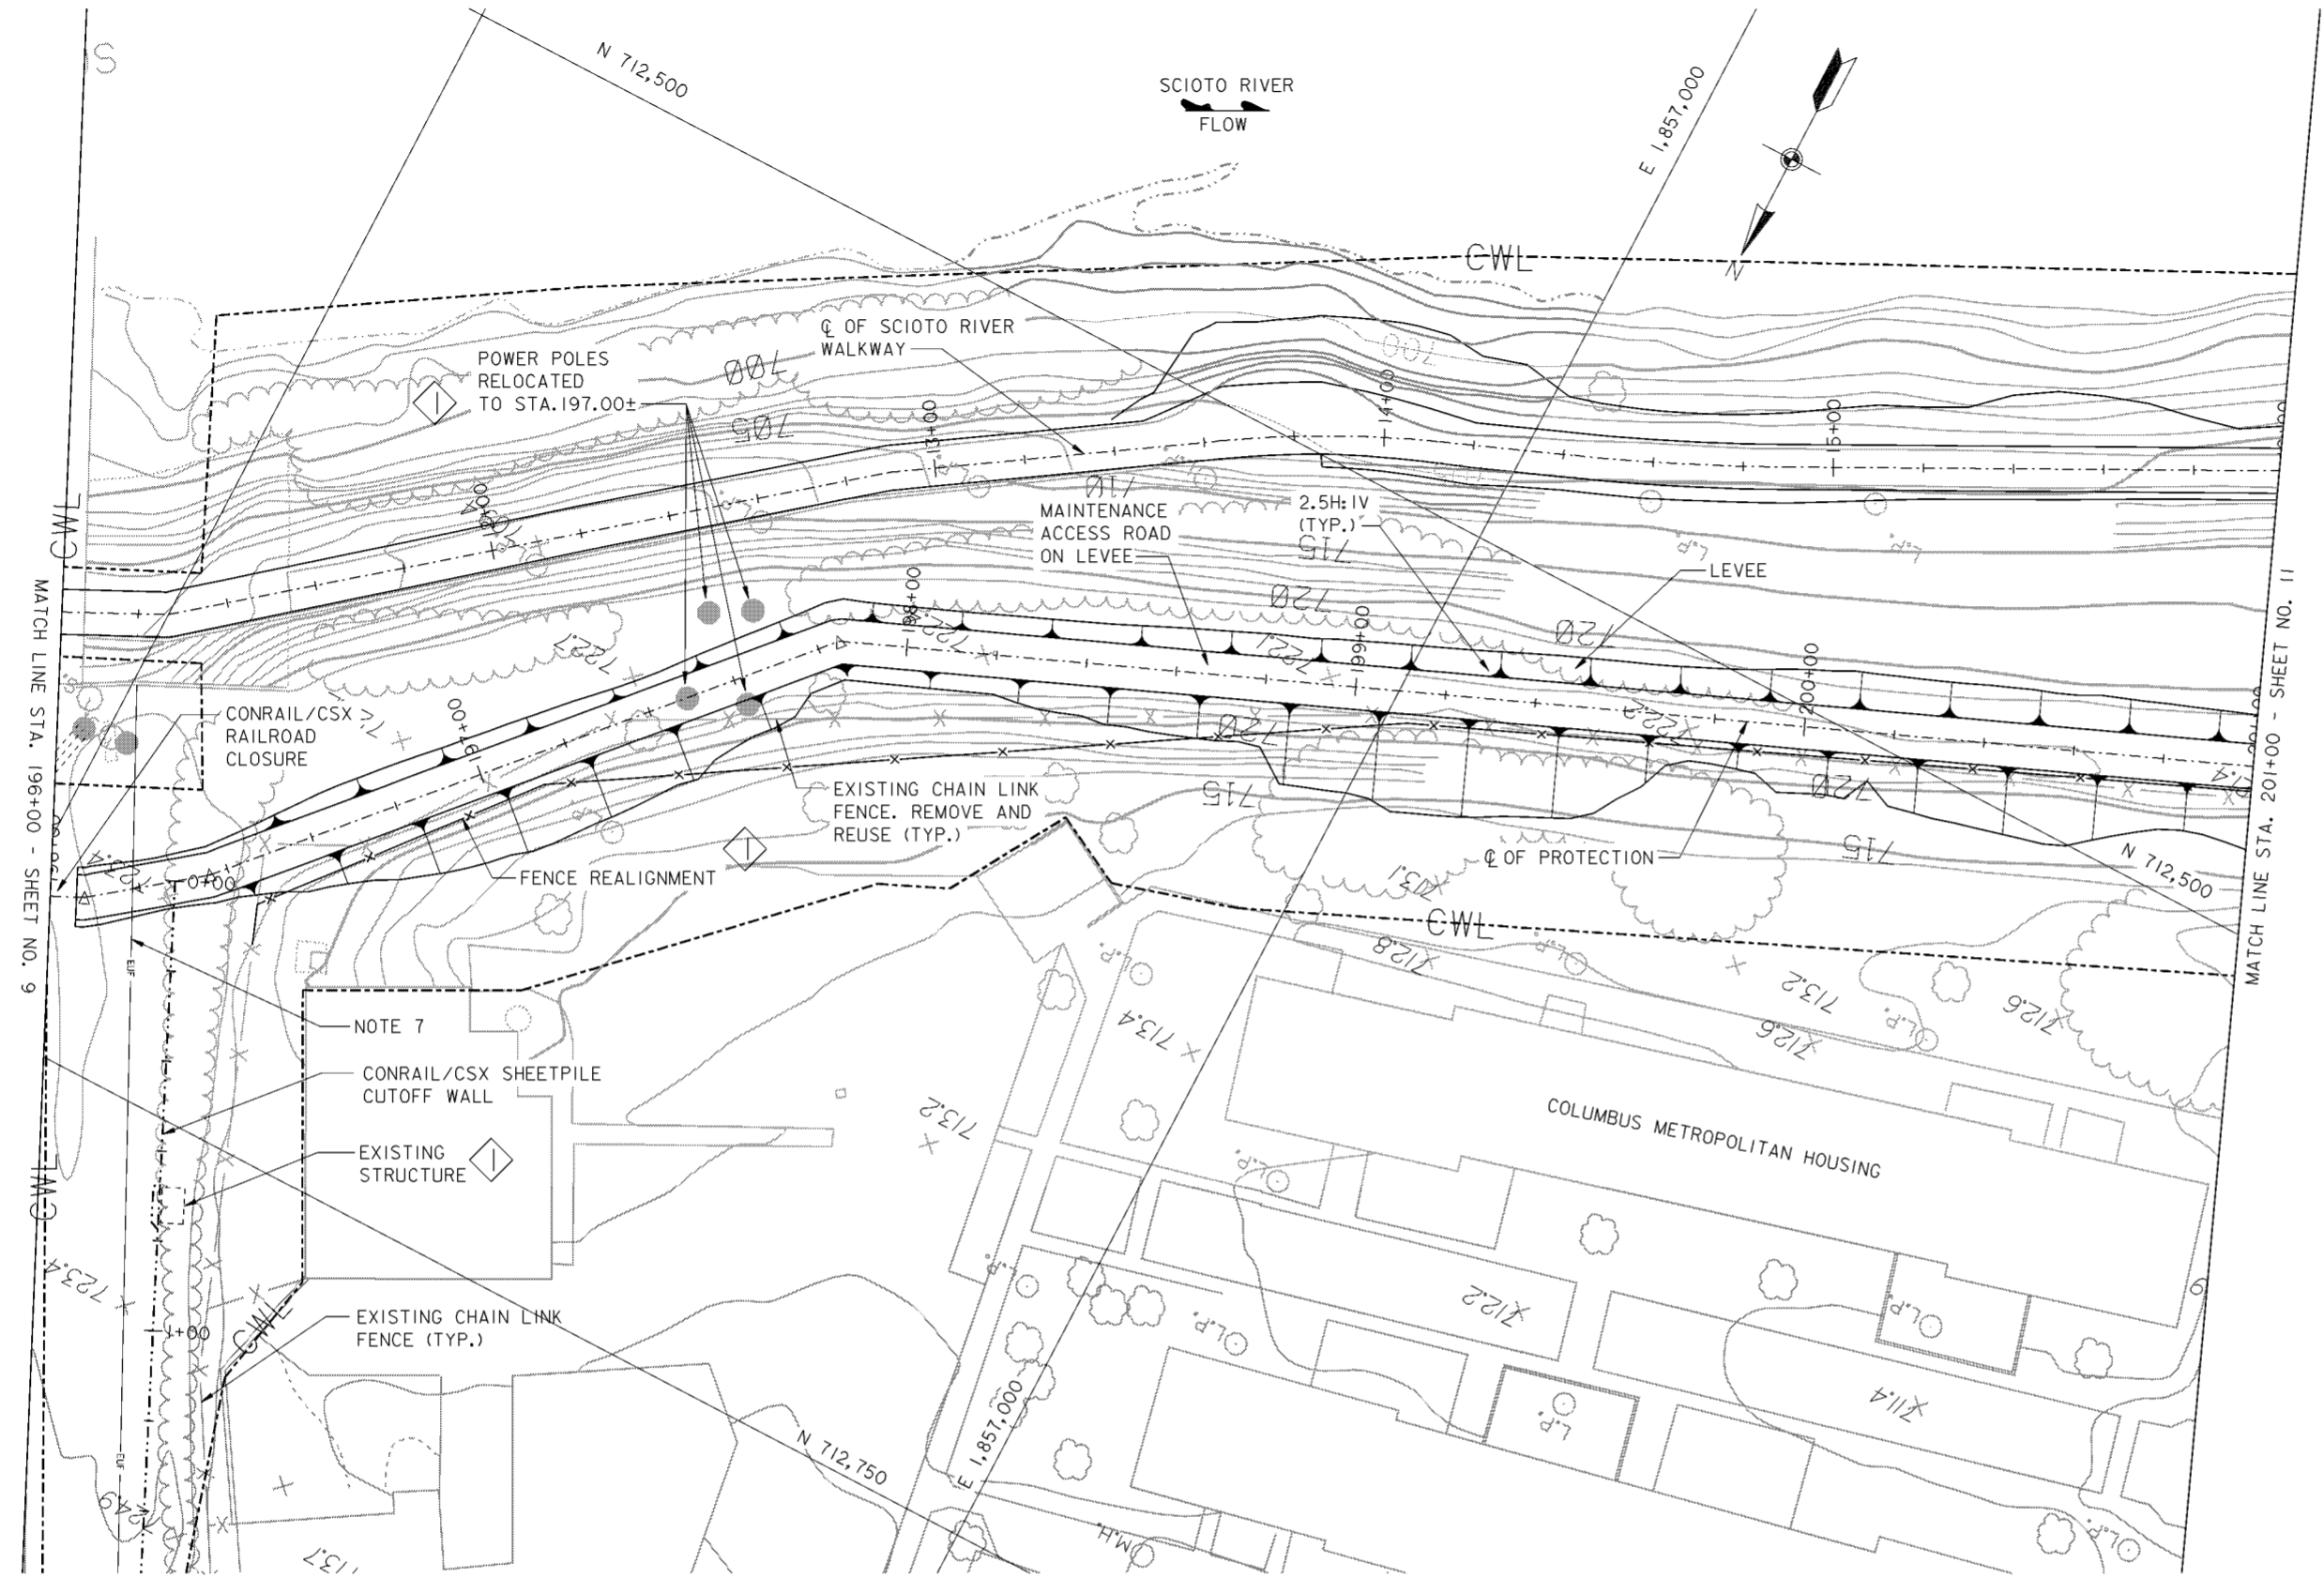

PLAN
 SCALE: 1" = 20'

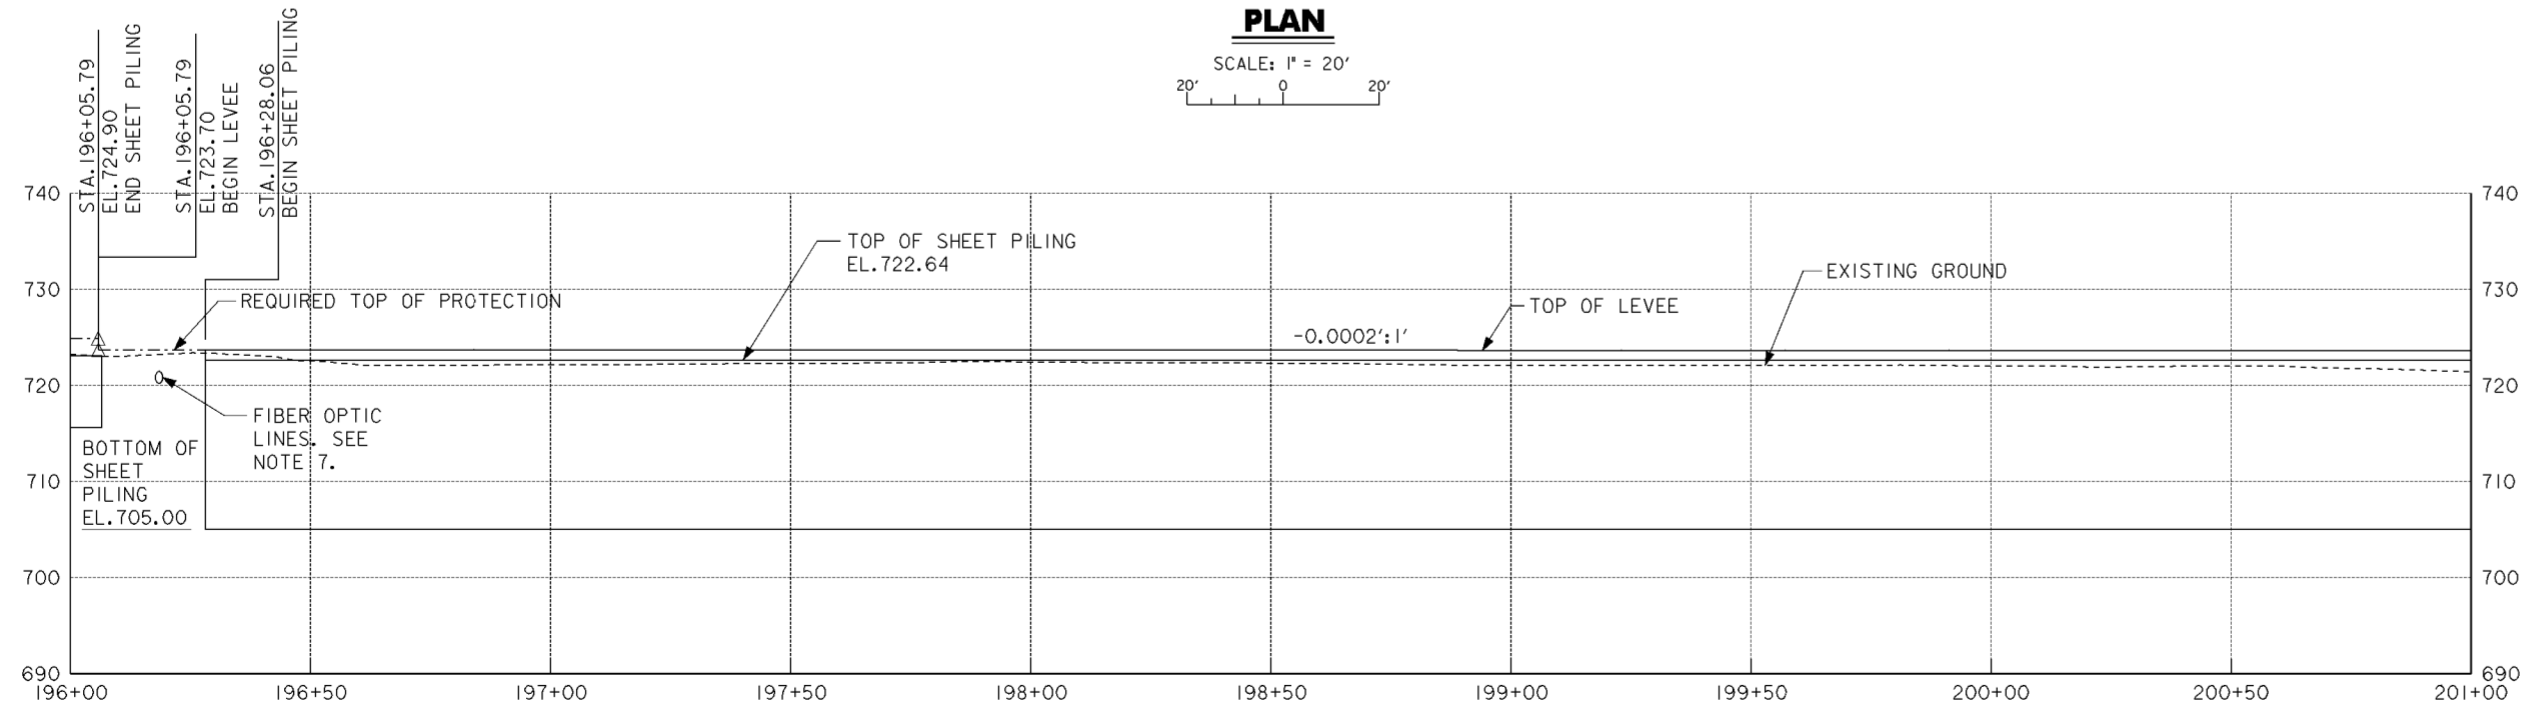


PROFILE
 SCALE IN FEET

NOTES

- FOR CONCRETE I-WALL DETAILS SEE DRAWING NOS. 20.1/1 AND 20.1/2.
- FOR CONRAIL/CSX RAILROAD CLOSURE SEE DRAWING NO. 20.2/18.
- FOR CONRAIL/CSX SHEETPILE CUTOFF WALL SEE DRAWING NO. 20.2/20.
- FOR TYPICAL LEVEE SECTIONS SEE DRAWING NOS. 20.3/1 AND 20.3/2.
- FOR SCIO TO RIVER WALKWAY SEE DRAWING NOS. 20.5/2 THRU 20.5/4.
- THE LOCATION OF THE CHAIN LINK FENCE IS APPROXIMATE AND SHALL BE FIELD SURVEYED PRIOR TO DISMANTLING. THE FENCE SHALL BE REMOVED AND STORED FOR RE-USE TO THE ORIGINAL ALIGNMENT EXCEPT AS SHOWN AFTER CONSTRUCTION OF THE LEVEE IS COMPLETE.
- MULTIPLE EXISTING FIBER OPTIC LINES (2 MCI AND SPRINT) LOCATED IN RAILROAD RIGHT-OF-WAY SOUTH OF CONRAIL/CSX TRACKS. THE CONTRACTOR SHALL HAVE LINES LOCATED BY THE OWNING COMPANY PRIOR TO EXCAVATION AND PLACEMENT OF EMBANKMENT.

Revisions			
Symbol	Descriptions	Date	Approved
◁	REVISED AS CONSTRUCTED	7/02	P.O.C.


BURGESS & NIPLE, LIMITED COLUMBUS, OHIO	U.S. ARMY ENGINEER DISTRICT CORPS OF ENGINEERS HUNTINGTON, WEST VIRGINIA
Designed by: J. HALL	SCIO TO RIVER COLUMBUS, OHIO WEST COLUMBUS, L.P.P. PHASE IID
Drawn by: T. MULLINS	PLAN AND PROFILE STA. 196+00 TO 201+00
Checked by: P. CONROY	Scale: AS SHOWN
Reviewed by:	Date: MARCH 1998
Approved by:	Sheet reference number: 16/10
	FILENAME: a009pp10.dgn
	Sheet 10 of 13

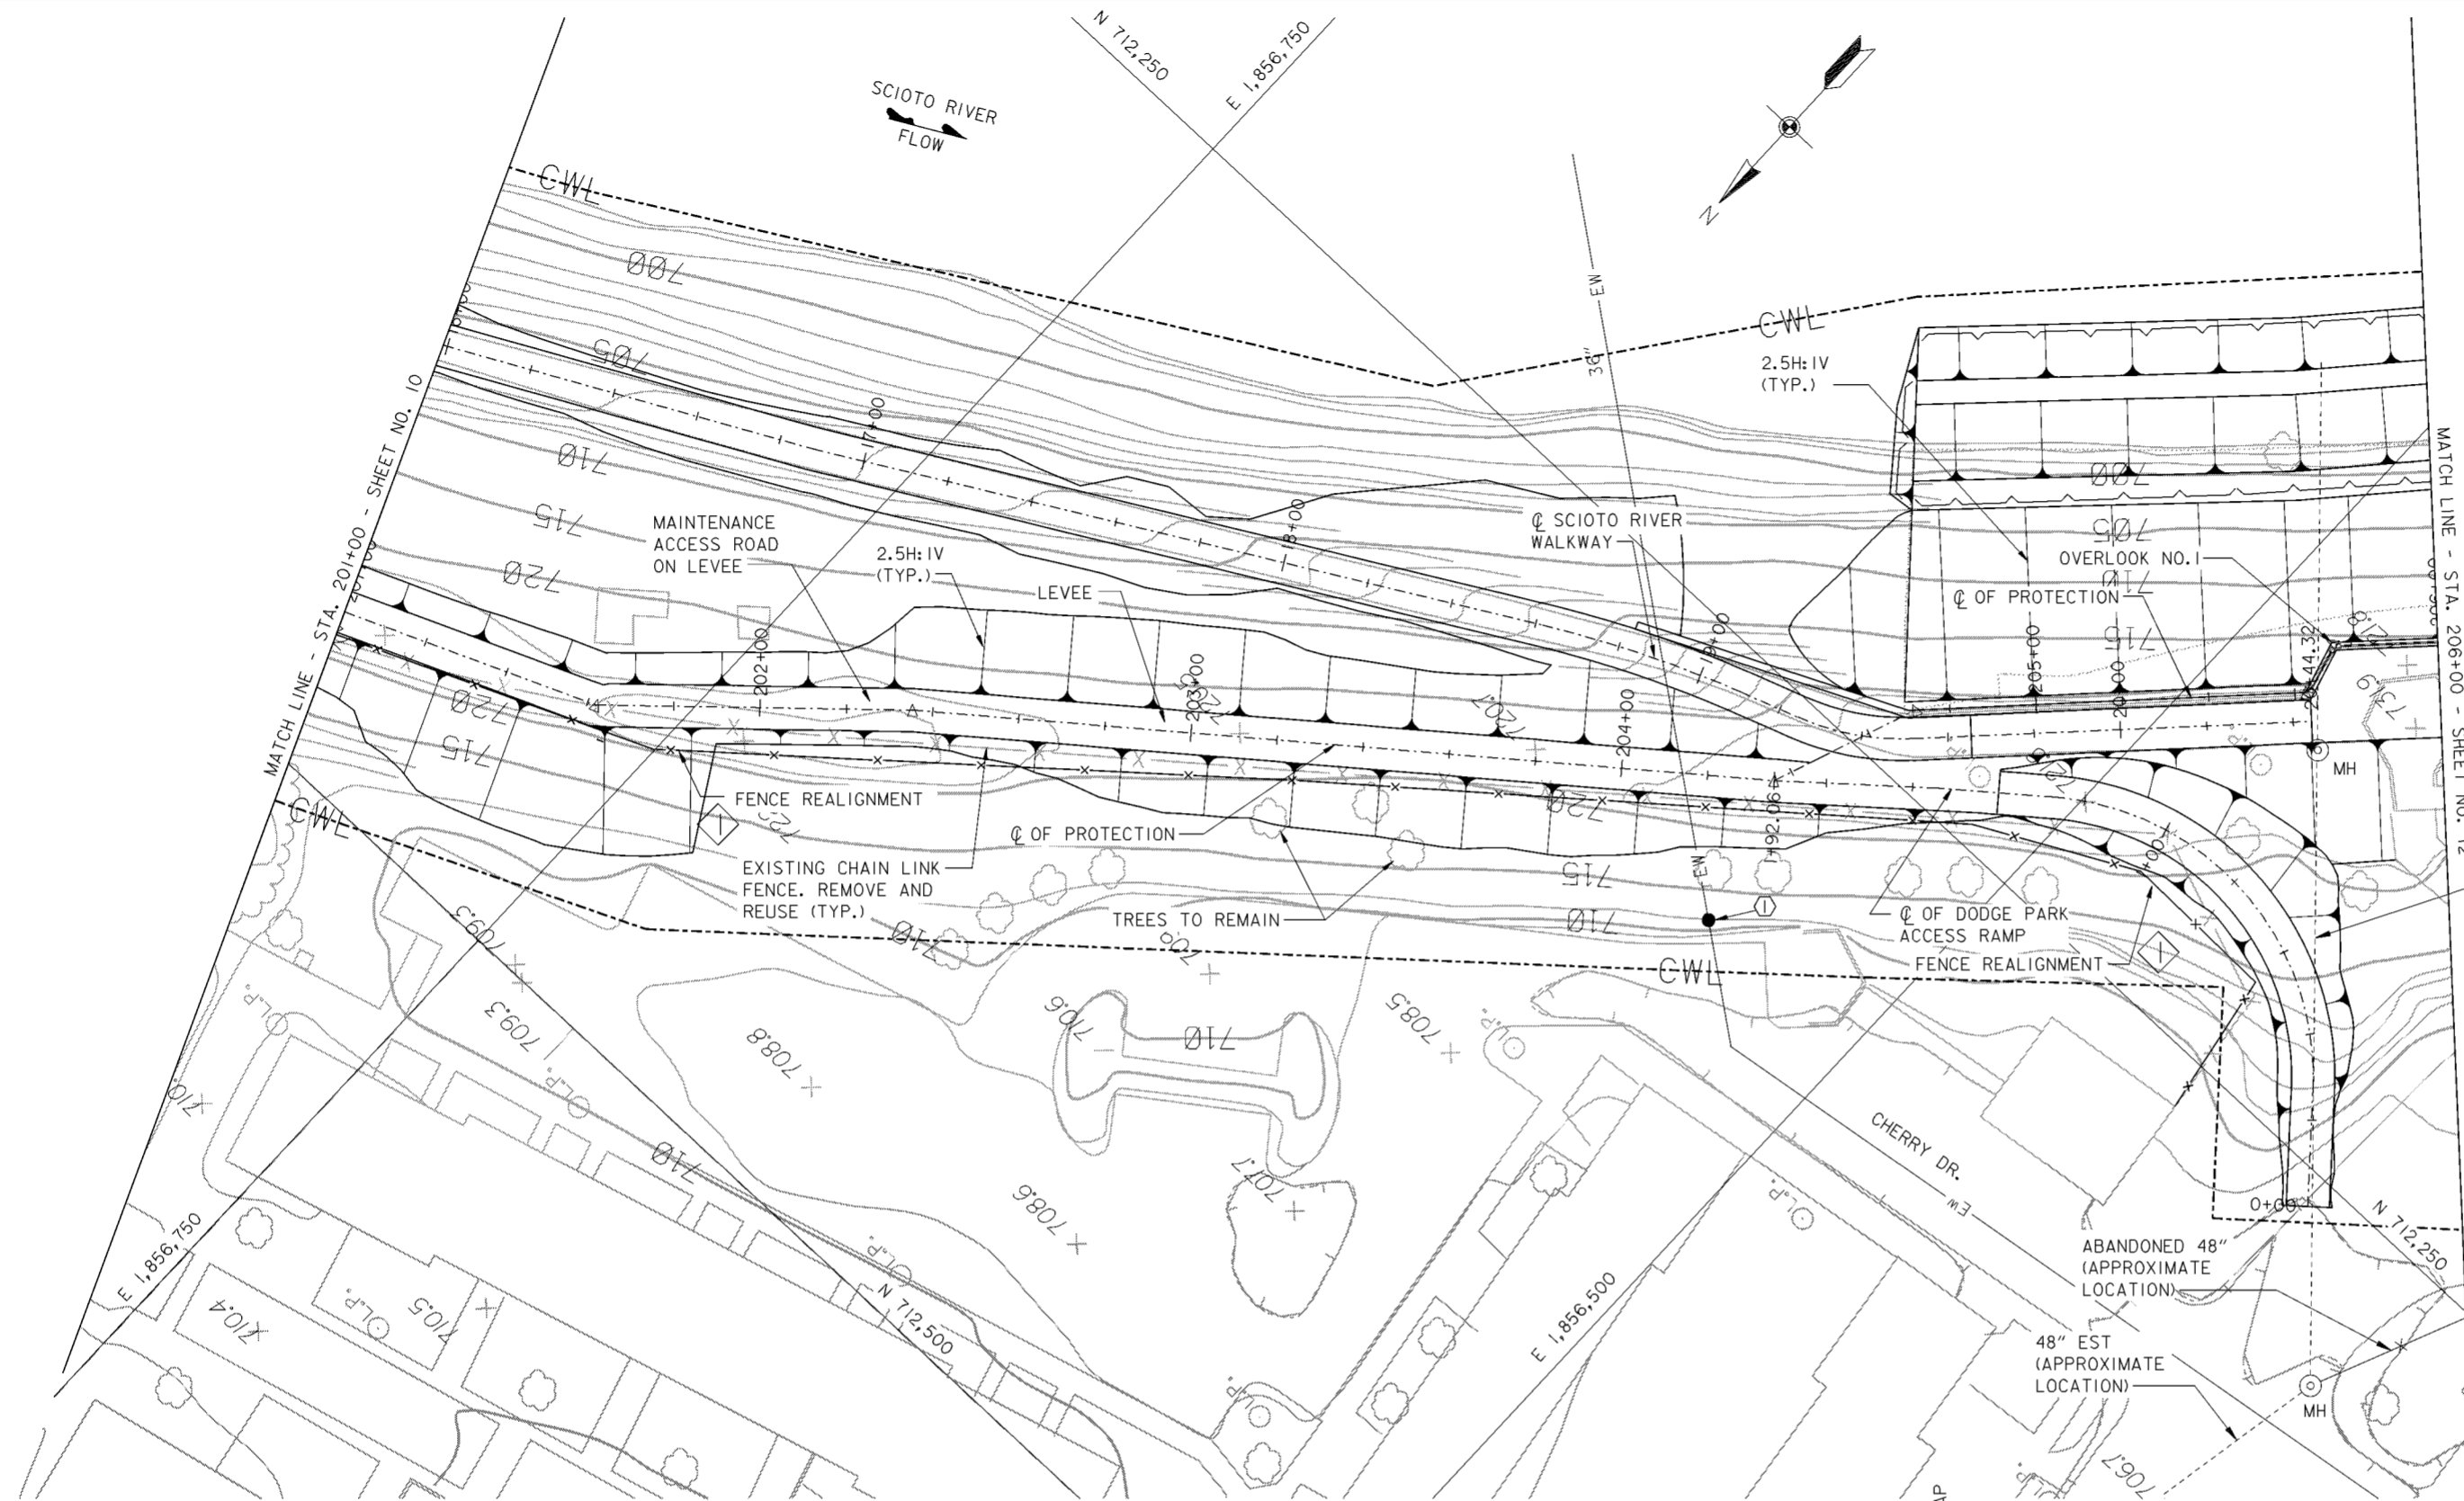

Ⓢ EXISTING 36" WATERLINE FIELD LOCATED AT
 NORTHING 712,302.78
 EASTING 1,856,544.40
 TOP AT EL. 699.88
 WATERLINE ALIGNMENT IS SHOWN APPROXIMATELY.
 CONTRACTOR TO EXERCISE CAUTION WHEN DRIVING
 SHEET PILING IN THE VICINITY OF EXISTING 36" WATER
 LINE.

NOTES

1. FOR TYPICAL LEVEE SECTIONS SEE DRAWING NOS. 20.3/1 AND 20.3/2.
2. FOR DODGE PARK ACCESS RAMP SEE DRAWING NO. 20.2/21.
3. FOR SCIOTO RIVER WALKWAY SEE DRAWING NOS. 20.5/2 THRU 20.5/4.
4. FOR CONCRETE CAP SEE DRAWING NO. 20.3/2.
5. FOR DODGE PARK OVERLOOKS SITE PLANS SEE DRAWING NOS. 20.2/24 AND 20.2/25.
6. THE LOCATION OF THE CHAIN LINK FENCE IS APPROXIMATE AND SHALL BE FIELD SURVEYED PRIOR TO DISMANTLING. THE FENCE SHALL BE REMOVED AND STORED FOR RE-USE TO THE ORIGINAL ALIGNMENT EXCEPT AS SHOWN AFTER CONSTRUCTION OF THE LEVEE IS COMPLETE.

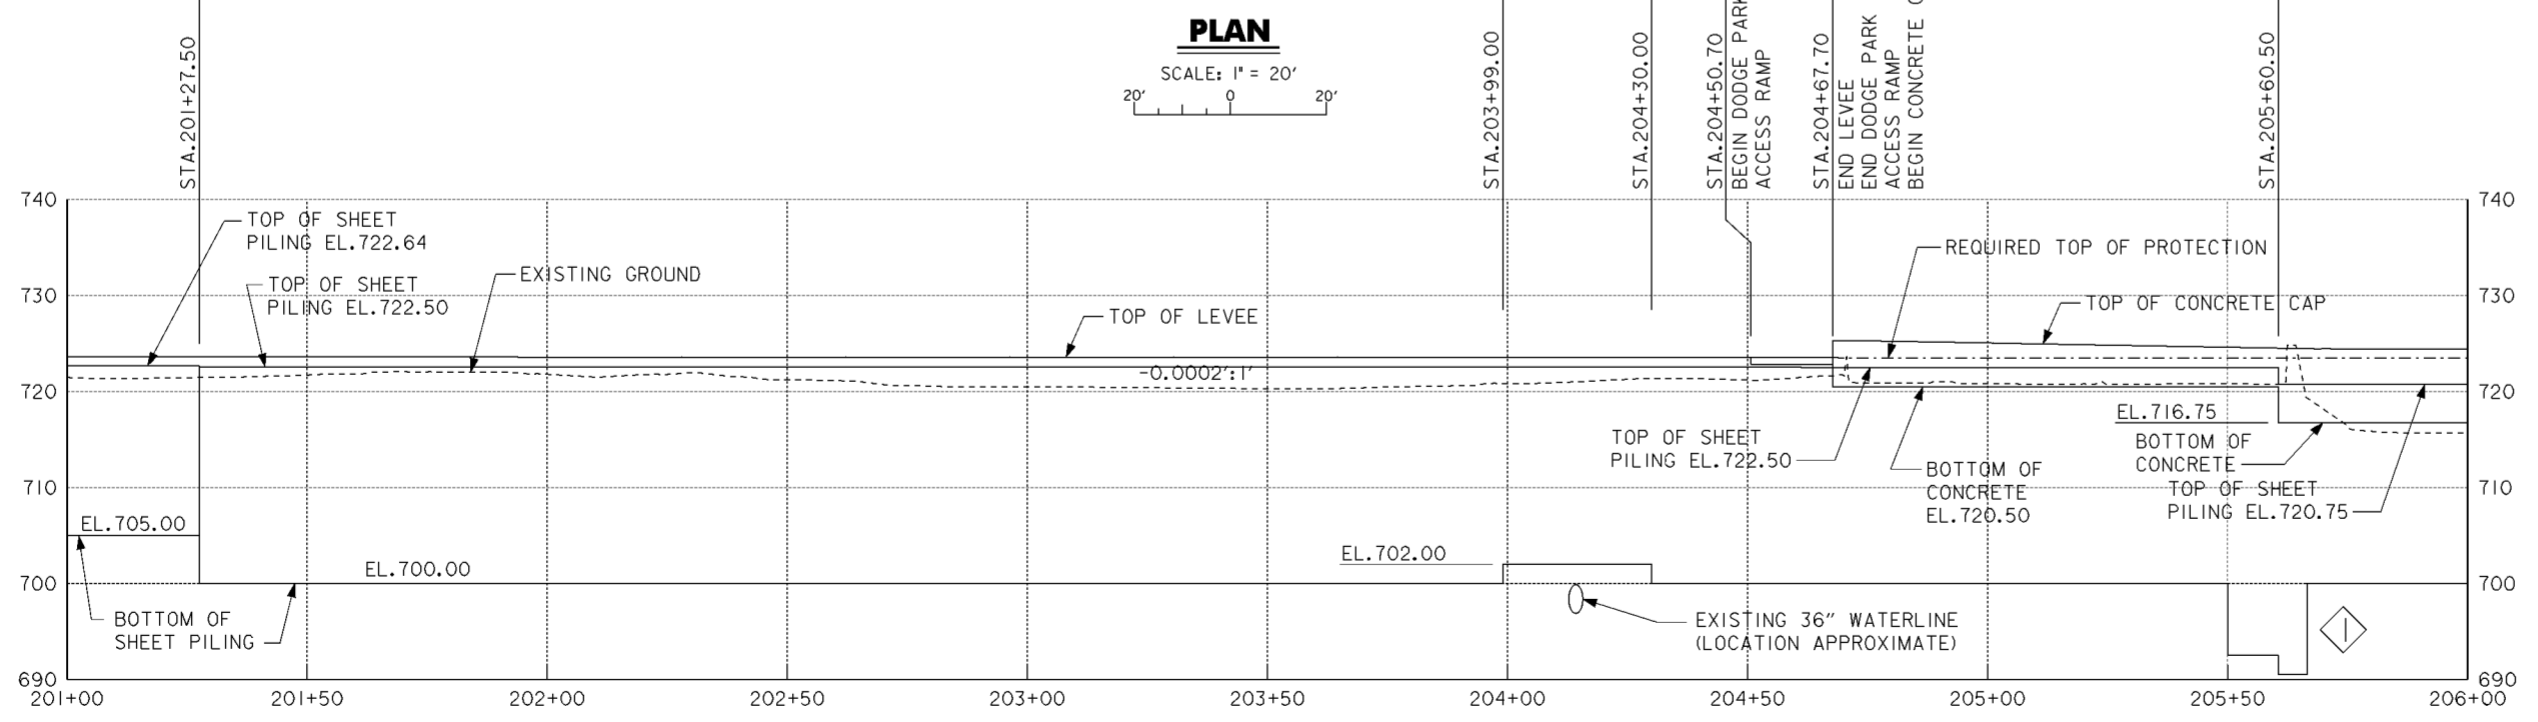



PLAN
 SCALE: 1" = 20'

PROFILE
 SCALE IN FEET

Revisions			
Symbol	Descriptions	Date	Approved
Ⓢ	REVISED AS CONSTRUCTED	7/02	P.O.C.

BURGESS & NIPL, LIMITED COLUMBUS, OHIO	U.S. ARMY ENGINEER DISTRICT CORPS OF ENGINEERS HUNTINGTON, WEST VIRGINIA		
Designed by: J. HALL	SCIO TO RIVER COLUMBUS, OHIO WEST COLUMBUS, L.P.P. PHASE IID		
Drawn by: T. MULLINS	PLAN AND PROFILE STA. 201 + 00 TO 206 + 00		
Checked by: P. CONROY			
Reviewed by:	Scale: AS SHOWN	Sheet reference number: 16/11	FILENAME: a009pp11.dgn
Approved by:	Date: MARCH 1998	Drawing Code: 16-PWC-10-	Sheet 11 of 13

WORK AS CONSTRUCTED

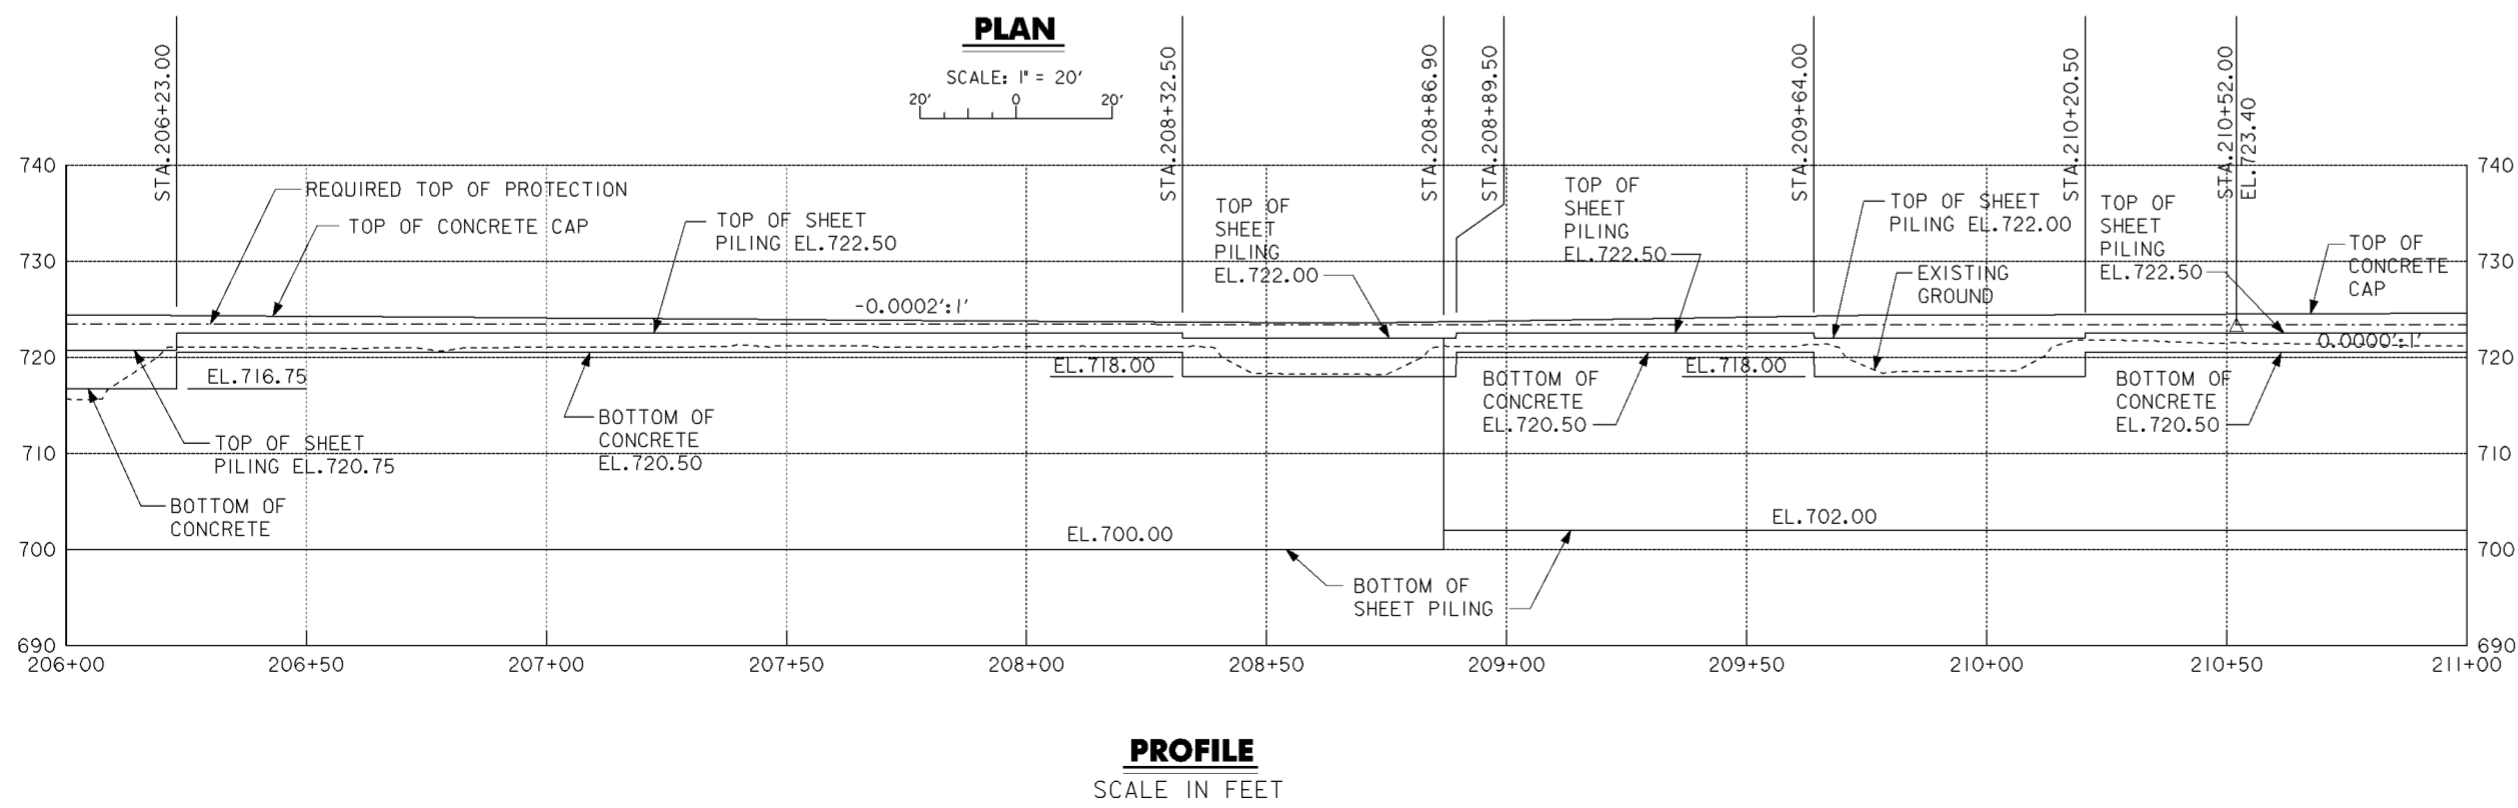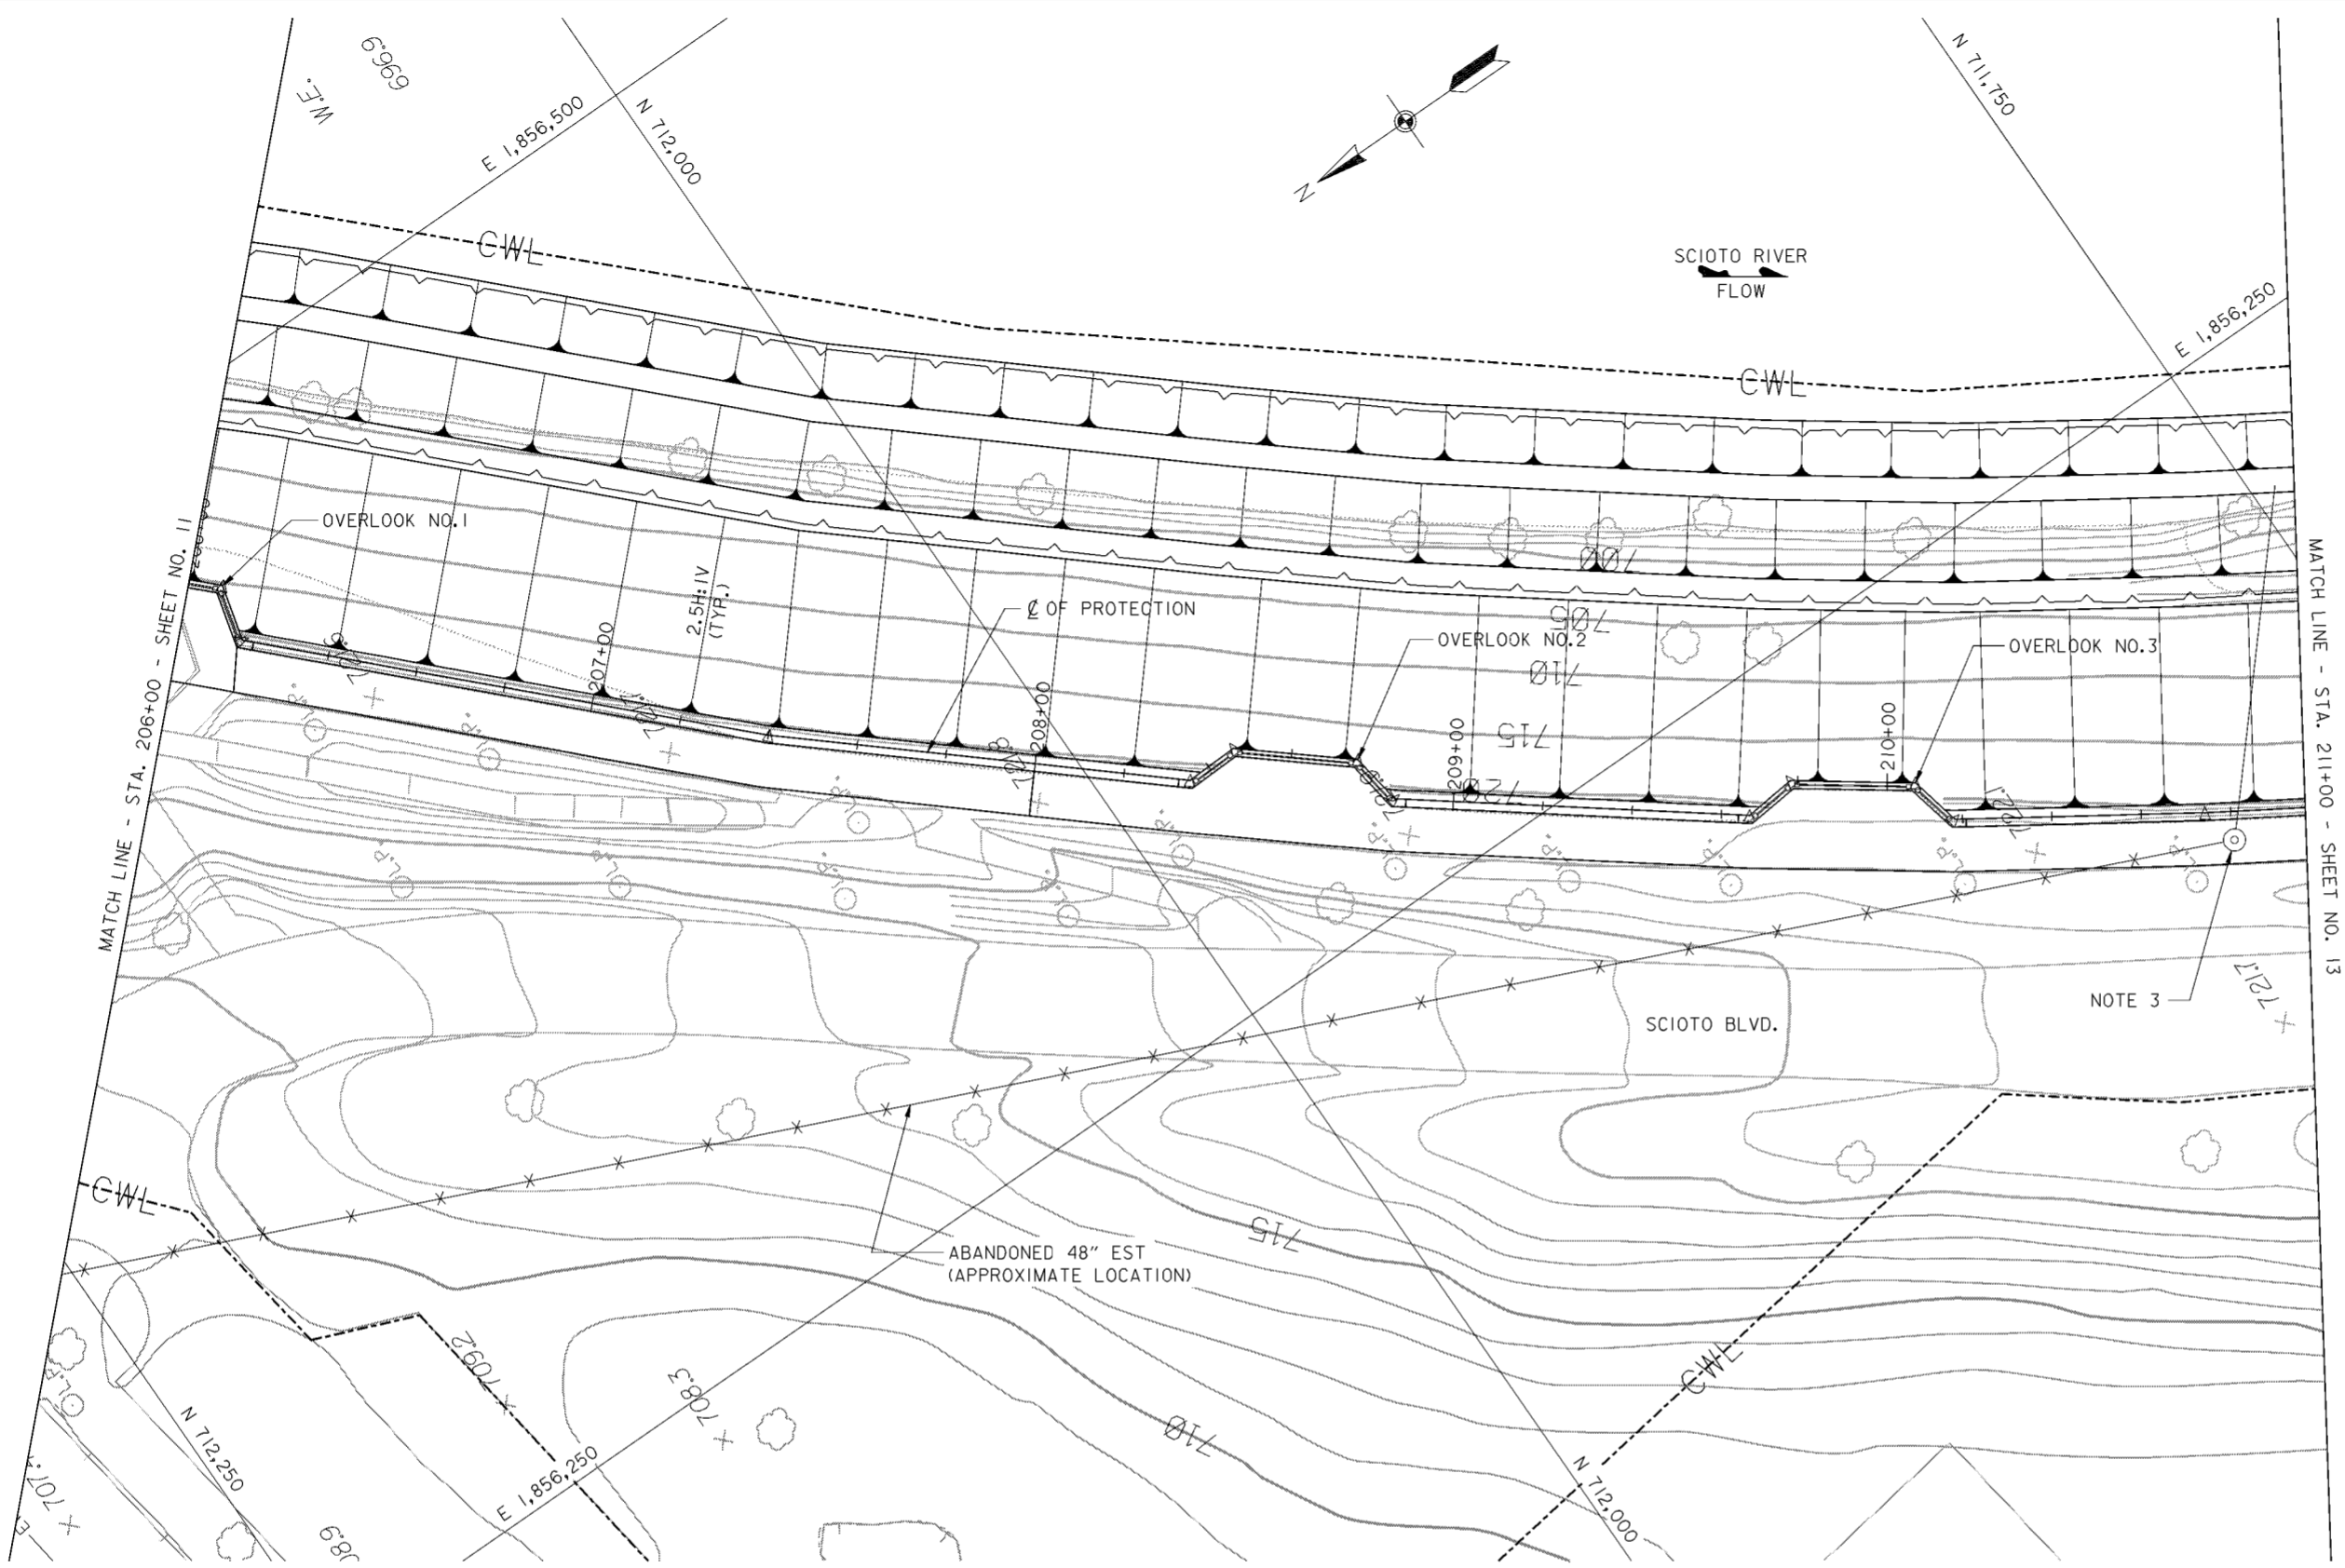

- NOTES**
1. FOR CONCRETE CAP SEE DRAWING NO. 20.3/2.
 2. FOR DODGE PARK OVERLOOKS SITE PLAN AND SECTIONS SEE DRAWING NOS. 20.2/24 AND 20.2/25.
 3. THE CONTRACTOR SHALL DRIVE SHEET PILING THROUGH THE ABANDONED 48" STORM SEWER. LOCATION OF SEWER TO BE FIELD DETERMINED BY CONTRACTOR AS NECESSARY.

Revisions			
Symbol	Descriptions	Date	Approved

BURGESS & NIPLE, LIMITED COLUMBUS, OHIO	U.S. ARMY ENGINEER DISTRICT CORPS OF ENGINEERS HUNTINGTON, WEST VIRGINIA	SCIOTO RIVER COLUMBUS, OHIO WEST COLUMBUS, L.P.P. PHASE IID	
		PLAN AND PROFILE STA. 206 + 00 TO 211 + 00	
Designed by: J. HALL	Drawn by: T. MULLINS	Checked by: P. CONROY	Reviewed by: Scale: AS SHOWN
Approved by:	Date: MARCH 1998	Drawing Code: 16-PWC-10-	Sheet reference number: 16/12
FILENAME: 00c5pp12.dgn		PEN TABLE: Sheet 12 of 13	

WORK AS CONSTRUCTED

LEGEND

- A -EXISTING UNDERGROUND FIBER OPTIC
- B -EXISTING 30" RCP STORM SEWER
- C -EXISTING 8" WATERLINE
- D -NEW 30" RCP STORM SEWER
- E -NEW 24" RCP STORM SEWER
- F -EXISTING 18" RCP STORM SEWER
- G -EXISTING 10" RCP STORM SEWER
- H -EXISTING 8" RCP STORM SEWER
- I -EXISTING 15" RCP STORM SEWER
- J -EXISTING 12" RCP STORM SEWER
- K -NEW 12" RCP STORM SEWER
- L -EXISTING 12" WATERLINE
- M -EXISTING 24" RCP STORM SEWER
- N -ABANDONED SANITARY SEWER
- O -EXISTING 15" BRICK STORM SEWER
- P -EXISTING 4" RCP STORM SEWER
- Q -EXISTING 8" SANITARY SEWER
- R -EXISTING 36" WATERLINE
- S -EXISTING 72" RCP STORM SEWER
- T -EXISTING 6" WATERLINE
- U -EXISTING TELEPHONE LINE
- V -NEW 36" RCP STORM SEWER
- W -NEW 8" WATERLINE
- X -EXISTING 12" GAS LINE
- Y -EXISTING 6" GAS LINE
- Z -NEW 10" AND 36" SANITARY FORCE MAIN


NOTES

1. FOR RECREATIONAL TRAIL SEE DRAWING NOS. 16/50, 16/51 AND 20.2/35 THRU 20.2/37.
2. FOR TYPICAL LEVEE SECTIONS SEE DRAWING NOS. 20.3/1 AND 20.3/2.
3. FOR CWL AND LWL SEE DRAWING NOS. 6/1 THRU 6/4.
4. RECREATIONAL TRAIL SHOWN AT STA.151+25.72, STA.151+50, AND STA.152+00 NOT INCLUDED IN THIS CONTRACT. CONSTRUCTION COMPLETED UNDER PHASE IIC CONTRACT.

Revisions			
Symbol	Descriptions	Date	Approved

BURGESS & NIPLE, LIMITED COLUMBUS, OHIO	U.S. ARMY ENGINEER DISTRICT CORPS OF ENGINEERS HUNTINGTON, WEST VIRGINIA
Designed by: J.HALL	SCIO TO RIVER COLUMBUS, OHIO WEST COLUMBUS, L.P.P. PHASE IID
Drawn by: T.MULLINS	CROSS SECTIONS 151 + 26.73 TO 153 + 00
Checked by: P.CONROY	Scale: AS SHOWN
Reviewed by:	Date: MARCH 1998
Approved by:	Drawing Code: 16-PWC-10-
FILENAME: 00c3a01.dgn PEN TABLE: b.tbl L.tbl Sheet 1 of 22	

WORK AS CONSTRUCTED

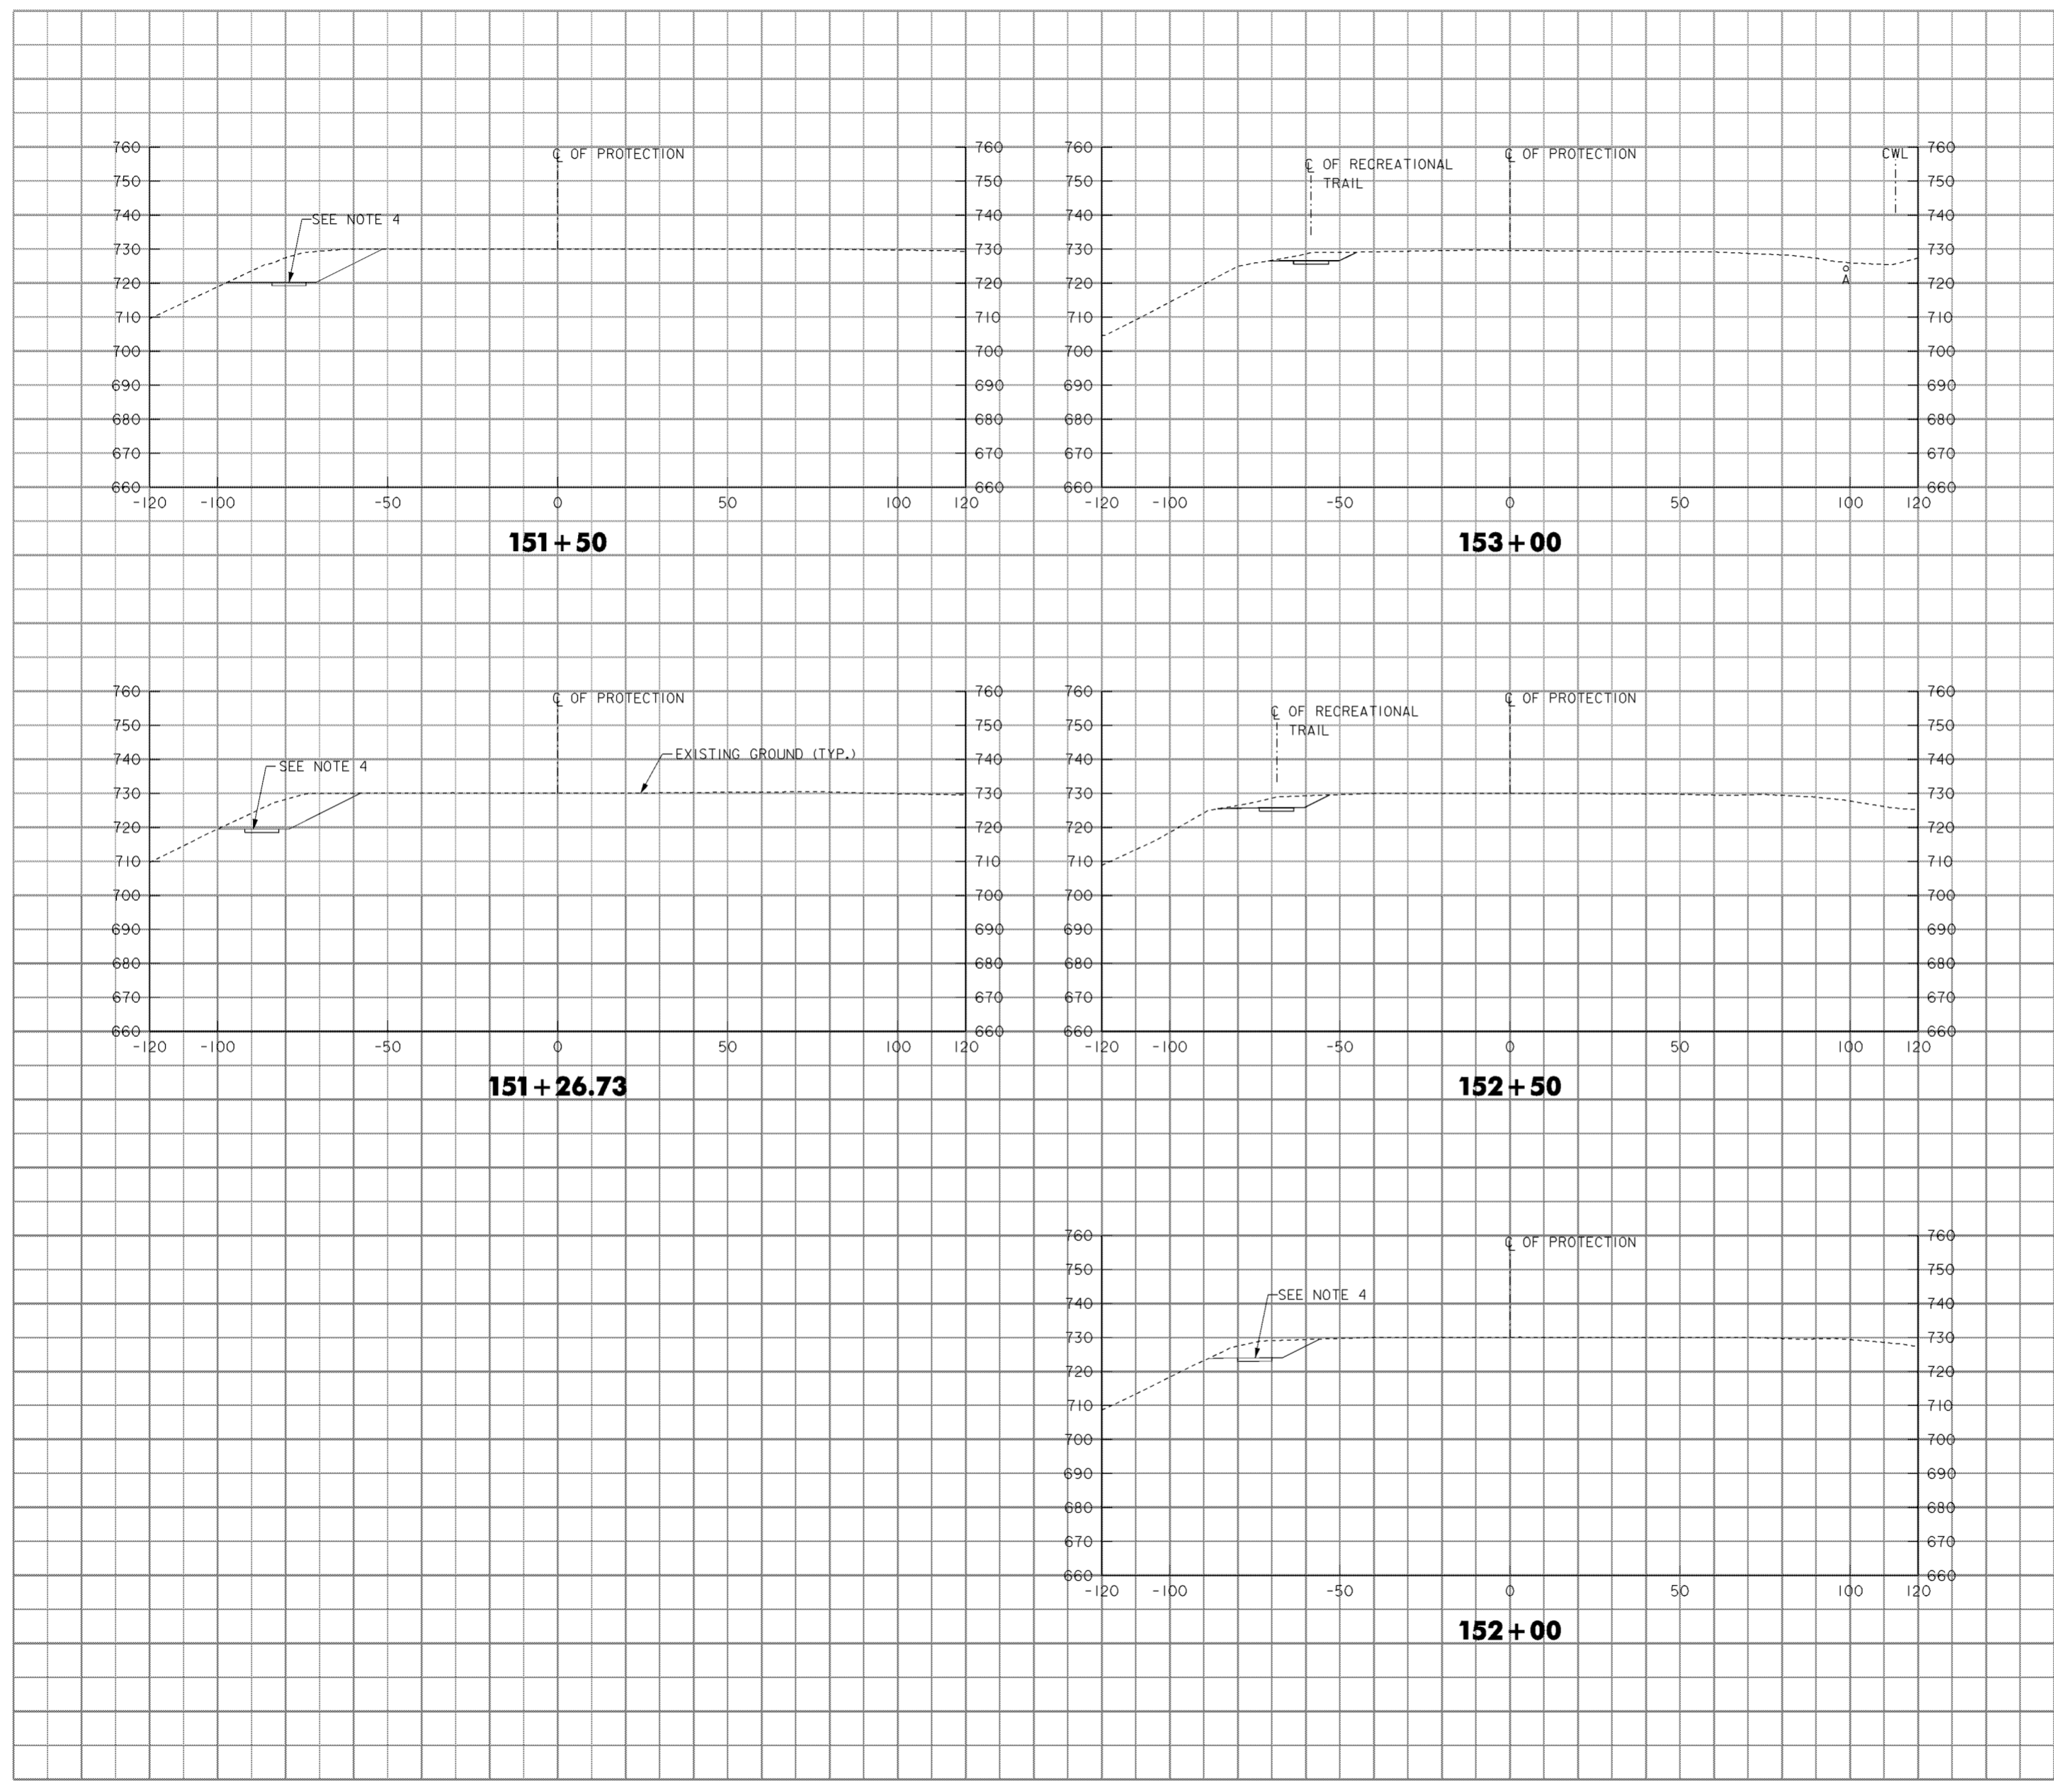

LEGEND


- A - EXISTING UNDERGROUND FIBER OPTIC
- B - EXISTING 30" RCP STORM SEWER
- C - EXISTING 8" WATERLINE
- D - NEW 30" RCP STORM SEWER
- E - NEW 24" RCP STORM SEWER
- F - EXISTING 18" RCP STORM SEWER
- G - EXISTING 10" RCP STORM SEWER
- H - EXISTING 8" RCP STORM SEWER
- I - EXISTING 15" RCP STORM SEWER
- J - EXISTING 12" RCP STORM SEWER
- K - NEW 12" RCP STORM SEWER
- L - EXISTING 12" WATERLINE
- M - EXISTING 24" RCP STORM SEWER
- N - ABANDONED SANITARY SEWER
- O - EXISTING 15" BRICK STORM SEWER
- P - EXISTING 4" RCP STORM SEWER
- Q - EXISTING 8" SANITARY SEWER
- R - EXISTING 36" WATERLINE
- S - EXISTING 72" RCP STORM SEWER
- T - EXISTING 6" WATERLINE
- U - EXISTING TELEPHONE LINE
- V - NEW 36" RCP STORM SEWER
- W - NEW 8" WATERLINE
- X - EXISTING 12" GAS LINE
- Y - EXISTING 6" GAS LINE
- Z - NEW 10" AND 36" SANITARY FORCE MAIN

NOTES

1. FOR RECREATIONAL TRAIL SEE DRAWING NOS. 16/50, 18/51 AND 20.2/35 THRU 20.2/37.
2. FOR TYPICAL LEVEE AND T-WALL SECTIONS SEE DRAWING NOS. 20.3/1 AND 20.3/2.
3. FOR CONRAIL EAST RAILROAD CLOSURE SEE DRAWING NO. 20.2/1.
4. FOR CONCRETE T-WALL DETAILS SEE DRAWING NOS. 20.1/3 AND 20.1/4.
5. FOR CONRAIL EAST SHEETPILE CUTOFF WALL SEE DRAWING NO. 20.2/3.
6. FOR CWL AND LWL SEE DRAWING NOS. 6/1 THRU 6/4.
7. FOR LIMITS OF SAFETY RAIL SEE DRAWING NOS. 20.2/38 AND 20.2/39.

Revisions			
Symbol	Descriptions	Date	Approved

BURGESS & NIPLE, LIMITED COLUMBUS, OHIO	U.S. ARMY ENGINEER DISTRICT CORPS OF ENGINEERS HUNTINGTON, WEST VIRGINIA
Designed by: J. HALL Drawn by: T. MULLINS Checked by: P. CONROY Reviewed by: Approved by: Scale: AS SHOWN Date: MARCH 1998 Drawing Code: 16-PWC-10-	SCIOTO RIVER COLUMBUS, OHIO WEST COLUMBUS, L.P.P. PHASE IID CROSS SECTIONS 153+50 TO 156+00 FILENAME: 00c3x02.dgn PEN TABLE: s.pfb l.pfb Sheet 2 of 22

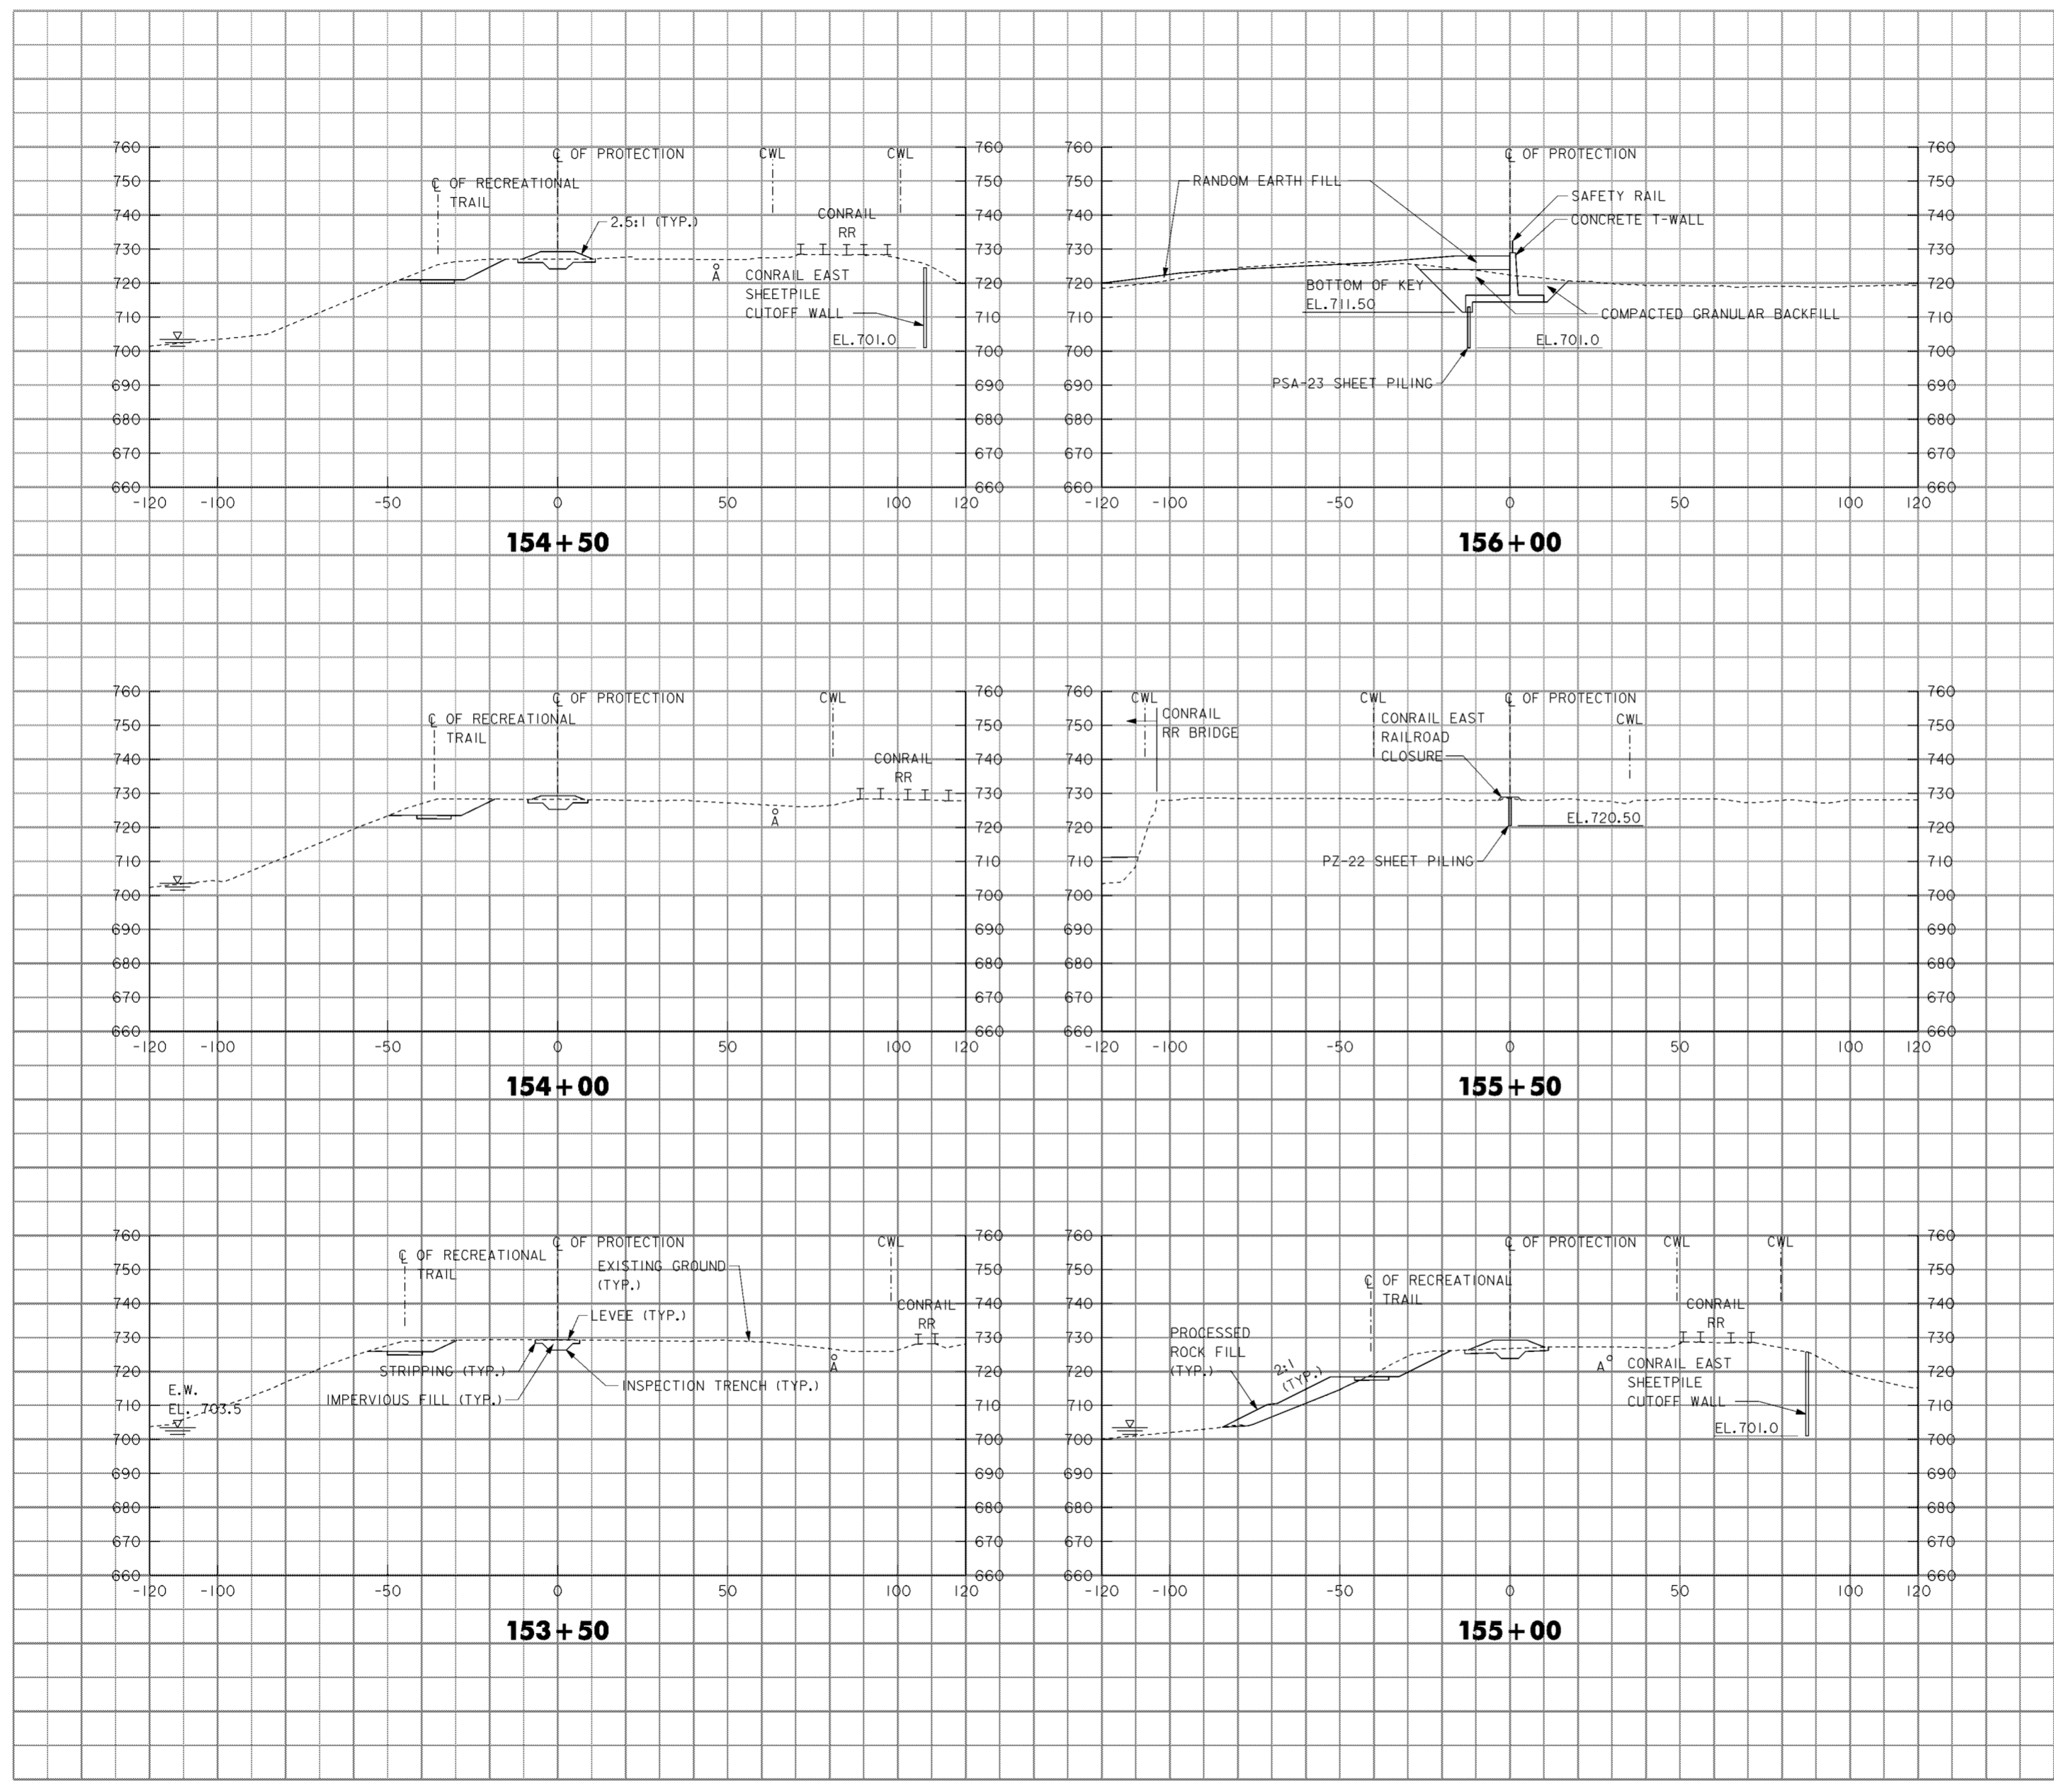

LEGEND







- A -EXISTING UNDERGROUND FIBER OPTIC
- B -EXISTING 30" RCP STORM SEWER
- C -EXISTING 8" WATERLINE
- D -NEW 30" RCP STORM SEWER
- E -NEW 24" RCP STORM SEWER
- F -EXISTING 18" RCP STORM SEWER
- G -EXISTING 10" RCP STORM SEWER
- H -EXISTING 8" RCP STORM SEWER
- I -EXISTING 15" RCP STORM SEWER
- J -EXISTING 12" RCP STORM SEWER
- K -NEW 12" RCP STORM SEWER
- L -EXISTING 12" WATERLINE
- M -EXISTING 24" RCP STORM SEWER
- N -ABANDONED SANITARY SEWER
- O -EXISTING 15" BRICK STORM SEWER
- P -EXISTING 4" RCP STORM SEWER
- Q -EXISTING 8" SANITARY SEWER
- R -EXISTING 36" WATERLINE
- S -EXISTING 72" RCP STORM SEWER
- T -EXISTING 6" WATERLINE
- U -EXISTING TELEPHONE LINE
- V -NEW 36" RCP STORM SEWER
- W -NEW 8" WATERLINE
- X -EXISTING 12" GAS LINE
- Y -EXISTING 6" GAS LINE
- Z -NEW 10" AND 36" SANITARY FORCE MAIN

NOTES

1. FOR RECREATIONAL TRAIL SEE DRAWING NOS. 16/50, 16/51 AND 20.2/35 THRU 20.2/37.
2. FOR CONCRETE T-WALL DETAILS SEE DRAWING NOS. 20.1/3 AND 20.1/4.
3. FOR TYPICAL CONCRETE T-WALL SECTIONS SEE DRAWING NOS. 20.3/1 AND 20.3/2.
4. FOR CWL AND LWL SEE DRAWING NOS. 6/1 THRU 6/4.
5. FOR LIMITS OF SAFETY RAIL SEE DRAWING NOS. 20.2/38 AND 20.2/39.
6. FOR LIMITS OF DEMOLITION OF EXISTING RETAINING WALL SEE DRAWING NOS. 20.2/29 THRU 20.2/31.

Revisions			
Symbol	Descriptions	Date	Approved

BURGESS & NIPLE, LIMITED COLUMBUS, OHIO	U.S. ARMY ENGINEER DISTRICT CORPS OF ENGINEERS HUNTINGTON, WEST VIRGINIA
Designed by: J. HALL	SCOTO RIVER COLUMBUS, OHIO WEST COLUMBUS, L.P.P. PHASE IID
Drawn by: T. MULLINS	CROSS SECTIONS 156+50 TO 159+00
Checked by: P. CONROY	Scale: AS SHOWN
Reviewed by:	Sheet reference number: 16/17
Approved by:	Date: MARCH 1998
Drawing Code: 16-PWC-10-	FILENAME: 00a3a03.dgn PEN TABLE: s.pfb t.pfb Sheet 3 of 22

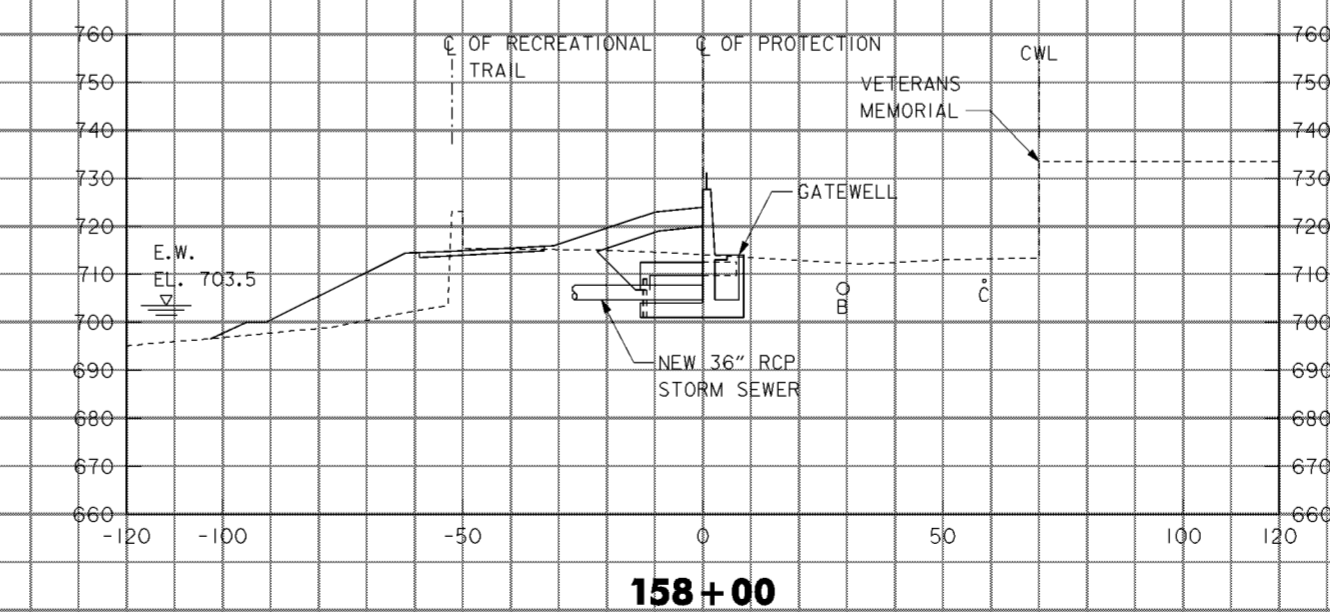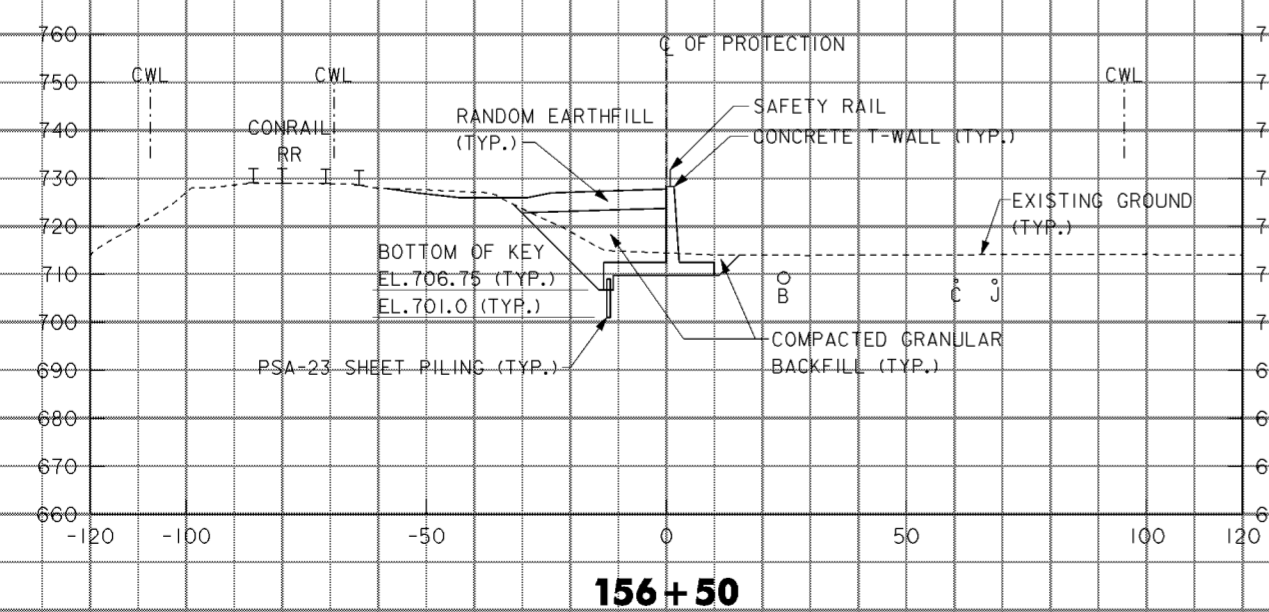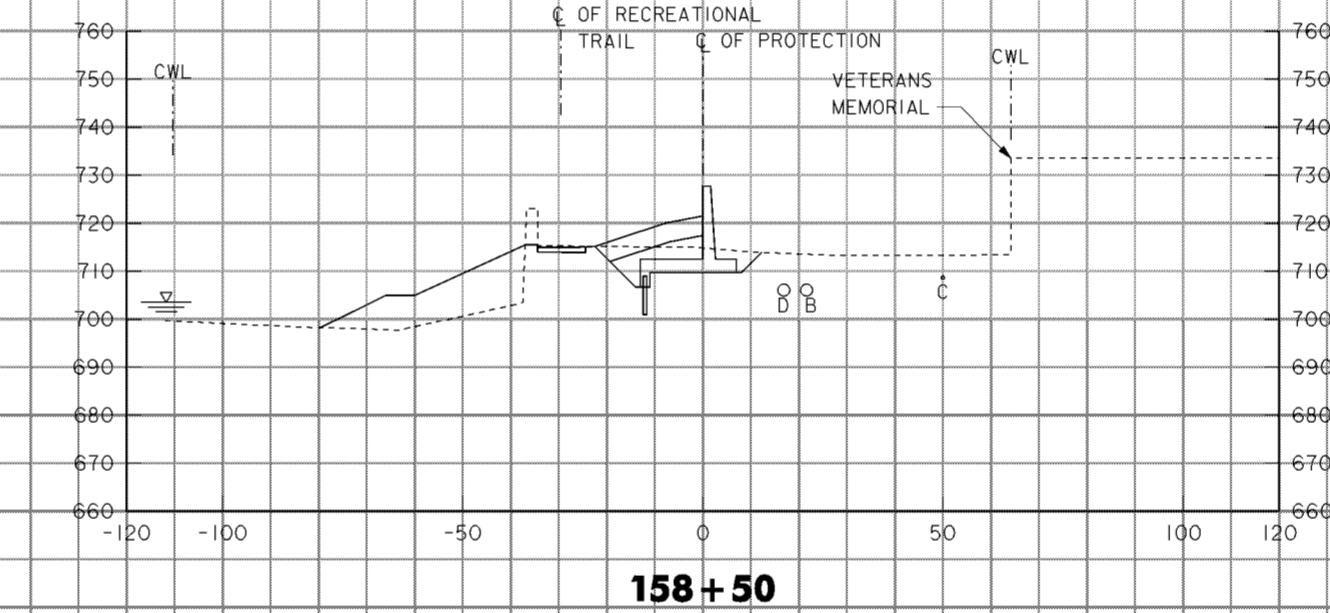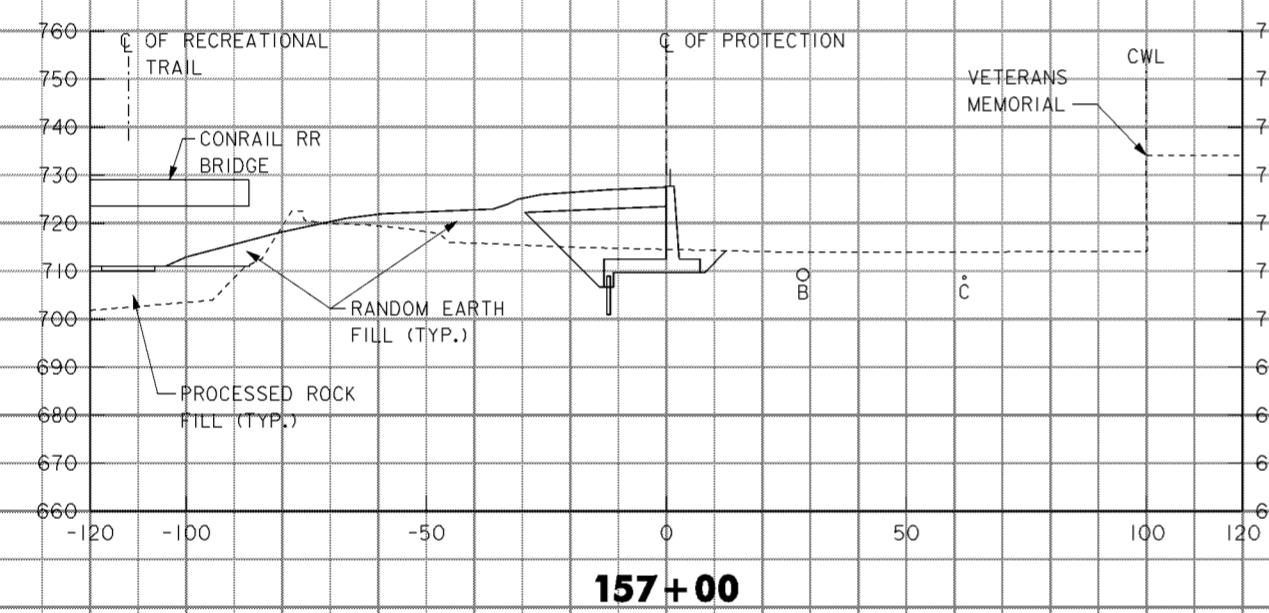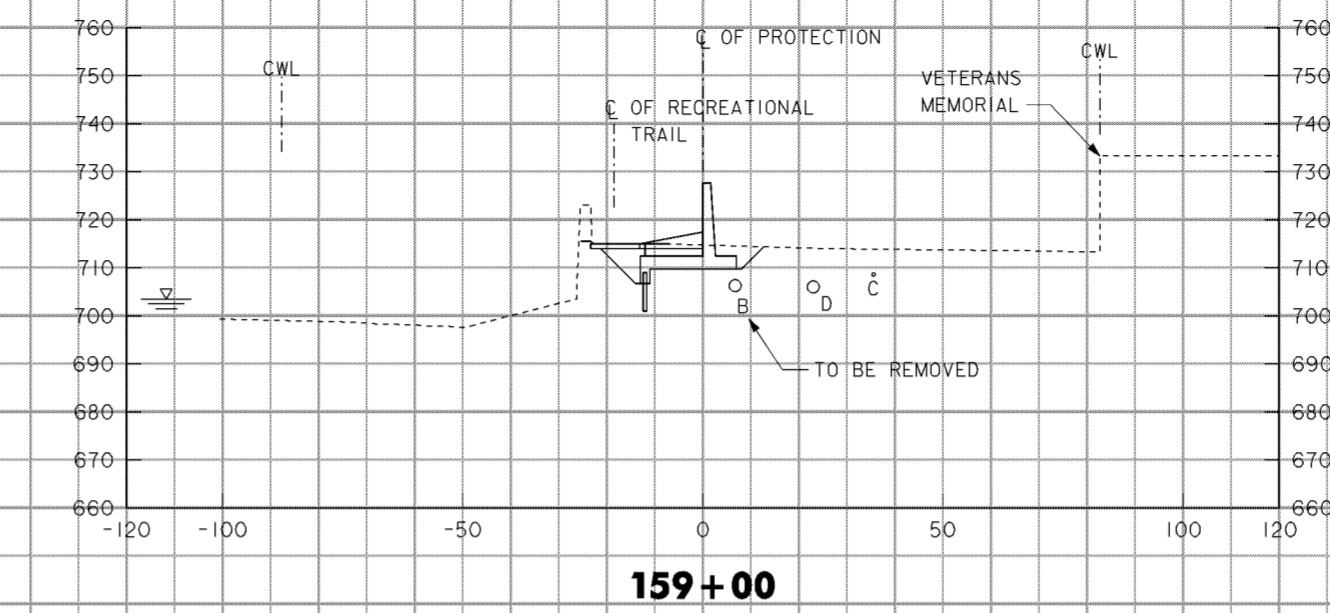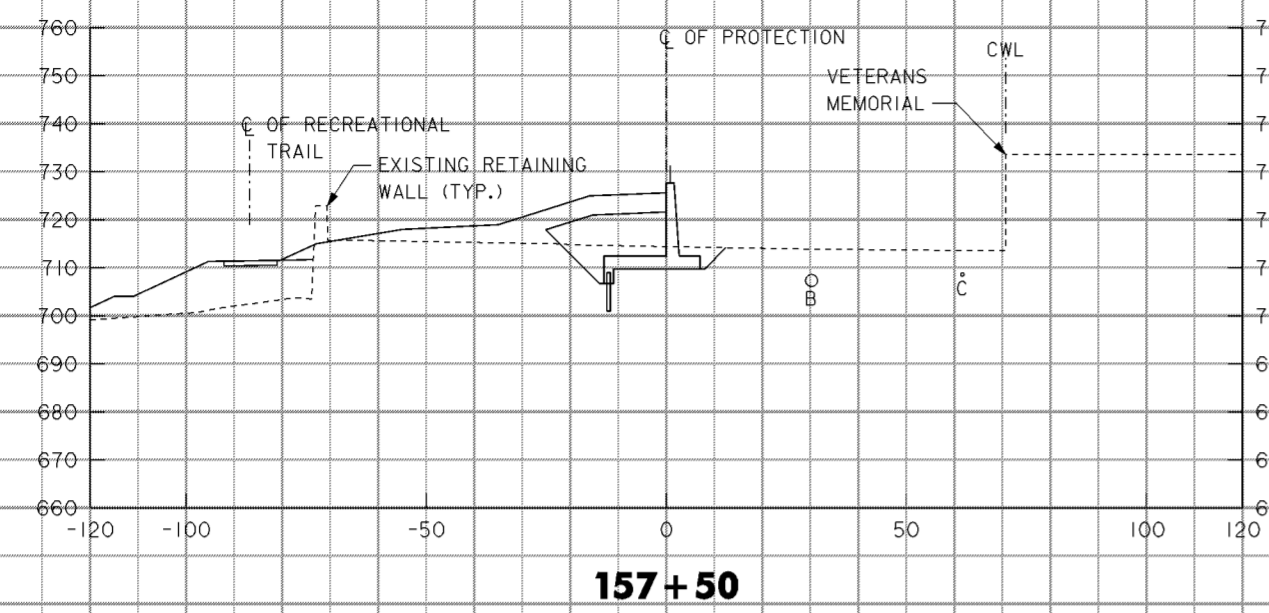

LEGEND

- A -EXISTING UNDERGROUND FIBER OPTIC
- B -EXISTING 30" RCP STORM SEWER
- C -EXISTING 8" WATERLINE
- D -NEW 30" RCP STORM SEWER
- E -NEW 24" RCP STORM SEWER
- F -EXISTING 18" RCP STORM SEWER
- G -EXISTING 10" RCP STORM SEWER
- H -EXISTING 8" RCP STORM SEWER
- I -EXISTING 15" RCP STORM SEWER
- J -EXISTING 12" RCP STORM SEWER
- K -NEW 12" RCP STORM SEWER
- L -EXISTING 12" WATERLINE
- M -EXISTING 24" RCP STORM SEWER
- N -ABANDONED SANITARY SEWER
- O -EXISTING 15" BRICK STORM SEWER
- P -EXISTING 4" RCP STORM SEWER
- Q -EXISTING 8" SANITARY SEWER
- R -EXISTING 36" WATERLINE
- S -EXISTING 72" RCP STORM SEWER
- T -EXISTING 6" WATERLINE
- U -EXISTING TELEPHONE LINE
- V -NEW 36" RCP STORM SEWER
- W -NEW 8" WATERLINE
- X -EXISTING 12" GAS LINE
- Y -EXISTING 6" GAS LINE
- Z -NEW 10" AND 36" SANITARY FORCE MAIN


NOTES

1. FOR RECREATIONAL TRAIL SEE DRAWING NOS. 16/50, 16/51 AND 20.2/35 THRU 20.2/37.
2. FOR CONCRETE I-WALL DETAILS SEE DRAWING NO. 20.1/1.
3. FOR TYPICAL CONCRETE I-WALL SECTIONS SEE DRAWING NOS. 20.3/1 AND 20.3/2.
4. FOR CWL AND LWL SEE DRAWING NOS. 6/1 THRU 6/4.
5. FOR LIMITS OF DEMOLITION OF EXISTING RETAINING WALL SEE DRAWING NOS. 20.2/29 THRU 20.2/31.

Revisions			
Symbol	Descriptions	Date	Approved

BURGESS & NIPLE, LIMITED COLUMBUS, OHIO	U.S. ARMY ENGINEER DISTRICT CORPS OF ENGINEERS HUNTINGTON, WEST VIRGINIA
Designed by: J. HALL	SCOTO RIVER COLUMBUS, OHIO WEST COLUMBUS, L.P.P. PHASE IID
Drawn by: T. MULLINS	CROSS SECTIONS 159+50 TO 162+00
Checked by: P. CONROY	Scale: AS SHOWN
Reviewed by:	Date: MARCH 1998
Approved by:	Drawing Code: 16-PWC-10-
	Sheet reference number: 16/18
	FILENAME: 00a5a04.dgn
	Sheet 4 of 22

WORK AS CONSTRUCTED

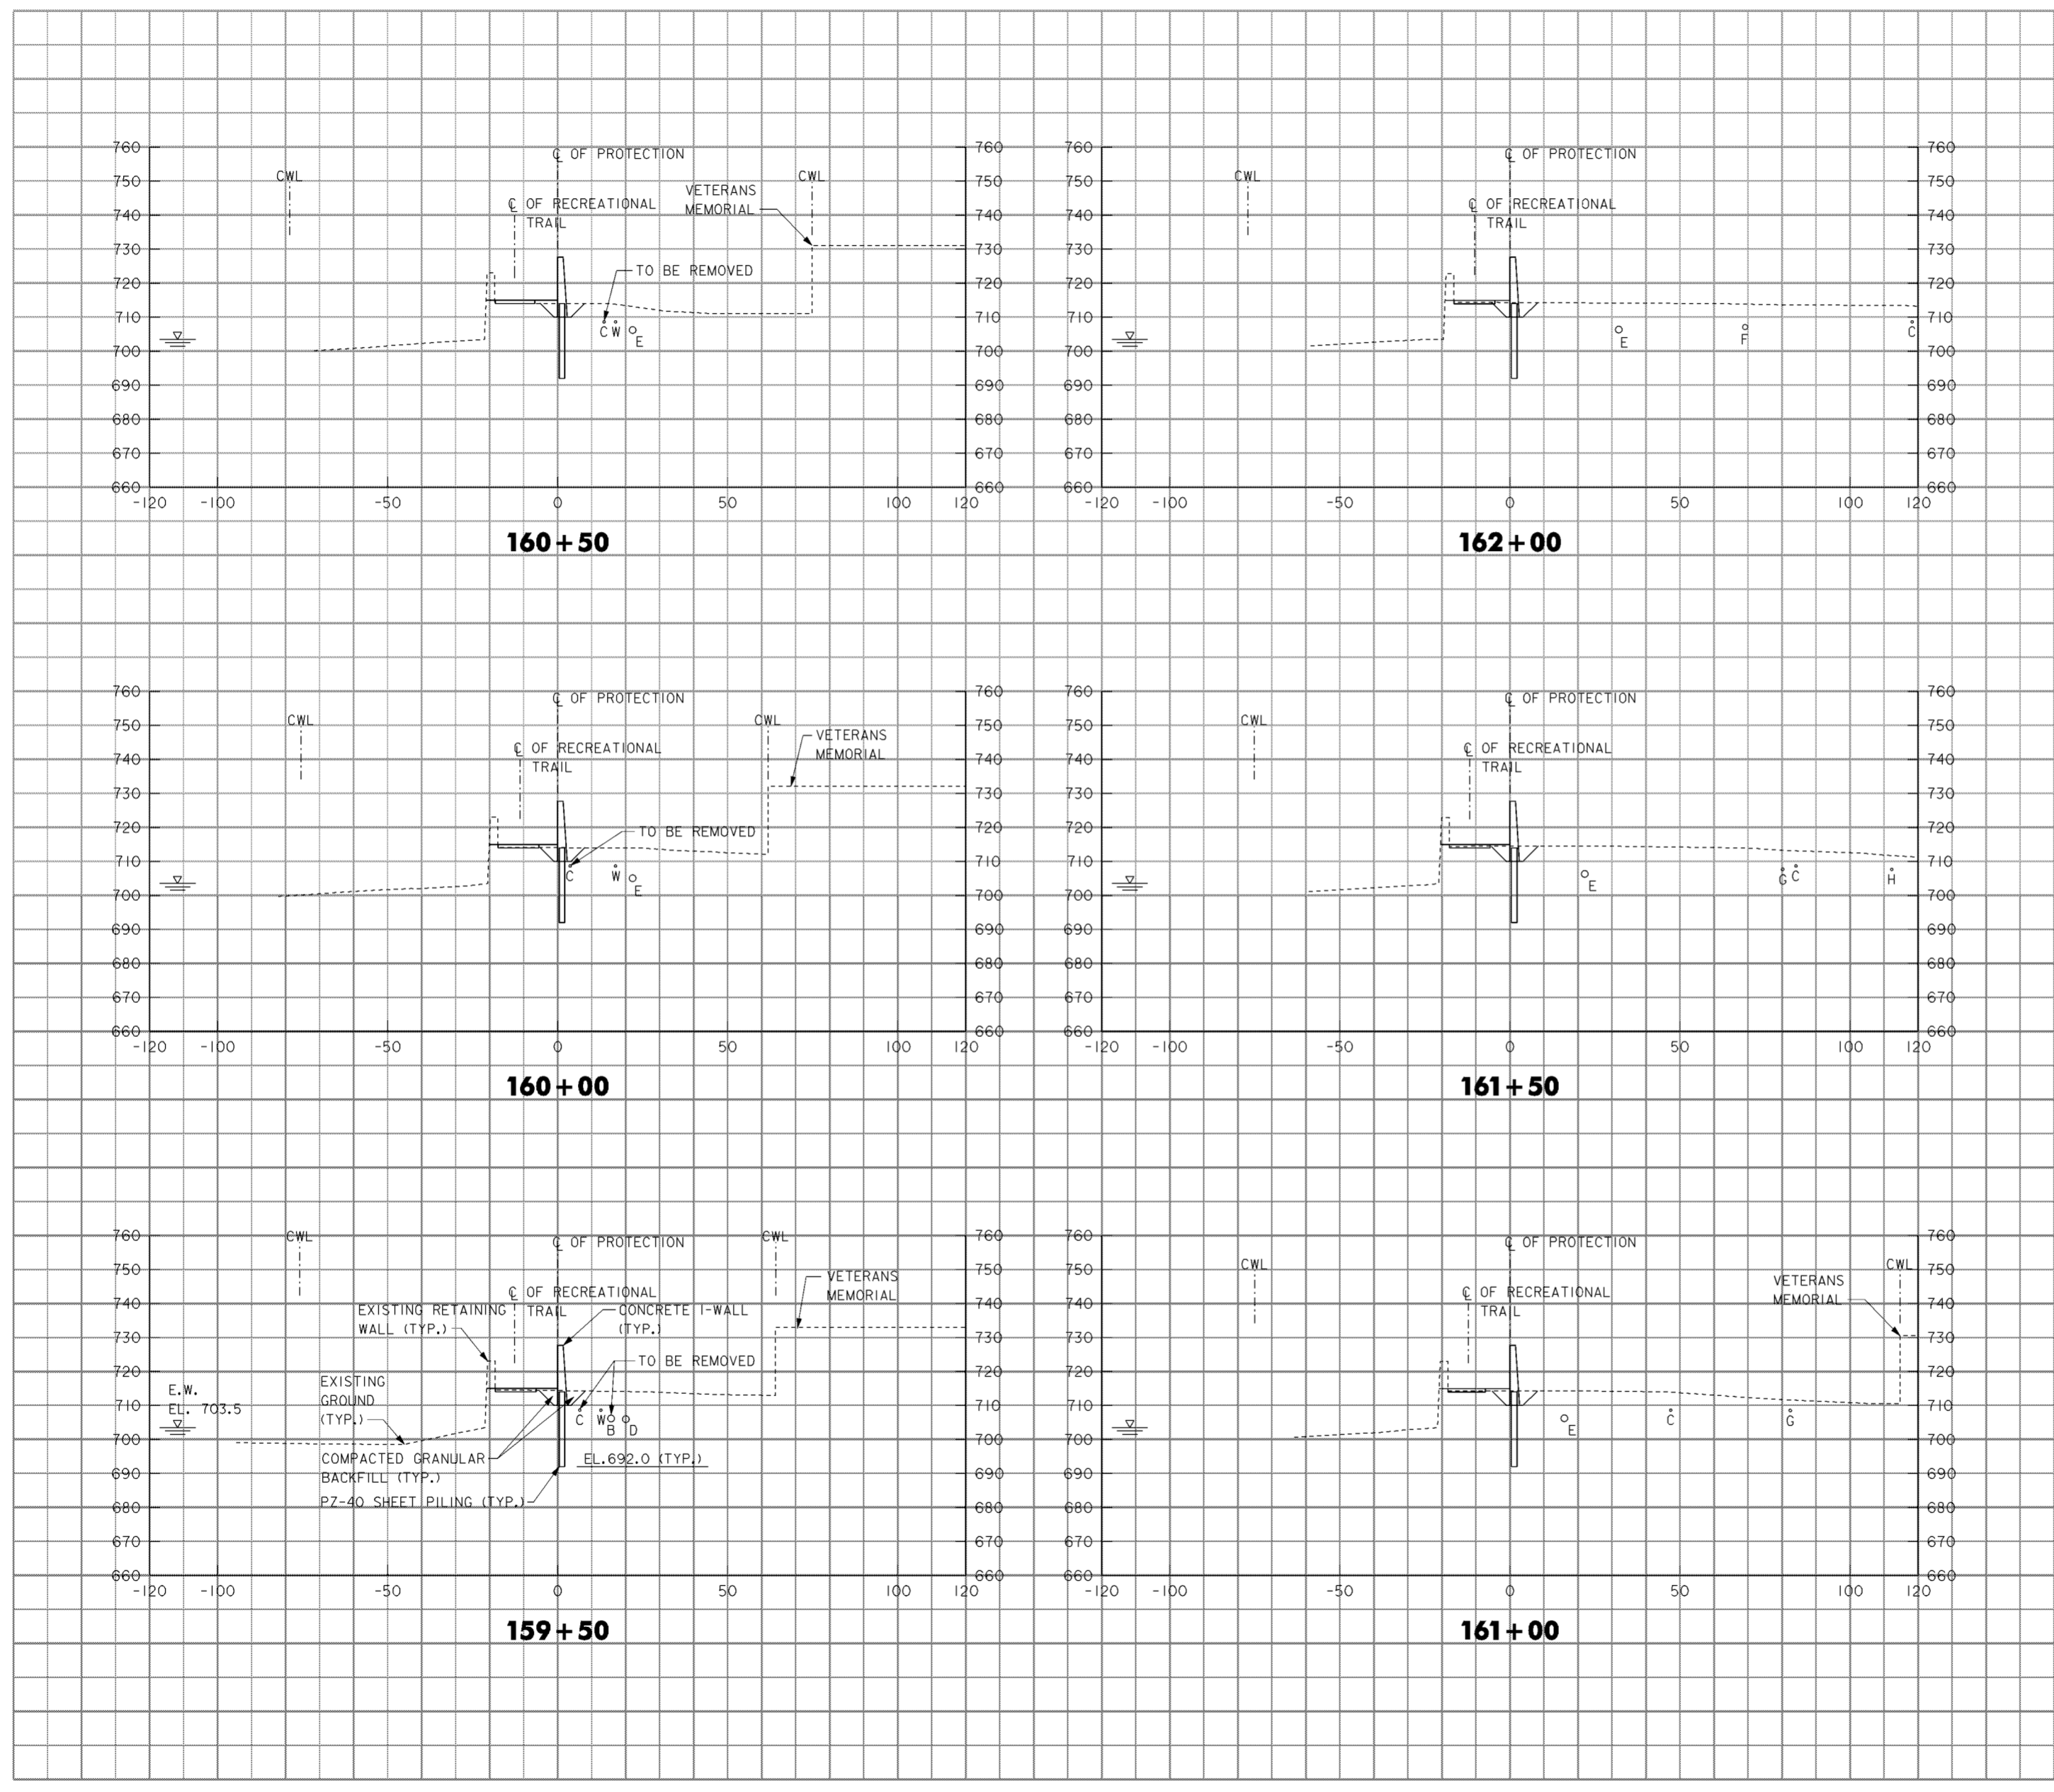

LEGEND

- A - EXISTING UNDERGROUND FIBER OPTIC
- B - EXISTING 30" RCP STORM SEWER
- C - EXISTING 8" WATERLINE
- D - NEW 30" RCP STORM SEWER
- E - NEW 24" RCP STORM SEWER
- F - EXISTING 18" RCP STORM SEWER
- G - EXISTING 10" RCP STORM SEWER
- H - EXISTING 8" RCP STORM SEWER
- I - EXISTING 15" RCP STORM SEWER
- J - EXISTING 12" RCP STORM SEWER
- K - NEW 12" RCP STORM SEWER
- L - EXISTING 12" WATERLINE
- M - EXISTING 24" RCP STORM SEWER
- N - ABANDONED SANITARY SEWER
- O - EXISTING 15" BRICK STORM SEWER
- P - EXISTING 4" RCP STORM SEWER
- Q - EXISTING 8" SANITARY SEWER
- R - EXISTING 36" WATERLINE
- S - EXISTING 72" RCP STORM SEWER
- T - EXISTING 6" WATERLINE
- U - EXISTING TELEPHONE LINE
- V - NEW 36" RCP STORM SEWER
- W - NEW 8" WATERLINE
- X - EXISTING 12" GAS LINE
- Y - EXISTING 6" GAS LINE
- Z - NEW 10" AND 36" SANITARY FORCE MAIN

NOTES

1. FOR RECREATIONAL TRAIL SEE DRAWING NOS. 16/50, 16/51 AND 20.2/35 THRU 20.2/37.
2. FOR CONCRETE T-WALL DETAILS SEE DRAWING NOS. 20.1/3 AND 20.1/4.
3. FOR TYPICAL CONCRETE T-WALL SECTIONS SEE DRAWING NO. 20.3/1 AND 20.3/2.
4. FOR CWL AND LWL SEE DRAWING NOS. 6/1 THRU 6/4.
5. FOR DETAILS OF VETERANS MEMORIAL LAWN AND RETAINING WALLS SEE DRAWING NOS. 20.2/56 THRU 20.2/68.
6. FOR LIMITS OF SAFETY RAIL SEE DRAWING NOS. 20.2/39 AND 20.2/40.
7. FOR LIMITS OF DEMOLITION OF EXISTING RETAINING WALL SEE DRAWING NOS. 20.2/29 THRU 20.2/31.
8. FOR VETERANS MEMORIAL SHEETPILE CUTOFF WALL SEE DRAWING NO. 20.1/10.

Revisions			
Symbol	Descriptions	Date	Approved

BURGESS & NIPLE, LIMITED
COLUMBUS, OHIO

Designed by: **J.HALL**

Drawn by: **T.MULLINS**

Checked by: **P.CONROY**

Reviewed by: **AS SHOWN**

Approved by: **MARCH 1998**

Drawing Code: **16-PWC-10-**

U.S. ARMY ENGINEER DISTRICT
CORPS OF ENGINEERS
HUNTINGTON, WEST VIRGINIA

SCOTO RIVER
COLUMBUS, OHIO
WEST COLUMBUS, L.P.P.
PHASE IID

CROSS SECTIONS
162+50 TO 165+00

Scale: **AS SHOWN**

Date: **MARCH 1998**

Drawing Code: **16-PWC-10-**


Sheet reference number: **1619**

FILENAME: **00a3a05.dgn**

PEN TABLE: **5.pfb**

Sheet **5** of **22**

WORK AS CONSTRUCTED

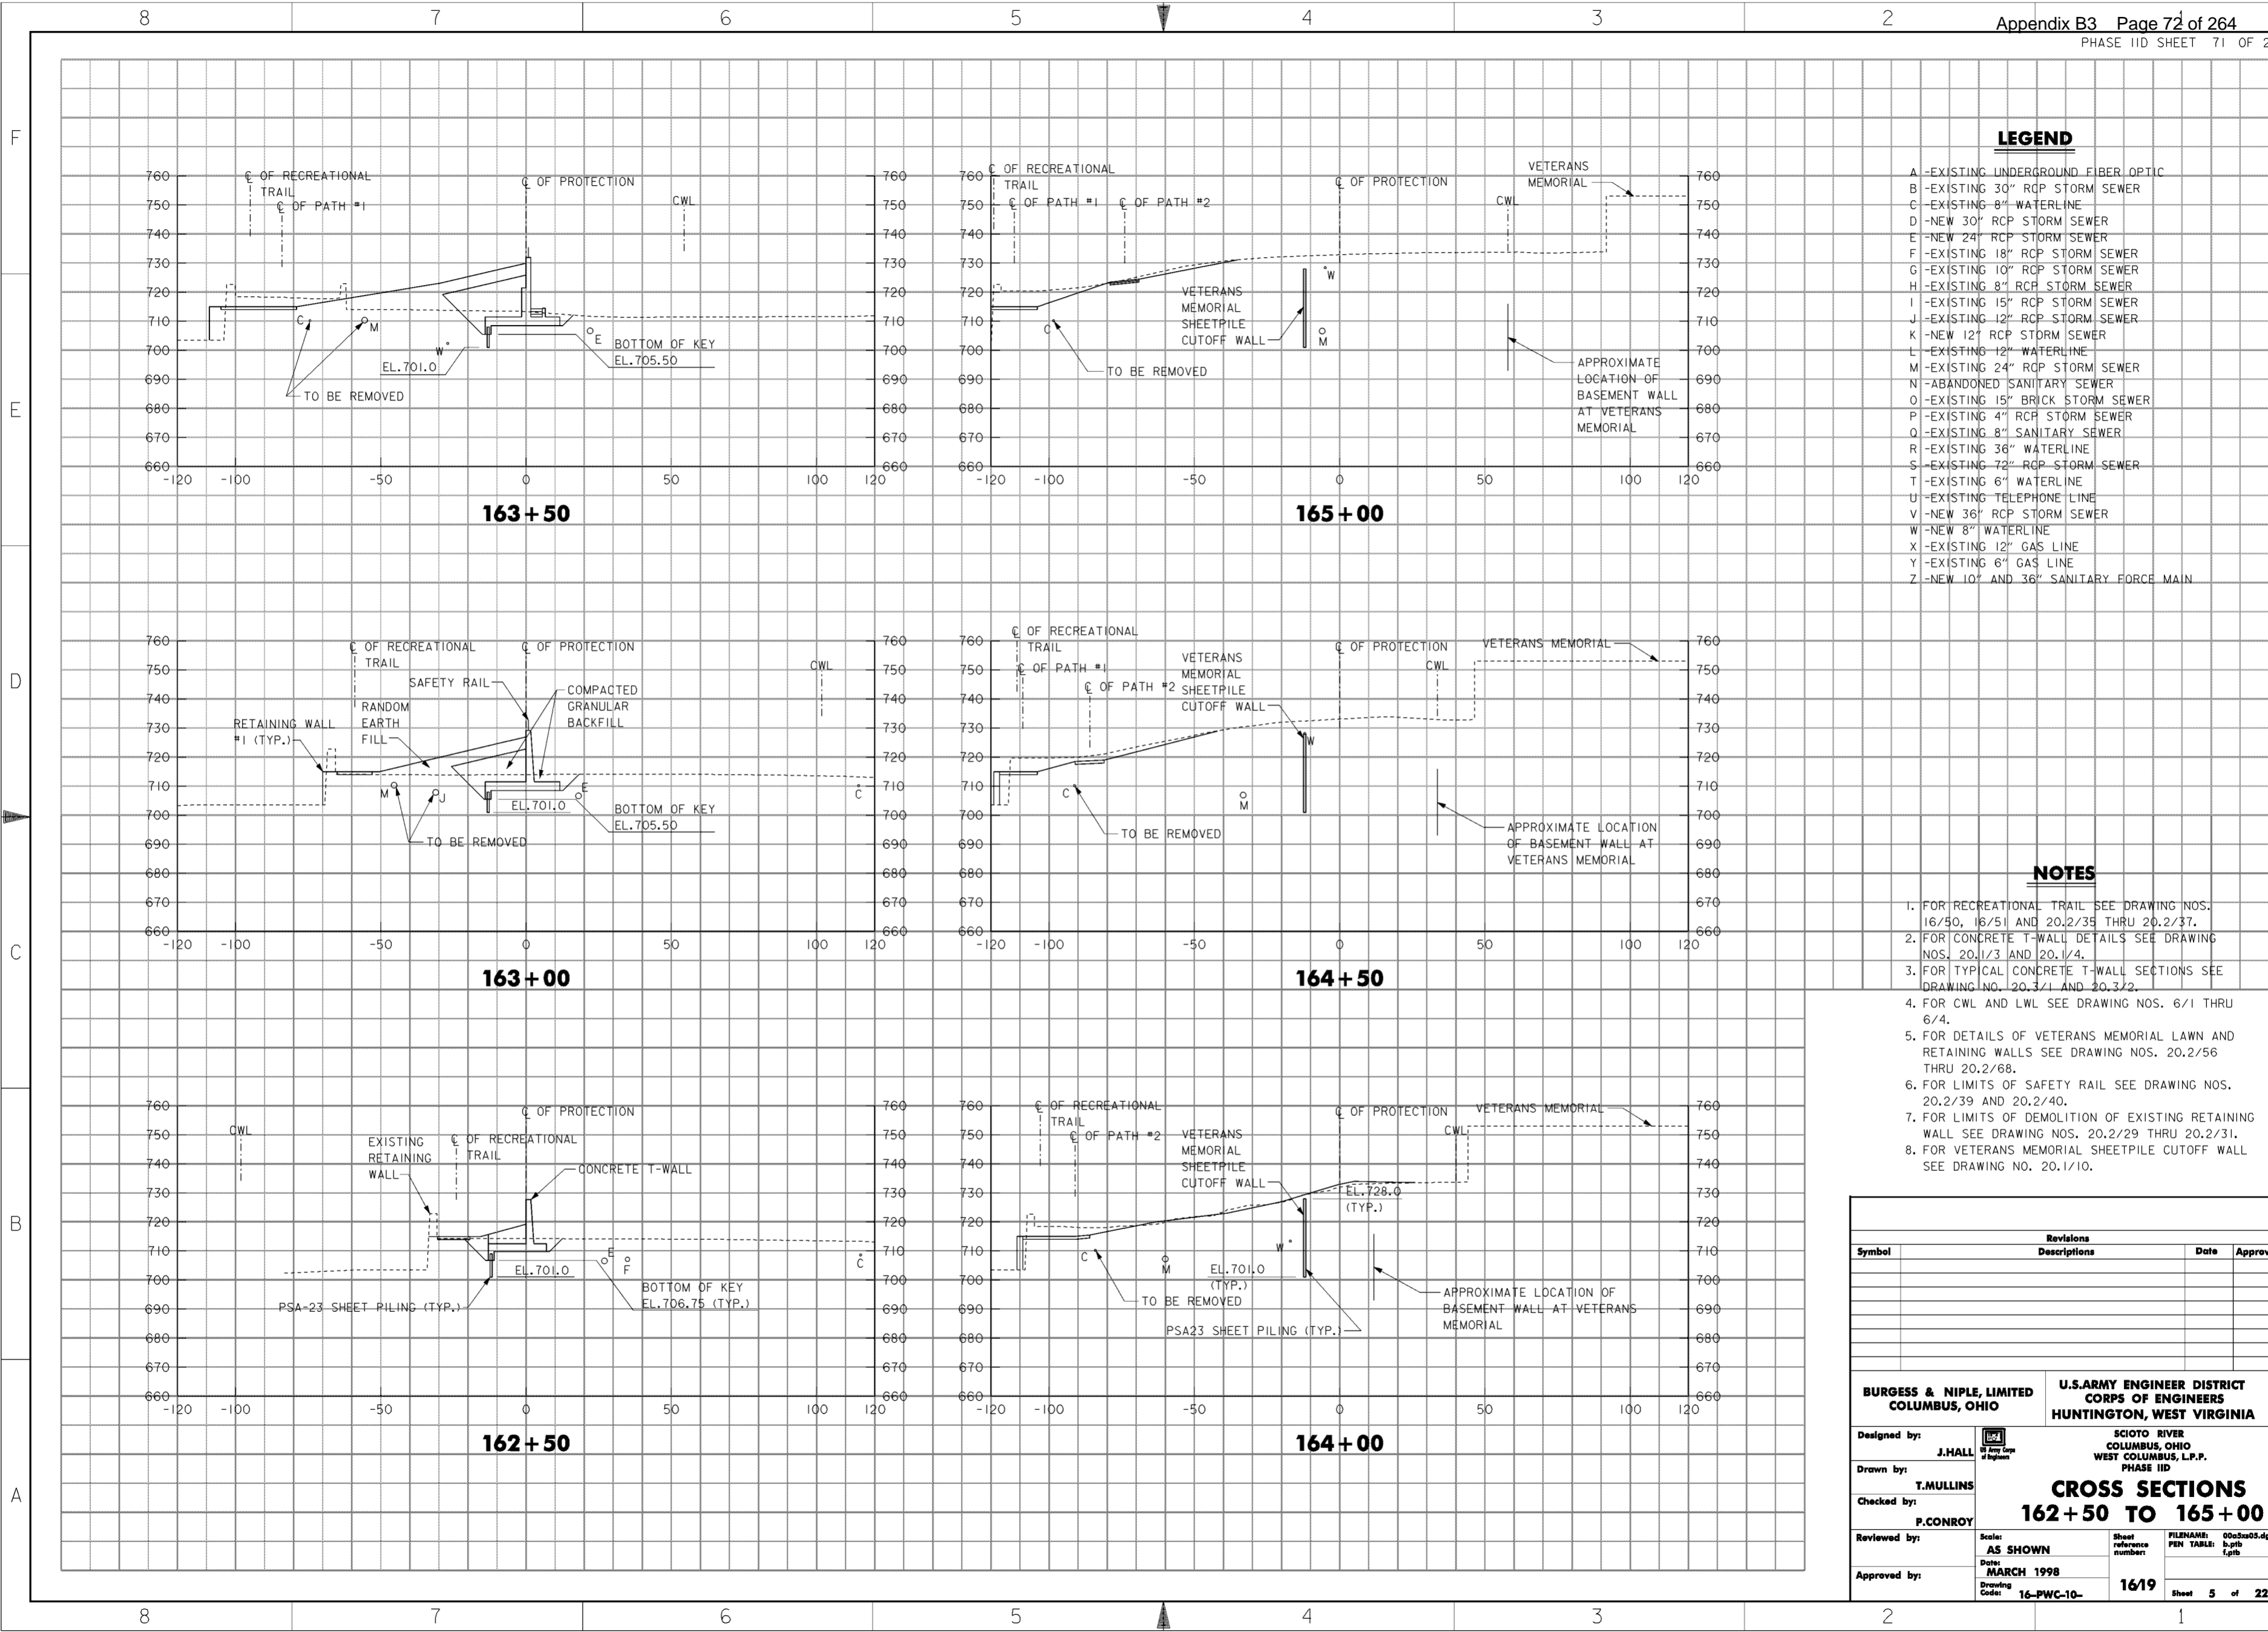

LEGEND


- A - EXISTING UNDERGROUND FIBER OPTIC
- B - EXISTING 30" RCP STORM SEWER
- C - EXISTING 8" WATERLINE
- D - NEW 30" RCP STORM SEWER
- E - NEW 24" RCP STORM SEWER
- F - EXISTING 18" RCP STORM SEWER
- G - EXISTING 10" RCP STORM SEWER
- H - EXISTING 8" RCP STORM SEWER
- I - EXISTING 15" RCP STORM SEWER
- J - EXISTING 12" RCP STORM SEWER
- K - NEW 12" RCP STORM SEWER
- L - EXISTING 12" WATERLINE
- M - EXISTING 24" RCP STORM SEWER
- N - ABANDONED SANITARY SEWER
- O - EXISTING 15" BRICK STORM SEWER
- P - EXISTING 4" RCP STORM SEWER
- Q - EXISTING 8" SANITARY SEWER
- R - EXISTING 36" WATERLINE
- S - EXISTING 72" RCP STORM SEWER
- T - EXISTING 6" WATERLINE
- U - EXISTING TELEPHONE LINE
- V - NEW 36" RCP STORM SEWER
- W - NEW 8" WATERLINE
- X - EXISTING 12" GAS LINE
- Y - EXISTING 6" GAS LINE
- Z - NEW 10" AND 36" SANITARY FORCE MAIN

NOTES

1. FOR RECREATIONAL TRAIL SEE DRAWING NOS. 16/50, 16/51 AND 20.2/35 THRU 20.2/37.
2. FOR CWL AND LWL SEE DRAWING NOS. 6/1 THRU 6/4.
3. FOR DETAILS OF VETERANS MEMORIAL LAWN AND RETAINING WALLS SEE DRAWING NOS. 20.2/56 THRU 20.2/68.
4. FOR LIMITS OF DEMOLITION OF EXISTING RETAINING WALL SEE DRAWING NOS. 20.2/29 THRU 20.2/31.


Revisions			
Symbol	Descriptions	Date	Approved

BURGESS & NIPLE, LIMITED COLUMBUS, OHIO	U.S. ARMY ENGINEER DISTRICT CORPS OF ENGINEERS HUNTINGTON, WEST VIRGINIA
Designed by: J. HALL	SCOTO RIVER COLUMBUS, OHIO WEST COLUMBUS, L.P.P. PHASE IID
Drawn by: T. MULLINS	CROSS SECTIONS 165+50 TO 168+00
Checked by: P. CONROY	Scale: AS SHOWN
Reviewed by:	Sheet reference number: 1620
Approved by:	Date: MARCH 1998
Drawing Code: 16-PWC-10-	FILENAME: 00a3a06.dgn PEN TABLE: s.pfb t.pfb Sheet 6 of 22

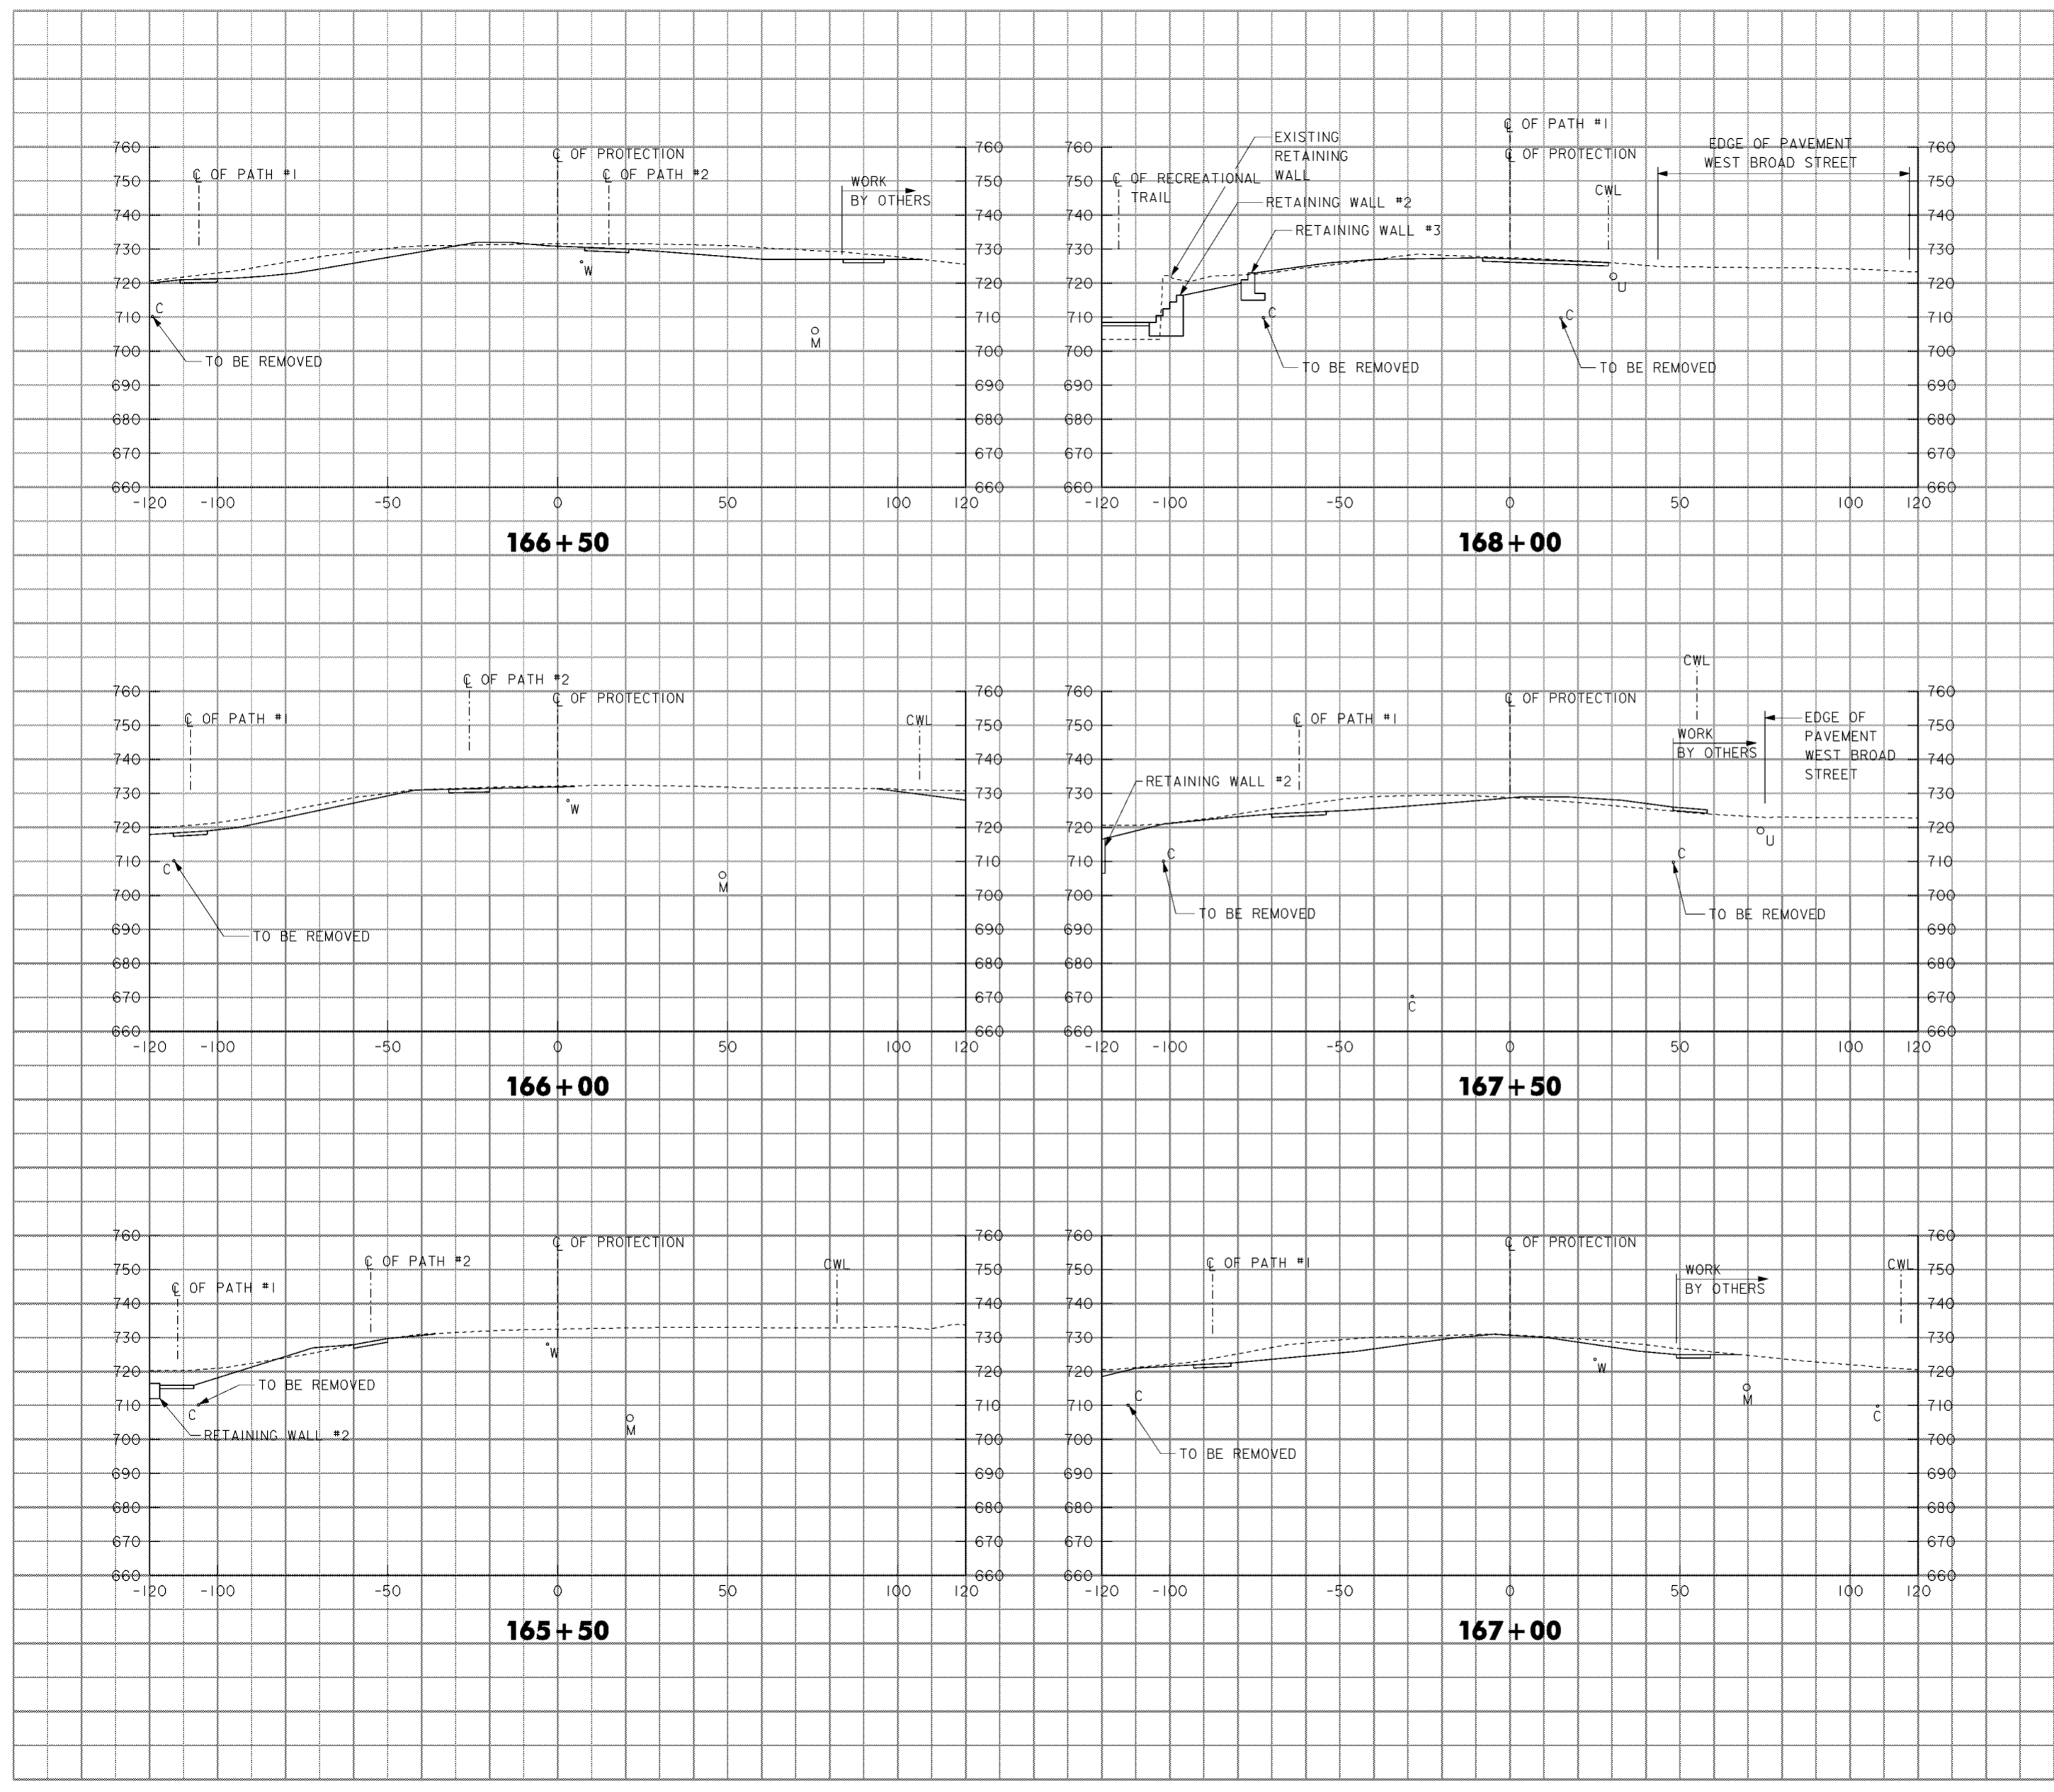

LEGEND

- A -EXISTING UNDERGROUND FIBER OPTIC
- B -EXISTING 30" RCP STORM SEWER
- C -EXISTING 8" WATERLINE
- D -NEW 30" RCP STORM SEWER
- E -NEW 24" RCP STORM SEWER
- F -EXISTING 18" RCP STORM SEWER
- G -EXISTING 10" RCP STORM SEWER
- H -EXISTING 8" RCP STORM SEWER
- I -EXISTING 15" RCP STORM SEWER
- J -EXISTING 12" RCP STORM SEWER
- K -NEW 12" RCP STORM SEWER
- L -EXISTING 12" WATERLINE
- M -EXISTING 24" RCP STORM SEWER
- N -ABANDONED SANITARY SEWER
- O -EXISTING 15" BRICK STORM SEWER
- P -EXISTING 4" RCP STORM SEWER
- Q -EXISTING 8" SANITARY SEWER
- R -EXISTING 36" WATERLINE
- S -EXISTING 72" RCP STORM SEWER
- T -EXISTING 6" WATERLINE
- U -EXISTING TELEPHONE LINE
- V -NEW 36" RCP STORM SEWER
- W -NEW 8" WATERLINE
- X -EXISTING 12" GAS LINE
- Y -EXISTING 6" GAS LINE
- Z -NEW 10" AND 36" SANITARY FORCE MAIN

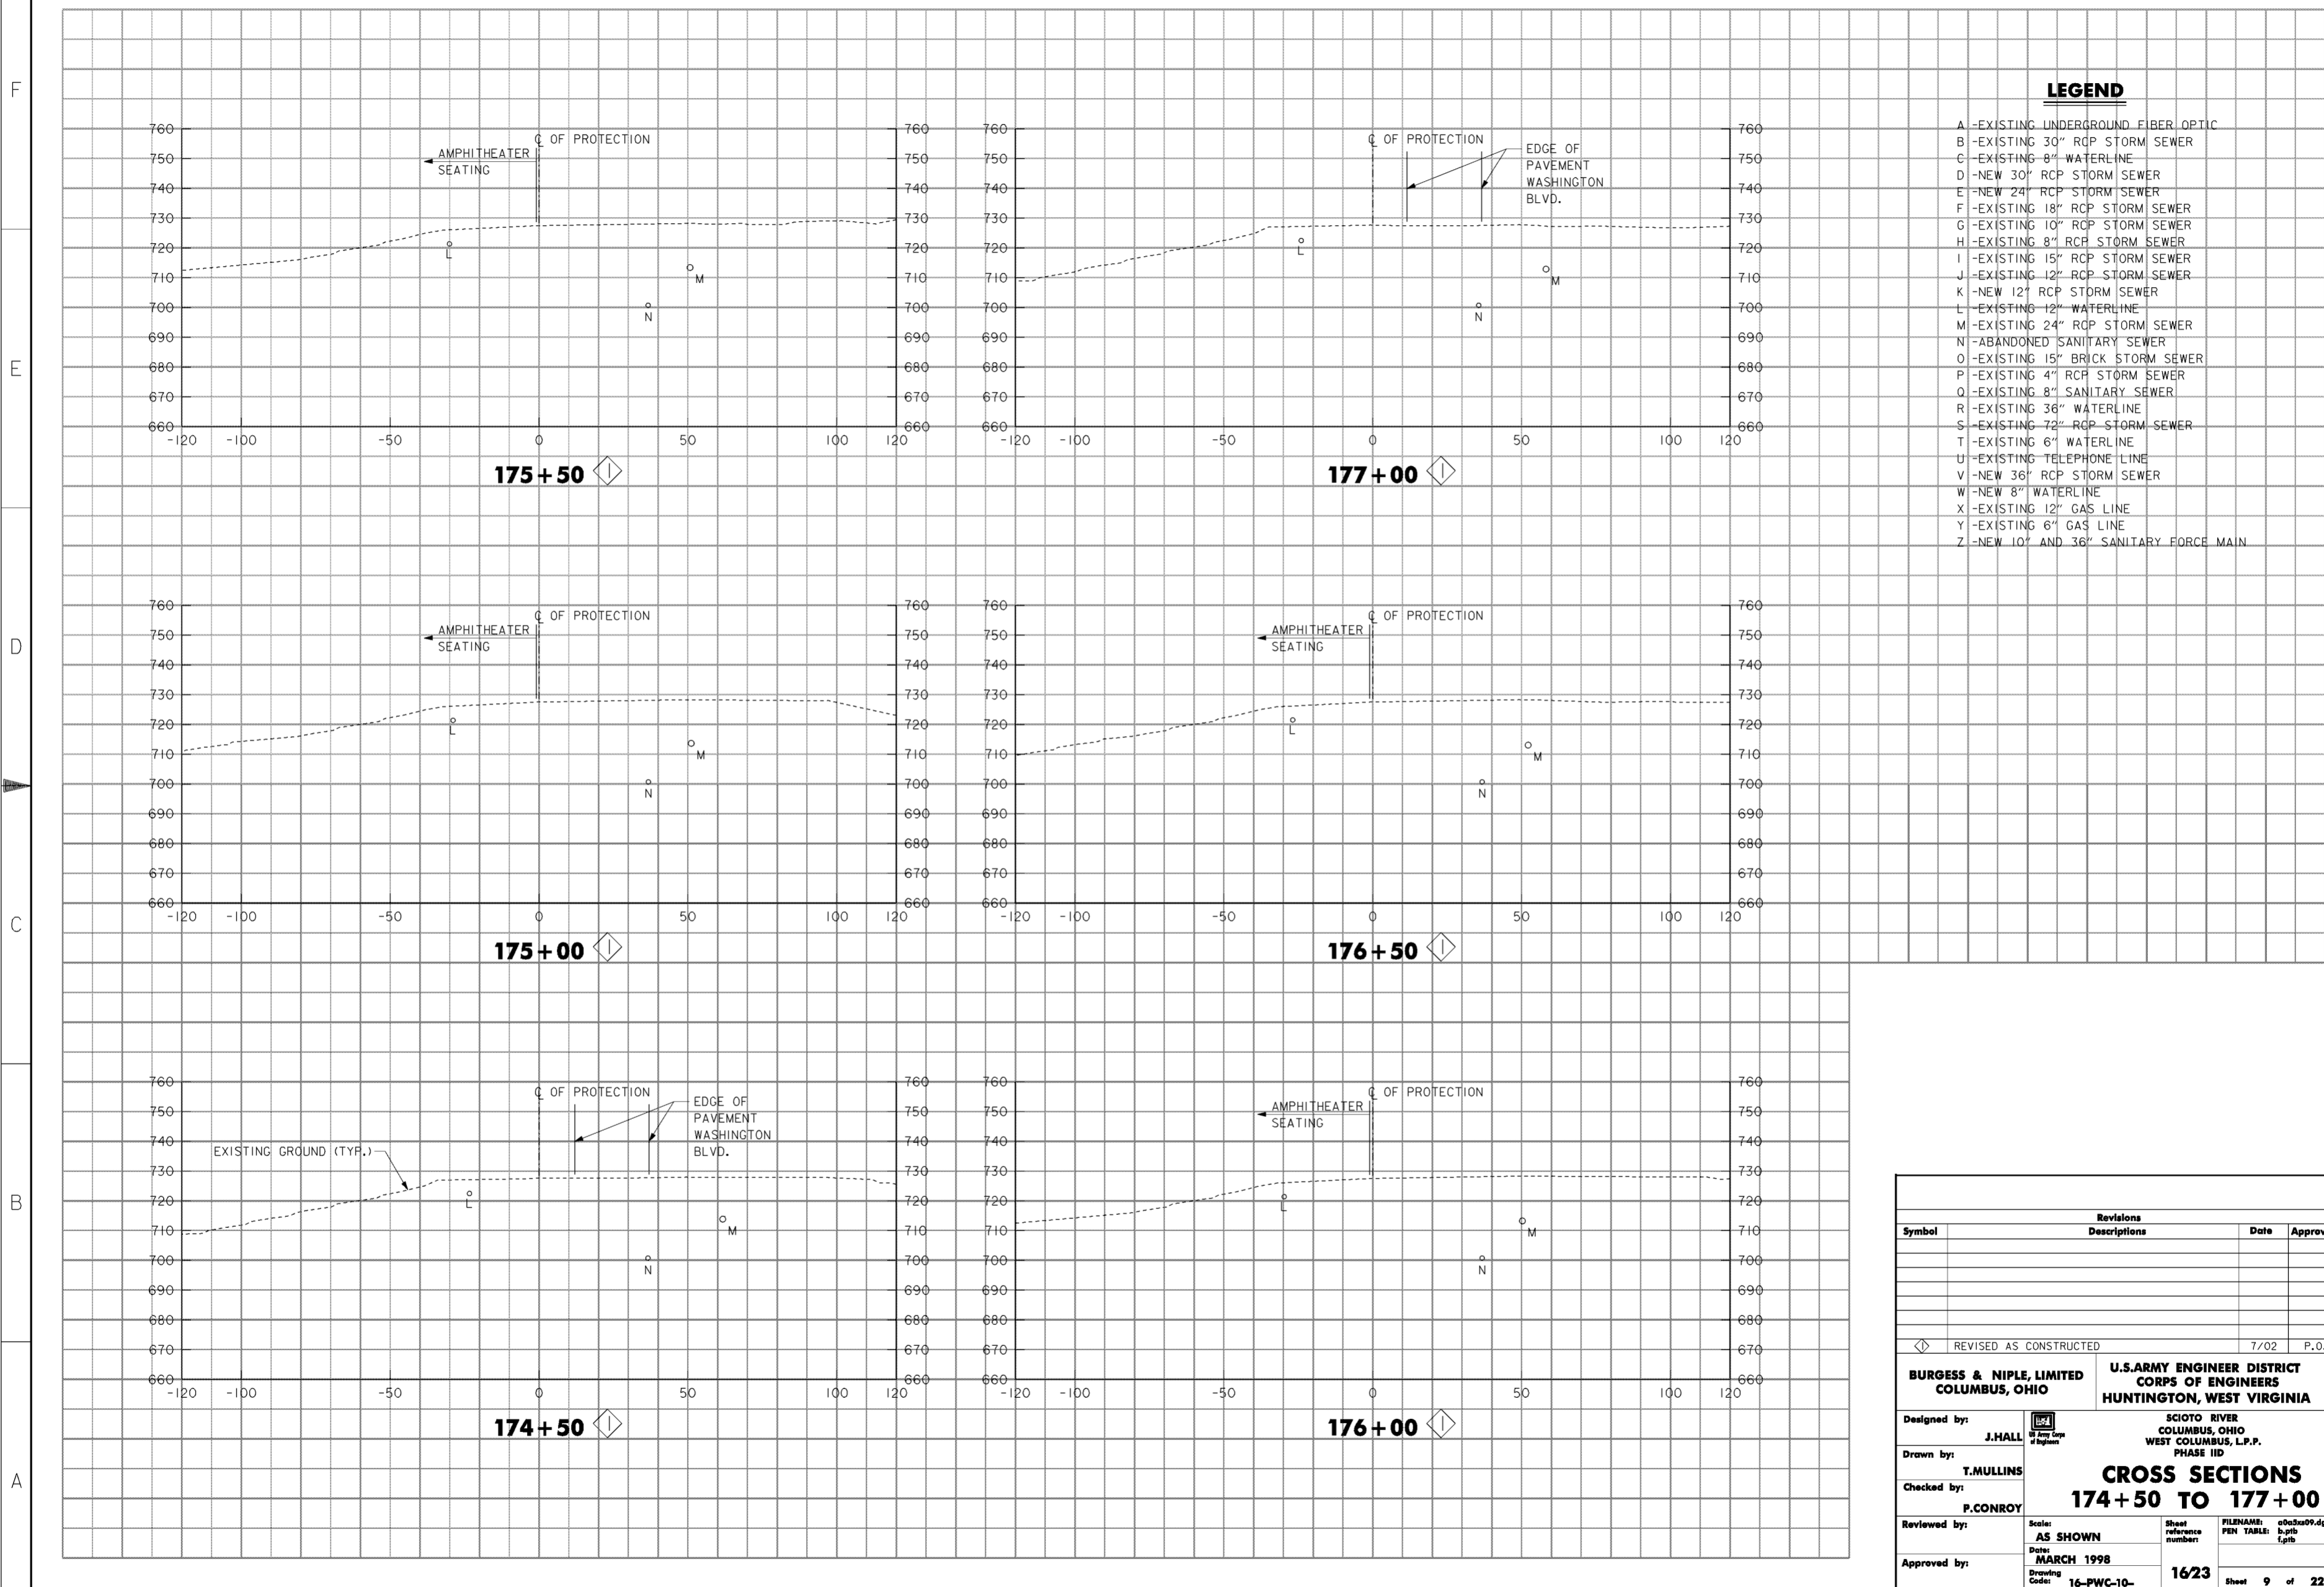


Revisions			
Symbol	Descriptions	Date	Approved
◁	REVISED AS CONSTRUCTED	7/02	P.O.C.

BURGESS & NIPLE, LIMITED COLUMBUS, OHIO	U.S. ARMY ENGINEER DISTRICT CORPS OF ENGINEERS HUNTINGTON, WEST VIRGINIA
Designed by: J. HALL	SCIO TO RIVER COLUMBUS, OHIO WEST COLUMBUS, L.P.P. PHASE IID
Drawn by: T. MULLINS	CROSS SECTIONS 174 + 50 TO 177 + 00
Checked by: P. CONROY	Scale: AS SHOWN
Reviewed by:	Date: MARCH 1998
Approved by:	Drawing Code: 16-PWC-10-
	Sheet reference number: 1623
	FILENAME: a063a09.dgn PEN TABLE: b.pfb l.pfb
	Sheet 9 of 22

LEGEND

- A -EXISTING UNDERGROUND FIBER OPTIC
- B -EXISTING 30" RCP STORM SEWER
- C -EXISTING 8" WATERLINE
- D -NEW 30" RCP STORM SEWER
- E -NEW 24" RCP STORM SEWER
- F -EXISTING 18" RCP STORM SEWER
- G -EXISTING 10" RCP STORM SEWER
- H -EXISTING 8" RCP STORM SEWER
- I -EXISTING 15" RCP STORM SEWER
- J -EXISTING 12" RCP STORM SEWER
- K -NEW 12" RCP STORM SEWER
- L -EXISTING 12" WATERLINE
- M -EXISTING 24" RCP STORM SEWER
- N -ABANDONED SANITARY SEWER
- O -EXISTING 15" BRICK STORM SEWER
- P -EXISTING 4" RCP STORM SEWER
- Q -EXISTING 8" SANITARY SEWER
- R -EXISTING 36" WATERLINE
- S -EXISTING 72" RCP STORM SEWER
- T -EXISTING 6" WATERLINE
- U -EXISTING TELEPHONE LINE
- V -NEW 36" RCP STORM SEWER
- W -NEW 8" WATERLINE
- X -EXISTING 12" GAS LINE
- Y -EXISTING 6" GAS LINE
- Z -NEW 10" AND 36" SANITARY FORCE MAIN

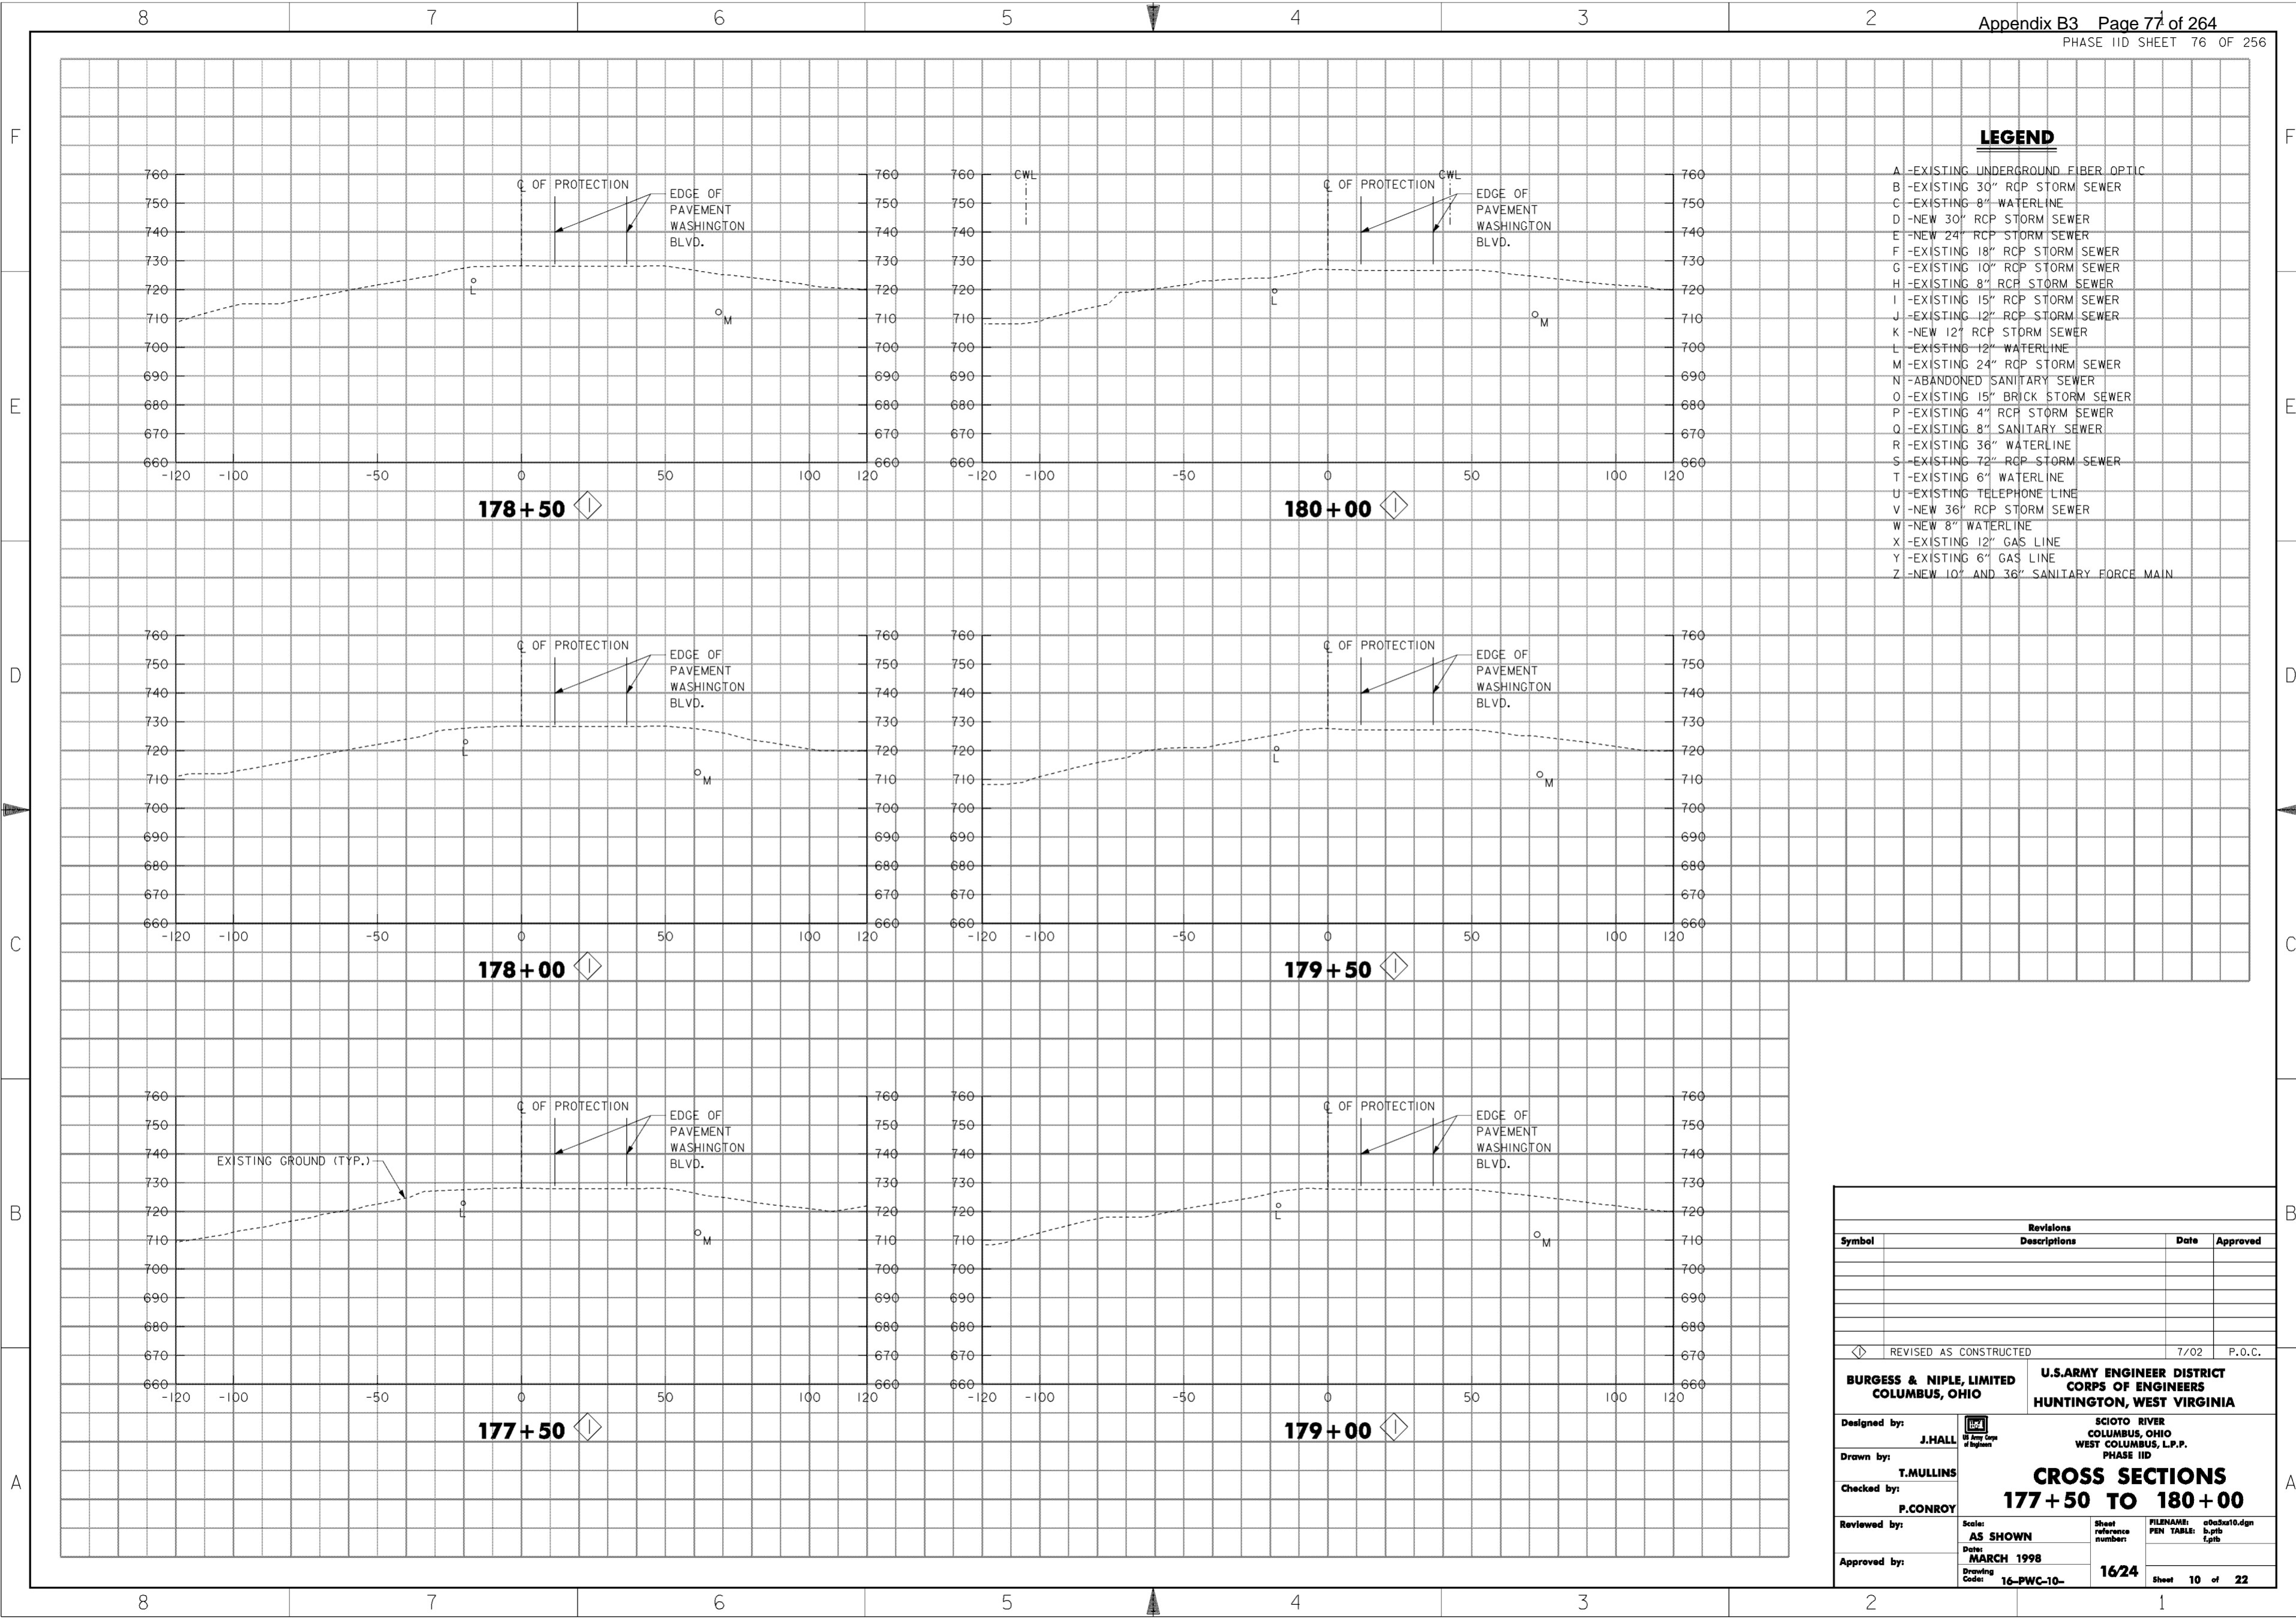

Revisions			
Symbol	Descriptions	Date	Approved
◊	REVISED AS CONSTRUCTED	7/02	P.O.C.

BURGESS & NIPLE, LIMITED COLUMBUS, OHIO	U.S. ARMY ENGINEER DISTRICT CORPS OF ENGINEERS HUNTINGTON, WEST VIRGINIA		
		SCIOTO RIVER COLUMBUS, OHIO WEST COLUMBUS, L.P.P. PHASE IID	
Designed by: J. HALL	CROSS SECTIONS 177+50 TO 180+00		
Drawn by: T. MULLINS			
Checked by: P. CONROY			
Reviewed by:			
Approved by:	Scale: AS SHOWN	Sheet reference number: 1624	FILENAME: a063ax10.dgn PEN TABLE: b.pfb l.pfb
	Date: MARCH 1998	Drawing Code: 16-PWC-10-	Sheet 10 of 22

WORK AS CONSTRUCTED

LEGEND

- A -EXISTING UNDERGROUND FIBER OPTIC
- B -EXISTING 30" RCP STORM SEWER
- C -EXISTING 8" WATERLINE
- D -NEW 30" RCP STORM SEWER
- E -NEW 24" RCP STORM SEWER
- F -EXISTING 18" RCP STORM SEWER
- G -EXISTING 10" RCP STORM SEWER
- H -EXISTING 8" RCP STORM SEWER
- I -EXISTING 15" RCP STORM SEWER
- J -EXISTING 12" RCP STORM SEWER
- K -NEW 12" RCP STORM SEWER
- L -EXISTING 12" WATERLINE
- M -EXISTING 24" RCP STORM SEWER
- N -ABANDONED SANITARY SEWER
- O -EXISTING 15" BRICK STORM SEWER
- P -EXISTING 4" RCP STORM SEWER
- Q -EXISTING 8" SANITARY SEWER
- R -EXISTING 36" WATERLINE
- S -EXISTING 72" RCP STORM SEWER
- T -EXISTING 6" WATERLINE
- U -EXISTING TELEPHONE LINE
- V -NEW 36" RCP STORM SEWER
- W -NEW 8" WATERLINE
- X -EXISTING 12" GAS LINE
- Y -EXISTING 6" GAS LINE
- Z -NEW 10" AND 36" SANITARY FORCE MAIN


NOTES

1. FOR TYPICAL LEVEE SECTIONS SEE DRAWING NO. 20.3/2.
2. FOR CWL AND LWL SEE DRAWING NOS. 6/1 THRU 6/4.

Revisions			
Symbol	Descriptions	Date	Approved

BURGESS & NIPLE, LIMITED COLUMBUS, OHIO	U.S. ARMY ENGINEER DISTRICT CORPS OF ENGINEERS HUNTINGTON, WEST VIRGINIA
Designed by: J. HALL	SCOTO RIVER COLUMBUS, OHIO WEST COLUMBUS, L.P.P. PHASE IID
Drawn by: T. MULLINS	CROSS SECTIONS 183+50 TO 186+00
Checked by: P. CONROY	Scale: AS SHOWN
Reviewed by:	Date: MARCH 1998
Approved by:	Drawing Code: 16-PWC-10-
FILENAME: 00a3a12.dgn PEN TABLE: 5.pfb 1.pfb Sheet reference number: 1626 Sheet 12 of 22	

WORK AS CONSTRUCTED

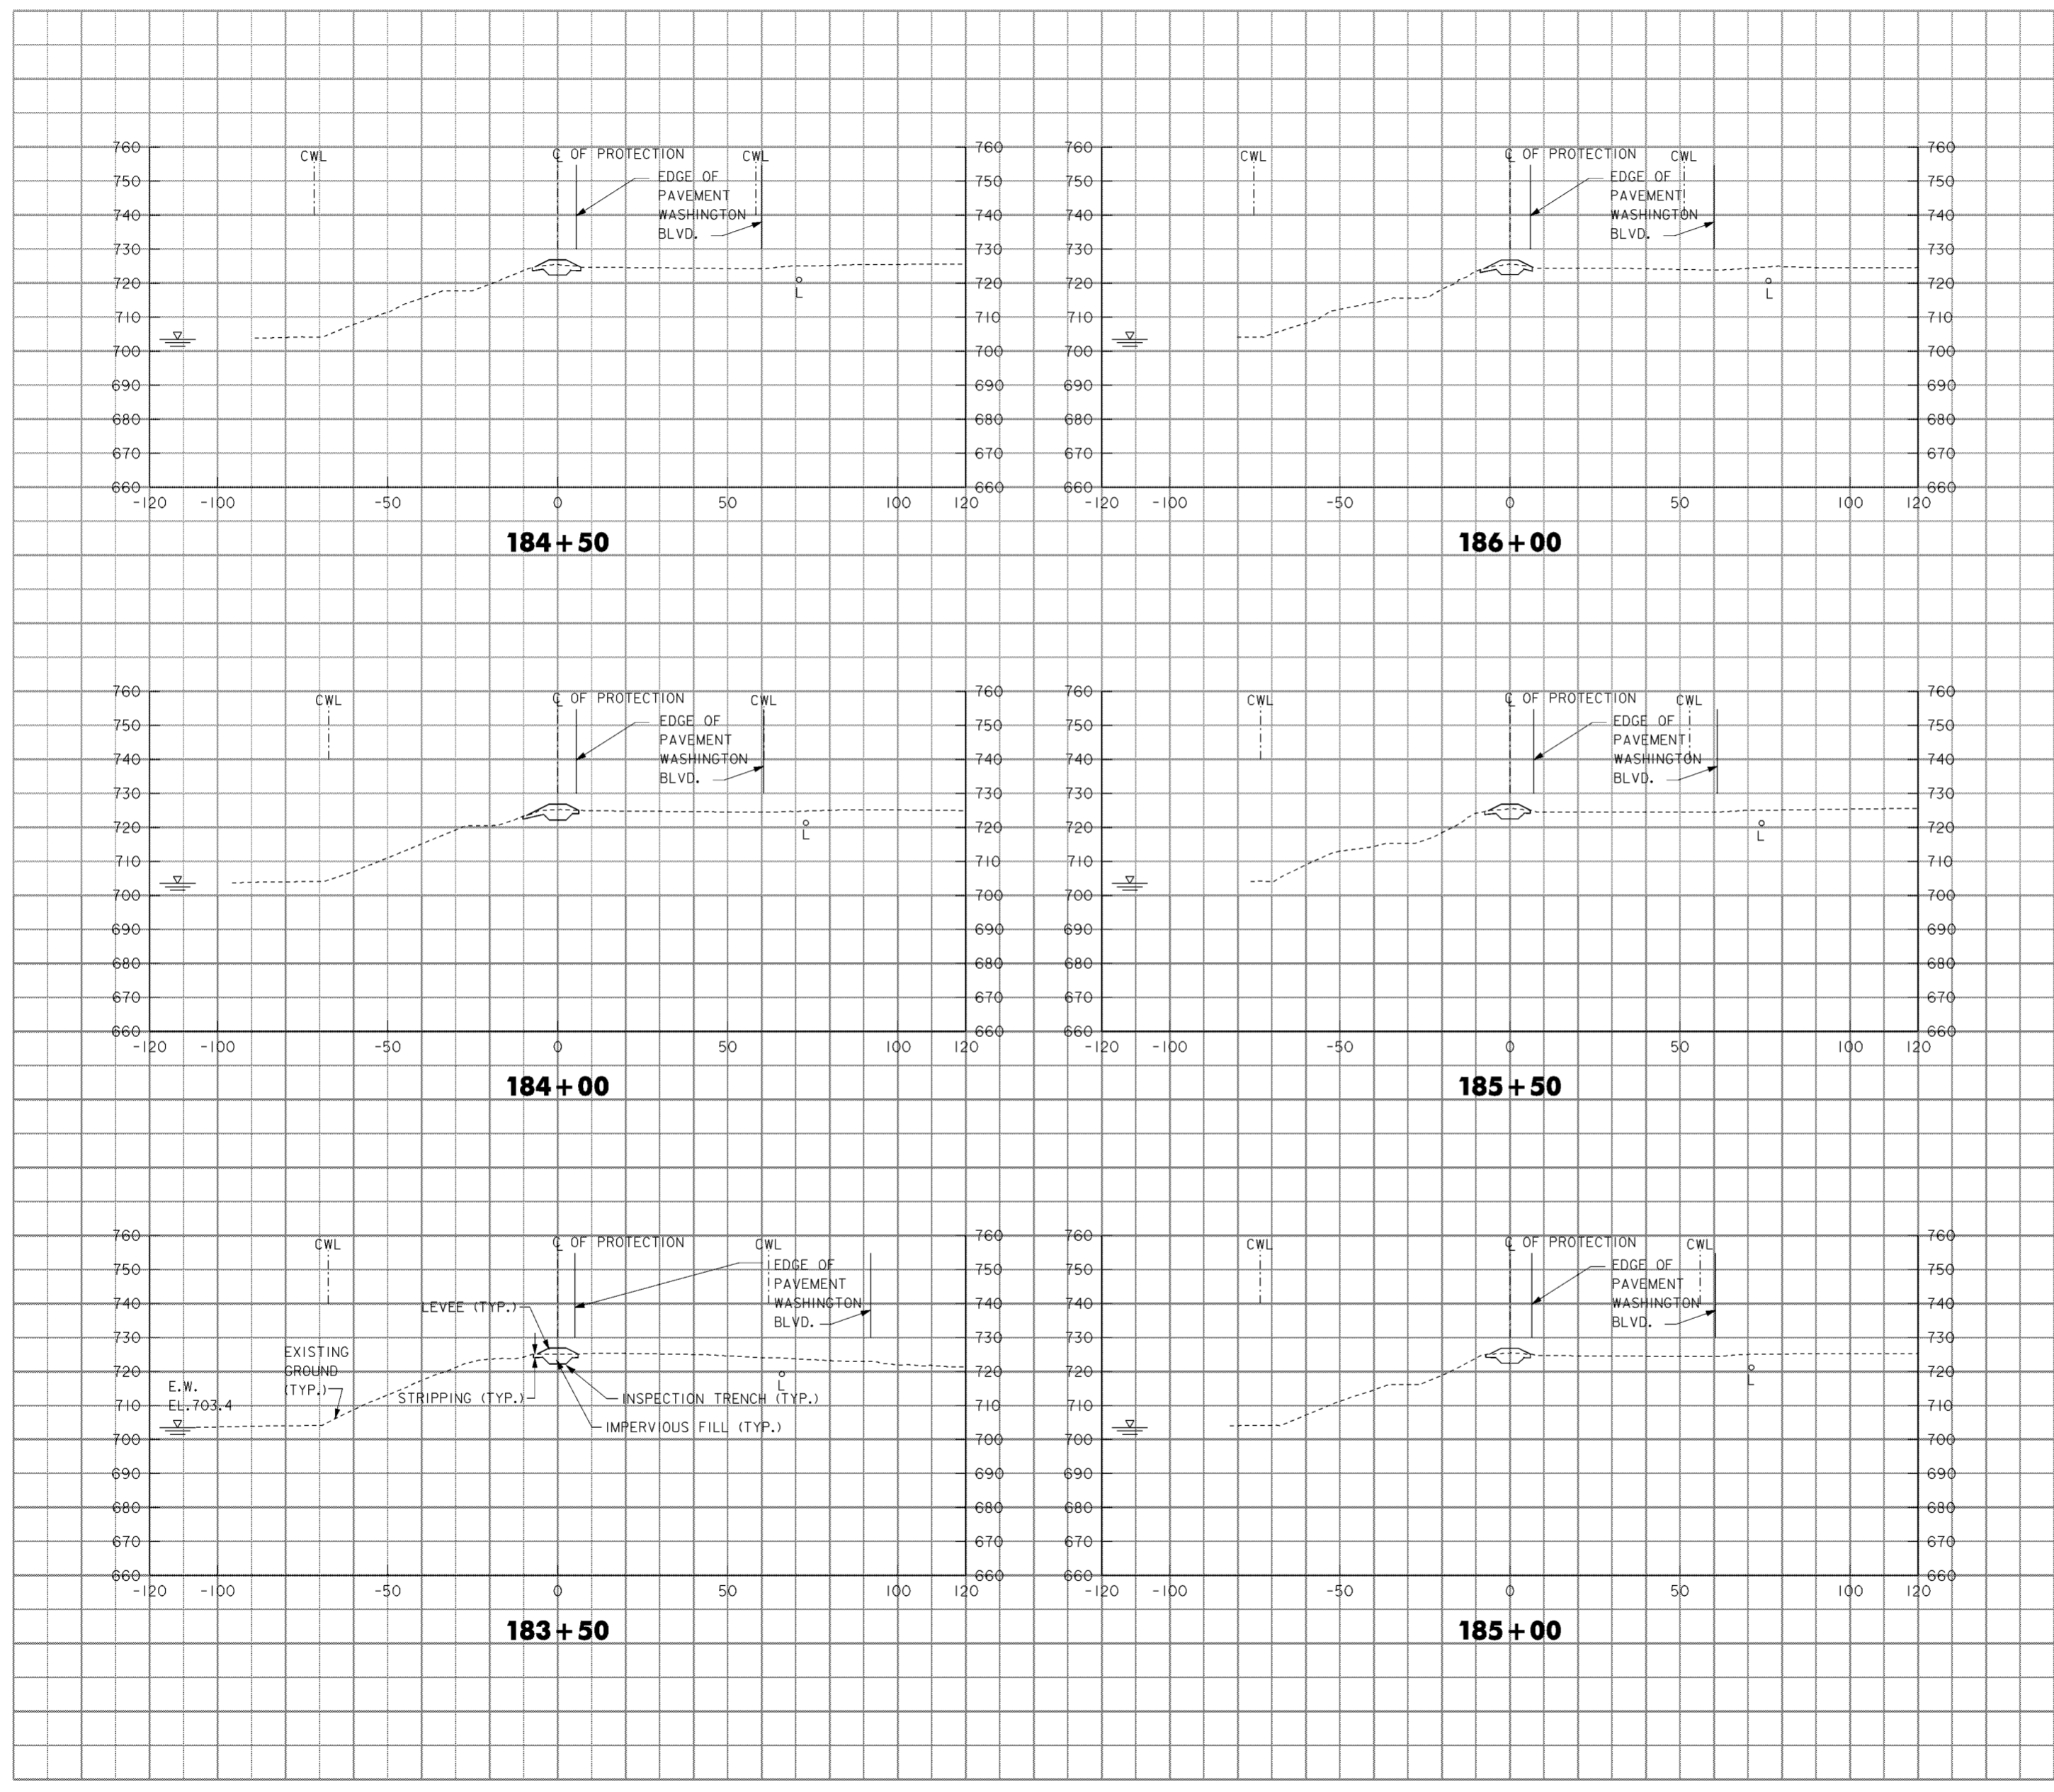

LEGEND


- A -EXISTING UNDERGROUND FIBER OPTIC
- B -EXISTING 30" RCP STORM SEWER
- C -EXISTING 8" WATERLINE
- D -NEW 30" RCP STORM SEWER
- E -NEW 24" RCP STORM SEWER
- F -EXISTING 18" RCP STORM SEWER
- G -EXISTING 10" RCP STORM SEWER
- H -EXISTING 8" RCP STORM SEWER
- I -EXISTING 15" RCP STORM SEWER
- J -EXISTING 12" RCP STORM SEWER
- K -NEW 12" RCP STORM SEWER
- L -EXISTING 12" WATERLINE
- M -EXISTING 24" RCP STORM SEWER
- N -ABANDONED SANITARY SEWER
- O -EXISTING 15" BRICK STORM SEWER
- P -EXISTING 4" RCP STORM SEWER
- Q -EXISTING 8" SANITARY SEWER
- R -EXISTING 36" WATERLINE
- S -EXISTING 72" RCP STORM SEWER
- T -EXISTING 6" WATERLINE
- U -EXISTING TELEPHONE LINE
- V -NEW 36" RCP STORM SEWER
- W -NEW 8" WATERLINE
- X -EXISTING 12" GAS LINE
- Y -EXISTING 6" GAS LINE
- Z -NEW 10" AND 36" SANITARY FORCE MAIN

NOTES

1. FOR TYPICAL LEVEE SECTIONS SEE DRAWING NO. 20.3/2.
2. FOR WASHINGTON BLVD. SANDBAG CLOSURE SEE DRAWING NO. 20.2/6.
3. FOR CWL AND LWL SEE DRAWING NOS. 6/1 THRU 6/4.
4. NEW FILL PLACED ON EXISTING SLOPES SHALL BE PLACED USING BENCHING IN ACCORDANCE WITH THE SPECIFICATIONS.

Revisions			
Symbol	Descriptions	Date	Approved

BURGESS & NIPLE, LIMITED COLUMBUS, OHIO	U.S. ARMY ENGINEER DISTRICT CORPS OF ENGINEERS HUNTINGTON, WEST VIRGINIA
Designed by: J. HALL	SCOTO RIVER COLUMBUS, OHIO WEST COLUMBUS, L.P.P. PHASE IID
Drawn by: T. MULLINS	CROSS SECTIONS 186 + 50 TO 189 + 00
Checked by: P. CONROY	Scale: AS SHOWN
Reviewed by:	Sheet reference number: 16/27
Approved by:	FILENAME: 00a3a13.dgn PEN TABLE: 5.pfb L.pfb Sheet 13 of 22
Date: MARCH 1998	Drawing Code: 16-PWC-10-

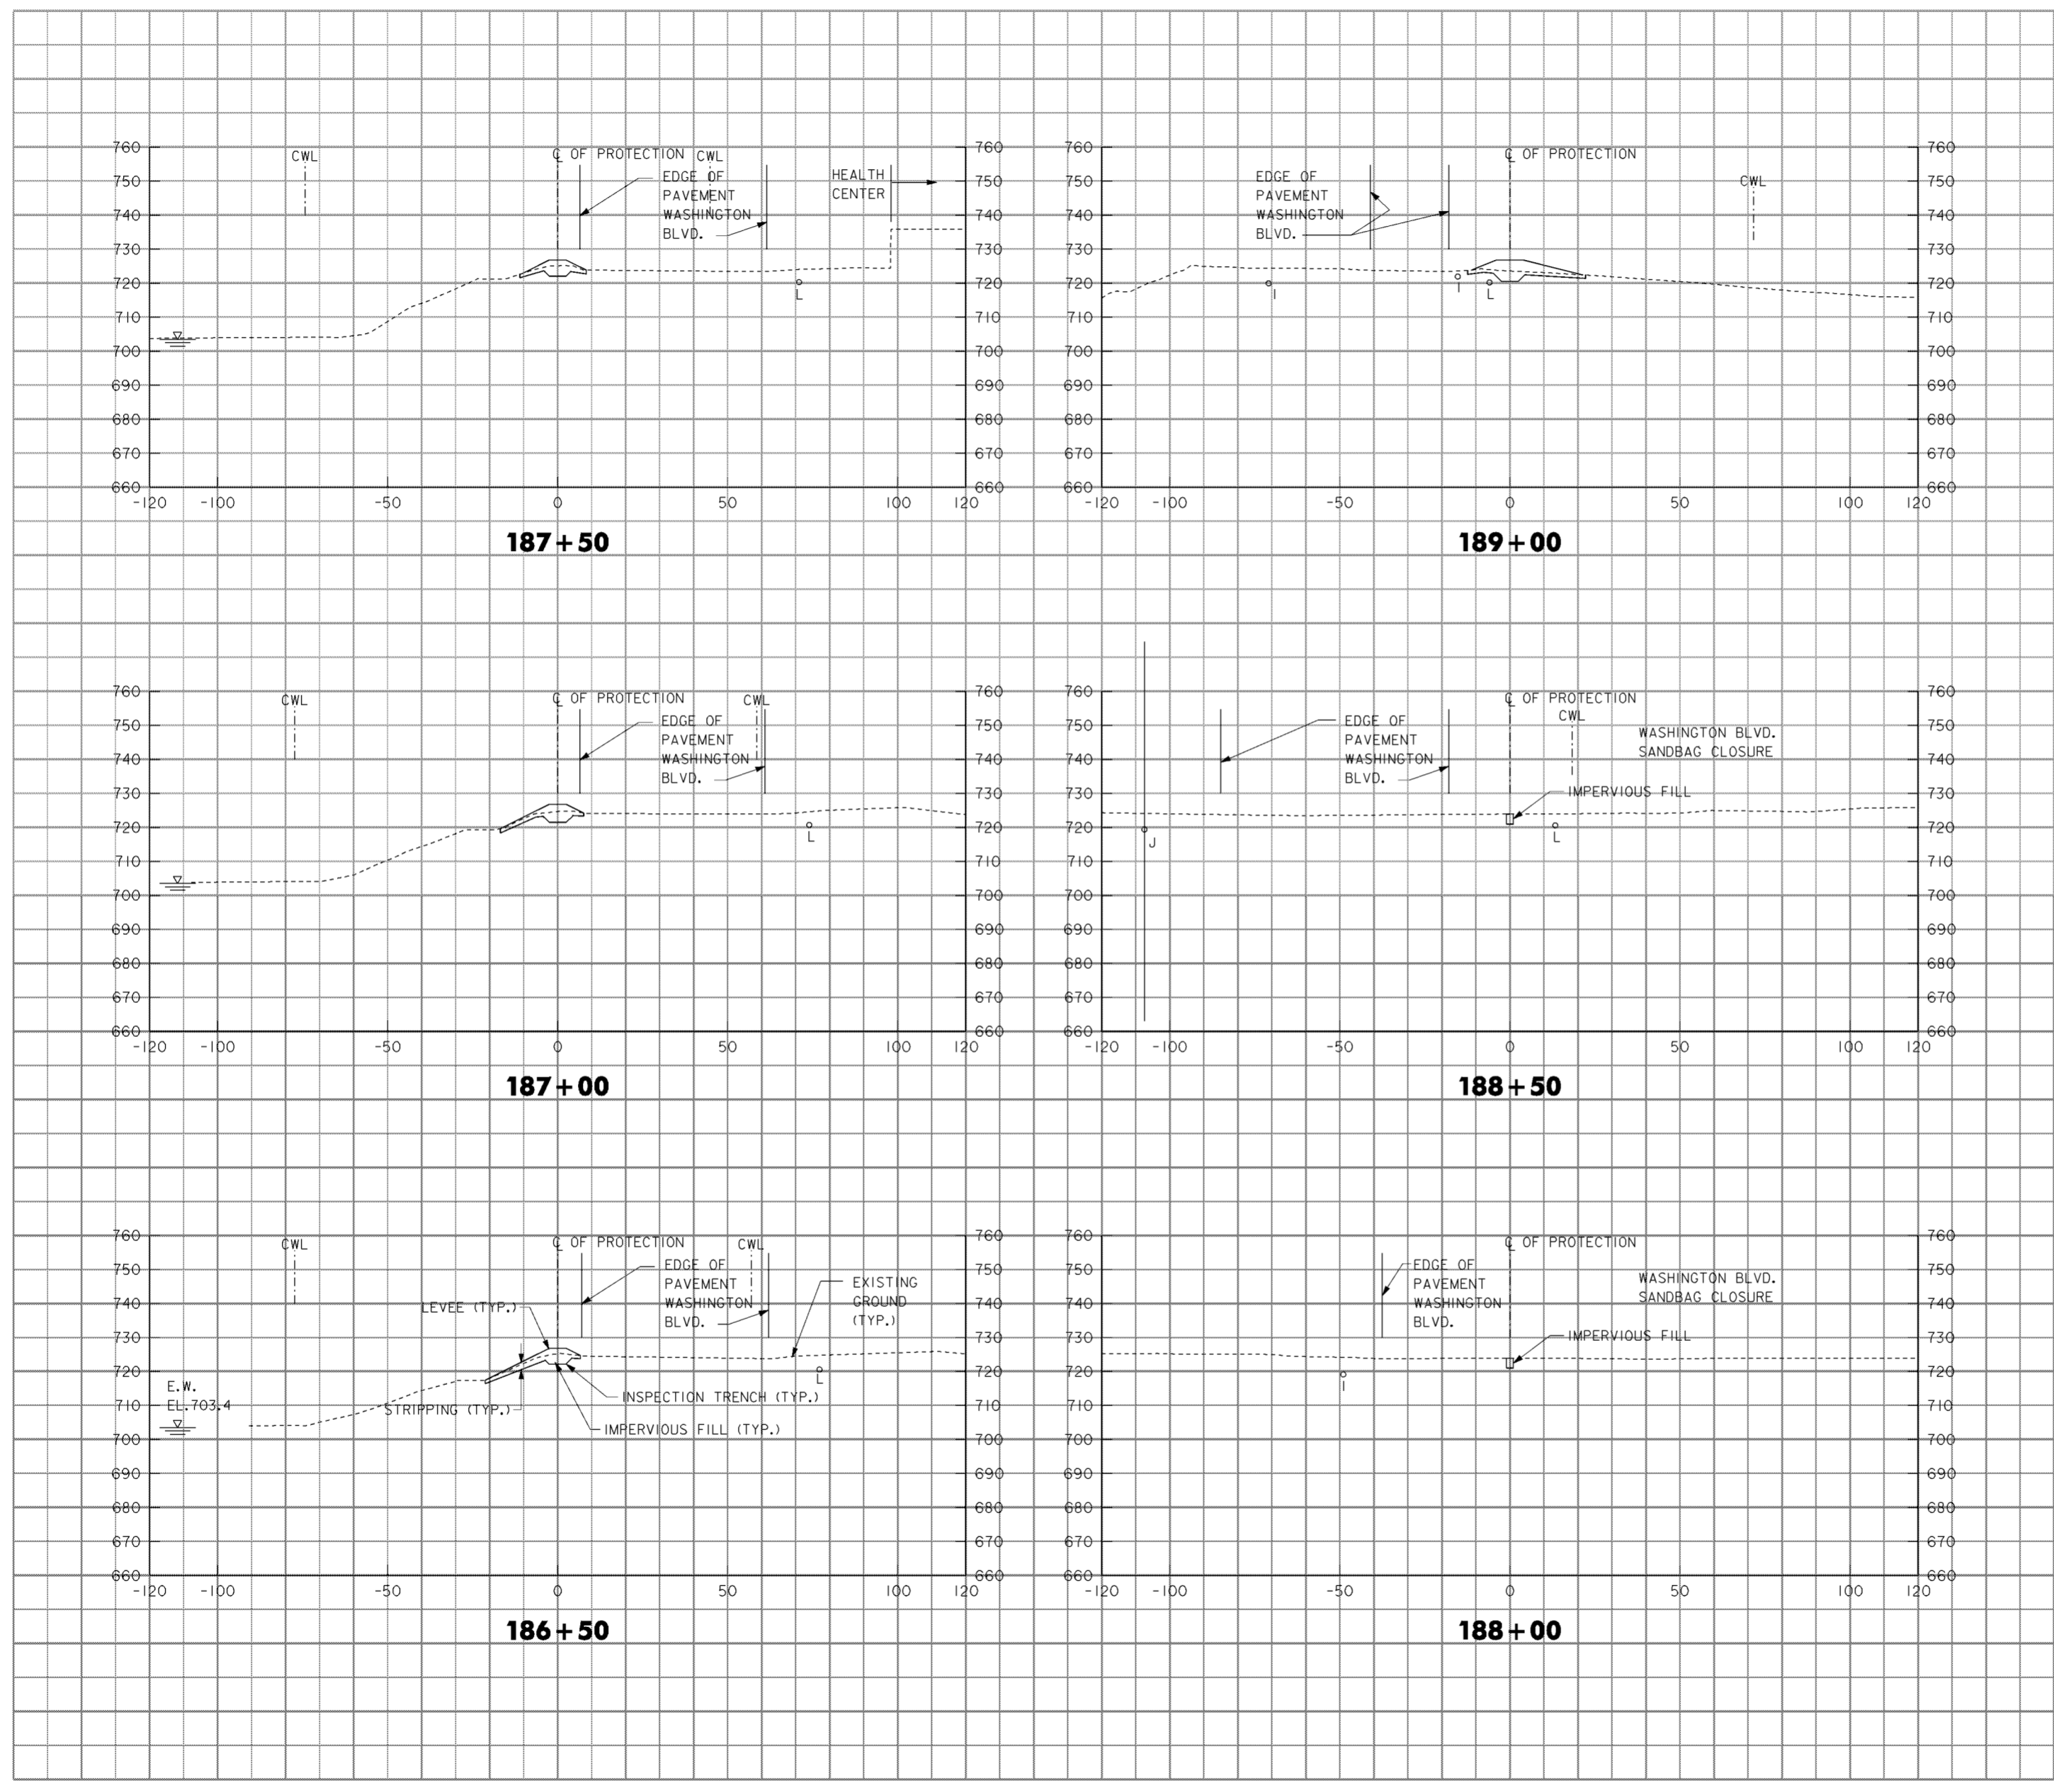

LEGEND




- A -EXISTING UNDERGROUND FIBER OPTIC
- B -EXISTING 30" RCP STORM SEWER
- C -EXISTING 8" WATERLINE
- D -NEW 30" RCP STORM SEWER
- E -NEW 24" RCP STORM SEWER
- F -EXISTING 18" RCP STORM SEWER
- G -EXISTING 10" RCP STORM SEWER
- H -EXISTING 8" RCP STORM SEWER
- I -EXISTING 15" RCP STORM SEWER
- J -EXISTING 12" RCP STORM SEWER
- K -NEW 12" RCP STORM SEWER
- L -EXISTING 12" WATERLINE
- M -EXISTING 24" RCP STORM SEWER
- N -ABANDONED SANITARY SEWER
- O -EXISTING 15" BRICK STORM SEWER
- P -EXISTING 4" RCP STORM SEWER
- Q -EXISTING 8" SANITARY SEWER
- R -EXISTING 36" WATERLINE
- S -EXISTING 72" RCP STORM SEWER
- T -EXISTING 6" WATERLINE
- U -EXISTING TELEPHONE LINE
- V -NEW 36" RCP STORM SEWER
- W -NEW 8" WATERLINE
- X -EXISTING 12" GAS LINE
- Y -EXISTING 6" GAS LINE
- Z -NEW 10" AND 36" SANITARY FORCE MAIN

NOTES

1. FOR TYPICAL LEVEE SECTIONS SEE DRAWING NO. 20.3/2.
2. FOR CONCRETE I-WALL DETAILS SEE DRAWING NOS. 20.1/1 AND 20.1/2.
3. FOR CONCRETE I-WALL TYPICAL SECTIONS SEE DRAWING NO. 20.3/2.
4. FOR RICH STREET GATE CLOSURE SEE DRAWING NO. 20.2/7.
5. FOR CWL AND LWL SEE DRAWING NOS. 6/1 THRU 6/4.
6. NEW FILL PLACED ON EXISTING SLOPES SHALL BE PLACED USING BENCHING IN ACCORDANCE WITH THE SPECIFICATIONS.

Revisions			
Symbol	Descriptions	Date	Approved

BURGESS & NIPLE, LIMITED COLUMBUS, OHIO	U.S. ARMY ENGINEER DISTRICT CORPS OF ENGINEERS HUNTINGTON, WEST VIRGINIA
Designed by: J. HALL	SCOTO RIVER COLUMBUS, OHIO WEST COLUMBUS, L.P.P. PHASE IID
Drawn by: T. MULLINS	CROSS SECTIONS 189+50 TO 192+00
Checked by: P. CONROY	Scale: AS SHOWN
Reviewed by:	Date: MARCH 1998
Approved by:	Drawing Code: 16-PWC-10-
	Sheet reference number: 16/28
	FILENAME: 00a3a14.dgn PEN TABLE: 5.plt 1.plt
	Sheet 14 of 22

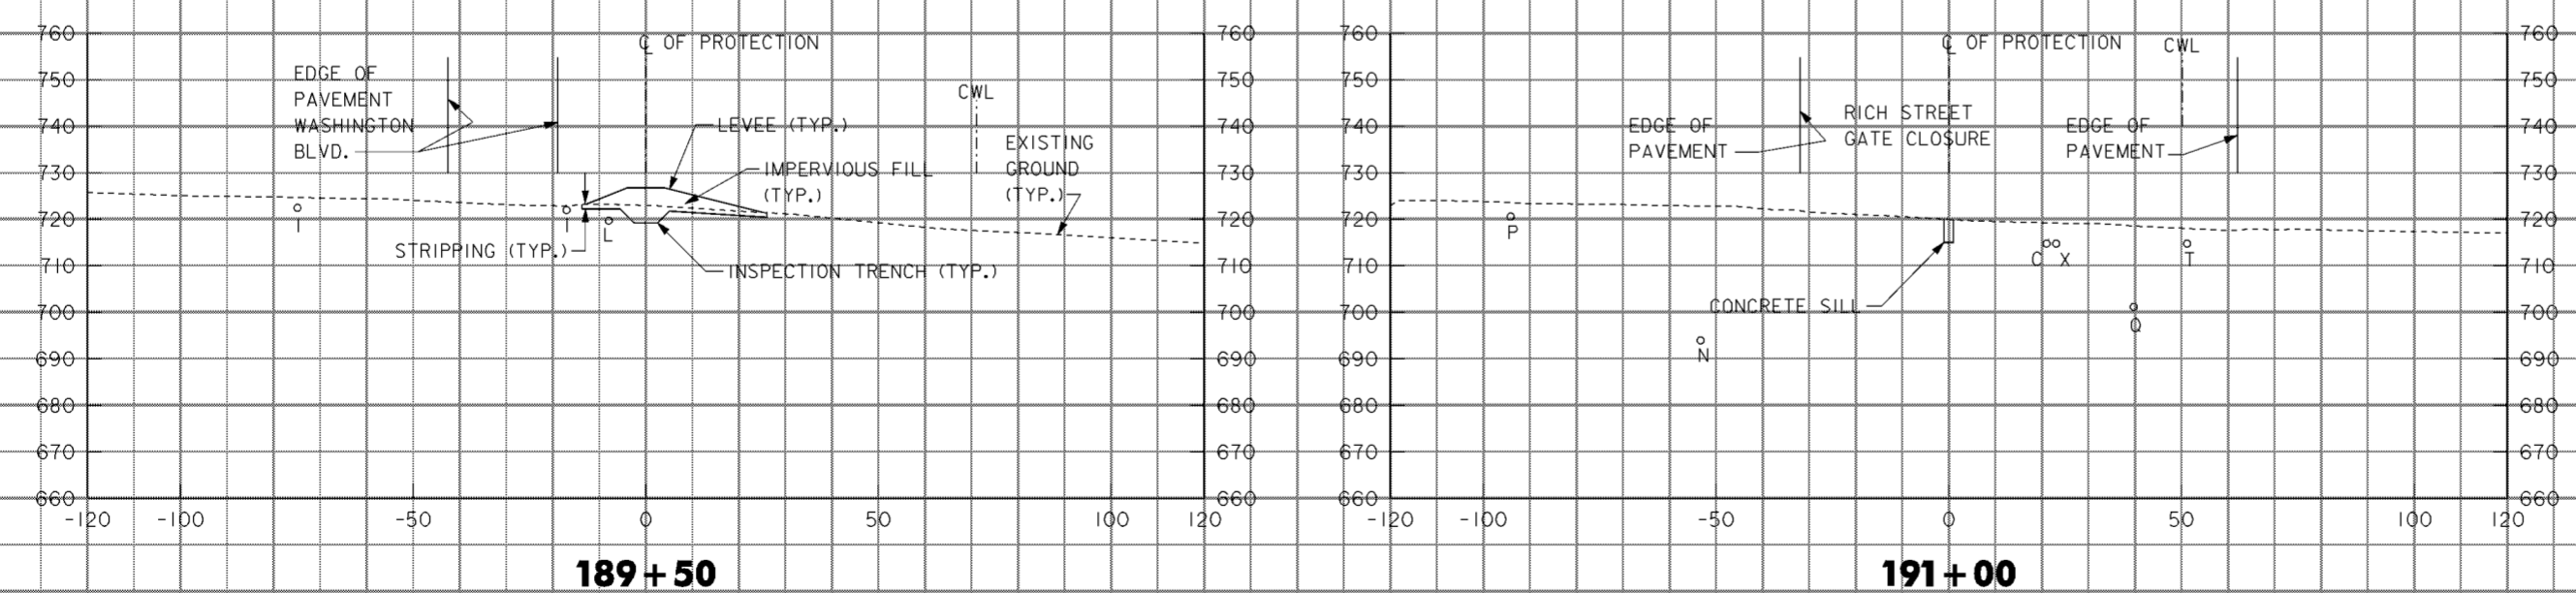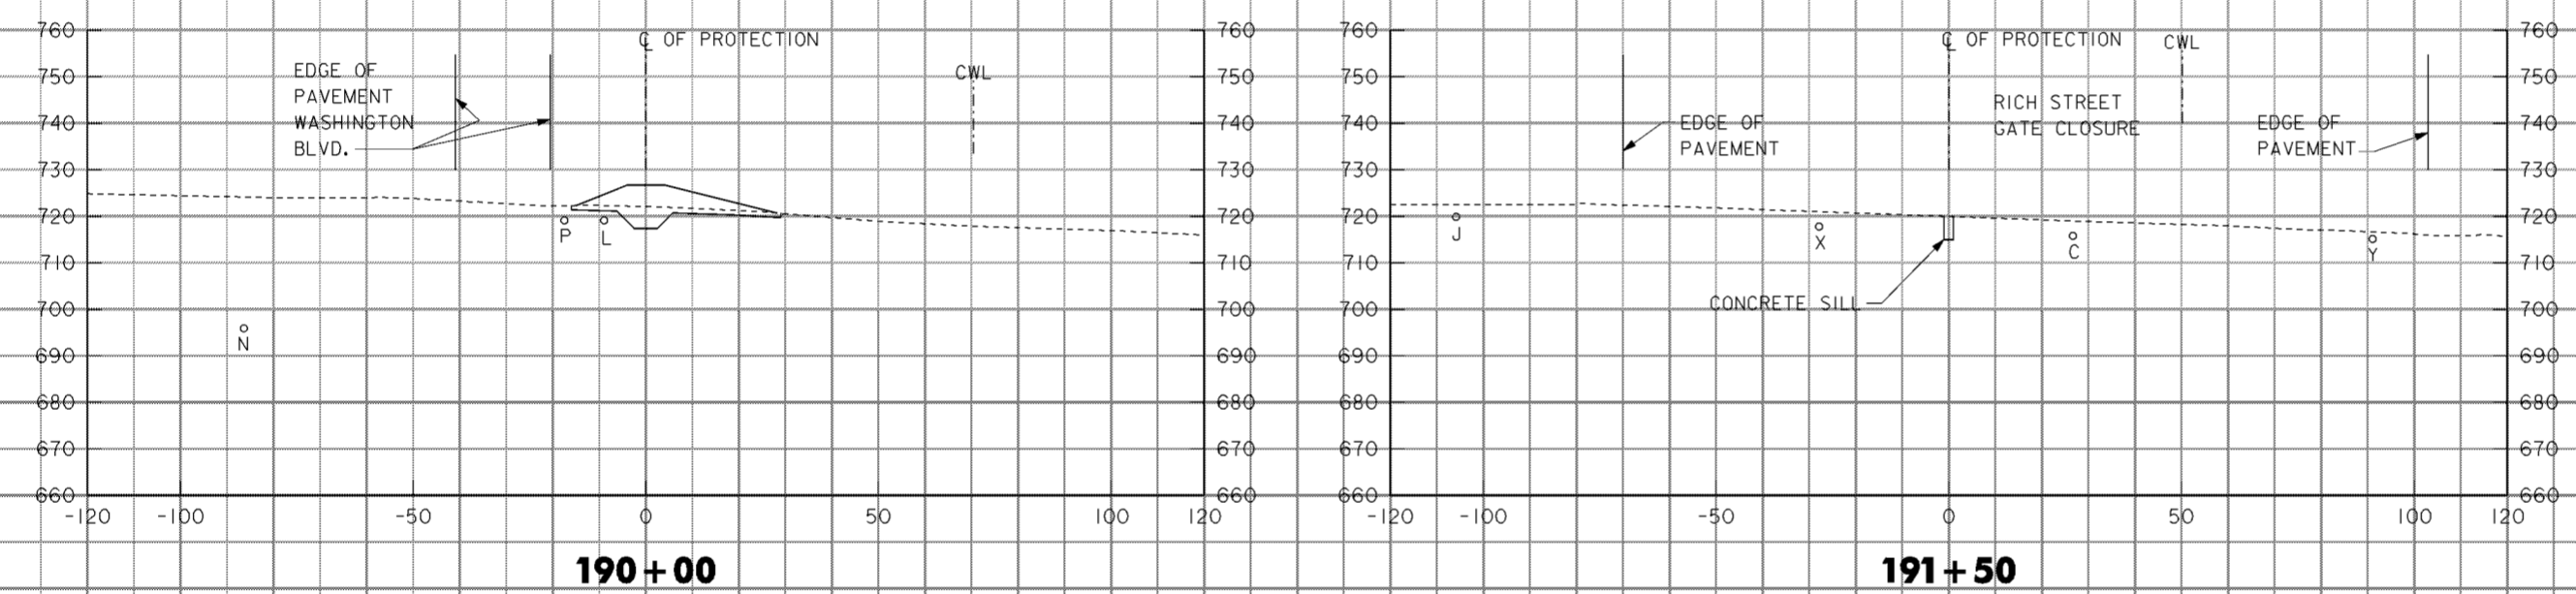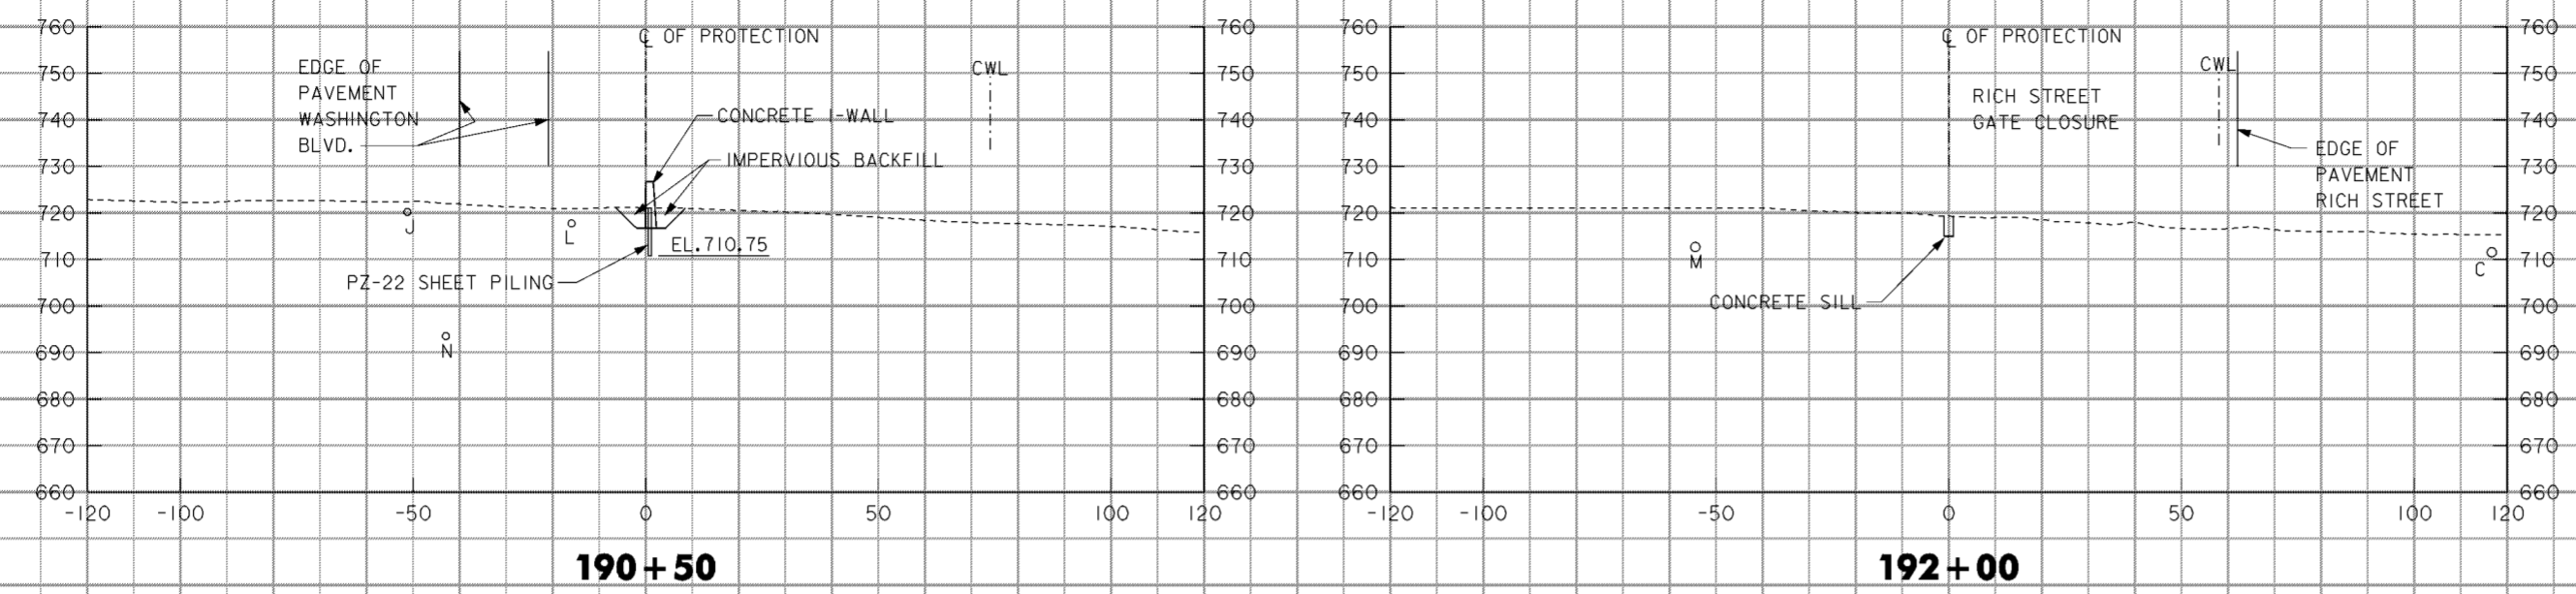

LEGEND


- A -EXISTING UNDERGROUND FIBER OPTIC
- B -EXISTING 30" RCP STORM SEWER
- C -EXISTING 8" WATERLINE
- D -NEW 30" RCP STORM SEWER
- E -NEW 24" RCP STORM SEWER
- F -EXISTING 18" RCP STORM SEWER
- G -EXISTING 10" RCP STORM SEWER
- H -EXISTING 8" RCP STORM SEWER
- I -EXISTING 15" RCP STORM SEWER
- J -EXISTING 12" RCP STORM SEWER
- K -NEW 12" RCP STORM SEWER
- L -EXISTING 12" WATERLINE
- M -EXISTING 24" RCP STORM SEWER
- N -ABANDONED SANITARY SEWER
- O -EXISTING 15" BRICK STORM SEWER
- P -EXISTING 4" RCP STORM SEWER
- Q -EXISTING 8" SANITARY SEWER
- R -EXISTING 36" WATERLINE
- S -EXISTING 72" RCP STORM SEWER
- T -EXISTING 6" WATERLINE
- U -EXISTING TELEPHONE LINE
- V -NEW 36" RCP STORM SEWER
- W -NEW 8" WATERLINE
- X -EXISTING 12" GAS LINE
- Y -EXISTING 6" GAS LINE
- Z -NEW 10" AND 36" SANITARY FORCE MAIN

NOTES

1. FOR TYPICAL LEVEE SECTIONS SEE DRAWING NO. 20.3/2.
2. FOR CONCRETE I-WALL TYPICAL SECTIONS SEE DRAWING NO. 20.3/2.
3. FOR CWL AND LWL SEE DRAWING NOS. 6/1 THRU 6/4.
4. NEW FILL PLACED ON EXISTING SLOPES SHALL BE PLACED USING BENCHING IN ACCORDANCE WITH THE SPECIFICATIONS.
5. FOR STOP LOG STORAGE BUILDING SEE DRAWING NO. 20.2/16.

Revisions			
Symbol	Descriptions	Date	Approved

BURGESS & NIPLE, LIMITED COLUMBUS, OHIO	U.S. ARMY ENGINEER DISTRICT CORPS OF ENGINEERS HUNTINGTON, WEST VIRGINIA
Designed by: J.HALL Drawn by: T.MULLINS Checked by: P.CONROY Reviewed by:	SCIO TO RIVER COLUMBUS, OHIO WEST COLUMBUS, L.P.P. PHASE IID CROSS SECTIONS 192+50 TO 195+00 Scale: AS SHOWN Date: MARCH 1998 Drawing Code: 16-PWC-10-
Approved by:	Sheet reference number: 00a3a15.dgn FILENAME: 00a3a15.dgn PEN TABLE: 1,ptb 16/29 Sheet 15 of 22

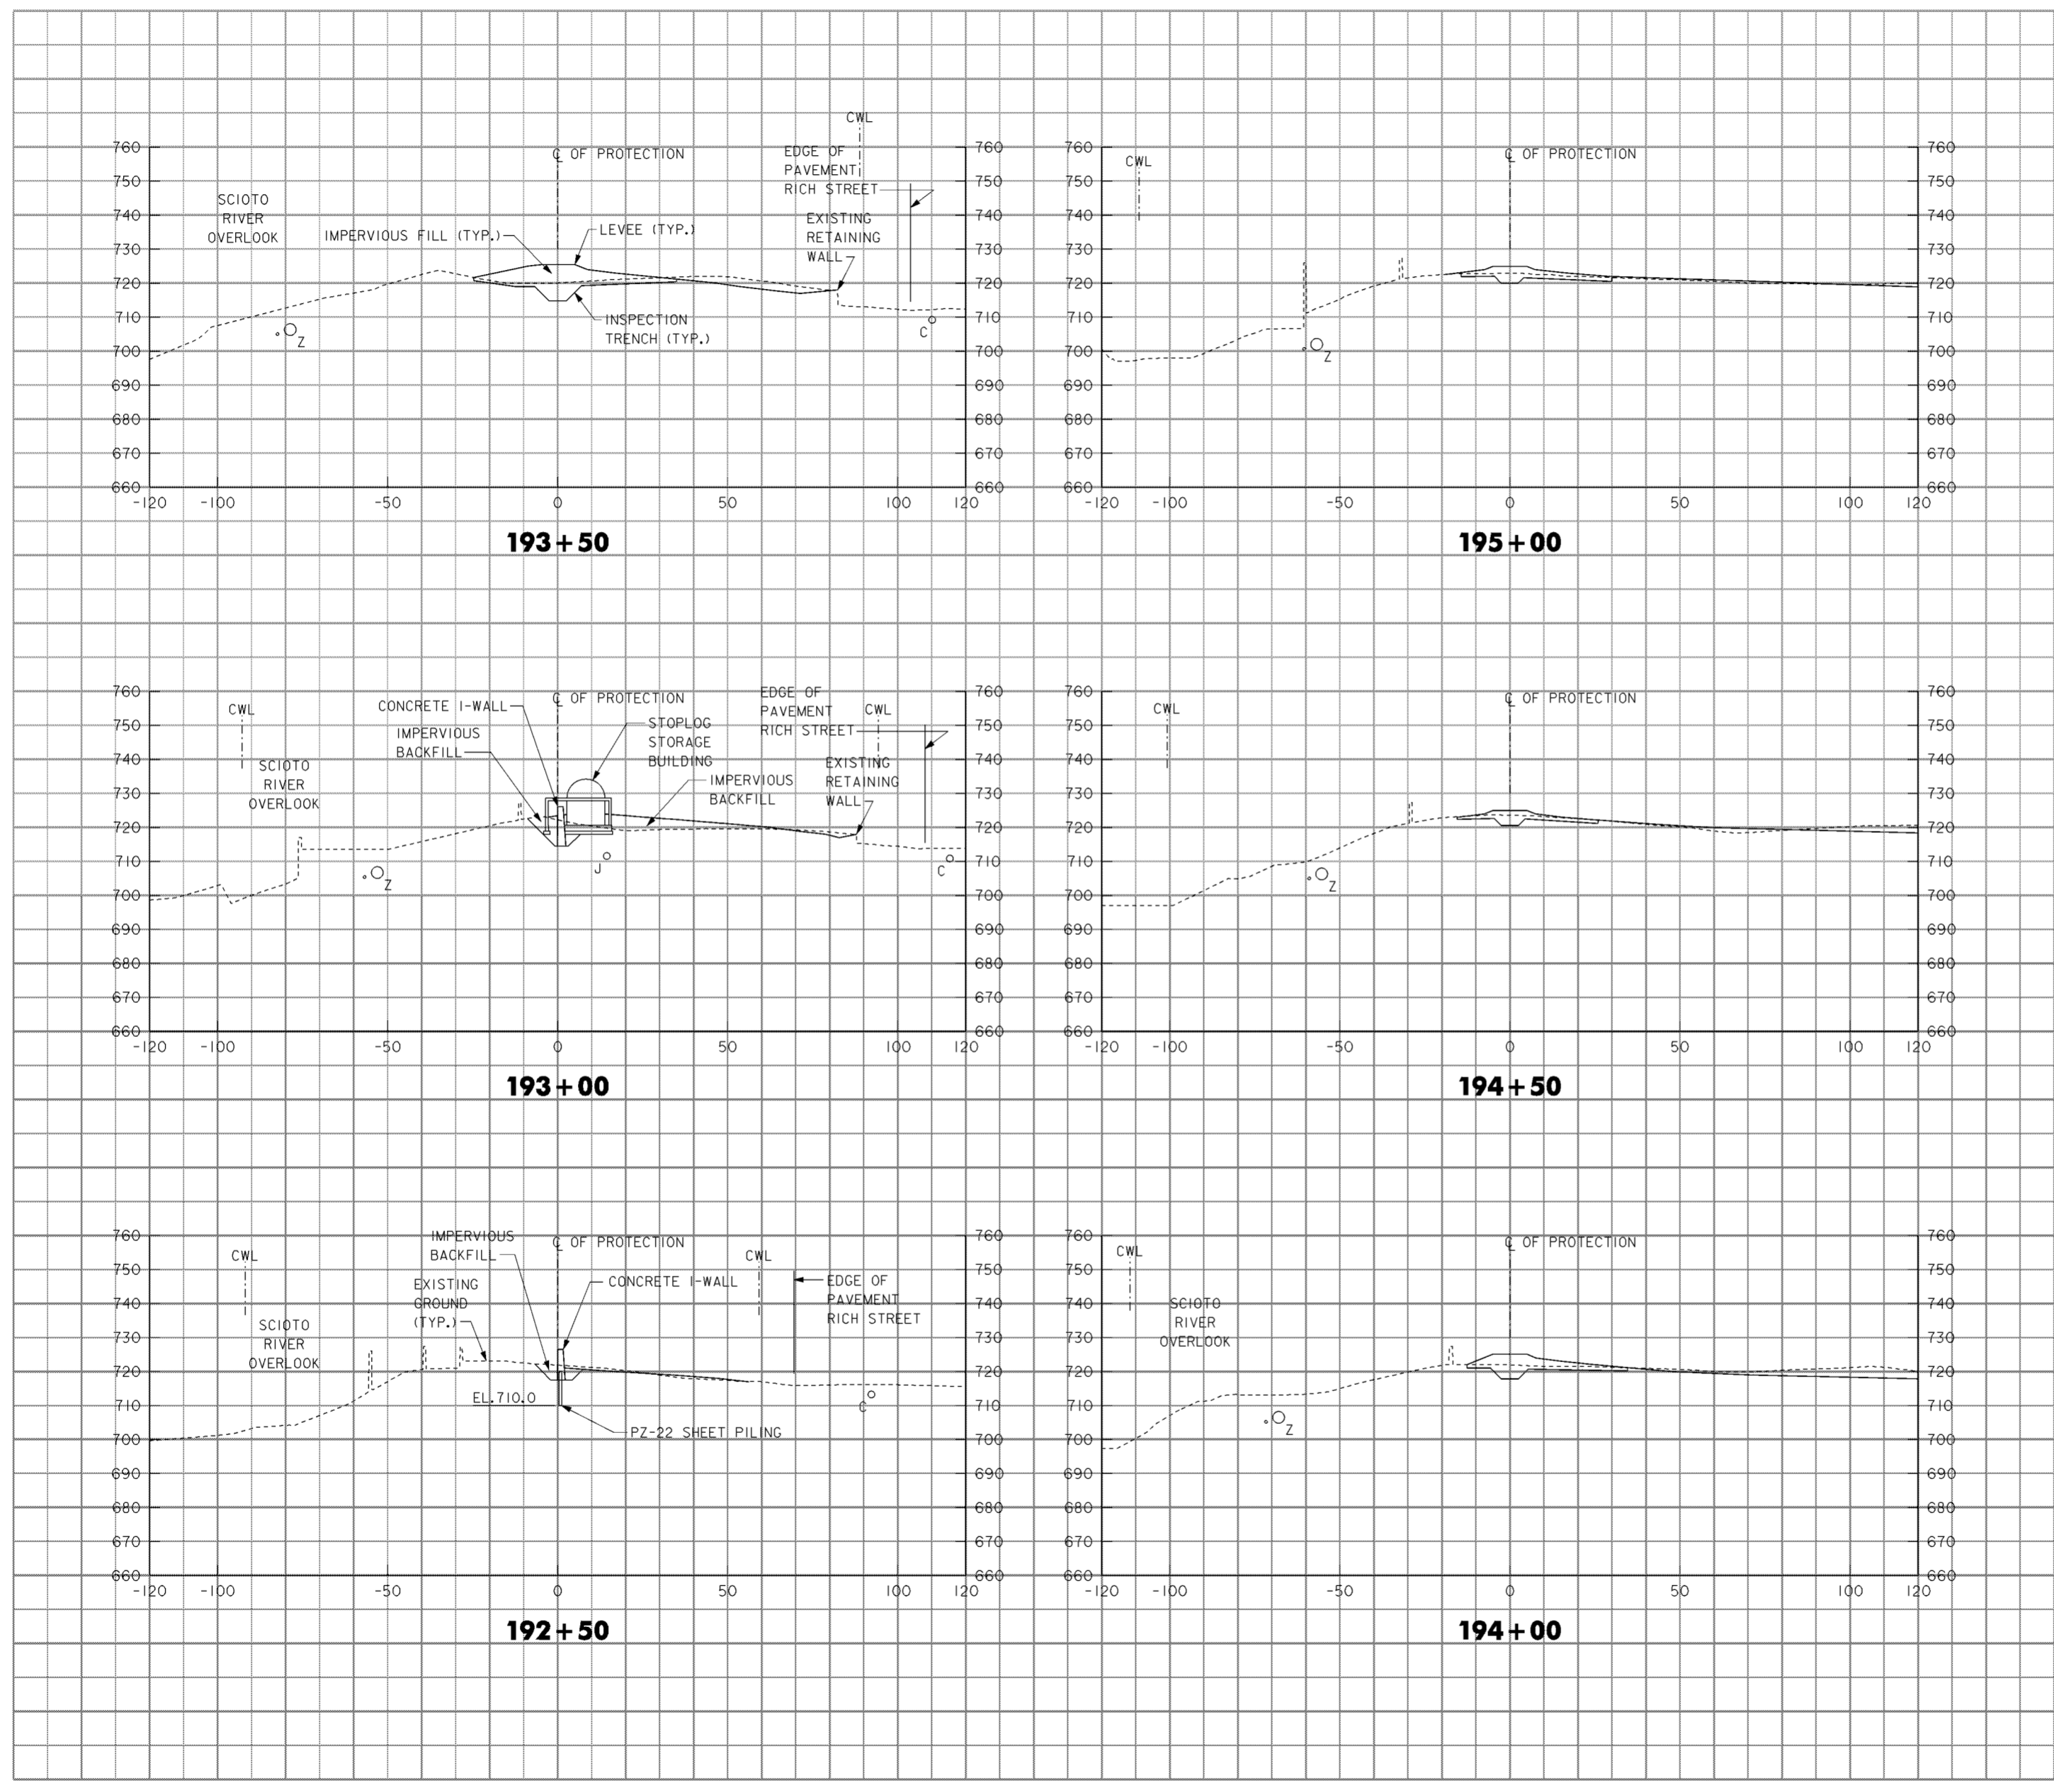

LEGEND


- A -EXISTING UNDERGROUND FIBER OPTIC
- B -EXISTING 30" RCP STORM SEWER
- C -EXISTING 8" WATERLINE
- D -NEW 30" RCP STORM SEWER
- E -NEW 24" RCP STORM SEWER
- F -EXISTING 18" RCP STORM SEWER
- G -EXISTING 10" RCP STORM SEWER
- H -EXISTING 8" RCP STORM SEWER
- I -EXISTING 15" RCP STORM SEWER
- J -EXISTING 12" RCP STORM SEWER
- K -NEW 12" RCP STORM SEWER
- L -EXISTING 12" WATERLINE
- M -EXISTING 24" RCP STORM SEWER
- N -ABANDONED SANITARY SEWER
- O -EXISTING 15" BRICK STORM SEWER
- P -EXISTING 4" RCP STORM SEWER
- Q -EXISTING 8" SANITARY SEWER
- R -EXISTING 36" WATERLINE
- S -EXISTING 72" RCP STORM SEWER
- T -EXISTING 6" WATERLINE
- U -EXISTING TELEPHONE LINE
- V -NEW 36" RCP STORM SEWER
- W -NEW 8" WATERLINE
- X -EXISTING 12" GAS LINE
- Y -EXISTING 6" GAS LINE
- Z -NEW 10" AND 36" SANITARY FORCE MAIN

NOTES

1. FOR TYPICAL LEVEE SECTIONS SEE DRAWING NO. 20.3/2.
2. FOR CONRAIL/CSX RAILROAD CLOSURE SEE DRAWING NO. 20.2/18.
3. FOR CONRAIL/CSX SHEETPILE CUTOFF SEE DRAWING NO. 20.2/20.
4. FOR CWL AND LWL SEE DRAWING NOS. 6/1 THRU 6/4.
5. NEW FILL PLACED ON EXISTING SLOPES SHALL BE PLACED USING BENCHING IN ACCORDANCE WITH THE SPECIFICATIONS.

Revisions			
Symbol	Descriptions	Date	Approved

BURGESS & NIPLE, LIMITED COLUMBUS, OHIO	U.S. ARMY ENGINEER DISTRICT CORPS OF ENGINEERS HUNTINGTON, WEST VIRGINIA
Designed by: J. HALL	SCIO TO RIVER COLUMBUS, OHIO WEST COLUMBUS, L.P.P. PHASE IID
Drawn by: T. MULLINS	CROSS SECTIONS 195 + 50 TO 198 + 00
Checked by: P. CONROY	Scale: AS SHOWN
Reviewed by:	Sheet reference number: 1630
Approved by:	FILENAME: 00a3a16.dgn PEN TABLE: 6.pfb 1.pfb Sheet 16 of 22
Date: MARCH 1998	Drawing Code: 16-PWC-10-

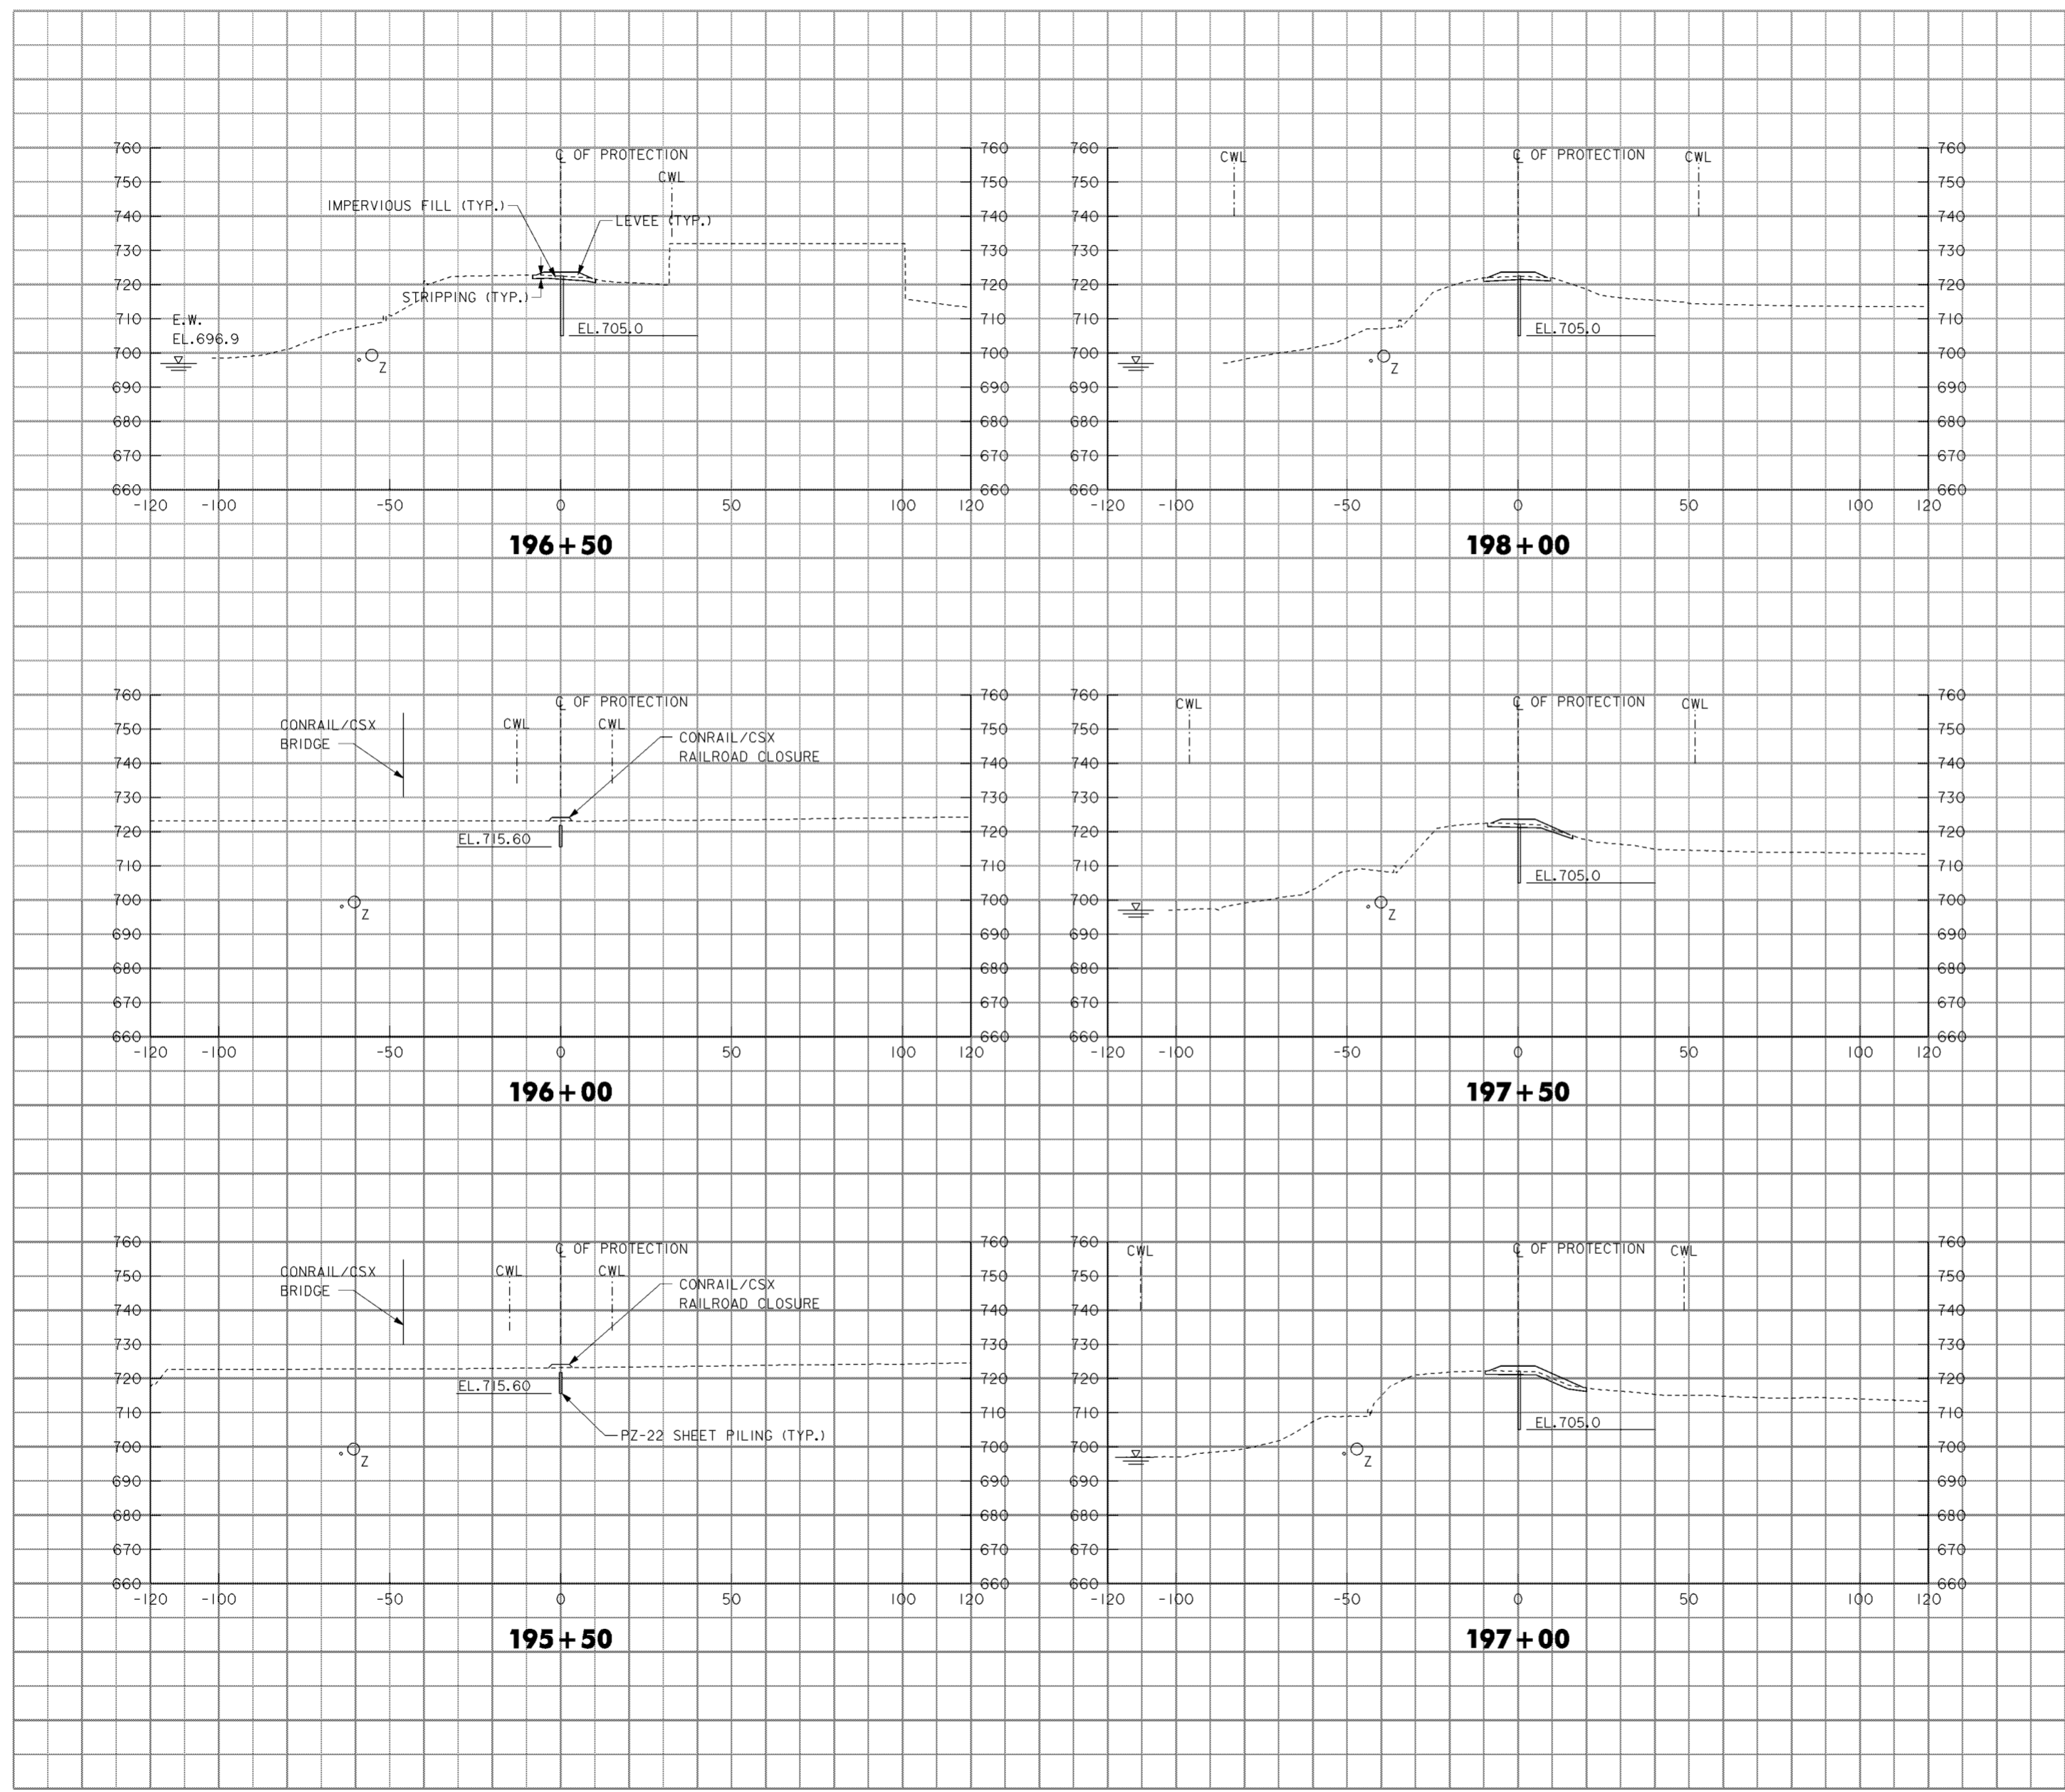

LEGEND

- A -EXISTING UNDERGROUND FIBER OPTIC
- B -EXISTING 30" RCP STORM SEWER
- C -EXISTING 8" WATERLINE
- D -NEW 30" RCP STORM SEWER
- E -NEW 24" RCP STORM SEWER
- F -EXISTING 18" RCP STORM SEWER
- G -EXISTING 10" RCP STORM SEWER
- H -EXISTING 8" RCP STORM SEWER
- I -EXISTING 15" RCP STORM SEWER
- J -EXISTING 12" RCP STORM SEWER
- K -NEW 12" RCP STORM SEWER
- L -EXISTING 12" WATERLINE
- M -EXISTING 24" RCP STORM SEWER
- N -ABANDONED SANITARY SEWER
- O -EXISTING 15" BRICK STORM SEWER
- P -EXISTING 4" RCP STORM SEWER
- Q -EXISTING 8" SANITARY SEWER
- R -EXISTING 36" WATERLINE
- S -EXISTING 72" RCP STORM SEWER
- T -EXISTING 6" WATERLINE
- U -EXISTING TELEPHONE LINE
- V -NEW 36" RCP STORM SEWER
- W -NEW 8" WATERLINE
- X -EXISTING 12" GAS LINE
- Y -EXISTING 6" GAS LINE
- Z -NEW 10" AND 36" SANITARY FORCE MAIN


NOTES

1. FOR TYPICAL LEVEE SECTIONS SEE DRAWING NO. 20.3/2.
2. FOR CWL AND LWL SEE DRAWING NOS. 6/1 THRU 6/4.
3. NEW FILL PLACED ON EXISTING SLOPES SHALL BE PLACED USING BENCHING IN ACCORDANCE WITH THE SPECIFICATIONS.

Revisions			
Symbol	Descriptions	Date	Approved

BURGESS & NIPLE, LIMITED COLUMBUS, OHIO	U.S. ARMY ENGINEER DISTRICT CORPS OF ENGINEERS HUNTINGTON, WEST VIRGINIA
Designed by: J. HALL	SCIO TO RIVER COLUMBUS, OHIO WEST COLUMBUS, L.P.P. PHASE IID
Drawn by: T. MULLINS	CROSS SECTIONS 198+50 TO 201+00
Checked by: P. CONROY	Scale: AS SHOWN
Reviewed by:	Sheet reference number: 16/31
Approved by:	FILENAME: 00c3x17.dgn Date: MARCH 1998 Drawing Code: 16-PWC-10-

WORK AS CONSTRUCTED

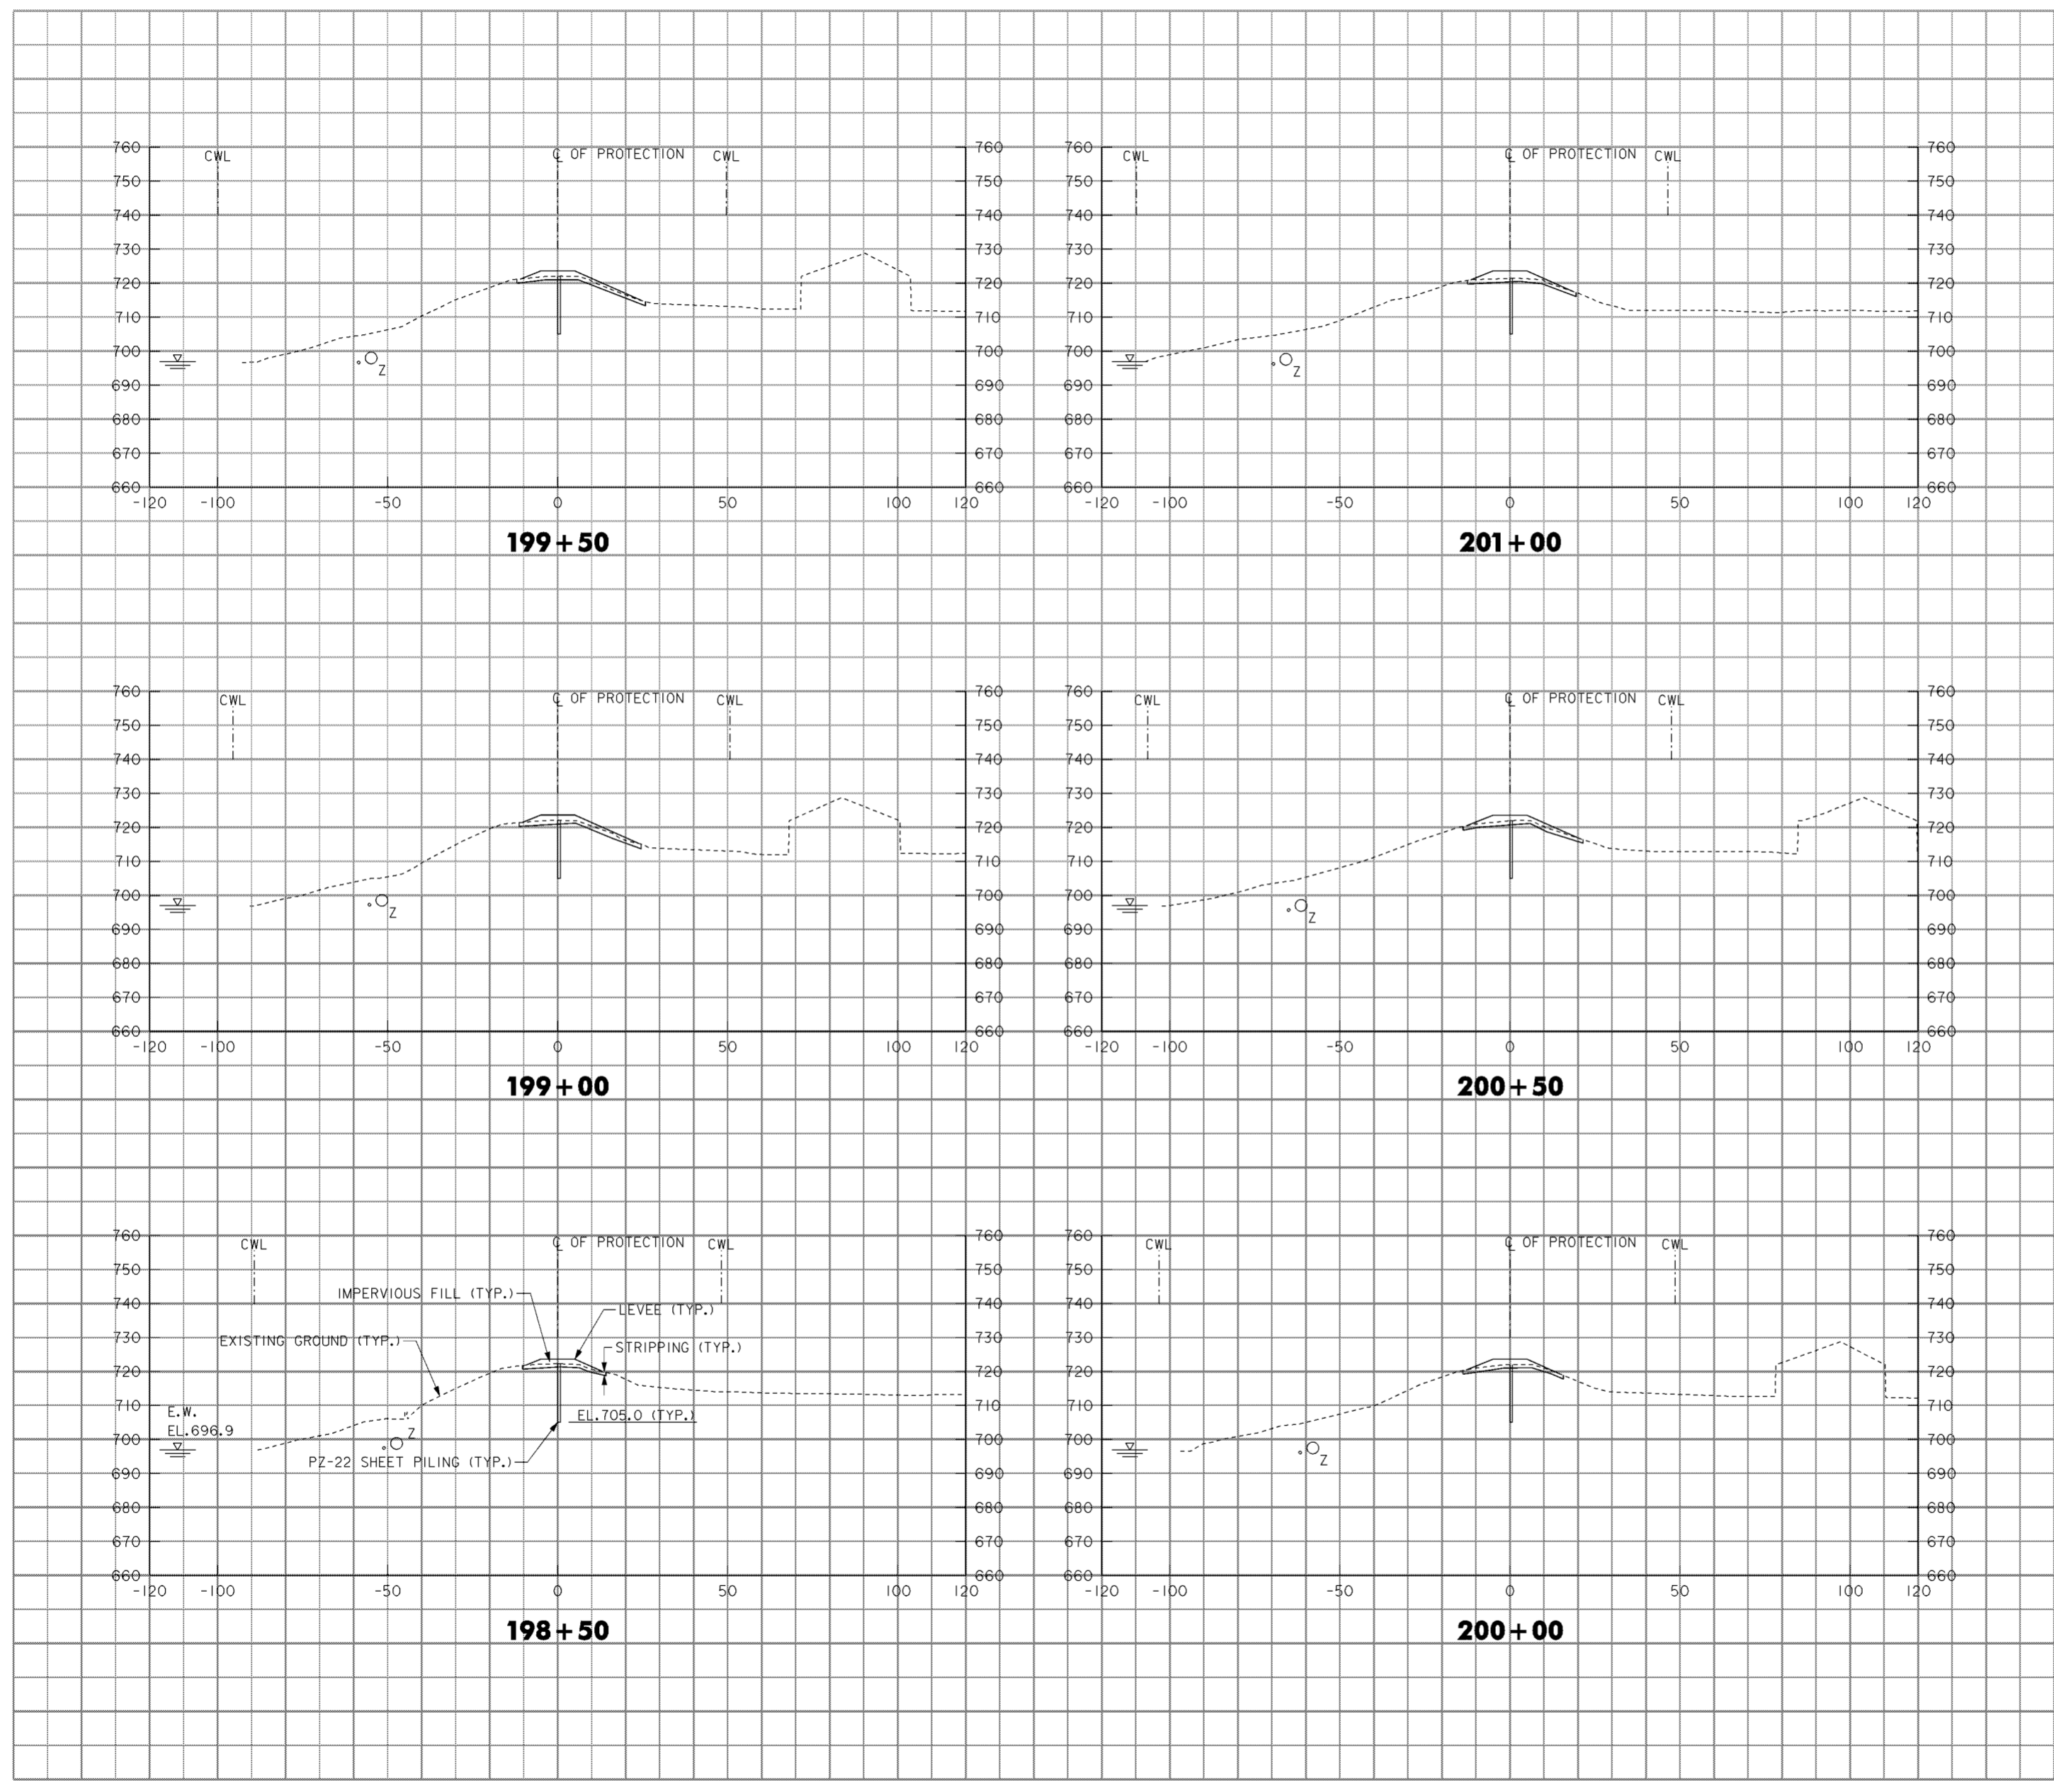

LEGEND


- A -EXISTING UNDERGROUND FIBER OPTIC
- B -EXISTING 30" RCP STORM SEWER
- C -EXISTING 8" WATERLINE
- D -NEW 30" RCP STORM SEWER
- E -NEW 24" RCP STORM SEWER
- F -EXISTING 18" RCP STORM SEWER
- G -EXISTING 10" RCP STORM SEWER
- H -EXISTING 8" RCP STORM SEWER
- I -EXISTING 15" RCP STORM SEWER
- J -EXISTING 12" RCP STORM SEWER
- K -NEW 12" RCP STORM SEWER
- L -EXISTING 12" WATERLINE
- M -EXISTING 24" RCP STORM SEWER
- N -ABANDONED SANITARY SEWER
- O -EXISTING 15" BRICK STORM SEWER
- P -EXISTING 4" RCP STORM SEWER
- Q -EXISTING 8" SANITARY SEWER
- R -EXISTING 36" WATERLINE
- S -EXISTING 72" RCP STORM SEWER
- T -EXISTING 6" WATERLINE
- U -EXISTING TELEPHONE LINE
- V -NEW 36" RCP STORM SEWER
- W -NEW 8" WATERLINE
- X -EXISTING 12" GAS LINE
- Y -EXISTING 6" GAS LINE
- Z -NEW 10" AND 36" SANITARY FORCE MAIN

NOTES

1. FOR TYPICAL LEVEE SECTIONS SEE DRAWING NO. 20.3/2.
2. FOR CWL AND LWL SEE DRAWING NOS. 6/1 THRU 6/4.
3. FOR SCIOTO RIVER WALKWAY SEE DRAWING NOS. 20.5/2 THRU 20.5/4.
4. NEW FILL PLACED ON EXISTING SLOPES SHALL BE PLACED USING BENCHING IN ACCORDANCE WITH THE SPECIFICATIONS.

Revisions			
Symbol	Descriptions	Date	Approved

BURGESS & NIPLE, LIMITED COLUMBUS, OHIO	U.S. ARMY ENGINEER DISTRICT CORPS OF ENGINEERS HUNTINGTON, WEST VIRGINIA	SCIOTO RIVER COLUMBUS, OHIO WEST COLUMBUS, L.P.P. PHASE IID CROSS SECTIONS 201 + 50 TO 204 + 00
Designed by: J. HALL	Drawn by: T. MULLINS	
Checked by: P. CONROY	Reviewed by:	
Approved by:	Scale: AS SHOWN	Sheet reference number: 1632
	Date: MARCH 1998	FILENAME: 00c3x18.dgn
	Drawing Code: 16-PWC-10-	PEN TABLE: b.pfb l.pfb
		Sheet 18 of 22

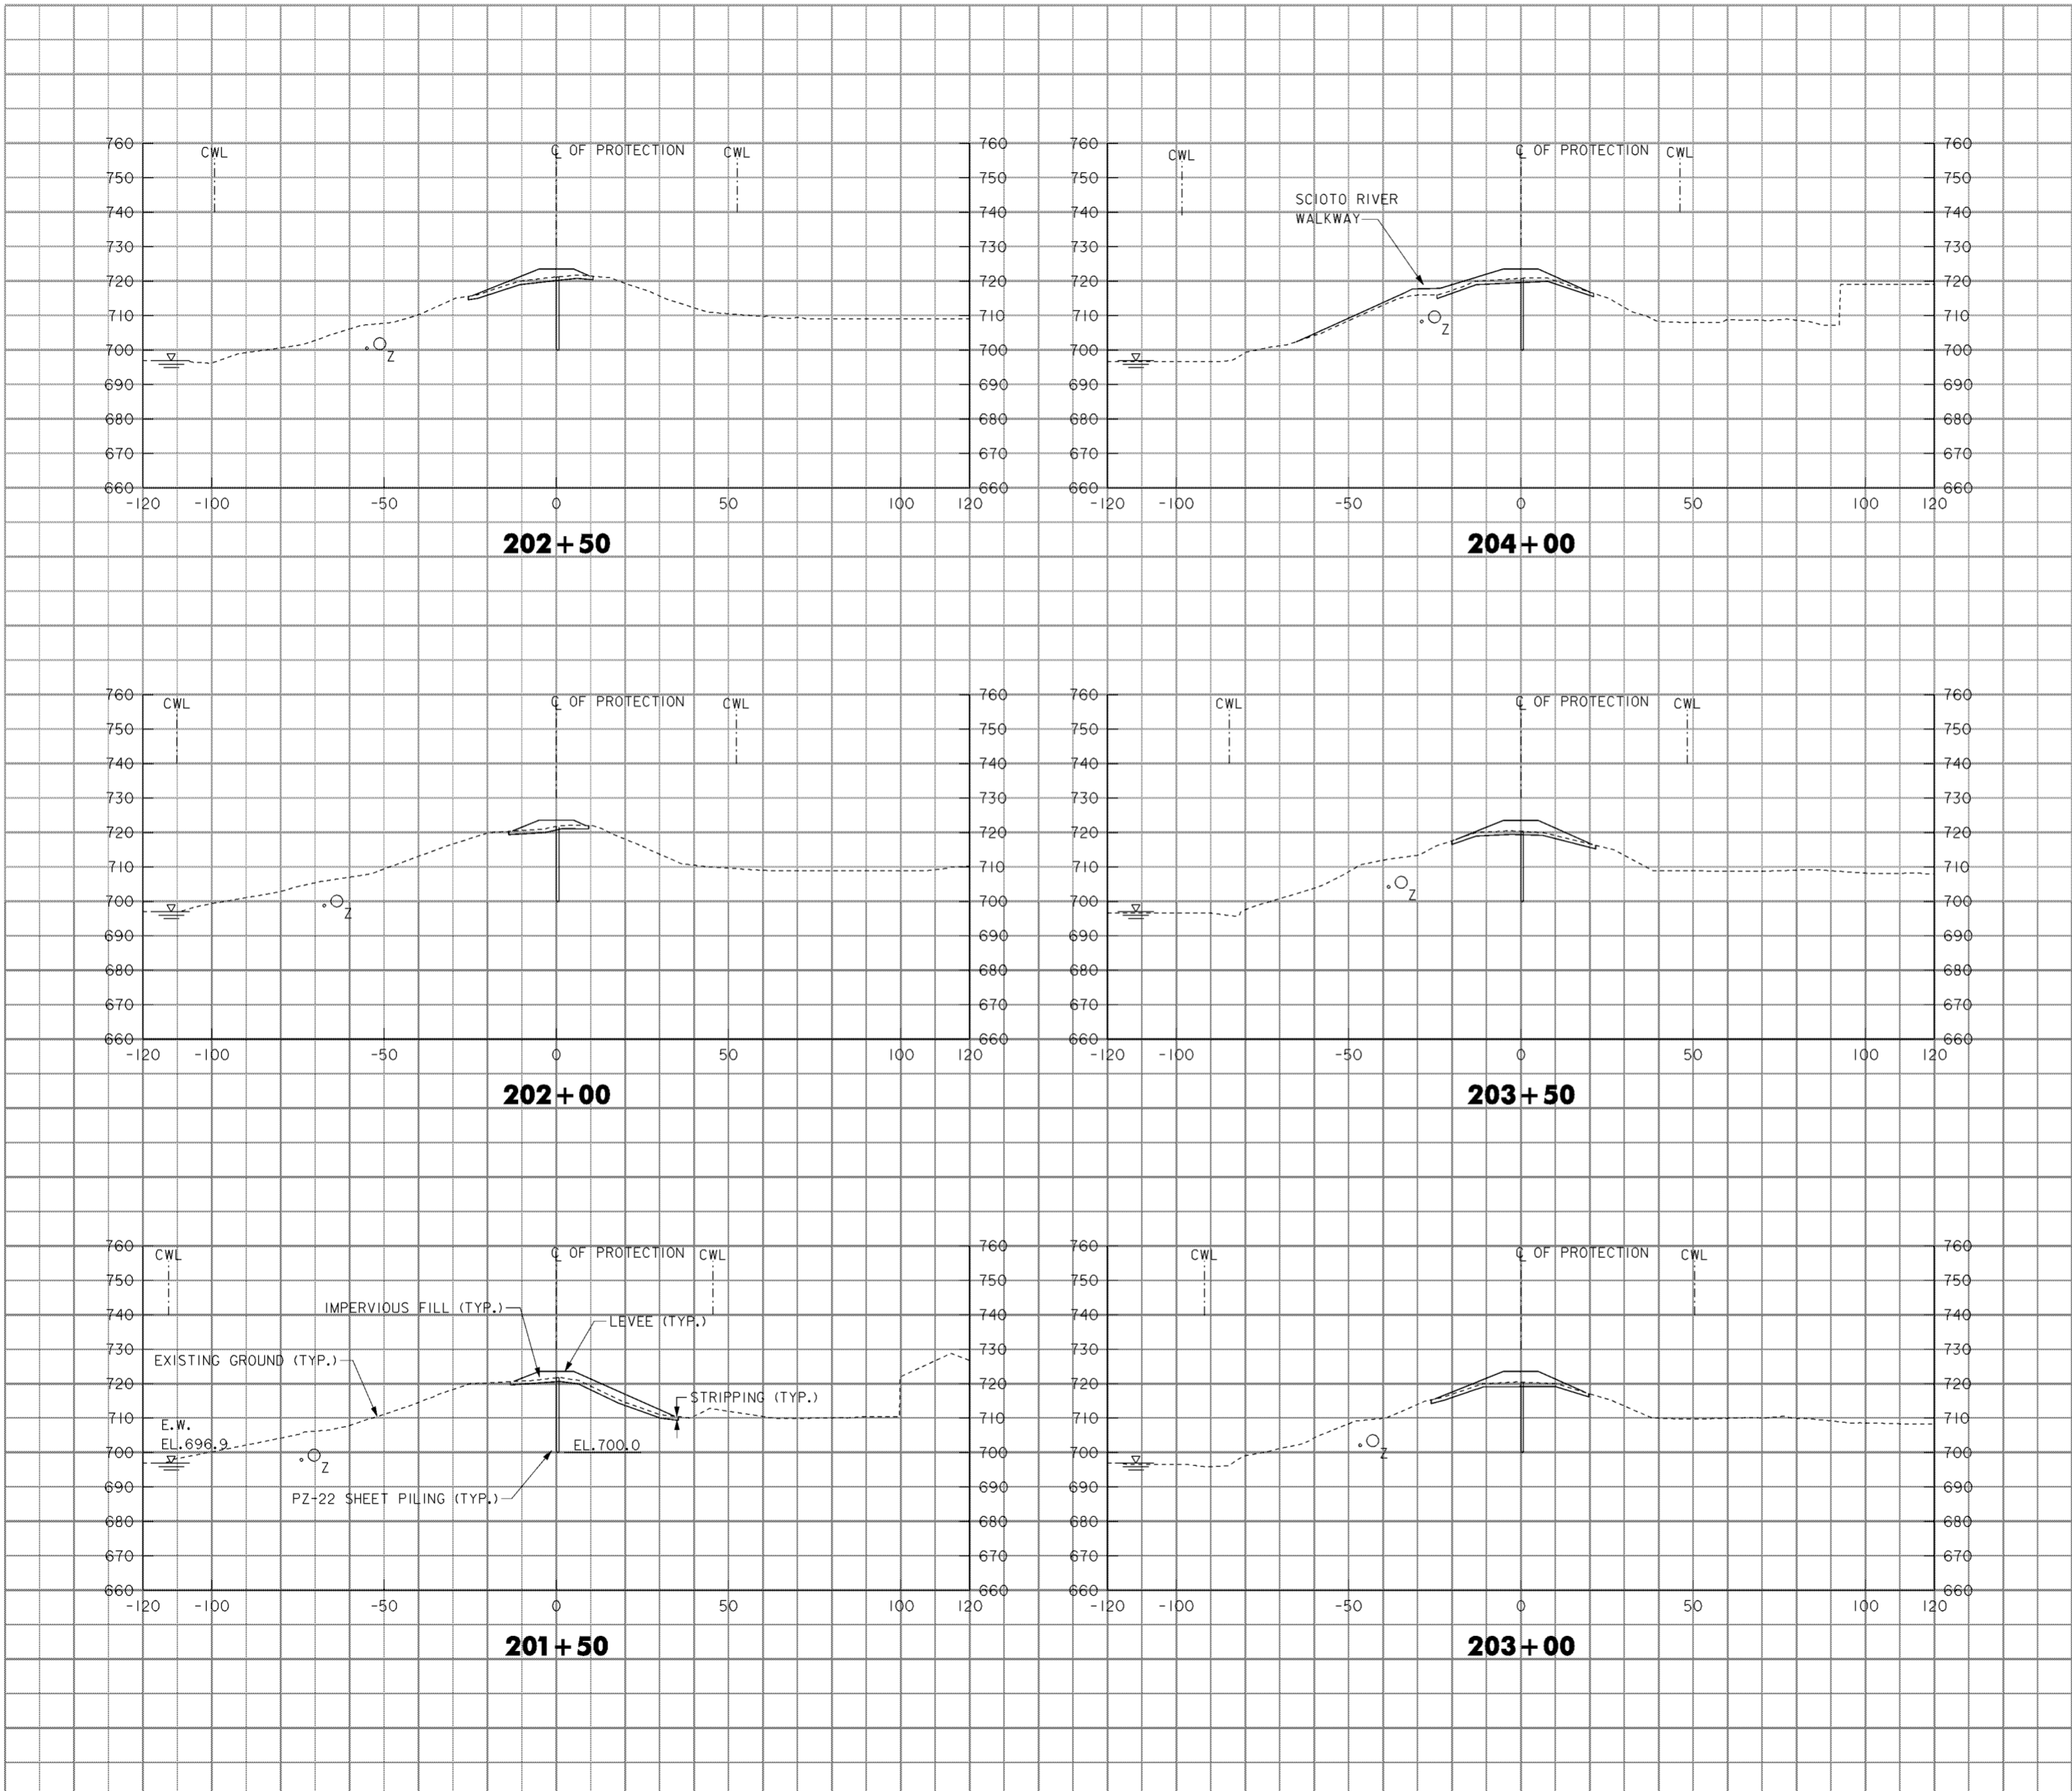


LEGEND

- A -EXISTING UNDERGROUND FIBER OPTIC
- B -EXISTING 30" RCP STORM SEWER
- C -EXISTING 8" WATERLINE
- D -NEW 30" RCP STORM SEWER
- E -NEW 24" RCP STORM SEWER
- F -EXISTING 18" RCP STORM SEWER
- G -EXISTING 10" RCP STORM SEWER
- H -EXISTING 8" RCP STORM SEWER
- I -EXISTING 15" RCP STORM SEWER
- J -EXISTING 12" RCP STORM SEWER
- K -NEW 12" RCP STORM SEWER
- L -EXISTING 12" WATERLINE
- M -EXISTING 24" RCP STORM SEWER
- N -ABANDONED SANITARY SEWER
- O -EXISTING 15" BRICK STORM SEWER
- P -EXISTING 4" RCP STORM SEWER
- Q -EXISTING 8" SANITARY SEWER
- R -EXISTING 36" WATERLINE
- S -EXISTING 72" RCP STORM SEWER
- T -EXISTING 6" WATERLINE
- U -EXISTING TELEPHONE LINE
- V -NEW 36" RCP STORM SEWER
- W -NEW 8" WATERLINE
- X -EXISTING 12" GAS LINE
- Y -EXISTING 6" GAS LINE
- Z -NEW 10" AND 36" SANITARY FORCE MAIN

NOTES

1. FOR CONCRETE CAP SEE DRAWING NO. 20.3/2.
2. FOR CWL AND LWL SEE DRAWING NOS. 6/1 THRU 6/4.
3. FOR DODGE PARK RIVERBANK TREATMENT TYPICAL SECTION SEE DRAWING NO.20.2/25.
4. NEW FILL PLACED ON EXISTING SLOPES SHALL BE PLACED USING BENCHING IN ACCORDANCE WITH THE SPECIFICATIONS.

Revisions			
Symbol	Descriptions	Date	Approved
REV. BY CONTRACT MODIFICATION LETTER MC002 11/98 P.O.C.			
BURGESS & NIPLE, LIMITED COLUMBUS, OHIO		U.S. ARMY ENGINEER DISTRICT CORPS OF ENGINEERS HUNTINGTON, WEST VIRGINIA	
Designed by: J. HALL	SCIOTO RIVER COLUMBUS, OHIO WEST COLUMBUS, L.P.P. PHASE IID		
Drawn by: T. MULLINS	CROSS SECTIONS 207+50 TO 210+00		
Checked by: P. CONROY	Scale: AS SHOWN	Sheet reference number: 16/34	FILENAME: 00a3x20.dgn
Reviewed by: _____	Date: MARCH 1998	Drawing Code: 16-PWC-10-	
Approved by: _____	Sheet 20 of 22		

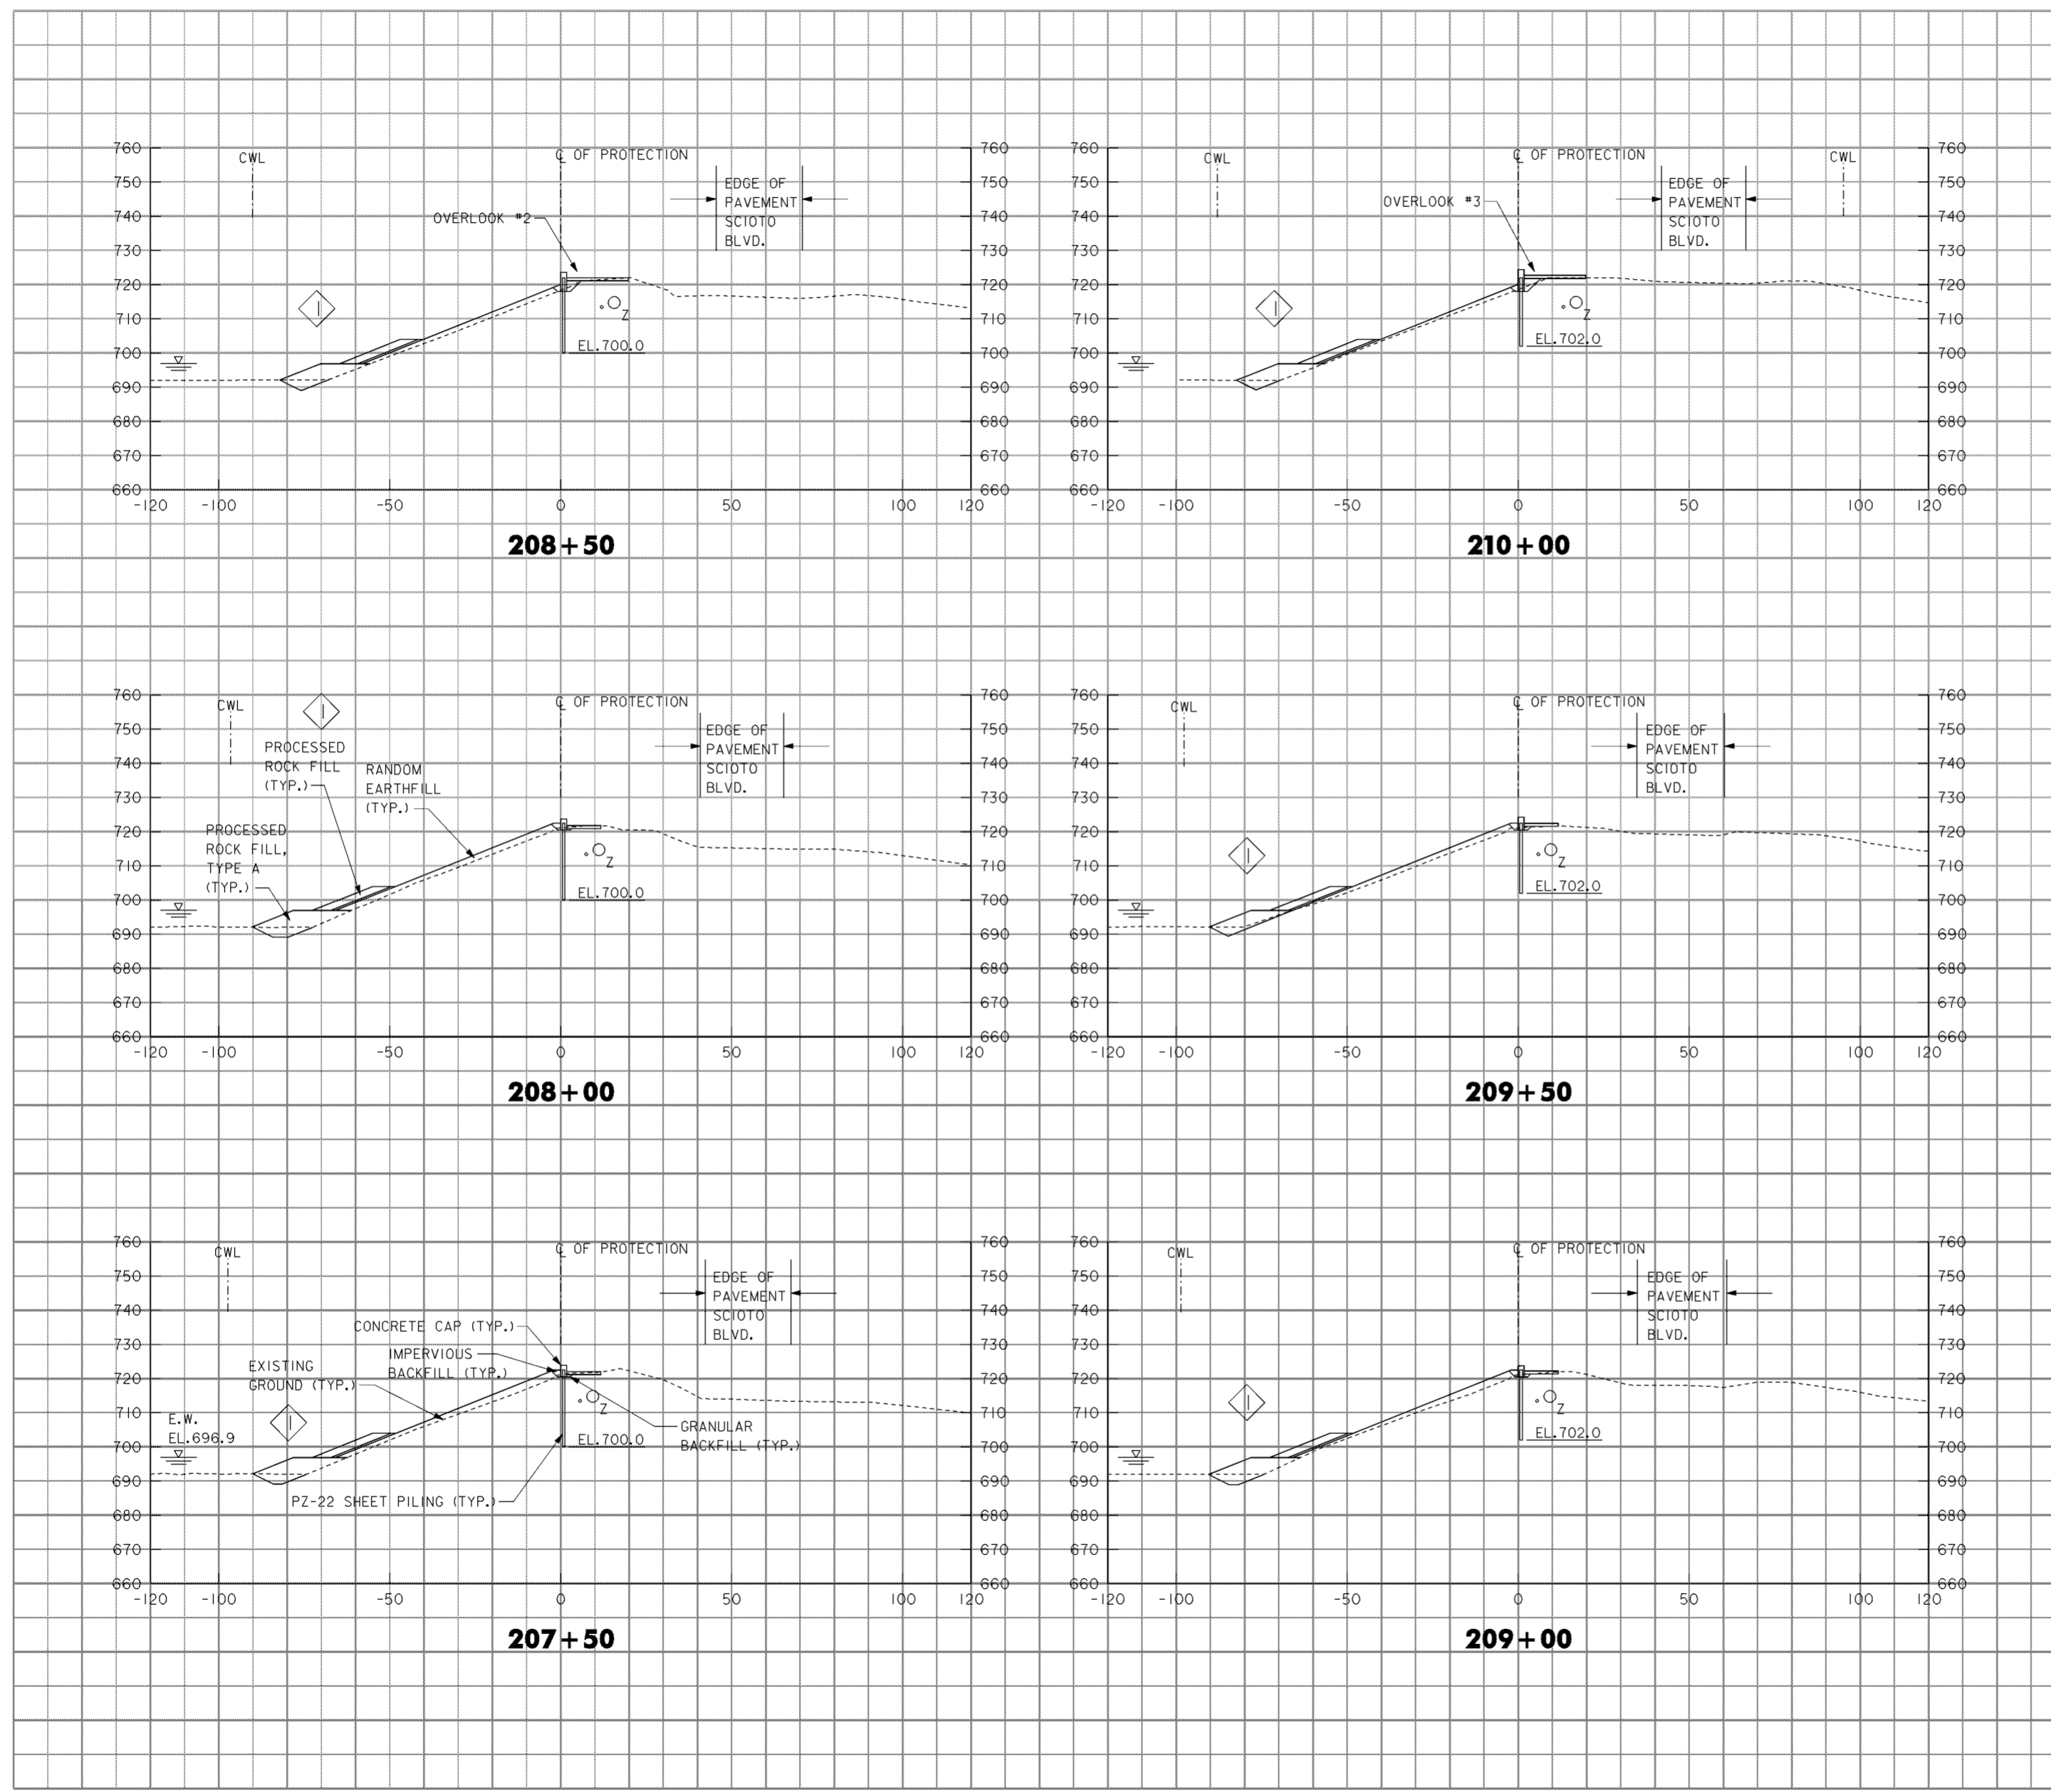

WORK AS CONSTRUCTED


LEGEND

- A - EXISTING UNDERGROUND FIBER OPTIC
- B - EXISTING 30" RCP STORM SEWER
- C - EXISTING 8" WATERLINE
- D - NEW 30" RCP STORM SEWER
- E - NEW 24" RCP STORM SEWER
- F - EXISTING 18" RCP STORM SEWER
- G - EXISTING 10" RCP STORM SEWER
- H - EXISTING 8" RCP STORM SEWER
- I - EXISTING 15" RCP STORM SEWER
- J - EXISTING 12" RCP STORM SEWER
- K - NEW 12" RCP STORM SEWER
- L - EXISTING 12" WATERLINE
- M - EXISTING 24" RCP STORM SEWER
- N - ABANDONED SANITARY SEWER
- O - EXISTING 15" BRICK STORM SEWER
- P - EXISTING 4" RCP STORM SEWER
- Q - EXISTING 8" SANITARY SEWER
- R - EXISTING 36" WATERLINE
- S - EXISTING 72" RCP STORM SEWER
- T - EXISTING 6" WATERLINE
- U - EXISTING TELEPHONE LINE
- V - NEW 36" RCP STORM SEWER
- W - NEW 8" WATERLINE
- X - EXISTING 12" GAS LINE
- Y - EXISTING 6" GAS LINE
- Z - NEW 10" AND 36" SANITARY FORCE MAIN

NOTES

1. FOR CONCRETE CAP SEE DRAWING NO. 20.3/2.
2. FOR CWL AND LWL SEE DRAWING NOS. 6/1 THRU 6/4.
3. FOR DODGE PARK RIVERBANK TREATMENT TYPICAL SECTION SEE DRAWING NO.20.2/25.
4. NEW FILL PLACED ON EXISTING SLOPES SHALL BE PLACED USING BENCHING IN ACCORDANCE WITH THE SPECIFICATIONS.

Revisions			
Symbol	Descriptions	Date	Approved
REV. BY CONTRACT MODIFICATION LETTER MC002 11/98 P.O.C.			
BURGESS & NIPLE, LIMITED COLUMBUS, OHIO		U.S. ARMY ENGINEER DISTRICT CORPS OF ENGINEERS HUNTINGTON, WEST VIRGINIA	
Designed by: J. HALL	SCIOTO RIVER COLUMBUS, OHIO WEST COLUMBUS, L.P.P. PHASE IID		
Drawn by: T. MULLINS	CROSS SECTIONS 213+50 TO 215+82.37		
Checked by: P. CONROY	Scale: AS SHOWN	Sheet reference number: 1636	FILENAME: 00a5x22.dgn
Reviewed by: _____	Date: MARCH 1998	Drawing Code: 16-PWC-10-	
Approved by: _____	Sheet 22 of 22		

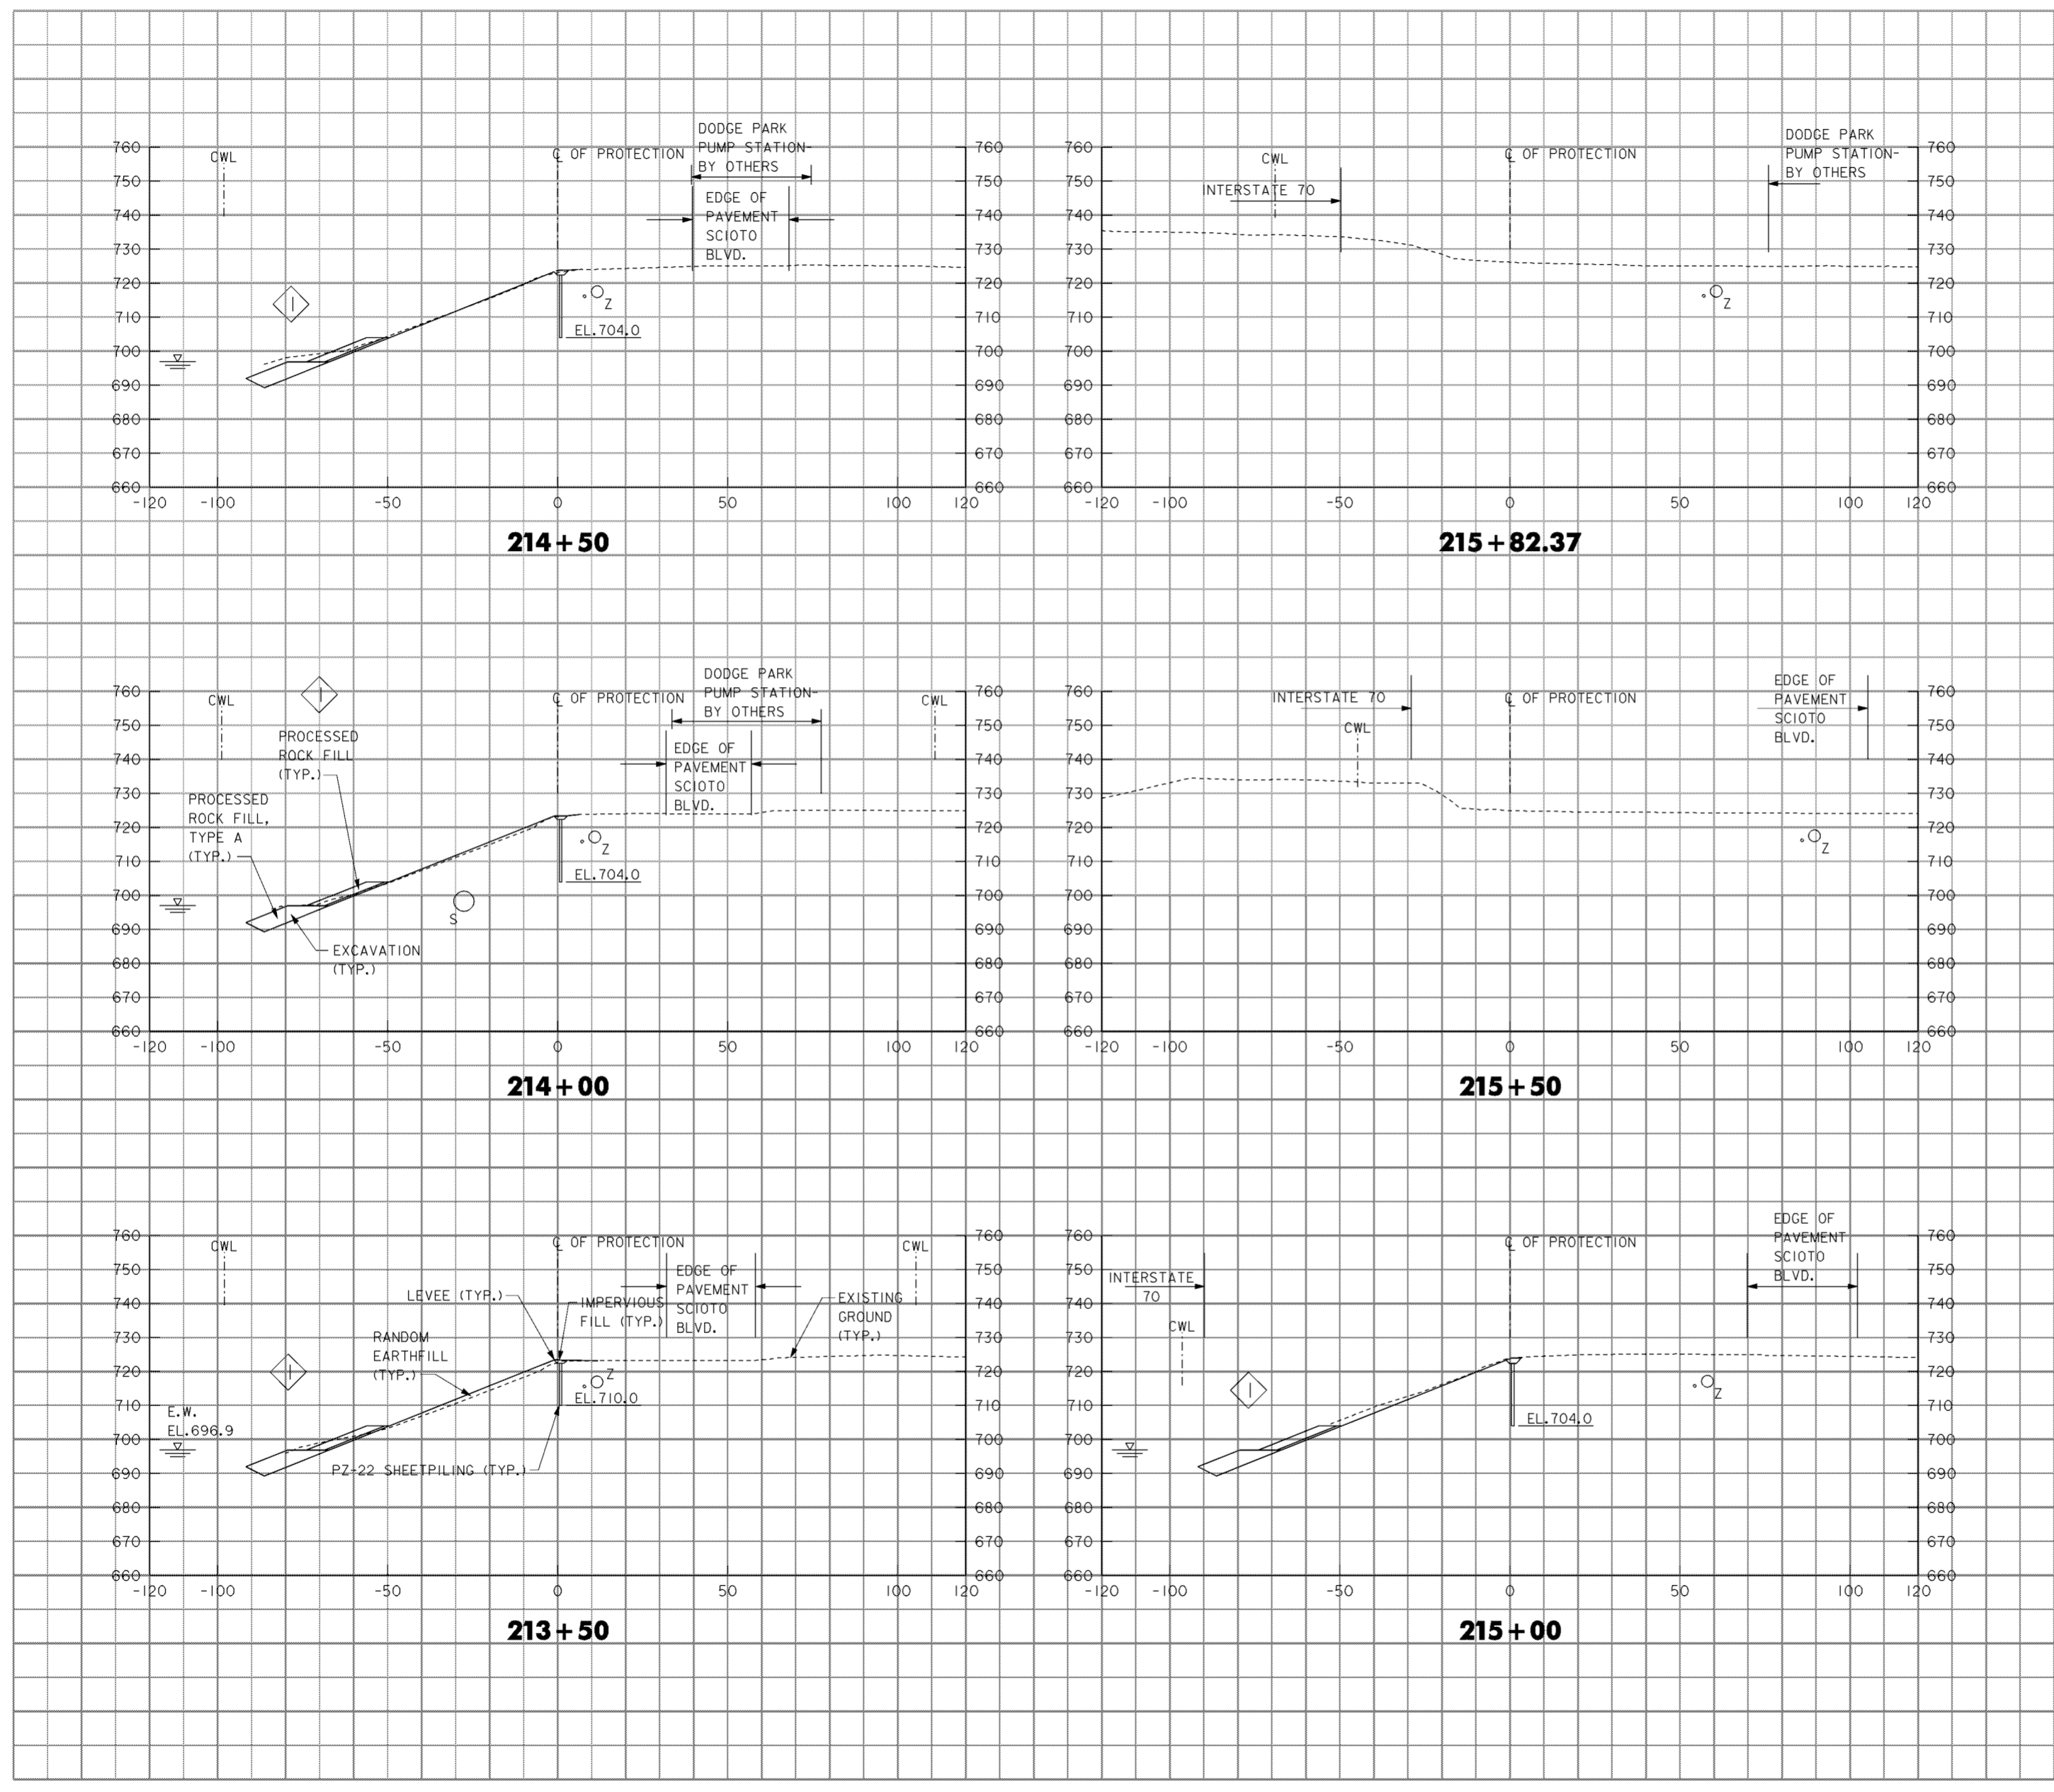

WORK AS CONSTRUCTED

LEGEND


- A -EXISTING UNDERGROUND FIBER OPTIC
- B -EXISTING 30" RCP STORM SEWER
- C -EXISTING 8" WATERLINE
- D -NEW 30" RCP STORM SEWER
- E -NEW 24" RCP STORM SEWER
- F -EXISTING 18" RCP STORM SEWER
- G -EXISTING 10" RCP STORM SEWER
- H -EXISTING 8" RCP STORM SEWER
- I -EXISTING 15" RCP STORM SEWER
- J -EXISTING 12" RCP STORM SEWER
- K -NEW 12" RCP STORM SEWER
- L -EXISTING 12" WATERLINE
- M -EXISTING 24" RCP STORM SEWER
- N -ABANDONED SANITARY SEWER
- O -EXISTING 15" BRICK STORM SEWER
- P -EXISTING 4" RCP STORM SEWER
- Q -EXISTING 8" SANITARY SEWER
- R -EXISTING 36" WATERLINE
- S -EXISTING 72" RCP STORM SEWER
- T -EXISTING 6" WATERLINE
- U -EXISTING TELEPHONE LINE
- V -NEW 36" RCP STORM SEWER
- W -NEW 8" WATERLINE
- X -EXISTING 12" GAS LINE
- Y -EXISTING 6" GAS LINE
- Z -NEW 10" AND 36" SANITARY FORCE MAIN

NOTES

1. FOR CWL AND LWL SEE DRAWING NOS.6/1 THRU 6/4.
2. FOR RECREATIONAL TRAIL PLAN AND PROFILE SEE DRAWING NOS.16/50 AND 16/51.
3. FOR TYPICAL RECREATIONAL TRAIL SECTIONS SEE DRAWING NO.16/55.
4. FOR TYPICAL LEVEE SECTIONS SEE DRAWING NO.20.3/1.

Revisions			
Symbol	Descriptions	Date	Approved

BURGESS & NIPLE, LIMITED COLUMBUS, OHIO	U.S. ARMY ENGINEER DISTRICT CORPS OF ENGINEERS HUNTINGTON, WEST VIRGINIA
Designed by: J. HALL	SCOTO RIVER COLUMBUS, OHIO WEST COLUMBUS, L.P.P. PHASE IID
Drawn by: T. MULLINS	CROSS SECTIONS 34+40 TO 36+50
Checked by: P. CONROY	Scale: AS SHOWN
Reviewed by:	Date: MARCH 1998
Approved by:	Drawing Code: 16-PWC-10-
	Sheet reference number: 16/52
	FILENAME: PEN TABLE: 00c9z01.dgn
	Sheet 1 of 3

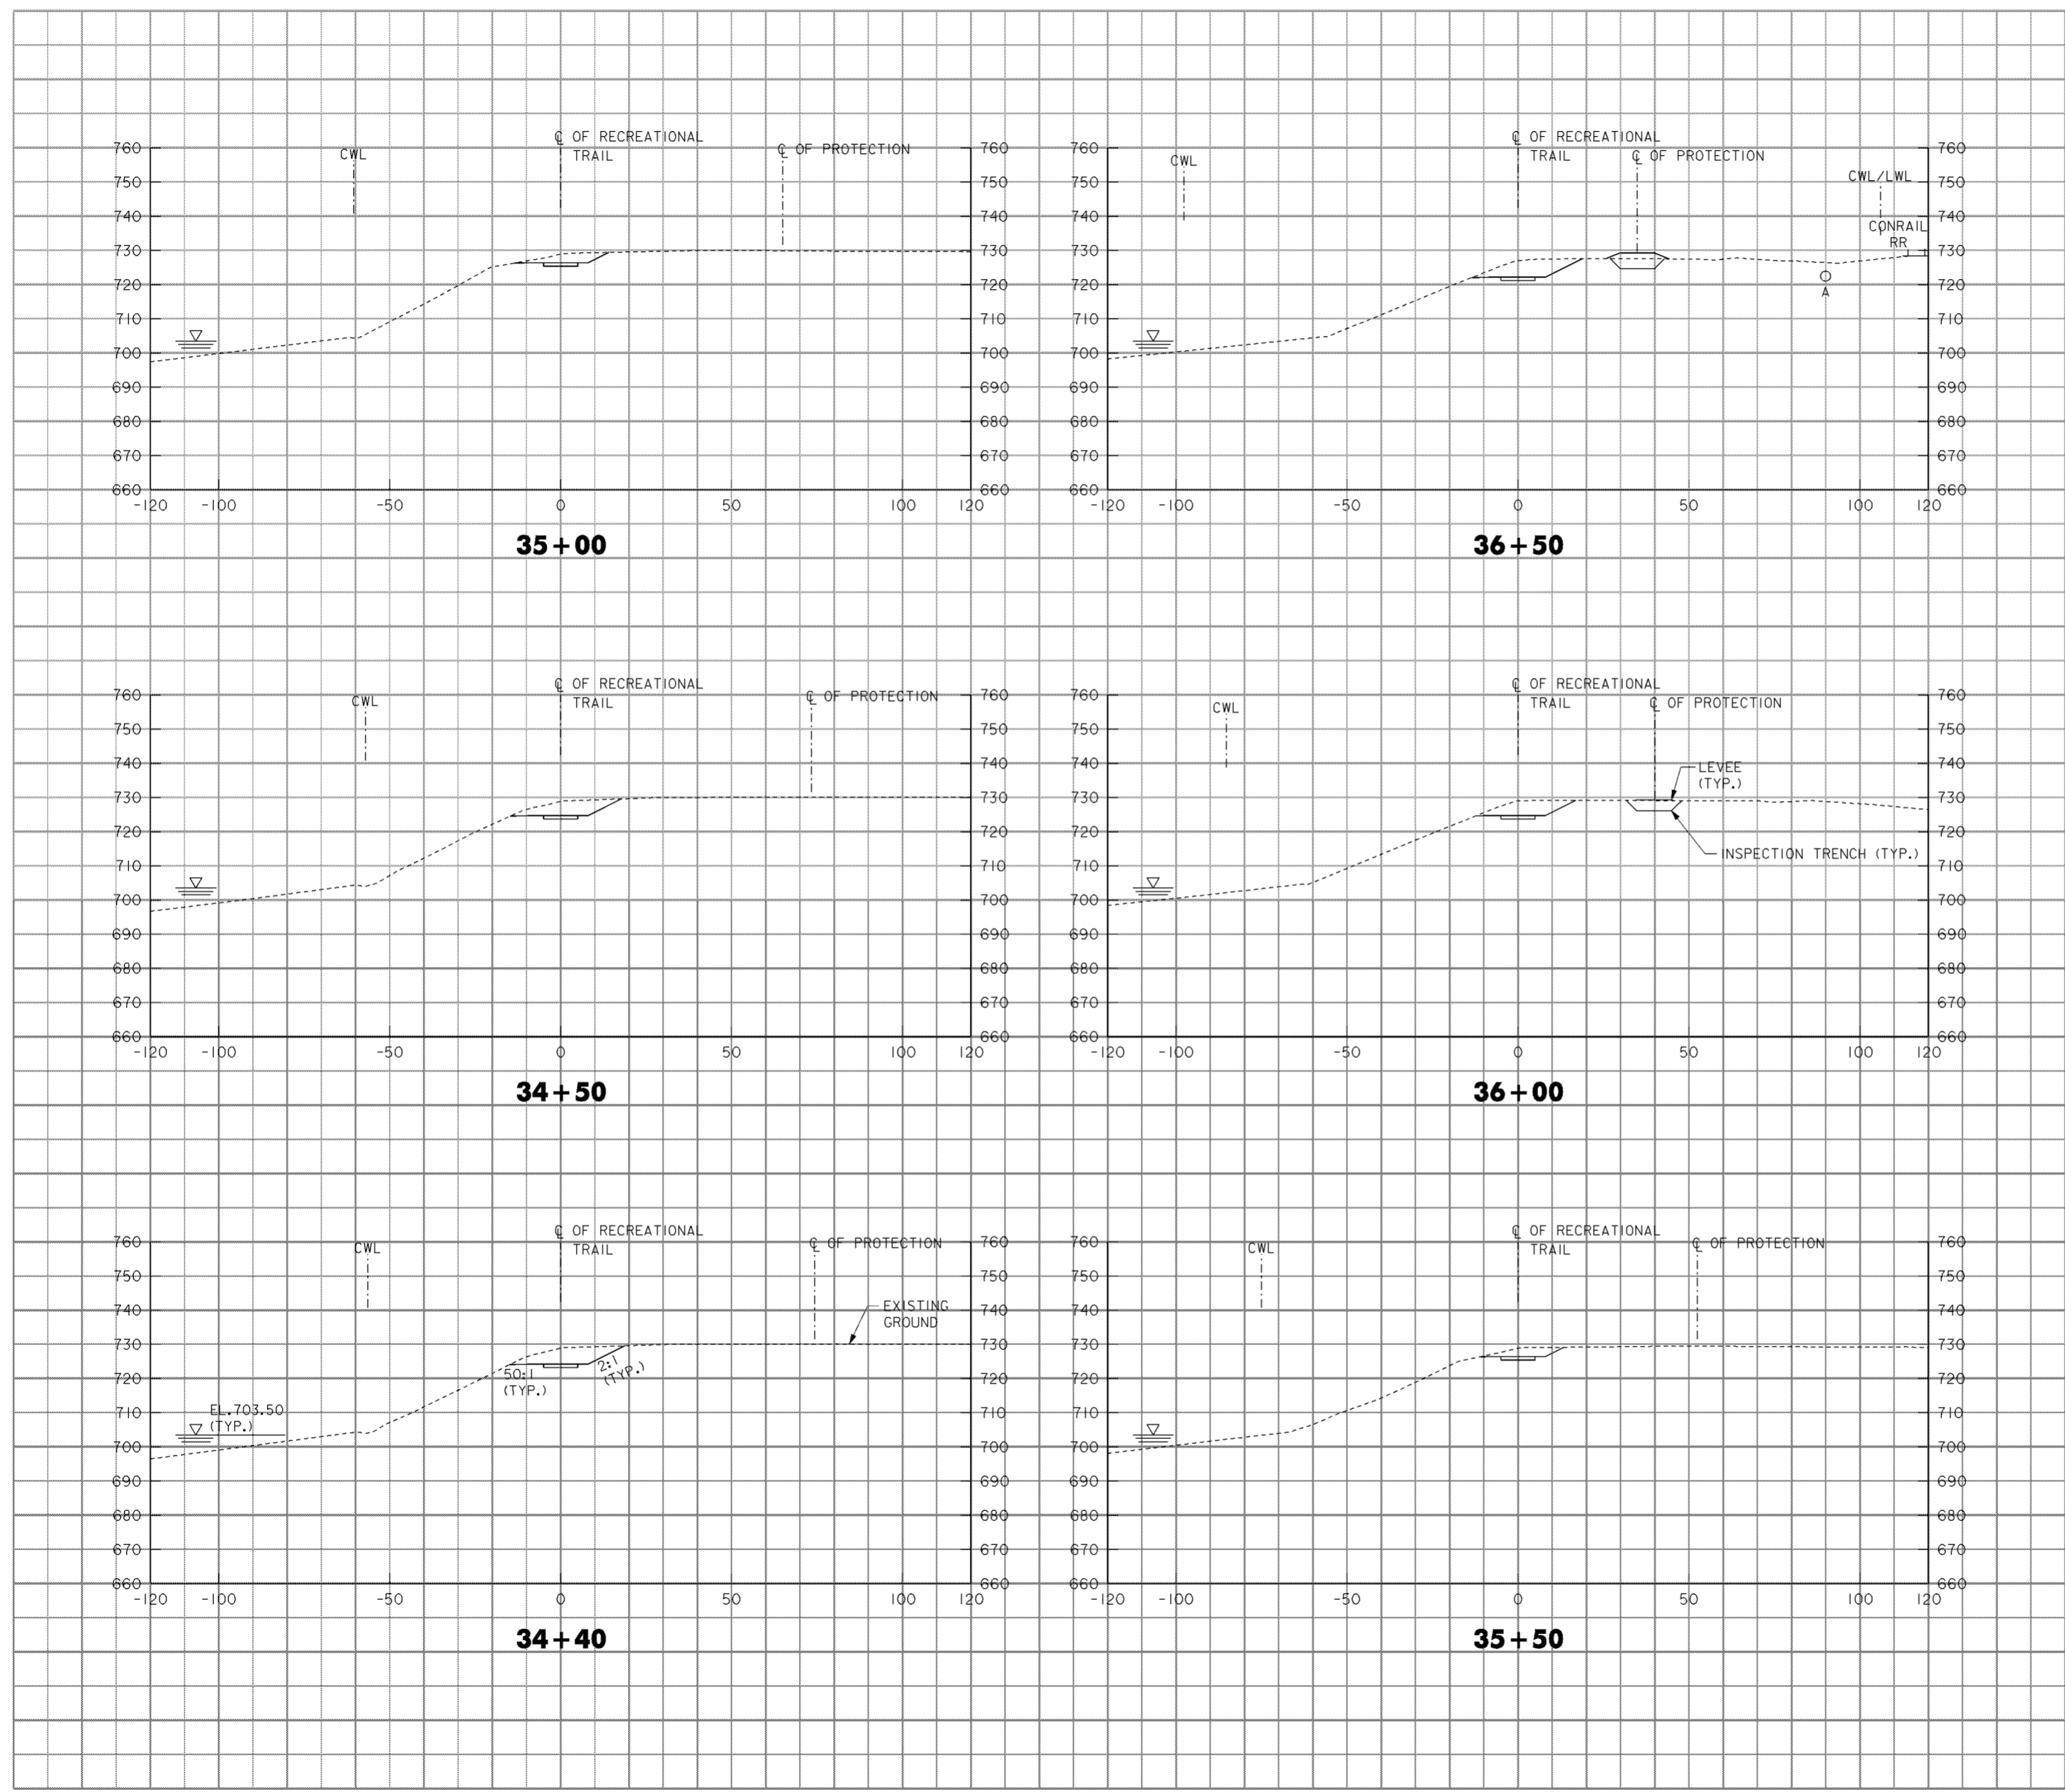

LEGEND

- A -EXISTING UNDERGROUND FIBER OPTIC
- B -EXISTING 30" RCP STORM SEWER
- C -EXISTING 8" WATERLINE
- D -NEW 30" RCP STORM SEWER
- E -NEW 24" RCP STORM SEWER
- F -EXISTING 18" RCP STORM SEWER
- G -EXISTING 10" RCP STORM SEWER
- H -EXISTING 8" RCP STORM SEWER
- I -EXISTING 15" RCP STORM SEWER
- J -EXISTING 12" RCP STORM SEWER
- K -NEW 12" RCP STORM SEWER
- L -EXISTING 12" WATERLINE
- M -EXISTING 24" RCP STORM SEWER
- N -ABANDONED SANITARY SEWER
- O -EXISTING 15" BRICK STORM SEWER
- P -EXISTING 4" RCP STORM SEWER
- Q -EXISTING 8" SANITARY SEWER
- R -EXISTING 36" WATERLINE
- S -EXISTING 72" RCP STORM SEWER
- T -EXISTING 6" WATERLINE
- U -EXISTING TELEPHONE LINE
- V -NEW 36" RCP STORM SEWER
- W -NEW 8" WATERLINE
- X -EXISTING 12" GAS LINE
- Y -EXISTING 6" GAS LINE
- Z -NEW 10" AND 36" SANITARY FORCE MAIN


NOTES

1. FOR CWL AND LWL SEE DRAWING NOS. 6/1 THRU 6/4.
2. FOR RECREATIONAL TRAIL PLAN AND PROFILE SEE DRAWING NOS. 16/50 AND 16/51.
3. FOR TYPICAL RECREATIONAL TRAIL SECTIONS SEE DRAWING NO. 16/55.
4. FOR TYPICAL LEVEE SECTIONS SEE DRAWING NO. 20.3/1.
5. FOR CONCRETE T-WALL DETAILS SEE DRAWING NO. 20.1/3.
6. FOR LIMITS OF SAFETY RAIL SEE DRAWING NOS. 20.2/38 AND 20.2/39.
7. FOR LIMITS OF DEMOLITION OF EXISTING RETAINING WALL SEE DRAWING NOS. 20.2/29 THRU 20.2/31.

Revisions			
Symbol	Descriptions	Date	Approved

BURGESS & NIPLE, LIMITED COLUMBUS, OHIO	U.S. ARMY ENGINEER DISTRICT CORPS OF ENGINEERS HUNTINGTON, WEST VIRGINIA
Designed by: J. HALL	SCOTO RIVER COLUMBUS, OHIO WEST COLUMBUS, L.P.P. PHASE IID
Drawn by: T. MULLINS	CROSS SECTIONS 37+00 TO 39+50
Checked by: P. CONROY	Scale: AS SHOWN
Reviewed by:	Date: MARCH 1998
Approved by:	Drawing Code: 16-PWC-10-
	Sheet reference number: 16/53
	FILENAME: PEN TABLE: 00c92s02.dgn
	Sheet 2 of 3

WORK AS CONSTRUCTED

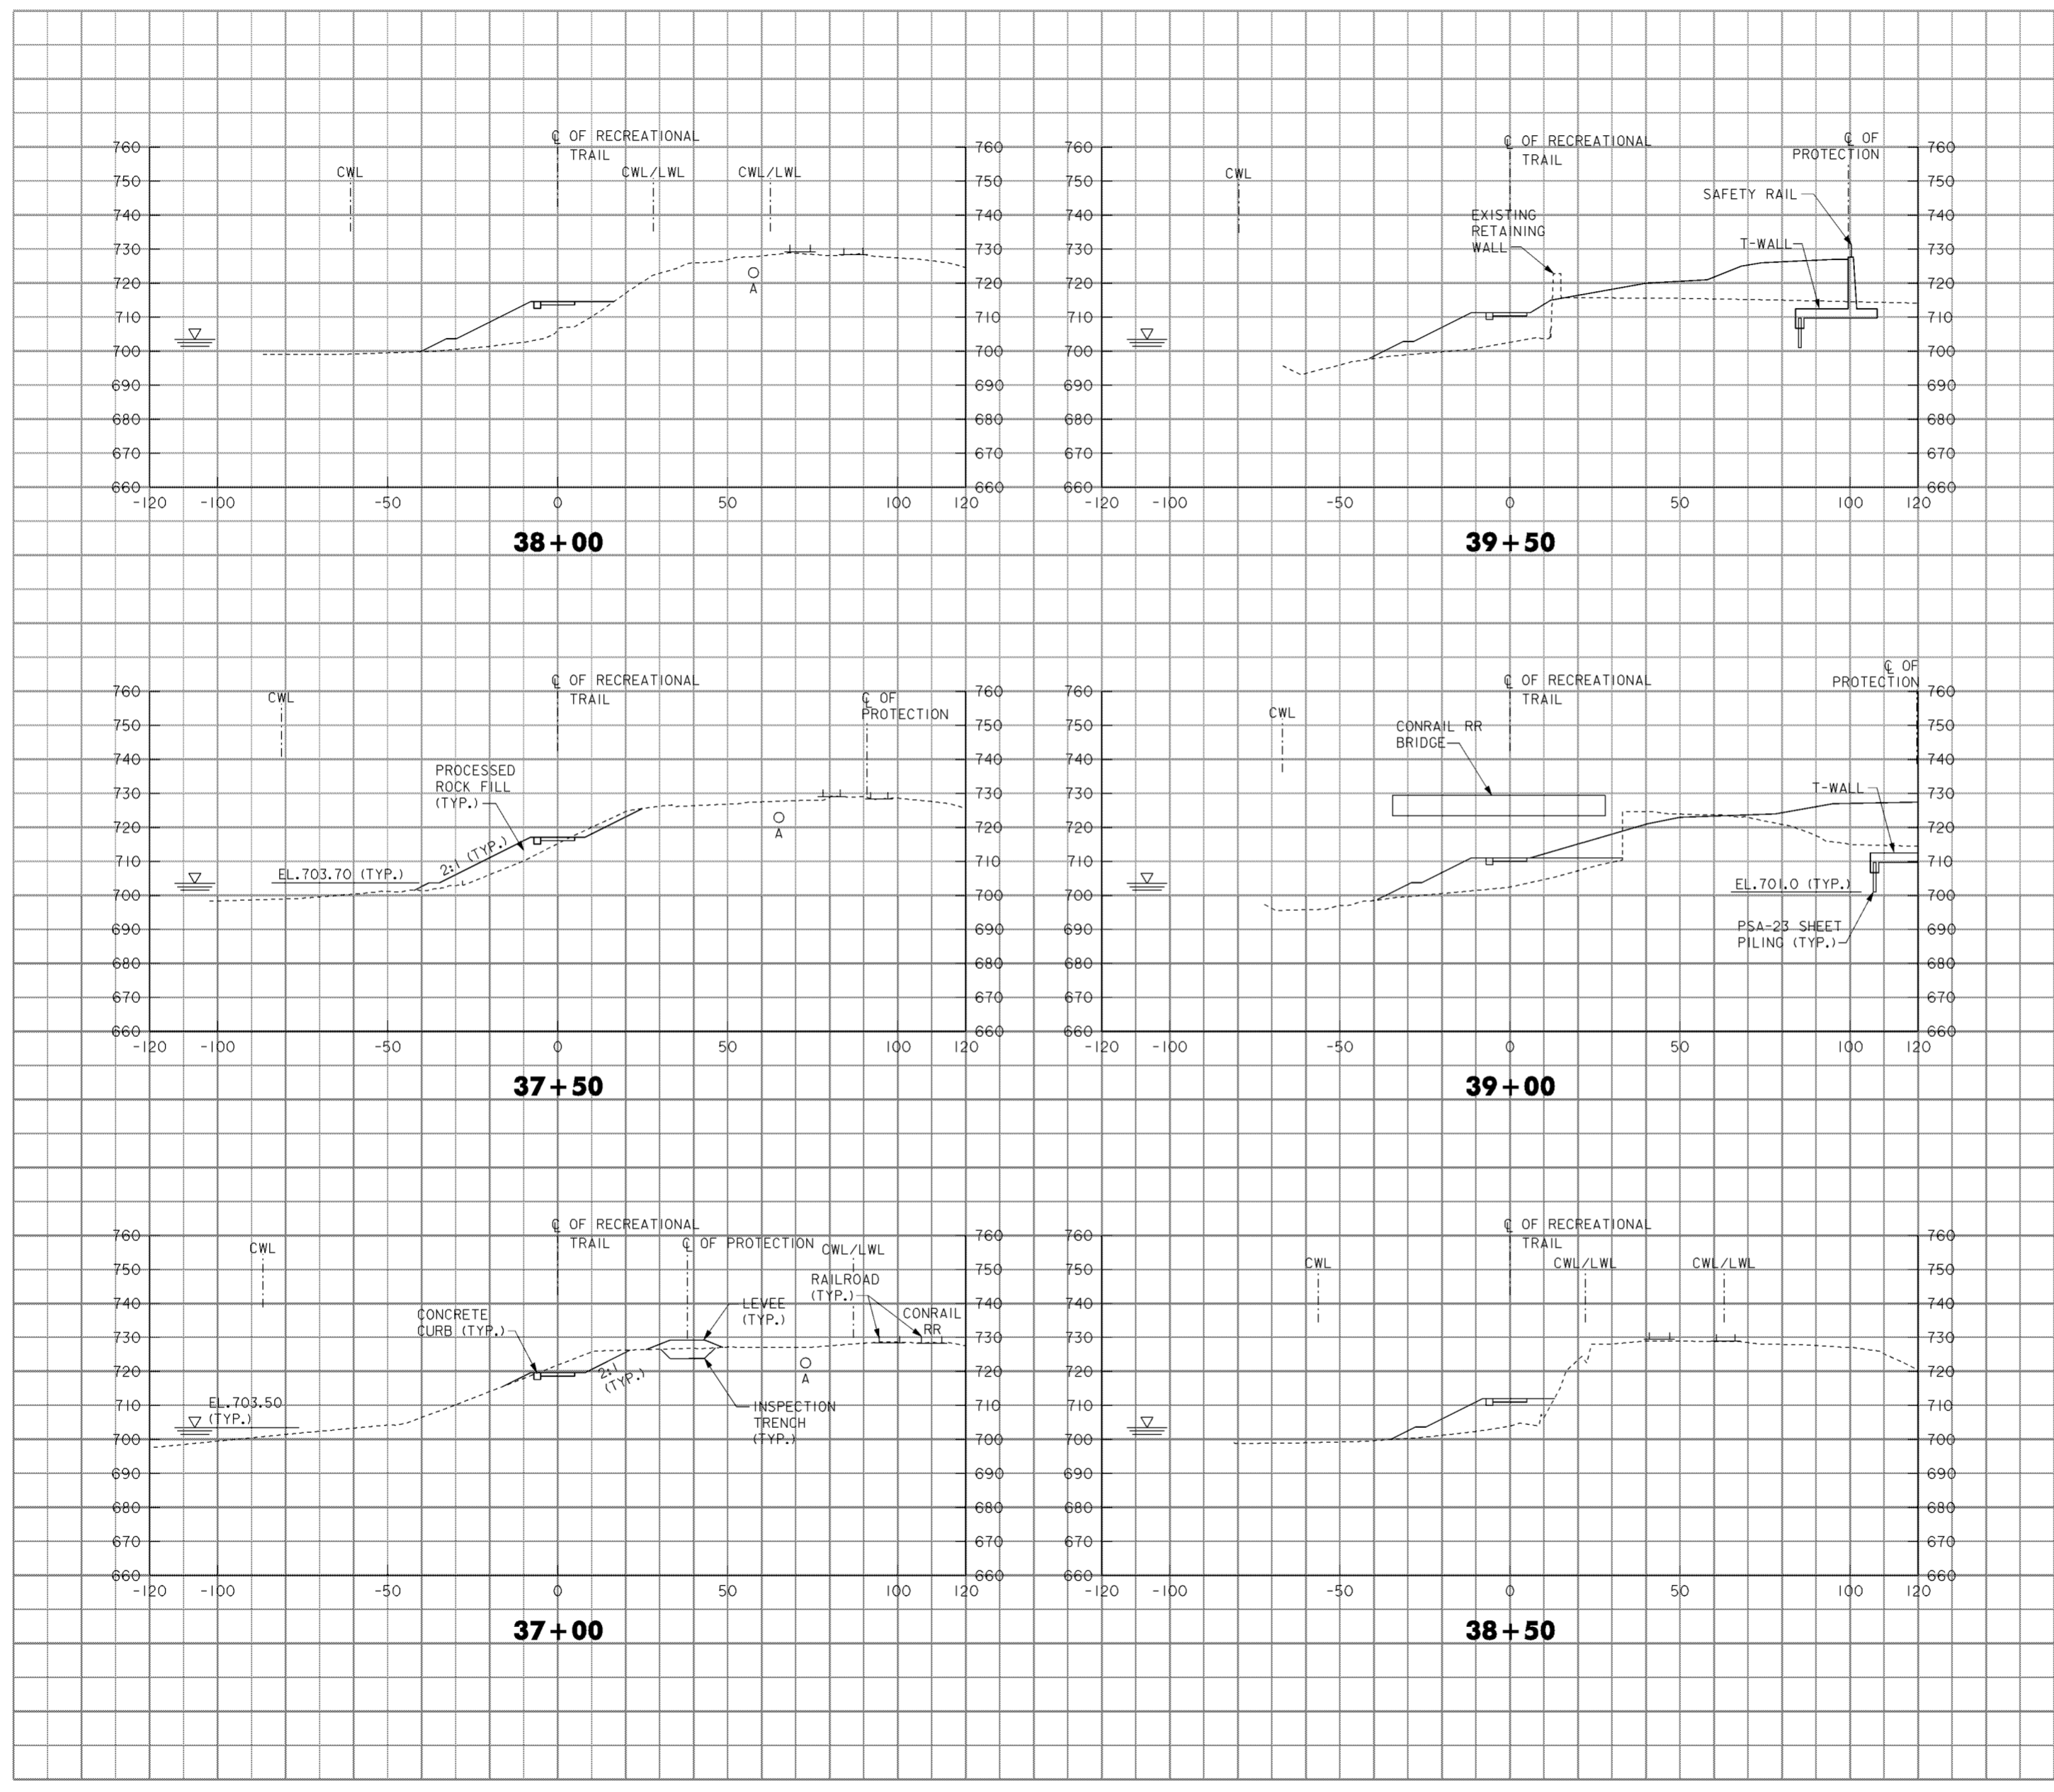

8

7

6

5

4

3

2

8

7

6

5

4

3

2

1

LEGEND





- A -EXISTING UNDERGROUND FIBER OPTIC
- B -EXISTING 30" RCP STORM SEWER
- C -EXISTING 8" WATERLINE
- D -NEW 30" RCP STORM SEWER
- E -NEW 24" RCP STORM SEWER
- F -EXISTING 18" RCP STORM SEWER
- G -EXISTING 10" RCP STORM SEWER
- H -EXISTING 8" RCP STORM SEWER
- I -EXISTING 15" RCP STORM SEWER
- J -EXISTING 12" RCP STORM SEWER
- K -NEW 12" RCP STORM SEWER
- L -EXISTING 12" WATERLINE
- M -EXISTING 24" RCP STORM SEWER
- N -ABANDONED SANITARY SEWER
- O -EXISTING 15" BRICK STORM SEWER
- P -EXISTING 4" RCP STORM SEWER
- Q -EXISTING 8" SANITARY SEWER
- R -EXISTING 36" WATERLINE
- S -EXISTING 72" RCP STORM SEWER
- T -EXISTING 6" WATERLINE
- U -EXISTING TELEPHONE LINE
- V -NEW 36" RCP STORM SEWER
- W -NEW 8" WATERLINE
- X -EXISTING 12" GAS LINE
- Y -EXISTING 6" GAS LINE
- Z -NEW 10" AND 36" SANITARY FORCE MAIN


NOTES

1. FOR CWL AND LWL SEE DRAWING NOS. 6/1 THRU 6/4.
2. FOR RECREATIONAL TRAIL PLAN AND PROFILE SEE DRAWING NOS. 16/50 AND 16/51.
3. FOR TYPICAL RECREATIONAL TRAIL SECTIONS SEE DRAWING NO. 16/55.
4. FOR CONCRETE I-WALL DETAILS SEE DRAWING NO. 20.1/1.
5. FOR CONCRETE T-WALL DETAILS SEE DRAWING NO. 20.1/3.
6. FOR LIMITS OF SAFETY RAIL SEE DRAWING NOS. 20.2/38 AND 20.2/39.
7. FOR LIMITS OF DEMOLITION OF EXISTING RETAINING WALL SEE DRAWING NOS. 20.2/29 THRU 20.2/31.

Revisions			
Symbol	Descriptions	Date	Approved

BURGESS & NIPLE, LIMITED COLUMBUS, OHIO	U.S. ARMY ENGINEER DISTRICT CORPS OF ENGINEERS HUNTINGTON, WEST VIRGINIA
Designed by: J. HALL Drawn by: T. MULLINS Checked by: P. CONROY Reviewed by:	SCIOTO RIVER COLUMBUS, OHIO WEST COLUMBUS, L.P.P. PHASE IID CROSS SECTIONS 40+00 TO 41+50
Approved by:	Scale: AS SHOWN Date: MARCH 1998 Drawing Code: 16-PWC-10-
Sheet reference number: 16/54	FILENAME: 00c92s03.dgn PEN TABLE: Sheet 3 of 3

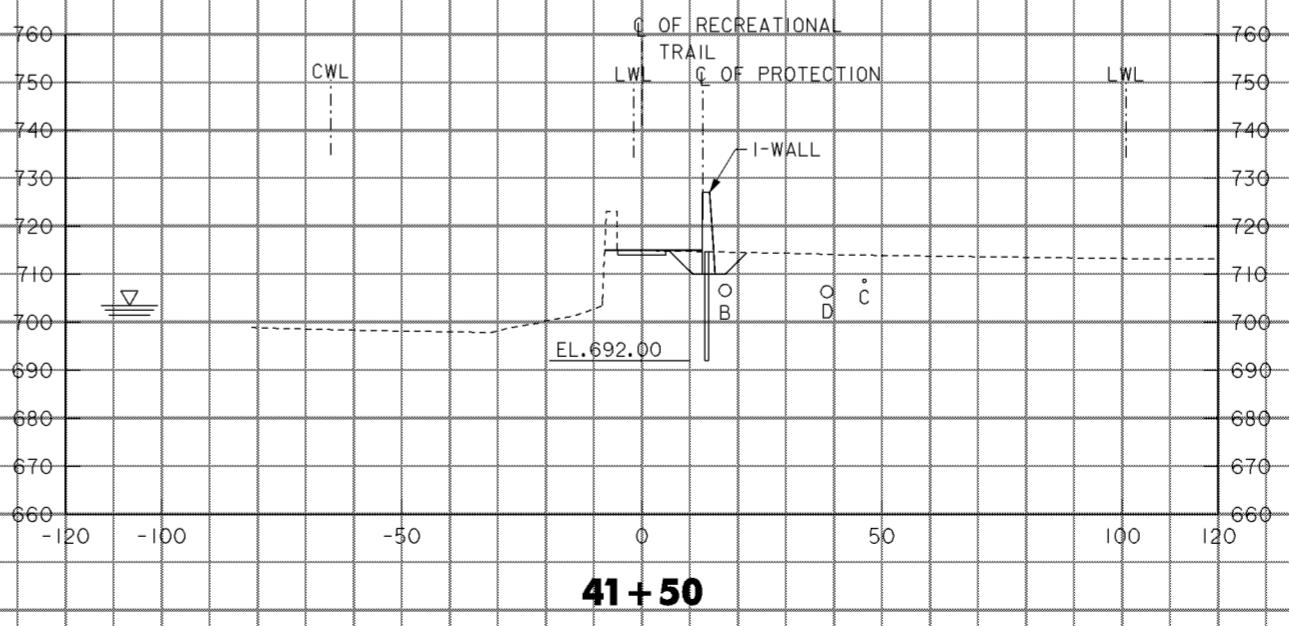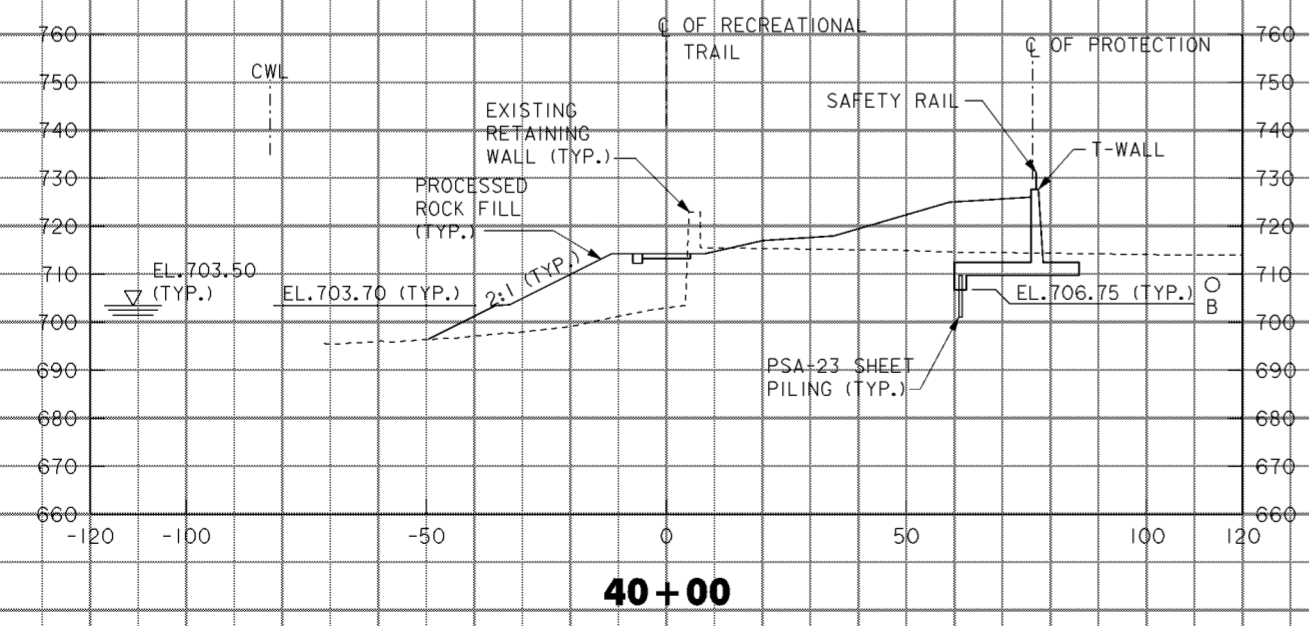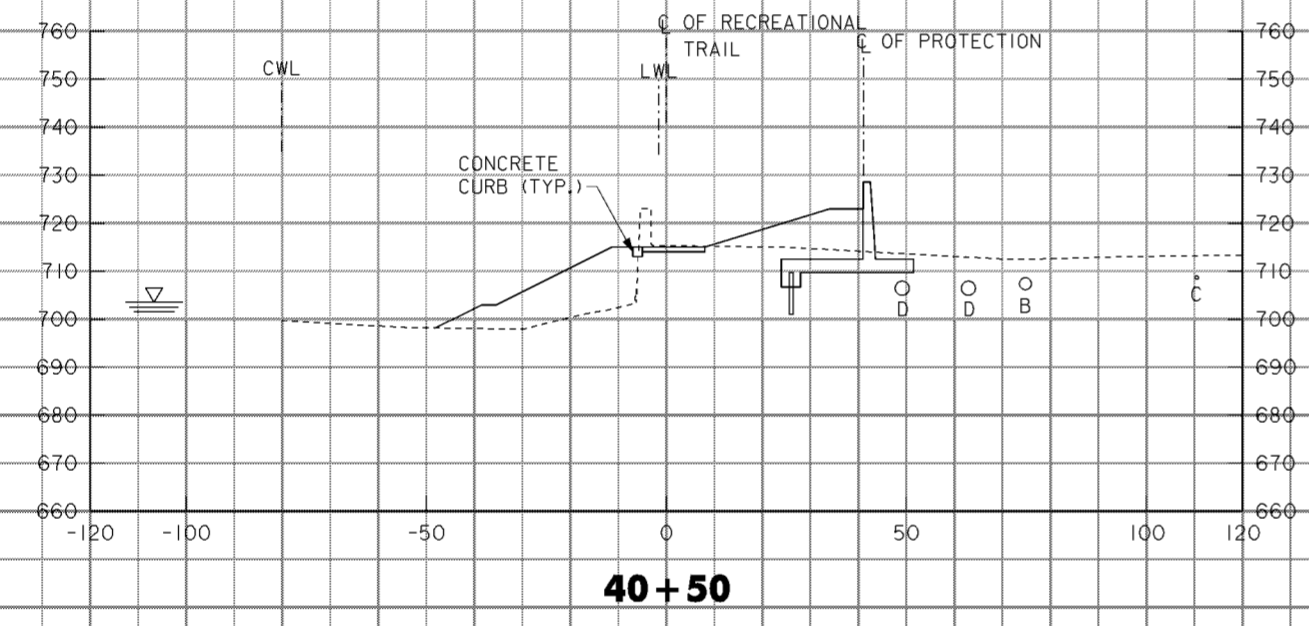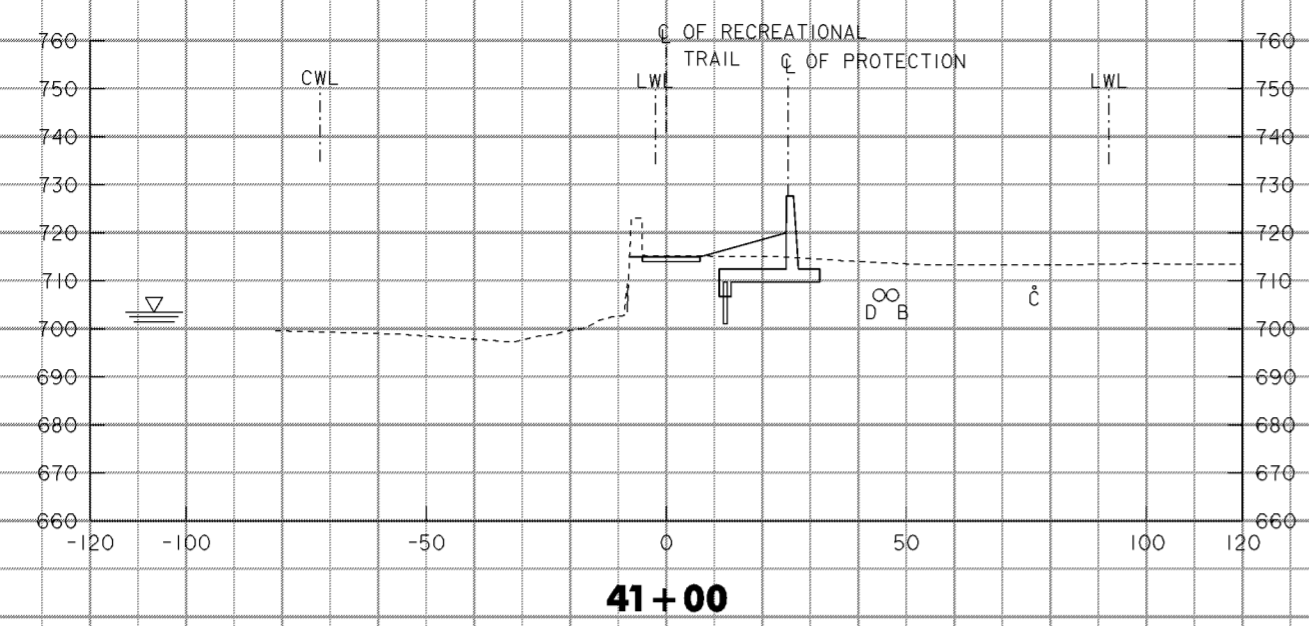


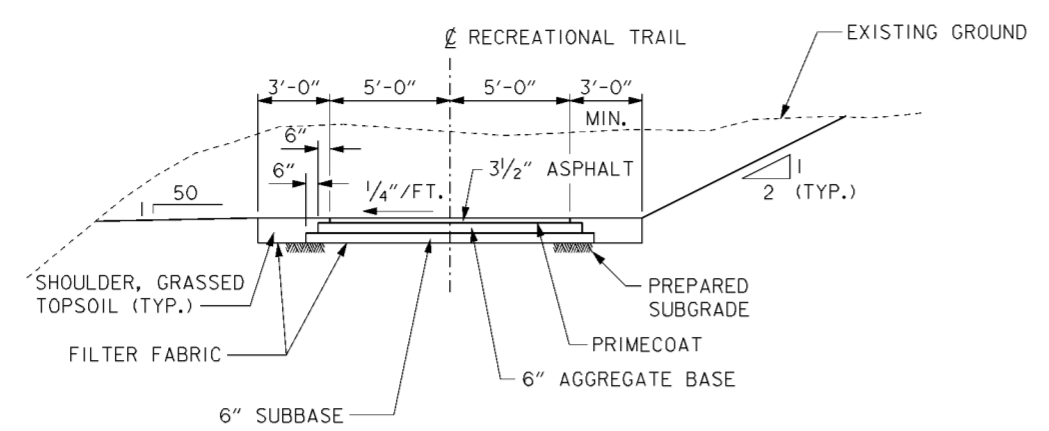

NOTE: ASPHALT CONSISTS OF 1 1/2" OF ASPHALT CONCRETE SURFACE COURSE OVERLYING 2" OF ASPHALT CONCRETE BASE COURSE. APPLY TACK COAT BETWEEN ASPHALT CONCRETE BASE COURSE AND ASPHALT CONCRETE SURFACE COURSE.

TYPICAL ASPHALT RECREATIONAL TRAIL SECTION


STA. 34+40 TO STA. 36+90
 SCALE: 1/4" = 1'-0"
 12" 0 5'

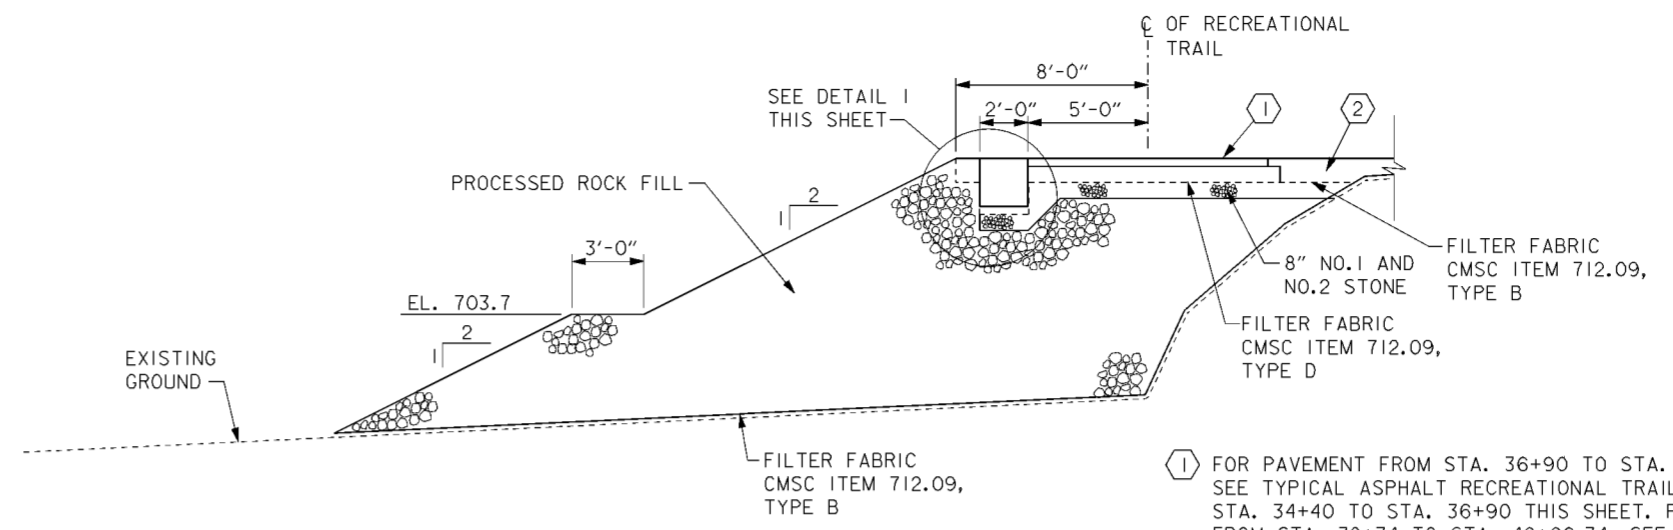

TYPICAL RECREATIONAL TRAIL SECTION WITH PROCESSED ROCK FILL

STA. 36+90 TO STA. 40+66.34
 SCALE: 1/4" = 1'-0"
 12" 0 5'


- ① FOR PAVEMENT FROM STA. 36+90 TO STA. 38+74 SEE TYPICAL ASPHALT RECREATIONAL TRAIL SECTION, STA. 34+40 TO STA. 36+90 THIS SHEET. FOR PAVEMENT FROM STA. 38+74 TO STA. 40+66.34, SEE DWG. NO.20.2/51.
- ② GRASSED SHOULDER FROM STA. 36+90 TO STA. 38+74. CONCRETE CURB AND RANDOM EARTH FILL STARTS AT STA. 38+74, SEE DWG NO.20.2/51.

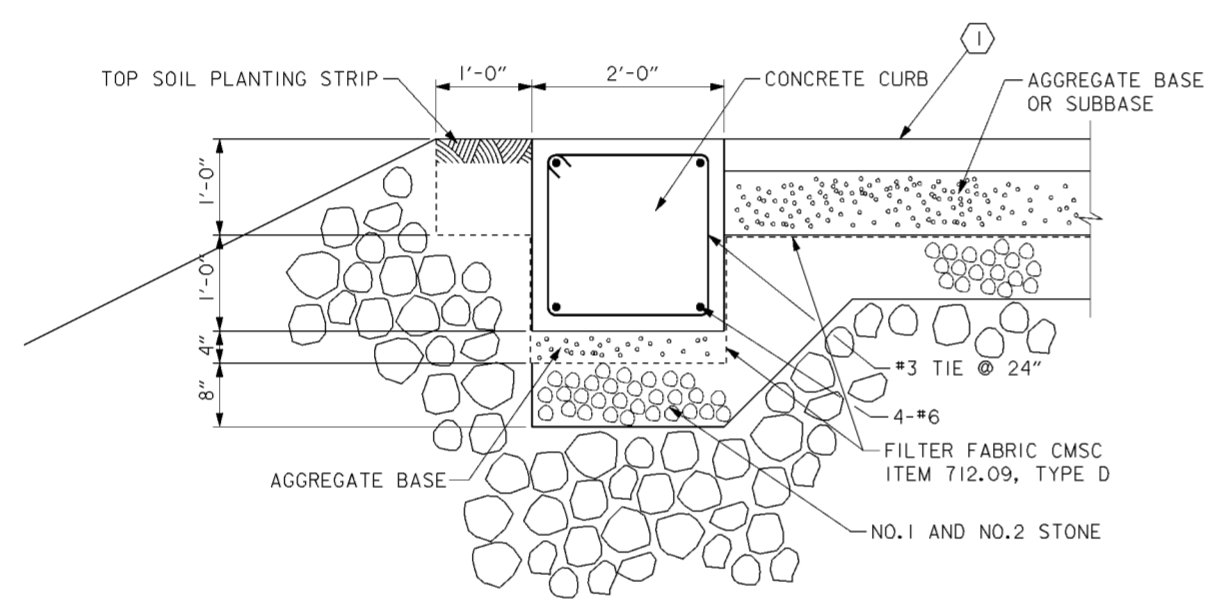

NOTE: PROVIDE EXPANSION JOINT AT 20'-0" O.C. AND CONTROL JOINTS AT 10'-0" O.C. JOINTS IN CURB ADJACENT TO CONCRETE PAVEMENT SHALL COINCIDE WITH PAVEMENT JOINTING.

DETAIL 1

SCALE: 1" = 1'-0"
 12" 0 1'

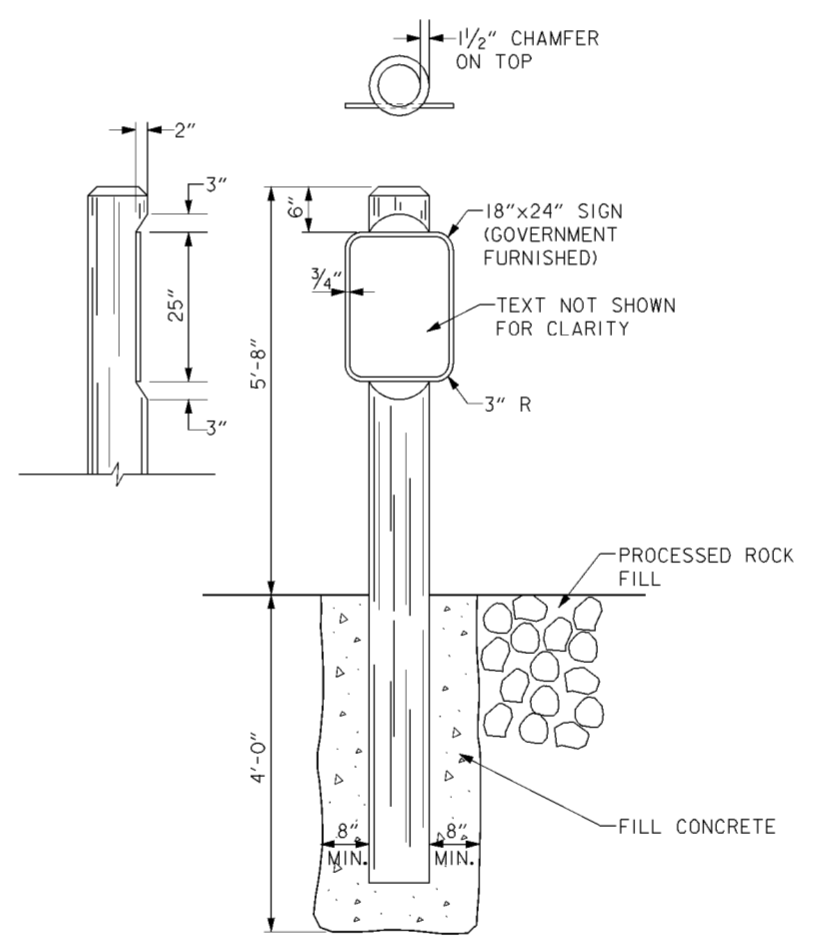

- SIGNBOARDS PROVIDED BY OWNER FOR CONTRACTOR INSTALLATION SIGNS DARK BROWN WITH WHITE LETTERS AND LINE BORDER.
- PROTECT CUT AREAS WITH POLYURETHANE
- POST STAINED BROWN
- INSTALL POST 3' FROM EDGE OF PAVEMENT

REC. TRAIL SIGN POST


SCALE: 3/4" = 1'-0"
 12" 6" 0 1' 2'

NOTES

1. FOR RECREATIONAL TRAIL LAYOUT SEE DRAWING NOS. 16/50, 16/51, AND 20.2/35 THRU 20.2/37


Revisions			
Symbol	Descriptions	Date	Approved

BURGESS & NIPLE, LIMITED COLUMBUS, OHIO	U.S. ARMY ENGINEER DISTRICT CORPS OF ENGINEERS HUNTINGTON, WEST VIRGINIA	Designed by: J. HALL	SCIOTO RIVER COLUMBUS, OHIO WEST COLUMBUS, L.P.P. PHASE IID
		Drawn by: T. MULLINS	
Checked by: P. CONROY	TYPICAL SECTIONS AND DETAILS	Reviewed by: AS SHOWN	Sheet reference number: 16/55
Approved by:	Date: MARCH 1998	Drawing Code: 16-PWC-10-	FILENAME: 00ds09.dgn PEN TABLE: Sheet 1 of 1

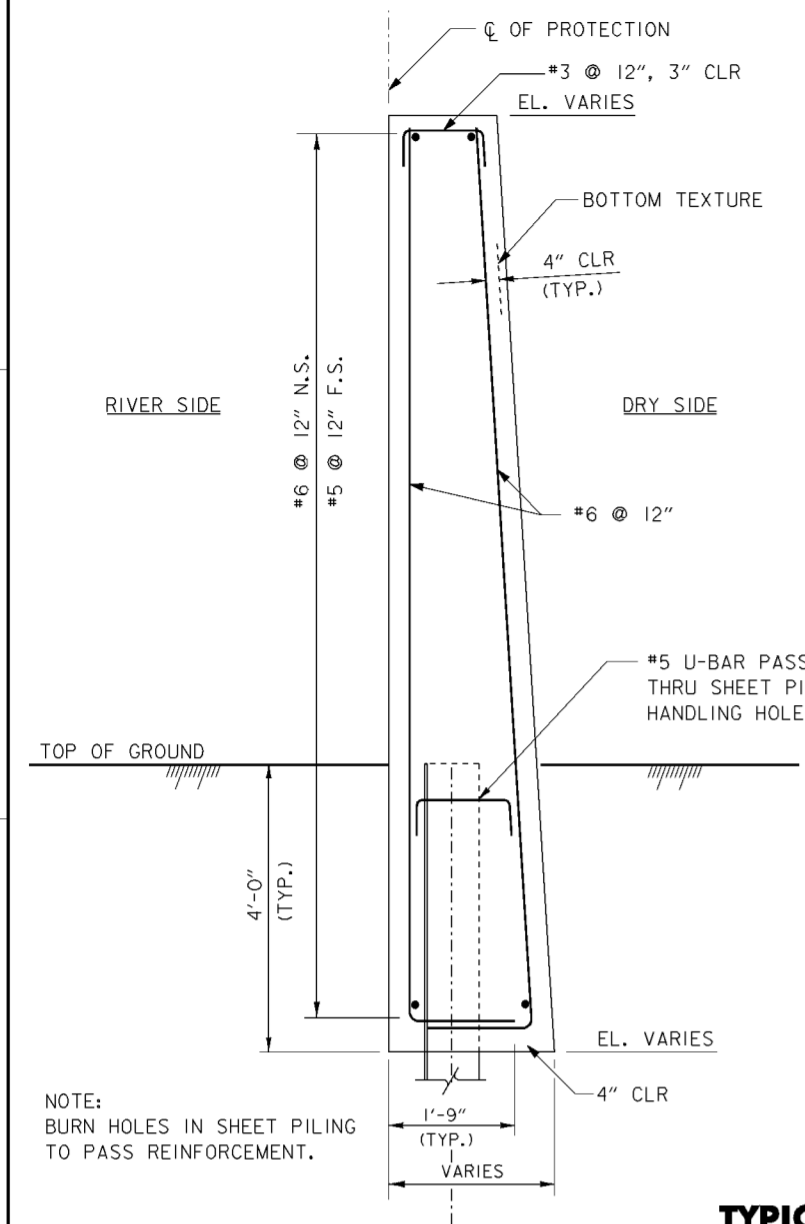


TYPICAL I-WALL SECTIONS

STA. 190+40.04 TO 190+70.91
 STA. 192+11.91 TO 192+63.59
 SCALE: 3/8" = 1'-0"
 12" 6" 0 1' 2'

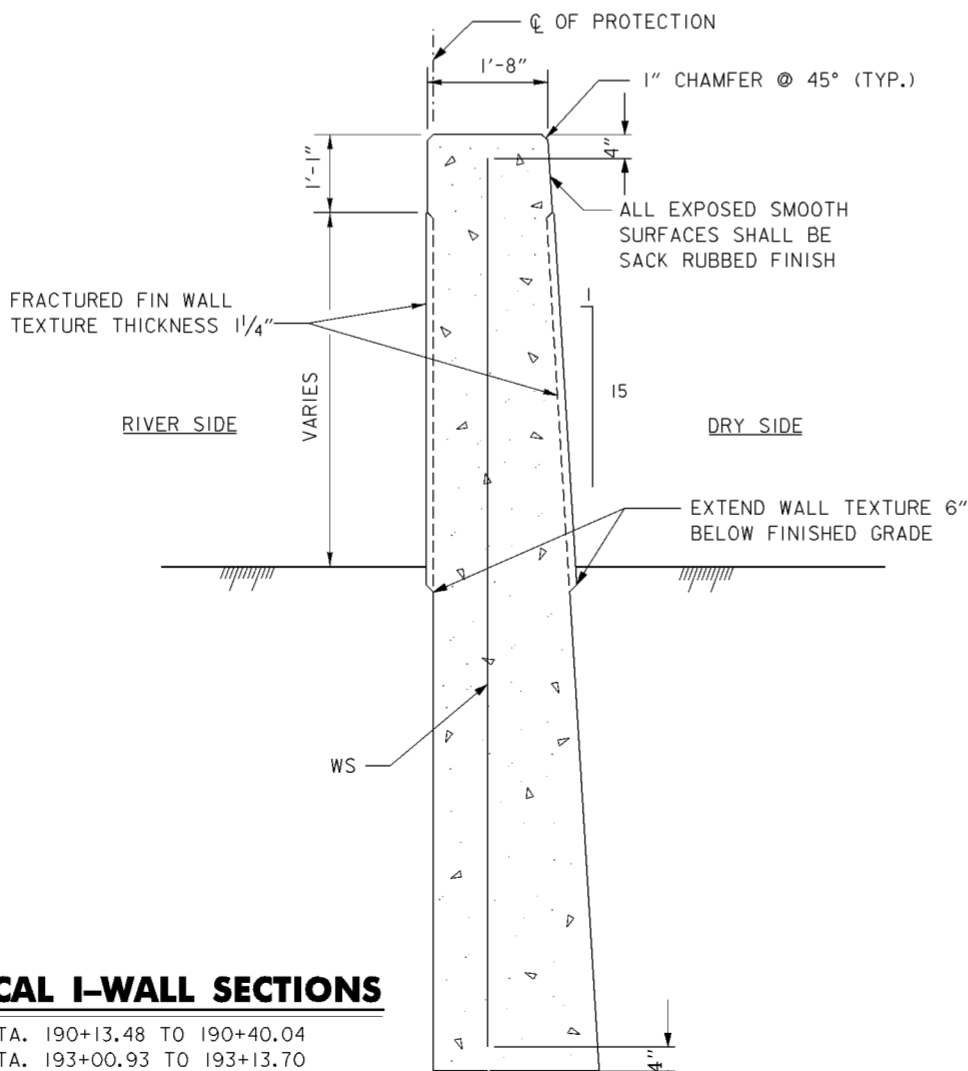


TYPICAL I-WALL SECTIONS

STA. 190+13.48 TO 190+40.04
 STA. 193+00.93 TO 193+13.70
 SCALE: 3/8" = 1'-0"
 12" 6" 0 1' 2'

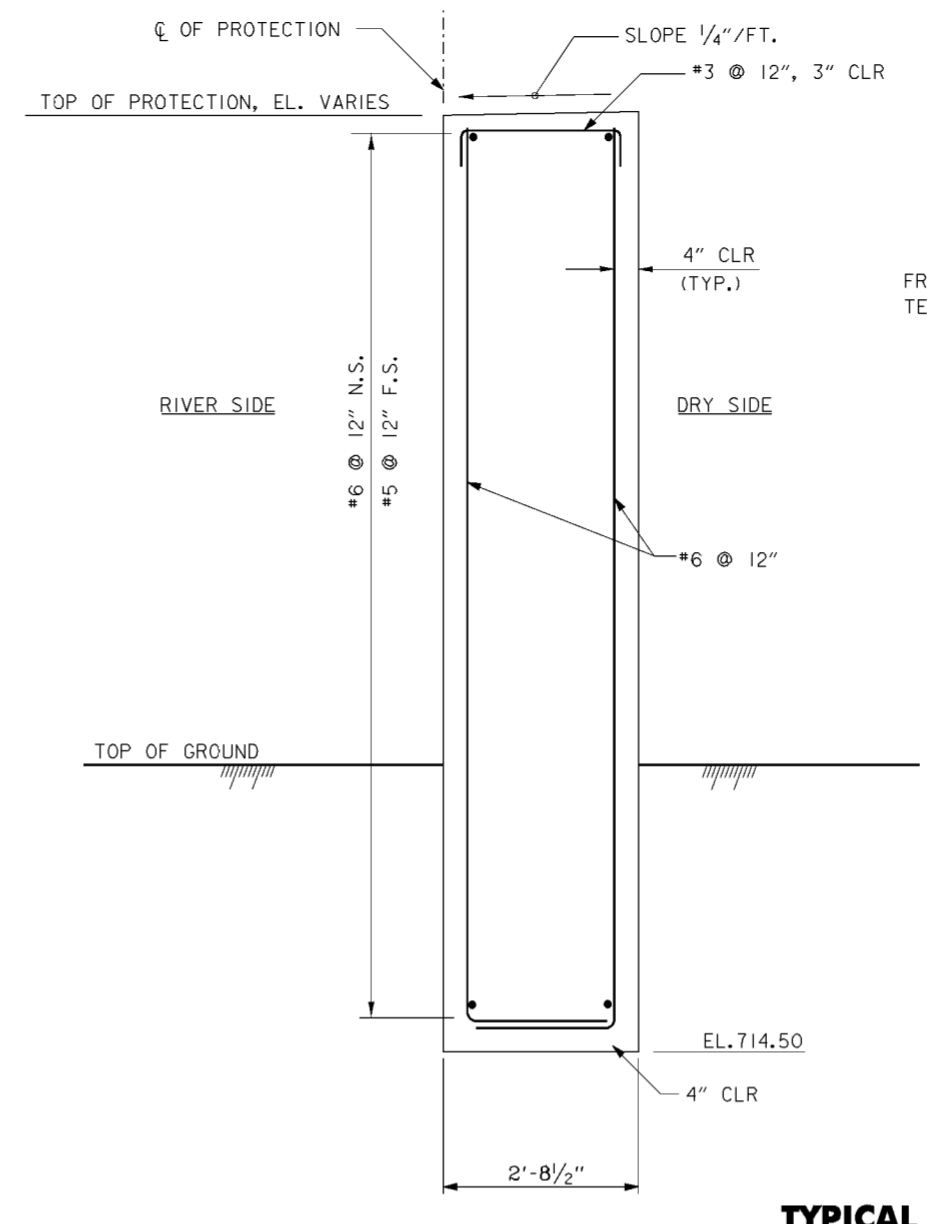


TYPICAL I-WALL SECTIONS

STA. 192+63.59 TO 193+00.93
 SCALE: 3/8" = 1'-0"
 12" 6" 0 1' 2'

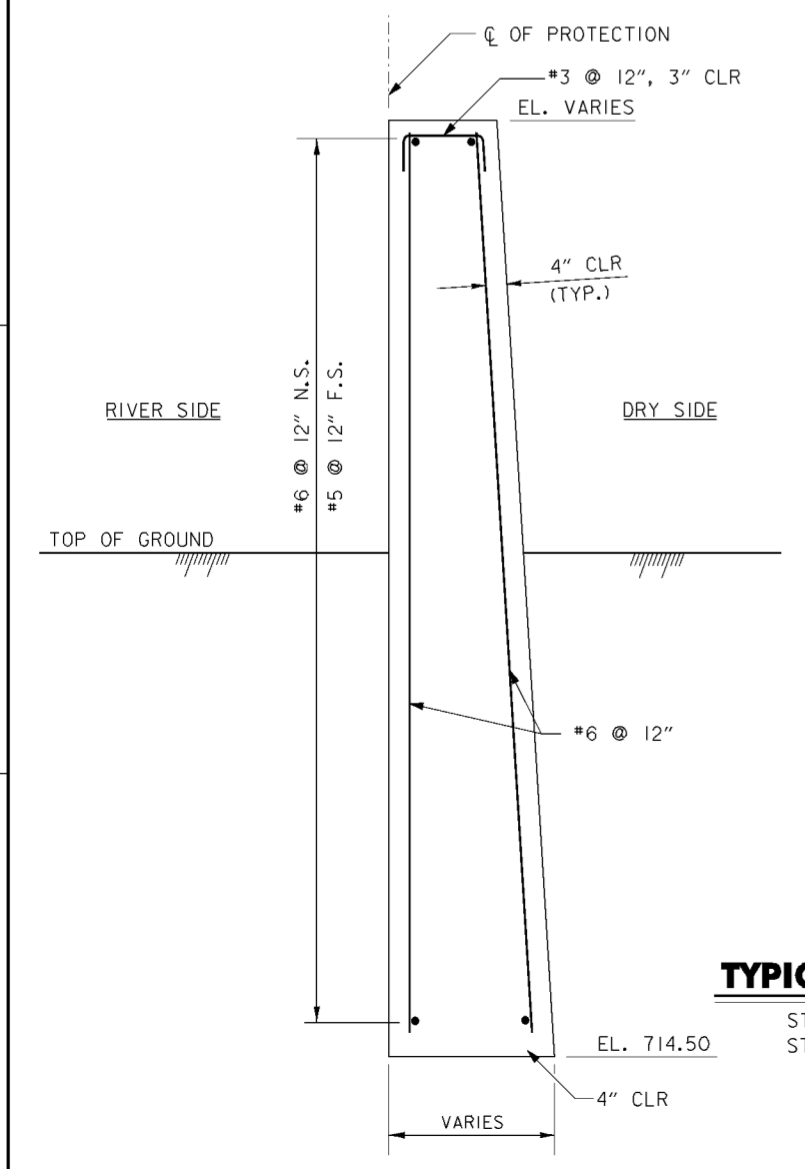

TYPICAL I-WALL SECTIONS

STA. 190+13.48 TO 190+40.04
 STA. 193+00.93 TO 193+13.70
 SCALE: 3/8" = 1'-0"
 12" 6" 0 1' 2'

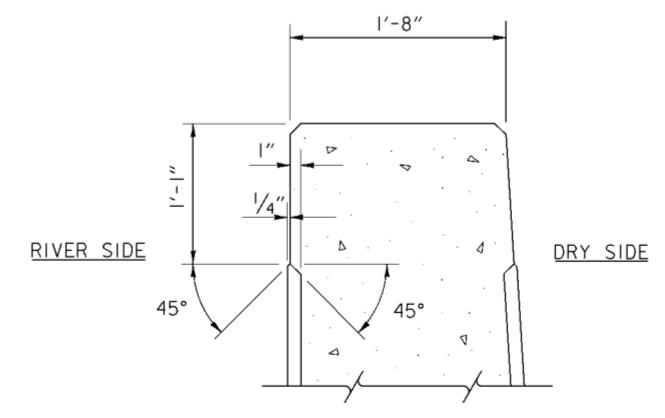

TYPICAL CAP DETAIL


STA. 190+13.48 TO 192+36.36
 STA. 193+00.93 TO 193+13.70
 EXCEPT AS NOTED AT RICH STREET GATE CLOSURE
 SCALE: 1 1/2" = 1'-0"
 12" 9" 6" 3" 0 1'

NOTES

1. FOR TYPICAL CORNER MONOLITH AND MONOLITH JOINT DETAILS SEE DRAWING NO. 20.1/1.
2. FOR STRUCTURAL GENERAL NOTES SEE DRAWING NO. 20.2/9.
3. SEE DRAWING NO. 20.1/11 FOR WATERSTOP LOCATION.


Revisions			
Symbol	Descriptions	Date	Approved

BURGESS & NIPLE, LIMITED COLUMBUS, OHIO	U.S. ARMY ENGINEER DISTRICT CORPS OF ENGINEERS HUNTINGTON, WEST VIRGINIA	SCIO TO RIVER COLUMBUS, OHIO WEST COLUMBUS, L.P.P. PHASE IID	
		TYPICAL I-WALL DETAILS	
Designed by: L.LINZELL	Scale: AS SHOWN	Sheet reference number: 20.12	FILENAME: 00add102.dgn
Drawn by: D.BECKNER		Date: MARCH 1998	PEN TABLE:
Checked by: D.TRAINA		Drawing Code: 16-PWC-10-	Sheet 2 of 2
Reviewed by:		Approved by:	Approved by:

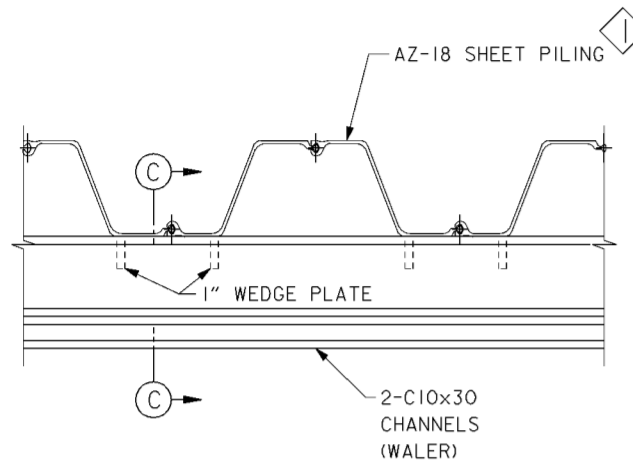


NOTE: ANCHORS NOT SHOWN


DETAIL 4
 SCALE: 1" = 1'-0"

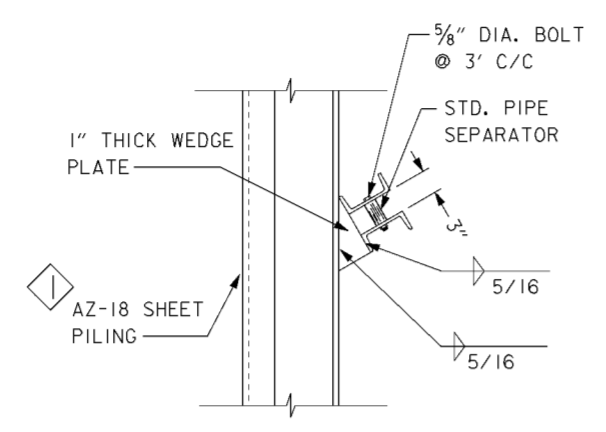


SECTION C-C
 SCALE: 1" = 1'-0"

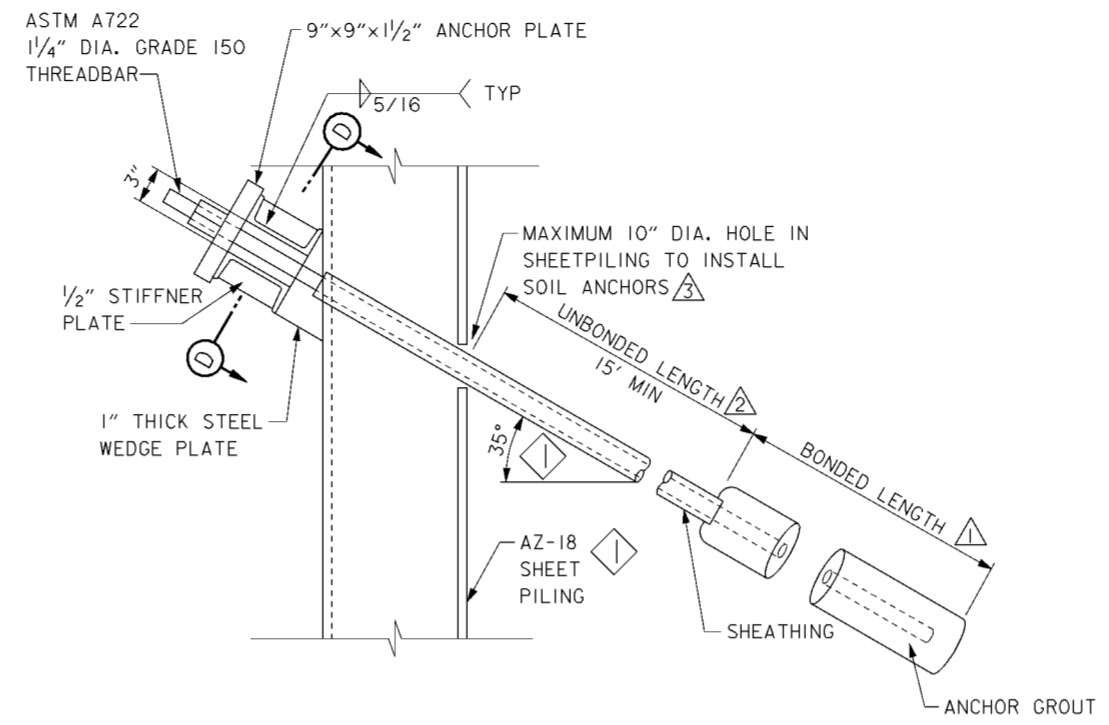

TYPICAL SOIL ANCHOR DETAIL
 SCALE: 1 1/2" = 1'-0"

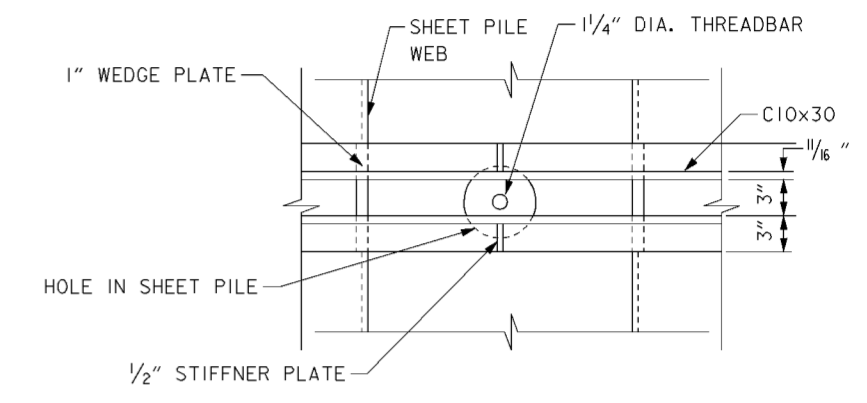

SECTION D-D
 SCALE: 3/4" = 1'-0"

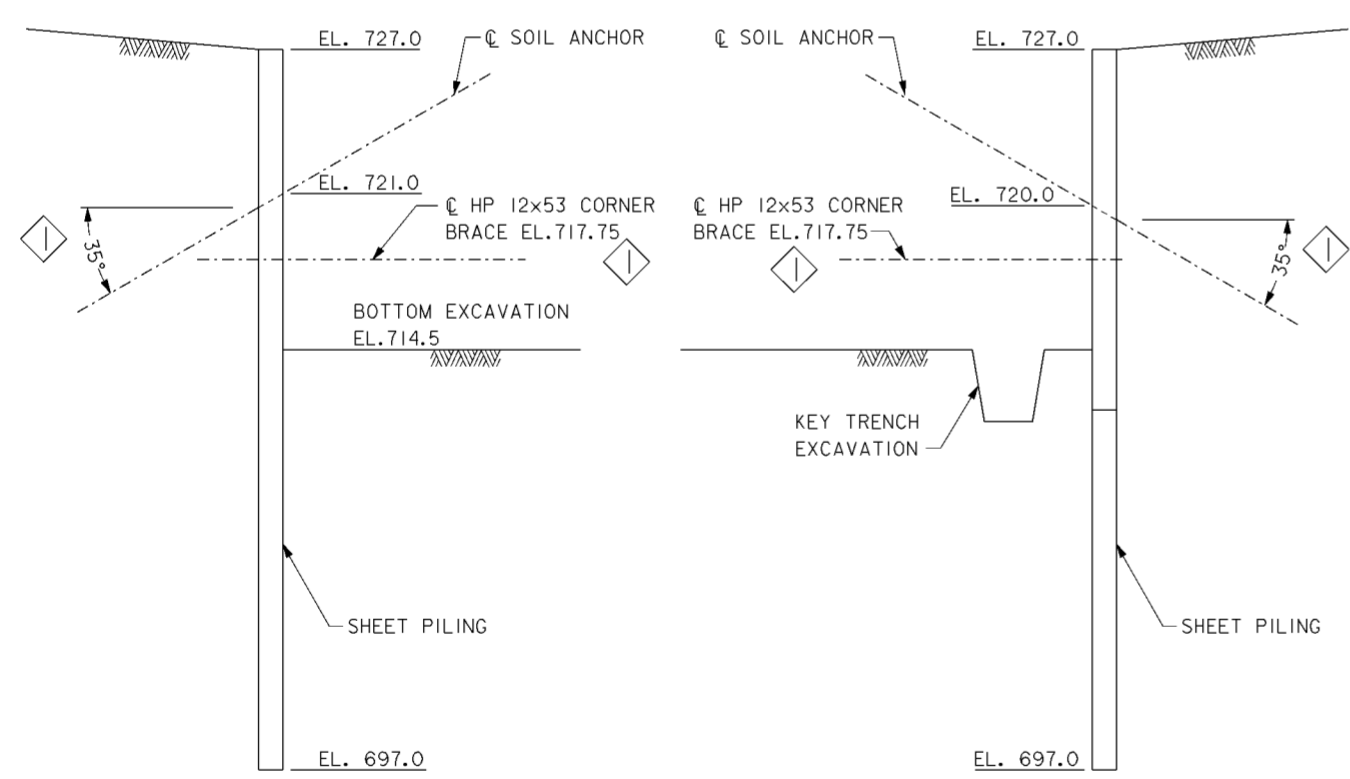

SECTION A-A
 SCALE: 1/4" = 1'-0"

SECTION B-B
 SCALE: 1/4" = 1'-0"

CODED NOTES



- △ SOIL ANCHOR BONDED LENGTH AND DIAMETER TO BE DETERMINED BY THE CONTRACTOR BASED ON PROPOSED METHODS OF INSTALLATION. ANCHOR BOND LENGTH SHALL SAFELY SUPPORT AN ANCHOR DESIGN LOAD OF 85 KIPS WITH A FACTOR OF SAFETY AGAINST PULLOUT OF 2.5. THE MINIMUM BOND LENGTH SHALL BE 20 FEET.
- △ VOID BETWEEN DRILL HOLE AND SHEATHING OF UNBONDED LENGTH SHALL BE FILLED WITH GROUT.
- △ SUBSEQUENT TO INSTALLATION OF SOIL ANCHORS AND ANCHOR TESTING A 3/8-INCH THICK STEEL PLATE WITH A SMALL HOLE FOR THE TENDON SHALL BE WELDED TO THE SHEET PILING TO PLUG THE HOLE IN THE SHEET PILING REQUIRED TO DRILL THE HOLES FOR THE SOIL ANCHORS. THE STEEL PLATE SHALL BE ESSENTIALLY SQUARE WITH MINIMUM DIMENSIONS 1 INCH GREATER THAN THE DIAMETER OF THE HOLE TO BE PLUGGED EXCEPT FOR NOTCHES CUT TO CLEAR THE PILING INTERLOCKS. THE PLATES SHALL BE INSTALLED AS SOON AS THE EXCAVATION REACHES A POINT WHERE THE WELDING CAN BE PERFORMED. A 5/16-INCH FILLET WELD SHALL BE USED ALONG THE ENTIRE PERIMETER OF THE PLATE.

GENERAL NOTES

1. A TEMPORARY SURCHARGE TO ELEVATION 721.0 SHALL BE PLACED PRIOR TO DRIVING THE SHEET PILING. THE TEMPORARY SURCHARGE SHALL REMAIN IN PLACE UNTIL ALL SOIL ANCHORS HAVE BEEN INSTALLED AND TESTED.
2. SOIL ANCHORS SHALL BE INSTALLED IN ACCORDANCE WITH "RECOMMENDATIONS FOR PRESTRESSED ROCK AND SOIL ANCHORS, 1996 EDITION BY THE POST-TENSIONING INSTITUTE" (PTI).
3. SOIL ANCHOR DESIGN LOAD = 85 KIPS.
4. THE FIRST SOIL ANCHOR INSTALLED SHALL BE PERFORMANCE TESTED AND THE REMAINING SOIL ANCHORS SHALL BE PROOF TESTED. THE TEST PROCEDURES USED SHALL BE AS SET FORTH BY PTI RECOMMENDATIONS.
5. NO EXCAVATION BELOW ELEVATION 721 (EXCEPT FOR MINOR EXCAVATION TO DRILL SOIL ANCHOR) SHALL OCCUR UNTIL ALL SOIL ANCHORS FOR SHORING PARALLEL TO THE RAILROAD HAVE BEEN INSTALLED AND TESTED. THE TWO END ANCHORS SHALL BE INSTALLED AND TESTED PRIOR TO EXCAVATION BELOW ELEVATION 720.
6. HP 12x53 CORNER BRACE SHALL BE INSTALLED PRIOR TO EXCAVATION FOR KEY TRENCH.
7. ALL SHORING AZ-18 SHEET PILING SHALL BE CUT OFF 1-FOOT BELOW FINISHED GRADE AND REMAIN IN PLACE.
8. SOIL ANCHORS TO REMAIN IN PLACE.

Revisions			
Symbol	Descriptions	Date	Approved
◁	REVISED AS CONSTRUCTED	7/02	P.O.C.


BURGESS & NIPLE, LIMITED COLUMBUS, OHIO	U.S.ARMAY ENGINEER DISTRICT CORPS OF ENGINEERS HUNTINGTON, WEST VIRGINIA
Designed by: V.AMATO	SCIO TO RIVER COLUMBUS, OHIO WEST COLUMBUS, L.P.P. PHASE IID
Drawn by: A.PUMMELL	CONRAIL EAST SHORING DETAILS
Checked by: J.HALL	Scale: AS SHOWN
Reviewed by:	Date: MARCH 1998
Approved by:	Drawing Code: 16-PWC-10-
	Sheet reference number: 20.1/6
	FILENAME: a0pdt01.dgn
	PIN TABLE:
	Sheet 1 of 1

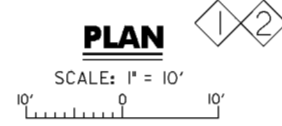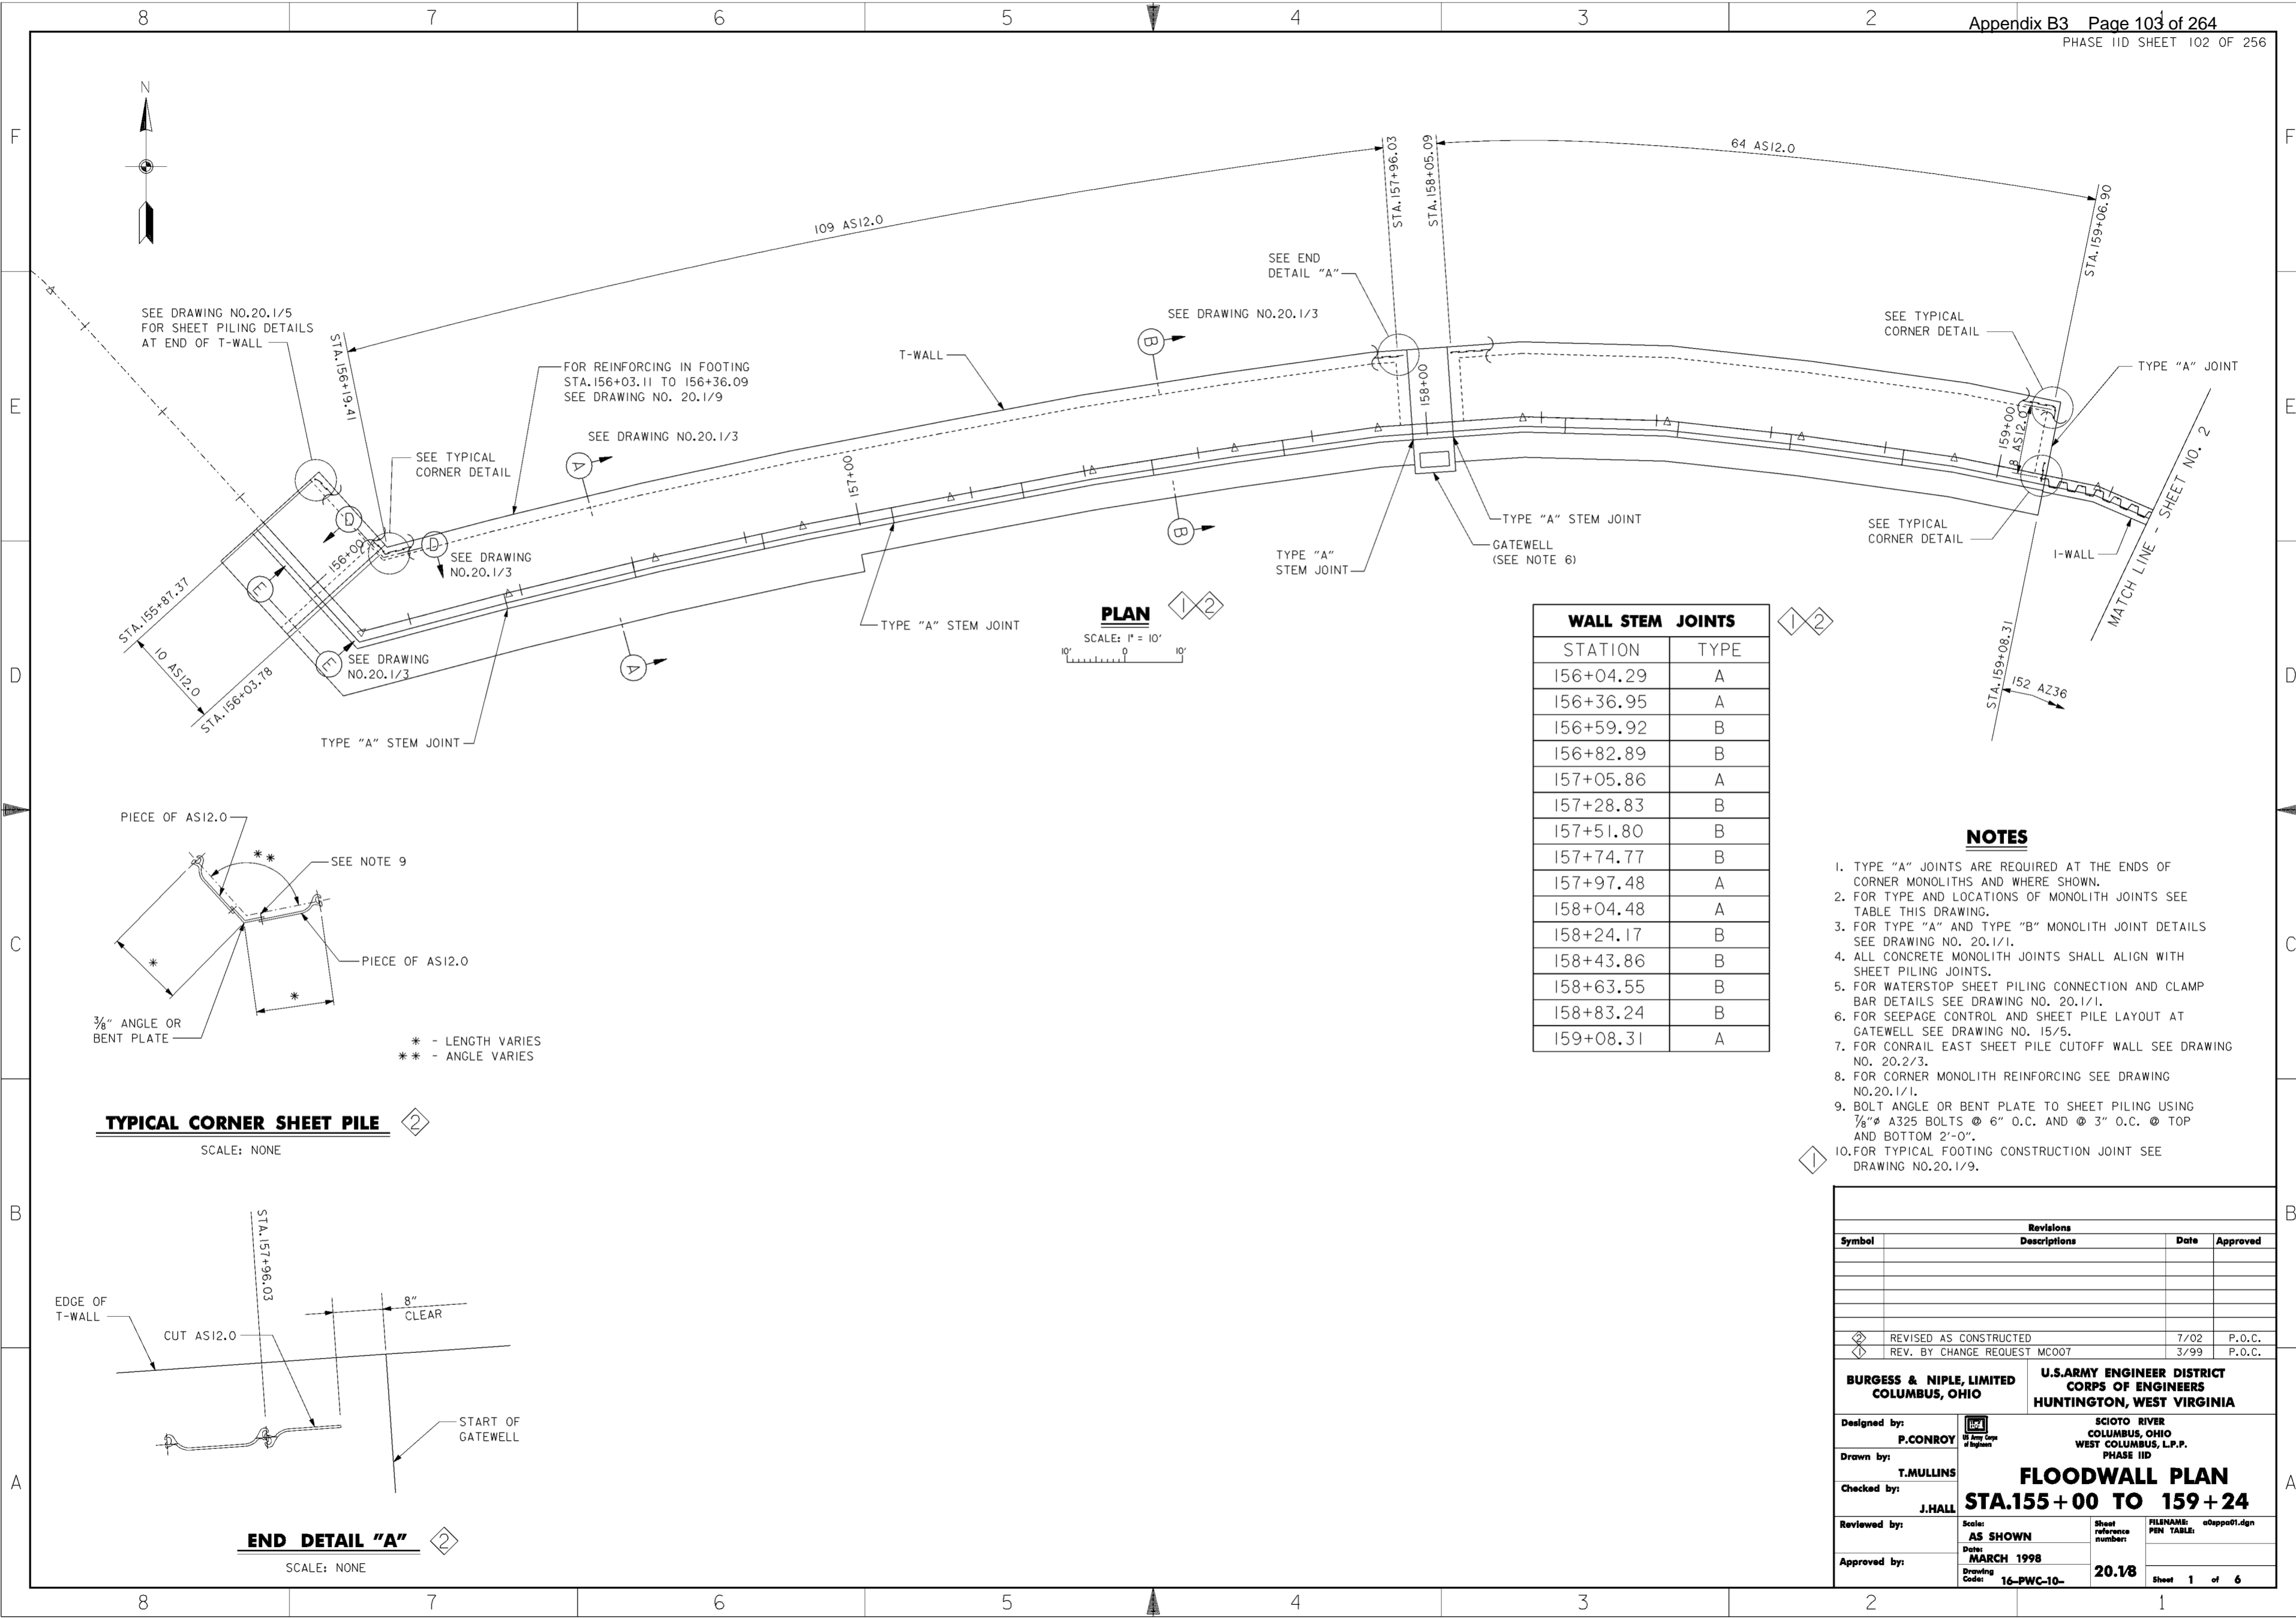


WALL STEM JOINTS	
STATION	TYPE
156+04.29	A
156+36.95	A
156+59.92	B
156+82.89	B
157+05.86	A
157+28.83	B
157+51.80	B
157+74.77	B
157+97.48	A
158+04.48	A
158+24.17	B
158+43.86	B
158+63.55	B
158+83.24	B
159+08.31	A

NOTES

1. TYPE "A" JOINTS ARE REQUIRED AT THE ENDS OF CORNER MONOLITHS AND WHERE SHOWN.
2. FOR TYPE AND LOCATIONS OF MONOLITH JOINTS SEE TABLE THIS DRAWING.
3. FOR TYPE "A" AND TYPE "B" MONOLITH JOINT DETAILS SEE DRAWING NO. 20.1/1.
4. ALL CONCRETE MONOLITH JOINTS SHALL ALIGN WITH SHEET PILING JOINTS.
5. FOR WATERSTOP SHEET PILING CONNECTION AND CLAMP BAR DETAILS SEE DRAWING NO. 20.1/1.
6. FOR SEEPAGE CONTROL AND SHEET PILE LAYOUT AT GATEWELL SEE DRAWING NO. 15/5.
7. FOR CONRAIL EAST SHEET PILE CUTOFF WALL SEE DRAWING NO. 20.2/3.
8. FOR CORNER MONOLITH REINFORCING SEE DRAWING NO.20.1/1.
9. BOLT ANGLE OR BENT PLATE TO SHEET PILING USING 1/8" A325 BOLTS @ 6" O.C. AND @ 3" O.C. @ TOP AND BOTTOM 2'-0".
10. FOR TYPICAL FOOTING CONSTRUCTION JOINT SEE DRAWING NO.20.1/9.

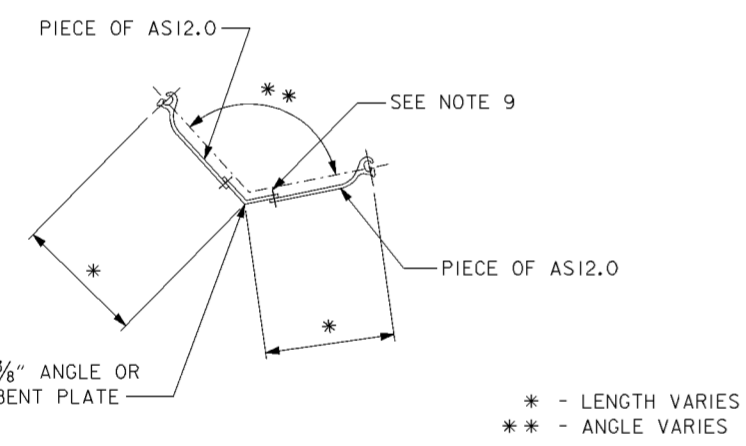



TYPICAL CORNER SHEET PILE
 SCALE: NONE

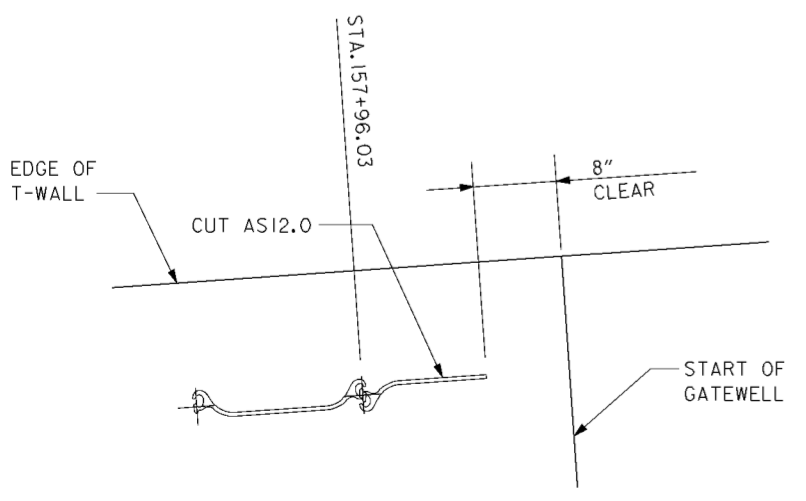

END DETAIL "A"
 SCALE: NONE


Revisions			
Symbol	Descriptions	Date	Approved
◇	REVISED AS CONSTRUCTED	7/02	P.O.C.
◇	REV. BY CHANGE REQUEST MC007	3/99	P.O.C.

BURGESS & NIPLE, LIMITED COLUMBUS, OHIO	U.S. ARMY ENGINEER DISTRICT CORPS OF ENGINEERS HUNTINGTON, WEST VIRGINIA
Designed by: P. CONROY	SCIO TO RIVER COLUMBUS, OHIO WEST COLUMBUS, L.P.P. PHASE IID
Drawn by: T. MULLINS	FLOODWALL PLAN STA. 155 + 00 TO 159 + 24
Checked by: J. HALL	Scale: AS SHOWN
Reviewed by:	Date: MARCH 1998
Approved by:	Drawing Code: 16-PWC-10-
	Sheet reference number: 20.18
	FILENAME: a0ppa01.dgn
	PEN TABLE: Sheet 1 of 6

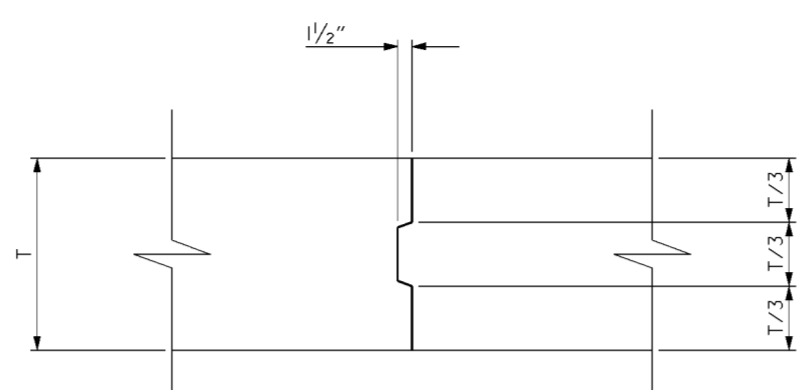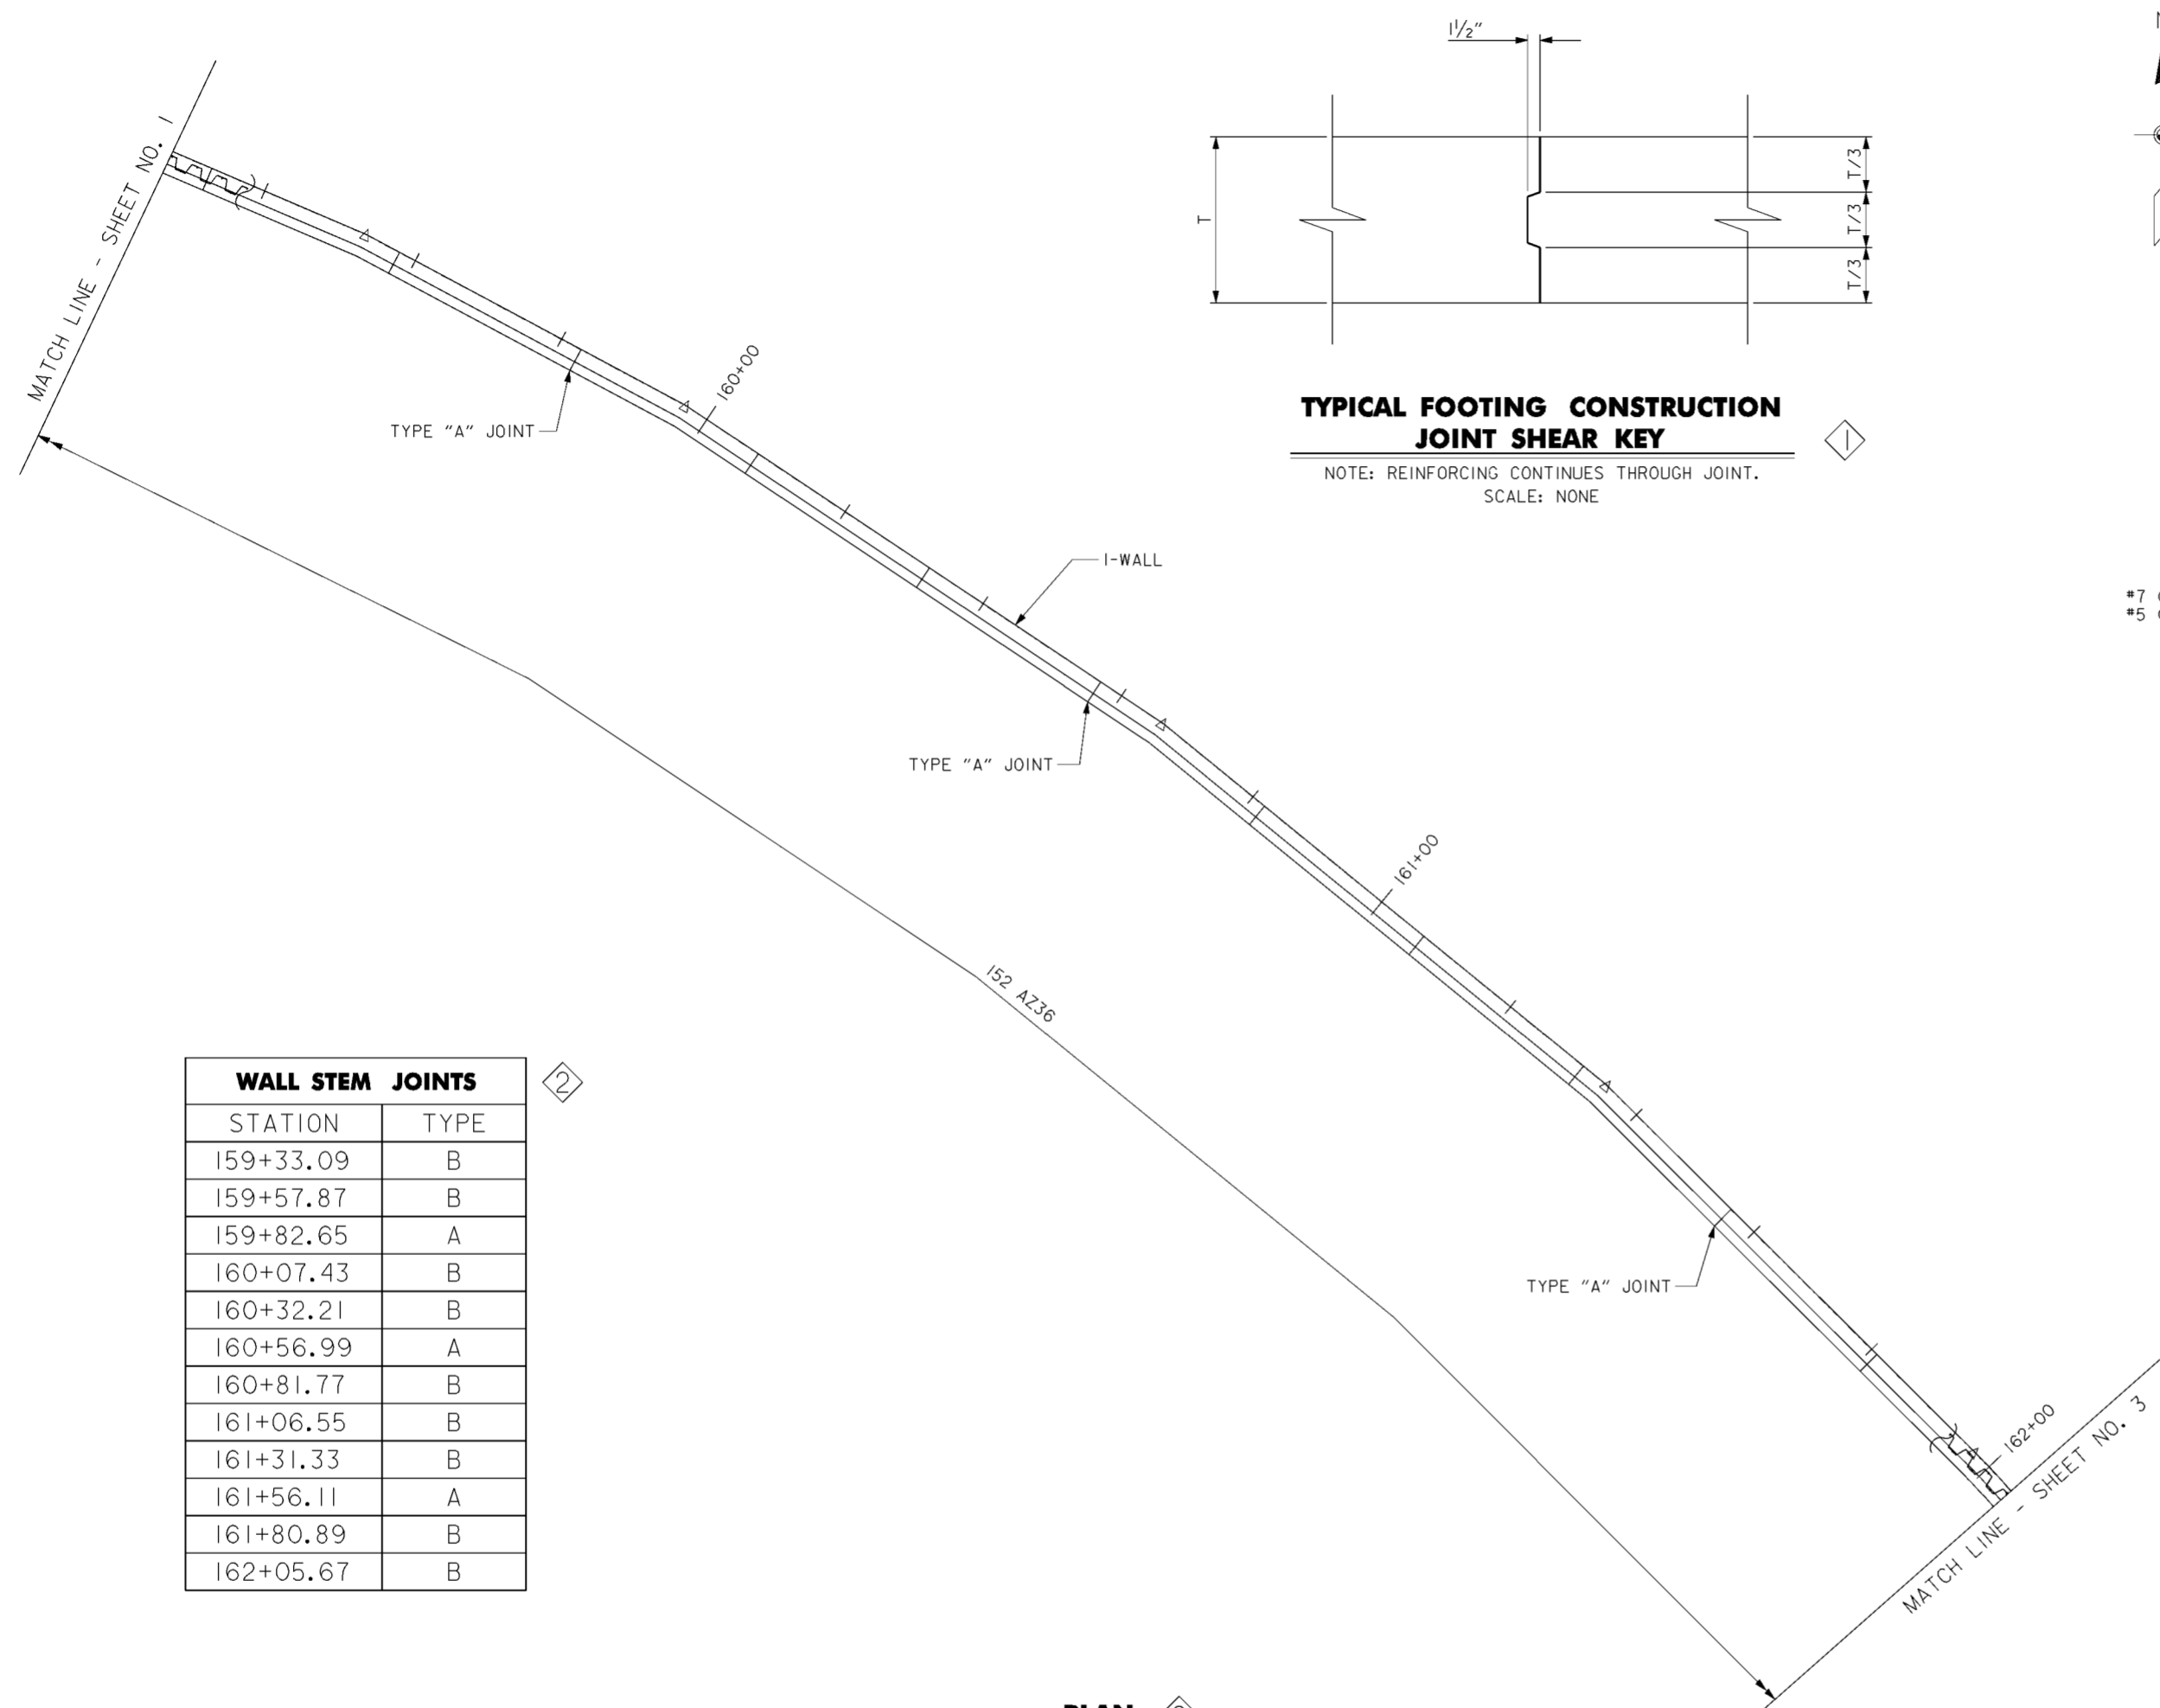

TYPICAL FOOTING CONSTRUCTION JOINT SHEAR KEY


NOTE: REINFORCING CONTINUES THROUGH JOINT.
 SCALE: NONE

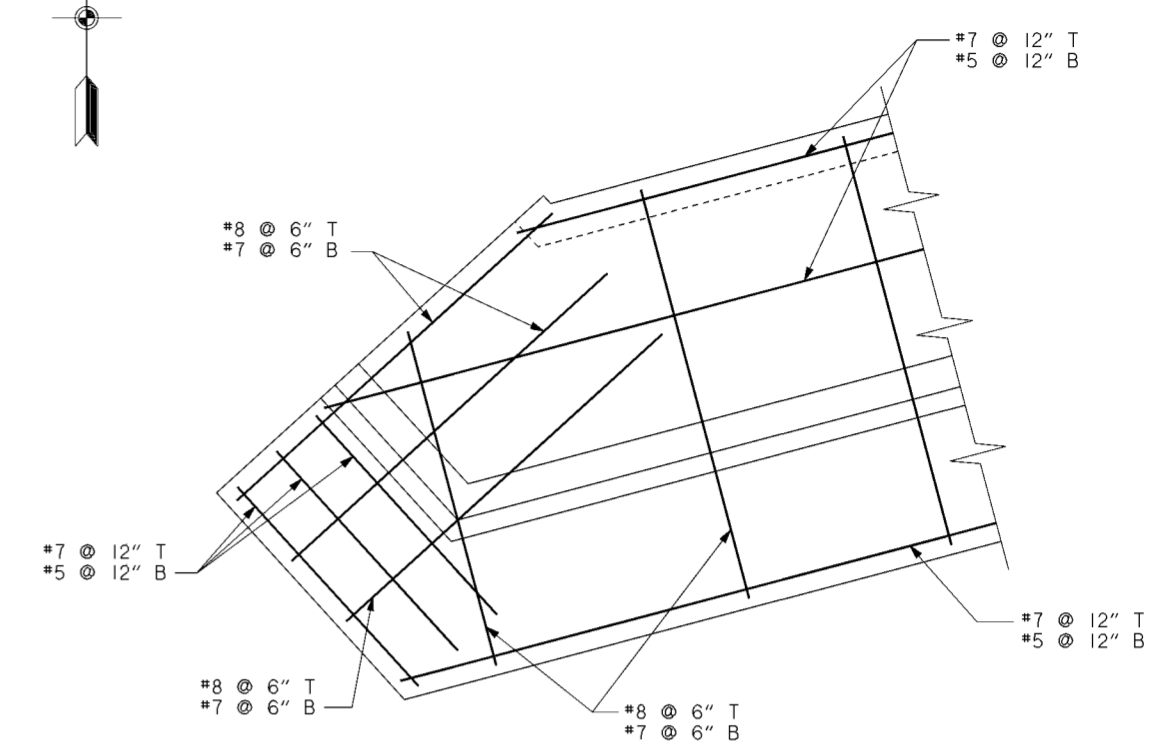

REINFORCING PLAN

TAKEN AT EL. 712.4
 T-WALL FOOTING STA. 156+03.11 TO 156+36.09
 SCALE: 1" = 5'

WALL STEM JOINTS	
STATION	TYPE
159+33.09	B
159+57.87	B
159+82.65	A
160+07.43	B
160+32.21	B
160+56.99	A
160+81.77	B
161+06.55	B
161+31.33	B
161+56.11	A
161+80.89	B
162+05.67	B


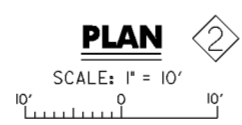


- NOTES**
1. TYPE "A" JOINTS ARE REQUIRED AT ENDS OF CORNER MONOLITHS AND WHERE SHOWN.
 2. FOR TYPE AND LOCATIONS OF MONOLITH JOINTS SEE TABLE THIS DRAWING.
 3. FOR TYPE "A" AND TYPE "B" MONOLITH JOINT DETAILS SEE DRAWING NO. 20.1/1.
 4. ALL CONCRETE MONOLITH JOINTS SHALL ALIGN WITH SHEET PILING JOINTS.
 5. FOR WATERSTOP SHEET PILING CONNECTION AND CLAMP BAR DETAILS SEE DRAWING NO. 20.1/1.
 6. FOR CORNER MONOLITH REINFORCING SEE DRAWING NO. 20.1/1.

Revisions			
Symbol	Descriptions	Date	Approved
◊	REVISED AS CONSTRUCTED	7/02	P.O.C.
◊	REV. BY CHANGE REQUEST MC007	3/99	P.O.C.

BURGESS & NIPLE, LIMITED COLUMBUS, OHIO		U.S. ARMY ENGINEER DISTRICT CORPS OF ENGINEERS HUNTINGTON, WEST VIRGINIA	
		SCIOTO RIVER COLUMBUS, OHIO WEST COLUMBUS, L.P.P. PHASE IID	
Designed by: P. CONROY		FLOODWALL PLAN STA. 159 + 24 TO 162 + 00	
Drawn by: T. MULLINS			
Checked by: J. HALL			
Reviewed by: AS SHOWN			
Approved by: Date: MARCH 1998 Drawing Code: 16-PWC-10-	Scale: AS SHOWN	Sheet reference number: 20.19	FILENAME: a0ppa02.dgn PEN TABLE: Sheet 2 of 6

WORK AS CONSTRUCTED

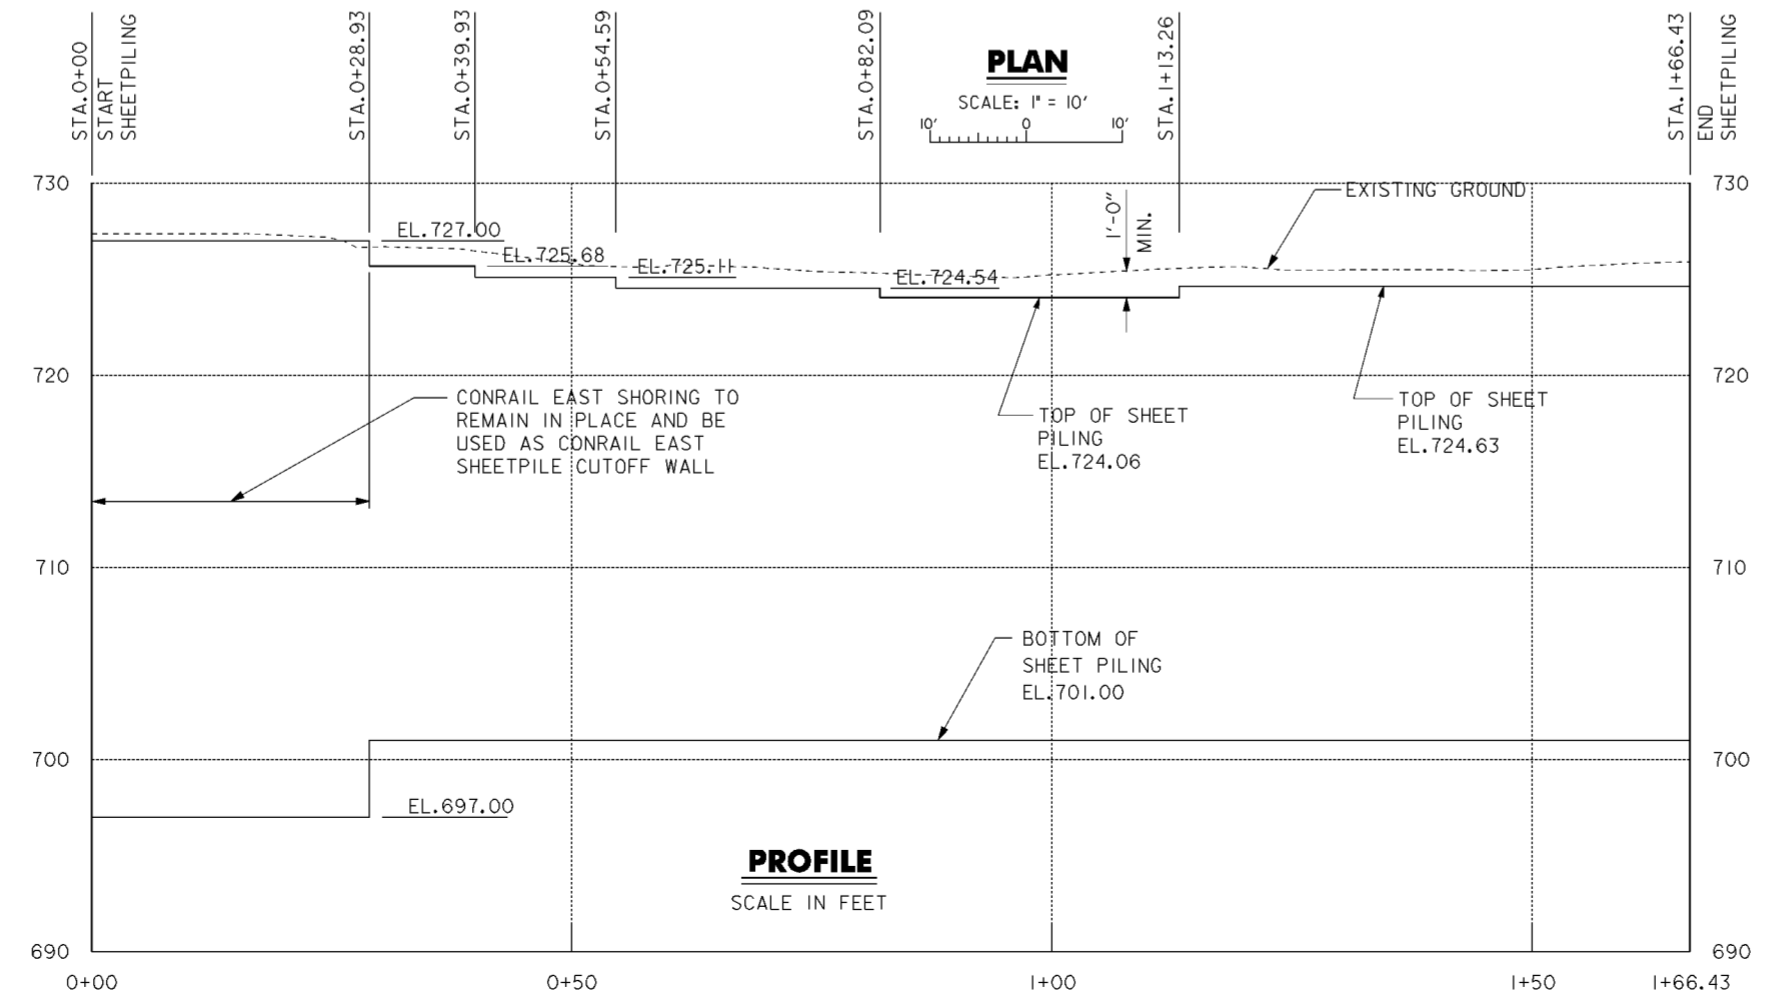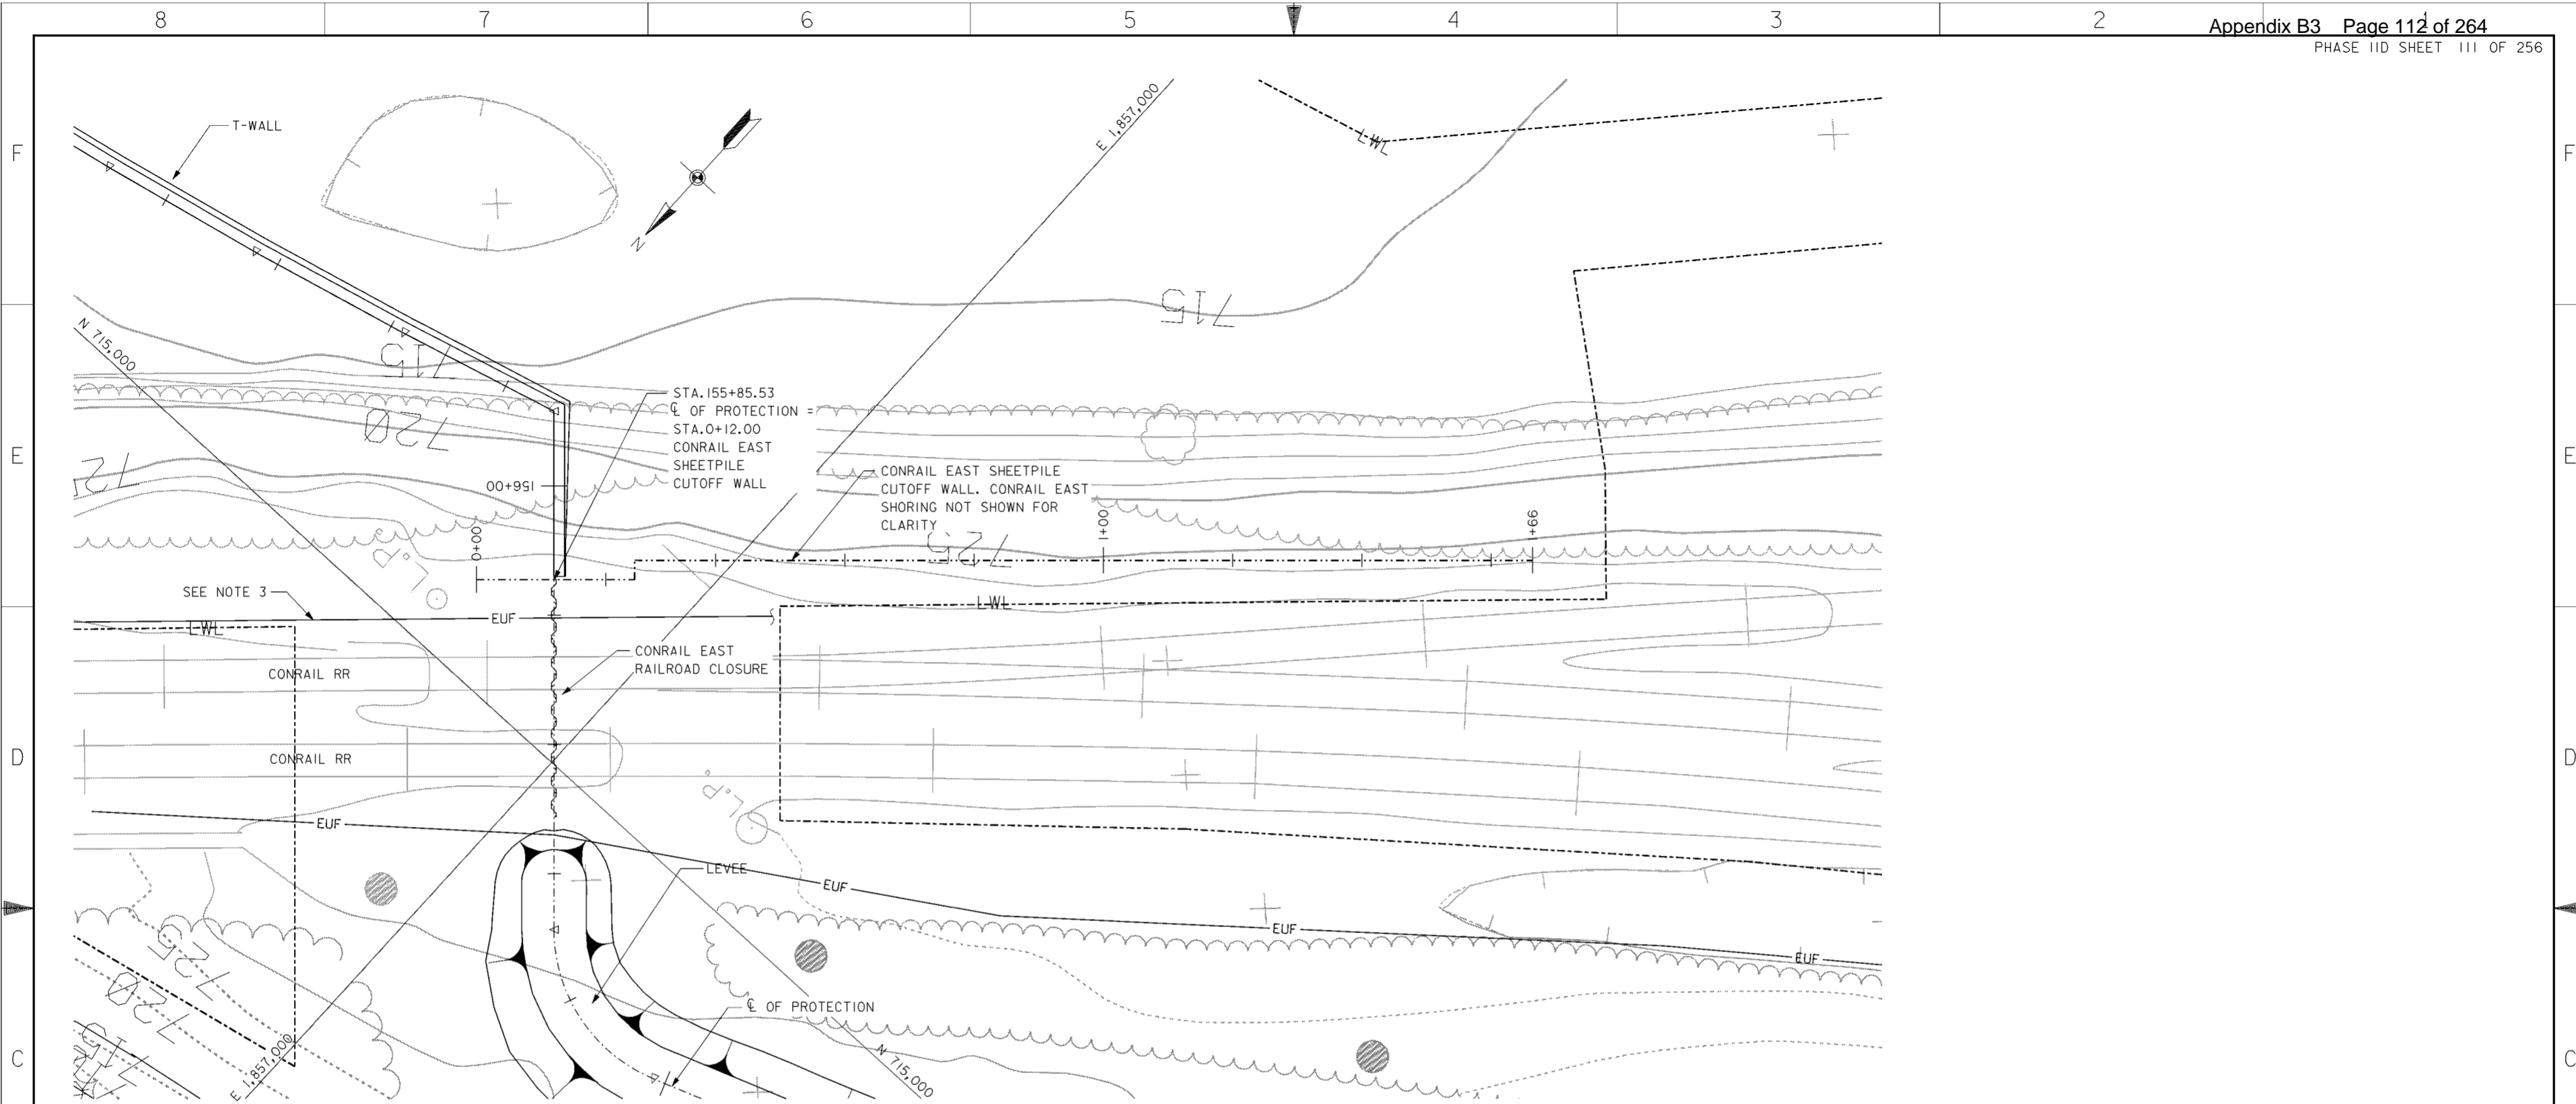


NOTES


1. FOR CONRAIL EAST SHORING PLAN SEE DRAWING NO.20.1/5.
2. FOR CONRAIL EAST RAILROAD CLOSURE DETAILS SEE DRAWING NO.20.2/2.
3. 0-WEST FIBER OPTIC LINE LOCATED IN RAILROAD RIGHT-OF-WAY SOUTH OF CONRAIL TRACKS. THE CONTRACTOR SHALL HAVE LINE LOCATED BY THE OWNING COMPANY PRIOR TO EXCAVATION OR INSTALLATION OF PILING.

Revisions			
Symbol	Descriptions	Date	Approved


BURGESS & NIPLE, LIMITED COLUMBUS, OHIO		U.S. ARMY ENGINEER DISTRICT CORPUS OF ENGINEERS HUNTINGTON, WEST VIRGINIA	
		SCIOTO RIVER COLUMBUS, OHIO WEST COLUMBUS, L.P.P. PHASE IID	
Designed by: J. HALL	CONRAIL EAST RR SHEETPILE CUTOFF WALL	Scale: AS SHOWN	Sheet reference number: 20.23
Drawn by: T. MULLINS		Date: MARCH 1998	FILENAME: 00app03.dgn
Checked by: V. AMATO		Drawing Code: 16-PWC-10-	PEN TABLE: Sheet 1 of 1
Reviewed by: (Signature)		Approved by: (Signature)	(Blank)

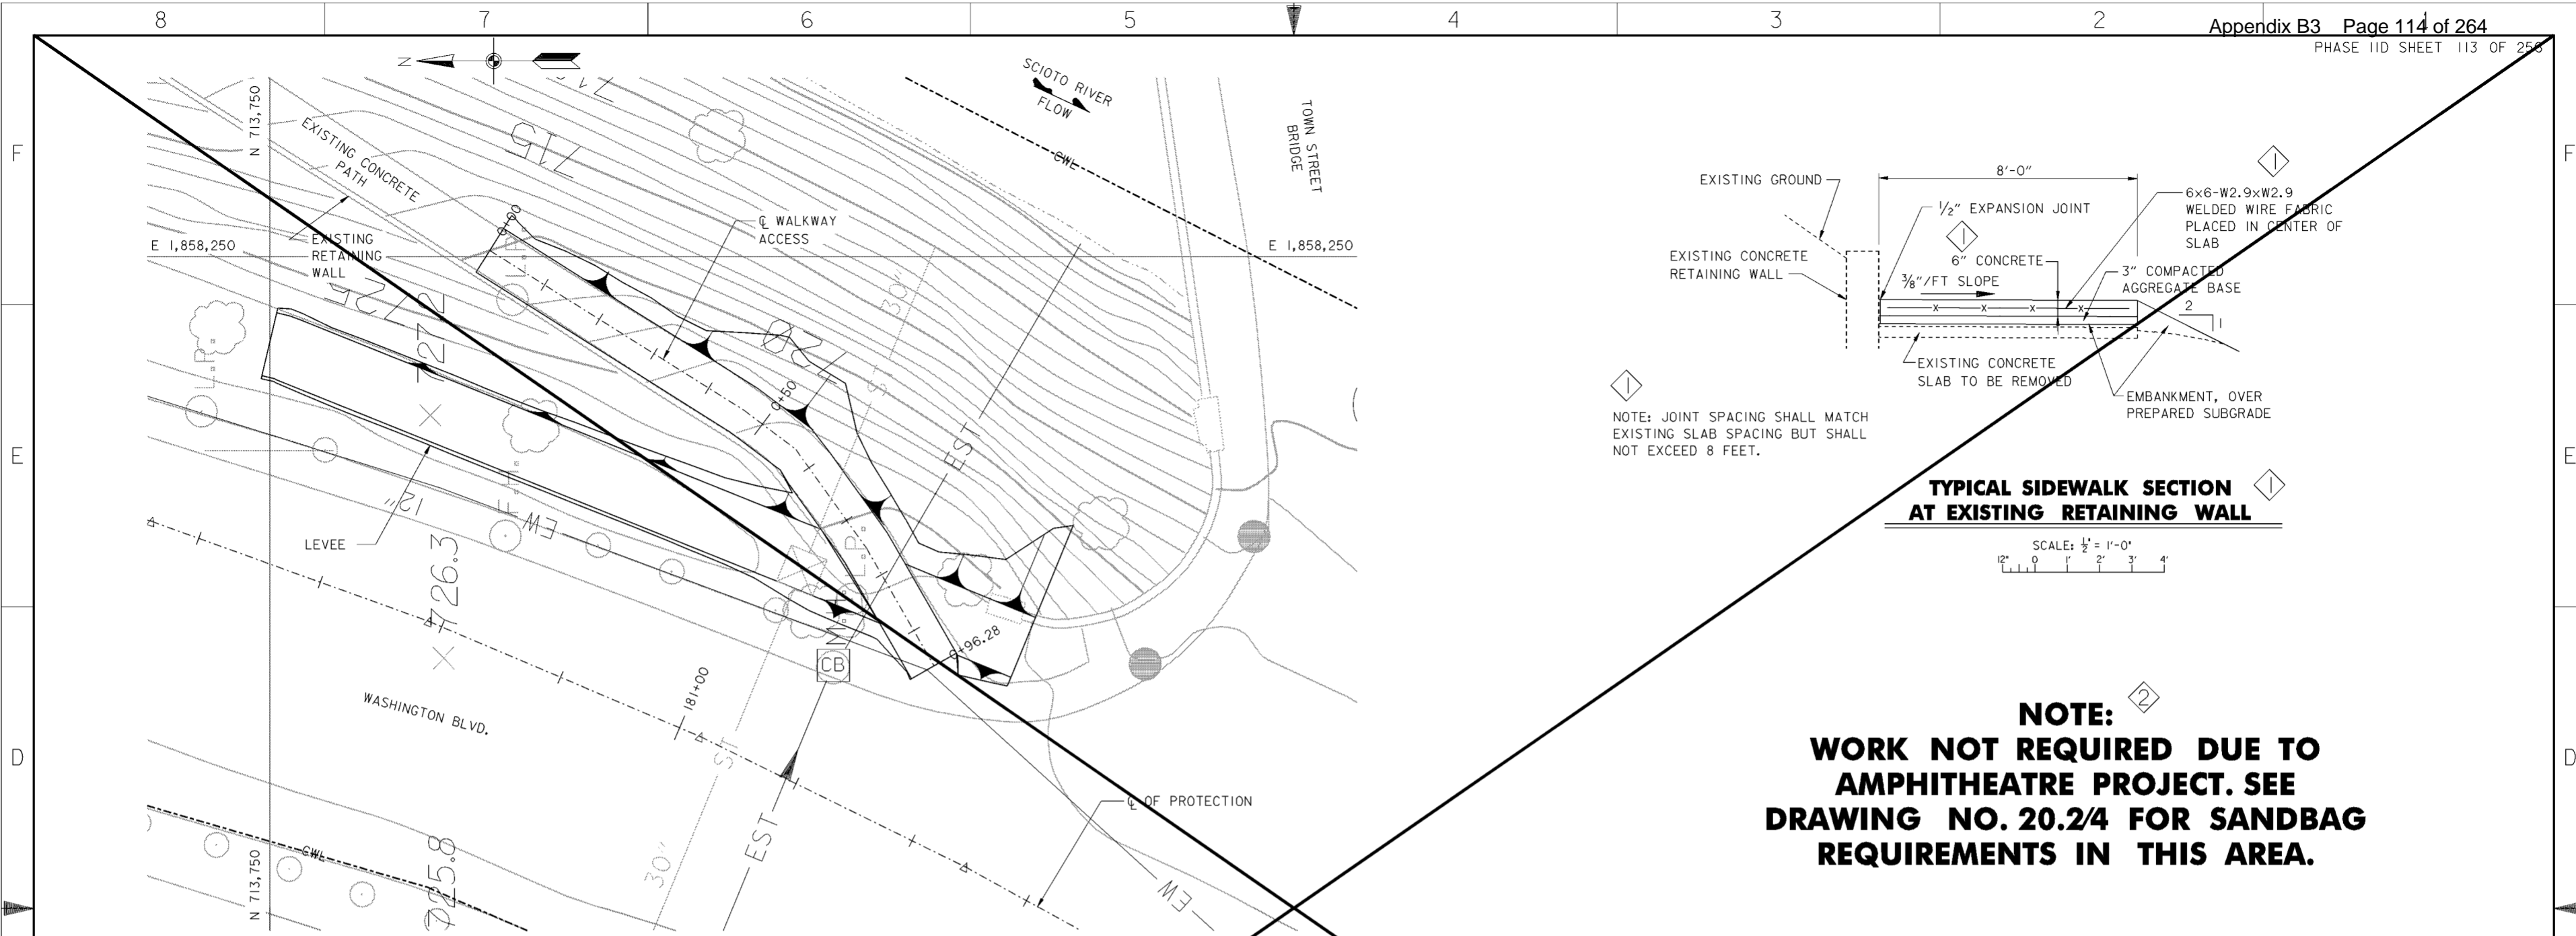

PLAN
 SCALE: 1" = 10'

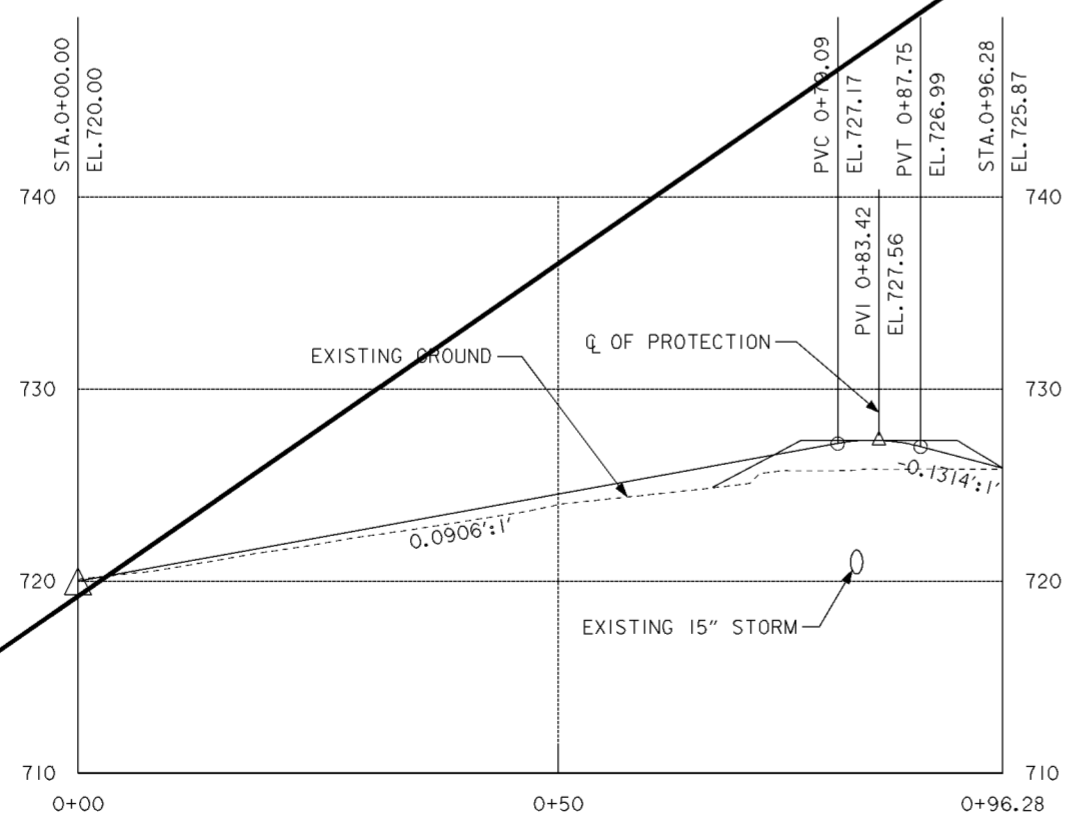

PROFILE
 SCALE IN FEET

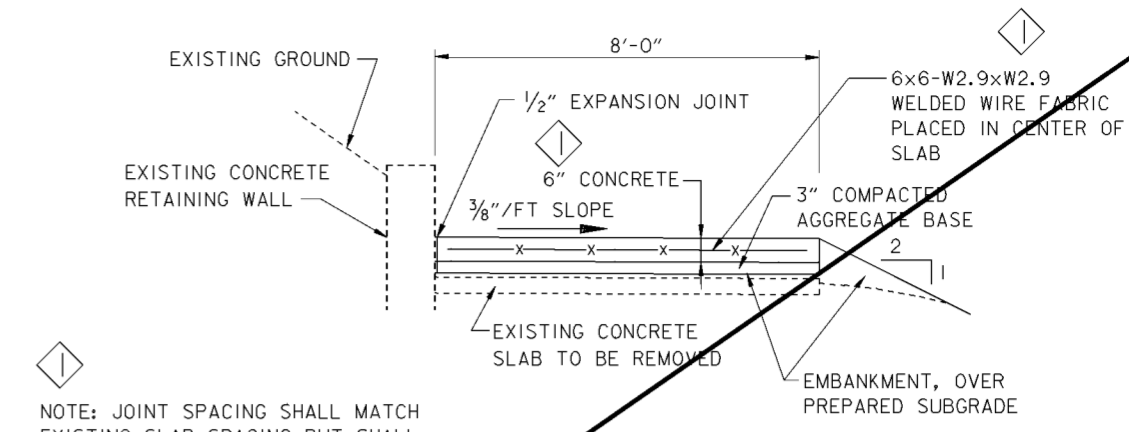

TYPICAL SIDEWALK SECTION AT EXISTING RETAINING WALL

SCALE: 1/2" = 1'-0"
 12' 0' 1' 2' 3' 4'



NOTE:
WORK NOT REQUIRED DUE TO AMPHITHEATRE PROJECT. SEE DRAWING NO. 20.2/4 FOR SANDBAG REQUIREMENTS IN THIS AREA.

HORIZONTAL ALIGNMENT

Review Horizontal Alignment Single	STATION	NORTHING	EASTING
Element: LINEAR			
POB ()	0+00.00	713715.96	1858250.93
PI ()	0+46.42	713676.66	1858226.21
Tangent Direction:	S 32°10' 18.44" W		
Tangent Length:	46.42		
Review Horizontal Alignment Single	STATION	NORTHING	EASTING
Element: LINEAR			
PI ()	0+46.42	713676.66	1858226.21
PI ()	0+56.52	713668.58	1858220.15
Tangent Direction:	S 36°54' 14.20" W		
Tangent Length:	10.10		
Review Horizontal Alignment Single	STATION	NORTHING	EASTING
Element: LINEAR			
PI ()	0+56.52	713668.59	1858220.15
PI ()	0+75.24	713657.71	1858204.92
Tangent Direction:	S 54°26' 42.87" W		
Tangent Length:	18.72		
Review Horizontal Alignment Single	STATION	NORTHING	EASTING
Element: LINEAR			
PI ()	0+75.24	713657.71	1858204.92
POE ()	0+96.28	713647.24	1858186.67
Tangent Direction:	S 60°09' 29.42" W		
Tangent Length:	21.04		


Revisions			
Symbol	Descriptions	Date	Approved
◊	REVISED AS CONSTRUCTED	7/02	P.O.C.
◊	REVISED IN ACCORDANCE WITH AMENDMENT 0001	4-23-98	P.O.C.

BURGESS & NIPLE, LIMITED COLUMBUS, OHIO	U.S. ARMY ENGINEER DISTRICT CORPS OF ENGINEERS HUNTINGTON, WEST VIRGINIA
Drawn by: T. MULLINS	TOWN STREET WALKWAY ACCESS PLAN & PROFILE
Checked by: P. CONROY	
Reviewed by: AS SHOWN	Scale: AS SHOWN
Approved by: MARCH 1998	Drawing Code: 16-PWC-10-
Sheet reference number: 20.2/5	FILENAME: a02pp01.dgn
PEN TABLE: 20.2/5	Sheet 1 of 1

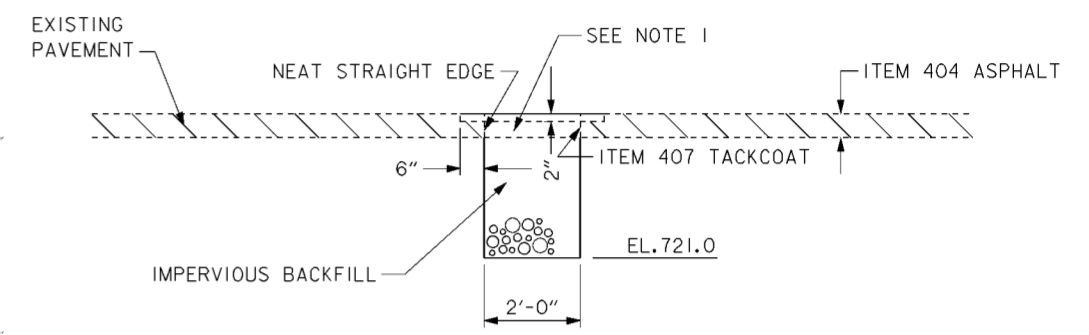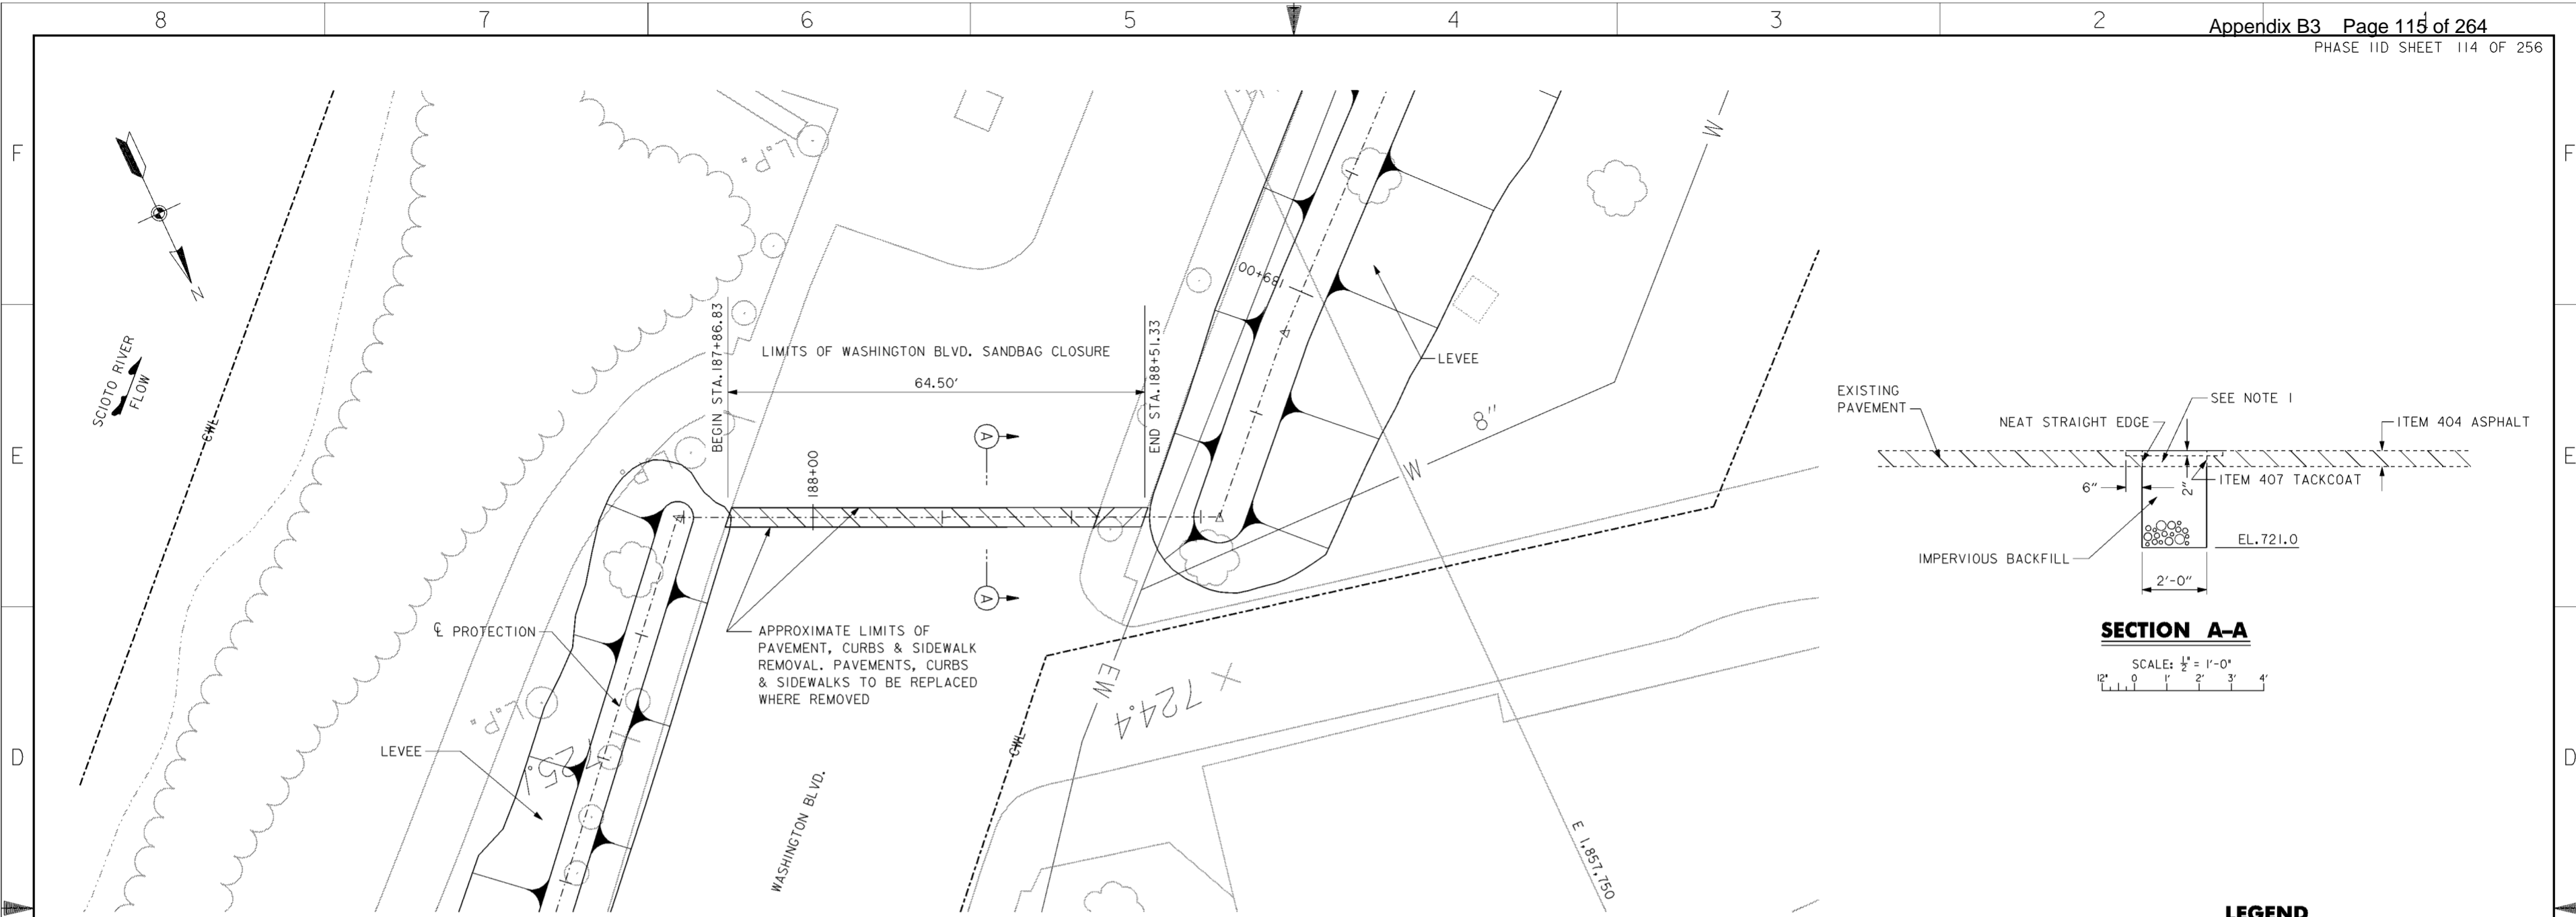

SECTION A-A
 SCALE: 1/2" = 1'-0"
 12" 0 1' 2' 3' 4'

PLAN
 SCALE: 1" = 10'

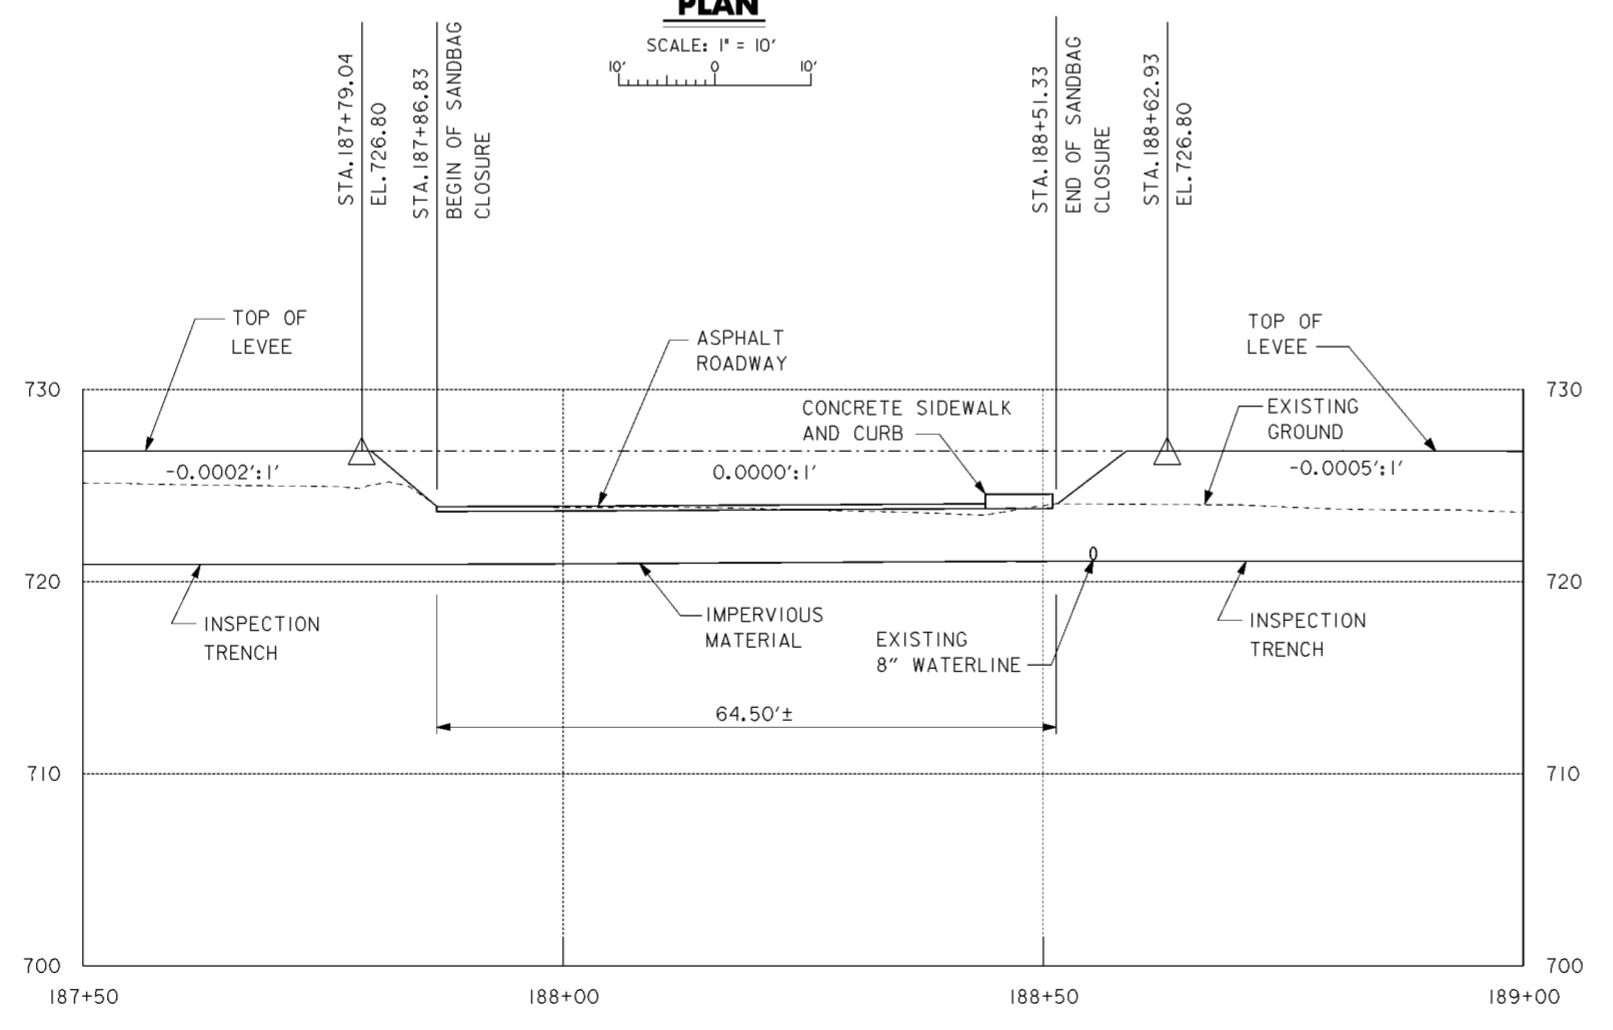

PROFILE
 SCALE IN FEET

LEGEND

- ASPHALT PAVEMENT
- CONCRETE SIDEWALK AND CURB

NOTES

1. FOR PAVEMENT REMOVAL AND REPLACEMENT DETAILS AND SIDEWALK/CURB REMOVAL LIMITS SEE CITY OF COLUMBUS STANDARD CONSTRUCTION DRAWING NO. 1441 DR. A.
2. FOR SIDEWALK REPLACEMENT SEE CITY OF COLUMBUS STANDARD CONSTRUCTION DRAWING NO. 2300 DR. A.
3. FOR CURB REPLACEMENT SEE CITY OF COLUMBUS STANDARD CONSTRUCTION DRAWING NO. 2000 DR. A.

Revisions			
Symbol	Descriptions	Date	Approved

BURGESS & NIPLE, LIMITED COLUMBUS, OHIO	U.S. ARMY ENGINEER DISTRICT CORPS OF ENGINEERS HUNTINGTON, WEST VIRGINIA
Designed by: J. HALL	SCIO TO RIVER COLUMBUS, OHIO WEST COLUMBUS, L.P.P. PHASE IID
Drawn by: T. MULLINS	WASHINGTON BLVD. CLOSURE PLAN & PROFILE
Checked by: P. CONROY	Scale: AS SHOWN
Reviewed by:	Date: MARCH 1998
Approved by:	Drawing Code: 16-PWC-10-
Sheet reference number: 20.2/6	FILENAME: PEN TABLE: 00g5pp01.dgn Sheet 1 of 1

STRUCTURAL GENERAL NOTES








- PROVIDE 1" CHAMFER ON ALL EXPOSED EDGES OR CORNERS UNLESS OTHERWISE SHOWN.
- UNLESS OTHERWISE SHOWN OR DIRECTED, BAR BENDING DETAILS SHALL CONFORM TO THE REQUIREMENTS OF THE AMERICAN CONCRETE INSTITUTE.
- THE CLEAR DISTANCE BETWEEN THE FACE OF THE CONCRETE AND THE (BOTTOM OF TEXTURED FINISH) SURFACE OF THE MAIN REINFORCING STEEL SHALL BE 4" UNLESS OTHERWISE SHOWN.
- REINFORCING STEEL MAY BE SPLICED IN PLACES OTHER THAN SHOWN FOR CONSTRUCTION PURPOSES, SUBJECT TO THE APPROVAL OF THE CONTRACTING OFFICER.
- ABBREVIATIONS:

B - BOTTOM	CLR. - CLEAR
T - TOP	C.J. - CONSTRUCTION JOINT
E.F. - EACH FACE	CONTR. JT. - CONTRACTION JOINT
(E) - EPOXY COATED	CL. - CLEARANCE
E.W. - EACH WAY	TYP. - TYPICAL
EA. - EACH	MK. - MARK
EJFS- PREMOLDED EXPANSION JOINT FILLER STRIP	WS. - WATERSTOP
LLH - LONG LEG HORIZONTAL	H - HORIZONTAL
	V - VERTICAL
- CUT AND HOOK HORIZONTAL AND VERTICAL BARS AT OPENINGS.
- ALL REINFORCING STEEL SHALL BE ASTM A615 GRADE 60.
- ALL SPLICES SHALL BE CLASS B UNLESS OTHERWISE SHOWN. CLASS B SPLICE LENGTH SHALL BE 1.3 TIMES THE DEVELOPMENT LENGTH GIVEN IN THE TABLE BELOW.
- DEVELOPMENT LENGTHS UNLESS OTHERWISE SHOWN OR DIRECTED SHALL BE AS FOLLOWS:

BAR SIZE	DEVELOPMENT LENGTH (L _d) INCHES *	
	TOP BARS **	OTHERS
3	13	12
4	17	14
5	22	17
6	26	20
7	38	29
8	43	33
9	49	38
10	55	42
11	61	47


* PLUS CLEARANCE
 ** TOP HORIZONTAL SLAB AND FOUNDATION BARS WITH MORE THAN 12" OF FRESH CONCRETE BELOW THE BARS.

- ALL CONCRETE SHALL HAVE A MINIMUM COMPRESSIVE STRENGTH (f'_c) OF 3,000 P.S.I. AT 28 DAYS, UNLESS OTHERWISE NOTED.
- TO FACILITATE CONSTRUCTION, HORIZONTAL STEM REINFORCEMENT IN FLOODWALL MONOLITHS MAY BE PLACED ON EITHER SIDE OF VERTICAL REINFORCEMENT PROVIDED THE REQUIRED CONCRETE COVER ON THE VERTICAL REINFORCING BARS IS MAINTAINED.
- ALL WELDING SHALL BE IN ACCORDANCE WITH THE AMERICAN WELDING SOCIETY STRUCTURAL WELDING CODE D1.1 OR D1.2.
- UNLESS OTHERWISE NOTED, ALL ITEMS NOTED C.R.S. SHALL BE CORROSION RESISTANT STEEL.
- ALL DOWEL BAR SUBSTITUTES SHALL BE LENTON FORM SAVER BY ERICO OR EQUAL.
- ALL GROUT SHALL BE NONSHRINK, NON-METALLIC, NONSTAINING, CAPABLE OF DEVELOPING A MINIMUM COMPRESSIVE STRENGTH OF 6000 PSI AT 28 DAYS. THE GROUT SHALL CONFORM TO ASTM C1107 OR CRD-C621 AND INSTALLED AS PER THE MANUFACTURERS RECOMMENDATIONS. ALL DRILLED HOLES SHALL BE DONE USING A ROTARY PERCUSSION DRILL.

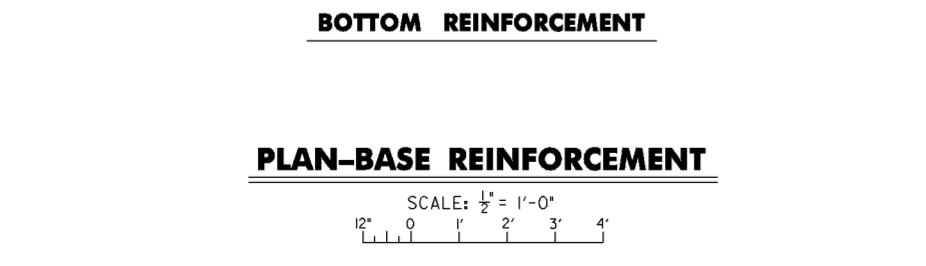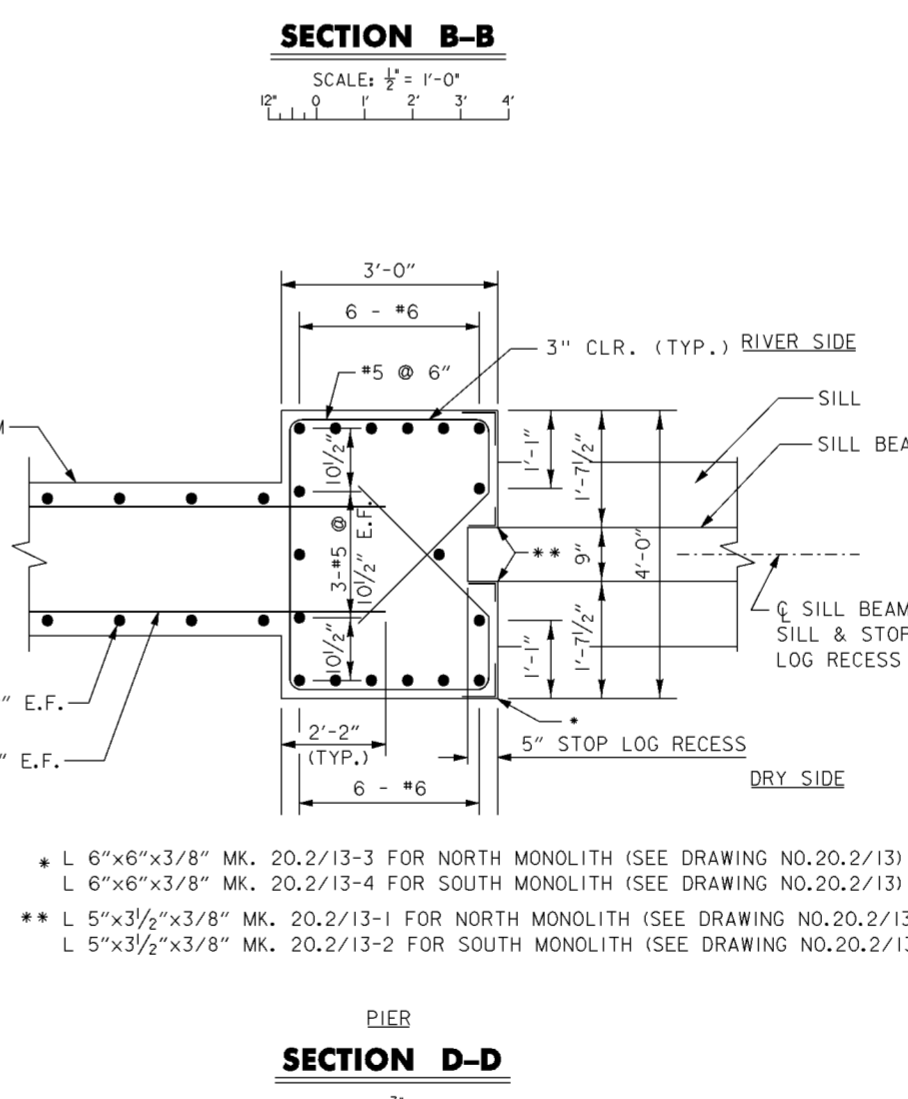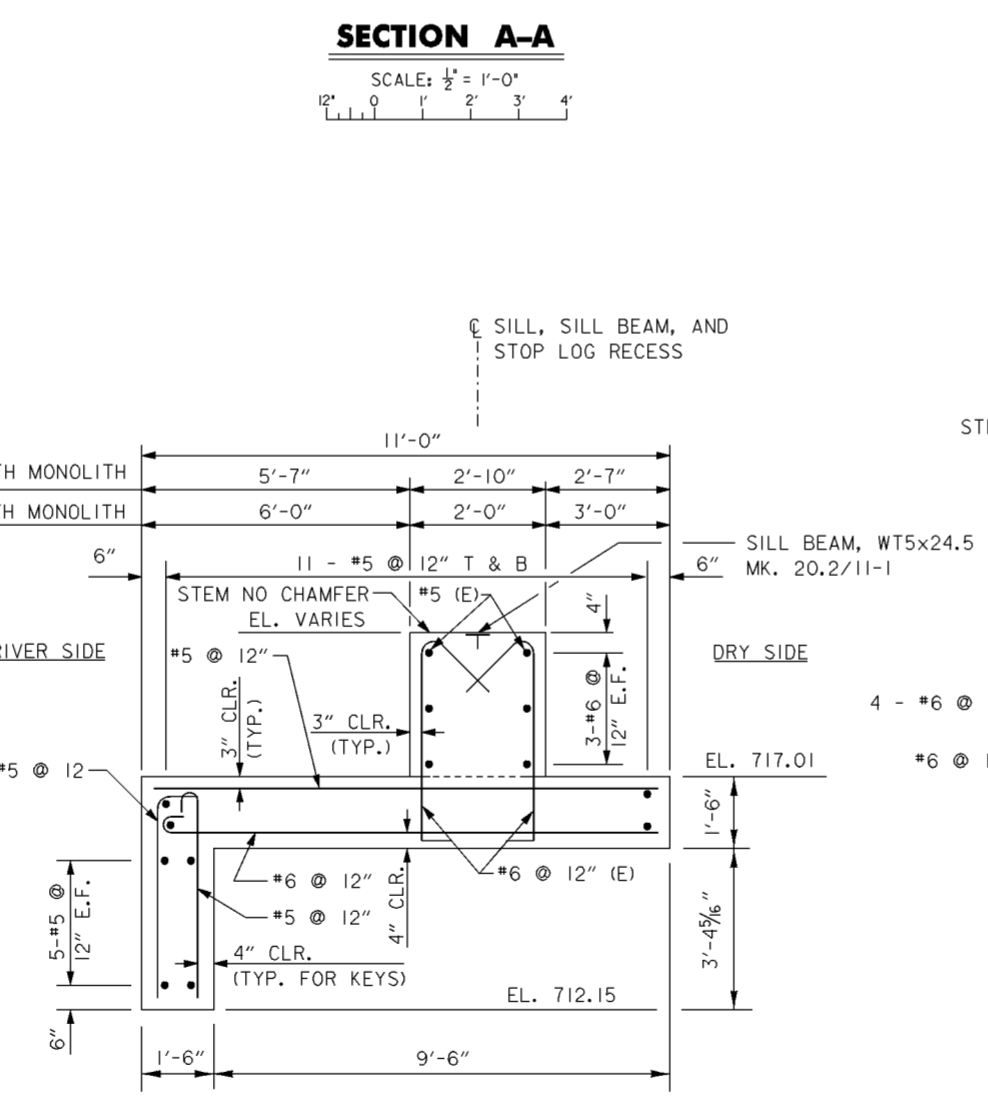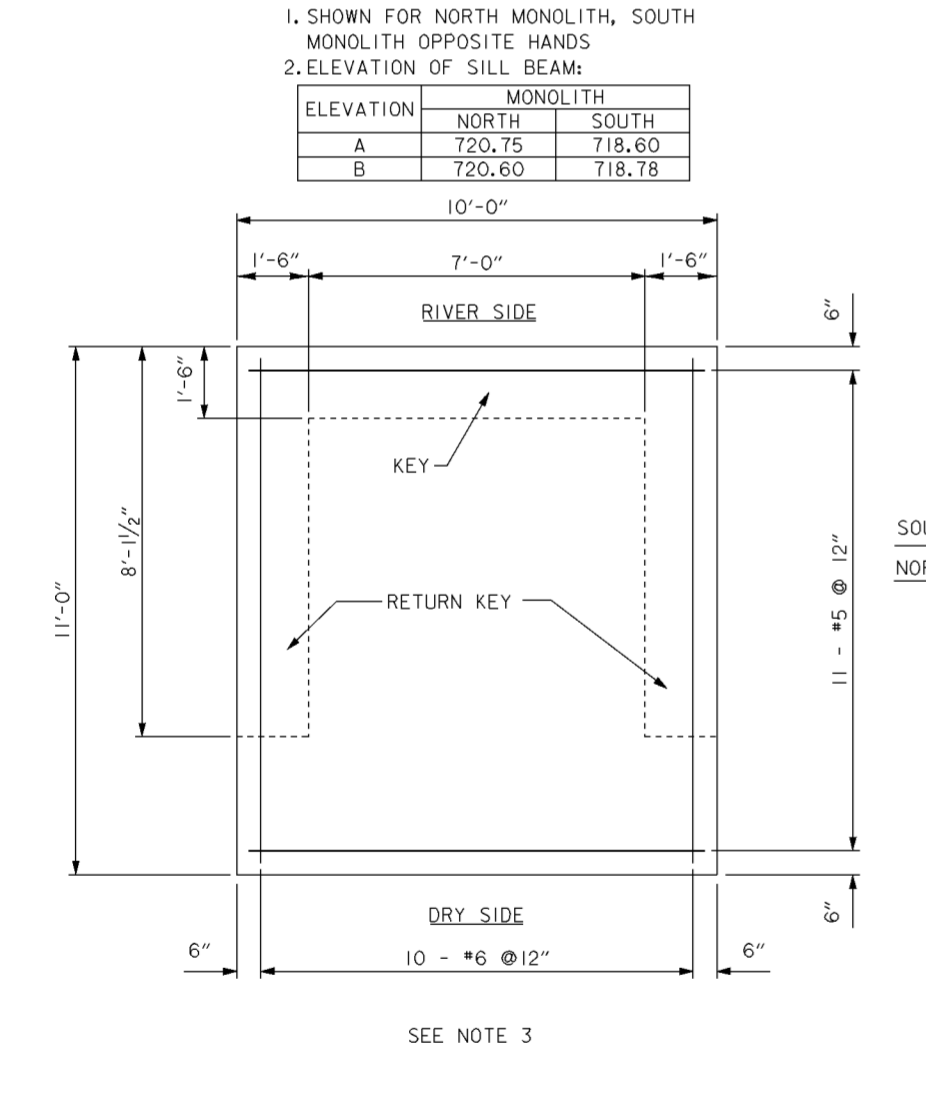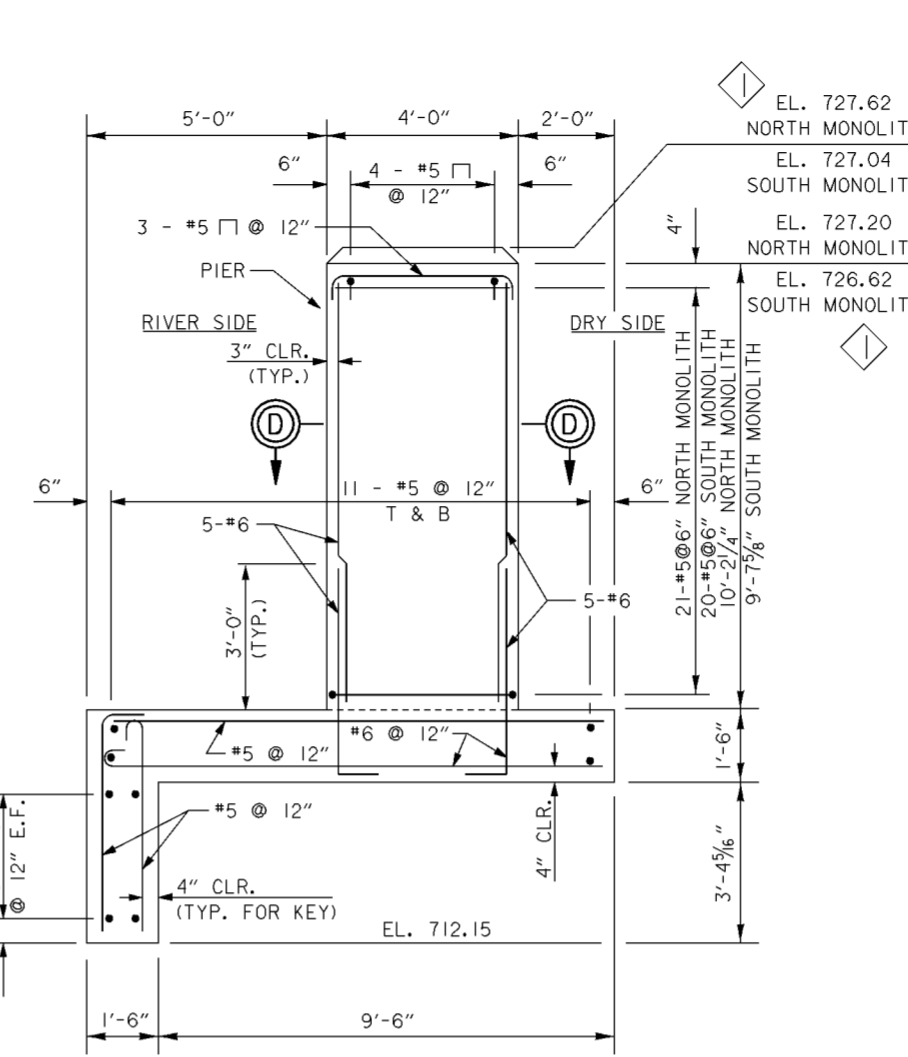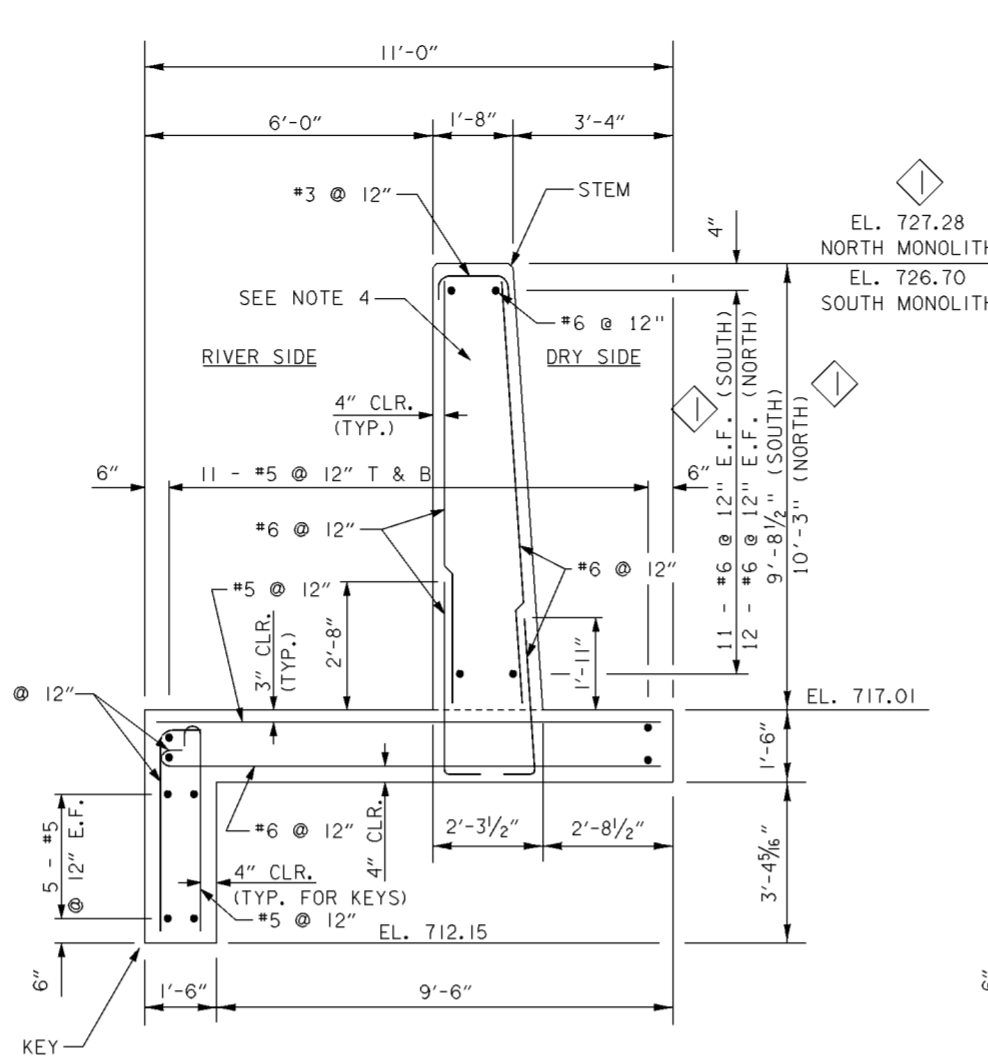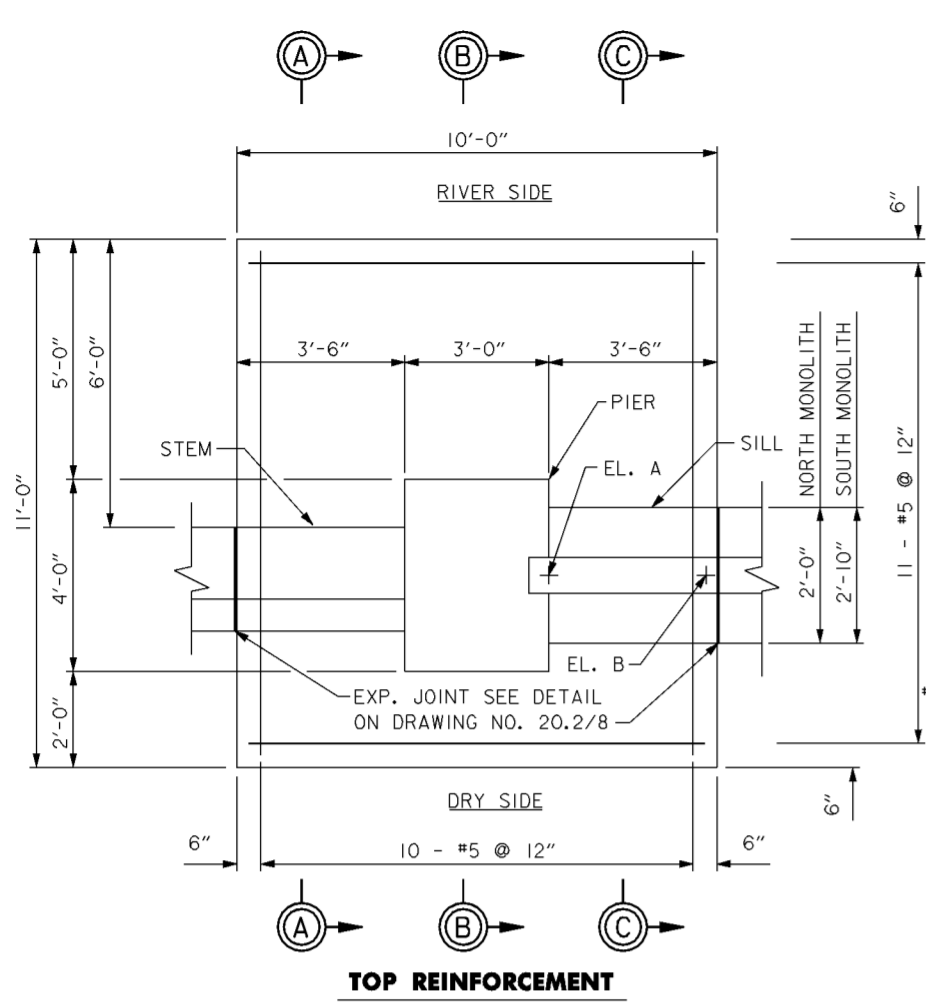

Revisions			
Symbol	Descriptions	Date	Approved
◁	REVISED AS CONSTRUCTED	7/02	P.O.C.

BURGESS & NIPLE, LIMITED COLUMBUS, OHIO	U.S. ARMY ENGINEER DISTRICT CORPS OF ENGINEERS HUNTINGTON, WEST VIRGINIA
Designed by: L.LINZELL	SCIO TO RIVER COLUMBUS, OHIO WEST COLUMBUS, L.P.P. PHASE IID
Drawn by: D.BECKNER	BUTRESS MONOLITHS REINF
Checked by: D.TRAINA	Scale: AS SHOWN
Reviewed by:	Date: MARCH 1998
Approved by:	Drawing Code: 16-PWC-10-
	Sheet reference number: 20.29
	FILENAME: a06m01.dgn
	PEN TABLE: Sheet 1 of 1

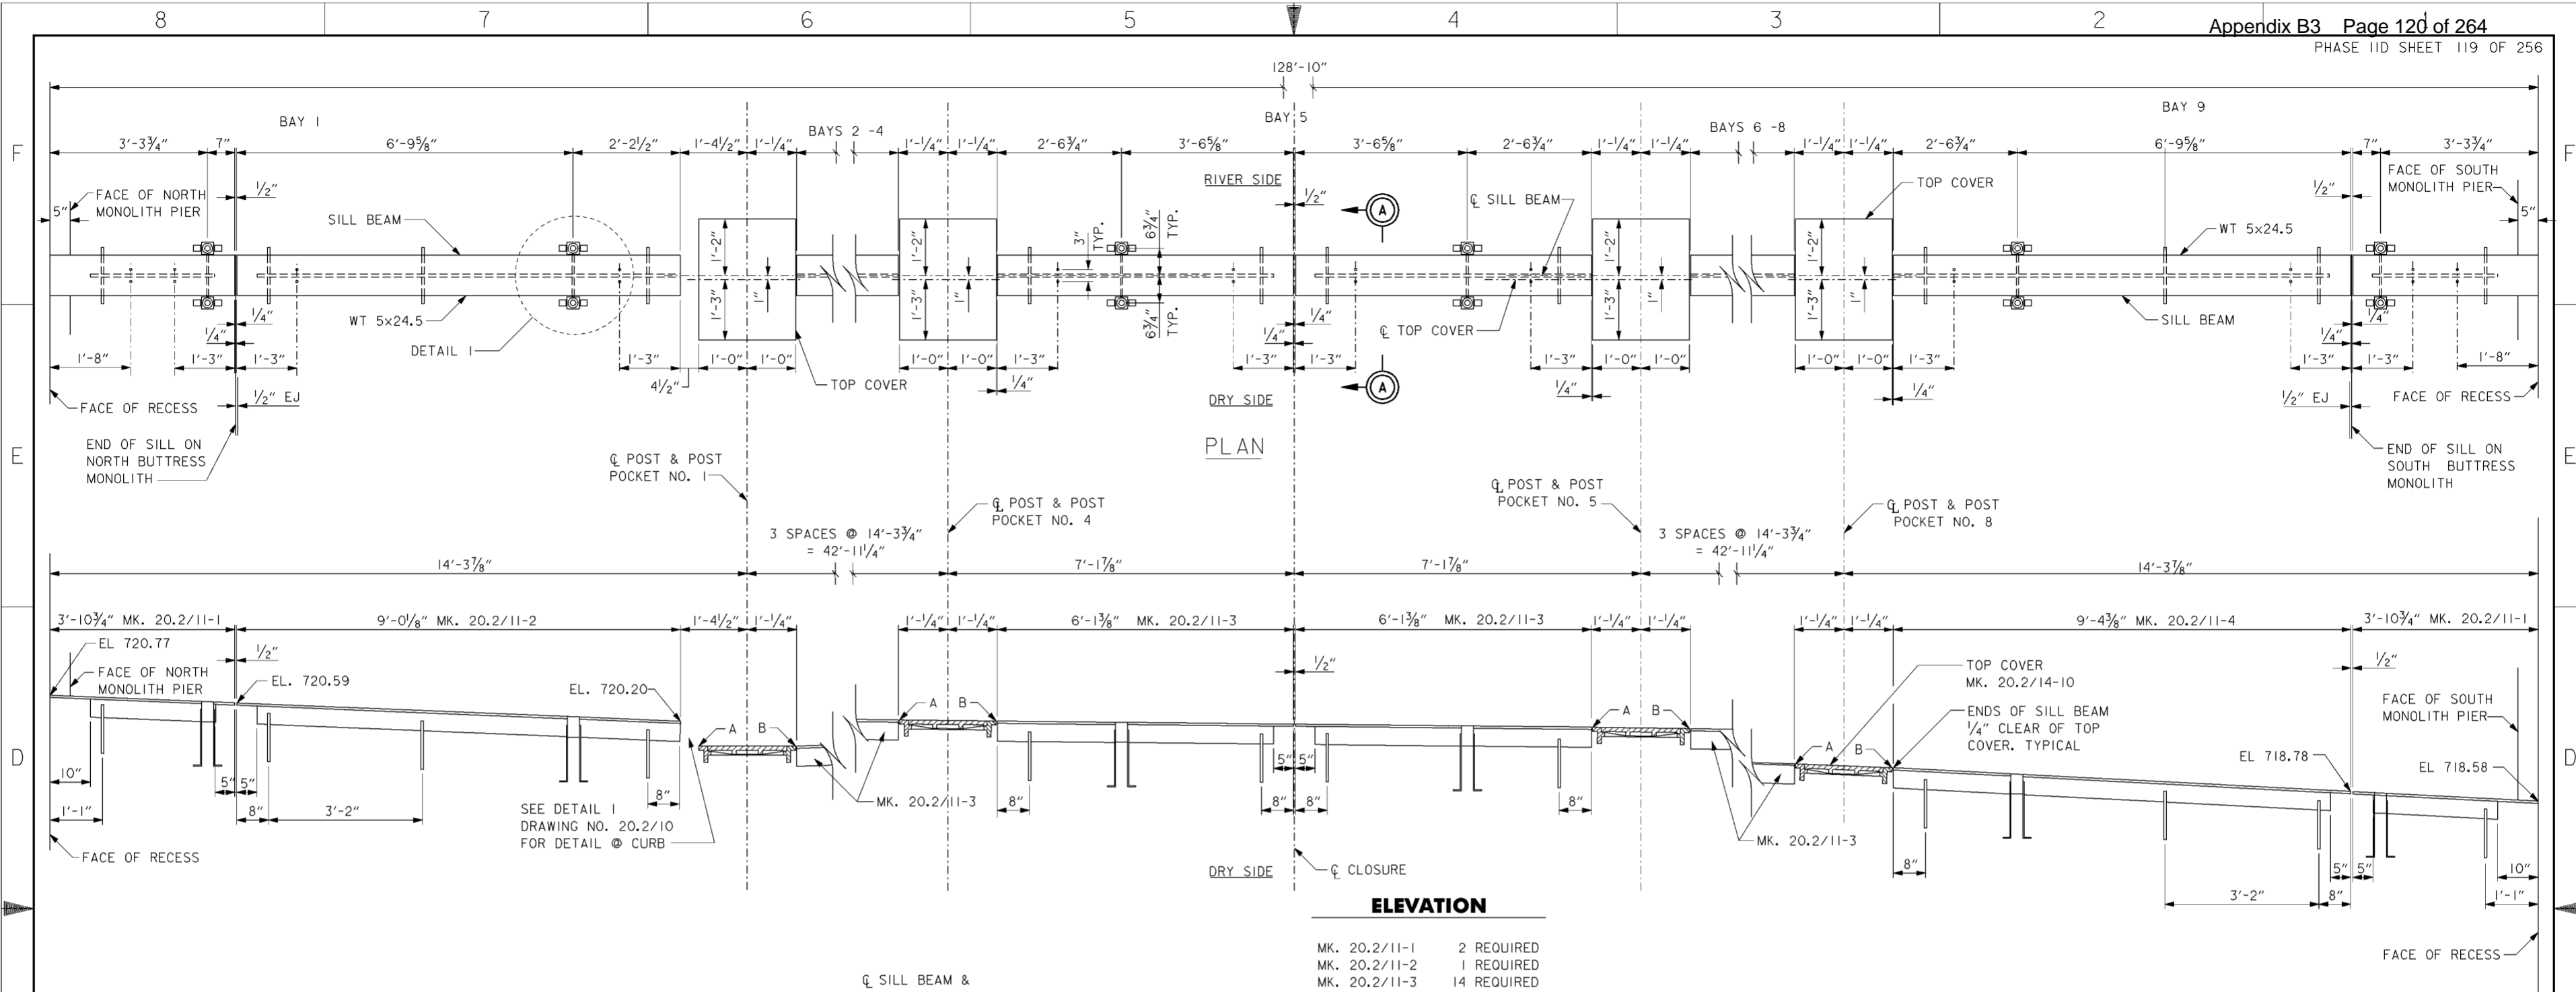

ELEVATION

MK. 20.2/11-1	2 REQUIRED
MK. 20.2/11-2	1 REQUIRED
MK. 20.2/11-3	14 REQUIRED
MK. 20.2/11-4	1 REQUIRED

SILL BEAM



SCALE: 3/4" = 1'-0"

POST POCKET Q STATIONS

POST NO.	STATION
1	190+91.32
2	191+05.63
3	191+19.94
4	191+34.25
5	191+48.57
6	191+62.88
7	191+77.19
8	191+91.50

TOP COVER ELEVATIONS

POST NO.	A	B
1	719.69	719.69
2	720.15	720.20
3	720.33	720.33
4	720.21	720.18
5	720.04	720.02
6	719.87	719.85
7	719.76	719.72
8	719.32	719.24

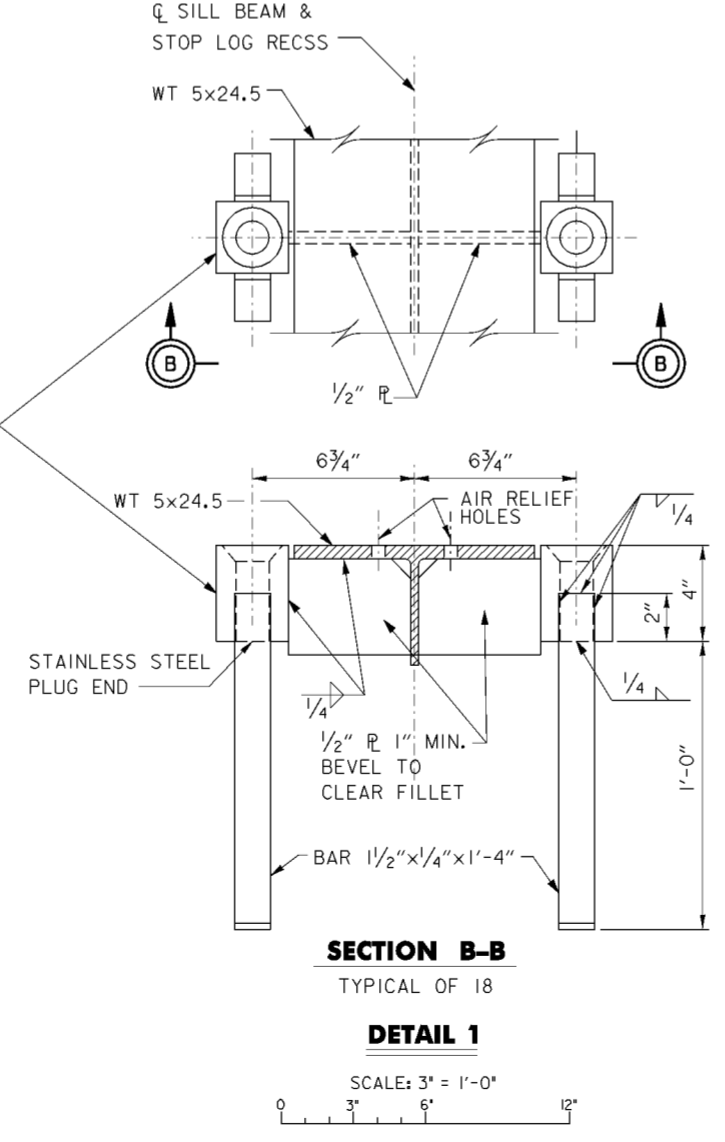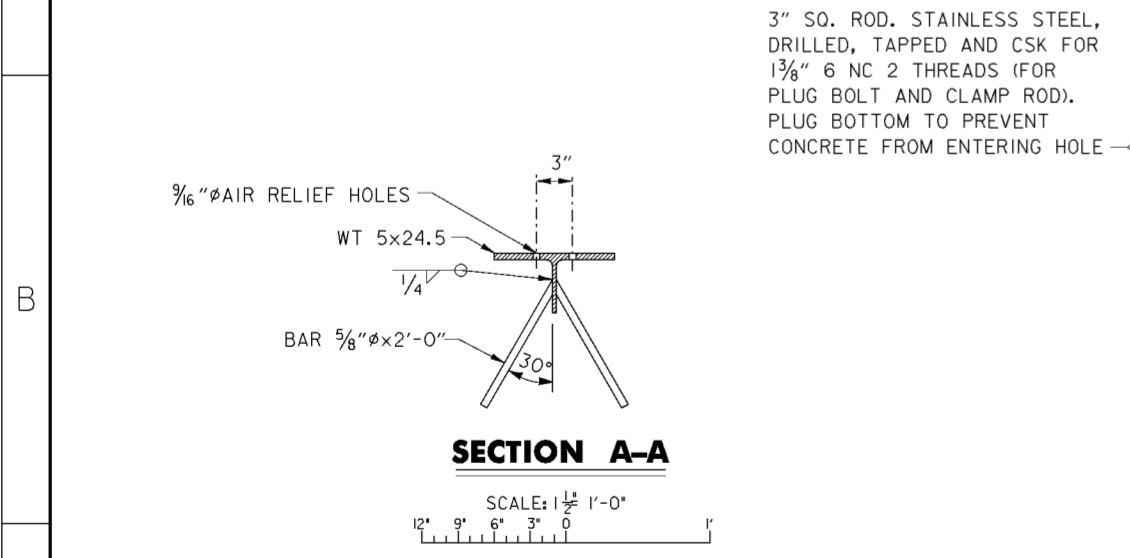


NOTES

- FOR STRUCTURAL GENERAL NOTES SEE DRAWING NO. 20.2/9.
- ALL STAINLESS STEEL SHALL CONFORM TO ASTM A 276-90a.
- STAINLESS STEEL FILLER METAL SHALL BE USED FOR ALL WELDING TO STAINLESS STEEL.
- SILL BEAM WT 5x24.5 MK. 20.2/10-1 THRU 4 SHALL BE FLAT TO WITHIN 1/8" IN 6'-0".
- LENGTH OF SILL BEAMS ARE BASED ON A TOP COVER WIDTH OF 2'-0" AND SHALL BE ADJUSTED IF THE TOP COVER FURNISHED HAS A DIFFERENT DIMENSION.
- ALUMINUM PAINT SILL BEAM AFTER FABRICATION, BUT BEFORE INSTALLING.
- END OF SILL ELEVATION SHALL MATCH ELEVATION OF ADJACENT EDGE OF TOP COVER EXCEPT AS SHOWN.
- TOP OF SILL BEAM SHALL HAVE A CONSTANT SLOPE WITHIN EACH BAY.
- SLOPE OF SILL BEAM IS CONSTANT BETWEEN POST NO. 3 & POST NO. 7.
- DELIVER SILL BEAMS TO SITE WITH BOLTS MK. 20.2/13-7 INSTALLED.


Revisions			
Symbol	Descriptions	Date	Approved
◊	REVISED AS CONSTRUCTED	7/02	P.O.C.

BURGESS & NIPLE, LIMITED COLUMBUS, OHIO Designed by: L.LINZELL Drawn by: D.BECKNER Checked by: P.CONROY Reviewed by: Approved by:	U.S. ARMY ENGINEER DISTRICT CORPS OF ENGINEERS HUNTINGTON, WEST VIRGINIA SCOTO RIVER COLUMBUS, OHIO WEST COLUMBUS, L.P.P. PHASE IID EMBEDDED SILL BEAM AND DETAILS Scale: AS SHOWN Date: MARCH 1998 Drawing Code: 16-PWC-10-	Sheet reference number: FILENAME: a06em01.dgn PEN TABLE: 20.2/11 Sheet 1 of 1
---	---	---

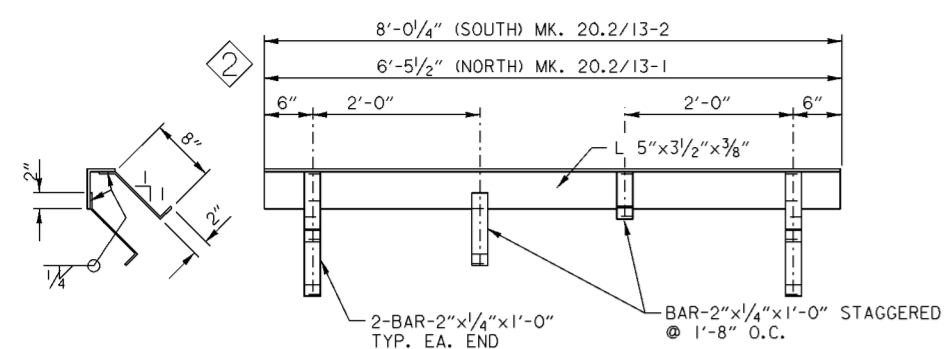


STOP LOG RECESS ANGLE

MK. 20.2/13-2 2 REQUIRED (SOUTH)
 MK. 20.2/13-1 2 REQUIRED (NORTH)
 SCALE: 1" = 1'-0"

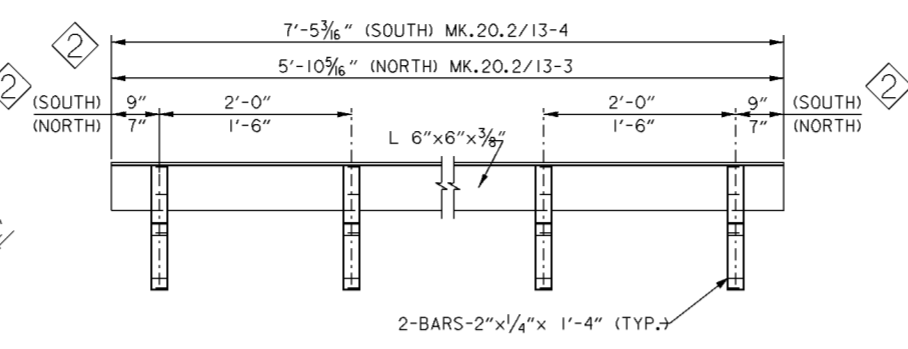

CORNER PROTECTION ANGLE

MK. 20.2/13-4 2 REQUIRED (SOUTH)
 MK. 20.2/13-3 2 REQUIRED (NORTH)
 SCALE: 1" = 1'-0"

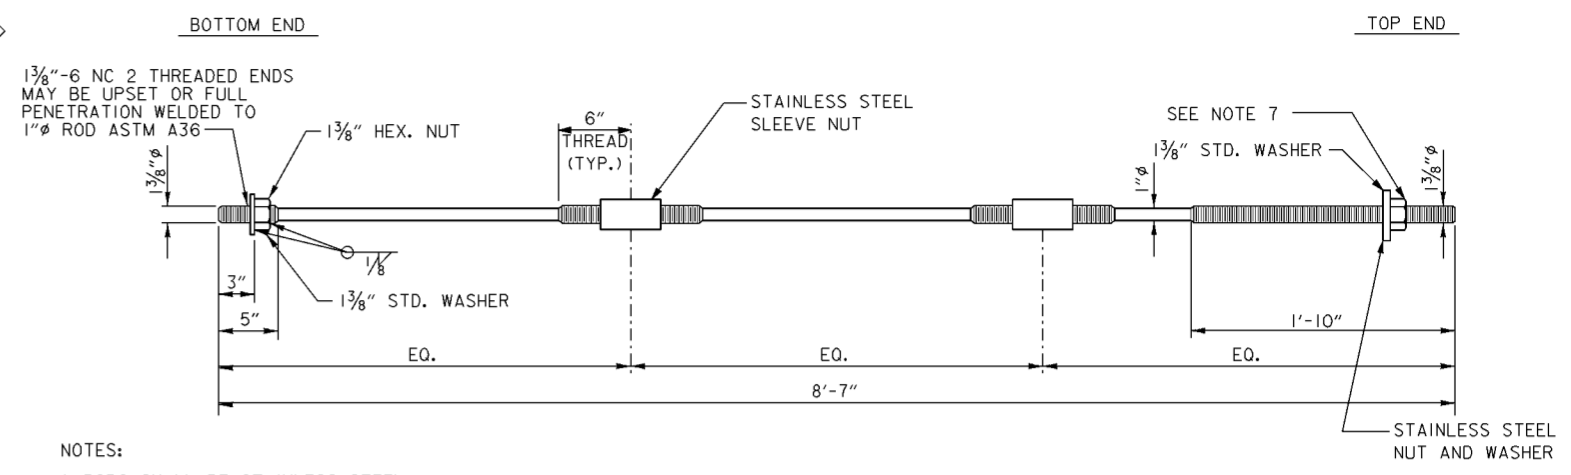


NOTES:


1. RODS SHALL BE STAINLESS STEEL.
2. END NUTS, WASHERS AND SLEEVES SHALL BE STAINLESS STEEL.

CLAMP ROD

MK. 20.2/13-5 36 REQUIRED
 SCALE: 1 1/2" = 1'-0"

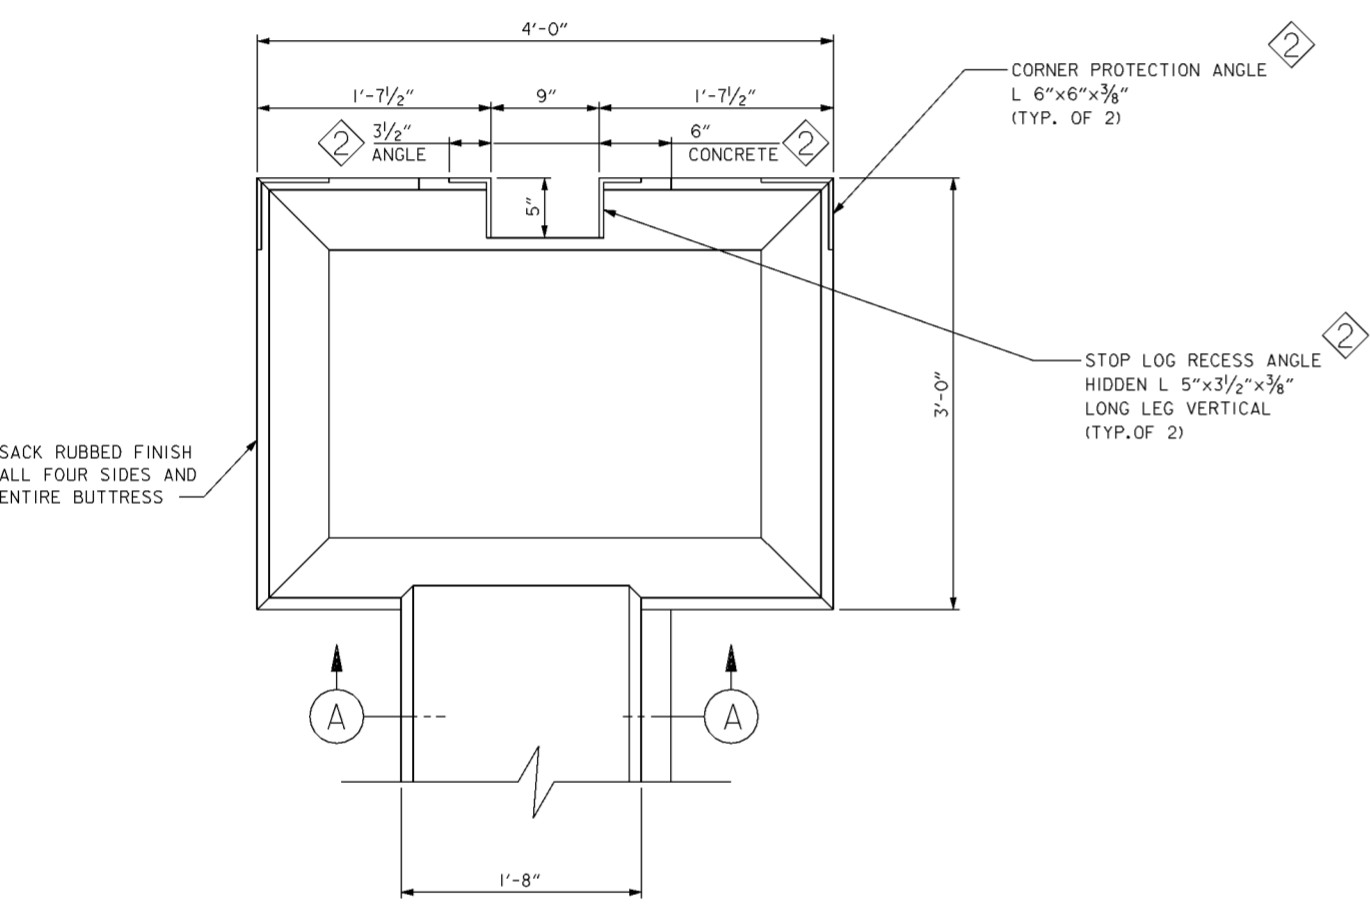


PLAN

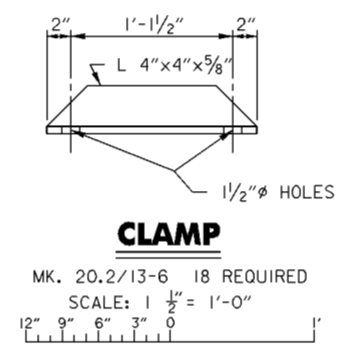

CLAMP

MK. 20.2/13-6 18 REQUIRED
 SCALE: 1 1/2" = 1'-0"

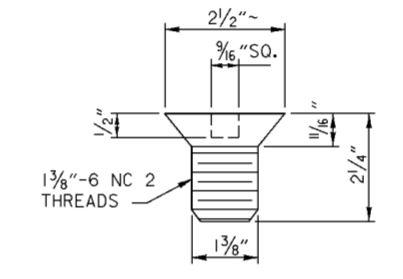


PLUG BOLT

STAINLESS STEEL
 MK. 20.2/13-7 36 REQUIRED
 SCALE: 6" = 1'-0"

NOTES


1. FOR STRUCTURAL GENERAL NOTES SEE DRAWING NO. 20.2/9.
2. ALL STAINLESS STEEL SHALL CONFORM TO ASTM A 276 TYPE 304 UNLESS OTHERWISE NOTED OR SPECIFIED.
3. STAINLESS STEEL FILLER METAL SHALL BE USED FOR ALL WELDING TO STAINLESS STEEL.
4. ANGLES SHALL BE ASTM A-36 STEEL.
5. STOP LOG RECESS ANGLES SHALL BE STRAIGHT TO WITHIN 1/4" IN 5'-0".
6. CORNER PROTECTION ANGLES SHALL BE STRAIGHT TO WITHIN 1/4" IN 4'-0".
7. PROVIDE 2-18" OPEN END OFFSET HEAD WRENCHES TO FIT 1 3/8" HEX. NUTS, WELDED TO WRENCH AT MID-POINT 1/2" SQ. TO PROVIDE WRENCH FOR BOLTS MK.XX/7 x3" LONG STAINLESS STEEL KEY.
8. ALUMINUM PAINT STOP LOG RECESS ANGLES, CORNER PROTECTION ANGLES AND CLAMPS AFTER FABRICATION BUT BEFORE INSTALLING.
9. EACH ANGLE AND CLAMP ROD SHALL BE STRAIGHT TO WITHIN 1/4" OVER THE FULL LENGTH OF THE PIECE.

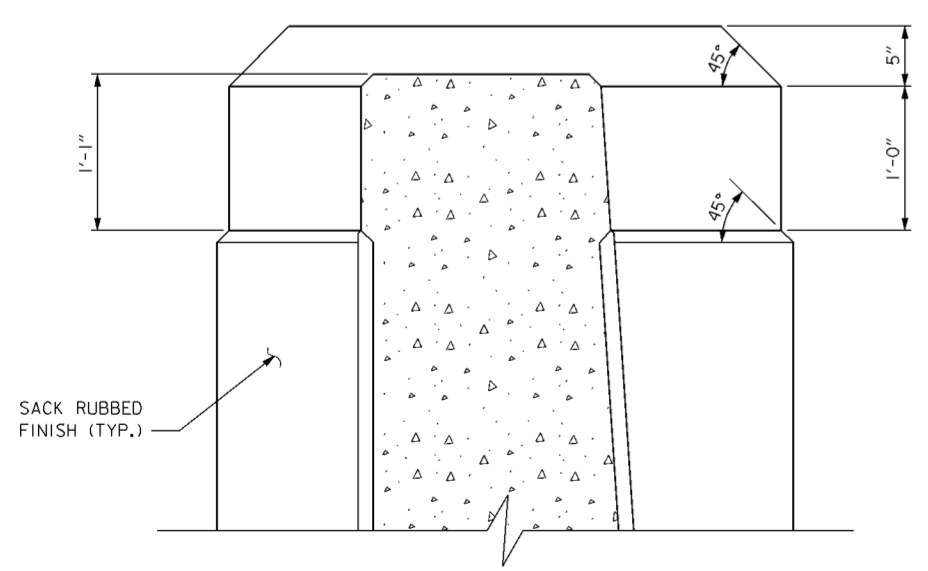

SECTION A-A

RICH STREET GATE BUTTRESS










SCALE: 1 1/2" = 1'-0"

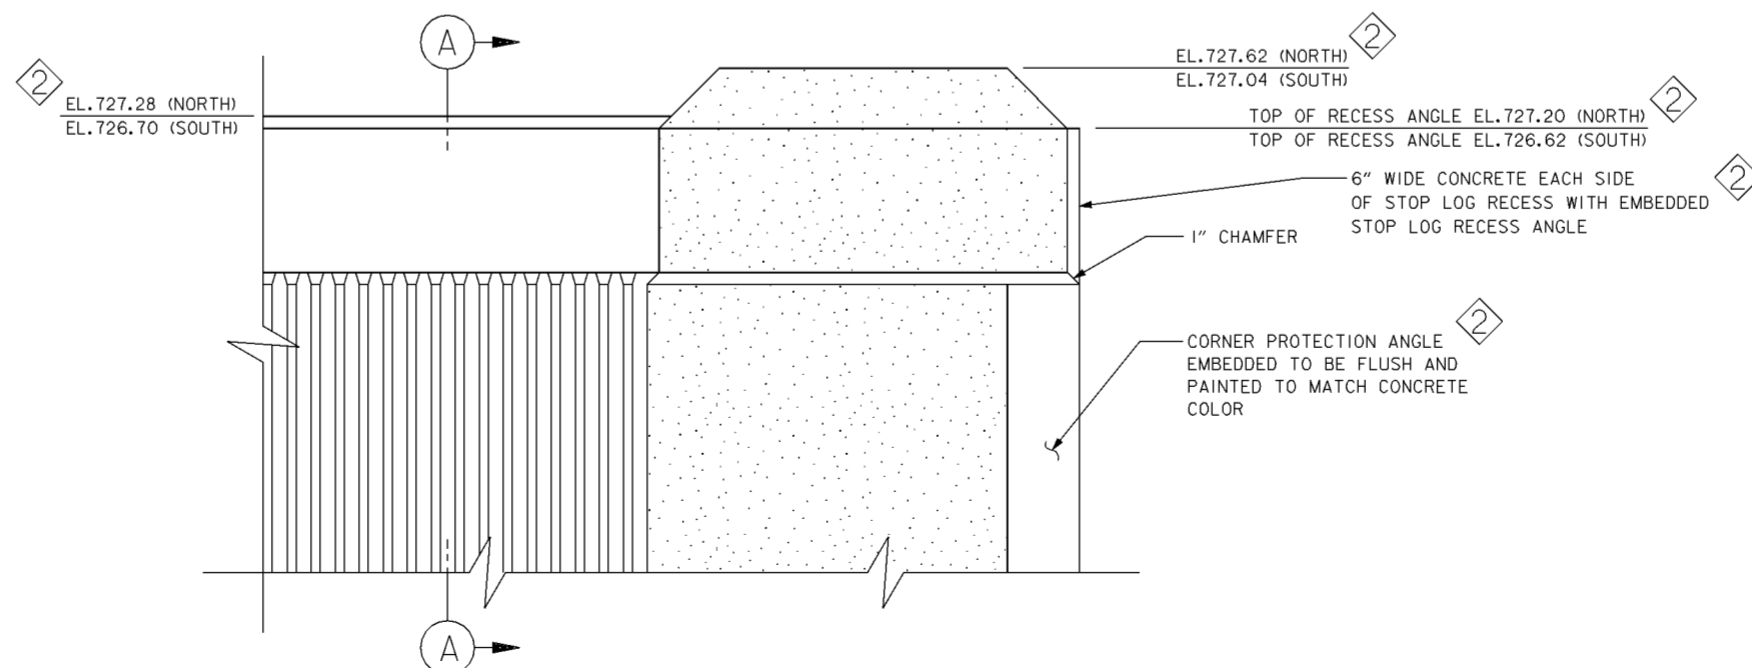

ELEVATION


Revisions			
Symbol	Descriptions	Date	Approved
◊	REVISED AS CONSTRUCTED	7/02	P.O.C.
◊	REV. BY CONTRACT MODIFICATION LETTER MCO02	11/98	P.O.C.

BURGESS & NIPLE, LIMITED COLUMBUS, OHIO	U.S. ARMY ENGINEER DISTRICT CORPS OF ENGINEERS HUNTINGTON, WEST VIRGINIA	Designed by: L.LINZELL	SCIOTO RIVER COLUMBUS, OHIO WEST COLUMBUS, L.P.P. PHASE IID MISCELLANEOUS METALS
		Drawn by: D.BECKNER	
Checked by: D.TRAINA	Reviewed by: AS SHOWN	Sheet reference number: 20.2/13	FILENAME: a06mm01.dgn PEN TABLE: Sheet 1 of 1
Approved by:	Date: MARCH 1998	Drawing Code: 16-PWC-10-	

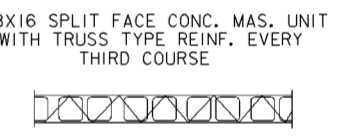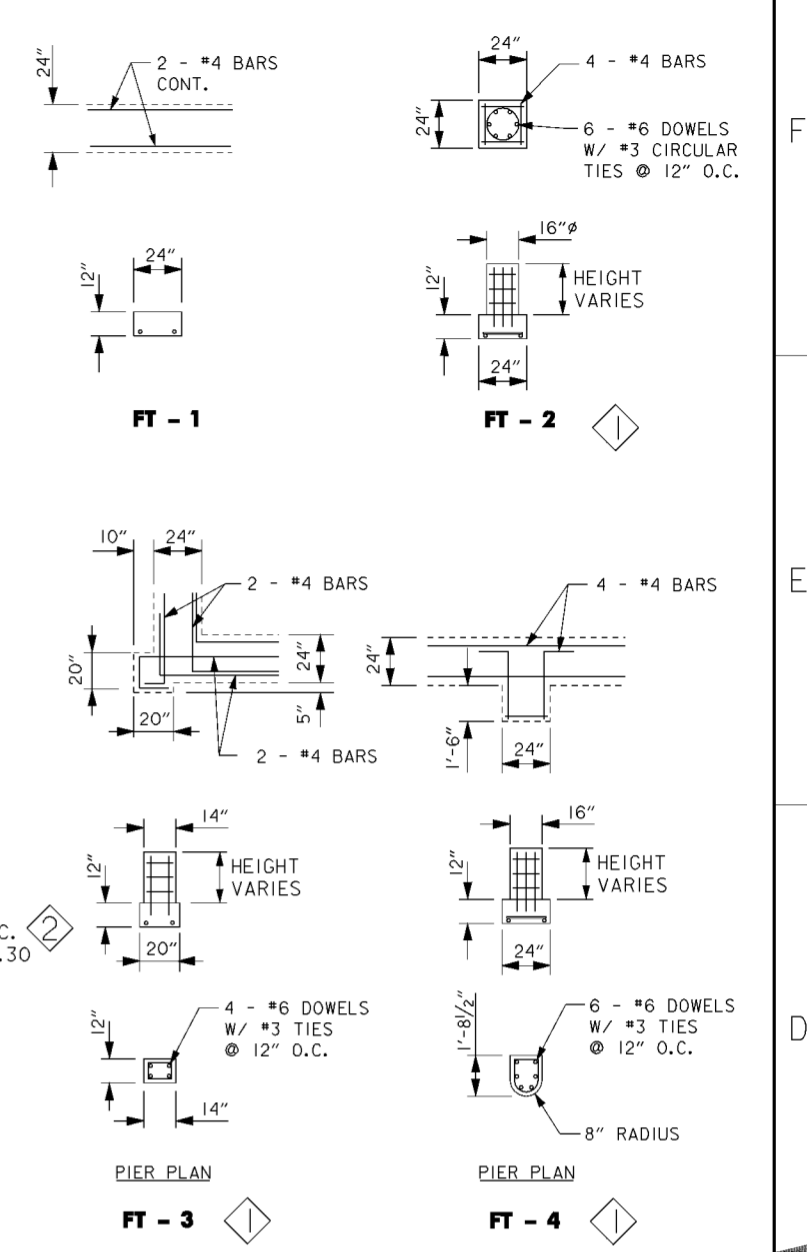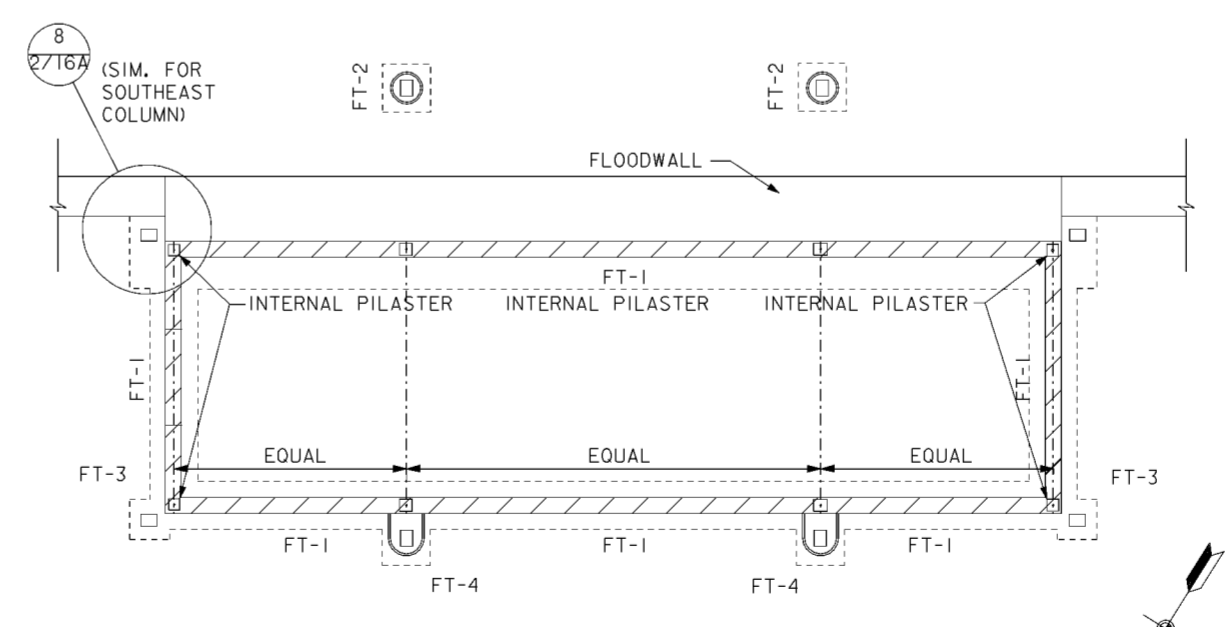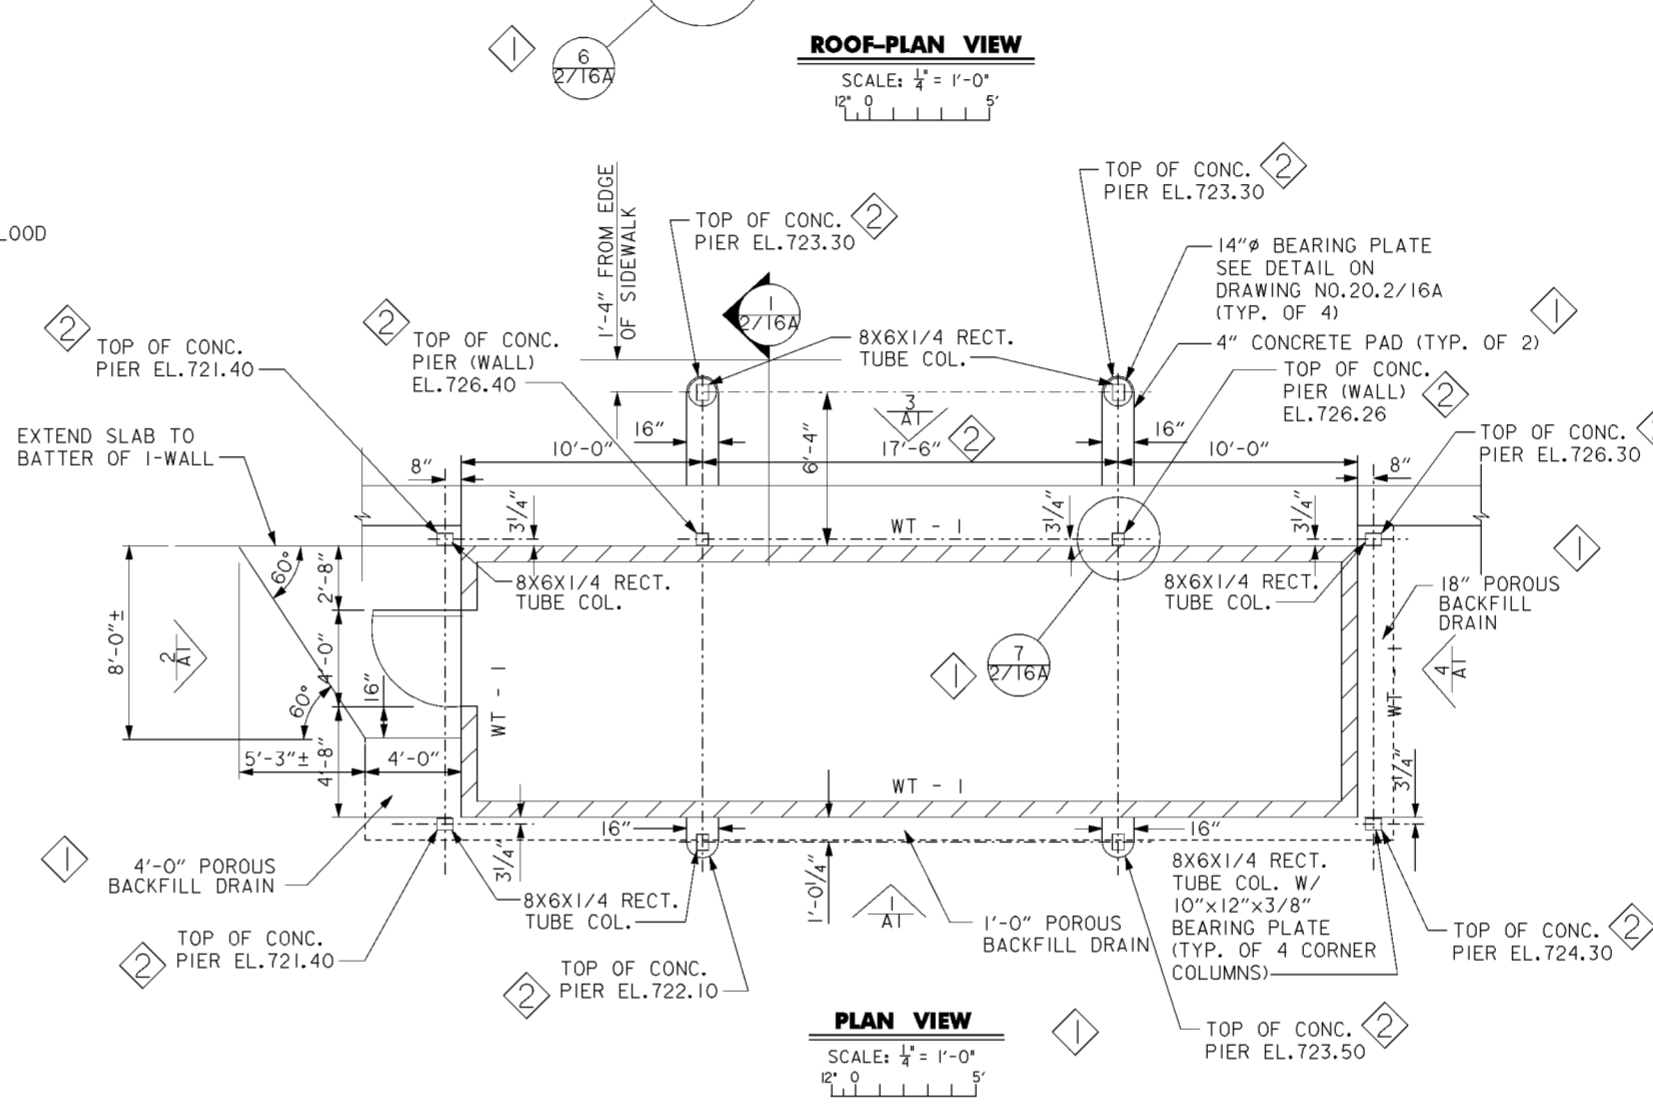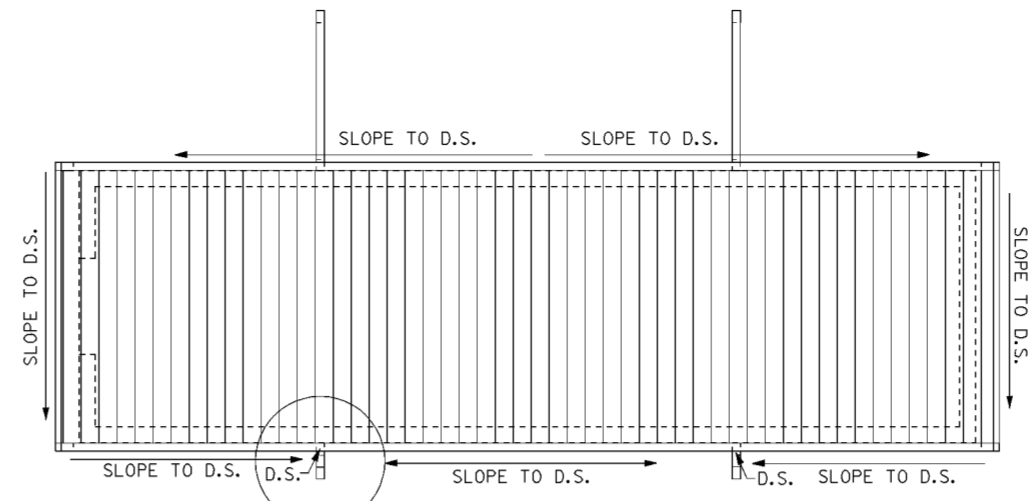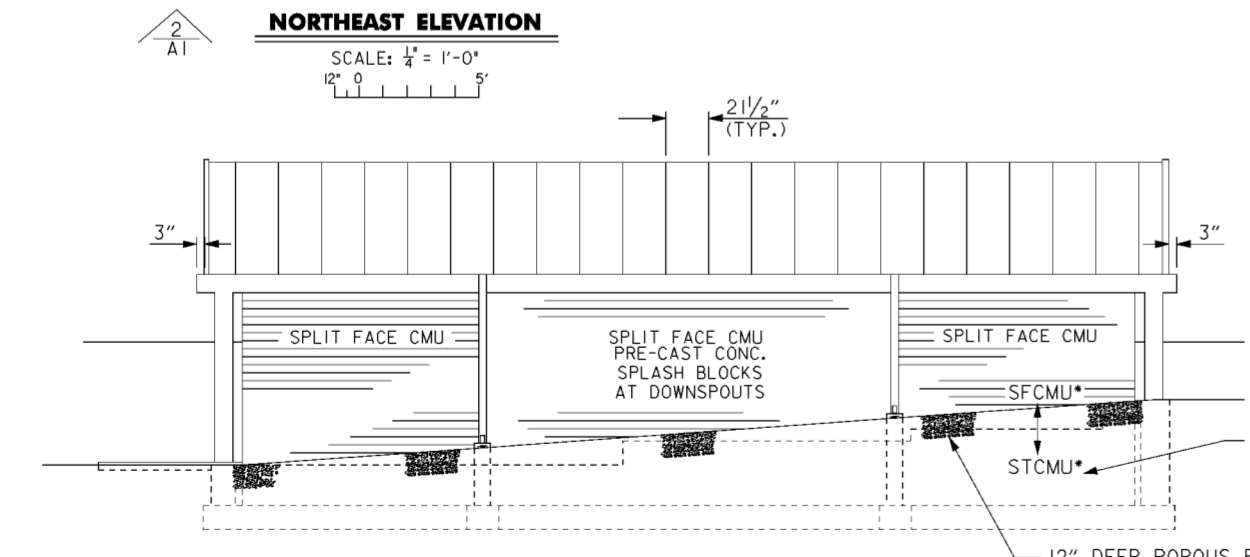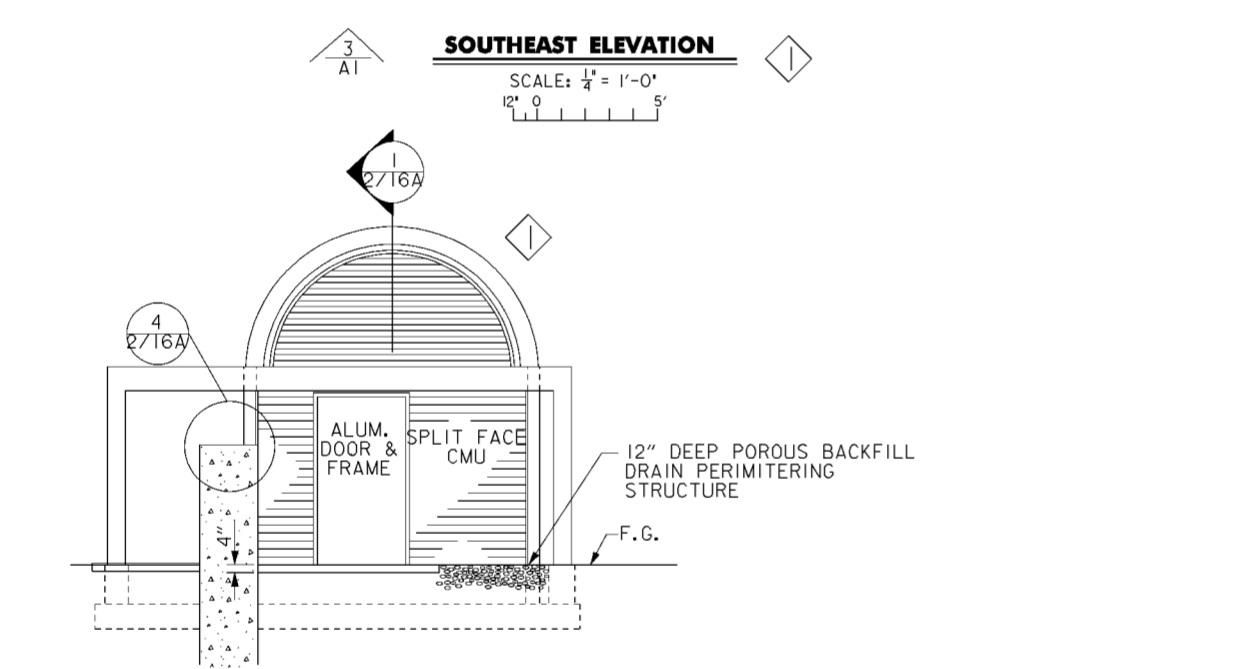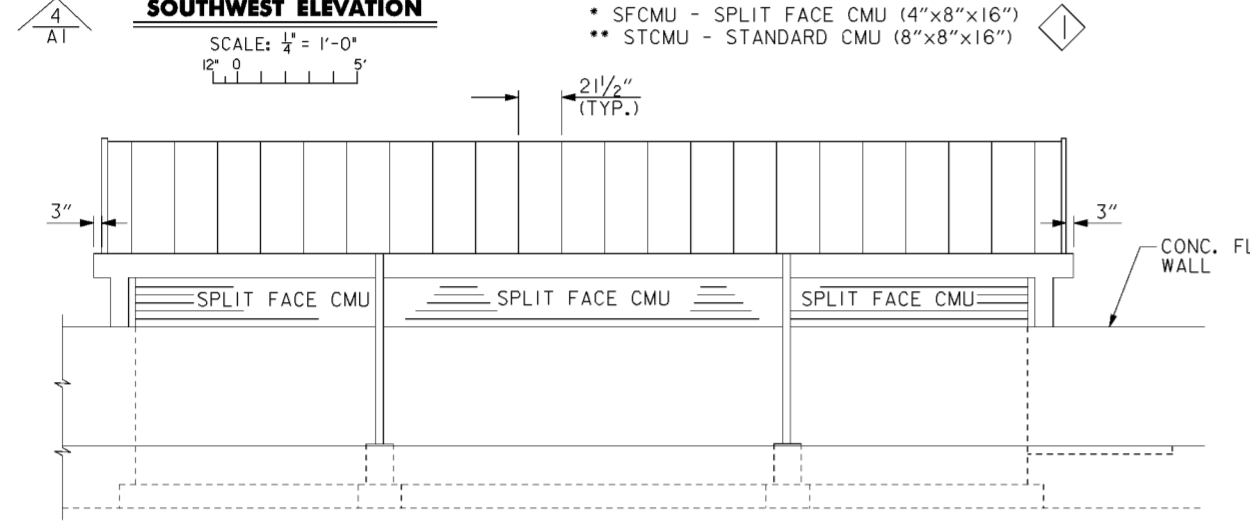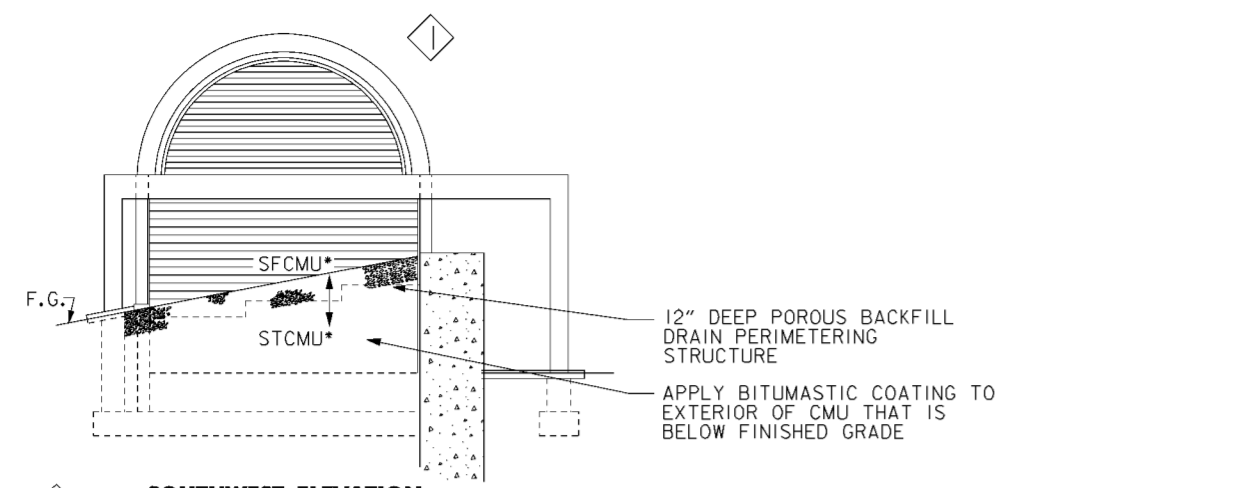


Revisions			
Symbol	Descriptions	Date	Approved
◇	REVISED AS CONSTRUCTED	7/02	P.O.C.
◇	REVISED IN ACCORDANCE WITH AMENDMENT 0001	4-23-98	P.O.C.


BURGESS & NIPLE, LIMITED COLUMBUS, OHIO	U.S. ARMY ENGINEER DISTRICT CORPS OF ENGINEERS WEST COLUMBUS, OHIO PHASE IID
Designed by: B.FACIANE	SCIO TO RIVER COLUMBUS, OHIO WEST COLUMBUS, L.P.P. PHASE IID
Drawn by: T.MULLINS	STOP LOG STORAGE BLDG PLAN & ELEV
Checked by: R.ROMAN	Scale: AS SHOWN
Reviewed by:	Date: MARCH 1998
Approved by:	Drawing Code: 16-PWC-10-
	Sheet reference number: 20.2/16
	FILENAME: a0floody1.dgn
	Sheet 1 of 1

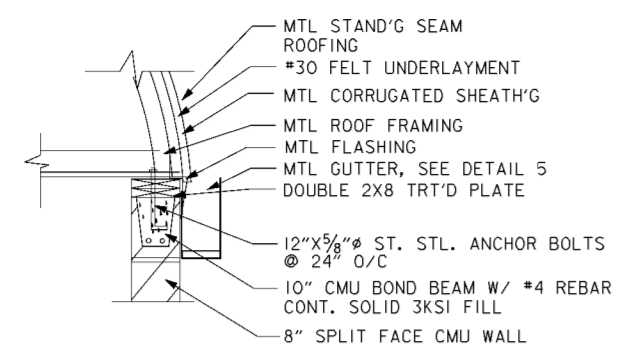


3
 2/16A
EAVE DETAIL
 SCALE: 3/4" = 1'-0"
 12" 6" 0" 1" 2"

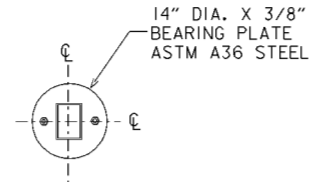


BEARING PLATE (TYP. OF 4)
 SCALE: NONE

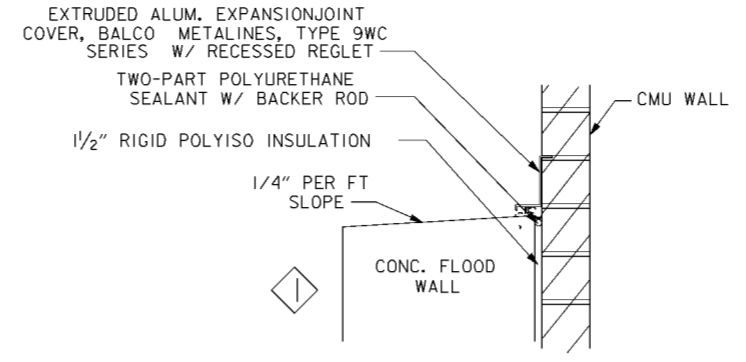


4
 2/16A
FLOOD WALL EXPANSION JOINT
 SCALE: 3/4" = 1'-0"
 12" 6" 0" 1" 2"

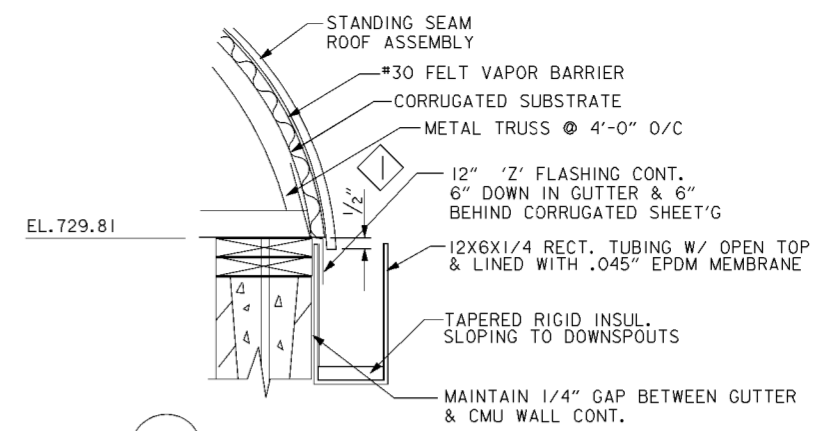


5
 2/16A
GUTTER DETAIL
 SCALE: 1 1/2" = 1'-0"
 12" 6" 0" 1" 2"

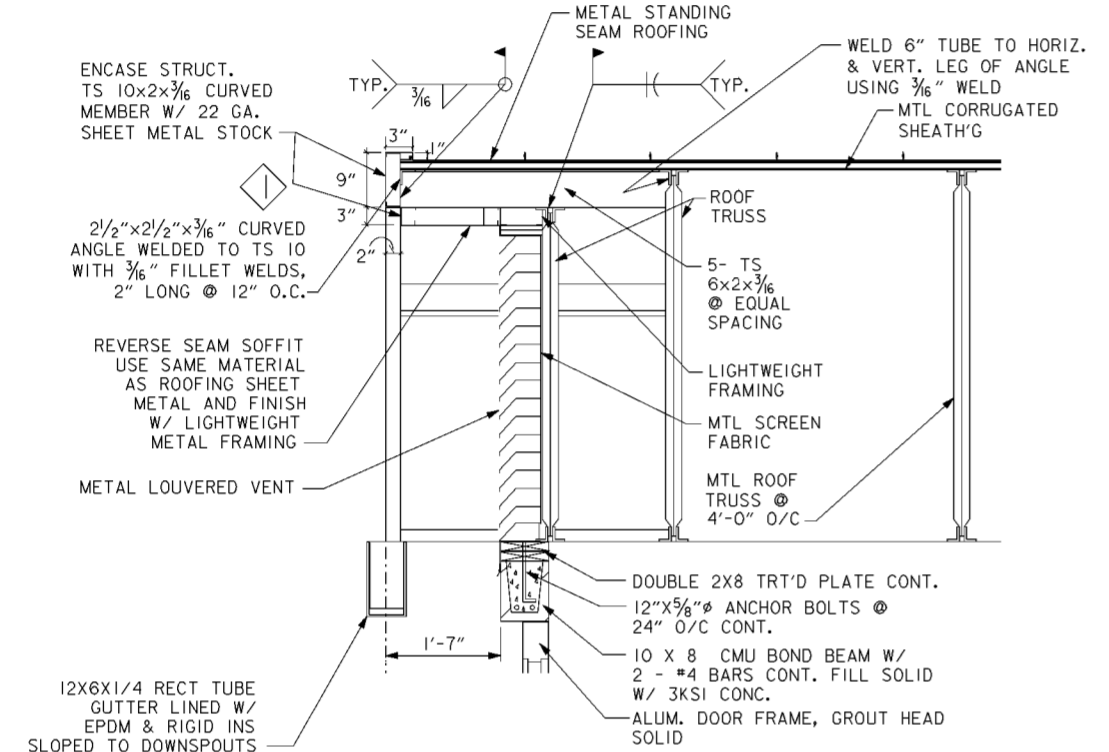





2
 2/16A
VAULT END SECTION
 SCALE: 3/4" = 1'-0"
 12" 6" 0" 1" 2"

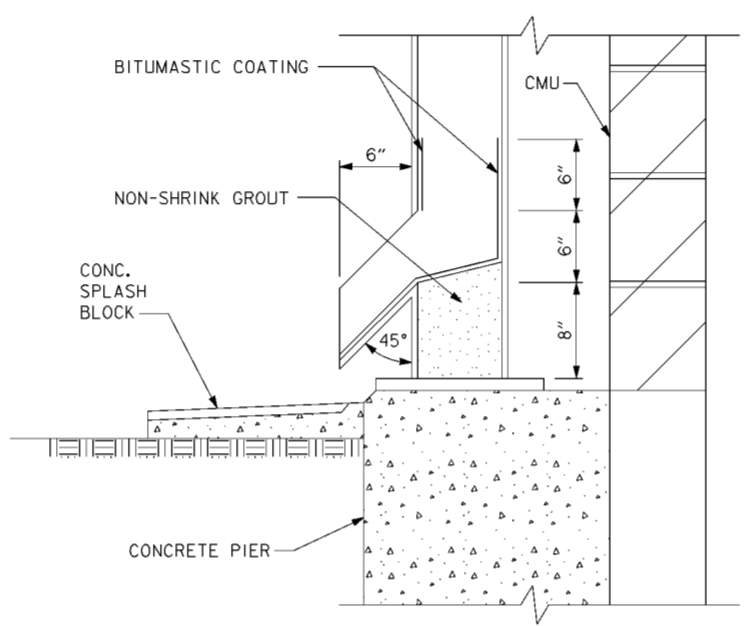


6
 2/16A
BASE OF DOWNSPOUTS
 SCALE: 1 1/2" = 1'-0"
 12" 6" 0" 1" 2"

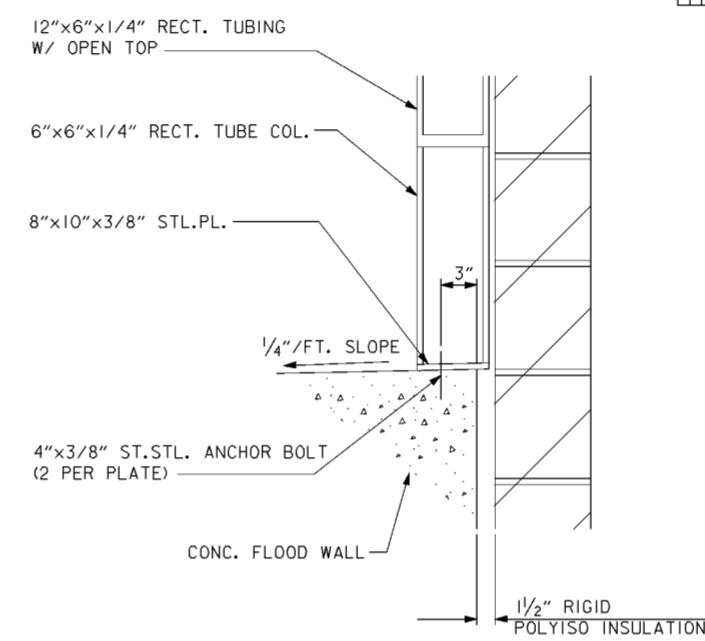


7
 2/16A
WALL TUBING DETAIL
 SCALE: 1 1/2" = 1'-0"
 12" 6" 0" 1" 2"

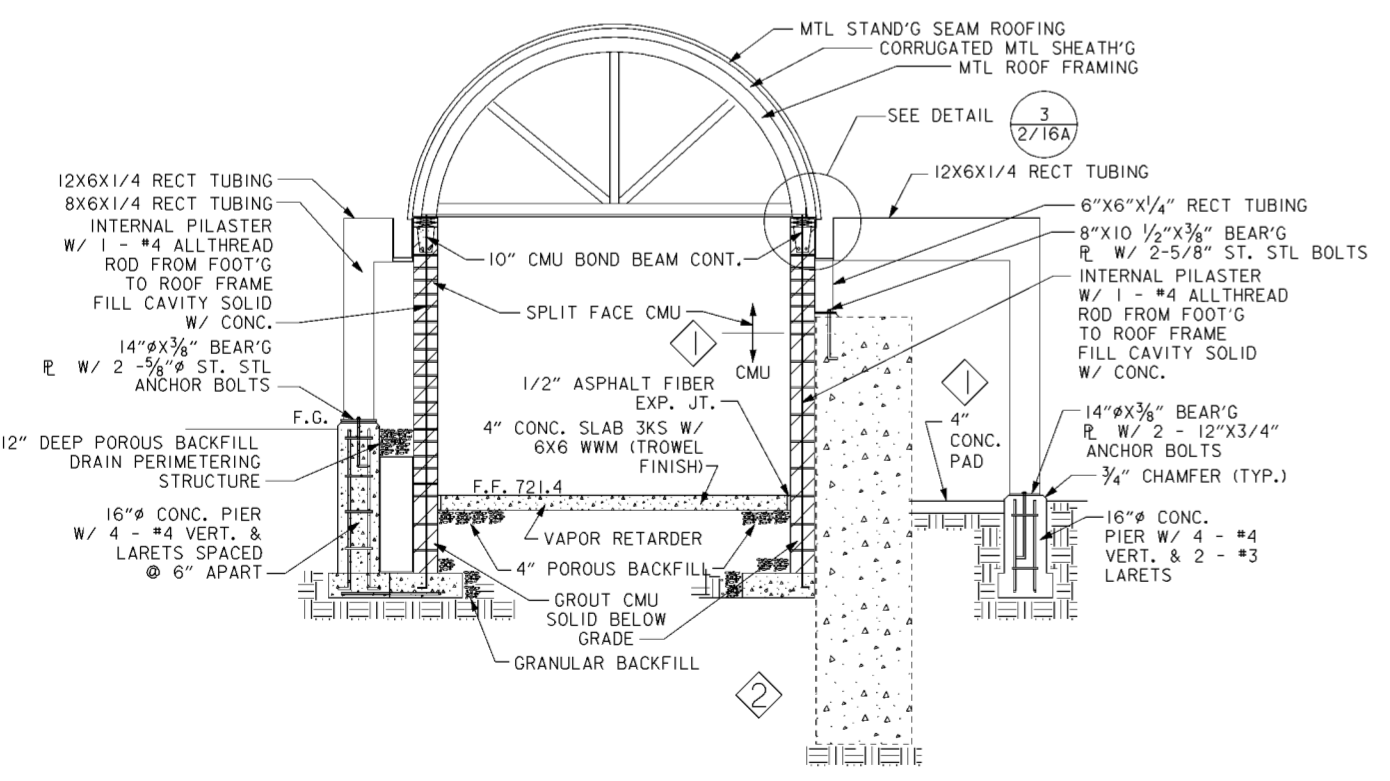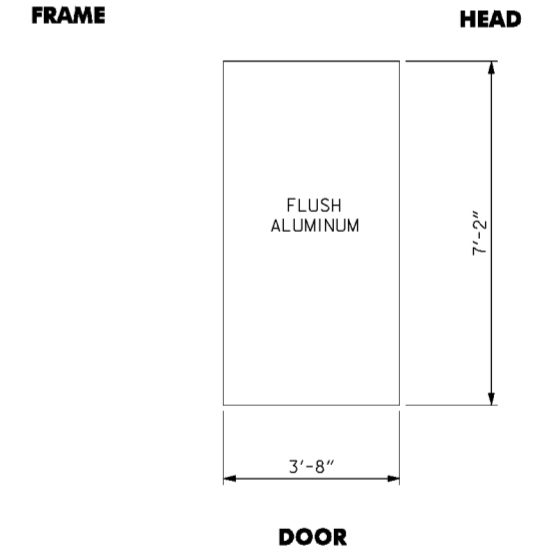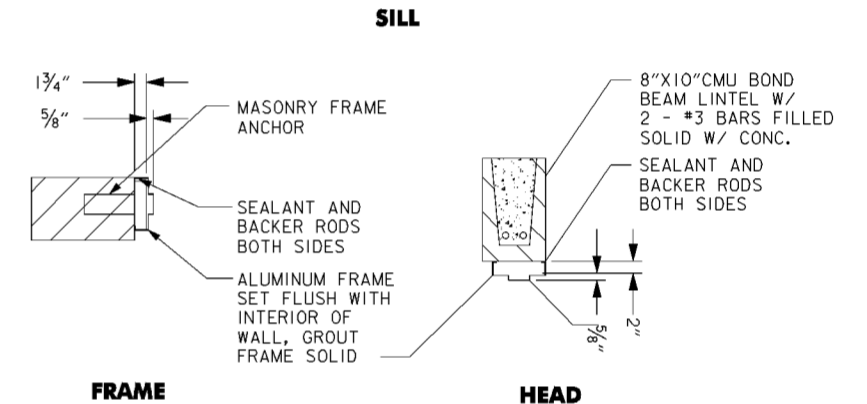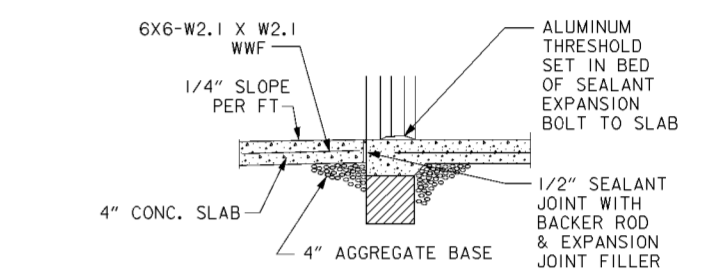

1
 2/16A
BUILDING SECTION VIEW
 SCALE: 3/8" = 1'-0"
 12" 0" 2" 4" 6"

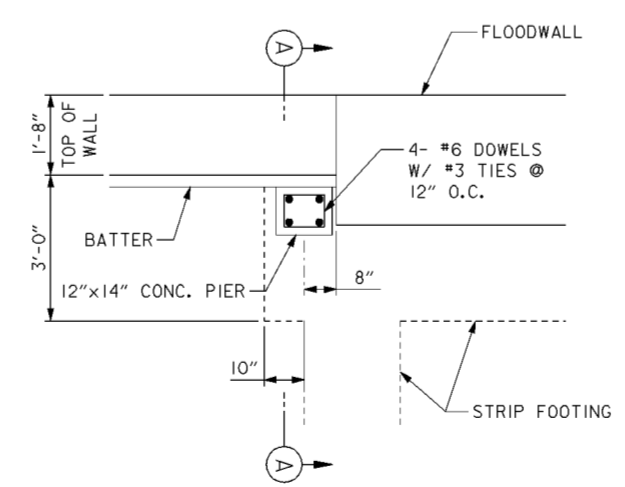


8
 2/16A
NORTHEAST COLUMN FOUNDATION
 (SOUTHEAST COLUMN FOUNDATION SIMILAR)
 SCALE: 1/2" = 1'-0"
 12" 0" 1" 2" 3" 4"

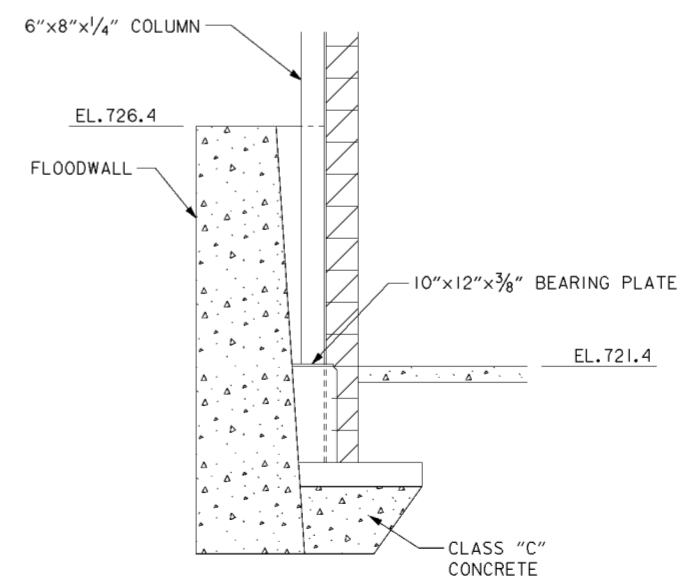

SECTION A-A
 SCALE: 1/2" = 1'-0"
 12" 0" 1" 2" 3" 4"


Revisions			
Symbol	Descriptions	Date	Approved
ⓓ	REVISED AS CONSTRUCTED	7/02	P.O.C.
ⓓ	REVISED IN ACCORDANCE WITH AMENDMENT 0001	4-23-98	P.O.C.

BURGESS & NIPLE, LIMITED COLUMBUS, OHIO		U.S. ARMY ENGINEER DISTRICT CORPS OF ENGINEERS HUNTINGTON, WEST VIRGINIA	
Designed by: B. FACIANE		SCIOTO RIVER COLUMBUS, OHIO WEST COLUMBUS, L.P.P. PHASE IID	
Drawn by: T. MULLINS		STOP LOG STORAGE BUILDING DETAILS	
Checked by: R. ROMAN		Reviewed by:	AS SHOWN
Approved by:		Date: MARCH 1998	Sheet reference number: 20.216A
	Drawing Code: 16-PWC-10-		FILENAME: a0floodg2.dgn P.O.C. TABLE: Sheet 1 of 1

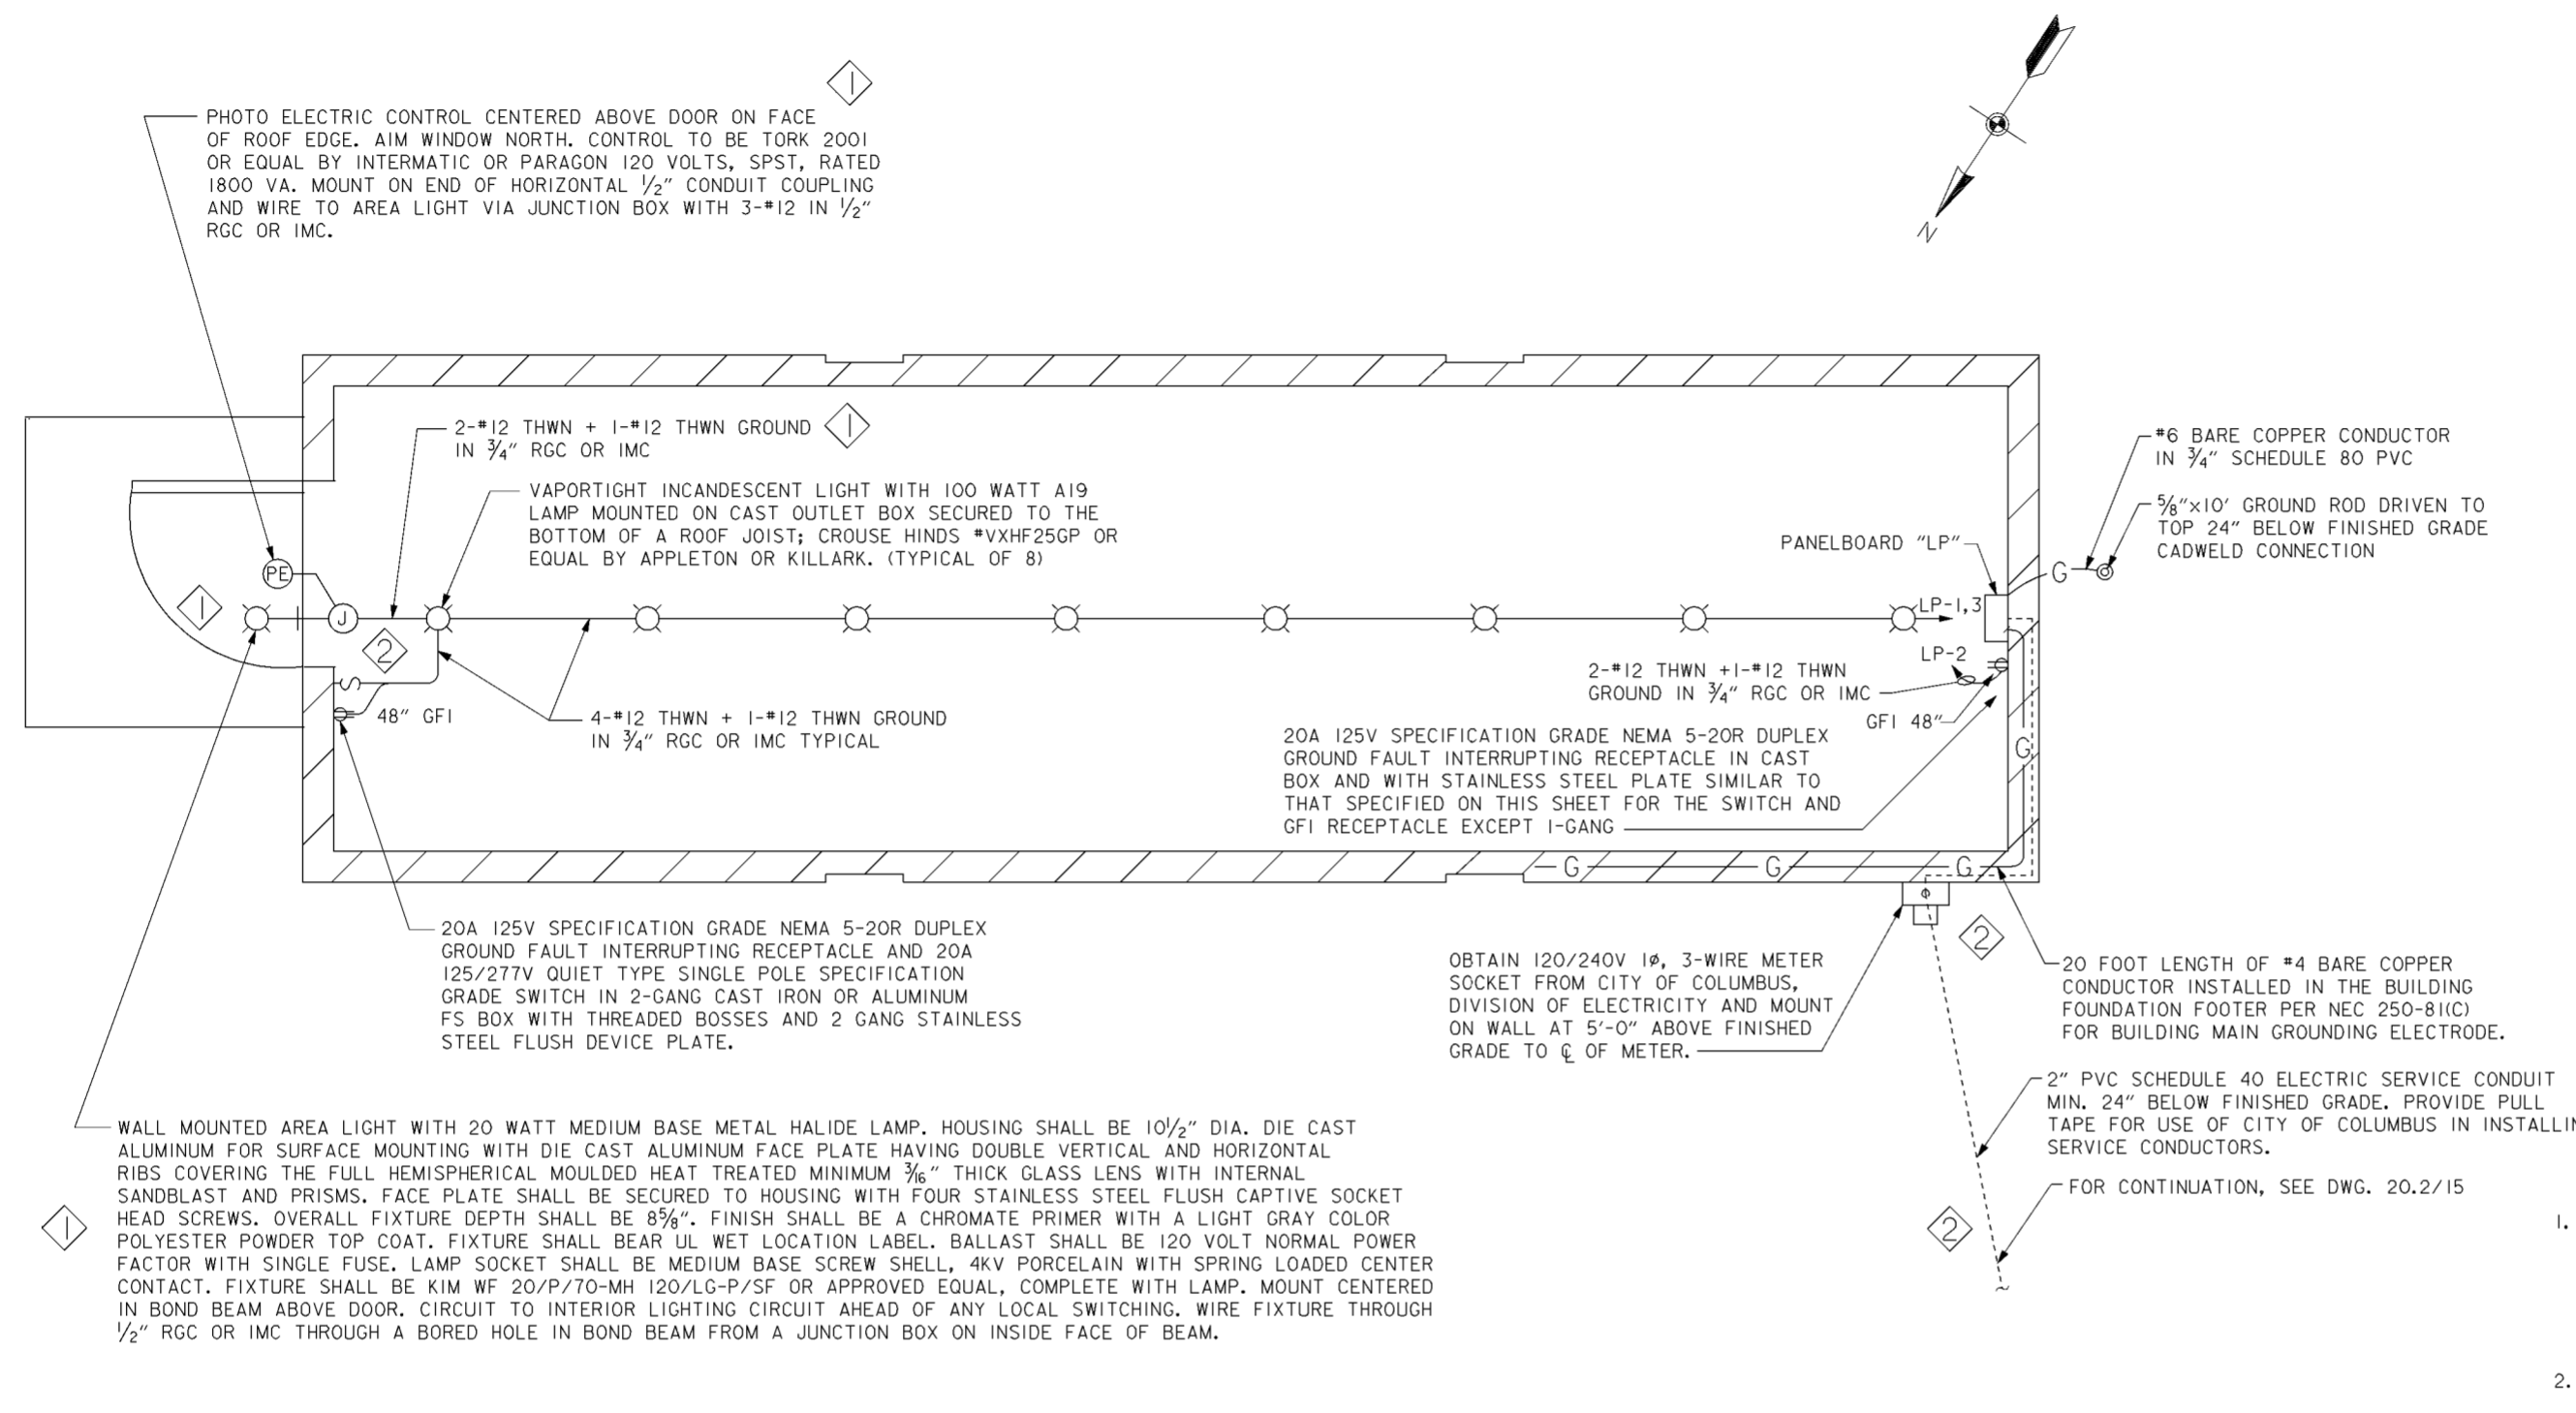

ELECTRICAL SPECIFICATIONS

- ALL ELECTRICAL WORK SHALL COMPLY WITH THE OHIO BASIC BUILDING CODE, THE LATEST EDITION OF THE NATIONAL ELECTRICAL CODE, AND ALL APPLICABLE LOCAL CODES AS A MINIMUM STANDARD, AND THE OCCUPATIONAL SAFETY AND HEALTH ACT OF 1970.
 - ALL MATERIALS AND EQUIPMENT FOR WHICH UNDERWRITERS LABORATORIES EXAMINATION SERVICE IS AVAILABLE SHALL BE SO INSPECTED AND TESTED AND SHALL BEAR THE UL LABEL.
- THE ELECTRICAL CONTRACTOR SHALL OBTAIN AND PAY FOR ALL PERMITS AND INSPECTIONS REQUIRED BY PREVAILING CODE, LAW OR ORDINANCE AND SHALL CORRECT ALL DEFICIENCIES ENUMERATED BY THE LAWFUL INSPECTOR PRIOR TO FINAL PAYMENT OF THE CONTRACT.
- ELECTRICAL PLANS ARE DIAGRAMMATIC ONLY AND ARE INTENDED TO INDICATE THE APPROXIMATE LOCATIONS OF SWITCH, RECEPTACLES, AND LIGHTING FIXTURES. THE EXACT LOCATIONS AND ROUGH-IN DIMENSIONS FOR ALL WORK AND EQUIPMENT SHALL BE OBTAINED FROM THE CONTRACTING OFFICER IN THE FIELD AS THE WORK PROGRESSES. SHOULD THE ELECTRICAL CONTRACTOR FAIL TO PROPERLY ASCERTAIN SUCH LOCATIONS OR DIMENSIONS, HE SHALL CHANGE SUCH WORK AT HIS OWN EXPENSE WHEN SO DIRECTED BY THE CONTRACTING OFFICER. THE CONTRACTING OFFICER RESERVES THE RIGHT TO MAKE MINOR CHANGES IN THE LOCATION OF ANY ELECTRICAL WORK OR EQUIPMENT PRIOR TO ROUGH-IN WITH NO ADDITIONAL COST.
- GROUNDING SHALL BE IN ACCORDANCE WITH NEC ARTICLE 250.

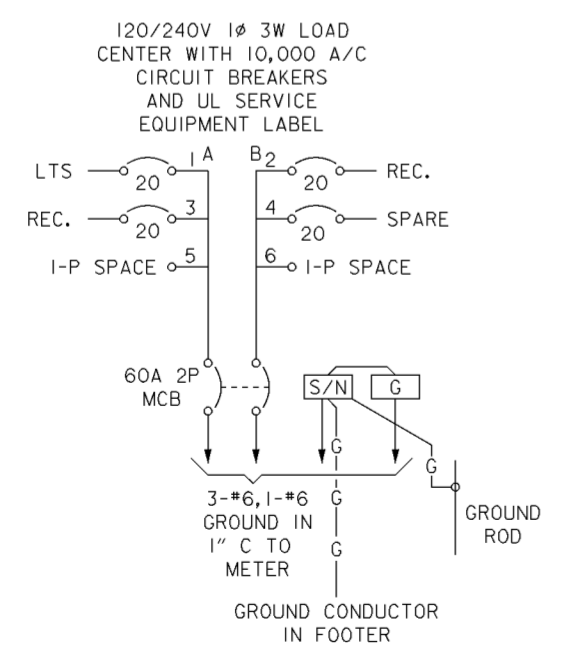


PANELBOARD "LP"
 SCALE: NONE


PLAN VIEW
 SCALE: 1/4" = 1'-0"
 0 5'

Revisions			
Symbol	Descriptions	Date	Approved
◊	REVISED AS CONSTRUCTED	7/02	P.O.C.
◊	REVISED IN ACCORDANCE WITH AMENDMENT 0001	4-23-98	P.O.C.


BURGESS & NIPLE, LIMITED COLUMBUS, OHIO	U.S. ARMY ENGINEER DISTRICT CORPS OF ENGINEERS HUNTINGTON, WEST VIRGINIA
Designed by: J.AYRES	SCIO TO RIVER COLUMBUS, OHIO WEST COLUMBUS, L.P.P. PHASE IID
Drawn by: A.PUMMEL	STOP LOG STORAGE BUILDING ELECTRICAL
Checked by: D.SCHAMP	Scale: AS SHOWN
Reviewed by:	Date: MARCH 1998
Approved by:	Drawing Code: 16-PWC-10-
	Sheet reference number: 20.2/17
	FILENAME: a010e0e1.dwg
	Sheet 3 of 3

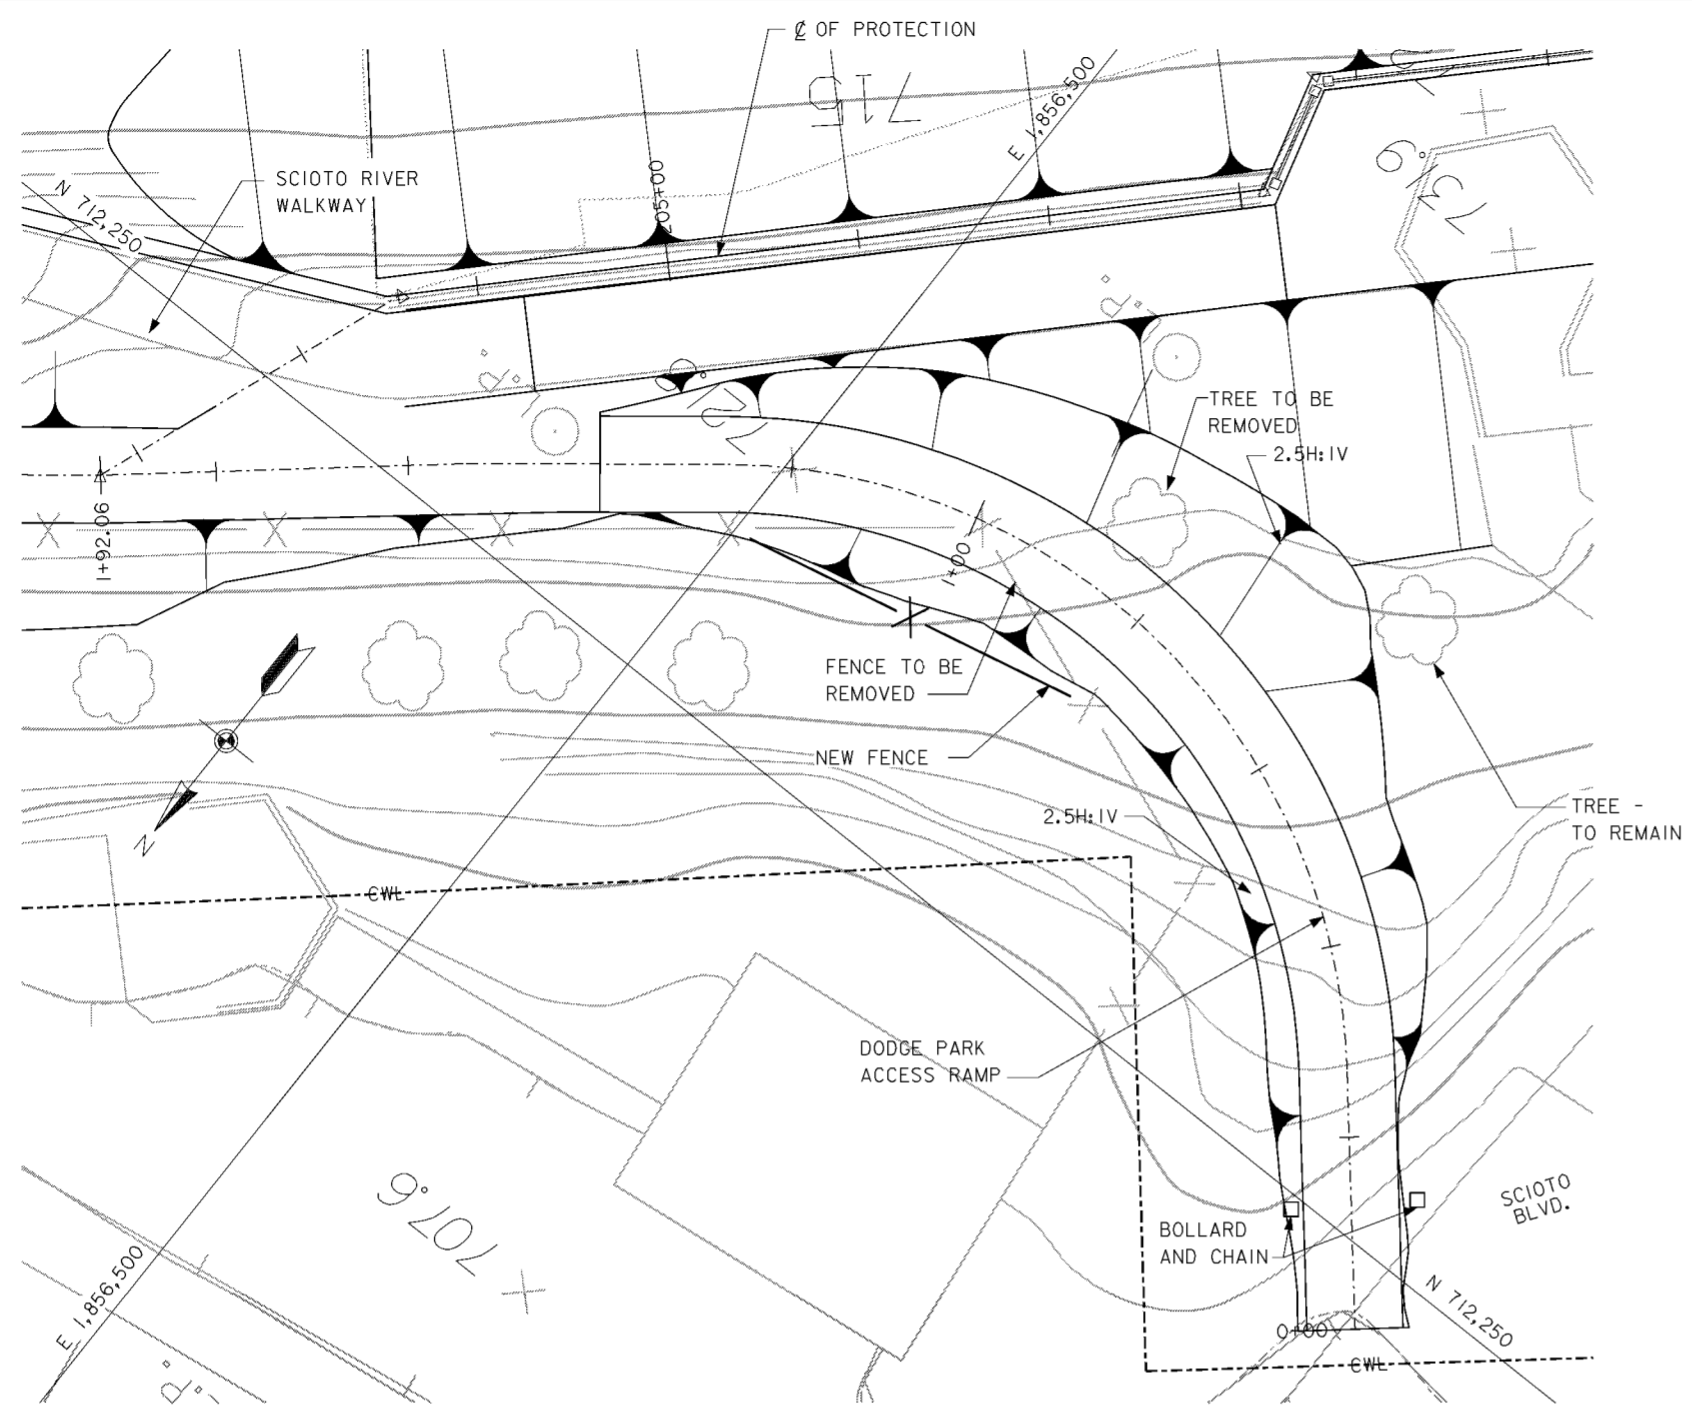

PLAN
 SCALE: 1" = 10'

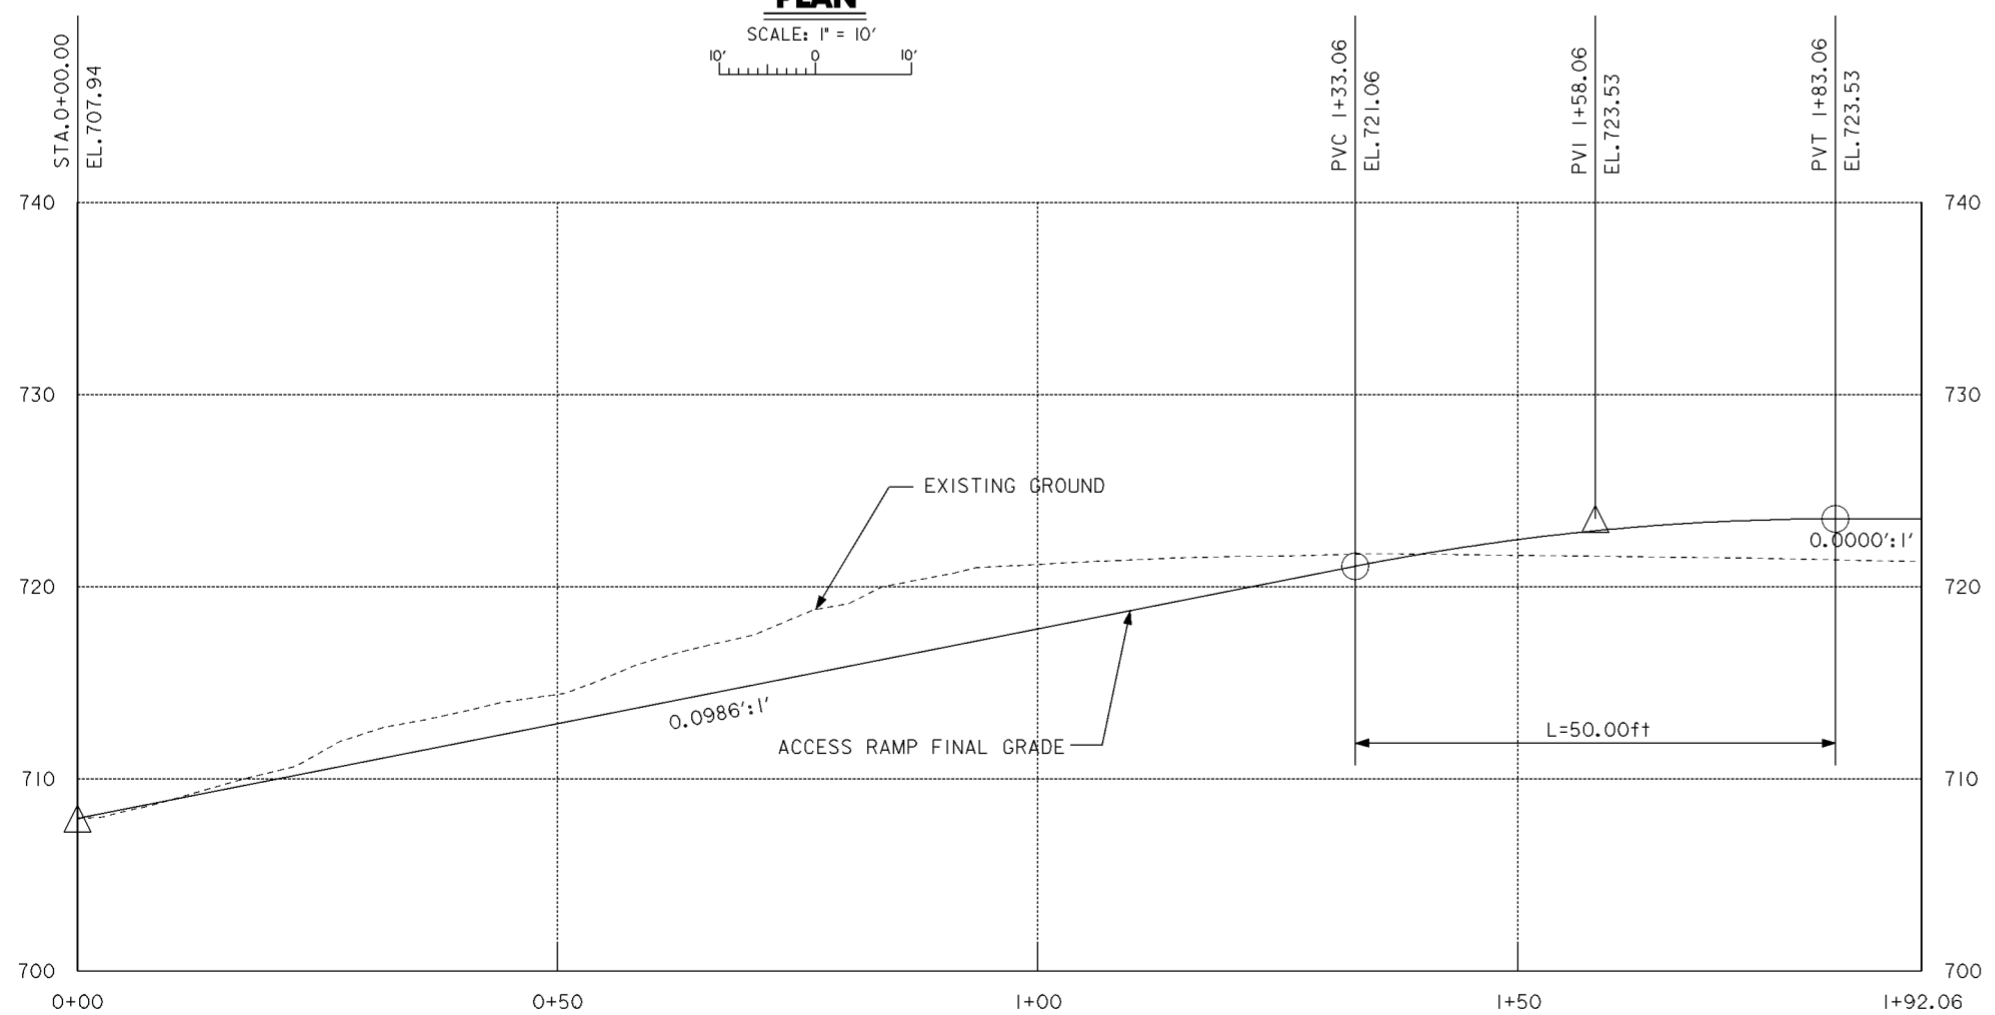


PROFILE
 SCALE IN FEET

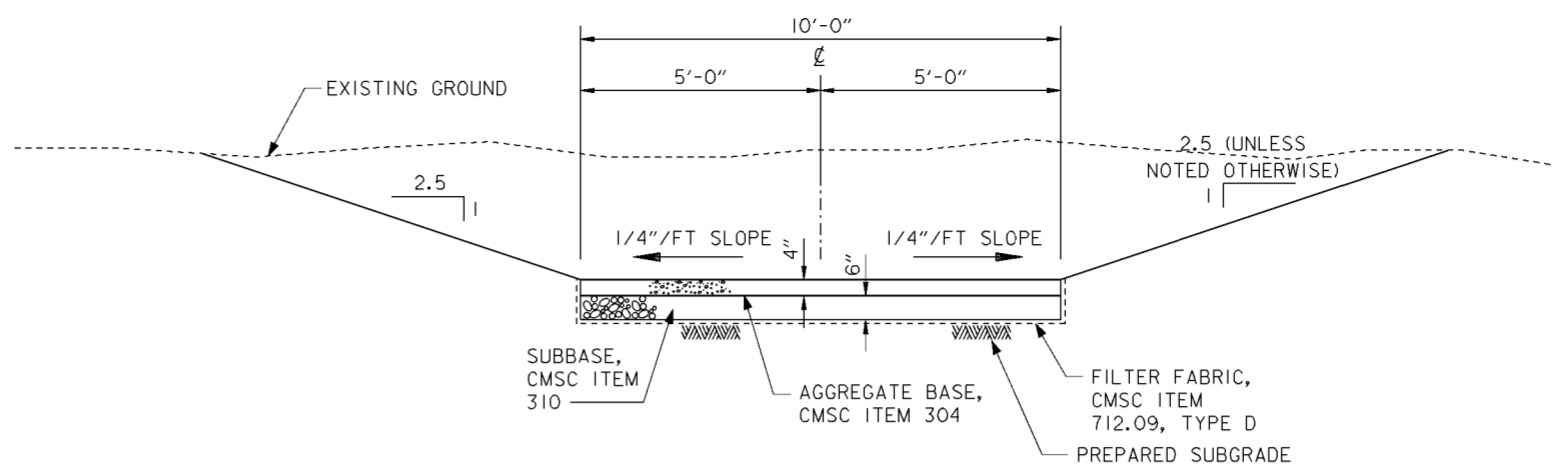

TYPICAL ACCESS RAMP SECTION
STA. 0+00 TO STA. 1+40.00

NOTE: FROM STA. 1+40 TO 1+92.06 ACCESS RAMP TO BE GRASSED 6-INCH TOPSOIL LAYER OVER IMPERVIOUS FILL.

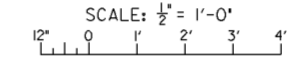

HORIZONTAL ALIGNMENT


Element	Station	North (Y)	East (X)
Element: LINEAR	POB	0+00.00	712257.020
	PC	0+27.13	712236.333
	Tangent Direction:	S 40° 18' 53.78" E	
	Tangent Length:	27.131	
Element: CIRCULAR CURVE	PC	0+27.13	712236.333
	PI	0+90.00	712188.395
	CC	712278.387	1856464.744
	PT	1+27.07	712227.451
	Curve Radius:	-65.000	
	Curve Length:	99.936	
	Total Central Angle:	88° 05' 26.11"	
Element: LINEAR	PT	1+27.07	712227.451
	PI	1+54.25	712244.336
Element: LINEAR	PI	1+54.25	712244.336
	POE	1+92.06	712268.800
Element: LINEAR	PI	1+54.25	712244.336
	POE	1+92.06	712268.800
Element: LINEAR	PI	1+54.25	712244.336
	POE	1+92.06	712268.800
Element: LINEAR	PI	1+54.25	712244.336
	POE	1+92.06	712268.800

NOTES

- FOR CENTERLINE OF PROTECTION SEE DRAWING NOS. 11/2 THRU 11/7.
- FOR BOLLARD AND CHAIN DETAIL SEE DRAWING NO. 20.2/27.
- FOR SCIOTO RIVER WALKWAY SEE DRAWING NOS. 20.5/2 THRU 20.5/4.


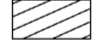



Revisions			
Symbol	Descriptions	Date	Approved

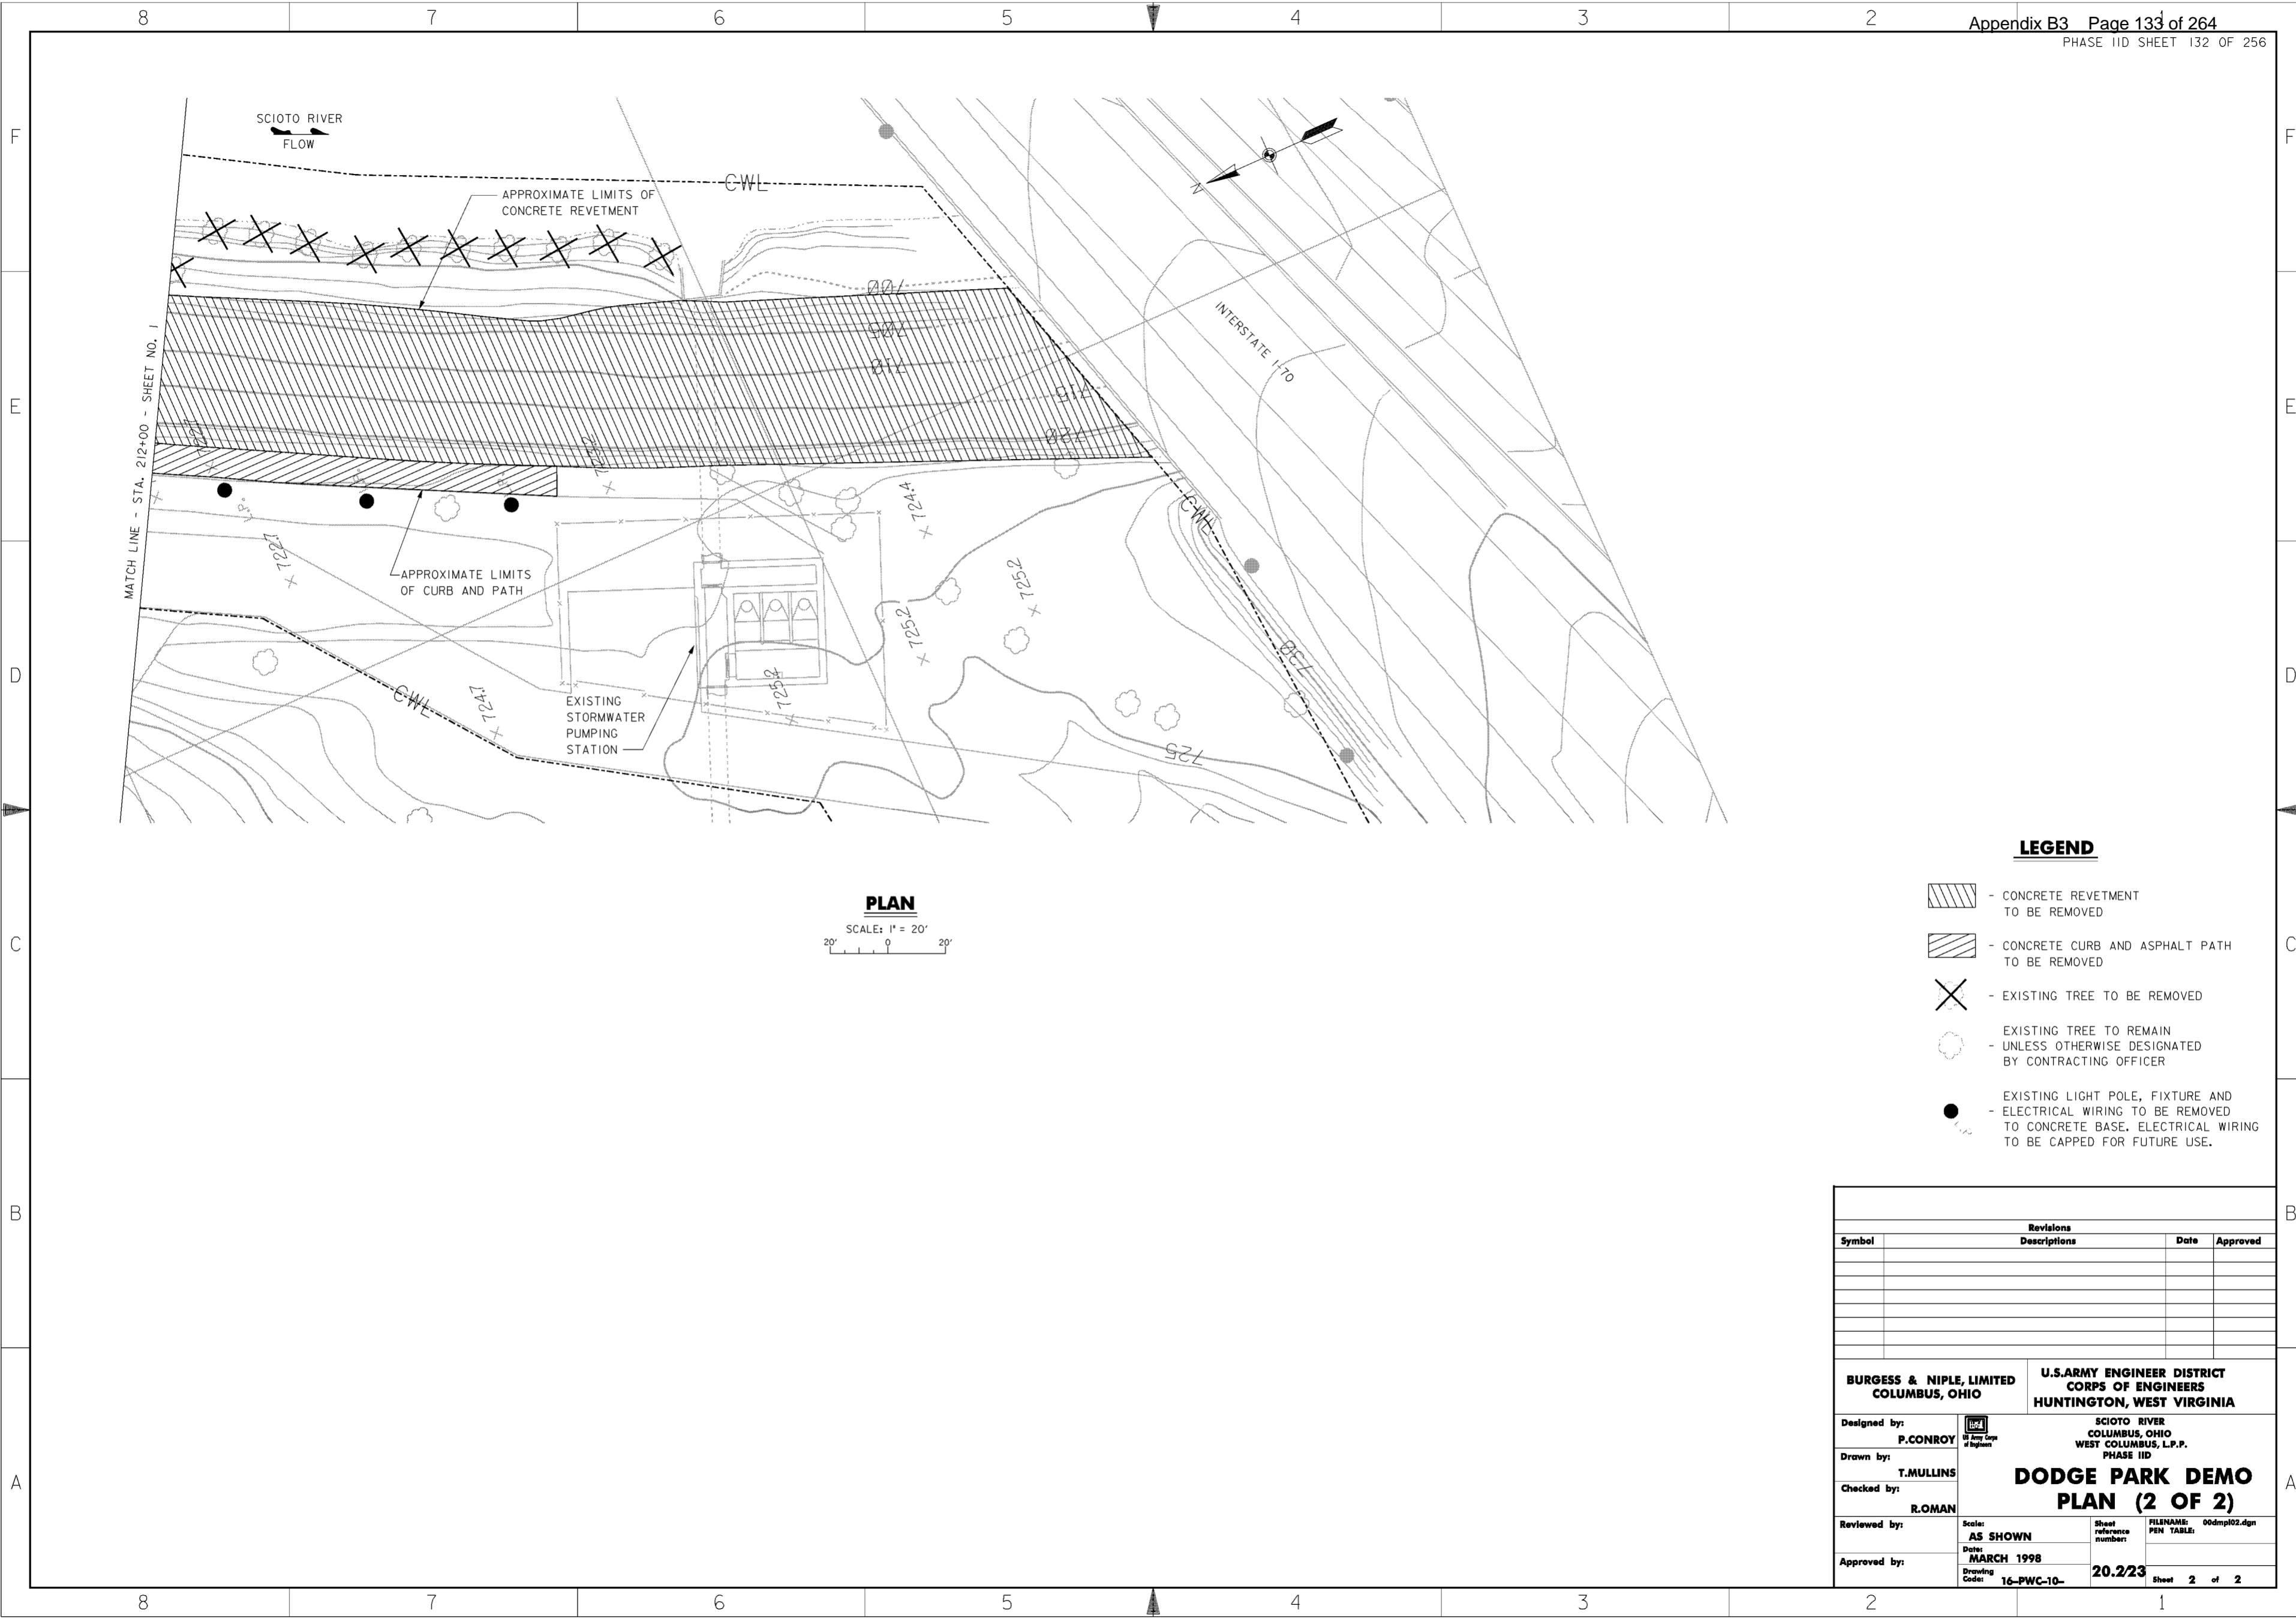BURGESS & NIPLE, LIMITED COLUMBUS, OHIO	U.S. ARMY ENGINEER DISTRICT CORPS OF ENGINEERS HUNTINGTON, WEST VIRGINIA
Designed by: P. CONROY	SCIOTO RIVER COLUMBUS, OHIO WEST COLUMBUS, L.P.P. PHASE IID
Drawn by: T. MULLINS	DODGE PARK ACCESS RAMP PLAN & DETAILS
Checked by: J. HALL	Scale: AS SHOWN
Reviewed by:	Date: MARCH 1998
Approved by:	Sheet reference number: 20.2/21
	FILENAME: PEN TABLE: 004pp01.dgn
	Drawing Code: 16-PWC-10-
	Sheet 1 of 1



PLAN
 SCALE: 1" = 20'


LEGEND

-  - CONCRETE REVETMENT TO BE REMOVED
-  - CONCRETE CURB AND ASPHALT PATH TO BE REMOVED
-  - EXISTING TREE TO BE REMOVED
-  - EXISTING TREE TO REMAIN - UNLESS OTHERWISE DESIGNATED BY CONTRACTING OFFICER
-  - EXISTING LIGHT POLE, FIXTURE AND ELECTRICAL WIRING TO BE REMOVED TO CONCRETE BASE. ELECTRICAL WIRING TO BE CAPPED FOR FUTURE USE.

Revisions			
Symbol	Descriptions	Date	Approved

BURGESS & NIPLE, LIMITED COLUMBUS, OHIO	U.S. ARMY ENGINEER DISTRICT CORPS OF ENGINEERS HUNTINGTON, WEST VIRGINIA	
Designed by: P. CONROY	SCIOTO RIVER COLUMBUS, OHIO WEST COLUMBUS, L.P.P. PHASE IID DODGE PARK DEMO PLAN (2 OF 2)	
Drawn by: T. MULLINS		
Checked by: R. ROMAN		
Reviewed by:		
Approved by:	Scale: AS SHOWN Date: MARCH 1998 Drawing Code: 16-PWC-10-	Sheet reference number: 20.2/23 FILENAME: PEN TABLE: 00dmp102.dgn Sheet 2 of 2


WORK AS CONSTRUCTED

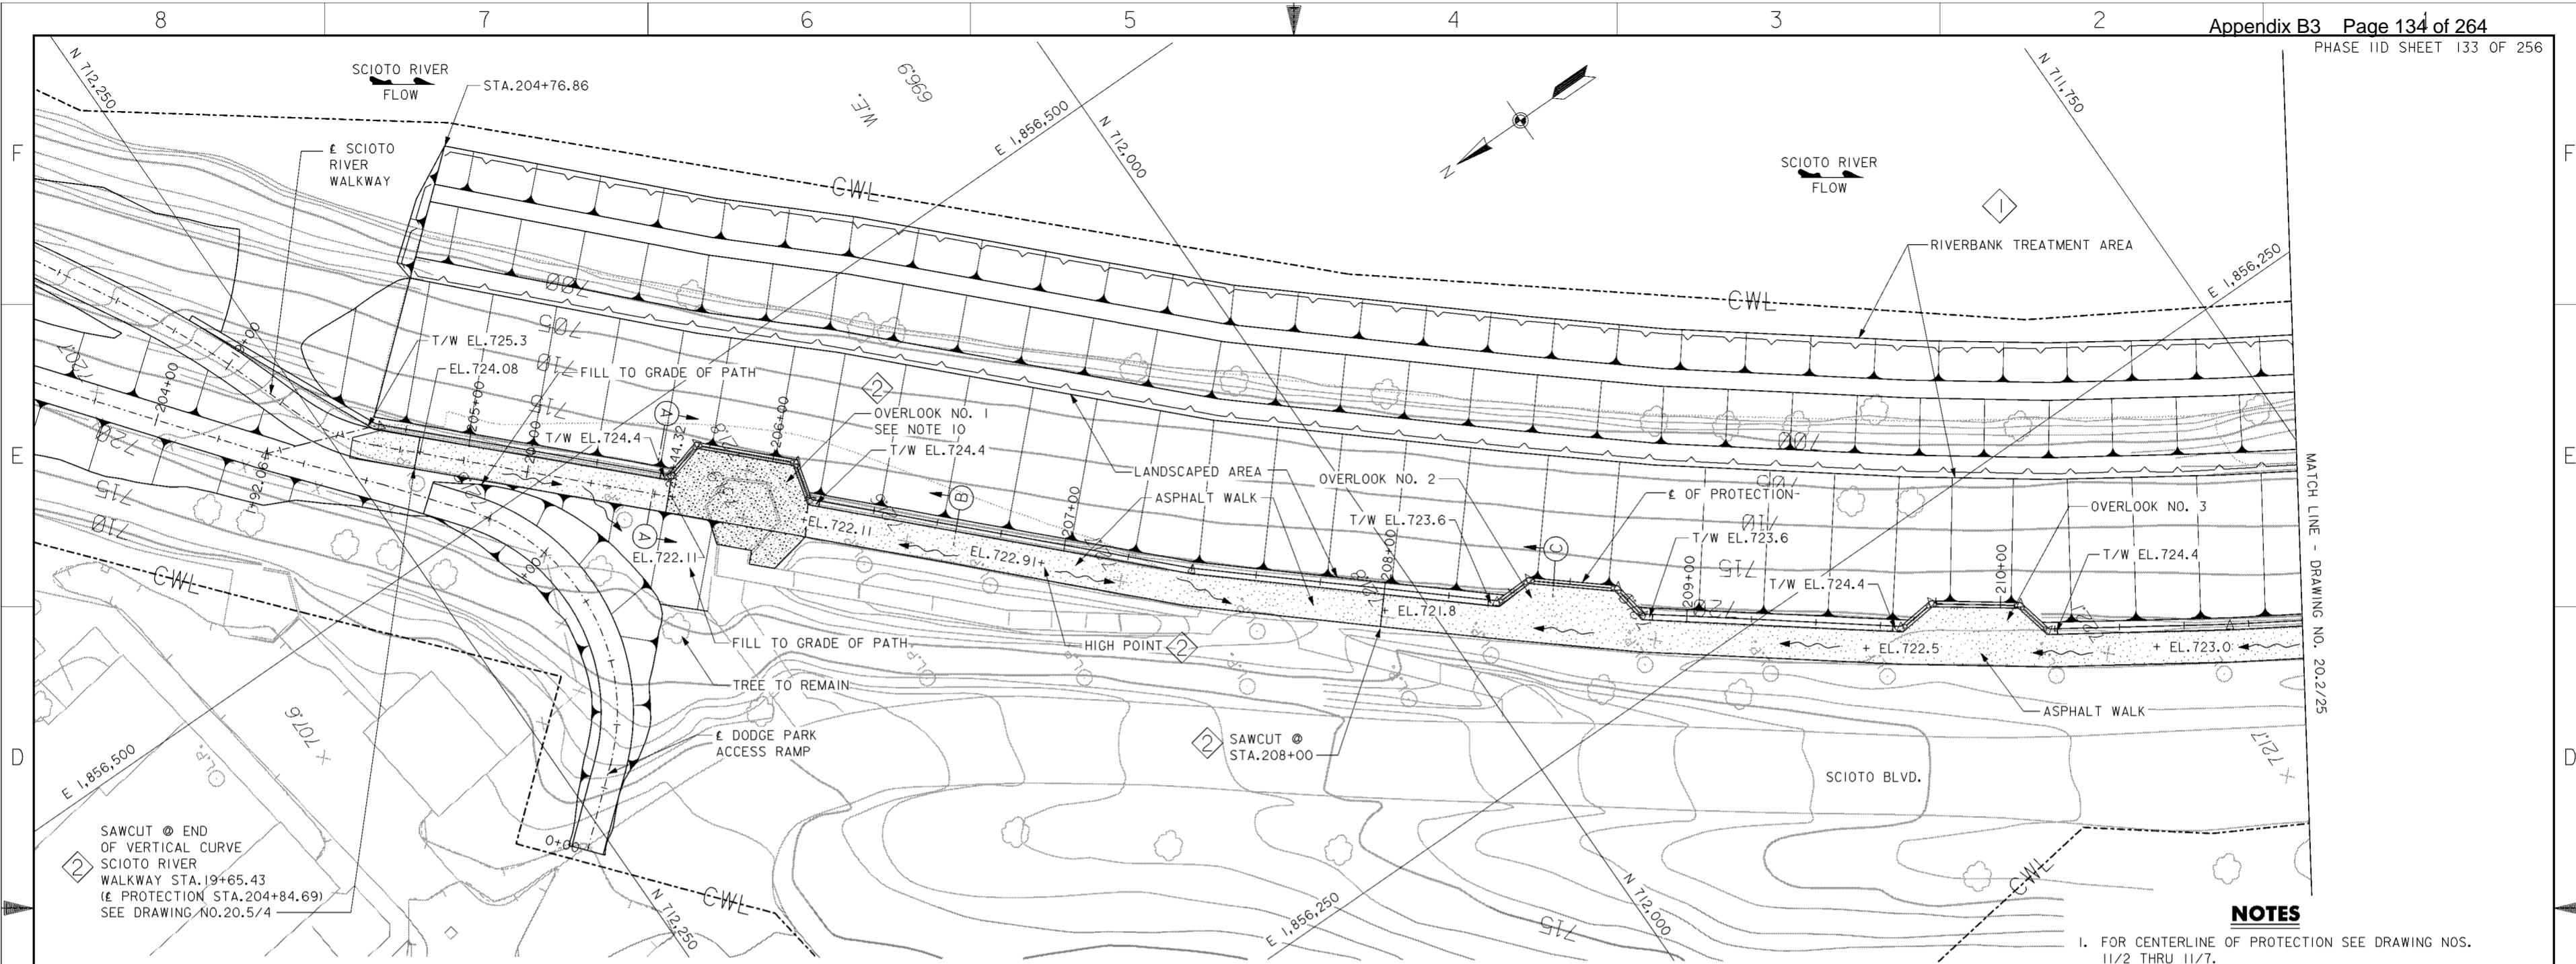


PLAN
 SCALE: 1" = 20'

- LEGEND**
- ASPHALT WALK
 - CONCRETE PAVEMENT
 - + EL. 721.8 - PROPOSED ELEVATION
 - DRAINAGE FLOW
 - T/W - TOP OF WALL


- NOTES**
1. FOR CENTERLINE OF PROTECTION SEE DRAWING NOS. 11/2 THRU 11/7.
 2. FOR DODGE PARK DEMOLITION SEE DRAWING NOS. 20.2/22 AND 20.2/23.
 3. FOR DODGE PARK OVERLOOK PLANS AND DETAILS SEE DRAWING NOS. 20.2/26 THRU 20.2/28.
 4. FOR CONTINUATION OF SCIOTO RIVER WALKWAY SEE DRAWING NOS. 20.5/2 THRU 20.5/4
 5. REMOVE TWO EXISTING CONCRETE COLUMNS AND PLATFORM TO ALLOW FOR INSTALLATION OF SHEET PILING AND FORCE MAINS. REPLACE IN KIND.
 6. THE CONTRACTOR SHALL VERIFY LOCATION AND DEPTH OF AMERICAN ELECTRIC POWER CONDUITS AT ALL EXCAVATIONS ALONG PATH.
 7. FOR DODGE PARK LANDSCAPING PLAN SEE DRAWING NOS. 12/8 AND 12/9.
 8. FOR DODGE PARK RIVERBANK TREATMENT TYPICAL SECTION SEE DRAWING NO. 20.2/25.
 9. FOR SANITARY FORCE MAIN LAYOUT BELOW PATH SEE DRAWING NOS. 20.4/2 THRU 20.4/7.
 10. FOR DODGE PARK OVERLOOK #1 PAVEMENT PLAN SEE DRAWING NO. 20.2/28.
 11. LIMITS FOR PAVEMENT REMOVAL SHALL BE BETWEEN STATIONS 204+84.69 TO 208+00.

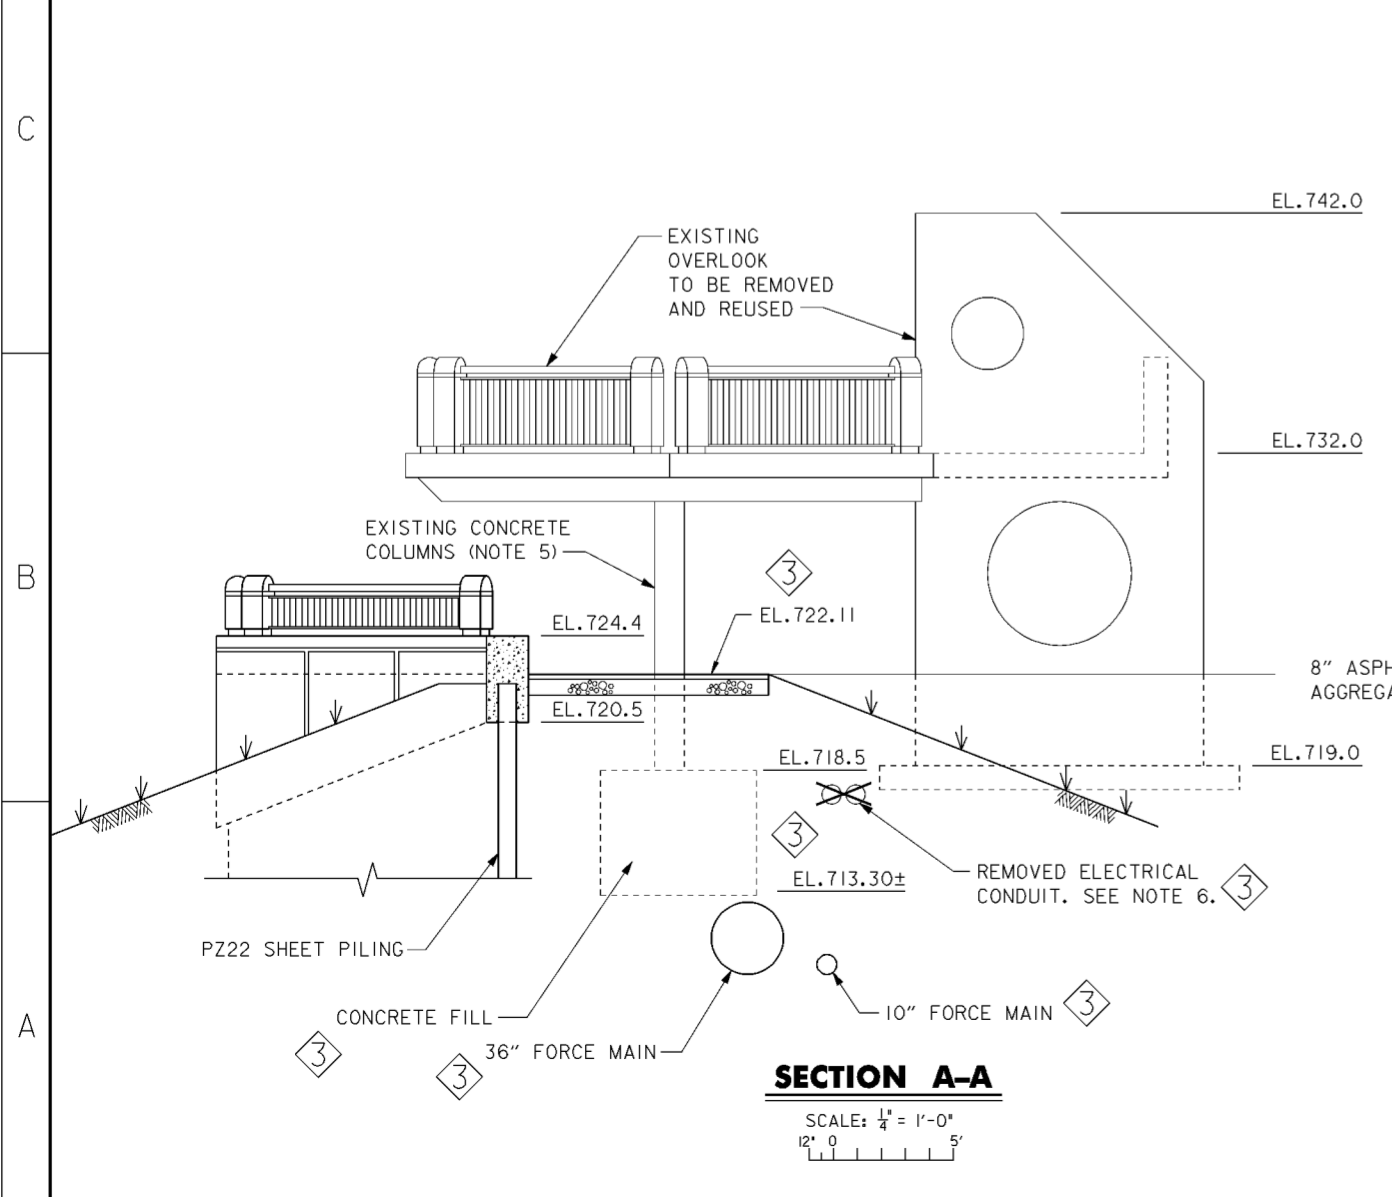

SECTION A-A
 SCALE: 1/4" = 1'-0"

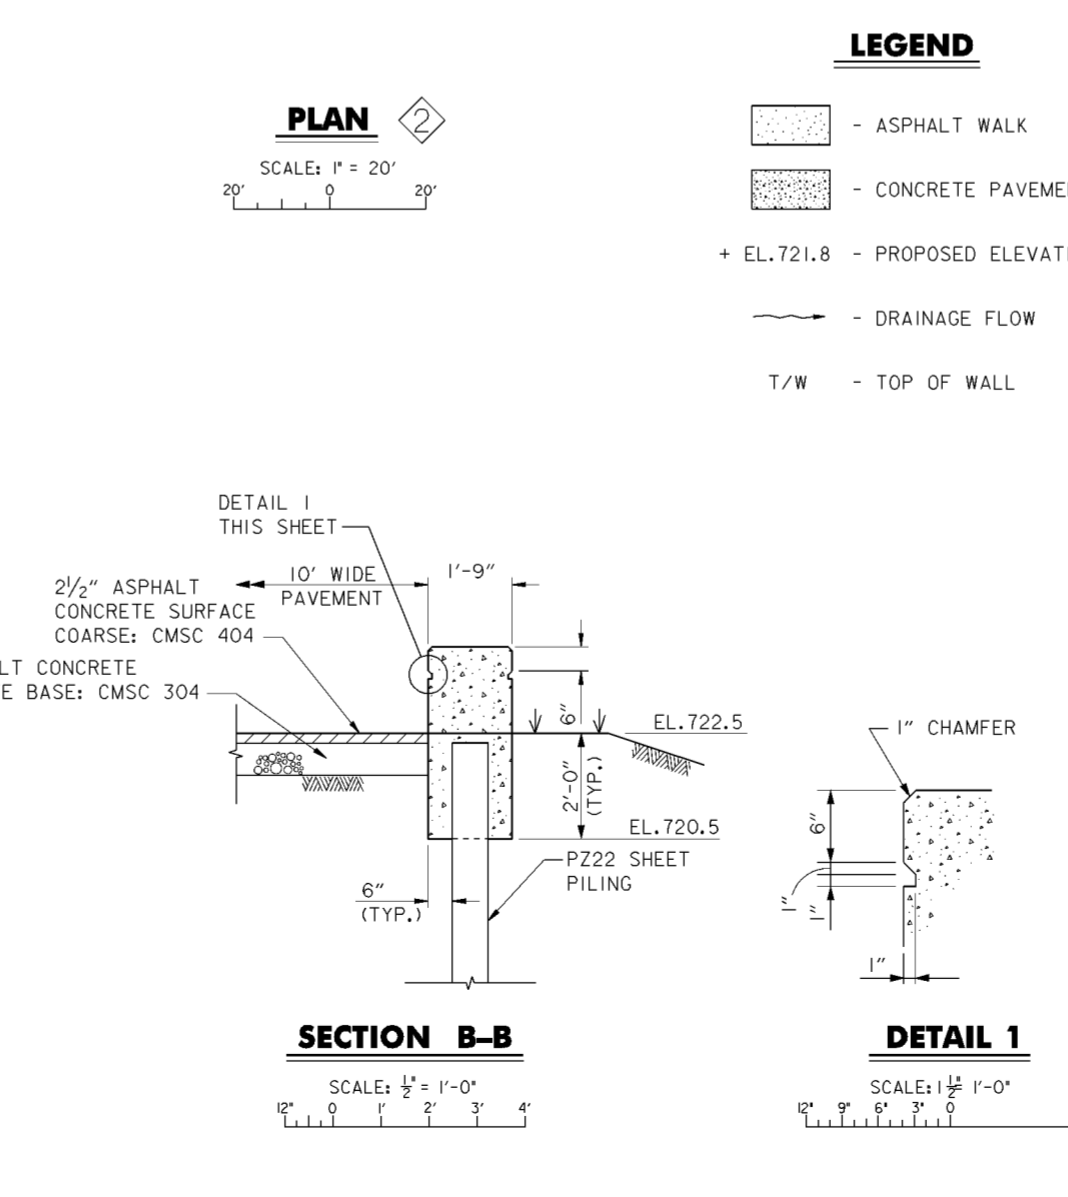


SECTION B-B
 SCALE: 1/2" = 1'-0"

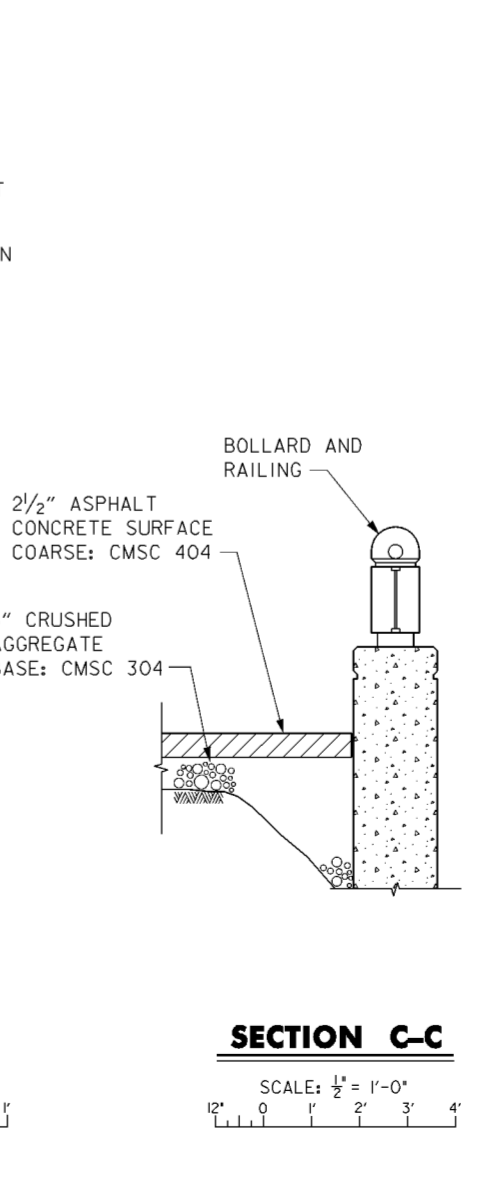


SECTION C-C
 SCALE: 1/2" = 1'-0"

Revisions			
Symbol	Descriptions	Date	Approved
Ⓛ	REVISED AS CONSTRUCTED	7/02	P.O.C.
Ⓛ	REV. BY CONTRACT MODIFICATION LETTER MC021	2/00	P.O.C.
Ⓛ	REV. BY CONTRACT MODIFICATION LETTER MC002	11/98	P.O.C.


BURGESS & NIPLE, LIMITED COLUMBUS, OHIO	U.S. ARMY ENGINEER DISTRICT CORPS OF ENGINEERS HUNTINGTON, WEST VIRGINIA
DODGE PARK SITE PLAN (1 OF 2)	
Approved by:	Scale: AS SHOWN Date: MARCH 1998 Drawing Code: 16-PWC-10-
Sheet reference number:	FILENAME: 003p01.dgn PEN TABLE: 20.2/24 Sheet 1 of 2

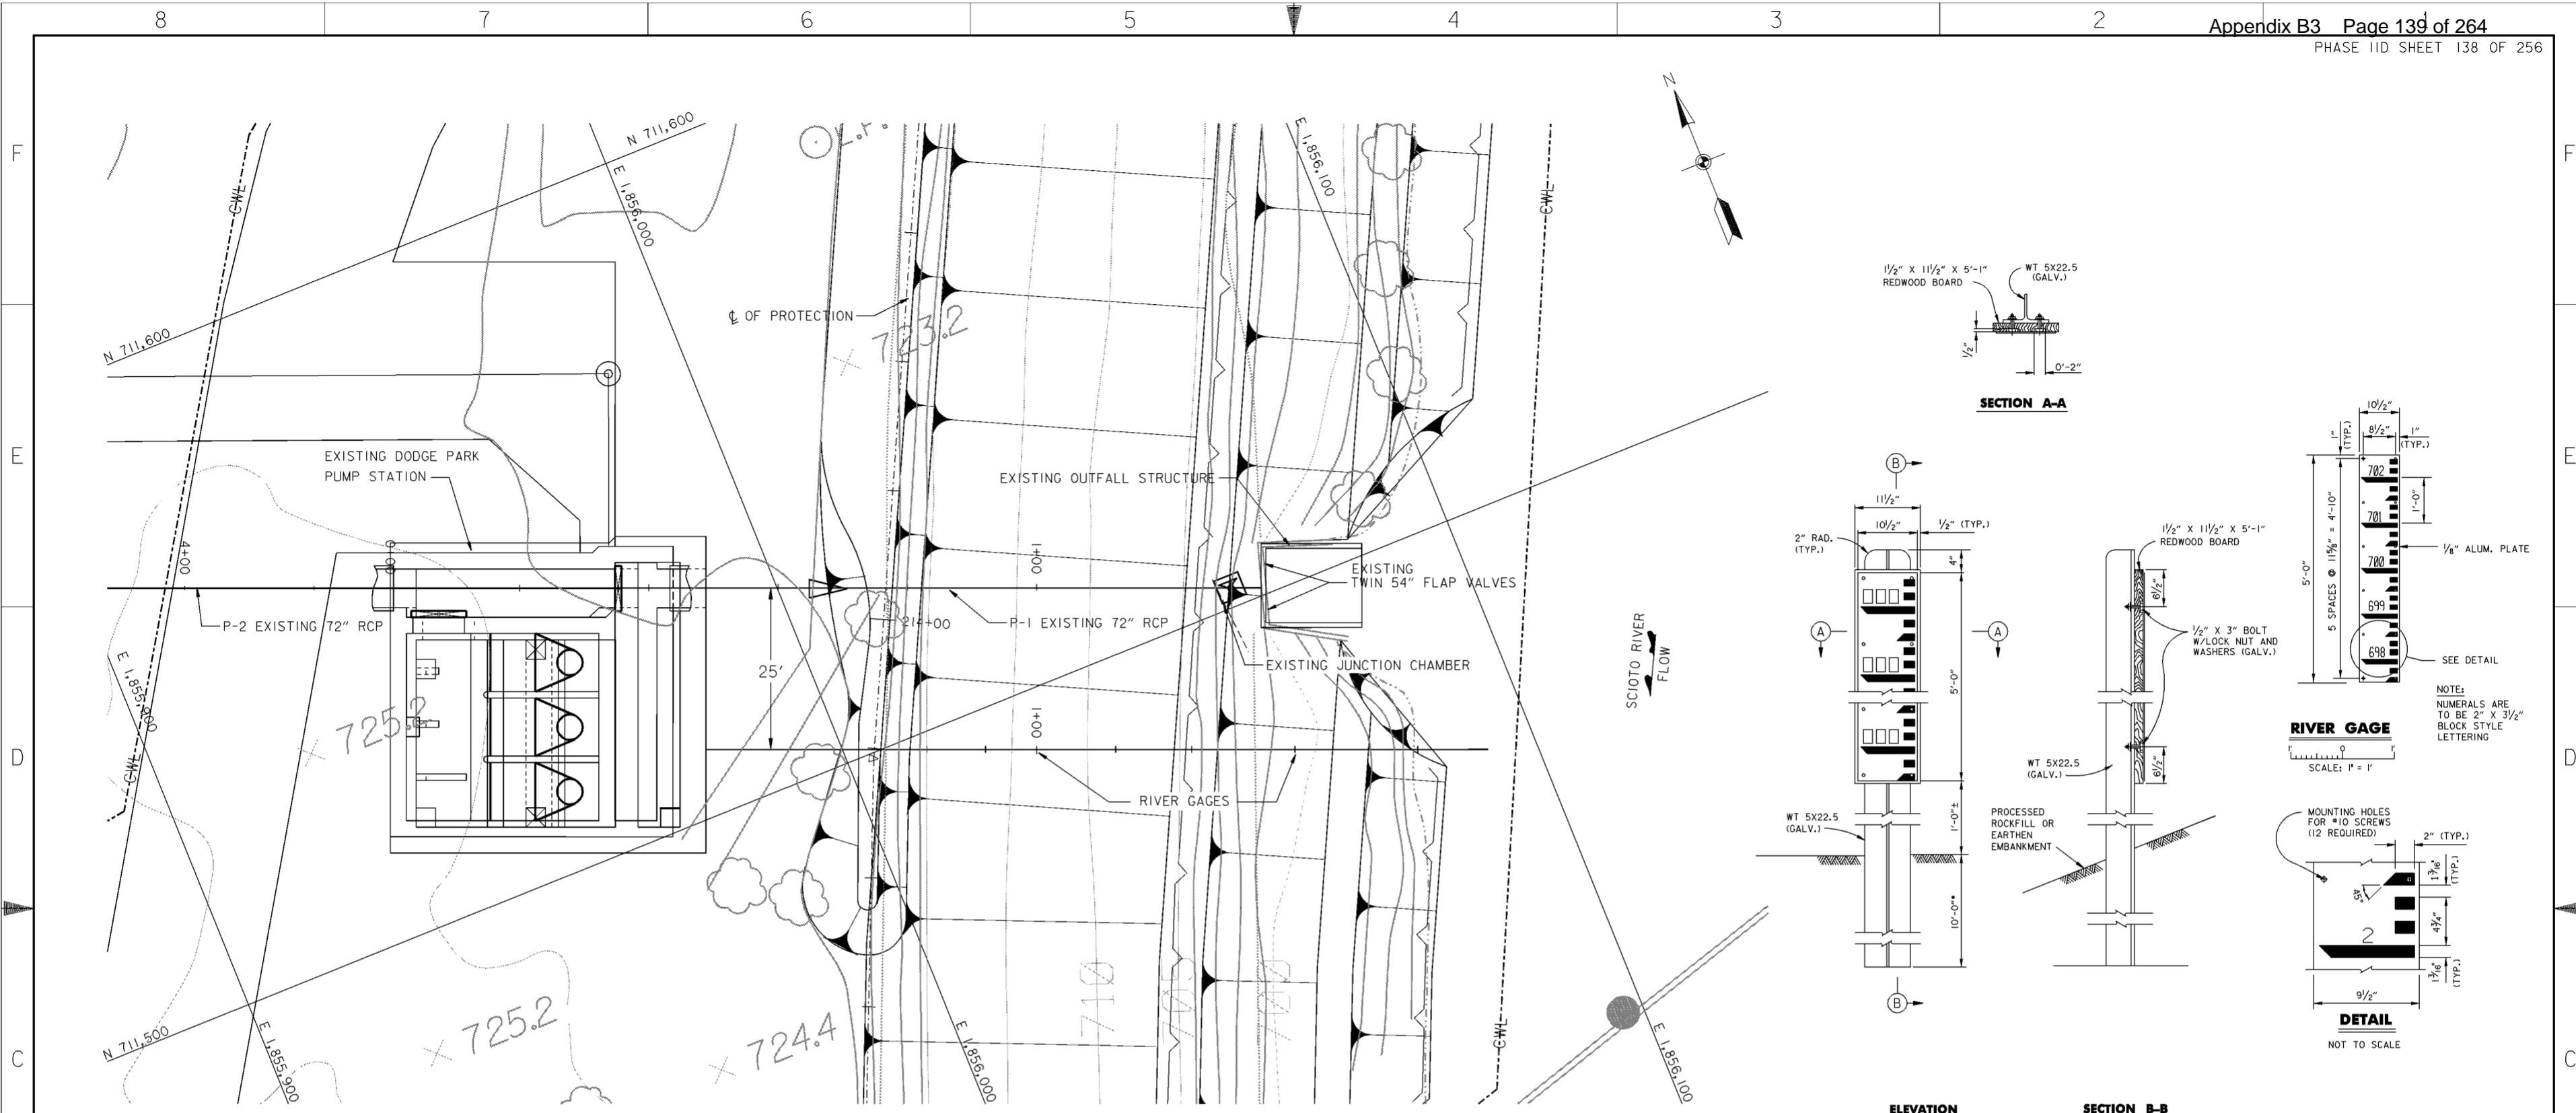

PLAN
 SCALE: 1" = 10'

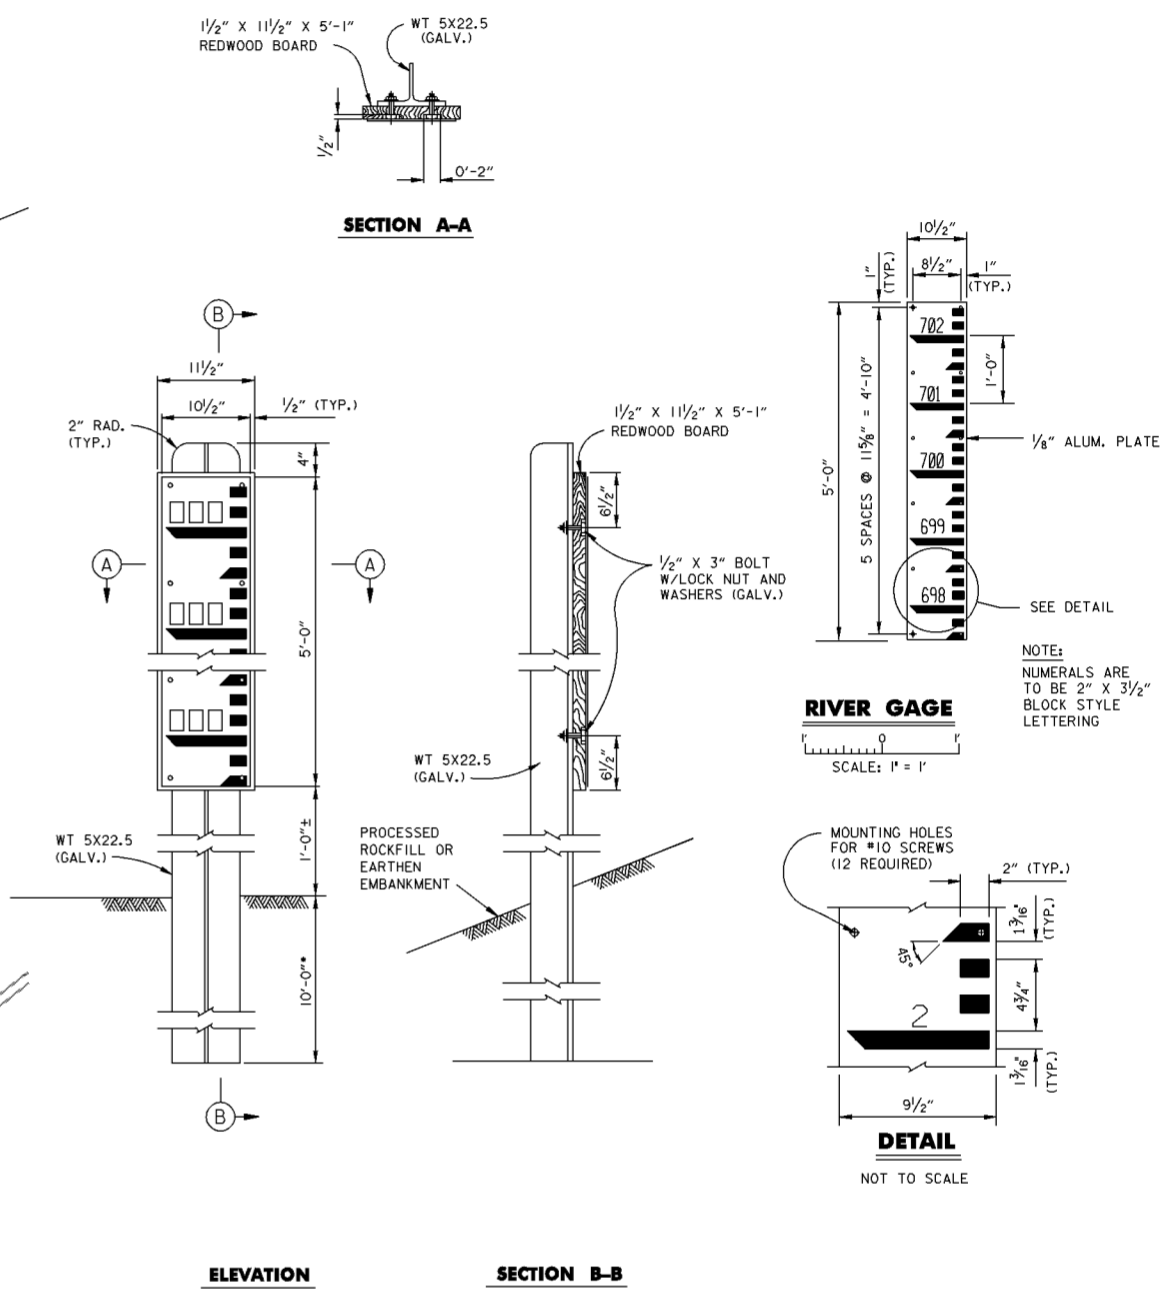

RIVER GAGE MOUNTS
 NOT TO SCALE

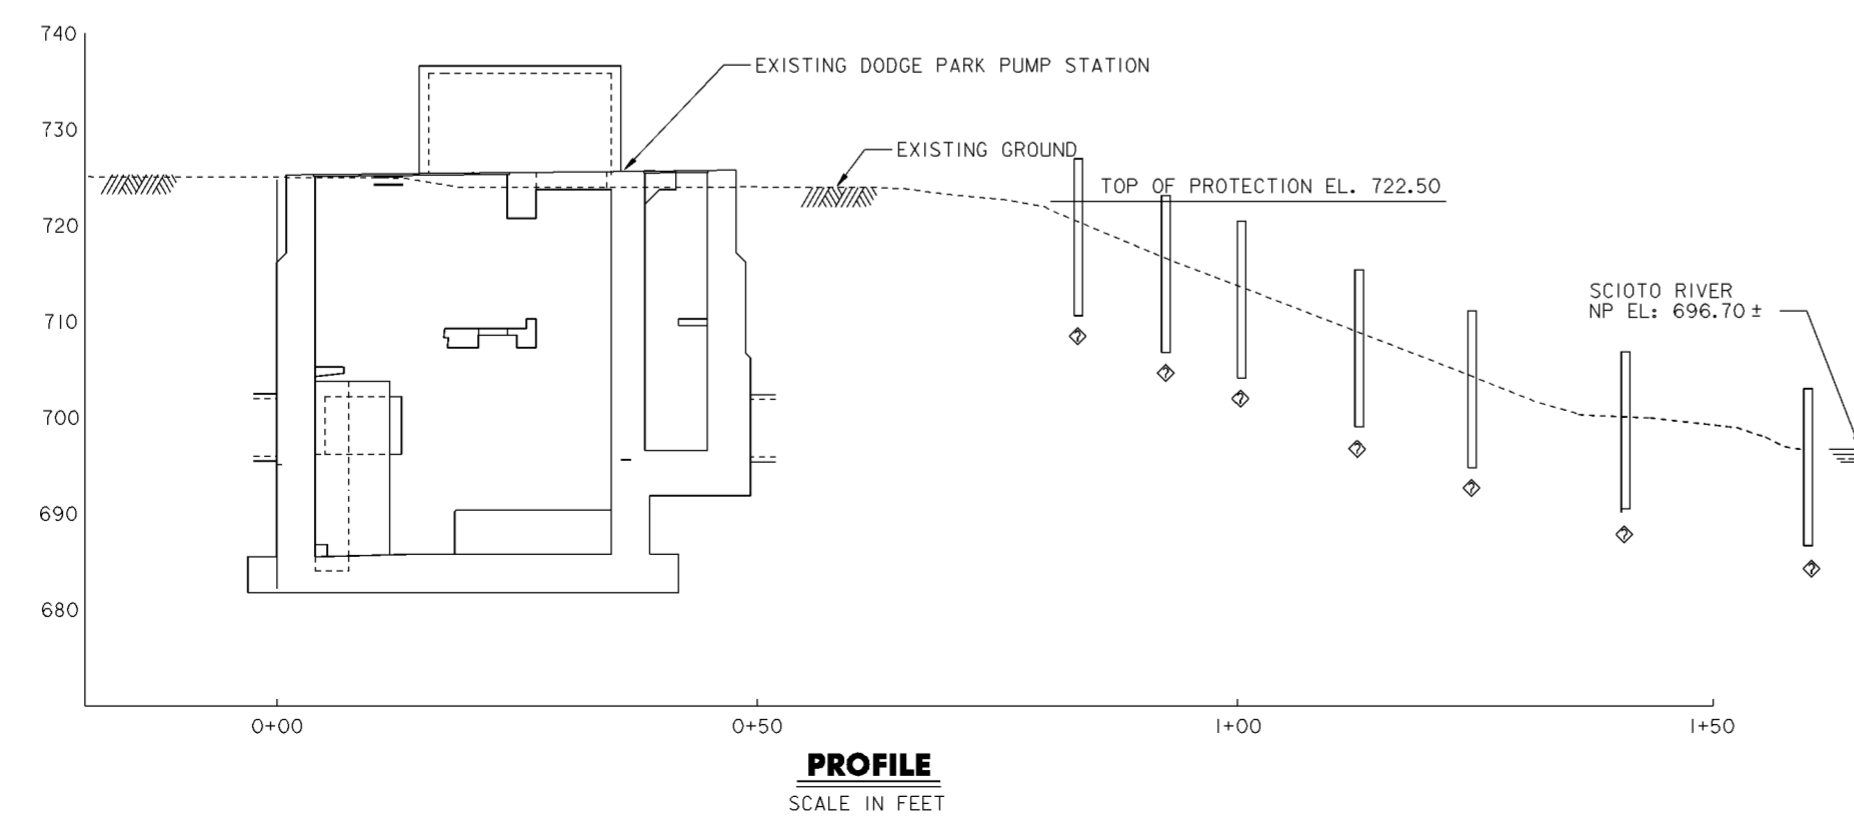

PROFILE
 SCALE IN FEET

NO.	GROUND EL. @ GAGE	EL. @ TOP OF WT5x22.5	GAGE READING		POST IN PROCESSED ROCK FILL
			BOTTOM	TOP	
1	696.5	702.83	698.0	702.0	YES
2	700.5	706.83	702.0	706.0	YES
3	704.5	710.83	706.0	710.0	YES
4	708.5	714.83	710.0	714.0	NO
5	712.5	718.83	714.0	718.0	NO
6	716.5	722.83	718.0	722.0	NO
7	720.5	726.83	722.0	726.0	NO

Revisions			
Symbol	Descriptions	Date	Approved

BURGESS & NIPL, LIMITED
 COLUMBUS, OHIO


U.S. ARMY ENGINEER DISTRICT
CORPS OF ENGINEERS
 HUNTINGTON, WEST VIRGINIA

Designed by: **P.CONROY**
 Drawn by: **T.MULLINS**
 Checked by: **R.ROMAN**
 Reviewed by: **AS SHOWN**
 Approved by: **MARCH 1998**

SCIO TO RIVER
 COLUMBUS, OHIO
 WEST COLUMBUS, L.P.P.
 PHASE IID
RIVER GAGE MOUNTS

Scale: **AS SHOWN**
 Date: **MARCH 1998**
 Drawing Code: **16-PWC-10-**

Sheet reference number: **20.228A**
 FILENAME: **rtvarmts.dgn**
 PEN TABLE:
 Sheet **1** of **1**

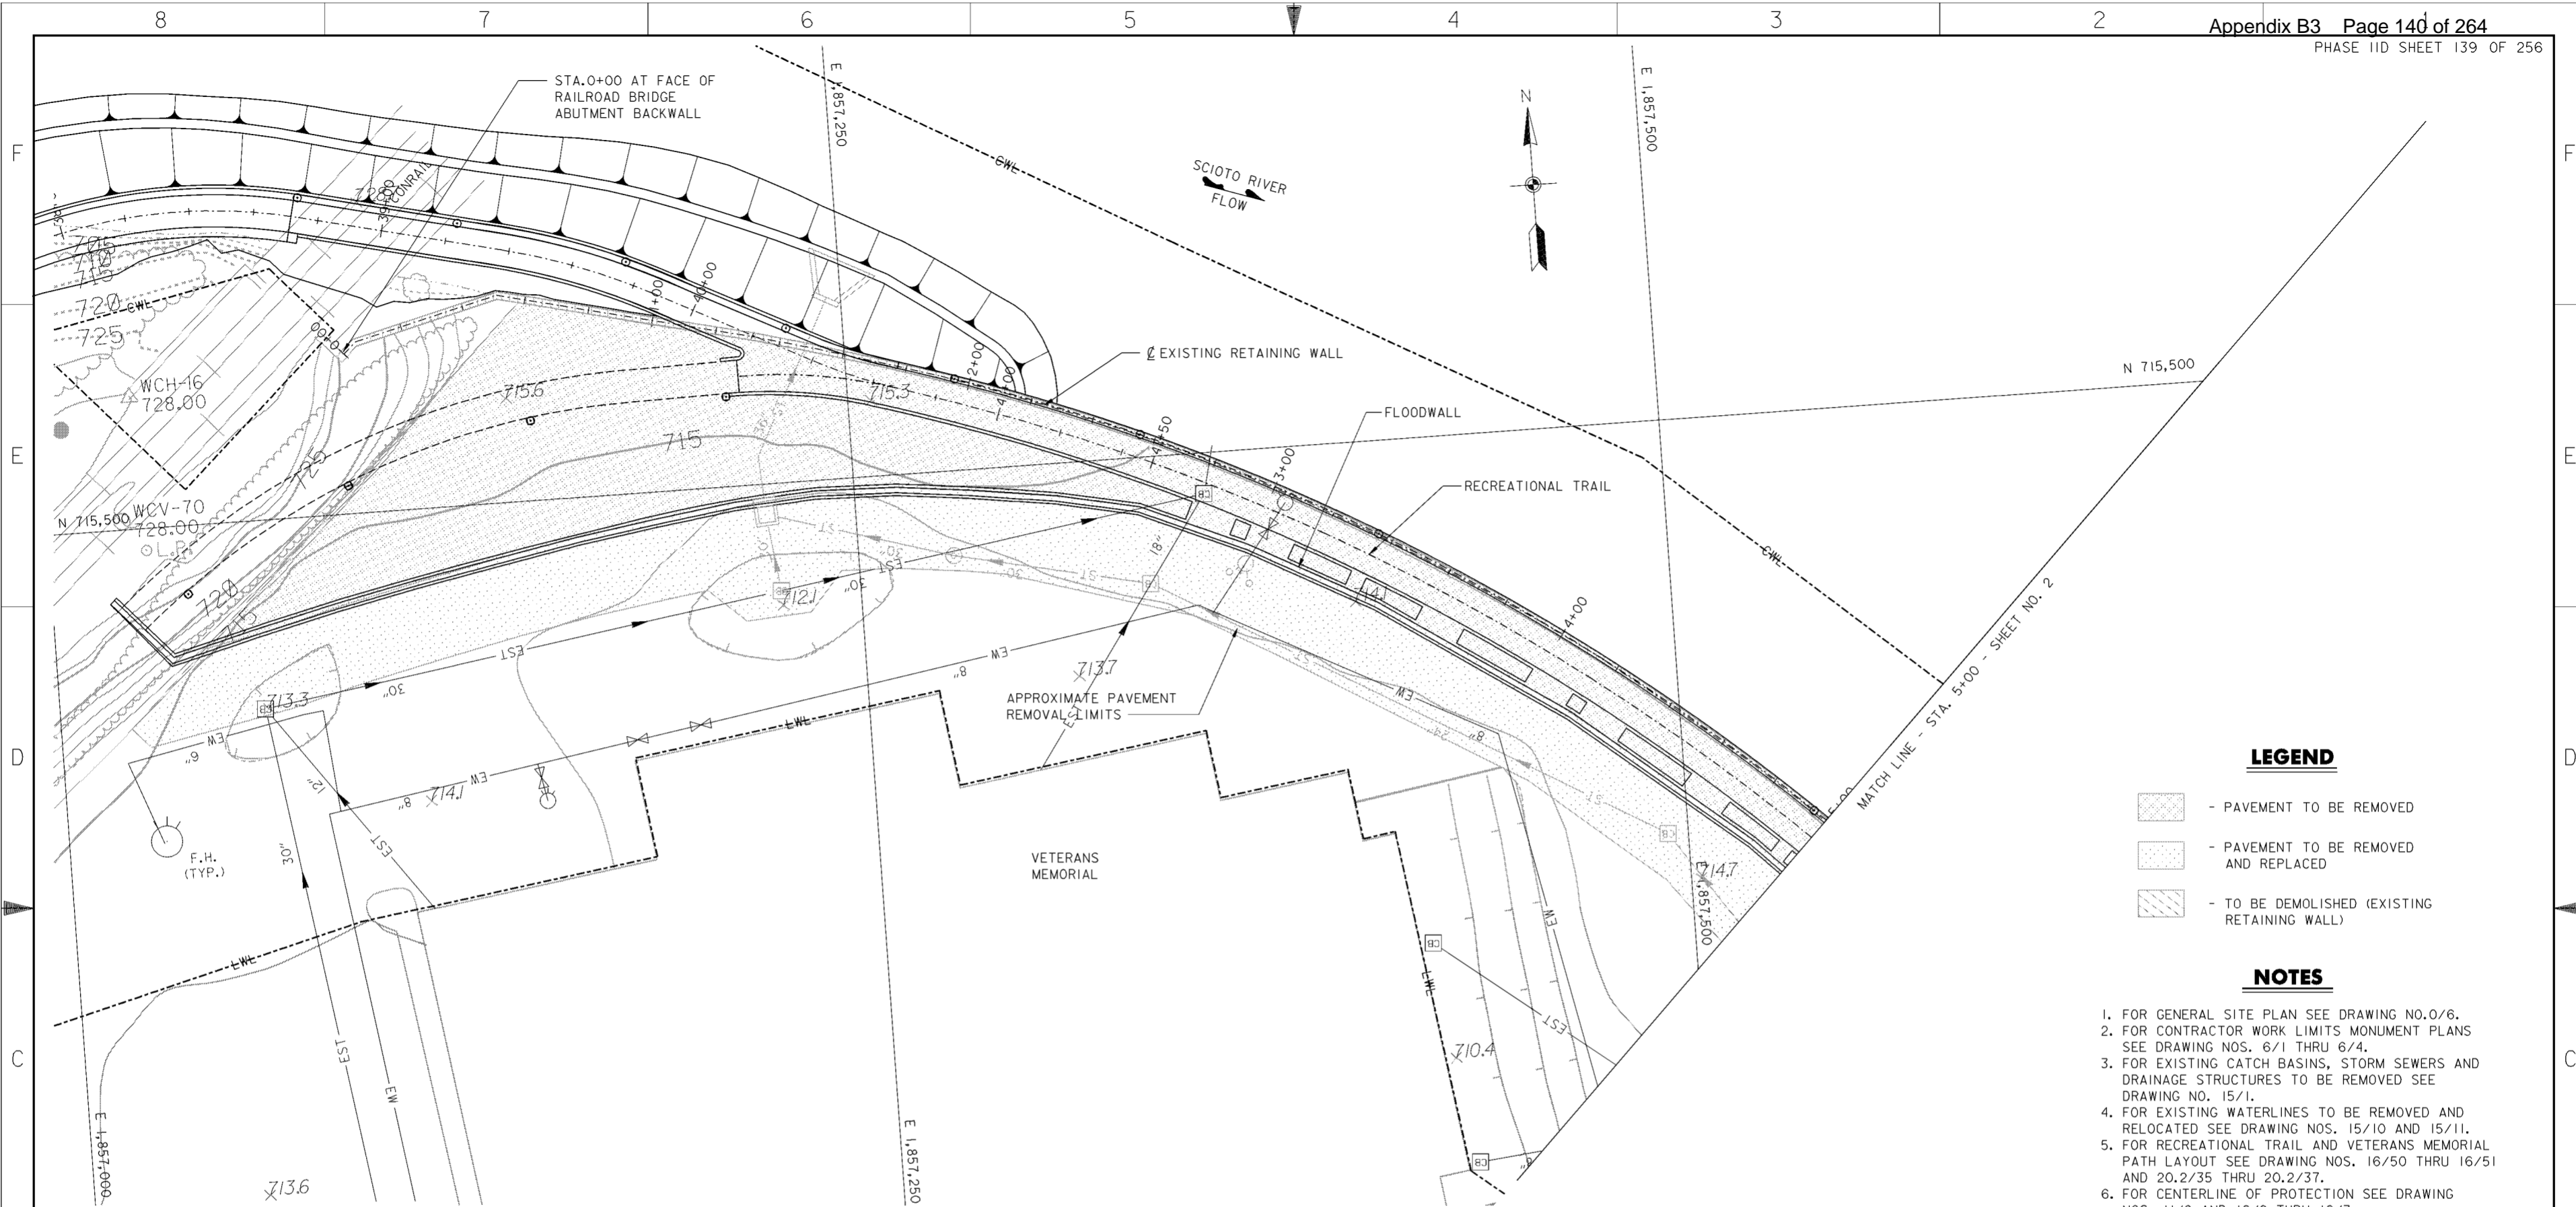


LEGEND

- PAVEMENT TO BE REMOVED
- PAVEMENT TO BE REMOVED AND REPLACED
- TO BE DEMOLISHED (EXISTING RETAINING WALL)

NOTES

1. FOR GENERAL SITE PLAN SEE DRAWING NO. 0/6.
2. FOR CONTRACTOR WORK LIMITS MONUMENT PLANS SEE DRAWING NOS. 6/1 THRU 6/4.
3. FOR EXISTING CATCH BASINS, STORM SEWERS AND DRAINAGE STRUCTURES TO BE REMOVED SEE DRAWING NO. 15/1.
4. FOR EXISTING WATERLINES TO BE REMOVED AND RELOCATED SEE DRAWING NOS. 15/10 AND 15/11.
5. FOR RECREATIONAL TRAIL AND VETERANS MEMORIAL PATH LAYOUT SEE DRAWING NOS. 16/50 THRU 16/51 AND 20.2/35 THRU 20.2/37.
6. FOR CENTERLINE OF PROTECTION SEE DRAWING NOS. 11/2 AND 16/2 THRU 16/3.
7. THE EXISTING RETAINING WALL SHALL BE SAW CUT SMOOTH AND LEVEL. THE WALL SHALL BE CUT WITH THE FOLLOWING VARIATIONS FOR LEVEL TOLERANCES: IN 10 FEET - 1/2 INCH; IN 20 FEET - 3/4 INCH; IN 40 FEET OR MORE - 1 INCH.

PLAN
 SCALE: 1" = 20'

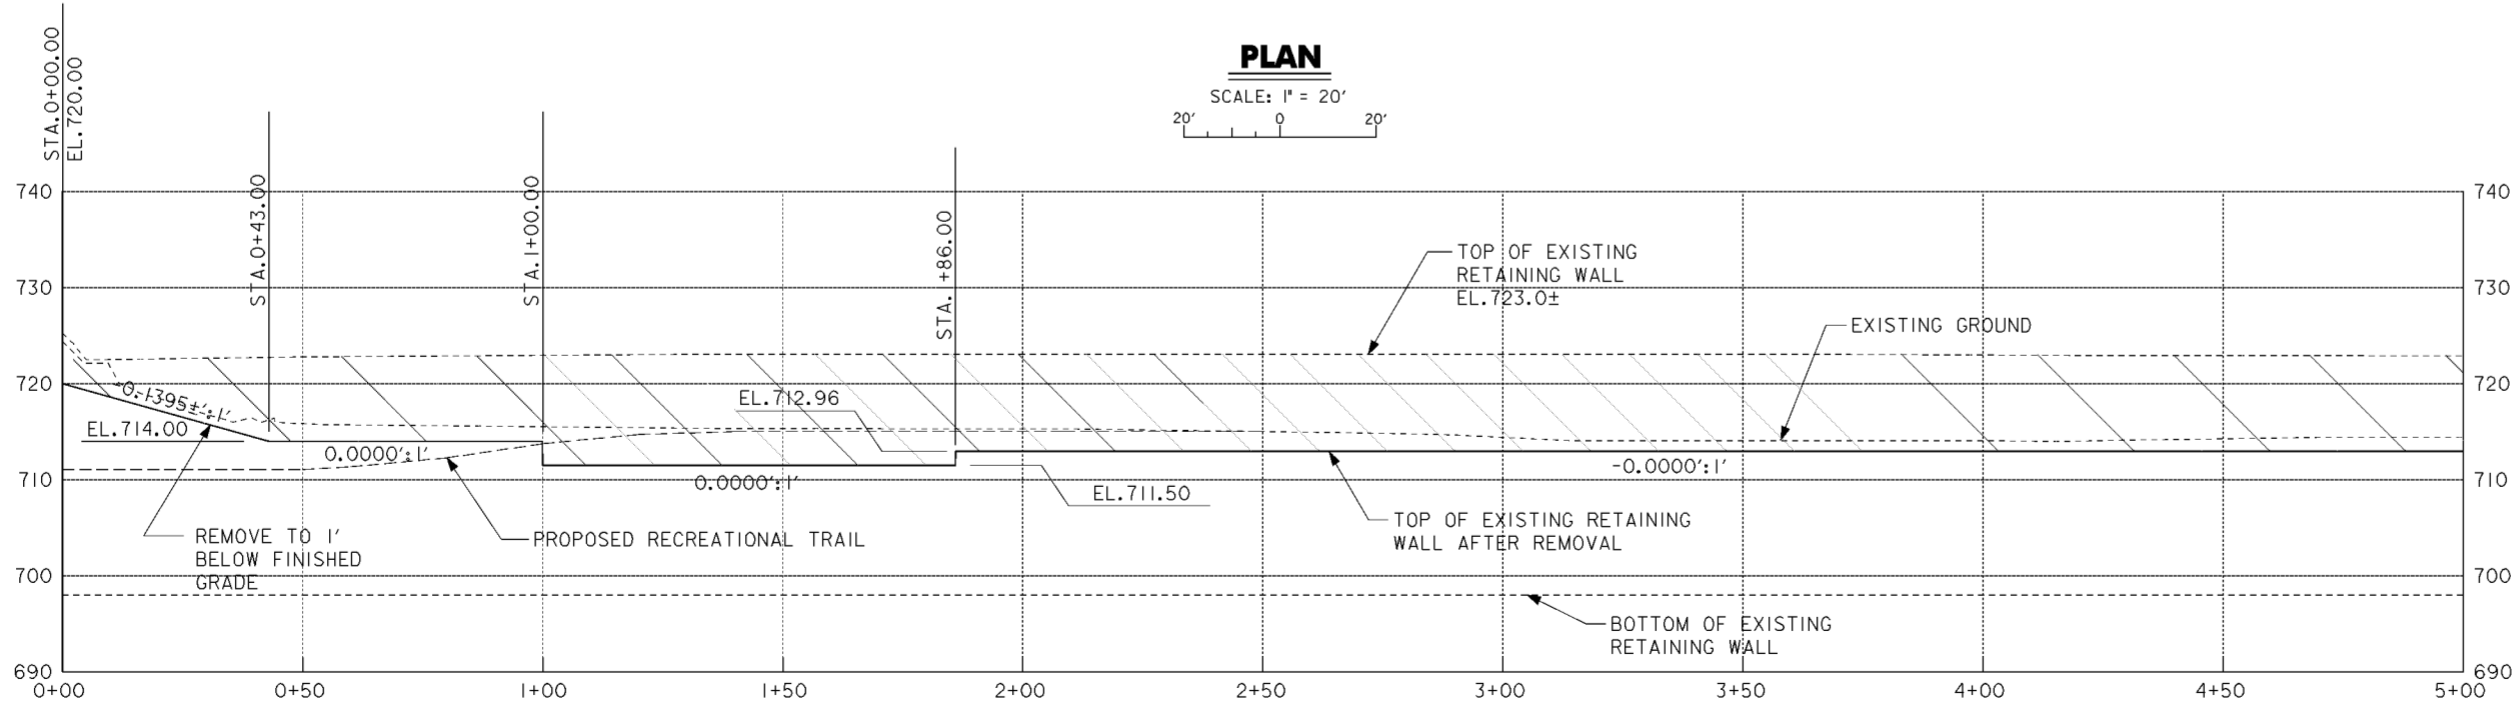


EXISTING RETAINING WALL PROFILE
 SCALE IN FEET

Revisions			
Symbol	Descriptions	Date	Approved

BURGESS & NIPLE, LIMITED COLUMBUS, OHIO		U.S. ARMY ENGINEER DISTRICT CORPS OF ENGINEERS HUNTINGTON, WEST VIRGINIA	
Designed by: R.ROMAN		SCIOTO RIVER COLUMBUS, OHIO WEST COLUMBUS, L.P.P. PHASE IID VETERANS MEMORIAL DEMO PLAN (1 OF 3)	
Drawn by: T.MULLINS			
Checked by: P.CONROY	Scale: AS SHOWN	Sheet reference number: 20.2/29	FILENAME: 00dmp01.dgn
Reviewed by:	Date: MARCH 1998	Drawing Code: 16-PWC-10-	Sheet 1 of 3


TREE PROTECTION LEGEND

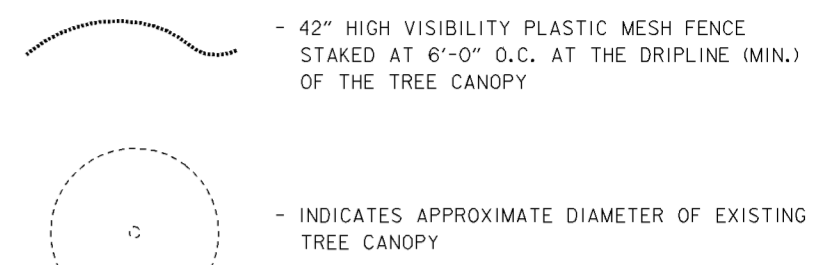

- 42" HIGH VISIBILITY PLASTIC MESH FENCE STAKED AT 6'-0" O.C. AT THE DRIPLINE (MIN.) OF THE TREE CANOPY

- INDICATES APPROXIMATE DIAMETER OF EXISTING TREE CANOPY

LEGEND

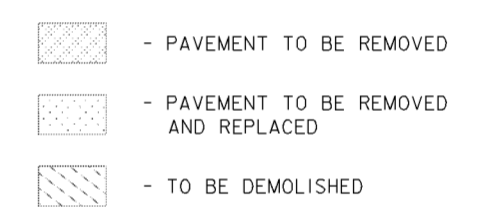


- PAVEMENT TO BE REMOVED

- PAVEMENT TO BE REMOVED AND REPLACED


- TO BE DEMOLISHED

NOTES

1. FOR GENERAL SITE PLAN SEE DRAWING NO.0/6.
2. FOR CONTRACTOR WORK LIMITS MONUMENT PLANS SEE DRAWING NOS. 6/1 THRU 6/4.
3. FOR EXISTING CATCH BASINS, STORM SEWERS AND DRAINAGE STRUCTURES TO BE REMOVED SEE DRAWING NO. 15/1.
4. FOR EXISTING WATERLINES TO BE REMOVED AND RELOCATED SEE DRAWING NOS. 15/10 AND 15/11.
5. FOR RECREATIONAL TRAIL AND VETERANS MEMORIAL PATH LAYOUT SEE DRAWING NOS.16/50 THRU 16/51 AND 20.2/35 THRU 20.2/37.
6. FOR CENTERLINE OF PROTECTION SEE DRAWING NOS. 11/2 THRU 11/3, 16/3 AND 20.2/34.

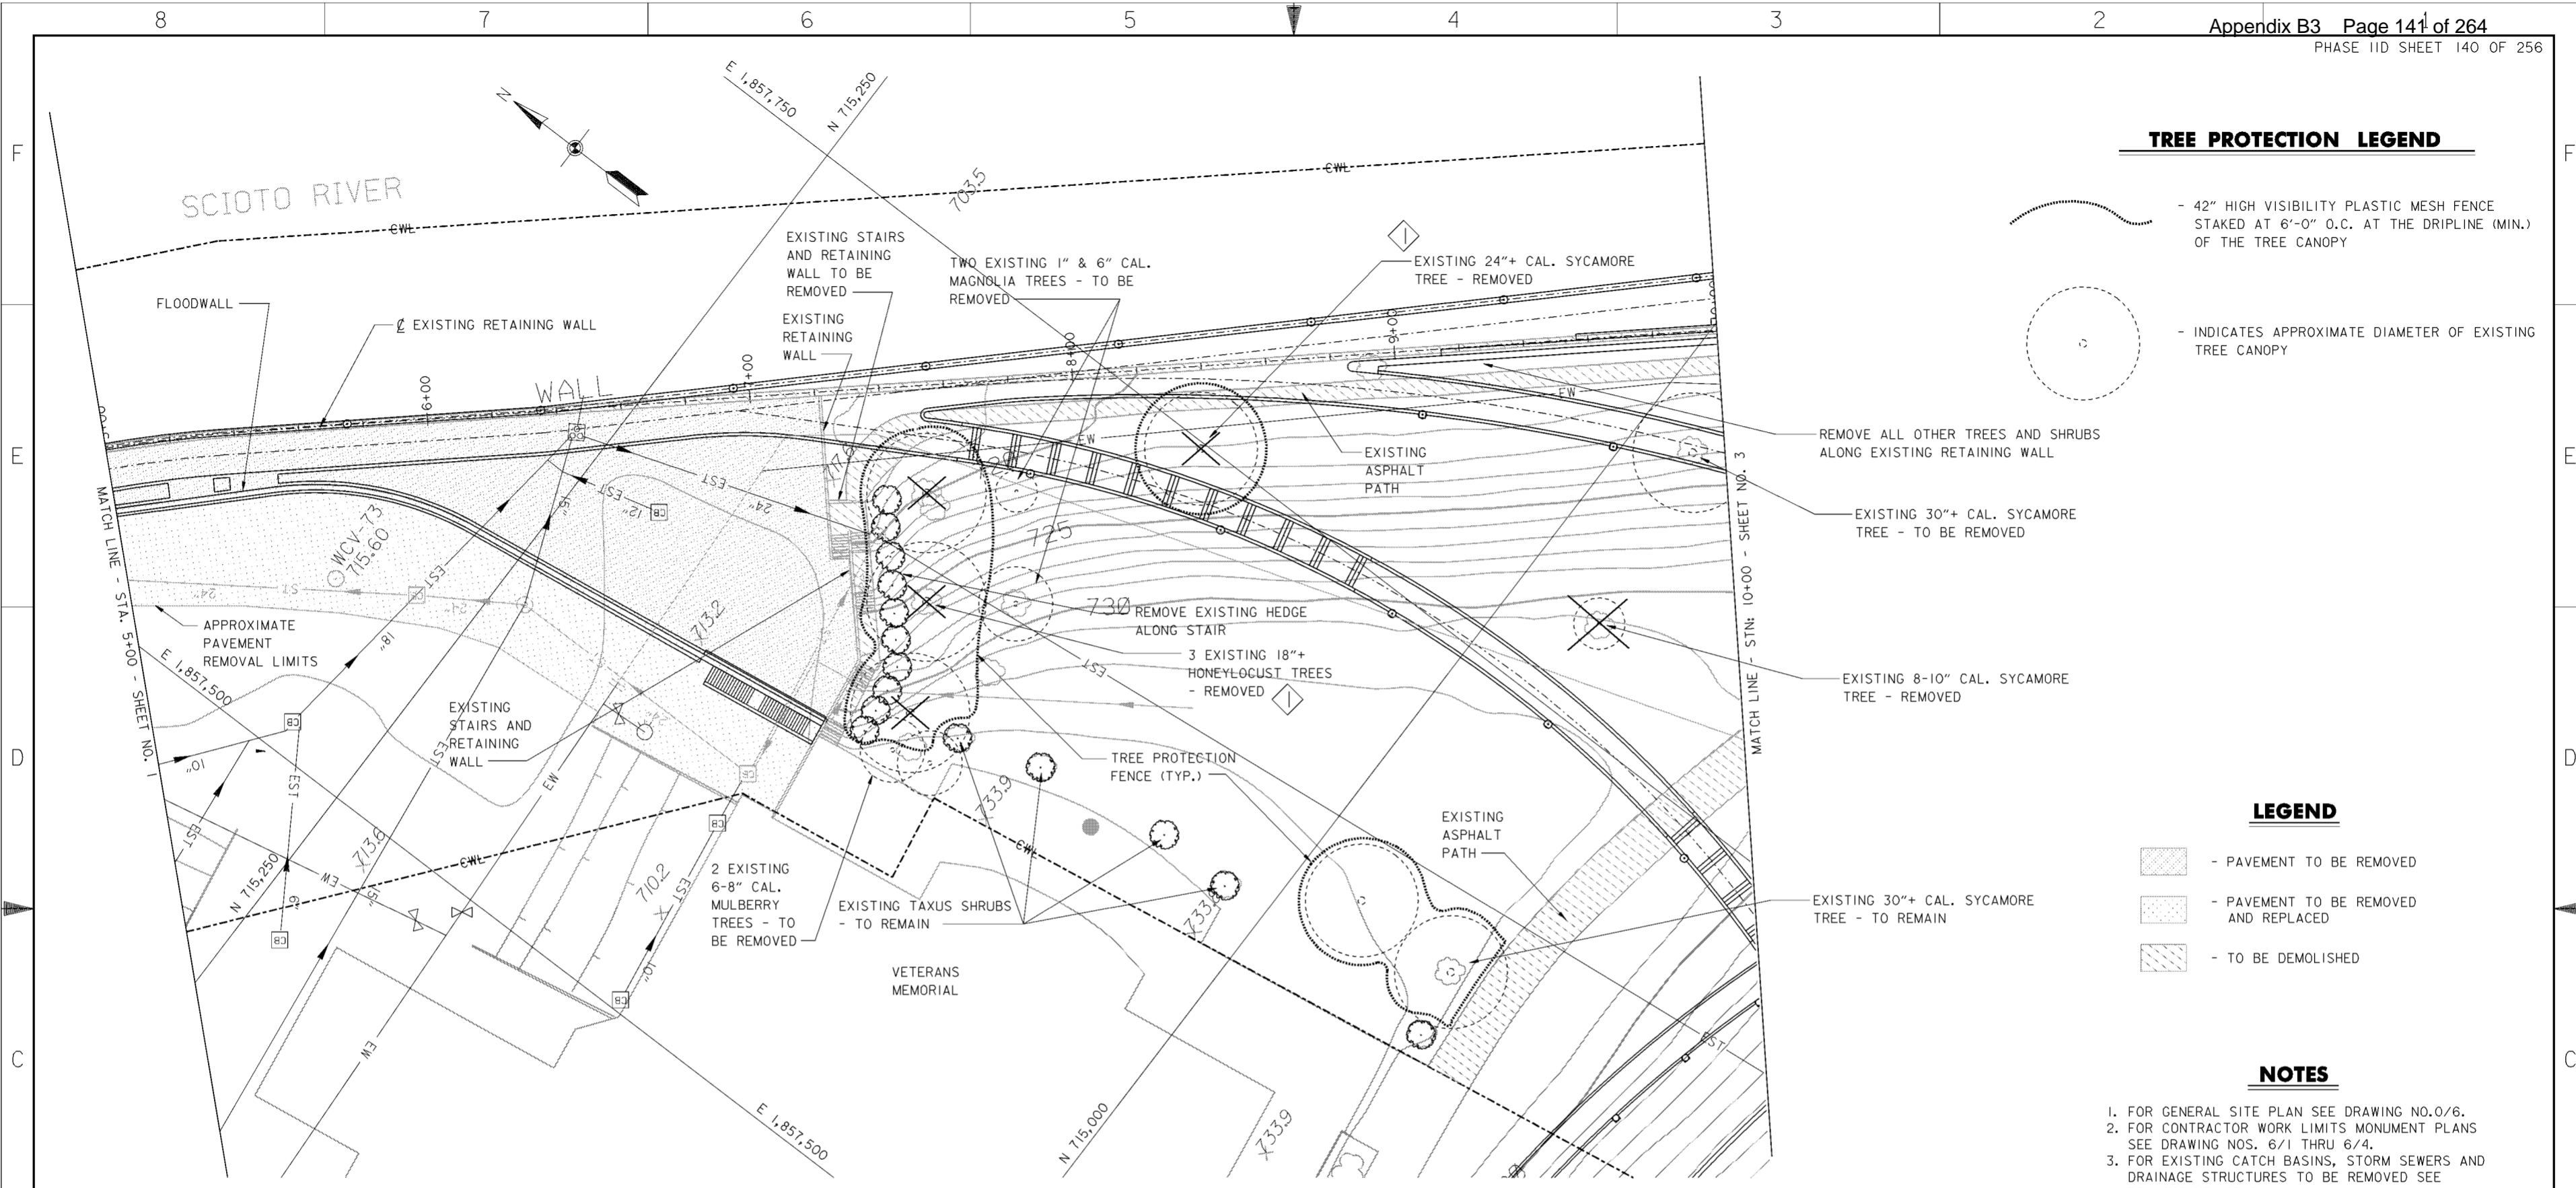

PLAN
 SCALE: 1" = 20'

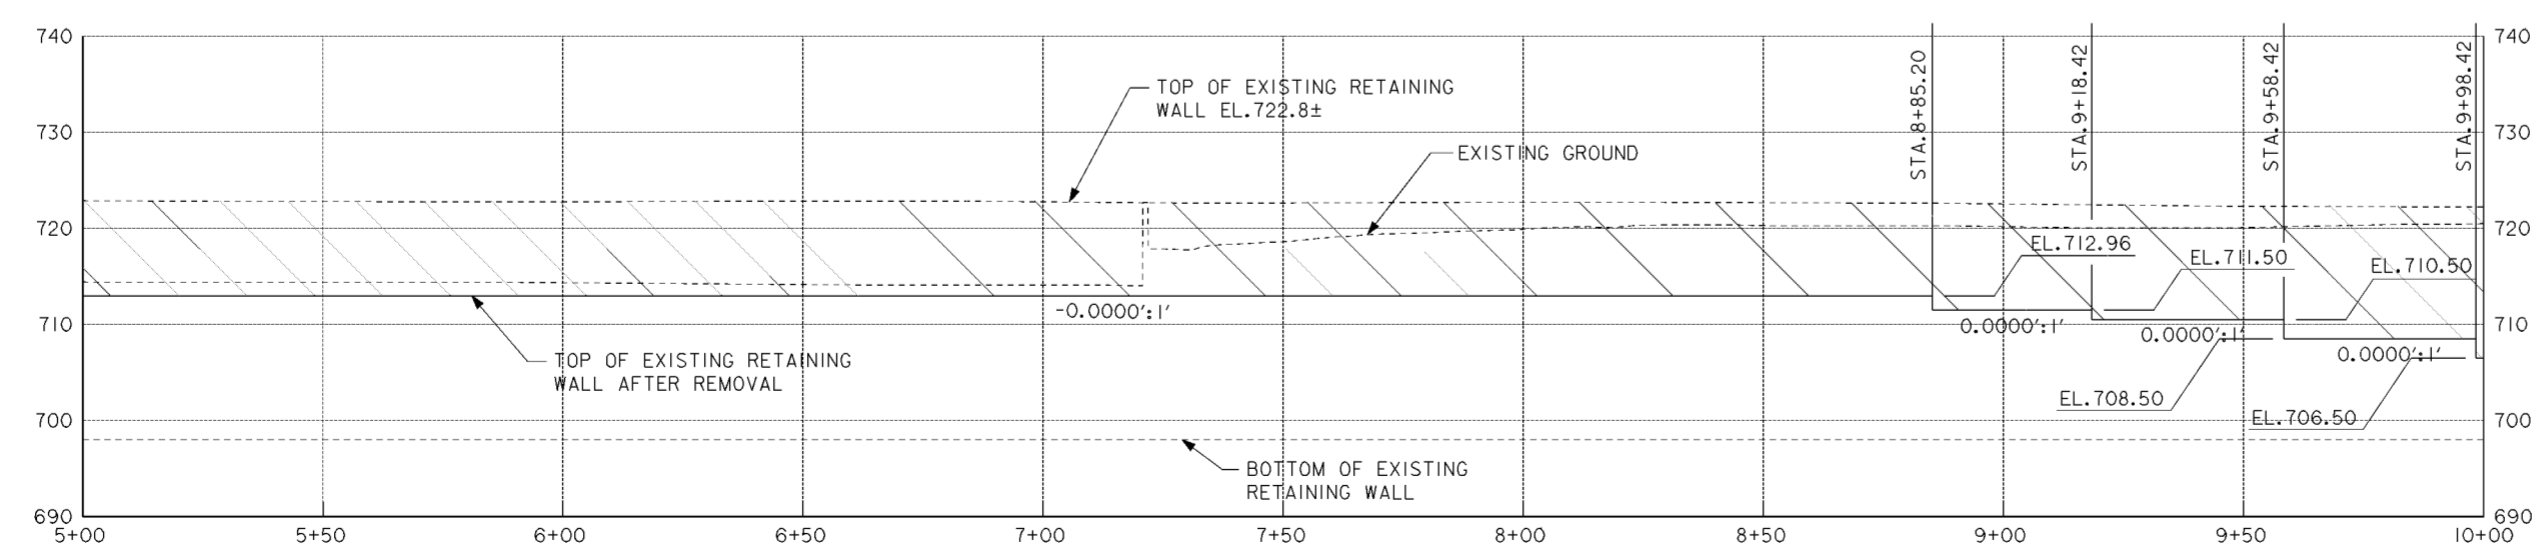

EXISTING RETAINING WALL PROFILE
 SCALE IN FEET

Revisions			
Symbol	Descriptions	Date	Approved
◁	REVISED AS CONSTRUCTED	7/02	P.O.C.

BURGESS & NIPLE, LIMITED COLUMBUS, OHIO	U.S. ARMY ENGINEER DISTRICT CORPS OF ENGINEERS WEST COLUMBUS, L.P.P. PHASE IID
Designed by: R.ROMAN	SCIO TO RIVER COLUMBUS, OHIO WEST COLUMBUS, L.P.P. PHASE IID
Drawn by: T.MULLINS	VETERANS MEMORIAL
Checked by: P.CONROY	DEMO PLAN (2 OF 3)
Reviewed by:	Scale: AS SHOWN
Approved by:	Date: MARCH 1998
	Drawing Code: 16-PWC-10-
	Sheet reference number: 20.2/30
	FILENAME: a0dmp02.dgn
	PEN TABLE:
	Sheet 2 of 3

LEGEND

- GWL--- CONTRACTOR'S WORK LIMITS
- +--- CENTERLINE OF FLOOD PROTECTION
- [] PLAN SHEET IMAGE AREA

SEE SHT. 20.2/33 GRADING PLAN
 SEE SHT. 20.2/35 LAYOUT PLAN
 SEE SHT. 20.2/36 MATERIALS PLAN
 SEE SHT. 20.2/41 PAVEMENT JOINTING PLAN
 SEE SHT. 12/1 PLANTING PLAN

SEE SHT. 20.2/36 LAYOUT PLAN
 SEE SHT. 20.2/39 MATERIALS PLAN
 SEE SHT. 20.2/42 PAVEMENT JOINTING PLAN
 SEE SHT. 12/2 PLANTING PLAN
 SEE SHT. 12/5 IRRIGATION PLAN

SEE SHT. 20.2/34 GRADING PLAN
 SEE SHT. 20.2/37 LAYOUT PLAN
 SEE SHT. 20.2/40 MATERIALS PLAN
 SEE SHT. 20.2/43 PAVEMENT JOINTING PLAN
 SEE SHT. 12/3 PLANTING PLAN
 SEE SHT. 12/6 IRRIGATION PLAN




SASAKI ASSOCIATES, INC. WATERTOWN, MASSACHUSETTS
 MYERS SCHMALENBERGER, INC. COLUMBUS, OHIO


Symbol	Revisions		
	Descriptions	Date	Approved

BURGESS & NIPLÉ, LIMITED
 COLUMBUS, OHIO

U.S. ARMY ENGINEER DISTRICT
 CORPS OF ENGINEERS
 HUNTINGTON, WEST VIRGINIA

Designed by:	SOD	 SCIOTO RIVER COLUMBUS, OHIO WEST COLUMBUS, L.P.P. PHASE IID SITE PLAN	
Drawn by:	DRB		
Checked by:	CLO		
Reviewed by:	NJD		
Approved by:	NJD		
Scale:	1" = 50'-0"	Sheet reference number:	20.2/32
Date:	MARCH 1998	FILENAME:	PIN TABLE:
Drawing Code:	16-PWC-10-	Sheet	1 of 1

PLAN
 SCALE: 1"=50'
 50' 0 50'

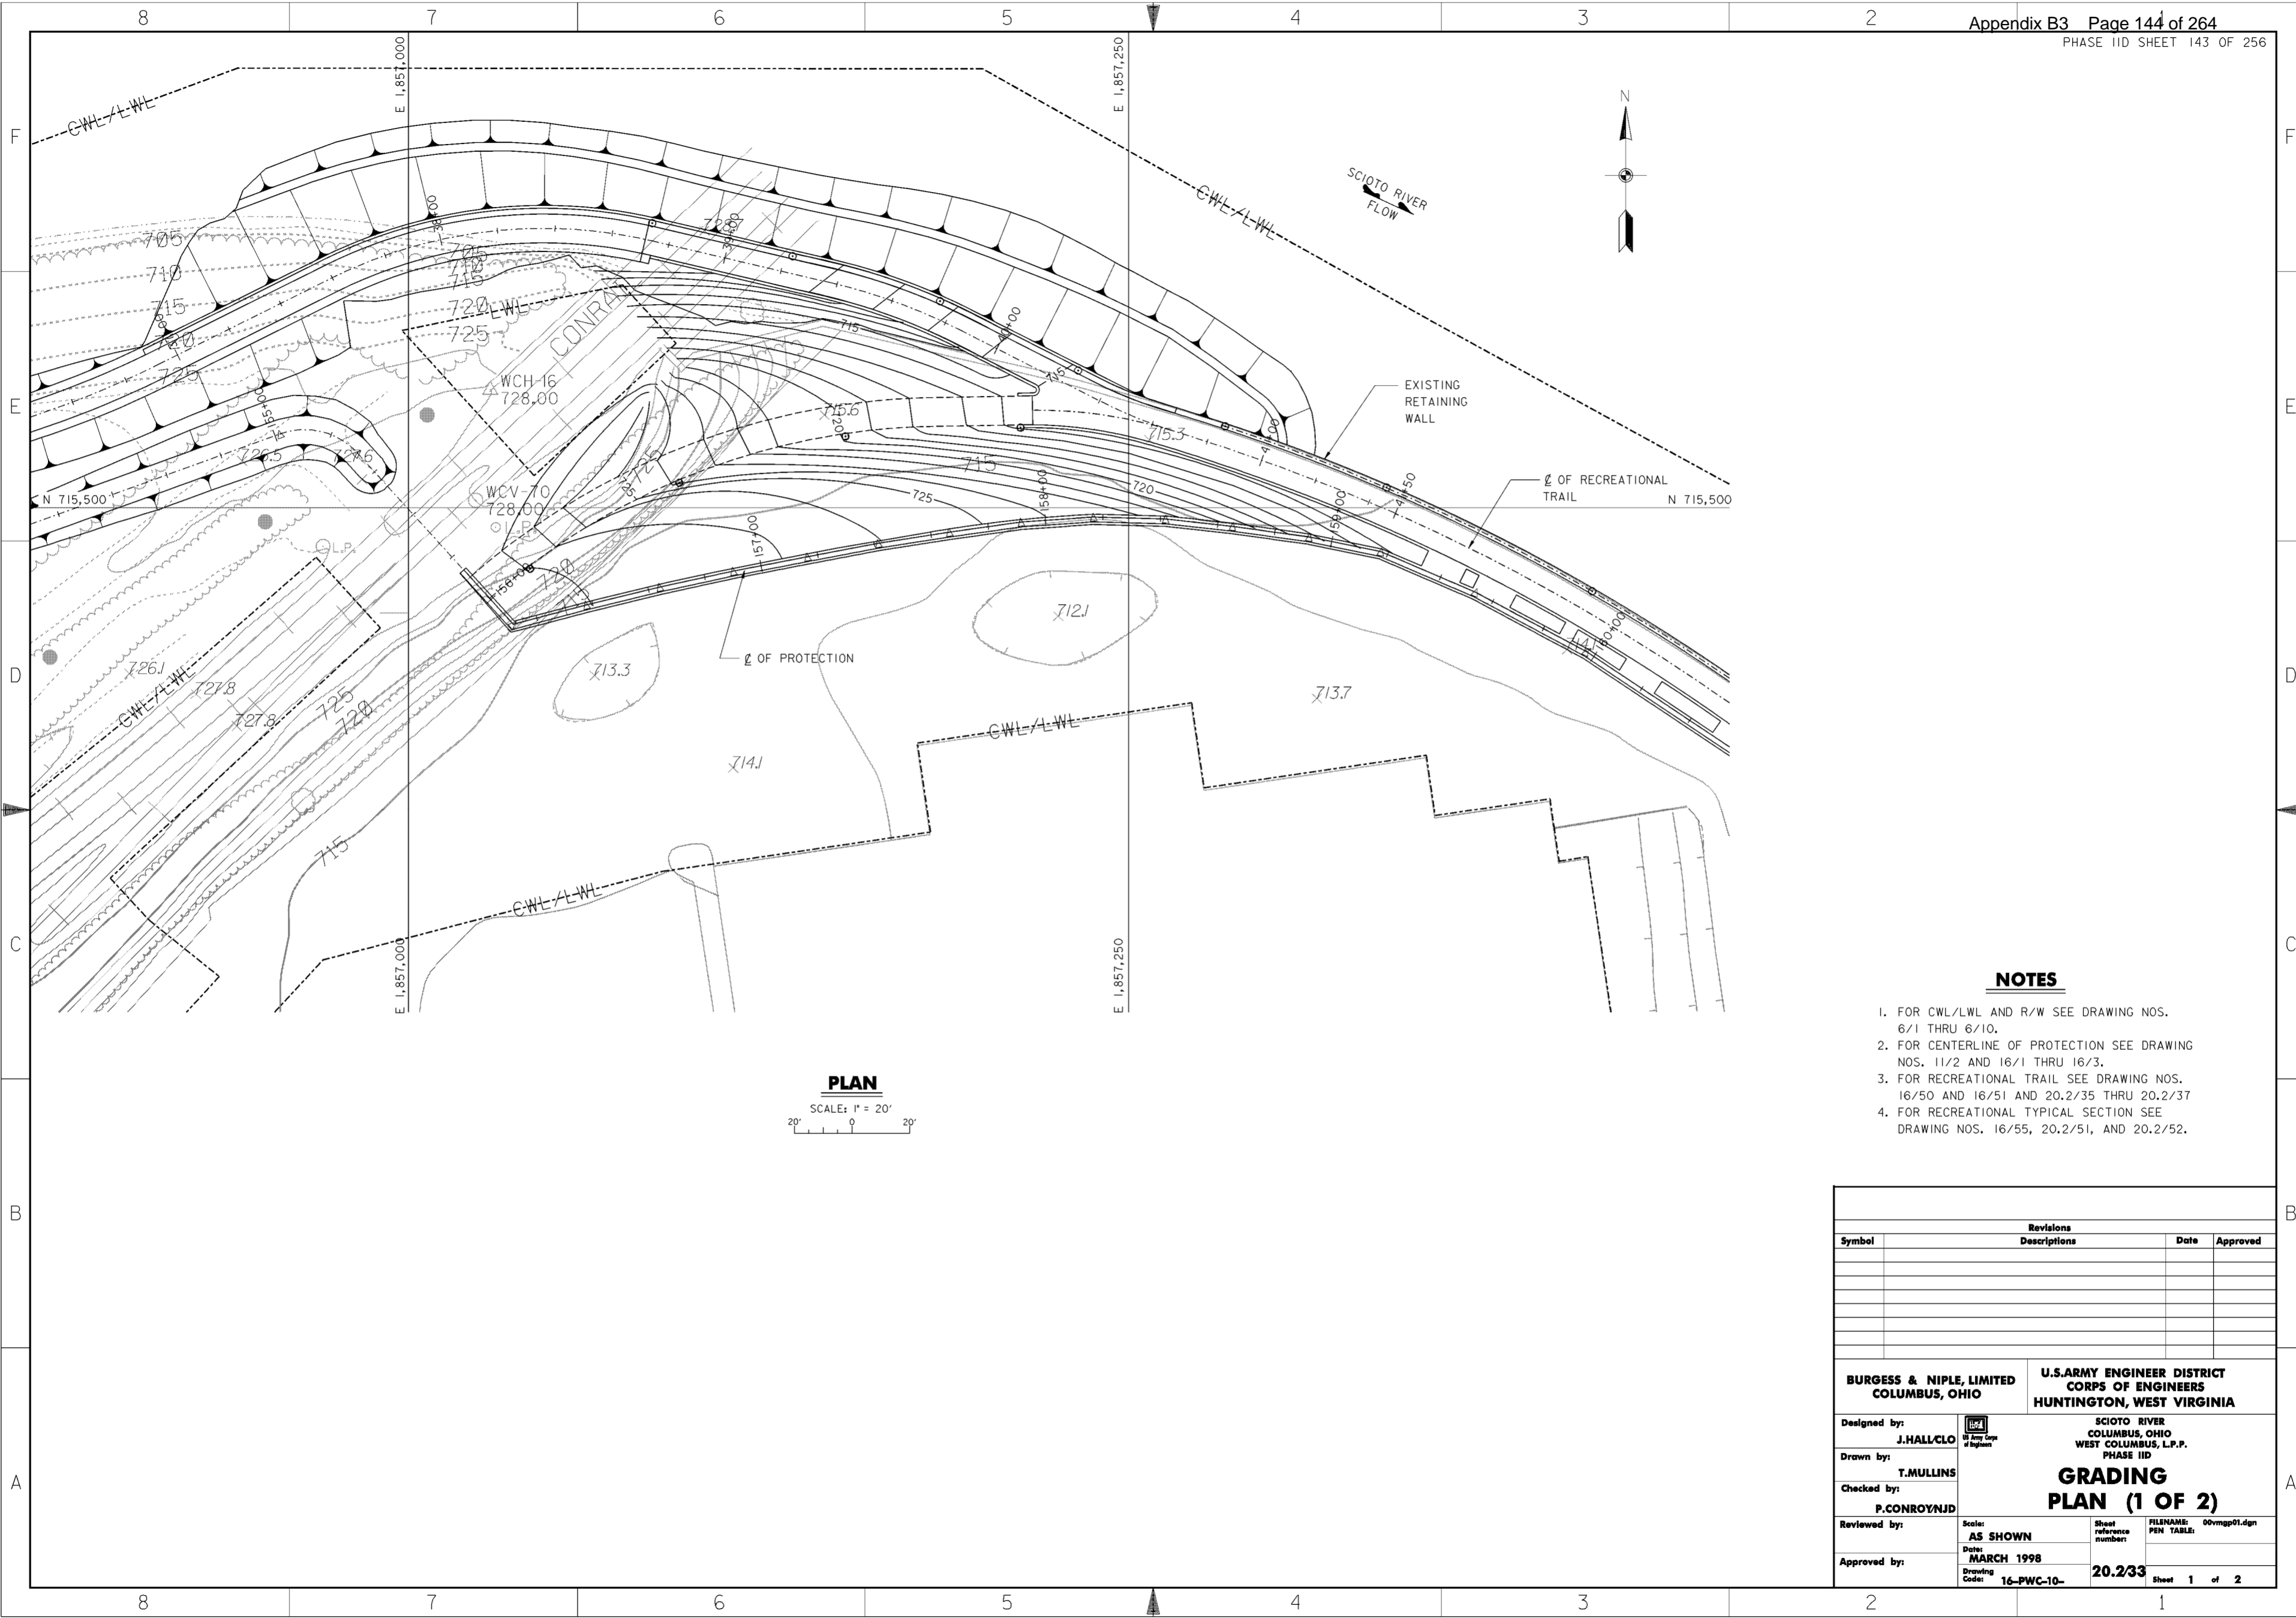

PLAN
 SCALE: 1" = 20'


NOTES

1. FOR CWL/LWL AND R/W SEE DRAWING NOS. 6/1 THRU 6/10.
2. FOR CENTERLINE OF PROTECTION SEE DRAWING NOS. 11/2 AND 16/1 THRU 16/3.
3. FOR RECREATIONAL TRAIL SEE DRAWING NOS. 16/50 AND 16/51 AND 20.2/35 THRU 20.2/37
4. FOR RECREATIONAL TYPICAL SECTION SEE DRAWING NOS. 16/55, 20.2/51, AND 20.2/52.

Revisions			
Symbol	Descriptions	Date	Approved

BURGESS & NIPLE, LIMITED COLUMBUS, OHIO	U.S. ARMY ENGINEER DISTRICT CORPS OF ENGINEERS HUNTINGTON, WEST VIRGINIA	
Designed by: J.HALL/CLO	SCIOTO RIVER COLUMBUS, OHIO WEST COLUMBUS, L.P.P. PHASE IID GRADING PLAN (1 OF 2)	
Drawn by: T.MULLINS		
Checked by: P.CONROY/NJD		
Reviewed by:		
Approved by:	Scale: AS SHOWN Date: MARCH 1998 Drawing Code: 16-PWC-10-	Sheet reference number: 20.2/33 FILENAME: PEN TABLE: 00vmgp01.dgn Sheet 1 of 2


WORK AS CONSTRUCTED

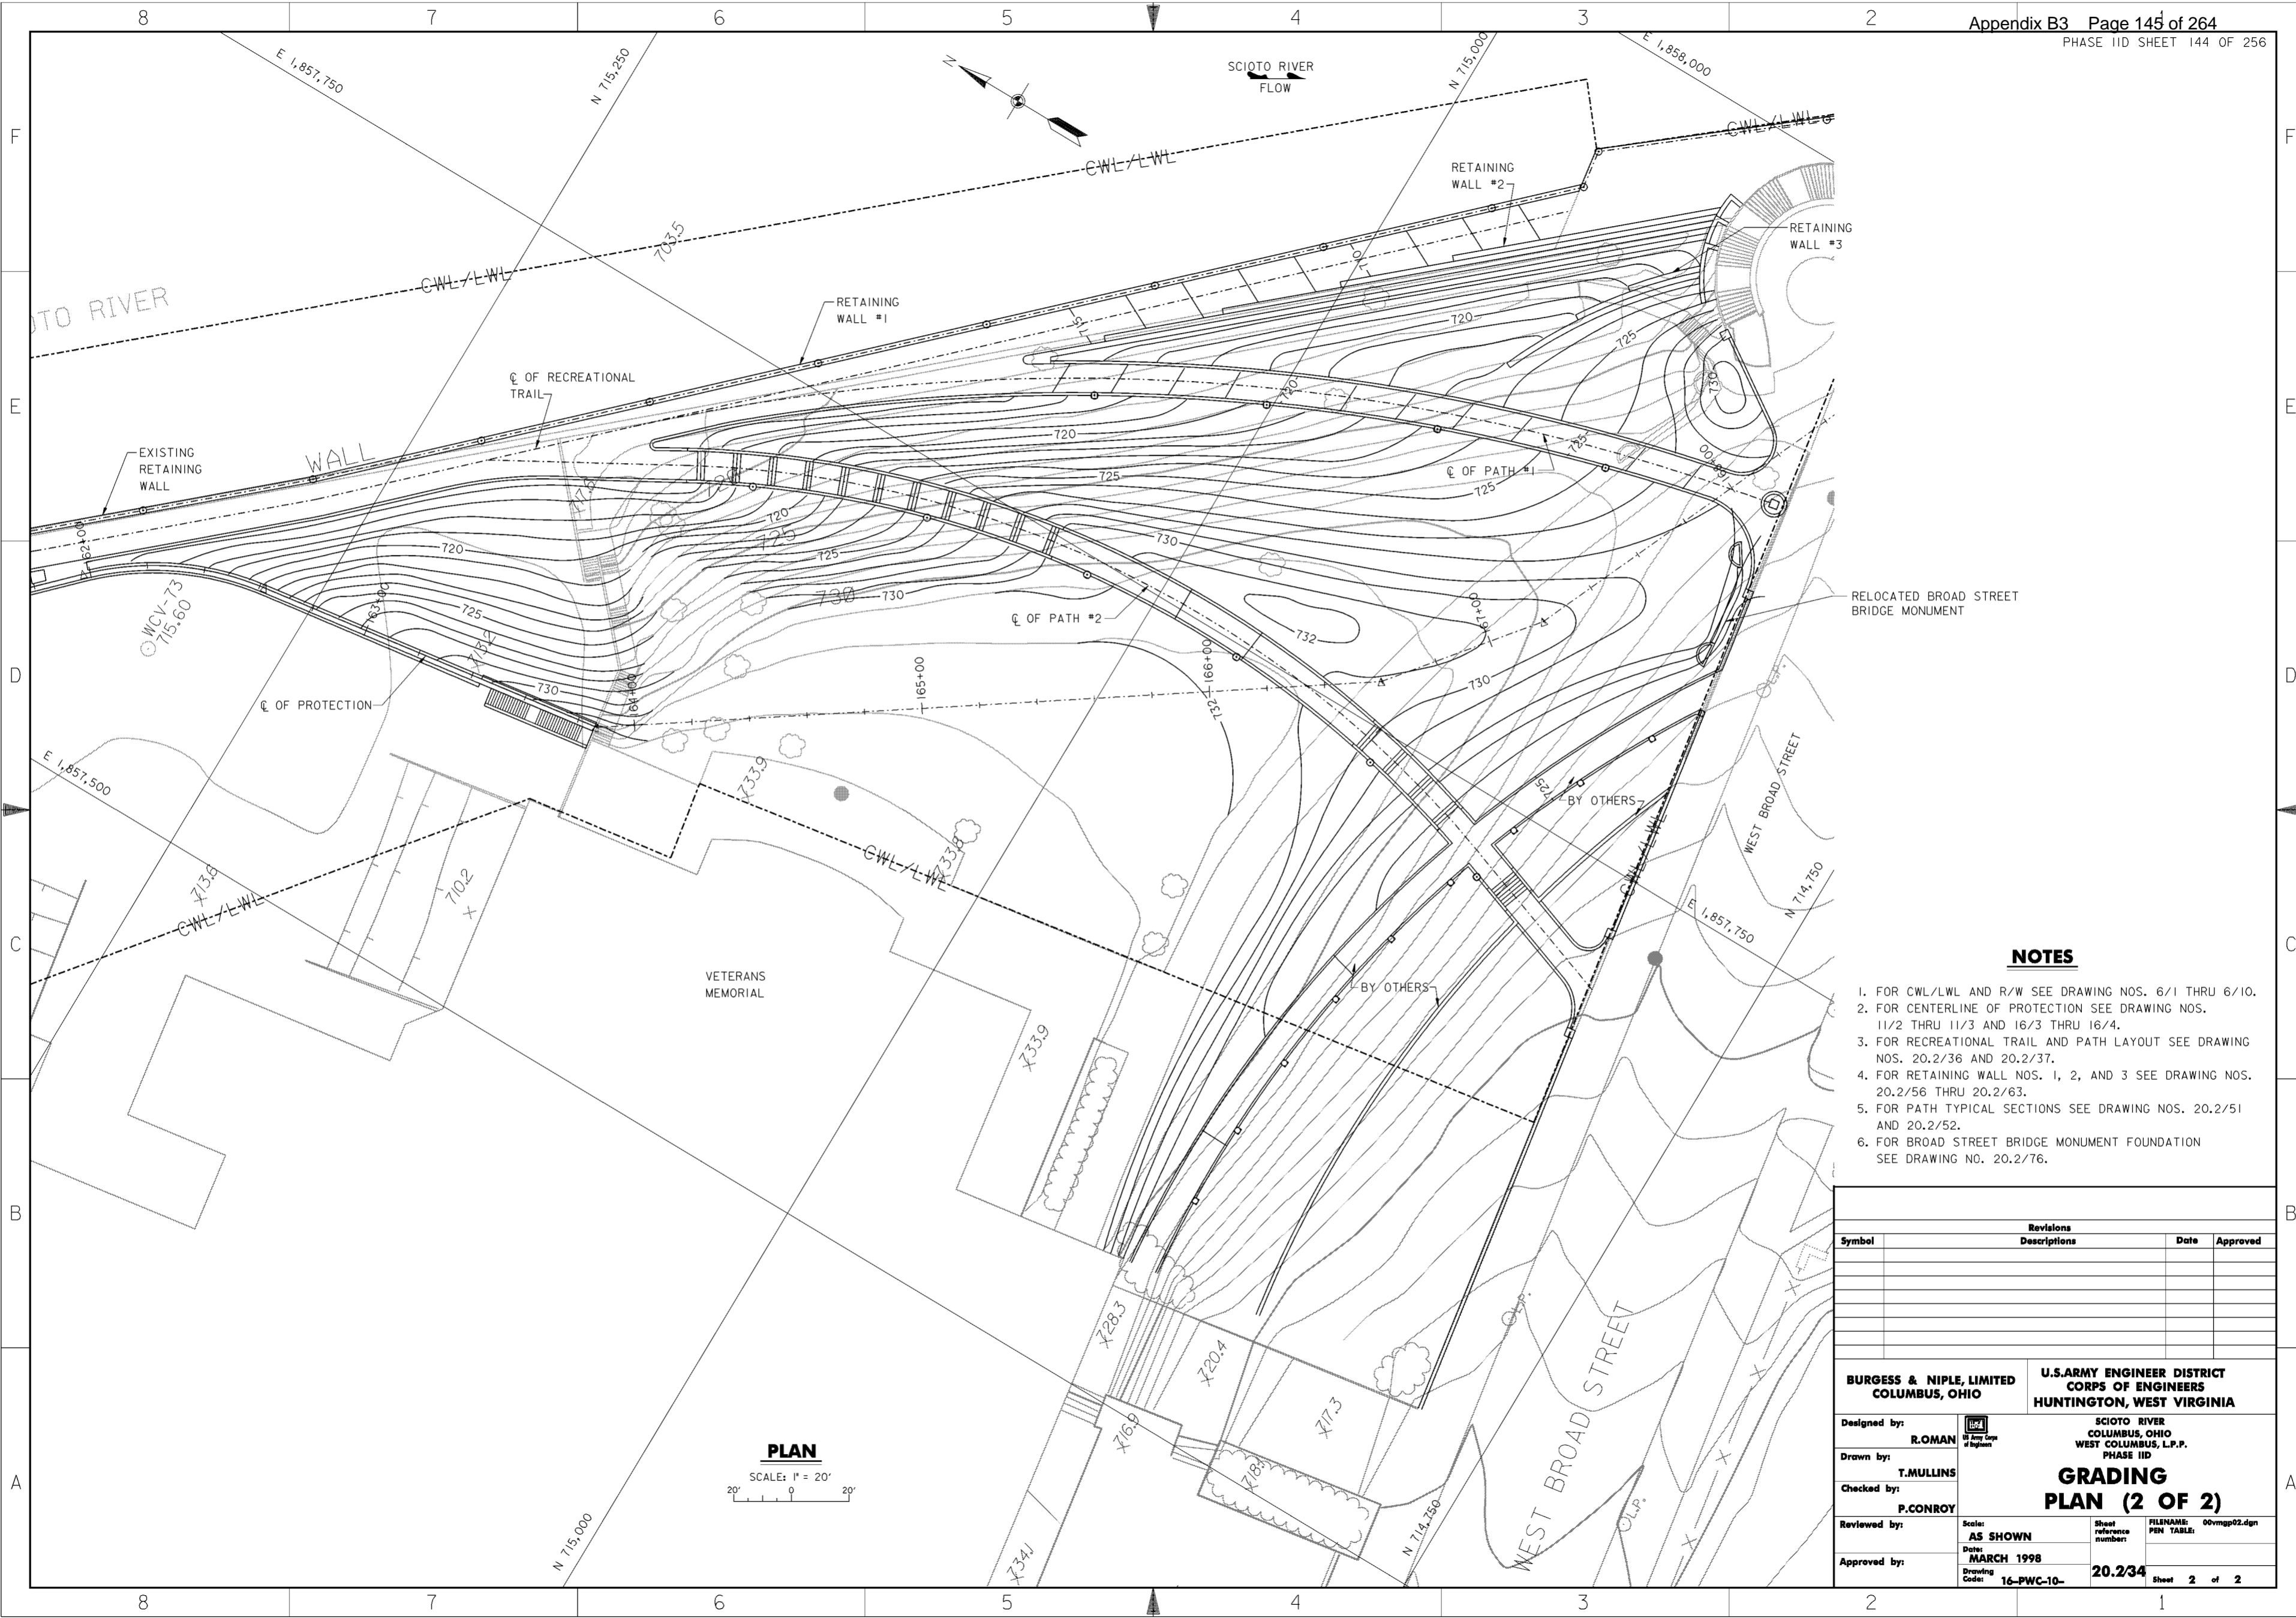


NOTES


1. FOR CWL/LWL AND R/W SEE DRAWING NOS. 6/1 THRU 6/10.
2. FOR CENTERLINE OF PROTECTION SEE DRAWING NOS. 11/2 THRU 11/3 AND 16/3 THRU 16/4.
3. FOR RECREATIONAL TRAIL AND PATH LAYOUT SEE DRAWING NOS. 20.2/36 AND 20.2/37.
4. FOR RETAINING WALL NOS. 1, 2, AND 3 SEE DRAWING NOS. 20.2/56 THRU 20.2/63.
5. FOR PATH TYPICAL SECTIONS SEE DRAWING NOS. 20.2/51 AND 20.2/52.
6. FOR BROAD STREET BRIDGE MONUMENT FOUNDATION SEE DRAWING NO. 20.2/76.

Revisions			
Symbol	Descriptions	Date	Approved

BURGESS & NIPLE, LIMITED COLUMBUS, OHIO		U.S. ARMY ENGINEER DISTRICT CORPS OF ENGINEERS HUNTINGTON, WEST VIRGINIA	
Designed by: R.ROMAN		SCIOTO RIVER COLUMBUS, OHIO WEST COLUMBUS, L.P.P. PHASE IID GRADING PLAN (2 OF 2)	
Drawn by: T.MULLINS			
Checked by: P.CONROY			
Reviewed by:			
Approved by:			
Scale: AS SHOWN	Sheet reference number: 20.2/34	FILENAME: 00vmgp02.dgn	PEN TABLE:
Date: MARCH 1998	Drawing Code: 16-PWC-10-	Sheet 2 of 2	

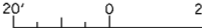PLAN
 SCALE: 1" = 20'


WORK AS CONSTRUCTED

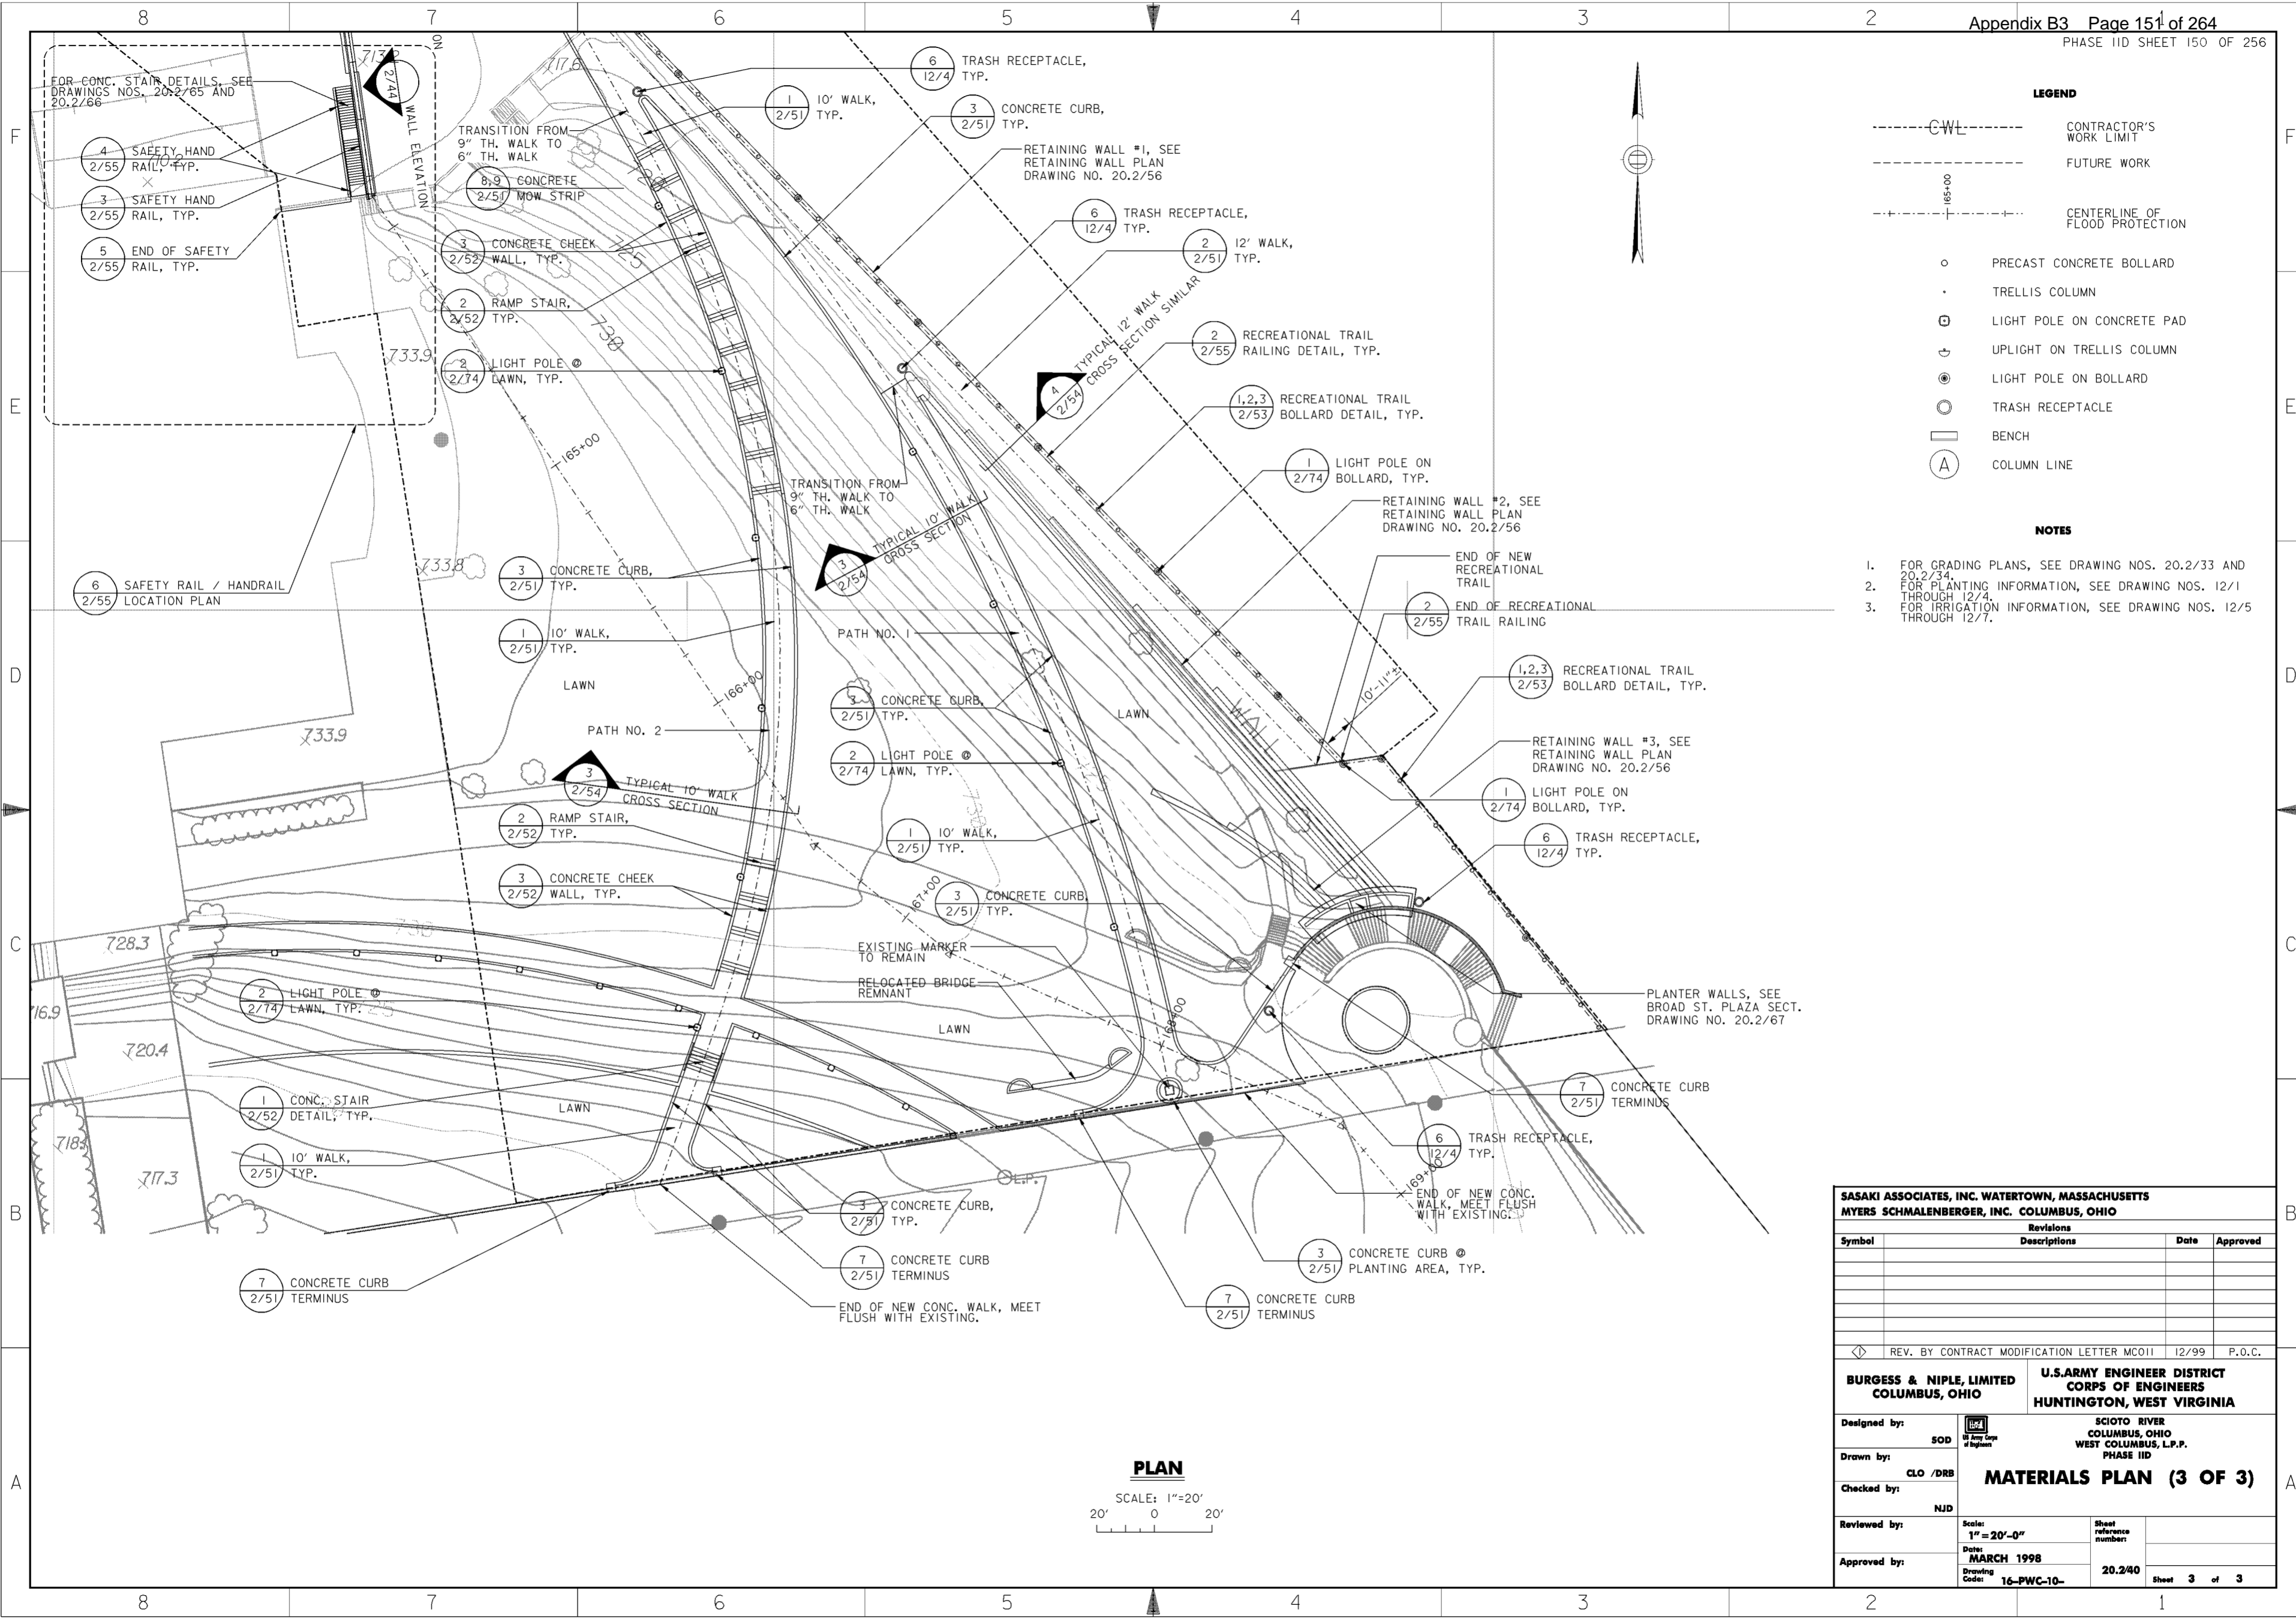


LEGEND

- CWL--- CONTRACTOR'S WORK LIMIT
- FUTURE WORK
- +---+--- CENTERLINE OF FLOOD PROTECTION
- PRECAST CONCRETE BOLLARD
- TRELLIS COLUMN
- ⊙ LIGHT POLE ON CONCRETE PAD
- ⊕ UPLIGHT ON TRELLIS COLUMN
- ⊙ LIGHT POLE ON BOLLARD
- TRASH RECEPTACLE
- ▭ BENCH
- ⊙ COLUMN LINE

- NOTES**
1. FOR GRADING PLANS, SEE DRAWING NOS. 20.2/33 AND 20.2/34.
 2. FOR PLANTING INFORMATION, SEE DRAWING NOS. 12/1 THROUGH 12/4.
 3. FOR IRRIGATION INFORMATION, SEE DRAWING NOS. 12/5 THROUGH 12/7.

PLAN
 SCALE: 1"=20'
 20' 0 20'

SASAKI ASSOCIATES, INC. WATERTOWN, MASSACHUSETTS			
MYERS SCHMALENBERGER, INC. COLUMBUS, OHIO			
Revisions		Date	Approved
Symbol	Descriptions		
◁ REV. BY CONTRACT MODIFICATION LETTER MCO11 12/99 P.O.C.			
BURGESS & NIPLE, LIMITED COLUMBUS, OHIO		U.S. ARMY ENGINEER DISTRICT CORPS OF ENGINEERS HUNTINGTON, WEST VIRGINIA	
Designed by:	SOD	SCIOTO RIVER COLUMBUS, OHIO WEST COLUMBUS, L.P.P. PHASE IID	
Drawn by:	CLO /DRB	MATERIALS PLAN (3 OF 3)	
Checked by:	NJD	Scale: 1" = 20'-0"	Sheet reference number: 20.2/40
Reviewed by:		Date: MARCH 1998	Sheet 3 of 3
Approved by:		Drawing Code: 16-PWC-10-	

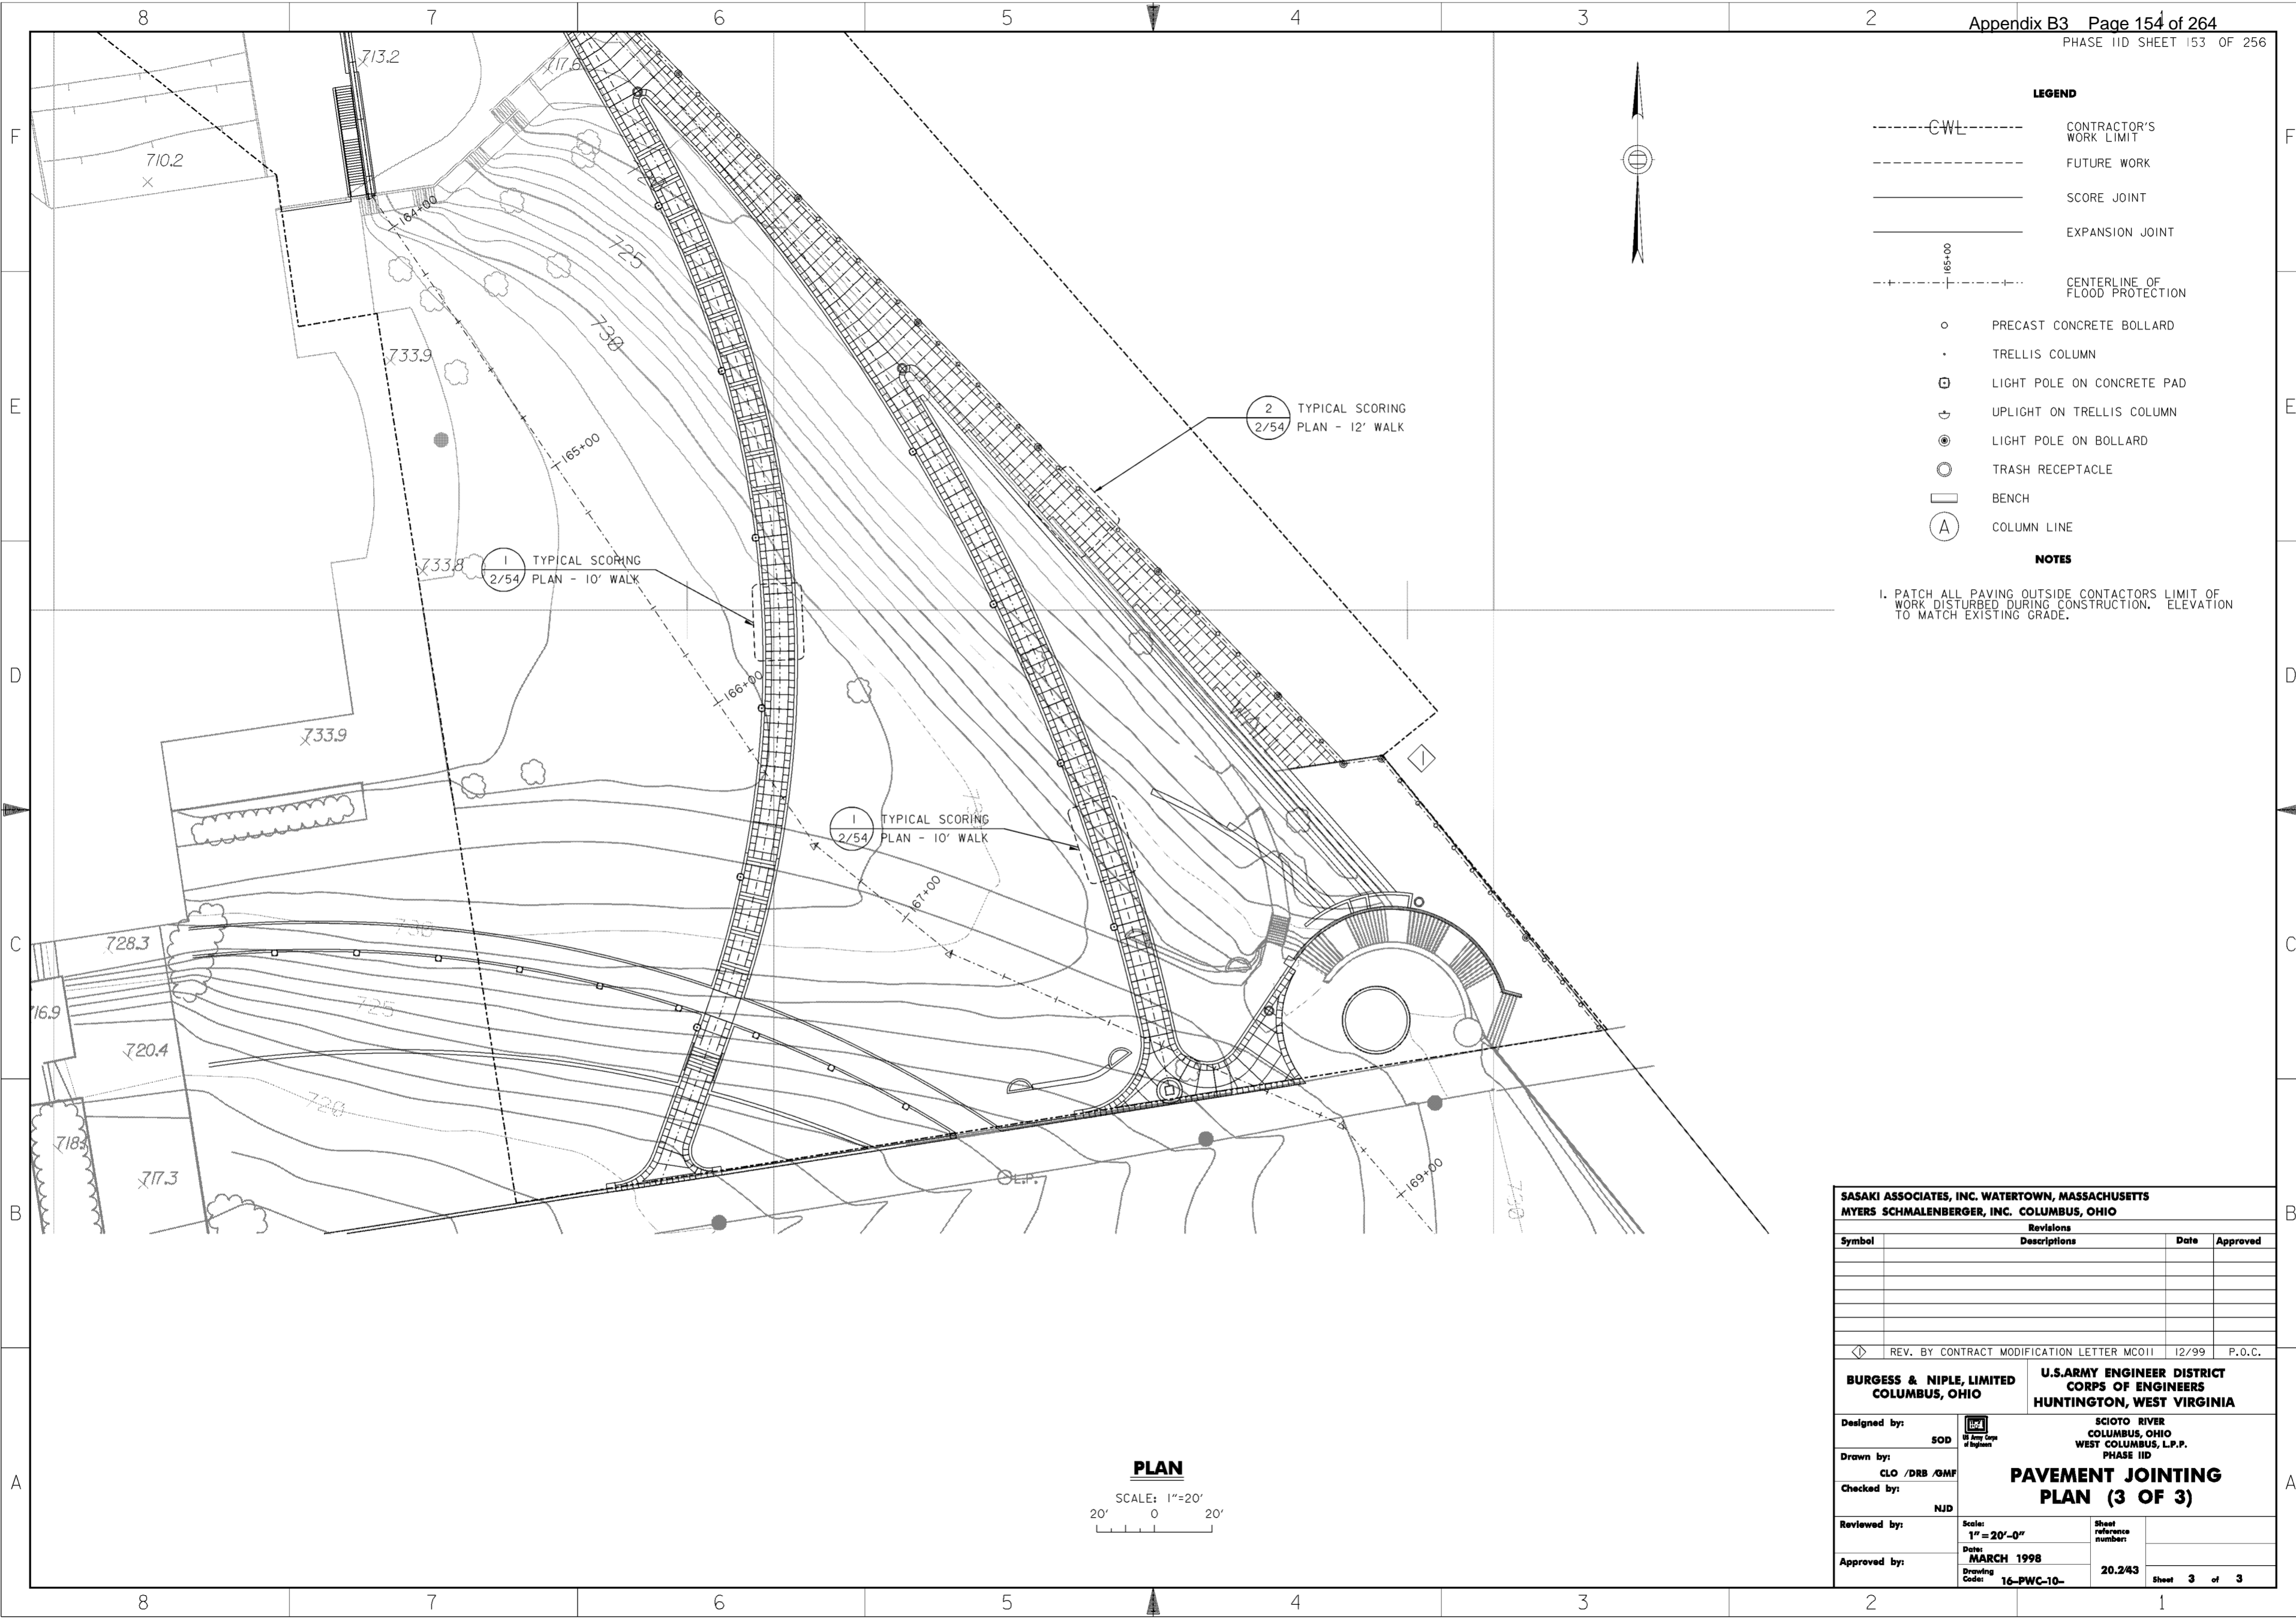


- LEGEND**
- CWL--- CONTRACTOR'S WORK LIMIT
 - FUTURE WORK
 - SCORE JOINT
 - EXPANSION JOINT
 - 165+00 CENTERLINE OF FLOOD PROTECTION
 - PRECAST CONCRETE BOLLARD
 - TRELLIS COLUMN
 - ⊕ LIGHT POLE ON CONCRETE PAD
 - ⊕ UPLIGHT ON TRELLIS COLUMN
 - ⊙ LIGHT POLE ON BOLLARD
 - TRASH RECEPTACLE
 - ▭ BENCH
 - ⊙ COLUMN LINE

NOTES

1. PATCH ALL PAVING OUTSIDE CONTRACTORS LIMIT OF WORK DISTURBED DURING CONSTRUCTION. ELEVATION TO MATCH EXISTING GRADE.

PLAN
SCALE: 1"=20'
0 20'

SASAKI ASSOCIATES, INC. WATERTOWN, MASSACHUSETTS			
MYERS SCHMALENBERGER, INC. COLUMBUS, OHIO			
Revisions		Date	Approved
Symbol	Descriptions		
◁ REV. BY CONTRACT MODIFICATION LETTER MCO11 12/99 P.O.C.			
BURGESS & NIPLÉ, LIMITED COLUMBUS, OHIO		U.S. ARMY ENGINEER DISTRICT CORPS OF ENGINEERS HUNTINGTON, WEST VIRGINIA	
Designed by:	SOD	SCIOTO RIVER COLUMBUS, OHIO WEST COLUMBUS, L.P.P. PHASE IID	
Drawn by:	CLO / DRB / GMF	PAVEMENT JOINTING PLAN (3 OF 3)	
Checked by:	NJD	Scale: 1" = 20'-0"	Sheet reference number: 20.243
Reviewed by:		Date: MARCH 1998	Sheet 3 of 3
Approved by:		Drawing Code: 16-PWC-10-	

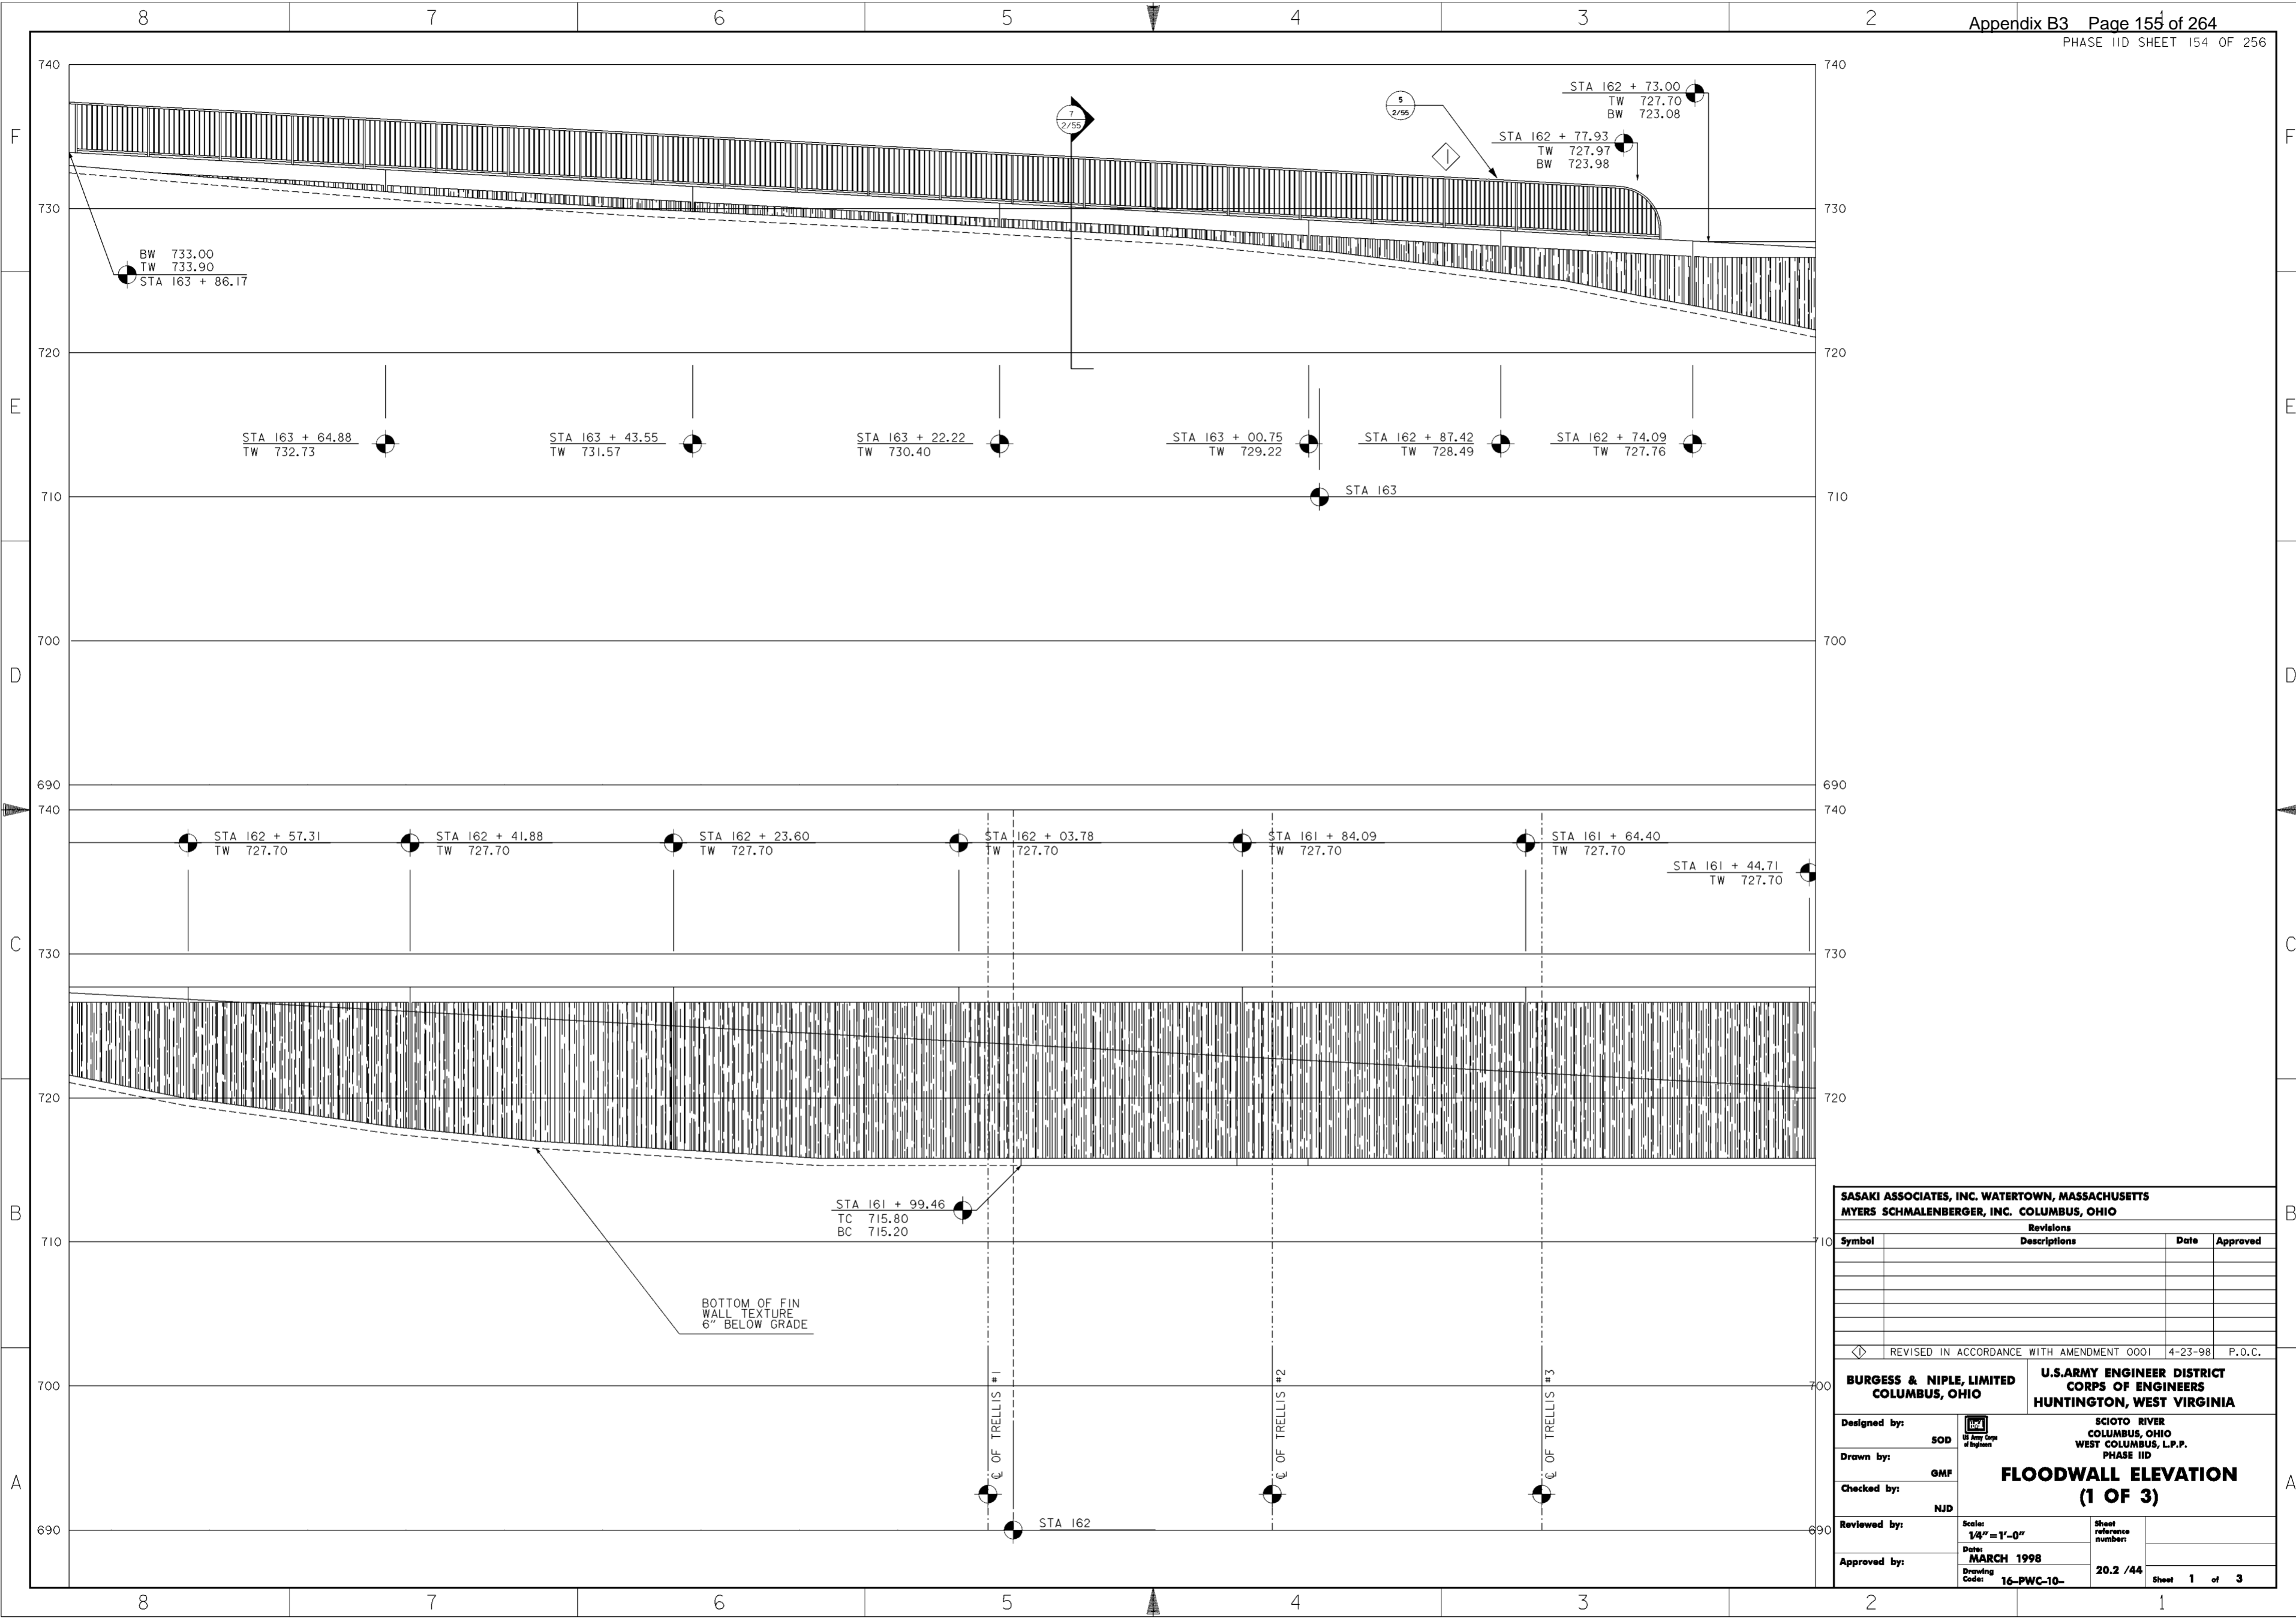

SASAKI ASSOCIATES, INC. WATERTOWN, MASSACHUSETTS
MYERS SCHMALENBERGER, INC. COLUMBUS, OHIO

Symbol	Revisions Descriptions	Date	Approved

REVISOR: REVISED IN ACCORDANCE WITH AMENDMENT 0001 4-23-98 P.O.C.

BURGESS & NIPLÉ, LIMITED
 COLUMBUS, OHIO


U.S. ARMY ENGINEER DISTRICT
 CORPS OF ENGINEERS
 HUNTINGTON, WEST VIRGINIA

Designed by: SOD
 Drawn by: GMP
 Checked by: NJD
 Reviewed by:

Scale: 1/4" = 1'-0"
 Date: MARCH 1998
 Drawing Code: 16-PWC-10-


Sheet reference number: 20.2 / 44
 Sheet 1 of 3

WORK AS CONSTRUCTED

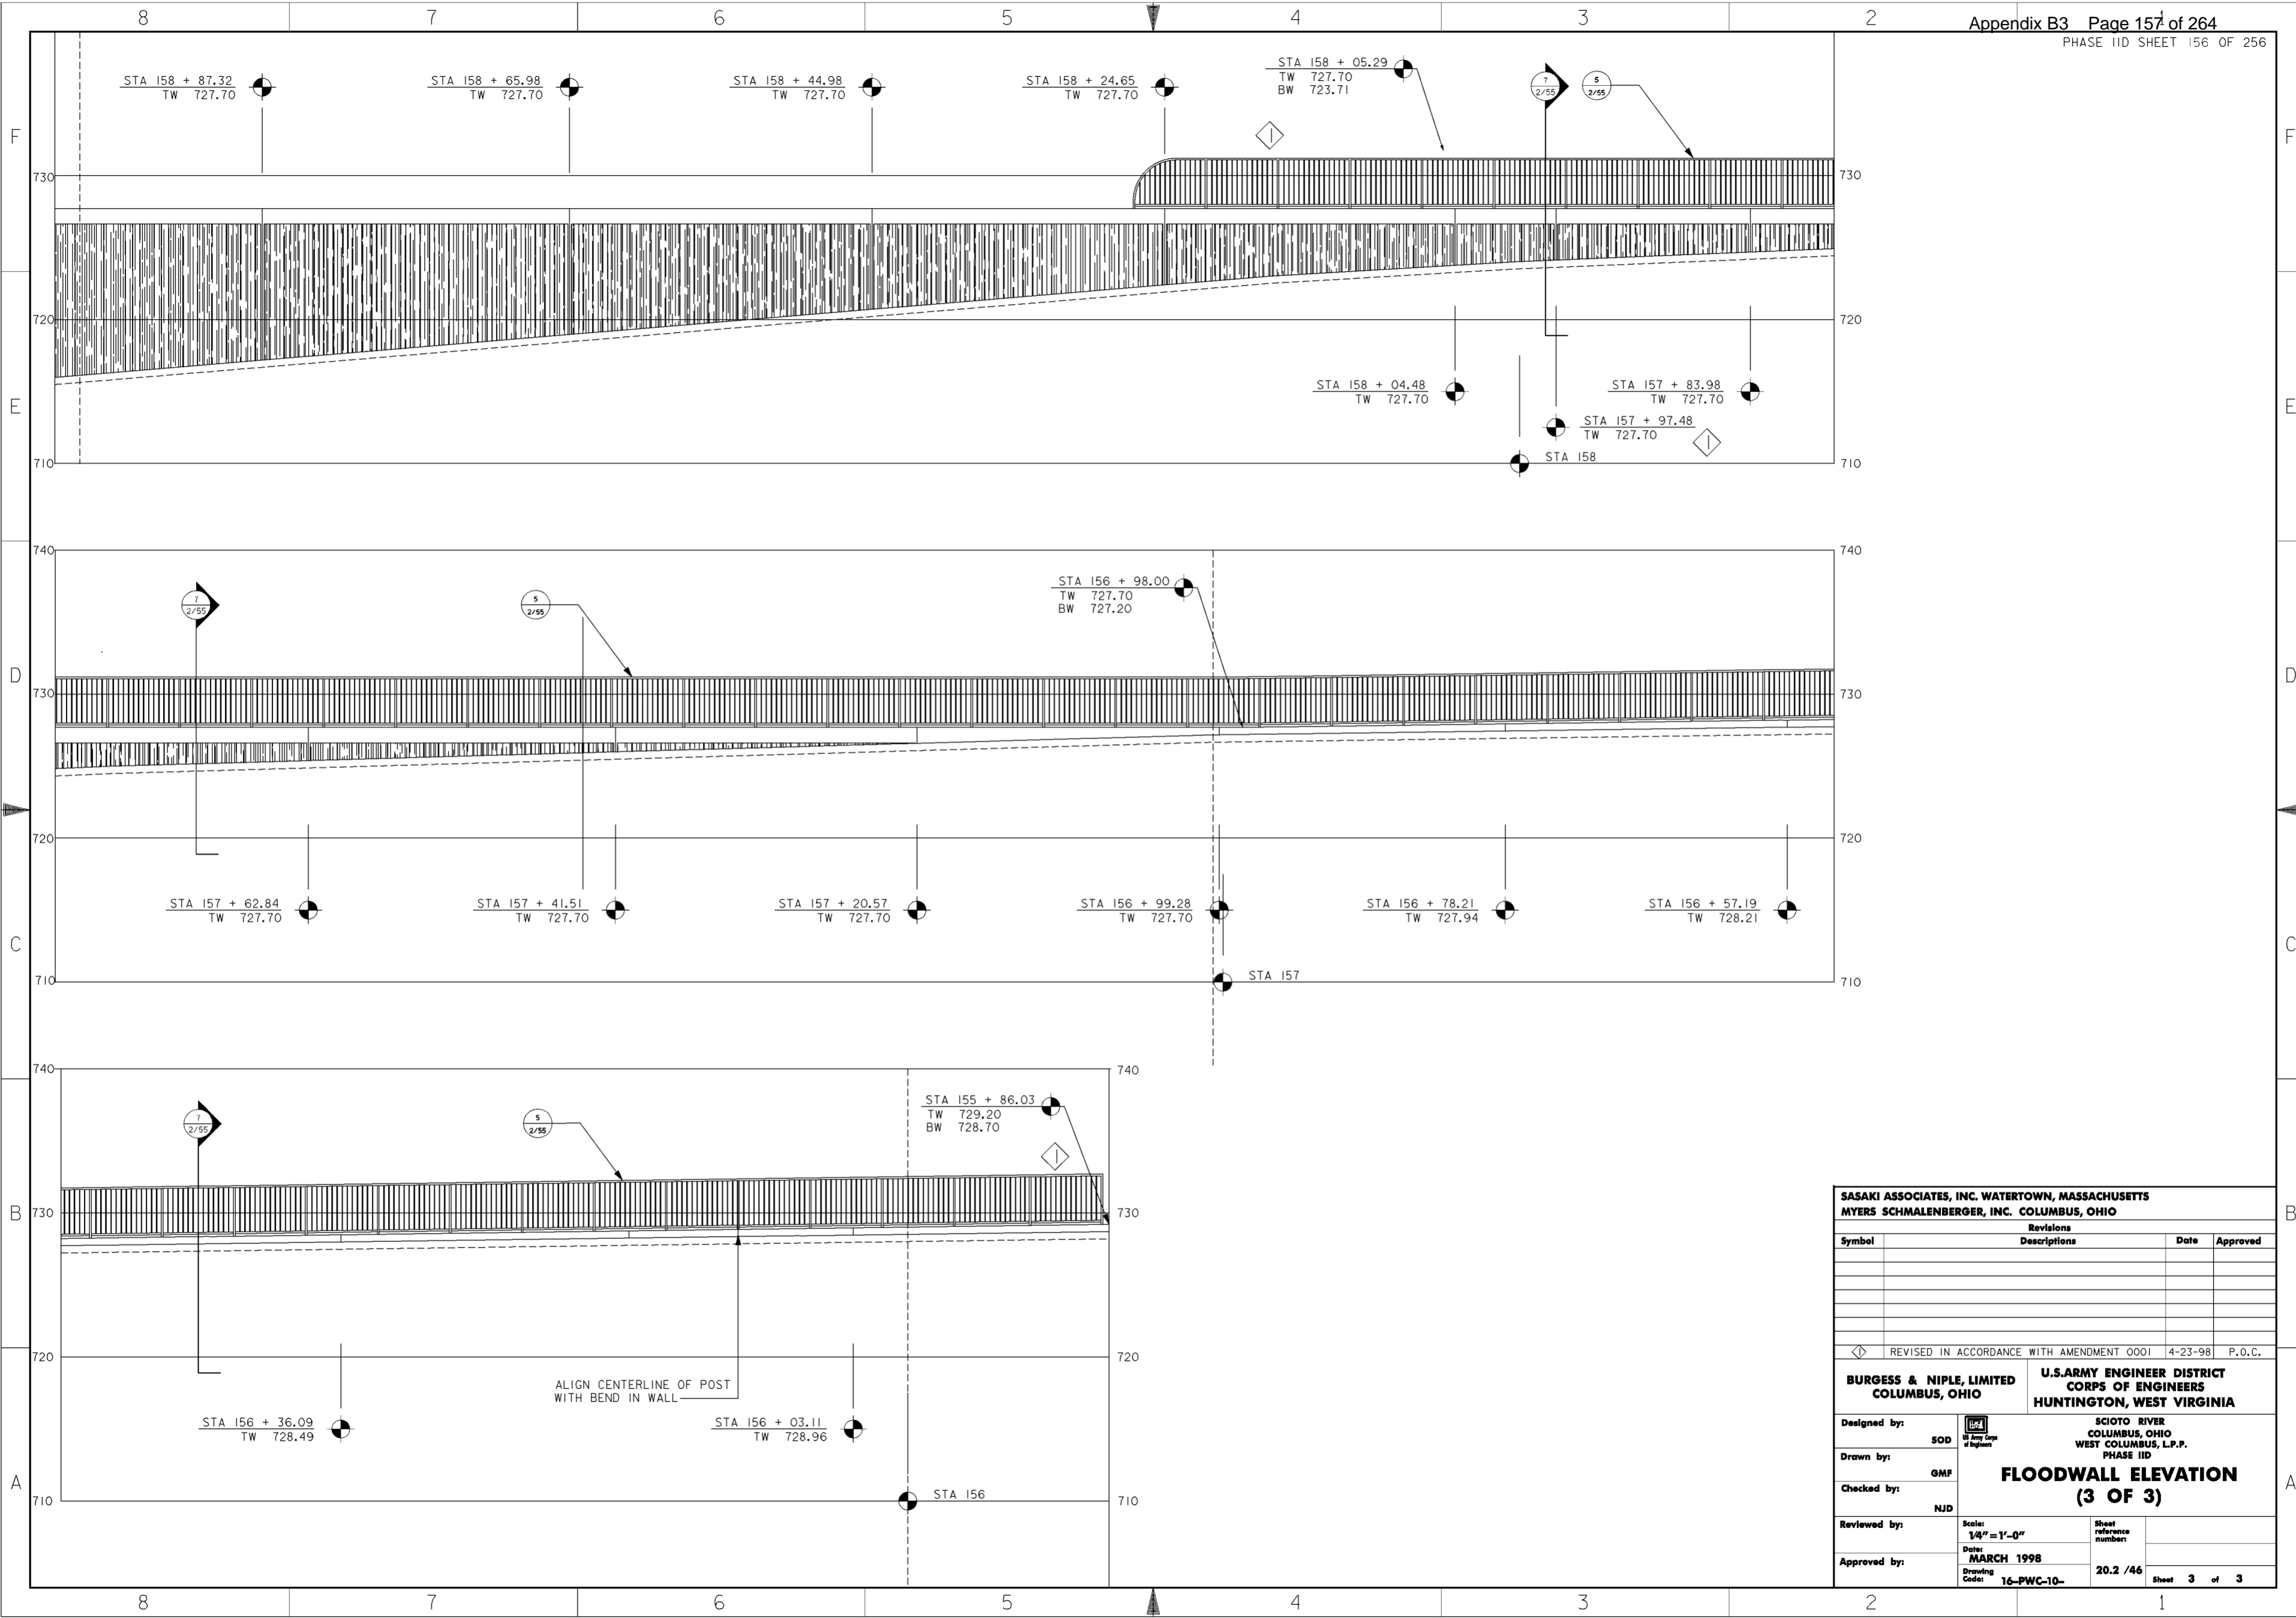


SASAKI ASSOCIATES, INC. WATERTOWN, MASSACHUSETTS			
MYERS SCHMALENBERGER, INC. COLUMBUS, OHIO			
Revisions		Date	Approved
Symbol	Descriptions		
◊ REVISED IN ACCORDANCE WITH AMENDMENT 0001 4-23-98 P.O.C.			
BURGESS & NIPLÉ, LIMITED COLUMBUS, OHIO		U.S. ARMY ENGINEER DISTRICT CORPS OF ENGINEERS HUNTINGTON, WEST VIRGINIA	
Designed by:	SOD	SCIOTO RIVER COLUMBUS, OHIO WEST COLUMBUS, L.P.P. PHASE IID	
Drawn by:	GMP	FLOODWALL ELEVATION (3 OF 3)	
Checked by:	NJD	Scale:	Sheet reference number:
Reviewed by:		1/4" = 1'-0"	20.2 / 46
Approved by:		Date:	Sheet 3 of 3
		MARCH 1998	
		Drawing Code:	
		16-PWC-10-	


WORK AS CONSTRUCTED

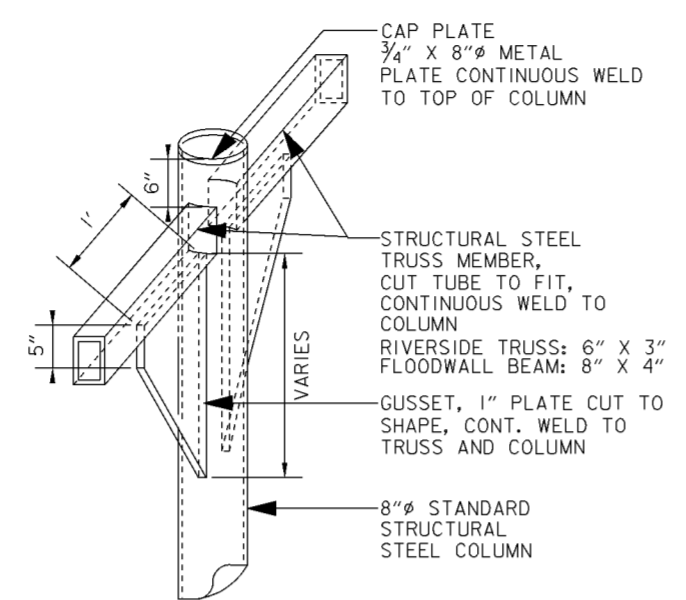


2 COLUMN TERMINUS: AXONOMETRIC
 SCALE: 1"=1'-0"

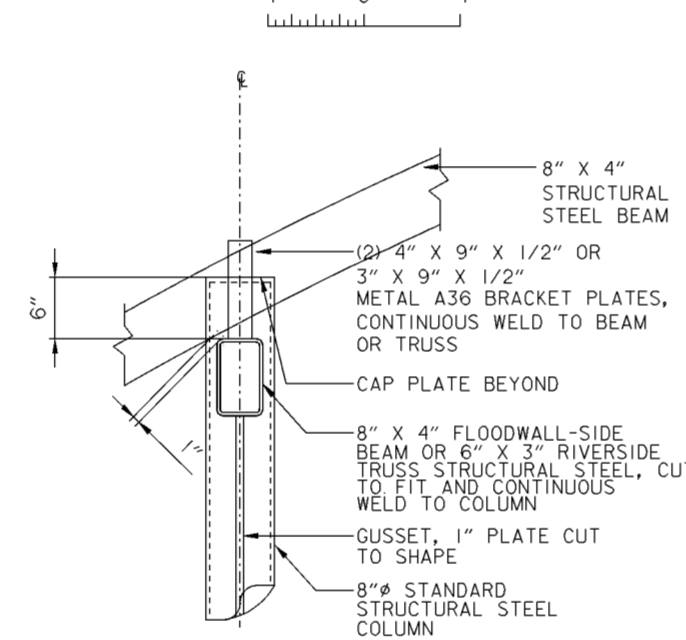

3 COLUMN TERMINUS: SECTION
 SCALE: 1"=1'-0"

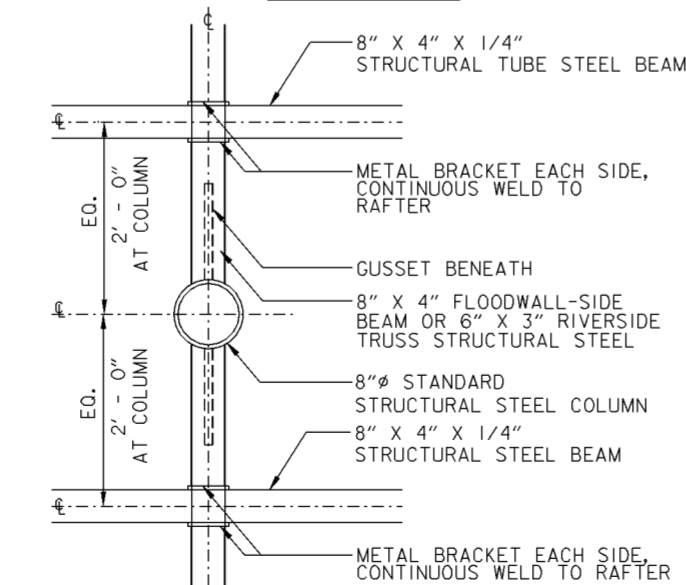

4 COLUMN TERMINUS: PLAN
 SCALE: 1"=1'-0"

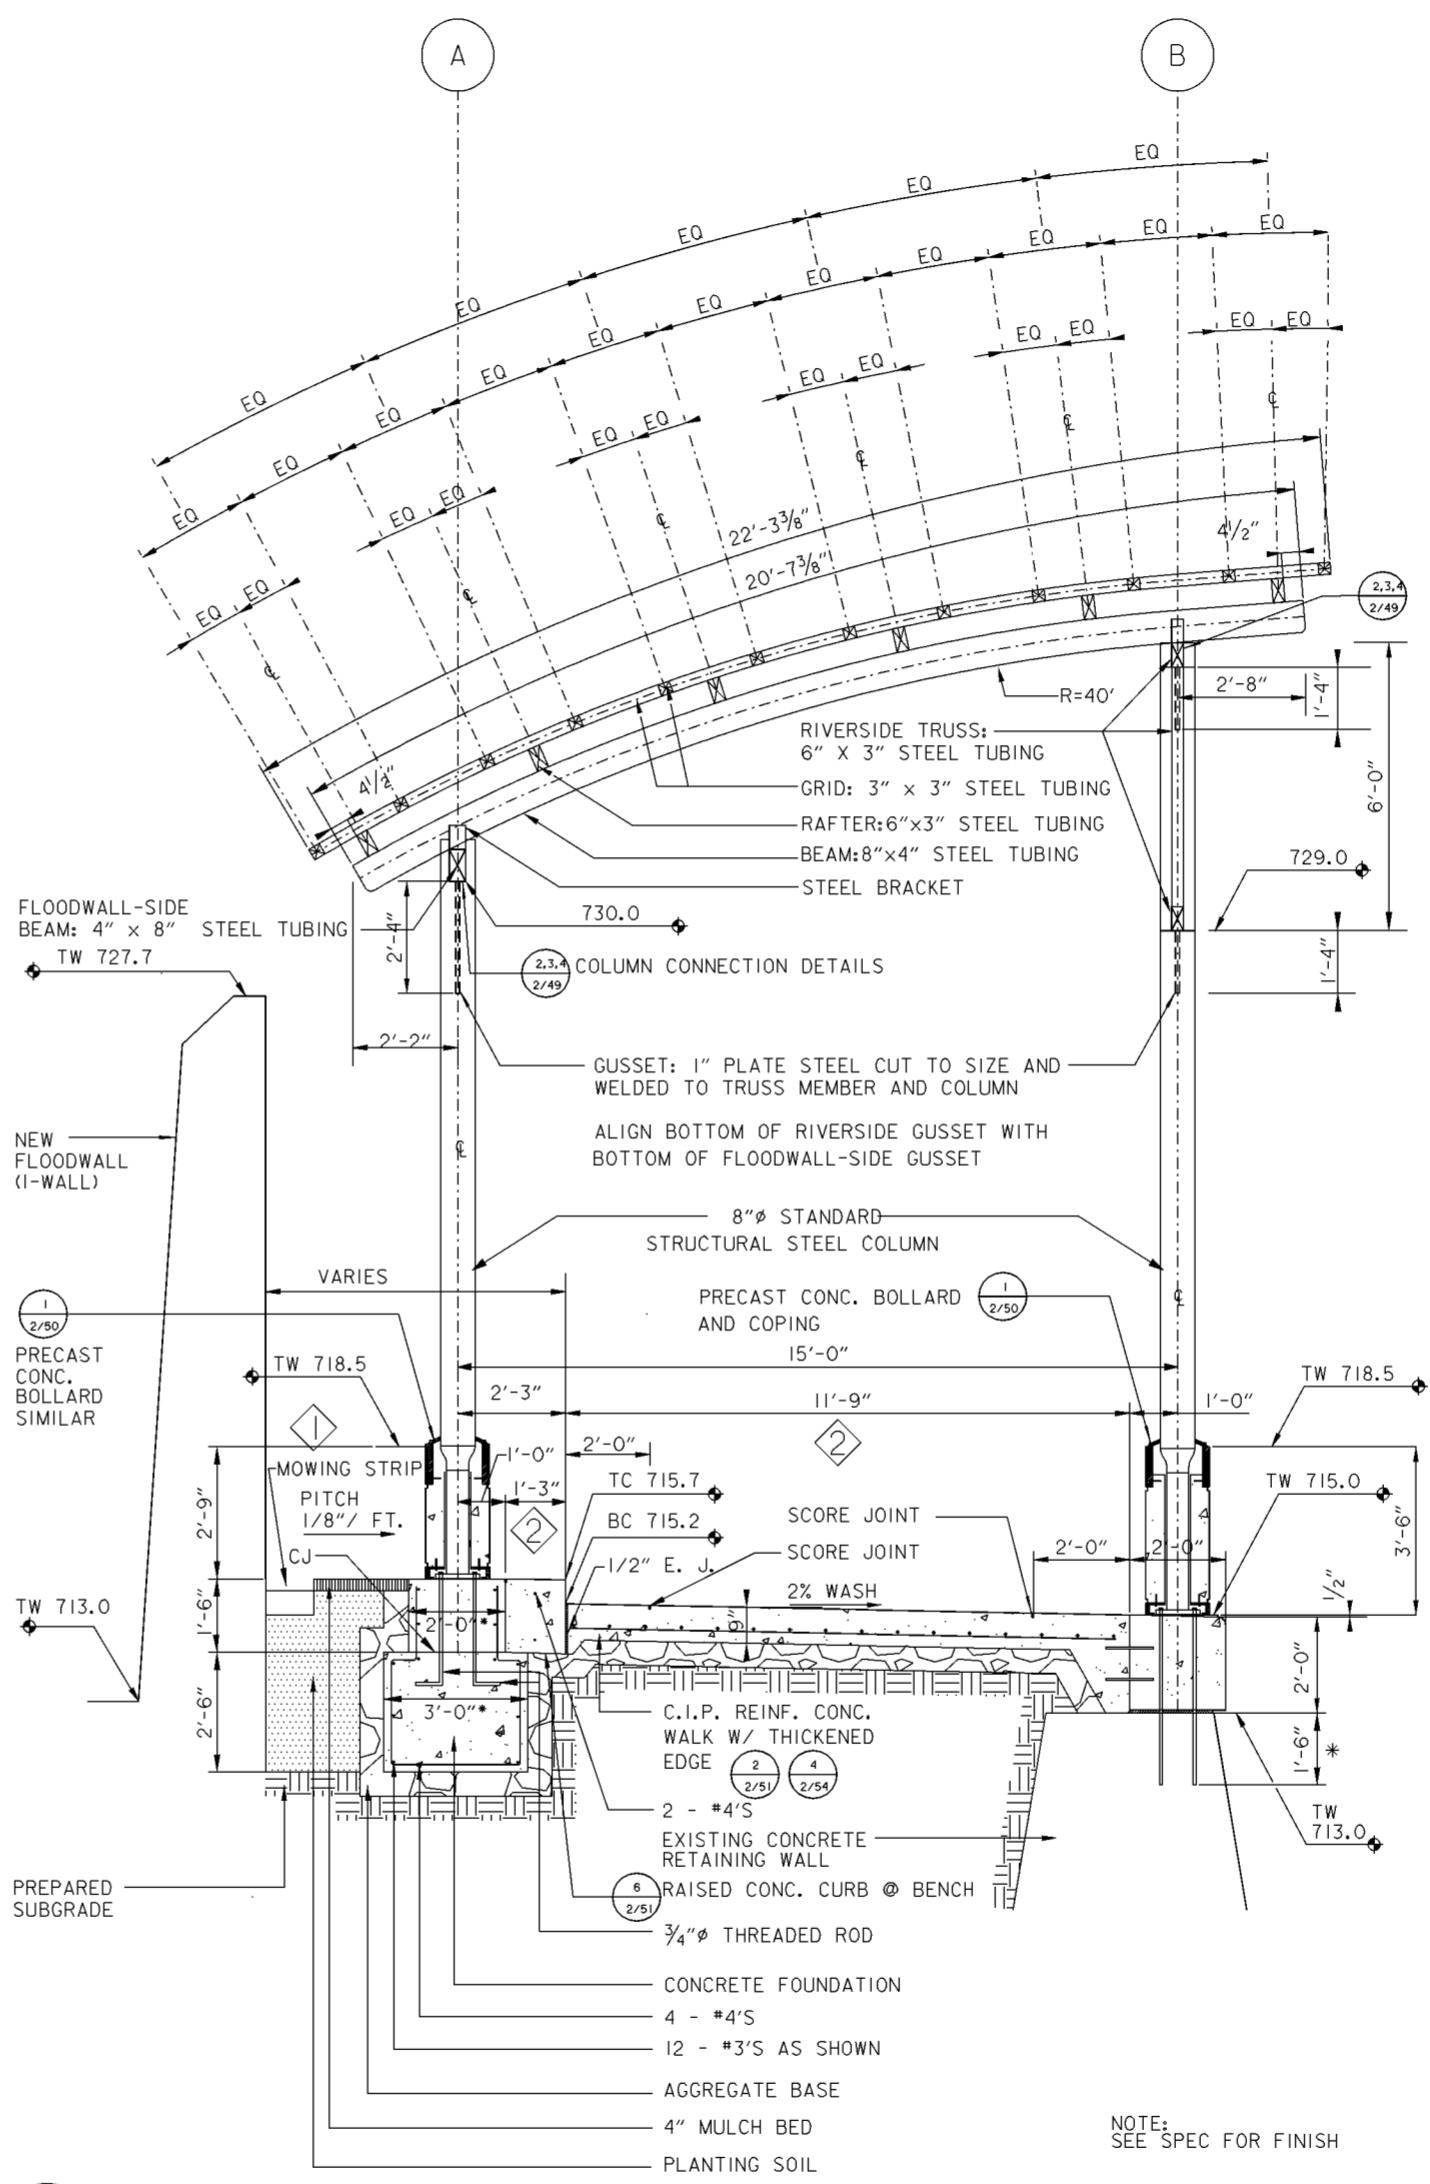


1 CROSS SECTION AT TRELLIS
 SCALE: 1/2"=1'-0"

- NOTES**
- FOR PRECAST CONCRETE COPE DETAILS, SEE DRAWING NO. 20.2/64.
 - STEEL FABRICATION SHOP DRAWINGS, INCLUDING ALL WELD DETAILS, SHALL BE PREPARED AND STAMPED BY A STRUCTURAL ENGINEER.
 - SEE SPECIFICATIONS FOR FINISHES.


* 1'-6" EMBEDMENT AT COPING END (CAP PLUG)
 2'-0" EMBEDMENT AT BOLLARD LOCATIONS

SASAKI ASSOCIATES, INC. WATERTOWN, MASSACHUSETTS MYERS-SCHMALENBURGER, INC. COLUMBUS, OHIO			
Symbol	Revisions Descriptions	Date	Approved
◇	REVISED AS CONSTRUCTED	7/02	P.O.C.
◇	REVISED IN ACCORDANCE WITH AMENDMENT 0001	4-23-98	P.O.C.


Designed by: SOD Drawn by: IS / CLB / GMF Checked by: CLO Reviewed by: NJD Approved by:	SCIO TO RIVER COLUMBUS, OHIO WEST COLUMBUS, L.P.P. PHASE IID TRELLIS DETAILS (2 OF 3) Scale: AS NOTED Date: MARCH 1998 Drawing Code: 16-PWC-10-	U.S. ARMY ENGINEER DISTRICT CORPS OF ENGINEERS HUNTINGTON, WEST VIRGINIA FILENAME: PEN TABLE: 20.2/49 Sheet 2 of 1
---	---	--

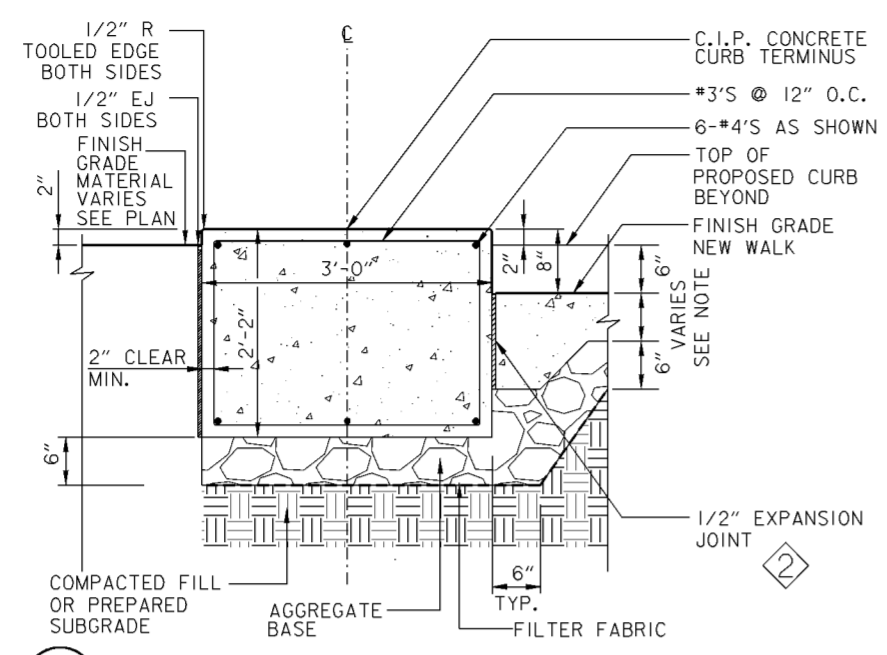

7 SQUARE CONCRETE CURB TERMINUS
 SCALE: 1"=1'-0"
 1' 0 1'

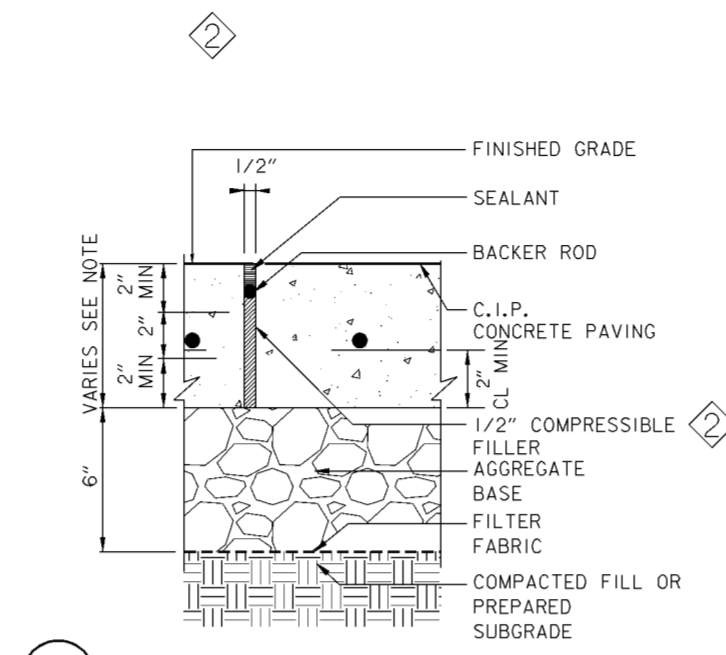


4 EXPANSION JOINT: SECTION
 SCALE: 3/4"=1'-0"
 12" 8" 4" 0 4" 8" 12"

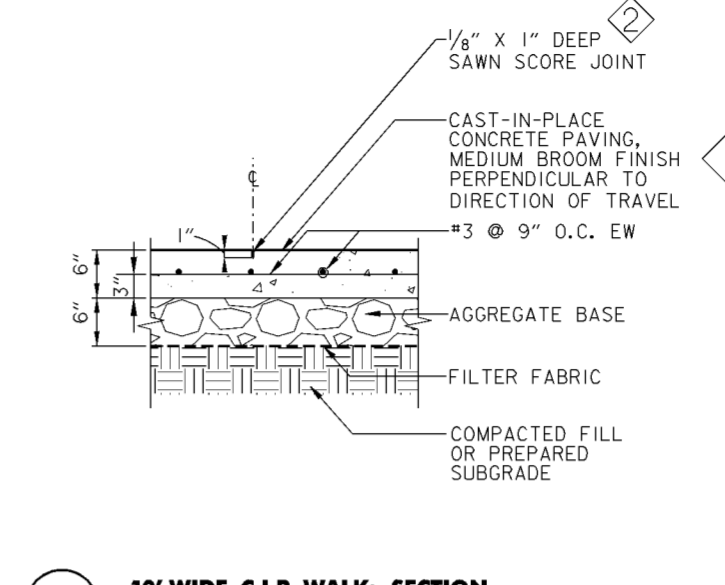


1 10' WIDE C.I.P. WALK: SECTION
 SCALE: 1"=1'-0"
 1' 0 1'


- NOTES**
- 2" MIN. CONC. COVER THROUGHOUT.
 - ALL REBAR SHALL BE EPOXY COATED.
 - ALL 10' WIDE WALKS ARE 6" DEEP.
 - ALL 12' WIDE WALKS ARE 9" DEEP.

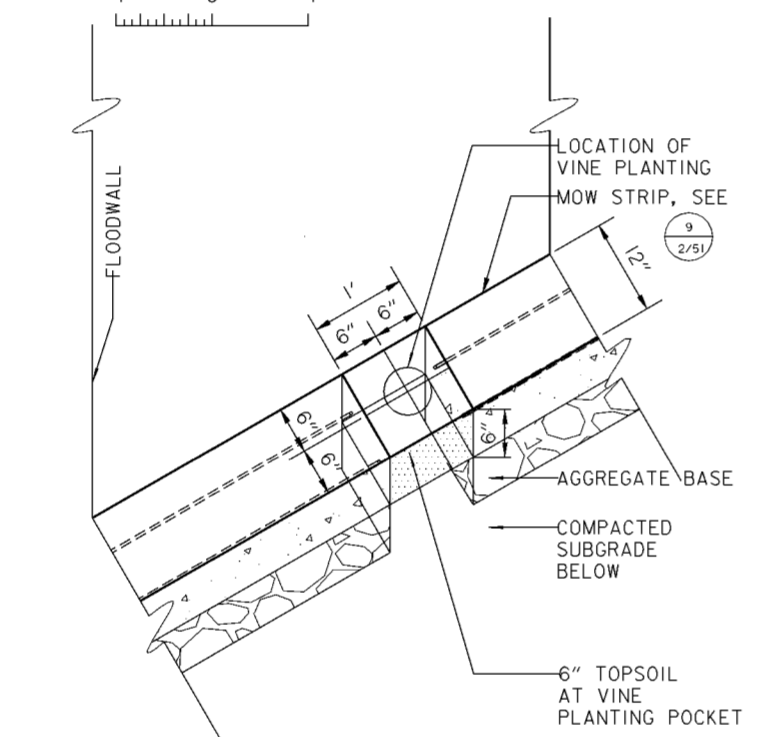


8 CONCRETE MOW STRIP: AXONOMETRIC
 SCALE: 1"=1'-0"
 1' 0 1'

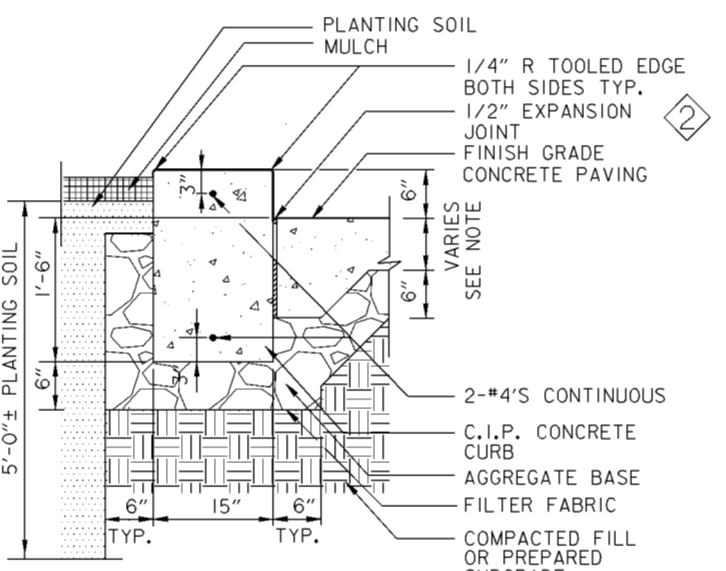


5 C.I.P. CONCRETE CURB @ PLANTING AREA
 SCALE: 1"=1'-0"
 1' 0 1'

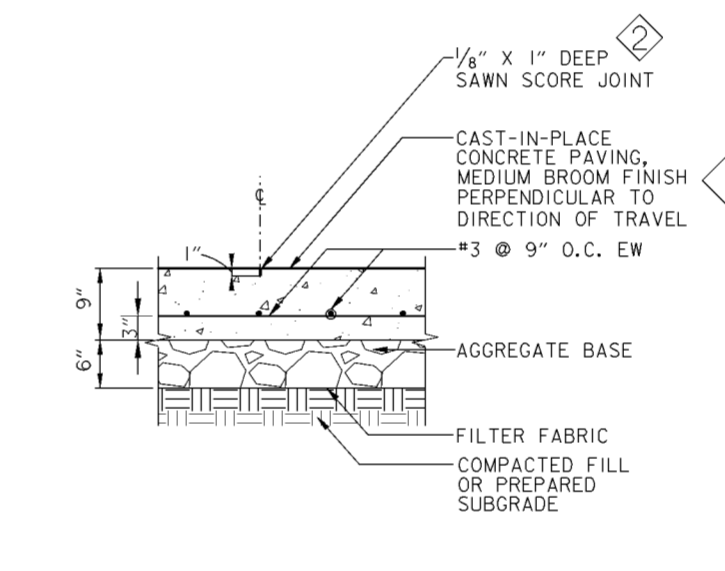


2 12' WIDE C.I.P. WALK: SECTION
 SCALE: 1"=1'-0"
 1' 0 1'

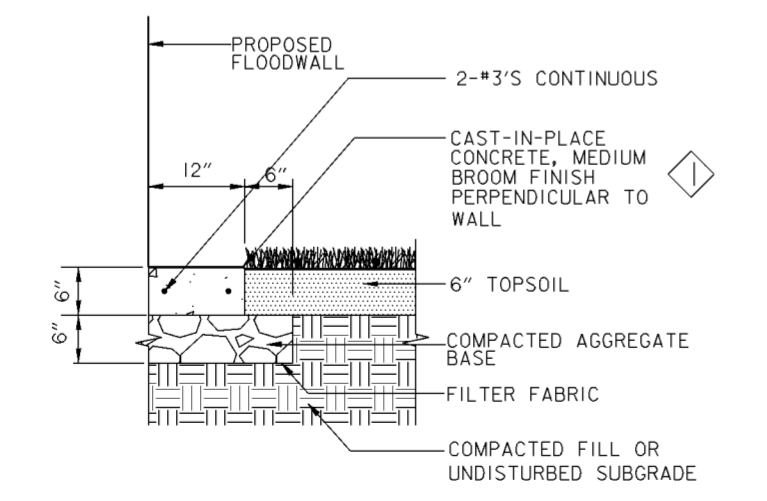

9 CONCRETE MOW STRIP: SECTION
 SCALE: 1"=1'-0"
 1' 0 1'

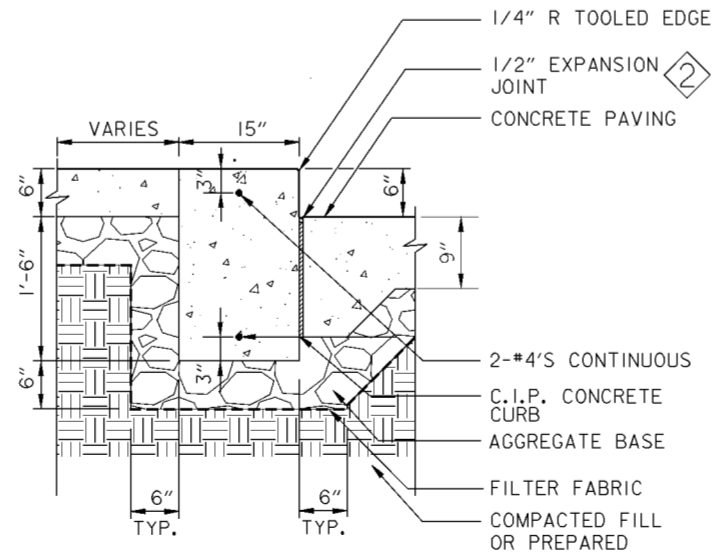


6 RAISED C.I.P. CONCRETE CURB @ BENCH PLATFORMS
 SCALE: 1"=1'-0"
 1' 0 1'

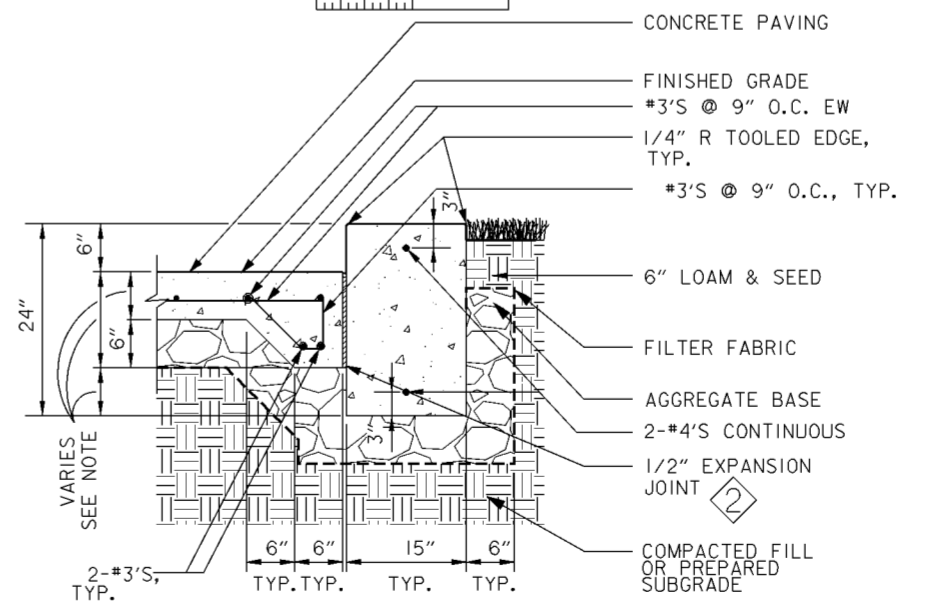

3 CONCRETE WALK WITH CURB: SECTION
 SCALE: 1"=1'-0"
 1' 0 1'

SASAKI ASSOCIATES, INC. WATERTOWN, MASSACHUSETTS MYERS-SCHMALENBURGER, INC. COLUMBUS, OHIO			
Symbol	Revisions Descriptions	Date	Approved
⊠	REVISED AS CONSTRUCTED	7/02	P.O.C.
⊠	REVISED IN ACCORDANCE WITH AMENDMENT 0001	4-23-98	P.O.C.


BURGESS & NIPLE, LIMITED COLUMBUS, OHIO	U.S. ARMY ENGINEER DISTRICT CORPS OF ENGINEERS HUNTINGTON, WEST VIRGINIA
Designed by: SOD	SCIO TO RIVER COLUMBUS, OHIO WEST COLUMBUS, L.P.P. PHASE IID
Drawn by: IS / CLB / GMF	SITE DETAILS (1 OF 4)
Checked by: CLO	Scale: AS NOTED
Reviewed by: NJD	Date: MARCH 1998
Approved by:	Drawing Code: 16-PWC-10-
	Sheet reference number: 20.2/51
	FILENAME: PEN TABLE:
	Sheet 1 of 4

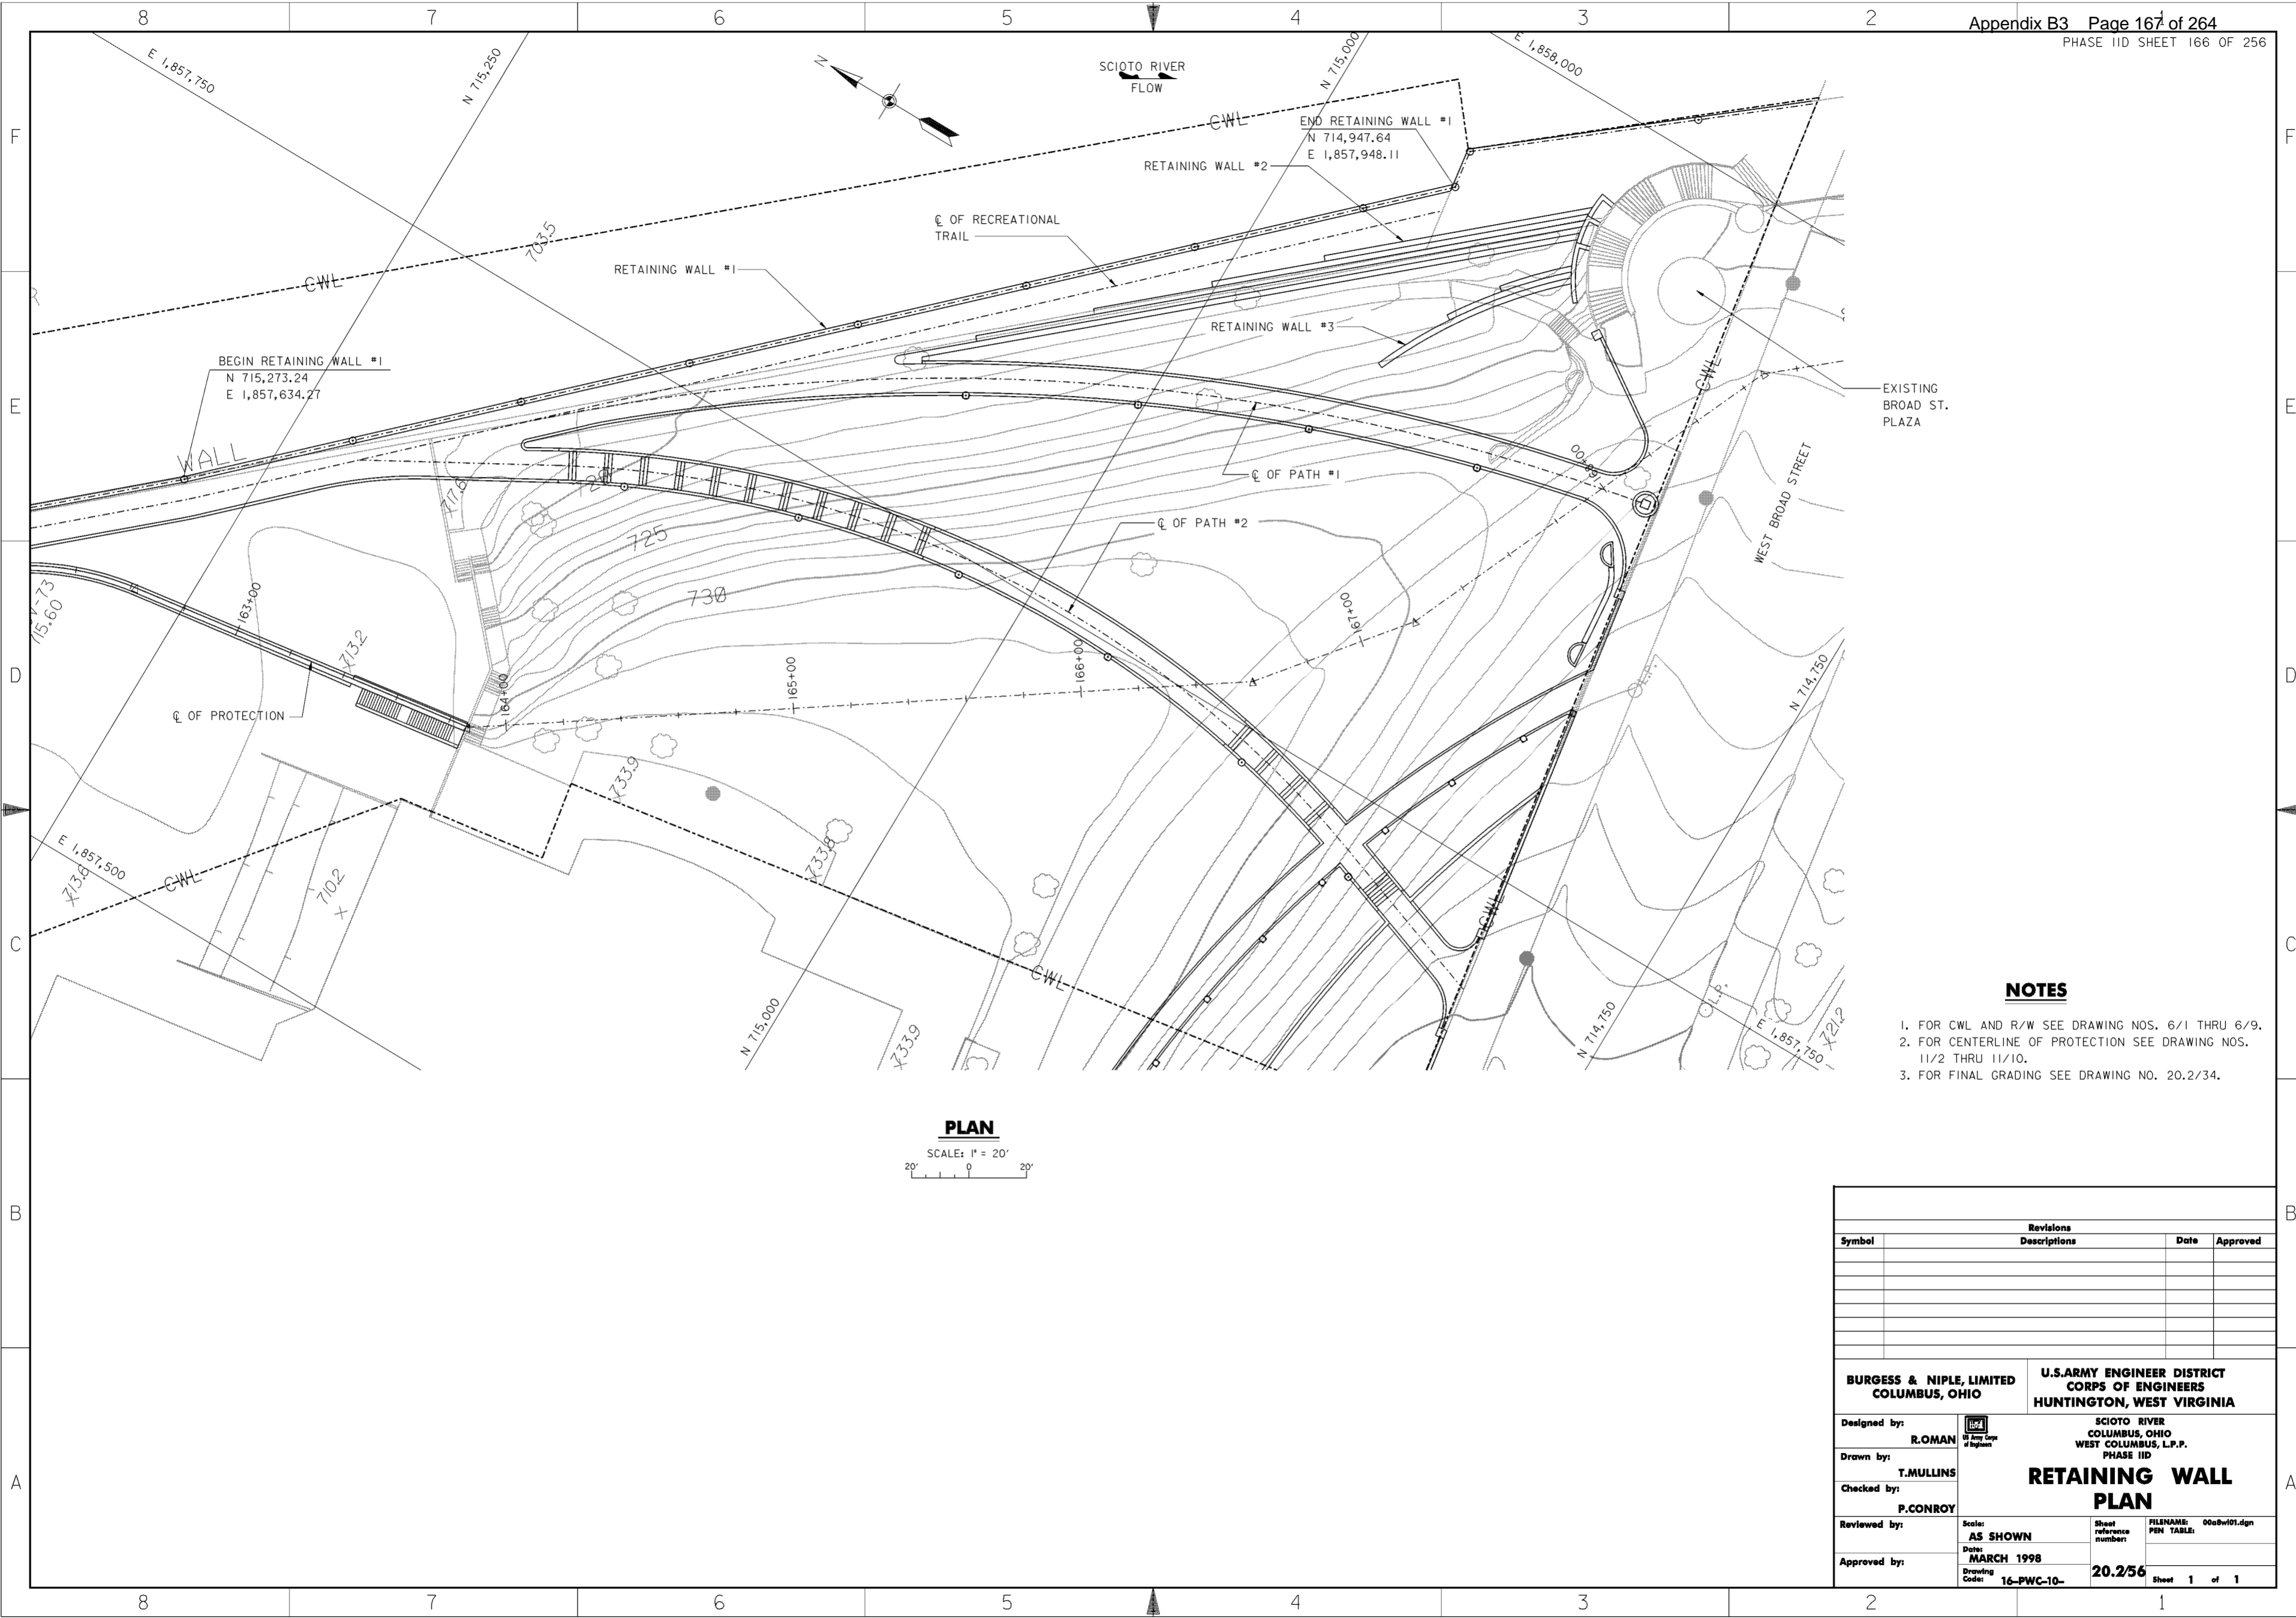

NOTES

1. FOR CWL AND R/W SEE DRAWING NOS. 6/1 THRU 6/9.
2. FOR CENTERLINE OF PROTECTION SEE DRAWING NOS. 11/2 THRU 11/10.
3. FOR FINAL GRADING SEE DRAWING NO. 20.2/34.


PLAN

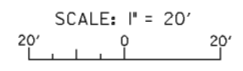

Revisions			
Symbol	Descriptions	Date	Approved

BURGESS & NIPLE, LIMITED COLUMBUS, OHIO	U.S. ARMY ENGINEER DISTRICT CORPS OF ENGINEERS HUNTINGTON, WEST VIRGINIA	
Designed by: R.ROMAN	SCIOTO RIVER COLUMBUS, OHIO WEST COLUMBUS, L.P.P. PHASE IID RETAINING WALL PLAN	
Drawn by: T.MULLINS		
Checked by: P.CONROY		
Reviewed by:		
Approved by:	Scale: AS SHOWN Date: MARCH 1998 Drawing Code: 16-PWC-10-	Sheet reference number: 20.2/56 FILENAME: PEN TABLE: 0008w01.dgn Sheet 1 of 1

WORK AS CONSTRUCTED

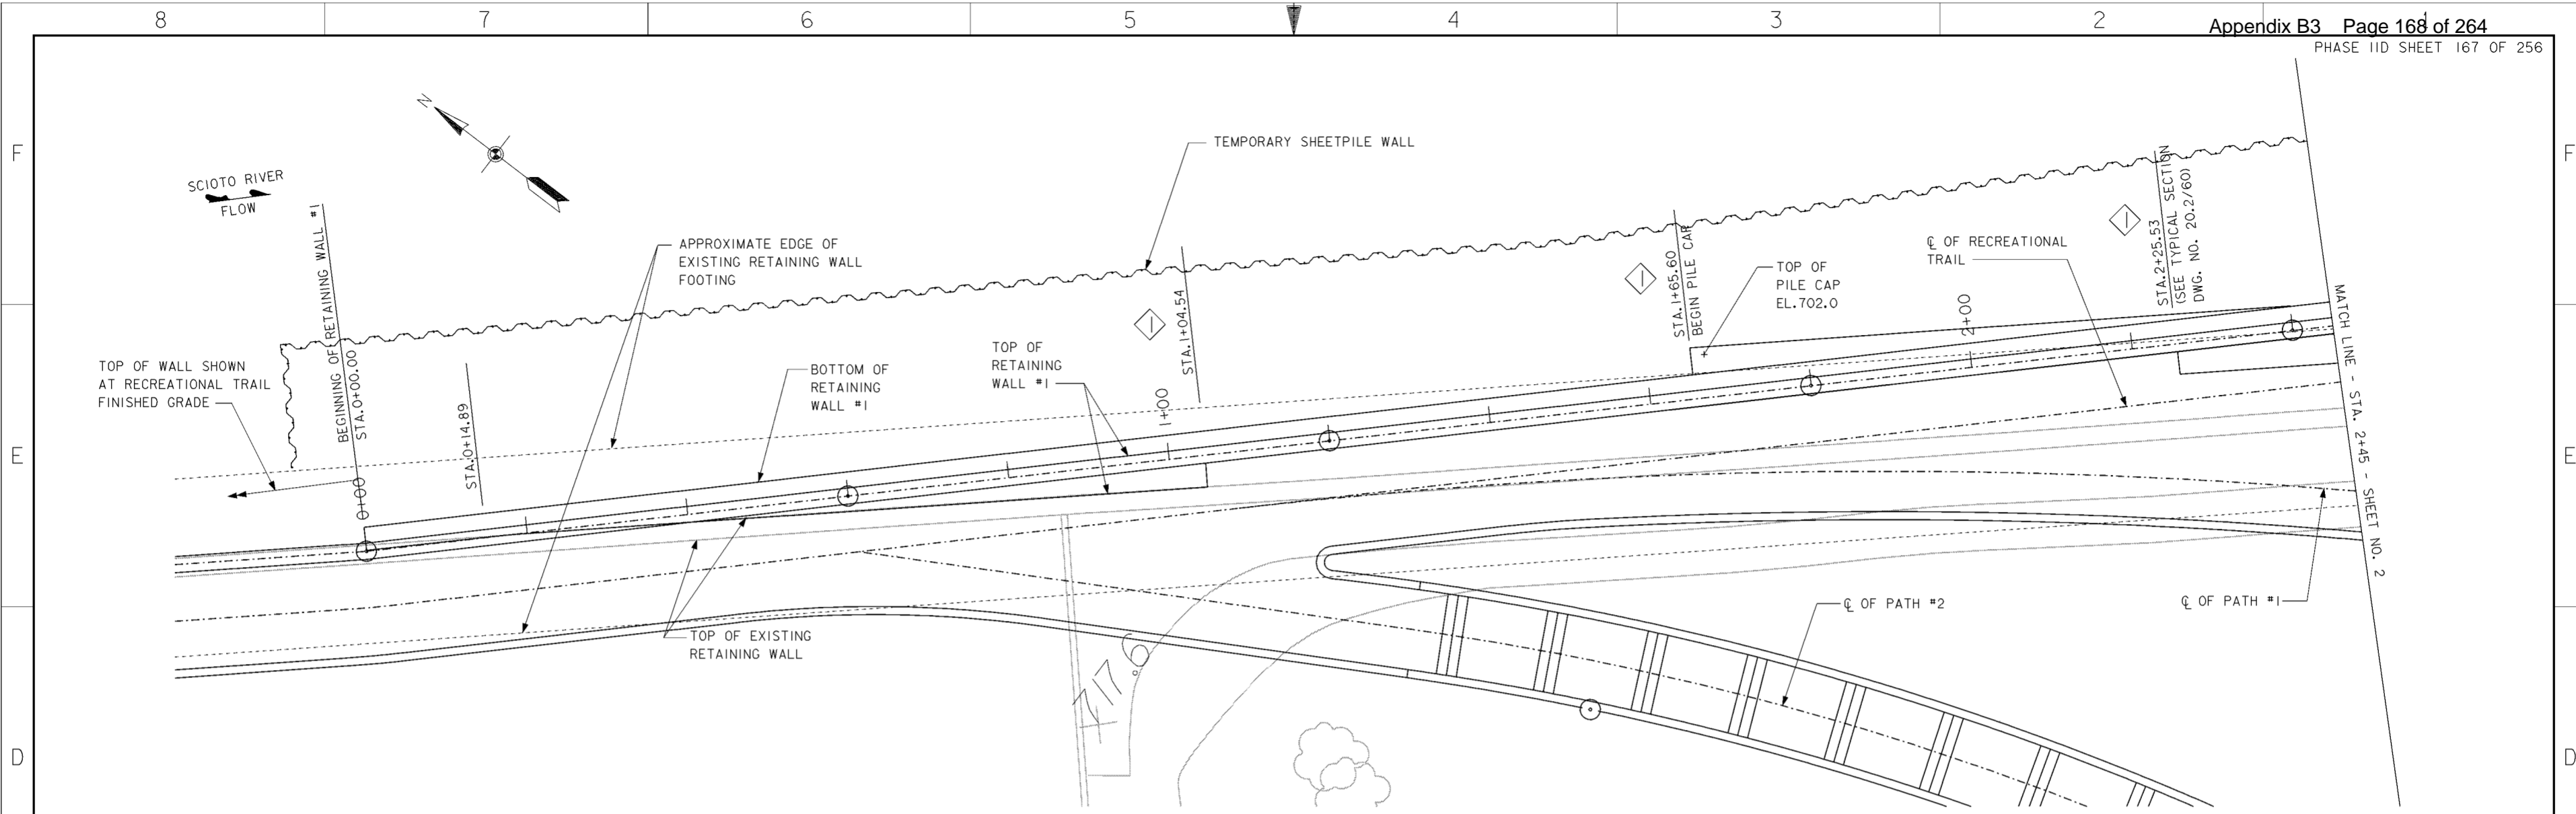


PLAN
SCALE: 1/8" = 1'-0"
12' 0" 5' 10' 15'

PLAN NOTES


1. TOP OF RETAINING WALL #1 SHOWN AT 2'-0" BELOW RECREATIONAL TRAIL FINISHED GRADE, UNLESS NOTED OTHERWISE.
2. BETWEEN STA.0+00.00 AND STA.2+64.63 PROVIDE TYPE "A" JOINTS IN NEW WALL TO ALIGN WITH JOINTS IN EXISTING RETAINING WALL.

NOTES

1. TOP OF RETAINING WALL #1 VARIES WITH RECREATIONAL TRAIL. FOR FINAL GRADE OF RECREATIONAL TRAIL SEE DRAWING NO. 20.2/34.
2. WHERE NEW WORK IS TO BE JOINED TO EXISTING WORK THE CONTRACTOR SHALL VERIFY THE DIMENSIONS, GRADES AND ELEVATIONS OF ALL EXISTING STRUCTURES.
3. FOR RETAINING WALL #1 SECTIONS SEE DRAWING NOS. 20.2/59 AND 20.2/60.
4. TEMPORARY SHEETPILE WALL TO FACILITATE DEWATERING AND EXCAVATION FOR CONSTRUCTION OF RETAINING WALL #1 AND RECREATIONAL TRAIL. SEE SPECIFICATION SECTION 02222.
5. FOR MONOLITH JOINT TYPES SEE DRAWING NO. 20.1/1.
6. FOR MONOLITH JOINT AND TIE ROD LOCATIONS SEE DRAWING NO. 20.2/58.

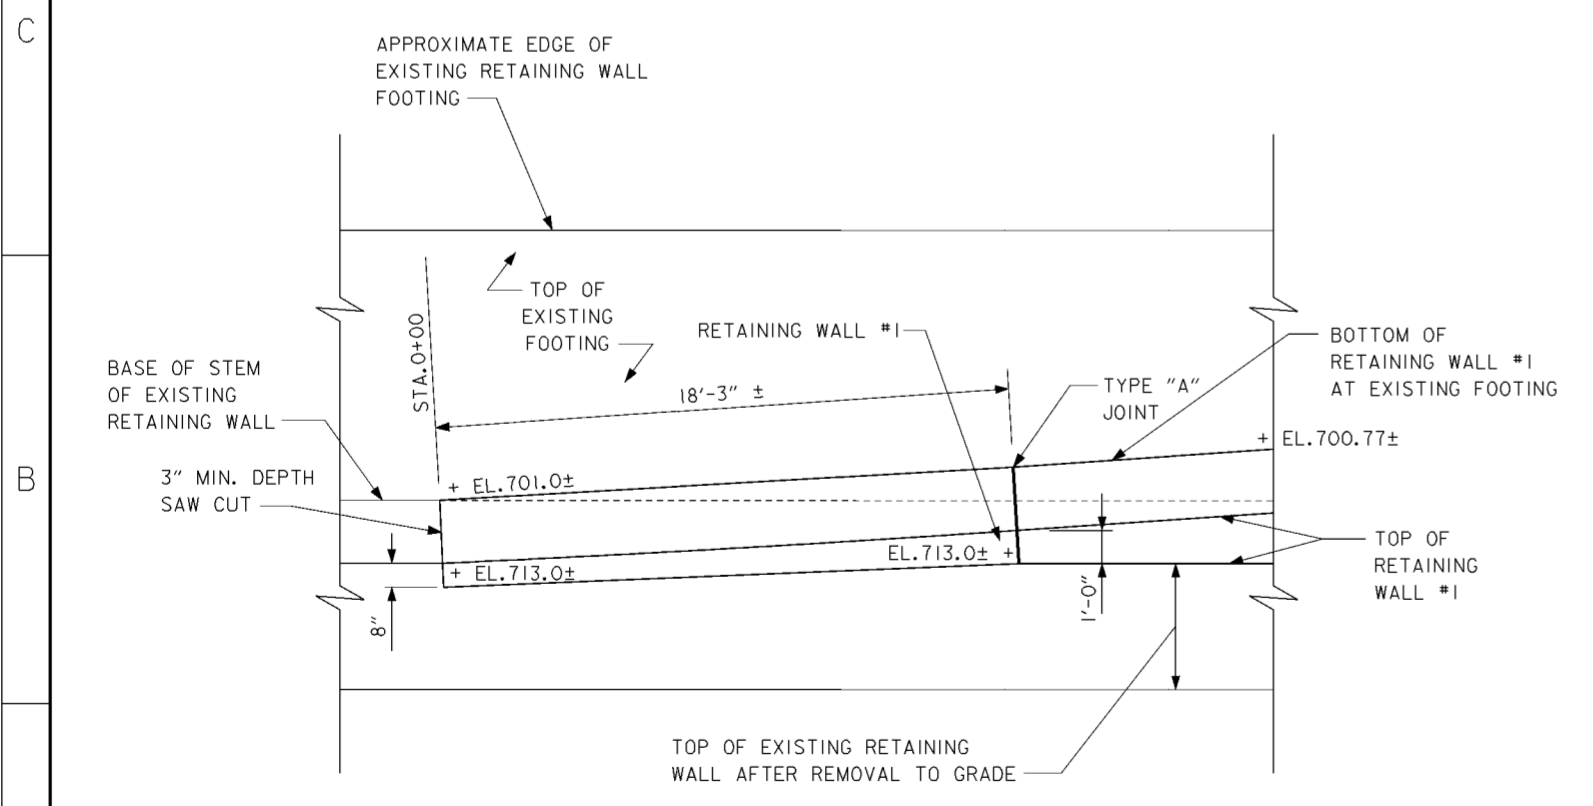

PARTIAL PLAN AT STA.0+00
SCALE: 3/8" = 1'-0"
12' 0" 2' 4' 6'

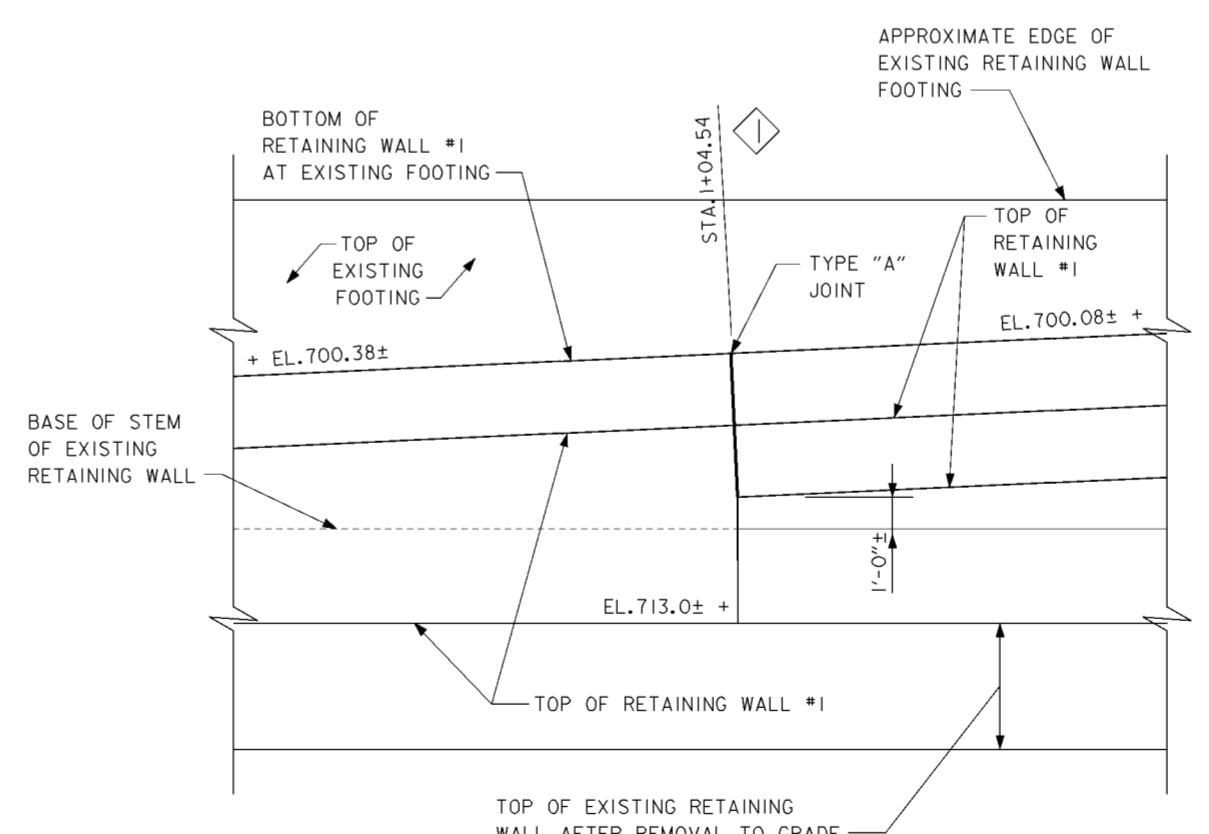


PARTIAL PLAN AT STA.1+04.54
SCALE: 3/8" = 1'-0"
12' 0" 2' 4' 6'


Revisions			
Symbol	Descriptions	Date	Approved
◊	REVISED AS CONSTRUCTED	7/02	P.O.C.

BURGESS & NIPLE, LIMITED COLUMBUS, OHIO	U.S. ARMY ENGINEER DISTRICT CORPS OF ENGINEERS HUNTINGTON, WEST VIRGINIA
Designed by: R.OMAN	SCIO TO RIVER COLUMBUS, OHIO WEST COLUMBUS, L.P.P. PHASE IID
Drawn by: T.MULLINS	RETAINING WALL NO.1 PLAN (1 OF 2)
Checked by: P.CONROY	Scale: AS SHOWN
Reviewed by:	Date: MARCH 1998
Approved by:	Drawing Code: 16-PWC-10-
	Sheet reference number: 20.2/57
	FILENAME: a0w9w01.dgn
	Sheet 1 of 2

WORK AS CONSTRUCTED

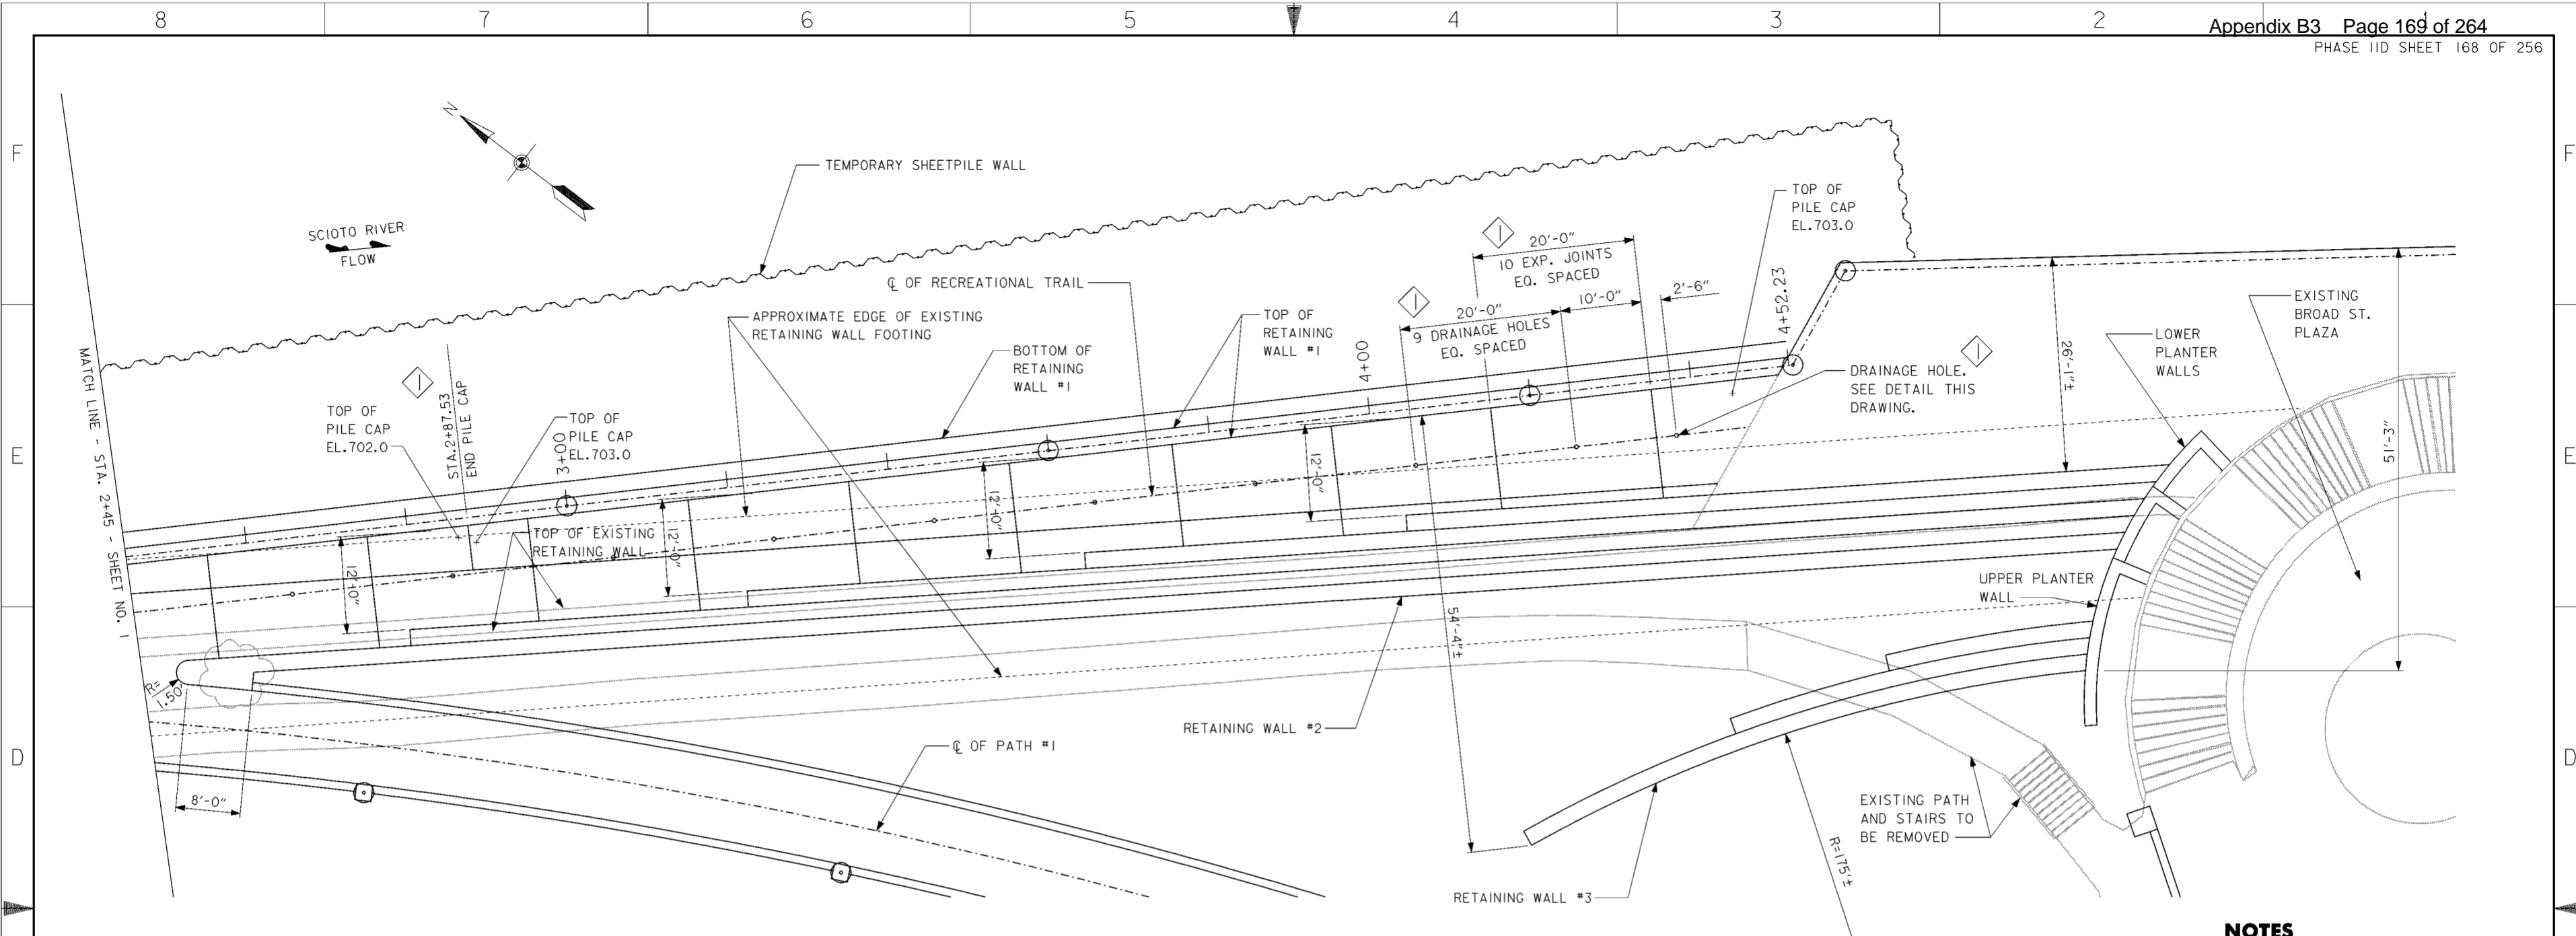

PLAN

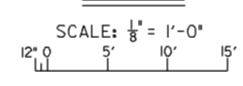

NOTE: TOP OF RETAINING WALL #1 SHOWN AT 2'-0" BELOW RECREATIONAL TRAIL FINISHED GRADE.

STATION	JOINT TYPE	TIE ROD
0+00.00	①	-
0+14.89	A	-
0+44.70	CONTROL	-
0+74.72	CONTROL	-
1+04.54	A	-
1+09.02	-	-
1+19.47	-	-
1+29.91	-	-
1+34.39	B	-
1+39.07	-	REQ'D
1+50.00	-	REQ'D
1+60.92	-	REQ'D
1+65.60	A	-
1+69.94	-	REQ'D
1+80.07	-	REQ'D
1+90.19	-	REQ'D
1+94.53	B	-
1+99.18	-	REQ'D
2+10.03	-	REQ'D
2+20.88	-	REQ'D
2+25.53	A	-
2+29.87	-	REQ'D
2+40.00	-	REQ'D
2+50.13	-	REQ'D
2+54.47	B	-


STATION	JOINT TYPE	TIE ROD
2+59.43	-	REQ'D
2+71.00	-	REQ'D
2+82.57	-	REQ'D
2+87.53	A	-
2+92.49	-	REQ'D
3+04.07	-	REQ'D
3+15.64	-	REQ'D
3+20.60	B	-
3+25.56	-	REQ'D
3+37.14	-	REQ'D
3+48.71	-	REQ'D
3+53.67	B	-
3+58.63	-	REQ'D
3+70.20	-	REQ'D
3+81.77	-	REQ'D
3+86.73	A	-
3+91.69	-	REQ'D
4+03.27	-	REQ'D
4+14.84	-	REQ'D
4+19.80	B	-
4+24.66	-	-
4+36.02	-	-
4+47.37	-	-
4+52.23	A	-

① BETWEEN STA. 0+00.00 AND STA. 2+64.63 PROVIDE TYPE "A" JOINTS IN NEW WALL TO ALIGN WITH JOINTS IN EXISTING RETAINING WALL.


NOTE: BETWEEN STA. 0+00 AND STA. 2+46.71 PROVIDE TYPE "A" JOINTS IN NEW WALL TO ALIGN WITH JOINTS IN EXISTING RETAINING WALL.

NOTES

1. TOP OF RETAINING WALL #1 VARIES WITH RECREATIONAL TRAIL. FOR FINAL GRADE OF RECREATIONAL TRAIL SEE DRAWING NO. 20.2/34.
2. WHERE NEW WORK IS TO BE JOINED TO EXISTING WORK THE CONTRACTOR SHALL VERIFY THE DIMENSIONS, GRADES AND ELEVATIONS OF ALL EXISTING STRUCTURES.
3. TEMPORARY SHEETPILE WALL TO FACILITATE DEWATERING AND EXCAVATION FOR CONSTRUCTION OF RETAINING WALL #1 AND RECREATIONAL TRAIL. SEE SPECIFICATION SECTION 02222.
4. FOR TIE-BACK DETAILS SEE DRAWING NO. 20.2/64.
5. FOR JOINT DETAILS SEE DRAWING NO. 20.1/1.


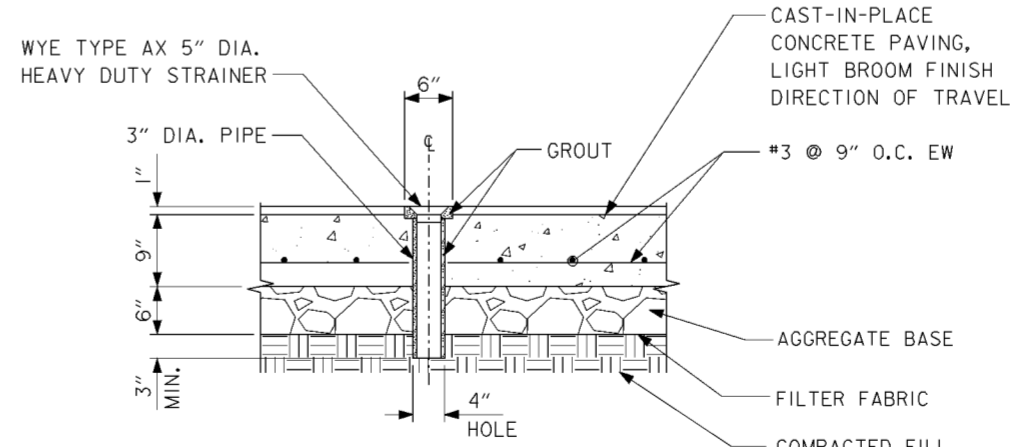


DRAINAGE HOLE SECTION

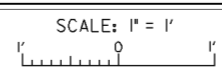


Revisions			
Symbol	Descriptions	Date	Approved
◊	REVISED AS CONSTRUCTED	7/02	P.O.C.

BURGESS & NIPLE, LIMITED COLUMBUS, OHIO	U.S. ARMY ENGINEER DISTRICT CORPS OF ENGINEERS HUNTINGTON, WEST VIRGINIA
Designed by: R.OMAN Drawn by: T.MULLINS Checked by: P.CONROY Reviewed by:	SCIO TO RIVER COLUMBUS, OHIO WEST COLUMBUS, L.P.P. PHASE IID RETAINING WALL NO.1 PLAN (2 OF 2) Scale: AS SHOWN Date: MARCH 1998 Drawing Code: 16-PWC-10-
Sheet reference number: 20.2/58	FILENAME: a0w9w02.dgn PEN TABLE: Sheet 2 of 2

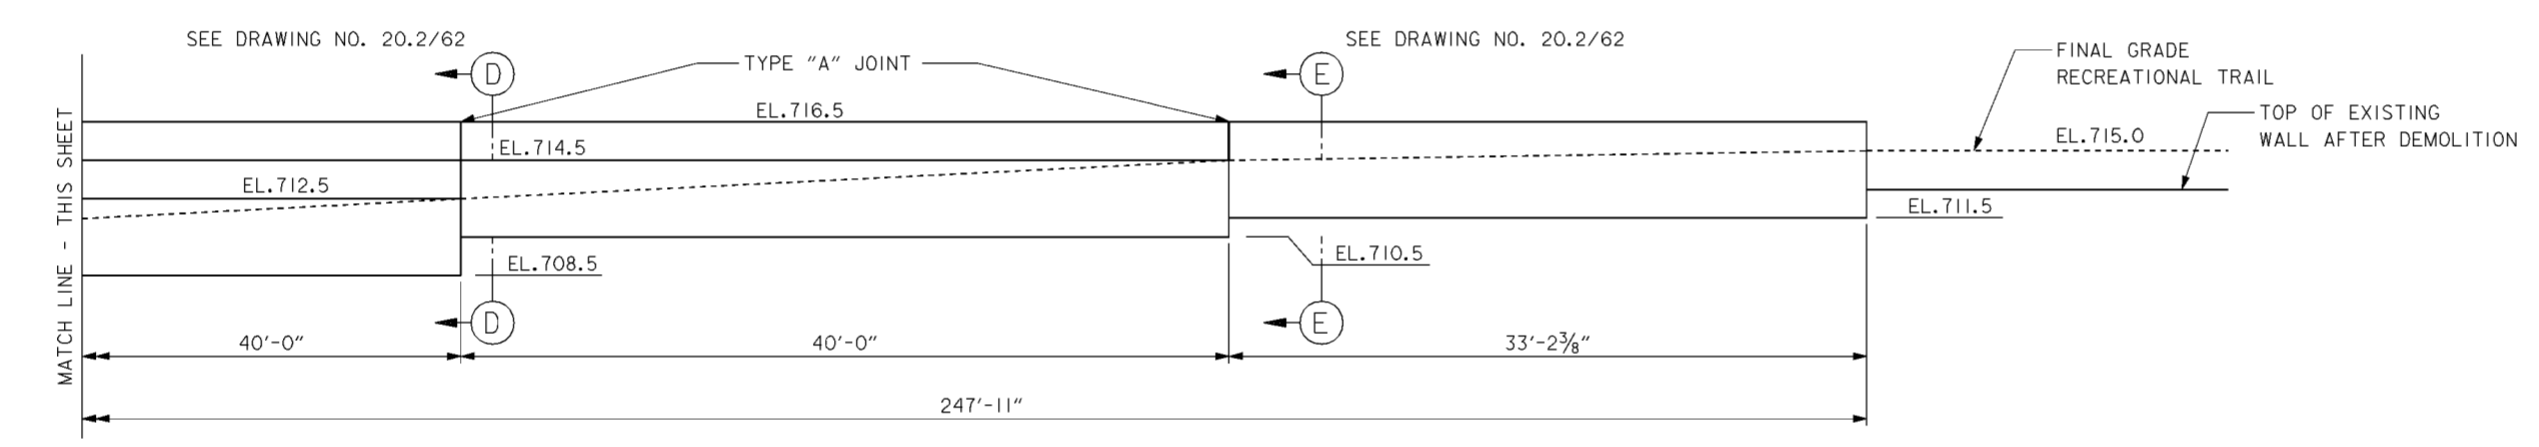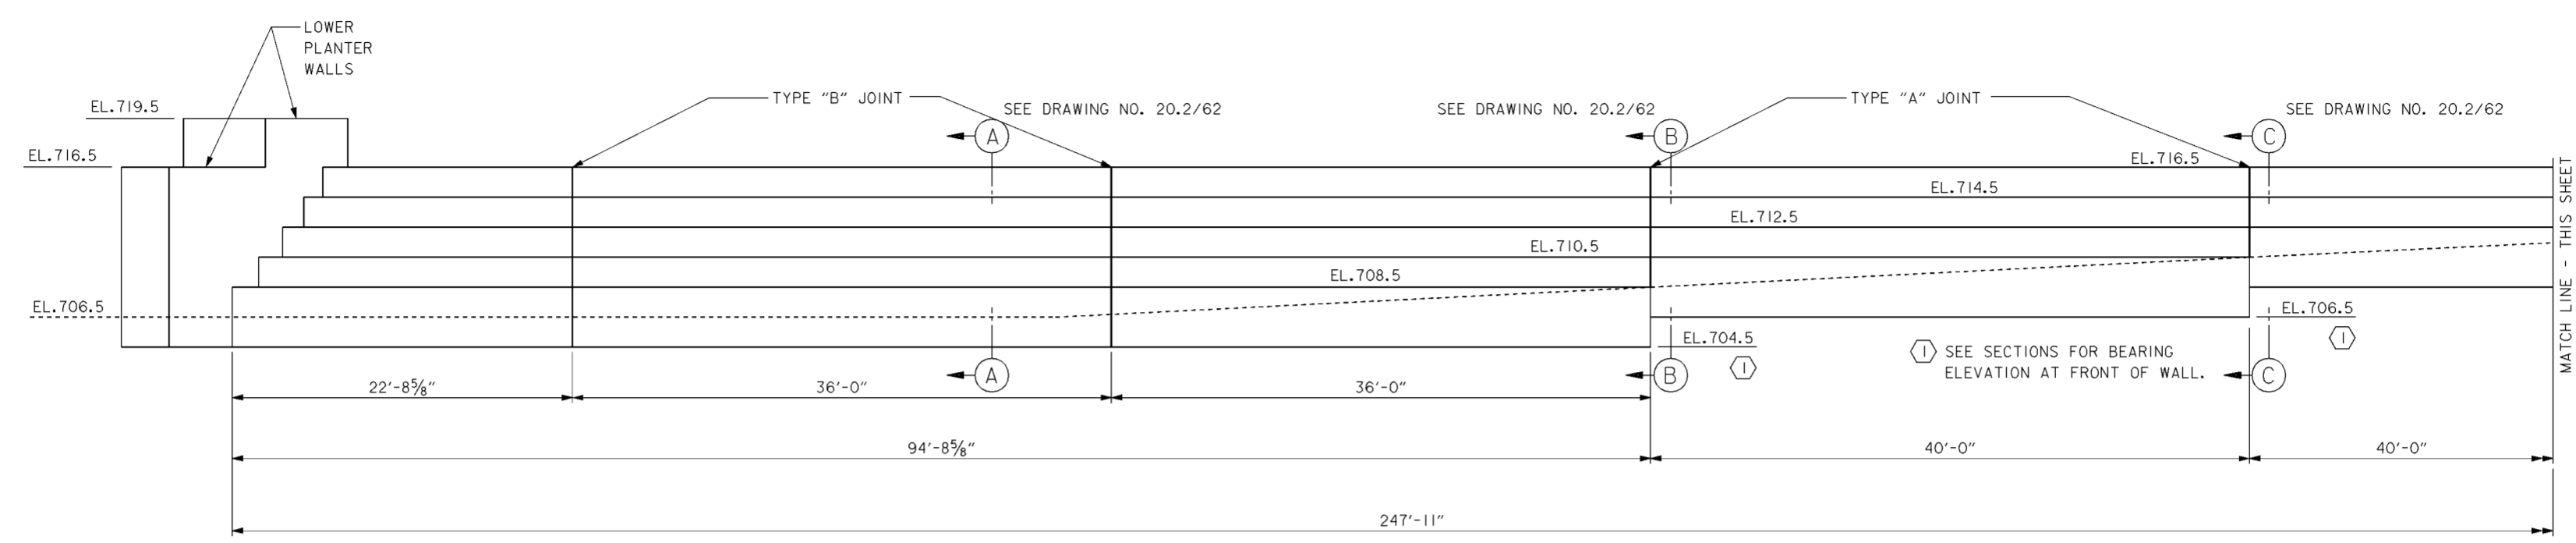


RETAINING WALL #2 ELEVATIONS

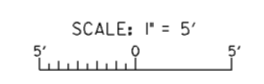


NOTES

1. FOR VETERANS MEMORIAL RETAINING WALL NOS. 2 AND 3 SECTIONS SEE DRAWING NOS. 20.2/62 AND 20.2/63.
2. FOR TYPE "A" AND TYPE "B" JOINT DETAILS SEE DRAWING NO. 20.1/1.
3. REINFORCING SHOWN ON DRAWING NOS. 20.2/62 AND 20.2/63.
4. FOR LONGITUDINAL DRAIN SEE DRAWING NO.20.2/63.

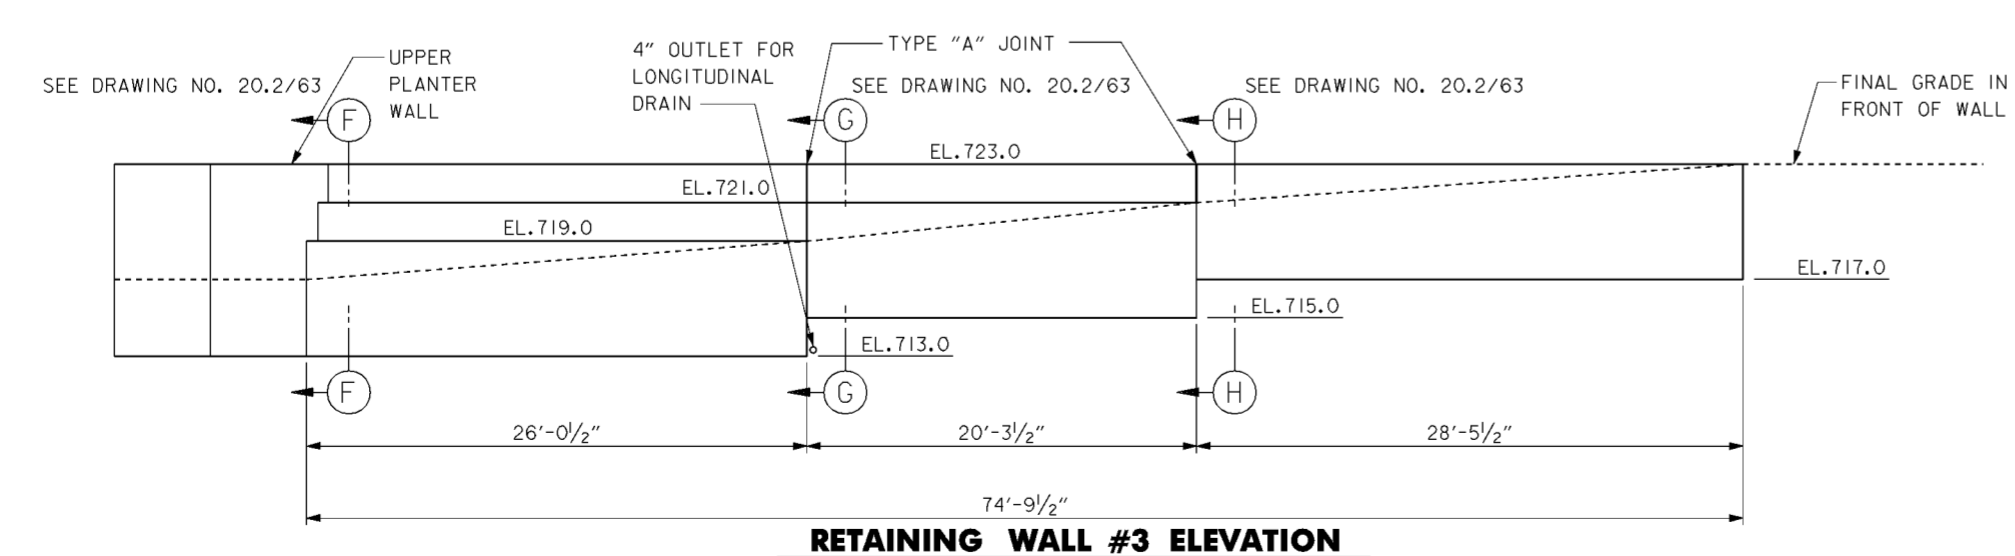


RETAINING WALL #3 ELEVATION

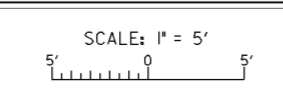

Revisions			
Symbol	Descriptions	Date	Approved

BURGESS & NIPLE, LIMITED COLUMBUS, OHIO	U.S. ARMY ENGINEER DISTRICT CORPS OF ENGINEERS HUNTINGTON, WEST VIRGINIA	Designed by: J. HALL	SCIOTO RIVER COLUMBUS, OHIO WEST COLUMBUS, L.P.P. PHASE IID
		Drawn by: T. MULLINS	
Checked by: L. LINZELL	RETAINING WALL NOS. 2 AND 3 ELEVATIONS		FILENAME: 0008w02.dgn PEN TABLE:
Reviewed by:	Scale: AS SHOWN	Sheet reference number: 20.2/61	Drawing Code: 16-PWC-10-
Approved by:	Date: MARCH 1998	Sheet 1 of 1	Sheet 1 of 1

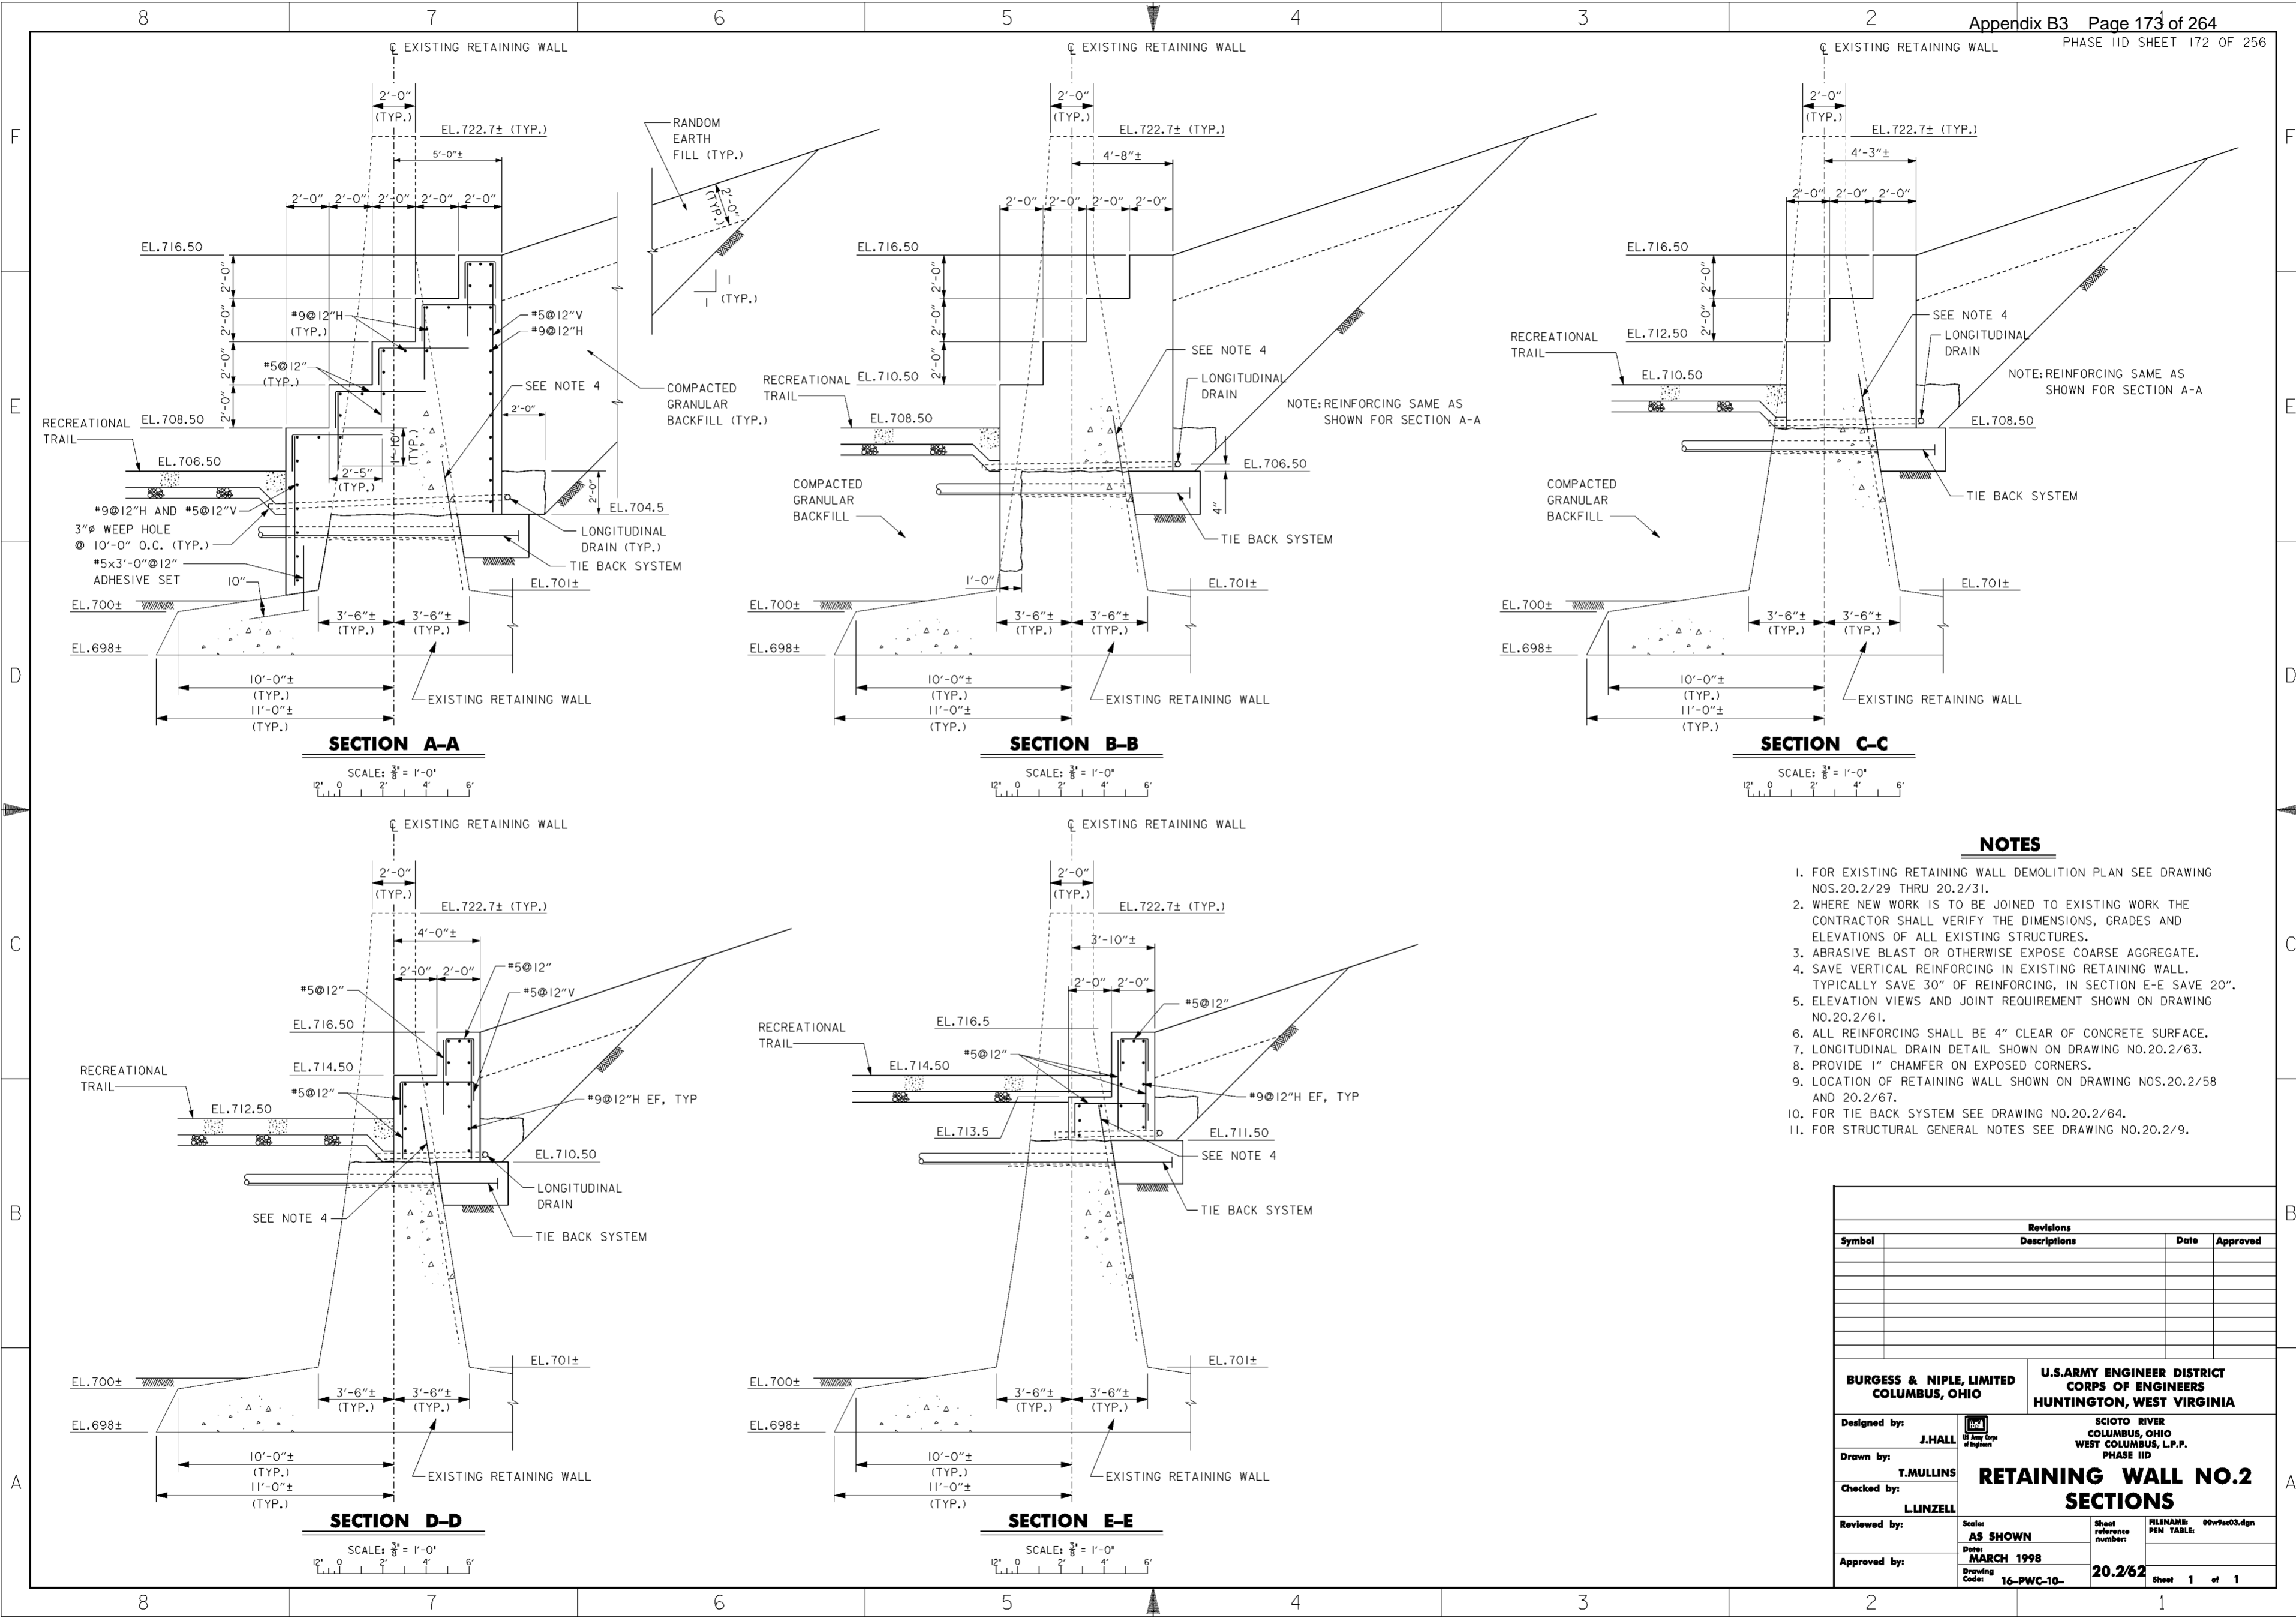


NOTES

1. FOR EXISTING RETAINING WALL DEMOLITION PLAN SEE DRAWING NOS.20.2/29 THRU 20.2/31.
2. WHERE NEW WORK IS TO BE JOINED TO EXISTING WORK THE CONTRACTOR SHALL VERIFY THE DIMENSIONS, GRADES AND ELEVATIONS OF ALL EXISTING STRUCTURES.
3. ABRASIVE BLAST OR OTHERWISE EXPOSE COARSE AGGREGATE.
4. SAVE VERTICAL REINFORCING IN EXISTING RETAINING WALL. TYPICALLY SAVE 30" OF REINFORCING, IN SECTION E-E SAVE 20".
5. ELEVATION VIEWS AND JOINT REQUIREMENT SHOWN ON DRAWING NO.20.2/61.
6. ALL REINFORCING SHALL BE 4" CLEAR OF CONCRETE SURFACE.
7. LONGITUDINAL DRAIN DETAIL SHOWN ON DRAWING NO.20.2/63.
8. PROVIDE 1" CHAMFER ON EXPOSED CORNERS.
9. LOCATION OF RETAINING WALL SHOWN ON DRAWING NOS.20.2/58 AND 20.2/67.
10. FOR TIE BACK SYSTEM SEE DRAWING NO.20.2/64.
11. FOR STRUCTURAL GENERAL NOTES SEE DRAWING NO.20.2/9.


Revisions			
Symbol	Descriptions	Date	Approved

BURGESS & NIPLE, LIMITED COLUMBUS, OHIO		U.S. ARMY ENGINEER DISTRICT CORPS OF ENGINEERS HUNTINGTON, WEST VIRGINIA	
Designed by:	J. HALL	SCIOTO RIVER COLUMBUS, OHIO WEST COLUMBUS, L.P.P. PHASE IID RETAINING WALL NO.2 SECTIONS	
Drawn by:	T. MULLINS		
Checked by:	L. LINZELL		
Reviewed by:	AS SHOWN		
Approved by:	MARCH 1998		
Scale: AS SHOWN		Sheet reference number: 20.2/62	FILENAME: 00w9ac03.dgn
Drawing Code: 16-PWC-10-		Sheet 1 of 1	



WORK AS CONSTRUCTED

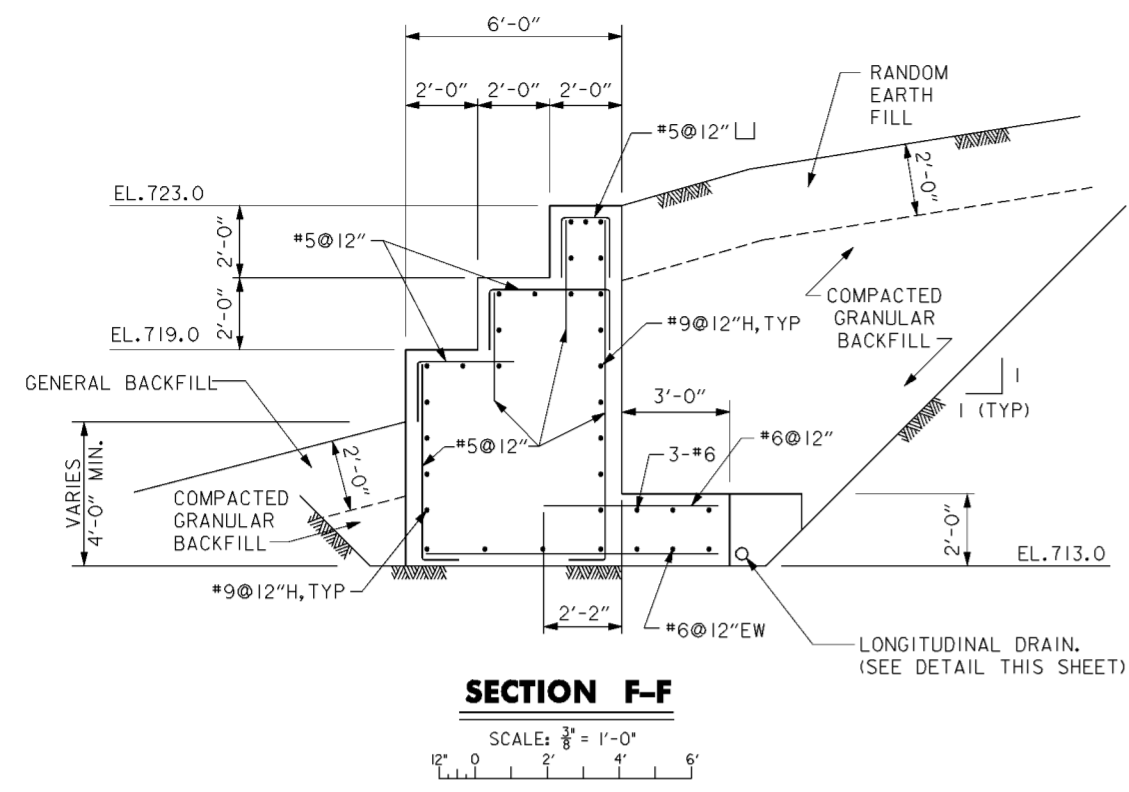

NOTE: REINFORCING SAME AS SHOWN ON SECTION A-A DRAWING NO. 20.2/62 EXCEPT AS SHOWN.

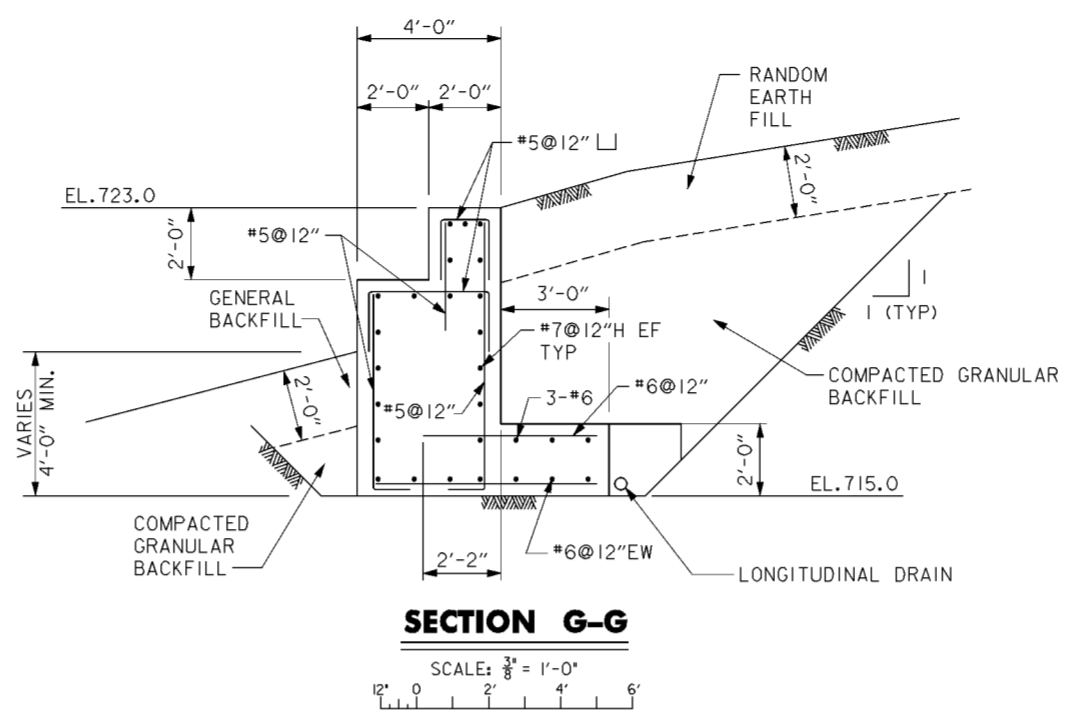

NOTE: REINFORCING SAME AS SHOWN ON SECTION A-A DRAWING NO. 20.2/62 EXCEPT AS SHOWN.

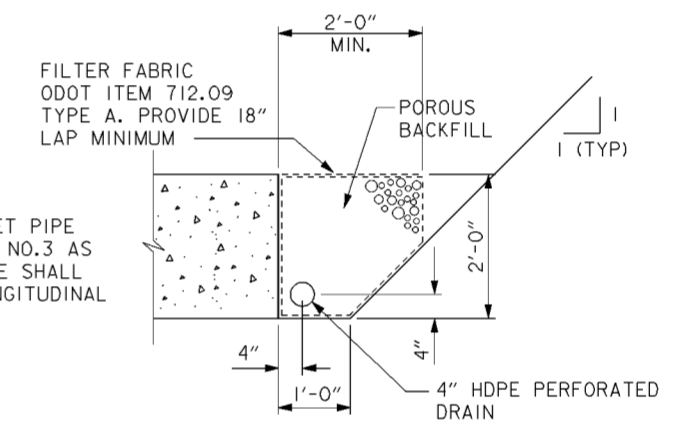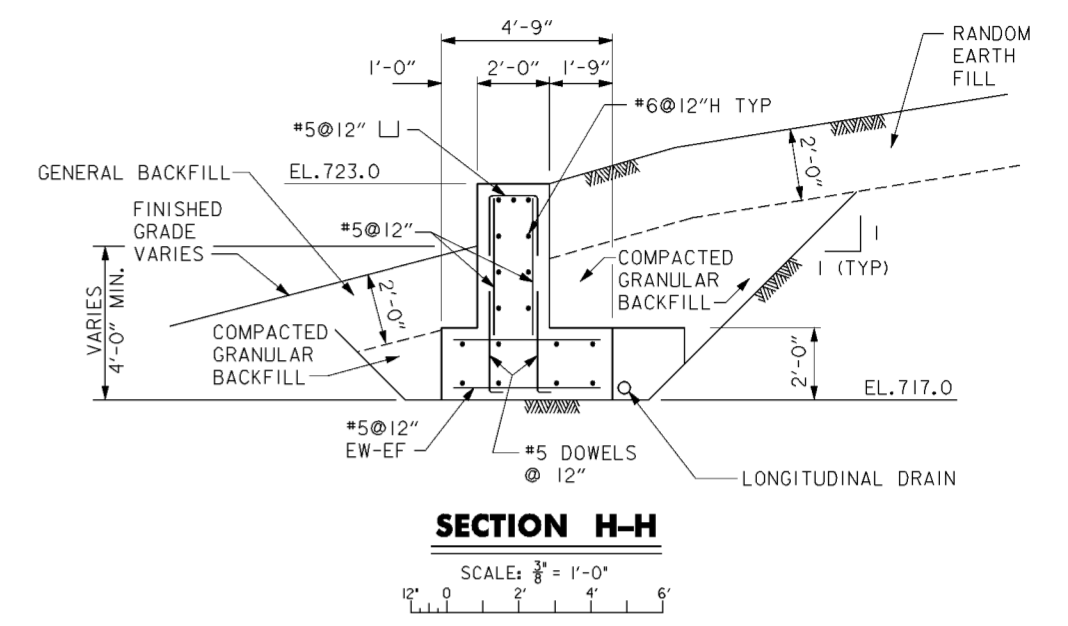

NOTE: PROVIDE 4" DIAMETER NON-PERFORATED OUTLET PIPE FOR LONGITUDINAL DRAIN AT RETAINING WALL NO.3 AS SHOWN ON DRAWING NO. 20.2/61. OUTLET PIPE SHALL DRAIN POSITIVELY AND BE CONNECTED TO LONGITUDINAL DRAIN FOR RETAINING WALL NO.2.


LONGITUDINAL DRAIN
 SCALE: $\frac{3}{4}'' = 1'-0''$

NOTES

1. TOP SOIL NOT SHOWN.
2. ELEVATION VIEWS AND JOINT REQUIREMENTS SHOWN ON DRAWING NO. 20.2/61.
3. LOCATION OF RETAINING WALL SHOWN ON DRAWING NOS. 20.2/58 AND 20.2/67
4. ALL REINFORCING SHALL BE 4" CLEAR OF CONCRETE SURFACE.
5. FOR STRUCTURAL GENERAL NOTES SEE DRAWING NO. 20.2/9.

Revisions			
Symbol	Descriptions	Date	Approved

BURGESS & NIPLE, LIMITED COLUMBUS, OHIO	U.S. ARMY ENGINEER DISTRICT CORPS OF ENGINEERS HUNTINGTON, WEST VIRGINIA		
Designed by: J. HALL	SCIO TO RIVER COLUMBUS, OHIO WEST COLUMBUS, L.P.P. PHASE IID		
Drawn by: T. MULLINS	RETAINING WALL NO. 3 SECTIONS		
Checked by: L. LINZELL			
Reviewed by:	Scale: AS SHOWN	Sheet reference number:	FILENAME: PEN TABLE: 000w03.dgn
Approved by:	Date: MARCH 1998	Drawing Code: 16-PWC-10-	20.2/63 Sheet 1 of 1

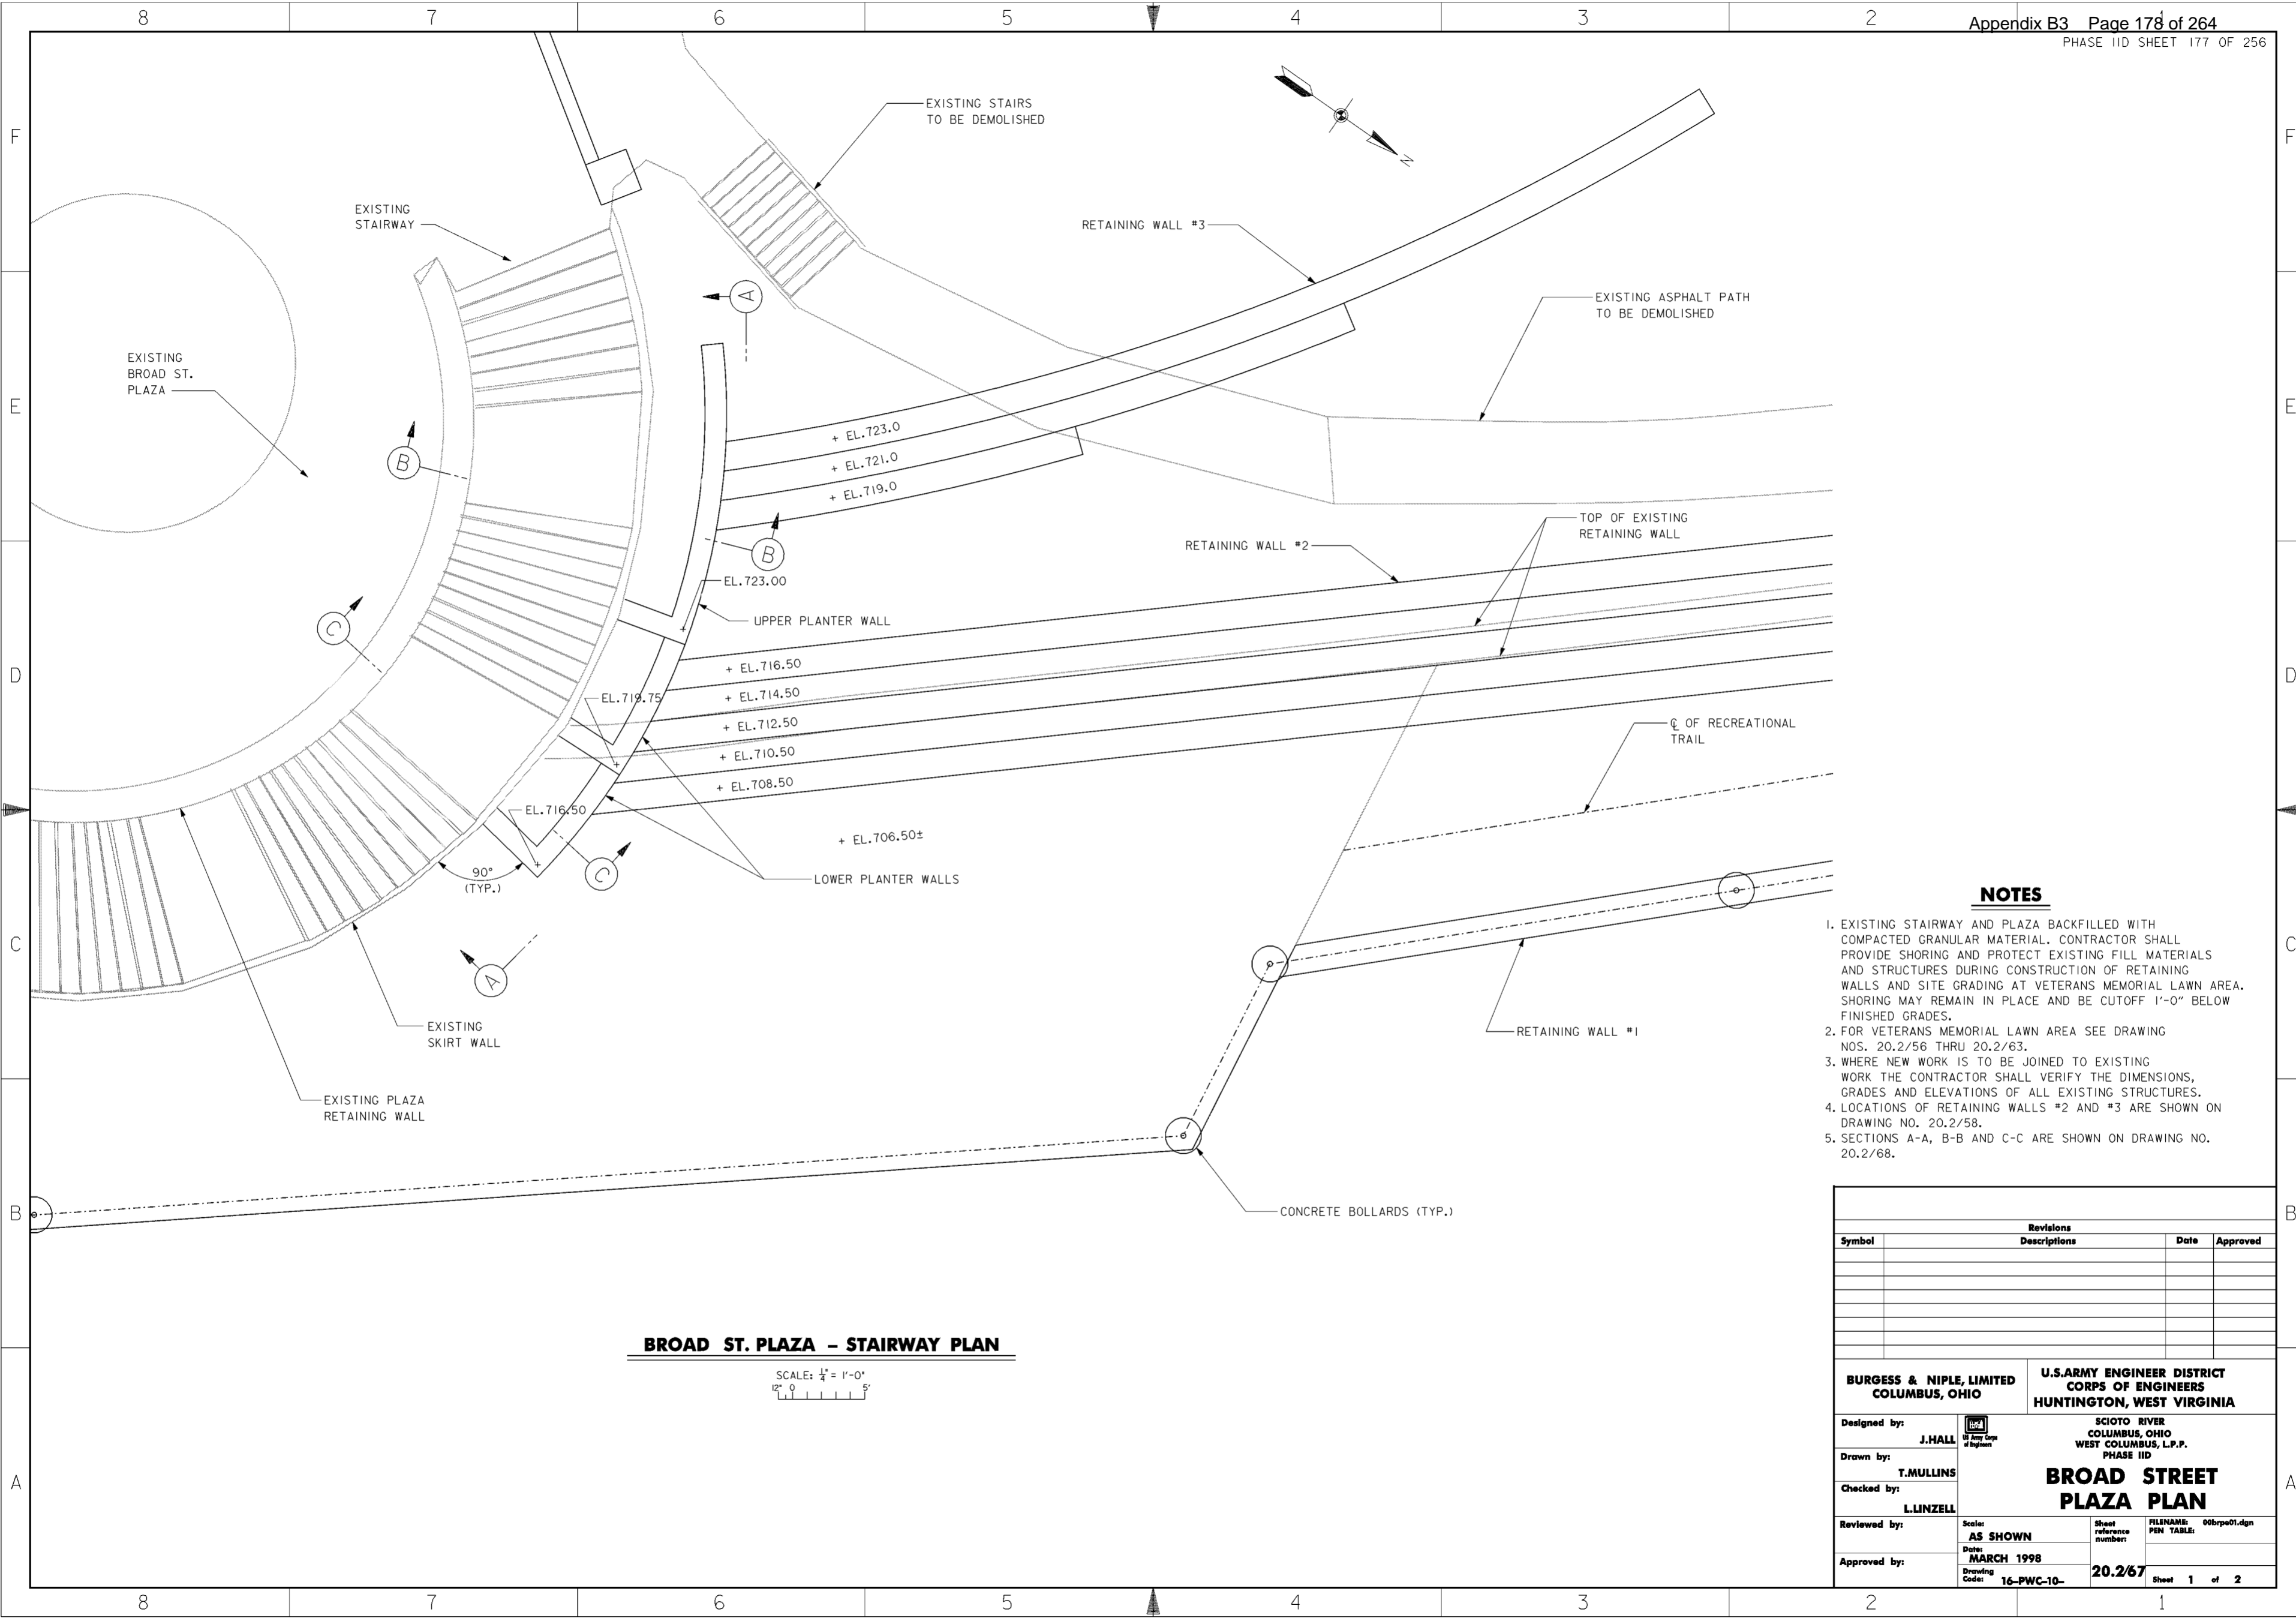

NOTES

1. EXISTING STAIRWAY AND PLAZA BACKFILLED WITH COMPACTED GRANULAR MATERIAL. CONTRACTOR SHALL PROVIDE SHORING AND PROTECT EXISTING FILL MATERIALS AND STRUCTURES DURING CONSTRUCTION OF RETAINING WALLS AND SITE GRADING AT VETERANS MEMORIAL LAWN AREA. SHORING MAY REMAIN IN PLACE AND BE CUTOFF 1'-0" BELOW FINISHED GRADES.
2. FOR VETERANS MEMORIAL LAWN AREA SEE DRAWING NOS. 20.2/56 THRU 20.2/63.
3. WHERE NEW WORK IS TO BE JOINED TO EXISTING WORK THE CONTRACTOR SHALL VERIFY THE DIMENSIONS, GRADES AND ELEVATIONS OF ALL EXISTING STRUCTURES.
4. LOCATIONS OF RETAINING WALLS #2 AND #3 ARE SHOWN ON DRAWING NO. 20.2/58.
5. SECTIONS A-A, B-B AND C-C ARE SHOWN ON DRAWING NO. 20.2/68.



BROAD ST. PLAZA - STAIRWAY PLAN

SCALE: 1/4" = 1'-0"
 12" 0' 1' 2' 3' 4' 5'

Revisions			
Symbol	Descriptions	Date	Approved



BURGESS & NIPLE, LIMITED COLUMBUS, OHIO	U.S. ARMY ENGINEER DISTRICT CORPS OF ENGINEERS HUNTINGTON, WEST VIRGINIA	Designed by: J. HALL	SCIOTO RIVER COLUMBUS, OHIO WEST COLUMBUS, L.P.P. PHASE IID
		Drawn by: T. MULLINS	
Checked by: L. LINZELL	BROAD STREET PLAZA PLAN	Reviewed by: AS SHOWN	FILENAME: 00brpe01.dgn PEN TABLE:
Approved by:	Date: MARCH 1998	Sheet reference number: 20.2/67	Sheet 1 of 2
Drawing Code: 16-PWC-10-	Scale: AS SHOWN	Date: MARCH 1998	Drawing Code: 16-PWC-10-

WORK AS CONSTRUCTED

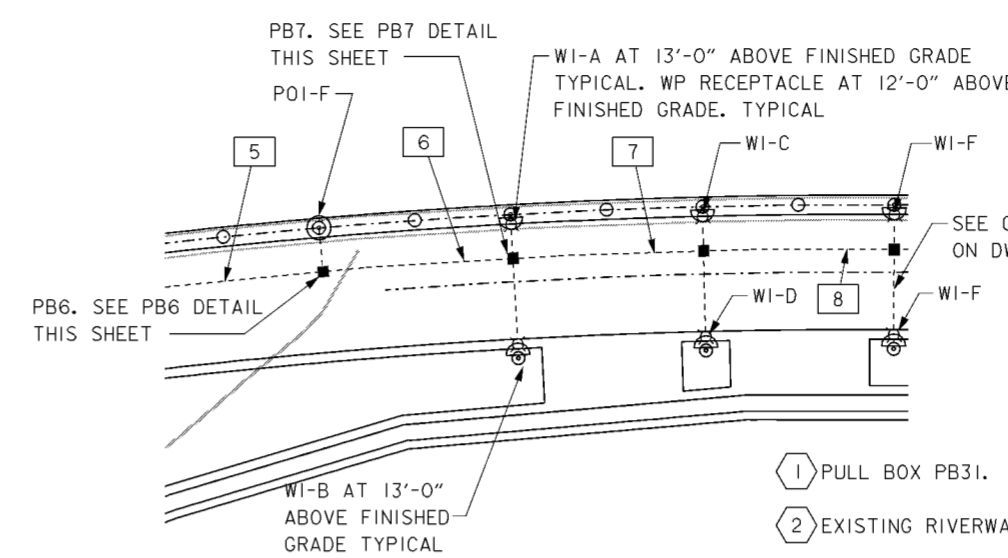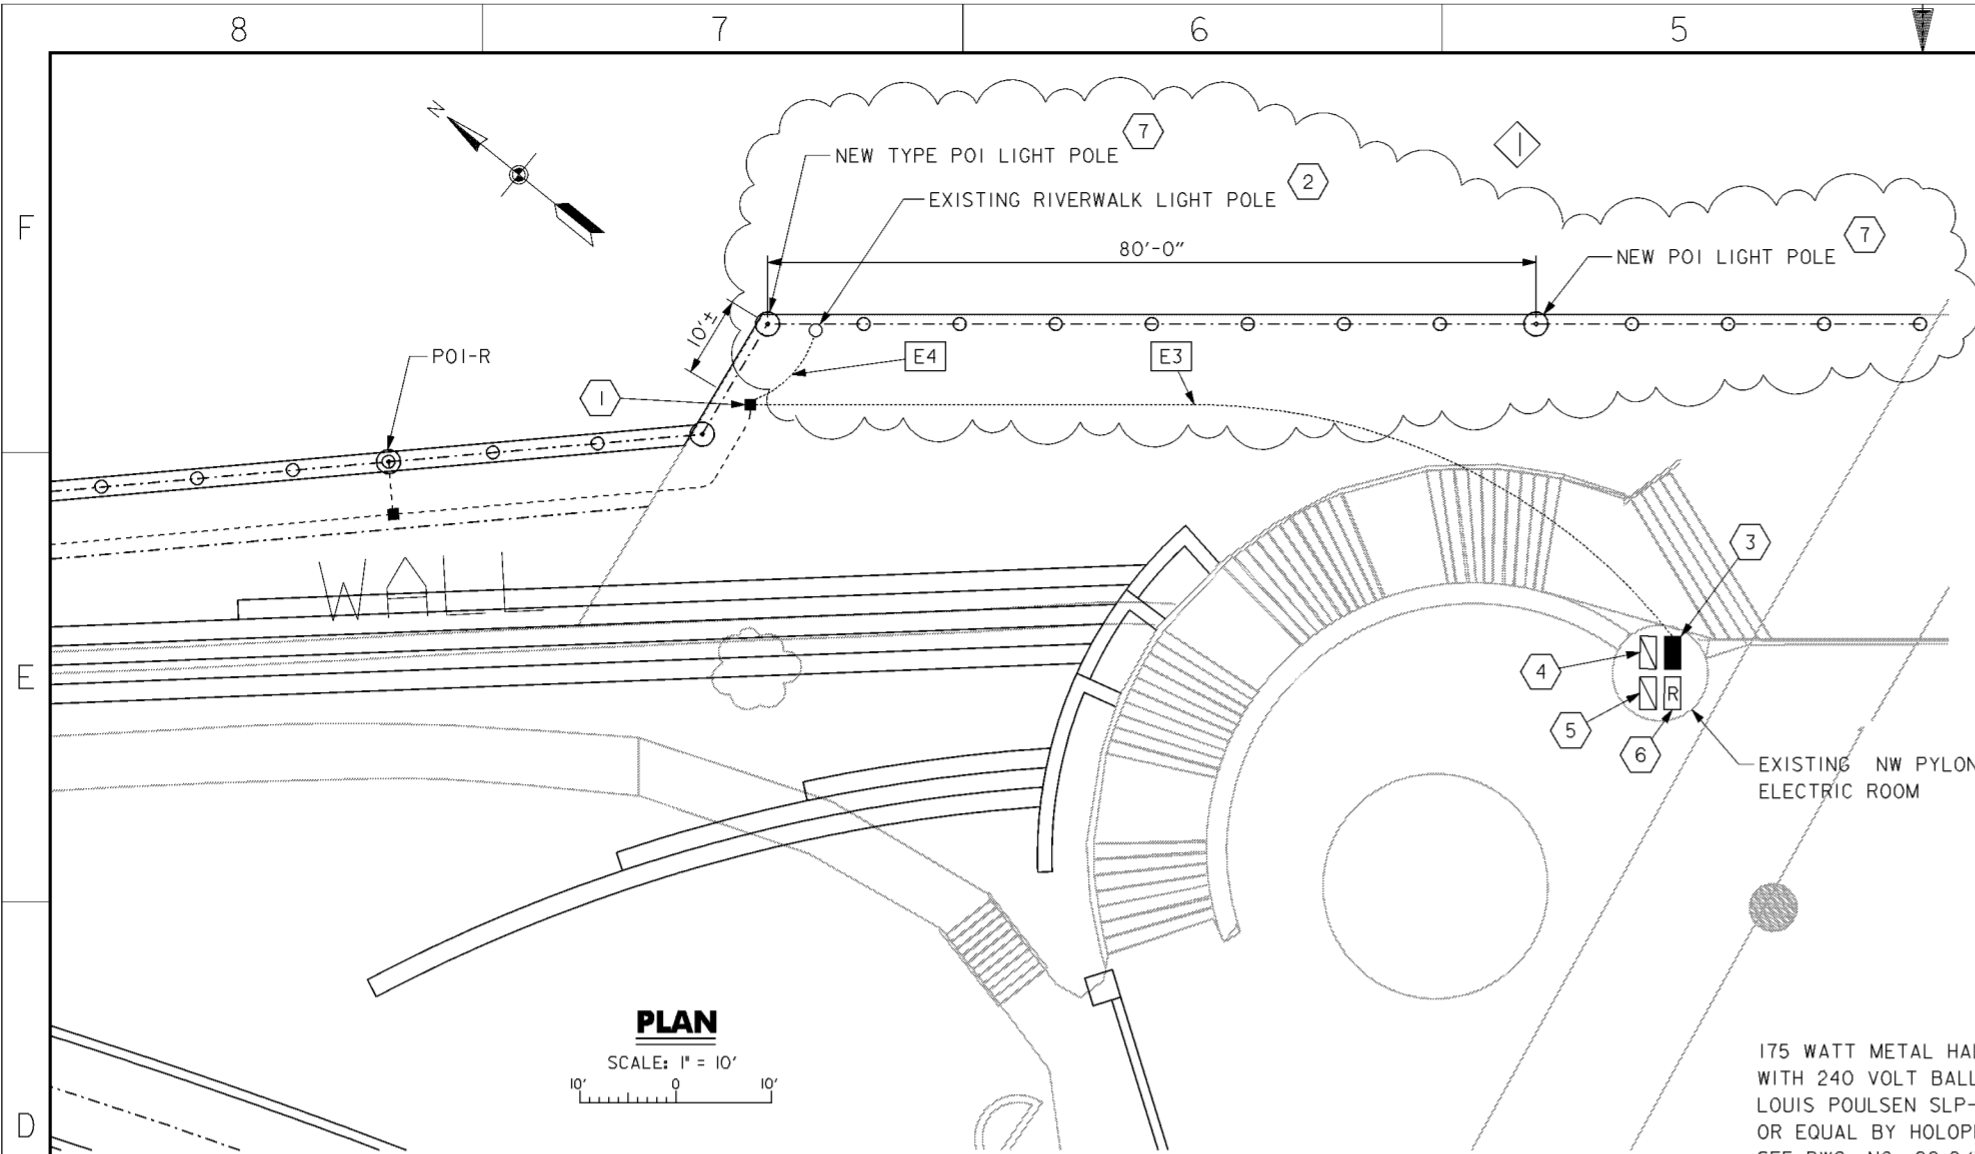

CODED NOTES

- 1 PULL BOX PB31. SEE LIGHTING PLAN ON DWG. NO.20.2/71.
- 2 EXISTING RIVERWALK LIGHTING POLE. SEE ELECTRICAL PLAN ON DWG. NO.20.2/71.
- 3 EXISTING 120/240 VOLT (V) 1-PHASE, 3-WIRE (W) PANELBOARD LPL-2 AND INTEGRAL 10 KILOVOLT-AMPERE (KVA) 480 V, 1-PHASE TO 120/240 V, 1-PHASE, 3-W DRY-TYPE TRANSFORMER. REPLACE WITH NEW POWER CENTER HAVING 100A 2-POLE (P) 480 V. PRIMARY 22,000 AMPERE INTERRUPTING CAPACITY (AIC) CIRCUIT BREAKER, A 25 KVA, 480V, 1-PHASE, 2-W, TO 120/240 V, 1-PHASE, 3-W DRY-TYPE TRANSFORMER WITH 2-5 PERCENT TAPS FULL CAPACITY BELOW NORMAL VOLTAGE, FULL LOAD TEMPERATURE RISE OF 115 DEGREE CENTIGRADE ABOVE AMBIENT, AND NEW PANELBOARD LPL-2. SEE PANELBOARD SCHEDULE ON DWG. NO. 20.2/73.
- 4 GENERAL PURPOSE, 30 AMPERE 6-POLE MECHANICALLY HELD CONTACTOR IN NEMA 1 ENCLOSURE WITH 2-WIRE CONTROL MODULE, HAND-OFF-AUTO SELECTOR SWITCH, AND 120 VOLT COIL, TO CONTROL THE THREE 20 AMPERE 240 V LIGHTING CIRCUITS. CONTACTOR TO BE ASCO BULLETIN 917 WITH ACCESSORY 48-TWO WIRE CONTROL, OR APPROVED EQUAL BY GENERAL ELECTRIC OR SQUARE D.
- 5 TUNGSTEN RATED, 20 AMPERE 8-POLE MECHANICALLY HELD LIGHTING CONTACTOR IN NEMA 1 ENCLOSURE WITH 2-WIRE CONTROL MODULE, HAND-OFF-AUTO SELECTOR SWITCH, AND 120 VOLT COIL, TO CONTROL THE SEVEN 120 V RECEPTACLE CIRCUITS (ONE POLE IS SPARE). CONTACTOR TO BE ASCO BULLETIN 917 WITH ACCESSORY 48-TWO WIRE CONTROL, OR APPROVED EQUAL BY GENERAL ELECTRIC OR SQUARE D.
- 6 DOUBLE POLE SINGLE THROW RELAY WITH MINIMUM 10 AMPERE CONTACTS AND 480 VOLT COIL IN NEMA 1 ENCLOSURE TO INTERFACE BETWEEN THE RIVERWALK LIGHTING CIRCUIT AND THE CONTACTORS OF NOTES 5 AND 6 ABOVE. RELAY TO BE ALLEN-BRADLEY BULLETIN 700, TYPE P, OR EQUAL BY GENERAL ELECTRIC OR SQUARE D.
- 7 SEE ELECTRICAL PLAN ON DWG. NO. 20.2/71.

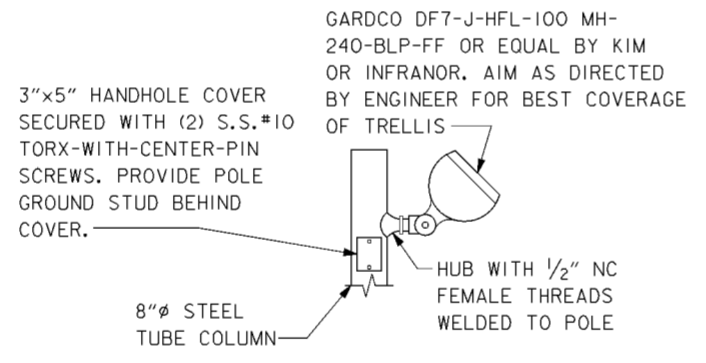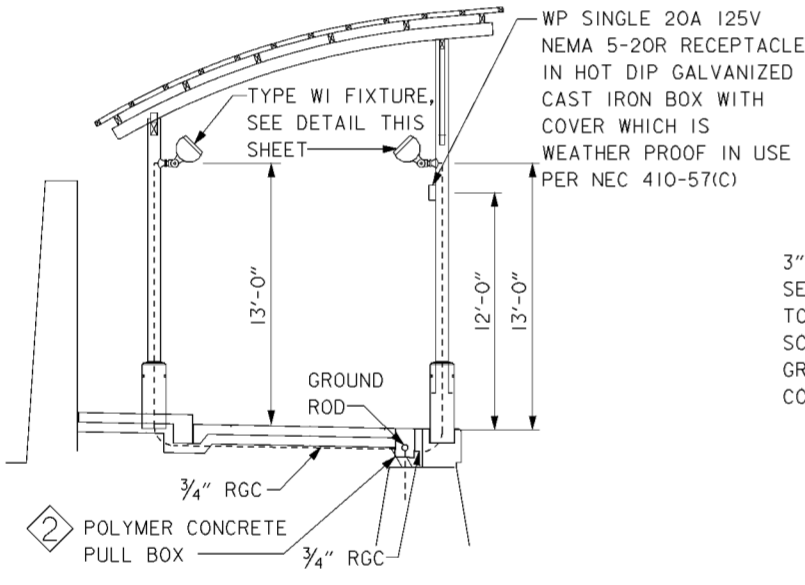





175 WATT METAL HALIDE LUMINAIRE. WITH 240 VOLT BALLAST AND 2-FUSES, LOUIS POULSEN SLP-MAX-536-GALV. OR EQUAL BY HOLOPHANE OR LUMEC. SEE DWG. NO. 20.2/74 FOR ADDITIONAL INFORMATION.

(1) SINCE 20A 125V NEMA 5-20R RECEPTACLE MOUNTED FLUSH IN POLE ON THE RIVER SIDE. PROVIDE WP COVER WHICH IS WEATHER PROOF WHEN RECEPTACLE IS IN USE. PER NEC410-57(C) RECEPTACLE TO BE ON SAME SIDE OF POLE AS HAND HOLE.

NOTE: FOR TYPE PO1 FOUNDATION DETAILS SEE DWG. NO. 20.2/74.



TYPE PO1 AND PO2 LIGHT POLE

SCALE: NONE

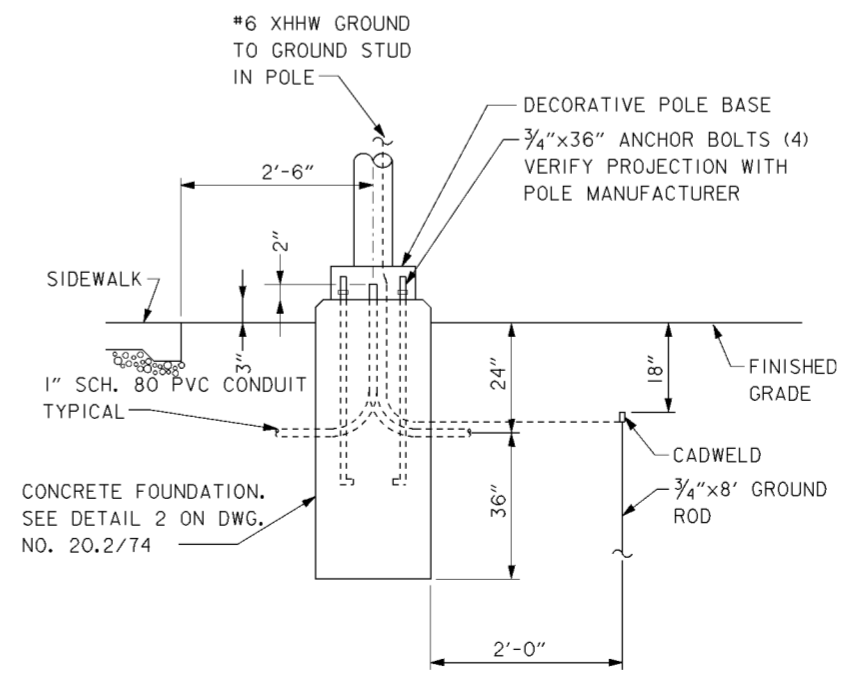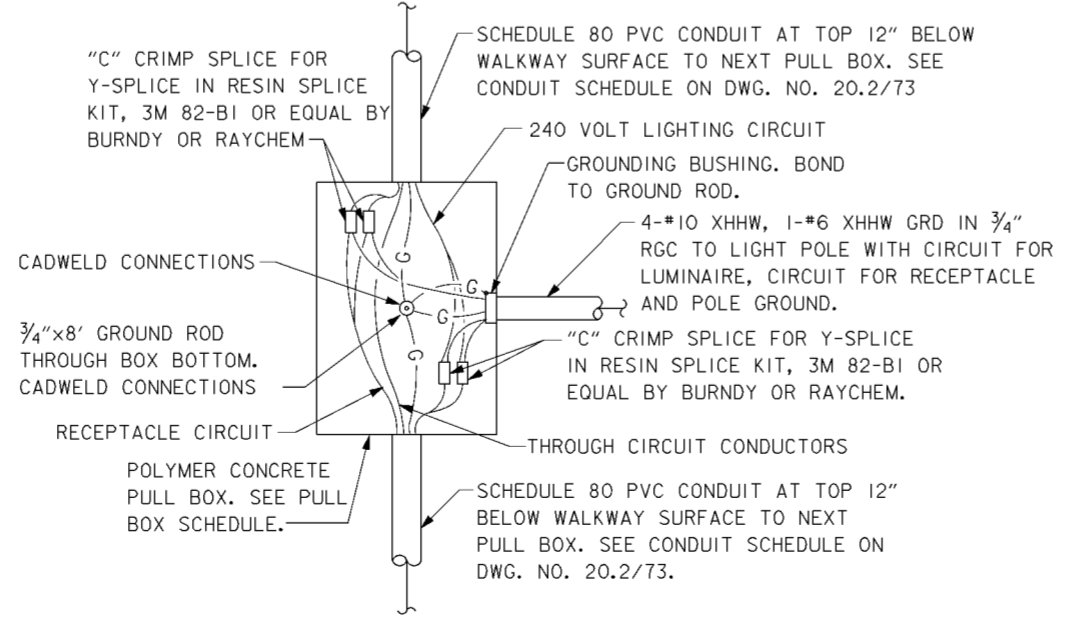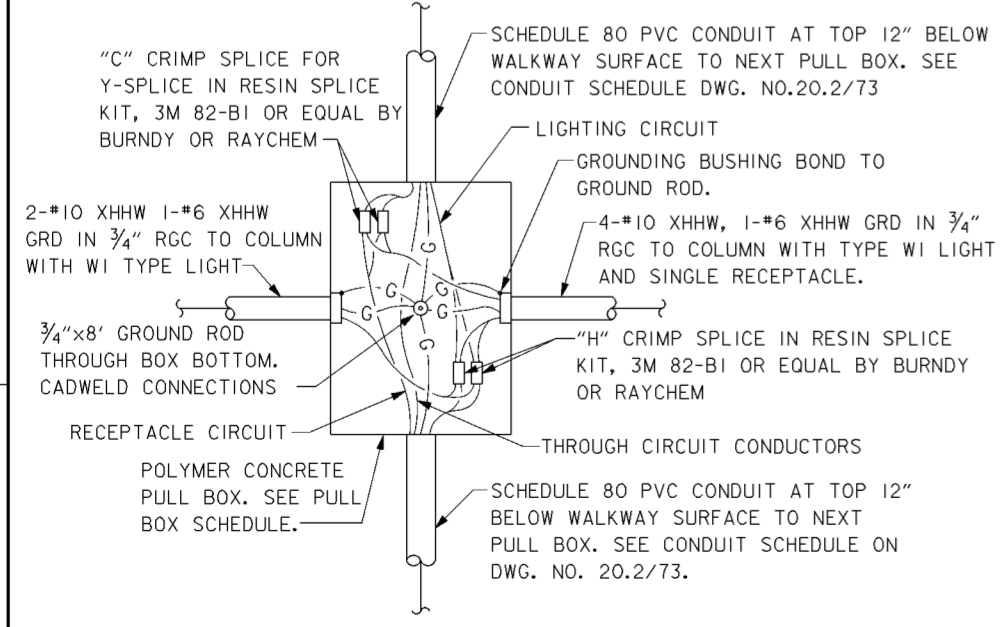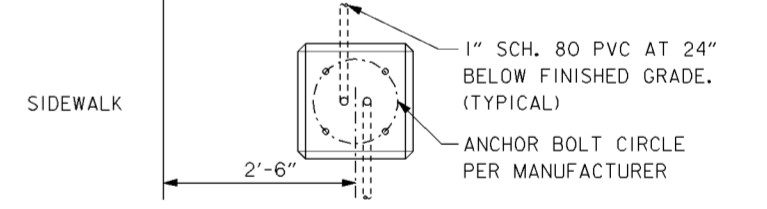

Symbol	Revisions Descriptions	Date	Approved
◊	REVISED AS CONSTRUCTED	7/02	P.O.C.
◊	REV. BY CONTRACT MODIFICATION LETTER MCO11	12/99	P.O.C.

BURGESS & NIPLE, LIMITED COLUMBUS, OHIO		U.S. ARMY ENGINEER DISTRICT CORPS OF ENGINEERS HUNTINGTON, WEST VIRGINIA	
Designed by: J. AYRES	Drawn by: A. PUMMELL	Checked by: D. SCHAMP	
Reviewed by:	AS SHOWN	Sheet reference number:	FILENAME: a0u5ed01.dgn
Approved by:	MARCH 1998	20.2/72	Sheet 1 of 2

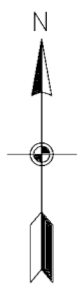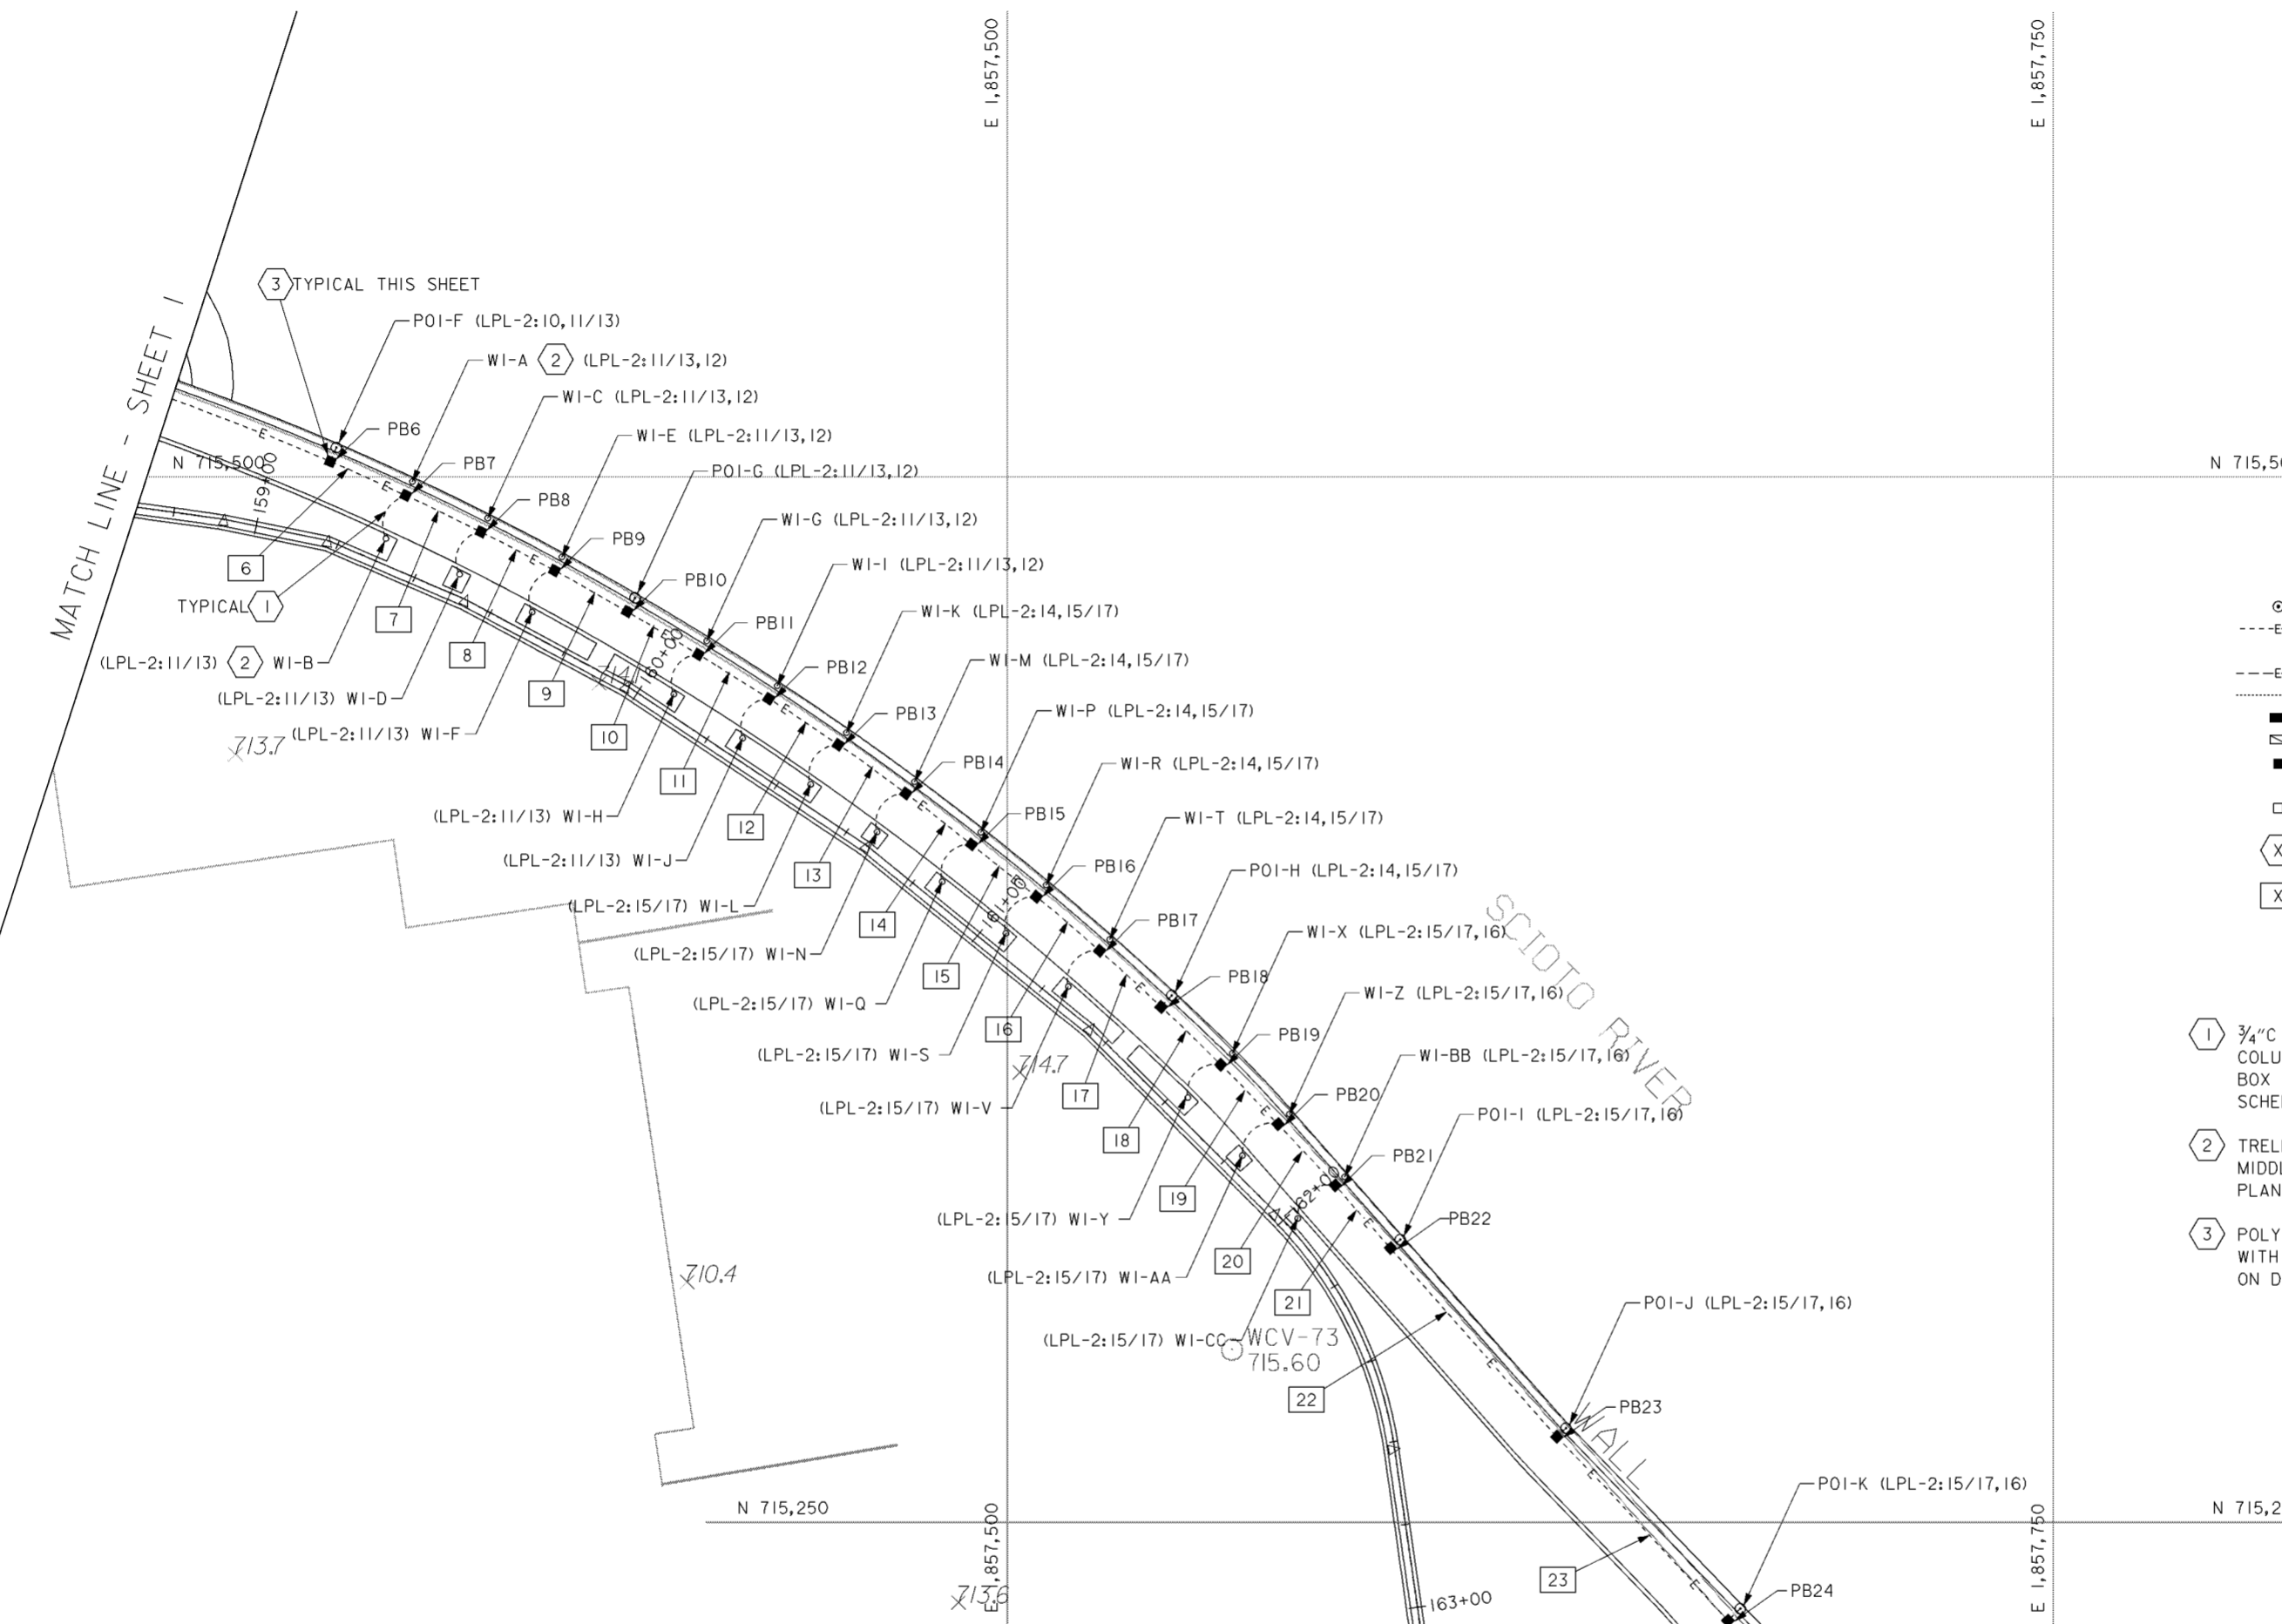


LEGEND

- ⊙ LIGHT POLE, SEE DETAILS ON DWG. NO. 20.2/72.
- E--- SCHEDULE 80 PVC CONDUIT 12" BELOW FINISHED WALKWAY SURFACE.
- E--- SCHEDULE 80 PVC CONDUIT 24" BELOW FINISHED GRADE
- EXISTING STEEL CONDUIT
- PANELBOARD
- ▣ LIGHTING CONTACTOR
- ▢ PULL BOX, SEE PULL BOX DETAIL PB6 AND PB7 ON DWG. NO. 20.2/72
- EMPTY PULL BOX, SEE EMPTY PULL BOX SECTION ON DWG. NO. 20.2/73
- ⊗ CODED NOTE REFERENCE
- ⊗ CONDUIT NUMBER FLAG, SEE CONDUIT AND WIRE SCHEDULE ON DWG. NO. 20.2/73

CODED NOTES

- ① 3/4" C WITH TWO NO. 10, ONE NO. 6 GROUND TO TYPE WI UP LIGHT ON WEST SIDE COLUMN. CONNECT TO 240 V LIGHT CIRCUIT WITH SUBMERSIBLE H SPLICE IN PULL BOX IN WALKWAY. SEE PARTIAL TRELLIS PLAN ON DWG. NO. 20.2/72 AND PULL BOX SCHEDULE ON DWG. NO. 20.2/73.
- ② TRELLIS SUPPORT COLUMN WITH TYPE WI UP-LIGHT AIMED TO LIGHT TRELLIS TO MIDDLE OF SPACE BETWEEN EAST AND WEST FLOODWALL. SEE PARTIAL TRELLIS PLAN ON DWG. NO. 20.2/72.
- ③ POLYMER CONCRETE PULL BOX WITH BOTTOM. BOX TO BE SET FLUSH IN WALKWAY WITH NO PROJECTIONS TO CREATE TRIPPING HAZARDS. SEE PULL BOX SCHEDULE ON DWG. NO. 20.2/73, AND CODED NOTE 2 ON DWG. NO. 20.2/69.


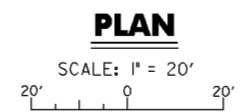


Revisions			
Symbol	Descriptions	Date	Approved

BURGESS & NIPLE, LIMITED COLUMBUS, OHIO	U.S. ARMY ENGINEER DISTRICT CORPS OF ENGINEERS HUNTINGTON, WEST VIRGINIA	SCIOTO RIVER COLUMBUS, OHIO WEST COLUMBUS, L.P.P. PHASE IID		
		ELECTRICAL PLAN (2 OF 3)		
Designed by: J.AYRES		Drawn by: A.PUMMELL	FILENAME: 00uSep02.dgn PEN TABLE:	
Checked by: D.SCHAMP				
Reviewed by:		Scale: AS SHOWN		Sheet reference number: 20.2/70
Approved by:		Date: MARCH 1998		Drawing Code: 16-PWC-10-
		Sheet 2 of 3		

WORK AS CONSTRUCTED

MATCH LINE - SHEET 2

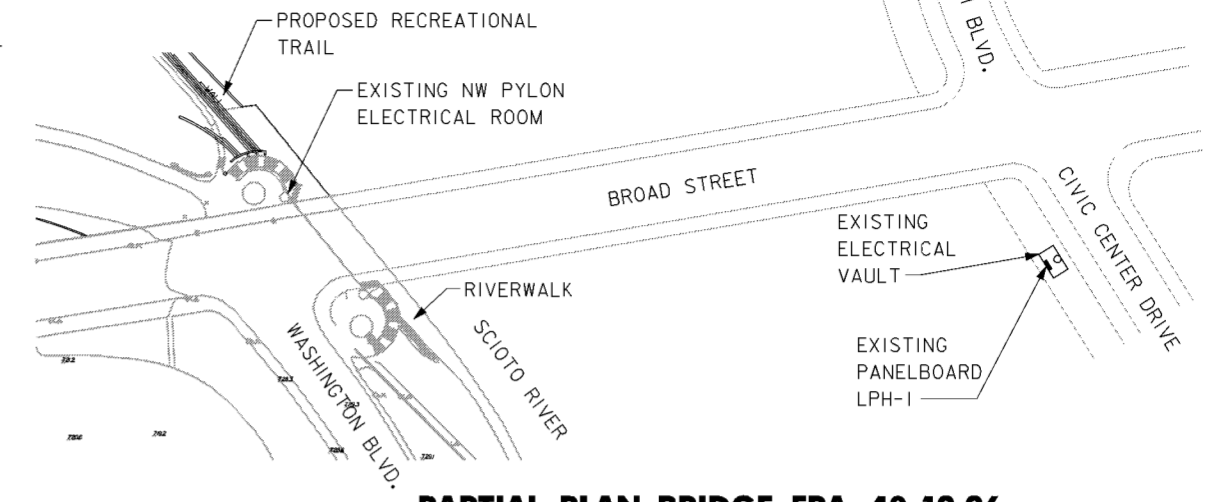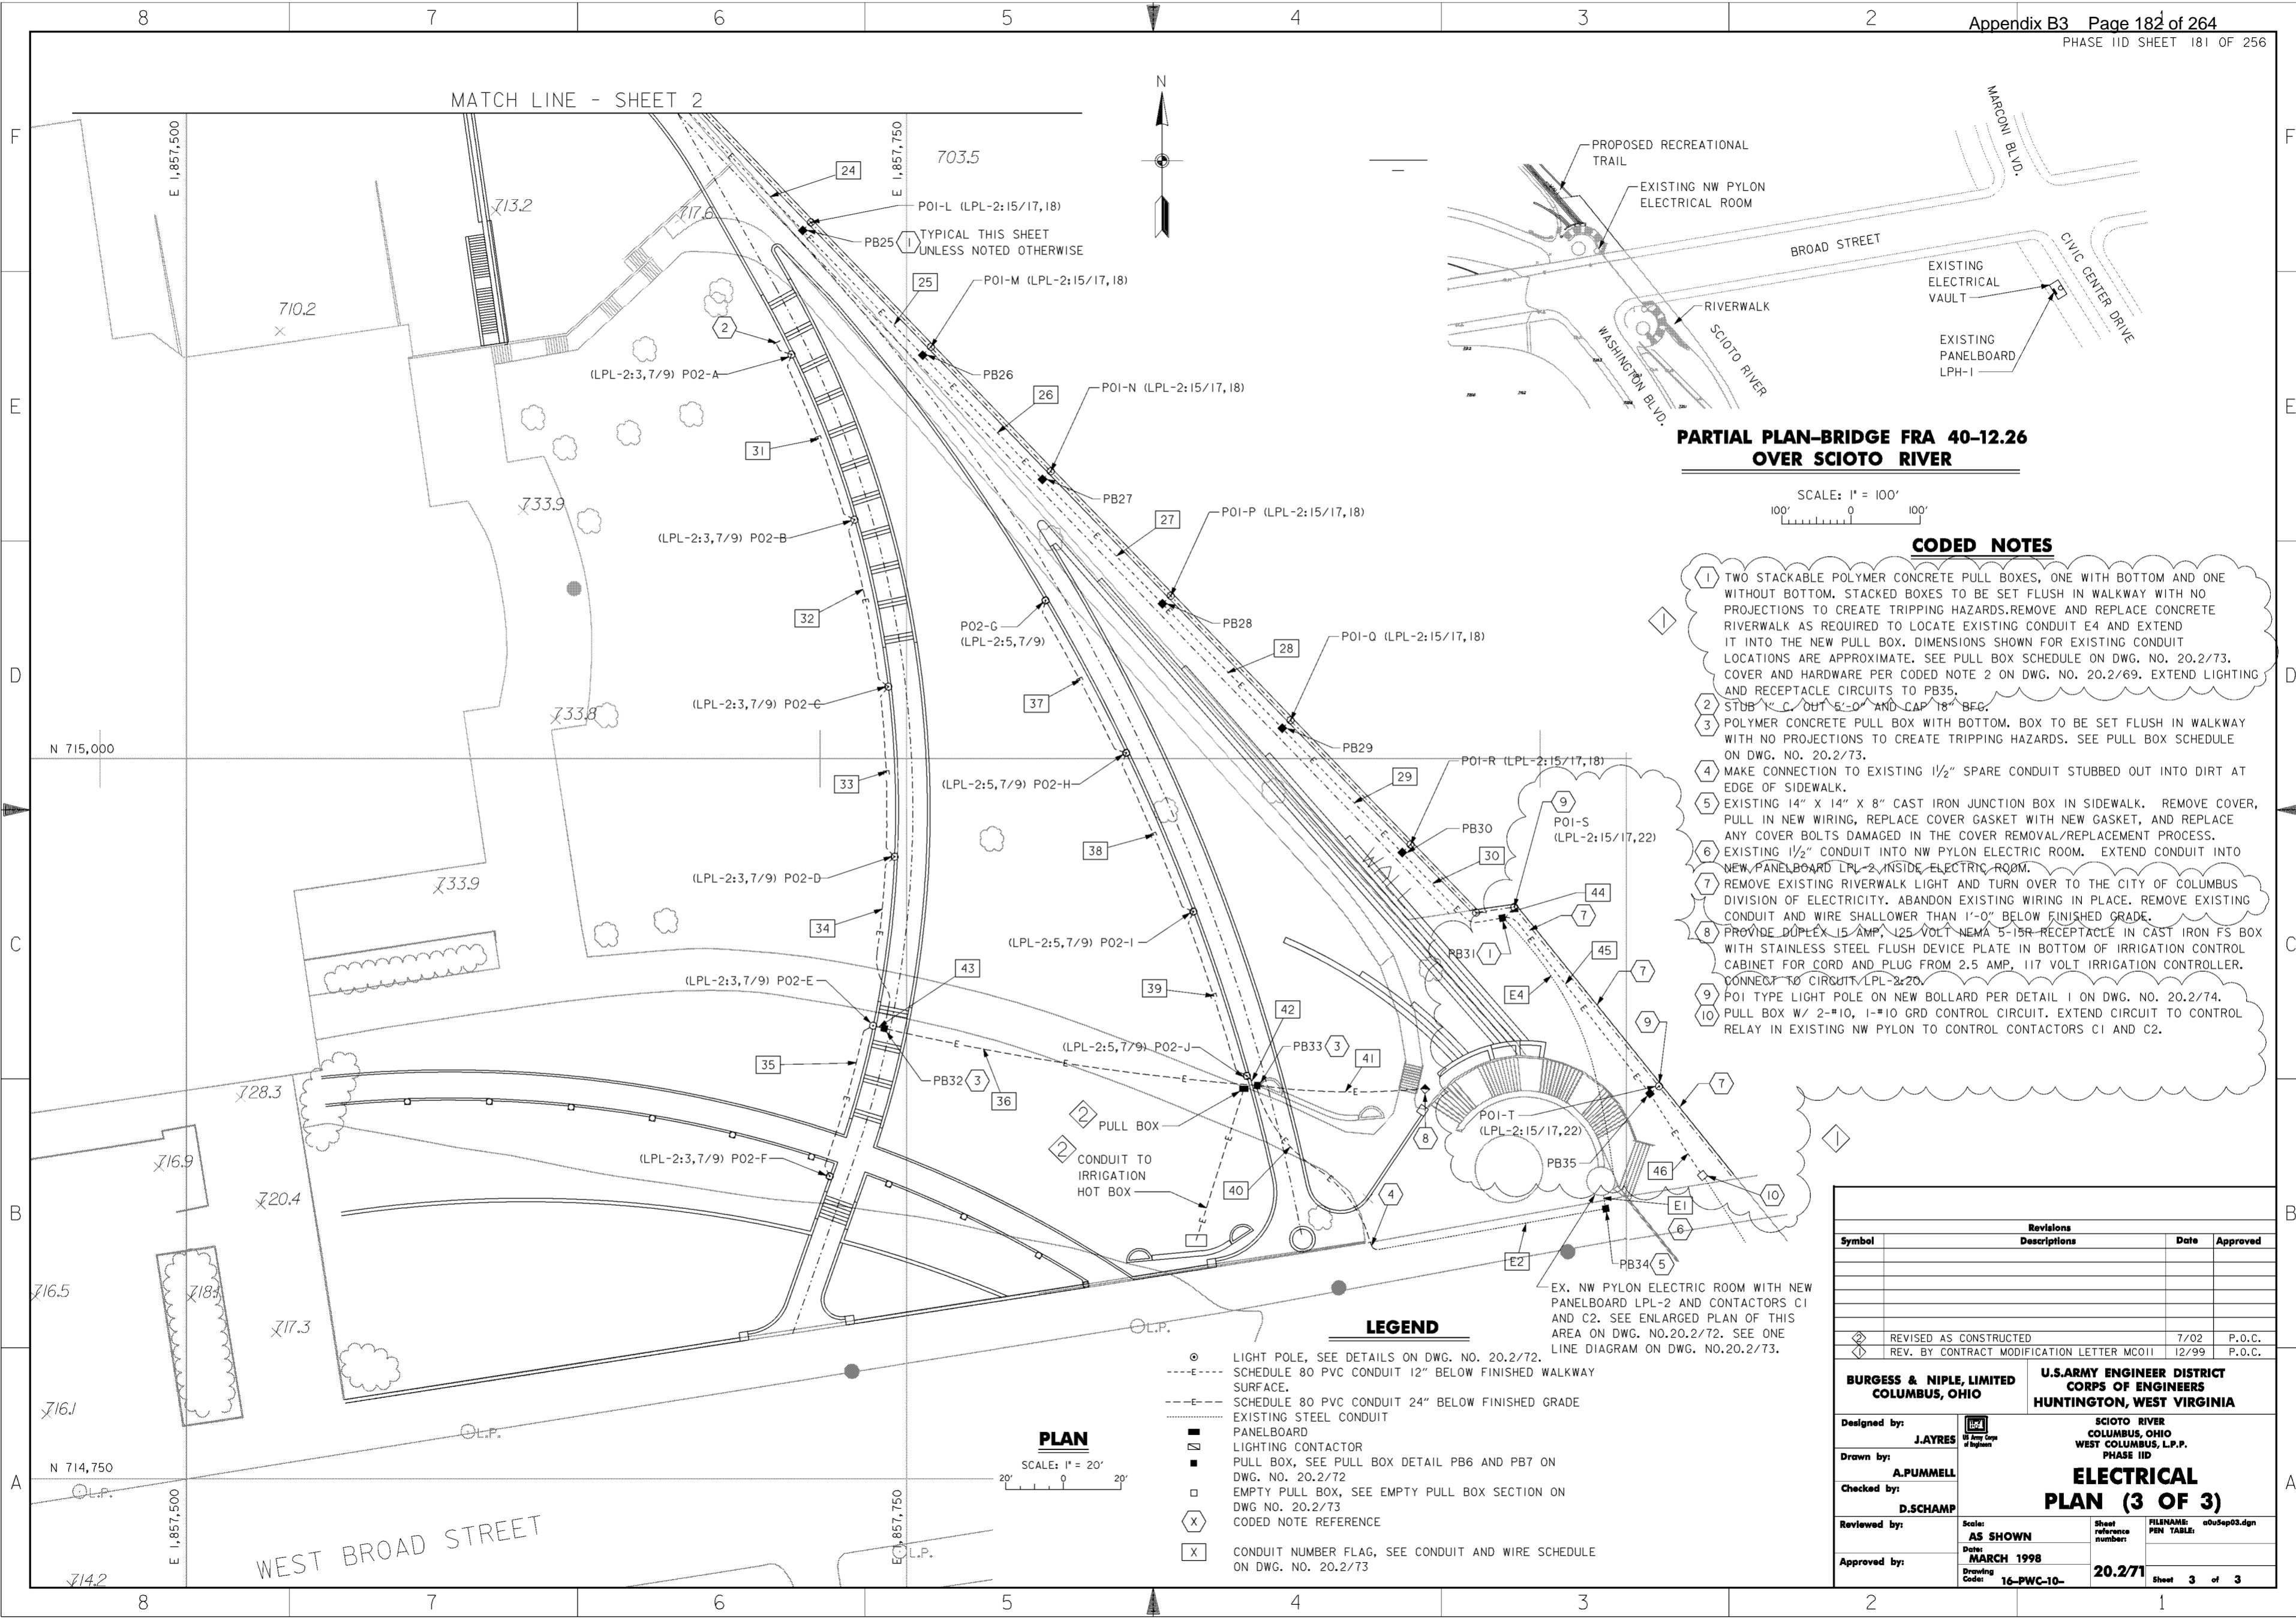

**PARTIAL PLAN-BRIDGE FRA 40-12.26
 OVER SCIOTO RIVER**

SCALE: 1" = 100'
 100' 0 100'

CODED NOTES

- 1 TWO STACKABLE POLYMER CONCRETE PULL BOXES, ONE WITH BOTTOM AND ONE WITHOUT BOTTOM. STACKED BOXES TO BE SET FLUSH IN WALKWAY WITH NO PROJECTIONS TO CREATE TRIPPING HAZARDS. REMOVE AND REPLACE CONCRETE RIVERWALK AS REQUIRED TO LOCATE EXISTING CONDUIT E4 AND EXTEND IT INTO THE NEW PULL BOX. DIMENSIONS SHOWN FOR EXISTING CONDUIT LOCATIONS ARE APPROXIMATE. SEE PULL BOX SCHEDULE ON DWG. NO. 20.2/73. COVER AND HARDWARE PER CODED NOTE 2 ON DWG. NO. 20.2/69. EXTEND LIGHTING AND RECEPTACLE CIRCUITS TO PB35.
- 2 STUB 1" C. OUT 5'-0" AND CAP 18" BEG.
- 3 POLYMER CONCRETE PULL BOX WITH BOTTOM. BOX TO BE SET FLUSH IN WALKWAY WITH NO PROJECTIONS TO CREATE TRIPPING HAZARDS. SEE PULL BOX SCHEDULE ON DWG. NO. 20.2/73.
- 4 MAKE CONNECTION TO EXISTING 1/2" SPARE CONDUIT STUBBED OUT INTO DIRT AT EDGE OF SIDEWALK.
- 5 EXISTING 14" X 14" X 8" CAST IRON JUNCTION BOX IN SIDEWALK. REMOVE COVER, PULL IN NEW WIRING, REPLACE COVER GASKET WITH NEW GASKET, AND REPLACE ANY COVER BOLTS DAMAGED IN THE COVER REMOVAL/REPLACEMENT PROCESS.
- 6 EXISTING 1/2" CONDUIT INTO NW PYLON ELECTRIC ROOM. EXTEND CONDUIT INTO NEW PANELBOARD LPL-2 INSIDE ELECTRIC ROOM.
- 7 REMOVE EXISTING RIVERWALK LIGHT AND TURN OVER TO THE CITY OF COLUMBUS DIVISION OF ELECTRICITY. ABANDON EXISTING WIRING IN PLACE. REMOVE EXISTING CONDUIT AND WIRE SHALLower THAN 1'-0" BELOW FINISHED GRADE.
- 8 PROVIDE DUPLEX 15 AMP, 125 VOLT NEMA 5-15R RECEPTACLE IN CAST IRON FS BOX WITH STAINLESS STEEL FLUSH DEVICE PLATE IN BOTTOM OF IRRIGATION CONTROL CABINET FOR CORD AND PLUG FROM 2.5 AMP, 117 VOLT IRRIGATION CONTROLLER. CONNECT TO CIRCUIT LPL-2-20.
- 9 P01 TYPE LIGHT POLE ON NEW BOLLARD PER DETAIL 1 ON DWG. NO. 20.2/74.
- 10 PULL BOX W/ 2-#10, 1-#10 GRD CONTROL CIRCUIT. EXTEND CIRCUIT TO CONTROL RELAY IN EXISTING NW PYLON TO CONTROL CONTACTORS C1 AND C2.

LEGEND


- LIGHT POLE, SEE DETAILS ON DWG. NO. 20.2/72.
- E--- SCHEDULE 80 PVC CONDUIT 12" BELOW FINISHED WALKWAY SURFACE.
- E--- SCHEDULE 80 PVC CONDUIT 24" BELOW FINISHED GRADE
- E--- EXISTING STEEL CONDUIT
- PANELBOARD
- LIGHTING CONTACTOR
- PULL BOX, SEE PULL BOX DETAIL PB6 AND PB7 ON DWG. NO. 20.2/72
- EMPTY PULL BOX, SEE EMPTY PULL BOX SECTION ON DWG. NO. 20.2/73
- (X) CODED NOTE REFERENCE
- (X) CONDUIT NUMBER FLAG, SEE CONDUIT AND WIRE SCHEDULE ON DWG. NO. 20.2/73

PLAN
 SCALE: 1" = 20'
 20' 0 20'

Revisions			
Symbol	Descriptions	Date	Approved
◇	REVISED AS CONSTRUCTED	7/02	P.O.C.
◇	REV. BY CONTRACT MODIFICATION LETTER MCO11	12/99	P.O.C.

BURGESS & NIPLE, LIMITED COLUMBUS, OHIO		U.S. ARMY ENGINEER DISTRICT CORPS OF ENGINEERS HUNTINGTON, WEST VIRGINIA	
Designed by: J. AYRES		SCIOTO RIVER COLUMBUS, OHIO WEST COLUMBUS, L.P.P. PHASE IID ELECTRICAL PLAN (3 OF 3)	
Drawn by: A. PUMMELL			
Checked by: D. SCHAMP		Scale: AS SHOWN	Sheet reference number: 20.2/71
Reviewed by:		Date: MARCH 1998	FILENAME: a05Sep03.dgn
Approved by:		Drawing Code: 16-PWC-10-	Sheet 3 of 3

WORK AS CONSTRUCTED

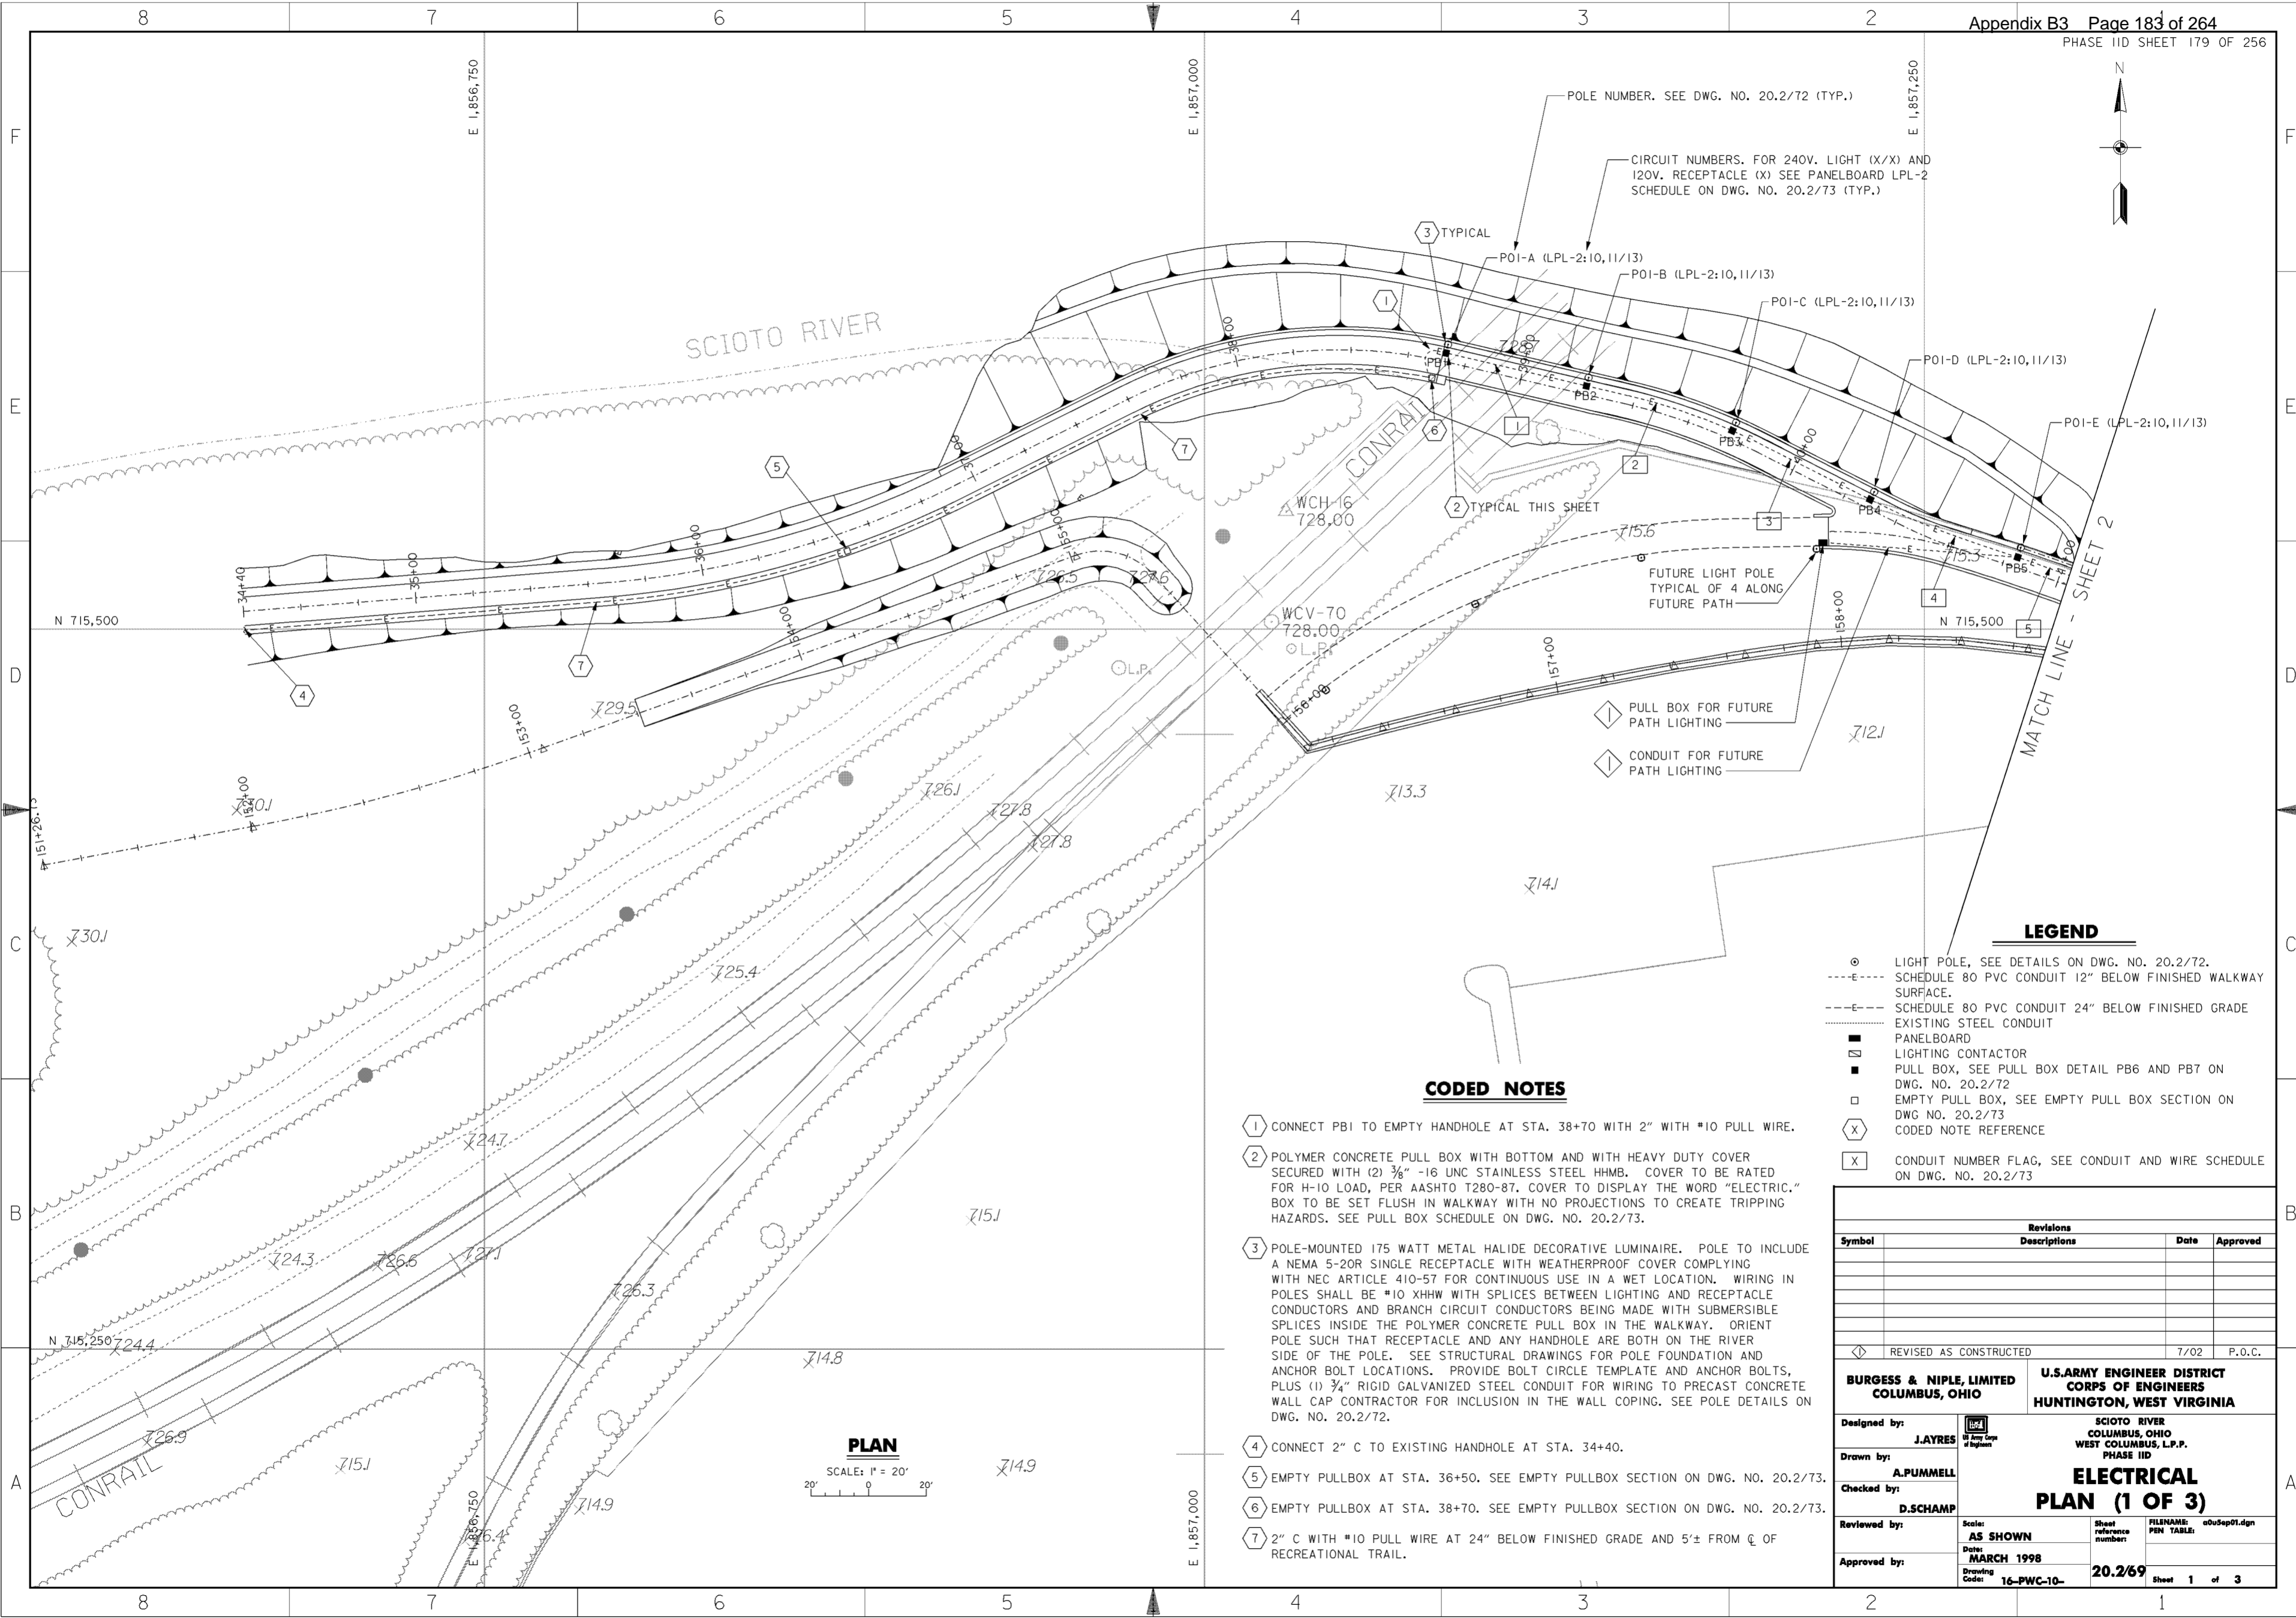

POLE NUMBER. SEE DWG. NO. 20.2/72 (TYP.)

CIRCUIT NUMBERS. FOR 240V. LIGHT (X/X) AND 120V. RECEPTACLE (X) SEE PANELBOARD LPL-2 SCHEDULE ON DWG. NO. 20.2/73 (TYP.)

P01-A (LPL-2:10,11/13)

P01-B (LPL-2:10,11/13)

P01-C (LPL-2:10,11/13)

P01-D (LPL-2:10,11/13)

P01-E (LPL-2:10,11/13)

FUTURE LIGHT POLE TYPICAL OF 4 ALONG FUTURE PATH

PULL BOX FOR FUTURE PATH LIGHTING

CONDUIT FOR FUTURE PATH LIGHTING

LEGEND

- ⊙ LIGHT POLE, SEE DETAILS ON DWG. NO. 20.2/72.
- E--- SCHEDULE 80 PVC CONDUIT 12" BELOW FINISHED WALKWAY SURFACE.
- E--- SCHEDULE 80 PVC CONDUIT 24" BELOW FINISHED GRADE
- E--- EXISTING STEEL CONDUIT
- PANELBOARD
- LIGHTING CONTACTOR
- ▣ PULL BOX, SEE PULL BOX DETAIL PB6 AND PB7 ON DWG. NO. 20.2/72
- EMPTY PULL BOX, SEE EMPTY PULL BOX SECTION ON DWG. NO. 20.2/73
- ⊗ CODED NOTE REFERENCE
- ⊗ CONDUIT NUMBER FLAG, SEE CONDUIT AND WIRE SCHEDULE ON DWG. NO. 20.2/73

CODED NOTES

- ① CONNECT PB1 TO EMPTY HANDHOLE AT STA. 38+70 WITH 2" WITH #10 PULL WIRE.
- ② POLYMER CONCRETE PULL BOX WITH BOTTOM AND WITH HEAVY DUTY COVER SECURED WITH (2) 3/8" -16 UNC STAINLESS STEEL HHMB. COVER TO BE RATED FOR H-10 LOAD, PER AASHTO T280-87. COVER TO DISPLAY THE WORD "ELECTRIC." BOX TO BE SET FLUSH IN WALKWAY WITH NO PROJECTIONS TO CREATE TRIPPING HAZARDS. SEE PULL BOX SCHEDULE ON DWG. NO. 20.2/73.
- ③ POLE-MOUNTED 175 WATT METAL HALIDE DECORATIVE LUMINAIRE. POLE TO INCLUDE A NEMA 5-20R SINGLE RECEPTACLE WITH WEATHERPROOF COVER COMPLYING WITH NEC ARTICLE 410-57 FOR CONTINUOUS USE IN A WET LOCATION. WIRING IN POLES SHALL BE #10 XHHW WITH SPLICES BETWEEN LIGHTING AND RECEPTACLE CONDUCTORS AND BRANCH CIRCUIT CONDUCTORS BEING MADE WITH SUBMERSIBLE SPLICES INSIDE THE POLYMER CONCRETE PULL BOX IN THE WALKWAY. ORIENT POLE SUCH THAT RECEPTACLE AND ANY HANDHOLE ARE BOTH ON THE RIVER SIDE OF THE POLE. SEE STRUCTURAL DRAWINGS FOR POLE FOUNDATION AND ANCHOR BOLT LOCATIONS. PROVIDE BOLT CIRCLE TEMPLATE AND ANCHOR BOLTS, PLUS (1) 3/4" RIGID GALVANIZED STEEL CONDUIT FOR WIRING TO PRECAST CONCRETE WALL CAP CONTRACTOR FOR INCLUSION IN THE WALL COPING. SEE POLE DETAILS ON DWG. NO. 20.2/72.
- ④ CONNECT 2" C TO EXISTING HANDHOLE AT STA. 34+40.
- ⑤ EMPTY PULLBOX AT STA. 36+50. SEE EMPTY PULLBOX SECTION ON DWG. NO. 20.2/73.
- ⑥ EMPTY PULLBOX AT STA. 38+70. SEE EMPTY PULLBOX SECTION ON DWG. NO. 20.2/73.
- ⑦ 2" C WITH #10 PULL WIRE AT 24" BELOW FINISHED GRADE AND 5± FROM C OF RECREATIONAL TRAIL.

PLAN
SCALE: 1" = 20'

Revisions			
Symbol	Descriptions	Date	Approved
◁	REVISED AS CONSTRUCTED	7/02	P.O.C.

BURGESS & NIPLE, LIMITED COLUMBUS, OHIO		U.S. ARMY ENGINEER DISTRICT CORPS OF ENGINEERS HUNTINGTON, WEST VIRGINIA	
Designed by: J. AYRES	Drawn by: A. PUMMELL	SCIOTO RIVER COLUMBUS, OHIO WEST COLUMBUS, L.P.P. PHASE IID ELECTRICAL PLAN (1 OF 3)	
Checked by: D. SCHAMP	Reviewed by:	Scale: AS SHOWN	Sheet reference number: 20.2/69
Approved by:	Date: MARCH 1998	FILENAME: a05Sep01.dgn	PIN TABLE:
Drawing Code: 16-PWC-10-		Sheet 1 of 3	

WORK AS CONSTRUCTED

CONDUIT AND WIRE SCHEDULE							
SCH. 80 PVC CONDUIT	NUMBER OF CIRCUIT CONDUCTORS BY AWG SIZE				GRD WIRE AWG SIZE	CIRCUIT NUMBERS LPL-2:	
	10	8	6	4			
1	1 1/2"			2	2	2	10, 11/13
2	1 1/2"			2	2	2	10, 11/13
3	1 1/2"			2	2	2	10, 11/13
4	1 1/2"			2	2	2	10, 11/13
5	1 1/2"			2	2	2	10, 11/13
6	1 1/2"			2	2	2	10, 11/13
7	1 1/2"			4	2	2	10, 11/13, 12
8	1 1/2"			4	2	2	10, 11/13, 12
9	1 1/2"			4	2	2	10, 11/13, 12
10	1 1/2"			4	2	2	10, 11/13, 12
11	1 1/2"			4	2	2	10, 11/13, 12
12	1 1/2"			4	2	2	10, 11/13, 12
13	2"			8	2	2	10, 11/13, 12, 14, 15/17
14	2"			8	2	2	10, 11/13, 12, 14, 15/17
15	2"			8	2	2	10, 11/13, 12, 14, 15/17
16	2"			8	2	2	10, 11/13, 12, 14, 15/17
17	2"			8	2	2	10, 11/13, 12, 14, 15/17
18	2"			8	2	2	10, 11/13, 12, 14, 15/17
19	3"			10	2	2	10, 11/13, 12, 14, 15/17, 16
20	3"			10	2	2	10, 11/13, 12, 14, 15/17, 16
21	3"			10	2	2	10, 11/13, 12, 14, 15/17, 16
22	3"			10	2	2	10, 11/13, 12, 14, 15/17, 16
23	3"			10	2	2	10, 11/13, 12, 14, 15/17, 16
24	3"			10	2	2	10, 11/13, 12, 14, 15/17, 16
25	3"			2	10	2	10, 11/13, 12, 14, 15/17, 16, 18
26	3"			2	10	2	10, 11/13, 12, 14, 15/17, 16, 18
27	3"			2	10	2	10, 11/13, 12, 14, 15/17, 16, 18
28	3"			2	10	2	10, 11/13, 12, 14, 15/17, 16, 18

CONDUIT AND WIRE SCHEDULE							
SCH. 80 PVC CONDUIT	NUMBER OF CIRCUIT CONDUCTORS BY AWG SIZE				GRD WIRE AWG SIZE	CIRCUIT NUMBERS LPL-2:	
	10	8	6	4			
29	3"			2	10	2	10, 11/13, 12, 14, 15/17, 16, 18
30	3"			2	10	2	10, 11/13, 12, 14, 15/17, 16, 18
31	1"	2				6	3, 7/9
32	1"	2				6	3, 7/9
33	1"	2				6	3, 7/9
34	1"	2				6	3, 7/9
35	1"	2				6	3, 7/9
36	1"	2				6	3, 7/9
37	1"	4				10	5, 7/9
38	1"	4				10	5, 7/9
39	1"	4				10	5, 7/9
40	2"	6		2		6	3, 5, 7/9, 20
41	1"	2				10	20
42	1"	4				10	5, 7/9
43	1"	2				6	3, 7/9
44	1"	4				10	15/17, 22
45	1"	4				10	15/17, 22
46	1"	2				10	CONTROL


CONDUIT AND WIRE SCHEDULE							
EXISTING STEEL CONDUIT	NUMBER OF CIRCUIT CONDUCTORS BY AWG SIZE				GRD WIRE AWG SIZE	CIRCUIT NUMBERS LPL-2:	
	10	8	6	4			
E1	1 1/2"	6		2		6	3, 5, 7/9, 20
E2	1 1/2"	6		2		6	3, 5, 7/9, 20
E3	2"	4		2	10	2	10, 11/13, 12, 14, 15/17, 16, 18, 22 CONTROL
E4	1 1/2"	2				10	CONTROL CIRCUIT FROM RIVER WALK

PULL BOX SCHEDULE						
PULL BOX NO.	N=NEW E=EXISTING	INSIDE DIMENSIONS	BOX TYPE PC=POLYMER CONC. CI=CAST IRON	GROUND ROD	NO. SPLICE BY TYPE	
					Y	H
1	N	10 1/2" x 17 1/2" x 17 1/4"	PC*	3/4" x 8'	4	
2	N	10 1/2" x 17 1/2" x 17 1/4"	PC*	3/4" x 8'	4	
3	N	10 1/2" x 17 1/2" x 17 1/4"	PC*	3/4" x 8'	4	
18	N	11 3/4" x 21 1/4" x 17 1/4"	PC*	3/4" x 8'	4	
19	N	11 3/4" x 21 1/4" x 17 1/4"	PC*	3/4" x 8'	4	
31	N	(2) 13" x 24" x 11 3/4" **	PC*	3/4" x 8'	2	2
32	N	12" x 12" x 13 3/4"	PC*	3/4" x 8'	NONE	
33	N	12" x 12" x 13 3/4"	PC*	3/4" x 8'	2	
34	N	14" x 14" x 8"	CI	NONE	NONE	
35	N	10 1/2" x 17 1/2" x 17 1/4"	PC*	3/4" x 8'	NONE	


* REFER TO CODED NOTES ON ELECTRICAL PLAN SHEETS AND TO SPECIFICATIONS FOR POLYMER CONCRETE PULL BOXES. ALSO SEE SPECIFICATIONS FOR REQUIRED CONCRETE FINISHING RING IN ASPHALT PAVEMENT AND TREATMENT OF CONCRETE SIDEWALK AT PULL BOXES.

**TWO PULL BOXES STACKED TO FORM 23 1/2" DEEP PULL BOX. BOTTOM BOX TO HAVE SOLID BOTTOM; TOP BOX TO HAVE NO BOTTOM.


NEW PANELBOARD LPL-2 SCHEDULE											
120/240V, 1Ø, 3-W, 225 AMP BUS					PANEL LOADING SCHEDULE						
125 AMP MAIN: CB (X) SW () LUGS ()					CONNECTED			DEMAND			
FEED THRU LUGS ()					PHASE	A	B	TOTAL			
SURFACE (X) FLUSH () COLUMN TYPE ()					AMPS	84.8	75.7	---	80.25		
ENCLOSURE: NEMA 1 () 3R(X) 12 () 4(X) ()					KVA	10.18	9.08	19.26	19.26		
CIRCUIT DESCRIPTION		LOAD AMPS	BKR./POLES	CKT. NO.	BKR./POLES	LOAD AMPS	CIRCUIT DESCRIPTION				
EX. NW PYLON LIGHT AND RECEPT		2.3	20/1	1	2	20/1	3.3	EXIST. RECEPTACLE AT RIVERWALK			
RECEPTACLE P02-A THRU P02-E		7.5	20/1	3	4	20/1	3.3	EXIST. RECEPTACLE AT RIVERWALK			
RECEPTACLE P02-F THRU P02-I		7.5	20/1	5	6	20/1	3.3	EXIST. RECEPTACLE AT RIVERWALK			
IGHTS P02-A THRU P02-J		9.0	20/2	7	8	20/1	3.3	EXIST. RECEPTACLE AT RIVERWALK			
		9.0		9	10	20/1	9.0	RECEPTACLE POI-A THRU POI-F			
LIGHTS. POI-A THRU WI-J		11.3	20/2	11	12	20/1	9.0	RECEPTACLE WI-A THRU WI-I			
		11.3		13	14	20/1	9.0	RECEPTACLE WI-K THRU POI-H			
LIGHTS. WI-K THRU POI-T		18.8	30/2	15	16	20/1	9.0	RECEPTACLE WI-X THRU POI-K			
		18.8		17	18	20/1	12.0	RECEPTACLE POI-L THRU POI-T			
LIGHTING CONTACTOR CONTROL		2.0	20/1	19	20	15/1	2.5	IRRIGATION CONTROLLER			
HOT BOX REC.		-	20/1	21	22	20/1	-	SPARE			
SPARE		-	20/1	23	24	20/1	-	SPARE			

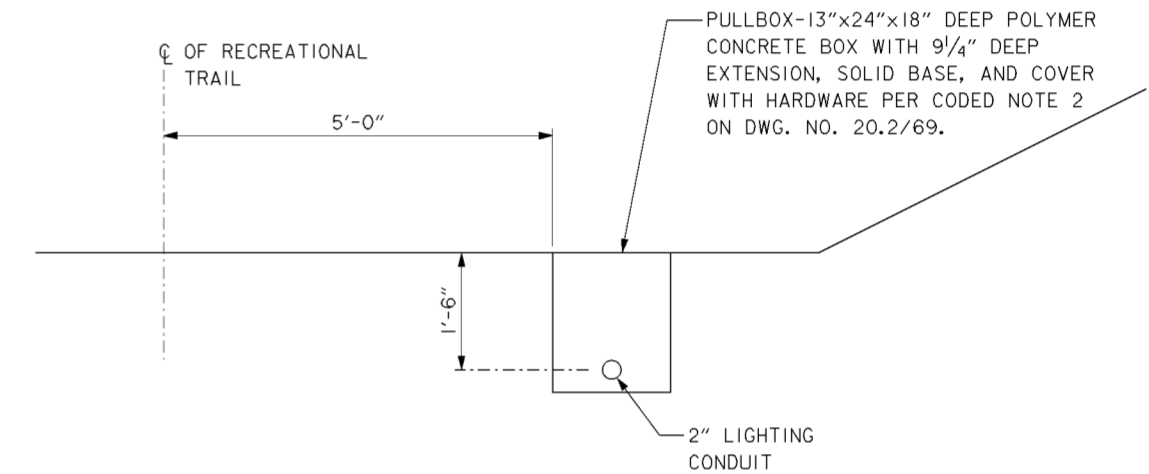

EMPTY PULLBOX SECTION
SCALE: NONE
RECREATIONAL TRAIL
STATION 36+50 AND 38+70

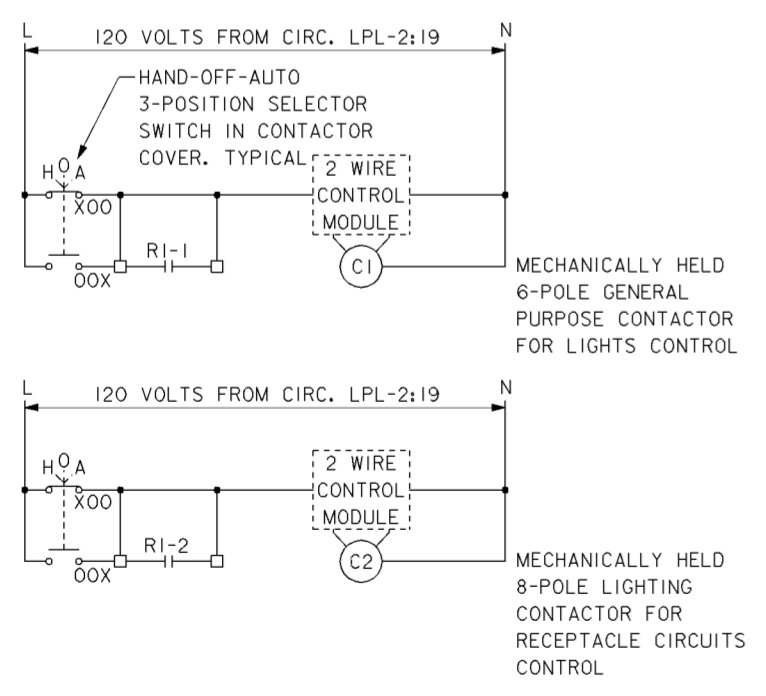










LIGHTING AND RECEPTACLE CONTACTORS CONTROL SCHEMATIC DIAGRAM
SCALE: NONE

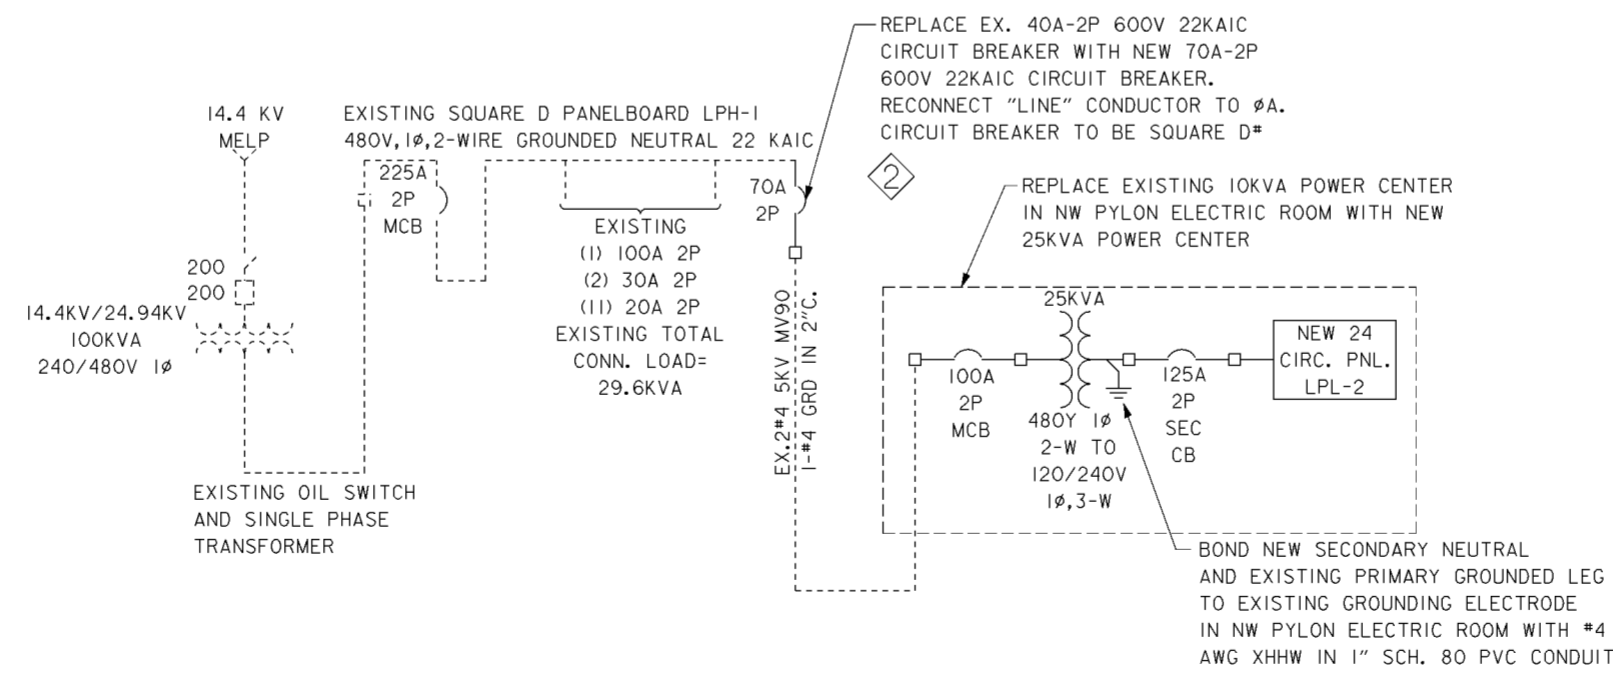

PARTIAL ONE LINE DIAGRAM OF THE EXISTING ELECTRICAL SYSTEM
SCALE: NONE

Revisions			
Symbol	Descriptions	Date	Approved
◇	REVISED AS CONSTRUCTED	7/02	P.O.C.
◇	REV. BY CONTRACT MODIFICATION LETTER MCO11	12/99	P.O.C.

BURGESS & NIPLE, LIMITED COLUMBUS, OHIO	U.S. ARMY ENGINEER DISTRICT CORPS OF ENGINEERS HUNTINGTON, WEST VIRGINIA
Designed by: J. AYRES	SCIO TO RIVER COLUMBUS, OHIO WEST COLUMBUS, L.P.P. PHASE I/D
Drawn by: A. PUMMELL	ELECTRICAL DETAILS (2 OF 2)
Checked by: D. SCHAMP	Scale: AS SHOWN
Reviewed by:	Date: MARCH 1998
Approved by:	Sheet reference number: 20.2/73
	Drawing Code: 16-PWC-10-
	FILENAME: a0u5ed02.dgn
	Sheet 2 of 2

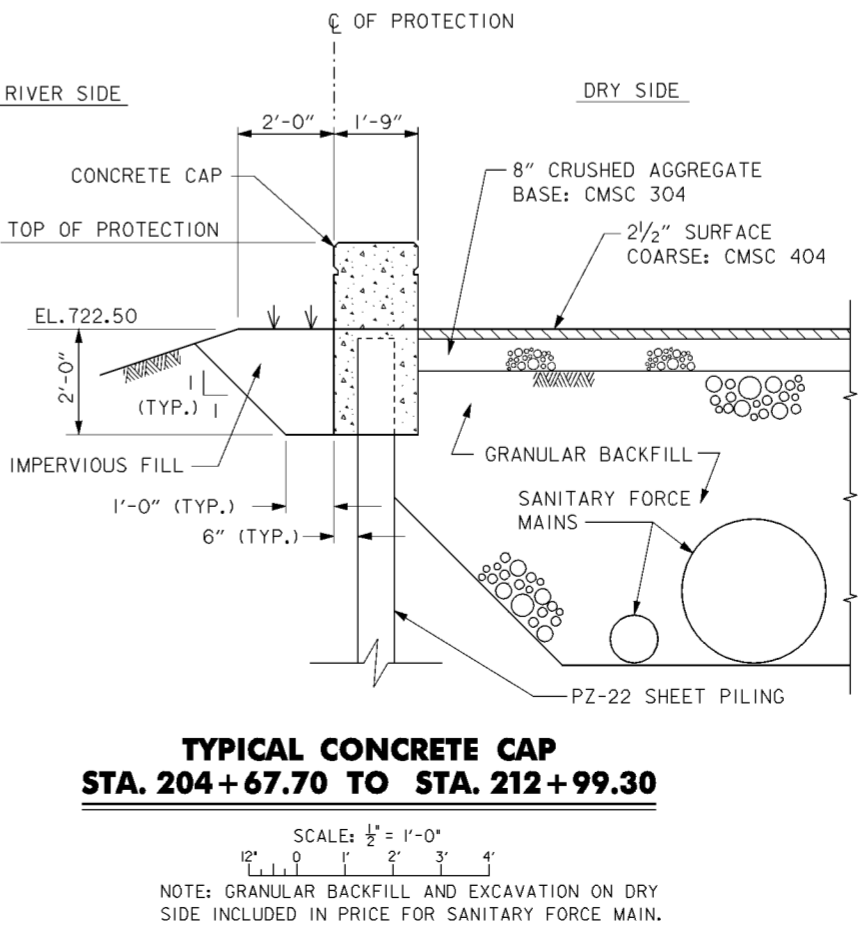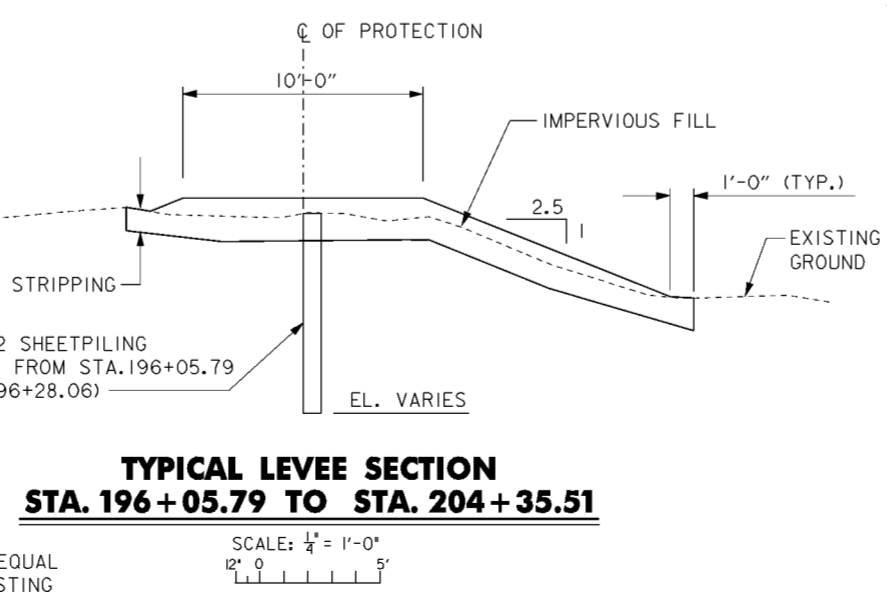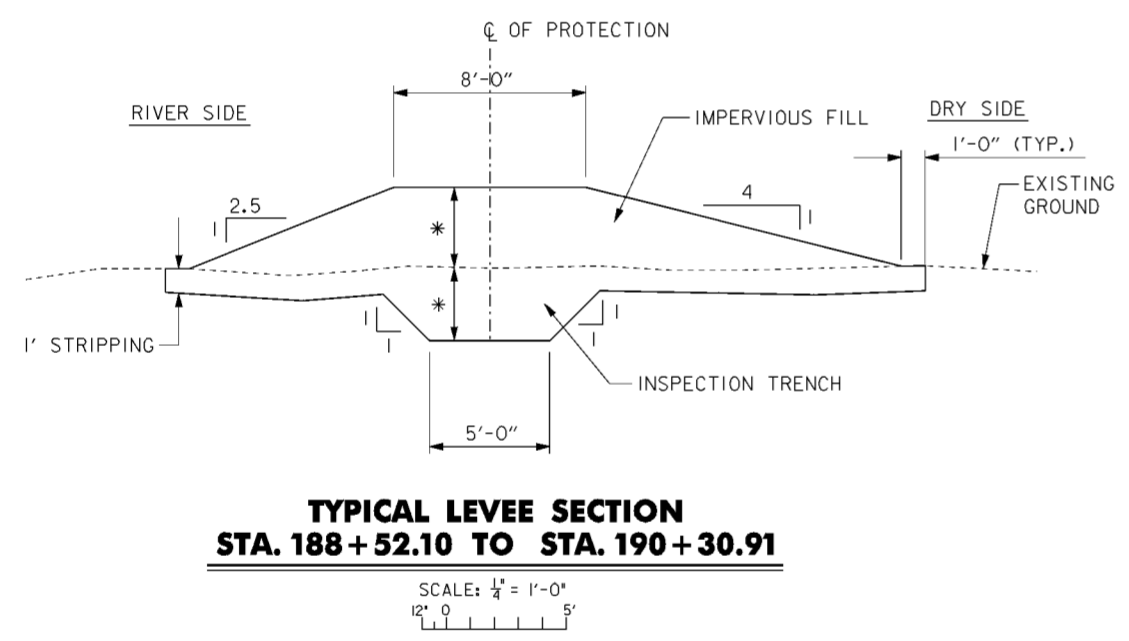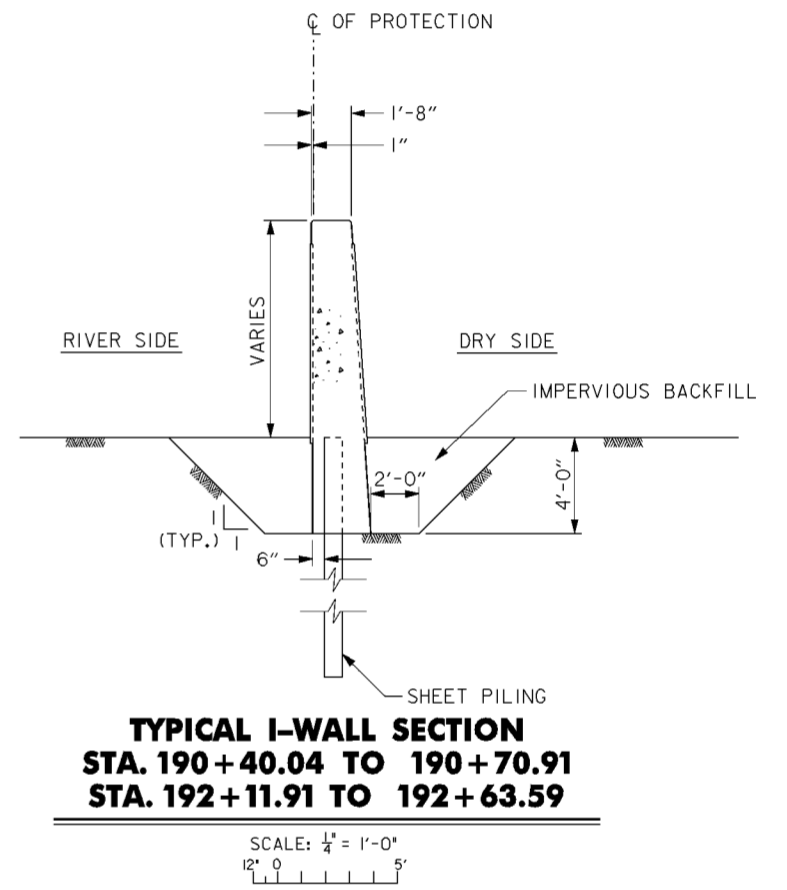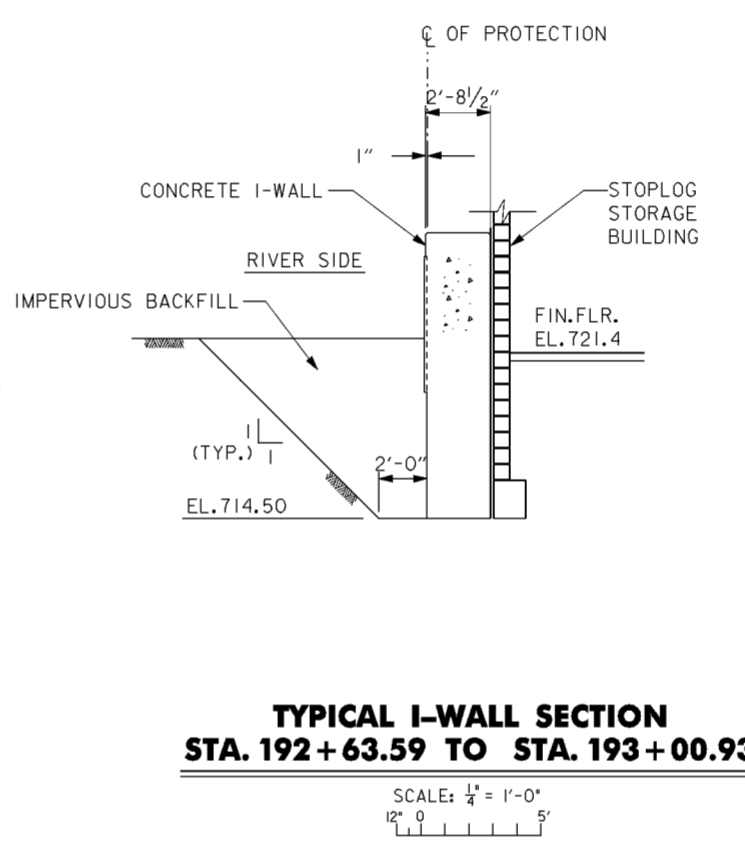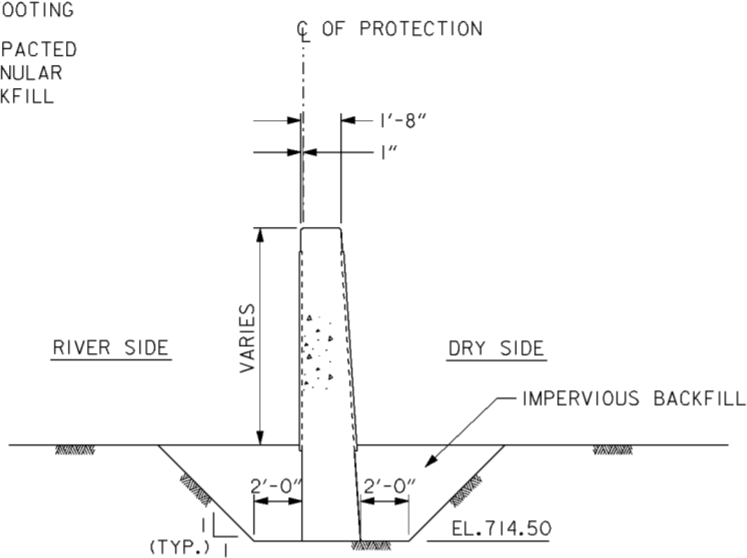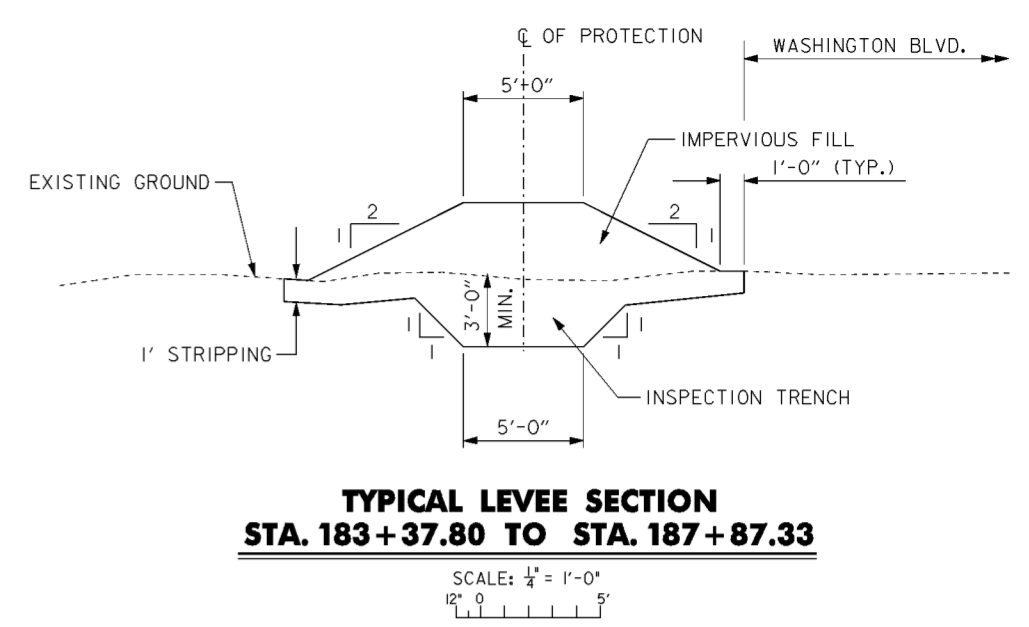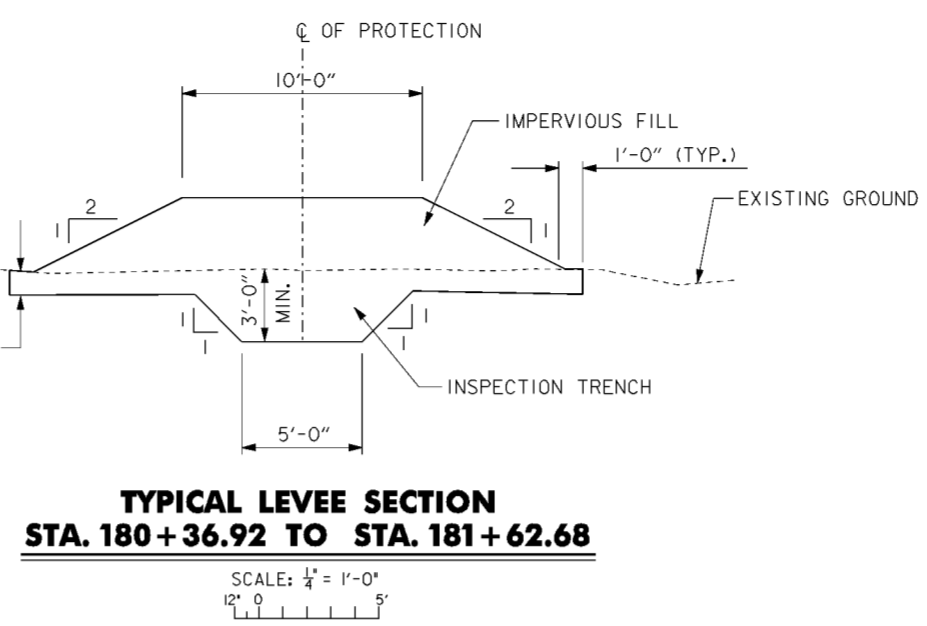
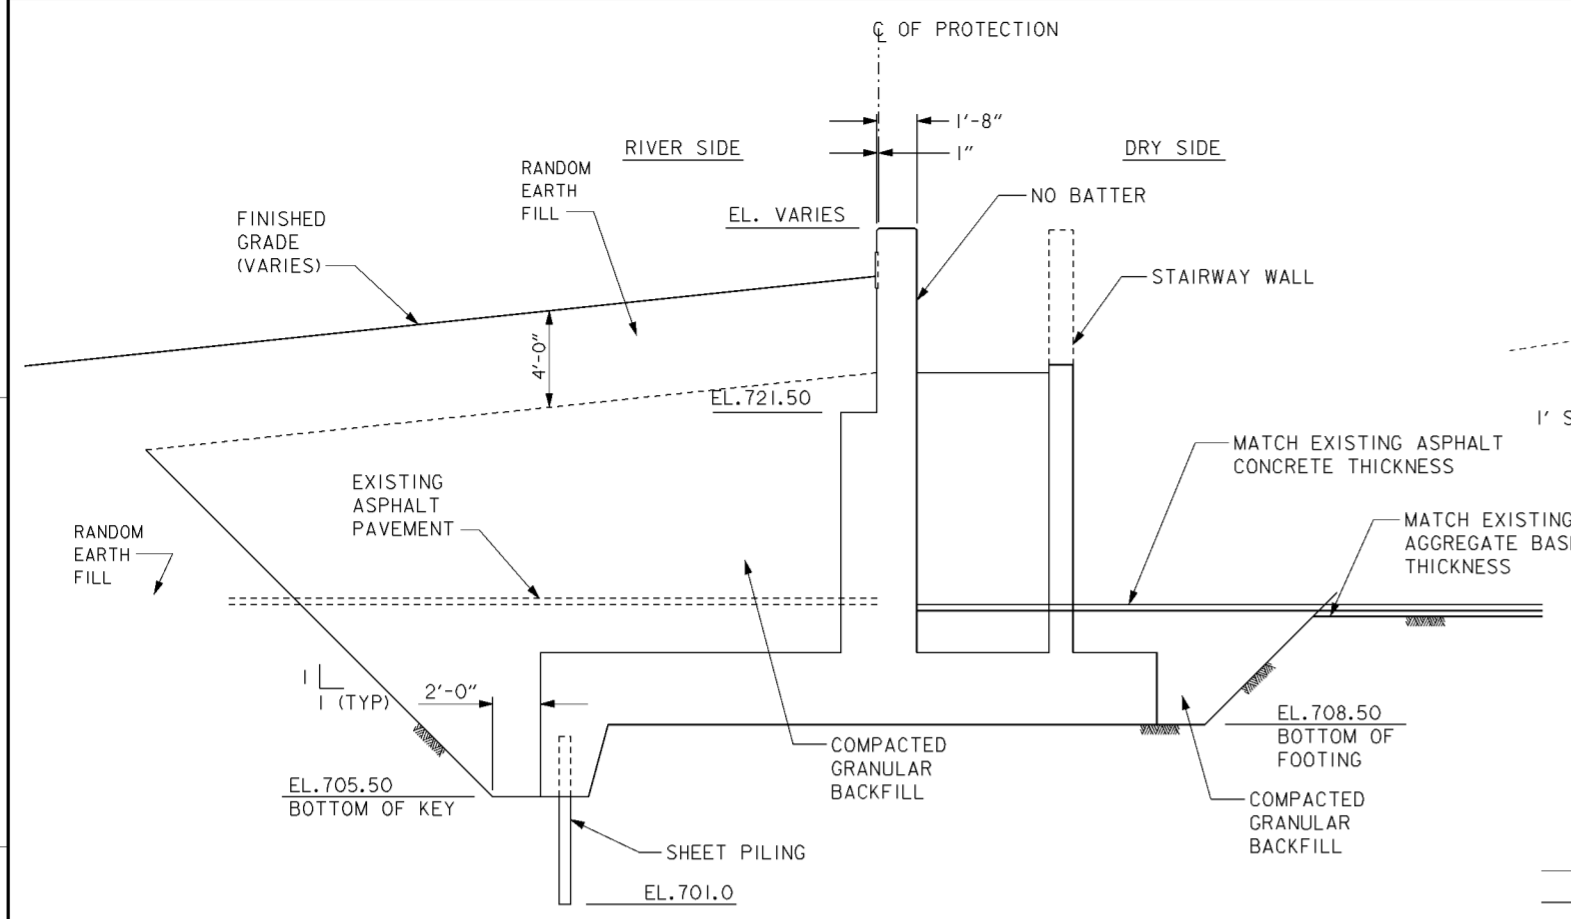


- NOTES**
- 6-INCH TOPSOIL NOT SHOWN.
 - FOR ADDITIONAL TYPICAL FLOOD PROTECTION SECTIONS SEE DRAWING NO.20.3/1.

Revisions			
Symbol	Descriptions	Date	Approved

BURGESS & NIPLE, LIMITED COLUMBUS, OHIO	U.S. ARMY ENGINEER DISTRICT CORPS OF ENGINEERS HUNTINGTON, WEST VIRGINIA	Designed by: J. HALL	SCIOTO RIVER COLUMBUS, OHIO WEST COLUMBUS, L.P.P. PHASE IID
		Drawn by: T. MULLINS	
Checked by: P. CONROY	FLOOD PROTECTION TYP SECTIONS (2 OF 2)	Scale: AS SHOWN	Sheet reference number: 20.3/2
Reviewed by: Date: MARCH 1998	FILENAME: 00ds02.dgn	Drawing Code: 16-PWC-10-	Sheet 2 of 2

* DEPTH OF INSPECTION TRENCH SHALL EQUAL THE HEIGHT OF THE LEVEE ABOVE EXISTING GROUND, IN NO CASE SHALL THE INSPECTION TRENCH BE LESS THAN 3'-0".

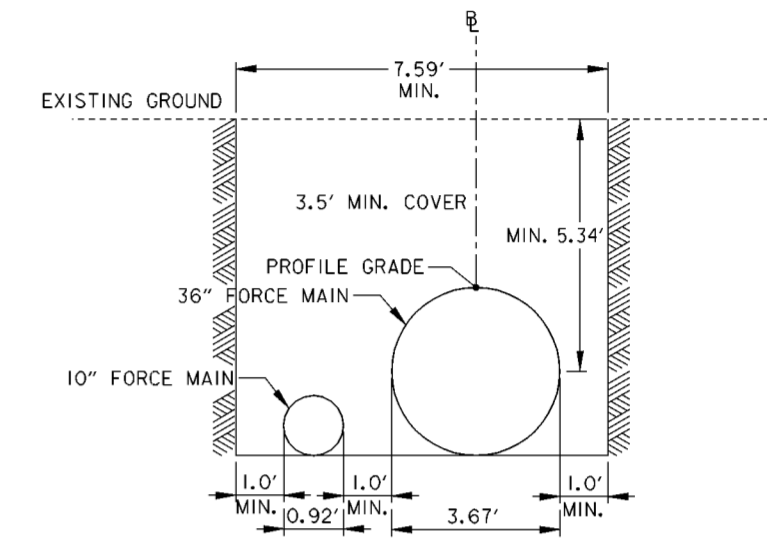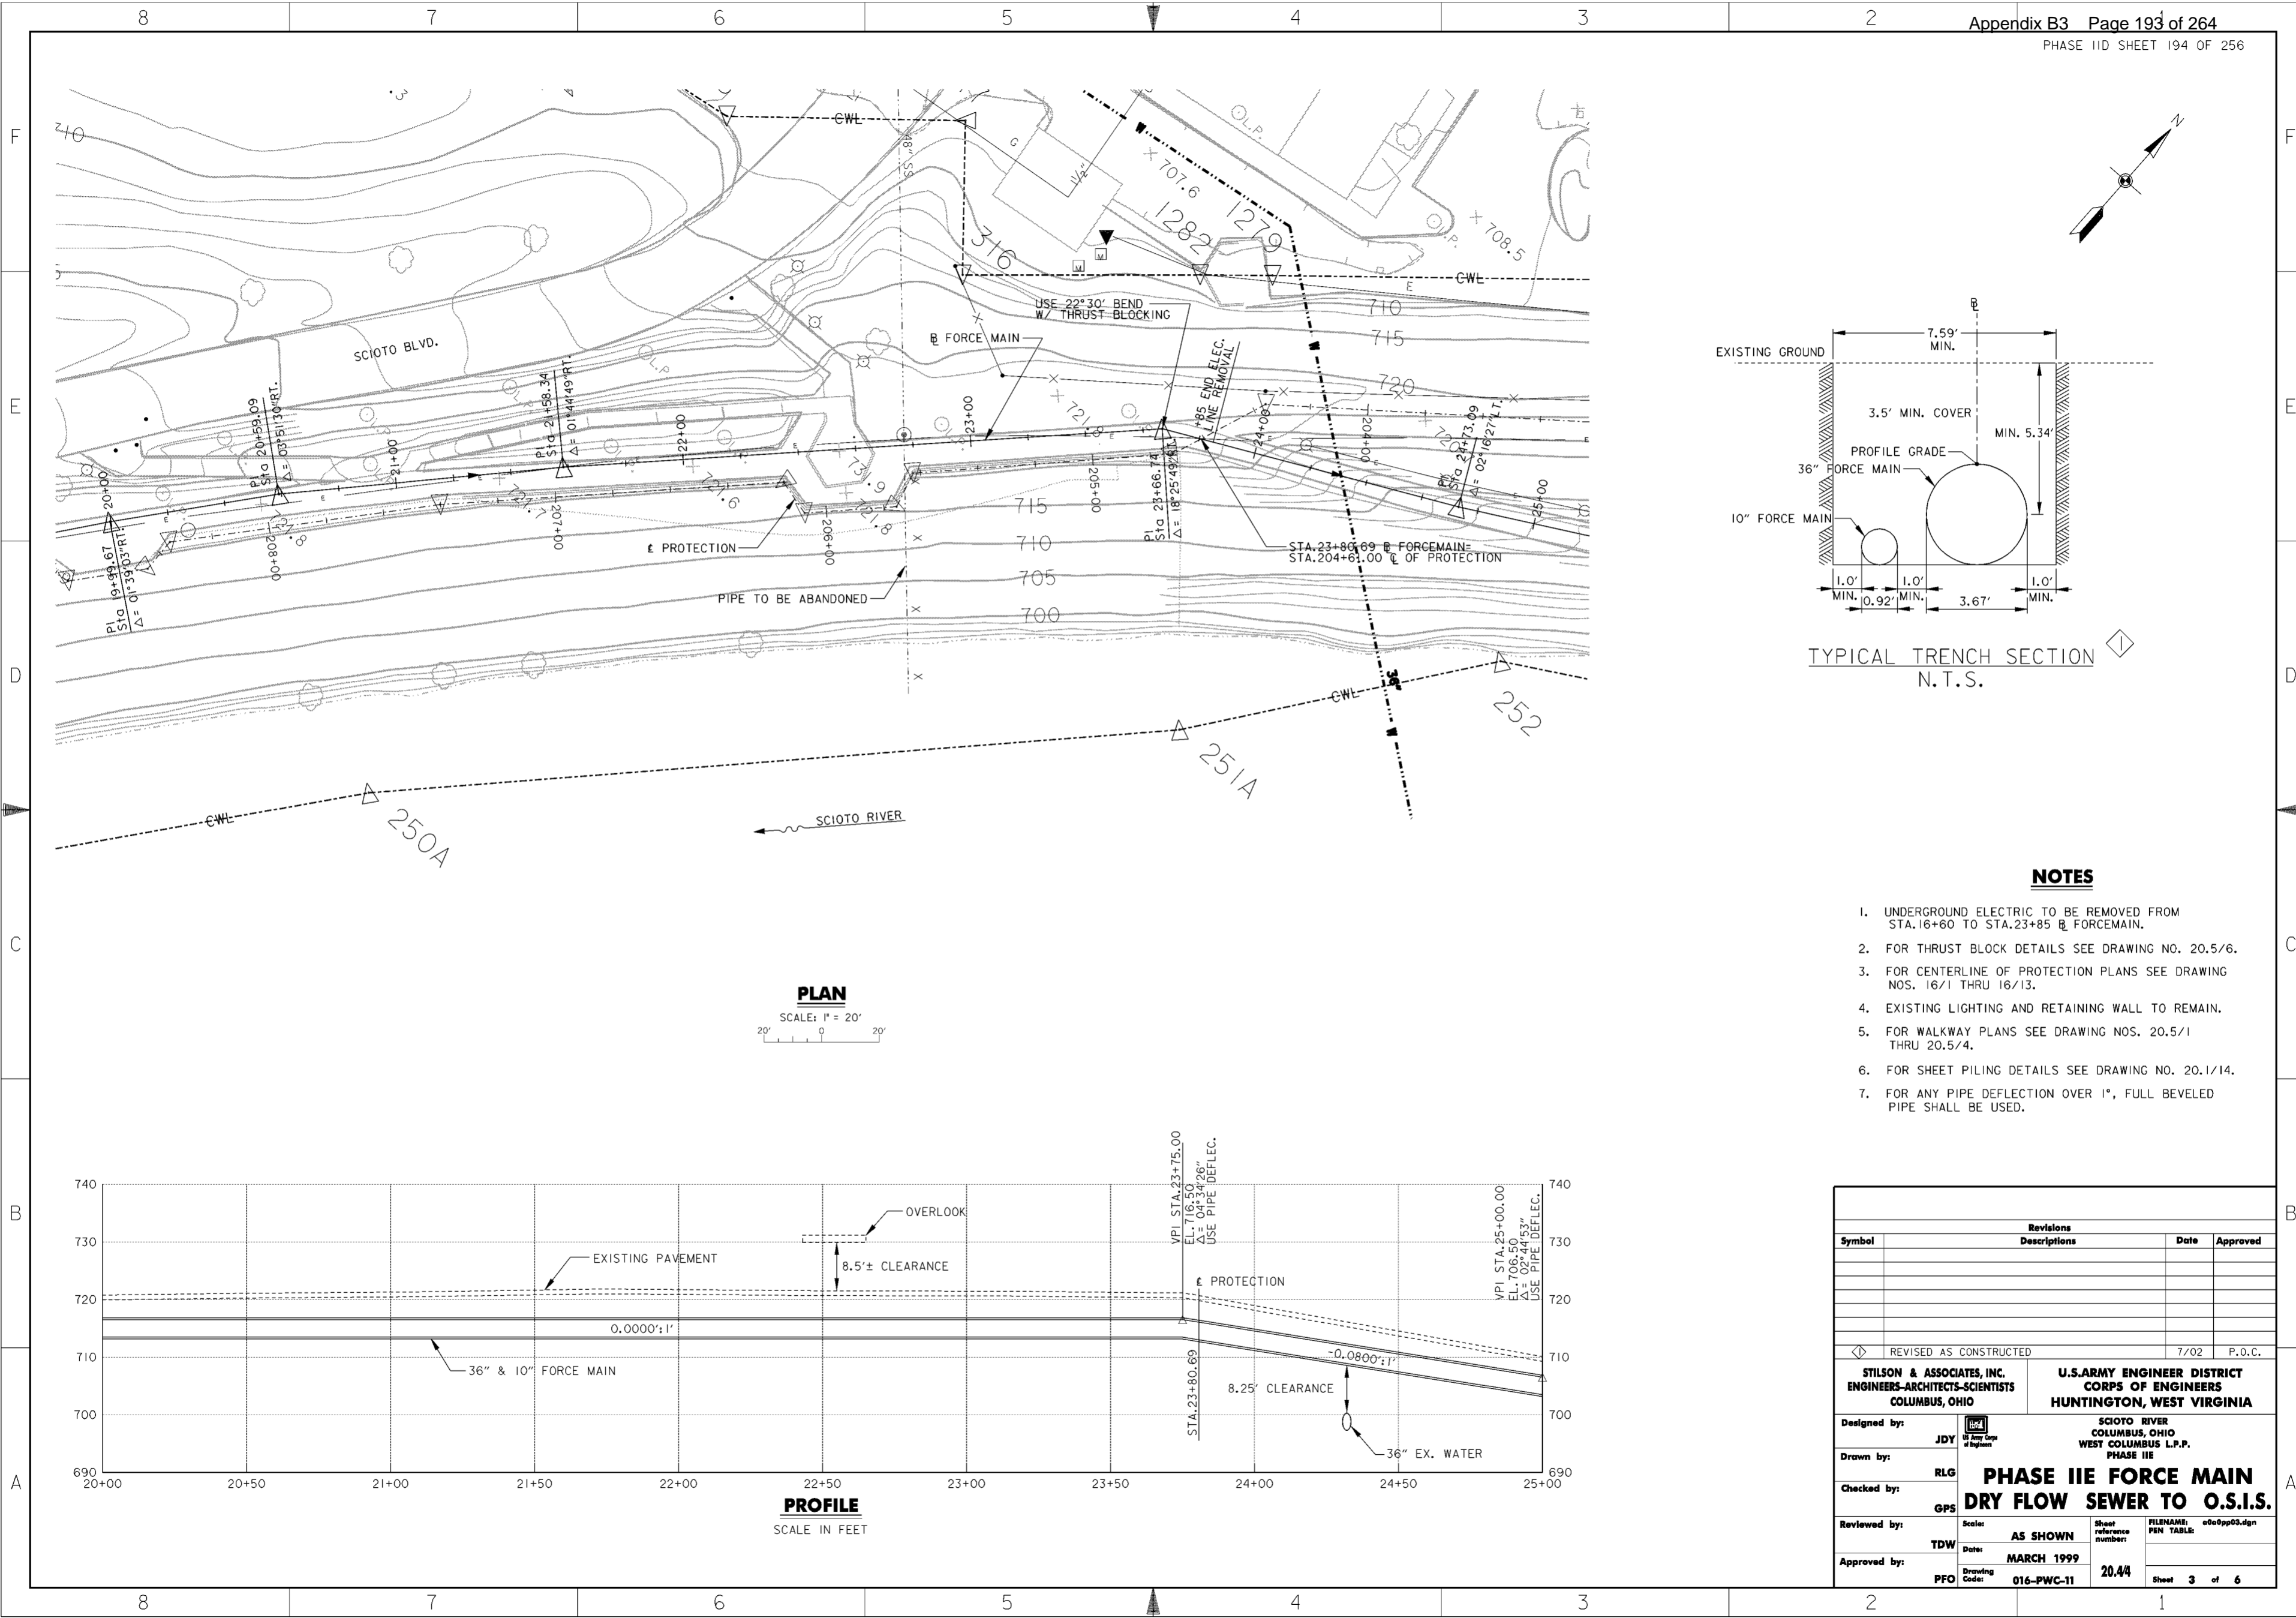


TYPICAL TRENCH SECTION
N.T.S.

NOTES

1. UNDERGROUND ELECTRIC TO BE REMOVED FROM STA. 16+60 TO STA. 23+85 @ FORCEMAIN.
2. FOR THRUST BLOCK DETAILS SEE DRAWING NO. 20.5/6.
3. FOR CENTERLINE OF PROTECTION PLANS SEE DRAWING NOS. 16/1 THRU 16/13.
4. EXISTING LIGHTING AND RETAINING WALL TO REMAIN.
5. FOR WALKWAY PLANS SEE DRAWING NOS. 20.1/1 THRU 20.5/4.
6. FOR SHEET PILING DETAILS SEE DRAWING NO. 20.1/14.
7. FOR ANY PIPE DEFLECTION OVER 1", FULL BEVELED PIPE SHALL BE USED.

PLAN
SCALE: 1" = 20'



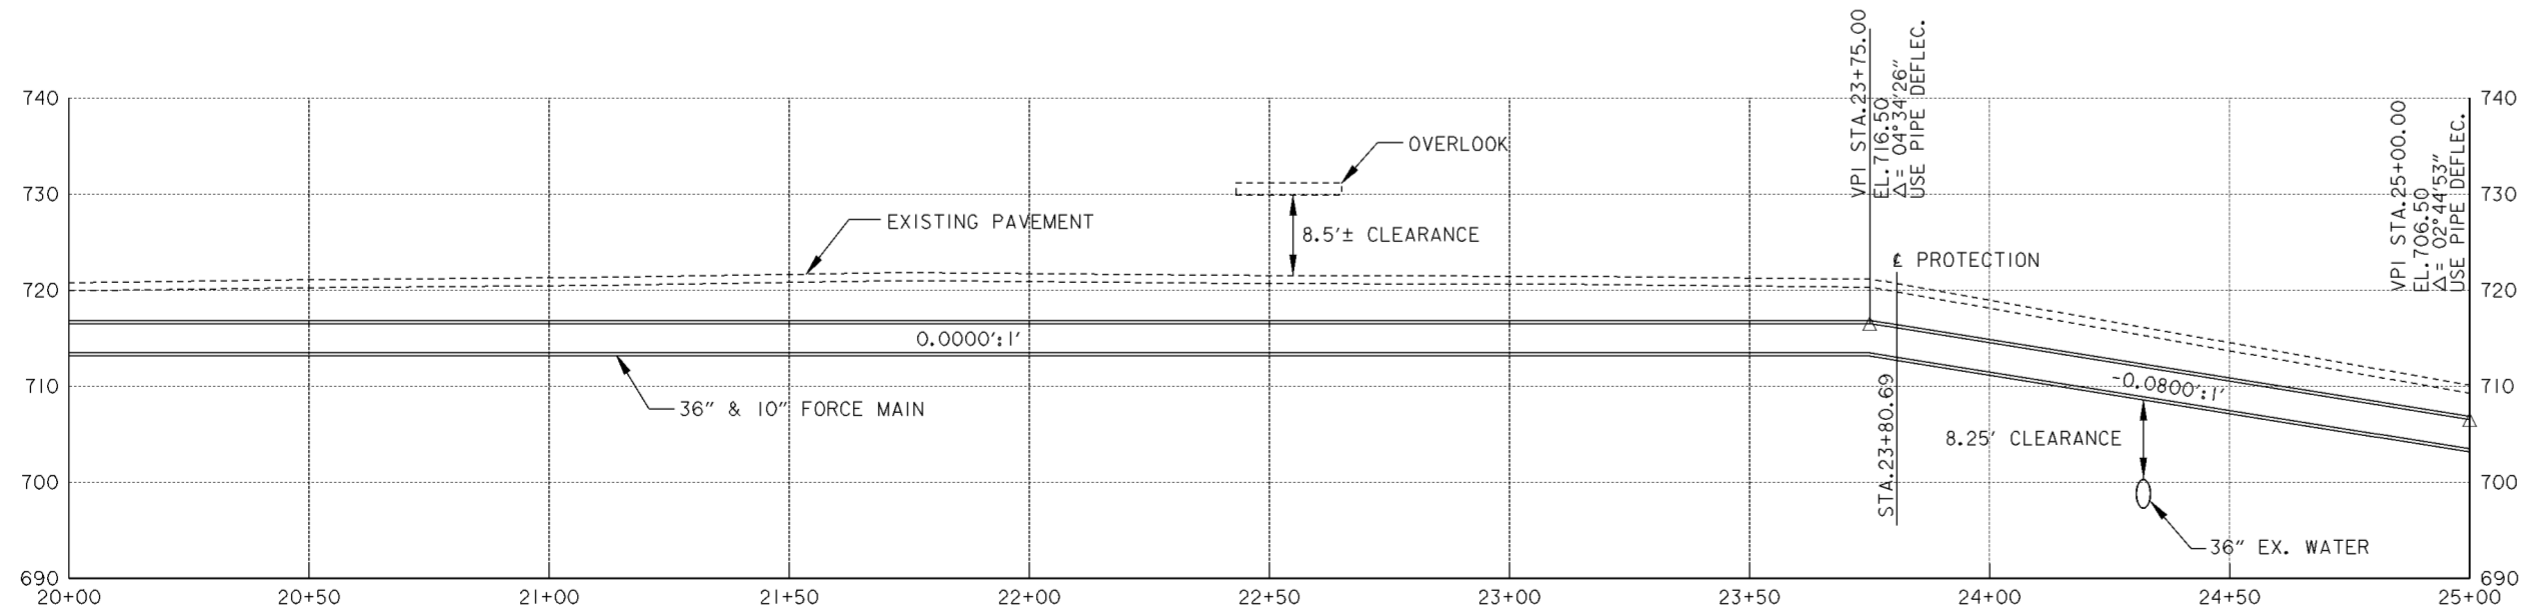


PROFILE
SCALE IN FEET

Revisions			
Symbol	Descriptions	Date	Approved
◊	REVISED AS CONSTRUCTED	7/02	P.O.C.


STILSON & ASSOCIATES, INC. ENGINEERS-ARCHITECTS-SCIENTISTS COLUMBUS, OHIO	U.S. ARMY ENGINEER DISTRICT CORPS OF ENGINEERS HUNTINGTON, WEST VIRGINIA
Designed by: JDY Drawn by: RLG Checked by: GPS Reviewed by: TDW Approved by: PFO	SCOTO RIVER COLUMBUS, OHIO WEST COLUMBUS L.P.P. PHASE IIE PHASE IIE FORCE MAIN DRY FLOW SEWER TO O.S.I.S. Scale: AS SHOWN Date: MARCH 1999 Drawing Code: 016-PWC-11
Sheet reference number: 20.44 FILENAME: a00pp03.dgn PEN TABLE: Sheet 3 of 6	

WORK AS CONSTRUCTED

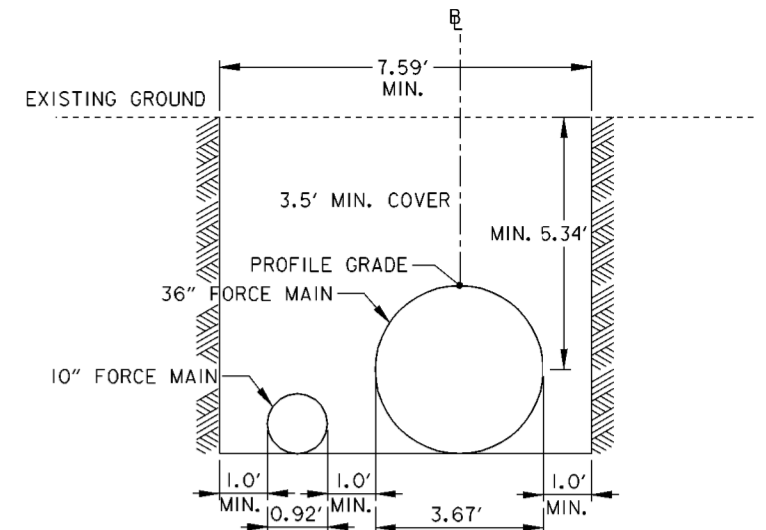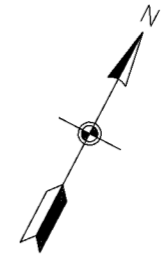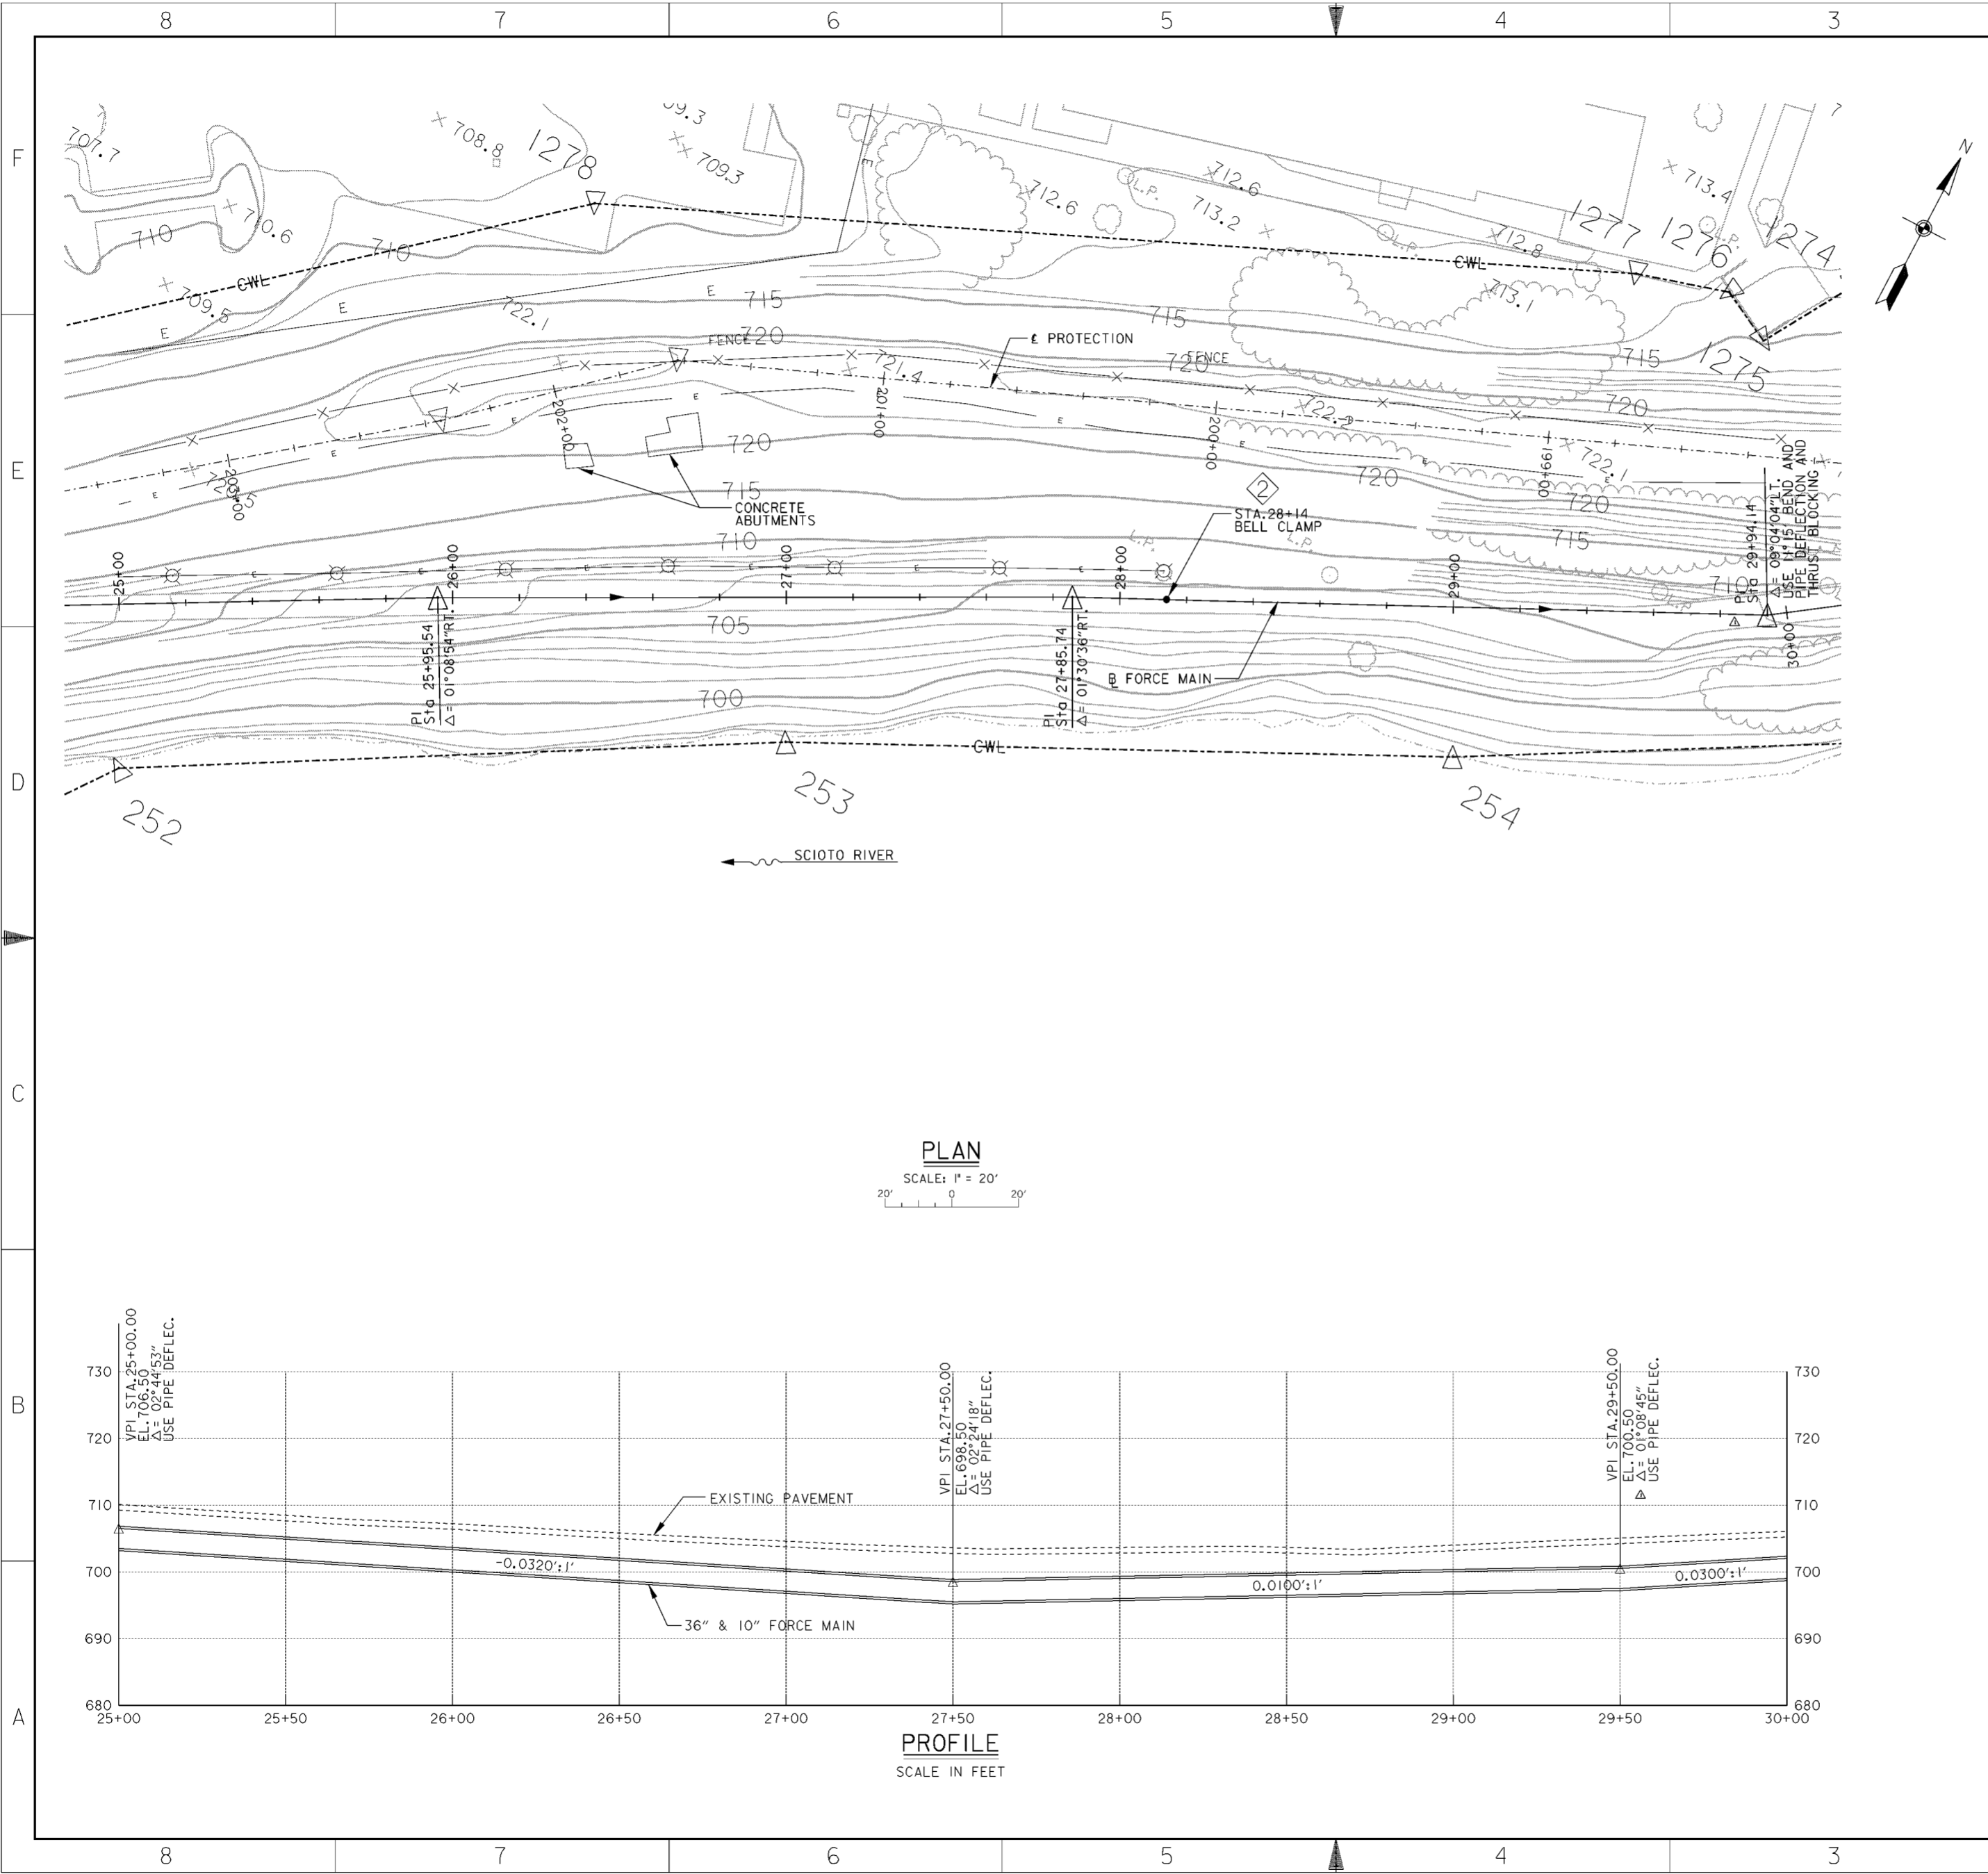

TYPICAL TRENCH SECTION

STA. 25+00 TO 29+50
N.T.S.

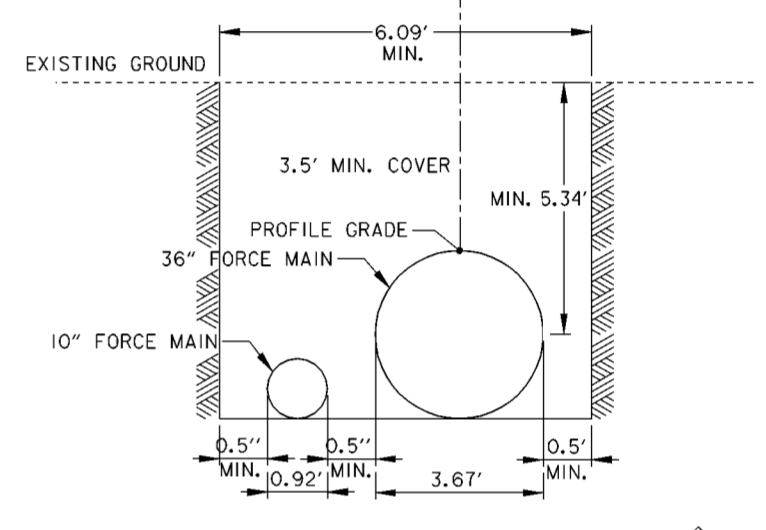


TYPICAL TRENCH SECTION

STA. 29+50 TO 30+00
N.T.S.

NOTES

1. FOR CENTERLINE OF PROTECTION PLANS SEE DRAWING NOS. 16/1 THRU 16/13.
2. EXISTING LIGHTING AND RETAINING WALL TO REMAIN.
3. FOR WALKWAY PLANS SEE DRAWING NOS. 20.5/1 THRU 20.5/4.
4. FOR ANY PIPE DEFLECTION OVER 1°, FULL BEVELED PIPE SHALL BE USED.

PLAN
SCALE: 1" = 20'

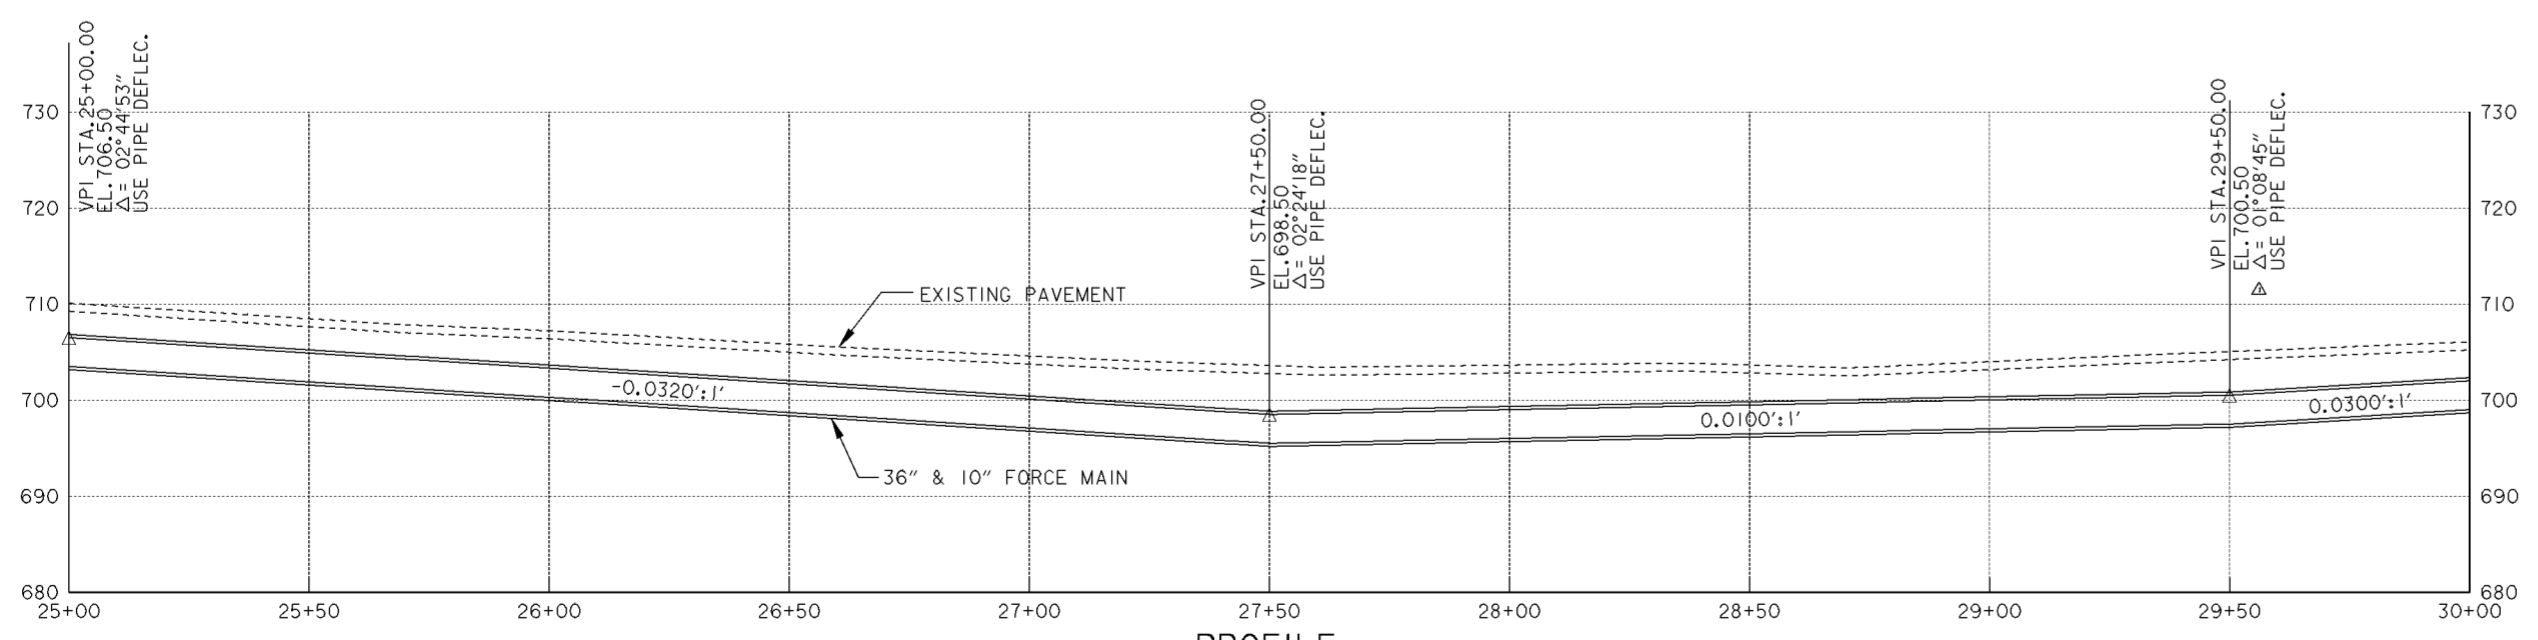


PROFILE
SCALE IN FEET


Revisions			
Symbol	Descriptions	Date	Approved
◇	REVISED AS CONSTRUCTED	7/02	P.O.C.
△	REVISED IN ACCORDANCE WITH AMENDMENT 0001	4/23/98	

STILSON & ASSOCIATES, INC. ENGINEERS-ARCHITECTS-SCIENTISTS COLUMBUS, OHIO	U.S. ARMY ENGINEER DISTRICT CORPS OF ENGINEERS HUNTINGTON, WEST VIRGINIA
Designed by: JDY Drawn by: RLG Checked by: GPS Reviewed by: PFO Approved by: AJS	SCIO TO RIVER COLUMBUS, OHIO WEST COLUMBUS L.P.P. PHASE IID PHASE IIE FORCE MAIN DRY FLOW SEWER TO O.S.I.S. Scale: AS SHOWN Date: MARCH 1998 Drawing Code: 016-PWC-10
Sheet reference number: 20.45 FILENAME: a00pp04.dgn PEN TABLE: Sheet 4 of 6	


WORK AS CONSTRUCTED

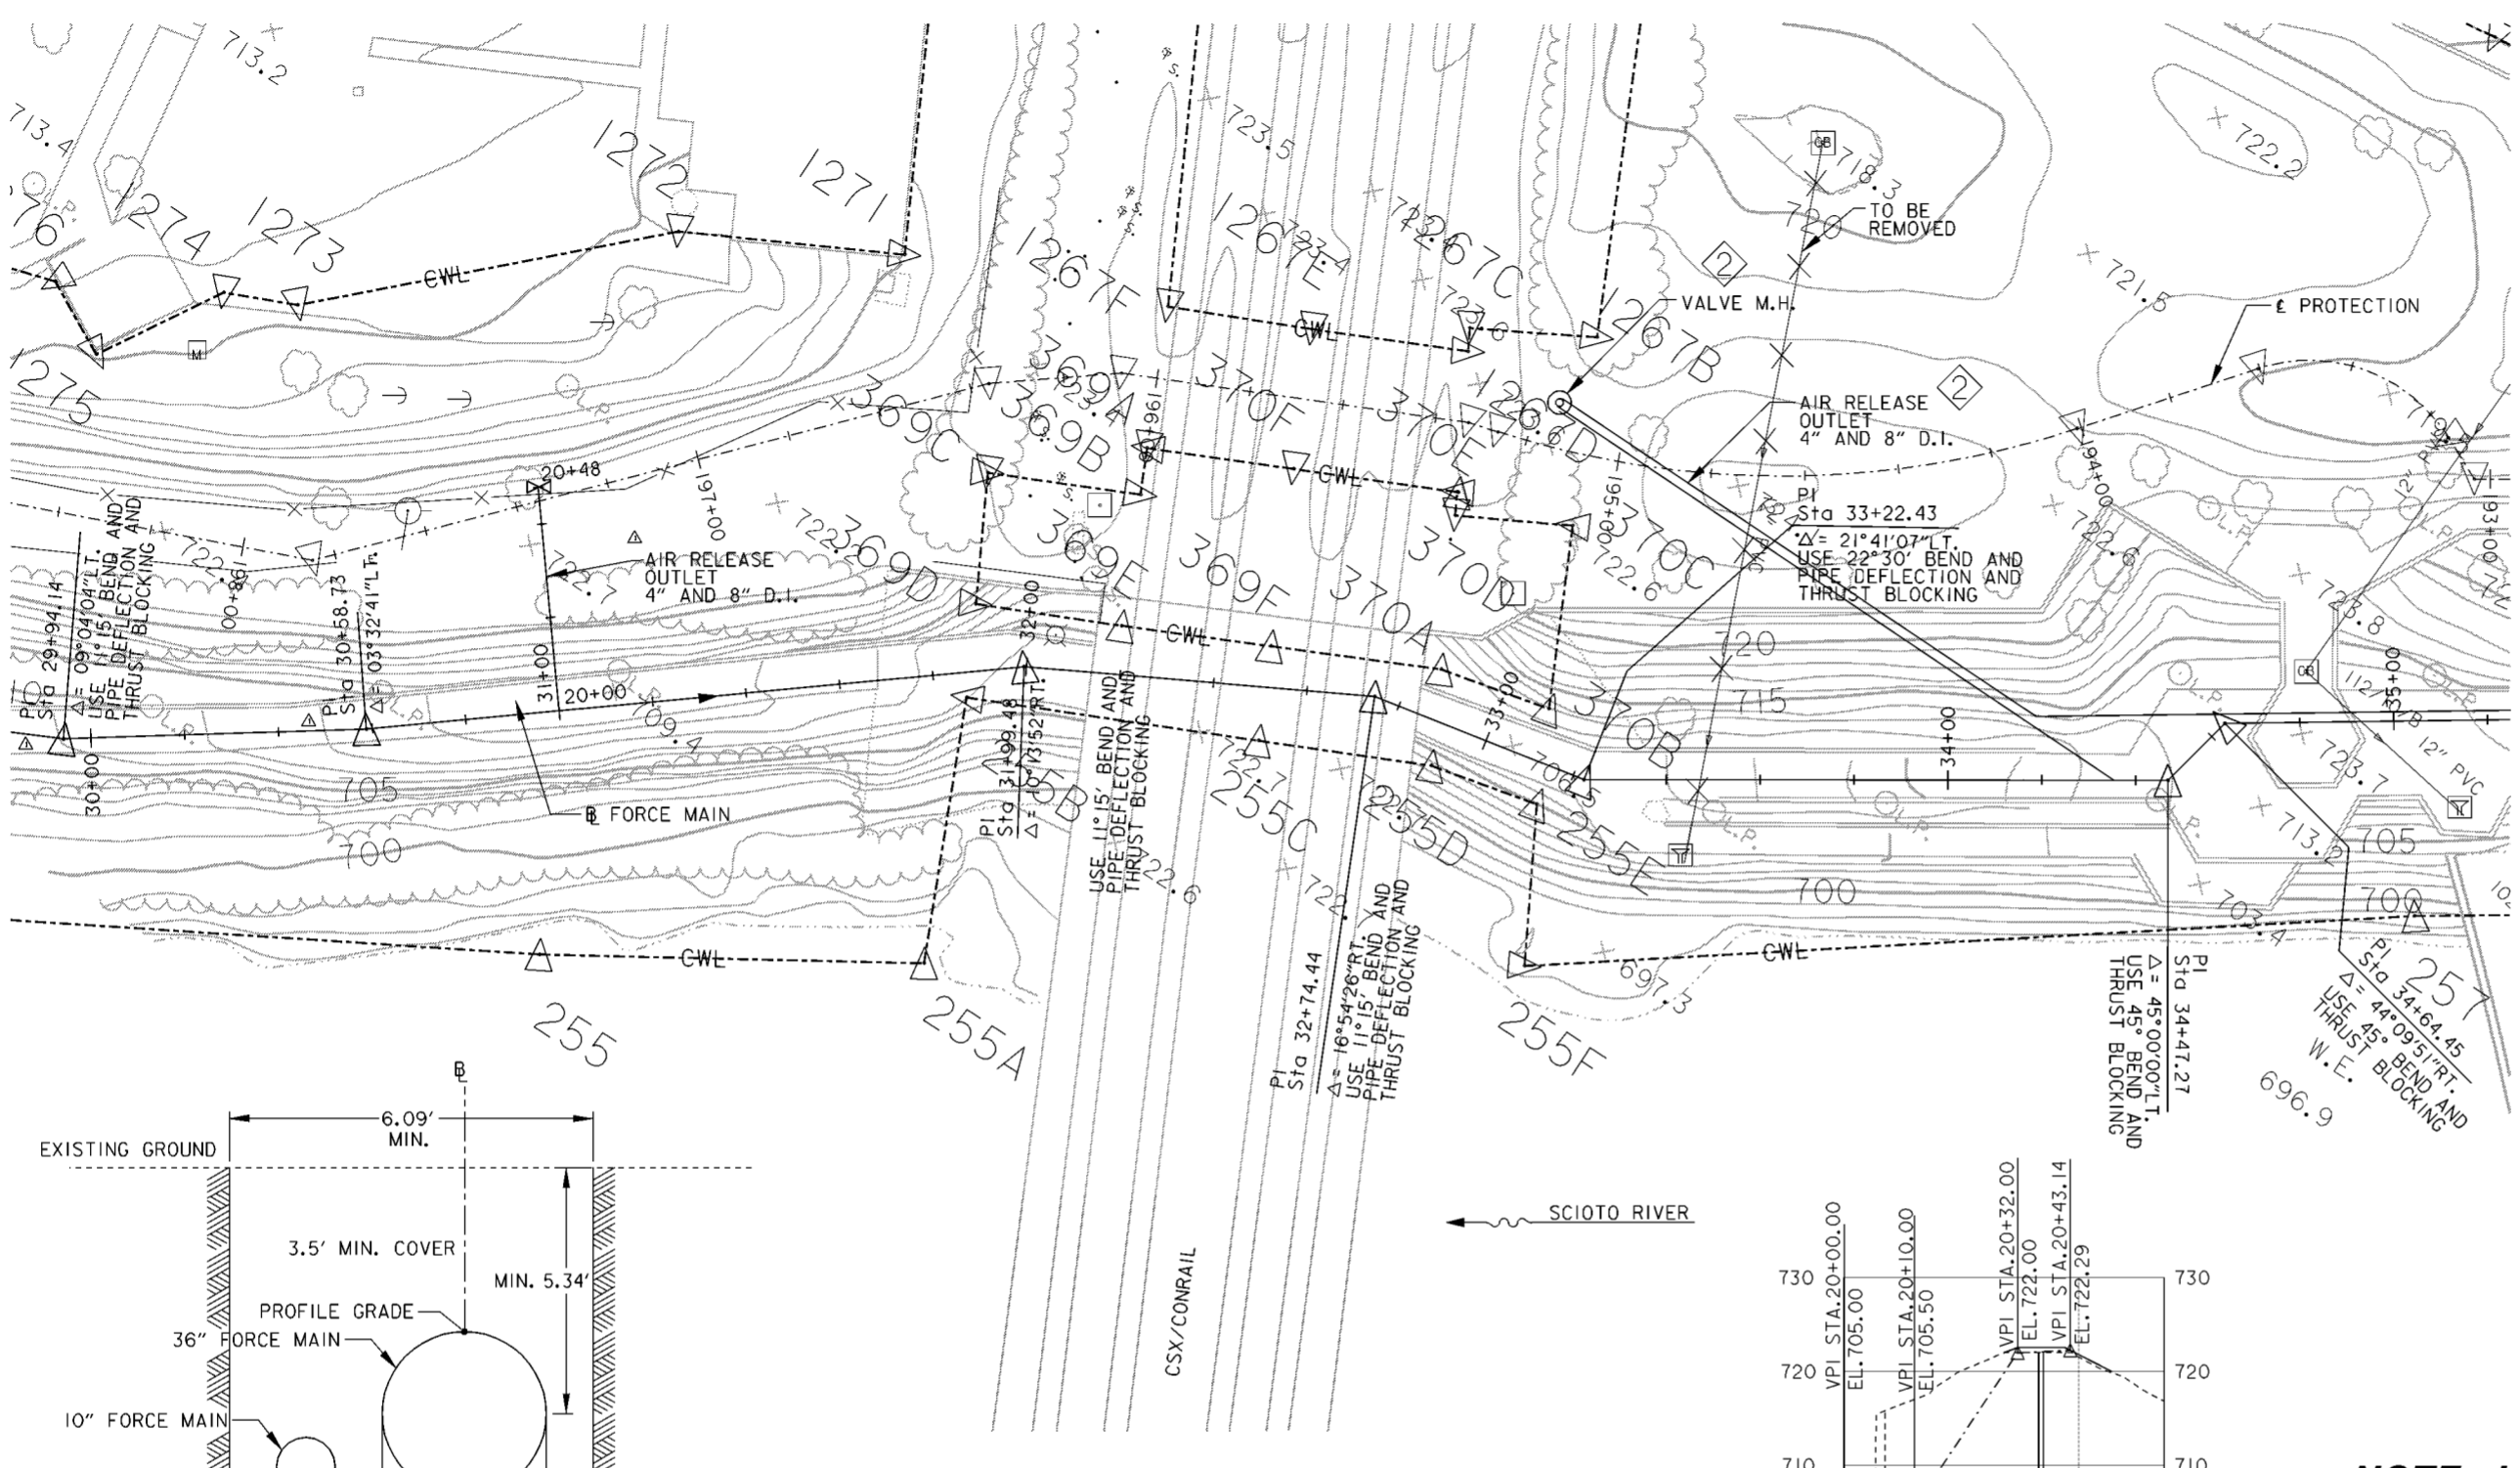


PLAN
 SCALE: 1" = 20'

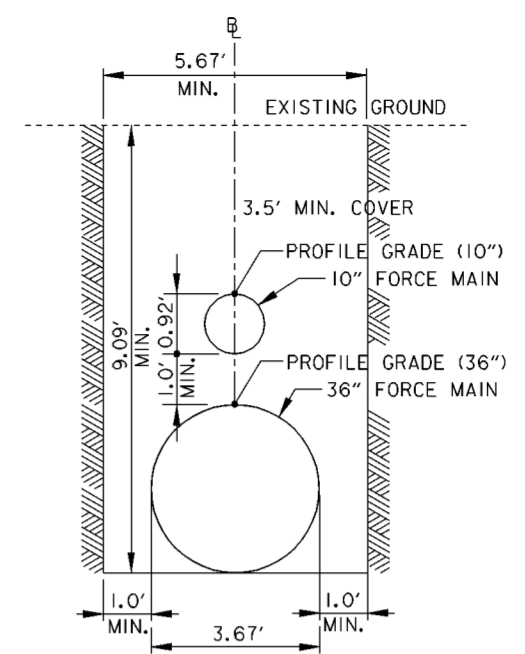


TYPICAL TRENCH SECTION
 STA. 32+74.84 TO STA. 34+35.00
 N.T.S.

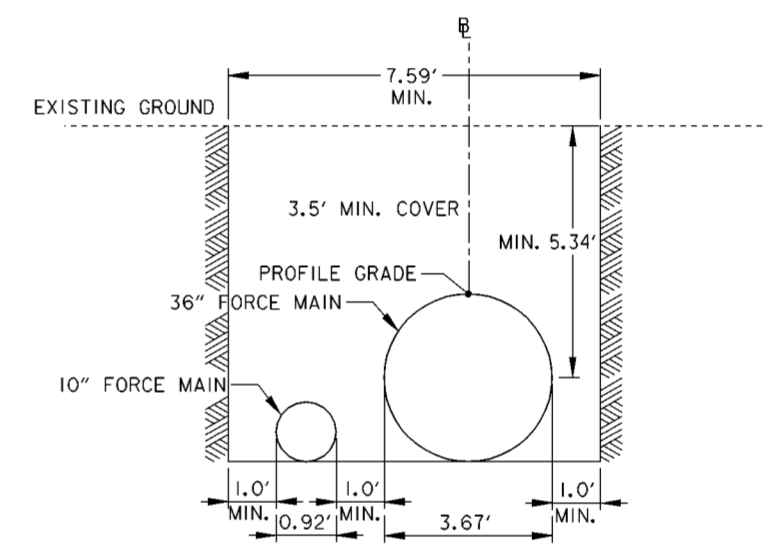

TYPICAL TRENCH SECTION
 STA. 34+60 TO 35+00
 N.T.S.

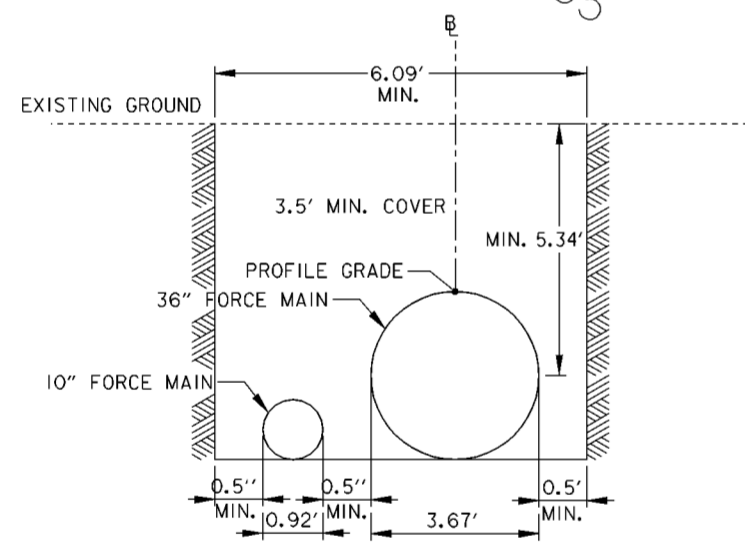


TYPICAL TRENCH SECTION
 STA. 30+00 TO 32+50
 N.T.S.

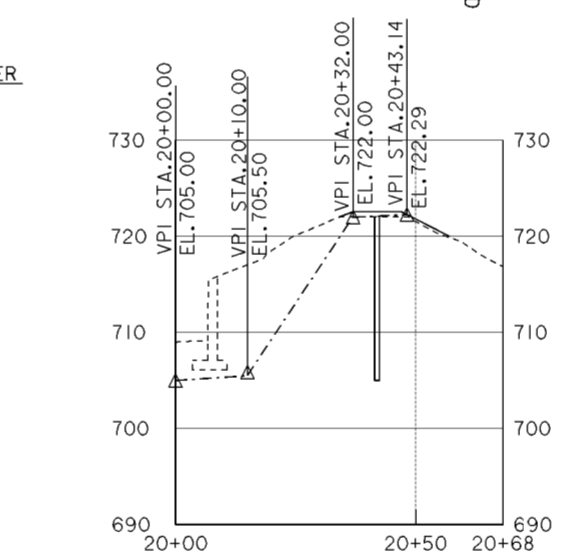

AIR RELEASE OULTE STA. 31+00

NOTE: Line of Protection alignment has been changed per E-1934 pgs. 88-94

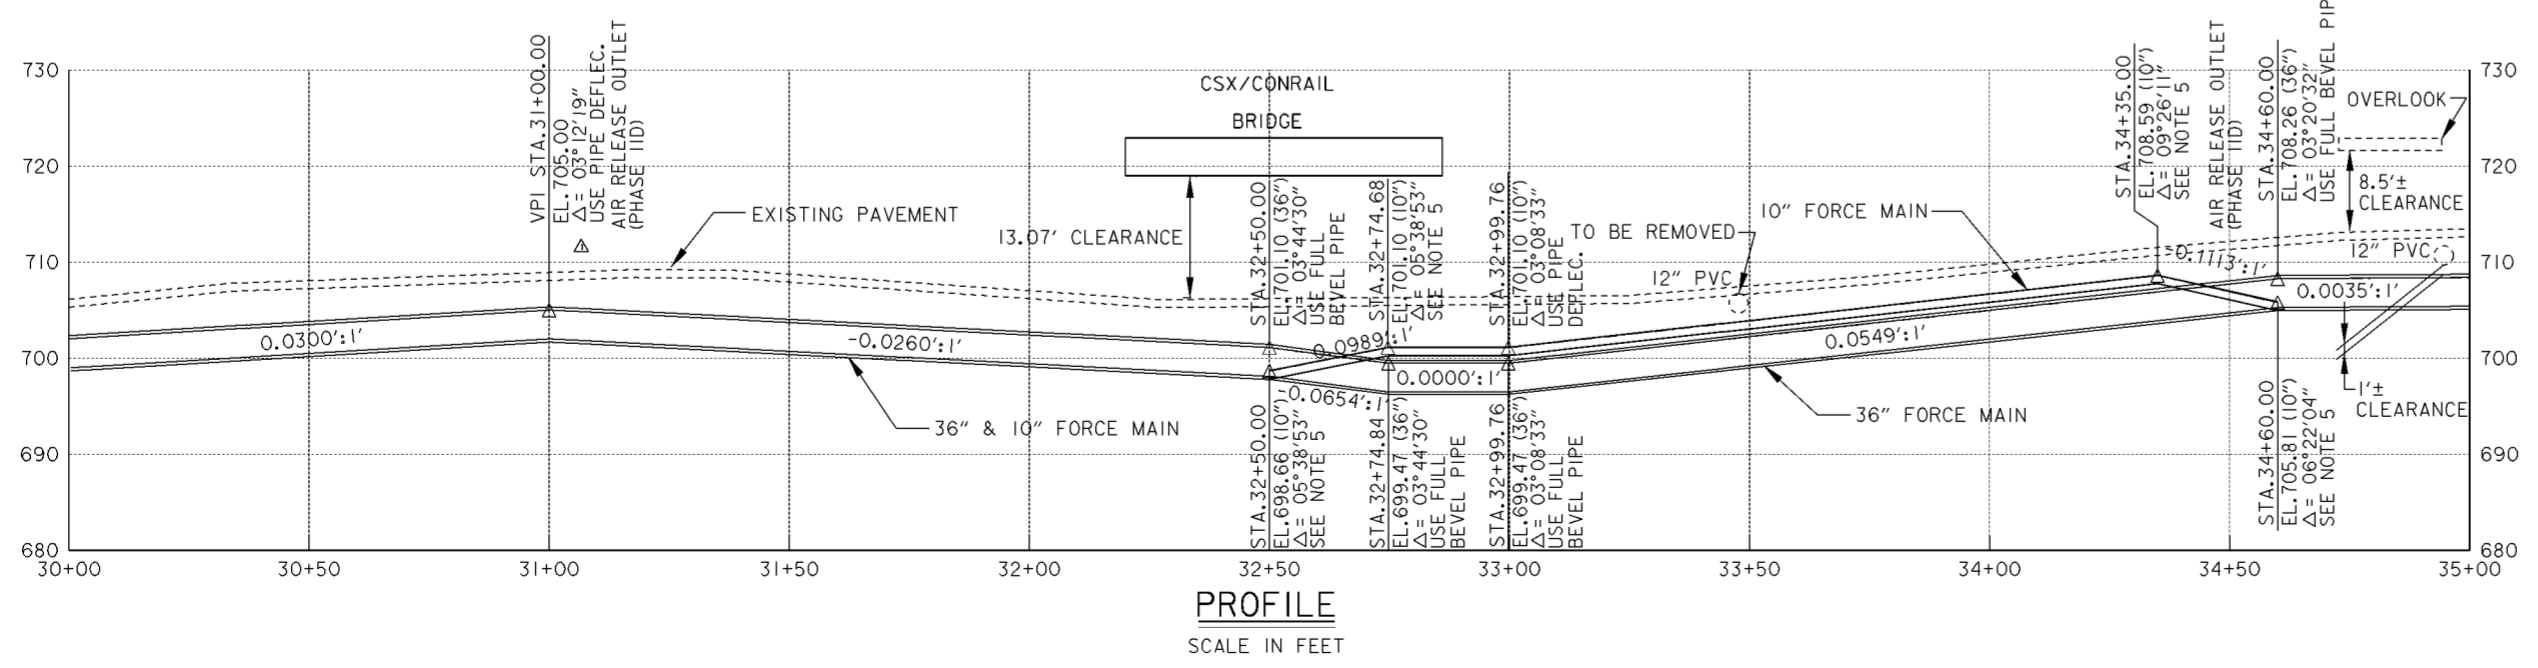



PROFILE
 SCALE IN FEET

NOTES

- FOR THRUST BLOCK DETAIL SEE DRAWING NO. 20.5/6.
- FOR CENTERLINE OF PROTECTION PLANS SEE DRAWING NOS. 16/1 THRU 16/13.
- EXISTING LIGHTING AND RETAINING WALL TO REMAIN.
- FOR WALKWAY PLANS SEE DRAWING NOS. 20.5/1 THRU 20.5/4.
- USE 11°15' BEND AND PIPE DEFLECTION AND THRUST BLOCKING
- FOR AIR RELEASE OUTLET DETAILS SEE DRAWING NO. 20.4/16
- FOR ANY PIPE DEFLECTION OVER 1°, FULL BEVELED PIPE SHALL BE USED.

Revisions			
Symbol	Descriptions	Date	Approved
◇	REVISED AS CONSTRUCTED	7/02	P.O.C.
△	REVISED IN ACCORDANCE WITH AMENDMENT 0001	4/23/98	

STILSON & ASSOCIATES, INC. ENGINEERS-ARCHITECTS-SCIENTISTS COLUMBUS, OHIO		U.S. ARMY ENGINEER DISTRICT CORPS OF ENGINEERS HUNTINGTON, WEST VIRGINIA	
Designed by: JDY Drawn by: RLG Checked by: GPS Reviewed by: PFO Approved by: AJS	SCIO TO RIVER COLUMBUS, OHIO WEST COLUMBUS L.P.P. PHASE IID PHASE IIE FORCE MAIN DRY FLOW SEWER TO O.S.I.S.		
Scale: AS SHOWN Date: MARCH 1998 Drawing Code: 016-PWC-10	Sheet reference number: 20.46	FILENAME: o00pp05.dgn PEN TABLE:	Sheet 5 of 6

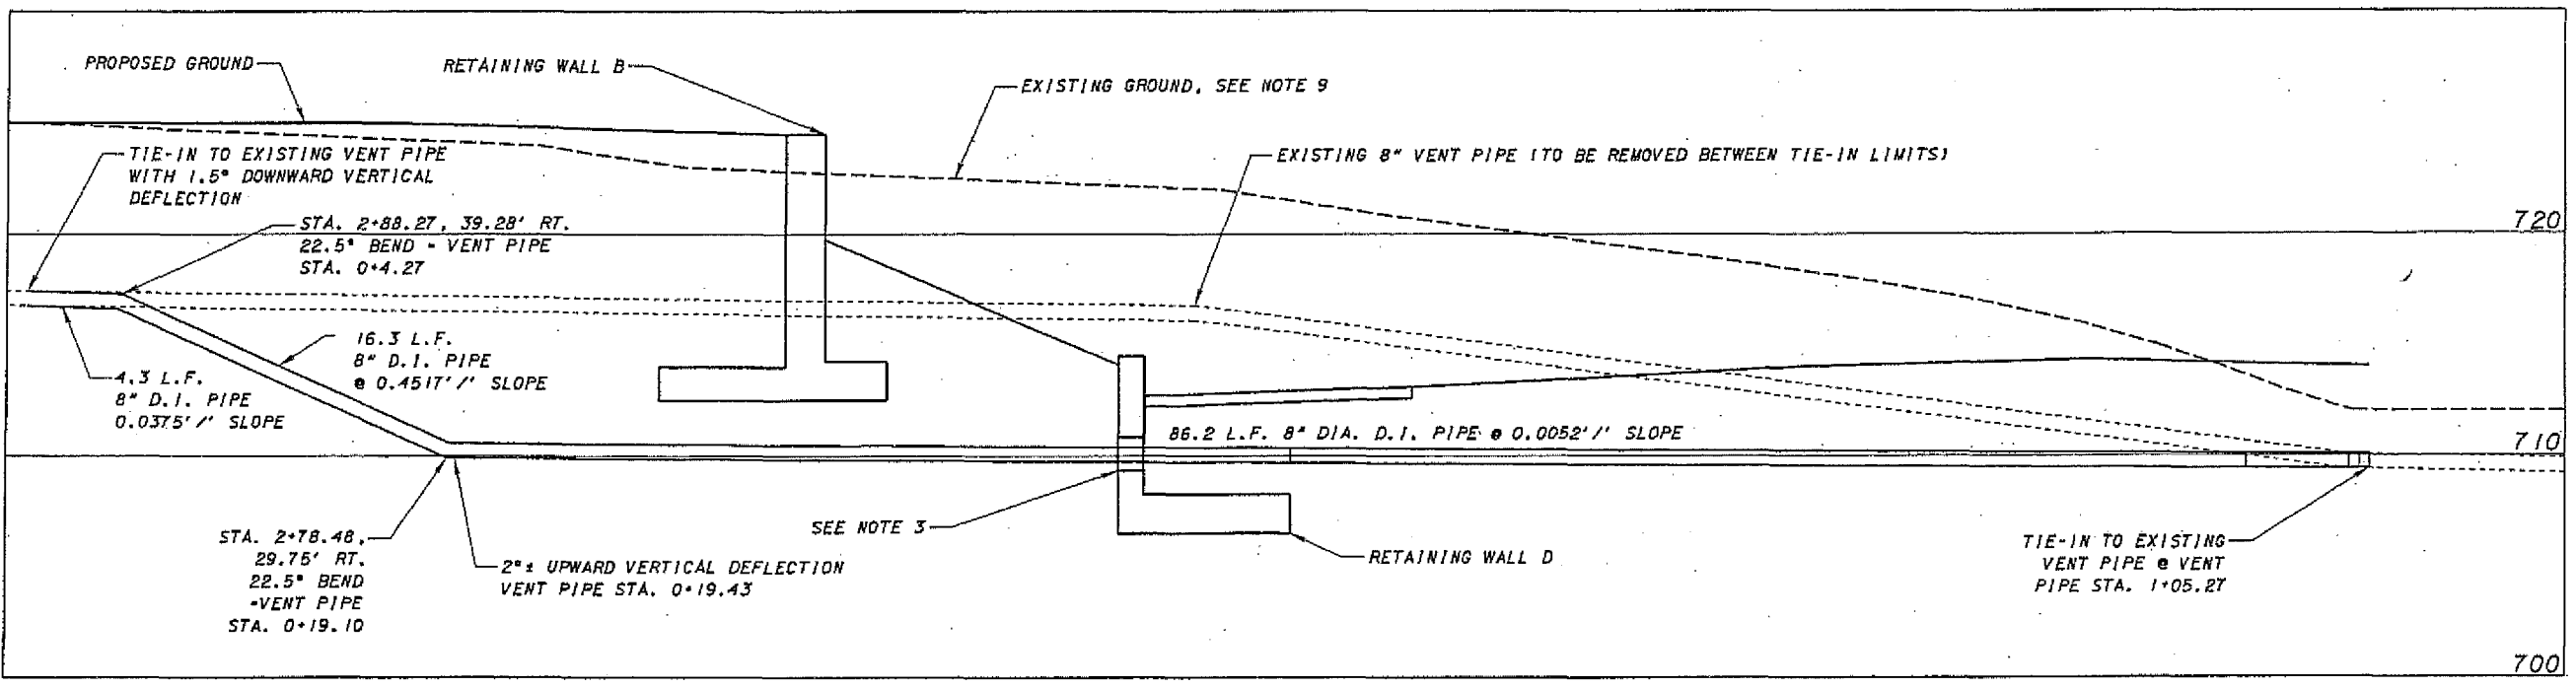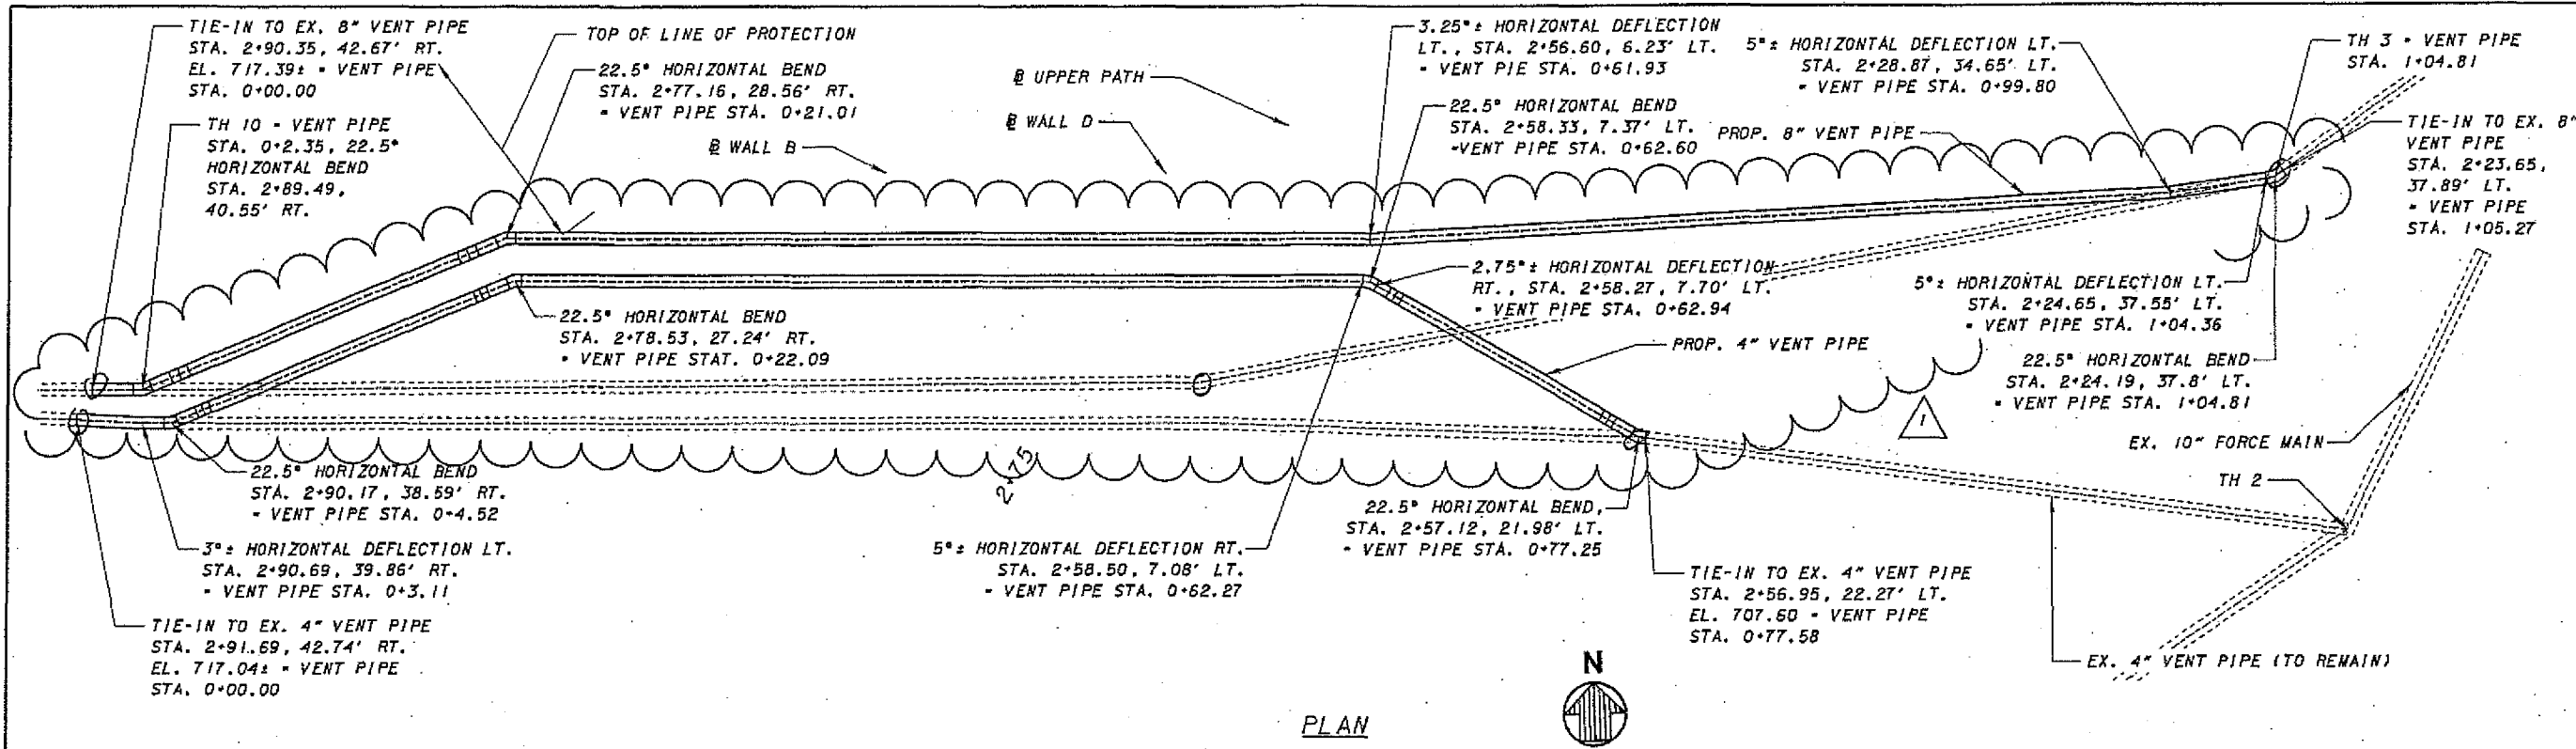

NOTES

1. STATIONS AND OFFSETS ARE BASED ON THE UPPER PATH ALIGNMENT SHOWN ON SHEET 91/299.
2. PROPOSED VENT PIPE ALIGNMENTS ARE BASED ON FIELD DATA PROVIDED BY SO-DEEP, DATED SEPTEMBER 25, 2006. ALL STATIONS AND ELEVATIONS ARE APPROXIMATE. THE CONTRACTOR SHALL DETERMINE THE EXACT LOCATION OF THE EXISTING VENT PIPES BEFORE STARTING THE REALIGNMENT WORK. ADJUSTMENTS MAY BE REQUIRED IN THE FIELD ONCE EXACT PIPE ALIGNMENTS ARE DETERMINED. PROVIDE THE CITY OF COLUMBUS WITH TIE-IN AND BEND STATIONS AND ELEVATIONS FOR THEIR AS-BUILT RECORDS.

3. PROVIDE AN 18" DIAMETER HOLE IN WALL D FOR THE 8" VENT PIPE. PROVIDE A 15" DIAMETER HOLE IN WALL D FOR THE 4" VENT PIPE. SEAL HOLES WITH NON-SHRINK GROUT FOR A WATERTIGHT FIT.
4. FOR 4" VENT PROFILE, SEE SHEET 111B/299.
5. FOR VENT PIPE QUANTITIES, SEE SHEET 111B/299.
6. FOR WALL B DETAILS, SEE SHEETS 114/299 THROUGH 116A/299.
7. FOR WALL D DETAILS, SEE SHEETS 119/299 THROUGH 121/299.

8. TH - TEST HOLE
9. EXISTING GROUND IS BASED ON FIELD SURVEY BY DLZ OHIO, INC. DATED NOVEMBER 2003.

BENCHMARK
 BENCHMARK - WEST END: EL. 712.67
 CHIS " " IN CENTER OF CONC. PUMP ISLAND (PUMPS REMOVED) NORTH OF RICH STREET WEST OF STARLING

THIS SHEET ADDED PER MIKE FOSTER

REVISED HORIZONTAL VENT PIPE ALIGNMENTS AND 8" VENT PIPE PROFILE
 DOR 11-07-08
 1934 DR. E


DLZ
 OHIO, INC.
 111A
 299

VENT PIPE REPLACEMENT PLAN
 BRIDGE NO. FRA-62-1411
 MAIN STREET OVER SCIOTO RIVER

FRA-62-14.11

DESIGNED	DOR	CHECKED
DRAWN	DOR	REVISED
REVIEWED	DOR	STRUCTURE FILE NUMBER
DATE	09-30-08	

8/7/2008 4:08 PM
 R:\proj\102\102\Project Plans\Waterbank Park\8 in Vent Pipe.dwg

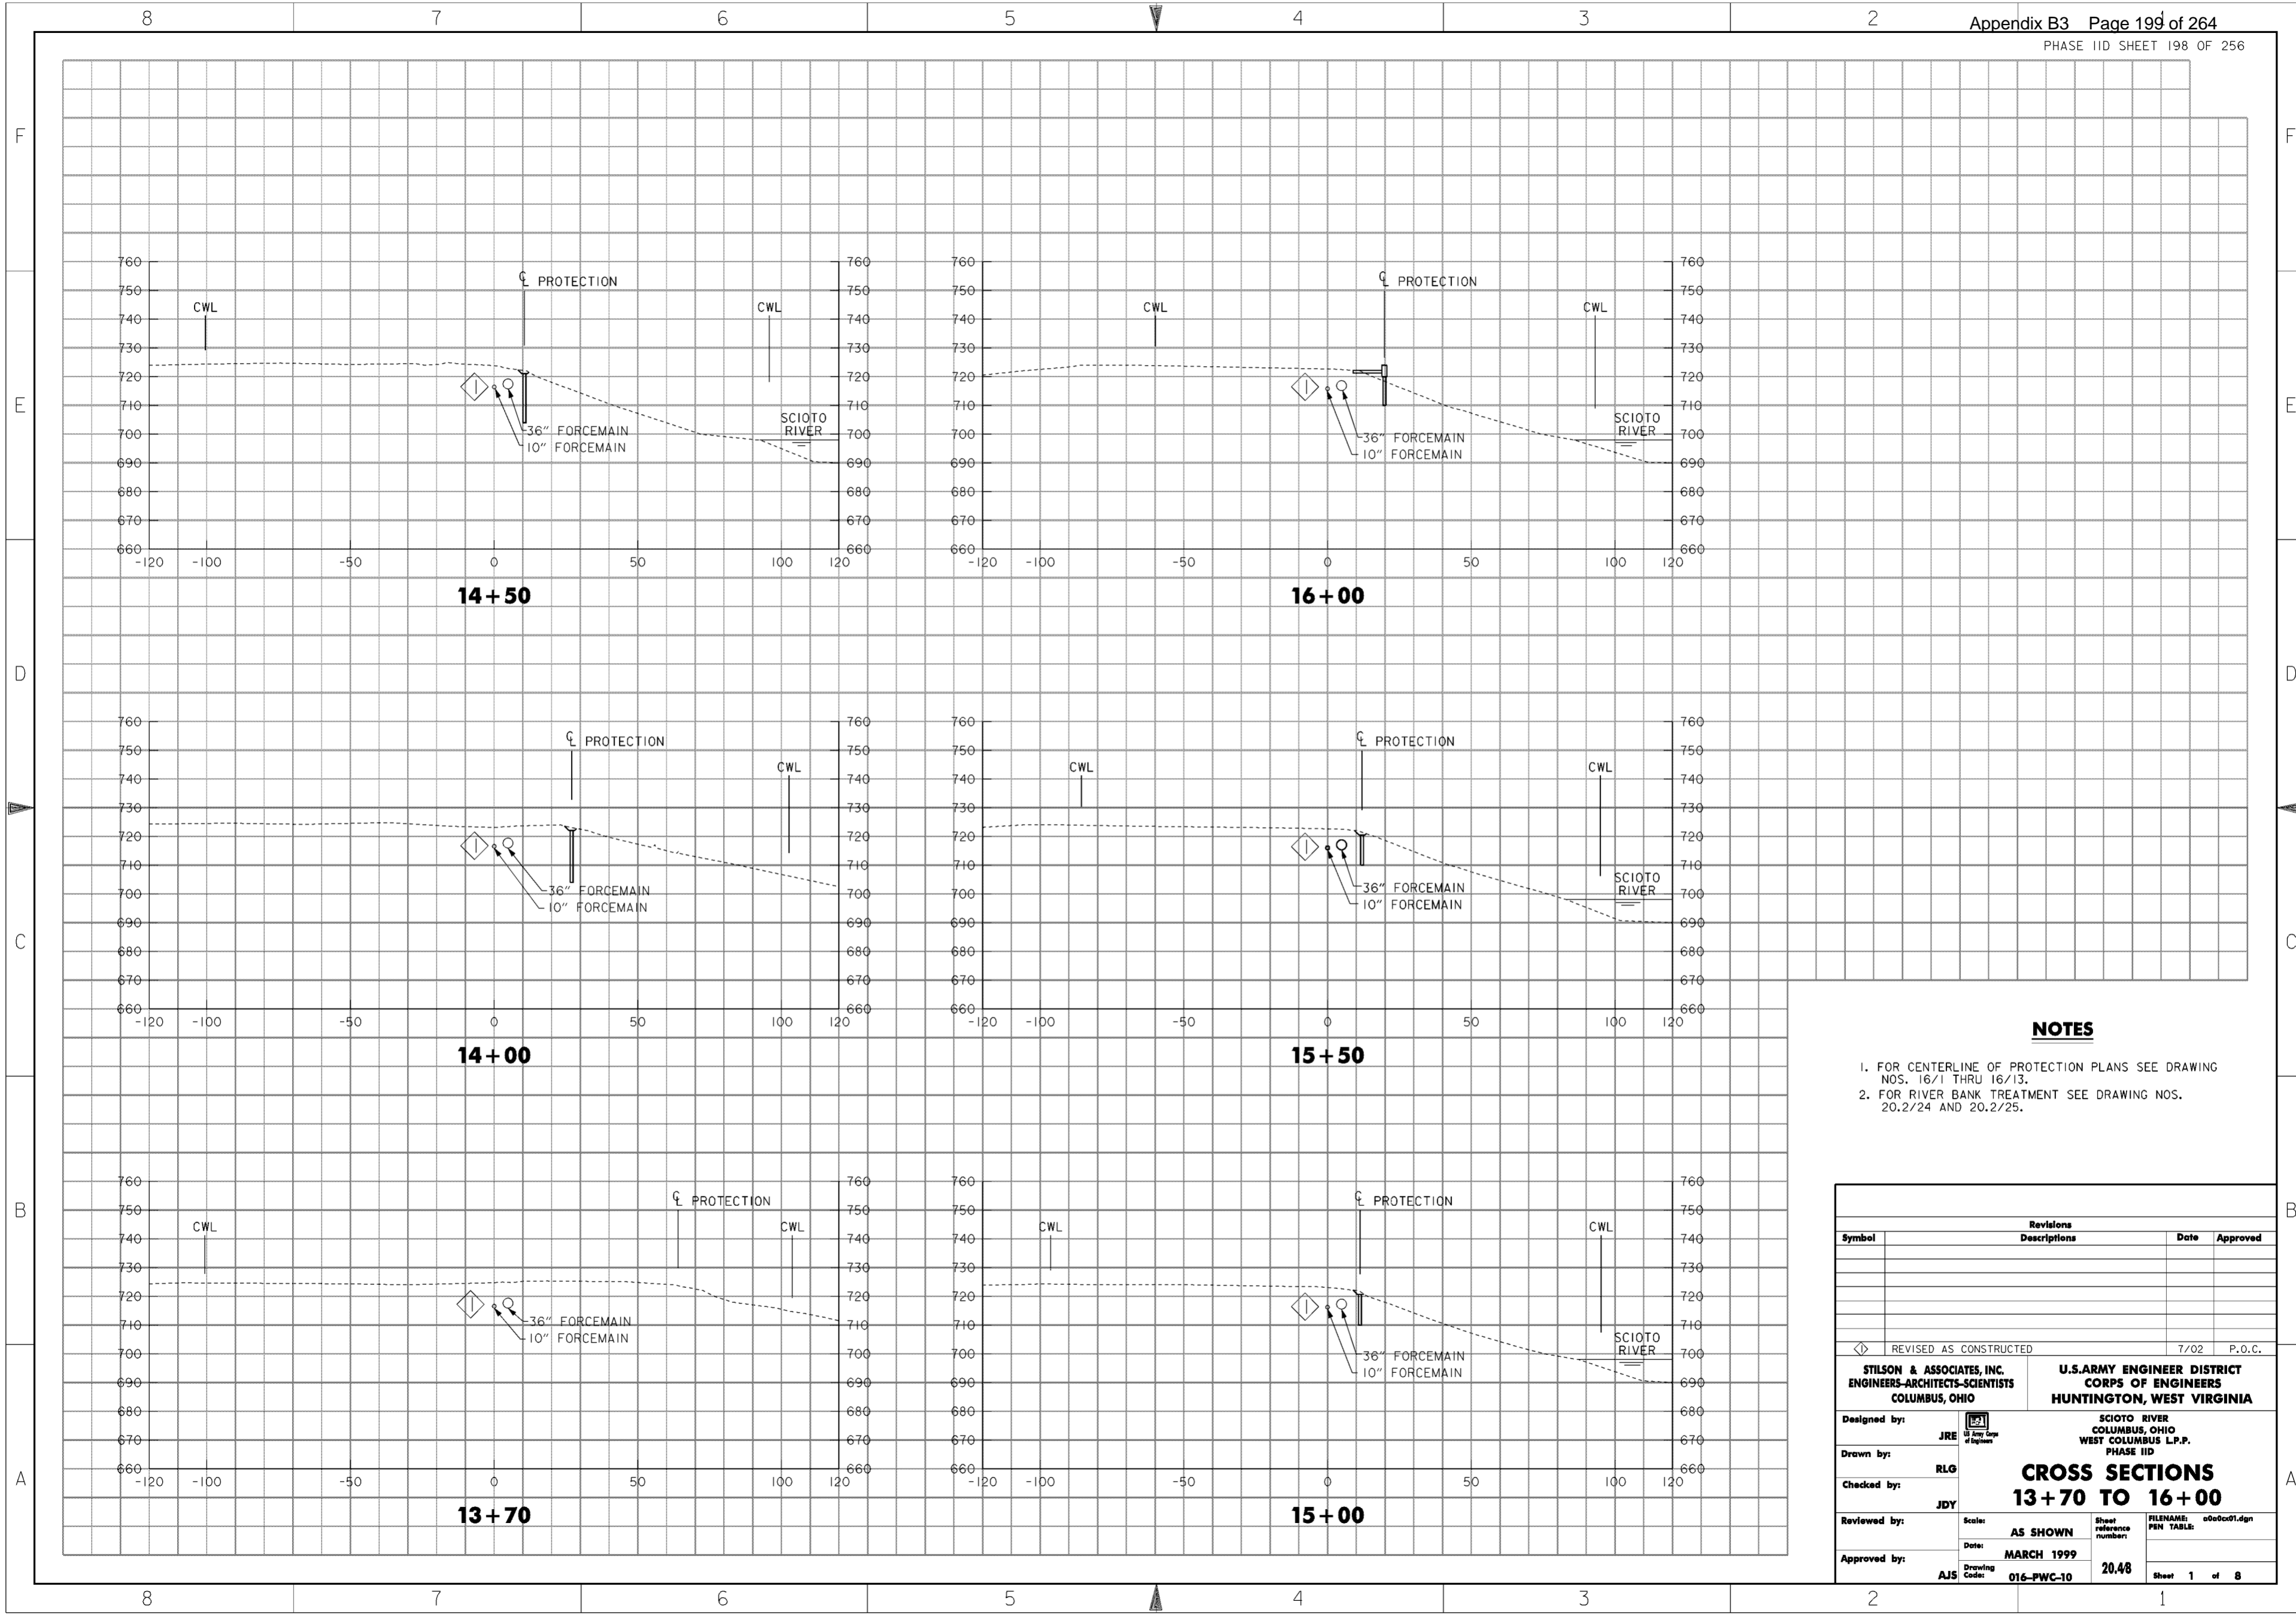


NOTES

1. FOR CENTERLINE OF PROTECTION PLANS SEE DRAWING NOS. 16/1 THRU 16/13.
2. FOR RIVER BANK TREATMENT SEE DRAWING NOS. 20.2/24 AND 20.2/25.


Revisions			
Symbol	Descriptions	Date	Approved
◊	REVISED AS CONSTRUCTED	7/02	P.O.C.

STILSON & ASSOCIATES, INC. ENGINEERS-ARCHITECTS-SCIENTISTS COLUMBUS, OHIO	U.S. ARMY ENGINEER DISTRICT CORPS OF ENGINEERS HUNTINGTON, WEST VIRGINIA
Designed by: JRE Drawn by: RLG Checked by: JDY Reviewed by: _____ Approved by: AJS	SCIO TO RIVER COLUMBUS, OHIO WEST COLUMBUS L.P.P. PHASE IID CROSS SECTIONS 13+70 TO 16+00 Scale: AS SHOWN Date: MARCH 1999 Drawing Code: 016-PWC-10
Sheet reference numbers: 20,48 FILENAME: a00cc01.dgn PEN TABLE: Sheet 1 of 8	


WORK AS CONSTRUCTED

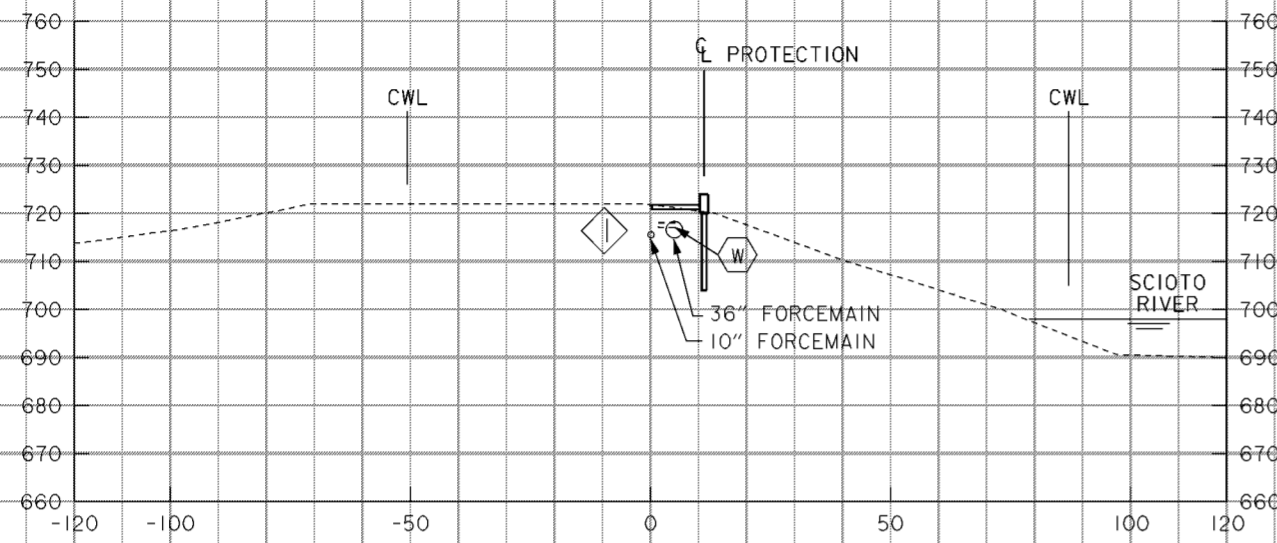


17+50

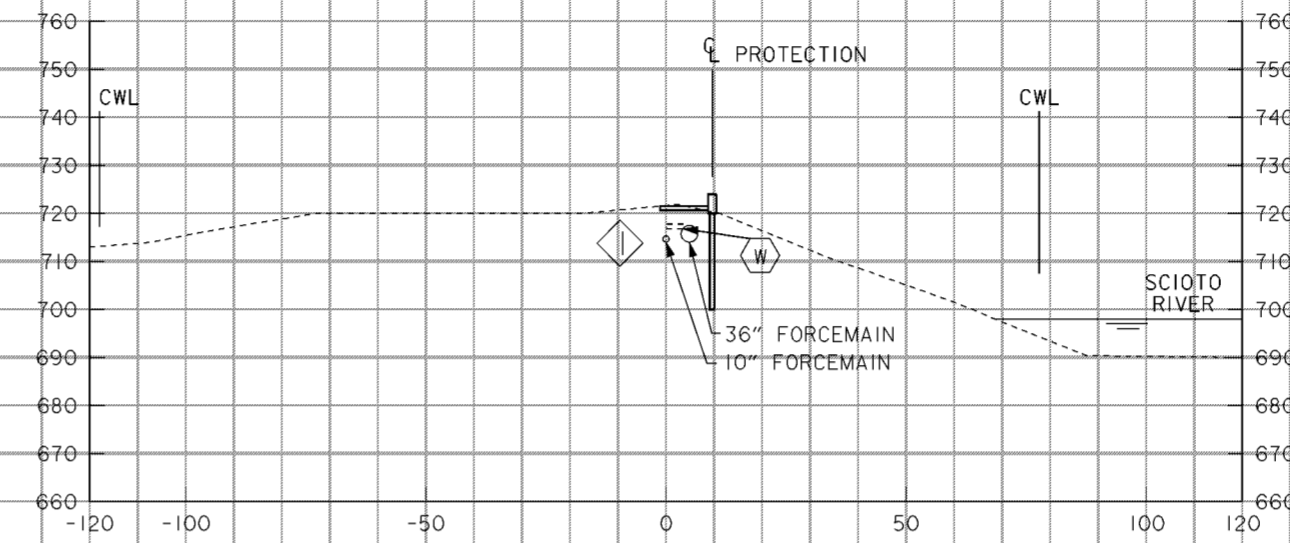


19+00

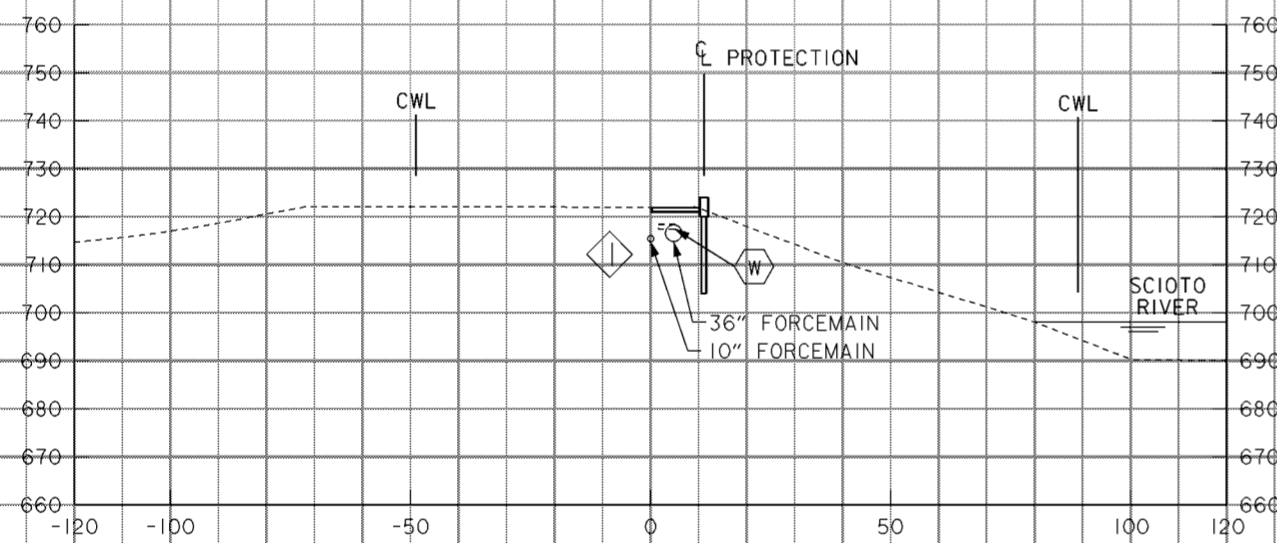


17+00

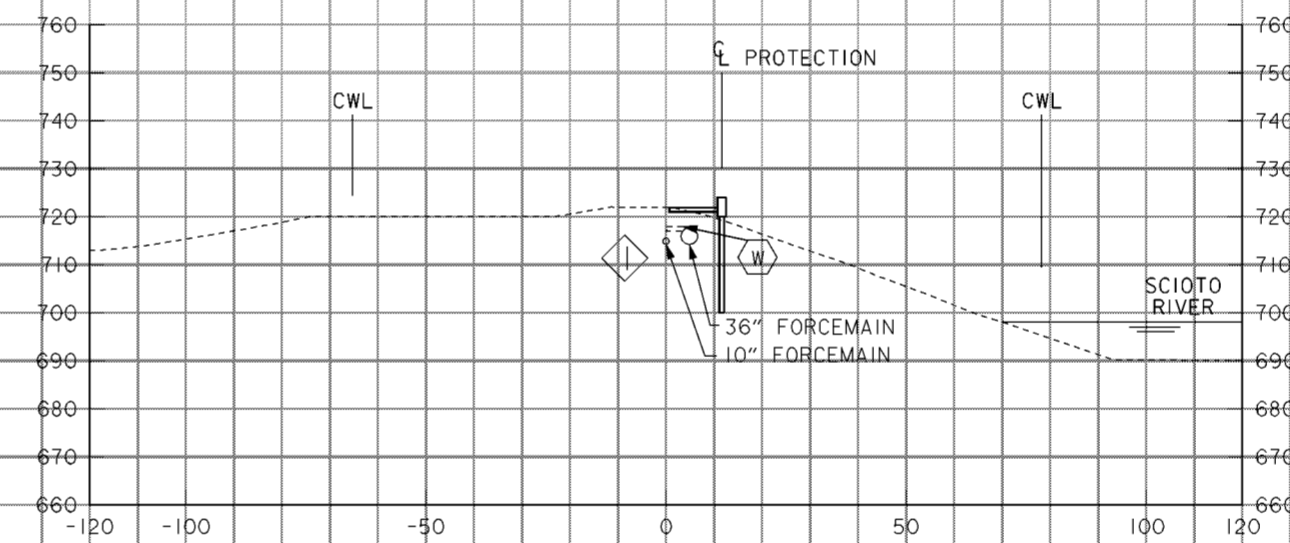

18+50

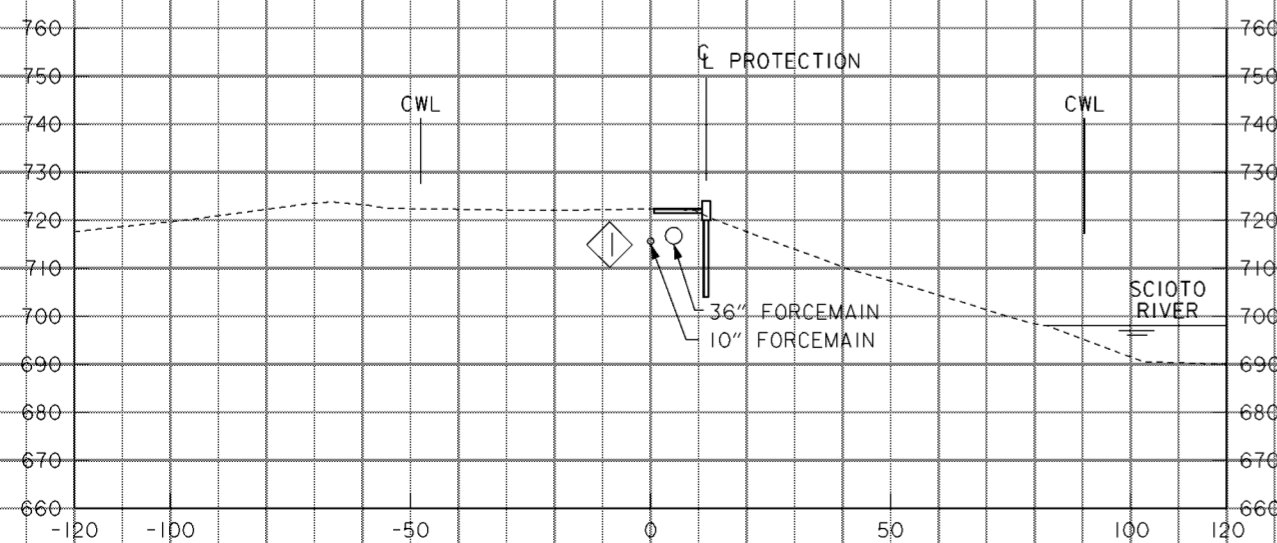

16+50

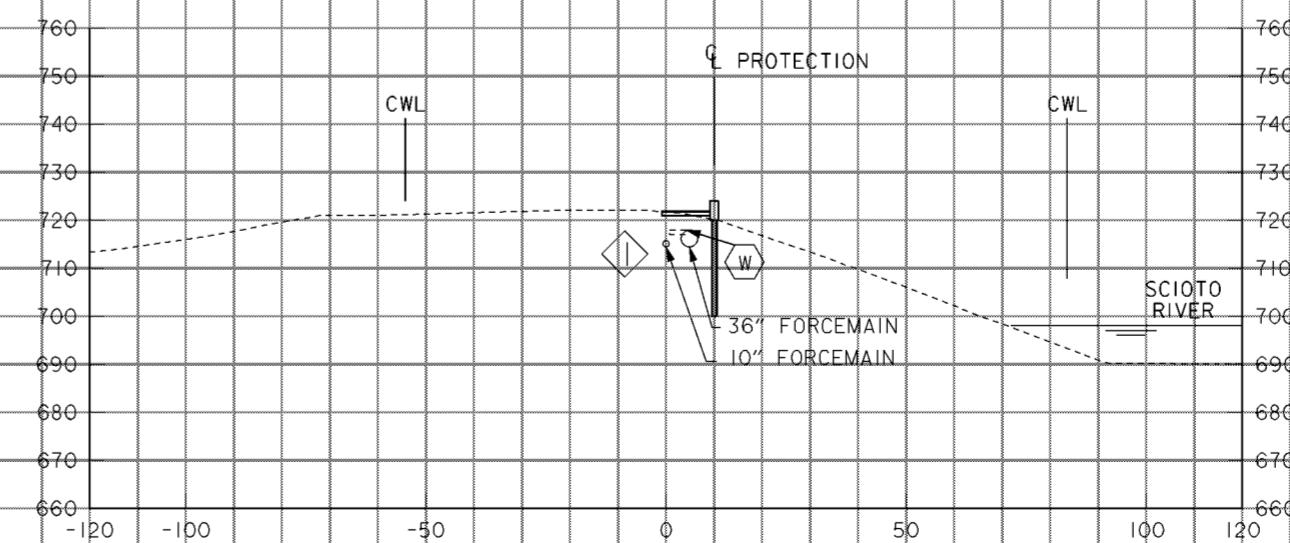

18+00


NOTES

1. FOR CENTERLINE OF PROTECTION PLANS SEE DRAWING NOS. 16/1 THRU 16/13.
2. FOR RIVER BANK TREATMENT SEE DRAWING NOS. 20.2/24 AND 20.2/25.

Revisions			
Symbol	Descriptions	Date	Approved
◊	REVISED AS CONSTRUCTED	7/02	P.O.C.

STILSON & ASSOCIATES, INC. ENGINEERS-ARCHITECTS-SCIENTISTS COLUMBUS, OHIO	U.S. ARMY ENGINEER DISTRICT CORPS OF ENGINEERS HUNTINGTON, WEST VIRGINIA
Designed by: JRE Drawn by: RLG Checked by: JDY Reviewed by: _____ Approved by: AJS	SCIOTO RIVER COLUMBUS, OHIO WEST COLUMBUS L.P.P. PHASE IID CROSS SECTIONS 16+50 TO 19+00 Scale: AS SHOWN Date: MARCH 1999 Drawing Code: 016-PWC-10
Sheet reference numbers: 20,49 FILENAME: a00c02.dgn PEN TABLE: _____ Sheet 2 of 8	

WORK AS CONSTRUCTED

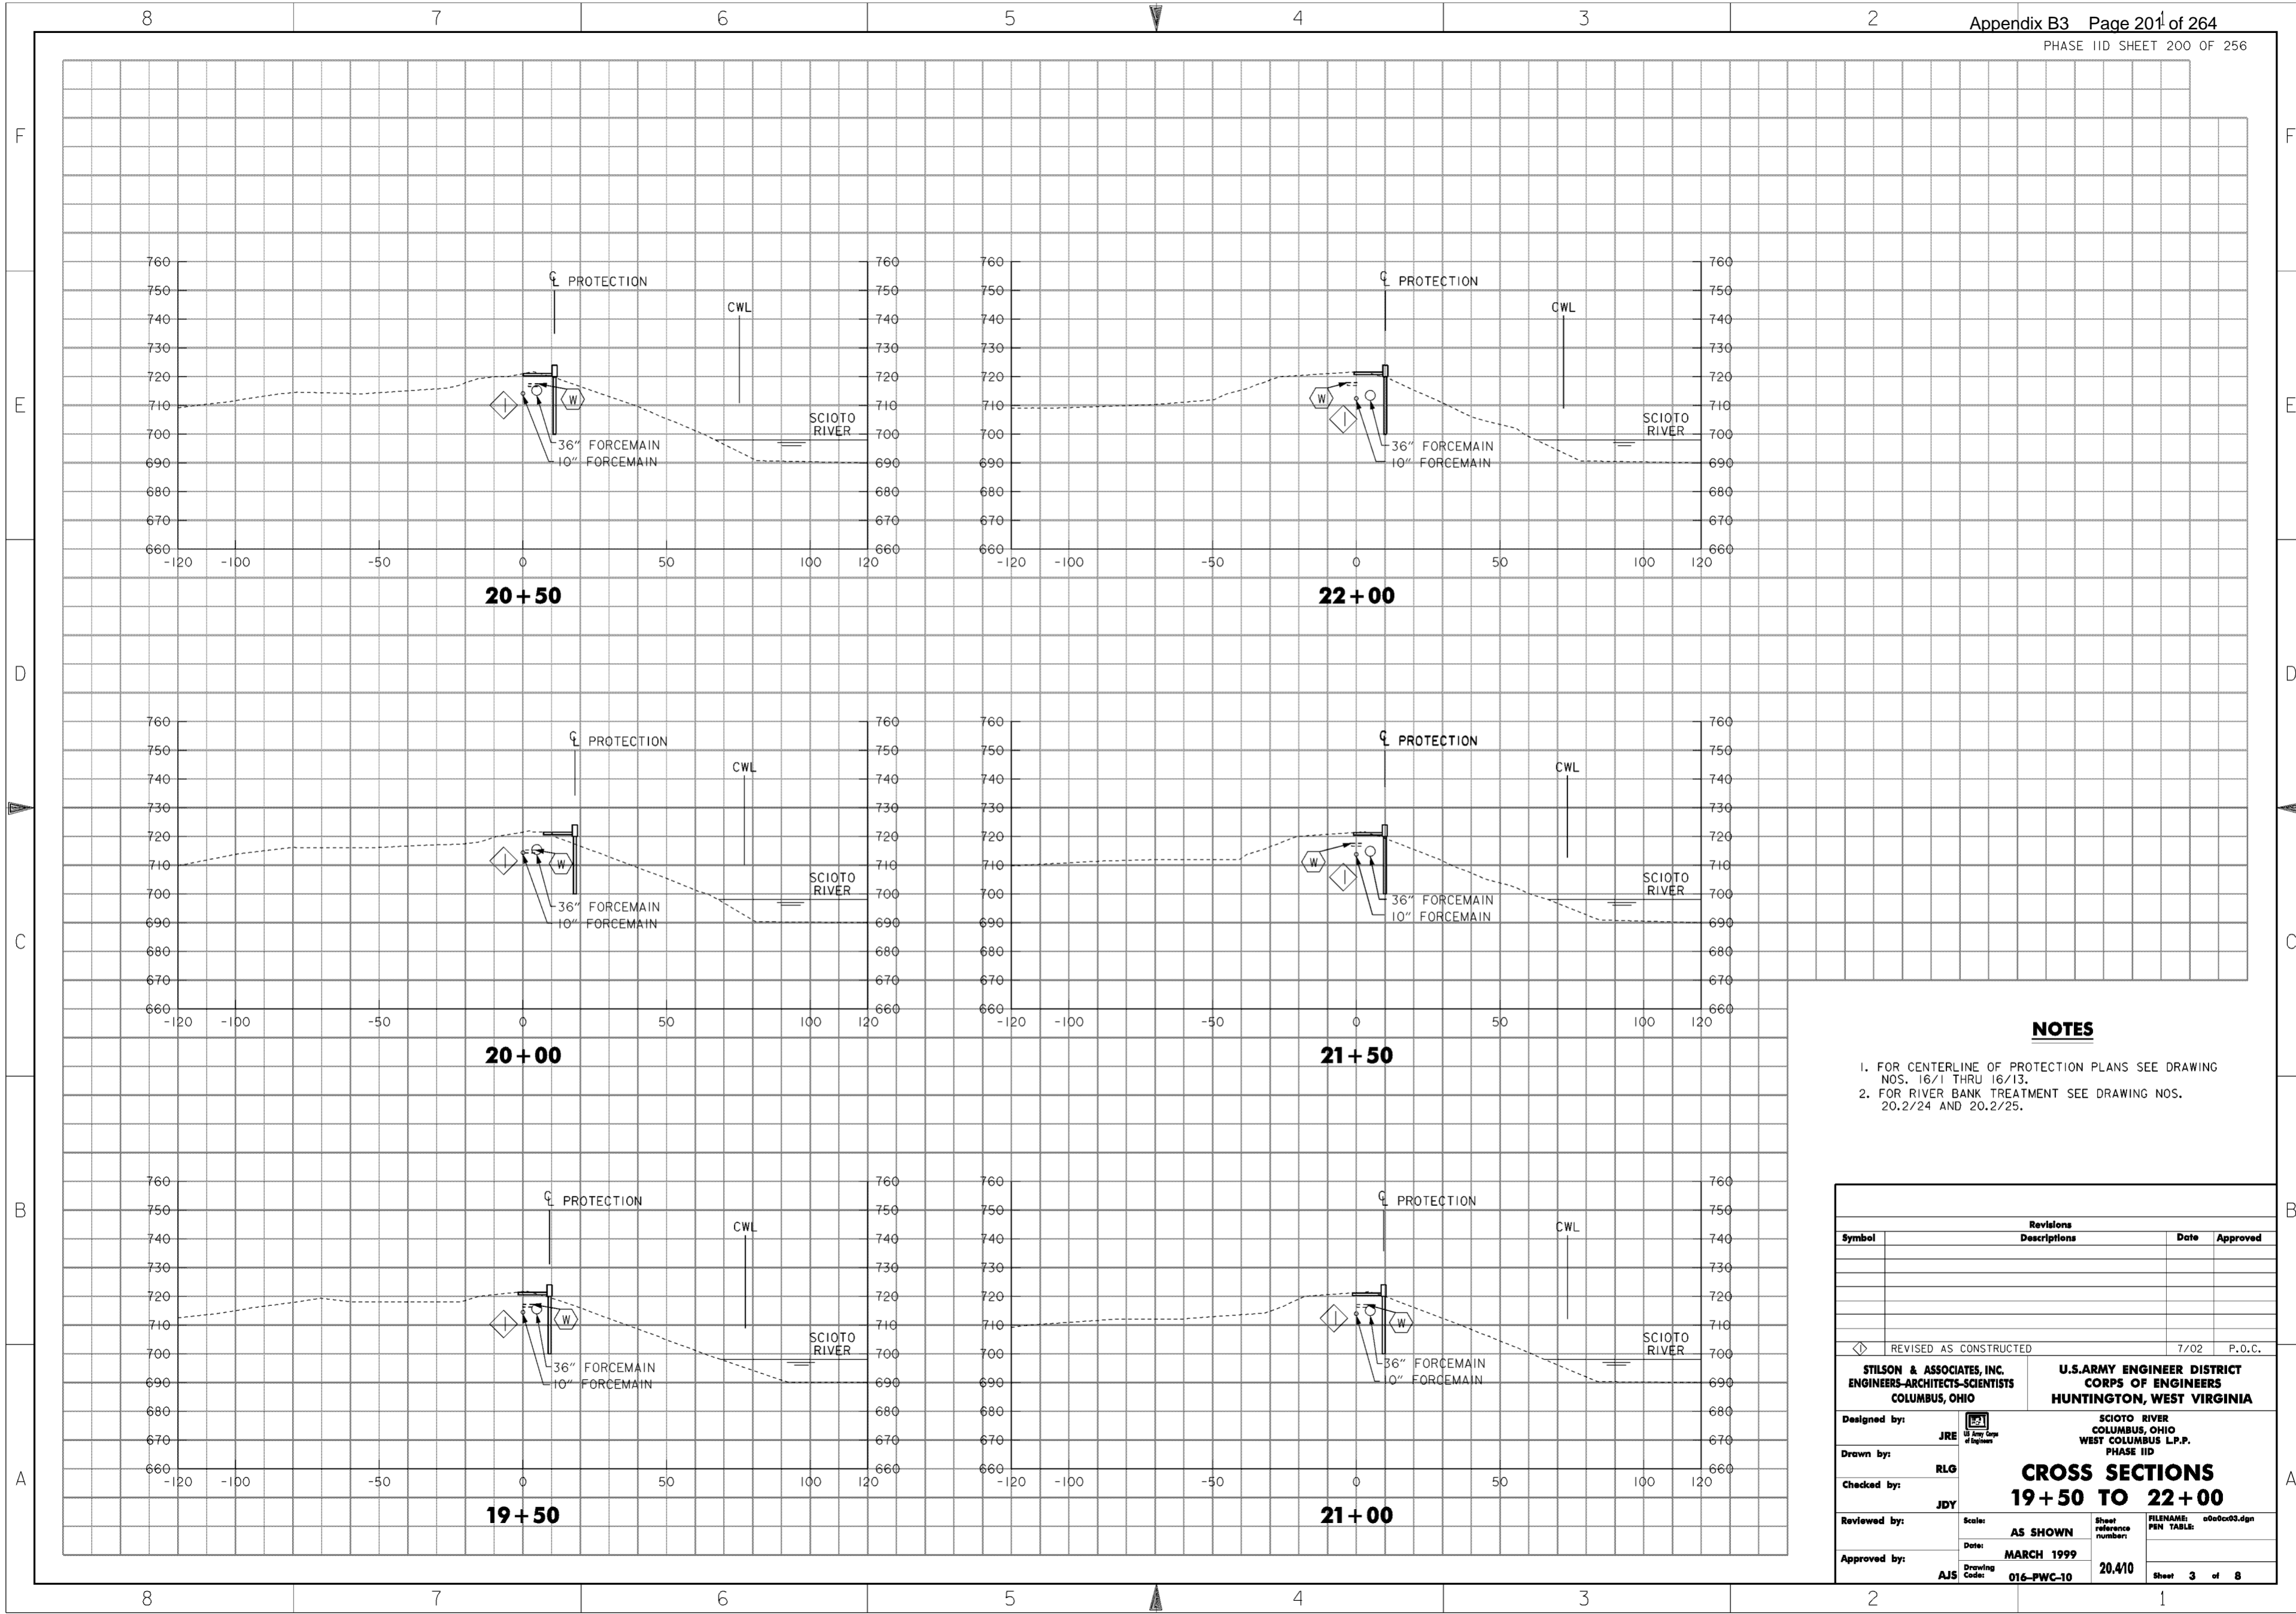

NOTES


1. FOR CENTERLINE OF PROTECTION PLANS SEE DRAWING NOS. 16/1 THRU 16/13.
2. FOR RIVER BANK TREATMENT SEE DRAWING NOS. 20.2/24 AND 20.2/25.

Revisions			
Symbol	Descriptions	Date	Approved
◁	REVISED AS CONSTRUCTED	7/02	P.O.C.


STILSON & ASSOCIATES, INC. ENGINEERS-ARCHITECTS-SCIENTISTS COLUMBUS, OHIO	U.S. ARMY ENGINEER DISTRICT CORPS OF ENGINEERS HUNTINGTON, WEST VIRGINIA
Designed by: JRE Drawn by: RLG Checked by: JDY Reviewed by: _____ Approved by: AJS	SCIOTO RIVER COLUMBUS, OHIO WEST COLUMBUS L.P.P. PHASE IID CROSS SECTIONS 19 + 50 TO 22 + 00 Scale: AS SHOWN Date: MARCH 1999 Drawing Code: 016-PWC-10
Sheet reference numbers: FILENAME: a00c03.dgn PEN TABLE: 20.4/10 Sheet 3 of 8	

WORK AS CONSTRUCTED


W EXISTING UNDERGROUND ELECTRIC

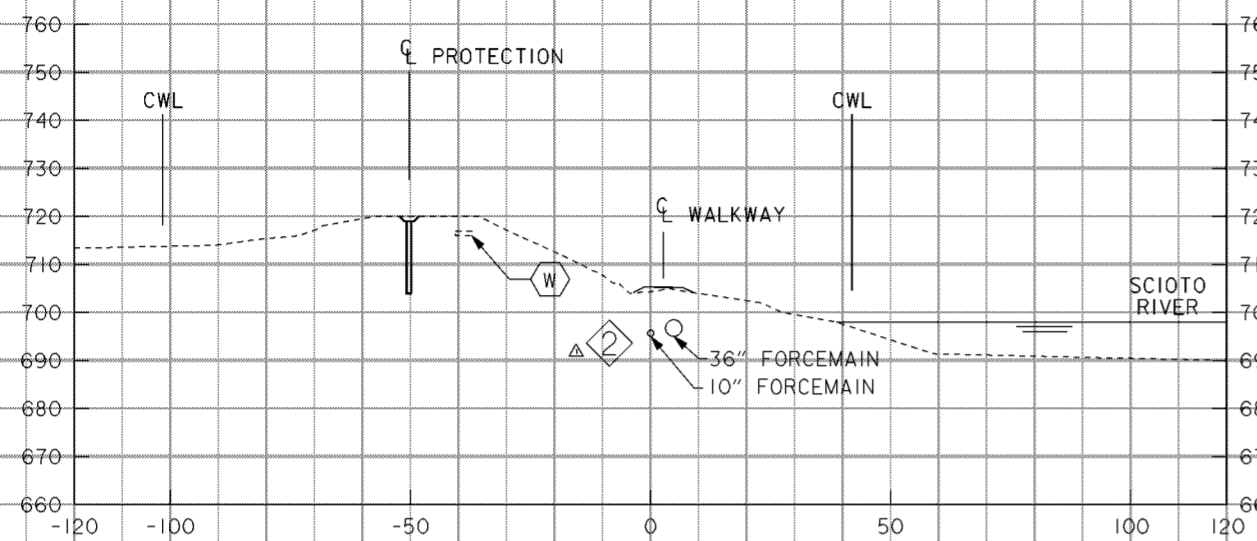


29+50

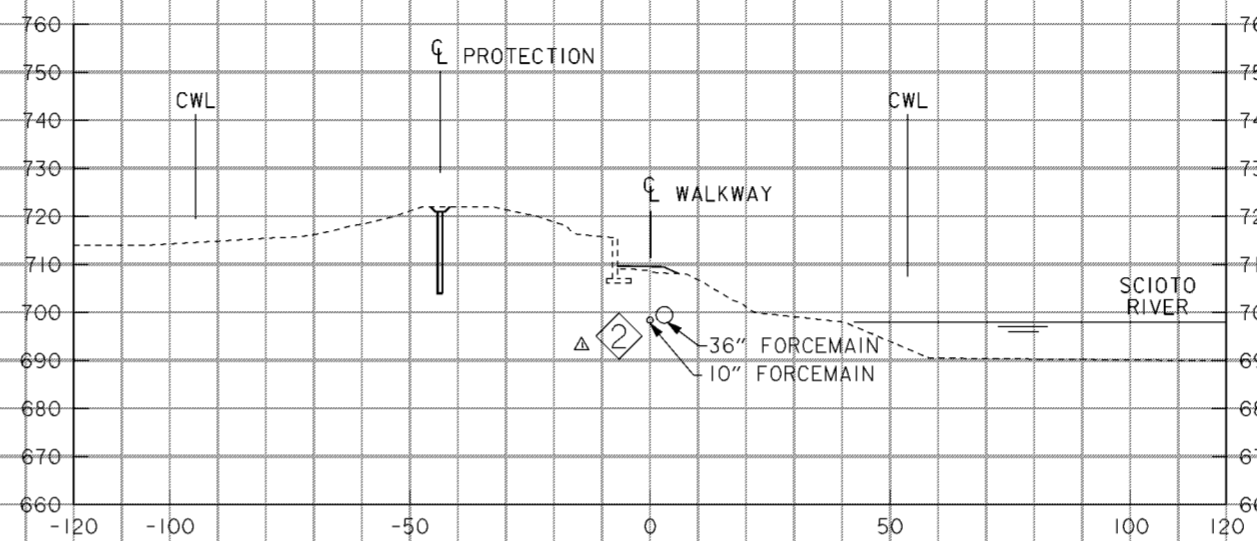


31+00

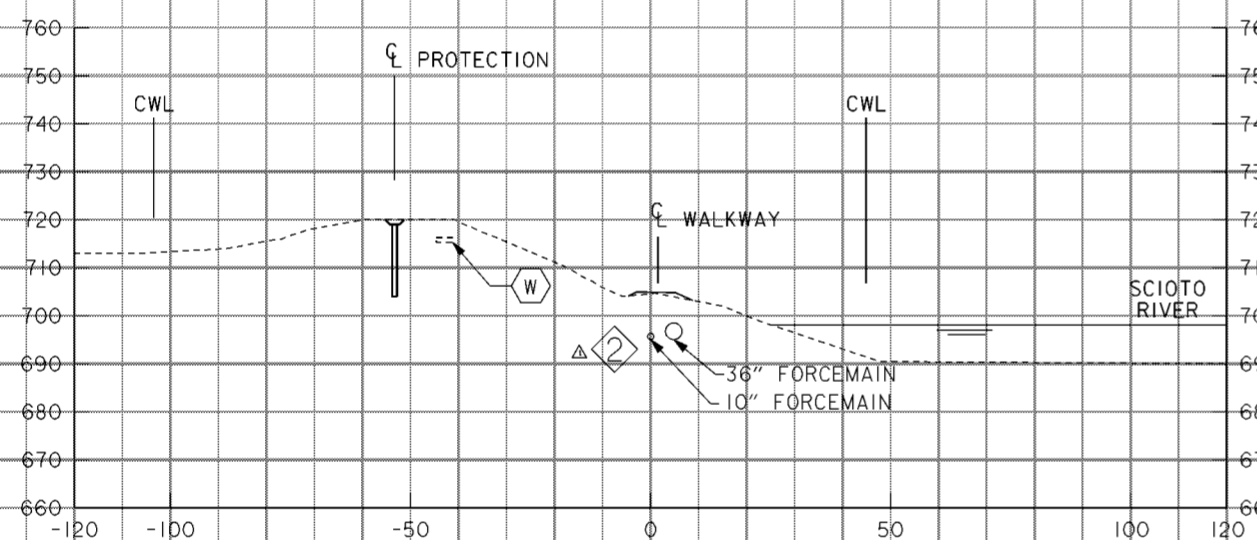


29+00

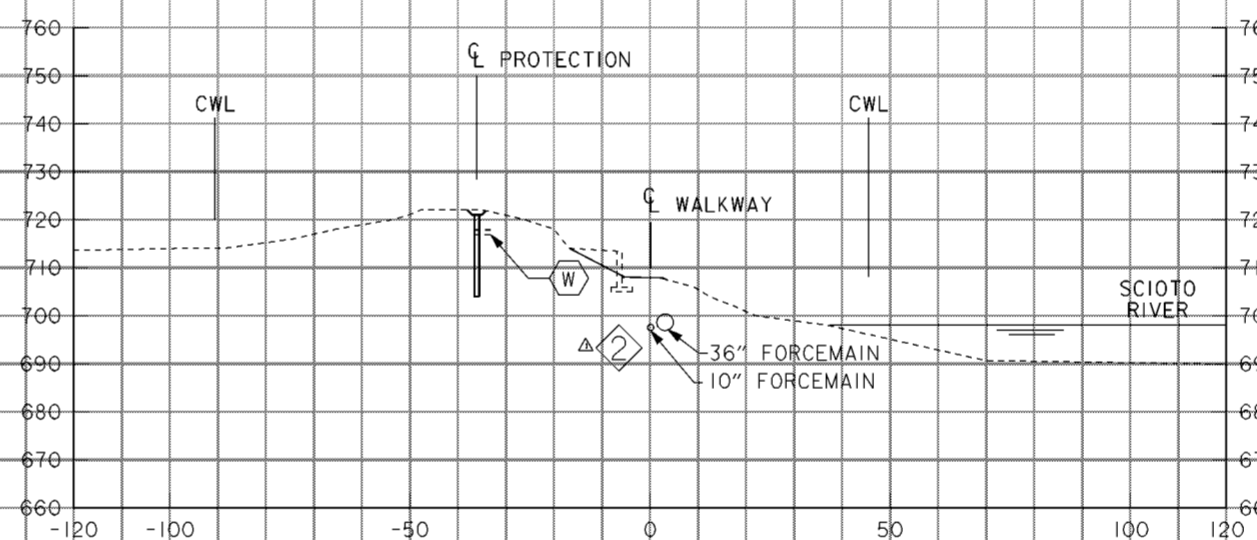

30+50

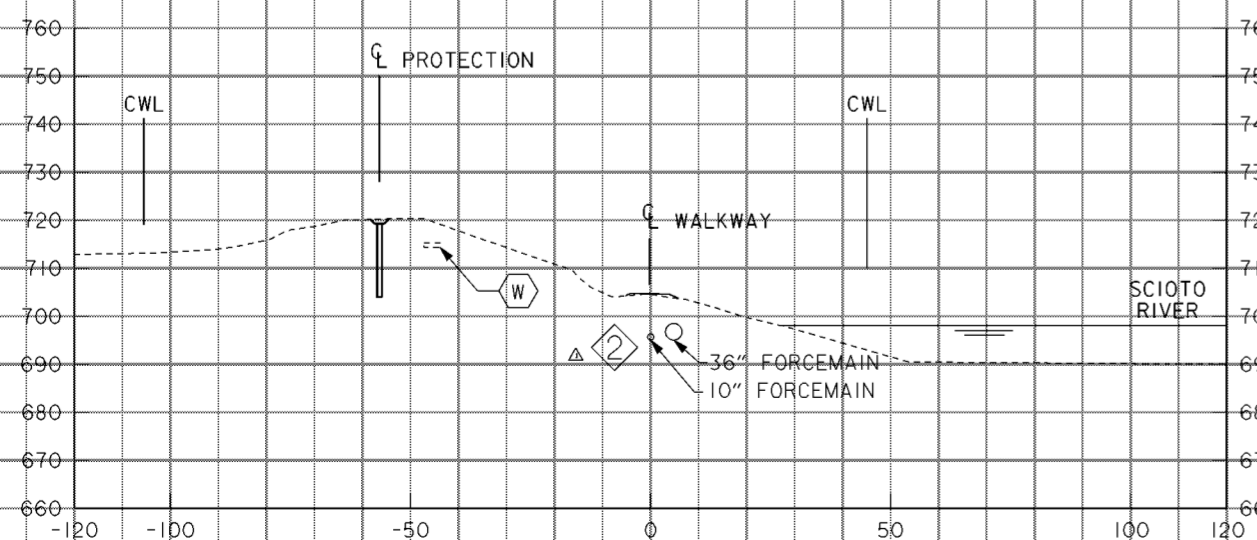

28+50

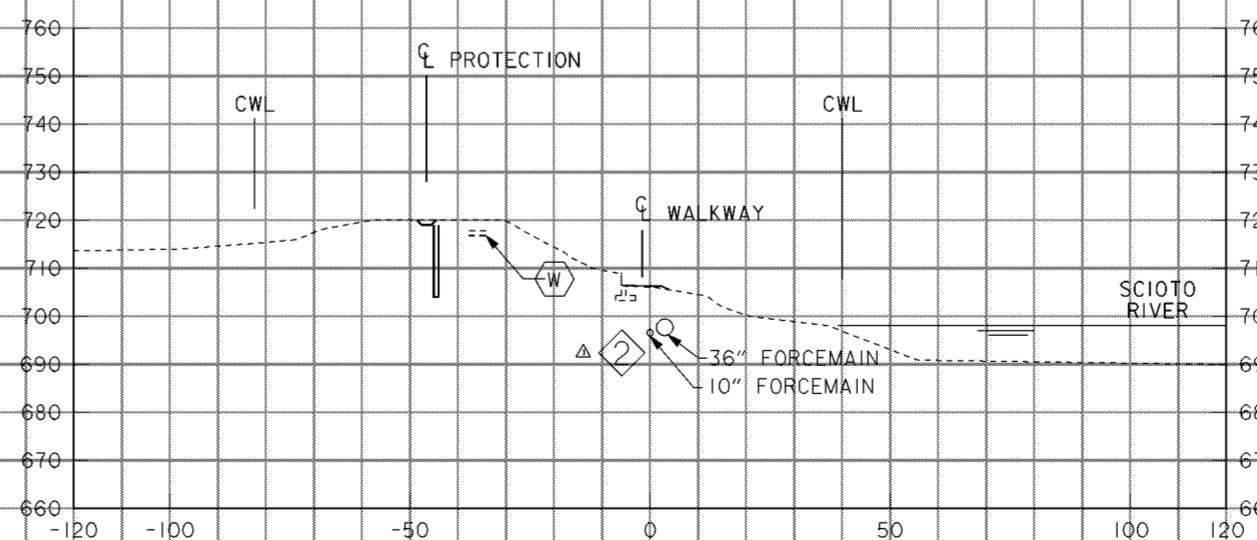

30+00

NOTES


1. FOR CENTERLINE OF PROTECTION PLANS SEE DRAWING NOS. 16/1 THRU 16/13.
2. FOR WALKWAY PLAN SEE DRAWING NOS. 20.5/1 THRU 20.5/4.
3. FOR TREETWELL DETAILS SEE DRAWING NO. 20.5/5.
4. LEVEE WORK NOT SHOWN FOR PROTECTION.

Revisions			
Symbol	Descriptions	Date	Approved
◇	REVISED AS CONSTRUCTED	7/02	P.O.C.
△	REVISED IN ACCORDANCE WITH AMENDMENT 0001	4/23/98	


STILSON & ASSOCIATES, INC. ENGINEERS-ARCHITECTS-SCIENTISTS COLUMBUS, OHIO	U.S. ARMY ENGINEER DISTRICT CORPS OF ENGINEERS HUNTINGTON, WEST VIRGINIA
Designed by: JRE Drawn by: RLG Checked by: JDY Reviewed by: _____ Approved by: AJS	SCIO TO RIVER COLUMBUS, OHIO WEST COLUMBUS L.P.P. PHASE IID CROSS SECTIONS 28+50 TO 31+00 Scale: AS SHOWN Date: MARCH 1999 Drawing Code: 016-PWC-10
Sheet reference numbers: _____ FILENAME: a00c06.dgn PEN TABLE: _____ 20.4/3 Sheet 6 of 8	

WORK AS CONSTRUCTED


W EXISTING UNDERGROUND ELECTRIC

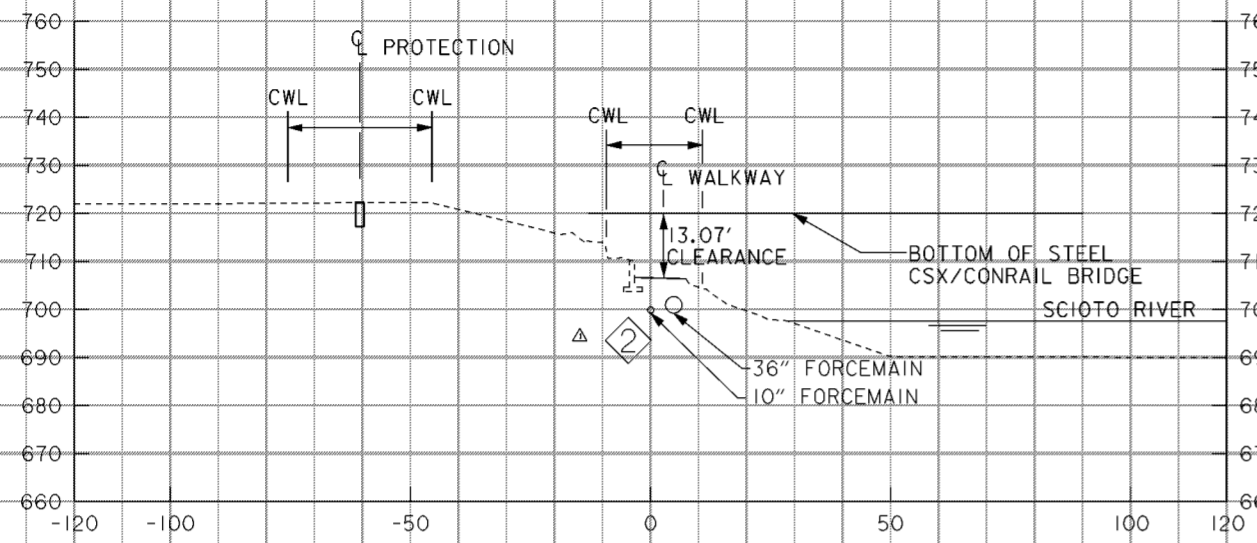


32+50

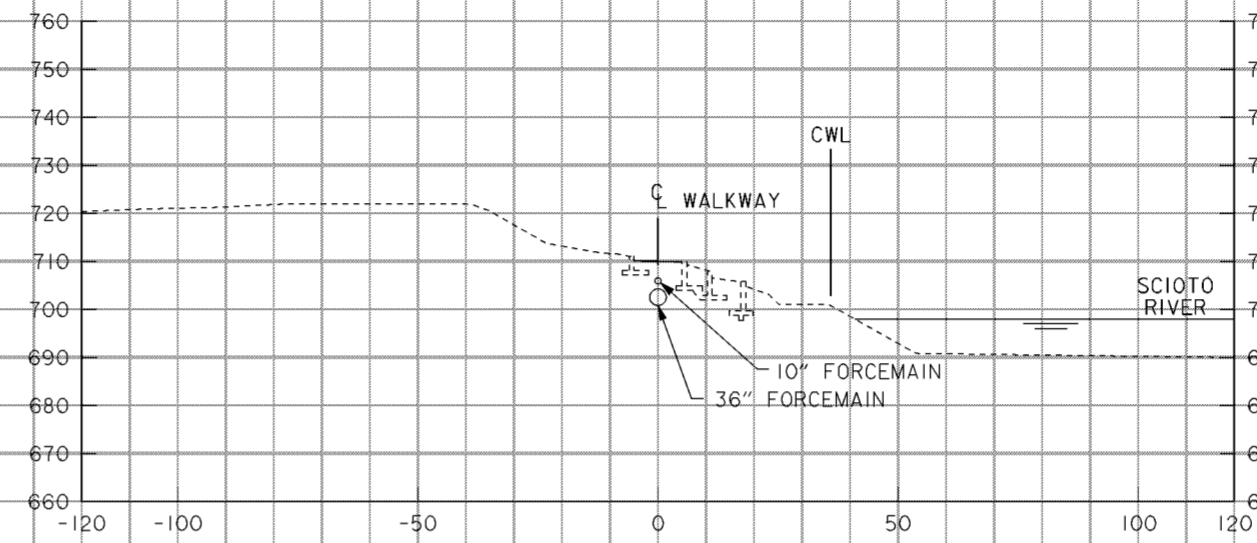


34+00

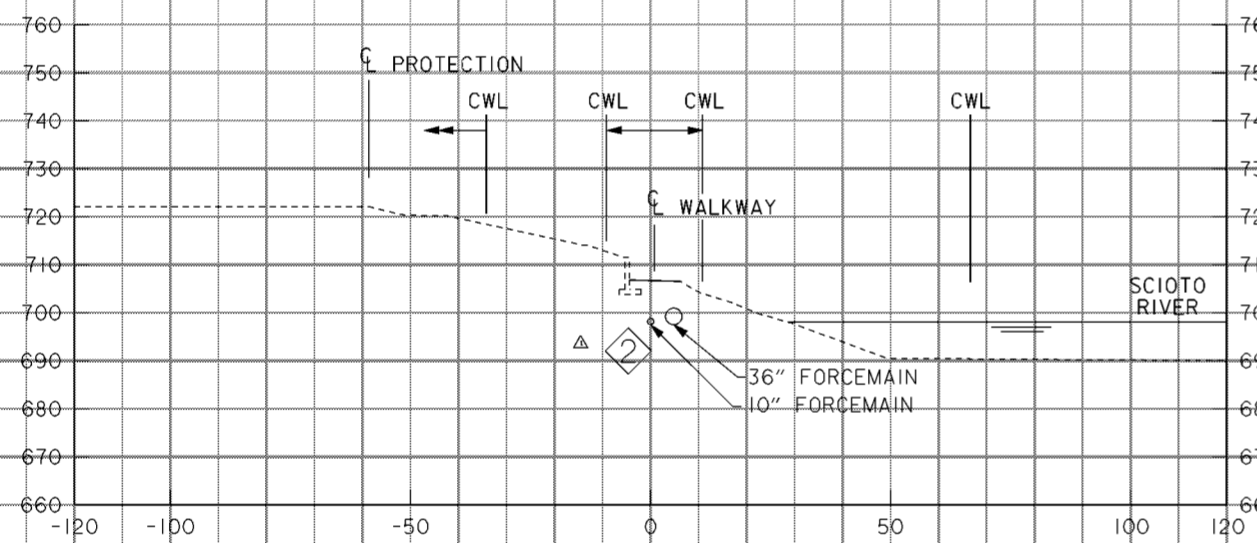


32+00

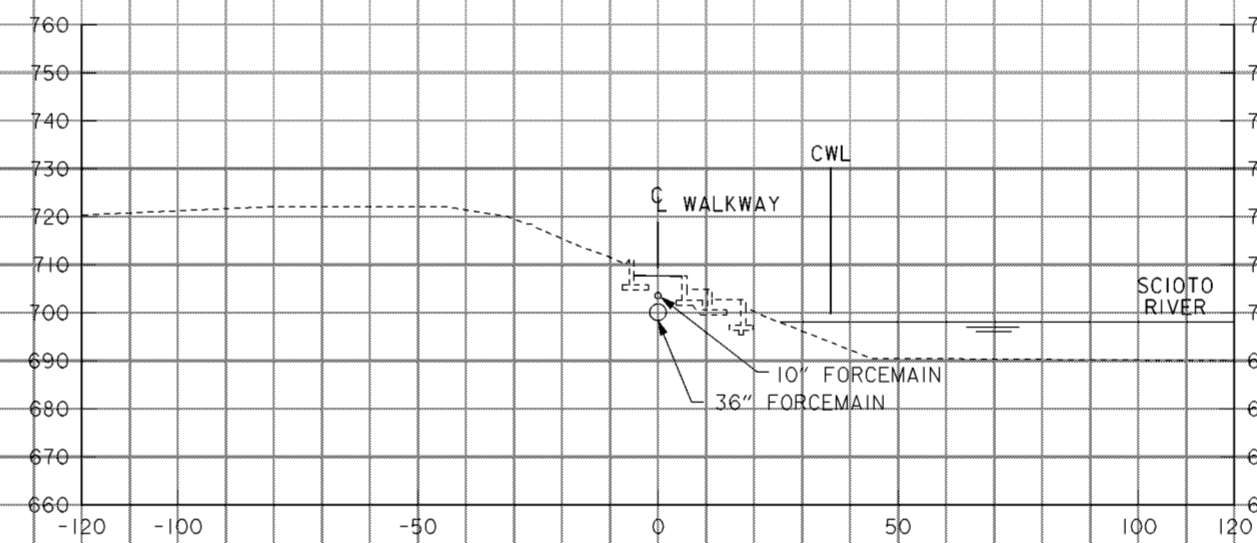

33+50

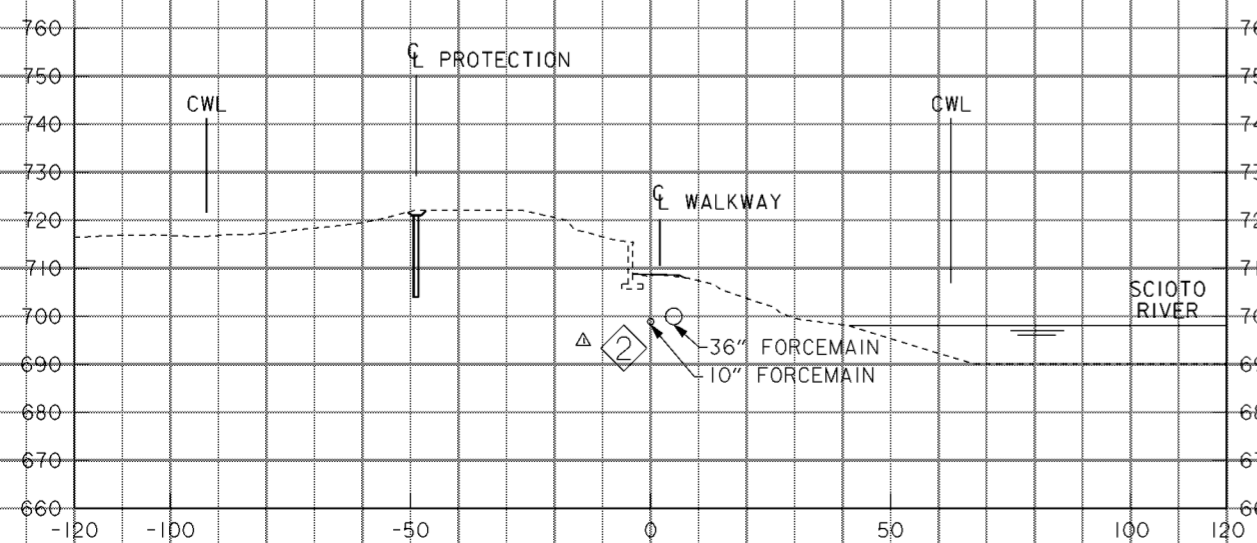

31+50

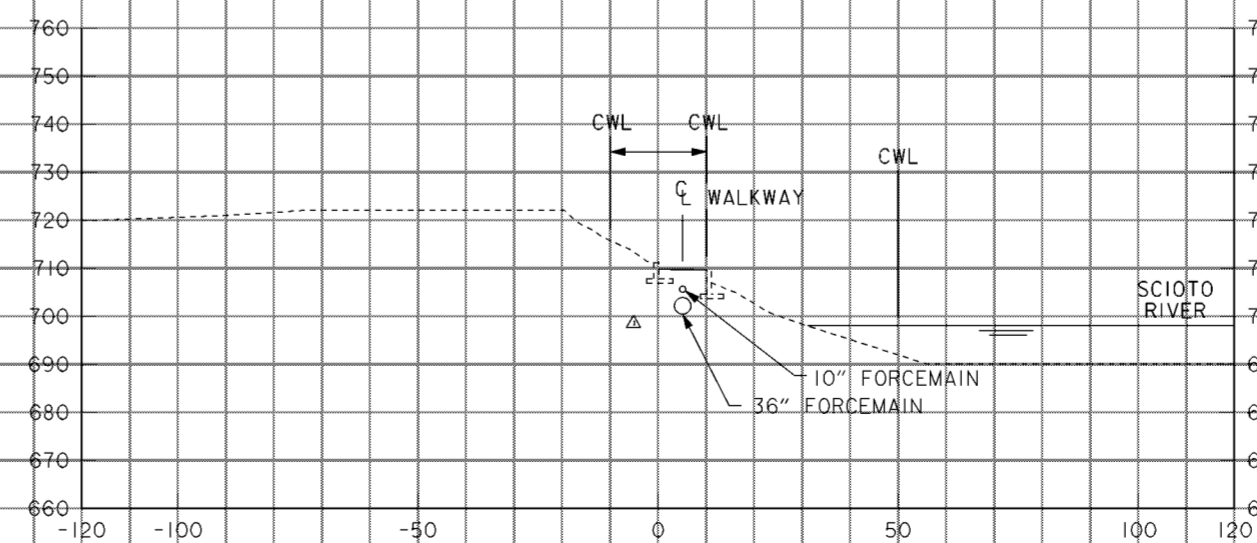

33+00


NOTES

1. FOR CENTERLINE OF PROTECTION PLANS SEE DRAWING NOS. 16/1 THRU 16/13.
2. FOR WALKWAY PLAN SEE DRAWING NOS. 20.5/1 THRU 20.5/4.
3. FOR TREEWELL DETAILS SEE DRAWING NO. 20.5/5.
4. LEVEE WORK NOT SHOWN FOR E PROTECTION.

Revisions			
Symbol	Descriptions	Date	Approved
◊	REVISED AS CONSTRUCTED	7/02	P.O.C.
△	REVISED IN ACCORDANCE WITH AMENDMENT 0001	4/23/98	


STILSON & ASSOCIATES, INC. ENGINEERS-ARCHITECTS-SCIENTISTS COLUMBUS, OHIO	U.S. ARMY ENGINEER DISTRICT CORPS OF ENGINEERS HUNTINGTON, WEST VIRGINIA
Designed by: JRE Drawn by: RLG Checked by: JDY Reviewed by: _____ Approved by: AJS	SCIOTO RIVER COLUMBUS, OHIO WEST COLUMBUS L.P.P. PHASE IID CROSS SECTIONS 31+50 TO 34+00 Scale: AS SHOWN Date: MARCH 1999 Drawing Code: 016-PWC-10
Sheet reference numbers: _____ FILENAME: a00cc07.dgn PEN TABLE: _____ 20.4/4 Sheet 7 of 8	

WORK AS CONSTRUCTED

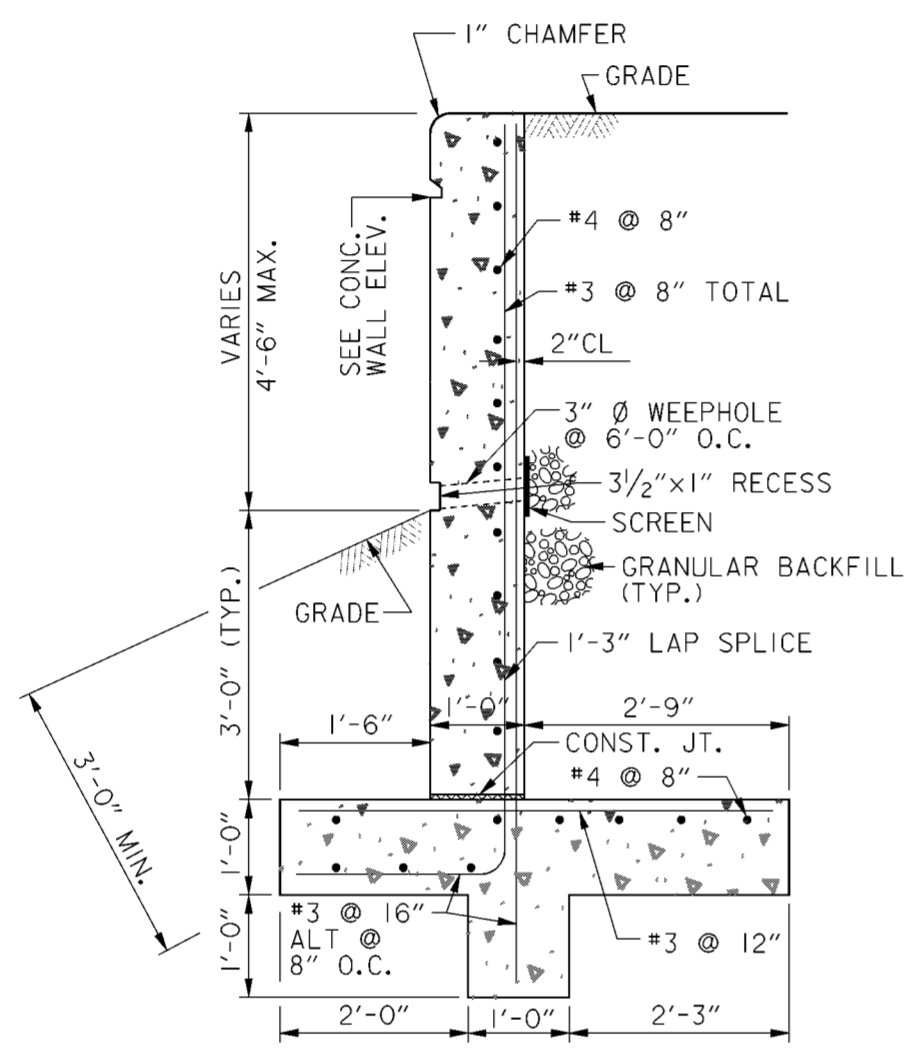

CONCRETE RETAINING WALL
N.T.S.

NOTE:
PROVIDE #4x24" HORIZONTAL DOWELS
IN GROUTED SOLID 3/4" Ø HOLES @ 16' c/c
AT NEW/EXISTING WALL INTERFACE.

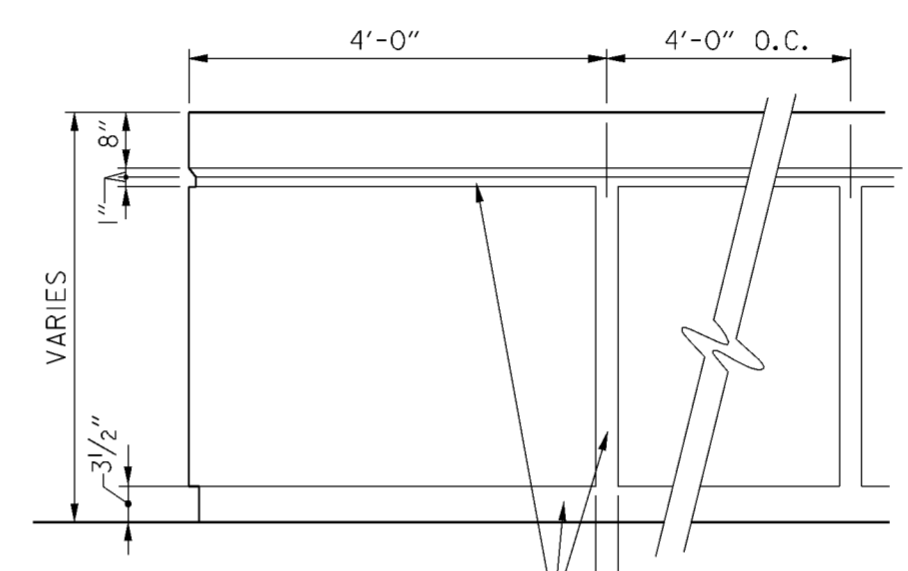


CONCRETE WALL ELEVATION
N.T.S.



NOTE:
I. THE DETAILS ON THIS SHEET APPLY
ONLY TO THE DRY FLOW SEWER FORCE
MAIN TO THE O.S.I.S. (OLENTANGY SCIOTO
INTERCEPTER SEWER)

Revisions			
Symbol	Descriptions	Date	Approved

STILSON & ASSOCIATES, INC. ENGINEERS-ARCHITECTS-SCIENTISTS COLUMBUS, OHIO		U.S. ARMY ENGINEER DISTRICT CORPS OF ENGINEERS HUNTINGTON, WEST VIRGINIA	
Designed by: JDY	Drawn by: RLG	Checked by: GPS	Reviewed by: WEB
Approved by: AJS	Date: MARCH 1998	Scale: 20.5/5	Sheet reference number: 00cad100.dgn PEN TABLE: Sheet 1 of 2

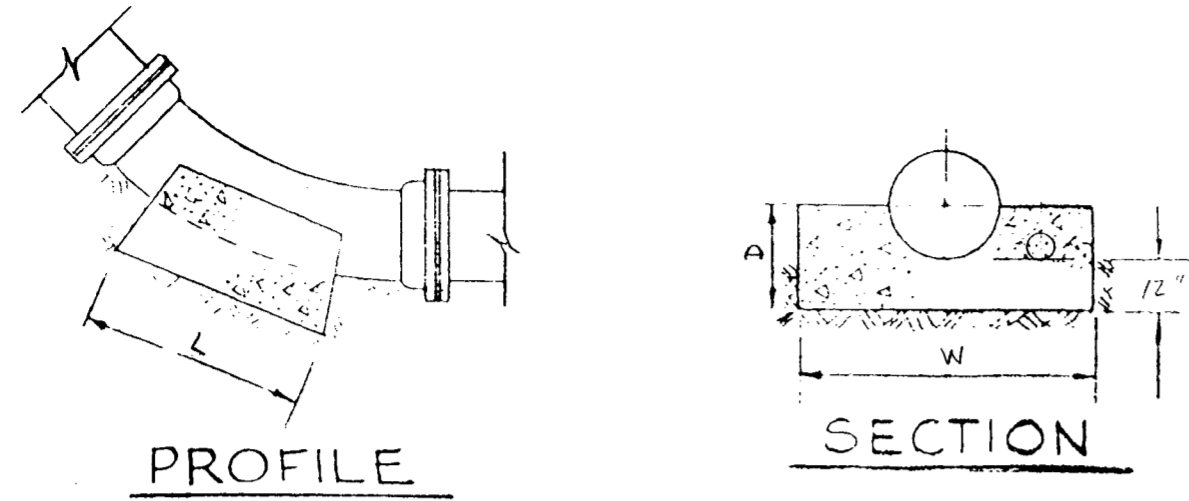


SAG BENDS
 N.T.S.
 CMSC L-6310

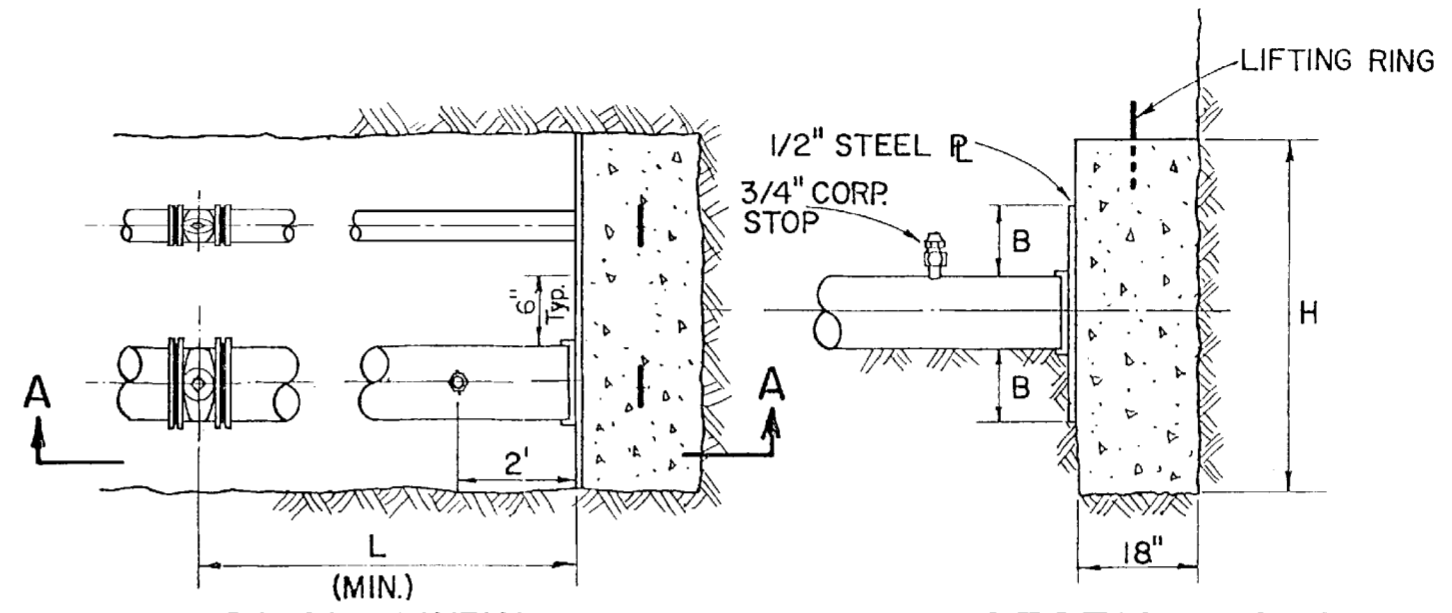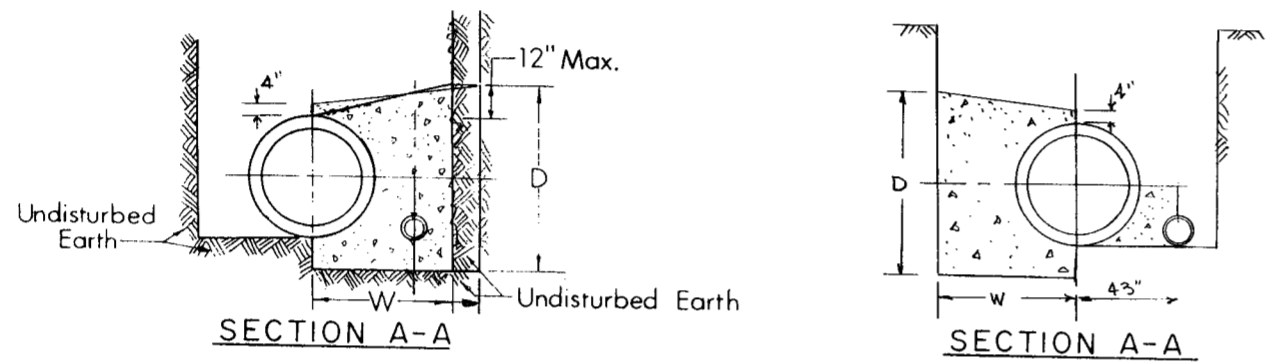


PLAN VIEW

PIPE DIAMETER	H	B	L	VOLUME CU-FT
36"	60"	6"	18'	63.15
10"	60"	1"	18'	

SECTION A-A

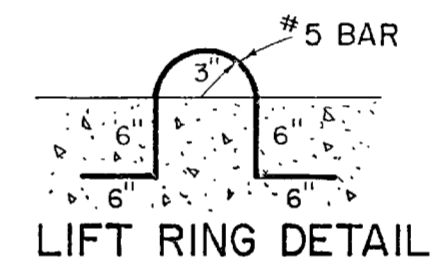

LIFT RING DETAIL

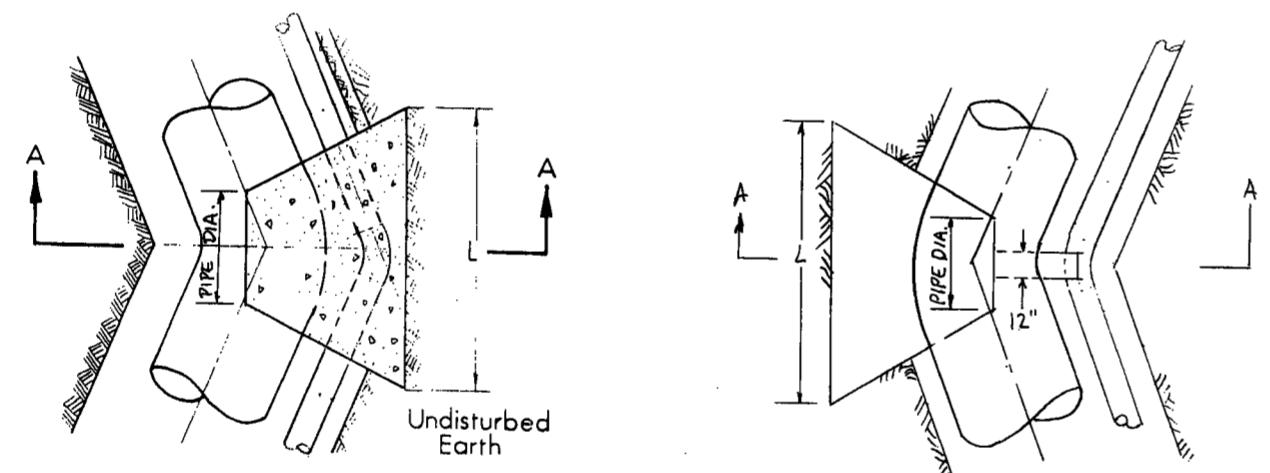

BLOCKING FOR HORIZONTAL BENDS
 N.T.S.
 CMSC L-6311

DEGREE OF BEND	DIMENSIONS IN INCHES			VOL. CONC. C. Y.
	W	D	L	
HORIZ. 11 1/4°	46	60	66	2.28
HORIZ. 22 1/2°	46	66	114	3.86
HORIZ. 45°	61	80	160	8.68
VERT. 11 1/4° SAG	66	33	50	1.19

NOTE:

1. BACKER DESIGNED FOR 3000 PSF SOIL BEARING.
2. END OF PIPE CAPPED OR PLUGGED.
3. GREASE STEEL PLATE WHERE IN CONTACT WITH CONCRETE BACKER.
4. PLACE CONCRETE AGAINST UNDISTURBED SOIL.
5. THOROUGHLY COMPACT BACKFILL BETWEEN VALVE AND END OF PIPE.


NOTE:

1. THE DETAILS ON THIS SHEET APPLY ONLY TO THE DRY FLOW SEWER FORCE MAIN TO THE O.S.I.S. (OLENTANGY SCIOTO INTERCEPTOR SEWER)


**THRUST BLOCK DETAIL
 END OF PIPE (BULKHEAD)**
 N.T.S.
 CMSC L-7001

Revisions			
Symbol	Descriptions	Date	Approved


STILSON & ASSOCIATES, INC. ENGINEERS-ARCHITECTS-SCIENTISTS COLUMBUS, OHIO	U.S. ARMY ENGINEER DISTRICT CORPS OF ENGINEERS HUNTINGTON, WEST VIRGINIA
Designed by: JDY Drawn by: RLG Checked by: GPS Reviewed by: WEB Approved by: AJS	SCIOTO RIVER COLUMBUS, OHIO WEST COLUMBUS, L.P.P. PHASE IID MISCELLANEOUS FORCE MAIN DETAILS (2 OF 2) Scale: 20.5/6 Date: MARCH 1998 Drawing Code: 016-PWC-10
Sheet reference number: 00cad101.dgn FILENAME: 00cad101.dgn PEN TABLE:	Sheet 2 of 2

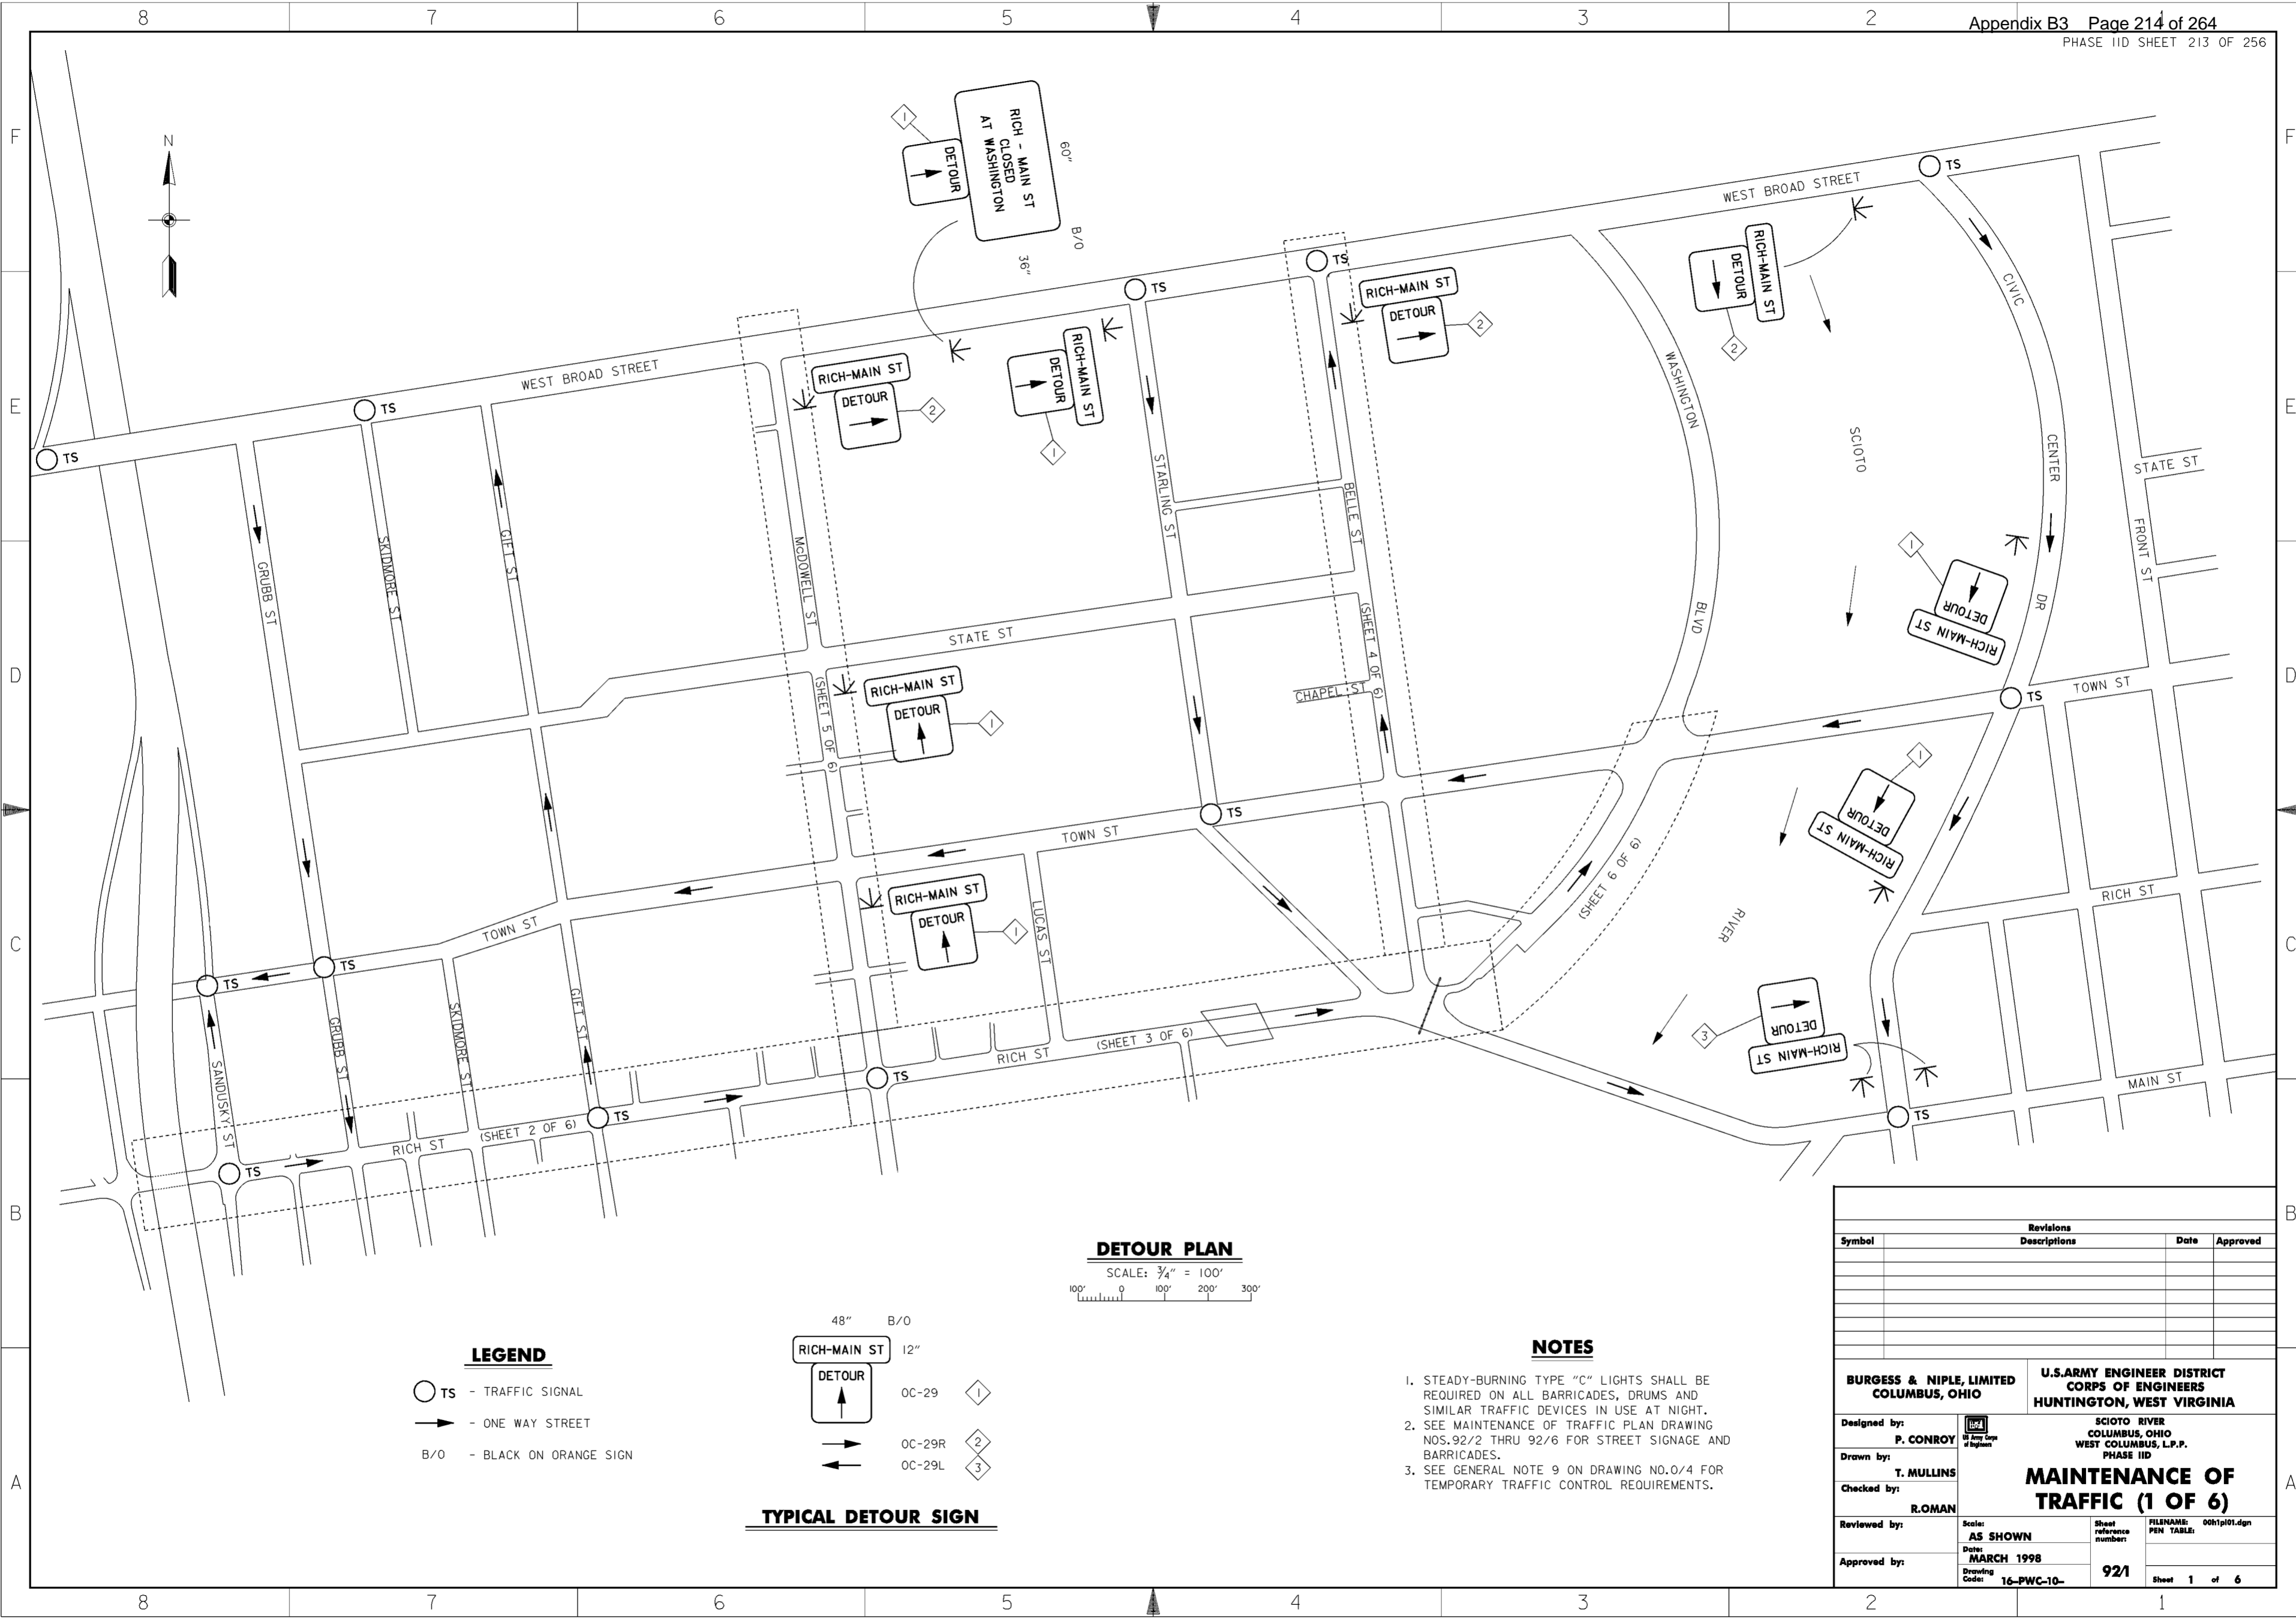

DETOUR PLAN

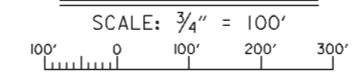

- LEGEND**
- TS - TRAFFIC SIGNAL
 - - ONE WAY STREET
 - B/O - BLACK ON ORANGE SIGN

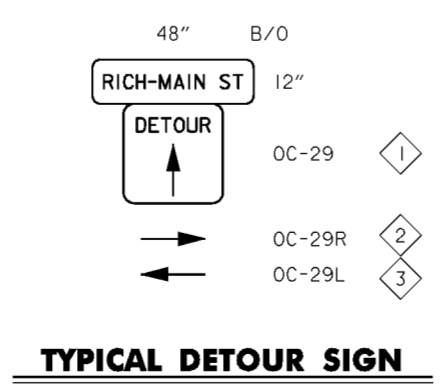


NOTES

1. STEADY-BURNING TYPE "C" LIGHTS SHALL BE REQUIRED ON ALL BARRICADES, DRUMS AND SIMILAR TRAFFIC DEVICES IN USE AT NIGHT.
2. SEE MAINTENANCE OF TRAFFIC PLAN DRAWING NOS. 92/2 THRU 92/6 FOR STREET SIGNAGE AND BARRICADES.
3. SEE GENERAL NOTE 9 ON DRAWING NO. 0/4 FOR TEMPORARY TRAFFIC CONTROL REQUIREMENTS.

Revisions			
Symbol	Descriptions	Date	Approved

BURGESS & NIPLE, LIMITED COLUMBUS, OHIO	P. CONROY Registered Professional Engineer No. 92101	U.S. ARMY ENGINEER DISTRICT CORPS OF ENGINEERS HUNTINGTON, WEST VIRGINIA	
		SCIOTO RIVER COLUMBUS, OHIO WEST COLUMBUS, L.P.P. PHASE IID	
Designed by: P. CONROY	T. MULLINS Registered Professional Engineer No. 92101	MAINTENANCE OF TRAFFIC (1 OF 6)	
Drawn by: T. MULLINS			
Checked by: R. ROMAN			
Reviewed by: AS SHOWN			
Approved by: MARCH 1998	Scale: AS SHOWN	Sheet reference number: 921	FILENAME: PEN TABLE: 00h1p01.dgn
Drawing Code: 16-PWC-10-	Sheet 1 of 6	Sheet 1 of 6	Sheet 1 of 6

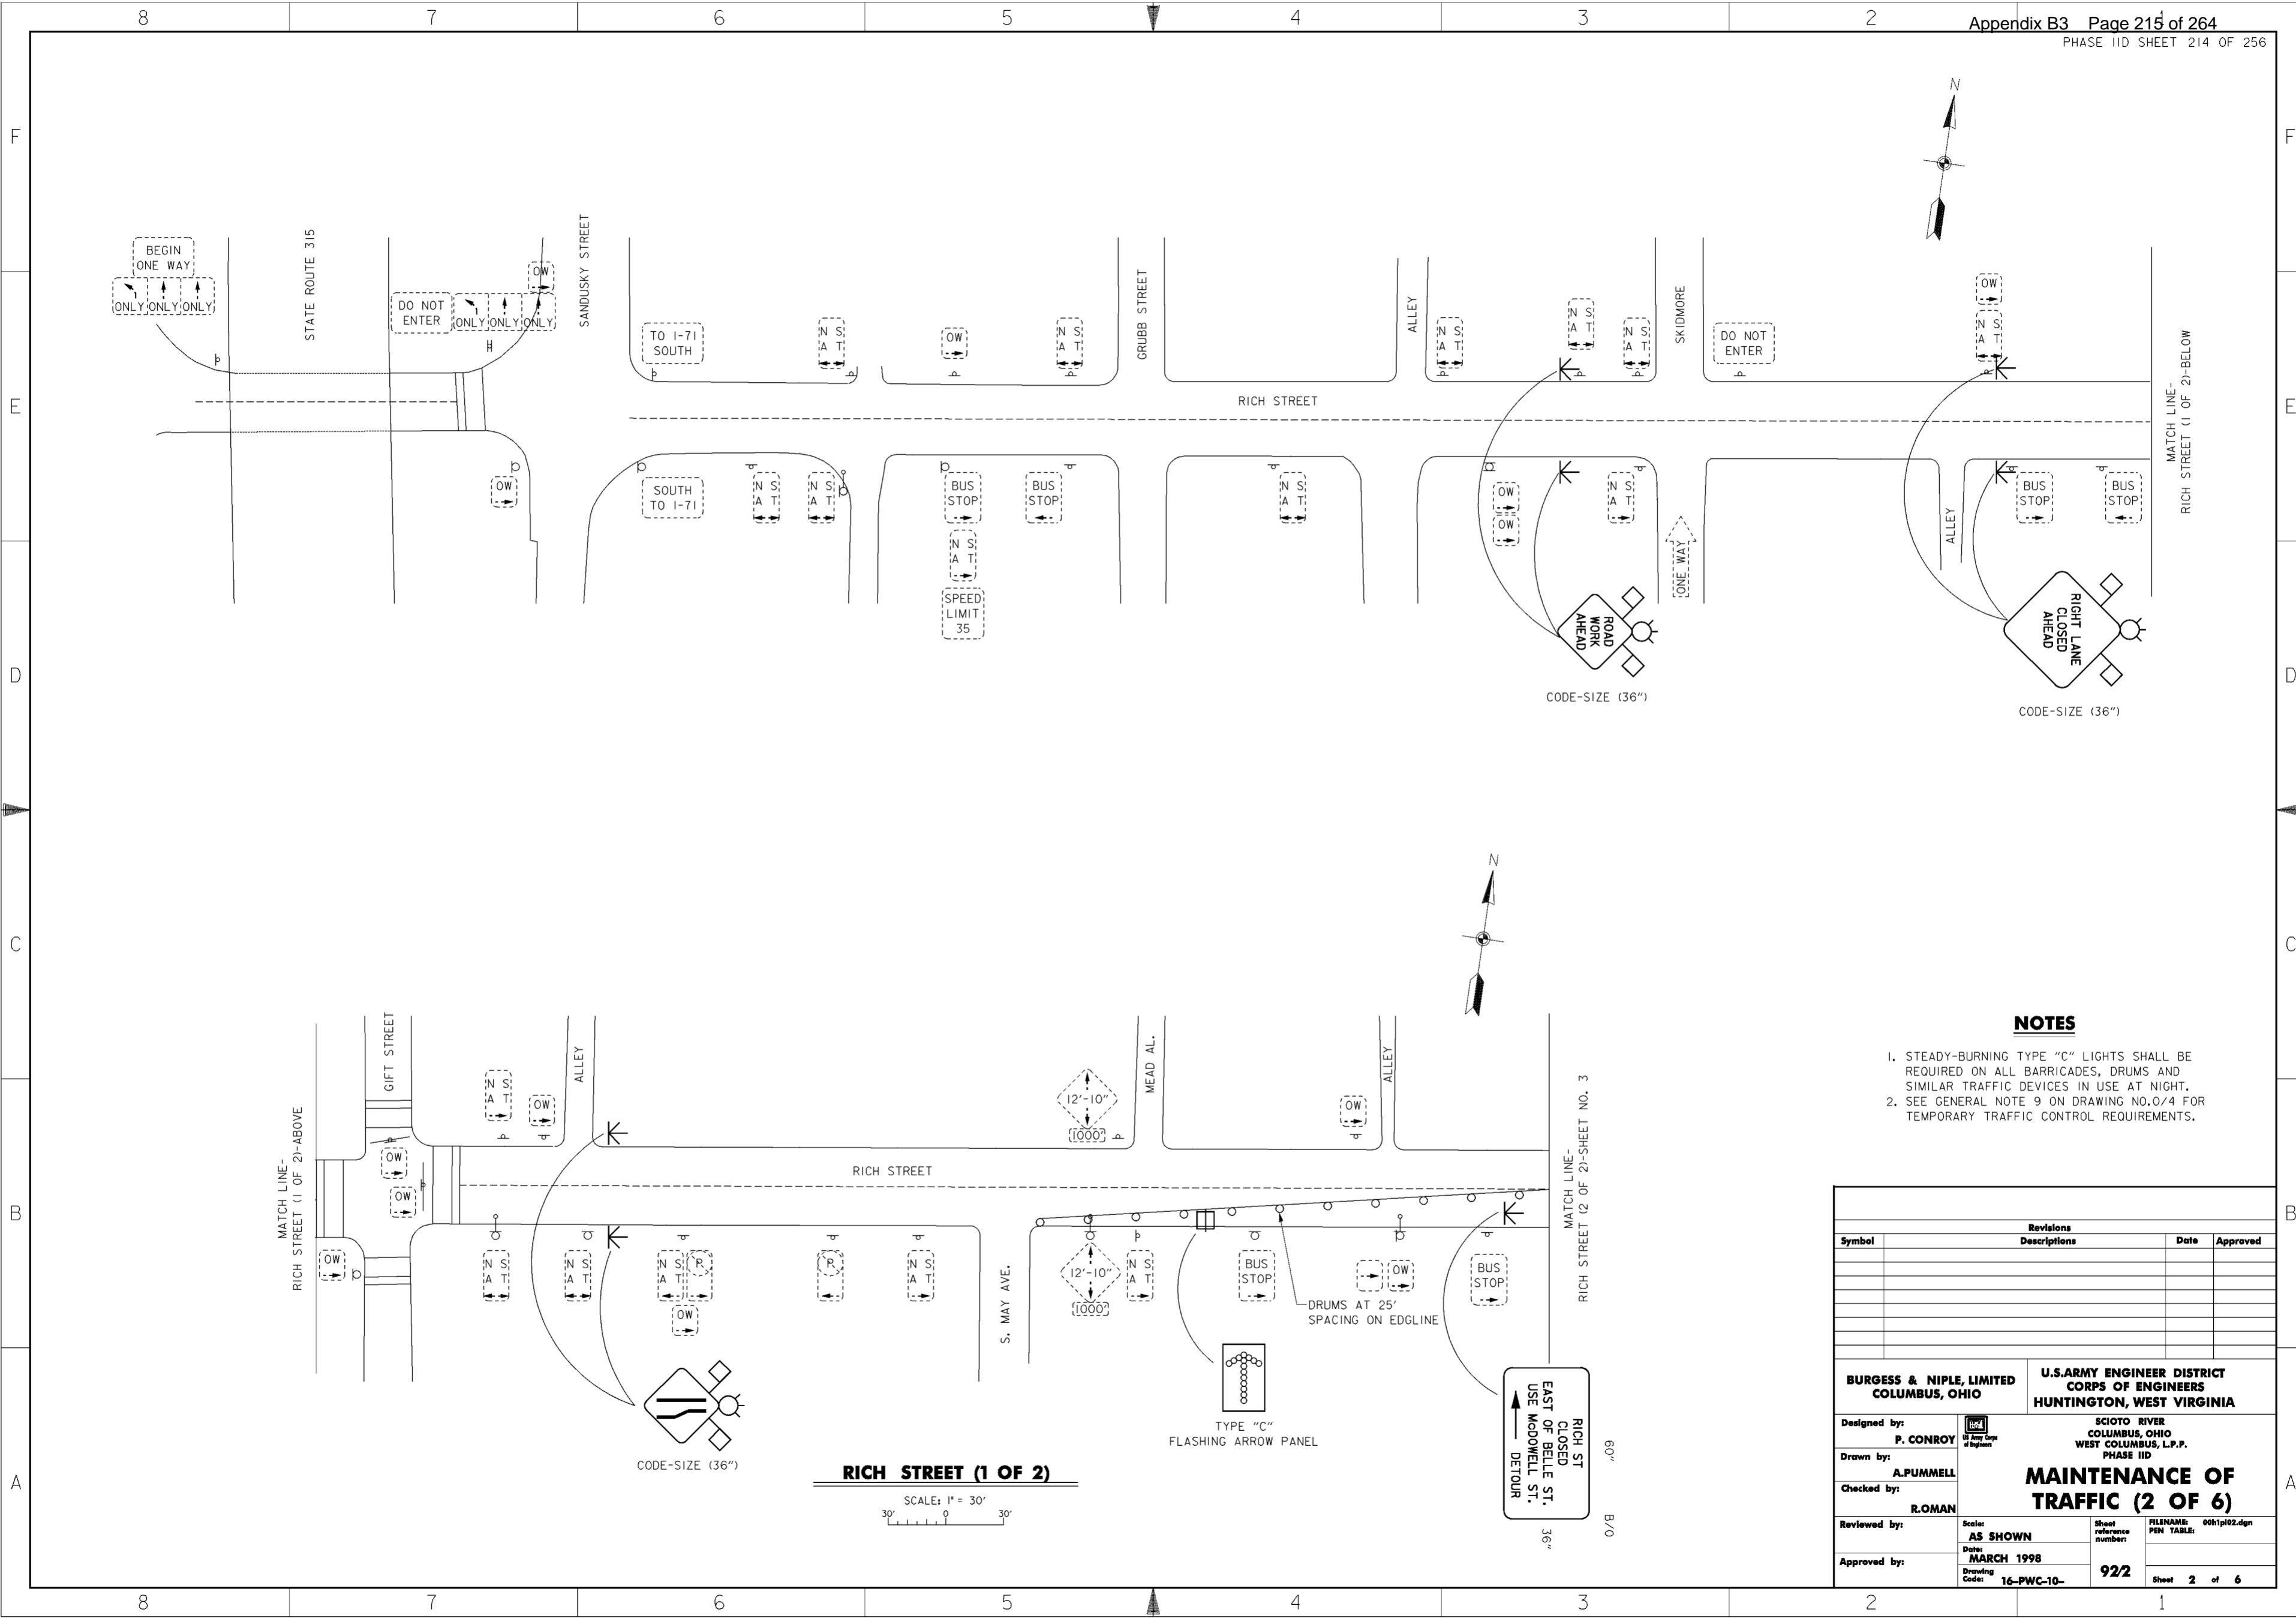

NOTES



1. STEADY-BURNING TYPE "C" LIGHTS SHALL BE REQUIRED ON ALL BARRICADES, DRUMS AND SIMILAR TRAFFIC DEVICES IN USE AT NIGHT.
2. SEE GENERAL NOTE 9 ON DRAWING NO.0/4 FOR TEMPORARY TRAFFIC CONTROL REQUIREMENTS.

Revisions			
Symbol	Descriptions	Date	Approved

BURGESS & NIPLE, LIMITED COLUMBUS, OHIO		U.S. ARMY ENGINEER DISTRICT CORPS OF ENGINEERS HUNTINGTON, WEST VIRGINIA	
Designed by: P. CONROY		SCIO TO RIVER COLUMBUS, OHIO WEST COLUMBUS, L.P.P. PHASE IID	
Drawn by: A. PUMMELL		MAINTENANCE OF TRAFFIC (2 OF 6)	
Checked by: R. ROMAN	Reviewed by:	Scale: AS SHOWN	Sheet reference number: 922
Approved by:	Date: MARCH 1998	Drawing Code: 16-PWC-10-	FILENAME: PEN TABLE: 00h1p102.dgn
		Sheet 2 of 6	

RICH STREET (1 OF 2)
 SCALE: 1" = 30'

WORK AS CONSTRUCTED

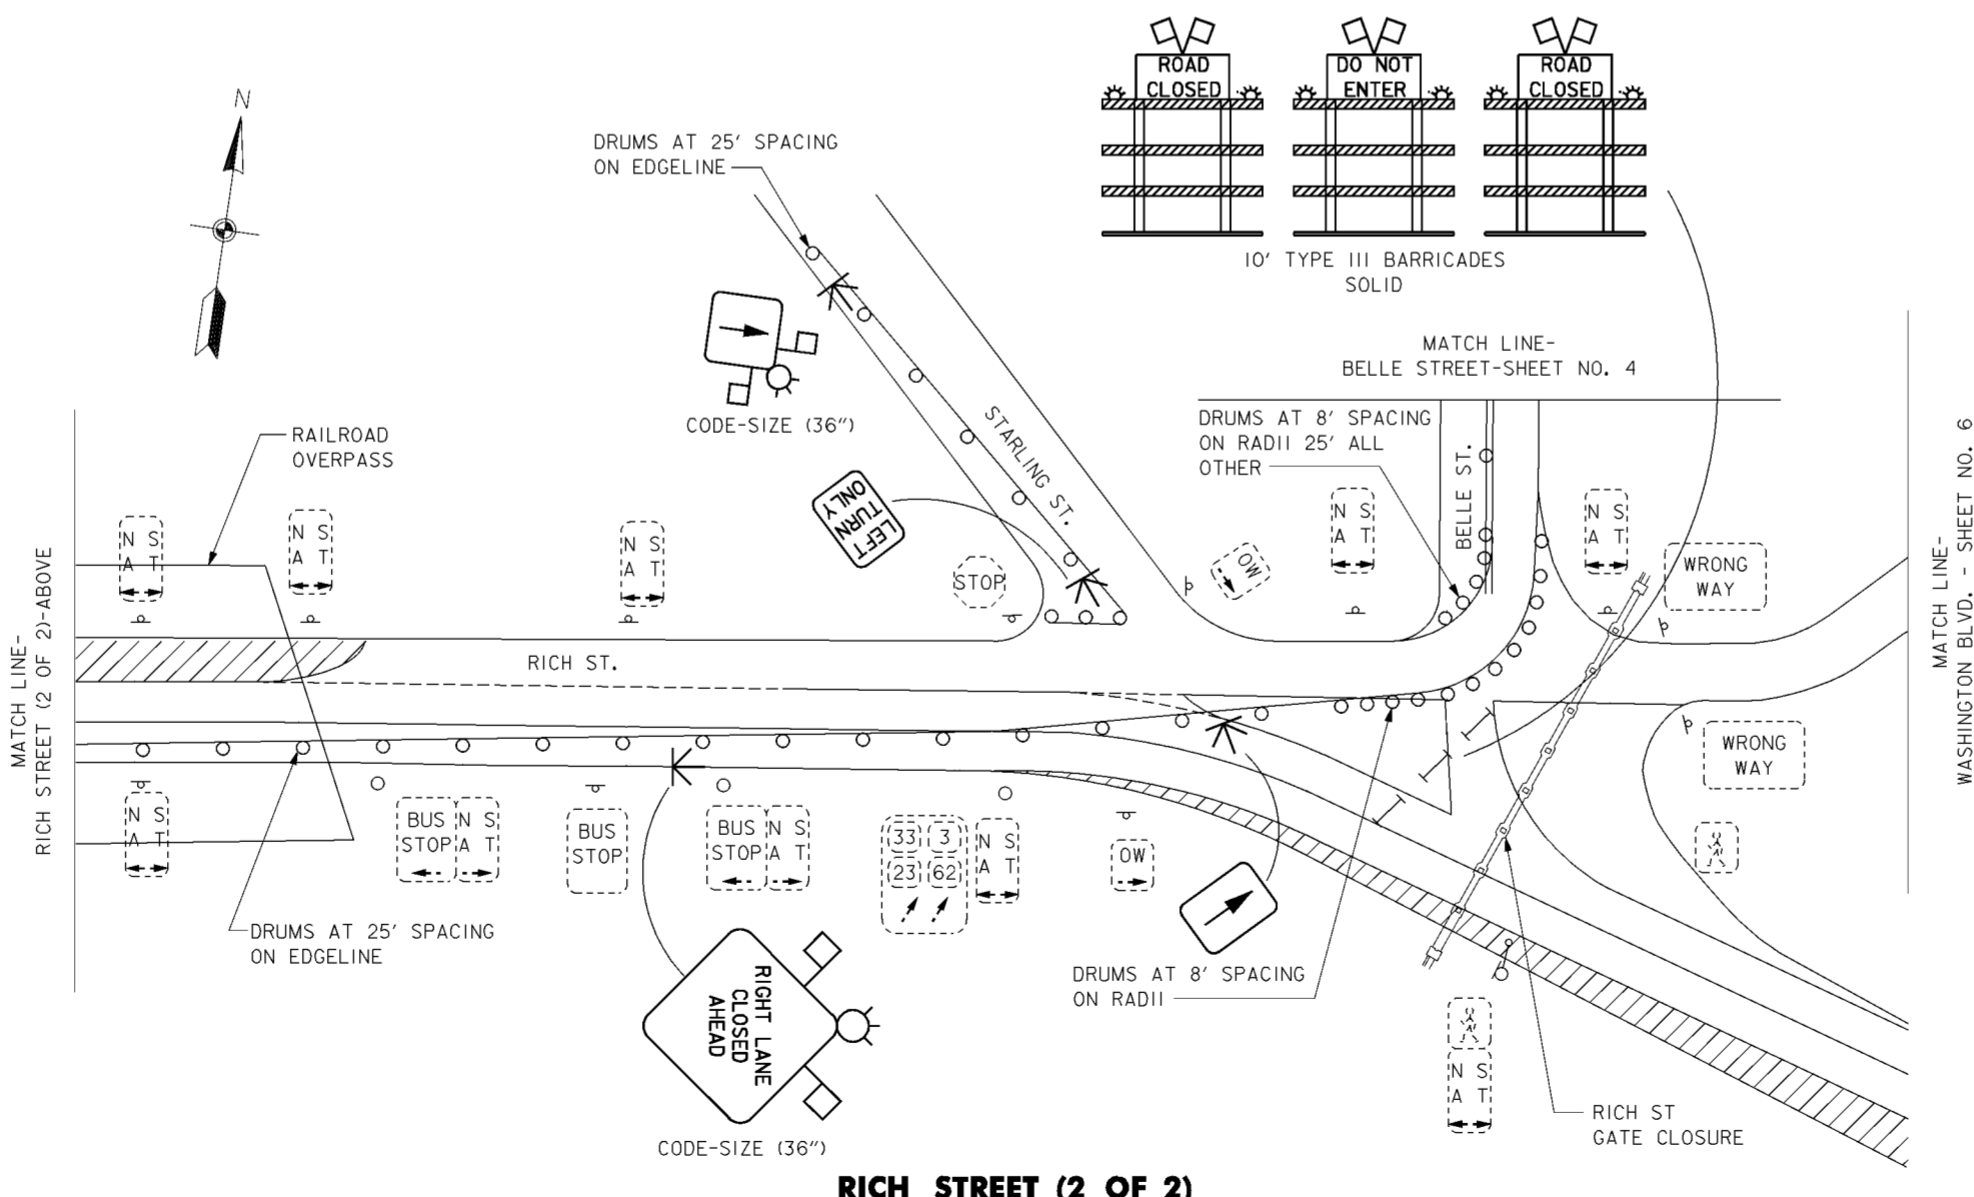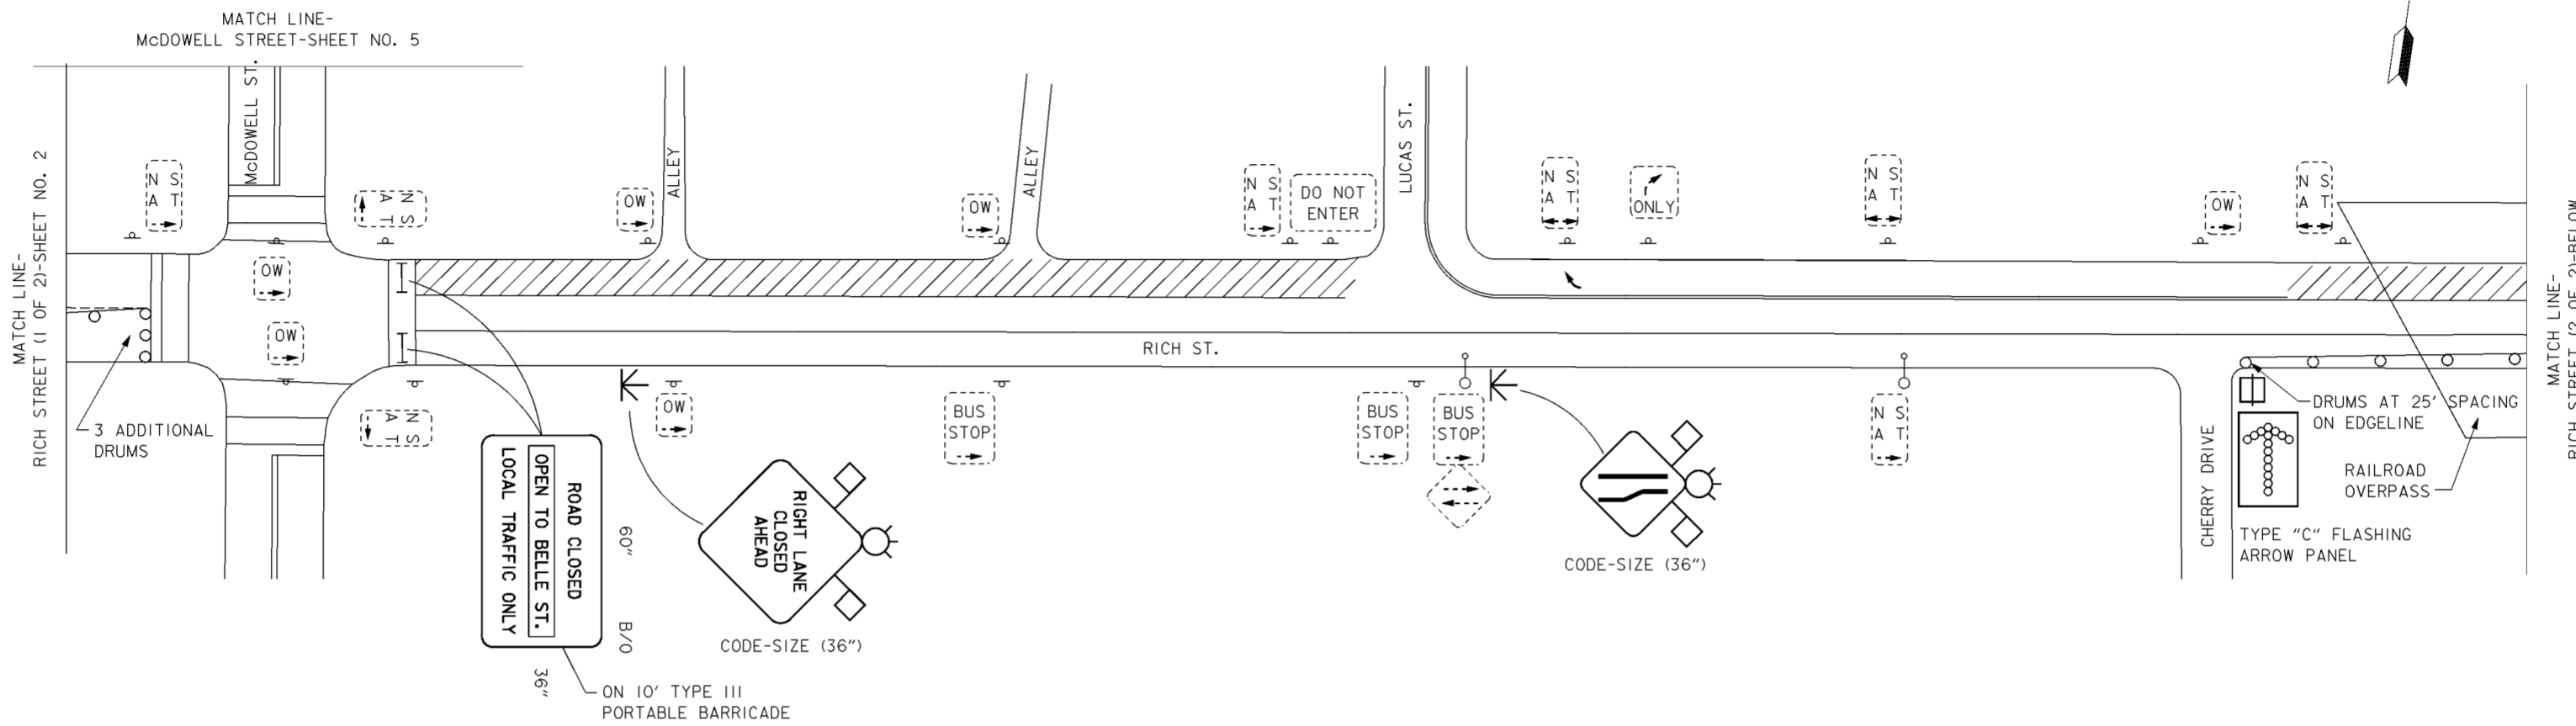

RICH STREET (2 OF 2)


SCALE: 1" = 30'

NOTES

1. STEADY-BURNING TYPE "C" LIGHTS SHALL BE REQUIRED ON ALL BARRICADES, DRUMS AND SIMILAR TRAFFIC DEVICES IN USE AT NIGHT.
2. SEE GENERAL NOTE 9 ON DRAWING NO.0/4 FOR TEMPORARY TRAFFIC CONTROL REQUIREMENTS.

Revisions			
Symbol	Descriptions	Date	Approved

BURGESS & NIPLE, LIMITED COLUMBUS, OHIO	P. CONROY Registered Professional Engineer State of Ohio	U.S. ARMY ENGINEER DISTRICT CORPS OF ENGINEERS HUNTINGTON, WEST VIRGINIA	SCIOTO RIVER COLUMBUS, OHIO WEST COLUMBUS, L.P.P. PHASE IID
Drawn by:	A. PUMMELL	<h3>MAINTENANCE OF TRAFFIC (3 OF 6)</h3>	
Checked by:	R. ROMAN		
Reviewed by:	AS SHOWN	Sheet reference number:	FILENAME: 00h1p03.dgn
Approved by:	MARCH 1998	PEN TABLE:	92/3
Drawing Code: 16-PWC-10-	92/3	Sheet 3 of 6	92/3

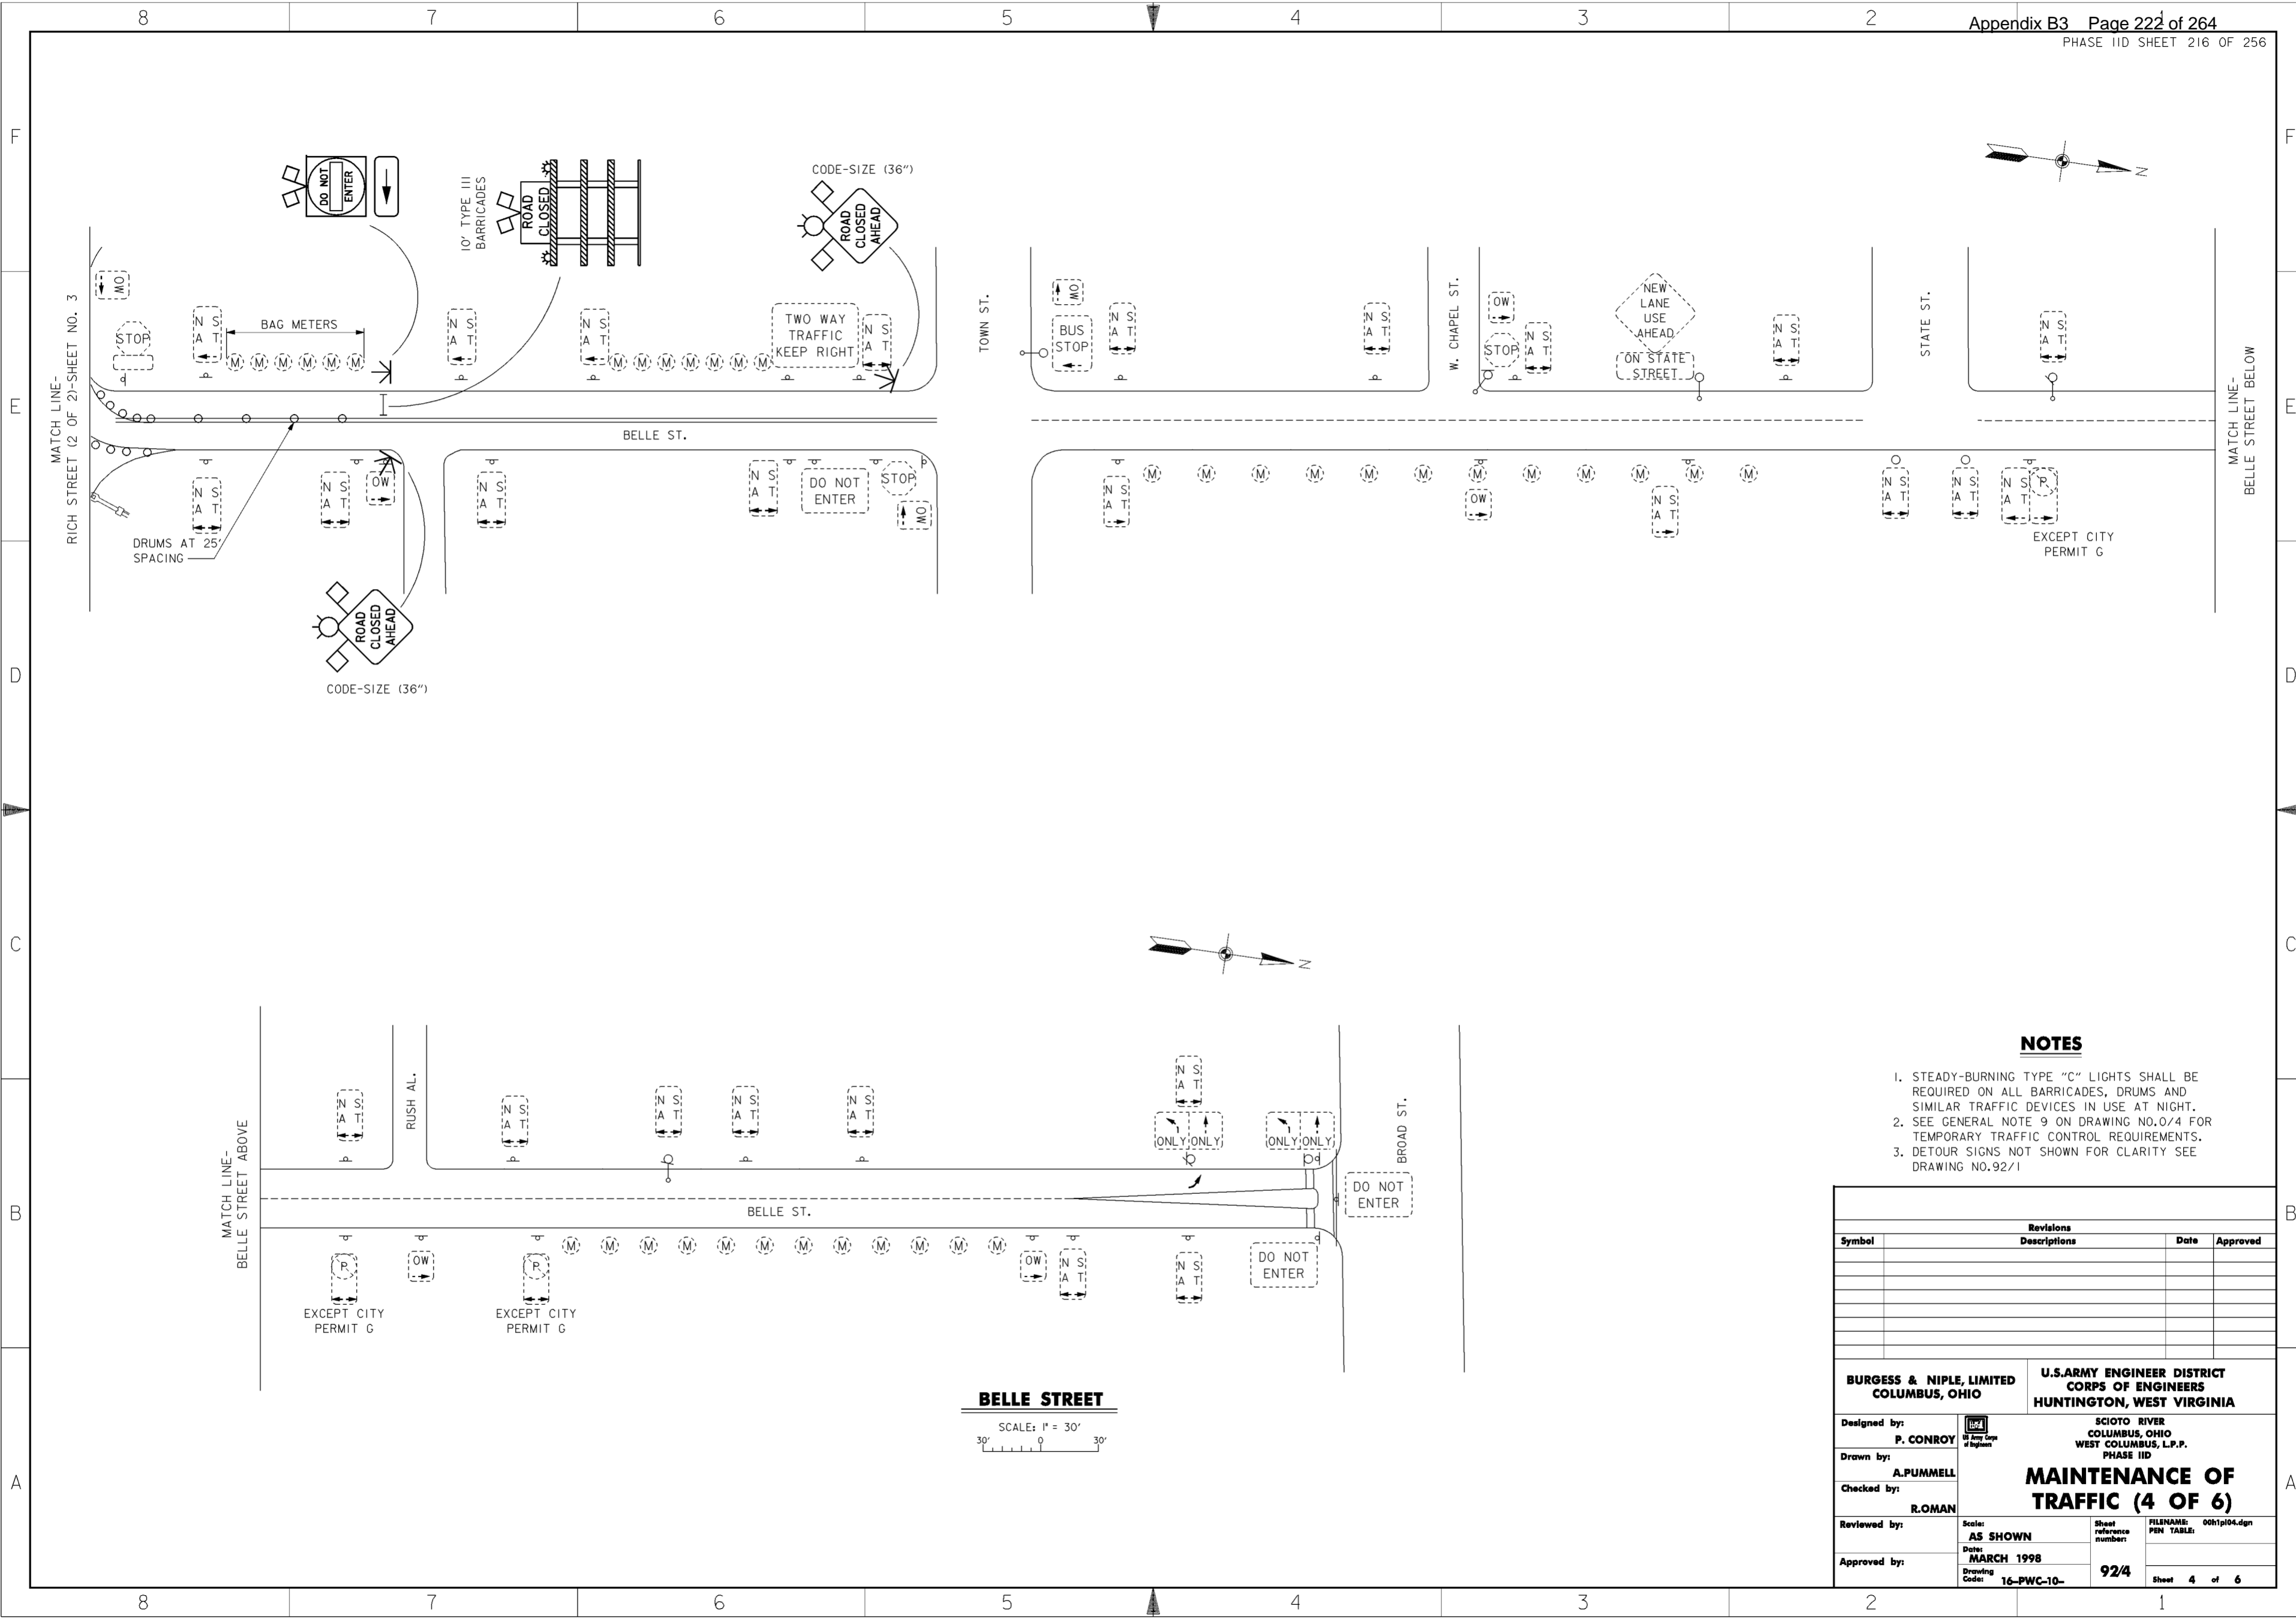

NOTES


1. STEADY-BURNING TYPE "C" LIGHTS SHALL BE REQUIRED ON ALL BARRICADES, DRUMS AND SIMILAR TRAFFIC DEVICES IN USE AT NIGHT.
2. SEE GENERAL NOTE 9 ON DRAWING NO.0/4 FOR TEMPORARY TRAFFIC CONTROL REQUIREMENTS.
3. DETOUR SIGNS NOT SHOWN FOR CLARITY SEE DRAWING NO.92/1

Revisions			
Symbol	Descriptions	Date	Approved

BURGESS & NIPLE, LIMITED COLUMBUS, OHIO	U.S. ARMY ENGINEER DISTRICT CORPS OF ENGINEERS HUNTINGTON, WEST VIRGINIA	Designed by: P. CONROY	SCIOTO RIVER COLUMBUS, OHIO WEST COLUMBUS, L.P.P. PHASE IID
		Drawn by: A. PUMMELL	
Checked by: R. ROMAN	MAINTENANCE OF TRAFFIC (4 OF 6)		
Reviewed by:	Scale: AS SHOWN	Sheet reference number: 92/4	FILENAME: 00h1p104.dgn PEN TABLE:
Approved by:	Date: MARCH 1998	Drawing Code: 16-PWC-10-	Sheet 4 of 6

BELLE STREET
 SCALE: 1" = 30'

WORK AS CONSTRUCTED

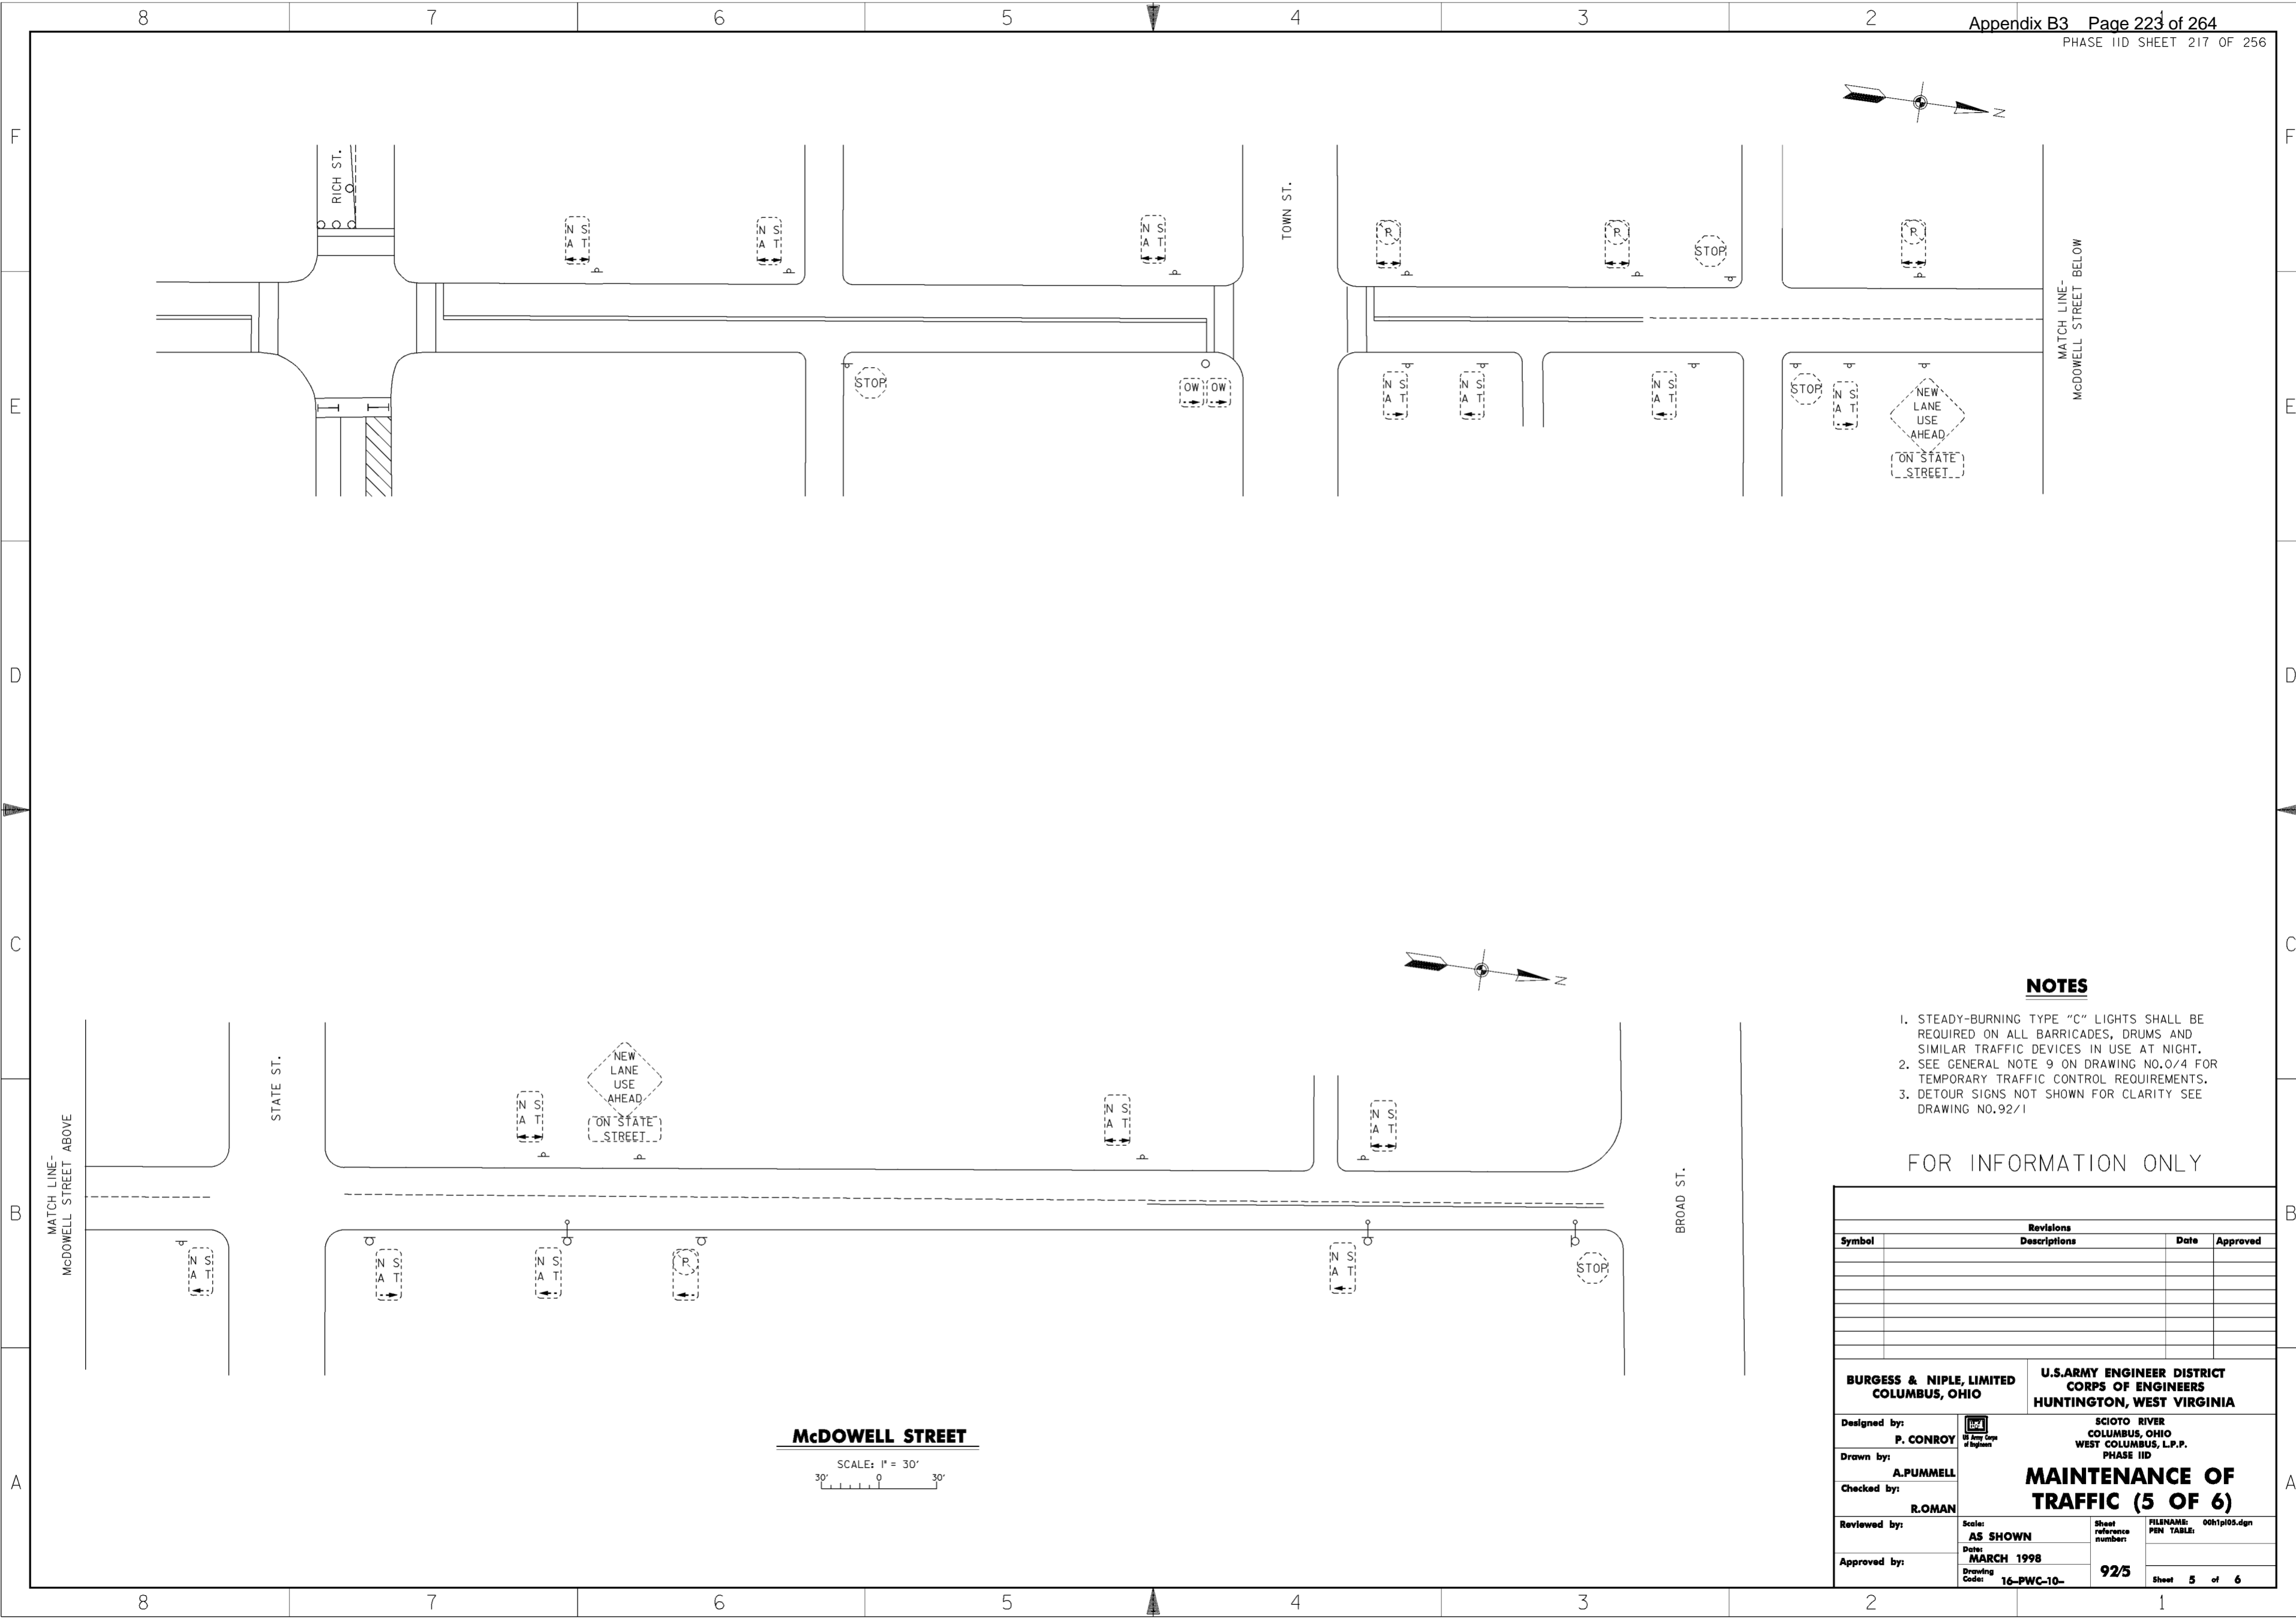

NOTES

1. STEADY-BURNING TYPE "C" LIGHTS SHALL BE REQUIRED ON ALL BARRICADES, DRUMS AND SIMILAR TRAFFIC DEVICES IN USE AT NIGHT.
2. SEE GENERAL NOTE 9 ON DRAWING NO.0/4 FOR TEMPORARY TRAFFIC CONTROL REQUIREMENTS.
3. DETOUR SIGNS NOT SHOWN FOR CLARITY SEE DRAWING NO.92/1


FOR INFORMATION ONLY

Revisions			
Symbol	Descriptions	Date	Approved

BURGESS & NIPLE, LIMITED COLUMBUS, OHIO		U.S. ARMY ENGINEER DISTRICT CORPS OF ENGINEERS HUNTINGTON, WEST VIRGINIA	
Designed by: P. CONROY		SCIOTO RIVER COLUMBUS, OHIO WEST COLUMBUS, L.P.P. PHASE IID	
Drawn by: A. PUMMELL		MAINTENANCE OF TRAFFIC (5 OF 6)	
Checked by: R. ROMAN	Reviewed by:	Scale: AS SHOWN	Sheet reference number: 92/5
Approved by:	Date: MARCH 1998	Drawing Code: 16-PWC-10-	FILENAME: PEN TABLE: 00h1p105.dgn Sheet 5 of 6

McDOWELL STREET
SCALE: 1" = 30'

WORK AS CONSTRUCTED

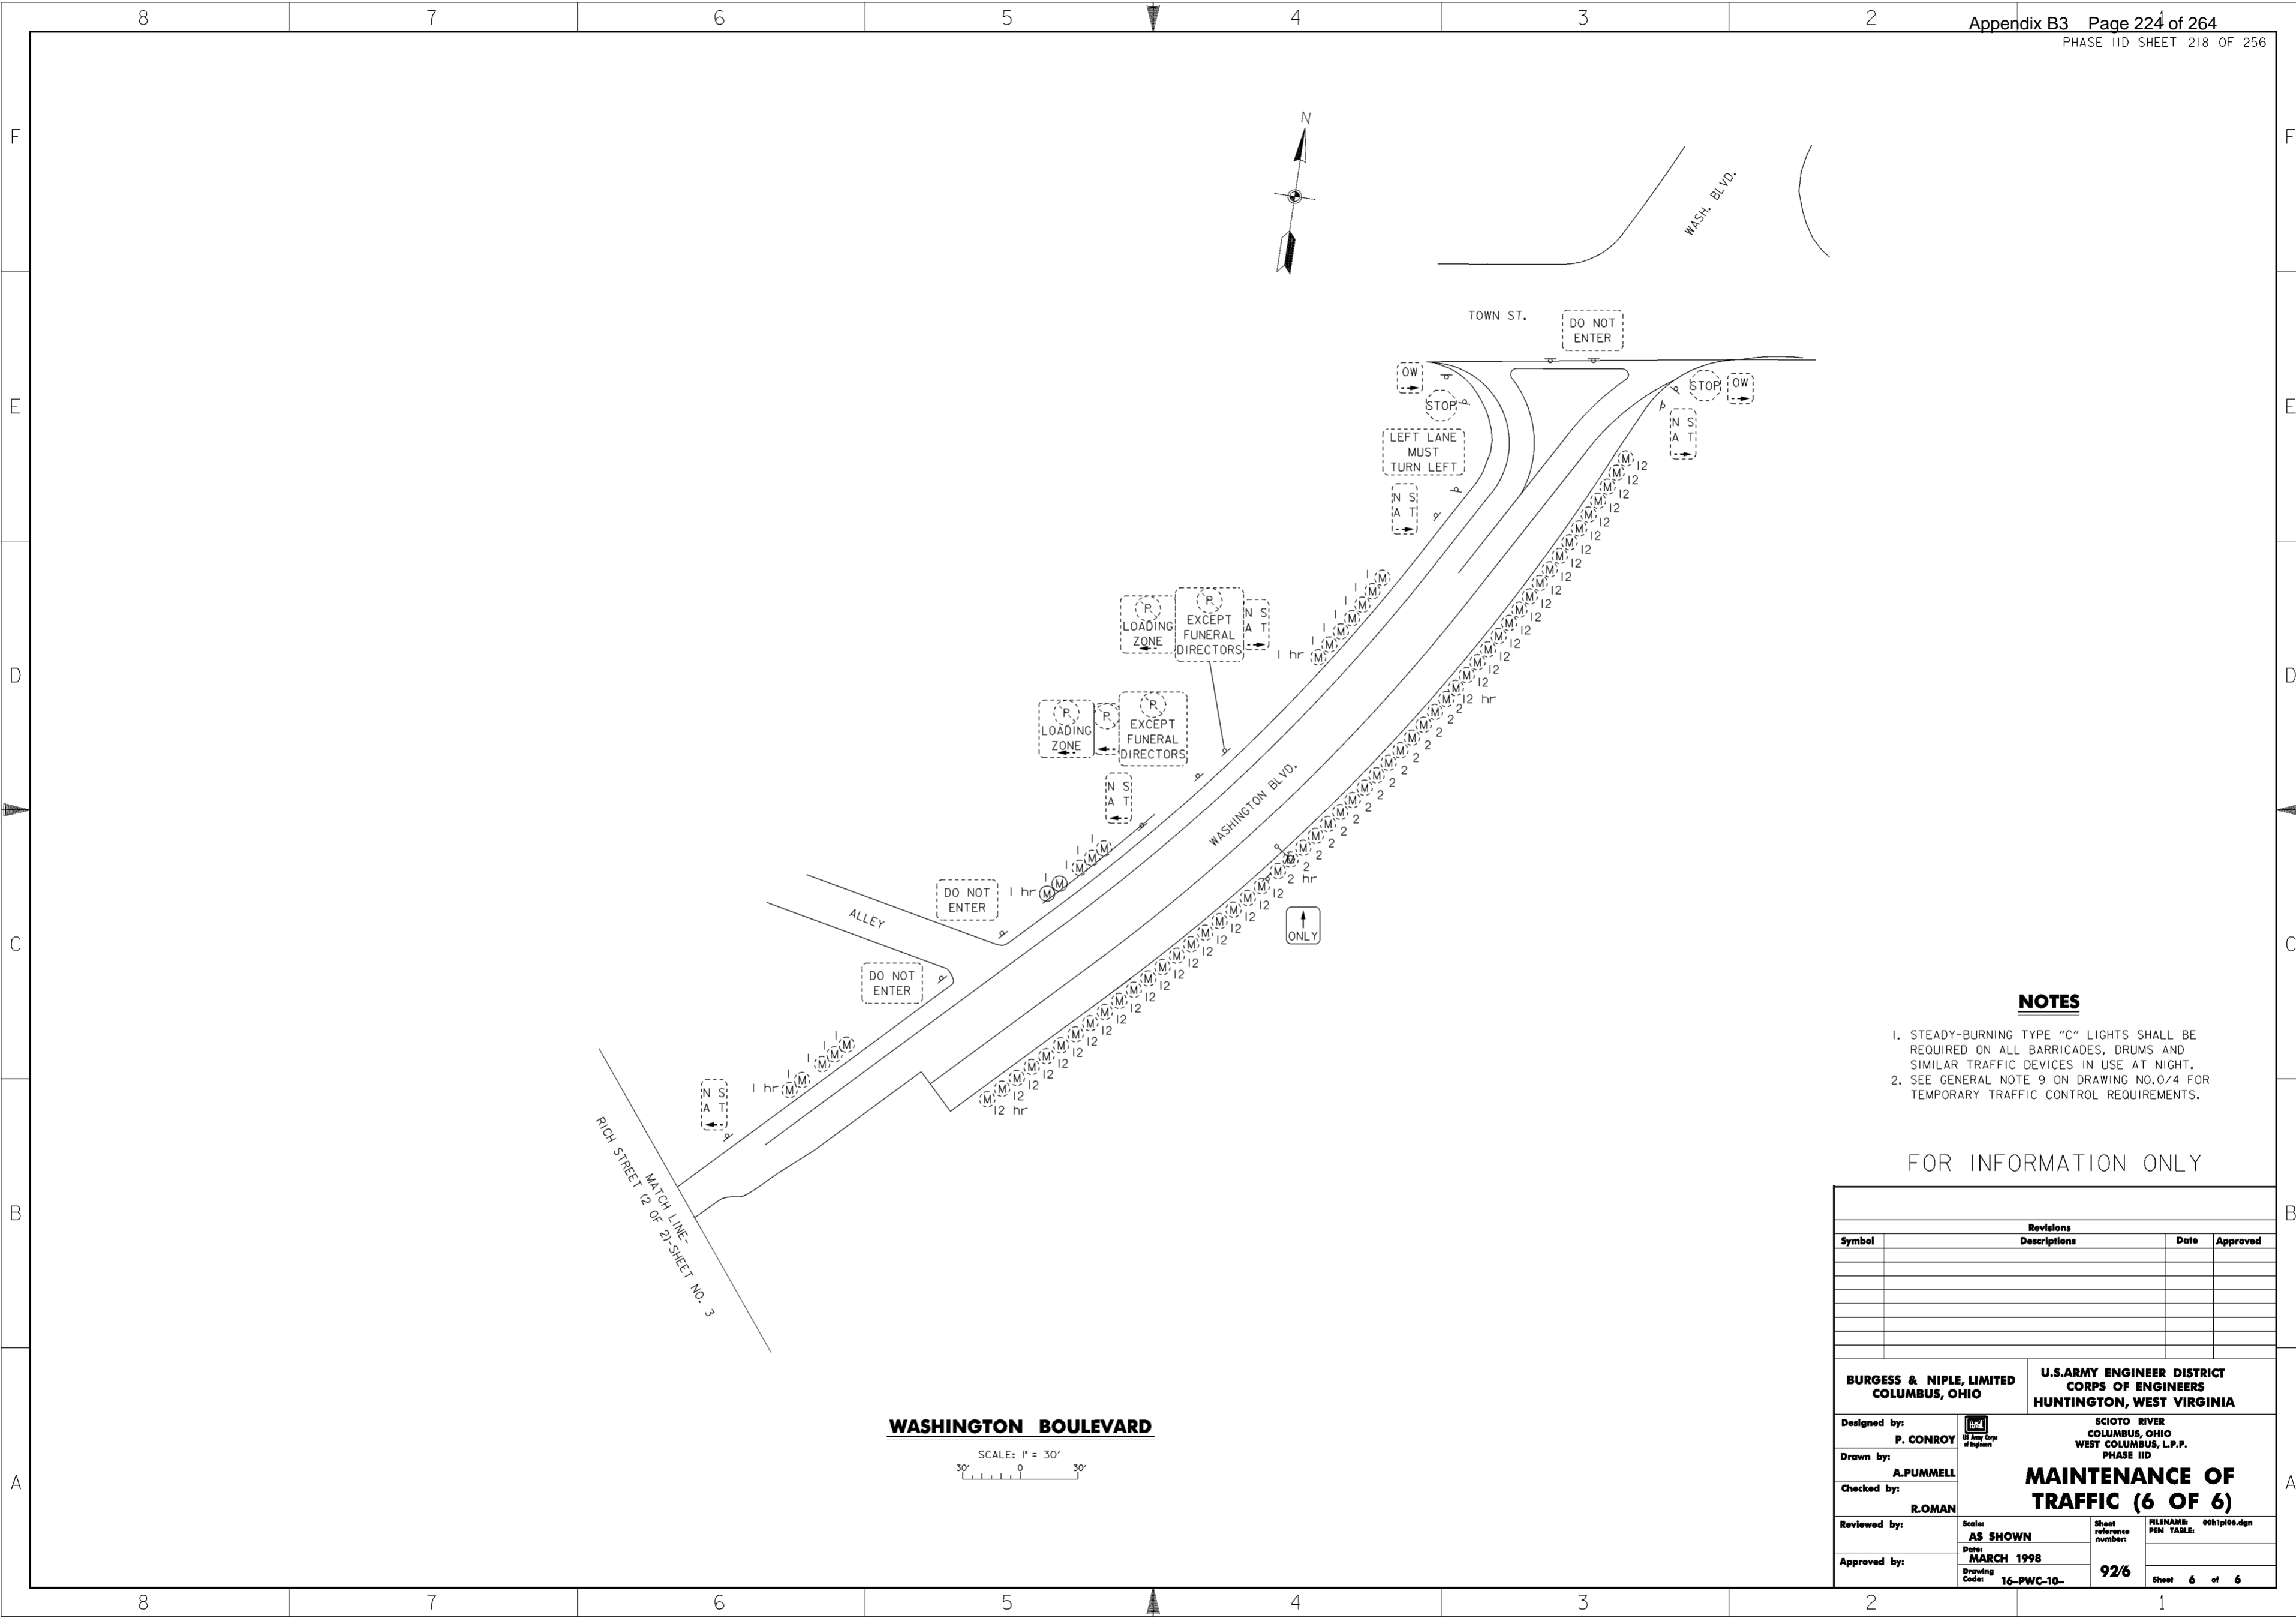

NOTES


1. STEADY-BURNING TYPE "C" LIGHTS SHALL BE REQUIRED ON ALL BARRICADES, DRUMS AND SIMILAR TRAFFIC DEVICES IN USE AT NIGHT.
2. SEE GENERAL NOTE 9 ON DRAWING NO.0/4 FOR TEMPORARY TRAFFIC CONTROL REQUIREMENTS.

FOR INFORMATION ONLY


Revisions			
Symbol	Descriptions	Date	Approved

BURGESS & NIPLE, LIMITED COLUMBUS, OHIO		U.S. ARMY ENGINEER DISTRICT CORPS OF ENGINEERS HUNTINGTON, WEST VIRGINIA	
Designed by: P. CONROY		MAINTENANCE OF TRAFFIC (6 OF 6)	
Drawn by: A. PUMMELL			
Checked by: R. ROMAN			
Reviewed by:			
Approved by:	Scale: AS SHOWN	Sheet reference number: 92/6	FILENAME: PEN TABLE: 00h1p106.dgn
	Date: MARCH 1998		Sheet 6 of 6
	Drawing Code: 16-PWC-10-		

WASHINGTON BOULEVARD

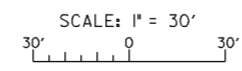

WORK AS CONSTRUCTED

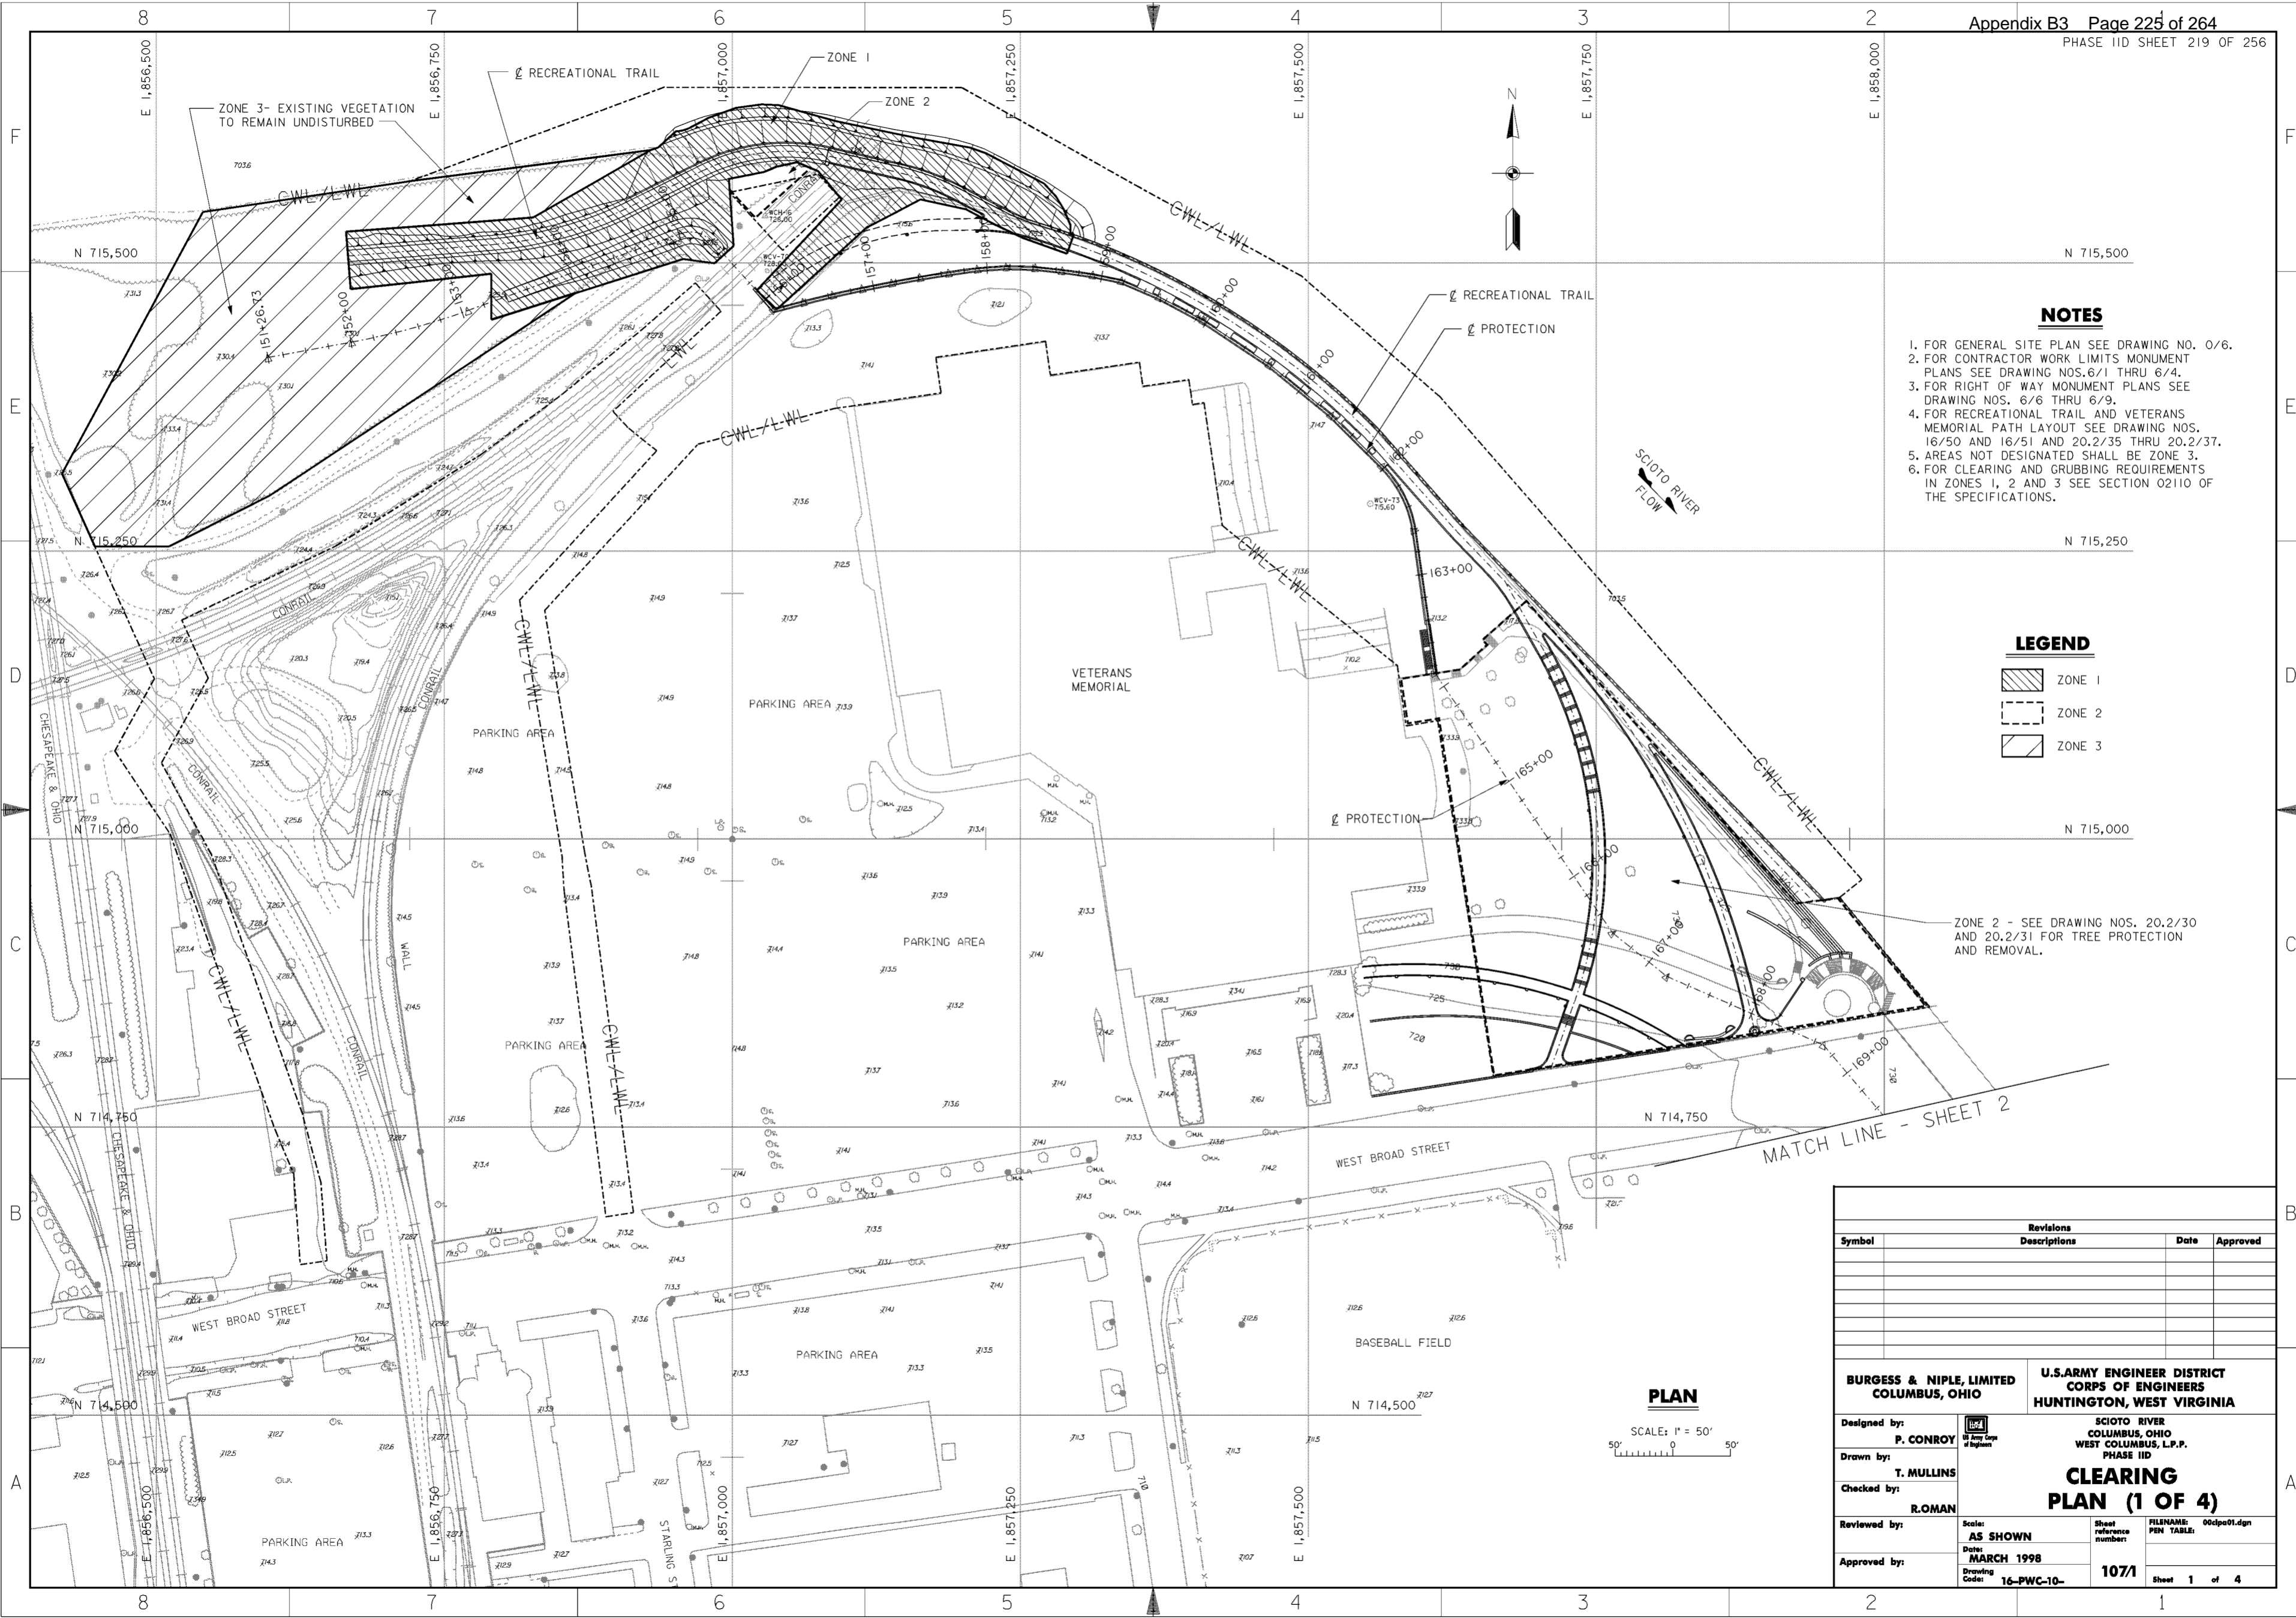

NOTES

1. FOR GENERAL SITE PLAN SEE DRAWING NO. 0/6.
2. FOR CONTRACTOR WORK LIMITS MONUMENT PLANS SEE DRAWING NOS. 6/1 THRU 6/4.
3. FOR RIGHT OF WAY MONUMENT PLANS SEE DRAWING NOS. 6/6 THRU 6/9.
4. FOR RECREATIONAL TRAIL AND VETERANS MEMORIAL PATH LAYOUT SEE DRAWING NOS. 16/50 AND 16/51 AND 20.2/35 THRU 20.2/37.
5. AREAS NOT DESIGNATED SHALL BE ZONE 3.
6. FOR CLEARING AND GRUBBING REQUIREMENTS IN ZONES 1, 2 AND 3 SEE SECTION 02110 OF THE SPECIFICATIONS.

LEGEND

- ZONE 1
- ZONE 2
- ZONE 3



ZONE 2 - SEE DRAWING NOS. 20.2/30 AND 20.2/31 FOR TREE PROTECTION AND REMOVAL.

PLAN

SCALE: 1" = 50'


Revisions			
Symbol	Descriptions	Date	Approved

BURGESS & NIPLE, LIMITED COLUMBUS, OHIO	U.S. ARMY ENGINEER DISTRICT CORPS OF ENGINEERS HUNTINGTON, WEST VIRGINIA		
	Designed by: P. CONROY	SCIOTO RIVER COLUMBUS, OHIO WEST COLUMBUS, L.P.P. PHASE IID	
Drawn by: T. MULLINS	CLEARING PLAN (1 OF 4)		
Checked by: ROMAN	Scale: AS SHOWN	Sheet reference number: 107/1	FILENAME: 00dpe01.dgn
Reviewed by:	Date: MARCH 1998	Drawing Code: 16-PWC-10-	Sheet 1 of 4
Approved by:	WORK AS CONSTRUCTED		

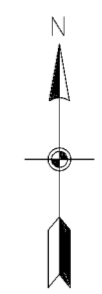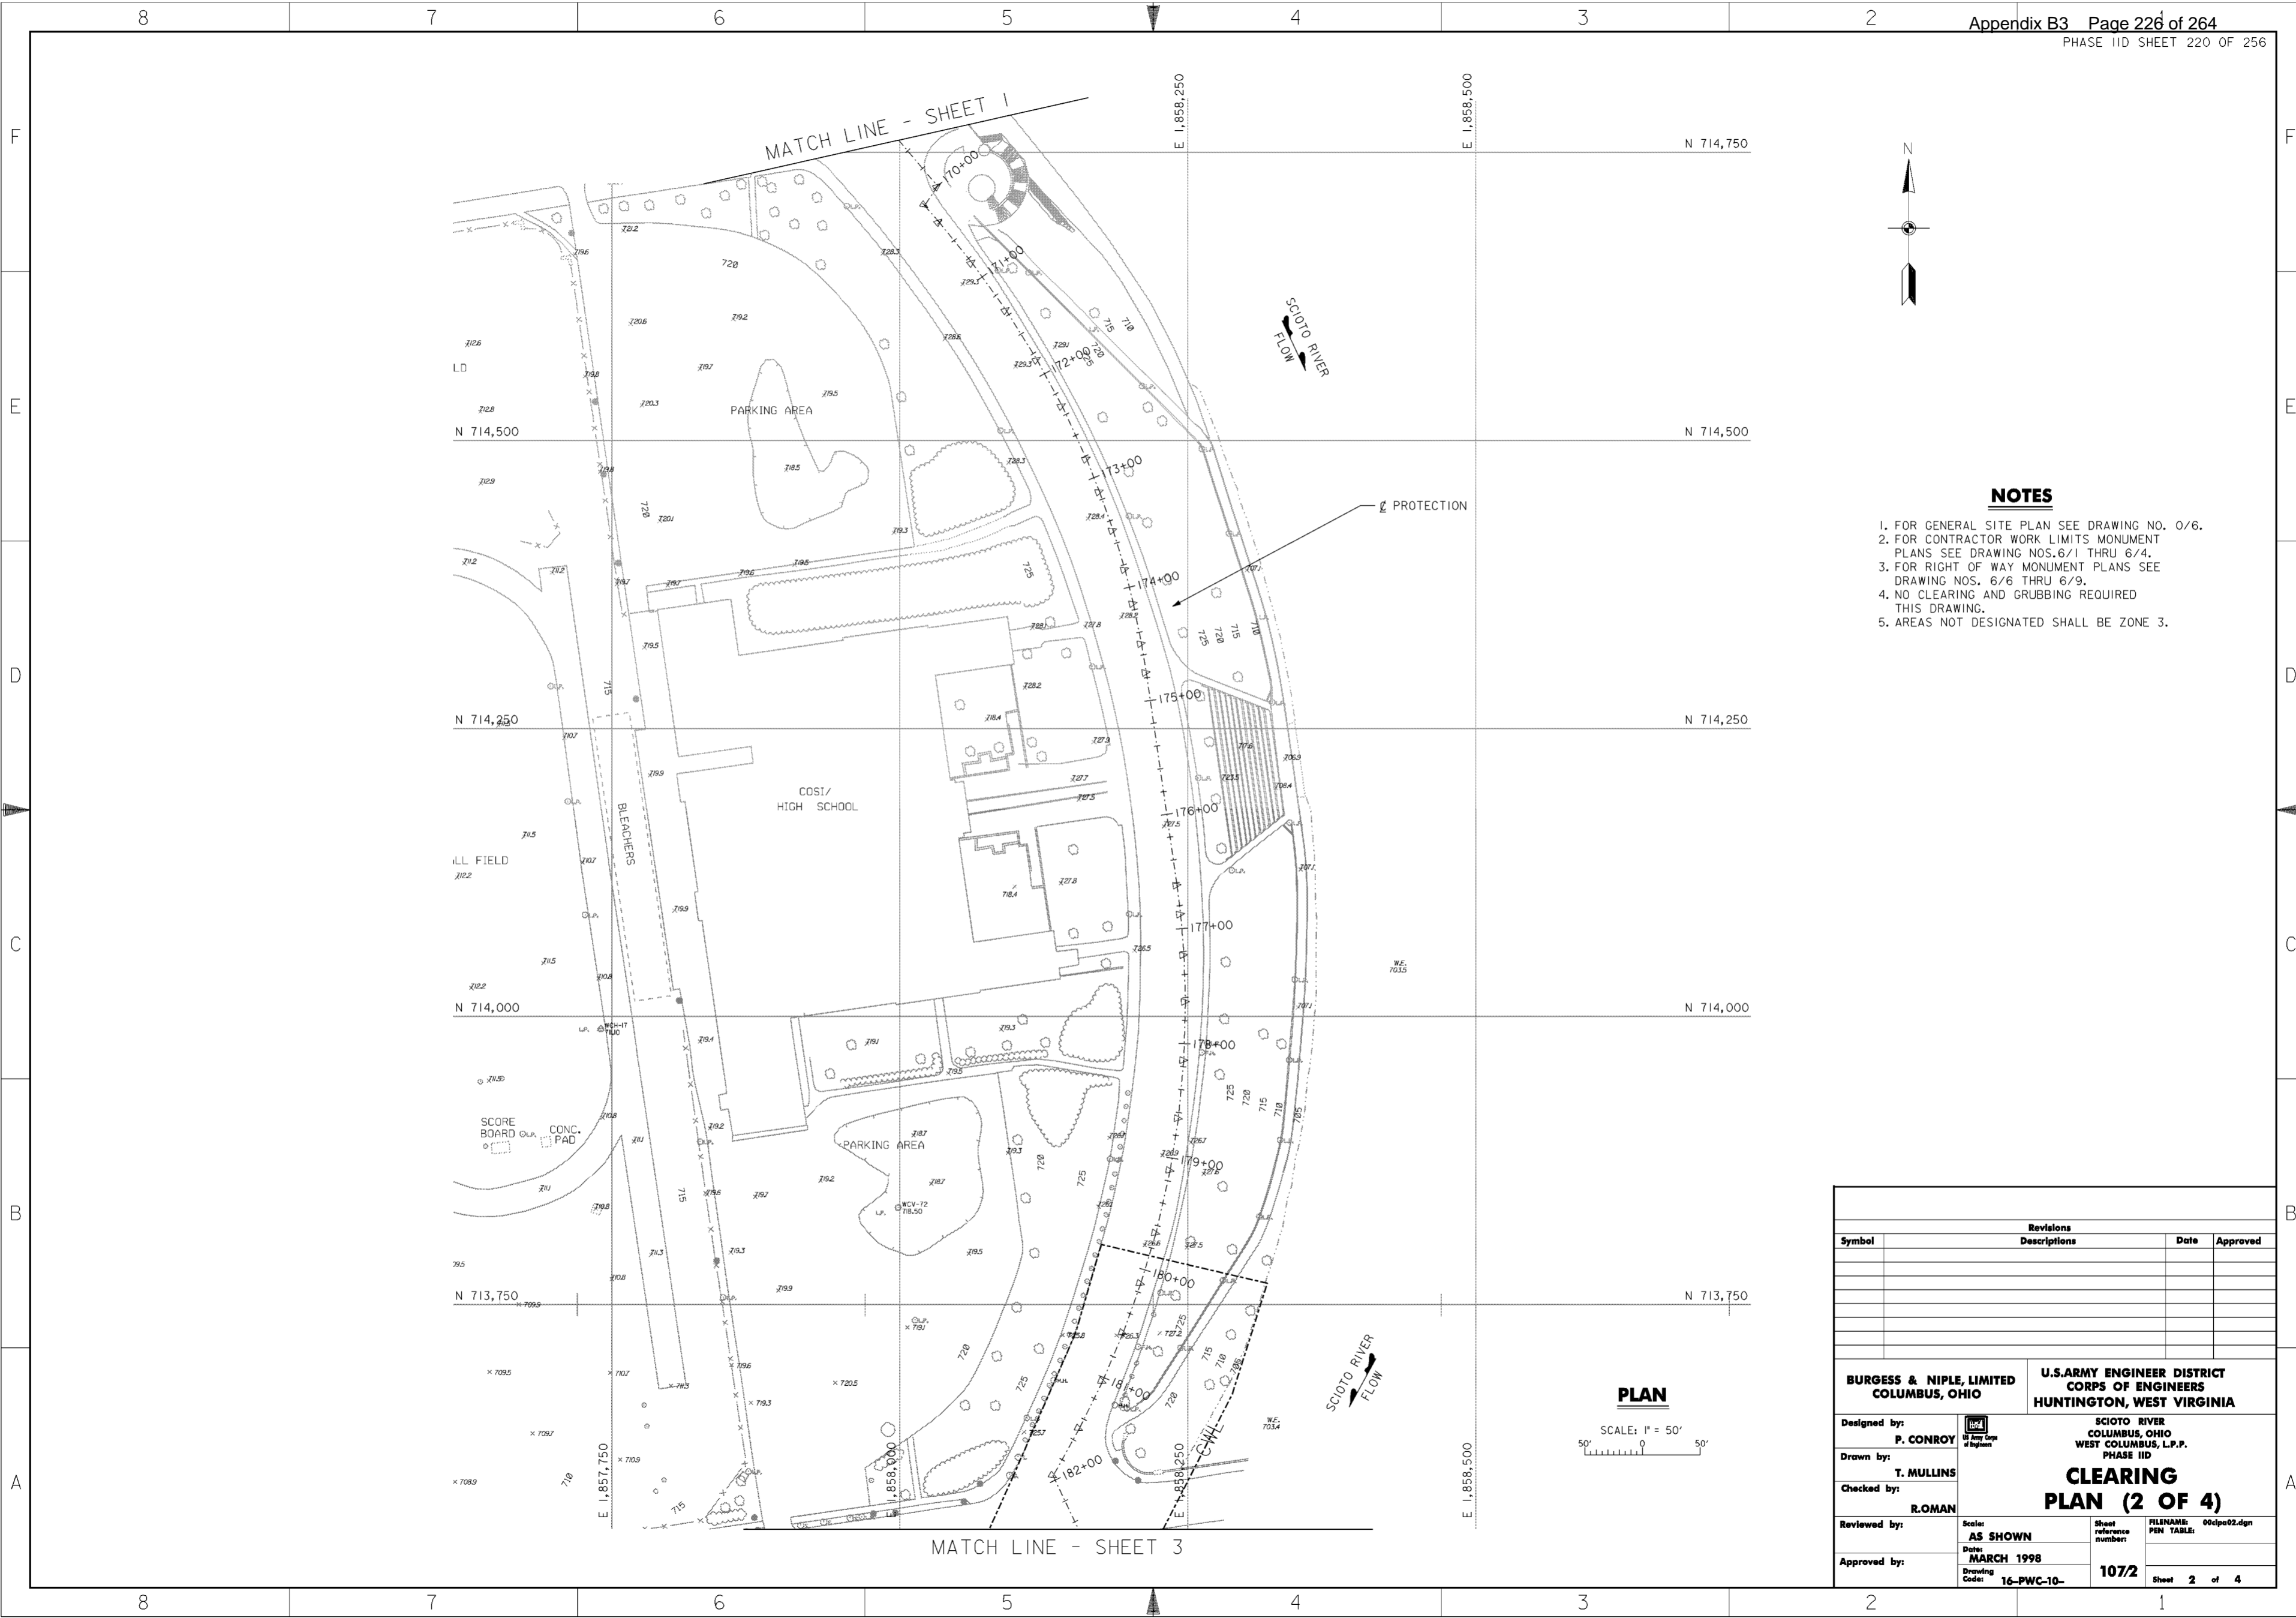

NOTES

1. FOR GENERAL SITE PLAN SEE DRAWING NO. 0/6.
2. FOR CONTRACTOR WORK LIMITS MONUMENT PLANS SEE DRAWING NOS. 6/1 THRU 6/4.
3. FOR RIGHT OF WAY MONUMENT PLANS SEE DRAWING NOS. 6/6 THRU 6/9.
4. NO CLEARING AND GRUBBING REQUIRED THIS DRAWING.
5. AREAS NOT DESIGNATED SHALL BE ZONE 3.

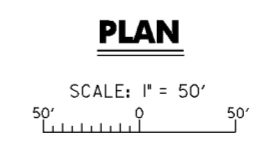


Revisions			
Symbol	Descriptions	Date	Approved

BURGESS & NIPLE, LIMITED COLUMBUS, OHIO		U.S. ARMY ENGINEER DISTRICT CORPS OF ENGINEERS HUNTINGTON, WEST VIRGINIA	
Designed by: P. CONROY		SCIOTO RIVER COLUMBUS, OHIO WEST COLUMBUS, L.P.P. PHASE IID CLEARING PLAN (2 OF 4)	
Drawn by: T. MULLINS			
Checked by: ROMAN		Scale: AS SHOWN	Sheet reference number: 107/2
Reviewed by:		Date: MARCH 1998	FILENAME: 00dps02.dgn
Approved by:		Drawing Code: 16-PWC-10-	PEN TABLE: Sheet 2 of 4

WORK AS CONSTRUCTED

MATCH LINE - SHEET 2

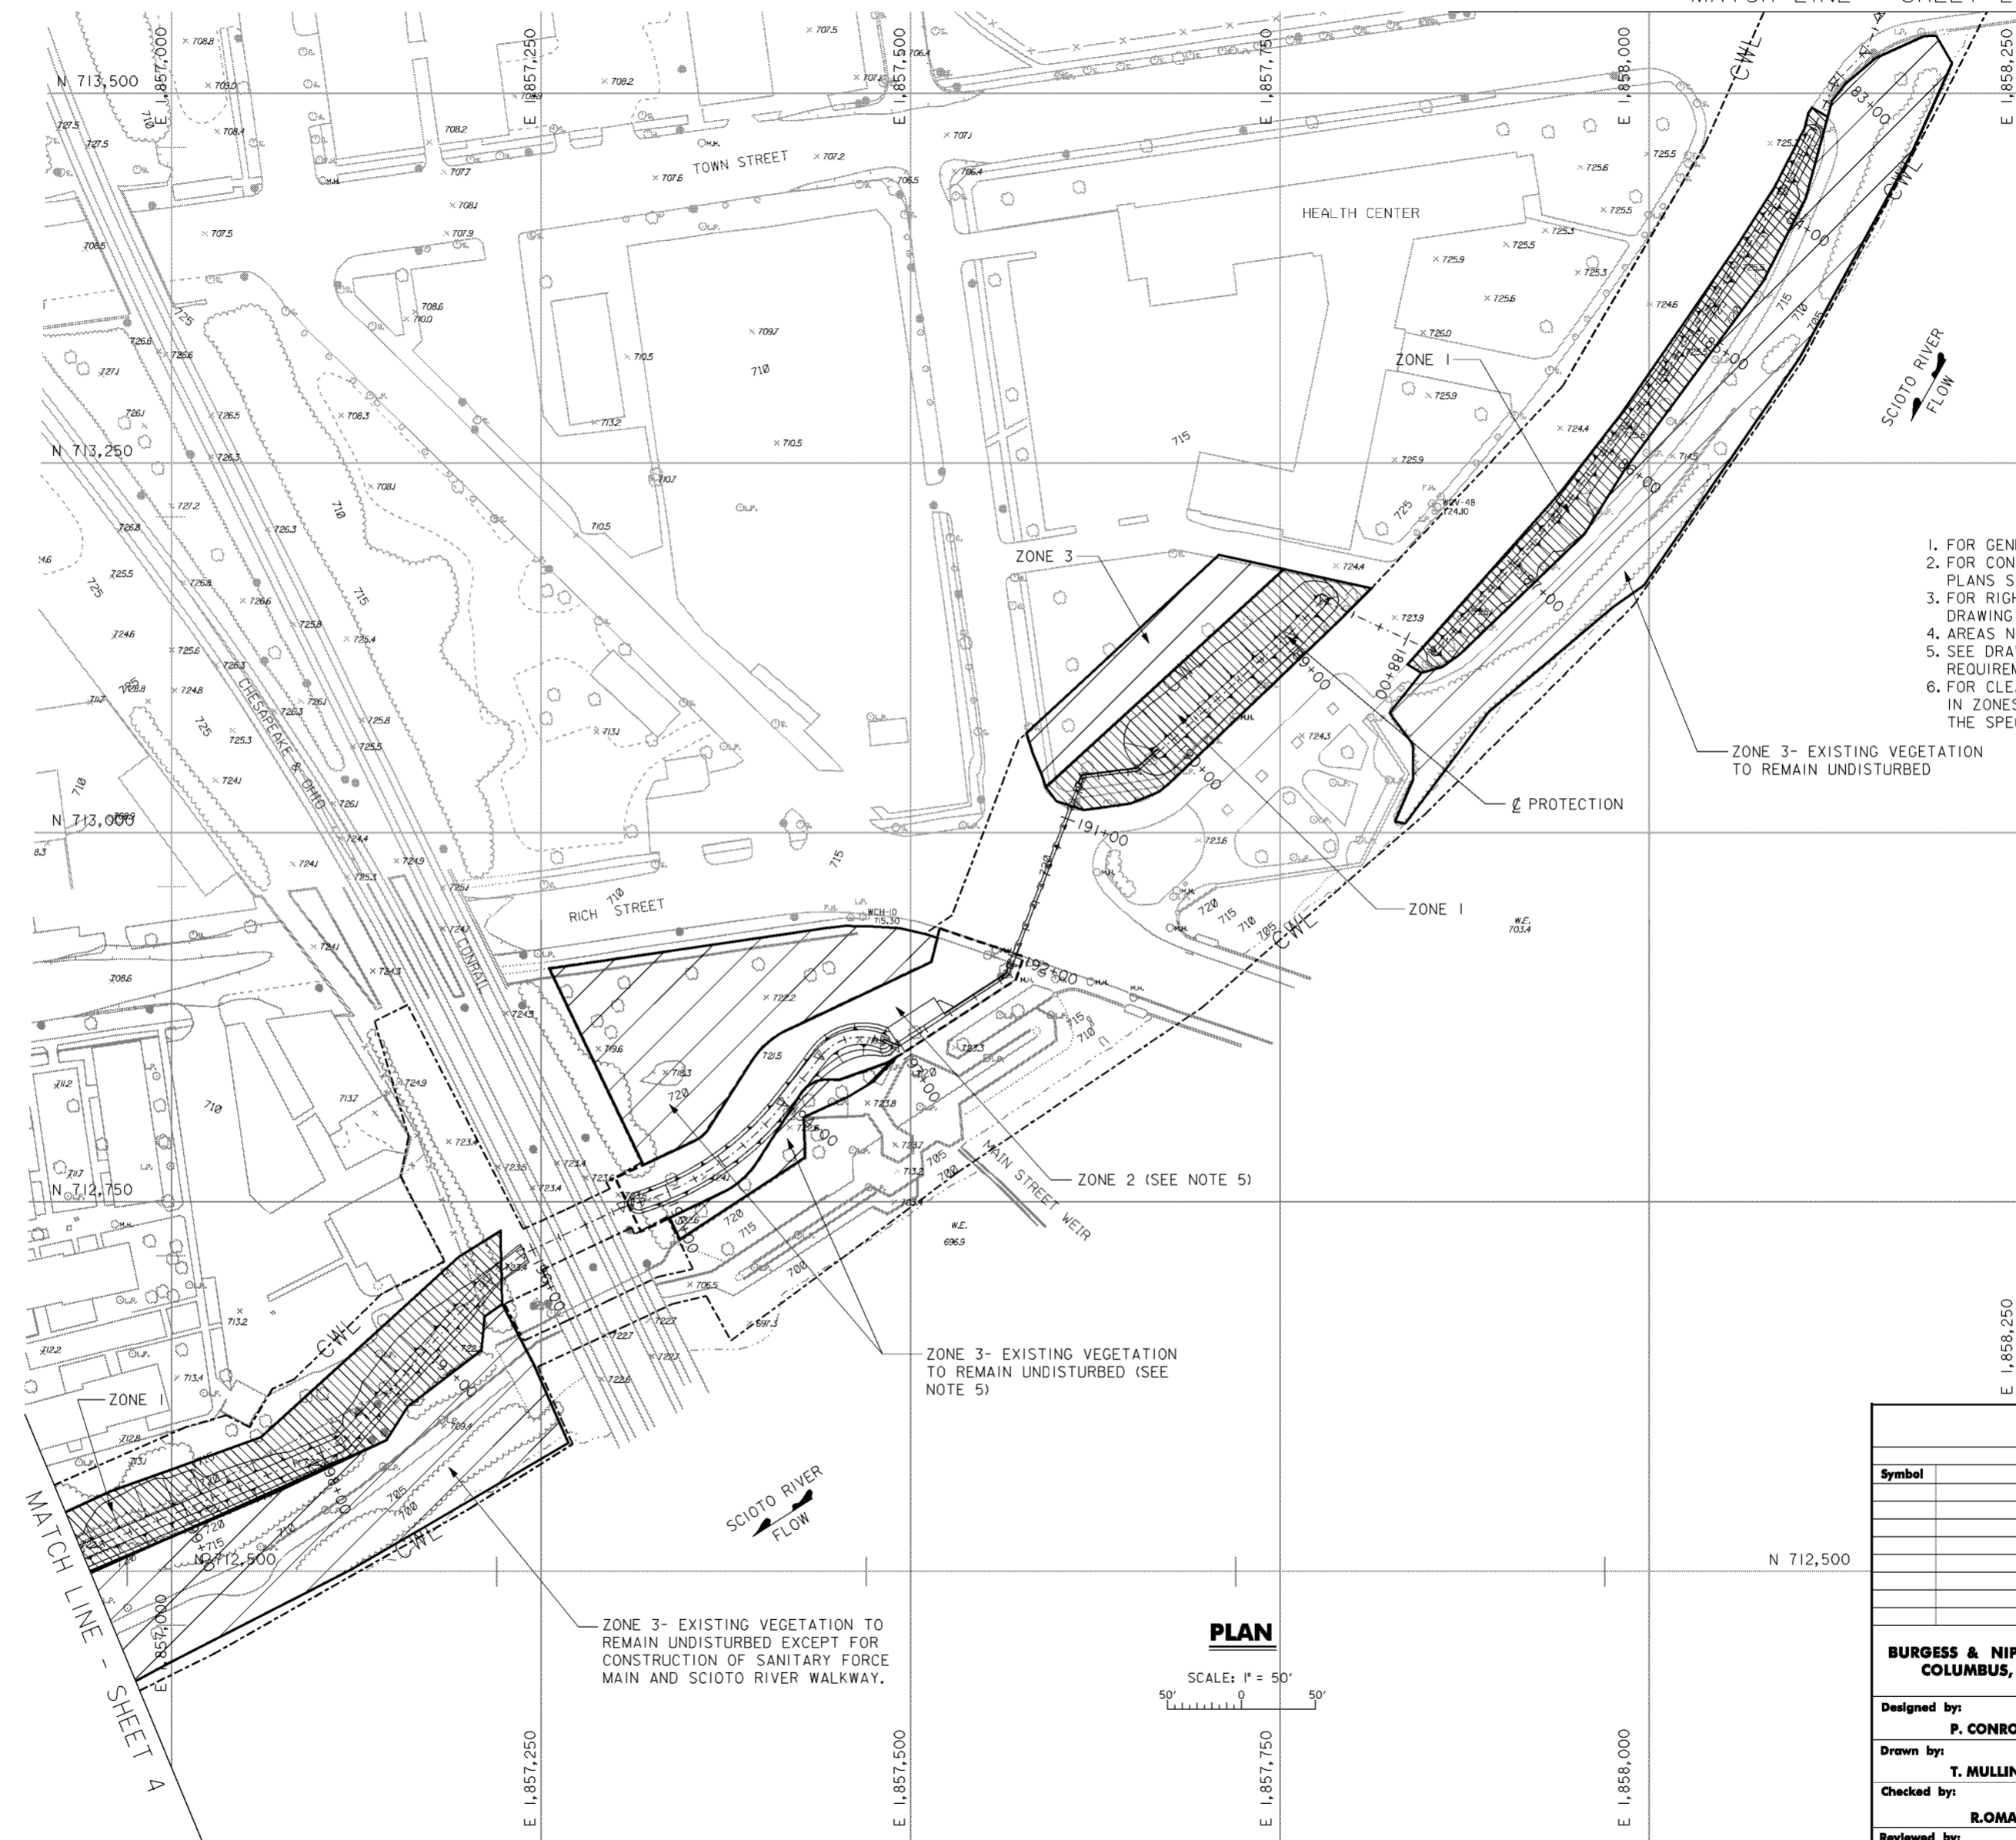

NOTES

1. FOR GENERAL SITE PLAN SEE DRAWING NO. 0/6.
2. FOR CONTRACTOR WORK LIMITS MONUMENT PLANS SEE DRAWING NOS. 6/1 THRU 6/4.
3. FOR RIGHT OF WAY MONUMENT PLANS SEE DRAWING NOS. 6/6 THRU 6/9.
4. AREAS NOT DESIGNATED SHALL BE ZONE 3.
5. SEE DRAWING NO. 16/9 FOR ADDITIONAL CLEARING REQUIREMENTS AT RICH STREET PARK.
6. FOR CLEARING AND GRUBBING REQUIREMENTS IN ZONES 1, 2 AND 3 SEE SECTION 02110 OF THE SPECIFICATIONS.

LEGEND

- ZONE 1
- ZONE 2
- ZONE 3


PLAN

SCALE: 1" = 50'


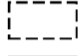
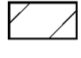
Revisions			
Symbol	Descriptions	Date	Approved

BURGESS & NIPLE, LIMITED COLUMBUS, OHIO	U.S. ARMY ENGINEER DISTRICT CORPS OF ENGINEERS HUNTINGTON, WEST VIRGINIA	SCIOTO RIVER COLUMBUS, OHIO WEST COLUMBUS, L.P.P. PHASE IID	
		CLEARING PLAN (3 OF 4)	
Designed by: P. CONROY	T. MULLINS	Scale: AS SHOWN	Sheet reference number: 107/3
Drawn by: T. MULLINS		Date: MARCH 1998	FILENAME: 00dpe03.dgn
Checked by: R.ROMAN	Reviewed by: (Signature)	Drawing Code: 16-PWC-10-	Sheet 3 of 4

WORK AS CONSTRUCTED

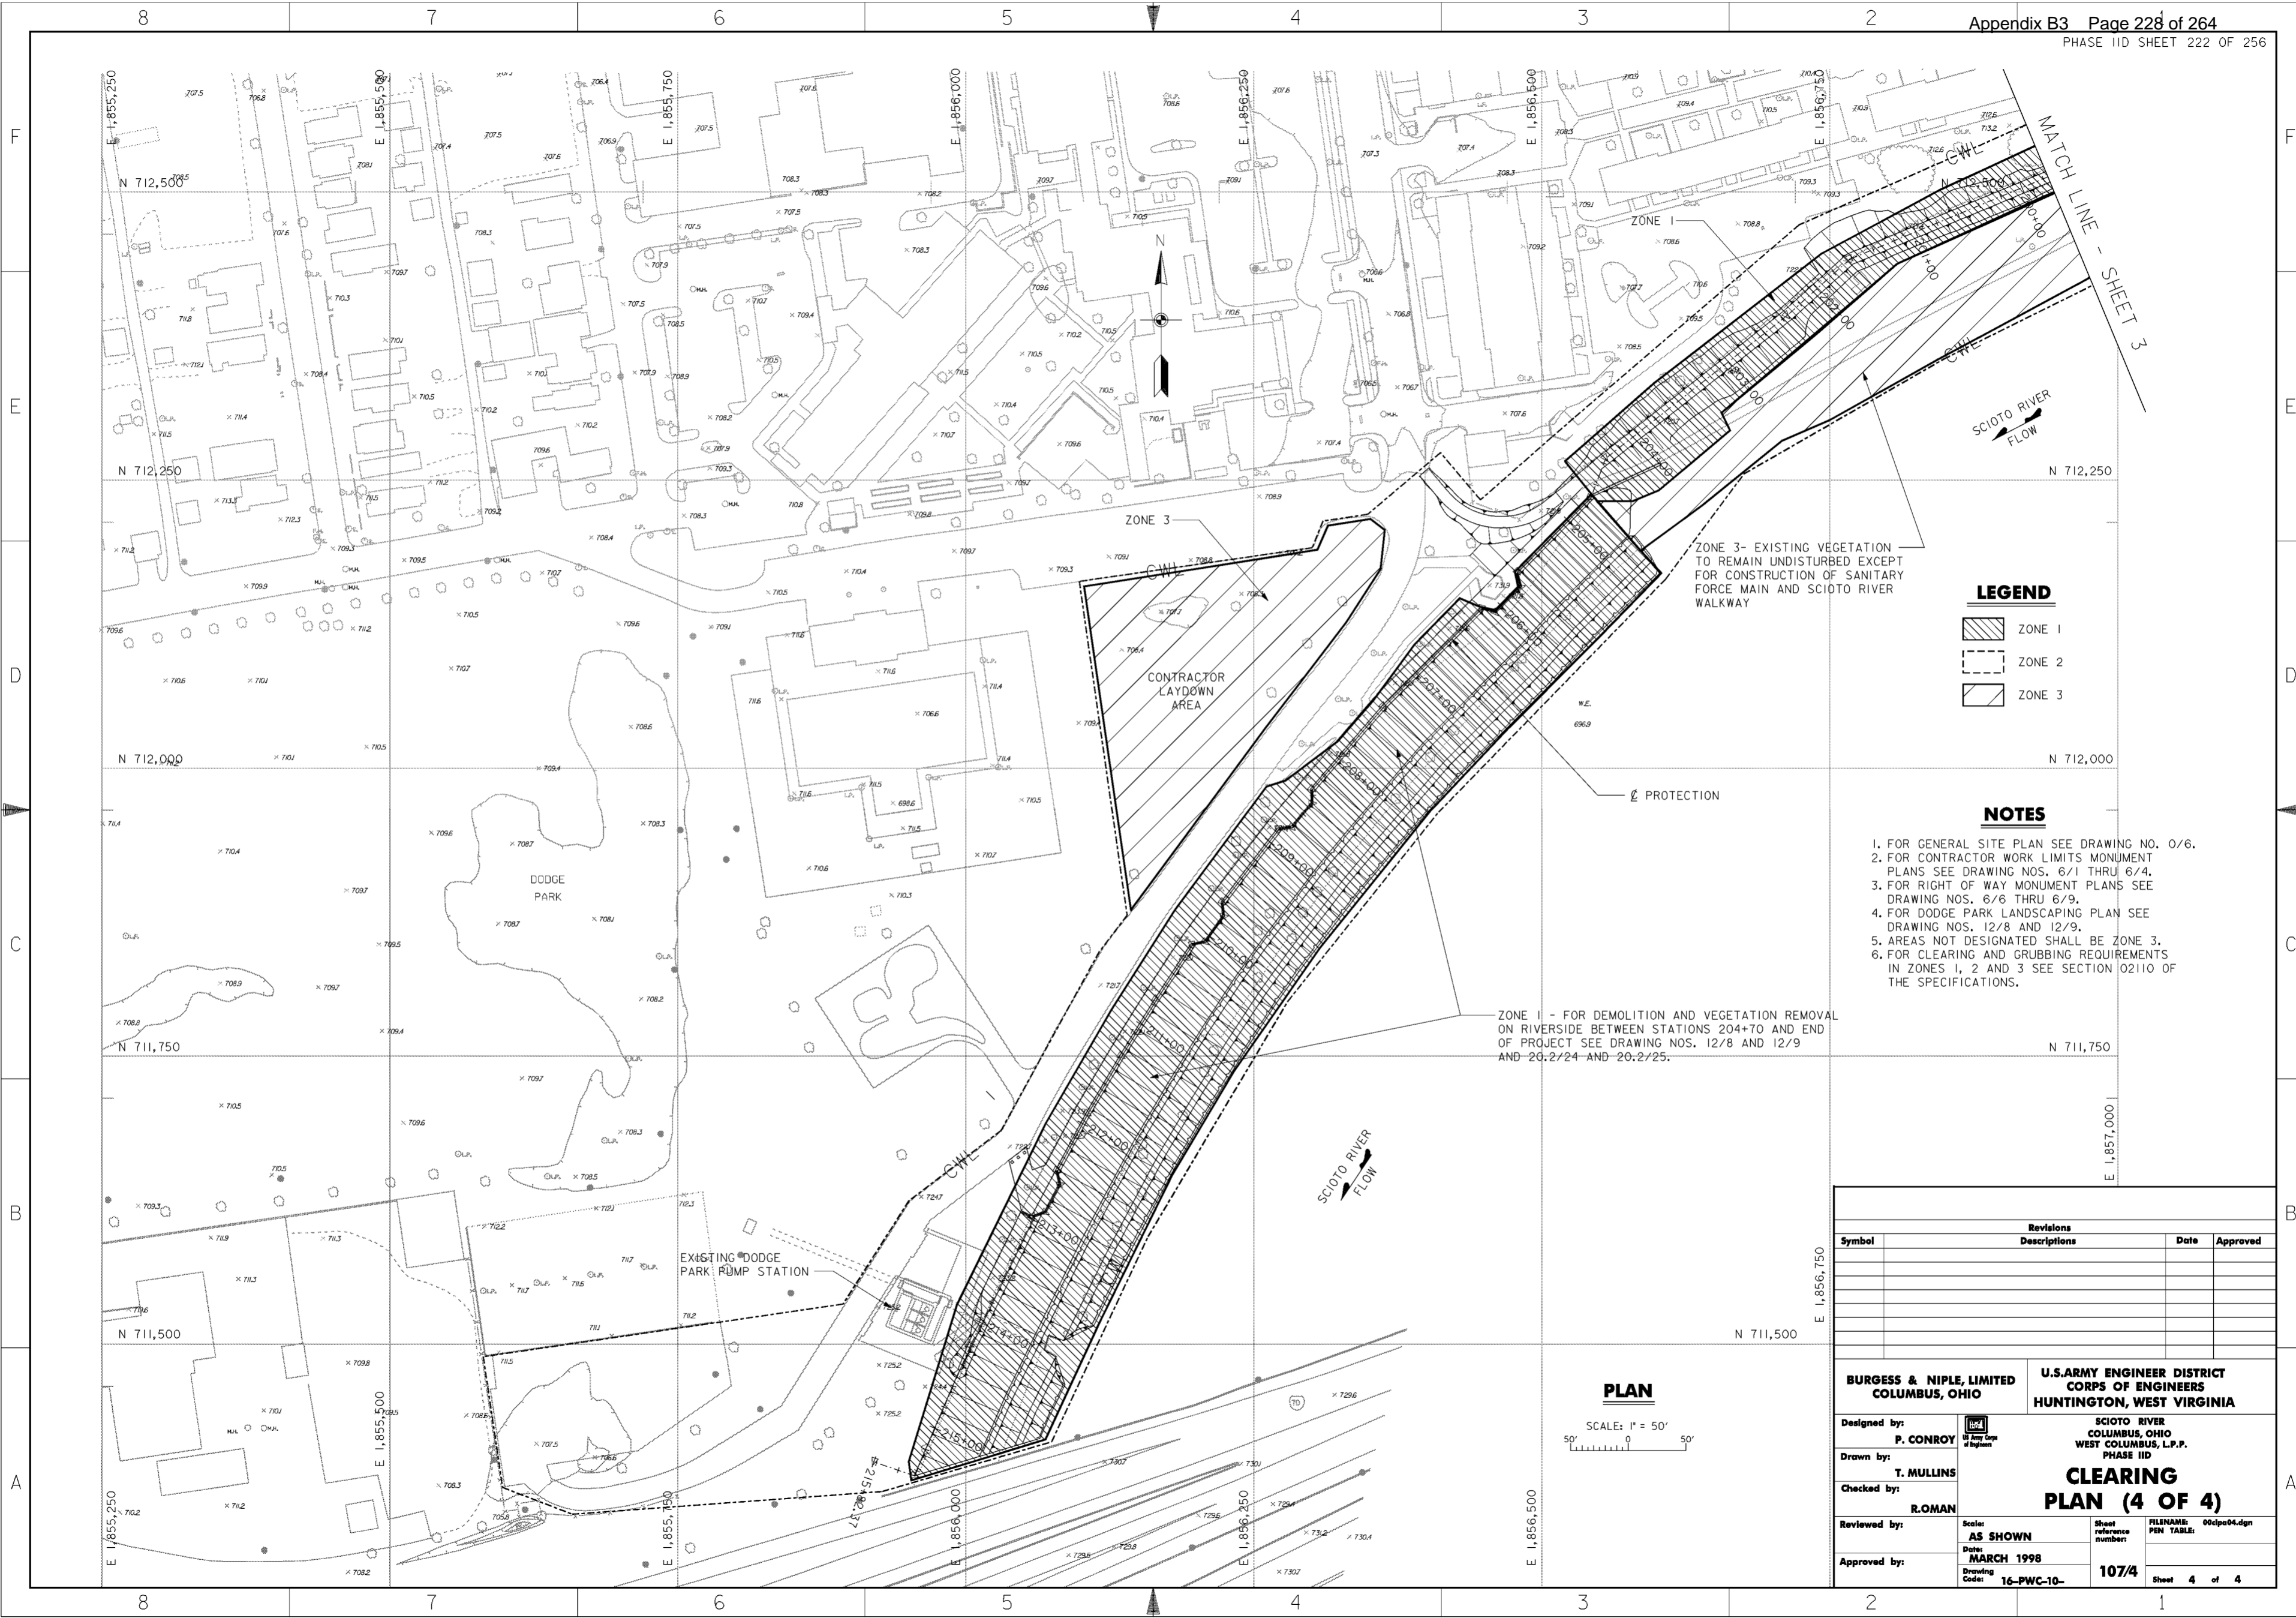

LEGEND

-  ZONE 1
-  ZONE 2
-  ZONE 3


NOTES

1. FOR GENERAL SITE PLAN SEE DRAWING NO. 0/6.
2. FOR CONTRACTOR WORK LIMITS MONUMENT PLANS SEE DRAWING NOS. 6/1 THRU 6/4.
3. FOR RIGHT OF WAY MONUMENT PLANS SEE DRAWING NOS. 6/6 THRU 6/9.
4. FOR DODGE PARK LANDSCAPING PLAN SEE DRAWING NOS. 12/8 AND 12/9.
5. AREAS NOT DESIGNATED SHALL BE ZONE 3.
6. FOR CLEARING AND GRUBBING REQUIREMENTS IN ZONES 1, 2 AND 3 SEE SECTION 02110 OF THE SPECIFICATIONS.


ZONE 1 - FOR DEMOLITION AND VEGETATION REMOVAL ON RIVERSIDE BETWEEN STATIONS 204+70 AND END OF PROJECT SEE DRAWING NOS. 12/8 AND 12/9 AND 20.2/24 AND 20.2/25.



PLAN

SCALE: 1" = 50'

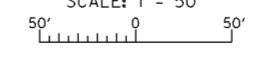

Revisions			
Symbol	Descriptions	Date	Approved

BURGESS & NIPLE, LIMITED COLUMBUS, OHIO		U.S. ARMY ENGINEER DISTRICT CORPS OF ENGINEERS HUNTINGTON, WEST VIRGINIA	
Designed by: P. CONROY		SCIOTO RIVER COLUMBUS, OHIO WEST COLUMBUS, L.P.P. PHASE IID CLEARING PLAN (4 OF 4)	
Drawn by: T. MULLINS			
Checked by: ROMAN	Scale: AS SHOWN	Sheet reference number: 107/4	FILENAME: PEN TABLE: 00dps04.dgn
Reviewed by:	Date: MARCH 1998	Drawing Code: 16-PWC-10-	Sheet 4 of 4

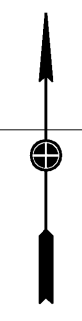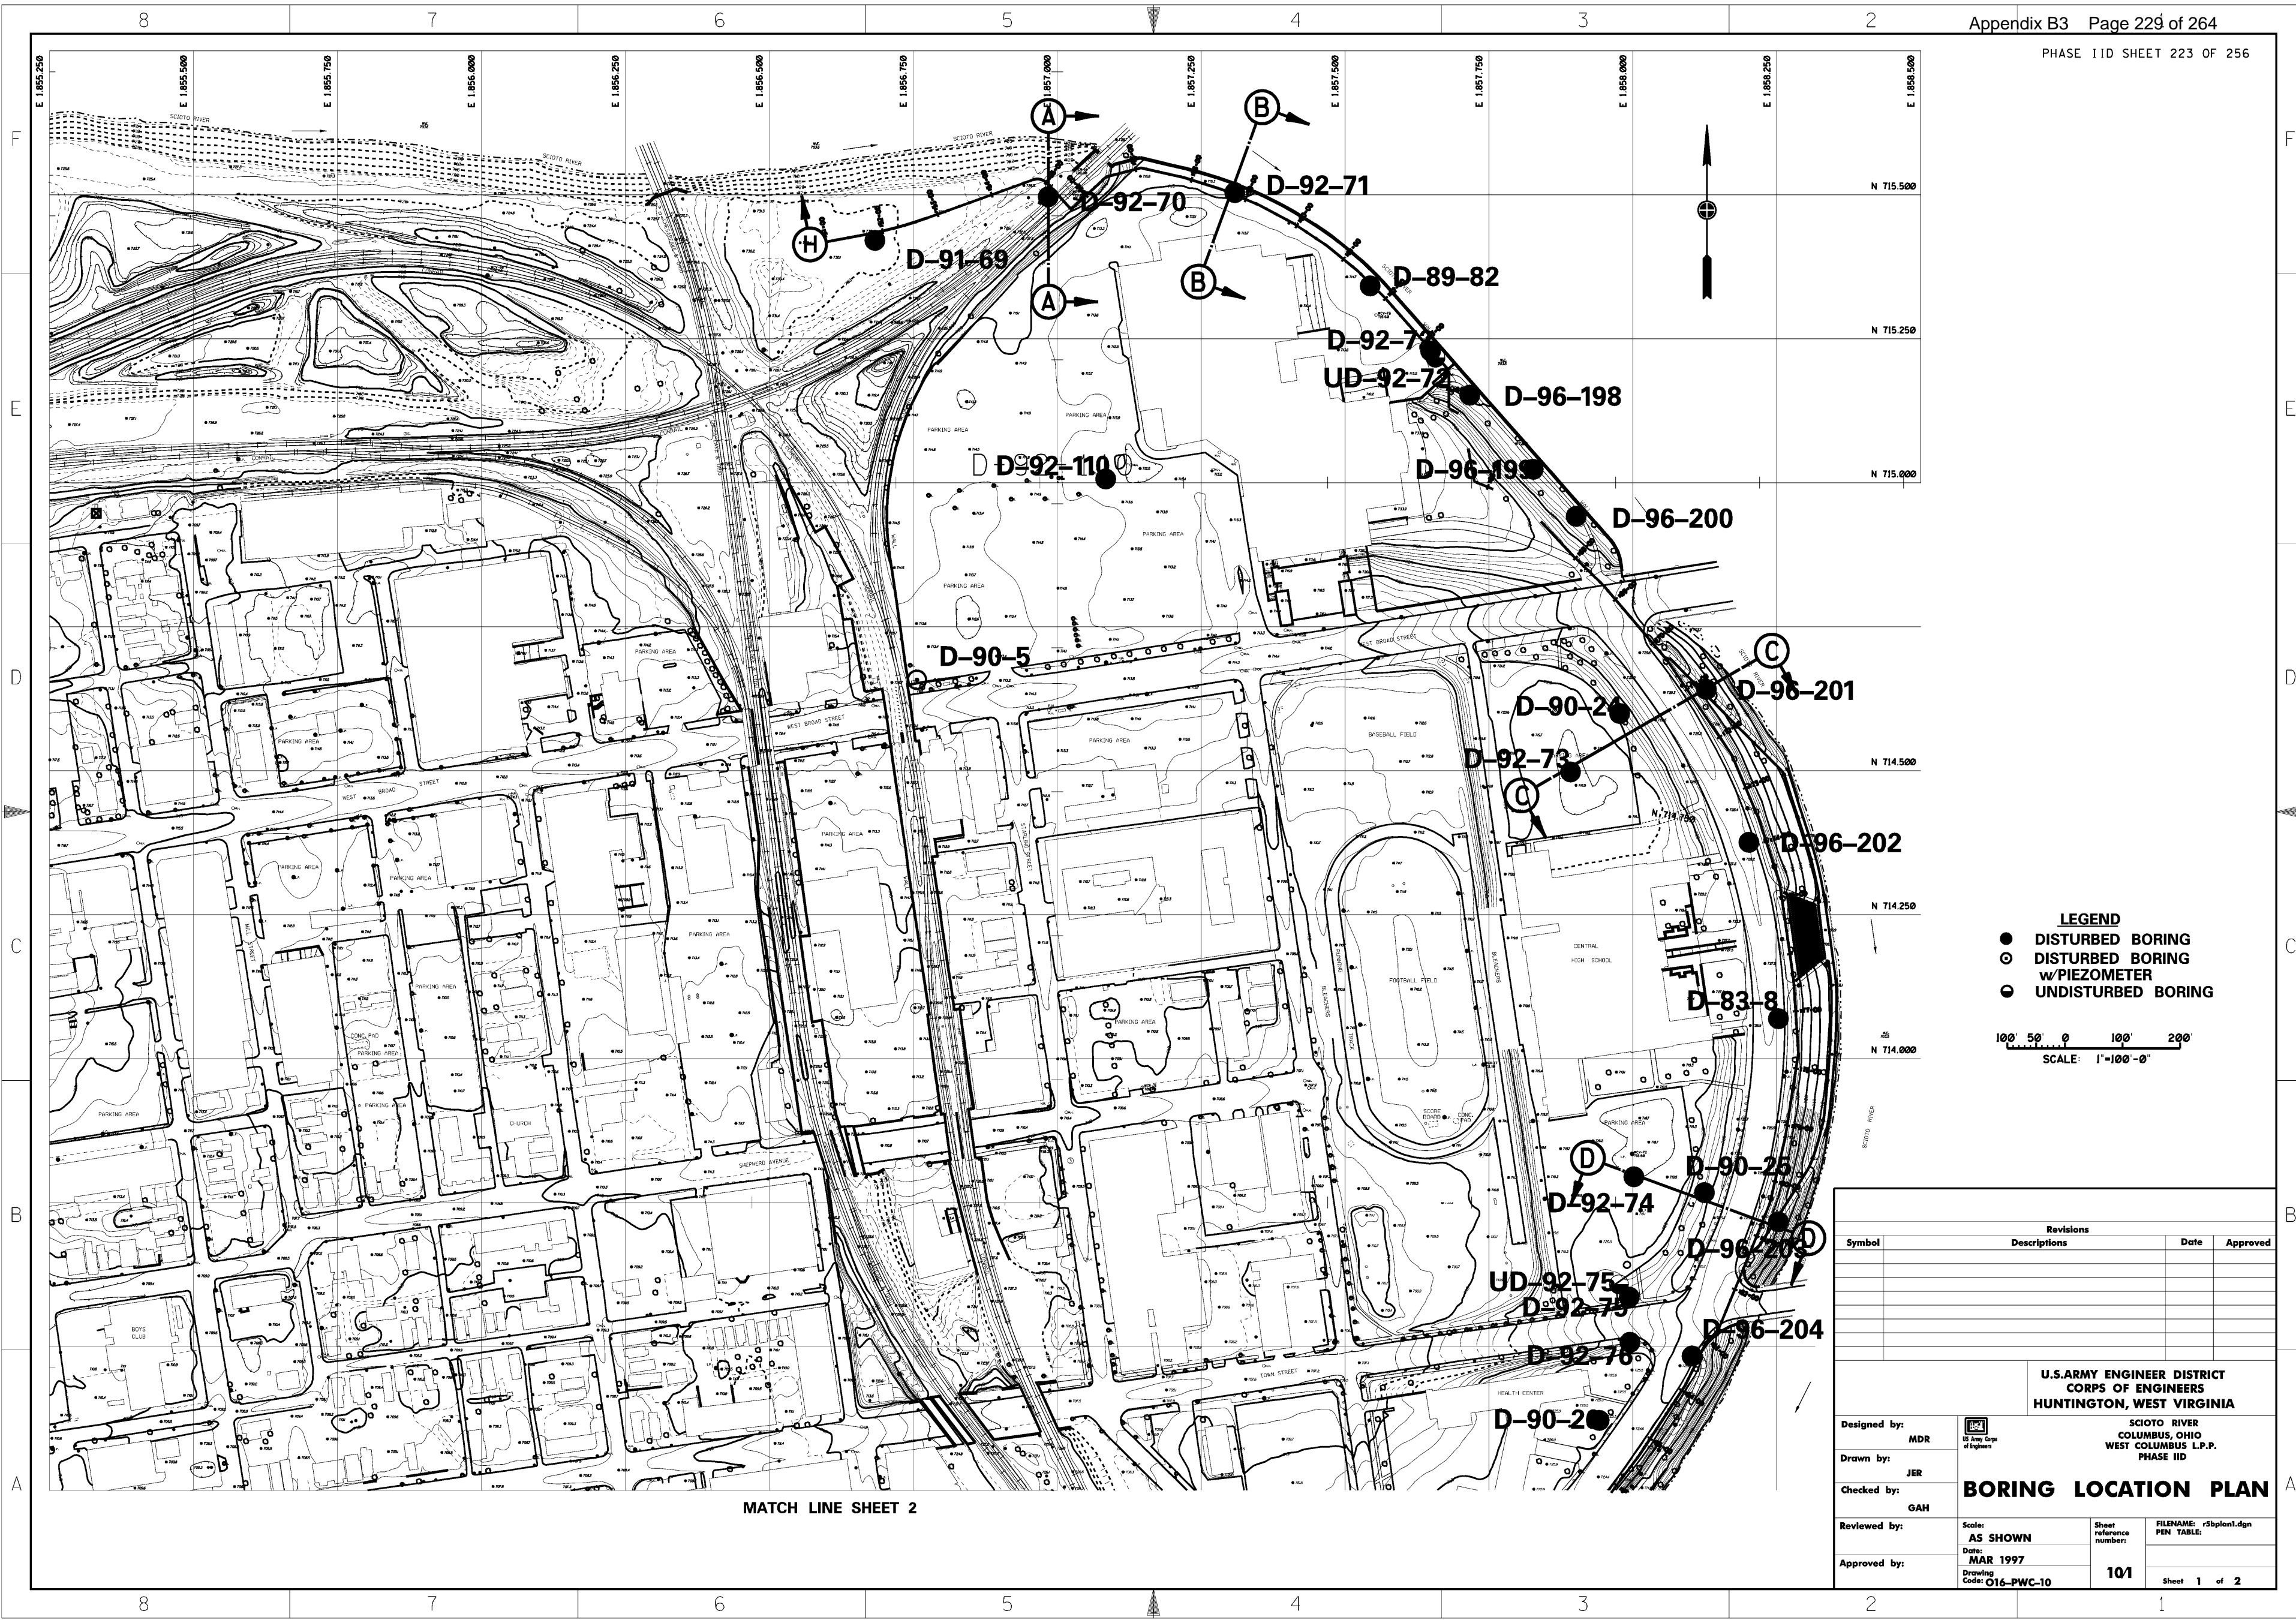

LEGEND

- DISTURBED BORING
- ⊙ DISTURBED BORING w/PIEZOMETER
- UNDISTURBED BORING

100' 50' 0' 100' 200'
SCALE: 1"=100'-0"

Revisions			
Symbol	Descriptions	Date	Approved

**U.S. ARMY ENGINEER DISTRICT
CORPS OF ENGINEERS
HUNTINGTON, WEST VIRGINIA**


SCIOTO RIVER
COLUMBUS, OHIO
WEST COLUMBUS L.P.P.
PHASE IID

BORING LOCATION PLAN


Designed by: MDR		Scale: AS SHOWN	Sheet reference number: 101	FILENAME: r5bplan1.dgn PEN TABLE:
Drawn by: JER		Date: MAR 1997		
Checked by: GAH				
Reviewed by:				
Approved by:		Drawing Code: 016-PWC-10		Sheet 1 of 2

MATCH LINE SHEET 2


MATCH LINE SHEET 1

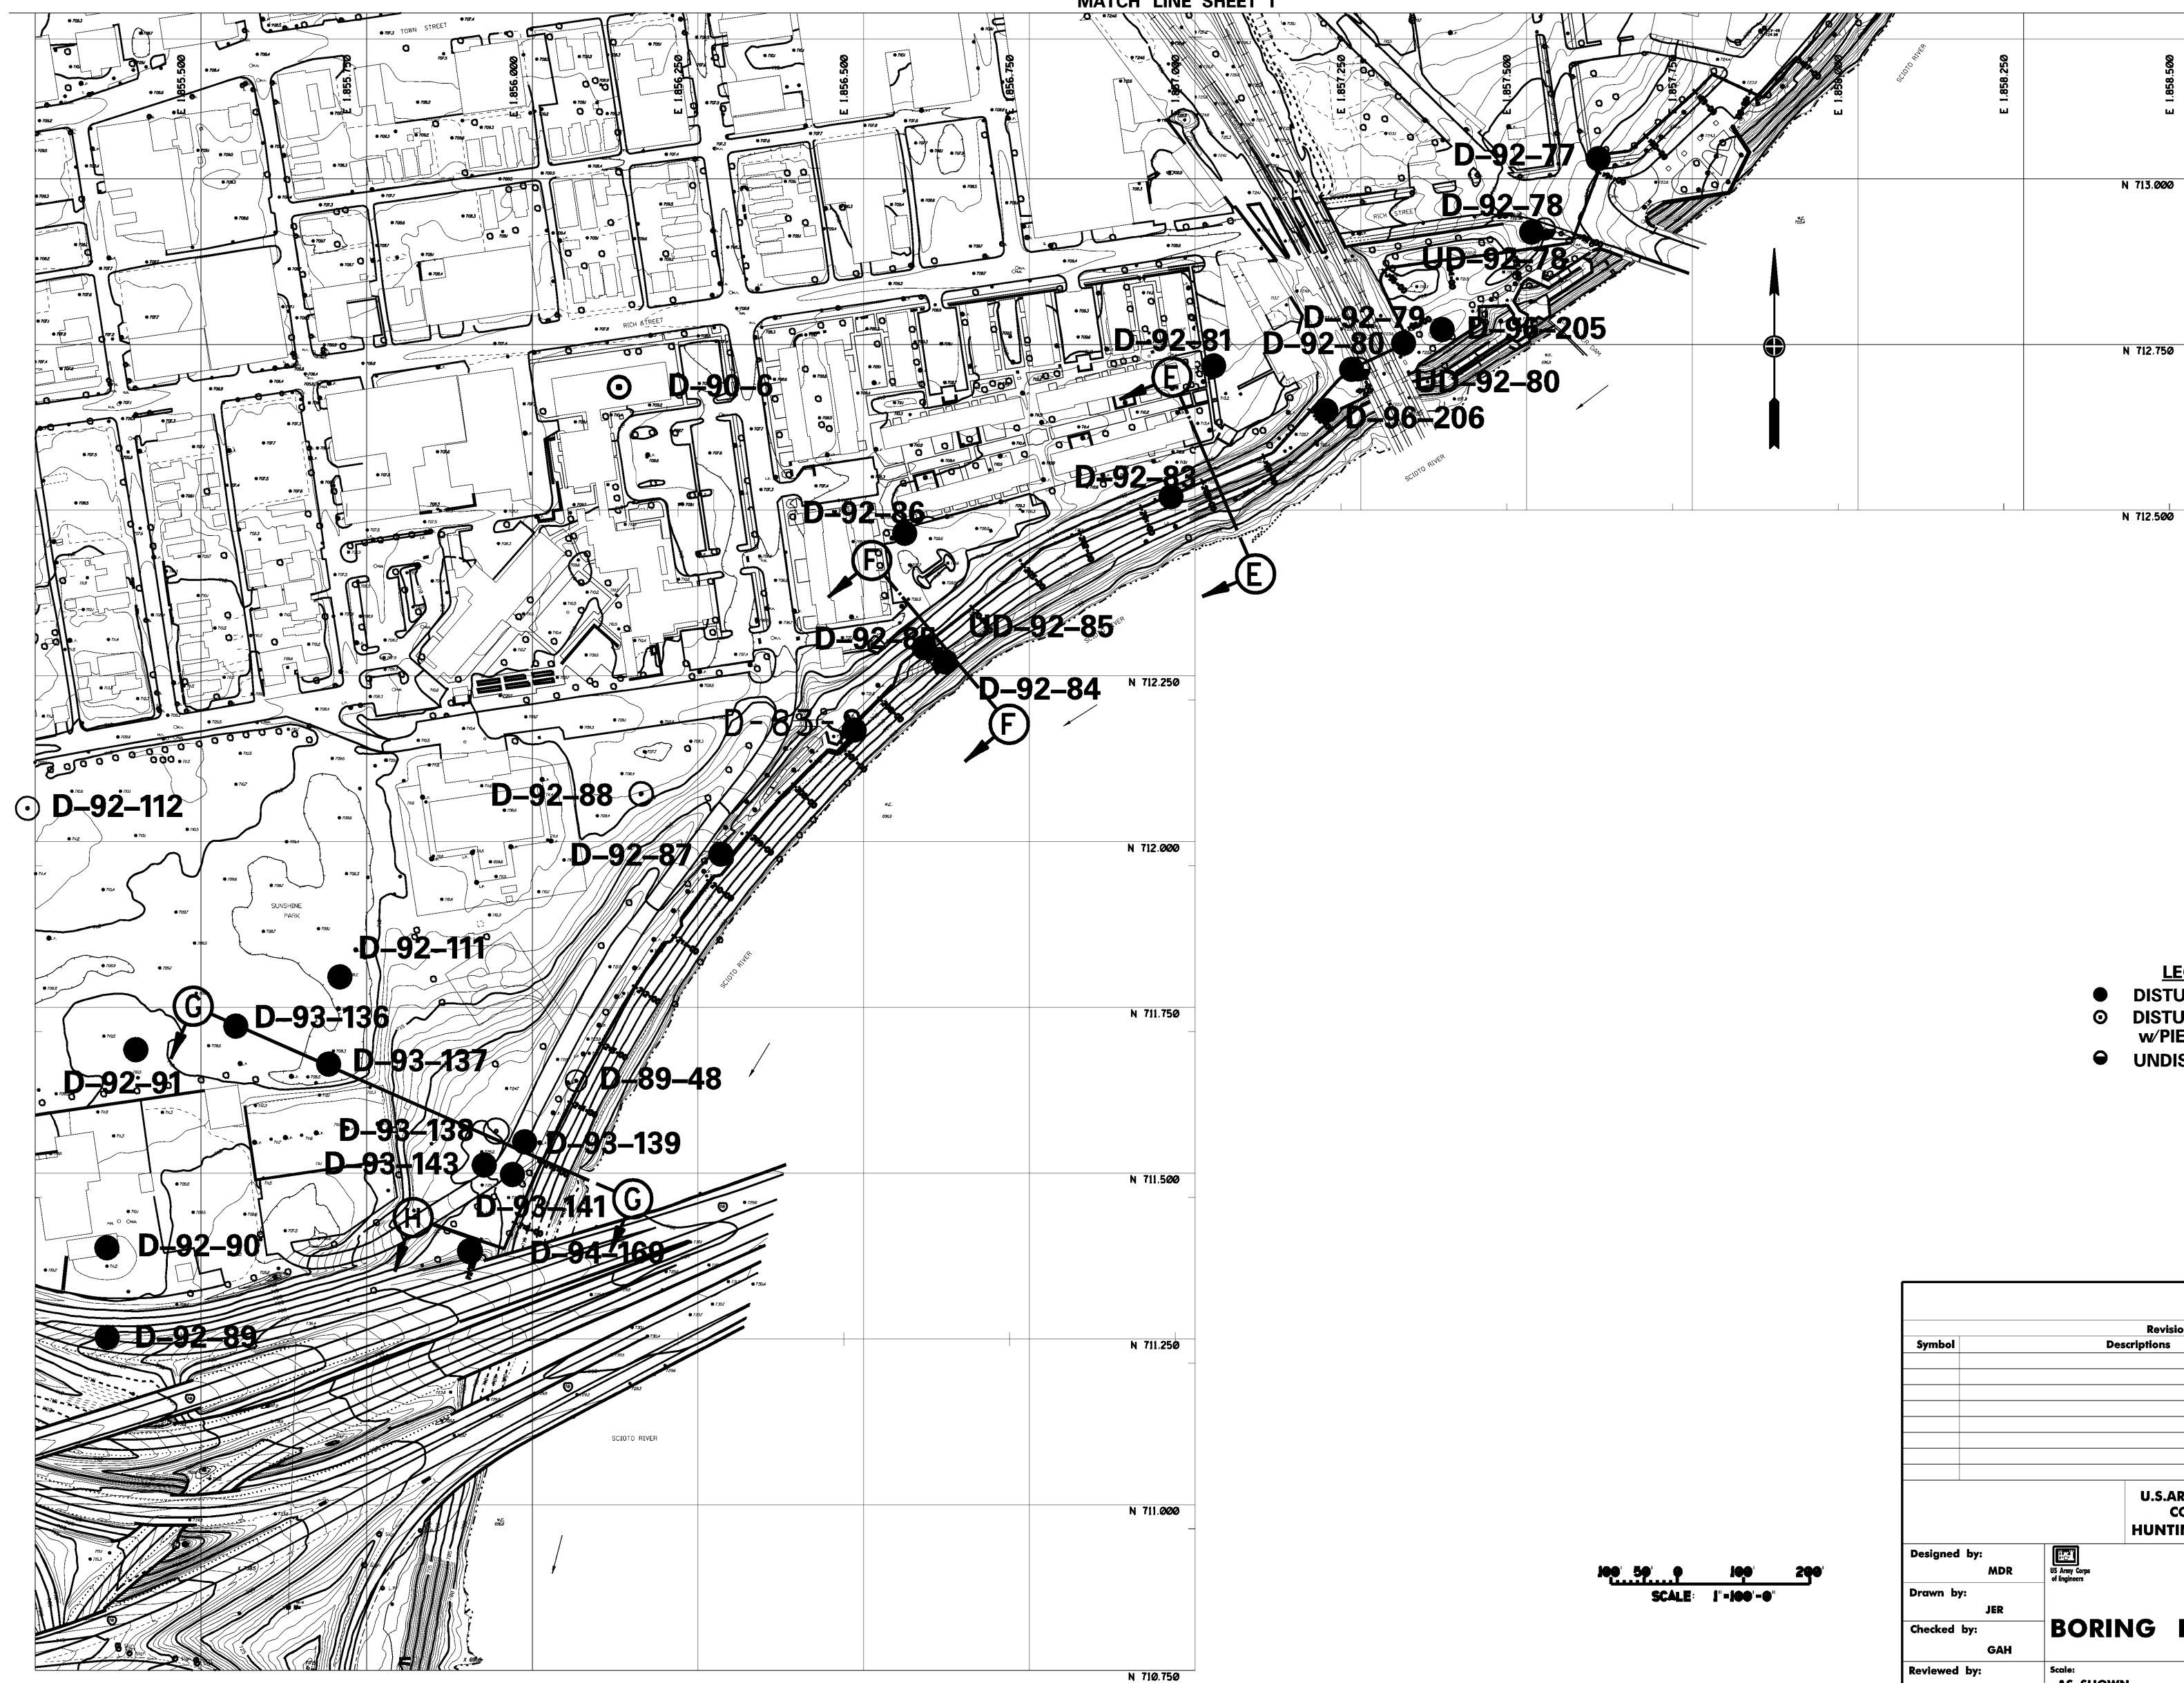

- LEGEND**
- DISTURBED BORING
 - ⊙ DISTURBED BORING w/PIEZOMETER
 - UNDISTURBED BORING

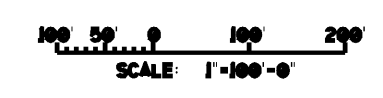

Revisions			
Symbol	Descriptions	Date	Approved

U.S. ARMY ENGINEER DISTRICT CORPS OF ENGINEERS HUNTINGTON, WEST VIRGINIA			
Designed by: MDR		SCIOTO RIVER COLUMBUS, OHIO WEST COLUMBUS, L.P.P. PHASE IID	
Drawn by: JER	Checked by: GAH	BORING LOCATION PLAN	
Reviewed by:	Scale: AS SHOWN	Sheet reference number: 102	FILENAME: r5bplan2.dgn
Approved by:	Date: DEC 1996	Drawing Code: 016-PWC-10	PEN TABLE: Sheet 2 of 2


UNIFIED SOIL CLASSIFICATION

Including Identification and Description

MAJOR DIVISIONS	GROUP SYMBOLS	TYPICAL NAMES	FIELD IDENTIFICATION PROCEDURES	INFORMATION REQUIRED FOR DESCRIBING SOILS	LABORATORY CLASSIFICATION CRITERIA				
COARSE - GRAINED SOILS More than half of material is larger than No. 200 sieve size	GRAVELS More than half of coarse fraction is smaller than No. 4 sieve size.	GW	Well - graded gravels, gravel - sand mixtures, little or no fines.	Wide range in grain sizes and substantial amounts of all intermediate particle sizes.	For undisturbed soils add information on stratification, degree of compactness, cementation, moisture conditions and drainage characteristics. Give typical name; indicate approximate percentage sand and gravel, max. size; angularity, surface condition, and hardness of the coarse grains; local or geologic name and other pertinent descriptive information; and symbol in parentheses. EXAMPLE Silty sand, gravelly; about 20% hard, angular gravel particles 1/2-in. max. size; rounded and subangular sand grains coarse to fine; about 15% nonplastic fines with low dry strength; well compacted and moist in place; alluvial sand (SM).	$C_u = \frac{D_{60}}{D_{10}}$ Greater than 4 $C_c = \frac{(D_{30})^2}{D_{10} D_{60}}$ Between one and 3 Not meeting all gradation requirements for GW Atterberg limits below 'A' line or PI less than 4 Atterberg limits above 'A' line with PI greater than 7 $C_u = \frac{D_{60}}{D_{10}}$ Greater than 6 $C_c = \frac{(D_{30})^2}{D_{10} D_{60}}$ Between one and 3 Not meeting all gradation requirements for SW Atterberg limits below 'A' line or PI less than 4 Atterberg limits above 'A' line with PI greater than 7			
		GP	Poorly - graded gravels, gravel - sand mixtures, little or no fines.	Predominantly one size or a range of sizes with some intermediate sizes missing.					
	SANDS More than half of coarse fraction is smaller than No. 4 sieve size. (For visual classification, the 1/4-inch size may be used as equivalent to the No. 4 sieve size.)	GM	Silty gravels, gravel - sand - silt mixtures.	Nonplastic fines or fines with low plasticity (for identification procedures see ML below).					
		GC	Clayey gravels, gravel - sand - clay mixtures.	Plastic fines (for identification procedures see CL below).					
	FINE - GRAINED SOILS More than half of material is smaller than No. 200 sieve size	Clean Sands (Little or no fines)	SW	Well - graded sands, gravelly sands, little or no fines.			Wide range in grain size and substantial amounts of all intermediate particle sizes.	Determine percentages of gravel and sand from grain size curves. Percentages of coarse-grained soils are classified as follows: Less than 5% GM, GC, SM, SC More than 5% to 12% GM, GC, SM, SC More than 12% to 50% GM, GC, SM, SC Use grain-size curve in identifying the fractions as given under field identification.	
			SP	Poorly - graded sands, gravelly sands, little or no fines.			Predominantly one size or a range of sizes with some intermediate sizes missing.		
		Sands with Fines (Appreciable amount of fines)	SM	Silty sands, sand - silt mixtures.			Nonplastic fines or fines with low plasticity (for identification procedures see ML below).		
			SC	Clayey sands, sand - clay mixtures.			Plastic fines (for identification procedures see CL below).		
		Silt and Clays Liquid Limit Less than 50	on Fraction Smaller than No. 40 Sieve Size (crushing) DILATANCY (reaction to shaking) TOUGHNESS (consistency near PL)	ML			Inorganic silts and very fine sands, rock flour, silty or clayey fine sands or clayey silts with slight plasticity.		None to slight Quick to slow None
				CL			Inorganic clays of low to medium plasticity, gravelly clays, sandy clays, silty clays, lean clays.		Medium to high None to slow Medium
Silt and Clays Liquid Limit Greater than 50	MH		Inorganic silts, micaceous or diatomaceous fine sandy or silty soils, elastic silts.	Slight to medium Slow to none Slight to medium					
	CH		Inorganic clays of high plasticity, fat clays.	High to very high None High					
OH	Organic clays of medium to high plasticity, organic silts.	Medium to high None to very slow Slight to medium							
Highly Organic Soils	Pt	Peat and other highly organic soils.	Readily identified by color, odor, spongy feel and frequently by fibrous texture.						

ROCK

NAME	ABBREVIATION
SANDSTONE	SS.
CONGLOMERATE	CONG.
SHALE	SH.
SILTSTONE	SLS.
CLAYSTONE	CLS.
LIMESTONE	LS.
COAL	C.
INDURATED CLAY	ICL.
DOLOMITE	DO.

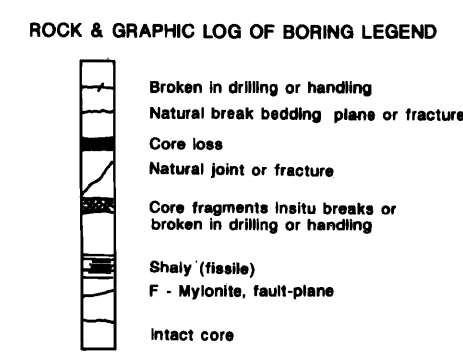

GRAPHIC LOG OF BORING

Vertical or Degrees From _____

Drill Hole Compass Direction _____

PROJECT SAMPLE LOG

HOLE NO. C-87-39

Date Started: 26 Oct. 1979
Completed: 1 Nov. 1979

Sampler: 2" S.S.
Drop: 30"
Hammer: 140#

Coordinates: N. 557,930.2
E. 1738,407.9

Location

ELEVATION (Feet)	SYMBOL	DESCRIPTION OF MATERIALS	REMARKS												
			W.C.	LL	PL	% Sat	200	Blows							
549.1		CLAY (CL), br. pl. met. w/ f.g.-c.g. SAND, no. frags. to 1"													
541.6	CL	SILTY SANDY GRAVEL (GM), gr. non pl. dmp. f.g.-c.g. ang. to subangular GRAVEL, f.g.-c.g. SAND	19	41				4	98						
535.1	GM	DRILLING W/O SAMPLING													
529.1	NS	SAMPLED - NO RECOVERY													
516.9	SH	Shale, silty, soft to mod. hard, gray, poorly fissile with clayey zones. 0.6' sandy SILTSTONE zone at 523.3 to 522.7. 0.5' partially broken along vertical fracture from 521.2 to 520.7. Unweathered, vertical fracture from 518.3 to 517.1.													
	SS	SANDSTONE, hard, fine to medium grained, gray, micaceous, thick bedded with micaceous, laminations. Very fine grained and silty to 513.2 1.6' zone with numerous micaceous laminations from 512.9 to 511.3. 0.3' broken, very friable zone & unweathered fracture from 509.2 to 508.9.													

(1) Boundary classifications: Soils possessing characteristics of two groups are designated by combinations of group symbols. For example GW-GC, well-graded gravel-sand mixture with clay binder (2) All sieve sizes on this chart are U.S. standard.

FIELD IDENTIFICATION PROCEDURES FOR FINE - GRAINED SOILS OR FRACTIONS

These procedures are to be performed on the minus No. 40 sieve size particles, approximately 1/64 in. for field classification purposes, screening is not intended, simply remove by hand the coarse particles that interfere with the tests.

DILATANCY (reaction to shaking)

After removing particles larger than No. 40 sieve size, prepare a pat of moist soil with a volume of about one-half cubic inch. Add enough water if necessary to make the soil soft but not sticky. Place the pat in the open palm of one hand and shake horizontally, striking vigorously against the other hand several times. A positive reaction consists of the appearance of water on the surface of the pat which changes to a livery consistency and becomes glossy. When the sample is squeezed between the fingers, the water and glass disappear from the surface, the pat stiffens, and finally cracks or crumbles. The rapidity of appearance of water during shaking and of its disappearance during squeezing assist in identifying the character of the fines in a soil. Very fine clean sands give the quickest and most distinct reaction whereas a plastic clay has no reaction. Inorganic silts, such as a typical rock flour show a moderately quick reaction.

Adopted by the Corps of Engineers and Bureau of Reclamation, January 1952.

DRY STRENGTH (crushing characteristics)

After removing particles larger than No. 40 sieve size, mold a pat of soil to the consistency of putty, adding water, if necessary. Allow the pat to dry completely by oven, sun, or air drying, and then test its strength by breaking and crumbling between the fingers. This strength is a measure of the character and quantity of the colloidal fraction contained in the soil. The dry strength increases with increasing plasticity. High dry strength is characteristic for clays of the CH group. A typical inorganic silt possesses only very slight dry strength. Silty fine sands and silts have about the same slight dry strength, but can be distinguished by the feel when powdering the dried specimen. Fine sand feels gritty whereas a typical silt has the smooth feel of flour.

TOUGHNESS (consistency near plastic limit)

After removing particles larger than the No. 40 sieve size, a specimen of soil about one-half inch cube in size, is molded to the consistency of putty. If too dry, water must be added and if sticky, the specimen should be spread out in a thin layer and allowed to lose some moisture by evaporation. Then the specimen is rolled out by hand on a smooth surface or between the palms into a thread about one-eighth inch in diameter. The thread is then folded and rerolled repeatedly. During this manipulation the moisture content is gradually reduced and the specimen stiffens, finally loses its plasticity, and crumbles, when the plastic limit is reached. After the thread crumbles, the pieces should be lumped together and a slight kneading action continued until the lump crumbles. The tougher the thread near the plastic limit and the stiffer the lump when it finally crumbles, the more potent is the colloidal clay fraction in the soil. Weakness of the thread at the plastic limit and quick loss of coherence of the lump below the plastic limit indicate either inorganic clay of low plasticity, or materials such as kaolin-type clays and organic clays which occur below the A-line. Highly organic clays have a very weak and spongy feel at the plastic limit.

ABBREVIATIONS

a. angle	alt. alternate(y)(ing)	amt. amount	ang. angular	approx. approximate(y)	arg. argillaceous	aren. arenaceous	asp. asphaltic	b. bone	ba. banded(ing)	bd. bed(ded)(ing)	bdr. bedrock	bf. buff	bk. black	bky. blocky	bkn. broken	bl. blue	bot. bottom	bou. boulder(s)	bre. breccia(ted)	br. brown(ish)	c. calcareous	carb. carbonaceous	cav. cavern, cavity	cbl. cobble(y)	ch. chert	cl. clay(ey)	clb. claybands	cln. clean	coa. coat(ed)(ing)	comp. compact(ed)	con. contains	conc. concretion	cong. conglomerate(ic)	cont. continuous	crm. crumbly	cr. crystal(ine)	cem. cement(ed)	dc. decayed	di. dirty	dia. diameter	diag. diagonal	dis. disintegrated	dis. discontinuous	dis. disseminated	dk. dark	dn. dense	dmp. damp	ext. extremely	elem. elements	f. fine	fer. ferruginous	fi. fissile	fil. fill(ed)(ing)	fm. firm	fos. fossil(iferous)	frac. fracture(d)	frags. fragment(s)(al)	fr. friable	FP fixed-piston	FW free water	g. grain(ed)	gen. generally	gn. green(ish)	gr. gray	gra. gravelly	grad. grading(ed)	GW groundwater	h. hard	ha. high angle	hl. high(er)(ly)	hor. horizontal(ly)	i. initial contact	inc. included, inclusions	inc. increasing(ly)	inc. cobble(y)	inor. intercalated	inla. intercalated	int. intercalations	intbd. interbedded	irr. irregular	jt. joint(ed)	l. low	li. little	la. low angle	las. laminate(ed)(ions)	lay. layer(s)	le. lean	lea. leached	lense(s) lens(e)s	lg. large	li. liquid limit	los. loose	lt. light	m. medium	ma. many	mas. massively	mat. material	mic. micaceous	min. mineralized	mod. moderate(ly)	mos. mostly	mot. moist	mtx. matrix	n. near	nod. nodule(s)	num. numerous	o. open	od. odor	occ. occasional(ly)	occu. occurring	org. organic	pa. parting(s)	part. particle(s)	% percent(age)	pie. piece	pl. plastic	PL plastic limit	peb. pebble(s)	pk. pink	pkt. pocket(s)	pl. plan(e)s	pn. porous	part(ly) part(ly)	pyr. pyrite(ic)	q. quartz(itic)	r. red(dish)	ro. rock(s)	rot. rotted(en)	rou. rounded	root(s)(et) root(s)(et)	s. soft	SS split spoon	sa. sandy	sat. saturated	scat. scattered	seams seams	sevr. several(y)	sh. shaly	shs. shaly	sil. siliceous	silt. silty	sik. slickensided	sm. small	so. some	sol. solution	sta. stain(ed)	stiff stiff	stks. streak(s)	str. stringer(s)	sty. sty. (ilite)	t. thin	tho. throughout	tk. thick	tr. trace	v. variably	va. variegated	ve. very	veg. vegetation	ver. vertical(ly)	vug. vuggy	w. water	w/ with	w/o without	WC water content	wd. weathered	WH weight of hammer	wh. white	WL water level	wo. wood	x-bd. cross-bedded(ing)	y. yellow(ish)	z. zone
----------	------------------------	-------------	--------------	------------------------	-------------------	------------------	----------------	---------	-----------------	-------------------	--------------	----------	-----------	-------------	-------------	----------	-------------	-----------------	-------------------	----------------	---------------	--------------------	---------------------	----------------	-----------	--------------	----------------	------------	--------------------	-------------------	---------------	------------------	------------------------	------------------	--------------	------------------	-----------------	-------------	-----------	---------------	----------------	--------------------	--------------------	-------------------	----------	-----------	-----------	----------------	----------------	---------	------------------	-------------	--------------------	----------	----------------------	-------------------	------------------------	-------------	-----------------	---------------	--------------	----------------	----------------	----------	---------------	-------------------	----------------	---------	----------------	------------------	---------------------	--------------------	---------------------------	---------------------	----------------	--------------------	--------------------	---------------------	--------------------	----------------	---------------	--------	------------	---------------	-------------------------	---------------	----------	--------------	-------------------	-----------	------------------	------------	-----------	-----------	----------	----------------	---------------	----------------	------------------	-------------------	-------------	------------	-------------	---------	----------------	---------------	---------	----------	---------------------	-----------------	--------------	----------------	-------------------	----------------	------------	-------------	------------------	----------------	----------	----------------	--------------	------------	-------------------	-----------------	-----------------	--------------	-------------	-----------------	--------------	-------------------------	---------	----------------	-----------	----------------	-----------------	-------------	------------------	-----------	------------	----------------	-------------	-------------------	-----------	----------	---------------	----------------	-------------	-----------------	------------------	-------------------	---------	-----------------	-----------	-----------	-------------	----------------	----------	-----------------	-------------------	------------	----------	---------	-------------	------------------	---------------	---------------------	-----------	----------------	----------	-------------------------	----------------	---------

NUMBER AND TYPE OF EXPLORATIONS

CODE	YEAR	HOLE NO.	DESIGNATION
C	- 91 -	39	● Core hole in bedrock
D	- 91 -	39	● Disturbed sample boring
CD	- 91 -	39	○ Disturbed sample boring (Percussion Drill/Cable Tool Drill)
UD	- 91 -	39	● Undisturbed sample boring
A	- 91 -	39	○ Auger hole hand or power auger, 2" to 24" diameter
			◆ Core hole in bedrock, hydraulic pressure tested
			◆ Indicates angle boring shows direction
			○ Boring with Piezometer
			⊕ Boring with Inclinator
TP	- 91 -	42	■ Test Pit in overburden
TT	- 91 -	7 - 135	⊔ Test Trench in overburden (TT-91-7), soils classified at stationing as shown (135 feet)
UD	- 91 -	39	● Undisturbed sample boring with Piezometer

Symbol	Revisions	Descriptions	Date	Approved

U.S. ARMY ENGINEER DISTRICT
CORPS OF ENGINEERS
HUNTINGTON, WEST VIRGINIA

Designed by: GAH
 Drawn by: GAH
 Checked by: JER
 Reviewed by: DLB
 Approved by: _____

Scale: AS SHOWN
 Date: FEB 1998
 Drawing Code: 016-PWC-10

Sheet reference number: 103
 FILENAME: PSLEGEND.DGN
 PEN TABLE: BW.PTB
 Sheet 1 of 1

PROJECT WEST COLUMBUS, OHIO LPP
HOLE NO. D-90-5

DATE STARTED 14 May 1990
COMPLETED 11 May 1990

ELEVATION (FEET) MSL	SYMBOL	R.S.#	DESCRIPTION OF MATERIALS	REMARKS OR TEST RESULTS					
				WC	LL	PL	FL	4+5	200 BLOWS
715.0	GM		SILTY SANDY GRAVEL (GM), gr., f.g.-c.g.	10.8					
713.0	GM		GRAVELLY SAND (SP-SM), lt. br., non-pl., dmp., f.g.-c.g.	13.4					
711.0	SM		SANDY CLAYEY GRAVEL (GC), br.-bk., low pl., dmp., f.g.-c.g., w/coal	21.8		37	46	17	7-32
709.2	SC		SANDY CLAYEY SAND (SM), br., non-pl., dmp., f.g.-c.g.	21.1					
706.0	CH		GRAVELLY CLAYEY SAND (SC), br., low pl., dmp., f.g.-c.g.	25.2			21	79	4-8
705.0	CL		SANDY CLAY (CH), dk. br., hi. pl., dmp., f.g.-c.g.						
703.5	SM		SANDY CLAY (CH), dk. br., hi. pl., dmp., f.g.-c.g.	F.W.					
702.0	GC		SANDY CLAY (CH), dk. br., hi. pl., dmp., f.g.-c.g.	F.W.		56	33	11	27
700.5	GC		SANDY CLAY (CH), dk. br., hi. pl., dmp., f.g.-c.g.	F.W.					
699.0	GM		SANDY GRAVEL (GP-GC), br., v. low pl., f.g.-c.g.	F.W.					
694.5	SP		SANDY GRAVEL (GP-GM), br., f.g.-c.g.	F.W.					
694.5	GM		GRAVELLY SAND (SP), br., f.g.-c.g., SAND (SP), 17.5'-19.0'	F.W.		42	41	17	22
691.5	GM		SANDY GRAVEL (GP-GM), br., f.g.-c.g.	F.W.					
690.0	GM		SANDY GRAVEL (GP-GM), br., f.g.-c.g.	F.W.					
688.5	SP		GRAVELLY SAND (SP), br., f.g.-c.g.	F.W.					
687.0	CL		GRAVELLY SANDY SILTY CLAY (CL-M), v. low pl., f.g.-c.g.	F.W.		18.5	11		
685.5	SM		SANDY CLAYEY SAND (SM), br., f.g.-c.g.	F.W.					
684.0	SC		GRAVELLY SANDY SILTY SAND (SM-SC), v. low pl., f.g.-c.g.	F.W.		18	12		
682.5	SC		SANDY CLAYEY GRAVEL (GC), gr., low pl., f.g.-c.g.	F.W.					
681.0	GC		GRAVELLY SANDY SILTY SAND (SM-SC), v. low pl., f.g.-c.g.	F.W.		9	46	45	14-28
678.0	SC		GRAVELLY CLAYEY SAND (SC), br.-gr., hi. pl., mst., f.g.-c.g.	F.W.		82	26		10-19
672.0	GC		low pl., 37.0' to 43.0'			10	41	49	8-12
670.5	GC		SANDY CLAYEY GRAVEL (GC), gr., low pl., mst., f.g.						4
669.0	SC		GRAVELLY CLAYEY SAND (SC), low pl., mst., f.g.						9-12

* ROCK STRUCTURAL ELEMENTS (OPTIONAL) SHEET 1 OF 1 SHEETS

PROJECT WEST COLUMBUS, OHIO LPP
HOLE NO. D-90-6

DATE STARTED 14 May 1990
COMPLETED 15 May 1990

ELEVATION (FEET) MSL	SYMBOL	R.S.#	DESCRIPTION OF MATERIALS	REMARKS OR TEST RESULTS					
				WC	LL	PL	FL	4+5	200 BLOWS
711.3	CL		GRAVELLY SANDY CLAY (CL), br., m. pl., dmp., f.g.-c.g.	16.3					3-6
706.8	CH		SANDY CLAY (CH), dk. br., m. pl., dmp.	23.9	54	29			4
705.3	CL		CLAY (CL), dk. br., m. pl., dmp.	22.3					9
703.8	CL		SANDY CLAY (CL), br., m. hi. pl., dmp.	21.3					6
702.3	SC		CLAYEY SAND (SC), br., low pl., mst.	20.2					2
701.4	CL		SANDY CLAY (CL), br., low pl., dmp.	19.8					2
699.3	CL		NO SAMPLE						
696.3	GC		CLAYEY SANDY GRAVEL (GC), lt. br., v. low pl., dmp., f.g.-c.g.	12.2					13-17
694.8	GC		GRAVELLY SAND (SP), br., non-pl., f.g.-c.g.	F.W.					7-18
693.3	SP		GRAVELLY SAND (SP-SM), r.-br., non-pl., f.g.-c.g.	F.W.		55	38	7	31-49
690.3	SC		CLAYEY SANDY GRAVEL (GC), br., v. low pl., low pl., wet, f.g.	F.W.					32-40
689.4	OC		CLAYEY SANDY GRAVEL (GC), br., low pl., wet, f.g.-c.g.	F.W.		1	32	67	33
688.1	NS		SANDY SILT (ML), br. & gr., non-pl., f.g.-c.g.	F.W.					13
686.8	SP		GRAVELLY SAND (SP-SM), br., non-pl., f.g.-c.g.	F.W.					27
683.4	SC		GRAVELLY SAND (SP), br., non-pl., f.g.-c.g.	F.W.					28-30
682.8	NS		NO SAMPLE						30
679.8	SC		CLAYEY SAND (SC), br.-gr., low pl., f.g.-c.g.	F.W.		21	13	10	41
678.4	CL		GRAVELLY SANDY CLAY (CL), br.-gr., low pl., mst., f.g.-c.g.	F.W.					30-32
676.8	NS		NO SAMPLE						30-32
675.3	CL		SANDY CLAY (CL), br. & gr., low pl., mst., f.g.-c.g.	F.W.					41-50
673.8	CL		GRAVELLY SANDY CLAY (CL), br. & gr., mst., low pl., f.g.	F.W.		20	12		47-50
670.8	GC		GRAVELLY SANDY CLAY (CL), br. & gr., low pl., mst., f.g.-c.g.	F.W.					50-50
669.3	GC		SANDY CLAYEY GRAVEL (GC), gr., low pl., mst., f.g.	F.W.		3	44	53	30-36
664.8	CL		SANDY CLAY (CL), gr. & br., low pl., mst., f.g.-c.g.	F.W.					37-46
664.5	CL		GRAVELLY SANDY CLAY (CL), gr. & br., low pl., mst., f.g.-c.g.	F.W.					30-39
663.5	CL		SHALE, gr., hi. wd.	F.W.					48-50

* ROCK STRUCTURAL ELEMENTS (OPTIONAL) SHEET 1 OF 1 SHEETS

PROJECT WEST COLUMBUS, OHIO LPP
HOLE NO. D-83-8

DATE STARTED 21 Oct. 1983

ELEVATION (FEET) MSL	SYMBOL	R.S.#	DESCRIPTION OF MATERIALS	REMARKS OR TEST RESULTS					
				WC	LL	PL	FL	4+5	200 BLOWS
728.3	CL		SANDY CLAY (CL), gr.-br., c.-f.g. SAND, pl. dmp., f.g.-c.g.	21.9					7-14
725.3	GC		SANDY CLAYEY GRAVEL (GC), br.-bk., c.-f.g. GRAVEL, vs. low pl. dmp.	10.5					21-60
721.8	CL		SANDY CLAY (CL), br.-bk., c.-f.g. SAND, low-m. pl., dry-dmp., w/brick frags.	18.7					12-17
719.8	CL		NO SAMPLE						12-11
711.8	CL		NO SAMPLE						8
711.3	NS		NO SAMPLE						6-6
710.8	NS		NO SAMPLE						5-8
707.8	CL		GRAVELLY SANDY CLAY (CL), br., c.-f.g. SAND, m. pl., dmp., w/brick frags.	18.9					6-6
704.8	CL		CLAY (CL), bk., c.-f.g. SAND, m. pl., dmp.	26.9					10-15
703.3	SC		SANDY CLAY (CL), br., m.-f.g. SAND, m. pl., wet	23.4					12
700.3	SC		CLAY SAND (SC), br., c.-f.g. SAND, low pl., wet	26.5		0	57	43	1-2
697.3	SC		GRAVELLY CLAYEY SAND (SC), br., c.-f.g. SAND, ve. low pl., wet	20.3		1	64	21	3-5

* ROCK STRUCTURAL ELEMENTS (OPTIONAL) SHEET 1 OF 1 SHEETS

PROJECT WEST COLUMBUS, OHIO LPP
HOLE NO. D-83-9

DATE STARTED 25 Oct. 1983

ELEVATION (FEET) MSL	SYMBOL	R.S.#	DESCRIPTION OF MATERIALS	REMARKS OR TEST RESULTS					
				WC	LL	PL	FL	4+5	200 BLOWS
721.8	CL		GRAVELLY SANDY CLAY (CL), bk., c.-f.g. SAND, m. pl., dmp.	18.5					4-5
719.8	CL		GRAVELLY SANDY CLAY (CL), bk., c.-f.g. SAND, m. pl., dmp.	18.5					4
717.8	CL		GRAVELLY SANDY CLAY (CL), bk., c.-f.g. SAND, m. pl., dmp.	18.5					3-3
715.8	CL		GRAVELLY SANDY CLAY (CL), bk., c.-f.g. SAND, m. pl., dmp.	18.5					3-3
713.8	CL		GRAVELLY SANDY CLAY (CL), bk., c.-f.g. SAND, m. pl., dmp.	18.5					2
711.8	CL		GRAVELLY SANDY CLAY (CL), bk., c.-f.g. SAND, m. pl., dmp.	18.5					2
709.8	CL		GRAVELLY SANDY CLAY (CL), bk., c.-f.g. SAND, m. pl., dmp.	18.5					2
707.8	CL		GRAVELLY SANDY CLAY (CL), bk., c.-f.g. SAND, m. pl., dmp.	18.5					2
705.8	CL		GRAVELLY SANDY CLAY (CL), bk., c.-f.g. SAND, m. pl., dmp.	18.5					2
703.8	CL		GRAVELLY SANDY CLAY (CL), bk., c.-f.g. SAND, m. pl., dmp.	18.5					2
701.8	CL		GRAVELLY SANDY CLAY (CL), bk., c.-f.g. SAND, m. pl., dmp.	18.5					2
700.8	CL		GRAVELLY SANDY CLAY (CL), bk., c.-f.g. SAND, m. pl., dmp.	18.5					2
699.3	CH		SANDY GRAVEL (GP-GC), gr.-br., c.-f.g. GRAVEL, hi. pl., mst.	42.4	56	31			5-3
697.3	CH		SANDY CLAY (CL), gr.-br., f.g. SAND, hi. pl., w/brick frags. mst., wet	32.1					5-3
693.5	CL		NO SAMPLE						3
691.8	GC		SANDY CLAYEY GRAVEL (GC), gr.-br., c.-f.g. GRAVEL, m. pl., wet	24.6		67	16	17	16
688.8	GC		SANDY GRAVEL (GP-GC), gr.-br., c.-f.g. GRAVEL, m. pl., wet	19.0					16-19
685.8	GC		SANDY GRAVEL (GP-GC), gr.-br., c.-f.g. GRAVEL, m. pl., wet	23.6		59	36	5	10
682.8	GC		SANDY CLAYEY GRAVEL (GC), gr.-br., c.-f.g. GRAVEL, low pl., wet	16.3					35-1
671.8	CL		SANDY CLAY (CL), br.-gr., c.-f.g. SAND, low-m. pl., wet	10.8					37
669.8	CL		NO SAMPLE						42-57
667.8	CL		NO SAMPLE						34-46
665.8	CL		NO SAMPLE						39
663.8	CL		NO SAMPLE						52-50
661.8	CL		NO SAMPLE						61
659.8	CL		NO SAMPLE						71
657.8	CL		NO SAMPLE						10-1
655.8	CL		NO SAMPLE						11

* ROCK STRUCTURAL ELEMENTS (OPTIONAL) SHEET 1 OF 2 SHEETS

PROJECT WEST COLUMBUS, OHIO LPP
CONTINUATION OF HOLE NO. D-83-9

ELEVATION (FEET) MSL	SYMBOL	R.S.#	DESCRIPTION OF MATERIALS	REMARKS OR TEST RESULTS					
				WC	LL	PL	FL	4+5	200 BLOWS
669.0	CL		SANDY CLAY (CL), br.-gr., f. SAND, low pl., wet	19.6					18-28
667.2	CL		WEATHERED SHALE	23.9					21
665.0	CL		CLAYSTONE: Gray, soft, shaley, thin to shaley bedded. Mod. weathered above 661.8. Severely broken with possible 3.6' lens at 663.7-661.8. High angled fracture with smooth and planar surface at 657.2-666.7, 660.6-660.2, 659.9-659.2. High angled (60°) fracture with smooth and planar surface at 657.6-657.5. Severely broken at 658.8-658.4, 656.1-656.0. High angled (45°) fracture with smooth and planar surface at 657.0-657.5. Thin (0.2") siltstone seam, brown, mod. hard at 656.6-656.4, 655.7-655.5.	19					Began Coring
655.0	CL		BOTTOM OF HOLE						45

* ROCK STRUCTURAL ELEMENTS (OPTIONAL) SHEET 2 OF 2 SHEETS

PROJECT WEST COLUMBUS, OHIO LPP
HOLE NO. D-90-24

DATE STARTED 26 Oct 1990
COMPLETED 26 Oct 1990

ELEVATION (FEET) MSL	SYMBOL	R.S.#	DESCRIPTION OF MATERIALS	REMARKS OR TEST RESULTS					
				WC	LL	PL	FL	4+5	200 BLOWS
722.6	CL		SANDY CLAY (CL), bk-br. m. hi pl. dmp. c.g.-f g SAND, w/brick frags. & rrs.	22.0	42	19			4-5
718.1	CL		SANDY CLAY (CL), br. m. pl. dmp. c.g.-f g SAND, w/SH & LS frags.	21.9					5-3
715.9	SC		SANDY CLAY (CL), br. m. pl. dmp. c.g.-f g SAND, w/SH & LS frags.	22.0	41	18	4	18	7-8
713.9	SC		CLAYEY SAND (SC), br., low pl., dmp. c.g.-f-g SAND, w/cinders & brick frags.	20.4					3-7
713.6	SC		CLAYEY SAND (SC), br., low pl., dmp. c.g.-f-g SAND, w/cinders & brick frags.	20.4					3
713.4	SC		CLAYEY SAND (SC), br., low pl., dmp. c.g.-f-g SAND, w/cinders & brick frags.	17.2					4-5
712.1	SM		GRAVELLY CLAYEY SAND (SC) mot. r.-bk low pl., dmp., c.g.-f-g SAND.	17.9					3
710.6	GM		GRAVELLY CLAYEY SAND (SC), gr.-br., low pl., dmp., c.g.-f-g SAND.	0					9-6
709.1	CH		SANDY CLAY (CH), dk. br., hi. pl., w/st. org. odor.	0					2
707.6	CH		SILTY SAND (SM), br., non pl., dmp., c.g.-f g SAND.	27.2	53	25	2	28	70
706.1	CL		SANDY SILTY GRAVEL (GM), r. bk. & br., non pl., dmp., c.g.-f g GRAVEL, w/brick frags.	27.8	51	22			8-10
703.1	CL		SANDY SANDY GRAVEL (GM), br., non pl., dmp., c.g.-f-g GRAVEL, w/cinders & SH frags.	24.0					3
701.6	CL		SANDY SANDY GRAVEL (GM), br., non pl., dmp., c.g.-f-g GRAVEL, w/cinders & SH frags.	29.5	49	20			7-10
701.6	CL		SANDY SANDY GRAVEL (GM), br., non pl., dmp., c.g.-f-g GRAVEL, w/cinders & SH frags.	29.2	34	19			2-1

* ROCK STRUCTURAL ELEMENTS (OPT) SHEET 1 OF 1

PROJECT WEST COLUMBUS, OHIO LPP
HOLE NO. D-90-25

DATE STARTED 27 Nov 1990
COMPLETED 27 Nov 1990

ELEVATION (FEET) MSL	SYMBOL	R.S.#	DESCRIPTION OF MATERIALS	REMARKS OR TEST RESULTS					
				WC	LL	PL	FL	4+5	200 BLOWS
723.9	SC		GRAVELLY CLAYEY SAND (SC), dk br., m. hi pl., dmp., c.g.-f-g SAND, w/GRAVEL, brick frags & org.	24.3	48	26	18	35	47
720.9	GC		CLAYEY SANDY GRAVEL (GC), br., low pl., dmp., c.g.-f-g GRAVEL, w/brick frags.	9.2					4-3
719.4	SC		SANDY CLAYEY GRAVEL (GC), br., low pl., dmp., c.g.-f-g GRAVEL, w/brick frags.	11.4					3-5
717.9	SC		SANDY CLAYEY GRAVEL (GC), br., low pl., dmp., c.g.-f-g GRAVEL, w/brick frags.	19.0					3
716.4	GC		CLAYEY SAND (SC), br., low pl., dmp., c.g.-f-g SAND	12	45	43	9-6		6
714.9	GC		CLAYEY SAND (SC), br., low pl., dmp., c.g.-f-g SAND	27	41	32	4-3		2-2
713.4	SM		GRAVELLY CLAYEY SAND (SC), r. s.dk br., low pl., dmp., c.g.-f-g SAND	0					1
711.9	GC		SANDY CLAYEY GRAVEL (GC), mot. gr.-bk., low pl., dmp., c.g.-f-g GRAVEL, w/brick frags.	18	43	39	1-2		2
710.4	SC		GRAVELLY SILTY SAND (SM), dk br., non pl., dmp., c.g.-f-g SAND	33.2					1
707.7	GC		SANDY CLAYEY GRAVEL (GC), r.-bk., low pl., dmp., c.g.-f-g GRAVEL, w/brick frags.	28.8					26-20
706.3	CL		GRAVELLY CLAYEY SAND (SC), bk low pl., dmp., c.g.-f-g GRAVEL, w/brick frags.	15.2					8-6
704.4	CH		GRAVELLY CLAYEY SAND (SC), bk low pl., dmp., c.g.-f-g GRAVEL, w/brick frags.	29.3	38	30	0	29	71
702.9	CL		CLAYEY SANDY GRAVEL (GC), bk, w/ occ. wood, brick & SS frags	24.8					2
702.9	CL		SANDY CLAY (CL), br., m. pl., dmp., c.g.-f g SAND	28.2					6-9
702.9	CL		SANDY CLAY (CL), br., m. pl., dmp., c.g.-f g SAND	28.2					5-4

CORE SIZE		PROJECT WEST COLUMBUS, OHIO LPP		SAMPLER 2" S.S.						
BATTER		DIRECTION VERTICAL		DROP 30"						
HOLE NO. UD-92-80		HOLE NO. D-92-81		HOLE NO. D-89-82						
DATE STARTED 12 March 1992		DATE STARTED 18 Feb 1992		DATE STARTED 4 Dec 1989						
COMPLETED 12 March 1992		COMPLETED 18 Feb 1992		COMPLETED 8 Dec 1989						
COORDINATES: N 712,713.1 E 1,857,235.4		COORDINATES: N 712,717.6 E 1,857,027.7		COORDINATES: N 712,717.6 E 1,857,543.5						
ELEVATION (FEET)	SYMBOL	R.S.E.	DESCRIPTION OF MATERIALS	REMARKS OR TEST RESULTS						
723.0	NS		NO SAMPLE	WC	LL	PL	I+4	SAND	Z-200	BLOWS
705.0	NS		NO SAMPLE							
704.5	SC		CLAYEY GRAVELLY SAND (SC), dk.br.-bk., low pl., f.g.-c.g., soft-loose							
703.5	CL		GRAVELLY SANDY CLAY (CL), br., m.pl., f.g.-c.g., m.	24.4	41	17	0	32	68	
702.5	NS		NO SAMPLE	22.9	36	15	0	41	51	
700.0	NS		NO SAMPLE							
697.8	CL		SANDY CLAY (CL), br., m.h.pl., f.g.-c.g., soft-m.	28.5	36	18	0	45	55	
BOTTOM OF HOLE										

CORE SIZE		PROJECT WEST COLUMBUS, OHIO LPP		SAMPLER 2" S.S.						
BATTER		DIRECTION VERTICAL		DROP 30"						
HOLE NO. D-92-84		HOLE NO. D-92-85		HOLE NO. UD-92-85						
DATE STARTED 23 March 1992		DATE STARTED 16 March 1992		DATE STARTED 17 March 1992						
COMPLETED 23 March 1992		COMPLETED 17 March 1992		COMPLETED 18 March 1992						
COORDINATES: N 712,270.9 E 1,856,623.1		COORDINATES: N 712,232.9 E 1,856,590.8		COORDINATES: N 712,233.9 E 1,856,593.2						
ELEVATION (FEET)	SYMBOL	R.S.E.	DESCRIPTION OF MATERIALS	REMARKS OR TEST RESULTS						
712.6	CL		SANDY CLAY (CL), br., low pl.-m.pl., dmp., f.g.-c.g., w/brick frags	21.7						
709.6	CL		GRAVELLY CLAYEY SAND (SC), br., low pl., dmp., f.g.-c.g., w/brick frags	16.2						
706.6	SC		GRAVELLY CLAYEY SAND (SC), br., m.pl., f.g.-c.g.	18.4						
705.1	CL		SANDY CLAY (CL), br., m.pl., dmp., f.g.-c.g.	16.6	22	32	46	3-4		
703.6	GP		GRAVEL (GP), gr.-r., non pl., dmp., f.g.-c.g., w/brick frags	13.6						
702.1	GC		SANDY CLAYEY GRAVEL (GC), br.-gr., m.pl., dmp., f.g.-c.g.	15.1						
			SANDY CLAY (CL), dk.br., low pl.-m.pl., ve. dmp., f.g.-c.g.	15.3						
			SANDY CLAY (CL), dk.br., low pl.-m.pl., ve. dmp., f.g.-c.g.	20.8						
			SANDY CLAY (CL), dk.br., low pl.-m.pl., ve. dmp., f.g.-c.g.	27.8	35	18				
			SANDY CLAY (CH), gr., hi.pl., ve. dmp., f.g.-c.g.	29.3						
			SANDY CLAY (CH), gr., hi.pl., ve. dmp., f.g.-c.g.	28.1						
			SANDY CLAY (CL), br., m.pl., ve. dmp., f.g.-c.g.	36.2	52	17				
			SANDY CLAY (CL), br., m.pl., ve. dmp., f.g.-c.g.	43.5						
			SILT SAND (SM), dk gr., non pl., wet, f.g.-c.g.	32.6						
			SANDY CLAYEY GRAVEL (GC), gr.-br., low pl., wet, f.g.-c.g.		18	63	19	2-11		
			GRAVELLY SILTY SAND (SM), br., non pl., wet, f.g.-c.g.							
			SILT SAND (SM), dk gr., non pl., wet, f.g.-c.g.							
			GRAVELLY SAND (SP-SM), br., low pl., wet, f.g.-c.g.							
			SANDY GRAVEL (GP-GM), br., non pl., wet, f.g.-c.g.							
BOTTOM OF HOLE										

Revisions

Symbol	Descriptions	Date	Approved

U.S. ARMY ENGINEER DISTRICT
CORPS OF ENGINEERS
HUNTINGTON, WEST VIRGINIA

Designed by: G. HENSLEY
Drawn by: L. MERS
Checked by: L. RIGGS

SCIO TO RIVER
COLUMBUS, OHIO
WEST COLUMBUS, L.P.P.
PHASE ID

**GRAPHIC LOGS
OF BORINGS**

Reviewed by: AS SHOWN
Date: MAR 1997
Drawing Code: O16-PWC-10

Sheet reference number: 107

FILENAME: LOGS.DGN
PEN TABLE

Sheet of

CORE SIZE		PROJECT WEST COLUMBUS, OHIO LPP		SAMPLER 2" S.S.		
BATTER DIRECTION VERTICAL		HOLE NO. D-92-86		DROP 30"		
DATE STARTED 19 March 1992		COMPLETED 12 March 1992		COORDINATES: N 712,465.1 E 1,856,561.7		
ELEVATION (FEET) MSL	SYMBOL	R.S.E.*	DESCRIPTION OF MATERIALS	REMARKS OF TEST RESULTS		
708.7	NS		NO SAMPLE	WC	LL	PL
707.2	CL		SANDY CLAY (CL), dk-br., m.pl., dmp., f.g.-c.g., w/brick frags	15.7		2-3
705.7	CL		SANDY CLAY (CL), dk-br., m.pl., dmp., f.g.-c.g., w/brick frags	25.6		3-4
702.7	CL		CLAY (CL), dk.br., m.pl., dmp., f.g.-c.g.	25.2	58	25
701.2	CL		SANDY CLAY (CL), dk.br., m.pl., dmp., f.g.-c.g.	24.1	0	11 89
699.2	CH		SANDY CLAY (CH), dk.br., hi.pl., dmp., f.g.-c.g.	23.7		3-5
696.7	CL		SANDY CLAY (CL), dk.br.-gr., m.pl.-m hi pl., mat., f.g.-c.g.	31.8	0	13 87
693.7	CL		SANDY CLAY (CL), dk.br.-gr., m.pl.-m hi pl., mat., f.g.-c.g.	32.5		2-3
692.2	CH		SANDY SILT (SH), bk., hi.pl., mat., f.g.-c.g., w/wood frags	52.3	57	36
690.7	CL		SANDY CLAY (CL), gr.-dk., m.pl., wet, f.g.-c.g.	14.8	W.L.	2-19-92
689.2	GM		SILTY SANDY GRAVEL (GM), br., non pl., wet, f.g.-c.g.	63	30	7
687.7	SM		SANDY GRAVEL (GP-GM), br., non pl., wet, f.g.-c.g.	9		9-12
686.2	GP		SAND (SP-SM), br., non pl., wet, f.g.-c.g.	9		9-11
684.7	GM		SANDY GRAVEL (GP-GM), br., non pl., wet, f.g.-c.g.	10		11
683.2	SM		SANDY GRAVEL (GP-GM), br., non pl., wet, f.g.-c.g.	8		8-8
681.7	GM		SANDY GRAVEL (GP-GM), br., non pl., wet, f.g.-c.g.	46	28	6
678.7	SM		GRAVELLY SAND (SP-SM), br., non pl., wet, f.g.-c.g.	3		3-10
			GRAVELLY SAND (GP-GM), br., non pl., wet, f.g.-c.g.	6		6-7
			GRAVELLY SAND (SP-SM), br., non pl., wet, f.g.-c.g.	10		10-12
			GRAVELLY SAND (GP-GM), br., non pl., wet, f.g.-c.g.	8		8-10
			GRAVELLY SAND (SP-SM), br., non pl., wet, f.g.-c.g.	6		6-7
			BOTTOM OF HOLE			

CORE SIZE		PROJECT WEST COLUMBUS, OHIO LPP		SAMPLER 2" S.S.		
BATTER DIRECTION VERTICAL		HOLE NO. D-92-91		DROP 30"		
DATE STARTED 2 Mar. 1992		COMPLETED 3 Mar. 1992		COORDINATES: N 711,586.2 E 1,855,401.7		
ELEVATION (FEET) MSL	SYMBOL	R.S.E.*	DESCRIPTION OF MATERIALS	REMARKS OF TEST RESULTS		
710.4	ML		SANDY SILT (ML), br., non pl., mat., s.g.-f g SAND	15.3		7-12
708.9	CL		SANDY CLAY (CL), dk br., m.hi.pl., mat., c.g.-f.g., SAND, w/r brick & ro. frags	20.3	43	22.8
705.9	CC		SANDY CLAYEY GRAVEL (CC), br., m hi pl., c.g.-f.g., GRAVEL, w/r brick & ro frags, mat	20.7	6	33 61
704.4	CC		SANDY CLAYEY GRAVEL (CC), br., m hi pl., c.g.-f.g., GRAVEL, w/r brick & ro frags, mat	19.3	62	52.2
699.9	SC		CLAYEY GRAVELLY SAND (SC), br., ve low pl., mat., c.g.-f.g., SAND, w/ro. frags	7.8		2
699.9	SC		CLAYEY GRAVELLY SAND (SC), br., ve low pl., mat., c.g.-f.g., SAND, w/ro. frags	15.9		38-50
699.9	SC		CLAYEY GRAVELLY SAND (SC), br., ve low pl., mat., c.g.-f.g., SAND, w/ro. frags	5.2		22-13
693.9	SP		SAND (SP-SM), br., non pl., mat., c.g.-f.g., SAND	5.8	7	83 10
693.9	SP		SAND (SP-SM), br., non pl., mat., c.g.-f.g., SAND	7.1		3-1
693.9	SP		SAND (SP-SM), br., non pl., mat., c.g.-f.g., SAND	8.6		2-4
693.9	SP		SAND (SP-SM), br., non pl., mat., c.g.-f.g., SAND	8.1		16-20
690.9	SP		GRAVELLY SAND (SP-SM), br., non pl., c.g.-f.g. SAND, mat	16.7		47-41
687.9	SP		GRAVELLY SAND (SP-SM), br., non pl., wet, c.g.-f.g., SAND, w/ro frags	11.9	W.L.	3-3-92
687.9	SP		GRAVELLY SAND (SP-SM), br., non pl., wet, c.g.-f.g., SAND, w/ro frags	3		38-50
687.9	SP		GRAVELLY SAND (SP-SM), br., non pl., wet, c.g.-f.g., SAND, w/ro frags	10		18-40
687.9	SP		GRAVELLY SAND (SP-SM), br., non pl., wet, c.g.-f.g., SAND, w/ro frags	10		21-50
683.4	GM		SANDY SILTY GRAVEL (GM), br., non pl., wet, f.g.-c.g.	6		6-8
681.9	GM		SANDY SILTY GRAVEL (GM), br., non pl., wet, f.g.-c.g.	16		35-28
680.4	GM		CLAYEY SILT, dk.gr., s.l. pl., mat.	3		30-29
			BOTTOM OF HOLE			

Revisions

Symbol	Descriptions	Date	Approved

U.S. ARMY ENGINEER DISTRICT
CORPS OF ENGINEERS
HUNTINGTON, WEST VIRGINIA

Designed by: G. HENSLEY
Drawn by: L. MERS
Checked by: L. RIGGS
Reviewed by: AS SHOWN
Approved by: MAR 1997

Scale: AS SHOWN
Date: MAR 1997
Drawing Code: O16-PWC-10

Sheet reference number: 108
FILENAME: PEN TABLE
LOGS DGN

PROJECT WEST COLUMBUS, OHIO LPP
HOLE NO. D-93-136

ELEVATION (FEET)	SYMBOL	R.S.E.#	DESCRIPTION OF MATERIALS	REMARKS OR TEST RESULTS
709.3	CL		CLAYEY SILT (CL-ML), dk. br., low pl., w/fg. SAND & rgs.	WC LL PL #4 SAND#200 BLOWS
707.8	CL		GRAVELLY CLAYEY SAND (SC), dk. br., low pl., dmp., f.g.-c.g.	21 49 30 7-7
705.2	SC		CLAYEY SAND (SC), dk. br., low pl., dmp., f.g.-c.g.	2-2
703.7	SP		SAND (SP), br., non pl., dmp., f.g.-c.g.	3-3
701.8	SM		SAND (SM-SM), br., non pl., dmp., f.g.-c.g.	1 92 7 1-1
700.3	SM		SILT SAND (SM), br., non pl., dmp., f.g.-c.g. w/CLAY lumps	2-2
698.8	NS		NO SAMPLE	4-5
697.3	GP		GRAVEL (GP), br., non pl., dmp., f.g.-c.g.	5-4
695.8	GP		SANDY GRAVEL (GP), br., non pl., dmp., f.g.-c.g.	10-7
694.3	SC		GRAVELLY SAND (SC), lt. r. br., low pl., mst., f.g.-c.g.	10-1
689.8	GP		SANDY GRAVEL (GP), br., non pl., mst., wet, f.g.-c.g.	16-2
688.3	SM		SILT SAND (SM), br., non pl., mst.-wet, f.g.-c.g.	12-5
686.8	GP		GRAVEL (GP), br., non pl., f.g.-c.g.	14-4
685.3	GM		SILT SANDY GRAVEL (GM), dk. y. br., non pl., wet, f.g.-c.g.	14-4
683.8	SM		SILT SAND (SM), dk. y. br., non pl., f.g.-c.g.	11-1
682.3	CL		SANDY CLAYEY SILT (CL-ML), dk. y. br., ve. low pl., mst., f.g.-c.g.	2-2
680.8	ML		CLAYEY SILT (CL-ML), dk. gr., ve. low pl., mst.	13 30 57 10-1
679.3			SANDY SILTY CLAY (CL-M), gr., ve. low pl., mst., f.g.-c.g.	14-1

BOTTOM OF HOLE

PROJECT WEST COLUMBUS, OHIO LPP
HOLE NO. D-93-137

ELEVATION (FEET)	SYMBOL	R.S.E.#	DESCRIPTION OF MATERIALS	REMARKS OR TEST RESULTS
708.1	CL		CLAYEY SILT (CL-ML), dk. br., low pl., dmp., w/fg.	WC LL PL #4 SAND#200 BLOWS
706.6	CL		SANDY CLAYEY SILT (CL-ML), dk. br., ve. low pl., dmp., f.g.-c.g. w/COAL	16-7
703.6	SM		SILT SAND (SM), br., non pl., dmp., f.g.-c.g.	4-1
701.9	SC		CLAYEY SAND (SC), ve. dk. br., low pl., mst., f.g.-c.g. w/COAL & wood	25-5
700.6	PT		PEAT, bk	40-2
697.6	CL		CLAY (CL), dk. br. - dk gr br., low pl., mst., w/fg. SAND	19-0
696.1	OC		CLAYEY GRAVEL (GC), br., low pl., mst., f.g.-c.g.	27-0
694.6	NS		NO SAMPLE	14
693.1	GM		SILT SANDY GRAVEL (GM), br., non pl., mst., f.g.-c.g.	10-8
690.1	GP		SANDY GRAVEL (GP), br., non pl., wet, f.g.-c.g.	9-1
688.6	GP		SANDY GRAVEL (GP), br., non pl., wet, f.g.-c.g.	11-8
687.1	GM		SANDY GRAVEL (GP-GM), dk. y. br., non pl., mst., f.g.-c.g. w/COAL	3-5
685.6	GC		SANDY CLAYEY GRAVEL (GC), gr., low pl., mst., f.g.-c.g.	8-2
681.1	CL		CLAYEY SILT (CL-ML), gr., ve. low pl., mst.	14-2
679.6	NS		NO SAMPLE	15
678.1	NS		NO SAMPLE	12-10
676.6	SC		CLAYEY SILTY SAND (SC-SM), gr., ve. low pl., dmp., f.g.-c.g.	15 20 65 16-2
669.1	SM		GRAVELLY SAND (SM-SM), gr., ve. low pl., dmp., f.g.-c.g.	18-2
667.6	SC		GRAVELLY SAND (SC), gr., low pl., dmp., f.g.-c.g.	12
663.1	ML		SILT (ML), gr., non pl., dmp. w/ f.g. SAND	17-22

BOTTOM OF HOLE

PROJECT WEST COLUMBUS, OHIO LPP
HOLE NO. D-93-138

ELEVATION (FEET)	SYMBOL	R.S.E.#	DESCRIPTION OF MATERIALS	REMARKS OR TEST RESULTS
724.8	GM		SILT SANDY GRAVEL (GM), gr.-gr. br., non pl., dry, f.g.-c.g.	WC LL PL #4 SAND#200 BLOWS
721.8	GM		CLAYEY GRAVELLY SAND (SC), r. br., low pl., dry, f.g.-c.g.	6-5
720.3	SC		GRAVELLY CLAYEY SAND (SC), br., m. pl., dry, f.g.-c.g.	11-1
715.8	GP		CLAYEY SANDY GRAVEL (GP-GC), br. gr., ve. low pl., dmp., f.g.-c.g.	15-4
714.3	GP		CLAYEY GRAVELLY SAND (SC), gr. br., low pl., dry, f.g.-c.g.	14-6
711.3	SC		CLAYEY SANDY GRAVEL (GC), br., low pl., dmp., f.g.-c.g.	12-7
708.3	GC		SANDY GRAVEL (GP-GM), br., non pl., dmp., f.g.-c.g.	19-5
706.8	GM		SANDY SILTY CLAY (CL-ML), dk. gr. bk., ve. low pl., dmp., f.g.-c.g.	11-5
705.3	SM		GRAVELLY SILTY SAND (SM-SC), dk. gr. bk., ve. low pl., dmp., f.g.-c.g. w/COAL	22-6
702.3	SC		GRAVELLY SILTY SAND (SM-SC), dk. gr. bk., ve. low pl., dmp., f.g.-c.g. w/COAL	14-8
700.8	SM		GRAVELLY SILTY SAND (SM), bk., non pl., dmp., f.g.-c.g.	9-5
699.3	SC		GRAVELLY SAND (SC), dk. gr. bk., ve. low pl., dmp., f.g.-c.g.	7-4
698.8	GP		SANDY GRAVEL (GP), br., non pl., dry, f.g.-c.g.	36-3
693.3	GM		SANDY GRAVEL (GP-GM), br., non pl., f.g.-c.g.	11 24 65 6-6
690.3	GM		SANDY GRAVEL (GP-GM), br., non pl., f.g.-c.g.	6-6
688.8	SP		GRAVELLY SAND (SP), br., non pl., f.g.-c.g.	3-3
684.3	GM		SANDY GRAVEL (GP-GM), br., non pl., f.g.-c.g.	10-8
682.8	GM		SANDY GRAVEL (GP-GM), br., non pl., f.g.-c.g.	10-8
681.3	GM		SANDY GRAVEL (GP-GM), br., non pl., f.g.-c.g.	10-8
675.5	SP		GRAVELLY SAND (SP), br., non pl., f.g.-c.g.	10-8
674.8	SP		GRAVELLY SAND (SP), br., non pl., f.g.-c.g.	10-8

CONTINUATION OF HOLE NO. D-93-138

ELEVATION (FEET)	SYMBOL	R.S.E.#	DESCRIPTION OF MATERIALS	REMARKS OR TEST RESULTS
674.8	SP		GRAVELLY SAND (SP), br., non pl., f.g.-c.g.	150
673.8	GP		SANDY GRAVEL (GP), br., non pl., f.g.-c.g.	45-6
672.3	SC		GRAVELLY CLAYEY SAND (SC), gr., dmp., low pl., dmp., f.g.-c.g.	12
669.3	SM		GRAVELLY SILTY SAND (SM), gr., non pl., dmp., f.g.-c.g.	19 32 49 23-15
667.8	SM		GRAVELLY SILTY SAND (SM), gr., non pl., dmp., f.g.-c.g.	42
666.3	ML		SANDY SILT (ML), br., non pl., dmp., f.g.-c.g.	53-1
664.8	SM		SILT SAND (SM), br., non pl., mst., f.g.-c.g.	22
663.3	GM		SILT SANDY GRAVEL (GP-GM), br., non pl., f.g.-c.g.	21
661.8	GM		SANDY GRAVEL (GP-GM), br., non pl., f.g.-c.g.	44-7
658.8	GP		SANDY GRAVEL (GP), br., non pl., f.g.-c.g.	51 37 12 57-6
657.3	SM		SILT SAND (SM), dk. gr., non pl., mst., f.g.-c.g.	36
655.8	SM		GRAVELLY SILTY SAND (SM), dk. gr. br., non pl., mst., f.g.-c.g.	72-2
654.3	SM		GRAVELLY SILTY SAND (SM), dk. gr. br., non pl., mst., f.g.-c.g.	51-70
652.8	SM		GRAVELLY SILTY SAND (SM), dk. gr. br., non pl., mst., f.g.-c.g.	52
651.3	CL		SHALE, gr., ht. wd.	13
647.3	SLS		CLAY: gray, very soft, calcareous, numerous small rock fragments, 0.3 loss. 532.9-551.9	150
646.8	CL		CLAYSTONE: gray, soft, shaly, slightly to med. broken, occasionally pyritic. Clay coated bedding planes below 651.2.	60
643.3	SLS		SILTSTONE: brownish gray, mod. hard, calcareous, numerous dark gray stringers throughout, occasionally pyritic. Thin (0.02") black chert beds at 647.3.	100
642.8	LS		LIMESTONE: Gray to brownish gray, mod. hard to hard, fine to very fine textured, silty, large black and brown chert nodules throughout.	100
641.3	LS		Numerous interbedded shaly stringers above 644.1.	96
640.8	LS		Numerous, large, black, chert nodules at 643.9-641.0.	96
640.3	LS		Scattered, very thin, calcite filled, low angled fractures and bedding planes at 641.0-640.7.	96
639.8	LS		LIMESTONE: Light gray, hard, fine to medium textured, highly fossiliferous, partly crystalline.	98
638.3	LS		Numerous marine fossil fragments at 635.7-635.0.	98

PROJECT WEST COLUMBUS, OHIO LPP
HOLE NO. D-93-139

ELEVATION (FEET)	SYMBOL	R.S.E.#	DESCRIPTION OF MATERIALS	REMARKS OR TEST RESULTS
723.7	NS		NO SAMPLE	WC LL PL #4 SAND#200 BLOWS
723.4	SM		SILT SANDY GRAVEL (GM), br., non pl., mst., f.g.-c.g.	7-9
721.7	OC		CLAYEY SANDY GRAVEL (GC), dk. br. gr., low pl., dmp., f.g.-c.g.	35 33 32 12-14
717.7	GP		GRAVELLY SAND (SP), br., non pl., dmp., f.g.-c.g.	20-9
716.2	SC		GRAVELLY SAND (SP), br., non pl., dmp., f.g.-c.g.	17-4
714.7	SC		GRAVELLY SAND (SC), br., low pl., mst., f.g.-c.g.	5-2
710.2	GC		SANDY CLAYEY GRAVEL (GC), br., low pl., f.g.-c.g.	13-0
708.7	CL		SANDY CLAY (CL), br., low pl., mst., f.g.-c.g.	24-8
707.2	CL		SANDY CLAY (CL), br., low pl., mst., f.g.-c.g.	17-7
706.9	SM		SILT SAND (SM), dk. gr. br.-r. br., non pl., mst., f.g.-c.g.	30 25 45 2-1
702.7	SM		GRAVELLY SILTY SAND (SM), r. br., non pl., mst., f.g.-c.g.	17-5
701.2	SM		GRAVELLY SILTY SAND (SM), r. br., non pl., mst., f.g.-c.g.	38-5
700.5	CL		GRAVELLY SANDY SILT (OL), dk. gr. bk., ve. low pl., mst., f.g.-c.g. w/COAL	40-4
698.8	GC		SANDY CLAY (CL), br., m. pl., mst., f.g.-c.g.	2-2
696.7	GC		CLAYEY SANDY GRAVEL (GC), br., low pl., mst., f.g.-c.g.	11-3
695.2	SC		SANDY GRAVEL (GP-GC), br., ve. low pl., mst., f.g.-c.g.	10-2
692.2	SP		CLAYEY SANDY GRAVEL (GC), br., low pl., mst., f.g.-c.g.	11-1
690.7	GM		GRAVELLY SILTY SAND (SM), br., non pl., wet, f.g.-c.g.	W.L. 6-16-93
689.2	SM		SANDY GRAVEL (GM-GM), br., non pl., f.g.-c.g.	10-9
687.7	SP		SAND (SP), br., non pl., f.g.-c.g.	65 26 9 6-5
686.2	SP		SAND (SP), br., non pl., f.g.-c.g.	7-5
684.7	GP		GRAVELLY SAND (SP), br., non pl., f.g.-c.g.	6-24
683.2	SP		GRAVELLY SAND (SP), br., non pl., f.g.-c.g.	11
681.7	GP		GRAVELLY SAND (SP), br., non pl., f.g.-c.g.	10
680.2	GP		GRAVELLY SAND (SP), br., non pl., f.g.-c.g.	11-1
678.7	SP		GRAVELLY SAND (SM-SM), br., non pl., f.g.-c.g.	43
677.2	GP		SANDY GRAVEL (GP-GM), br., non pl., f.g.-c.g.	34
675.7	GP		GRAVELLY SAND (SM-SM), br., non pl., f.g.-c.g.	91-16
673.7	SM		GRAVELLY SAND (SM-SM), br., non pl., f.g.-c.g.	100

PROJECT WEST COLUMBUS, OHIO LPP
CONTINUATION OF HOLE NO. D-93-139

ELEVATION (FEET)	SYMBOL	R.S.E.#	DESCRIPTION OF MATERIALS	REMARKS OR TEST RESULTS
673.7	SM		GRAVELLY SAND (SM-SM), br., non pl., f.g.-c.g.	150-180
669.7	GP		SANDY GRAVEL (GP), br., non pl., f.g.-c.g.	35
667.7	SP		GRAVELLY SAND (SP), gr., non pl., f.g.-c.g.	28
666.2	NS		NO SAMPLE	103-106
664.7	SM		SILT SAND (SM), br., gr., non pl., f.g.-c.g.	34-50
662.2	SP		SAND (SP), br., non pl., f.g.-c.g.	38-83
660.7	GP		GRAVELLY SAND (SP), br., non pl., f.g.-c.g.	44
659.2	GP		SANDY GRAVEL (GP), br., non pl., f.g.-c.g.	77-255
657.7	GM		SANDY GRAVEL (GM-GM), br., non pl., f.g.-c.g.	56 37 7 76-38
656.2	GM		SANDY GRAVEL (GM-GM), br., non pl., f.g.-c.g.	39
654.7	GM		SILT SANDY GRAVEL (GM), br., non pl., f.g.-c.g.	94-53
653.2	GM		SILT SANDY GRAVEL (GM), br., non pl., f.g.-c.g.	29
651.7	NS		NO SAMPLE	40-55
650.2	CL		SHALE, gr., wd.	38
648.7	CL		SHALE, gr., wd.	47-54
646.9	SLS		CLAY: Gray, very soft, calcareous, numerous rock fragments, 0.8 loss. 653.7-652.6.	85
645.9	LS		CLAYSTONE: gray, soft, shaly, occasionally pyritic. Clay coated bedding planes with 0.4 loss at 651.7-651.0. Decreases core diameter, mechanical below 651.0.	100
644.9	LS		SILTSTONE: Gray to brownish gray, mod. hard, calcareous, numerous stringers throughout, occasionally pyritic. Thin black pyritic layer at 647.0-646.9.	100
643.9	LS		LIMESTONE: Gray to brownish gray, mod. hard to hard, fine to very fine textured, silty, large black and brown chert nodules throughout.	100
642.9	LS		High angled (60) fracture, calcite filled, terminating on a bedding plane at 643.9-643.7.	100
641.9	LS		Numerous, thin, calcite filled, fractures and bedding planes at 643.9-642.5.	100
640.9	LS		LIMESTONE: Light gray, hard, fine to medium textured, highly fossiliferous, partly crystalline.	100

PROJECT WEST COLUMBUS, OHIO LPP
HOLE NO. D-93-141

ELEVATION (FEET)	SYMBOL	R.S.E.#	DESCRIPTION OF MATERIALS	REMARKS OR TEST RESULTS
724.2	SC		GRAVELLY CLAYEY SAND (SC), br., low pl., dmp., f.g.-c.g.	WC LL PL #4 SAND#200 BLOWS
722.7	SC		CLAYEY SANDY GRAVEL (GC), dk. br. - r. br., low pl., dry, f.g.-c.g.	18-1
719.7	SC		GRAVELLY CLAYEY SAND (SC), dk. gr. br., low pl., dry, f.g.-c.g.	17-4
718.2	GC		CLAYEY SANDY GRAVEL (GC), dk. gr. br., ve. low pl., dmp., f.g.-c.g.	26-6
716.7	GC		CLAYEY SANDY GRAVEL (GC), dk. gr. br., ve. low pl., dmp., f.g.-c.g.	12-1
715.2	GC		GRAVEL (GP), br. gr., non pl., dry, f.g.-c.g.	8-7
710.7	OC		SANDY CLAYEY GRAVEL (GC), dk. gr., low pl., dry, f.g.-c.g.	20-9
709.2	SC		CLAYEY GRAVELLY SAND (SC), br., low pl., dmp., f.g.-c.g.	12-0
707.7	SC		CLAYEY SANDY GRAVEL (GC), dk. br., low pl., dmp., f.g.-c.g. w/ brick frags. and COAL	21-4
703.2	CL		SANDY CLAY (CL), br., m. pl., mst., f.g.-c.g.	28-1
701.7	CL		SANDY CLAY (CL), br., m. pl., mst., f.g.-c.g.	28-1
698.7	GC		SANDY GRAVEL (GP-GC), gr. br., ve. low pl., dmp., f.g.-c.g.	28-1
694.2	GC		CLAYEY SANDY GRAVEL (GC), br., low pl. dry - mst., f.g.-c.g.	10-3
691.7	GC		SANDY GRAVEL (GP-GC), br., ve. low pl. vet, f.g.-c.g.	10-9
688.2	GP		SANDY GRAVEL (GP), br., non pl., f.g.-c.g.	11-2
686.7	SP		GRAVELLY SAND (SP), br., non pl., f.g.-c.g.	73 20 7 12-9
682.2	GP		SANDY GRAVEL (GP), br., non pl., f.g.-c.g.	6
680.7	GP		SANDY GRAVEL (GP), br., non pl., f.g.-c.g.	11-15
677.2	GP		GRAVELLY SAND (SP), br., non pl., f.g.-c.g.	22
675.7	GP		SANDY GRAVEL (GP-GM), br., non pl., f.g.-c.g.	11-1
674.2	GP		GRAVELLY SAND (SP), gr. br., non pl., f.g.-c.g.	9
672.7	GP		GRAVELLY SAND (SP), gr. br., non pl., f.g.-c.g.	18
671.2	GP		GRAVELLY SAND (SP), gr. br., non pl., f.g.-c.g.	24-53
670.7	GP		GRAVELLY SAND (SP), gr. br., non pl., f.g.-c.g.	80
670.2	GP		GRAVELLY SAND (SP), gr. br., non pl., f.g.-c.g.	60-40
670.7	GP		SANDY CLAY (CL), gr., low pl., dmp., f.g.-c.g.	100
670.2	GP		SANDY CLAY (CL), gr., low pl., dmp., f.g.-c.g.	7 33 58 27-1

PROJECT WEST COLUMBUS, OHIO LPP
CONTINUATION OF HOLE NO. D-93-141

ELEVATION (FEET)	SYMBOL	R.S.E.#	DESCRIPTION OF MATERIALS	REMARKS OR TEST RESULTS
674.2	GP		SANDY GRAVEL (GP-GC), gr., ve. low pl., f.g.-c.g.	50-24
671.7	GP		SANDY GRAVEL (GP-GM), gr., non pl., f.g.-c.g.	93
670.2	GP		SANDY GRAVEL (GP-GM), gr., non pl., f.g.-c.g.	49 41 10 59-15
668.7	GP		GRAVELLY SAND (SP), gr., non pl., f.g.-c.g.	

CORE SIZE		PROJECT		SAMPLER		PROJECT		SAMPLER			
BATTER	DIRECTION	WEST COLUMBUS LPP	WEST COLUMBUS LPP	DROP	HAMMER	WEST COLUMBUS LPP	WEST COLUMBUS LPP	DROP	HAMMER		
DATE STARTED	DATE COMPLETED	HOLE NO. D-93-143		CONTINUATION OF HOLE NO. D-93-143		HOLE NO. D-94-169		CONTINUATION OF HOLE NO. D-94-169			
25 May 1993	28 May 1993	HOLE NO. D-93-143		CONTINUATION OF HOLE NO. D-93-143		HOLE NO. D-94-169		CONTINUATION OF HOLE NO. D-94-169			
COORDINATES		COORDINATES		COORDINATES		COORDINATES		COORDINATES			
N 711512.3 E 1855927.3		N 711512.3 E 1855927.3		N 71382.2 E 1853986.1		N 71382.2 E 1853986.1		N 71852.0 E 1857716.5			
ELEVATION (FEET)	SYMBOL	DESCRIPTION OF MATERIALS	REMARKS OR TEST RESULTS	ELEVATION (FEET)	SYMBOL	DESCRIPTION OF MATERIALS	REMARKS OR TEST RESULTS	ELEVATION (FEET)	SYMBOL	DESCRIPTION OF MATERIALS	REMARKS OR TEST RESULTS
725.3	SM	GRAVELLY SILTY SAND (SM), dk br, non pl., dry-dmp, f.g.-c.g. w/frag	18.0	674.3	GP	SANDY GRAVEL (GP), br, non pl.	F.W.	726.4	CL	SANDY CLAY (CL), gr-br, m-hi pl., dmp, f.g.-c.g. w/frag	15.2
722.3	GM	SILTY SANDY GRAVEL (GM), br, non pl., dry, f.g.-c.g.	13.8	672.8	SP	GRAVELLY SAND (SP), gr, br., non pl., f.g.-c.g.	F.W.	724.9	SC	GRAVELLY CLAYEY SAND (SC), gr, br, med pl., f.g.-c.g. w/red brick	15.2
720.8	SC	CLAYEY GRAVELLY SAND (SC), br, low pl., dry, f.g.-c.g.	10.0	671.3	CL	SANDY CLAY (CL), gr, m pl., f.g.-c.g.	F.W.	721.9	GP-GM	SANDY GRAVEL (GP-GM), lt br, nonpl, mst, f.g.-c.g.	11.2
719.3	GM	SANDY GRAVEL (GP-GM), gr, br, non pl., dry, f.g.-c.g.	8.2	669.8	SC	GRAVELLY CLAYEY SAND (SC), gr, low pl., f.g.-c.g.	F.W.	719.9	GM	SANDY SANDY GRAVEL (GM), lt br, nonpl, mst, f.g.-c.g.	11.2
717.8	GM	SANDY GRAVEL (GP-GM), gr, br, non pl., dry, f.g.-c.g.	5.3	668.3	SP-SM	GRAVELLY SAND (SP-SM), gr, non pl., f.g.-c.g.	F.W.	718.9	GM	SANDY SANDY GRAVEL (GM), lt br, nonpl, mst, f.g.-c.g.	11.2
716.3	GM	CLAYEY SANDY GRAVEL (GC), gr, br, low pl., dry, f.g.-c.g. w/red brick frags	18.0	666.8	SM	SANDY GRAVEL (GP-GM), gr, non pl., f.g.-c.g.	F.W.	717.4	GM	SANDY SANDY GRAVEL (GM), lt br, nonpl, mst, f.g.-c.g.	11.2
714.8	SC	GRAVELLY CLAYEY SAND (SC), F, RE, BR, low pl., mst, f.g.-c.g. w/red brick frags	14.0	663.8	GP-GM	GRAVELLY SAND (SP), br., non pl., f.g.-c.g.	F.W.	715.9	GM	SANDY SANDY GRAVEL (GM), lt br, nonpl, mst, f.g.-c.g.	11.2
713.3	GP-GM	SANDY GRAVEL (GP-GM), gr, br, low pl., mst, f.g.-c.g. w/red brick frags	17.6	660.8	SP	GRAVELLY SAND (SP), br., non pl., f.g.-c.g.	F.W.	714.4	GM-GM	CLAYEY SANDY GRAVEL (GC), br, ve low pl., mst, f.g.-c.g.	11.2
711.8	SC	GRAVELLY CLAYEY SAND (SC), F, RE, BR, low pl., mst, f.g.-c.g.	14.7	657.8	SM	SILTY GRAVELLY SAND (SM), br, non pl., f.g.-c.g.	F.W.	712.9	GP-GM	SANDY GRAVEL (GP-GM), br, ve low pl., mst, f.g.-c.g.	11.2
710.3	SC	GRAVELLY CLAYEY SAND (SC), F, RE, BR, low pl., mst, f.g.-c.g.	12.6	655.3	GP	SANDY GRAVEL (GP), br., non pl., f.g.-c.g.	F.W.	709.9	GP-GM	SANDY GRAVEL (GP-GM), br, ve low pl., mst, f.g.-c.g.	11.2
708.8	GC	CLAYEY SANDY GRAVEL (GC), gr, br., low pl., mst, f.g.-c.g.	19.6	653.8	GP	SANDY GRAVEL (GP), br., non pl., f.g.-c.g.	F.W.	708.4	GP-GM	CLAYEY SANDY GRAVEL (GC), br, low pl., mst, f.g.-c.g.	11.2
707.3	CL	GRAVELLY SANDY CLAY (CL), br, m pl., dmp, f.g.-c.g. w/frag	15.3	651.3	SM	SANDY GRAVEL (GP), br., non pl., f.g.-c.g.	F.W.	706.9	GP-GM	SANDY GRAVEL (GP-GM), br, low pl., mst, f.g.-c.g.	11.2
705.8	SM	SANDY GRAVEL (GP), gr, br, non pl., dmp, f.g.-c.g. w/frag	33.5	648.8	GP	SANDY GRAVEL (GP), br., non pl., f.g.-c.g.	F.W.	705.4	GP-GM	SANDY GRAVEL (GP-GM), br, low pl., mst, f.g.-c.g.	11.2
704.3	SM	SANDY GRAVEL (GP), gr, br, non pl., dmp, f.g.-c.g. w/frag	29.7	646.3	CL	CLAYSTONE gray, soft, clayey, moderately to severely broken, occasionally calcareous, weathered, occasionally pyritic. Shaly above 653.8.	L 0.8	703.9	GP-GM	SANDY GRAVEL (GP-GM), br, low pl., mst, f.g.-c.g.	11.2
702.8	SM	SANDY GRAVEL (GP), gr, br, non pl., dmp, f.g.-c.g. w/frag	20.7	643.8	SLS	SILTSTONE Gray to brownish gray, mod. hard, calcareous, numerous dark stringers throughout	L 1.0	702.4	GP-GM	SANDY GRAVEL (GP-GM), br, low pl., mst, f.g.-c.g.	11.2
701.3	GC	SANDY CLAYEY GRAVEL (GC), br, m pl., dmp, f.g.-c.g. w/frag	18.7	641.3	LS	LIMESTONE Gray to brownish gray, mod. hard to hard, silty, fine to very fine textured, large chert nodules and seams throughout, numerous dark stringers throughout	L 0.0	700.9	GP-GM	SANDY GRAVEL (GP-GM), br, low pl., mst, f.g.-c.g.	11.2
699.8	CL	SANDY CLAY (CL), br., m pl., mst, f.g.-c.g.	18.3	638.8	LS	LIMESTONE Light gray, hard, medium to fine textured, highly fossiliferous, partly crystalline	L 0.0	699.4	GP-GM	SANDY GRAVEL (GP-GM), br, low pl., mst, f.g.-c.g.	11.2
698.3	GP-GM	SANDY GRAVEL (GP-GM), gr, br, ve, low pl., mst, f.g.-c.g.	6.0	636.3	LS	LIMESTONE Light gray, hard, medium to fine textured, highly fossiliferous, partly crystalline	L 0.0	697.9	GP-GM	SANDY GRAVEL (GP-GM), br, low pl., mst, f.g.-c.g.	11.2
696.8	GP-GM	SANDY GRAVEL (GP-GM), gr, br, non pl., mst, f.g.-c.g.	8.0	633.8	LS	LIMESTONE Light gray, hard, medium to fine textured, highly fossiliferous, partly crystalline	L 0.0	696.4	GP-GM	SANDY GRAVEL (GP-GM), br, low pl., mst, f.g.-c.g.	11.2
695.3	GM	SANDY GRAVEL (GP-GM), gr, br, non pl., mst, f.g.-c.g.	13.5	631.3	LS	LIMESTONE Light gray, hard, medium to fine textured, highly fossiliferous, partly crystalline	L 0.0	694.9	GP-GM	SANDY GRAVEL (GP-GM), br, low pl., mst, f.g.-c.g.	11.2
693.8	GM	SANDY GRAVEL (GP-GM), gr, br, non pl., mst, f.g.-c.g.	12.4	628.8	LS	LIMESTONE Light gray, hard, medium to fine textured, highly fossiliferous, partly crystalline	L 0.0	693.4	GP-GM	SANDY GRAVEL (GP-GM), br, low pl., mst, f.g.-c.g.	11.2
692.3	SP	GRAVELLY SAND (SP), gr., non pl., f.g.-c.g.	F.W.	626.3	LS	LIMESTONE Light gray, hard, medium to fine textured, highly fossiliferous, partly crystalline	L 0.0	691.9	GP-GM	SANDY GRAVEL (GP-GM), br, low pl., mst, f.g.-c.g.	11.2
690.8	GP	SANDY GRAVEL (GP), gr., non pl., f.g.-c.g.	F.W.	623.8	LS	LIMESTONE Light gray, hard, medium to fine textured, highly fossiliferous, partly crystalline	L 0.0	690.4	GP-GM	SANDY GRAVEL (GP-GM), br, low pl., mst, f.g.-c.g.	11.2
689.3	GP	SANDY GRAVEL (GP), gr., non pl., f.g.-c.g.	F.W.	621.3	LS	LIMESTONE Light gray, hard, medium to fine textured, highly fossiliferous, partly crystalline	L 0.0	688.9	GP-GM	SANDY GRAVEL (GP-GM), br, low pl., mst, f.g.-c.g.	11.2
687.8	GP	SANDY GRAVEL (GP), gr., non pl., f.g.-c.g.	F.W.	618.8	LS	LIMESTONE Light gray, hard, medium to fine textured, highly fossiliferous, partly crystalline	L 0.0	687.4	GP-GM	SANDY GRAVEL (GP-GM), br, low pl., mst, f.g.-c.g.	11.2
686.3	GM	SANDY GRAVEL (GP-GM), gr, non pl., f.g.-c.g.	F.W.	616.3	LS	LIMESTONE Light gray, hard, medium to fine textured, highly fossiliferous, partly crystalline	L 0.0	685.9	GP-GM	SANDY GRAVEL (GP-GM), br, low pl., mst, f.g.-c.g.	11.2
684.8	GP	SANDY GRAVEL (GP), br, non pl., f.g.-c.g.	F.W.	613.8	LS	LIMESTONE Light gray, hard, medium to fine textured, highly fossiliferous, partly crystalline	L 0.0	684.4	GP-GM	SANDY GRAVEL (GP-GM), br, low pl., mst, f.g.-c.g.	11.2
683.3	GP-GM	SANDY GRAVEL (GP-GM), r, br, non pl., f.g.-c.g.	F.W.	611.3	LS	LIMESTONE Light gray, hard, medium to fine textured, highly fossiliferous, partly crystalline	L 0.0	682.9	GP-GM	SANDY GRAVEL (GP-GM), br, low pl., mst, f.g.-c.g.	11.2
681.8	GP-GM	SANDY GRAVEL (GP-GM), r, br, non pl., f.g.-c.g.	F.W.	608.8	LS	LIMESTONE Light gray, hard, medium to fine textured, highly fossiliferous, partly crystalline	L 0.0	681.4	GP-GM	SANDY GRAVEL (GP-GM), br, low pl., mst, f.g.-c.g.	11.2
680.3	SP	GRAVELLY SAND (SP), br, non pl., f.g.-c.g.	F.W.	606.3	LS	LIMESTONE Light gray, hard, medium to fine textured, highly fossiliferous, partly crystalline	L 0.0	679.9	SM	SILTY GRAVELLY SAND (SM), br, nonpl, wet, f.g.-c.g. w/FW	14
678.8	GP	SANDY GRAVEL (GP), gr., non pl., f.g.-c.g.	F.W.	603.8	LS	LIMESTONE Light gray, hard, medium to fine textured, highly fossiliferous, partly crystalline	L 0.0	678.4	GP-GM	SANDY GRAVEL (GP-GM), br, nonpl, wet, f.g.-c.g. w/FW	14
677.3	GP-GM	SANDY GRAVEL (GP-GM), br, non pl., f.g.-c.g.	F.W.	601.3	LS	LIMESTONE Light gray, hard, medium to fine textured, highly fossiliferous, partly crystalline	L 0.0	676.9	GP-GM	SANDY GRAVEL (GP-GM), br, nonpl, wet, f.g.-c.g. w/FW	14
675.8	GP-GM	SANDY GRAVEL (GP-GM), br, non pl., f.g.-c.g.	F.W.	598.8	LS	LIMESTONE Light gray, hard, medium to fine textured, highly fossiliferous, partly crystalline	L 0.0	675.4	GP-GM	SANDY GRAVEL (GP-GM), br, nonpl, wet, f.g.-c.g. w/FW	14

CORE SIZE		PROJECT		SAMPLER		PROJECT		SAMPLER			
BATTER	DIRECTION	WEST COLUMBUS LPP	WEST COLUMBUS LPP	DROP	HAMMER	WEST COLUMBUS LPP	WEST COLUMBUS LPP	DROP	HAMMER		
DATE STARTED	DATE COMPLETED	HOLE NO. D-96-199		CONTINUATION OF HOLE NO. D-96-200		HOLE NO. D-96-201		CONTINUATION OF HOLE NO. D-96-201			
6/11/96	6/11/96	HOLE NO. D-96-199		CONTINUATION OF HOLE NO. D-96-200		HOLE NO. D-96-201		CONTINUATION OF HOLE NO. D-96-201			
COORDINATES		COORDINATES		COORDINATES		COORDINATES		COORDINATES			
N 715023.3 E 1857826.8		N 715023.3 E 1857826.8		N 714941.5 E 1857901.1		N 714941.5 E 1857901.1		N 714941.5 E 1857901.1			
ELEVATION (FEET)	SYMBOL	DESCRIPTION OF MATERIALS	REMARKS OR TEST RESULTS	ELEVATION (FEET)	SYMBOL	DESCRIPTION OF MATERIALS	REMARKS OR TEST RESULTS	ELEVATION (FEET)	SYMBOL	DESCRIPTION OF MATERIALS	REMARKS OR TEST RESULTS
728.2	CL	CLAY (CL), dk br, low pl., dry, w/frag. rts & shales	15.0	728.2	CL	CLAY (CL), dk br, low pl., dry, w/frag. rts & shales	15.0	672.6	NS	DRILLING WITHOUT SAMPLING (CONCRETE)	15.0
718.7	SC	GRAVELLY CLAYEY SAND (SC), br, low pl., dry, f.g.-c.g. w/red brick frag & coal part	15.3	718.5	SC	CLAYEY SAND (SC), br, low pl., dry, f.g.-c.g. w/red brick, coal & glass part	18.8	671.1	SM	SANDY CLAY (CL), low pl., dry, f.g.-c.g. w/red brick & coal part	19.9
717.2	CL	SANDY CLAY (CL), br, low pl., dry, f.g.-c.g. w/red brick part	12.7	717.4	SM	SILTY SAND (SM), br & bk, nonpl, dry, f.g.-c.g. w/red brick part	32.5	714.6	CL	SANDY CLAY (CL), low pl., dry, f.g.-c.g.	17.9
714.6	SM	GRAVELLY SILTY SAND (SM), bk, nonpl, dry, f.g.-c.g.	27.2	716.0	NS	DRILLING WITHOUT SAMPLING	15.2	712.7	SC	CLAYEY GRAVELLY SAND (SC), br & bk, low pl., dry, f.g.-c.g. w/red brick part	22.2
714.5	SM	GRAVELLY SILTY SAND (SM), bk, nonpl, dry, f.g.-c.g.	28.1	715.0	GP	GRAVEL (GP), br, nonpl, dry, f.g.-c.g.	15.2	711.6	NS	DRILLING WITHOUT SAMPLING (BRICKS)	22.2
711.7	SM	GRAVELLY SILTY SAND (SM), bk, nonpl, dry, f.g.-c.g.	28.1	713.0	SC	GRAVELLY CLAYEY SAND (SC), bk & whi, m pl., dry, f.g.-c.g.	27.4	708.6	SC-SM	SILTY GRAVELLY SAND (SC-SM), dk br, ve low pl., dry, f.g.-c.g. w/red brick pieces	14.0
709.9	SC	CLAYEY SAND (SC), dk br, m hi pl., dry, f.g.-c.g.	23.9	710.3	CL	CLAY (CL), br, m pl., dmp, w/fg SAND	31.0	706.6	CL	SANDY CLAY (CL), br, low pl., dry, f.g.-c.g.	25.0
707.3	CL	SANDY CLAY (CL), br, m hi pl., dmp, f.g.-c.g.	28.9	708.0	CL	CLAY (CL), br, hi pl., dmp, w/fg SAND	29.7	704.6	CL	dmp, fg sand @ 16' - 21'	22.9
707.2	CL	CLAY (CL), dk olive gr, hi pl., dmp, w/fg sand	27.9	706.0	CH	CLAY (CH), br, hi pl., dmp, w/fg SAND	29.7	701.1	CL	wel, lt br @ 18' - 21'	29.2
705.8	CL	CLAY (CL), dk olive gr, hi pl., dmp, w/fg sand	28.0	704.4	CH	CLAY (CH), br, hi pl., dmp, w/fg SAND	29.7	700.1	ML	SANDY SILT (ML), lt br, nonpl, f.g.-m.g. w/FW	17.1
699.3	CL	CLAY (CL), dk olive br, m hi pl., wet, w/fg sand	30.6	701.4	CL	fg-cg SAND @ 19'0" - 19'5" olive br, fg SAND @ 19'5" - 20'1"	27.3	25.0	SM	SILTY SAND (SM), lt br, nonpl, wet, f.g.-c.g.	16.2
698.1	CL	CLAY (CL), dk olive br, m hi pl., wet, w/fg sand	30.6	699.0	CL	CLAY (CL), olive br, m hi pl., dmp, fg SAND	31.6	25.0	GP-GM	SANDY GRAVEL (GP-GM), lt br, nonpl, wet, f.g.-c.g.	16.2
BOTTOM OF HOLE											

Revisions			
Symbol	Descriptions	Date	Approved

**U.S. ARMY ENGINEER DISTRICT
CORPS OF ENGINEERS
HUNTINGTON, WEST VIRGINIA**

Designed by: **G. HENSLEY**
 Drawn by: **L. MERS**
 Checked by: **L. RIGGS**
 Reviewed by: **AS SHOWN**
 Approved by: **MAR 1997**

**GRAPHIC LOGS
OF BORINGS**

Scale: **AS SHOWN**
 Date: **MAR 1997**
 Drawing Code: **O16-PWC-10**

Sheet reference number: **1010**
 FILENAME: **LOGS DGN**
 PEN TABLE

CORE SIZE NA		PROJECT WEST COLUMBUS LPP		SAMPLER 2" SPLITSPOON	
BATTER VERTICAL		DIRECTION NA		DROP 30"	
DATE 6/18/96		COORDINATES N 714375.5		HAMMER 140#	
STARTED 6/18/96		COMPLETED 6/18/96		E 185820.2	
HOLE NO. D-96-202					
ELEVATION (FEET) MSL	SYMBOL	RSE *	DESCRIPTION OF MATERIALS	REMARKS OR TEST RESULTS	
728.2	NS		DRILLING WITHOUT SAMPLING (ROAD MATERIAL)	W	C L L P L
726.7	CL		CLAY (CL), br. low pl. dry, w/f-g SAND	23.4	
			fg SAND @ 4' - 7'	23.3	
			m pl. f-g-m-g SAND, w/r/s. red brick part & a piece of GRAVEL @ 7' - 8'	23.0	
			dmp @ 8' - 18'	24.6 34 18	
			m hi pl. w/wood chips @ 10' - 13'	26.7 40 18	
			olive br @ 13' - 14'	26.7	
			dk gr. fg SAND @ 14' - 16'	28.7	
			coal part & org od @ 15' - 18'	33.5	
709.4	SP		GRAVELLY SAND (SP), br. nonpl. dmp. fg-c-g	11.6	
706.5	CL		CLAY (CL), ve dk gr. m pl. dmp. w/f-g SAND and org od	26.2	
705.3	CL		SANDY CLAY (CL), dk br. m pl. dmp. fg-c-g	20.9	
703.7	CL		CLAY (CL), dk gr. m hi pl. dmp. w/f-g SAND	25.7 45 19	
701.2	CL		CLAY (CL), olive br. m hi pl. wet. w/f-g-m-g SAND		
698.1	SM		SILTY SAND (SM), lt br. nonpl. wet. fg-c-g	25.4	
697.5	CL		CLAY (CL), bk. m pl. wet. fg-c-g, w/gravel and brick frags		
695.2	SP		GRAVELLY SAND (SP), br. nonpl. wet. fg-c-g		
692.2	SM		SILTY GRAVELLY SAND (SM), br. nonpl. wet. fg-c-g	20.3	
689.2	GP-GM		SANDY GRAVEL (GP-GM), gr. br. nonpl. wet. fg-c-g	14.1	
686.2	SM		SILTY GRAVELLY SAND (SM), gr. br. nonpl. wet. fg-c-g		
685.3	SC		CLAYEY GRAVELLY SAND (SC), gr. low pl. dmp. fg-c-g SAND, fg GRAVEL		
681.5	CL		SANDY CLAY (CL), olive gr. low pl. dmp. fg-c-g		
679.5	SM		GRAVELLY SILTY SAND (SM), olive br. nonpl. wet. fg-c-g	16.8	
679.0	SP		SAND (SP), gr. br. nonpl. wet. fg-c-g		
678.4	SM		SILTY SAND (SM), gr. br. nonpl. wet. w/f-g SAND		

CORE SIZE NA		PROJECT WEST COLUMBUS LPP		SAMPLER 2" SPLITSPOON	
BATTER VERTICAL		DIRECTION NA		DROP 30"	
DATE 6/13/96		COORDINATES N 712772.3		HAMMER 140#	
STARTED 6/13/96		COMPLETED 6/13/96		E 1851372.5	
HOLE NO. D-96-206					
ELEVATION (FEET) MSL	SYMBOL	RSE *	DESCRIPTION OF MATERIALS	REMARKS OR TEST RESULTS	
678.2	SM		SILTY SAND (SM), gr. br. nonpl. wet. fg-c-g		
665.2	SM		SILTY GRAVELLY SAND (SM), gr. nonpl. wet. fg-c-g		
662.2			BOTTOM OF HOLE		

CORE SIZE NA		PROJECT WEST COLUMBUS LPP		SAMPLER 2" SPLITSPOON	
BATTER VERTICAL		DIRECTION NA		DROP 30"	
DATE 6/12/96		COORDINATES N 713716.2		HAMMER 140#	
STARTED 6/12/96		COMPLETED 6/12/96		E 185825.5	
HOLE NO. D-96-203					
ELEVATION (FEET) MSL	SYMBOL	RSE *	DESCRIPTION OF MATERIALS	REMARKS OR TEST RESULTS	
719.7	NS		DRILLING WITHOUT SAMPLING	W	C L L P L
718.4	CL		SANDY CLAY (CL), gr. br. nonpl. dry. fg-c-g	7.4	
			SANDY CLAY (CL), br. m pl. dry. fg-c-g	21.7	
			w/brick frags	20.5 40 23	
710.9	NS		DRILLING WITHOUT SAMPLING	17.3	
709.2	CL		GRAVELLY SANDY CLAY (CL), br. m pl. dry. fg-c-g, w/brick frags	15.1	
708.2	CH		SANDY CLAY (CH), dk gr. m pl. dry. fg-c-g (w/org odor)	24.1 54 27	
706.2	CL		SANDY CLAY (CL), br. m pl. dmp. fg-c-g	28.2	
703.6	SC		CLAYEY SAND (SC), br. m pl. dmp. fg-c-g, w/F W	23.7	
701.7	SC		SILTY SAND (SM), br. nonpl. wet. fg-c-g, w/F W and cr she	26.7	
699.4	SP-SM		GRAVELLY SAND (SP-SM), br. nonpl. wet. fg-c-g, w/F W and cr she	26.5	
696.4	GP-GM		SANDY GRAVEL (GP-GM), br. nonpl. wet. fg-c-g, w/F W	14.7	
694.2	SP		GRAVELLY SAND (SP), br. nonpl. wet. fg-c-g, w/F W		
692.5	GP		SANDY GRAVEL (GP), br. nonpl. wet. fg-c-g, w/F W		
689.7	SP-SM		GRAVELLY SAND (SP-SM), gr. nonpl. wet. fg-c-g, w/F W		
687.3	CL		SANDY CLAY (CL), gr. low pl. dmp. fg-c-g, w/f-g GRAVEL		
685.2	CL		GRAVELLY SANDY CLAY (CL), gr. low pl. dmp. fg-c-g		
682.2	CL		CLAY (CL), gr. low pl. dmp. w/f-g SAND		

CORE SIZE NA		PROJECT WEST COLUMBUS LPP		SAMPLER 2" SPLITSPOON	
BATTER VERTICAL		DIRECTION NA		DROP 30"	
DATE 6/14/96		COORDINATES N 713453.4		HAMMER 140#	
STARTED 6/14/96		COMPLETED 6/14/96		E 1858102.5	
HOLE NO. D-96-204					
ELEVATION (FEET) MSL	SYMBOL	RSE *	DESCRIPTION OF MATERIALS	REMARKS OR TEST RESULTS	
725.5	NS		DRILLING WITHOUT SAMPLING	W	C L L P L
724.0	NS		DRILLING WITHOUT SAMPLING	6.0	
			GRAVELLY CLAYEY SAND (SC), lt br. low pl. dry. fg-c-g	12.5	
			gr. br. m pl @ 2' - 4'	23.8 43 22	
			r br. m hi pl. w/brick frags @ 4' - 7'		
718.0	CL		SANDY CLAY (CL), r br. m pl. dry. fg-c-g, w/brick frags	20.5	
715.0	CL		GRAVELLY SANDY CLAY (CL), r br. m hi pl. dry. fg-c-g, w/brick frags	24.8 44 22	
710.8	CL		SANDY CLAY (CL), dk gr. m hi pl. dmp. fg-c-g, w/organics	22.2 40 19	
707.6	GC		CLAYEY SANDY GRAVEL (GC), r br. low pl. dry. fg-c-g, w/brick frags	23.9	
706.0	CL		SANDY CLAY (CL), dk br. m pl. dry. fg-c-g		
703.0	CL		GRAVELLY CLAYEY SAND (SC), r br. m hi pl. dry. c to fg w/brick frags	24.1	
702.5	SC		SANDY CLAY (CL), dk br. m pl. dmp. fg-c-g	24.4	
702.0	SC		CLAYEY SAND (SC), br. low pl. wet. fg-c-g w/cr she		
			BOTTOM OF HOLE		

CORE SIZE NA		PROJECT WEST COLUMBUS LPP		SAMPLER 2" SPLITSPOON	
BATTER VERTICAL		DIRECTION NA		DROP 30"	
DATE 6/13/96		COORDINATES N 712772.3		HAMMER 140#	
STARTED 6/13/96		COMPLETED 6/13/96		E 1851372.5	
HOLE NO. D-96-205					
ELEVATION (FEET) MSL	SYMBOL	RSE *	DESCRIPTION OF MATERIALS	REMARKS OR TEST RESULTS	
723.9	CL		SANDY CLAY (CL), br. m pl. fg-c-g, w/org	23.9	
720.4	CL		GRAVELLY SANDY CLAY (CL), br. m pl. dry. fg-c-g	17.2	
718.2	SC		CLAYEY GRAVELLY SAND (SC), br. low pl. dry. fg-c-g	19.8 40 21	
715.6	SC		CLAYEY GRAVELLY SAND (SC), br. low pl. dry. fg-c-g	32.9	
			SANDY CLAYEY GRAVEL (GC), r br. low pl. dmp. fg-c-g, w/brick frags	24.4	
			dk gr. m pl @ 10' - 13'	29.4	
710.4	SM		GRAVELLY SILTY SAND (SM), dk gr. nonpl. dmp. fg-c-g, w/org	44.0 NP NP	
706.8	SC		GRAVELLY CLAYEY SAND (SC), br. gr. m pl. dmp. fg-c-g, w/org	48.9	
705.3	SC		CLAYEY SAND (SC), dk gr. and bk. m pl. fg-c-g, w/org	46.1	
702.9	CH		SANDY CLAY (CH), dk gr. hi pl. dmp. fg-c-g	27.5 54 25	
701.4	CL		SANDY CLAY (CL), br. gr. m pl. dmp. fg-m-g	26.7	
			BOTTOM OF HOLE		

CORE SIZE NA		PROJECT WEST COLUMBUS LPP		SAMPLER 2" SPLITSPOON	
BATTER VERTICAL		DIRECTION NA		DROP 30"	
DATE 6/13/96		COORDINATES N 712650.0		HAMMER 140#	
STARTED 6/13/96		COMPLETED 6/13/96		E 1857187.0	
HOLE NO. D-96-206					
ELEVATION (FEET) MSL	SYMBOL	RSE *	DESCRIPTION OF MATERIALS	REMARKS OR TEST RESULTS	
722.3	CL		SANDY CLAY (CL), gr. m pl. fg-c-g	23.7	
716.3	SC		GRAVELLY CLAYEY SAND (SC), gr. low pl. dry. fg-c-g	13.9	
			m pl @ 3' - 6'	12.4 33 17	
713.3	SM		SILTY GRAVELLY SAND (SM), lt br. r br. nonpl. dry. fg-c-g, w/brick frags	12.2	
710.3	SM		GRAVELLY SILTY SAND (SM), gr. br. r br. nonpl. dry. fg-c-g, w/brick frags	11.7	
710.0	SM		GRAVELLY SAND (SP-SM), br. nonpl. dry. fg-c-g	4.8	
707.2	CL		GRAVELLY SANDY CLAY (CL), gr. m hi pl. dry. fg-c-g	22.4 47 22	
706.6	ML		SANDY SILTY SAND (SM), lt br. nonpl. dmp. fg-c-g	14.2	
704.3	SM		GRAVELLY SILTY SAND (SM), bk. nonpl. fg-c-g	21.8	
703.9	SM		SILTY GRAVELLY SAND (SM), br. bk. nonpl. fg-c-g	16.6	
702.0	CH		SANDY CLAY (CH), br. hi pl. dry. fg-c-g	23.7 54 24	
699.8	CL		SANDY CLAY (CL), br. m pl. dry. fg-m-g, w/cr she	20.1	
			BOTTOM OF HOLE		

Revisions			
Symbol	Descriptions	Date	Approved

**U.S. ARMY ENGINEER DISTRICT
CORPS OF ENGINEERS
HUNTINGTON, WEST VIRGINIA**


Designed by: **G. HENSLEY**
 Drawn by: **L. MERS**
 Checked by: **L. RIGGS**
 Reviewed by: **AS SHOWN**
 Approved by: **MAR 1997**

**SCIO TO RIVER
COLUMBUS, OHIO
WEST COLUMBUS, L.P.P.
PHASE IID**


GRAPHIC LOGS OF BORINGS

Scale: **AS SHOWN**
 Date: **MAR 1997**
 Drawing Code: **O16-PWC-10**

Sheet reference number: **10/11**
 FILENAME: **LOGS DGN**
 PEN TABLE

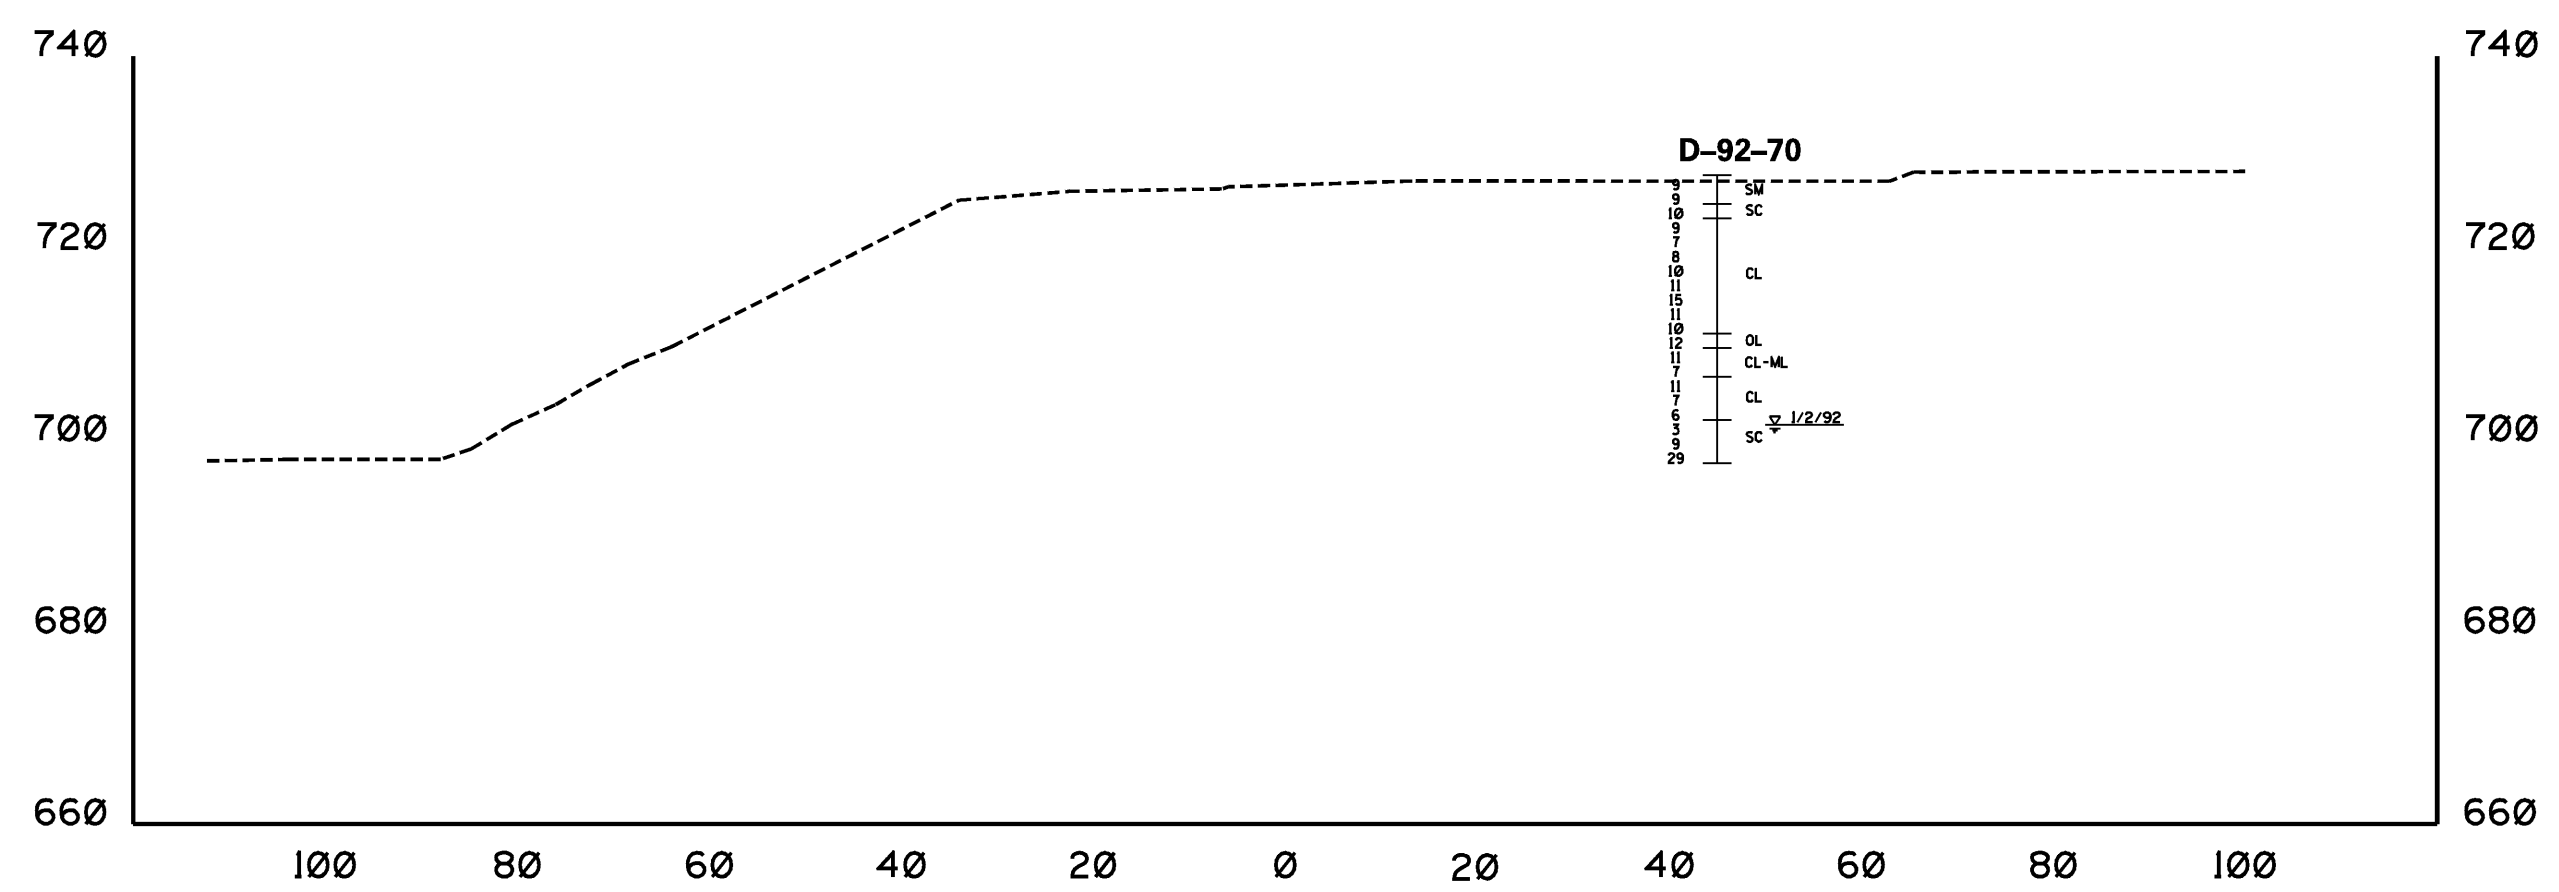


GEOLOGIC SECTION A-A'
STATION 155 + 00

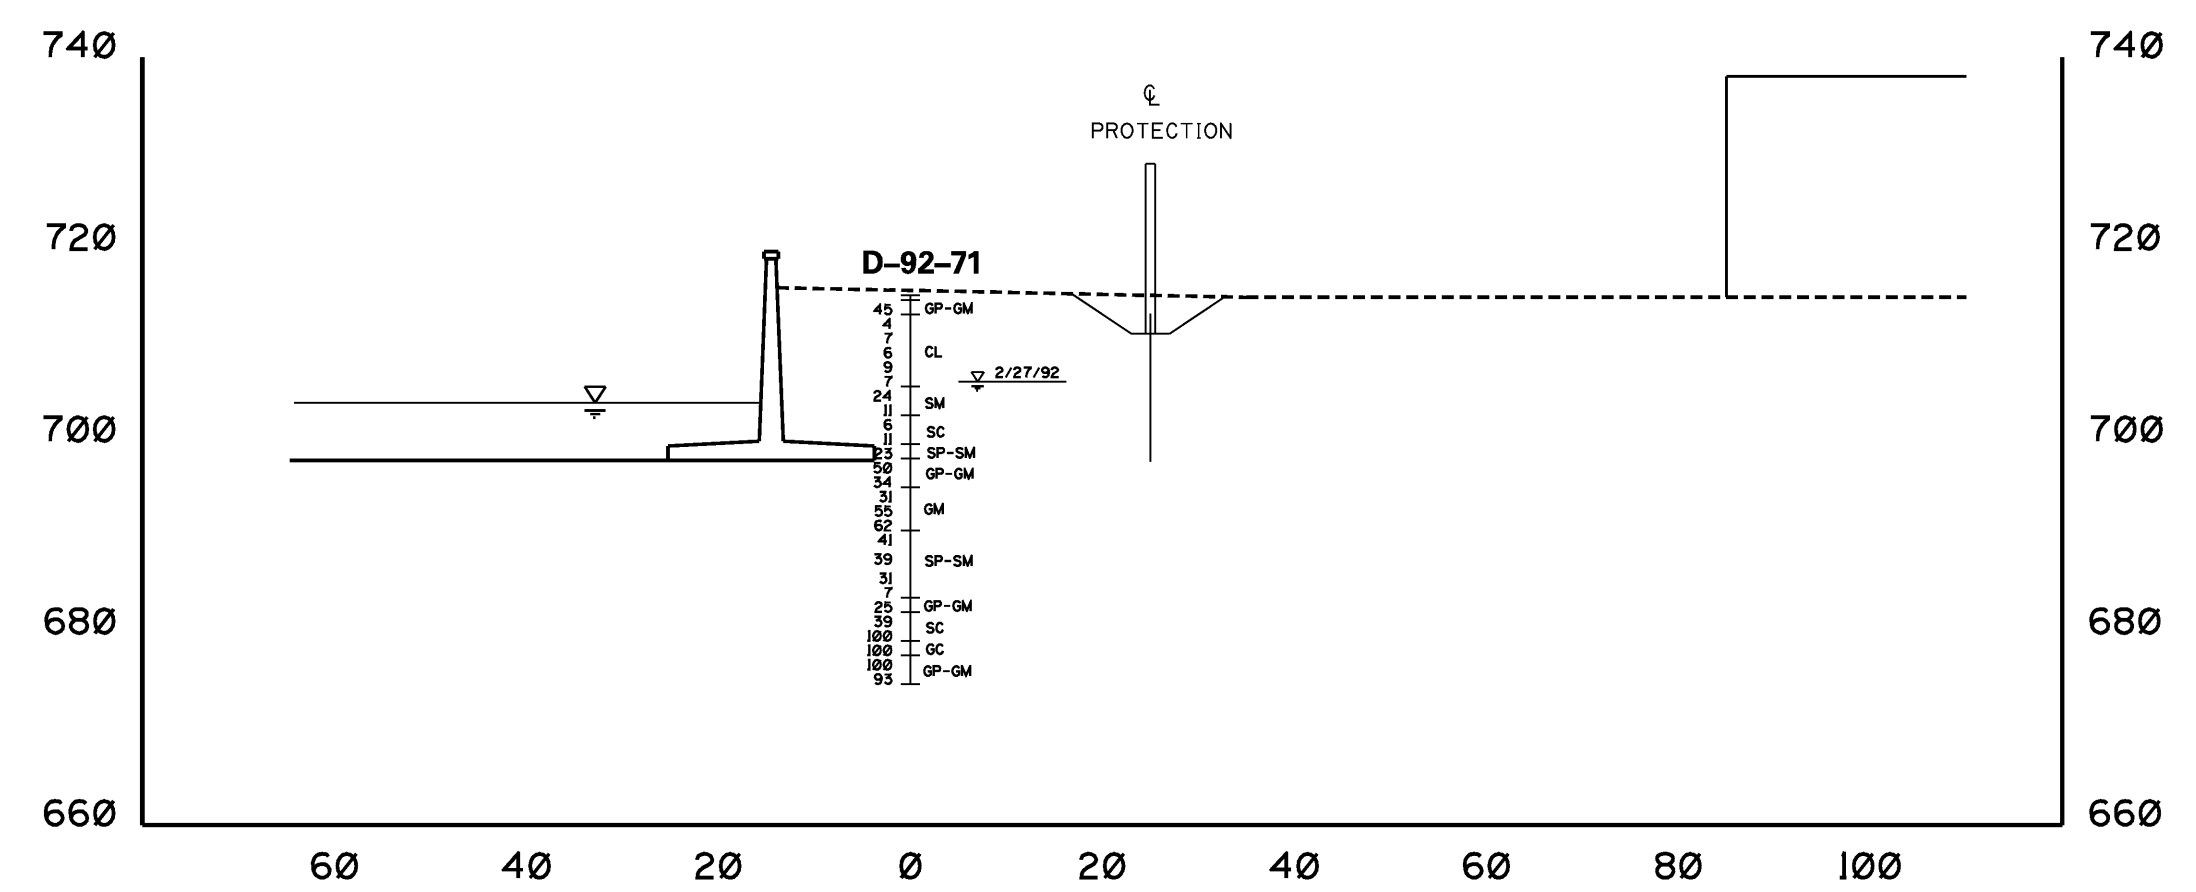

GEOLOGIC SECTION B-B'
STATION 159 + 00


Revisions			
Symbol	Descriptions	Date	Approved


U.S. ARMY ENGINEER DISTRICT CORPS OF ENGINEERS HUNTINGTON, WEST VIRGINIA		SCIOTO RIVER COLUMBUS, OHIO WEST COLUMBUS, L.P.P. PHASE IID	
Designed by: GAH		GEOLOGIC SECTIONS	
Drawn by: JER			
Checked by: GAH			
Reviewed by:	Scale: AS SHOWN	Sheet reference number: 10/12	FILENAME: sections.dgn PEN TABLE:
Approved by:	Date: MARCH 1997	Drawing Code: 016-PWC-10	Sheet 1 of 4

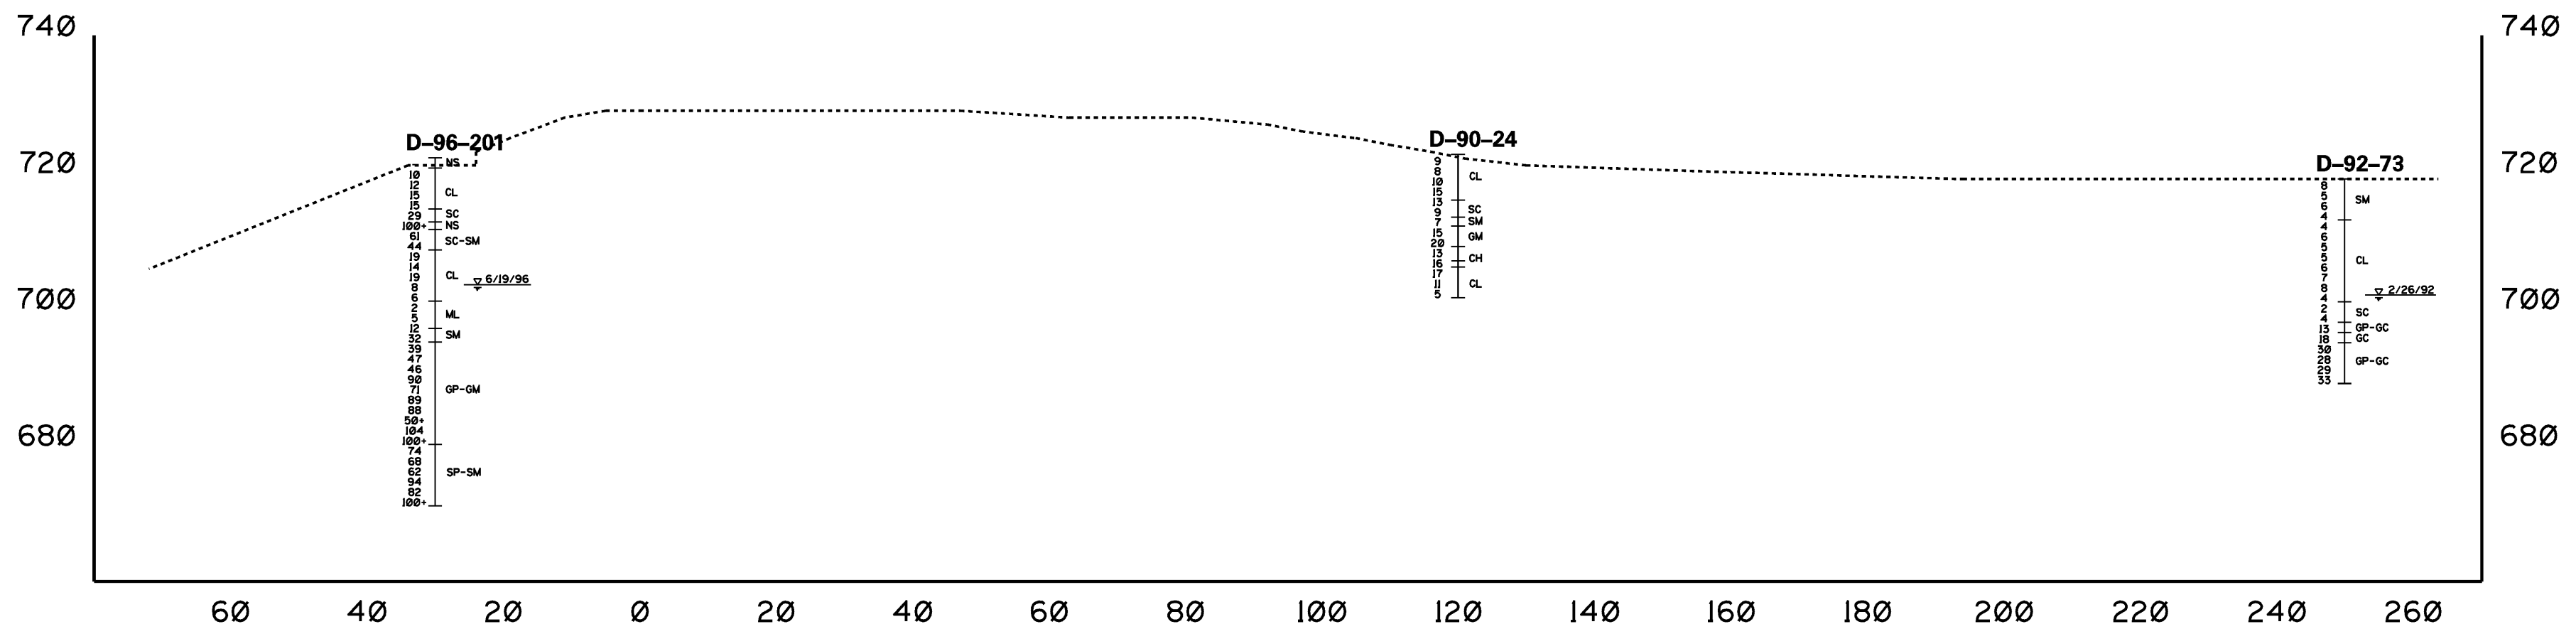


**GEOLOGIC SECTION C-C
STATION 171+00**

Revisions			
Symbol	Descriptions	Date	Approved

U.S. ARMY ENGINEER DISTRICT CORPS OF ENGINEERS HUNTINGTON, WEST VIRGINIA			
Designed by: GAH Drawn by: JER Checked by: GAH	 30 Day Corp of Engineers	SCIOTO RIVER COLUMBUS, OHIO WEST COLUMBUS, L.P.P. PHASE IID GEOLOGIC SECTIONS	
Reviewed by:	Scale: AS SHOWN Date: MARCH 1997 Drawing Code: O16-PWC-10	Sheet reference number: 10/13	FILENAME: sections.dgn Sheet 2 of 4

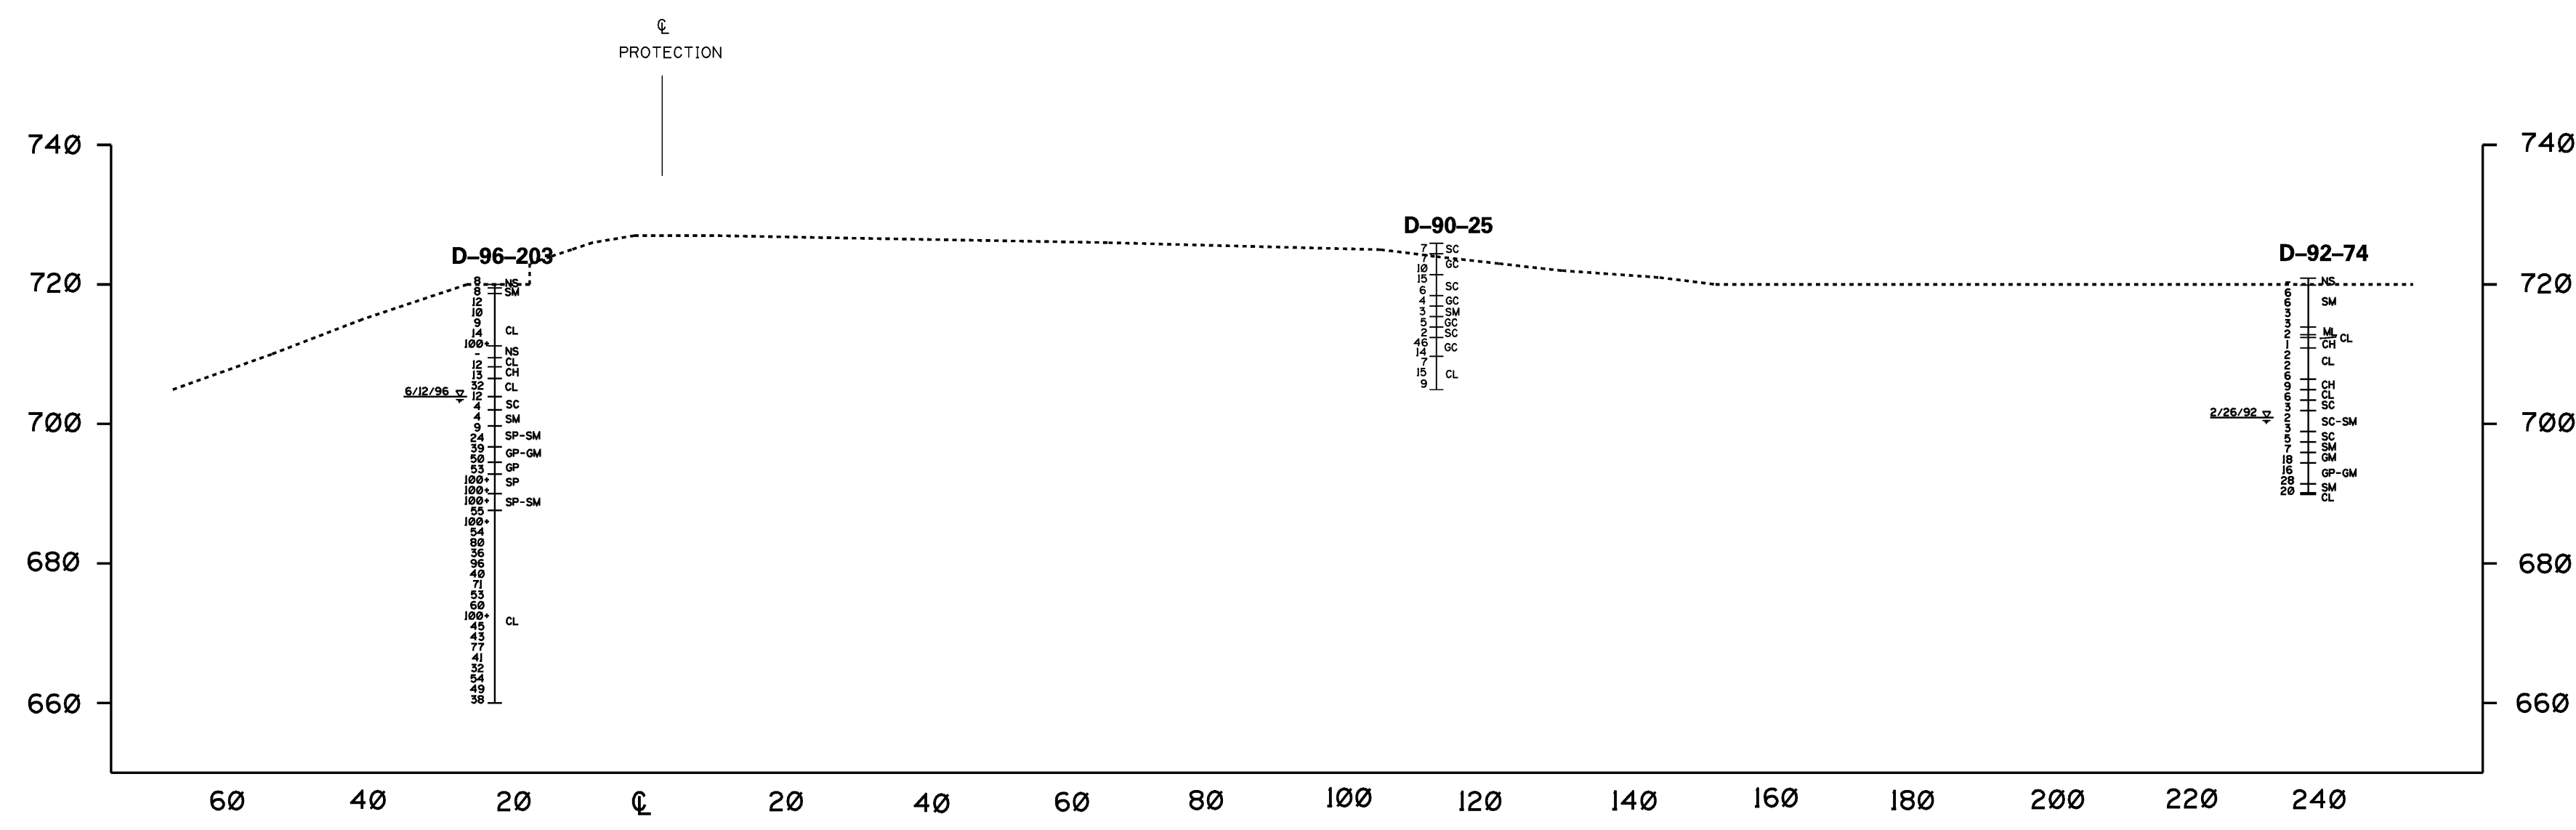



GEOLOGIC SECTION D-D'
STATION 181+00

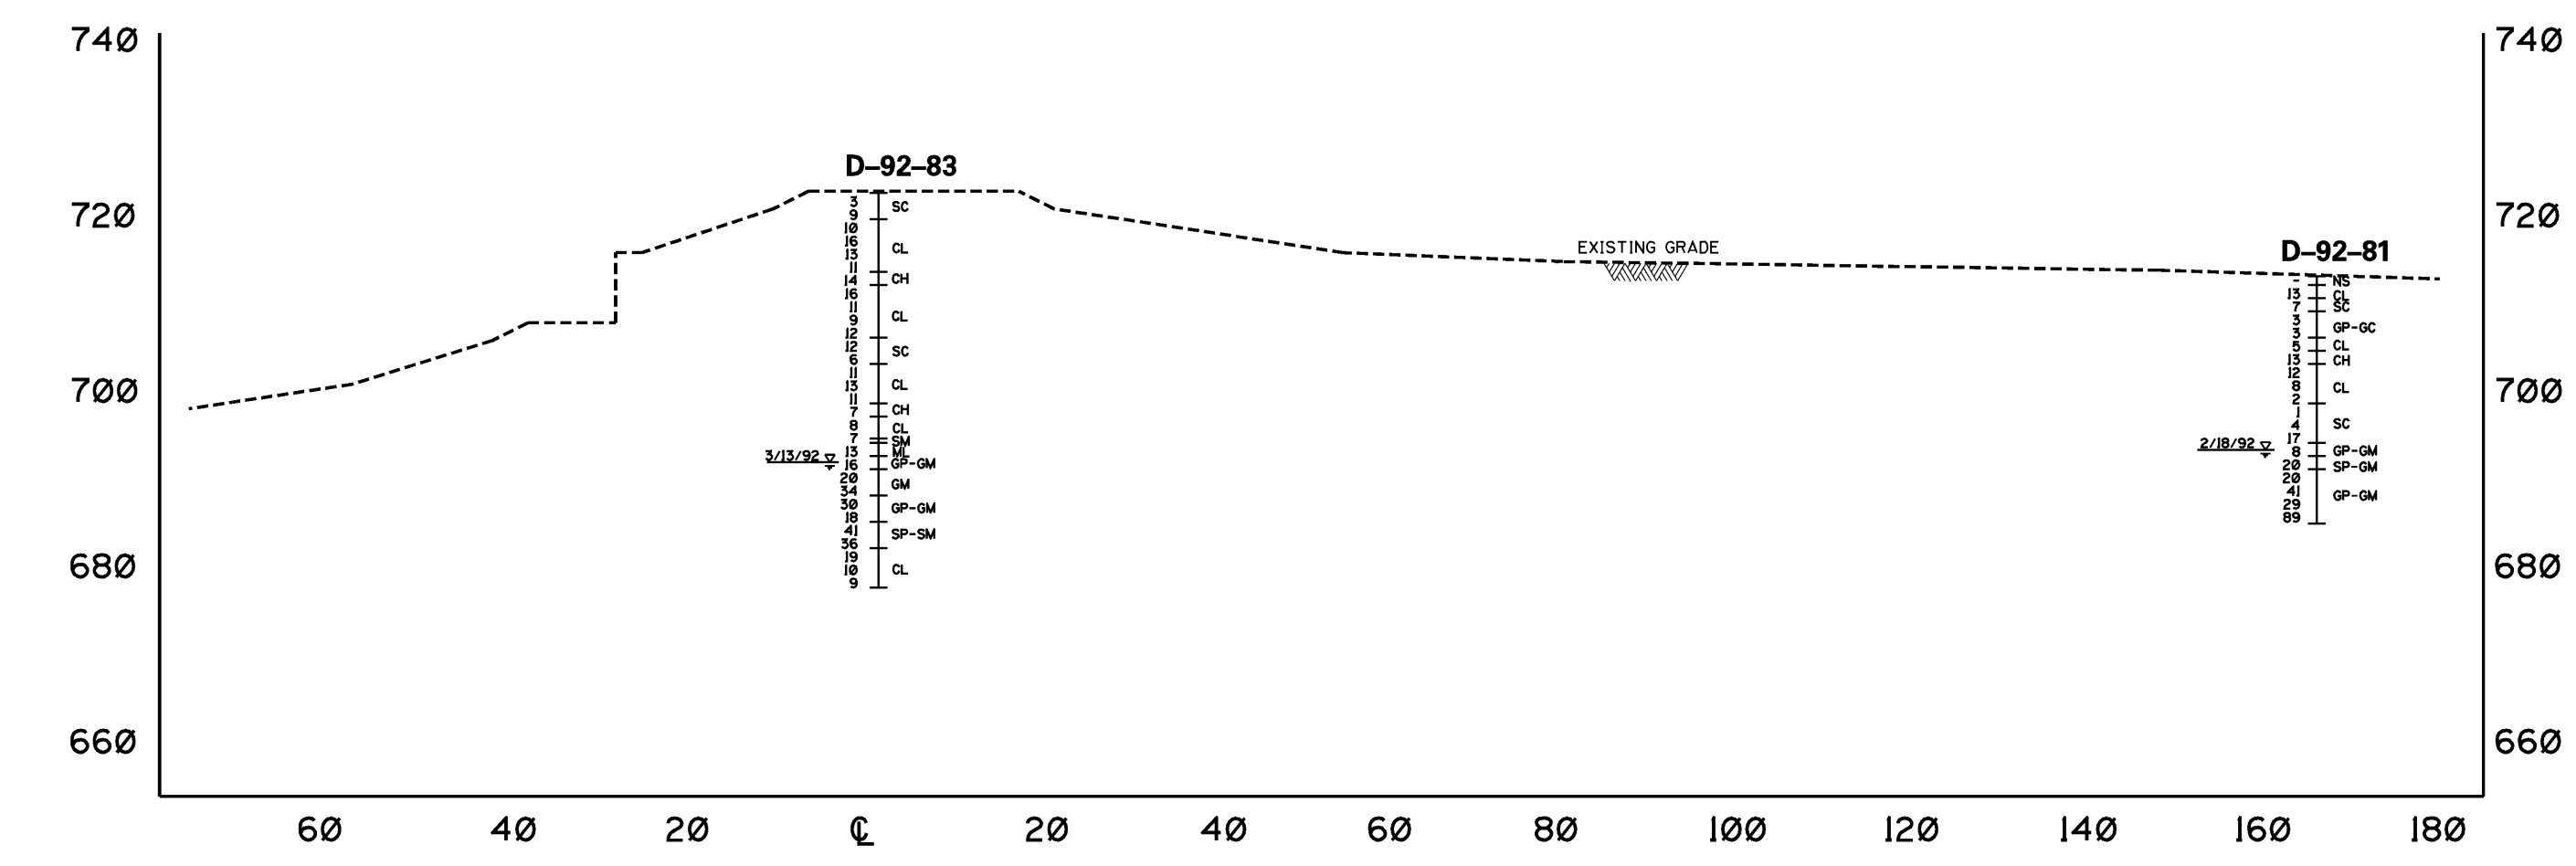

GEOLOGIC SECTION E-E'
STATION 199+00

Revisions			
Symbol	Descriptions	Date	Approved

U.S. ARMY ENGINEER DISTRICT CORPS OF ENGINEERS HUNTINGTON, WEST VIRGINIA		SCIOTO RIVER COLUMBUS, OHIO WEST COLUMBUS, L.P.P. PHASE IID	
Designed by: GAH		GEOLOGIC SECTIONS	
Drawn by: JER			
Checked by: GAH			
Reviewed by:			
Approved by:	Scale: AS SHOWN	Sheet reference number: 10/14	FILENAME: sections.dgn
Date: MARCH 1997	Drawing Code: 016-PWC-10	Sheet 3 of 4	1

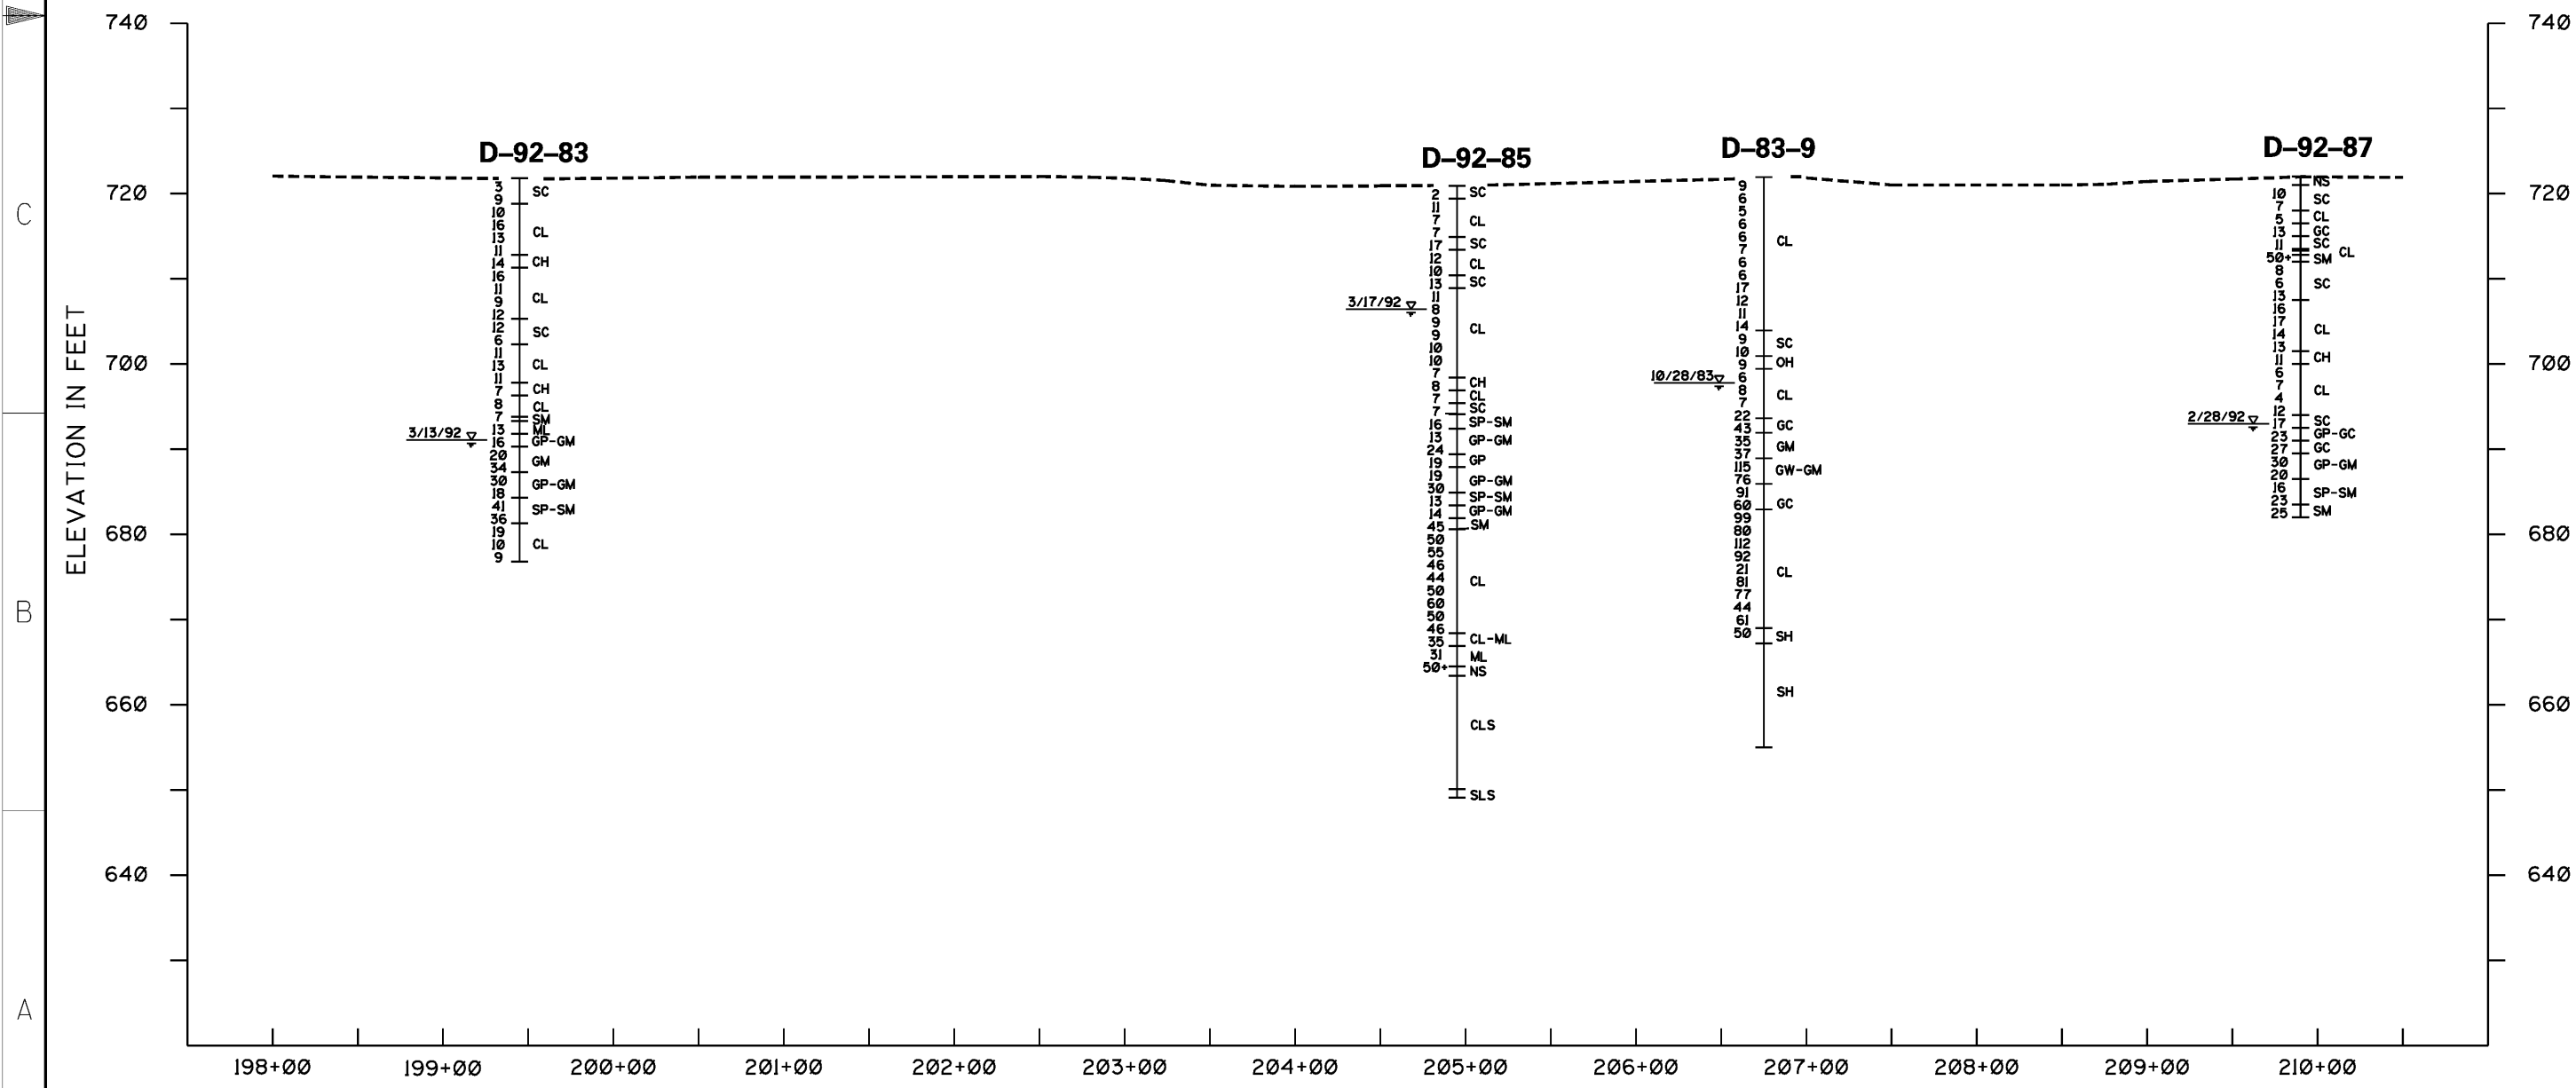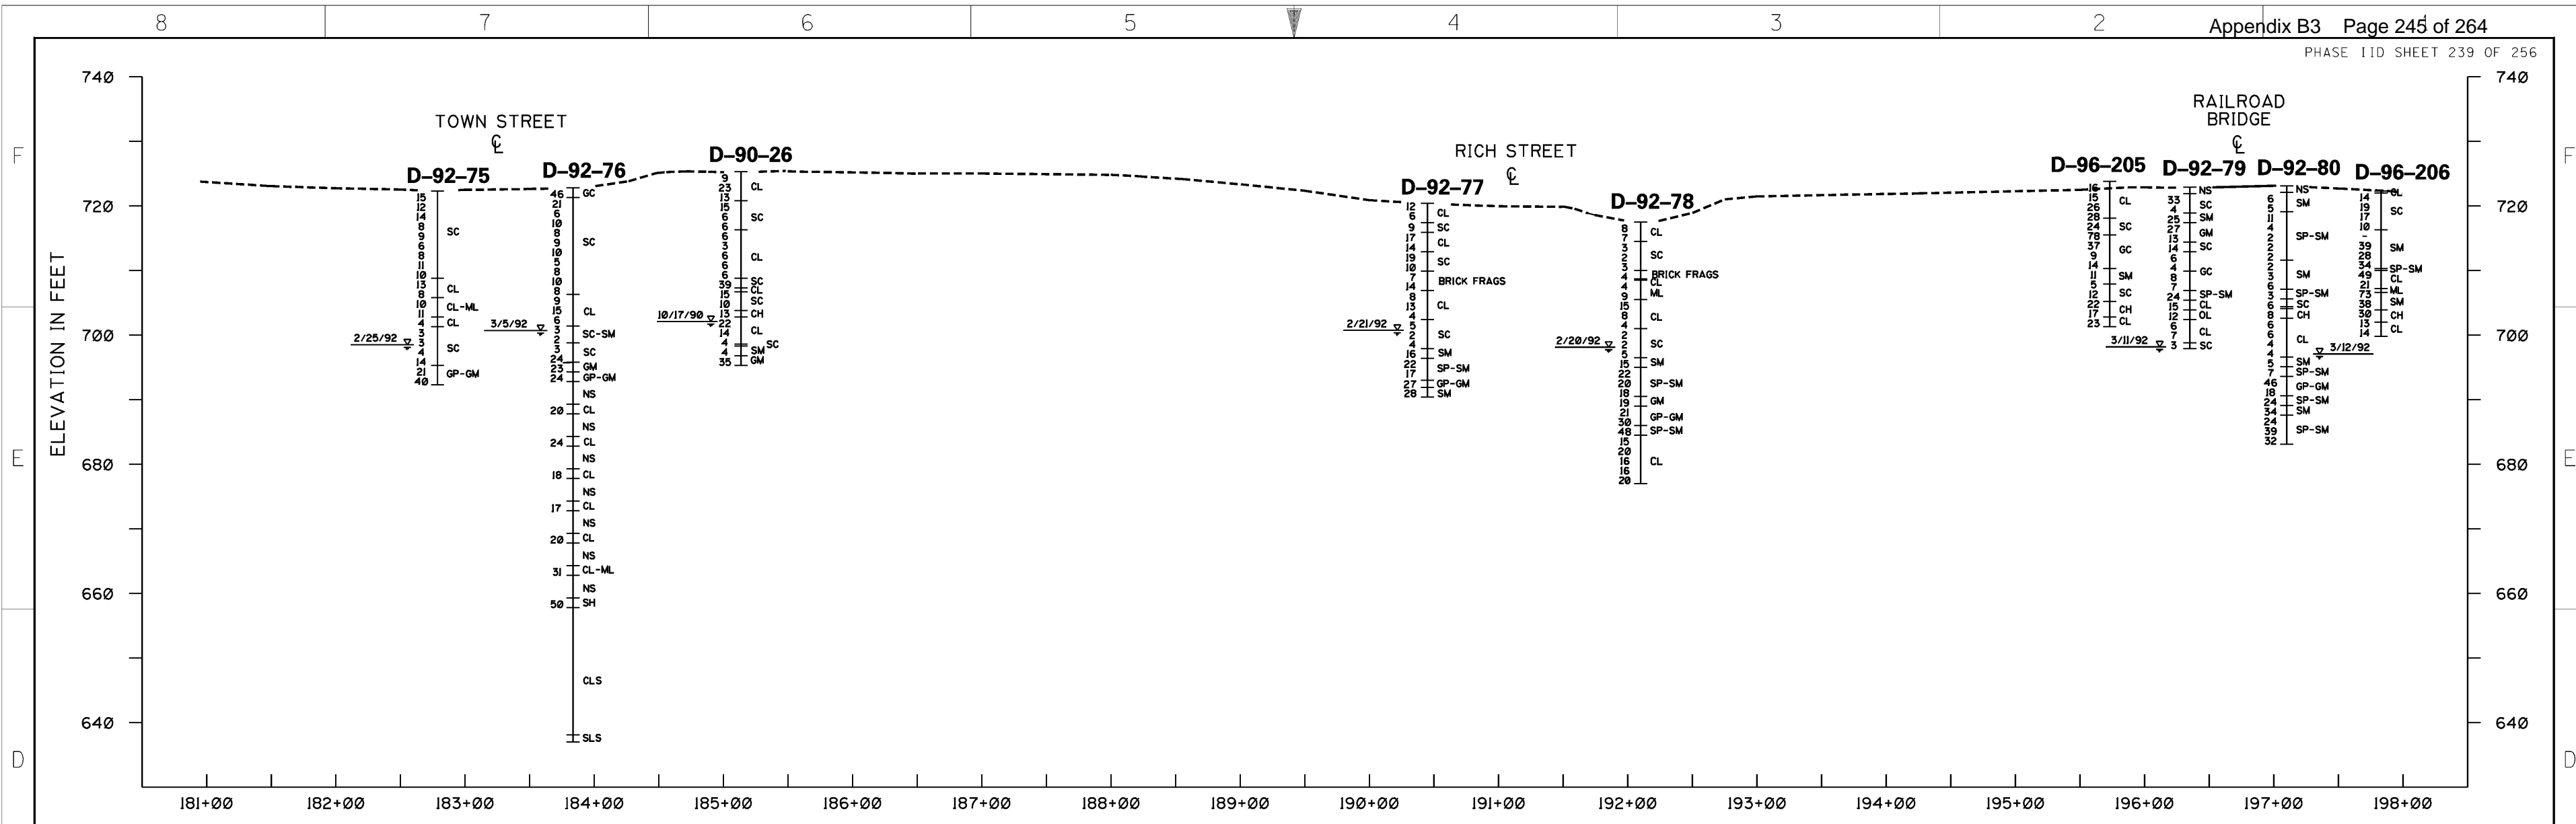

Revisions			
Symbol	Descriptions	Date	Approved

**U.S. ARMY ENGINEER DISTRICT
CORPS OF ENGINEERS
HUNTINGTON, WEST VIRGINIA**


Designed by: GAH
 Drawn by: JER
 Checked by: GAH
 Reviewed by: _____
 Approved by: _____

**SCIO TO RIVER
COLUMBUS, OHIO
WEST COLUMBUS, L.P.P.
PHASE IID**

GEOLOGIC PROFILE H-H'

Scale: AS SHOWN
 Date: MARCH 1997
 Drawing Code: O16-PWC-10

Sheet reference number: 10/17
 FILENAME: profile.dgn
 Sheet 2 of 3

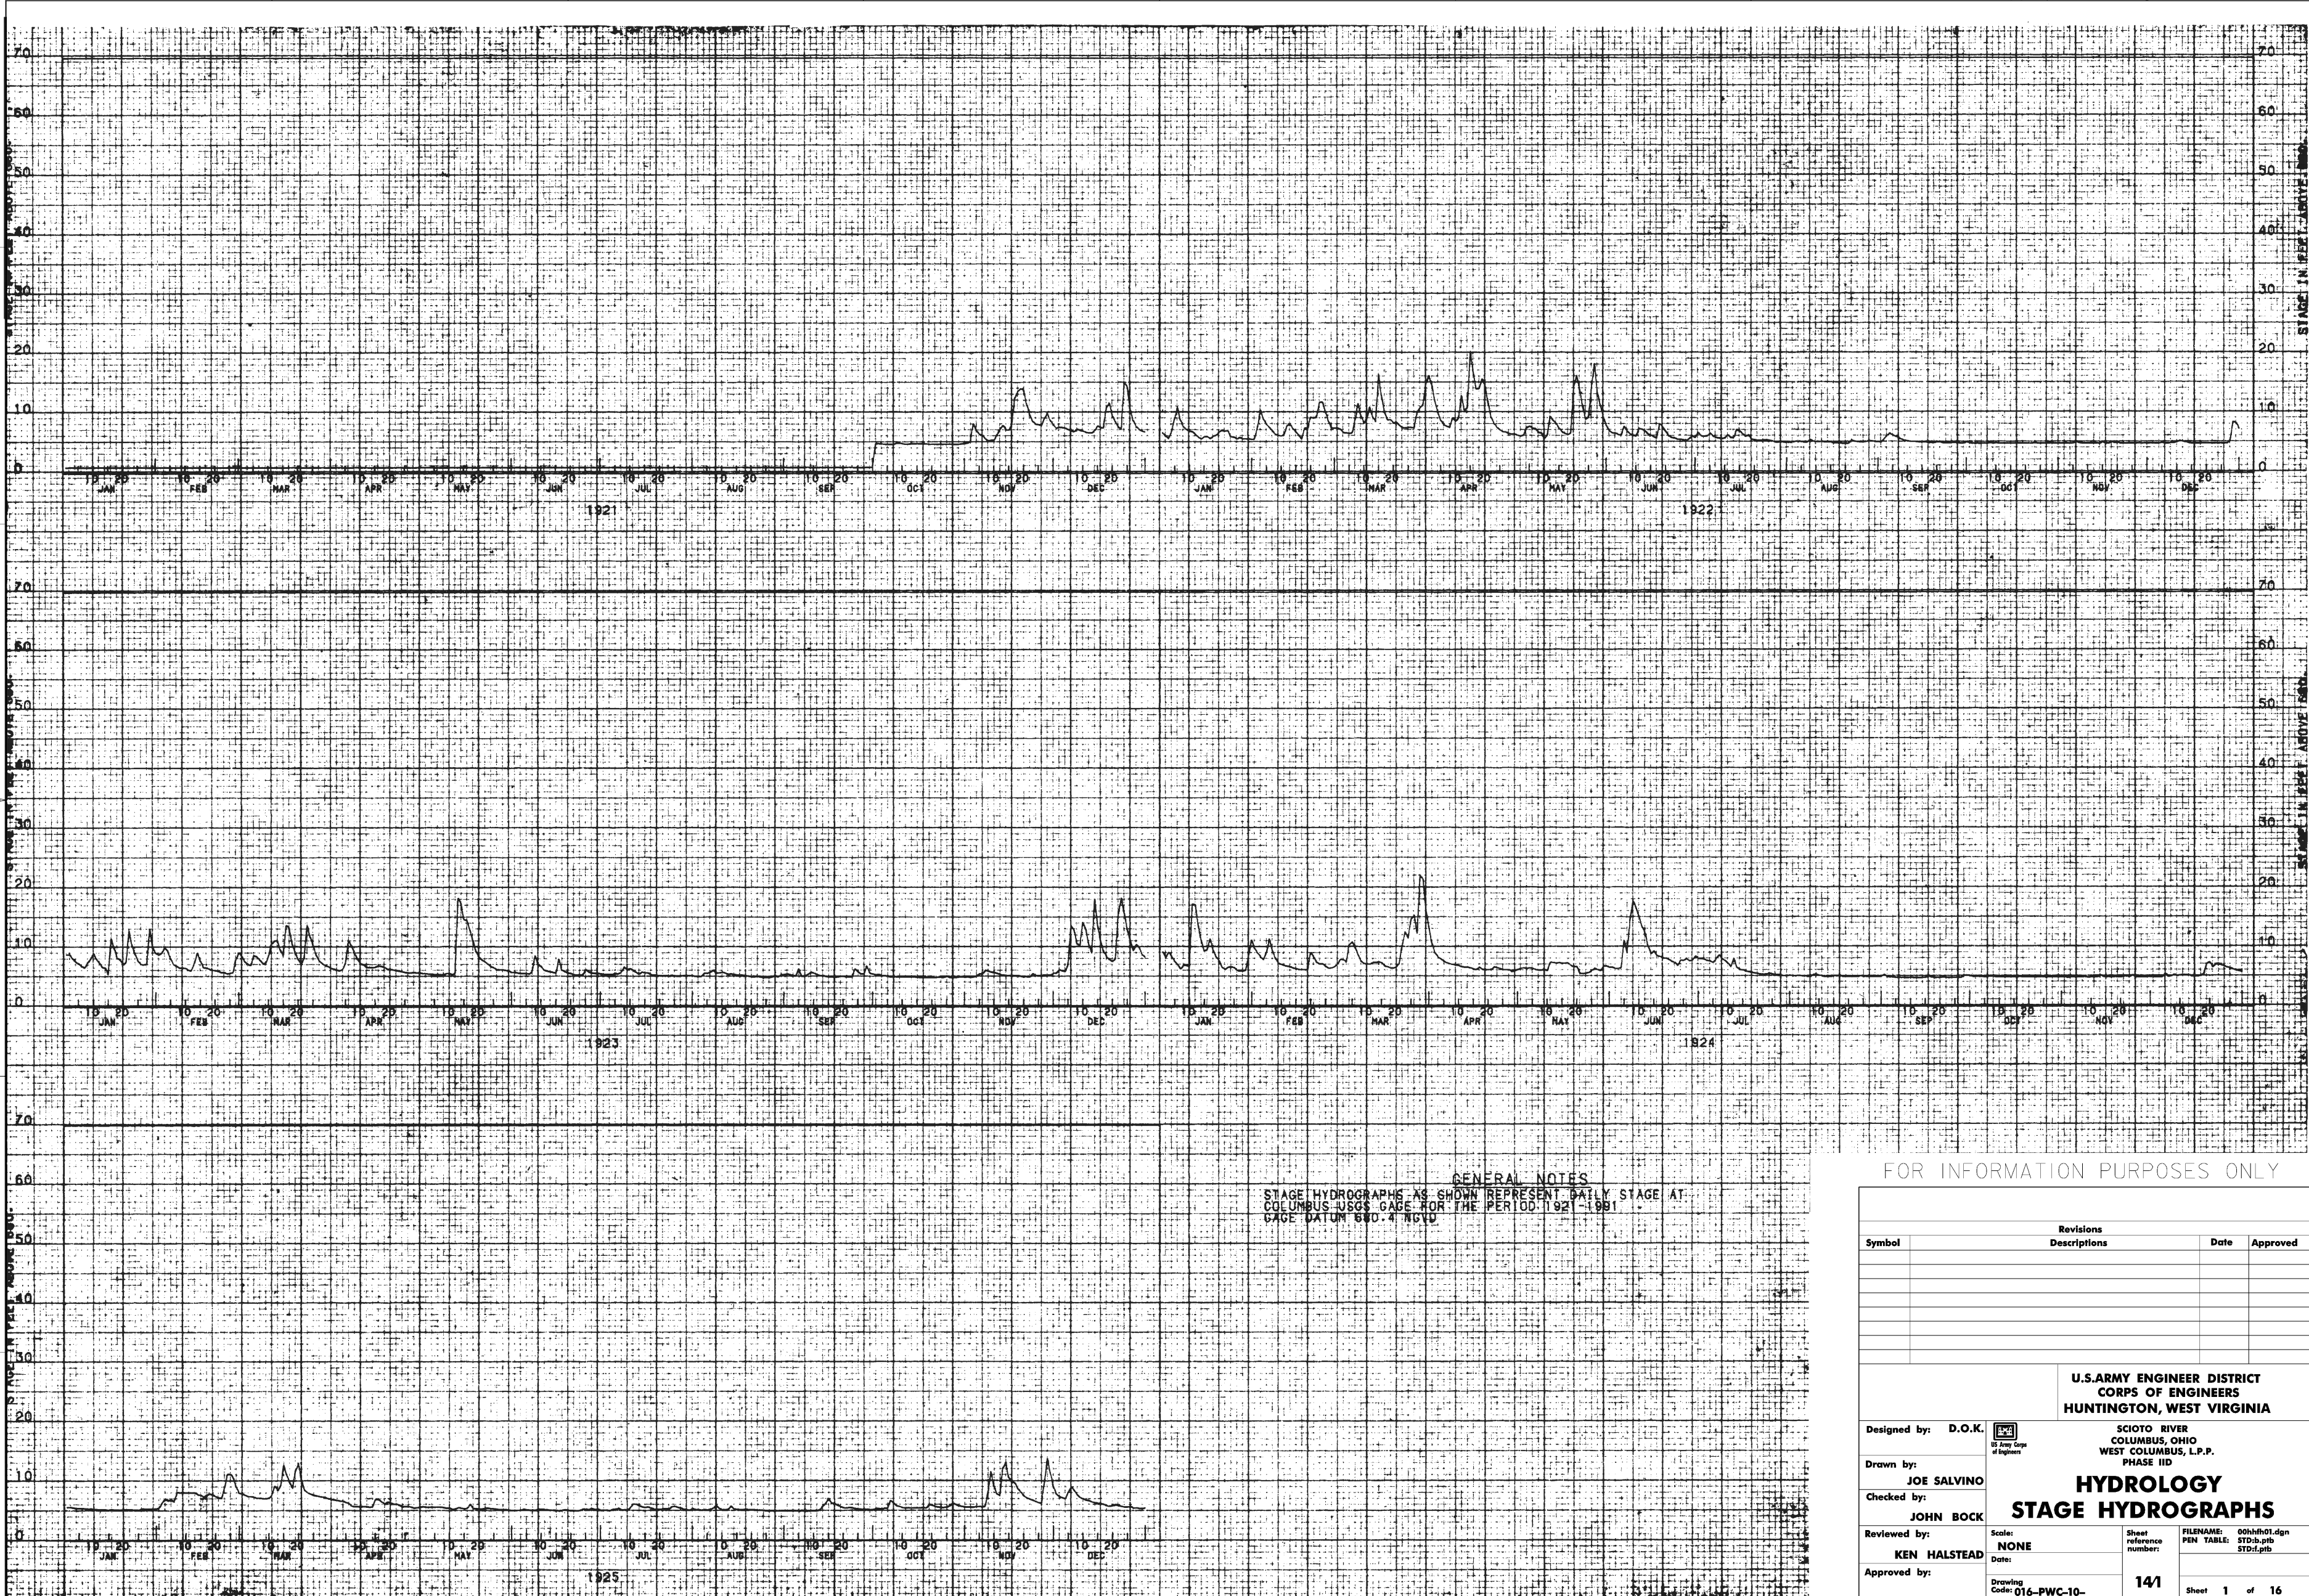

GENERAL NOTES
 STAGE HYDROGRAPHS AS SHOWN REPRESENT DAILY STAGE AT
 COLUMBUS USGS GAGE FOR THE PERIOD 1921-1991
 GAGE DATUM 680.4 NGVD

FOR INFORMATION PURPOSES ONLY

Symbol	Revisions Descriptions	Date	Approved

U.S. ARMY ENGINEER DISTRICT
 CORPS OF ENGINEERS
 HUNTINGTON, WEST VIRGINIA

SCIO TO RIVER
 COLUMBUS, OHIO
 WEST COLUMBUS, L.P.P.
 PHASE IID

HYDROLOGY
STAGE HYDROGRAPHS

Designed by: D.O.K.
 Drawn by: JOE SALVINO
 Checked by: JOHN BOCK
 Reviewed by: KEN HALSTEAD
 Approved by:

Scale: NONE
 Date:

Sheet reference number: 141

FILENAME: 00hth01.dgn
 PEN TABLE: STD-b-pib
 STD-d-pib

Drawing Code: 016-PWC-10-
 Sheet 1 of 16



GENERAL NOTES
 STAGE HYDROGRAPHS AS SHOWN REPRESENT DAILY STAGE AT
 COLUMBUS USGS GAGE FOR THE PERIOD 1921-1991
 GAGE DATUM S.W.O. 4 NGVD

FOR INFORMATION PURPOSES ONLY

Symbol	Revisions		Date	Approved
	Descriptions			

U.S. ARMY ENGINEER DISTRICT CORPS OF ENGINEERS HUNTINGTON, WEST VIRGINIA			
SCIO TO RIVER COLUMBUS, OHIO WEST COLUMBUS, L.P.P. PHASE IID			
HYDROLOGY STAGE HYDROGRAPHS			
Designed by: D.O.K.		Scale: NONE	Sheet reference number: 142
Drawn by: JOE SALVINO		Date:	FILENAME: 00hth02.dgn PEN TABLE: STD-b-pib STD-d-pib
Checked by: JOHN BOCK			
Reviewed by: KEN HALSTEAD			
Approved by:		Drawing Code: 016-PWC-10-	Sheet 2 of 16



GENERAL NOTES
 STAGE HYDROGRAPHS AS SHOWN REPRESENT DAILY STAGE AT
 COLUMBUS USGS GAGE FOR THE PERIOD 1921-1991
 GAGE DATUM 680.4 NGVD

FOR INFORMATION PURPOSES ONLY

Symbol	Revisions Descriptions	Date	Approved


Designed by: **D.O.K.**
 Drawn by: **JOE SALVINO**
 Checked by: **JOHN BOCK**
 Reviewed by: **KEN HALSTEAD**
 Approved by:

Scale: **NONE**
 Date:

Drawing Code: **016-PWC-10-**

U.S. ARMY ENGINEER DISTRICT
 CORPS OF ENGINEERS
 HUNTINGTON, WEST VIRGINIA
 SCIOTO RIVER
 COLUMBUS, OHIO
 WEST COLUMBUS, L.P.P.
 PHASE IIC
HYDROLOGY
STAGE HYDROGRAPHS

Sheet reference number: **143**
 FILENAME: 00hth03.dgn
 PEN TABLE: STD-pb.tbl
 STD-d.tbl
 Sheet **3** of **16**

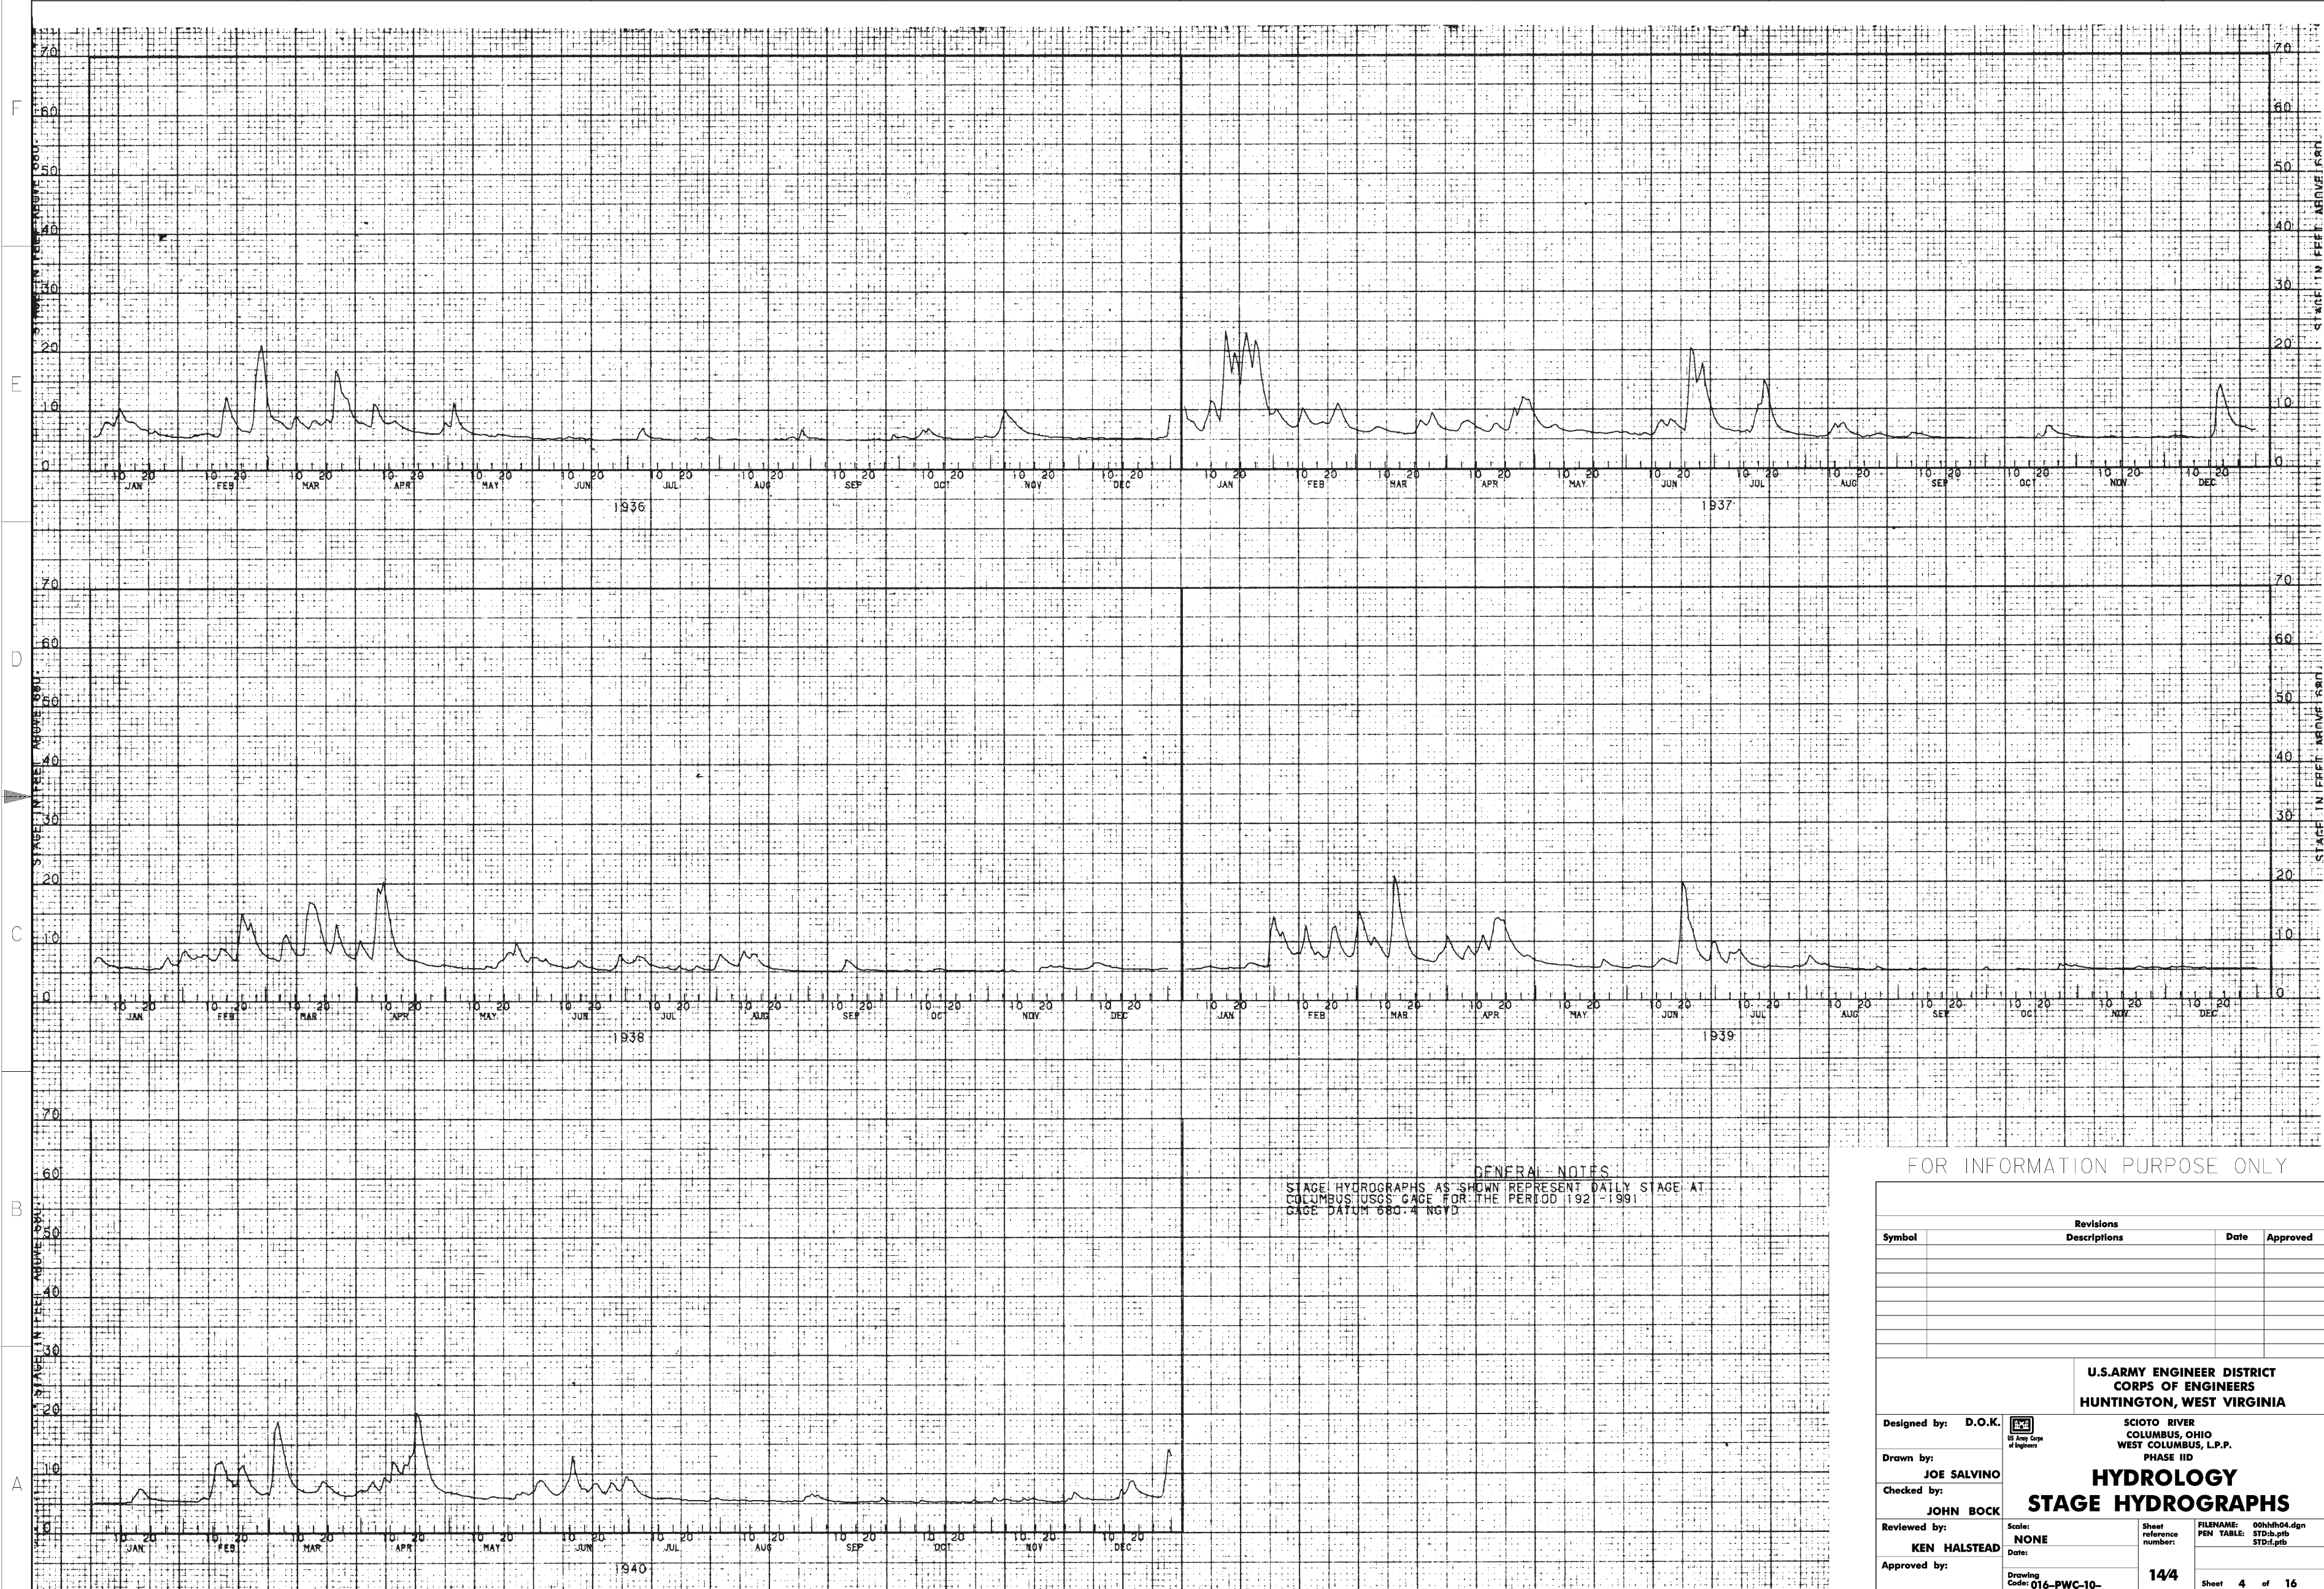

GENERAL NOTES
 STAGE HYDROGRAPHS AS SHOWN REPRESENT DAILY STAGE AT
 COLUMBUS USGS GAGE FOR THE PERIOD 1921-1991
 GAGE DATUM 680.4 NGVD

FOR INFORMATION PURPOSE ONLY

Symbol	Revisions		Date	Approved
	Descriptions			

U.S. ARMY ENGINEER DISTRICT
CORPS OF ENGINEERS
HUNTINGTON, WEST VIRGINIA

SCIO TO RIVER
 COLUMBUS, OHIO
 WEST COLUMBUS, L.P.P.
 PHASE IID

HYDROLOGY
STAGE HYDROGRAPHS

Designed by: **D.O.K.**
 Drawn by: **JOE SALVINO**
 Checked by: **JOHN BOCK**
 Reviewed by: **KEN HALSTEAD**
 Approved by:


Scale: **NONE**
 Date:

Drawing Code: **016-PWC-10-**

Sheet reference number: **144**

FILENAME: 00hth04.dgn
 PEN TABLE: STD-b.ptb
 STD-d.ptb

Sheet **4** of **16**

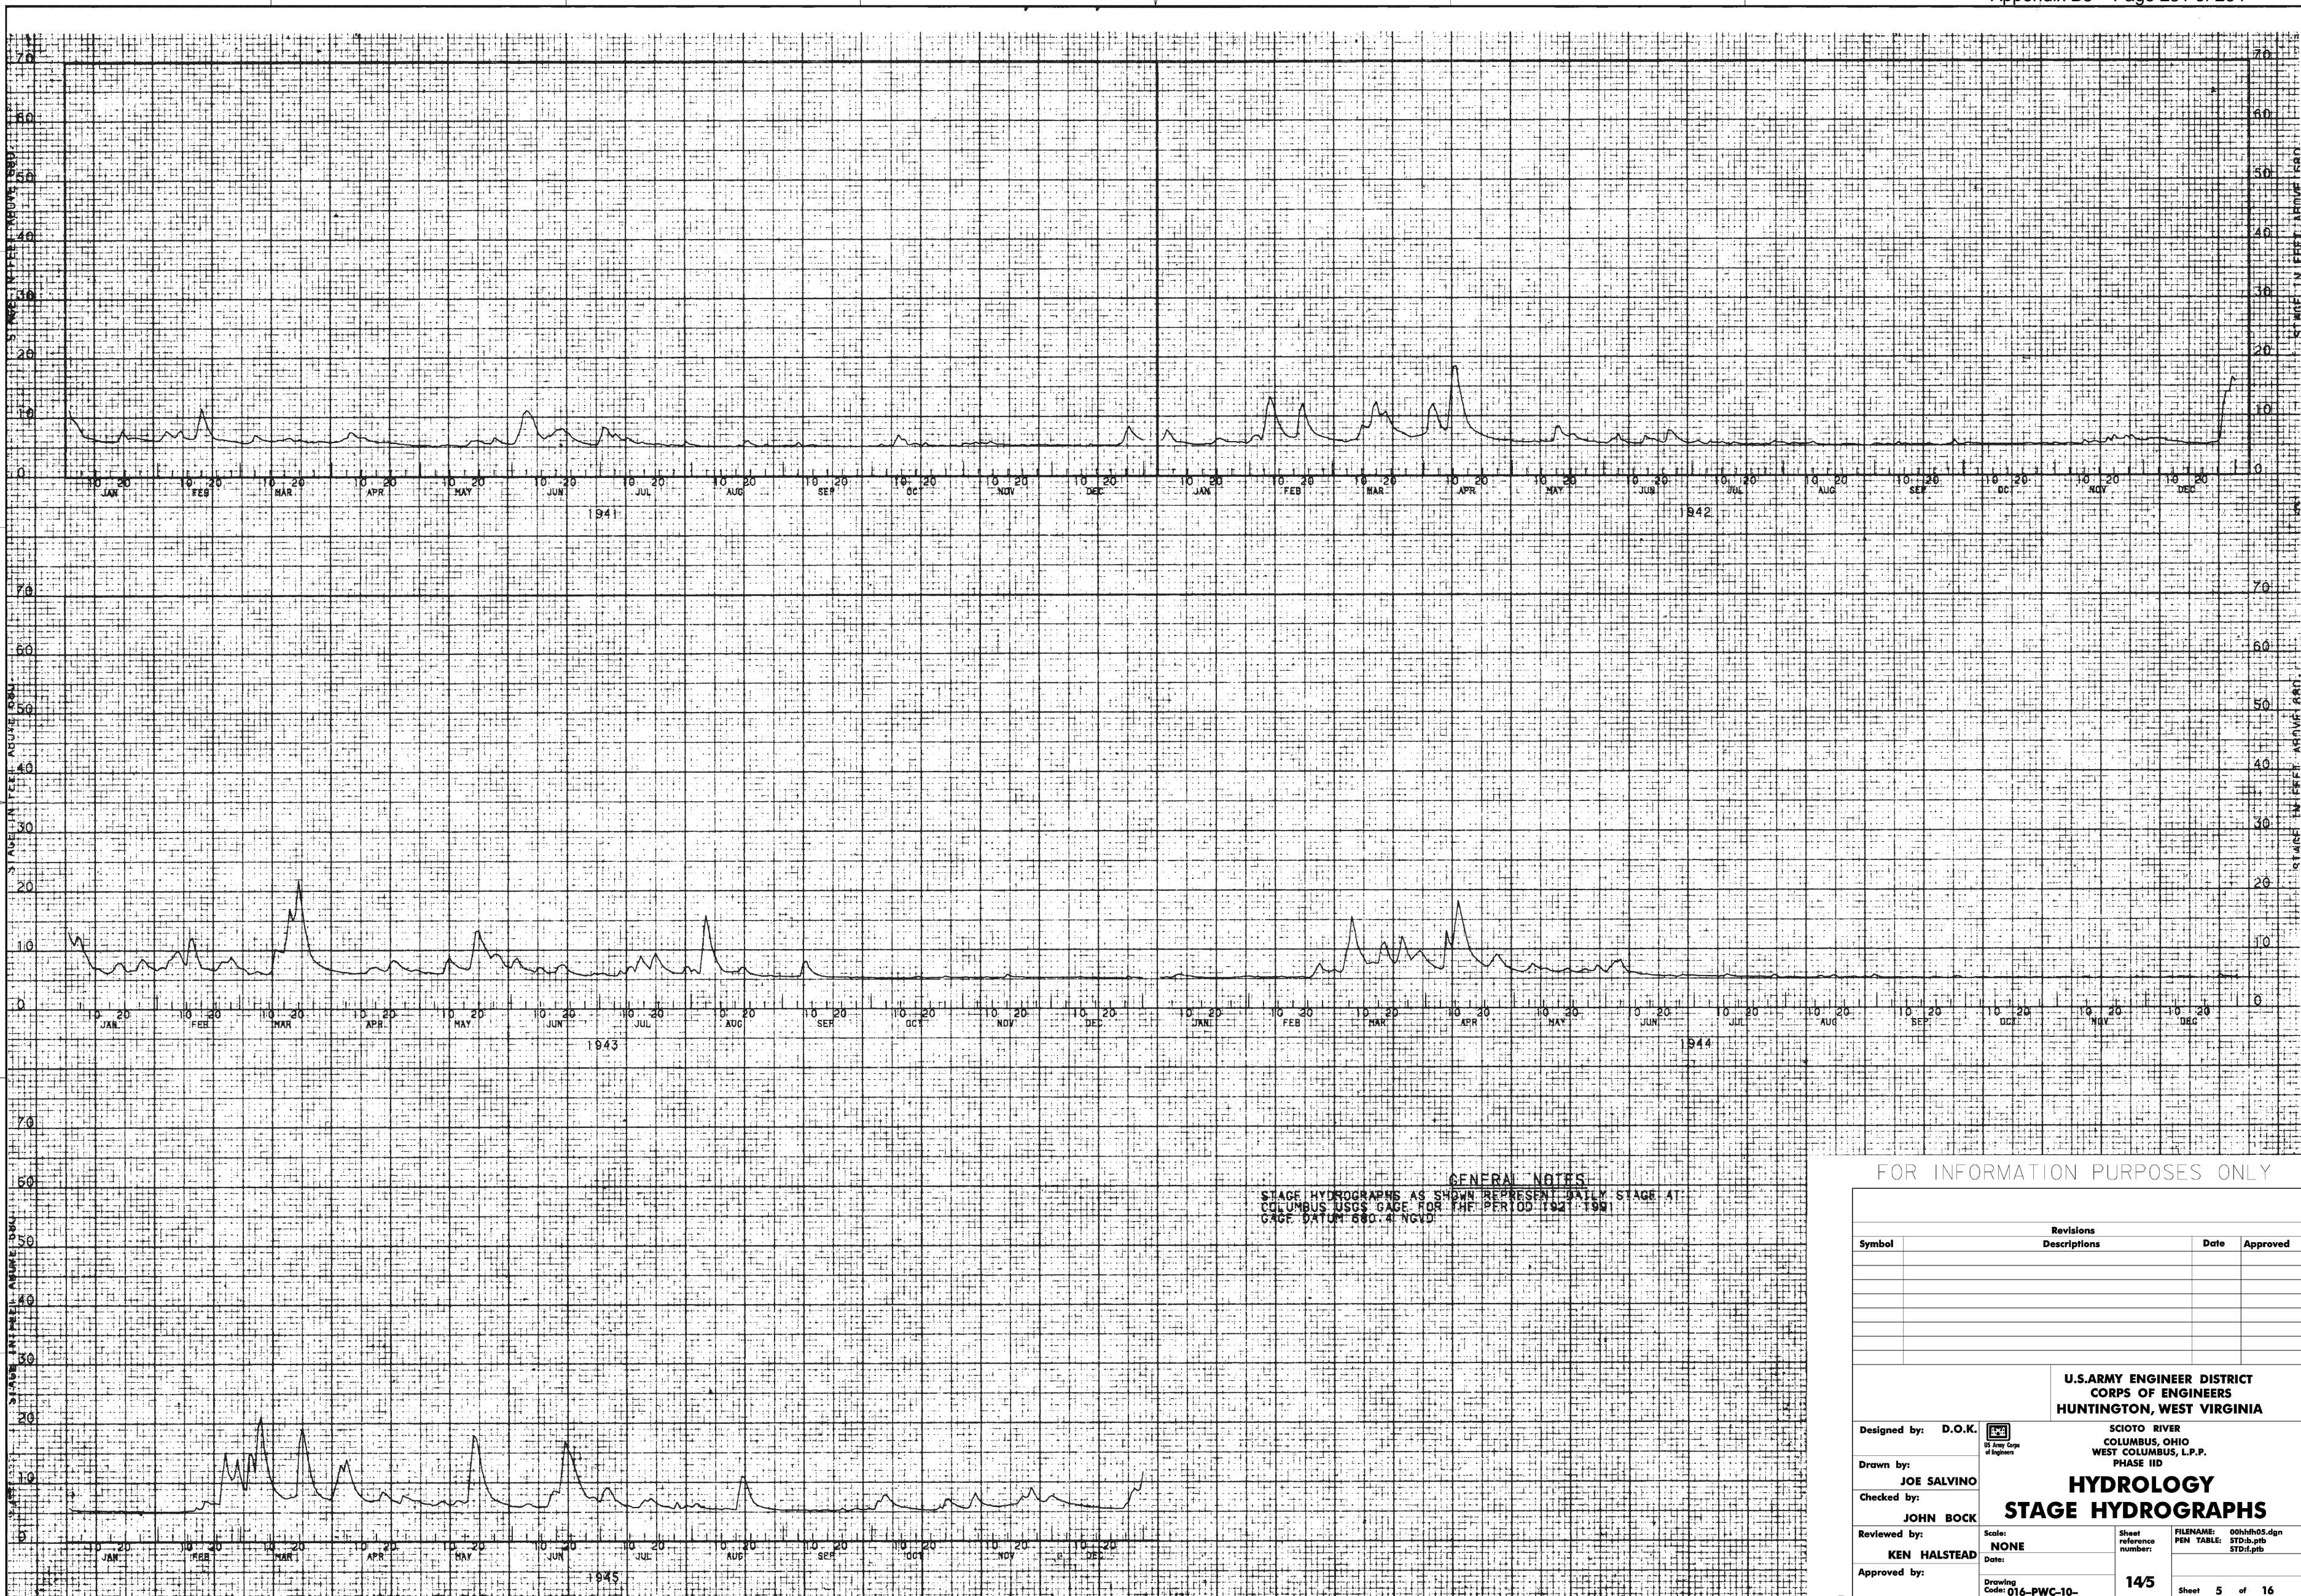

GENERAL NOTES
 STAGE HYDROGRAPHS AS SHOWN REPRESENT DAILY STAGE AT COLUMBUS USGS GAGE FOR THE PERIOD 1941-1944. GAGE DATUM 680.4 NGVD.

FOR INFORMATION PURPOSES ONLY

Symbol	Revisions Descriptions	Date	Approved

U.S. ARMY ENGINEER DISTRICT
CORPS OF ENGINEERS
HUNTINGTON, WEST VIRGINIA

SCIO TO RIVER
 COLUMBUS, OHIO
 WEST COLUMBUS, L.P.P.
 PHASE IID

HYDROLOGY
STAGE HYDROGRAPHS


Designed by: **D.O.K.**
 Drawn by: **JOE SALVINO**
 Checked by: **JOHN BOCK**
 Reviewed by: **KEN HALSTEAD**
 Approved by:

Scale: **NONE**
 Date:

Drawing Code: **016-PWC-10-**

Sheet reference number: **145**
 FILENAME: 00hth05.dgn
 PEN TABLE: STD-pb-pib
 STD-pib

Sheet **5** of **16**

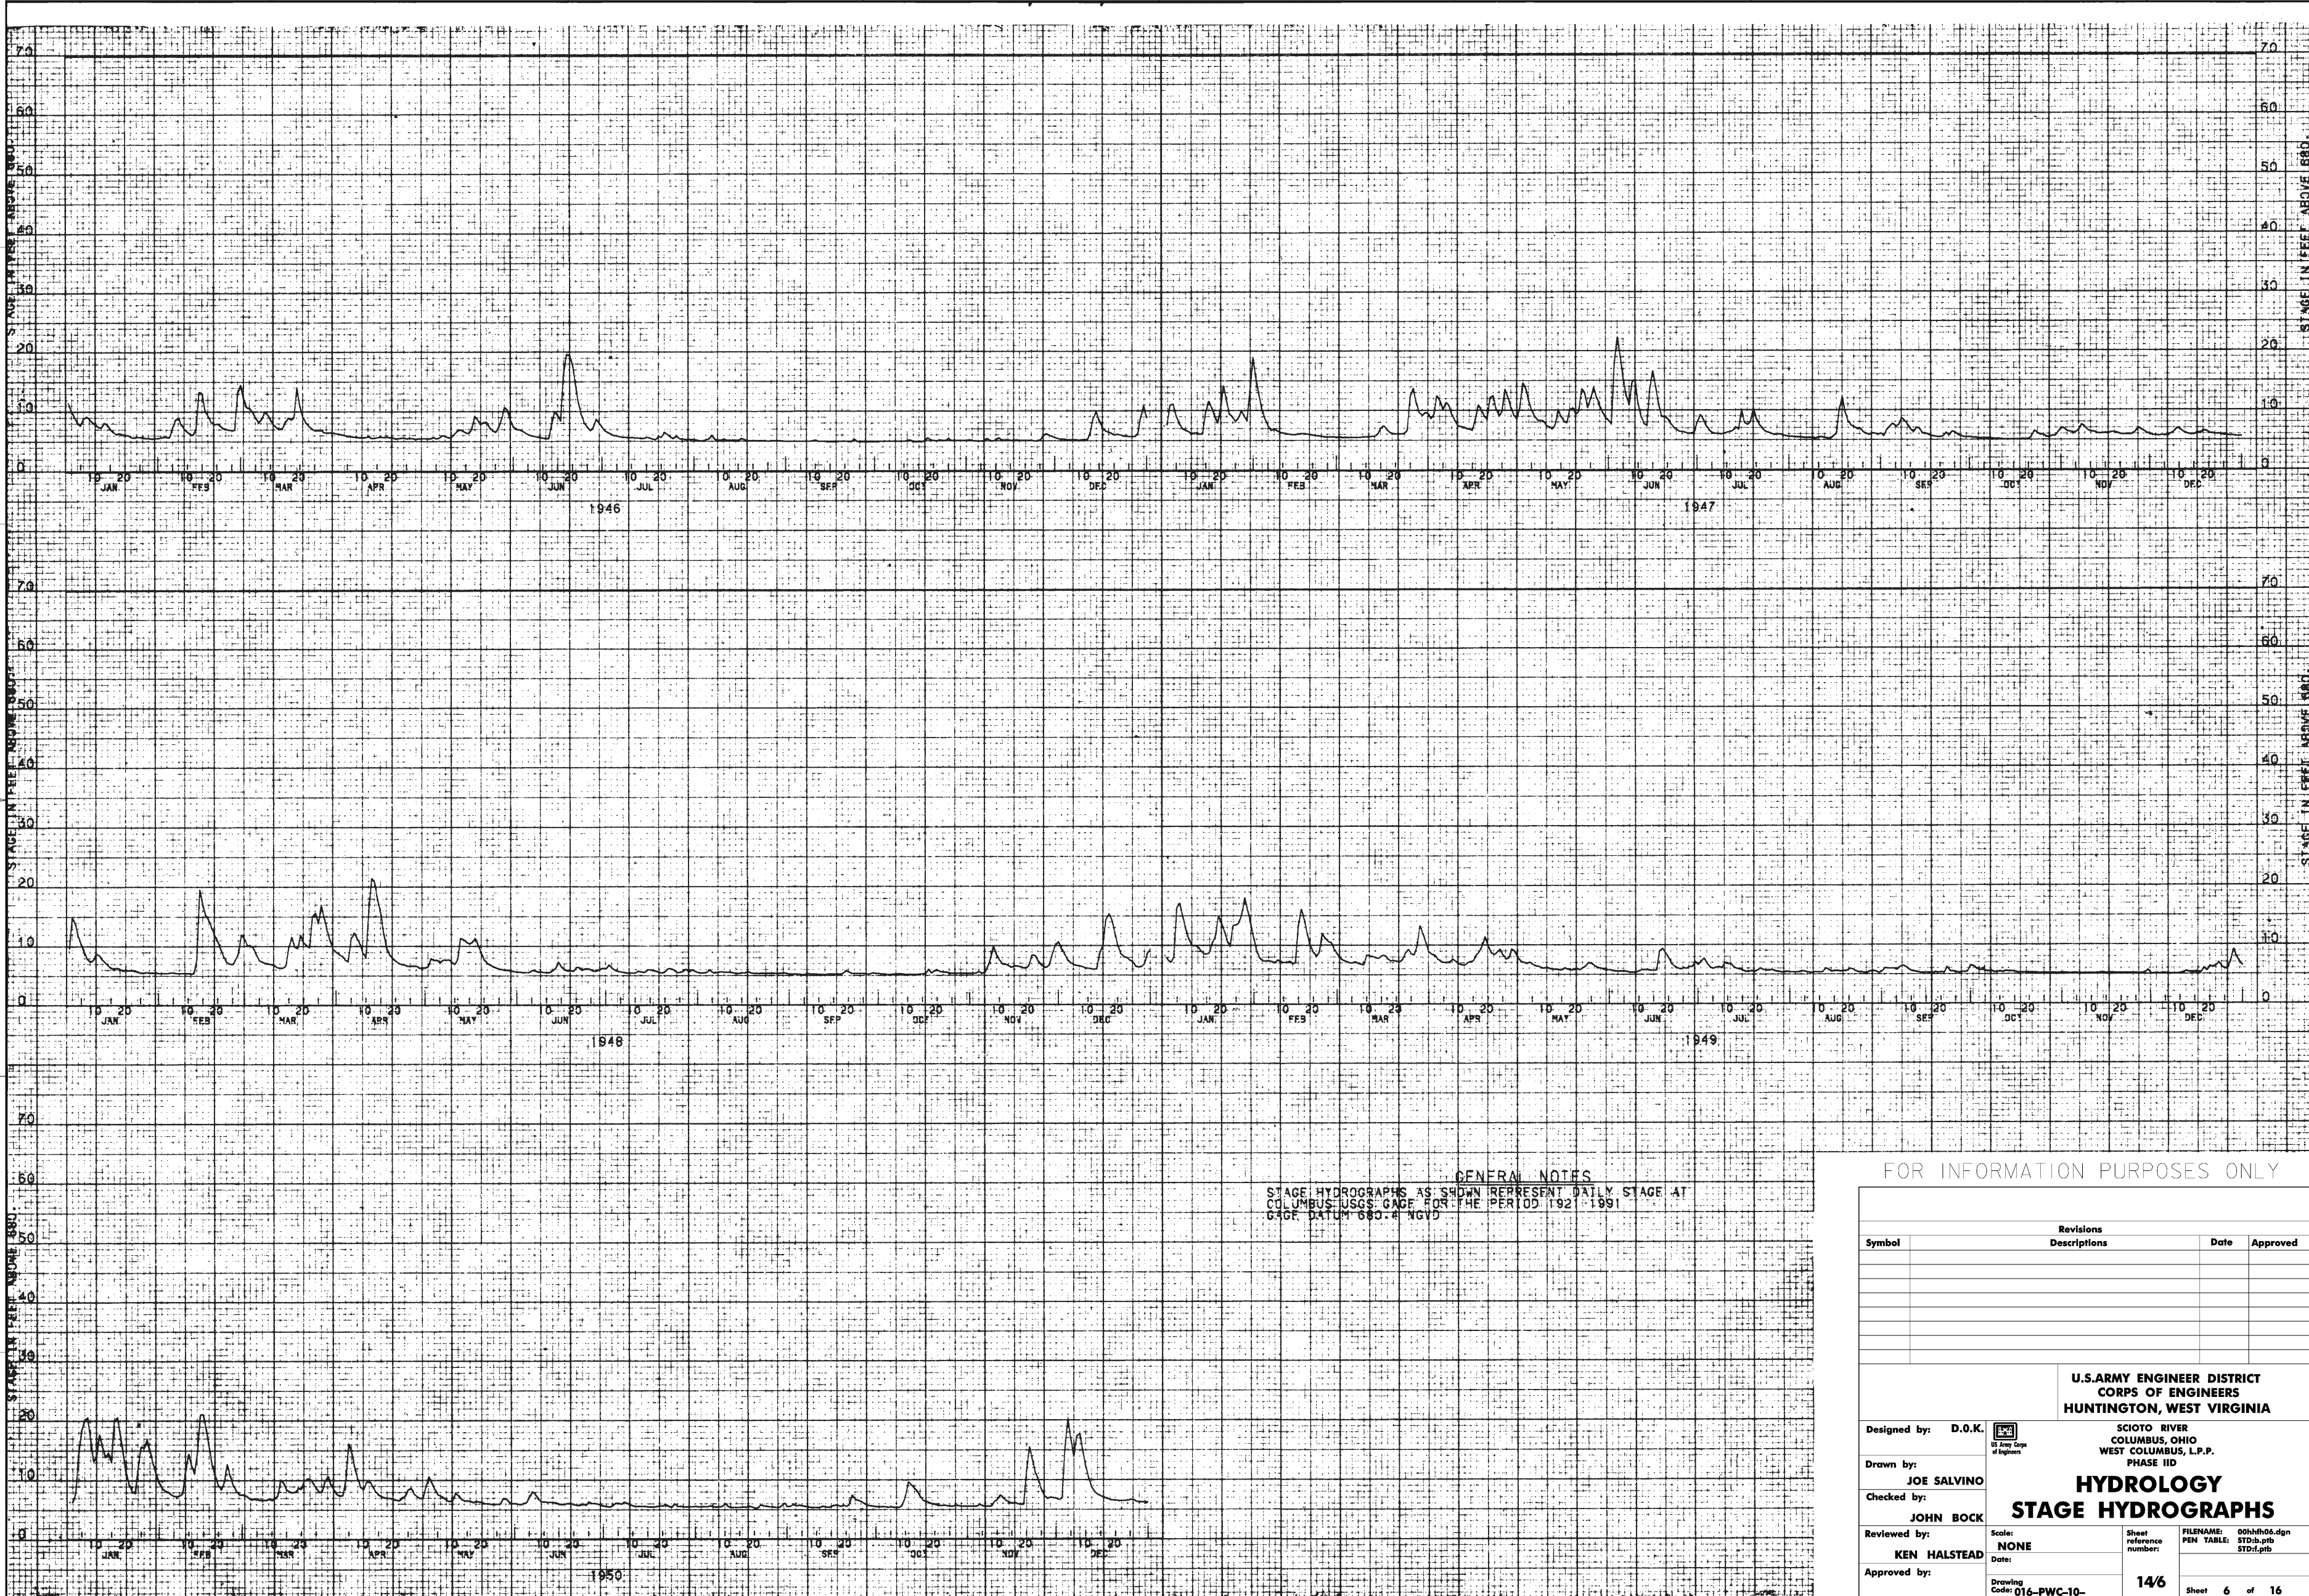

GENERAL NOTES
 STAGE HYDROGRAPHS AS SHOWN REPRESENT DAILY STAGE AT
 COLUMBUS USGS GAGE FOR THE PERIOD 1921-1991
 GAGE DATUM 880.4 NGVD

FOR INFORMATION PURPOSES ONLY

Symbol	Revisions		Date	Approved
	Descriptions			

U.S. ARMY ENGINEER DISTRICT
CORPS OF ENGINEERS
HUNTINGTON, WEST VIRGINIA

SCIO TO RIVER
 COLUMBUS, OHIO
 WEST COLUMBUS, L.P.P.
 PHASE IID

HYDROLOGY
STAGE HYDROGRAPHS


Designed by: **D.O.K.**
 Drawn by: **JOE SALVINO**
 Checked by: **JOHN BOCK**
 Reviewed by: **KEN HALSTEAD**
 Approved by:

Scale: **NONE**
 Date:

Drawing Code: **016-PWC-10-**

Sheet reference number: **146**
 FILENAME: 00hthf06.dgn
 PEN TABLE: STD-b-pib
 STD-d-pib

Sheet 6 of 16

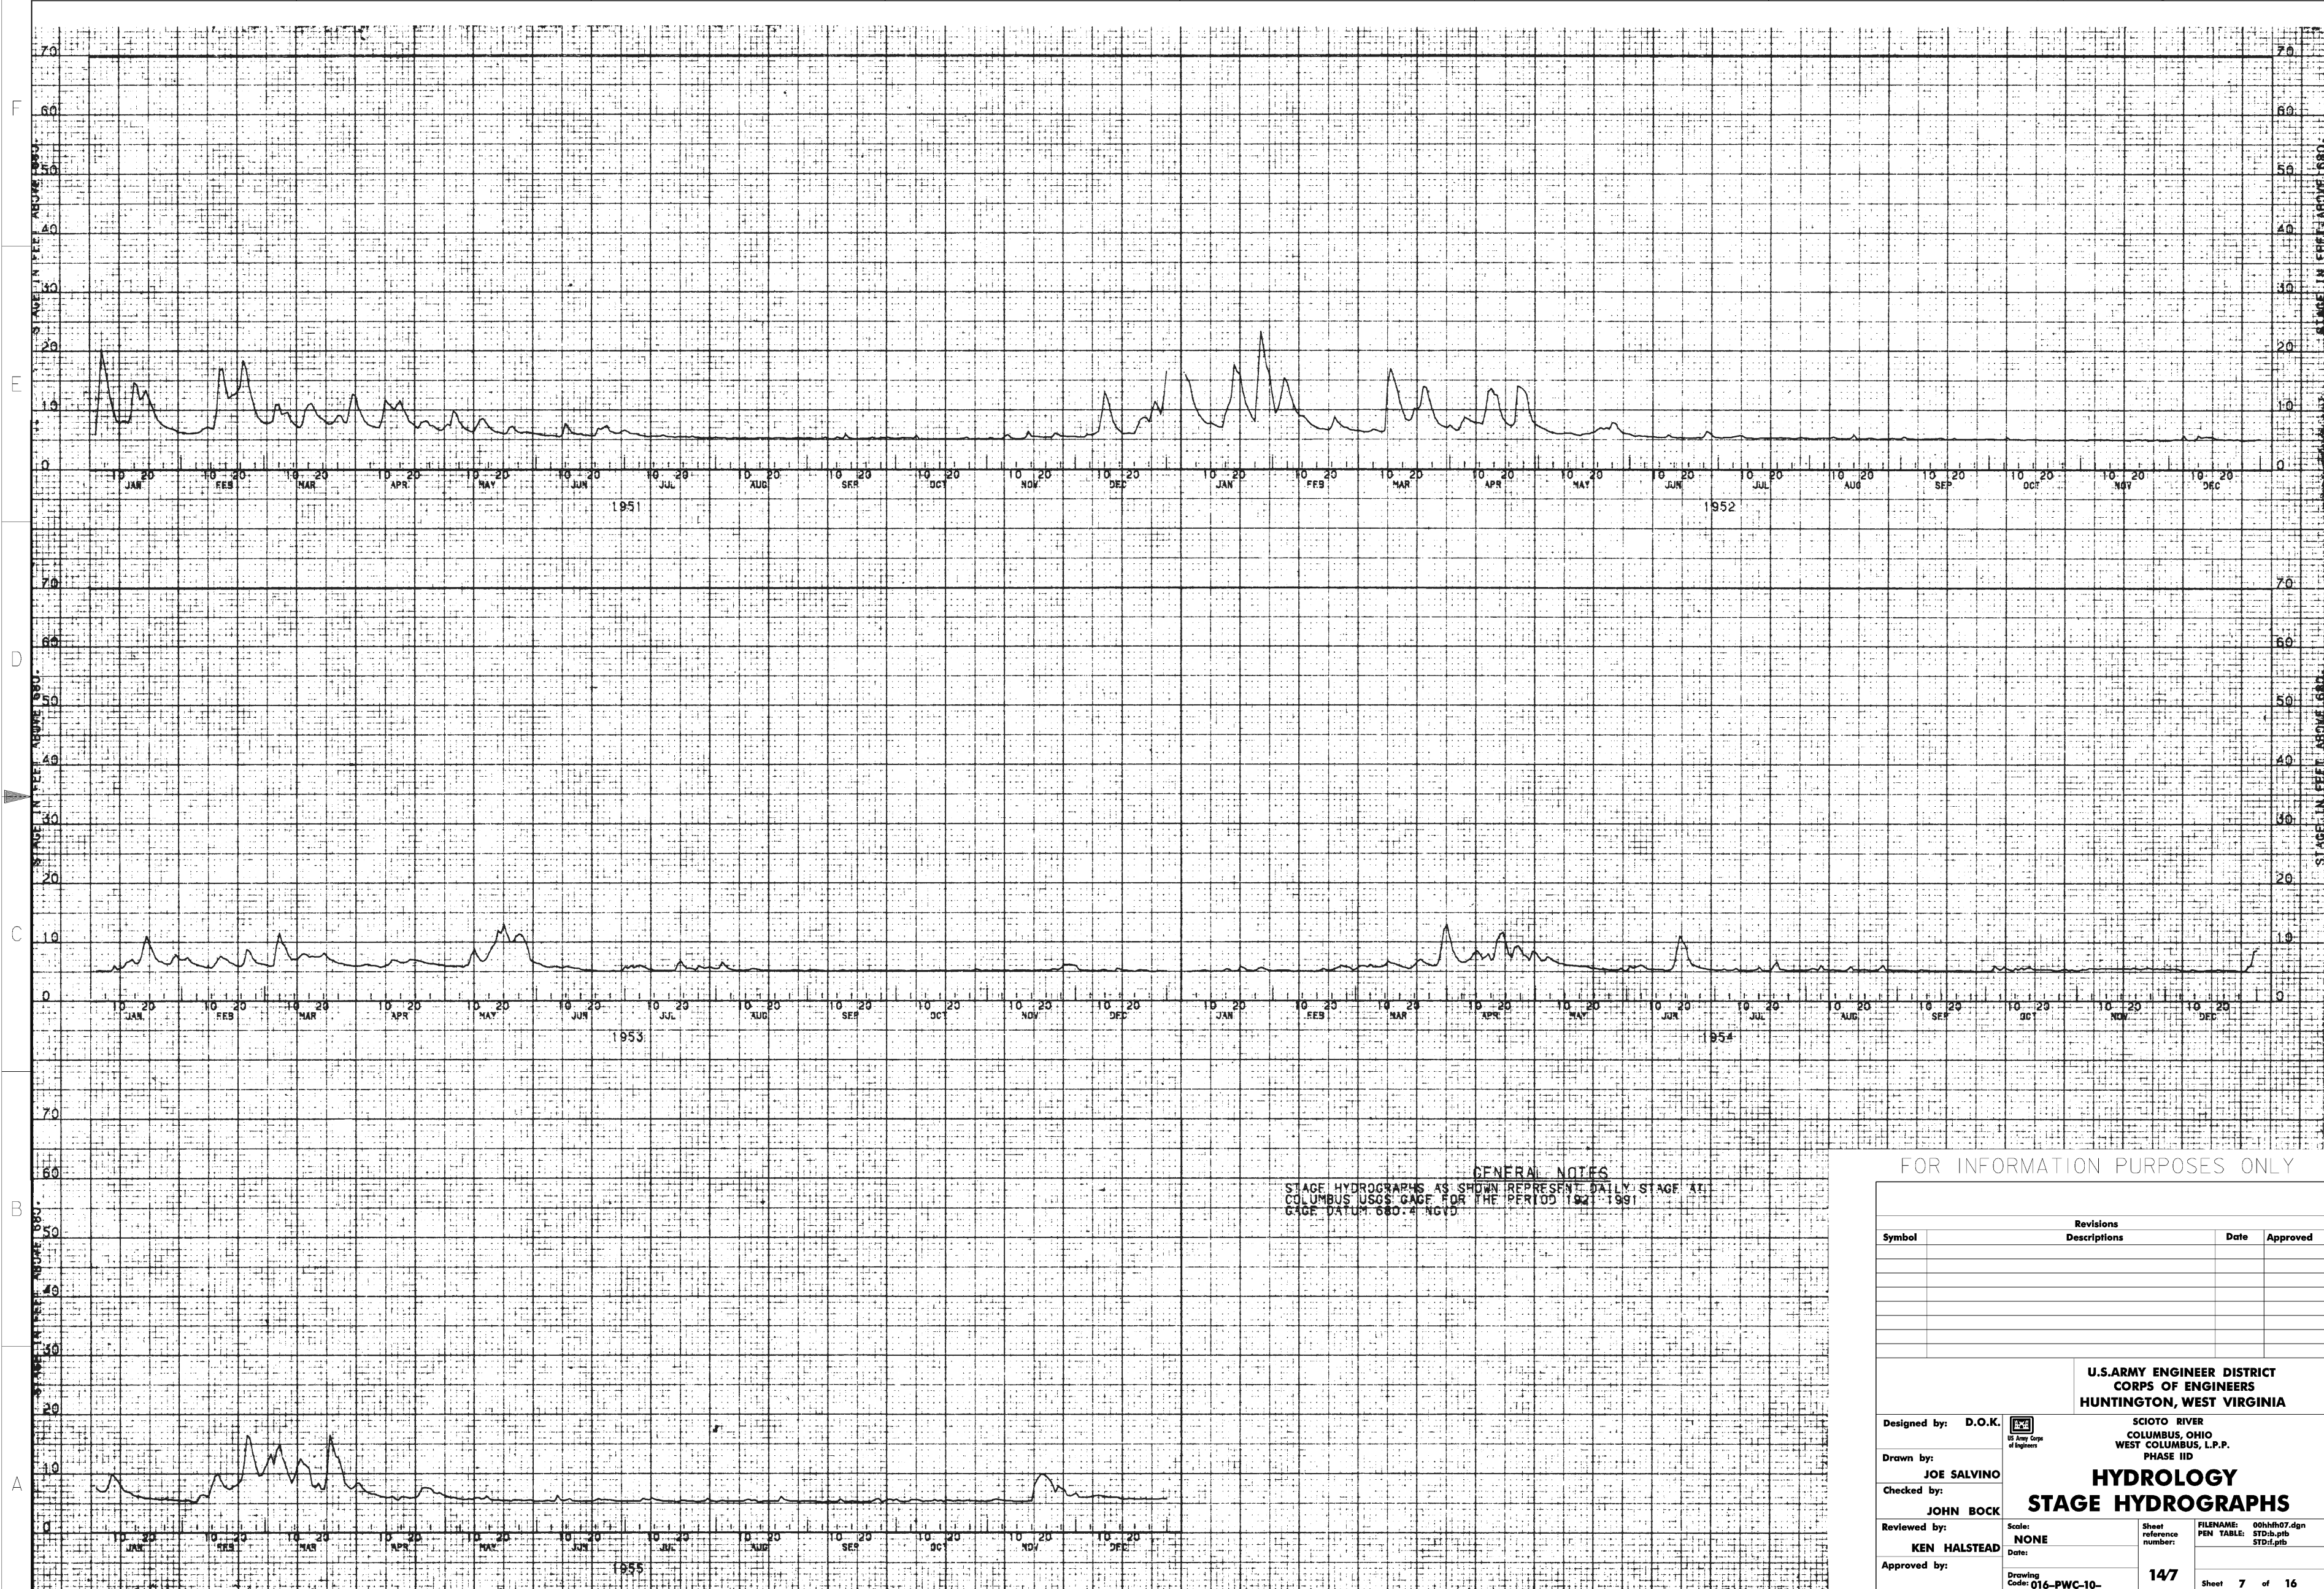

GENERAL NOTES
 STAGE HYDROGRAPHS AS SHOWN REPRESENT DAILY STAGE AT
 COLUMBUS USGS GAGE FOR THE PERIOD 1951-1991
 GAGE DATUM 680.4 NGVD

FOR INFORMATION PURPOSES ONLY

Symbol	Revisions		Date	Approved
	Descriptions			

U.S. ARMY ENGINEER DISTRICT
CORPS OF ENGINEERS
HUNTINGTON, WEST VIRGINIA

SCIO TO RIVER
 COLUMBUS, OHIO
 WEST COLUMBUS, L.P.P.
 PHASE IID

HYDROLOGY
STAGE HYDROGRAPHS

Designed by: **D.O.K.**
 Drawn by: **JOE SALVINO**
 Checked by: **JOHN BOCK**
 Reviewed by: **KEN HALSTEAD**
 Approved by:

Scale: **NONE**
 Date:

Drawing Code: **016-PWC-10-**

Sheet reference number: **147**

FILENAME: 00hth07.dgn
 PEN TABLE: STD-pb.tbl
 STD-d.pfb

Sheet **7** of **16**




GENERAL NOTES
 STAGE HYDROGRAPHS AS SHOWN REPRESENT DAILY STAGE AT
 COLUMBUS USGS GAGE FOR THE PERIOD 1921-1991
 GAGE DATUM 680.4 NGVD

FOR INFORMATION PURPOSES ONLY

Symbol	Revisions		Date	Approved
	Descriptions			

U.S. ARMY ENGINEER DISTRICT CORPS OF ENGINEERS HUNTINGTON, WEST VIRGINIA			
SCIO TO RIVER COLUMBUS, OHIO WEST COLUMBUS, L.P.P. PHASE IID			
HYDROLOGY STAGE HYDROGRAPHS			
Designed by: D.O.K.		Scale: NONE Date:	Sheet reference number: 148
Drawn by: JOE SALVINO			
Checked by: JOHN BOCK			
Reviewed by: KEN HALSTEAD			
Approved by:			

FILENAME: 00hth08.dgn
PEN TABLE: STD-b-pfb
STD-d-pfb
Sheet 8 of 16

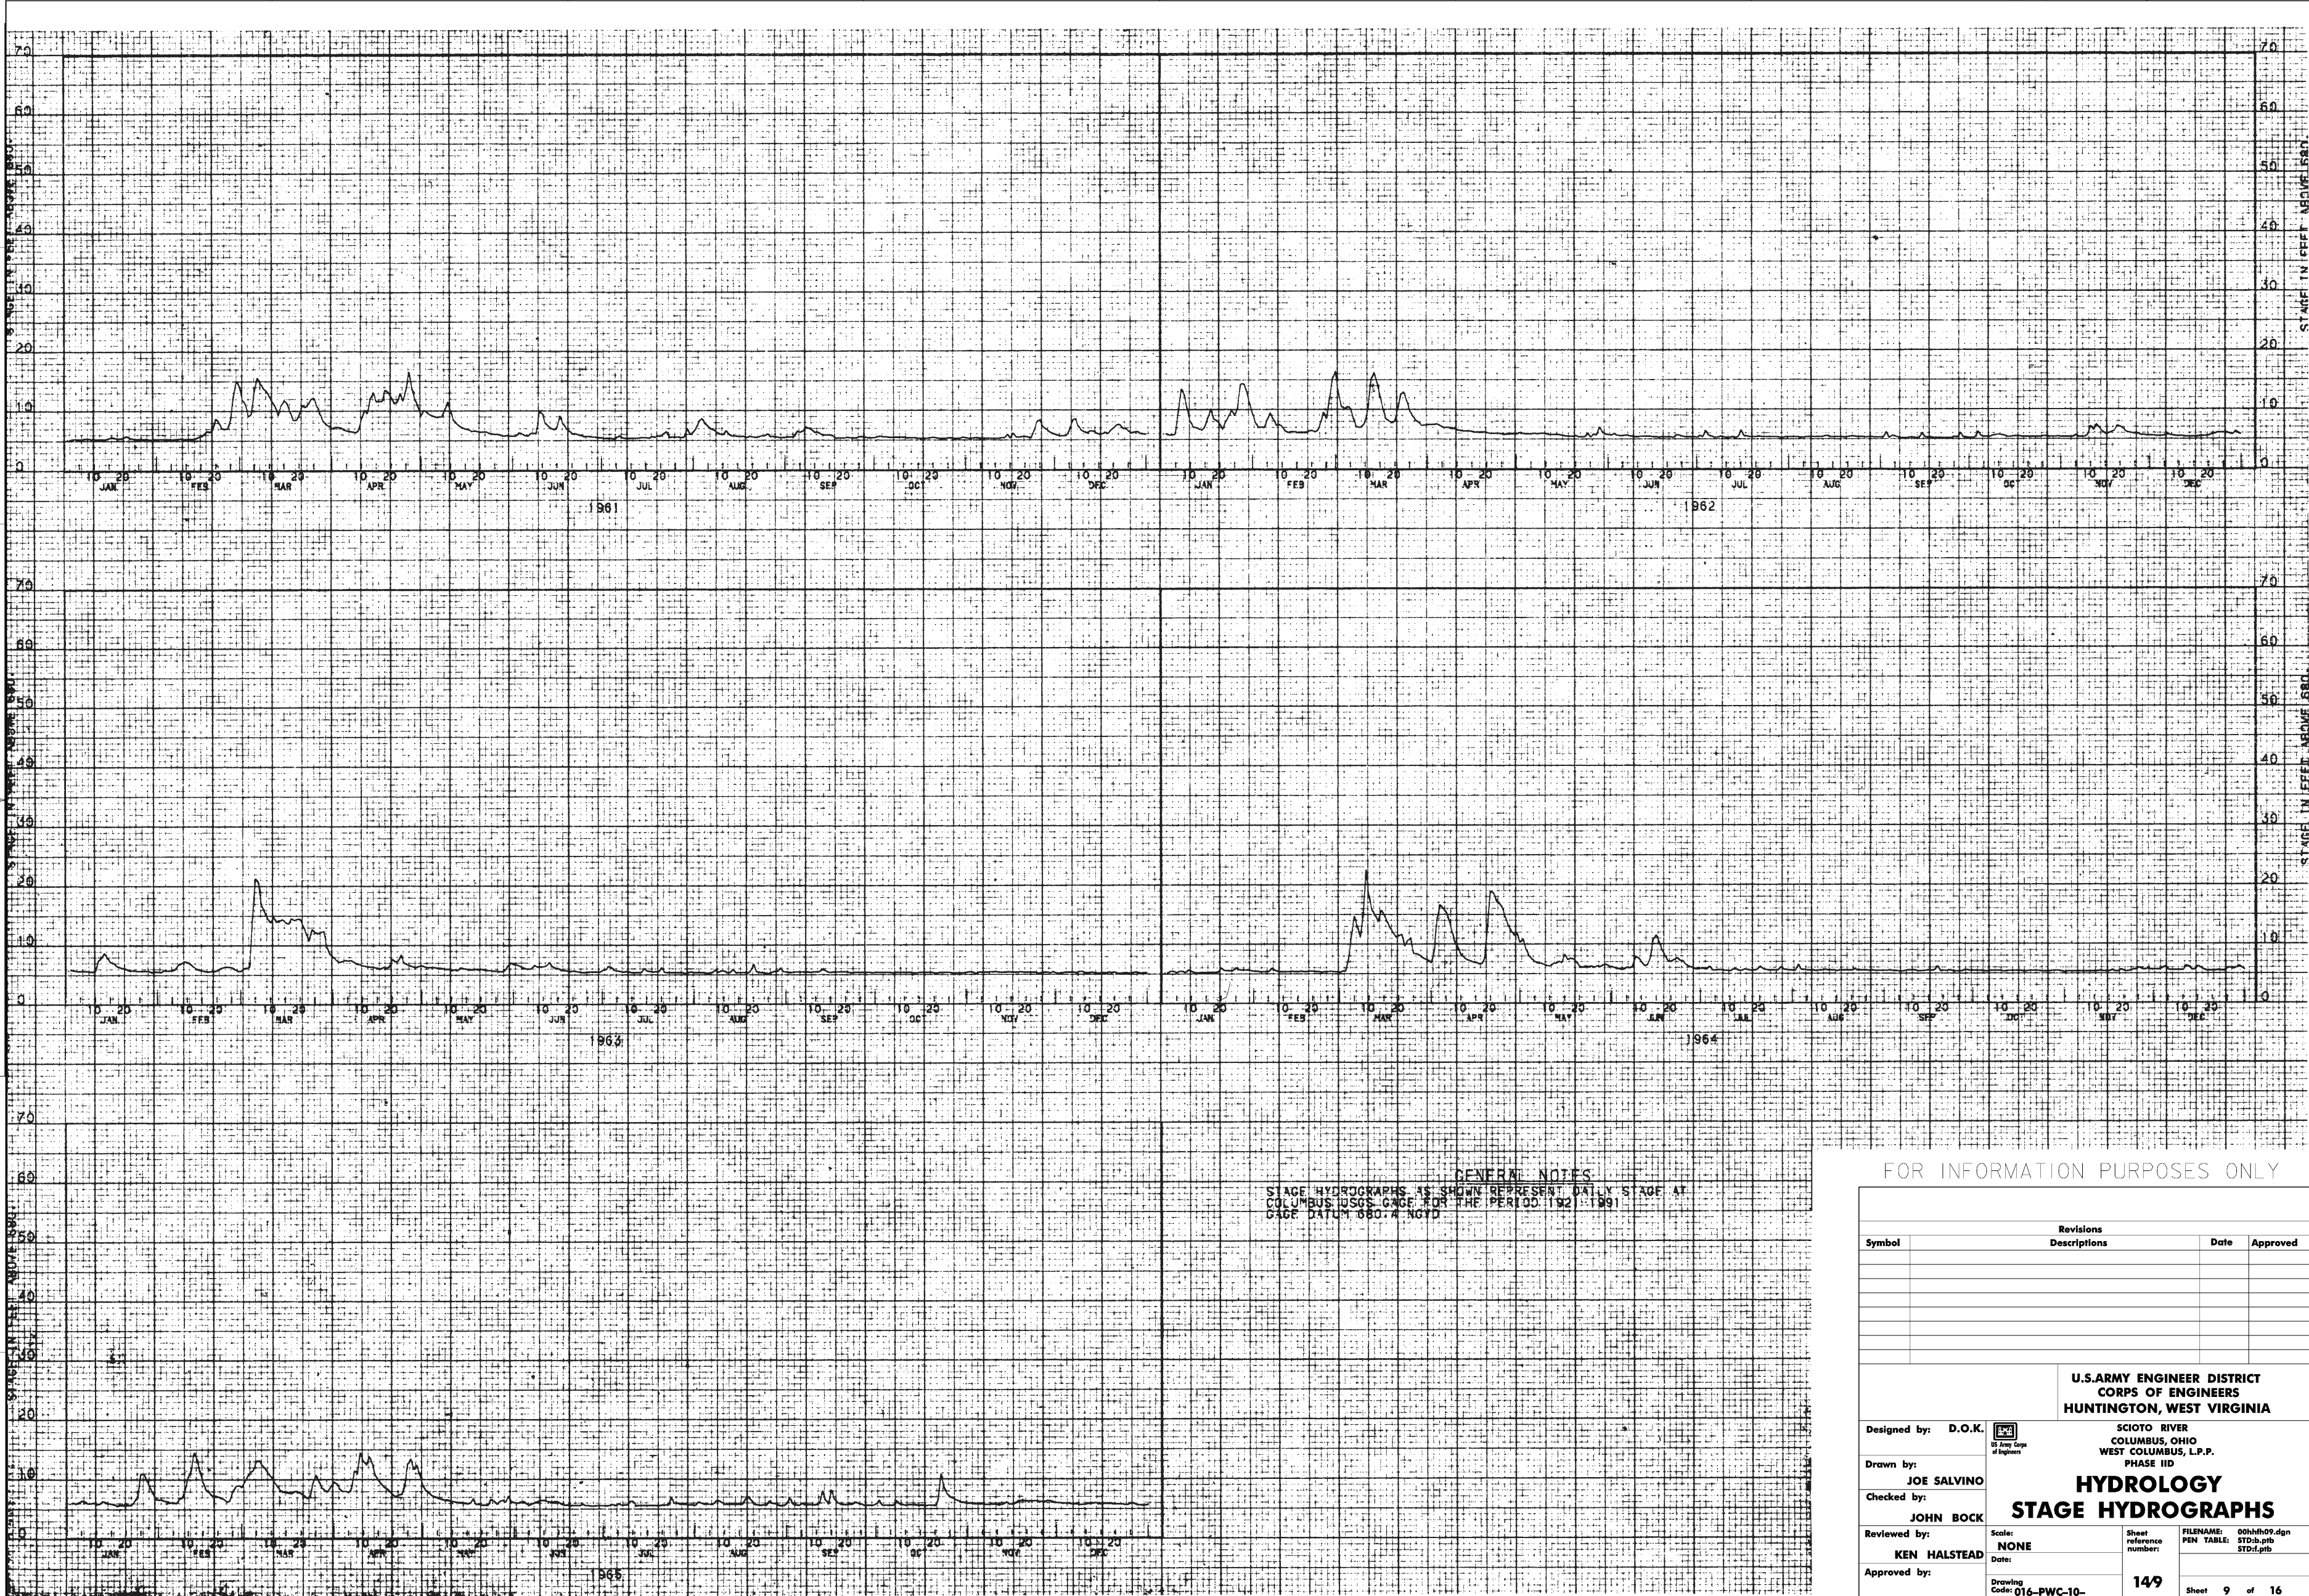

GENERAL NOTES
 STAGE HYDROGRAPHS AS SHOWN REPRESENT DAILY STAGE AT
 COLUMBUS USGS GAGE FOR THE PERIOD 1962-1991
 GAGE DATUM 580.4 NGVD

FOR INFORMATION PURPOSES ONLY

Symbol	Revisions		Date	Approved
	Descriptions			

U.S. ARMY ENGINEER DISTRICT
CORPS OF ENGINEERS
HUNTINGTON, WEST VIRGINIA

SCIO TO RIVER
 COLUMBUS, OHIO
 WEST COLUMBUS, L.P.P.
 PHASE IID

HYDROLOGY
STAGE HYDROGRAPHS

Designed by: **D.O.K.**
 Drawn by: **JOE SALVINO**
 Checked by: **JOHN BOCK**
 Reviewed by: **KEN HALSTEAD**
 Approved by:

Scale: **NONE**
 Date:

Drawing Code: **016-PWC-10-**

Sheet reference number: **149**
 FILENAME: 00hth09.dgn
 PEN TABLE: STD-b-pib
 STD-d-pib

Sheet **9** of **16**



GENERAL NOTES
 STAGE HYDROGRAPHS AS SHOWN REPRESENT DAILY STAGE AT
 COLUMBUS USGS GAGE FOR THE PERIOD 1921-1991
 GAGE DATUM 880.4 NGVD


FOR INFORMATION PURPOSES ONLY


Symbol	Revisions		Date	Approved
	Descriptions			

U.S. ARMY ENGINEER DISTRICT
 CORPS OF ENGINEERS
 HUNTINGTON, WEST VIRGINIA

SCIO TO RIVER
 COLUMBUS, OHIO
 WEST COLUMBUS, L.P.P.
 PHASE IID

HYDROLOGY
STAGE HYDROGRAPHS

Designed by: D.O.K. 
 Drawn by: JOE SALVINO
 Checked by: JOHN BOCK
 Reviewed by: KEN HALSTEAD
 Approved by:
 Scale: NONE
 Date:
 Sheet reference number: 14/10
 FILENAME: 00hth10.dgn
 PEN TABLE: STD-b.ptb
 STD-d.ptb
 Drawing Code: 016-PWC-10-
 Sheet 10 of 16

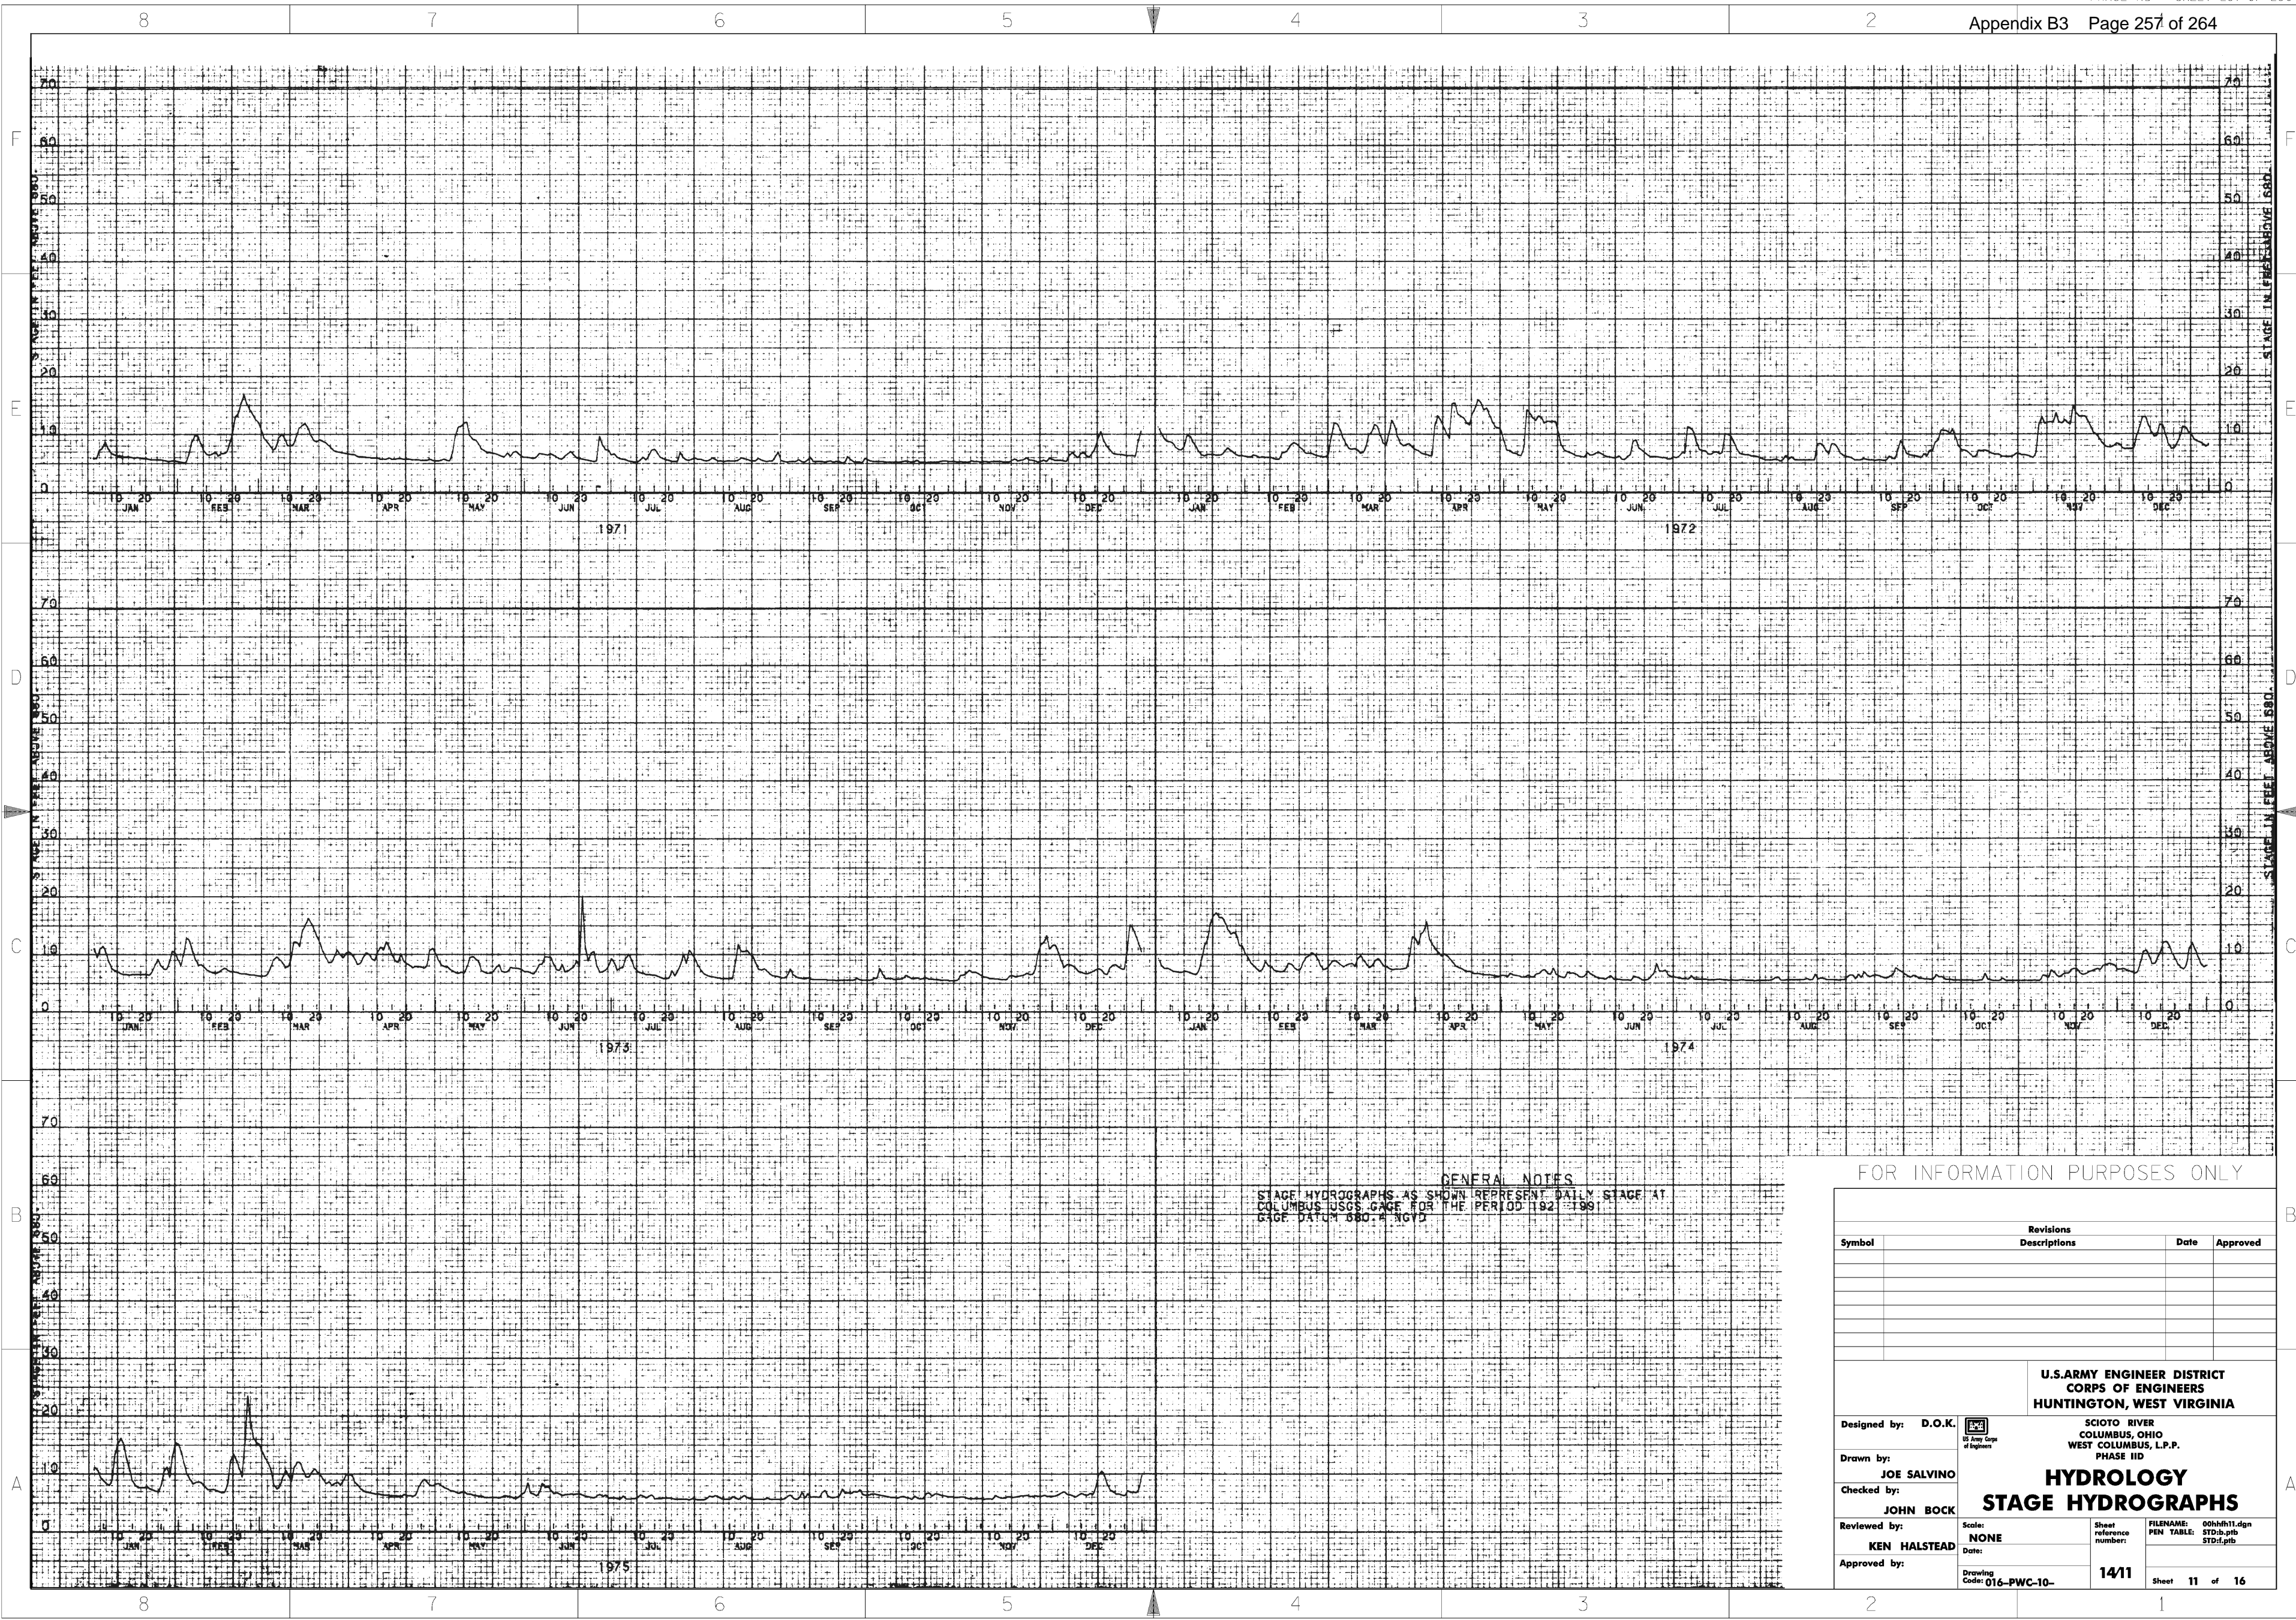

GENERAL NOTES
 STAGE HYDROGRAPHS AS SHOWN REPRESENT DAILY STAGE AT
 COLUMBUS USGS GAGE FOR THE PERIOD 1921-1991
 GAGE DATUM 880.4 NGVD

FOR INFORMATION PURPOSES ONLY

Symbol	Revisions Descriptions	Date	Approved

U.S. ARMY ENGINEER DISTRICT
CORPS OF ENGINEERS
HUNTINGTON, WEST VIRGINIA

SCIO TO RIVER
 COLUMBUS, OHIO
 WEST COLUMBUS, L.P.P.
 PHASE IID

HYDROLOGY
STAGE HYDROGRAPHS

Designed by: **D.O.K.**
 Drawn by: **JOE SALVINO**
 Checked by: **JOHN BOCK**
 Reviewed by: **KEN HALSTEAD**
 Approved by:

Scale: **NONE**
 Date:

Drawing Code: **016-PWC-10-**

Sheet reference number: **14/11**

FILENAME: 00hh11.dgn
 PEN TABLE: STD-b.pfb
 STD-d.pfb

Sheet **11** of **16**



GENERAL NOTES
 STAGE HYDROGRAPHS AS SHOWN REPRESENT DAILY STAGE AT
 COLUMBUS USGS GAGE FOR THE PERIOD 1927-1991
 GAGE DATUM 580.4 NGVD

FOR INFORMATION PURPOSES ONLY

Symbol	Revisions		Date	Approved
	Descriptions			

U.S. ARMY ENGINEER DISTRICT
CORPS OF ENGINEERS
HUNTINGTON, WEST VIRGINIA

SCIO TO RIVER
 COLUMBUS, OHIO
 WEST COLUMBUS, L.P.P.
 PHASE IID


HYDROLOGY
STAGE HYDROGRAPHS

Designed by: **D.O.K.**
 Drawn by: **JOE SALVINO**
 Checked by: **JOHN BOCK**
 Reviewed by: **KEN HALSTEAD**
 Approved by:

Scale: **NONE**
 Date:

Sheet reference number: **14/12**
 FILENAME: 00hth12.dgn
 PEN TABLE: STD-b.pfb
 STD-d.pfb

Drawing Code: **016-PWC-10-**
 Sheet **12** of **16**

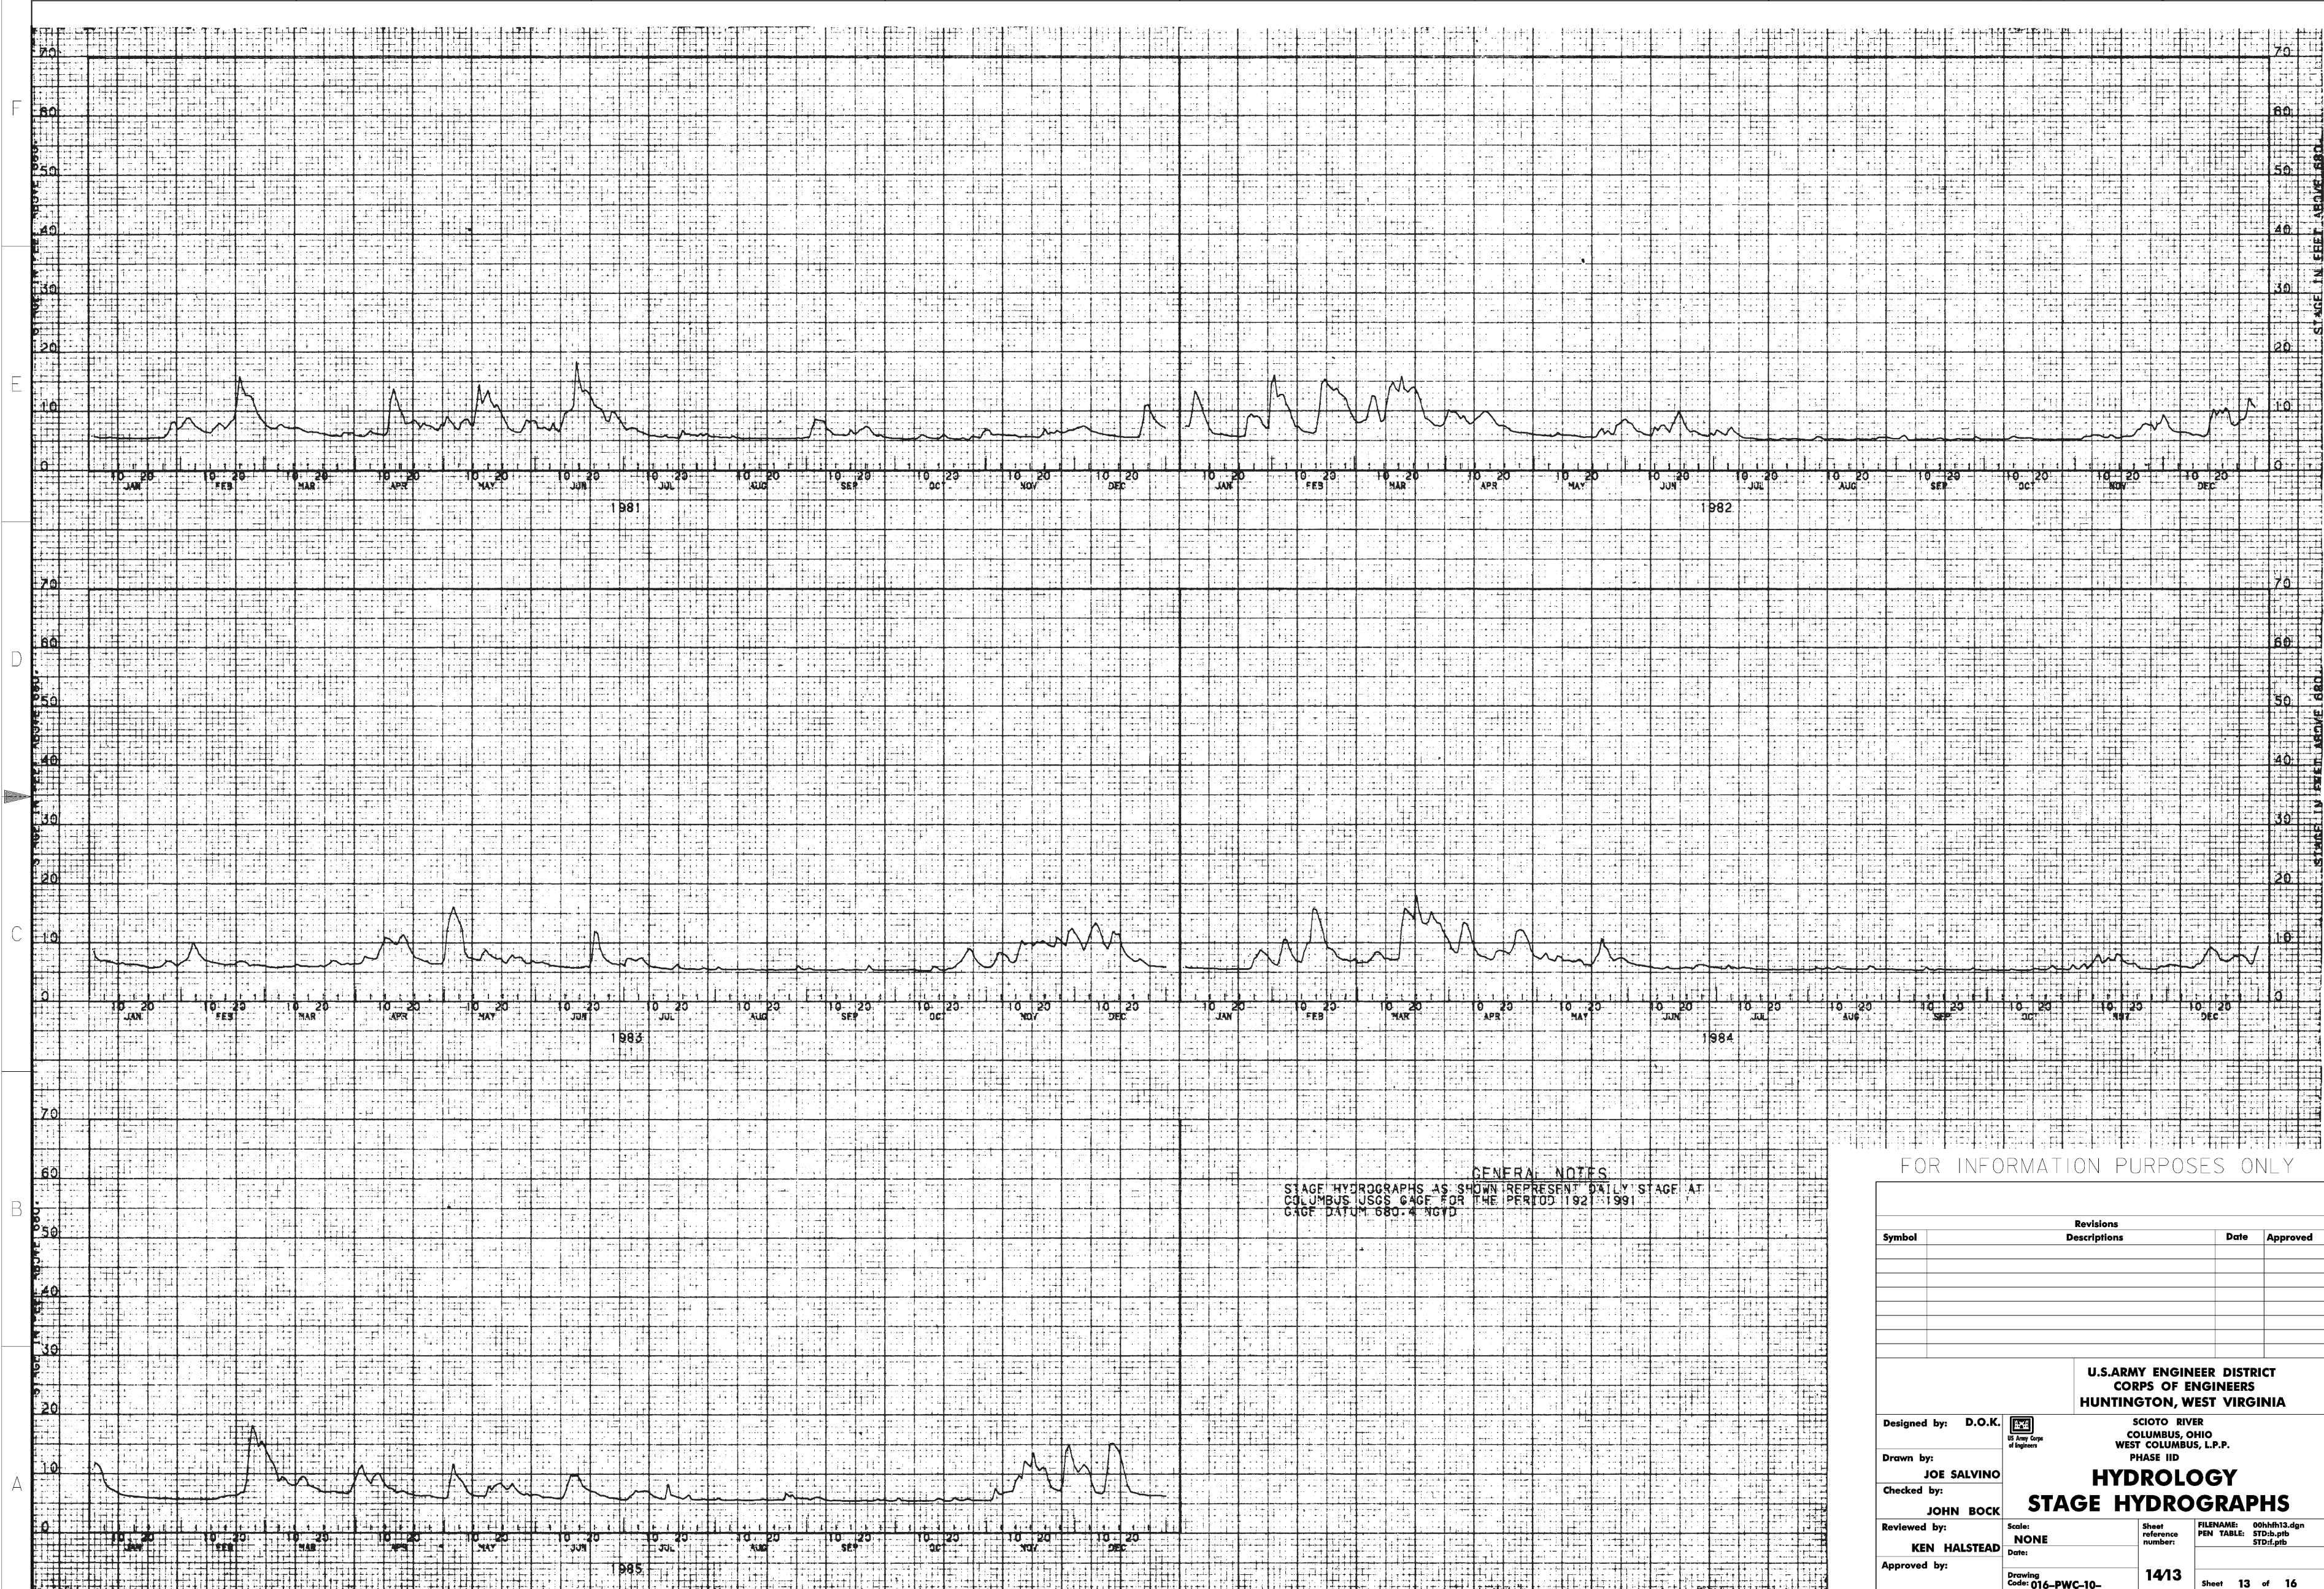


GENERAL NOTES
 STAGE HYDROGRAPHS AS SHOWN REPRESENT DAILY STAGE AT
 COLUMBUS USGS GAGE FOR THE PERIOD 1921-1991
 GAGE DATUM 680.4 NGVD

FOR INFORMATION PURPOSES ONLY

Symbol	Revisions Descriptions	Date	Approved

U.S. ARMY ENGINEER DISTRICT CORPS OF ENGINEERS HUNTINGTON, WEST VIRGINIA		SCIOTO RIVER COLUMBUS, OHIO WEST COLUMBUS, L.P.P. PHASE IID	
HYDROLOGY STAGE HYDROGRAPHS			
Designed by: D.O.K. Drawn by: JOE SALVINO Checked by: JOHN BOCK Reviewed by: KEN HALSTEAD Approved by:	Scale: NONE Date:	Sheet reference number: 14/13	FILENAME: 00hth13.dgn PEN TABLE: STD-b-pib STD-d-pib Sheet 13 of 16
Drawing Code: 016-PWC-10-		14/13	

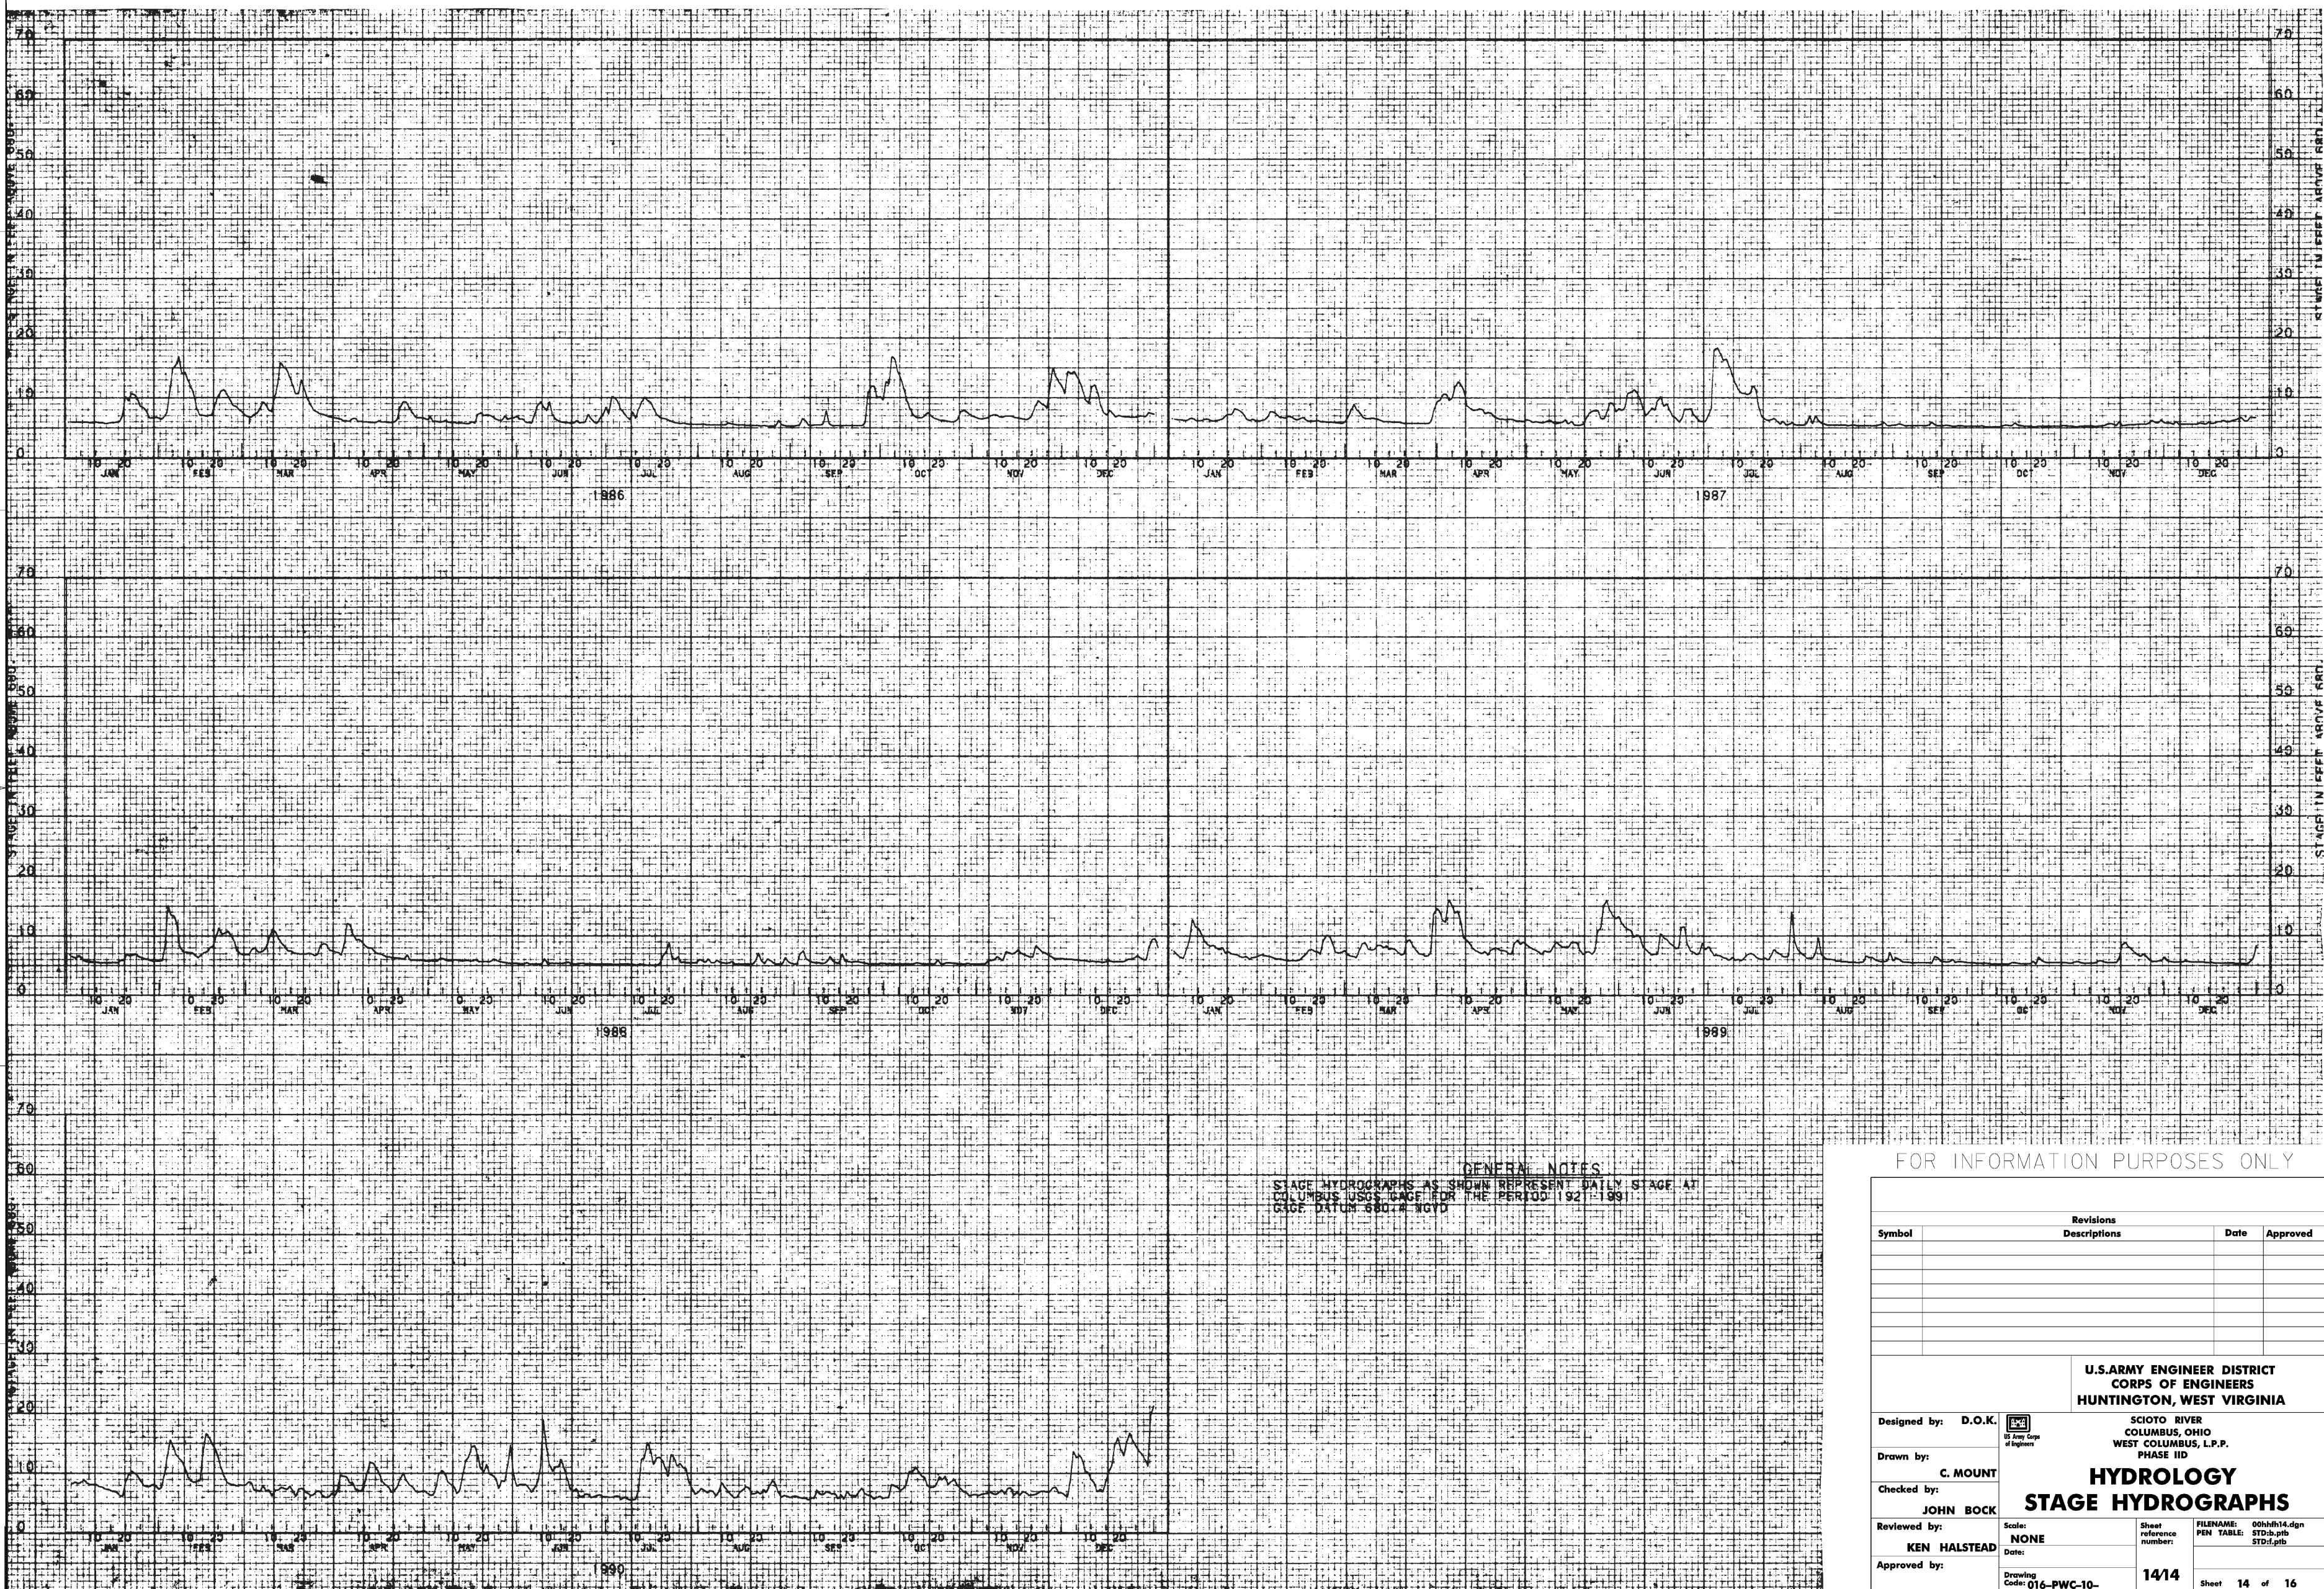





GENERAL NOTES
 STAGE HYDROGRAPHS AS SHOWN REPRESENT DAILY STAGE AT COLUMBUS USGS GAGE FOR THE PERIOD 1921-1991
 GAGE DATUM 680.4 NGVD

FOR INFORMATION PURPOSES ONLY

Symbol	Revisions		Date	Approved
	Descriptions			

U.S. ARMY ENGINEER DISTRICT CORPS OF ENGINEERS HUNTINGTON, WEST VIRGINIA			
SCIO TO RIVER COLUMBUS, OHIO WEST COLUMBUS, L.P.P. PHASE IID			
HYDROLOGY STAGE HYDROGRAPHS			
Designed by: D.O.K.		Scale: NONE Date:	Sheet reference number: 14/14
Drawn by: C. MOUNT			
Checked by: JOHN BOCK			
Reviewed by: KEN HALSTEAD			
Approved by:			

STAGE IN FEET ABOVE 680.4

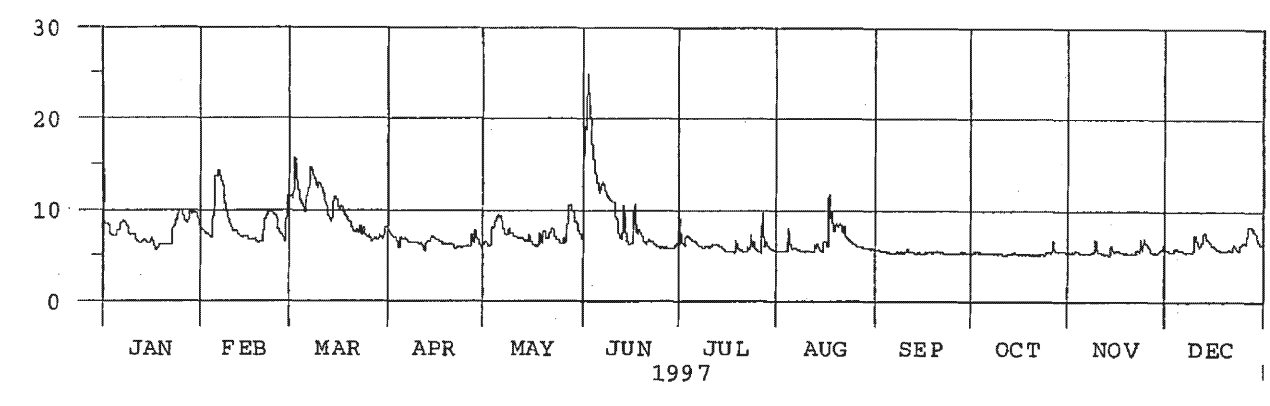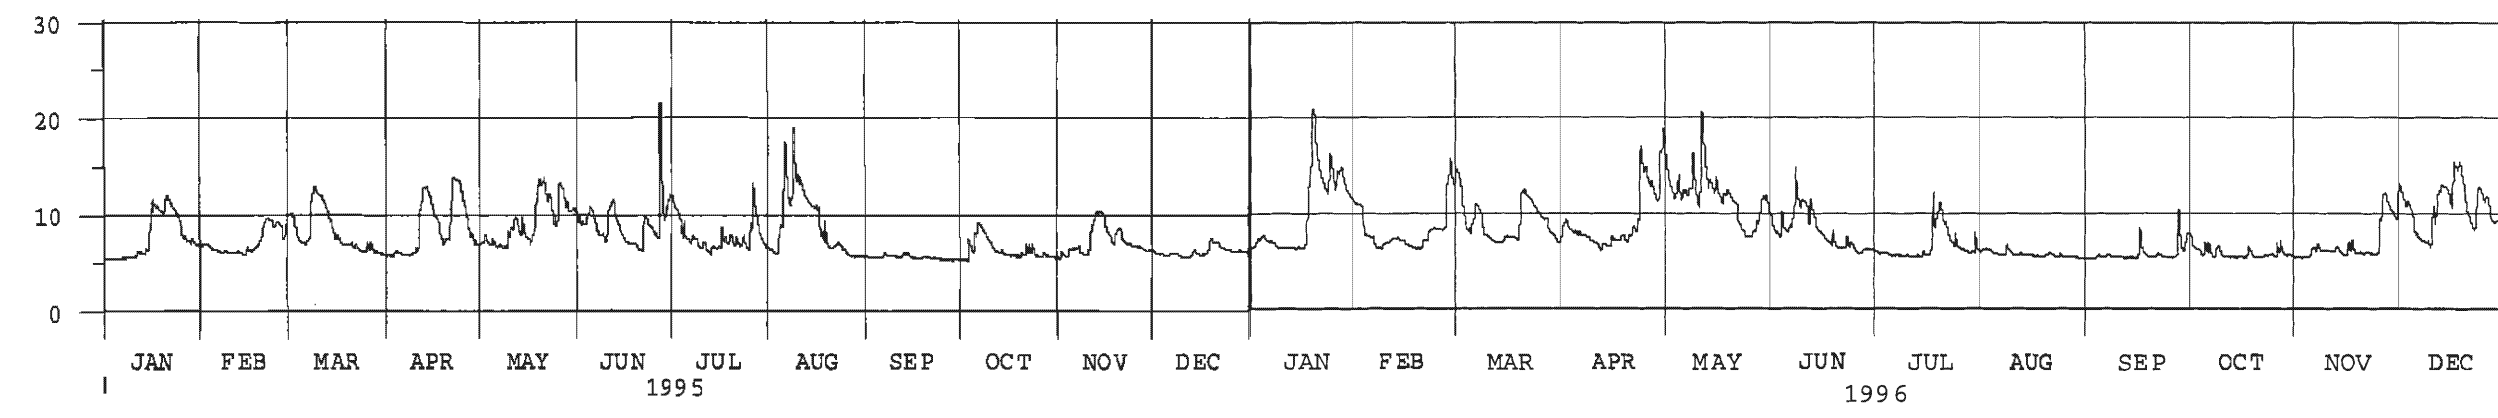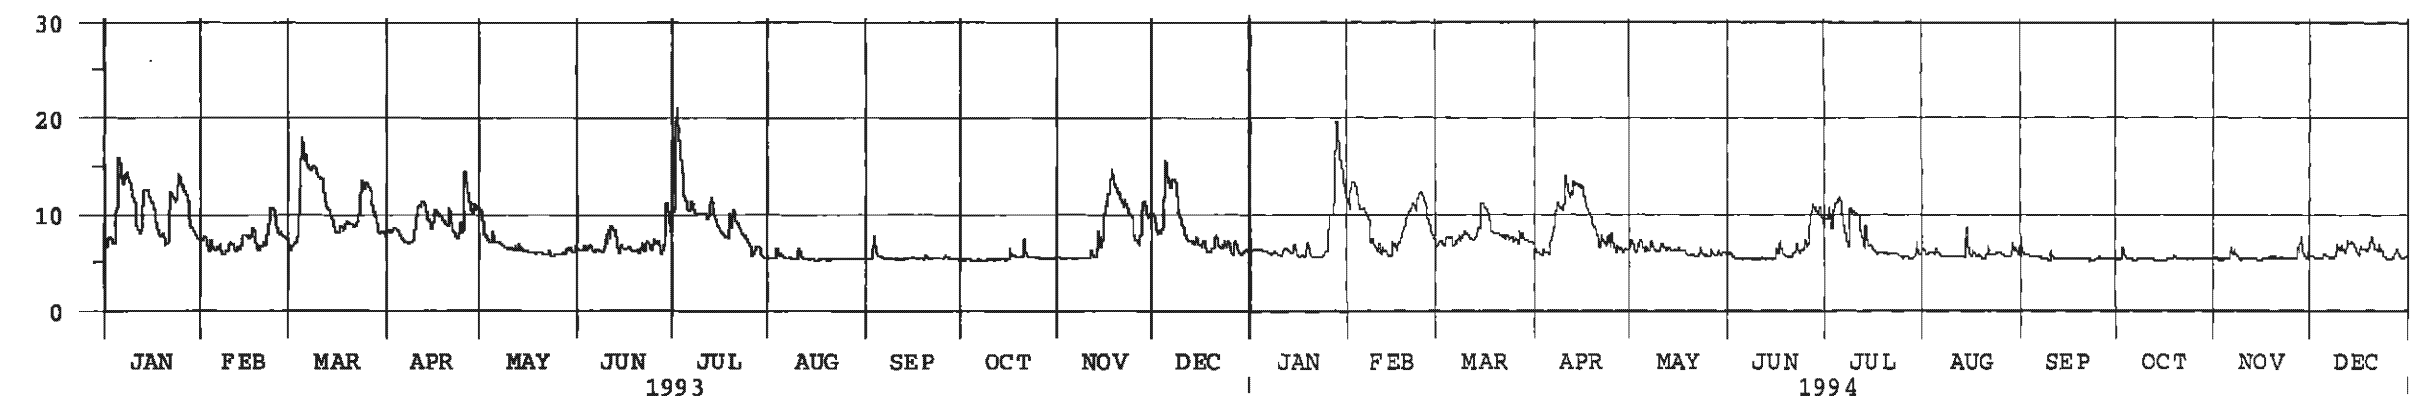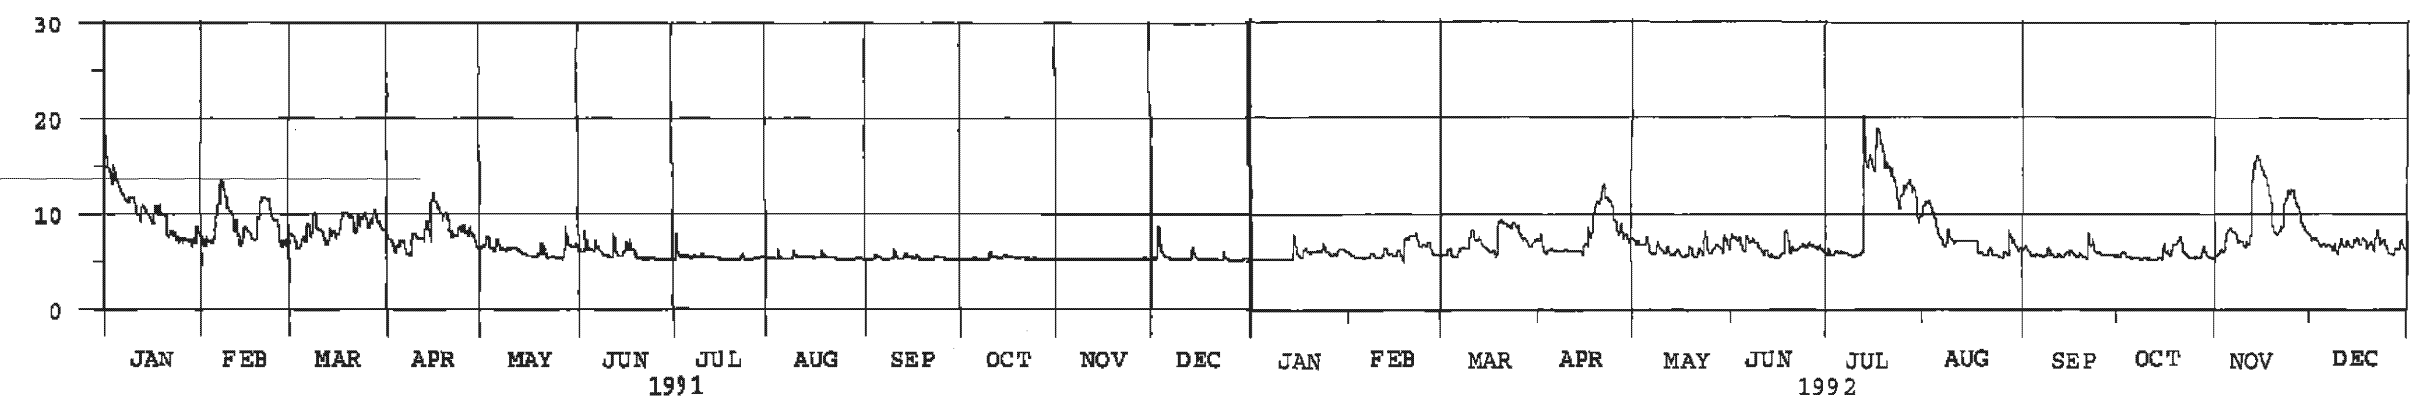


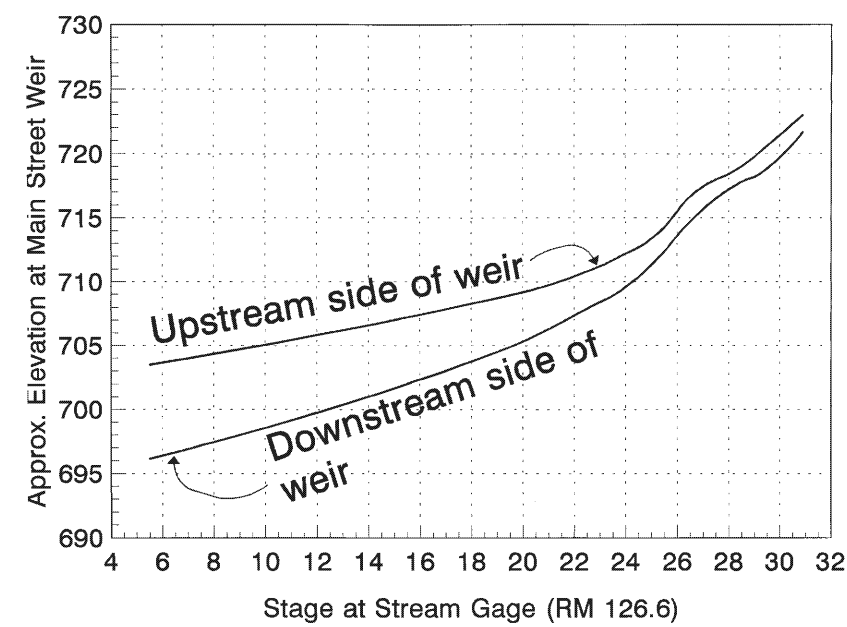
NOTES

STAGE HYDROGRAPHS AS SHOWN REPRESENT DAILY STAGE AT COLUMBUS USGS GAGE FOR THE PERIOD 1921-1997 GAGE DATUM 680.4 NGVD.
 PLOTS OBTAINED FROM SCANNED IMAGES OF CEORH-ED-HR SATELLITE DATA W/VERTICAL SCALE RANGE 0-100.


FOR INFORMATION PURPOSES ONLY

Revisions			
Symbol	Descriptions	Date	Approved


U.S. ARMY ENGINEER DISTRICT CORPS OF ENGINEERS HUNTINGTON, WEST VIRGINIA			
Designed by:	V.L.P.	 Professional Engineer State of Ohio	SCIOTO RIVER COLUMBUS, OHIO WEST COLUMBUS, L.P.P. PHASE IID
Drawn by:	C.S.C.		
Checked by:	HYDROLOGY STAGE HYDROGRAPHS		
Reviewed by:	KEN HALSTEAD	Scale: NONE	Sheet reference number: 1415
Approved by:		Date:	FILENAME: 00hhfh15.dgn PEN TABLE: STD: b.plt STD: f.plt
Drawing Code: 016-PWC-10-		1415	Sheet 15 of 16




Correlation Curve from Stream Gage to Phase IID - Main Street Weir

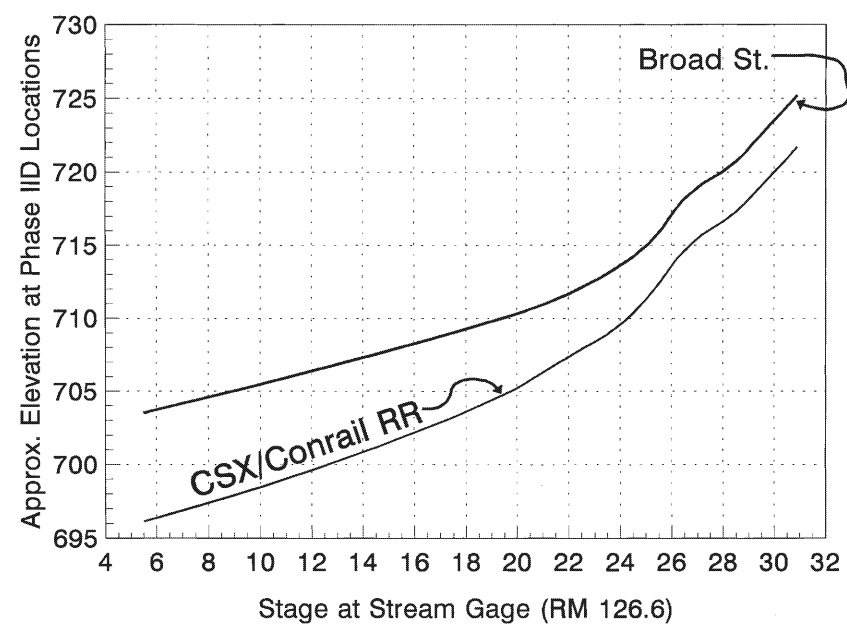

Correlation Curve from Stream Gage to IID Locations

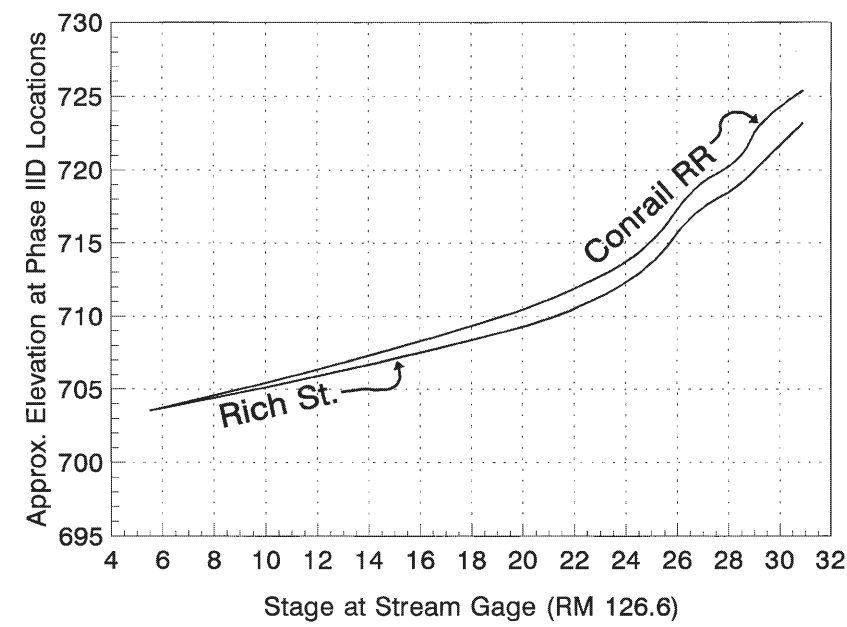

Correlation Curve from Stream Gage to IID Locations

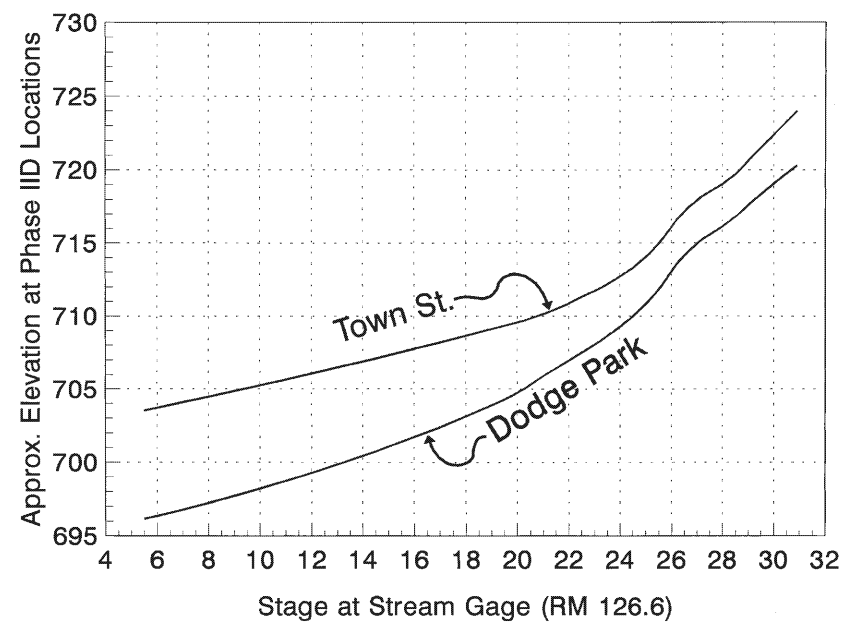

Correlation Curve from Stream Gage to IID Locations


NOTES

PHASE IID LOCATIONS IN ORDER FROM UPSTREAM TO DOWNSTREAM ARE:

- CONRAIL RR
- BROAD ST.
- TOWN ST.
- RICH ST.
- UPSTREAM SIDE OF WIER
- DOWNSTREAM SIDE OF WIER
- CSX / CONRAIL RR
- DODGE PARK

FOR INFORMATION PURPOSES ONLY

Revisions			
Symbol	Descriptions	Date	Approved

U.S. ARMY ENGINEER DISTRICT CORPS OF ENGINEERS HUNTINGTON, WEST VIRGINIA			
Designed by: K.C.H.	 SCIOTO RIVER COLUMBUS, OHIO WEST COLUMBUS, L.P.P. PHASE IID	HYDROLOGY CORRELATION CURVE	
Drawn by: JOE SALVINO			
Checked by: JOHN BOCK	Scale: NONE	Sheet reference number: 14/16	FILENAME: PEN TABLE: 00hhhh16.dgn STD-b.ptb STD-f.ptb
Reviewed by: KEN HALSTEAD	Date:		
Approved by:	Drawing Code: 016-PWC-10-		Sheet 16 of 16

